


GENERAL NOTES

- 1.) THE PROJECT IS IN CONFORMANCE WITH THE LATEST HOWARD COUNTY STANDARDS UNLESS ALTERNATIVE COMPLIANCES OR DESIGN MANUAL WAIVERS HAVE BEEN APPROVED.
2.) THIS PROJECT IS SUBJECT TO THE AMENDED FIFTH EDITION OF THE SUBDIVISION AND LAND DEVELOPMENT REGULATIONS...
3.) THE SUBJECT PROPERTY IS ZONED PGCC-1 PER THE 10-6-2013 COMPREHENSIVE ZONING PLAN.
4.) TRACT BOUNDARY IS BASED ON RECORD PLAT NO. 25078-25081.
5.) THE COORDINATES SHOWN HEREON ARE BASED UPON THE HOWARD COUNTY GEODETIC CONTROL WHICH IS BASED UPON THE MARYLAND STATE PLANE COORDINATE SYSTEM...
6.) THE EXISTING TOPOGRAPHY SHOWN ON THESE LOTS IS BASED ON MASS GRADING AS SHOWN ON APPROVED F-17-095 ROAD CONSTRUCTION PLANS AND AERIAL TOPOGRAPHIC SURVEY BY WINGS AERIAL MAPPING, CO., FLOWN ON OR ABOUT JANUARY, 2006.
7.) THE EXISTING UTILITIES SHOWN ARE BASED ON CONTRACT DRAWINGS AND FILED SURVEY LOCATIONS.
8.) THIS PROJECT IS LOCATED WITHIN THE METROPOLITAN DISTRICT.
9.) WATER IS PUBLIC. THE CONTRACT NUMBERS ARE 24-5133-D.
10.) SEWER IS PUBLIC. THE CONTRACT NUMBERS ARE 24-5133-D.
11.) LOTS 1-7 ARE SUBJECT TO SECTION 18.122B OF THE HOWARD COUNTY CODE...
12.) THERE ARE NO WETLANDS, STREAMS, THEIR REQUIRED BUFFERS, 100-YEAR FLOODPLAIN OR 25% OR GREATER STEEP SLOPES THAT ARE AT LEAST 20,000 S.F. OF CONTIGUOUS AREA LOCATED ON LOTS 1-7 OR BUILDABLE BULK PARCEL 'AA'.
13.) TO THE BEST OF OUR KNOWLEDGE, THERE ARE NO BURIAL GROUNDS, CEMETERIES OR HISTORIC STRUCTURES LOCATED ON THESE LOTS.
14.) THE NOISE STUDY WAS ORIGINALLY PREPARED BY HUSH ACOUSTICS LLC DATED OCTOBER 23, 2016 AND APPROVED UNDER SP-16-011 ON JANUARY 10, 2017...
15.) THE TRAFFIC STUDY WAS PREPARED BY THE TRAFFIC GROUP ON JANUARY 7, 2005 AND UPDATED ON AUGUST 11, 2006 AND WAS APPROVED UNDER THE 4TH AMENDED COMPREHENSIVE SKETCH PLAN, S-86-013.
16.) THE GEOTECHNICAL REPORTS WERE PREPARED BY HILLIS-CARNES ENGINEERING ASSOCIATES ON APRIL 26, 2016, OCTOBER 1, 2019, AND FEBRUARY 18, 2020.
17.) THE STORMWATER MANAGEMENT REPORT WAS PREPARED BY BENCHMARK ENGINEERING, INC. THE STORMWATER MANAGEMENT FOR THIS PROJECT COMPLIES WITH 'MARYLAND DEPARTMENT OF THE ENVIRONMENT STORMWATER MANAGEMENT ACT OF 2007' AND THE 'HOWARD COUNTY DESIGN MANUAL VOLUME 1, CHAPTER 5'.
18.) DECLARATION OF COVENANTS FOR LOTS 1-7 WERE RECORDED ON APRIL 29, 2019 WITH THE F-18-027 SUBDIVISION PLAN.
19.) THE REQUIREMENT OF SECTION 16.1200 OF THE HOWARD COUNTY CODE FOR FOREST CONSERVATION FOR THESE LOTS WAS PROVIDED UNDER F-17-095.
20.) LANDSCAPING IS PROVIDED IN ACCORDANCE WITH SECTION 16.124 OF THE HOWARD COUNTY CODE AND THE LANDSCAPE MANUAL AS SHOWN ON THE CERTIFIED LANDSCAPE PLAN WITHIN THIS SITE DEVELOPMENT PLAN SET.
21.) DRIVEWAYS SHALL BE PROVIDED PRIOR TO ISSUANCE OF A USE AND OCCUPANCY PERMIT FOR ANY NEW DWELLINGS FOR FIRE AND EMERGENCY VEHICLES PER THE FOLLOWING MINIMUM REQUIREMENTS:
A) WIDTH - 12' (16' SERVING MORE THAN ONE RESIDENCE).
B) SURFACE - 6" OF COMPACT CRUSHER RUN BASE WITH TAR AND CHIP COATING (1-3/4" MIN.).
C) GEOMETRY - MAX. 15% GRADE, MAX. 10% GRADE CHANGE & MIN. 45' TURNING RADIUS.
D) STRUCTURES/CULVERTS/BRIDGES - CAPABLE OF SUPPORTING 25 GROSS TONS (H25 LOAD)
E) DRAINAGE ELEMENTS - CAPABLE OF SAFELY PASSING 100 YEAR FLOODPLAIN WITH NO MORE THAN 1 FOOT DEPTH OVER DRIVEWAY.
G) MAINTENANCE - SUFFICIENT TO INSURE ALL WEATHER USE.
22.) ANY DAMAGE TO THE COUNTY'S RIGHT-OF-WAY SHALL BE CORRECTED AT THE BUILDER'S EXPENSE.
23.) FOR DRIVEWAY APRON DETAIL, REFER TO THE HOWARD COUNTY DESIGN MANUAL, VOLUME IV, STANDARD DETAIL R-6.03.
24.) SNOW REMOVAL, MAINTENANCE, AND TRASH COLLECTION FOR THE APARTMENT BUILDINGS SHALL BE PRIVATE.
25.) A KNOX BOX SHALL BE PLACED ON THE FRONT OF ALL APARTMENT BUILDINGS NO MORE THAN 6' TO THE RIGHT OF THE MAIN ENTRANCE AT A HEIGHT OF 4'-5". IT SHALL BE ELECTRONICALLY SUPERVISED TO NOTIFY THE OWNER THAT IT IS BEING ACCESSSED (INTEGRATED WITH THE FIRE SYSTEM). MORE THAN ONE KNOX BOX PER BUILDING MAY BE REQUIRED. THE CONSTRUCTION SUPERINTENDENT SHOULD COORDINATE WITH THE OFFICE OF THE FIRE MARSHAL TO DETERMINE THE NUMBER OF KNOX BOXES REQUIRED AND THE PLACEMENT LOCATIONS.
26.) IN ACCORDANCE WITH SECTION 128 OF THE HOWARD COUNTY ZONING REGULATIONS, BAY WINDOWS, WINDOW WELLS, ORIELS, VESTIBULES, BALCONIES AND CHIMNEYS MAY ENCLOSED 4 FEET INTO ANY SETBACK OR REQUIRED DISTANCE BETWEEN BUILDINGS PROVIDED THE FEATURE HAS A MAXIMUM WIDTH OF 16 FEET. EXTERIOR STAIRWAYS OR RAMPS, ABOVE OR BELOW GROUND LEVEL (EXCLUDING THOSE ATTACHED TO A PORCH OR DECK) MAY ENCLOSED 10 FEET INTO A FRONT SETBACK OR A SETBACK FROM A PROJECT BOUNDARY, 16 FEET INTO A REAR SETBACK, 4 FEET INTO A SIDE SETBACK OR REQUIRED DISTANCE BETWEEN BUILDINGS, OPEN OR ENCLOSED PORCHES OR DECKS AND THE STAIRWAYS OR RAMPS ATTACHED THERETO MAY ENCLOSED 10 FEET INTO A FRONT OR REAR SETBACK, SETBACK FROM A PROJECT BOUNDARY OR A REQUIRED DISTANCE BETWEEN BUILDINGS.
27.) THE CONTRACTOR SHALL NOTIFY THE DEPARTMENT OF PUBLIC WORKS/BUREAU OF ENGINEERING/CONSTRUCTION INSPECTION DIVISION AT 410-313-1880 AT LEAST FIVE (5) WORKING DAYS PRIOR TO THE START OF WORK.
28.) THE CONTRACTOR SHALL NOTIFY "MISS UTILITY" AT 1-800-257-7777 AT LEAST 48 HOURS PRIOR TO ANY EXCAVATION WORK BEING DONE.
29.) SHC ELEVATIONS SHOWN ARE LOCATED AT THE PROPERTY LINE.
30.) THE OPEN SPACE REQUIREMENT FOR THIS SITE DEVELOPMENT PLAN WAS PROVIDED UNDER THE RAVENWOOD AT TURF VALLEY FINAL ROAD CONSTRUCTION PLANS, F-18-027. A TOTAL OF 3.82 ACRES WAS REQUIRED (15% OF GROSS AREA) AND A TOTAL OF 15.38 ACRES WAS PROVIDED.
31.) THE OFFSITE WETLANDS LIMITS SHOWN ARE BASED ON A STUDY CONDUCTED BY EXPLORATION RESEARCH, INC. AND VERIFIED BY ECO-SCIENCE PROFESSIONALS, INC. ON MAY 26, 2016. THE LIMITS SHOWN ARE IN ACCORDANCE WITH THOSE SHOWN ON THE 4TH AMENDMENT TO THE TURF VALLEY COMPREHENSIVE SKETCH PLAN (S-86-13, PB 368) APPROVED JULY 28, 2006.
32.) THE OFF-SITE 100-YEAR FLOODPLAIN LIMITS SHOWN ALONG THE STREAM ON THE SOUTHWEST PORTION OF THE SITE IS BASED ON A STUDY PREPARED BY BENCHMARK ENGINEERING, INC. IN SEPTEMBER, 2016 AND APPROVED BY THE DEPARTMENT OF PLANNING AND ZONING UNDER SP-16-011 ON MARCH 29, 2017. THE FLOODPLAIN LIMIT ALONG THE STREAM ON THE SOUTHEAST PORTION OF THE SITE (LITTLE PATUXENT RIVER TRIBUTARY 15) IS BASED ON FEMA FLOOD INSURANCE MAP NUMBER 24027C0900, EFFECTIVE NOVEMBER 6, 2013.
33.) THIS PROJECT IS EXEMPT FROM MIHU REQUIREMENTS SINCE IT IS ZONED PGCC-1.
34.) THE DEPARTMENT OF PLANNING AND ZONING HAS DETERMINED THAT THE DISTURBANCE TO THE STREAM AND WETLAND BUFFERS ASSOCIATED WITH THE INSTALLATION OF THE UNDERGROUND UTILITIES IS NECESSARY IN ACCORDANCE WITH SECTION 16.116(c) OF THE SUBDIVISION AND LAND DEVELOPMENT REGULATIONS.

RESIDENTIAL SINGLE FAMILY ATTACHED AND MULTI-FAMILY SITE DEVELOPMENT PLAN RAVENWOOD CONDOMINIUMS AT TURF VALLEY LOTS 1 thru 7 AND BUILDABLE BULK PARCEL 'AA'

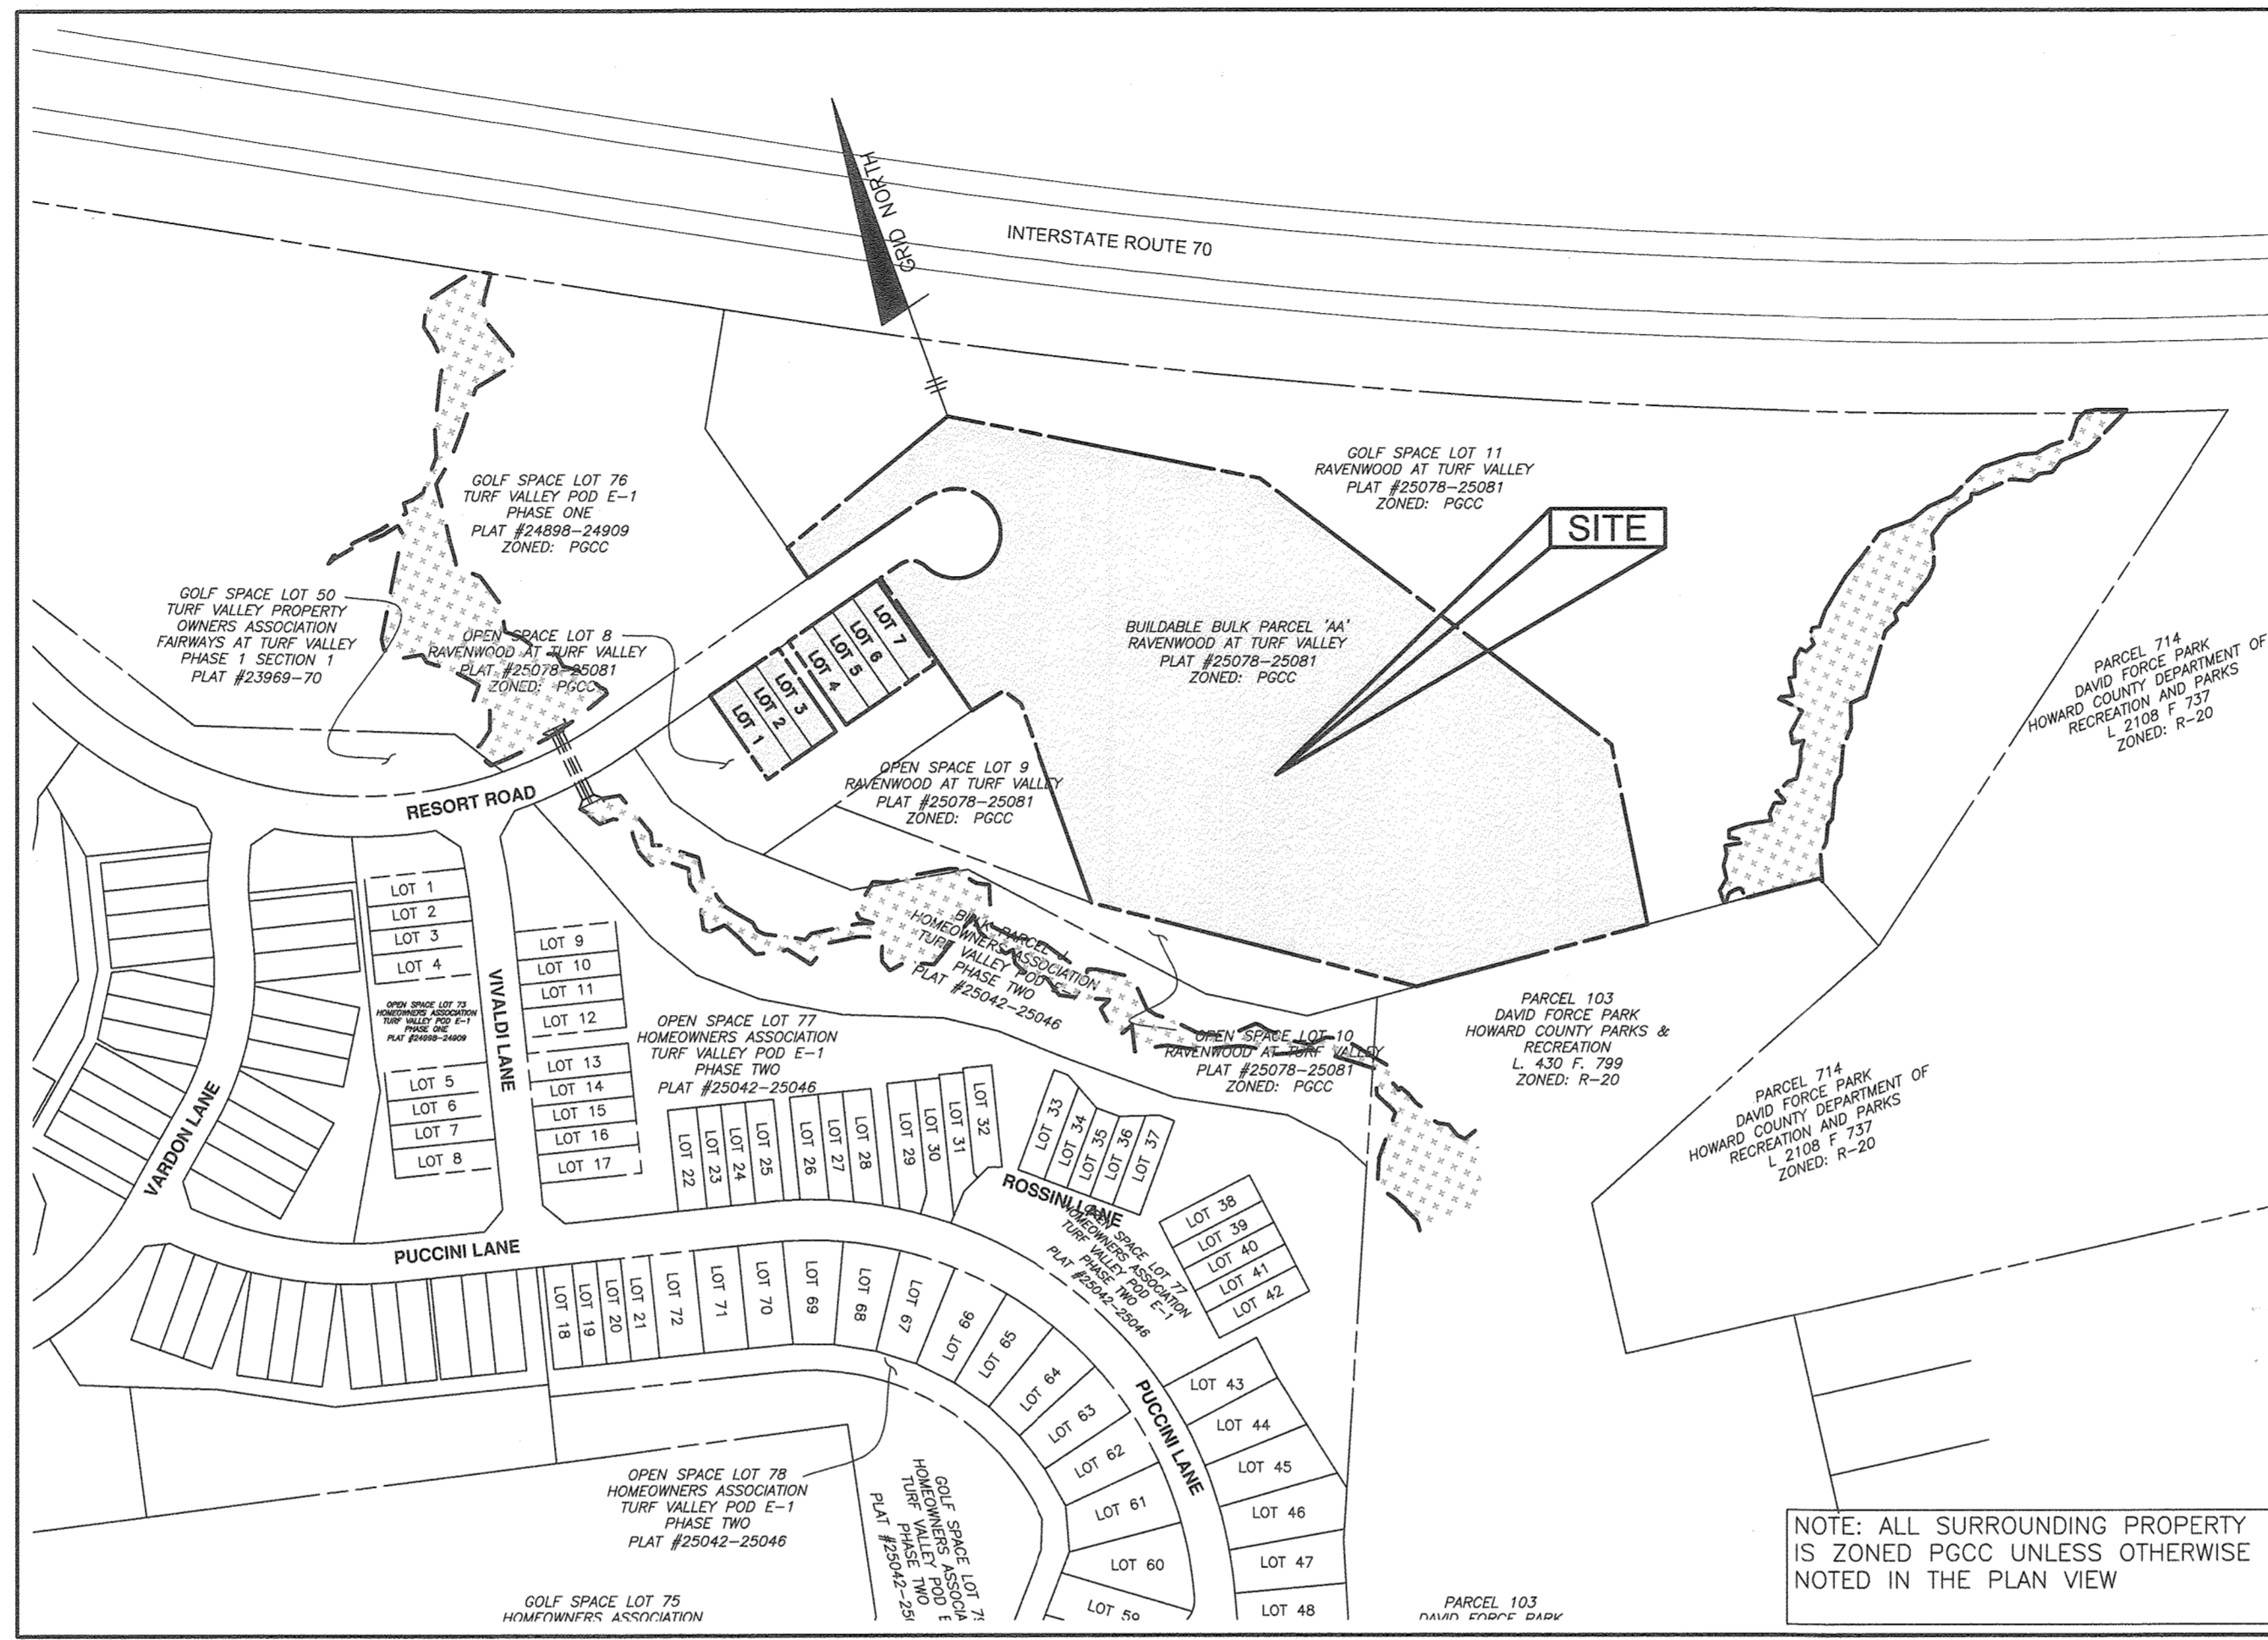

ADDRESS CHART table with columns: LOT, STREET ADDRESS, BUILDING, STREET ADDRESS. Lists addresses for lots 1 through 7.

CURVE TABLE table with columns: CURVE, RADIUS, ARC LENGTH, DELTA, TANGENT, CHORD DIRECTION, CHORD LENGTH. Lists curve data for C1, C2, and C3.

BOUNDARY COORDINATES table with columns: POINT #, NORTHING, EASTING. Lists coordinates for points 101 through 124.

SITE ANALYSIS DATA CHART table with columns: ITEM, VALUE. Lists project area, area of plan submission, limit of disturbed area, present zoning, proposed use of site, total number of units allowed, total number of units proposed, building coverage percentage, building square footage, and applicable DPZ file references.

Parking Chart table with columns: Item, Unit, Zoning Section, Requirement, Spaces Req., Spaces Prov. Lists parking requirements for SFA and APT units.

ADA Parking Chart table with columns: No. of spaces in facility, Minimum Requirement, ADA Spaces Provided, Van Accessible Provided. Lists ADA parking requirements.

Professional Certification. I hereby certify that these documents were prepared or approved by me, and that I am a duly licensed professional engineer under the laws of the State of Maryland. License No. 21443, Expiration Date: 12-21-24, AS-BUILT 5/26/24.


STORMWATER MANAGEMENT SUMMARY TABLE: LOTS 1-7. Table with columns: Lot, Street Address, Practice, ESDv Req., ESDv Prov., Ownership. Lists stormwater management practices for lots 1 through 7.

Note: Declaration of Covenants for these lots was previously recorded under F-18-027

STORMWATER MANAGEMENT SUMMARY TABLE: PARCEL 'AA'. Table with columns: Practice, DA (sf), Imp Area (sf), % Imp, Rv, Pe, Total ESDv Required, 75% ESDv ponding Required/Provided, 25% ESDv (cf) below Required/Provided, Total ESDv Provided, Pe Provided, Rev Req. (cf), Rev Prov. (cf), Ownership. Lists stormwater management data for parcel AA.

SHEET INDEX table with columns: SHEET, TITLE. Lists sheet numbers and titles for the site development plan.

PERMIT INFORMATION CHART table with columns: SUBDIVISION NAME, SECTION/AREA, LOT/PARCEL #, PLAT No., GRID No., ZONE, TAX MAP NO., ELECTION DISTRICT, CENSUS TRACT. Lists permit information for the project.

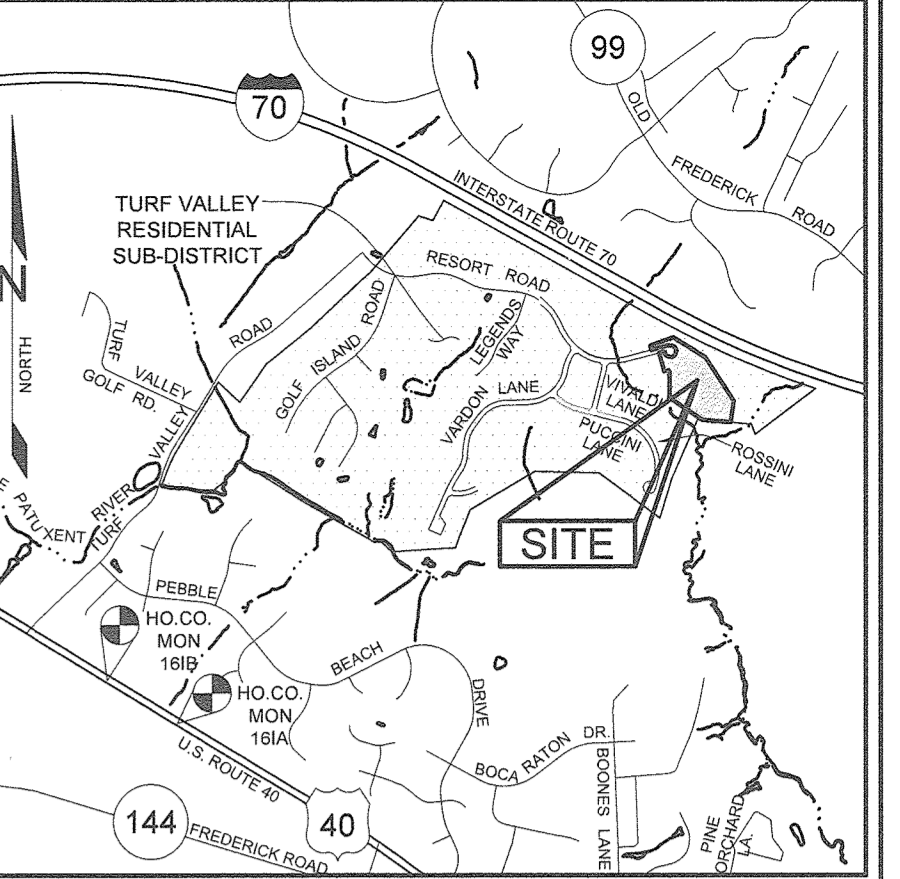


BENCHMARK NAD'83 HORIZONTAL HO. CO. #1618 11.5' SW OF WBL RTE 40 20.8' WEST OF PK NAIL IN SHOULDER 66.4' SOUTH OF LAST POST IN GUARDRAIL N 590475.2538' E 1344753.9350 ELEVATION: 469.892'

HO. CO. #1748 SE OF INTERSECTION OF RTE 99 AND WETHERBURN ROAD, 14.8' WEST OF FENCE POST, 35' NE OF MANHOLE N 598435.249' E 1348615.2482' ELEVATION: 508.469'


APPROVED: DEPARTMENT OF PLANNING AND ZONING. Signature of Chief, Development Engineering Division, dated 10-5-20. Signature of Chief, Division of Land Development, dated 10/28/20. Signature of Director, dated 10/29/20.

APPROVED PLANNING BOARD OF HOWARD COUNTY. DATE: AUGUST 20, 2020.

Project information block including OWNER (MANGIONE ENTERPRISES OF TURF VALLEY), BUILDER (NV HOMES), SITE DEVELOPMENT PLAN COVER SHEET, DATE (AUGUST 27, 2020), and AS-BUILT SDP-20-036.

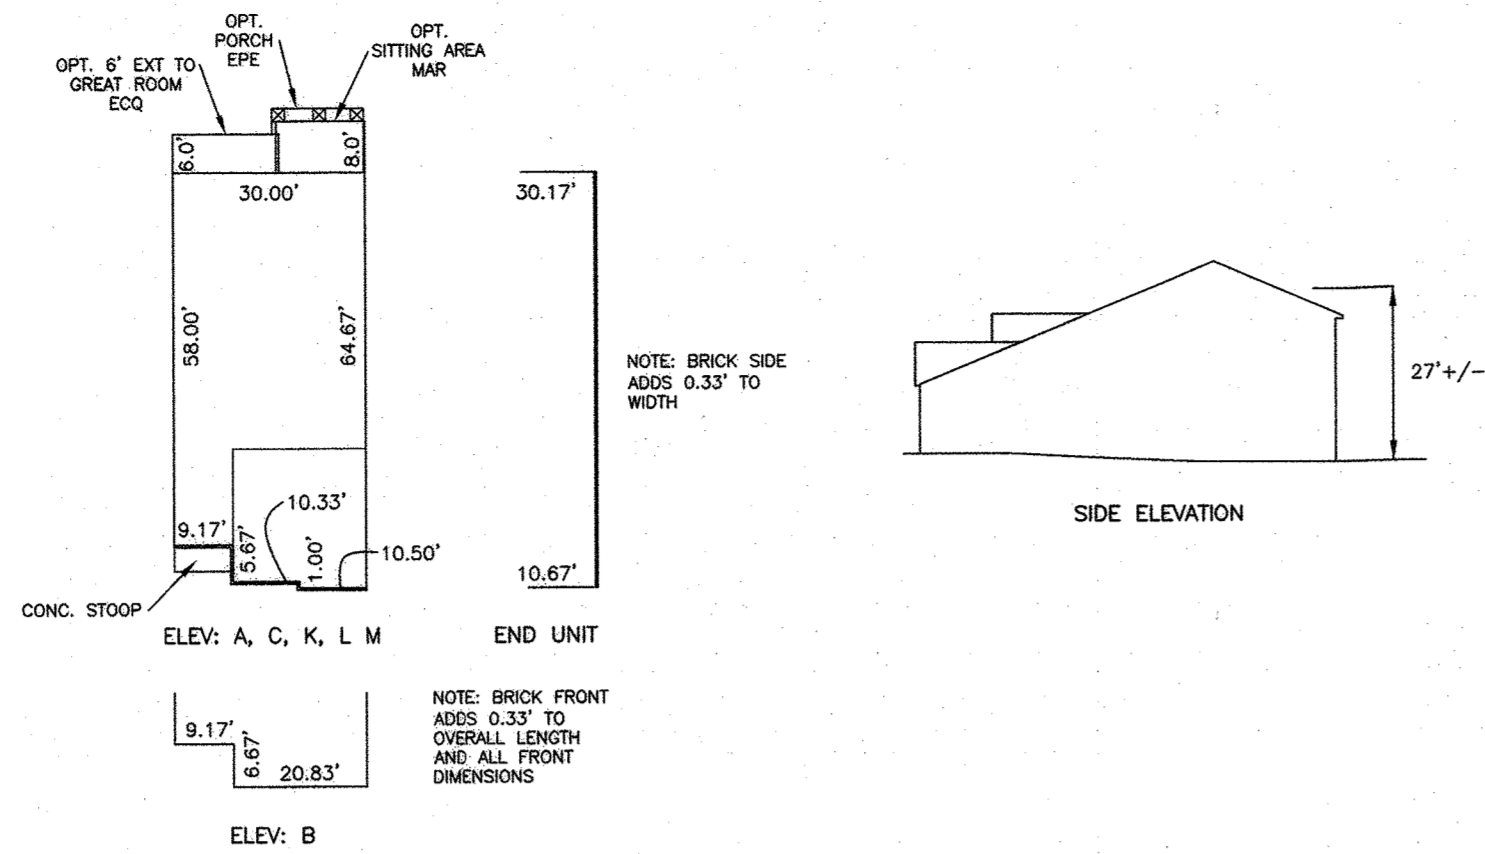

MONOCACY (TOWNHOUSE)

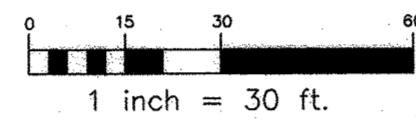

BULK REGULATIONS:
(per 2nd AMENDMENT TO THE TURF VALLEY, RESIDENTIAL SUBDISTRICT, FDP, RECORDED AS PLAT NO. 20286-87)

- PERMITTED USES: ALL USES AS PER ABOVE MENTIONED FDP
PROPOSED USE: SINGLE-FAMILY ATTACHED (SFA) AND MULTI-FAMILY CONDOMINIUM
- HEIGHT
- PRINCIPAL STRUCTURES:
 - SINGLE FAMILY ATTACHED AND DETACHED: 34 FEET
 - APARTMENT BUILDINGS: 40 FEET
 - OTHER: 34 FEET
 - ACCESSORY STRUCTURES: 15 FEET
- EXCEPT SPIRES, BELFRIES, CHIMNEYS, FLAG POLES, MONUMENTS, STACKS, STEEPLES, RADIO AND TELEVISION ANTENNAE, OBSERVATION TOWERS, WINDMILLS, BARNES, WATER AND GRAIN STORAGE FACILITIES, SILOS, OUTDOOR ATHLETIC STRUCTURES, LINES AND POLES OR OTHER SUPPORTING STRUCTURES FOR ELECTRIC, TELEPHONE, TELEGRAPH OR CATV TRANSMISSION OR DISTRIBUTION NO LIMIT
- LOT COVERAGE FOR STRUCTURES WITHIN SINGLE FAMILY ATTACHED PROJECTS DEVELOPED WITH ONE UNIT PER LOT: 60 PERCENT
- DENSITY: 1.75 DWELLING UNITS PER GROSS ACRE
- MAXIMUM UNITS PER STRUCTURE: 8 UNITS PER STRUCTURE
- BUILDING LENGTH - RESIDENTIAL STRUCTURE: 120 FEET
HOWEVER, THE PLANNING BOARD MAY APPROVE A GREATER LENGTH, UP TO A MAXIMUM OF 300 FEET, BASED ON A DETERMINATION THAT THE DESIGN OF THE BUILDING WILL MITIGATE THE VISUAL IMPACT OF THE INCREASED LENGTH.
- MINIMUM LOT SIZE REQUIREMENTS
- SINGLE FAMILY DETACHED DWELLINGS: 8,000 SF
 - EXCEPT ZERO LOT LINE DWELLINGS: 4,000 SF
 - SINGLE FAMILY SEMI-DETACHED DWELLINGS: 4,000 SF
- MINIMUM LOT WIDTH AT BUILDING RESTRICTION LINE
- SINGLE FAMILY DETACHED DWELLINGS: 50 FEET
 - EXCEPT ZERO LOT LINE DWELLINGS: 40 FEET
 - SINGLE FAMILY SEMI-DETACHED DWELLINGS: 40 FEET
- MINIMUM SETBACK REQUIREMENTS: EXCEPT THAT STRUCTURES MAY BE CONSTRUCTED AT ANY LOCATION WITHIN SUCH SETBACK IF SUCH CONSTRUCTION IS IN ACCORDANCE WITH A SITE DEVELOPMENT PLAN APPROVED BY THE PLANNING BOARD.
- FROM ARTERIAL ROADS
- RESIDENTIAL STRUCTURES (ALL): 50 FEET
 - NON-RESIDENTIAL STRUCTURES: 30 FEET
 - ACCESSORY USES: 30 FEET
- FROM COLLECTOR ROADS AND LOCAL STREETS
- RESIDENTIAL STRUCTURES (ALL): 20 FEET
 - NON-RESIDENTIAL STRUCTURES: 10 FEET
 - ACCESSORY USES: 10 FEET
- FROM NON-PGCC ADJACENT PROPERTIES
- RESIDENTIAL STRUCTURES (ALL): 30 FEET
 - NON-RESIDENTIAL STRUCTURES: 20 FEET
 - ACCESSORY USES: 10 FEET
- FROM NON-RESIDENTIAL DISTRICTS
- RESIDENTIAL STRUCTURES (ALL): 30 FEET
 - NON-RESIDENTIAL STRUCTURES: 20 FEET
 - ACCESSORY USES: 10 FEET
- FROM LOT LINES - STRUCTURE AND USES IN ALL DEVELOPMENT PROJECTS EXCEPT SINGLE-FAMILY ATTACHED:
- PRINCIPAL STRUCTURES - RESIDENTIAL: 7.5 FEET
 - EXCEPT ZERO LOT LINE DWELLINGS: 0 FEET
 - REAR: 25 FEET
 - DETACHED ACCESSORY GARAGES OR SHEDS - RESIDENTIAL: 0 FEET
 - SIDE: 0 FEET
 - REAR: 0 FEET
 - OTHER ACCESSORY STRUCTURES TO RESIDENTIAL USES: 7.5 FEET
 - SIDE: 0 FEET
 - REAR: 0 FEET
- MINIMUM DISTANCES BETWEEN ATTACHED DWELLING UNITS AND APARTMENT BUILDINGS, PROVIDED IMPROVEMENTS THEREON ARE CONSTRUCTED IN ACCORDANCE WITH A SITE DEVELOPMENT PLAN APPROVED BY THE HOWARD COUNTY PLANNING BOARD:
- FACE TO FACE: 30 FEET
 - FACE TO SIDE / REAR TO SIDE: 30 FEET
 - SIDE TO SIDE: 15 FEET
 - REAR TO REAR: 60 FEET
 - REAR TO FACE: 100 FEET


APPROVED
PLANNING BOARD OF HOWARD COUNTY
DATE: AUGUST 20, 2020

APPROVED: DEPARTMENT OF PLANNING AND ZONING

10-9-20
DATE

10/21/20
DATE

10/29/20
DATE

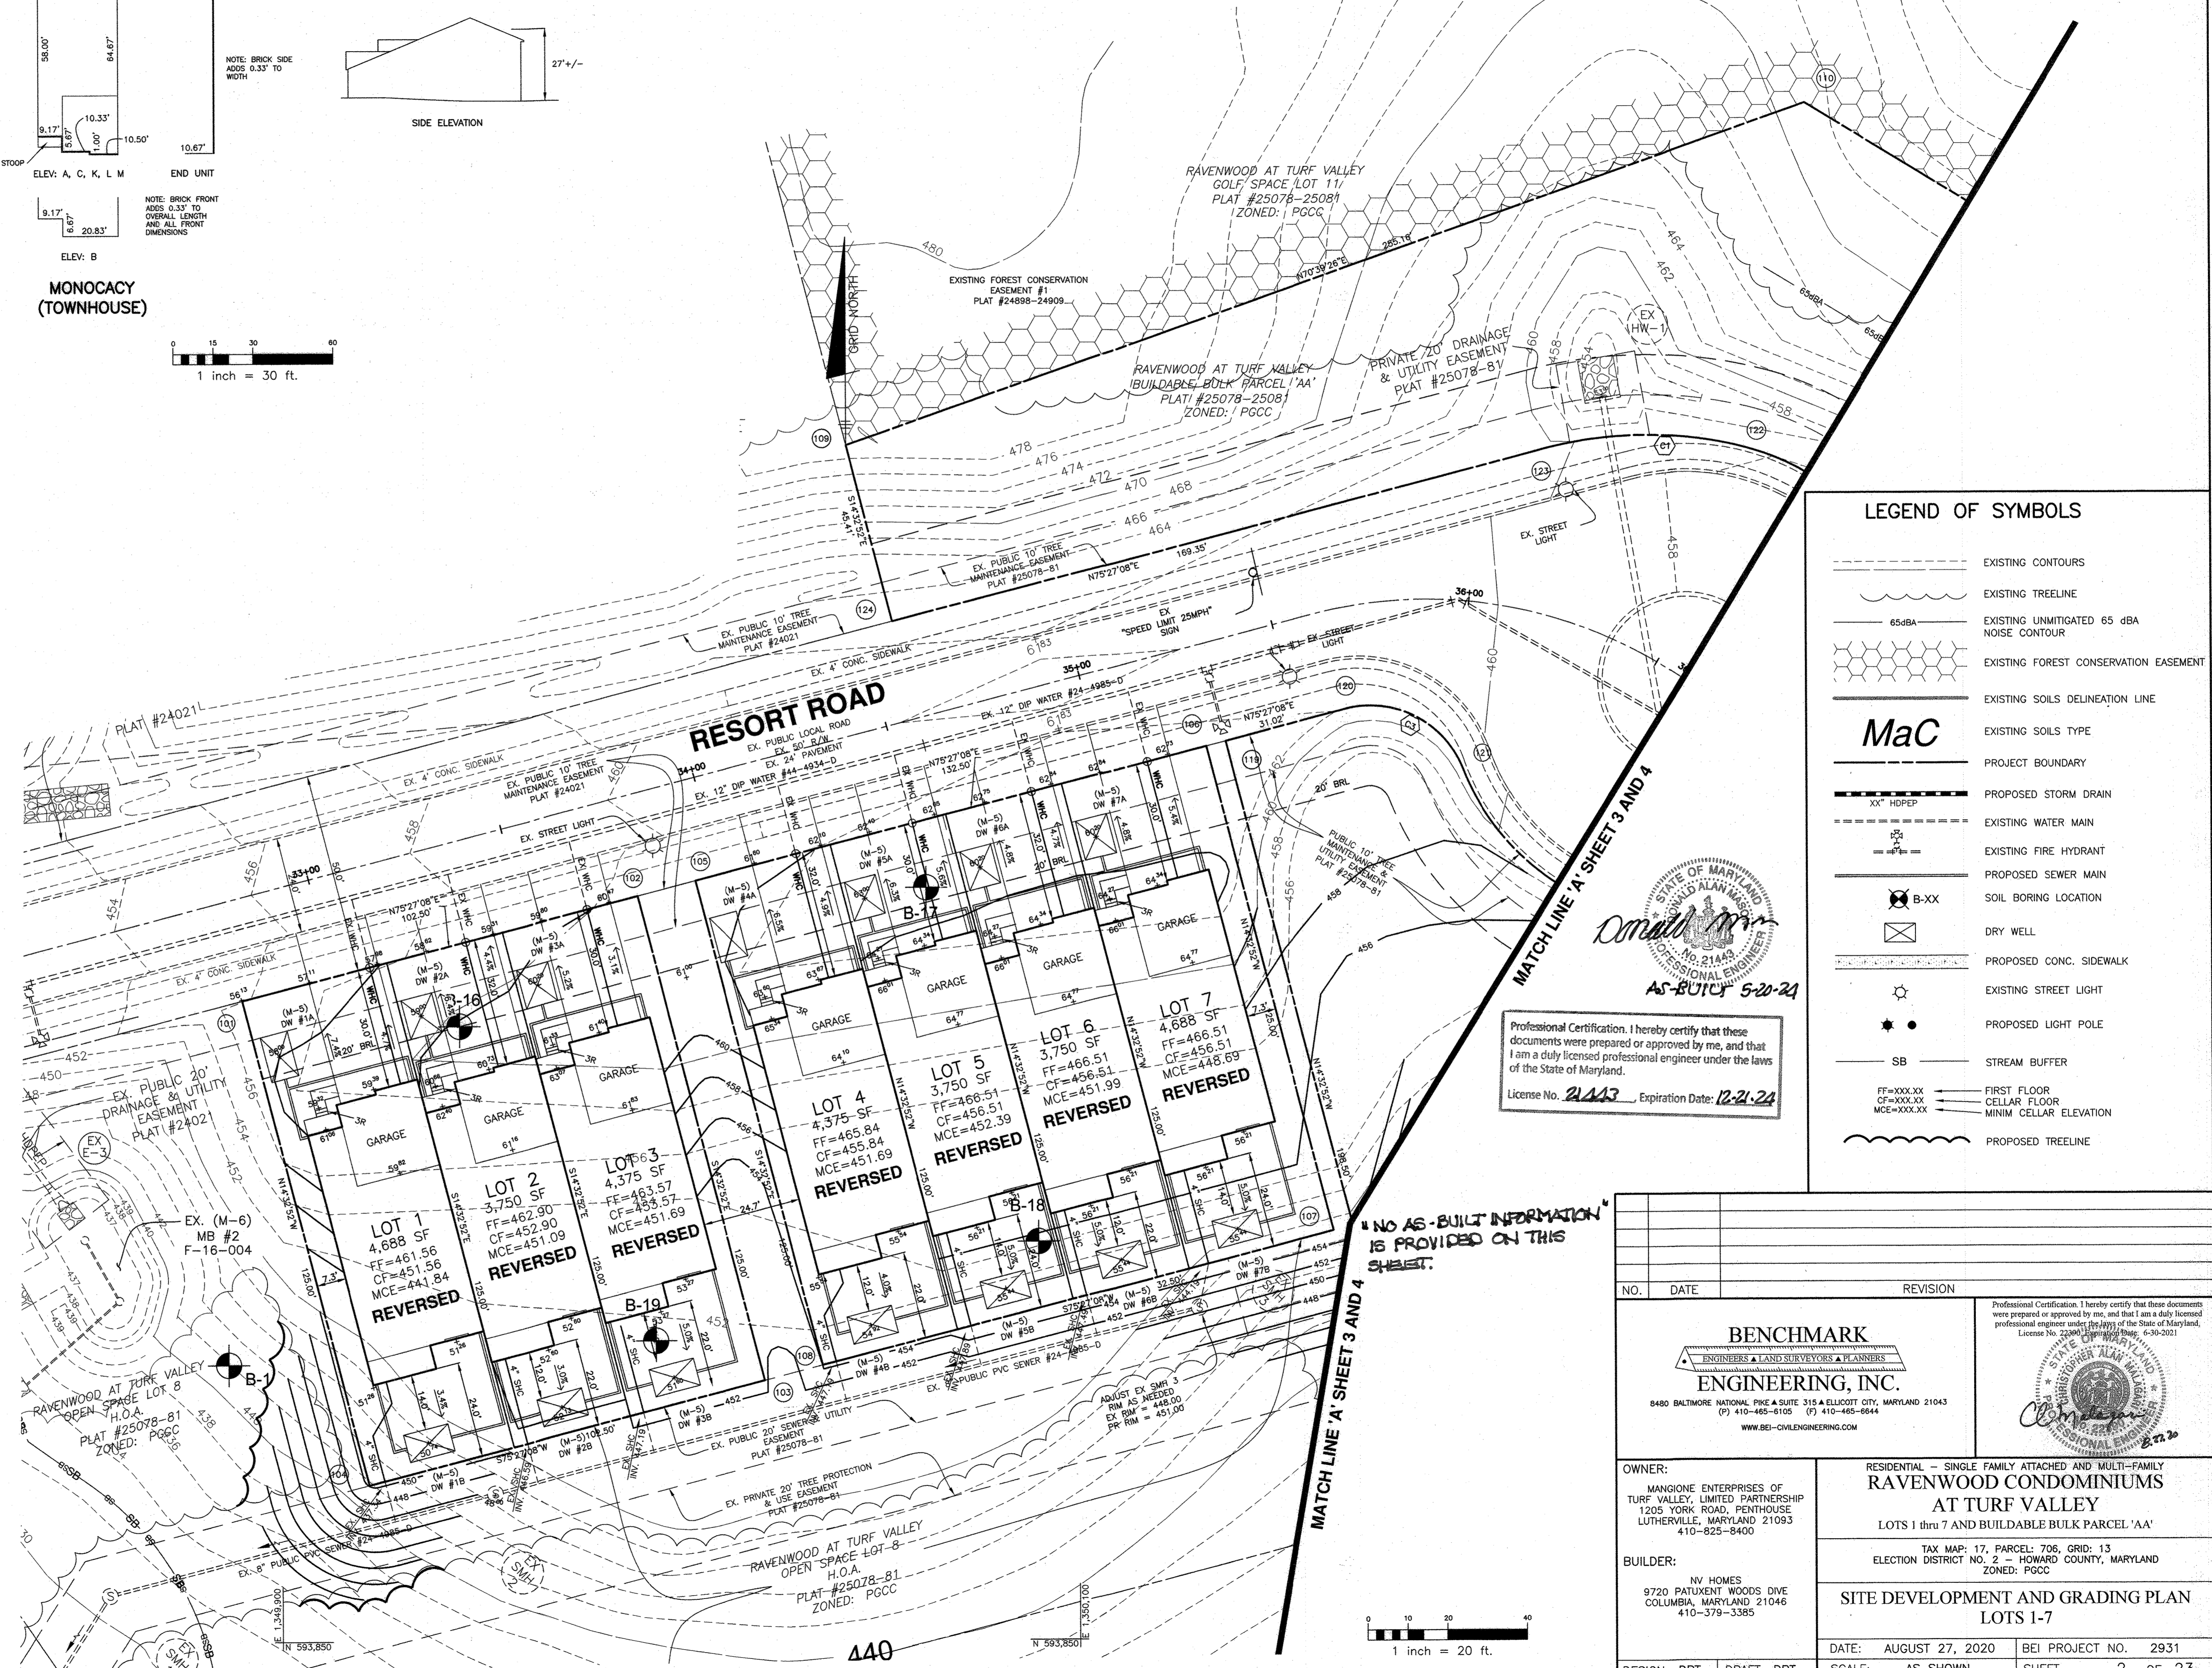

LEGEND OF SYMBOLS

- EXISTING CONTOURS
- EXISTING TREELINE
- EXISTING UNMITIGATED 65 dBA NOISE CONTOUR
- EXISTING FOREST CONSERVATION EASEMENT
- EXISTING SOILS DELINEATION LINE
- EXISTING SOILS TYPE
- PROJECT BOUNDARY
- PROPOSED STORM DRAIN
- EXISTING WATER MAIN
- EXISTING FIRE HYDRANT
- PROPOSED SEWER MAIN
- SOIL BORING LOCATION
- DRY WELL
- PROPOSED CONC. SIDEWALK
- EXISTING STREET LIGHT
- PROPOSED LIGHT POLE
- STREAM BUFFER
- FIRST FLOOR
- CELLAR FLOOR
- MINIM CELLAR ELEVATION
- PROPOSED TREELINE

Professional Certification. I hereby certify that these documents were prepared or approved by me, and that I am a duly licensed professional engineer under the laws of the State of Maryland.
License No. 21443 Expiration Date: 12-21-24



NO AS-BUILT INFORMATION IS PROVIDED ON THIS SHEET.

NO.	DATE	REVISION

BENCHMARK ENGINEERING, INC.
ENGINEERS & LAND SURVEYORS & PLANNERS
8480 BALTIMORE NATIONAL PIKE & SUITE 315 A ELLICOTT CITY, MARYLAND 21043
(P) 410-465-6105 (F) 410-465-6644
WWW.BEI-CIVILENGINEERING.COM

Professional Certification. I hereby certify that these documents were prepared or approved by me, and that I am a duly licensed professional engineer under the laws of the State of Maryland.
License No. 22960 Expiration Date: 6-30-2021

OWNER:
MANGIONE ENTERPRISES OF TURF VALLEY, LIMITED PARTNERSHIP
1205 YORK ROAD, PENTHOUSE LUTHERVILLE, MARYLAND 21093
410-825-8400

BUILDER:
NV HOMES
9720 PATUXENT WOODS DIVE
COLUMBIA, MARYLAND 21046
410-379-3385


RESIDENTIAL - SINGLE FAMILY ATTACHED AND MULTI-FAMILY
RAVENWOOD CONDOMINIUMS AT TURF VALLEY
LOTS 1 thru 7 AND BUILDABLE BULK PARCEL 'AA'

TAX MAP: 17, PARCEL: 706, GRID: 13
ELECTION DISTRICT NO. 2 - HOWARD COUNTY, MARYLAND
ZONED: PGCC

SITE DEVELOPMENT AND GRADING PLAN
LOTS 1-7

DATE: AUGUST 27, 2020 BEI PROJECT NO. 2931
SCALE: AS SHOWN SHEET 2 OF 23

- NOTES:
1. ALL CURB FILLET RADII IS 3'-0" UNLESS SPECIFIED OTHERWISE ON THIS PLAN SHEET.
 2. ALL CURB IS TO BE STD. 7" CURB AND GUTTER (HOCOSTD R-3.01) EXCEPT FOR THE CURB IN FRONT OF THE ADA PARKING SPACES AND ACCESS AISLES WHICH IS A FLUSH CURB (HOCOSTD R-3.07).
 3. ALL PAVEMENT WITHIN THE PARKING SPACES AND DRIVE AISLES IS TO BE P-2 PAVING (HOCOSTD R-2.01). THICKNESS TO BE BASED ON CBR RESULTS.
 4. ALL PLAN DIMENSIONS ON THIS SHEET ARE TO FACE OF CURB UNLESS OTHERWISE SPECIFIED.
 5. ALL STANDARD PARKING SPACES ARE TO BE 9' x 18'.

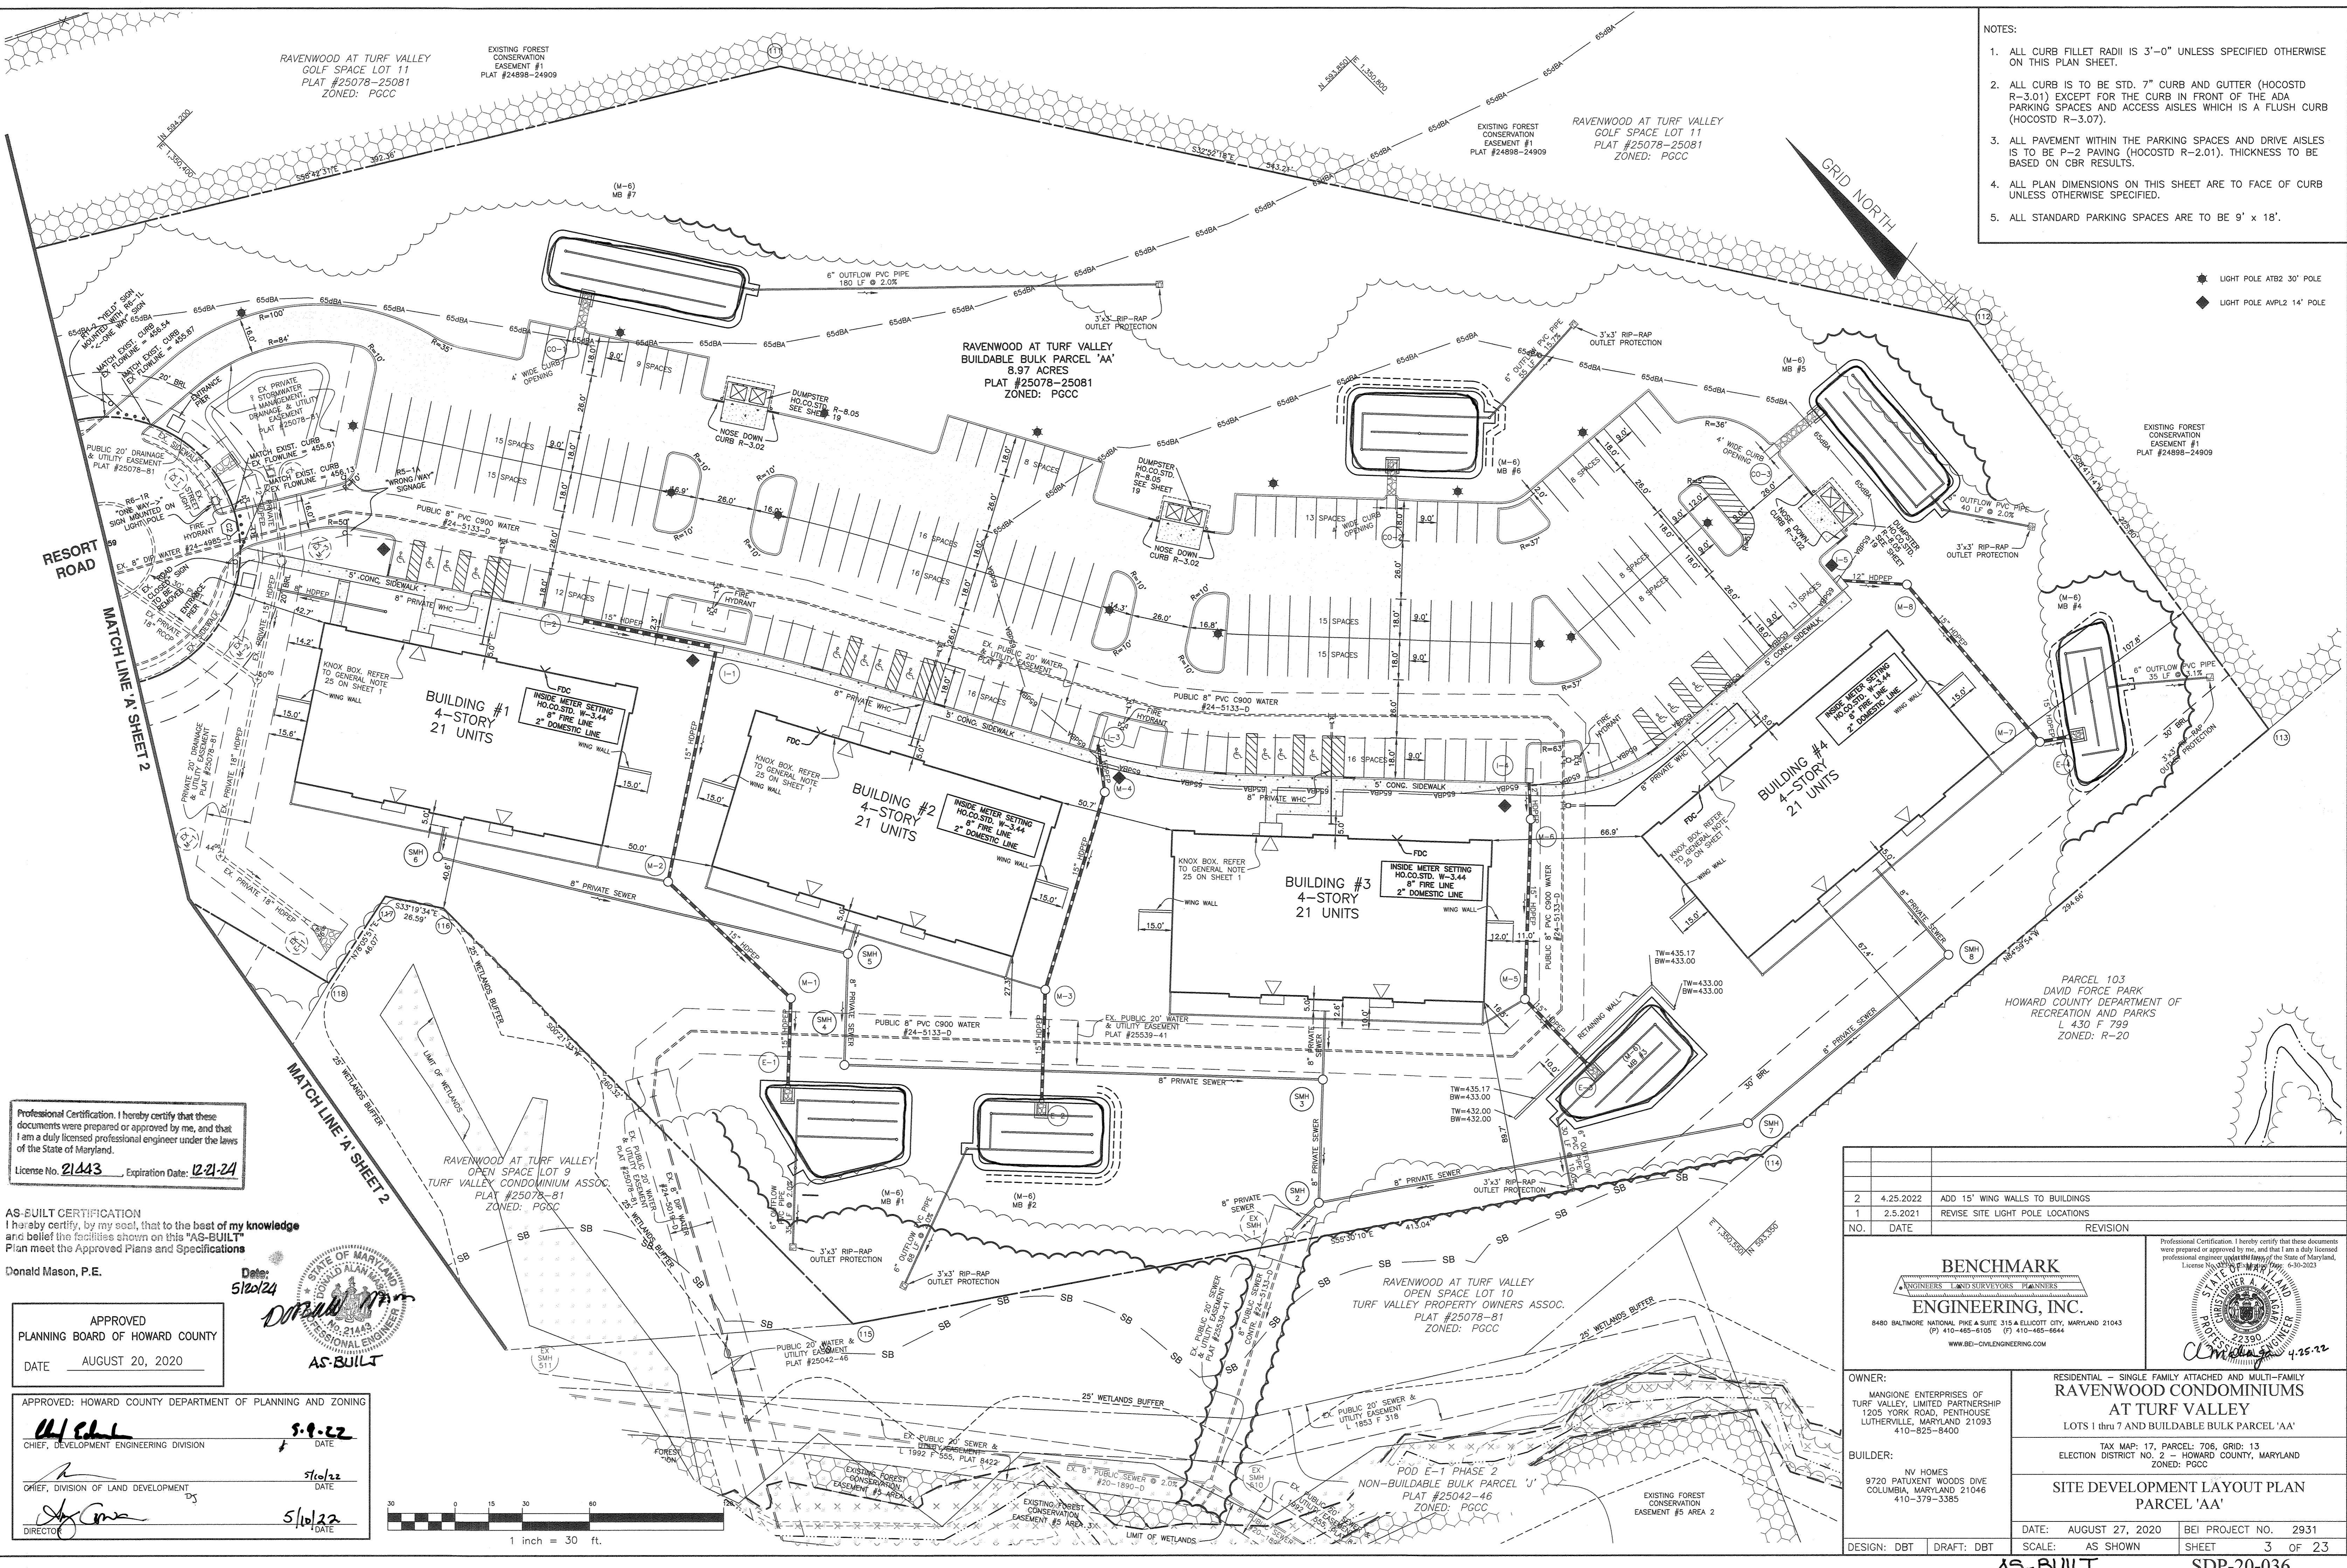


Professional Certification. I hereby certify that these documents were prepared or approved by me, and that I am a duly licensed professional engineer under the laws of the State of Maryland.
 License No. **21443**, Expiration Date: **12-21-24**

AS-BUILT CERTIFICATION
 I hereby certify, by my seal, that to the best of my knowledge and belief the facilities shown on this "AS-BUILT" Plan meet the Approved Plans and Specifications

APPROVED
 PLANNING BOARD OF HOWARD COUNTY
 DATE AUGUST 20, 2020

APPROVED: HOWARD COUNTY DEPARTMENT OF PLANNING AND ZONING
 CHIEF, DEVELOPMENT ENGINEERING DIVISION
 CHIEF, DIVISION OF LAND DEVELOPMENT
 DIRECTOR

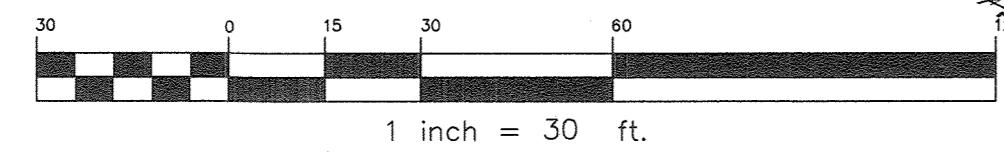

NO.	DATE	REVISION
2	4.25.2022	ADD 15' WING WALLS TO BUILDINGS
1	2.5.2021	REVISE SITE LIGHT POLE LOCATIONS

BENCHMARK ENGINEERING, INC.
 ENGINEERS LAND SURVEYORS PLANNERS
 8480 BALTIMORE NATIONAL PIKE SUITE 315 & ELLICOTT CITY, MARYLAND 21043
 (P) 410-465-6105 (F) 410-465-6644
 WWW.BEI-CIVLENGINEERING.COM

OWNER: MANGIONE ENTERPRISES OF TURF VALLEY, LIMITED PARTNERSHIP
 1205 YORK ROAD, PENTHOUSE LUTHERVILLE, MARYLAND 21093
 410-825-8400

BUILDER: NV HOMES
 9720 PATUXENT WOODS DIVE COLUMBIA, MARYLAND 21046
 410-379-3385


RESIDENTIAL - SINGLE FAMILY ATTACHED AND MULTI-FAMILY
RAVENWOOD CONDOMINIUMS AT TURF VALLEY
 LOTS 1 thru 7 AND BUILDABLE BULK PARCEL 'AA'

TAX MAP: 17, PARCEL: 706, GRID: 13
 ELECTION DISTRICT NO. 2 - HOWARD COUNTY, MARYLAND
 ZONED: PGCC

SITE DEVELOPMENT LAYOUT PLAN PARCEL 'AA'

DATE: AUGUST 27, 2020 BEI PROJECT NO. 2931
 DESIGN: DBT DRAFT: DBT SCALE: AS SHOWN SHEET 3 OF 23

NOTES:
 1. ALL SPOT GRADES WITHIN THE PARKING AREA ARE TOP OF PAVEMENT OR FLOWLINE.

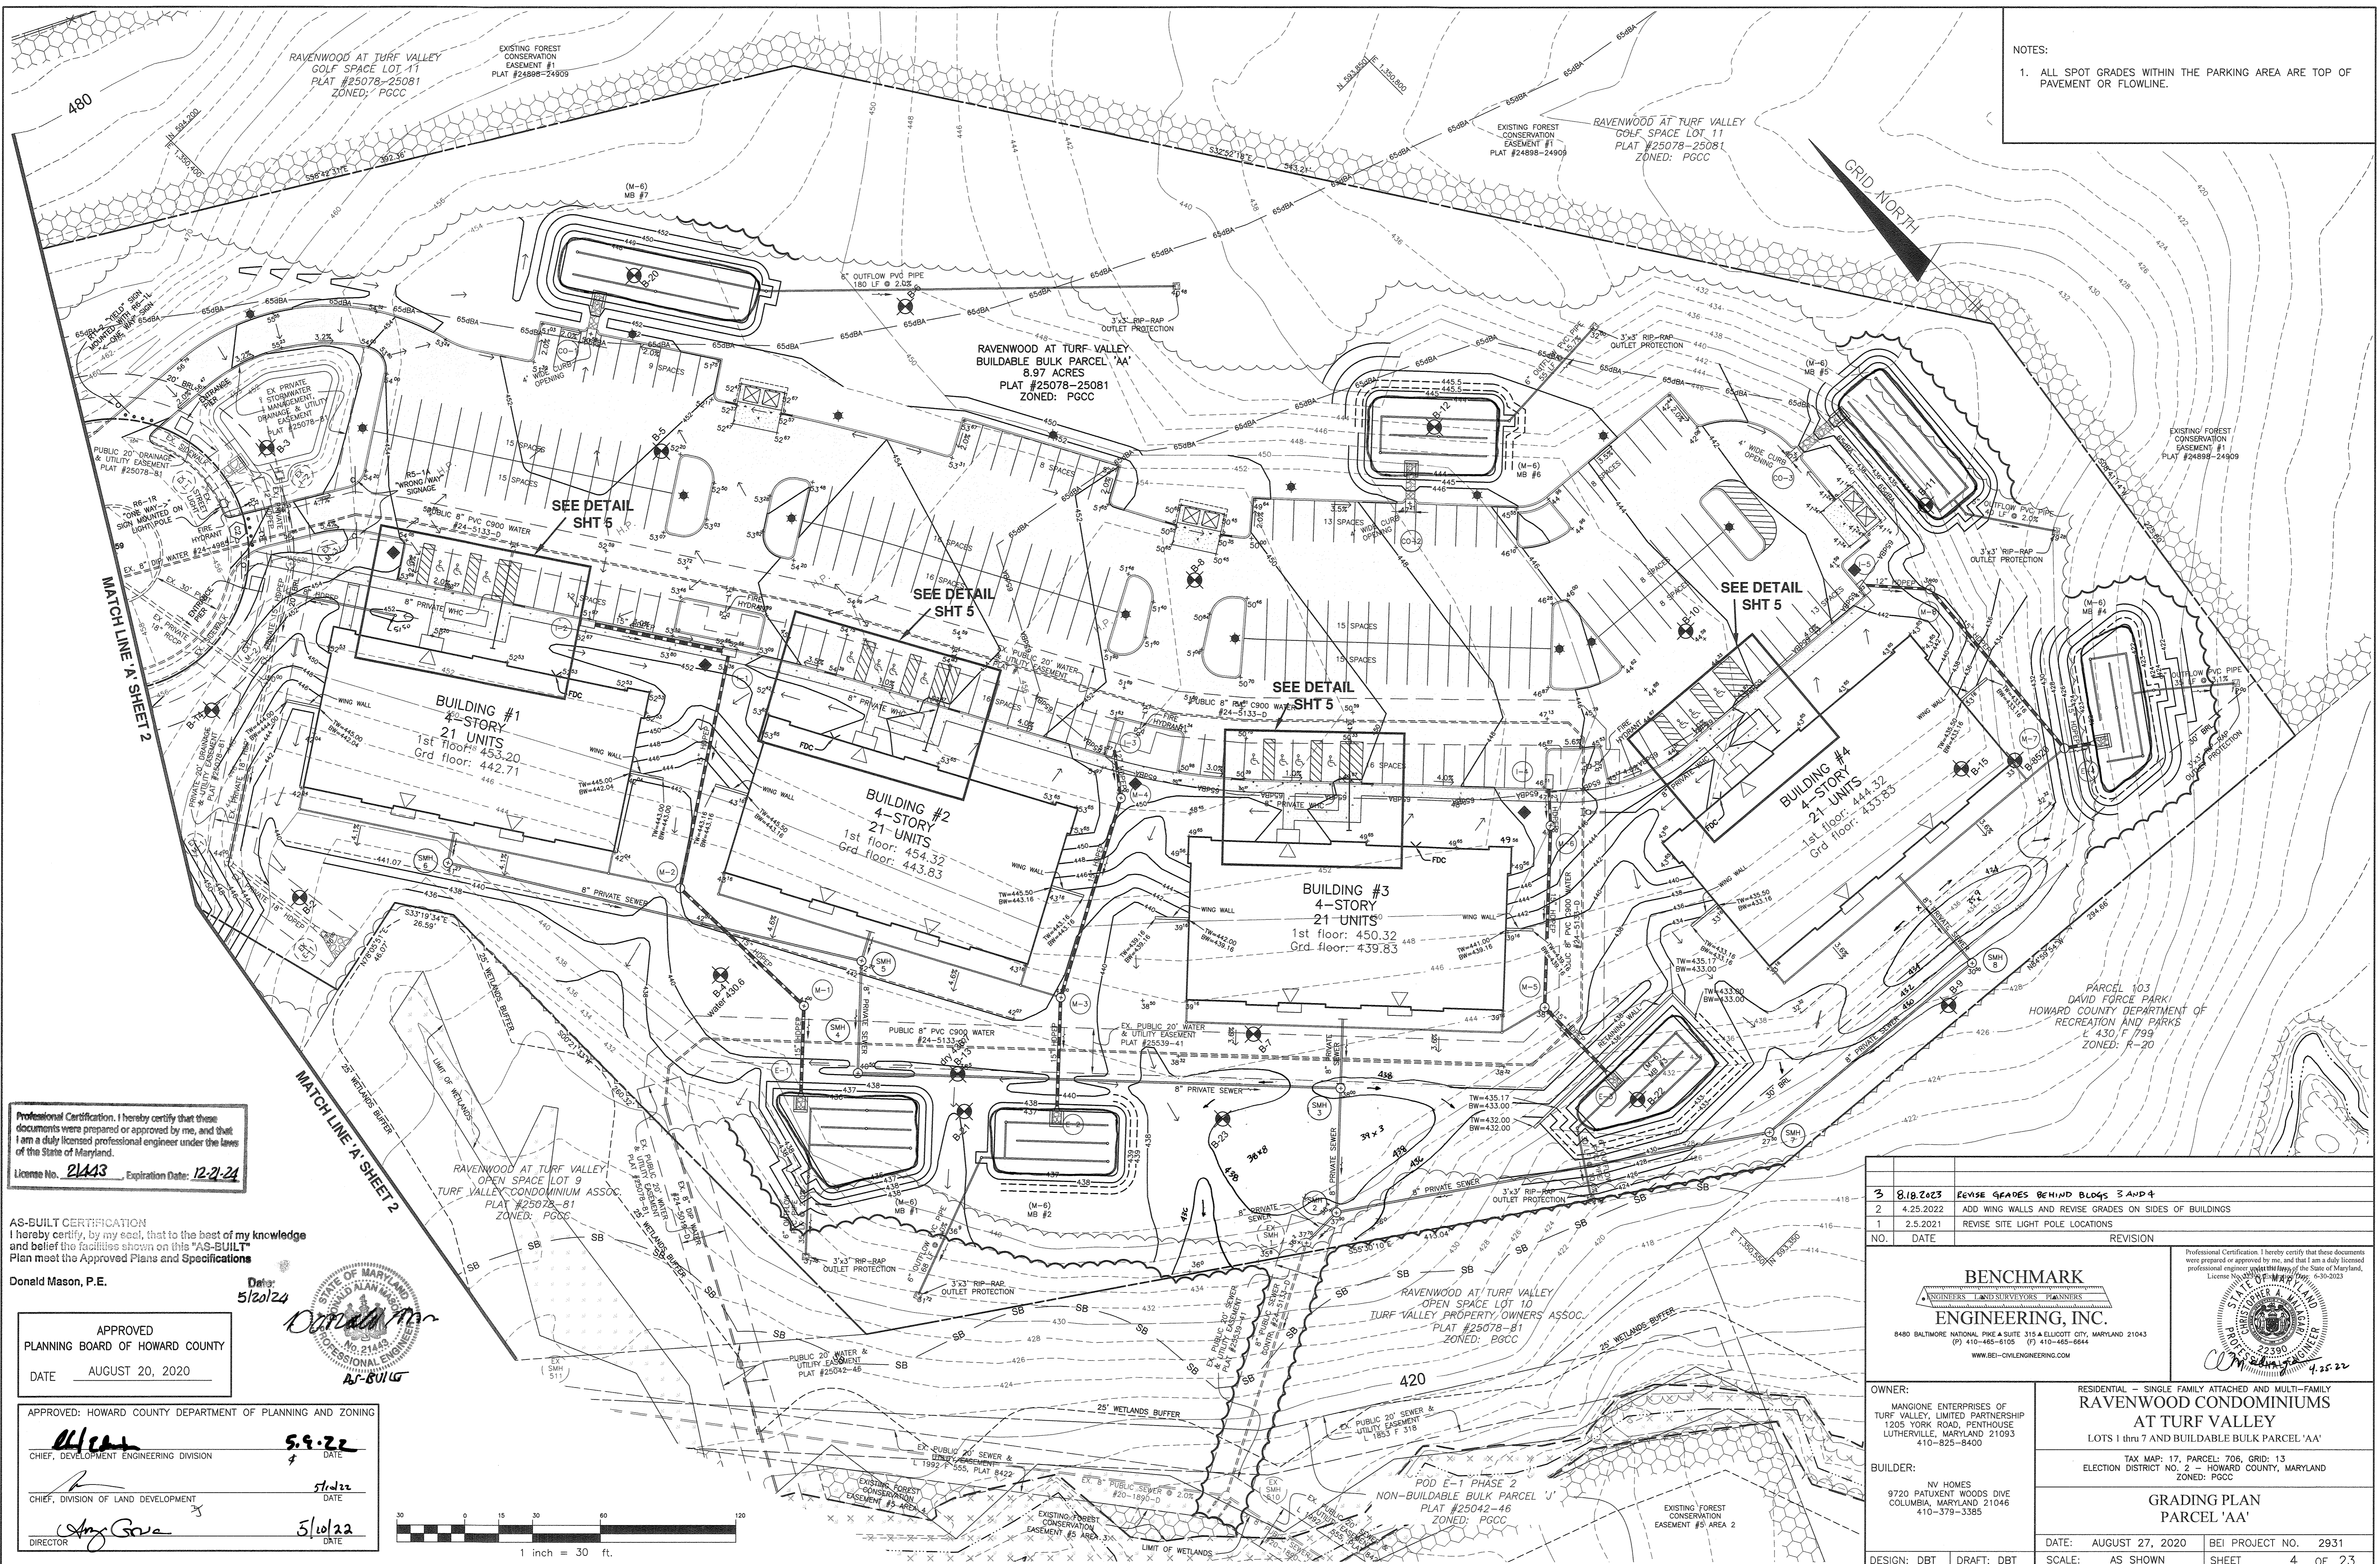


Professional Certification. I hereby certify that these documents were prepared or approved by me, and that I am a duly licensed professional engineer under the laws of the State of Maryland.
 License No. **21443** Expiration Date: **12-21-24**

AS-BUILT CERTIFICATION
 I hereby certify, by my seal, that to the best of my knowledge and belief the facilities shown on this "AS-BUILT" Plan meet the Approved Plans and Specifications

Donald Mason, P.E.
 Date: **5/20/24**
 APPROVED
 PLANNING BOARD OF HOWARD COUNTY
 DATE **AUGUST 20, 2020**

APPROVED: HOWARD COUNTY DEPARTMENT OF PLANNING AND ZONING
 Chief, Development Engineering Division: **5.9.22**
 Chief, Division of Land Development: **5/10/22**
 Director: **5/10/22**

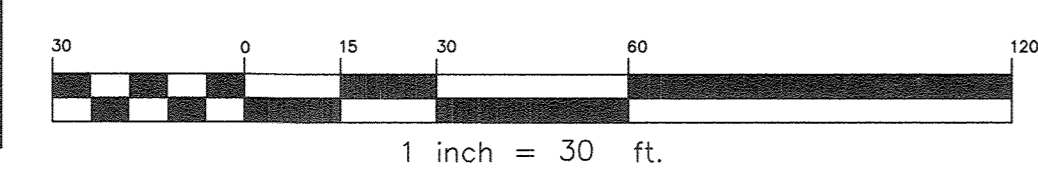


NO.	DATE	REVISION
3	8.18.2023	REVISE GRADES BEHIND BLDGS 3 AND 4
2	4.25.2022	ADD WING WALLS AND REVISE GRADES ON SIDES OF BUILDINGS
1	2.5.2021	REVISE SITE LIGHT POLE LOCATIONS



BENCHMARK ENGINEERING, INC.
 ENGINEERS LAND SURVEYORS PLANNERS
 8490 BALTIMORE NATIONAL PIKE & SUITE 315 & ELLIOTT CITY, MARYLAND 21043
 (P) 410-465-6105 (F) 410-465-6644
 WWW.BEI-CIVILENGINEERING.COM

OWNER: MANGIONE ENTERPRISES OF TURF VALLEY, LIMITED PARTNERSHIP 1205 YORK ROAD, PENTHOUSE LUTHERVILLE, MARYLAND 21093 410-825-8400	RESIDENTIAL - SINGLE FAMILY ATTACHED AND MULTI-FAMILY RAVENWOOD CONDOMINIUMS AT TURF VALLEY LOTS 1 thru 7 AND BUILDABLE BULK PARCEL 'AA'
BUILDER: NV HOMES 9720 PATUXENT WOODS DIVE COLUMBIA, MARYLAND 21046 410-379-3385	TAX MAP: 17, PARCEL: 706, GRID: 13 ELECTION DISTRICT NO. 2 - HOWARD COUNTY, MARYLAND ZONED: PGCC
DESIGN: DBT DRAFT: DBT	GRADING PLAN PARCEL 'AA'
DATE: AUGUST 27, 2020	BEI PROJECT NO. 2931
SCALE: AS SHOWN	SHEET 4 OF 23



MATCH LINE SEE THIS SHEET

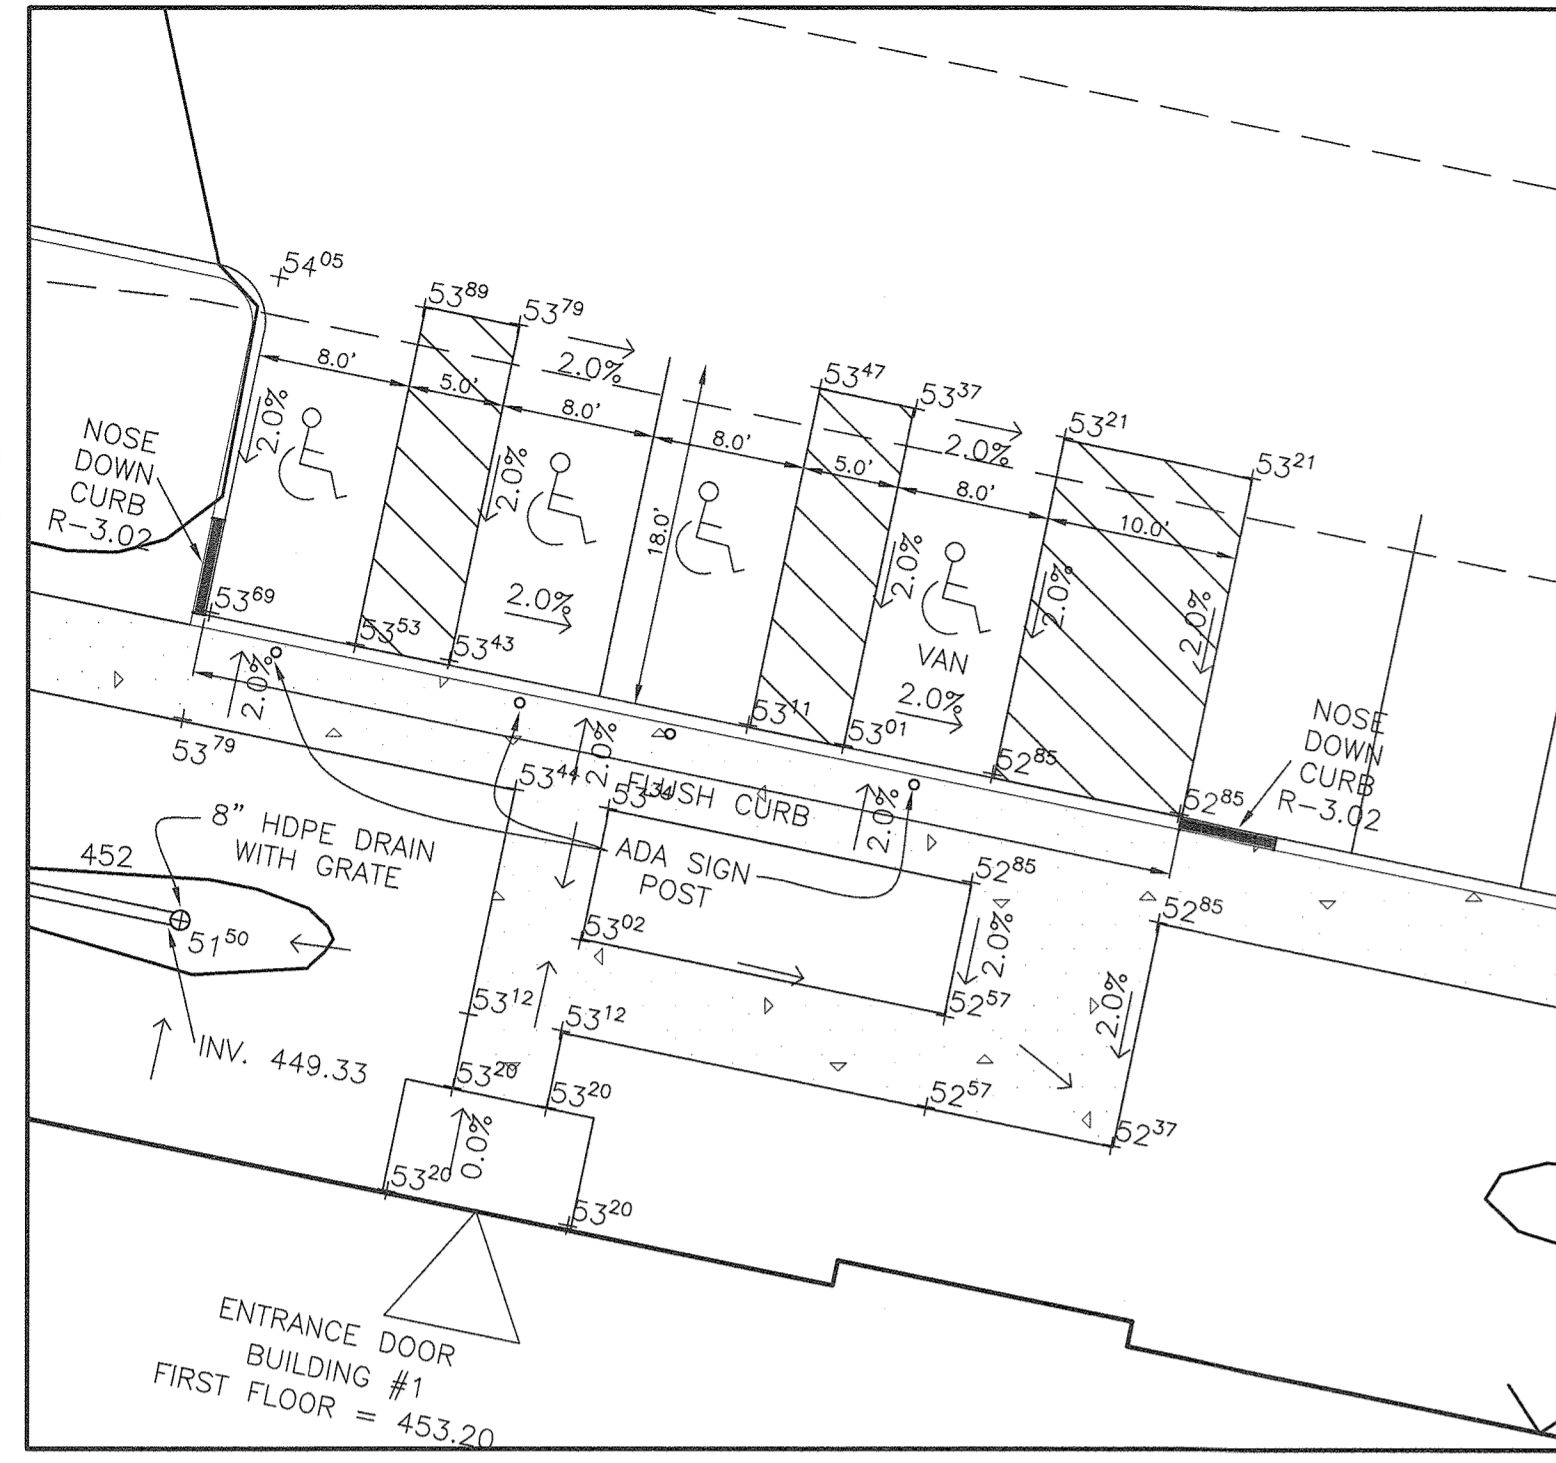



BUILDING 1

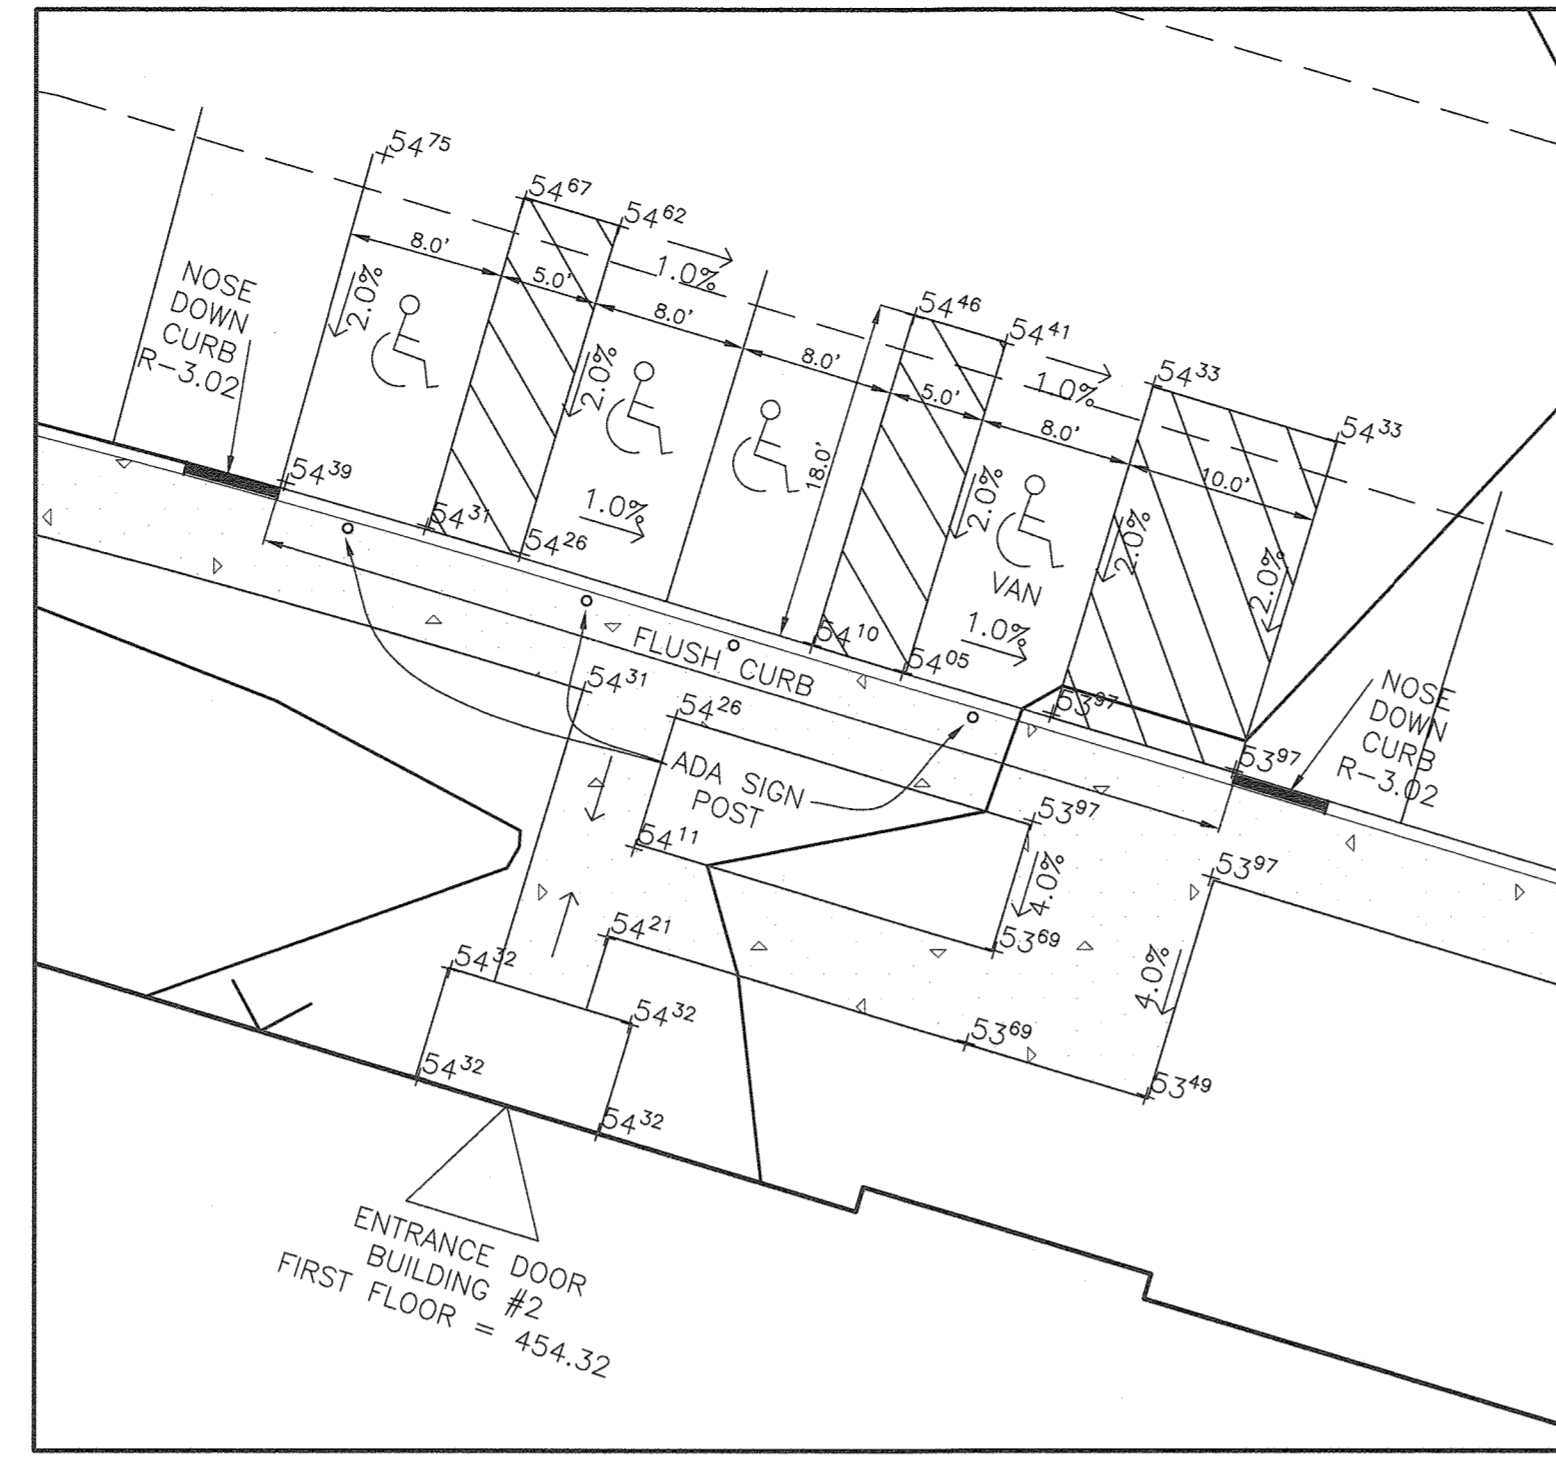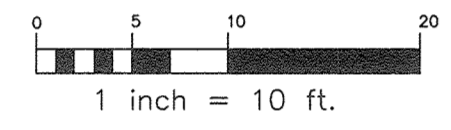



BUILDING 2

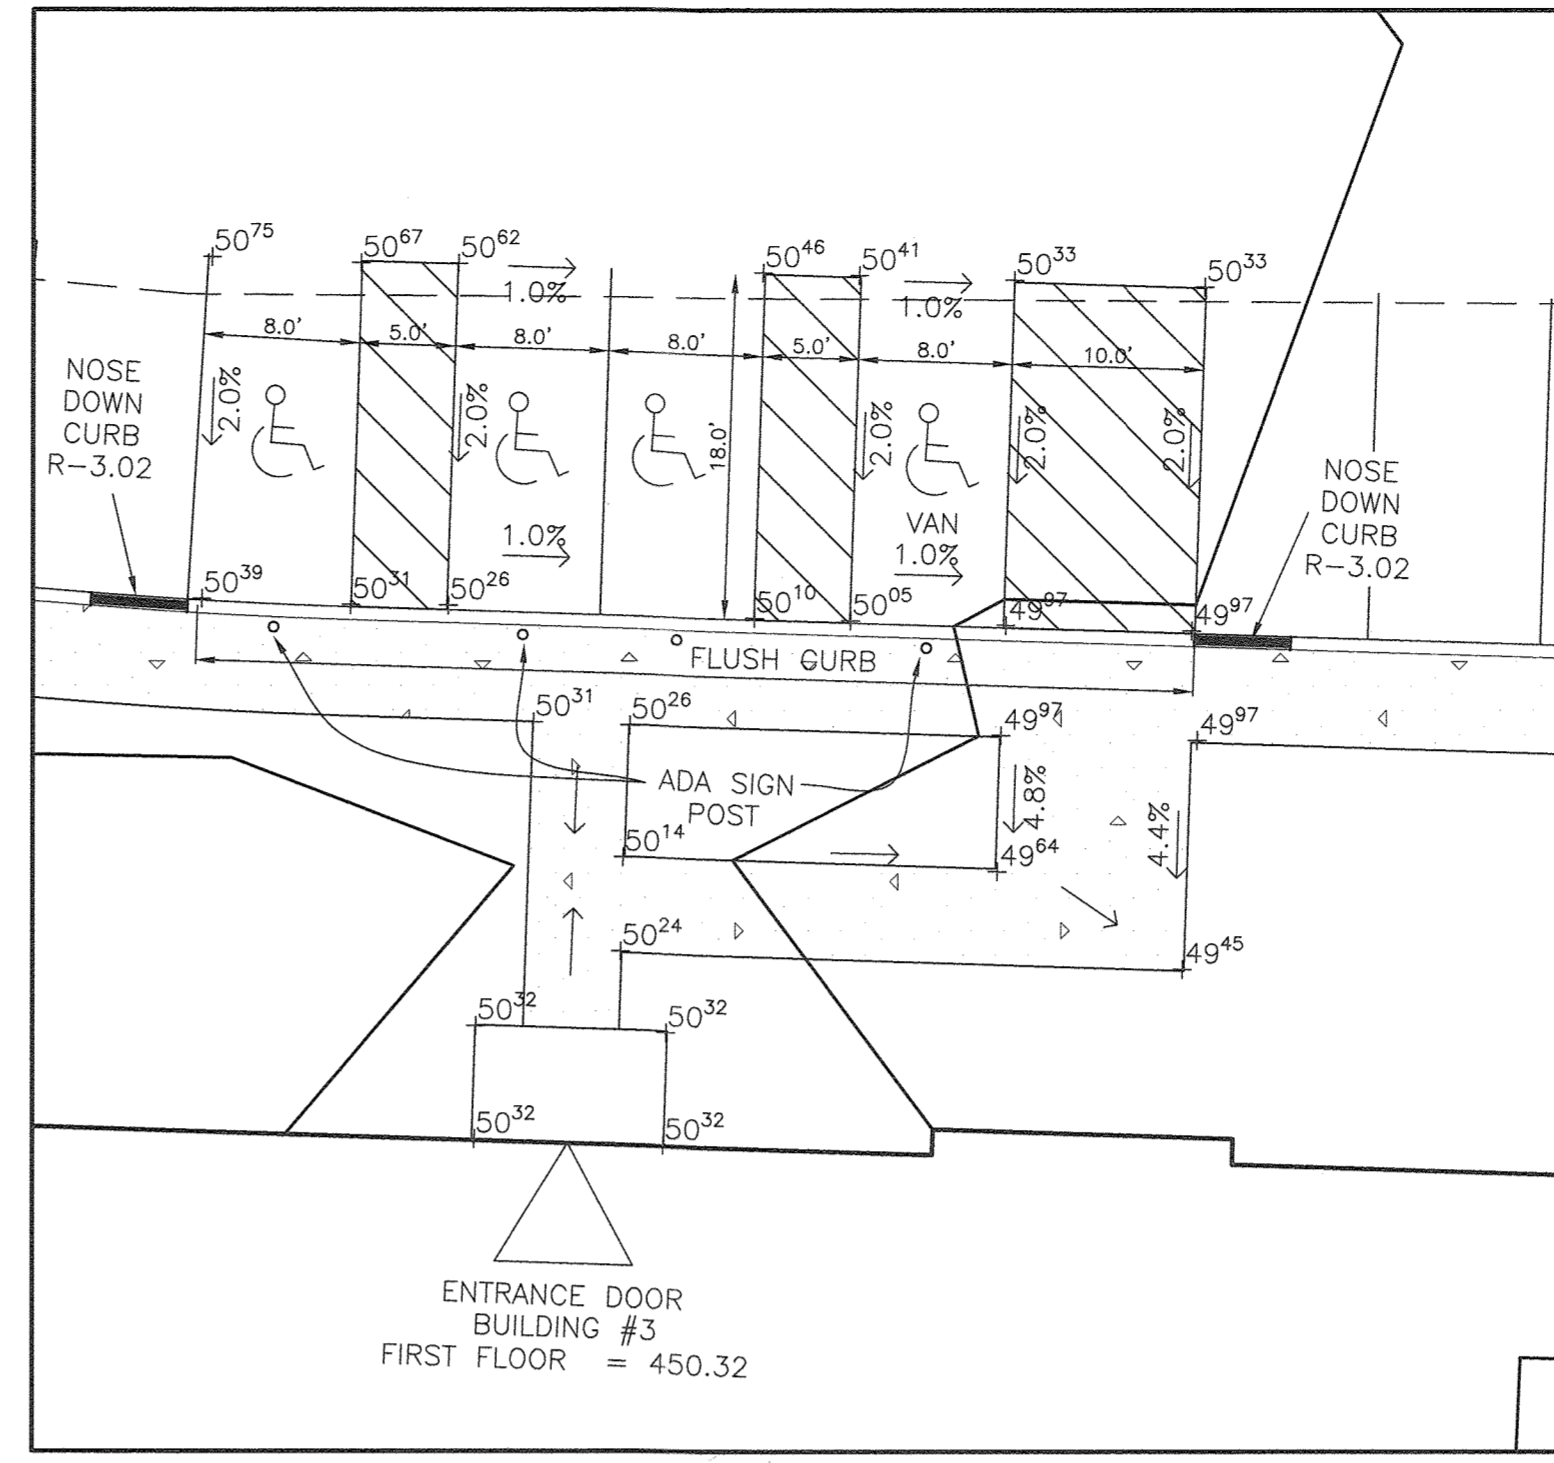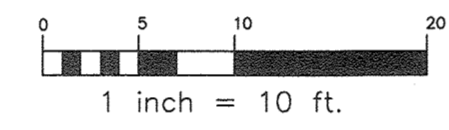

BUILDING 3

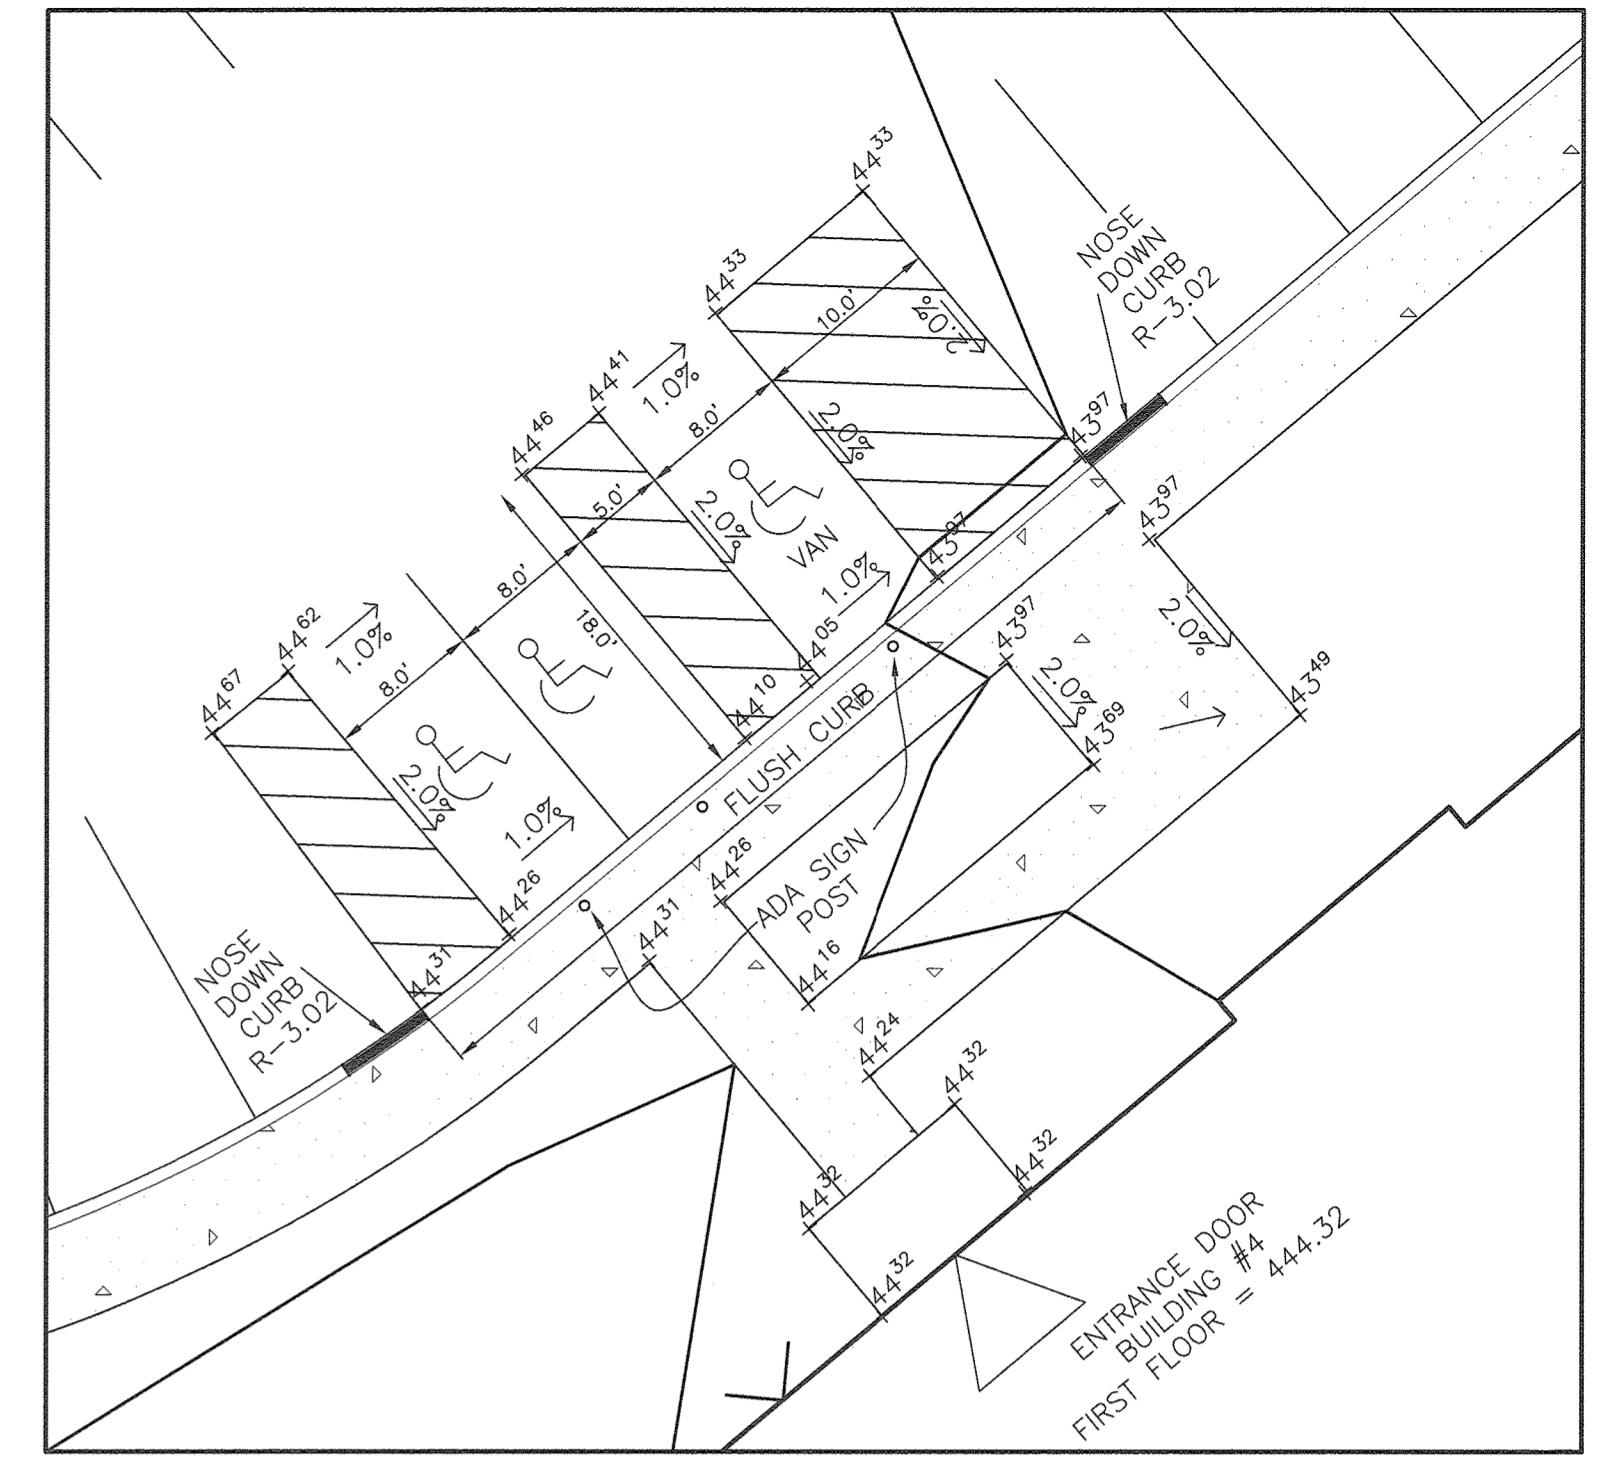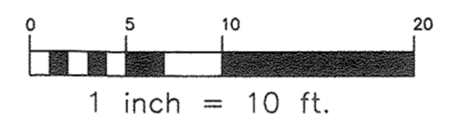

BUILDING 4

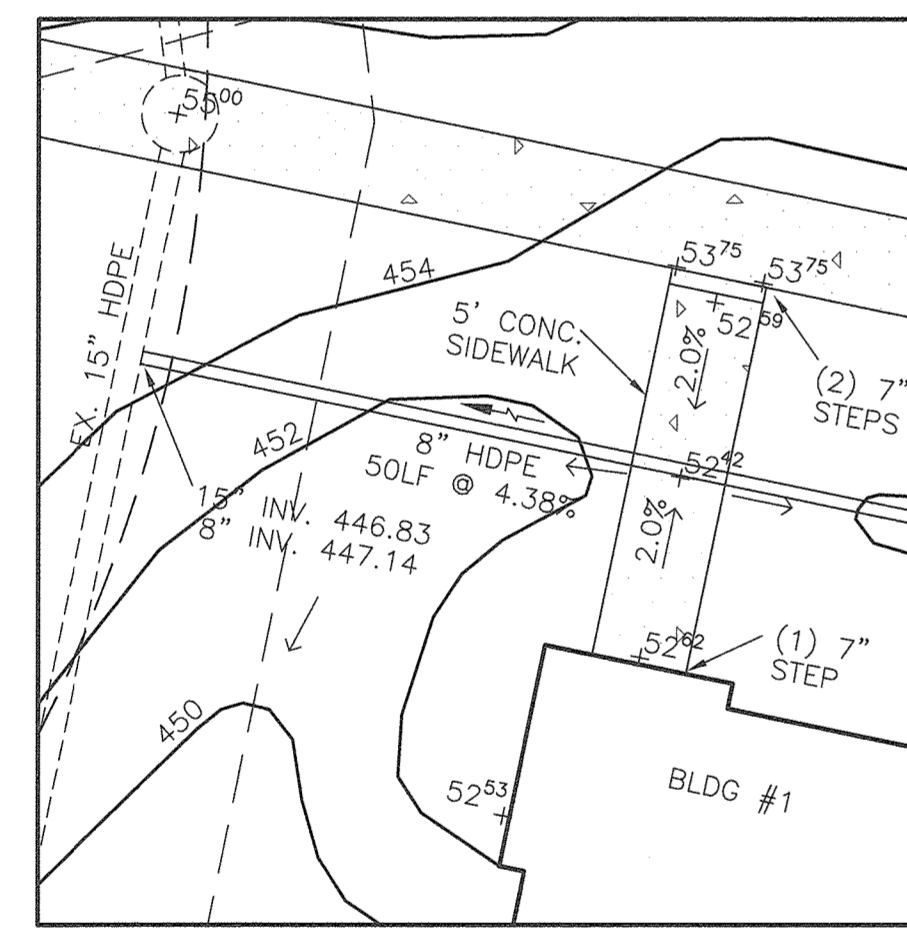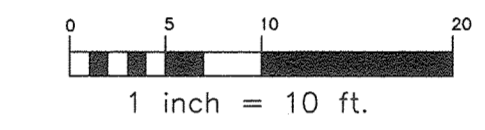

MATCH LINE SEE THIS SHEET


APPROVED
PLANNING BOARD OF HOWARD COUNTY
DATE AUGUST 20, 2020

APPROVED: HOWARD COUNTY DEPARTMENT OF PLANNING AND ZONING

[Signature] 5/9/22
CHIEF, DEVELOPMENT ENGINEERING DIVISION DATE

[Signature] 5/10/22
CHIEF, DIVISION OF LAND DEVELOPMENT DATE

[Signature] 5/10/22
DIRECTOR DATE

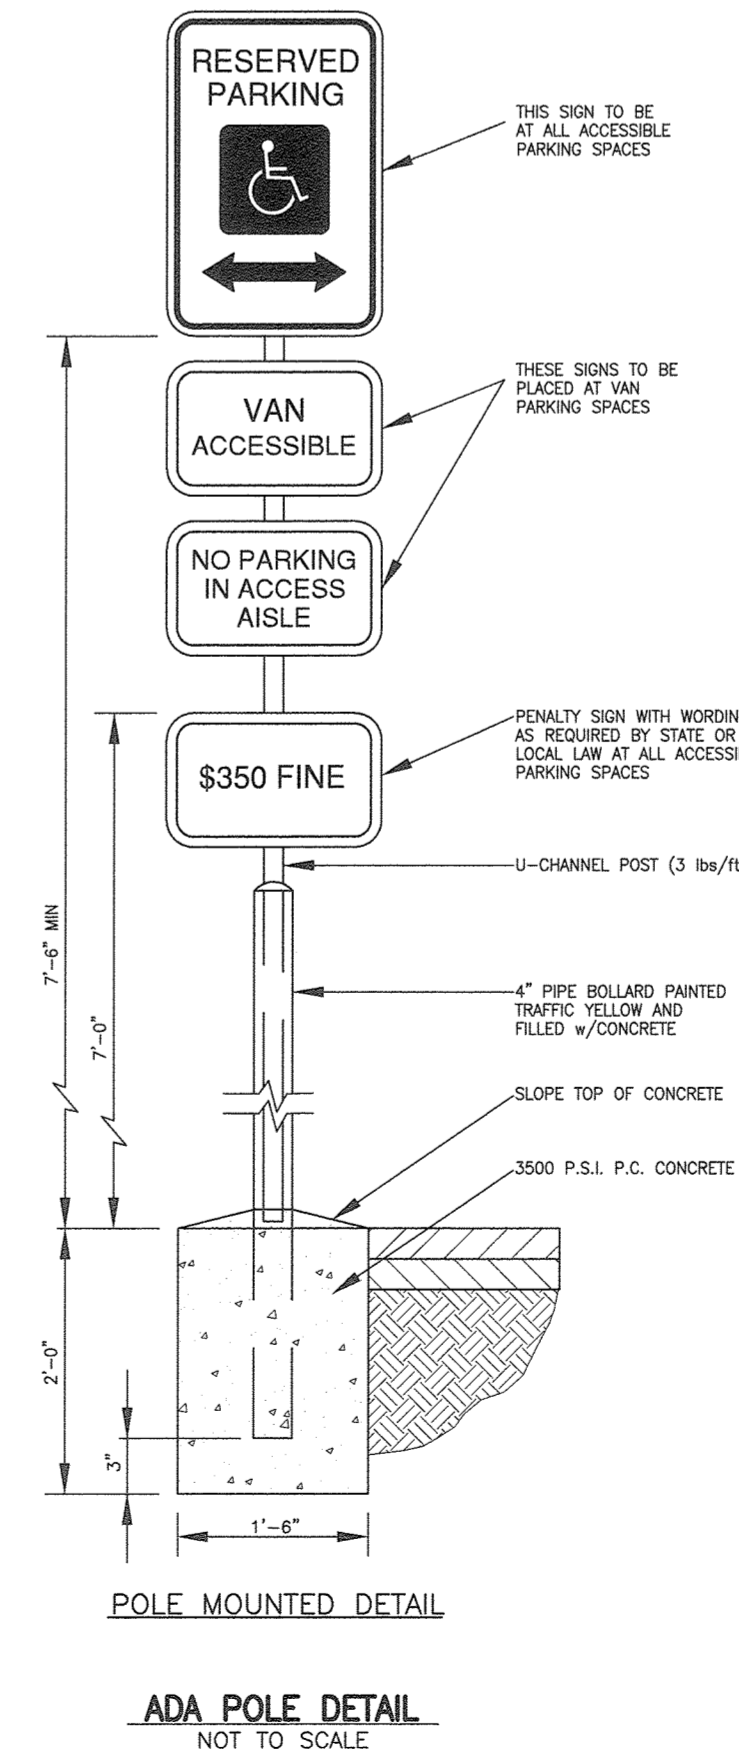

"NO AS-BUILT INFORMATION IS PROVIDED ON THIS SHEET"

STATE OF MARYLAND
[Signature]
PROFESSIONAL ENGINEER
NO. 21443
AS-BUILT 5-21-24

Professional Certification: I hereby certify that these documents were prepared or approved by me, and that I am a duly licensed professional engineer under the laws of the State of Maryland.
License No. 21443, Expiration Date: 12-31-24

NO.	DATE	REVISION
1	4.25.2022	EXPAND DETAIL FOR BUILDING #1 TO SHOW ADDITIONAL WALK AND 8\"/>

BENCHMARK ENGINEERING, INC.
ENGINEERS • LAND SURVEYORS • PLANNERS
8480 BALTIMORE NATIONAL PIKE SUITE 315 A ELLICOTT CITY, MARYLAND 21043
(P) 410-465-6105 (F) 410-465-6644
WWW.BEI-CIVILENGINEERING.COM

Professional Certification: I hereby certify that these documents were prepared or approved by me, and that I am a duly licensed professional engineer under the laws of the State of Maryland.
License No. 22550, Expiration Date: 6-30-2023


<p>OWNER: MANGIONE ENTERPRISES OF TURF VALLEY, LIMITED PARTNERSHIP 1205 YORK ROAD, PENTHOUSE LUTHERVILLE, MARYLAND 21093 410-825-8400</p>	<p>RESIDENTIAL - SINGLE FAMILY ATTACHED AND MULTI-FAMILY RAVENWOOD CONDOMINIUMS AT TURF VALLEY LOTS 1 thru 7 AND BUILDABLE BULK PARCEL 'AA'</p>
<p>BUILDER: NV HOMES 9720 PATUXENT WOODS DIVE COLUMBIA, MARYLAND 21046 410-379-3385</p>	<p>TAX MAP: 17, PARCEL: 706, GRID: 13 ELECTION DISTRICT NO. 2 - HOWARD COUNTY, MARYLAND ZONED: PGCC</p>
<p>ADA COMPLIANCE PLAN PARCEL 'AA'</p>	
<p>DATE: AUGUST 27, 2020 DESIGN: DBT DRAFT: DBT</p>	<p>BEI PROJECT NO. 2931 SCALE: AS SHOWN SHEET 5 OF 23</p>

FIELD TEST BORING LOG					
BORING NO.	DRILLER	START DATE	COMPLETION DATE	PROJECT NAME	PROJECT LOCATION
B-16	Harvest		11/29/2017	Ravenwood at Turf Valley (P-18-027)	End of Resort Road
CLIENT: Mangione Enterprises at Turf Valley, LP	DRILLING METHOD: Backhoe				
DEPTH (FT)	SOL DESCRIPTION	WATER LEVEL (FT)	REMARKS	DATE	TIME
0	Starting elevation = 458.19				
1	Topsoil				
2	reddish brown silty sand slightly moist				
3	very rocky small to medium size rocks				
4					
5					
FIELD TEST BORING LOG					
BORING NO.	DRILLER	START DATE	COMPLETION DATE	PROJECT NAME	PROJECT LOCATION
B-17	Harvest		11/29/2017	Ravenwood at Turf Valley (P-18-027)	End of Resort Road
CLIENT: Mangione Enterprises at Turf Valley, LP	DRILLING METHOD: Backhoe				
DEPTH (FT)	SOL DESCRIPTION	WATER LEVEL (FT)	REMARKS	DATE	TIME
0	Starting elevation = 457.09				
1	Topsoil				
2	reddish brown silty sand slightly moist				
3	rocks encountered at 3 feet medium to large size rocks				
4					
5					
FIELD TEST BORING LOG					
BORING NO.	DRILLER	START DATE	COMPLETION DATE	PROJECT NAME	PROJECT LOCATION
B-18	Harvest		11/29/2017	Ravenwood at Turf Valley (P-18-027)	End of Resort Road
CLIENT: Mangione Enterprises at Turf Valley, LP	DRILLING METHOD: Backhoe				
DEPTH (FT)	SOL DESCRIPTION	WATER LEVEL (FT)	REMARKS	DATE	TIME
0	Starting elevation = 458.61				
1	Topsoil				
2	reddish brown silty sand slightly moist				
3	rocks encountered at 3 feet medium to large size rocks				
4					
5					
FIELD TEST BORING LOG					
BORING NO.	DRILLER	START DATE	COMPLETION DATE	PROJECT NAME	PROJECT LOCATION
B-19	Harvest		11/29/2017	Ravenwood at Turf Valley (P-18-027)	End of Resort Road
CLIENT: Mangione Enterprises at Turf Valley, LP	DRILLING METHOD: Backhoe				
DEPTH (FT)	SOL DESCRIPTION	WATER LEVEL (FT)	REMARKS	DATE	TIME
0	Starting elevation = 457.76				
1	Topsoil				
2	reddish brown silty sand slightly moist				
3	rocks encountered at 3 feet medium to large size rocks				
4					
5					
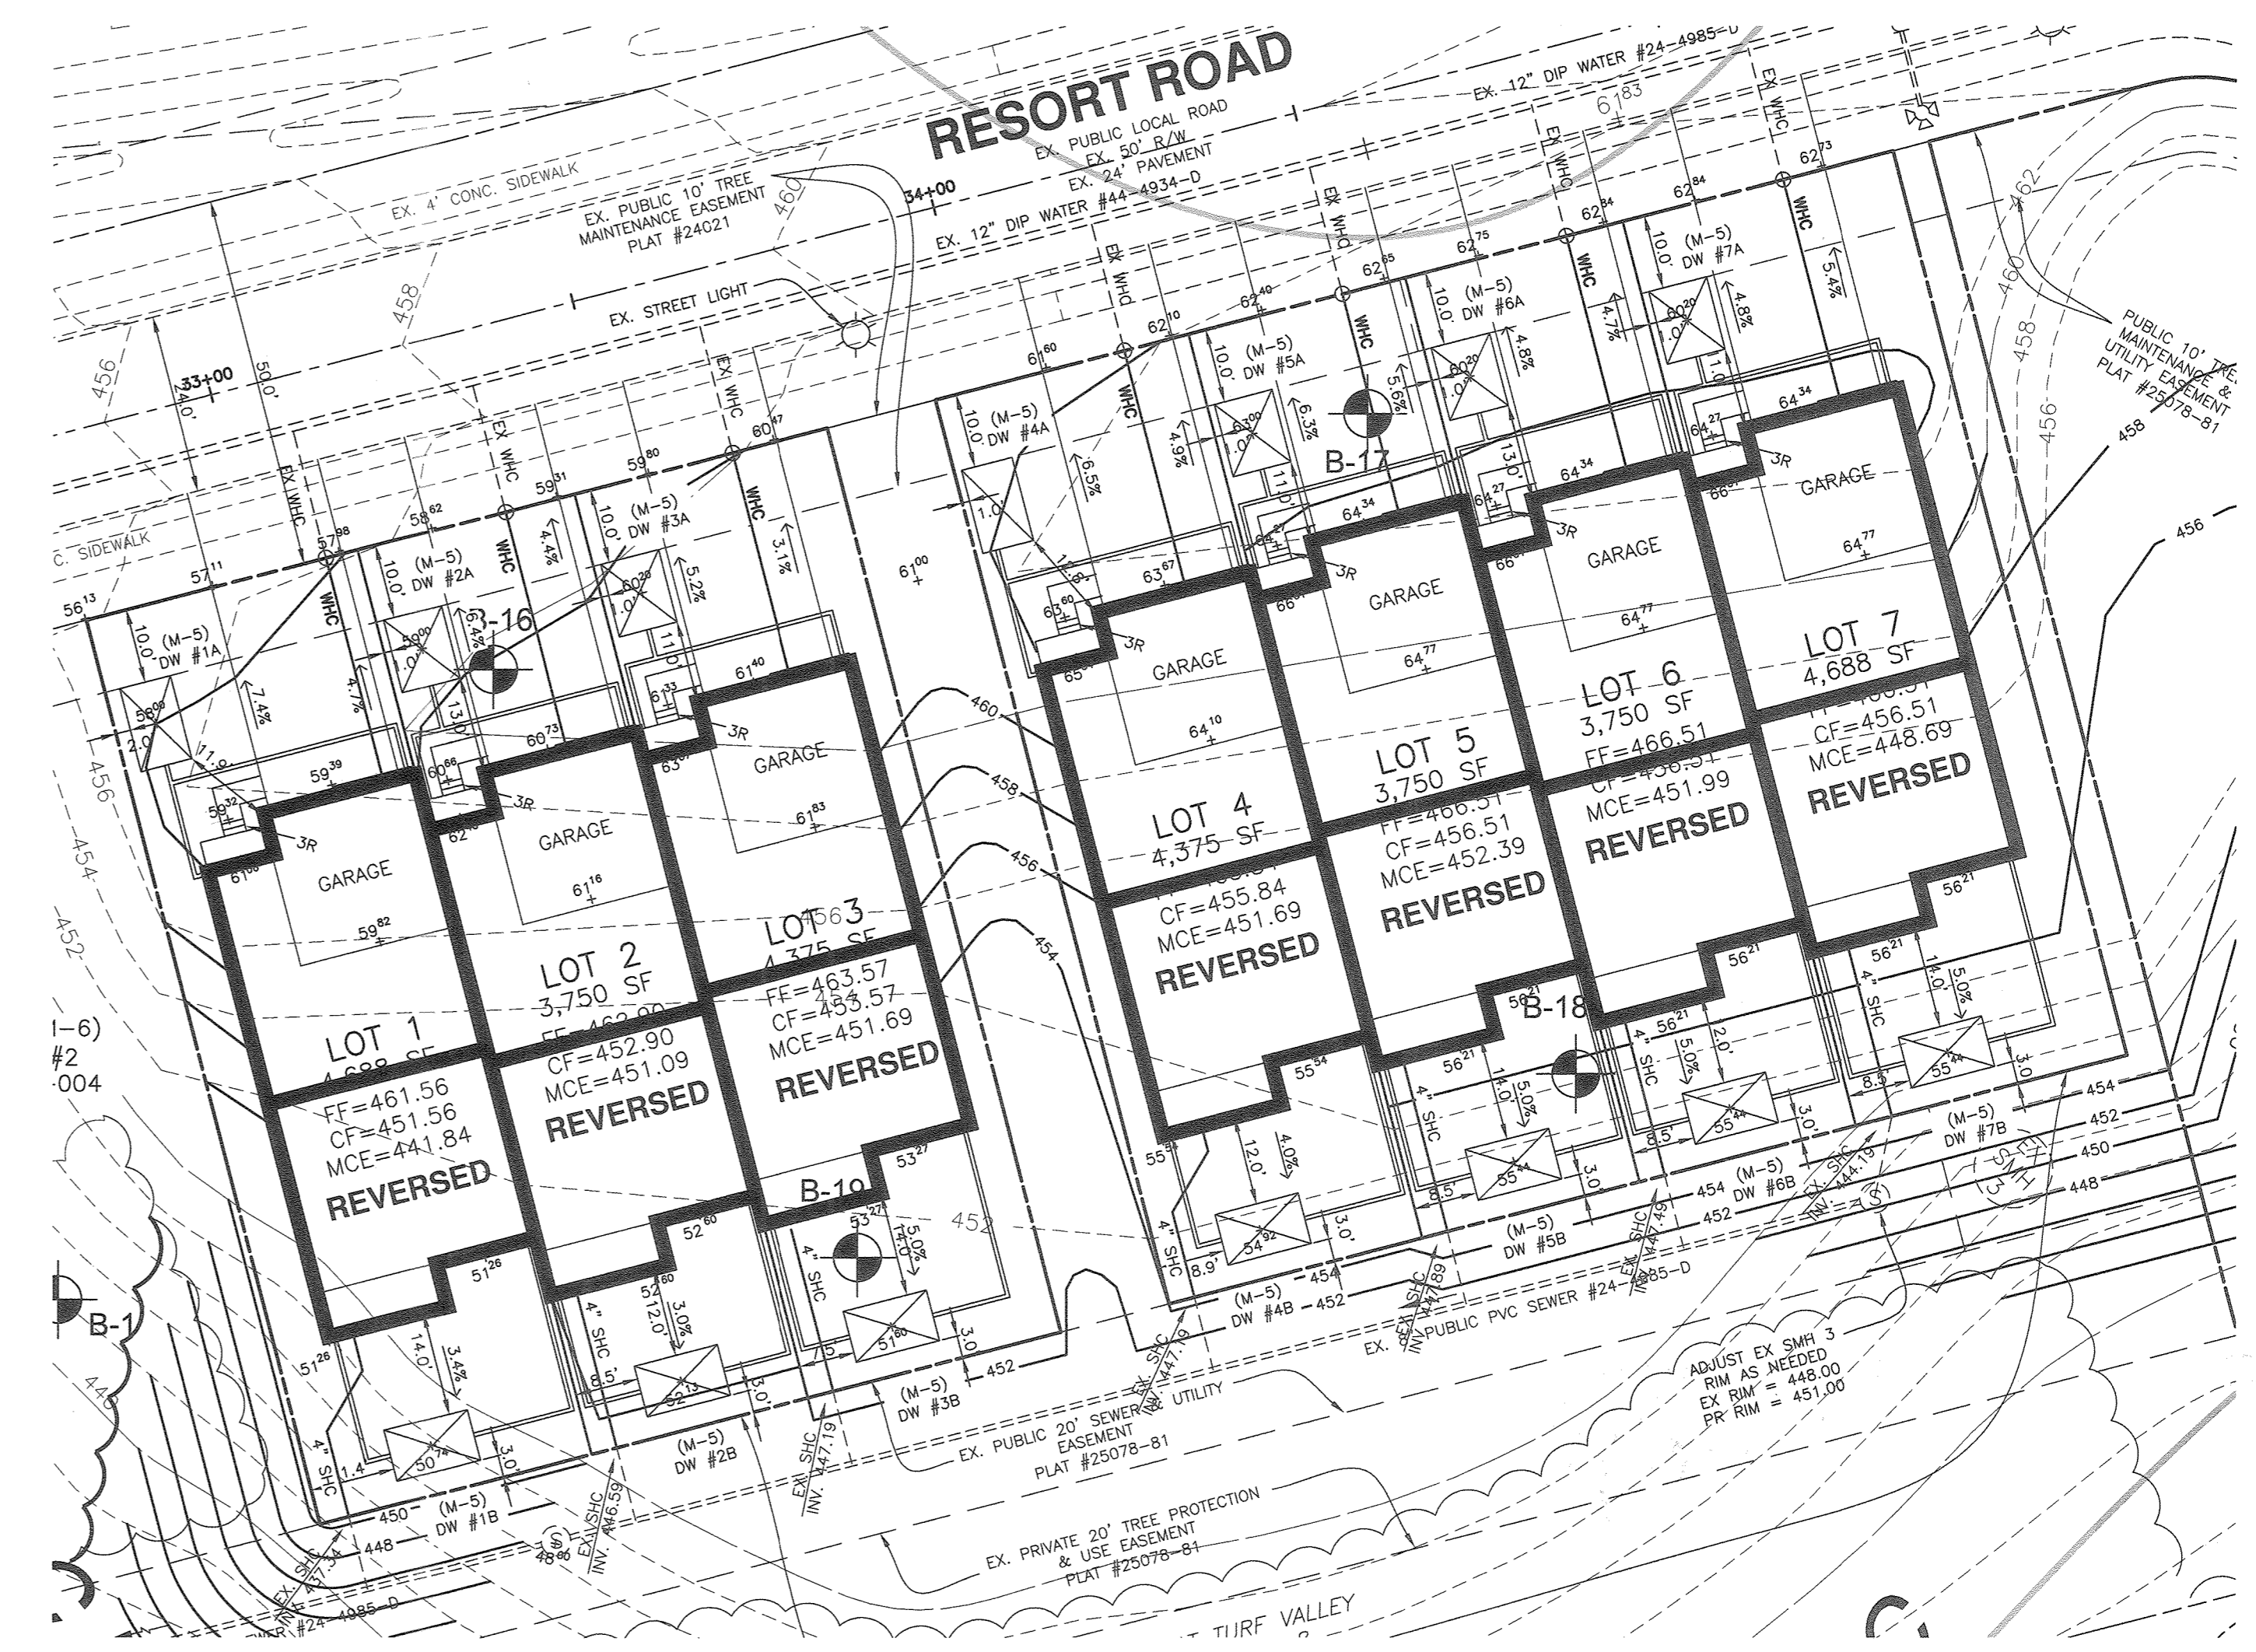

(M-5) DRY WELL PLAN

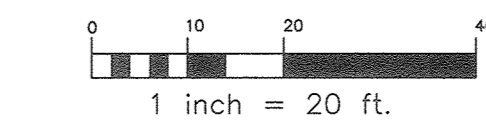


MATERIALS & SPECIFICATIONS FOR DRY WELLS			
MATERIAL	SPECIFICATION	SIZE	NOTES:
GEOTEXTILE (CLASS 'C')		N/A	PE TYPE 1 NONWOVEN
GRAVEL	AASHTO M 43	1 1/2" TO 2 1/2"	
UNDERDRAIN PIPING	F758, TYPE PS28 OR AASHTO M-278	4" TO 6" RIGID SCH.40 PVC, SDR35 OR HDPE	3/8" PERF. @ 6" O/C, 4 HOLES PER ROW; MINIMUM OF 2" OF GRAVEL OVER PIPES.
SAND	AASHTO M-6 OR ASTM-C-33	.02" TO .04"	SAND SUBSTITUTIONS SUCH AS DIABASE AND GRAYSTONE (AASHTO #10 ARE NOT ACCEPTABLE. NO CALCIUM CARBONATED OR DOLOMITIC SAND SUBSTITUTIONS ARE ACCEPTABLE. NT ROCK DUST CAN BE USED FOR SAND.

"NO AS-BUILT INFORMATION IS PROVIDED ON THIS SHEET"


APPROVED
PLANNING BOARD OF HOWARD COUNTY
DATE AUGUST 20, 2020

Professional Certification. I hereby certify that these documents were prepared or approved by me, and that I am a duly licensed professional engineer under the laws of the State of Maryland.
License No. 21443 Expiration Date: 12-21-24

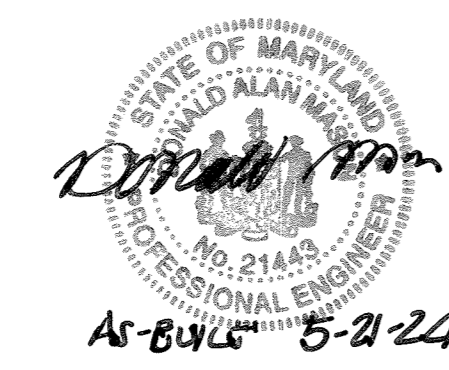


OPERATION AND MAINTENANCE SCHEDULE FOR PRIVATELY OWNED AND MAINTAINED (M-5) DRY WELLS

- The monitoring wells and structures shall be inspected on a quarterly basis and after every large storm event.
- Water levels and sediment build up in the monitoring wells shall be recorded over a period of several days to insure trench drainage.
- A log book shall be maintained to determine the rate at which the facility drains
- When the facility becomes clogged so that it does not drain down within the 72 hour time period, corrective action shall be taken.
- The maintenance log book shall be available to Howard County for inspection to insure compliance with operation and maintenance criteria.
- Once the performance characteristics of the infiltration facility have been verified, the monitoring schedule can be reduced to an annual basis unless the performance data indicates that a more frequent schedule is required.


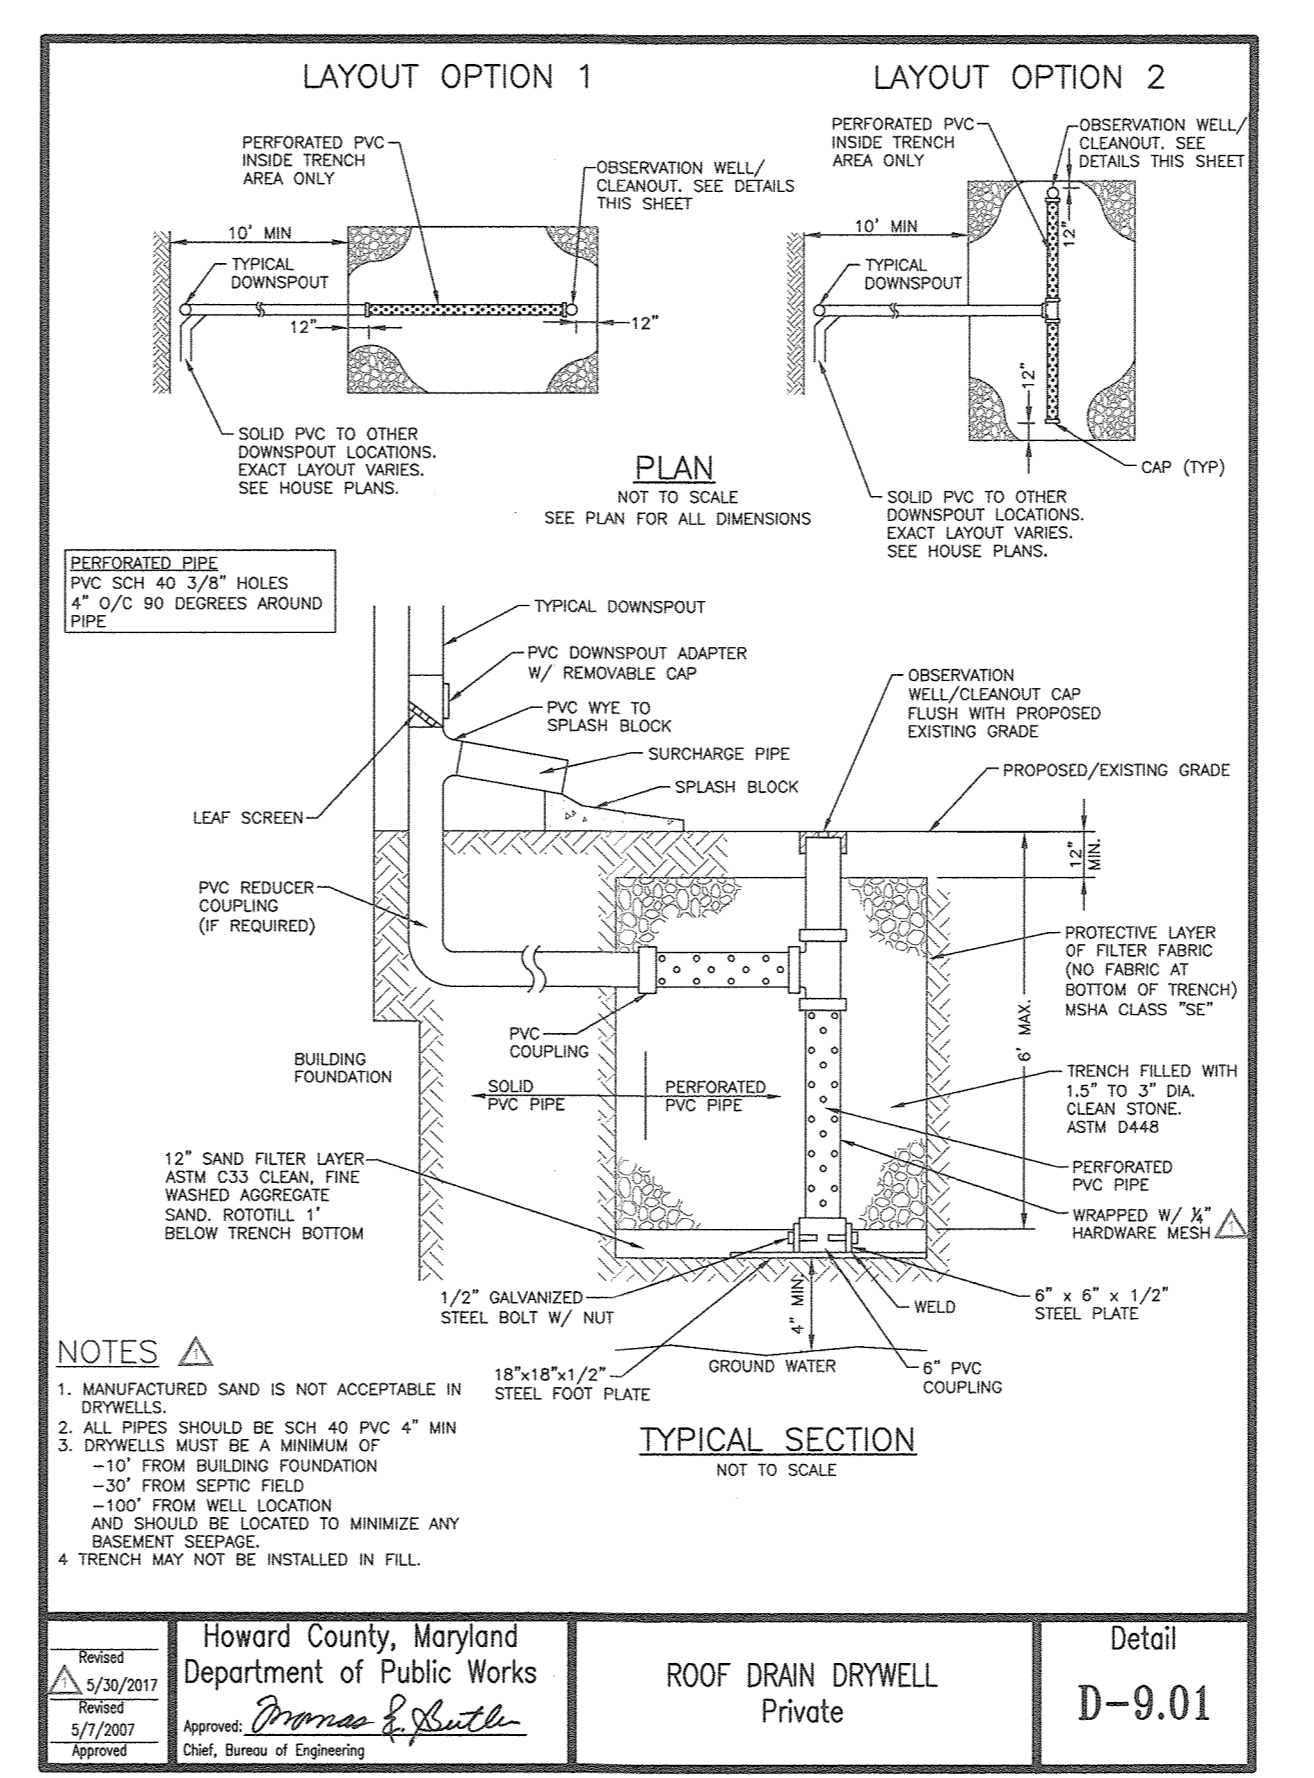


Dry Well Chart								
Lot	Dry Well	Width (ft)	Length (ft)	Depth (ft)	Ground Elevation	Top of Storage Elevation	Bottom of Stone Elevation	Bottom of Sand Elevation
1	1A	7.0	11.5	5.0	458.00	457.00	453.00	452.00
	1B	7.0	11.5	5.0	450.74	449.74	445.74	444.74
2	2A	8.0	10.0	5.0	459.00	458.00	454.00	453.00
	2B	7.0	11.5	5.0	452.13	451.13	447.13	446.13
3	3A	8.0	10.0	5.0	460.20	459.20	455.20	454.20
	3B	7.0	11.5	5.0	451.60	450.60	446.60	445.60
4	4A	7.0	11.5	5.0	462.00	461.00	457.00	456.00
	4B	7.0	11.5	5.0	454.92	453.92	449.92	448.92
5	5A	8.0	10.0	5.0	463.00	462.00	458.00	457.00
	5B	7.0	11.5	5.0	455.44	454.44	450.44	449.44
6	6A	8.0	10.0	5.0	463.50	462.50	458.50	457.50
	6B	7.0	11.5	5.0	455.44	454.44	450.44	449.44
7	7A	8.0	10.0	5.0	463.55	462.55	458.55	457.55
	7B	7.0	11.5	5.0	455.44	454.44	450.44	449.44



NO. DATE REVISION		<p>BENCHMARK ENGINEERING, INC. ENGINEERS & LAND SURVEYORS & PLANNERS 8480 BALTIMORE NATIONAL PIKE SUITE 315 & ELLICOTT CITY, MARYLAND 21043 (P) 410-465-6105 (F) 410-465-8644 WWW.BEI-CIVILENGINEERING.COM</p>	<p>Professional Certification. I hereby certify that these documents were prepared or approved by me, and that I am a duly licensed professional engineer under the laws of the State of Maryland. License No. 22390 Expiration Date: 6-30-2021</p>
OWNER: MANGIONE ENTERPRISES OF TURF VALLEY, LIMITED PARTNERSHIP 1205 YORK ROAD, PENTHOUSE LUTHERVILLE, MARYLAND 21093 410-825-8400			
BUILDER: NV HOMES 9720 PATUXENT WOODS DRIVE COLUMBIA, MARYLAND 21046 410-379-3385		<p>RESIDENTIAL - SINGLE FAMILY ATTACHED AND MULTI-FAMILY RAVENWOOD CONDOMINIUMS AT TURF VALLEY LOTS 1 thru 7 AND BUILDABLE BULK PARCEL 'AA'</p> <p>TAX MAP: 17, PARCEL: 706, GRID: 13 ELECTION DISTRICT NO. 2 - HOWARD COUNTY, MARYLAND ZONED: PGCC</p> <p>STORMWATER MANAGEMENT PLAN, DETAILS, AND BORING LOGS TOWNHOUSE LOTS</p> <p>DATE: AUGUST 27, 2020 BEI PROJECT NO. 2931 SCALE: AS SHOWN SHEET 6 OF 23</p>	

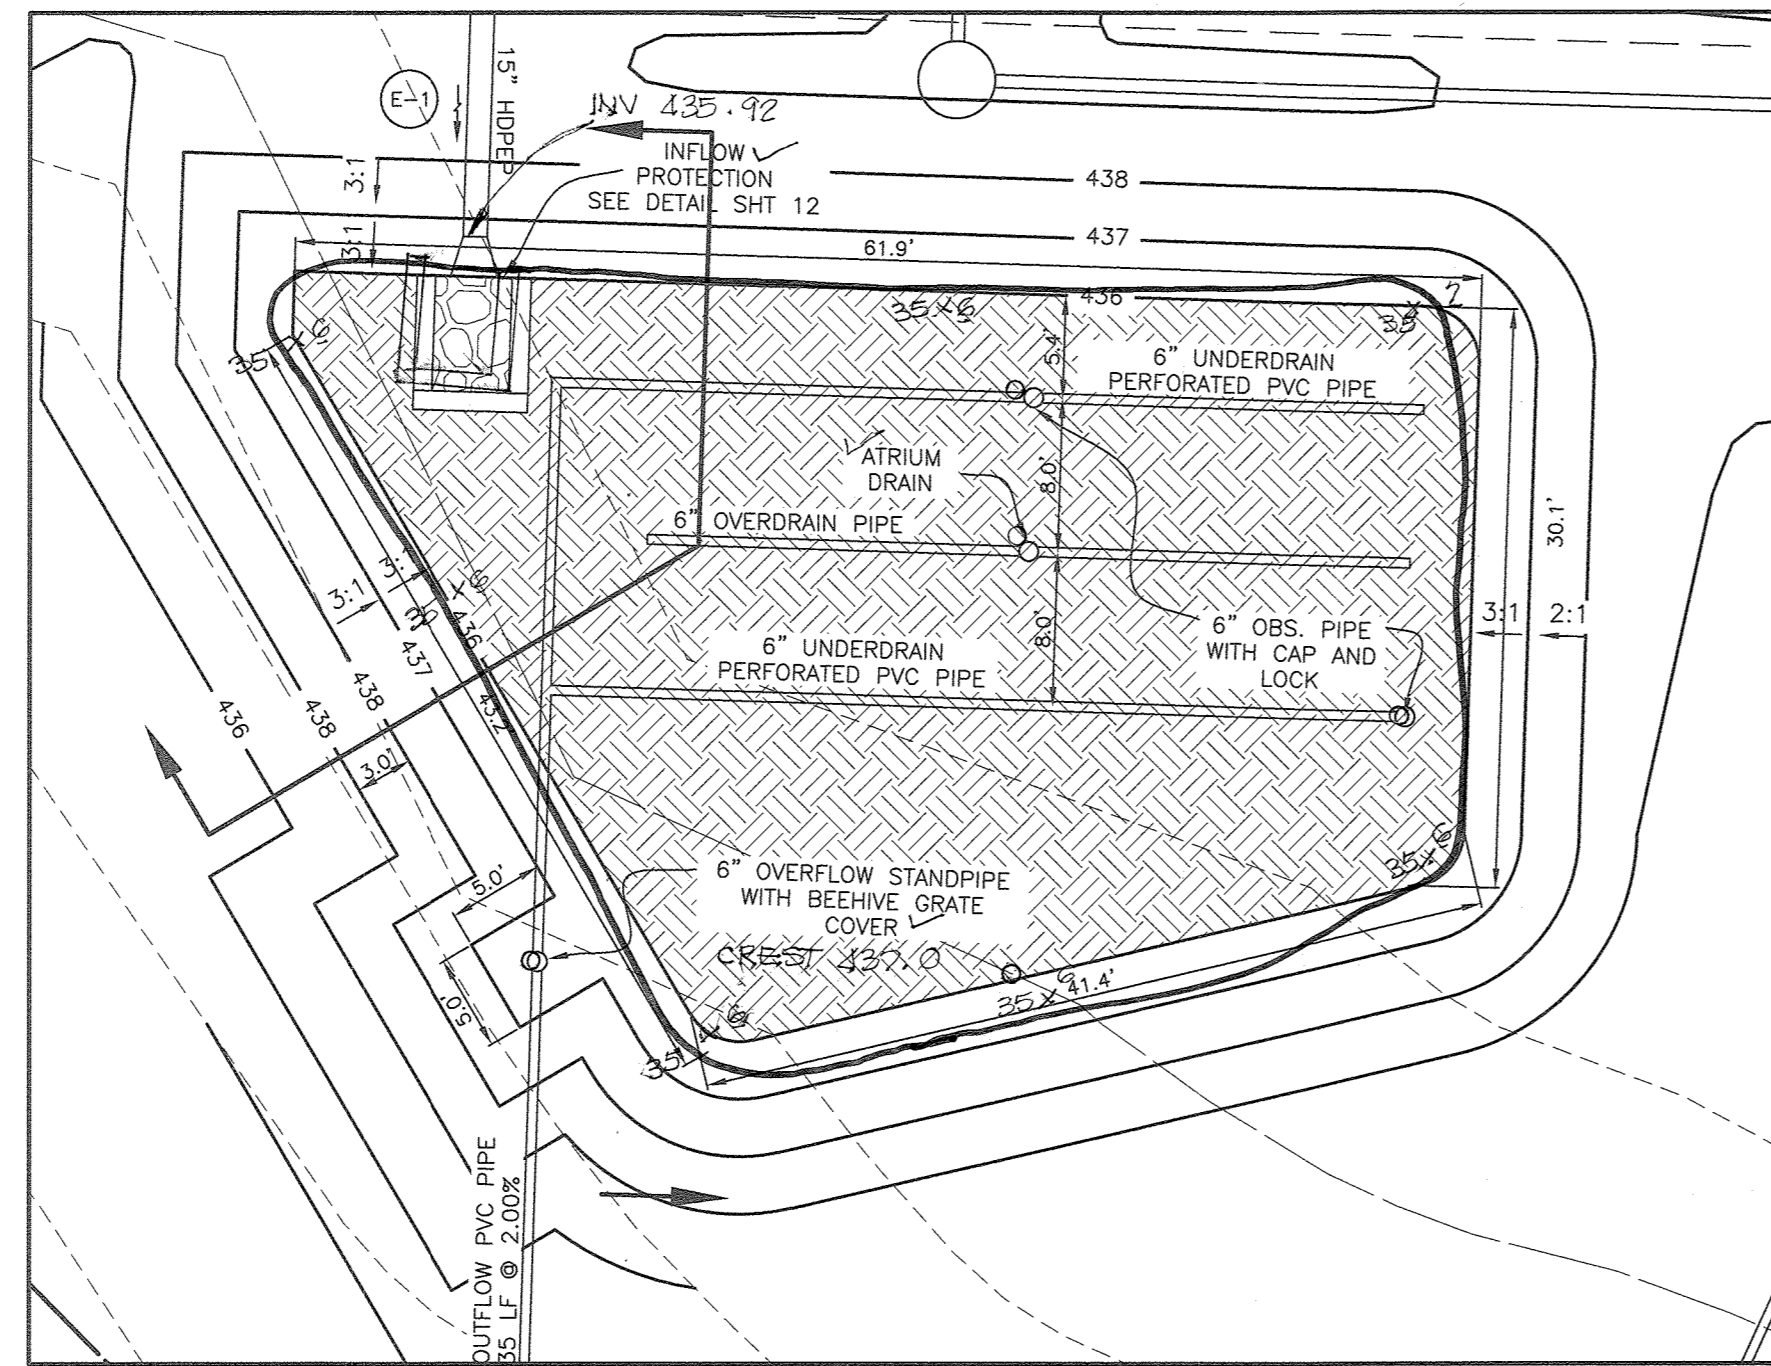


(M-6) MICRO BIO-RETENTION #1

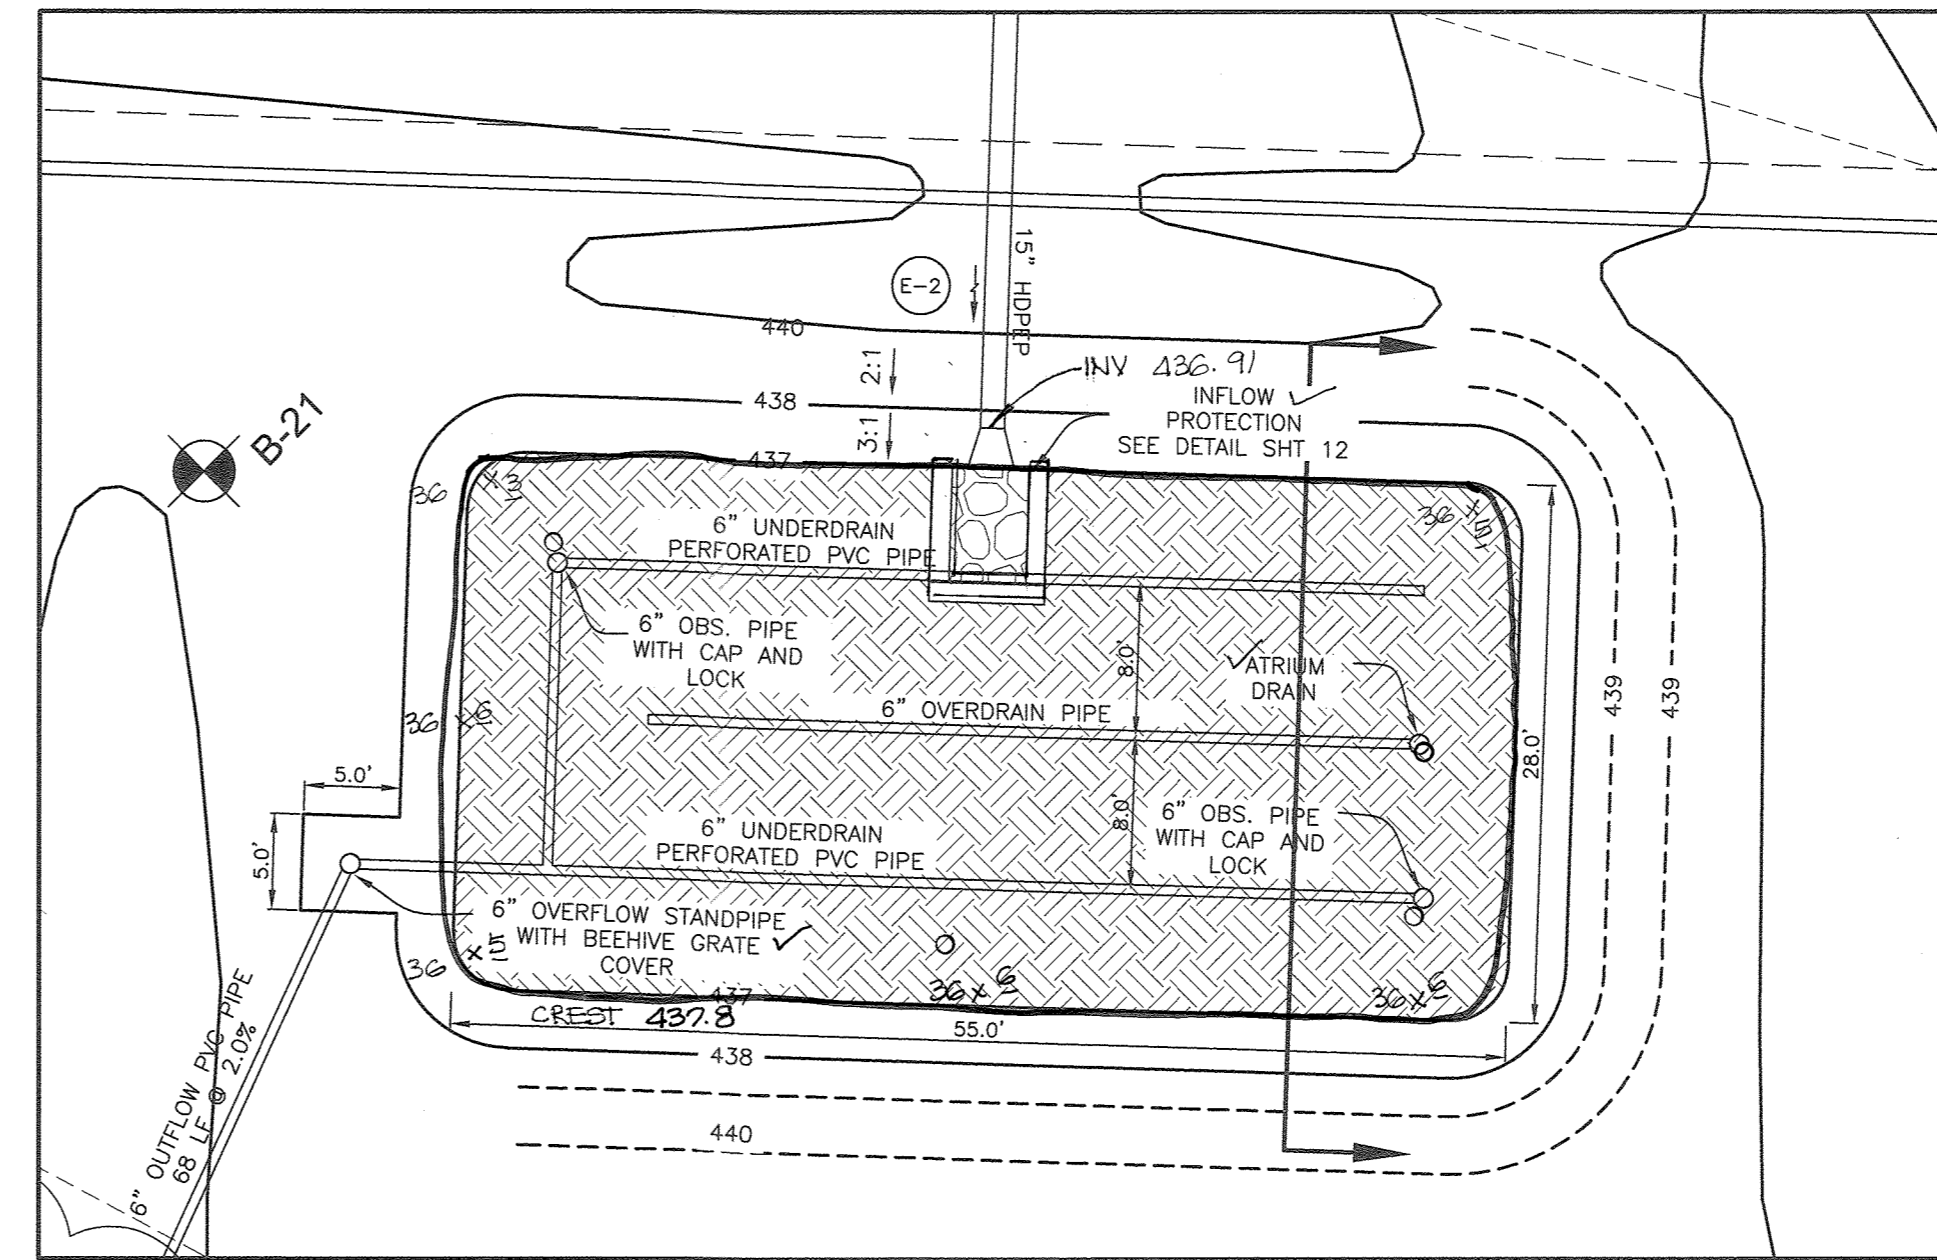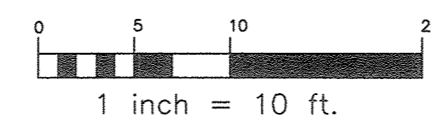


(M-6) MICRO BIO-RETENTION #2

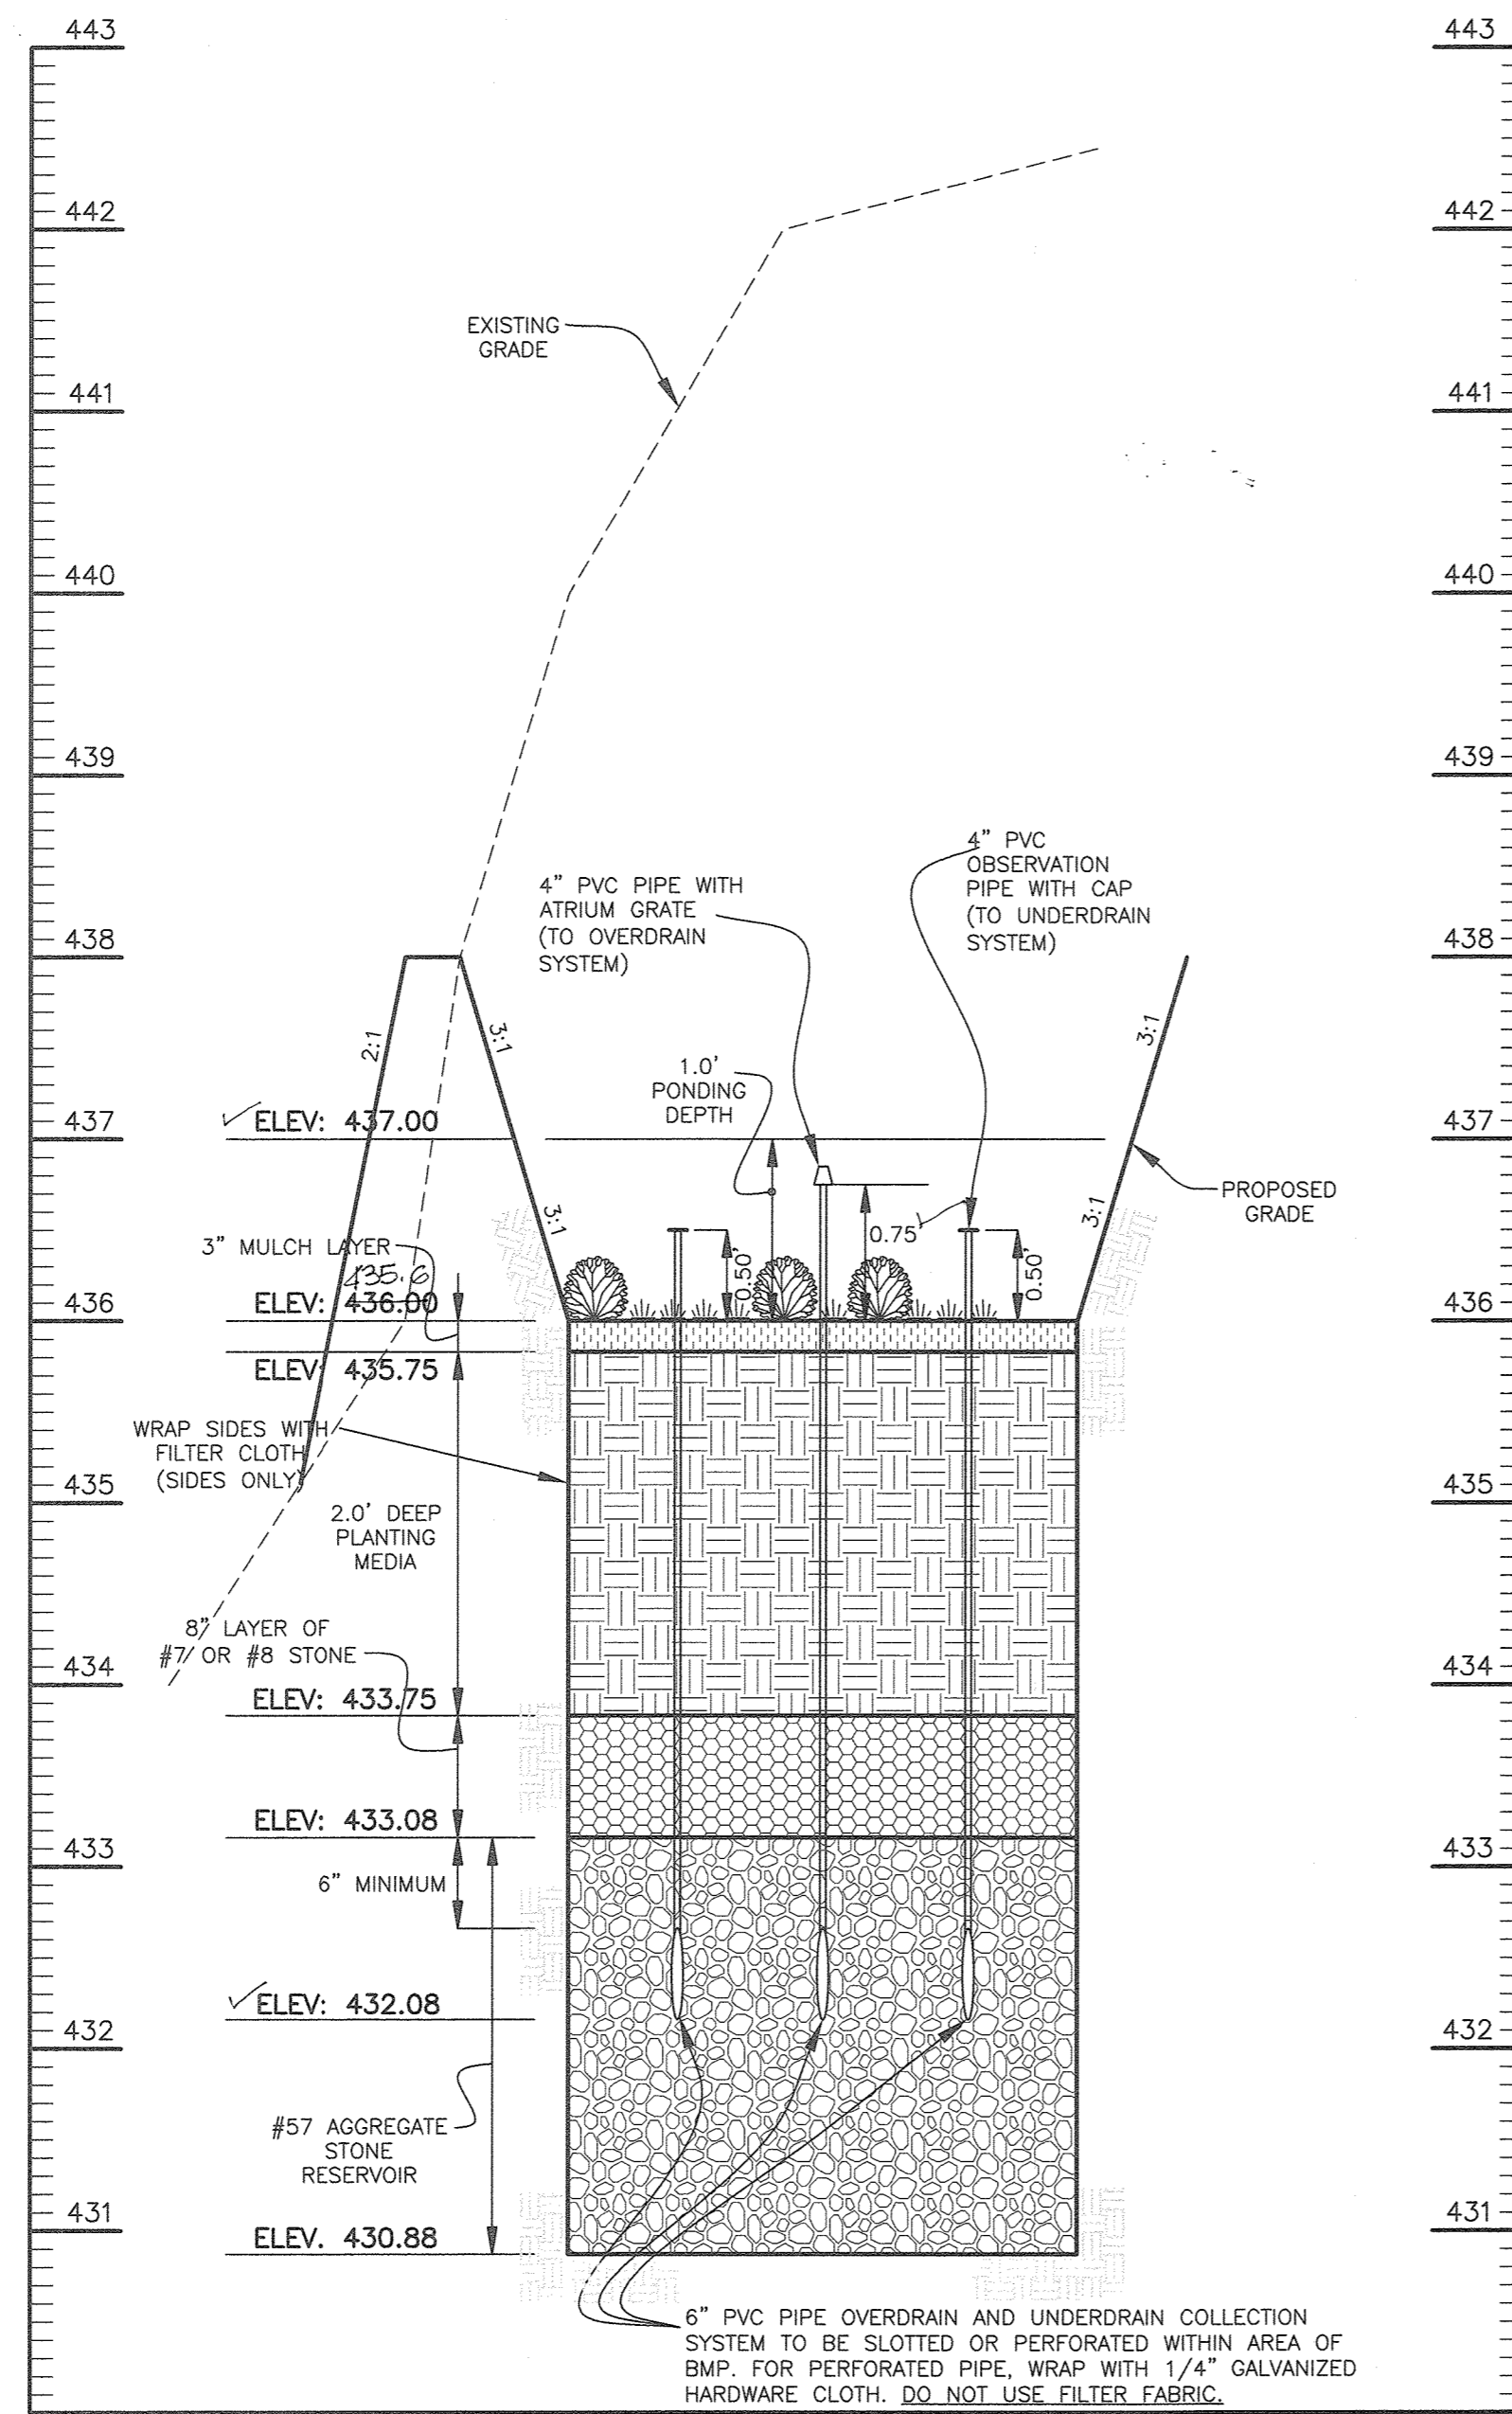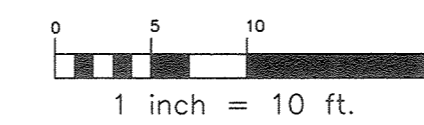

(M-6) MICRO BIO-RETENTION #1
CROSS SECTION
SCALE: 1"=20'H; 1"=2'V

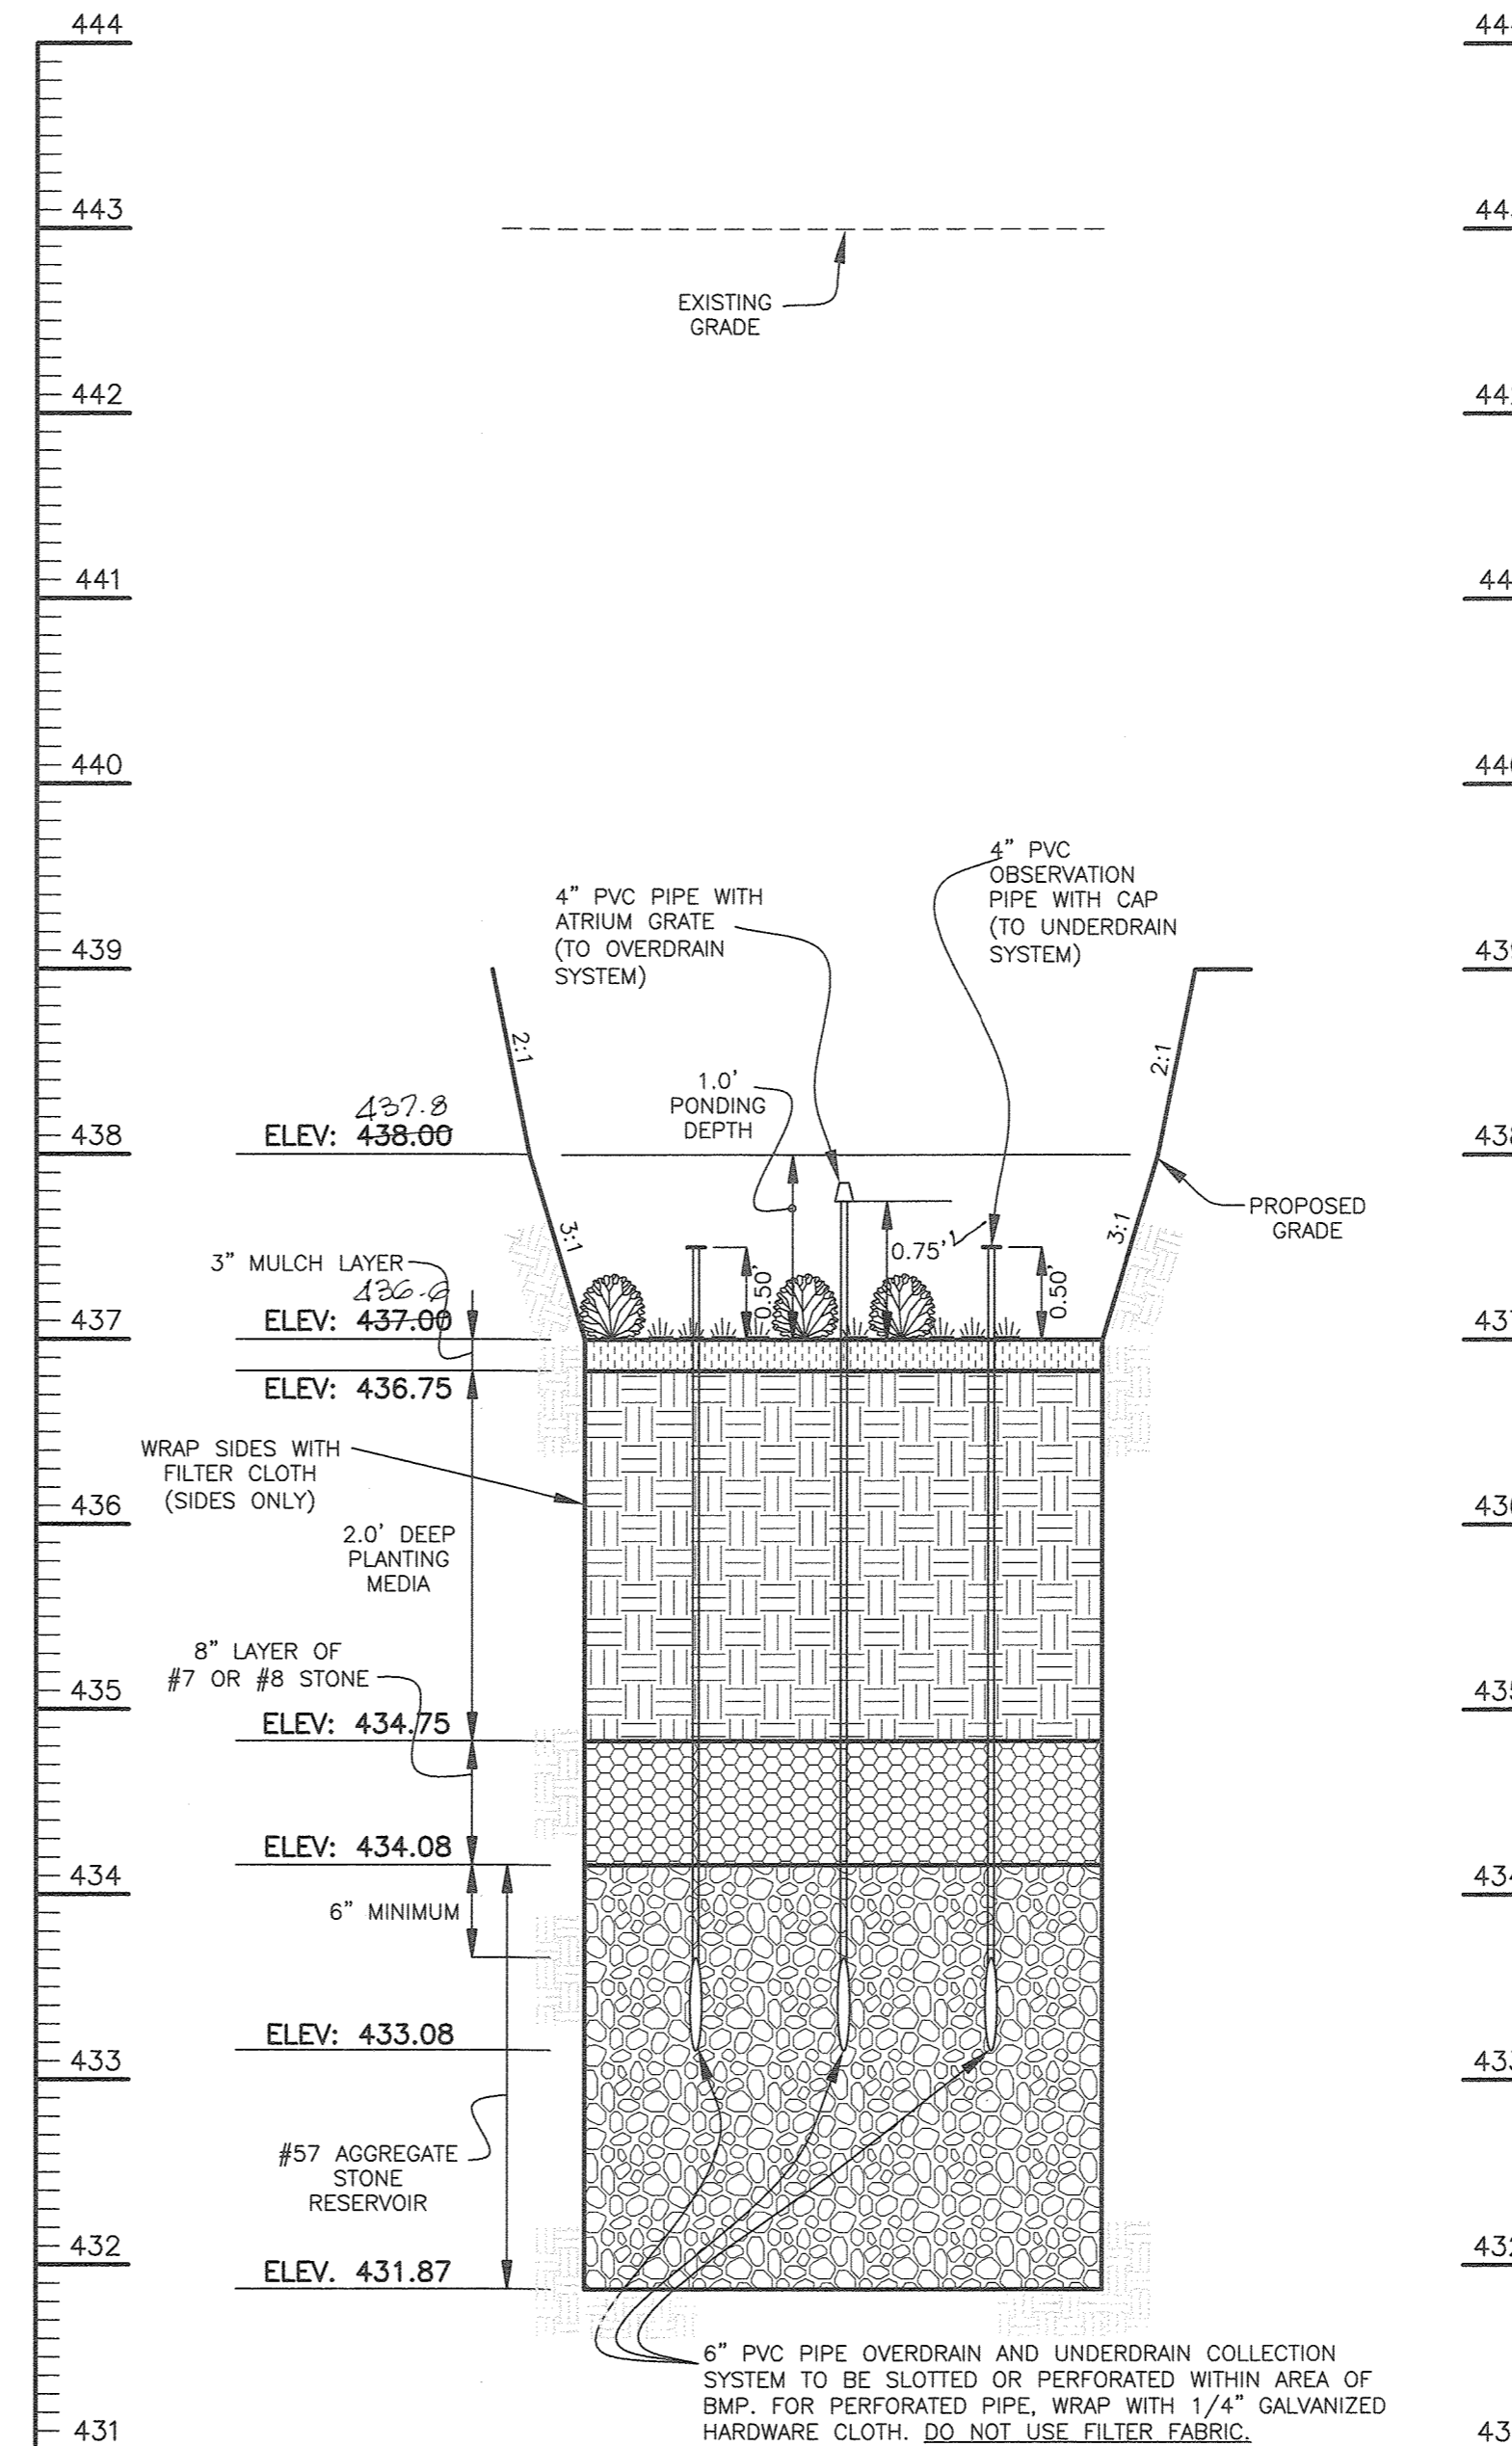

(M-6) MICRO BIO-RETENTION #2
CROSS SECTION
SCALE: 1"=20'H; 1"=2'V

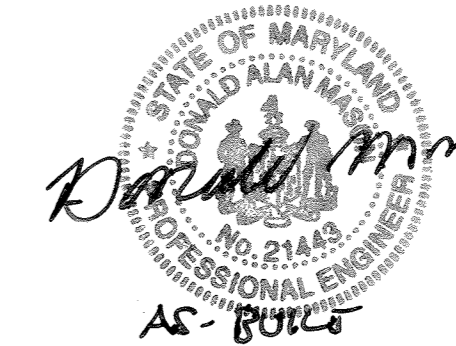

Professional Certification. I hereby certify that these documents were prepared or approved by me, and that I am a duly licensed professional engineer under the laws of the State of Maryland.
License No. 21463, Expiration Date: 12/31/24


AS-BUILT CERTIFICATION
I hereby certify, by my seal, that to the best of my knowledge and belief the facilities shown on this "AS-BUILT" Plan meet the Approved Plans and Specifications
Donald Mason, P.E. Date: 5/21/24

- NOTES:
- TOP OF GABION BASKETS TO BE SET AT PONDING ELEVATION OR 1-FOOT ABOVE SURFACE ELEVATION OF MICRO BIO-RETENTION.
 - BEEHIVE GRATES TO BE NDS 6" ROUND GRATE, GREEN, OR EQUIVALENT.



APPROVED
PLANNING BOARD OF HOWARD COUNTY
DATE AUGUST 20, 2020

APPROVED: DEPARTMENT OF PLANNING AND ZONING
10-5-20
CHIEF, DEVELOPMENT ENGINEERING DIVISION
CHIEF, DIVISION OF LAND DEVELOPMENT
DIRECTOR
10/27/20



NO.	DATE	REVISION
<p>BENCHMARK ENGINEERS & LAND SURVEYORS & PLANNERS ENGINEERING, INC. 8480 BALTIMORE NATIONAL PIKE & SUITE 315 & ELLICOTT CITY, MARYLAND 21043 (P) 410-485-6105 (F) 410-485-8844 WWW.BEI-CIVILENGINEERING.COM</p>		
<p>Professional Certification. I hereby certify that these documents were prepared or approved by me, and that I am a duly licensed professional engineer under the laws of the State of Maryland. License No. 21463, Expiration Date: 12/31/24</p>		
<p>OWNER: MANGIONE ENTERPRISES OF TURF VALLEY, LIMITED PARTNERSHIP 1205 YORK ROAD, PENTHOUSE LUTHERVILLE, MARYLAND 21093 410-825-8400</p>		<p>RESIDENTIAL - SINGLE FAMILY ATTACHED AND MULTI-FAMILY RAVENWOOD CONDOMINIUMS AT TURF VALLEY LOTS 1 thru 7 AND BUILDABLE BULK PARCEL 'AA'</p>
<p>BUILDER: NV HOMES 9720 PATUXENT WOODS DRIVE COLUMBIA, MARYLAND 21046 410-379-3385</p>		<p>TAX MAP: 17, PARCEL: 706, GRID: 13 ELECTION DISTRICT NO. 2 - HOWARD COUNTY, MARYLAND ZONED: PGOCC</p>
<p>STORMWATER MANAGEMENT DETAILS CONDOMINIUMS</p>		
DATE: AUGUST 27, 2020	BEI PROJECT NO. 2931	
DESIGN: DBT	DRAFT: DBT	SCALE: AS SHOWN SHEET 7 OF 23

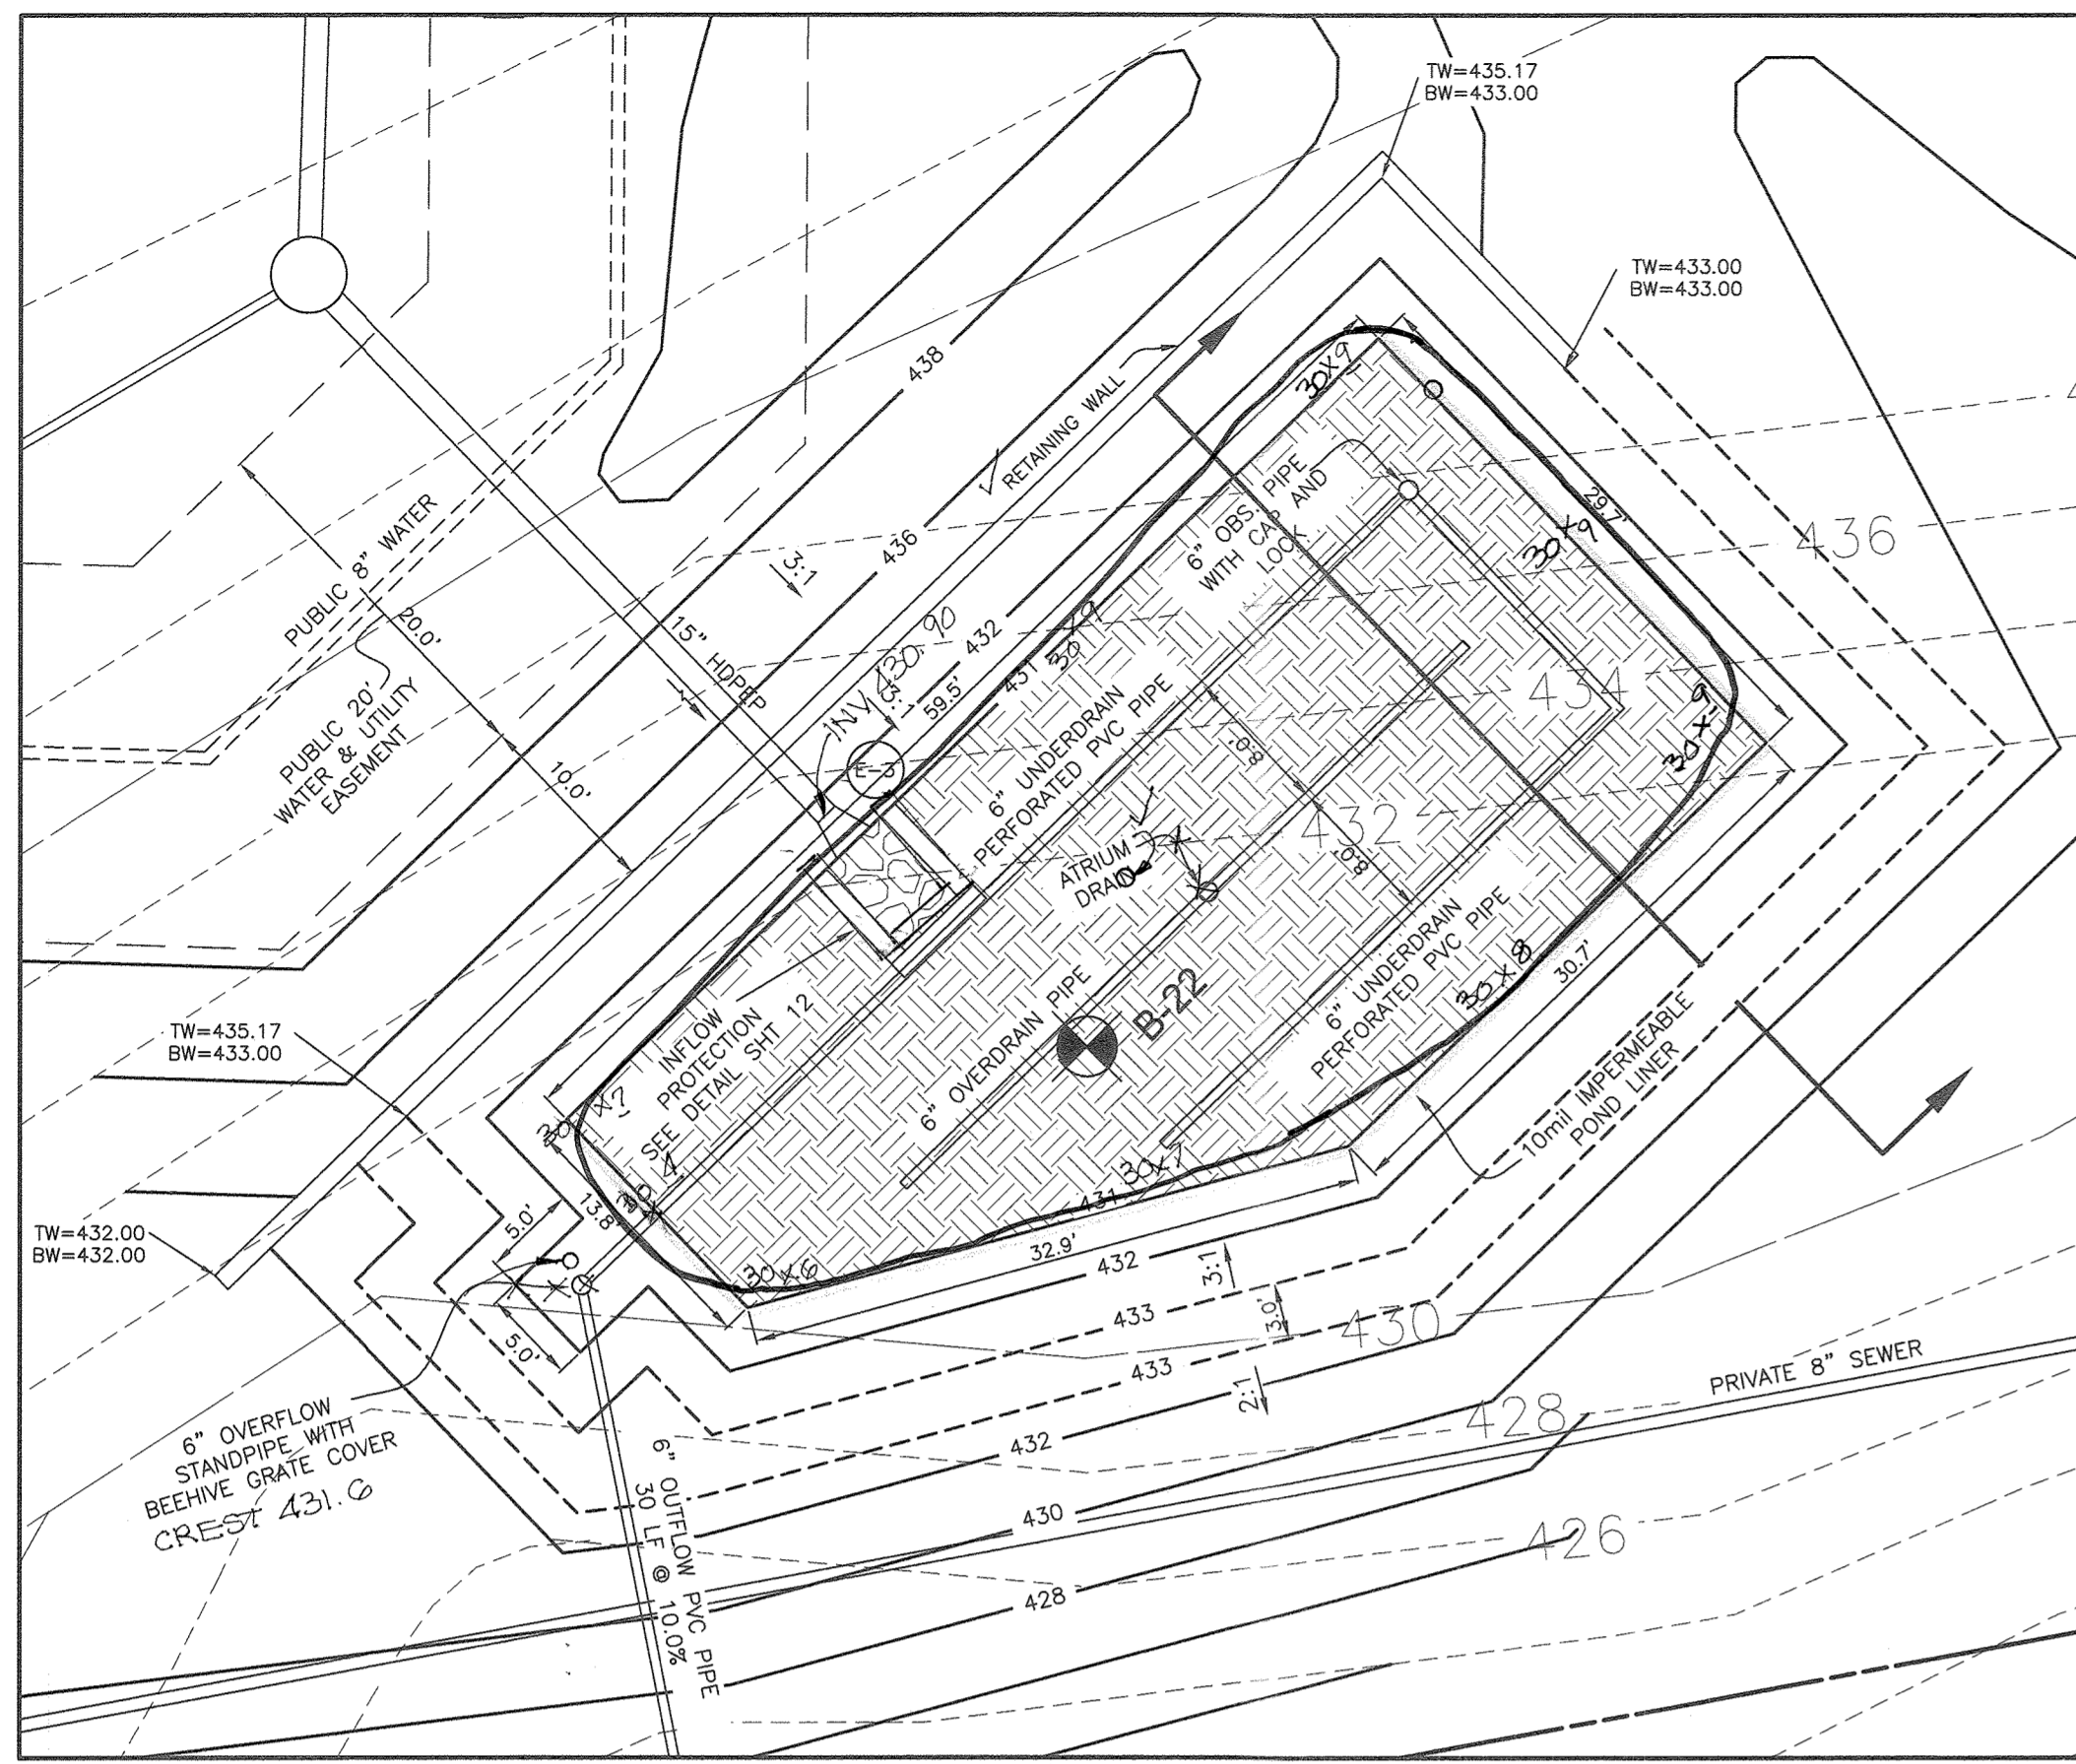


(M-6) MICRO BIO-RETENTION #3

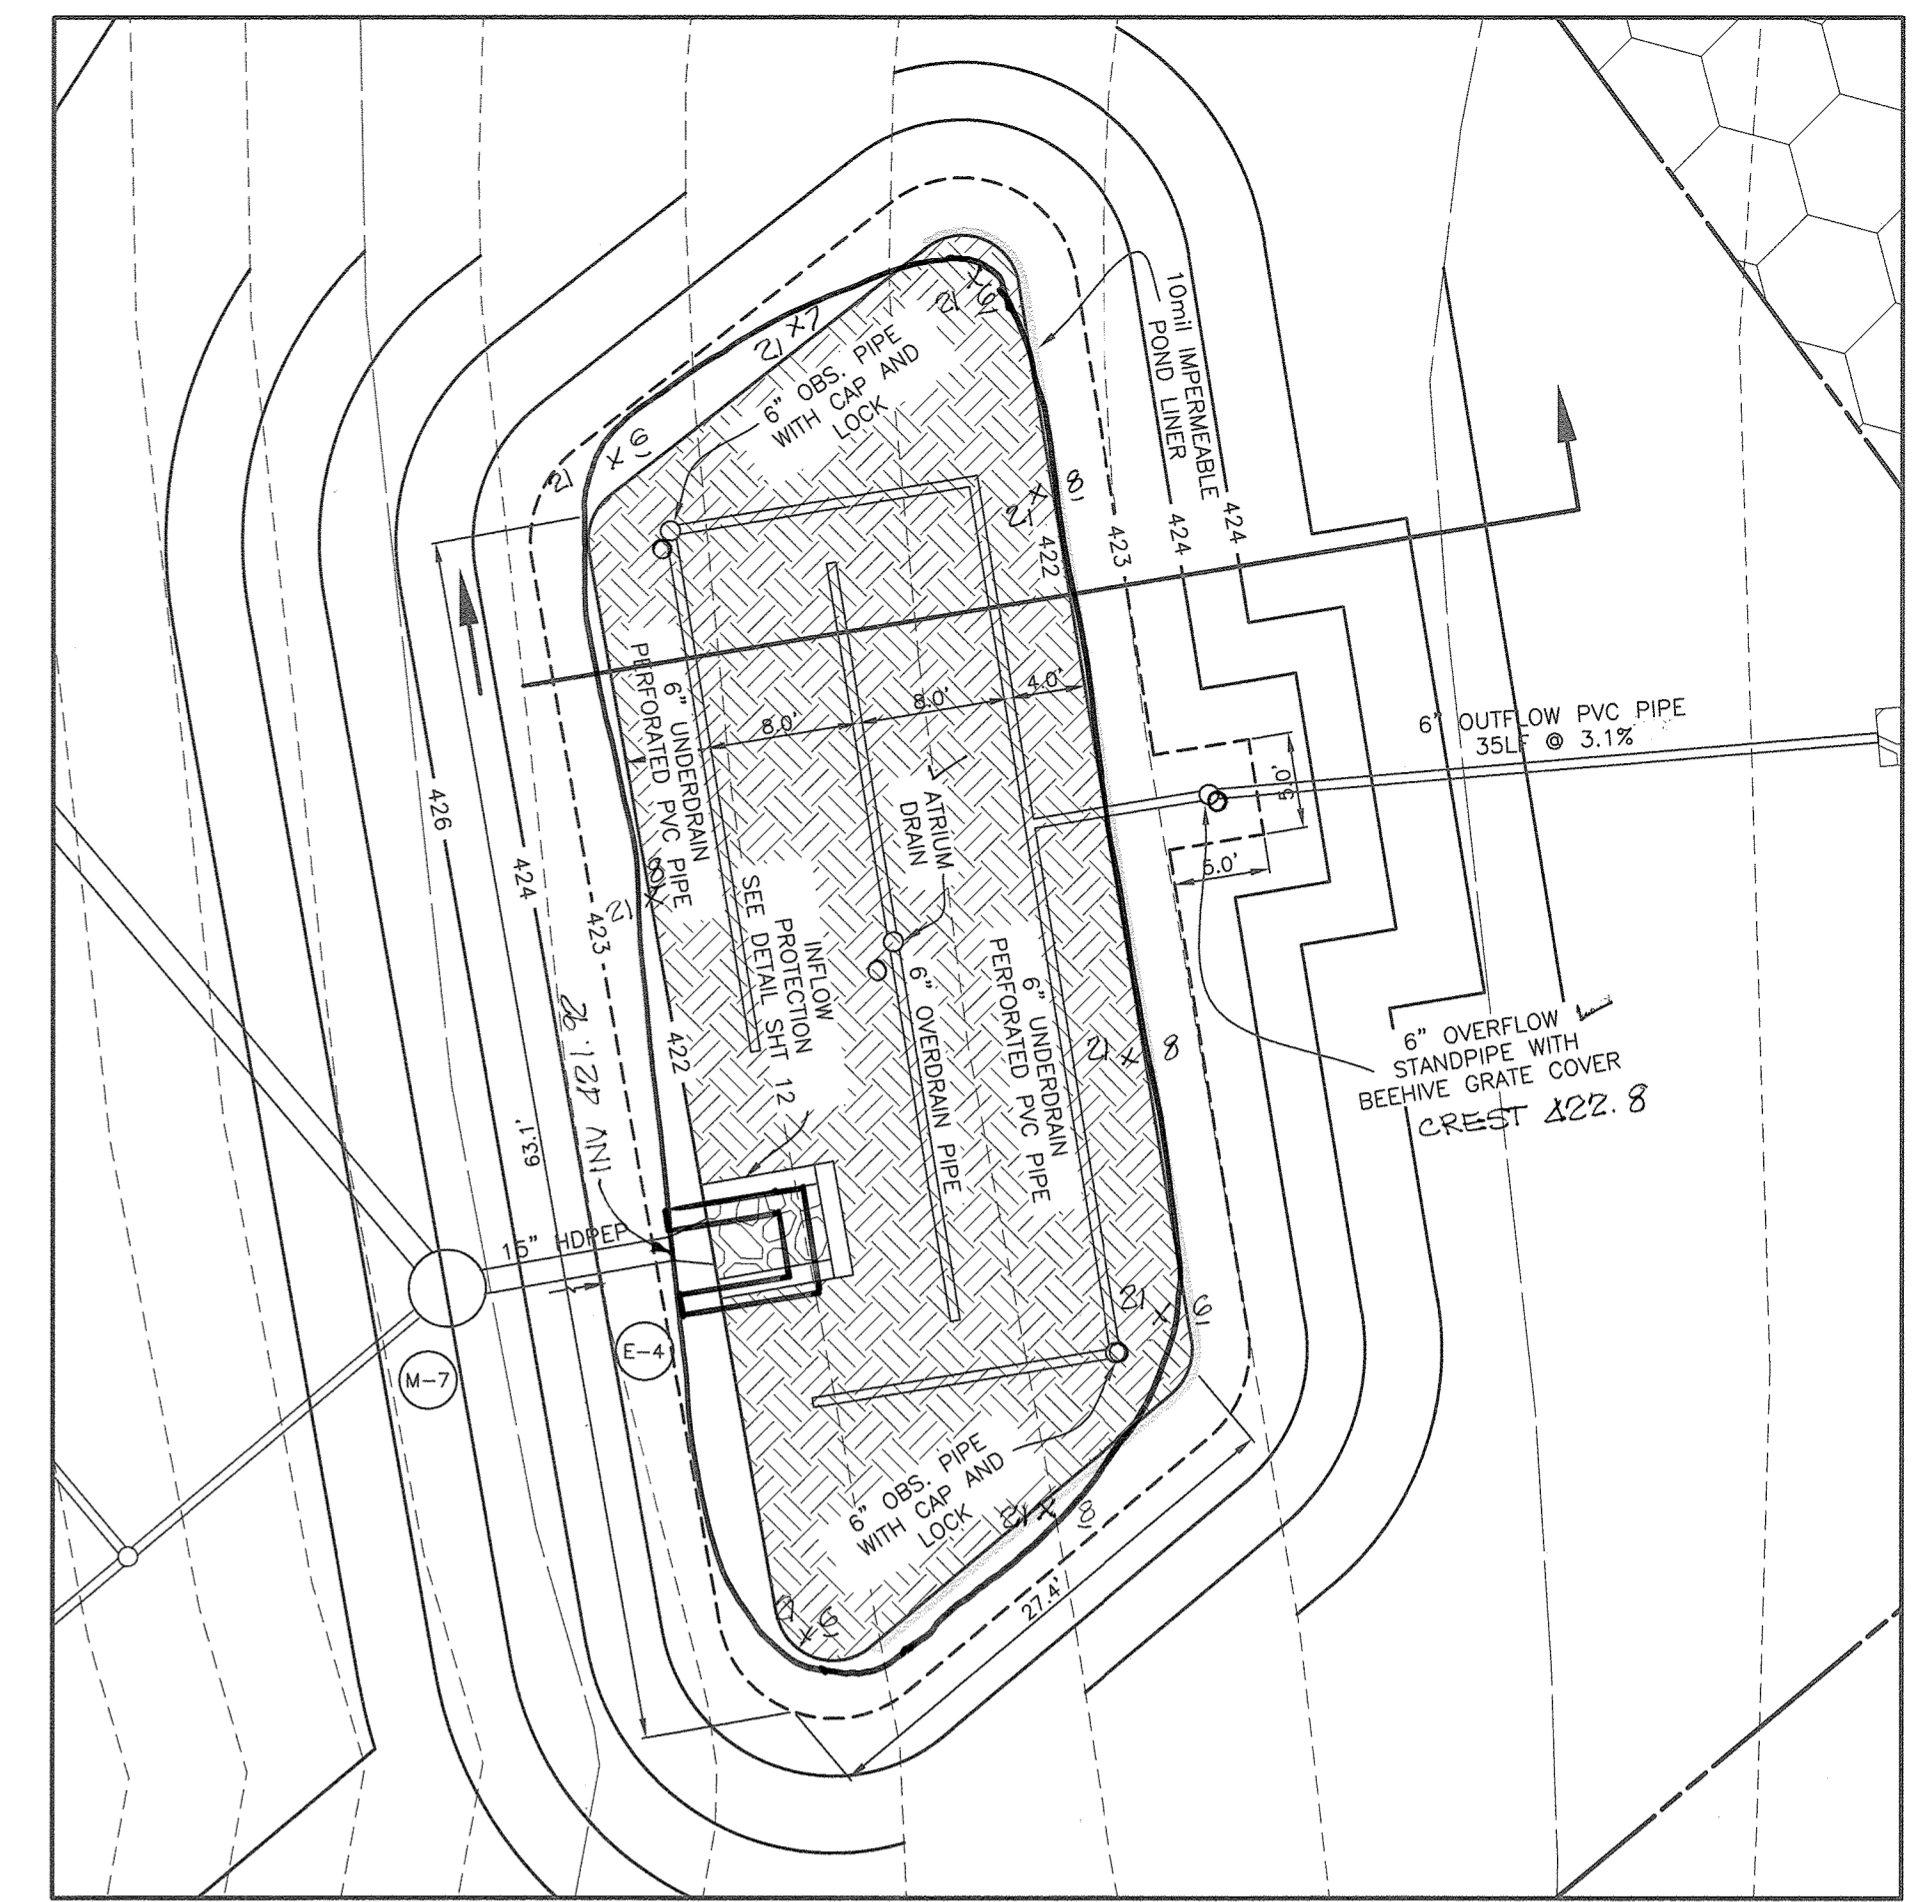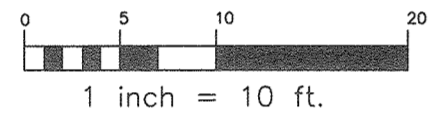


(M-6) MICRO BIO-RETENTION #4

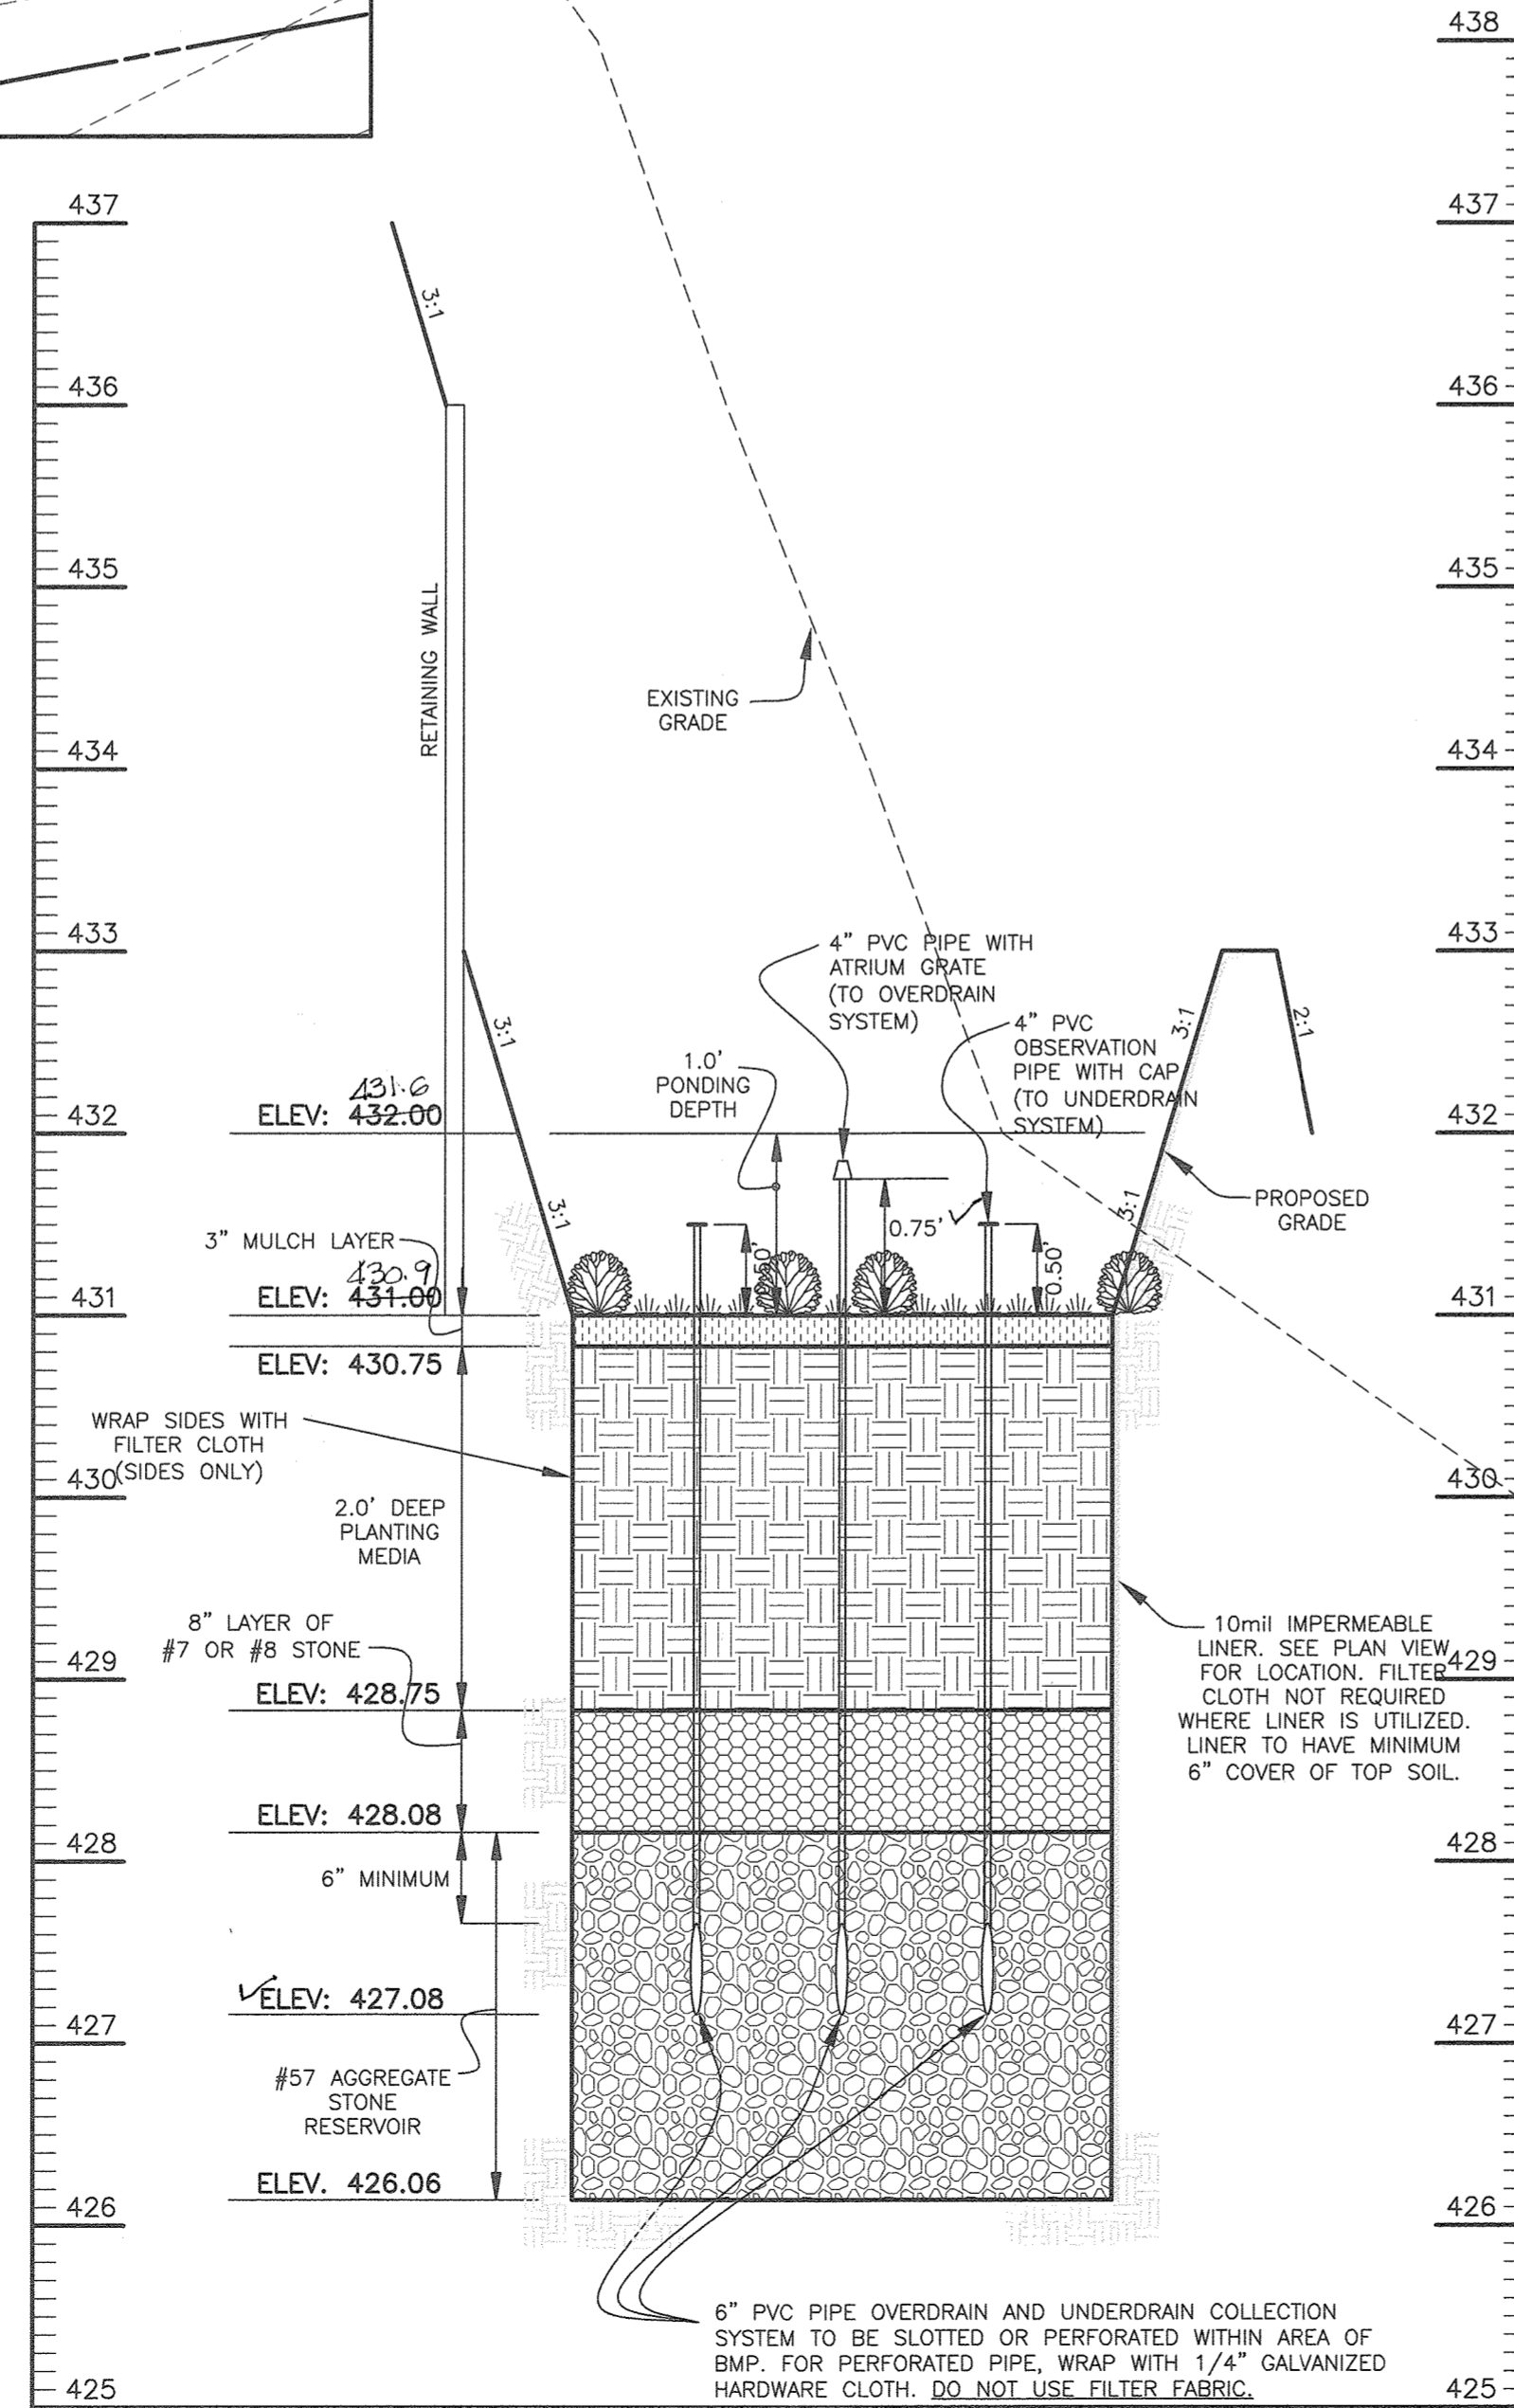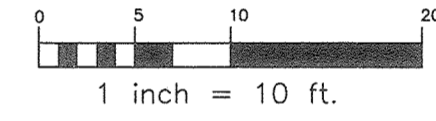

(M-6) MICRO BIO-RETENTION #3
CROSS SECTION
SCALE: 1"=20'H; 1"=2'V

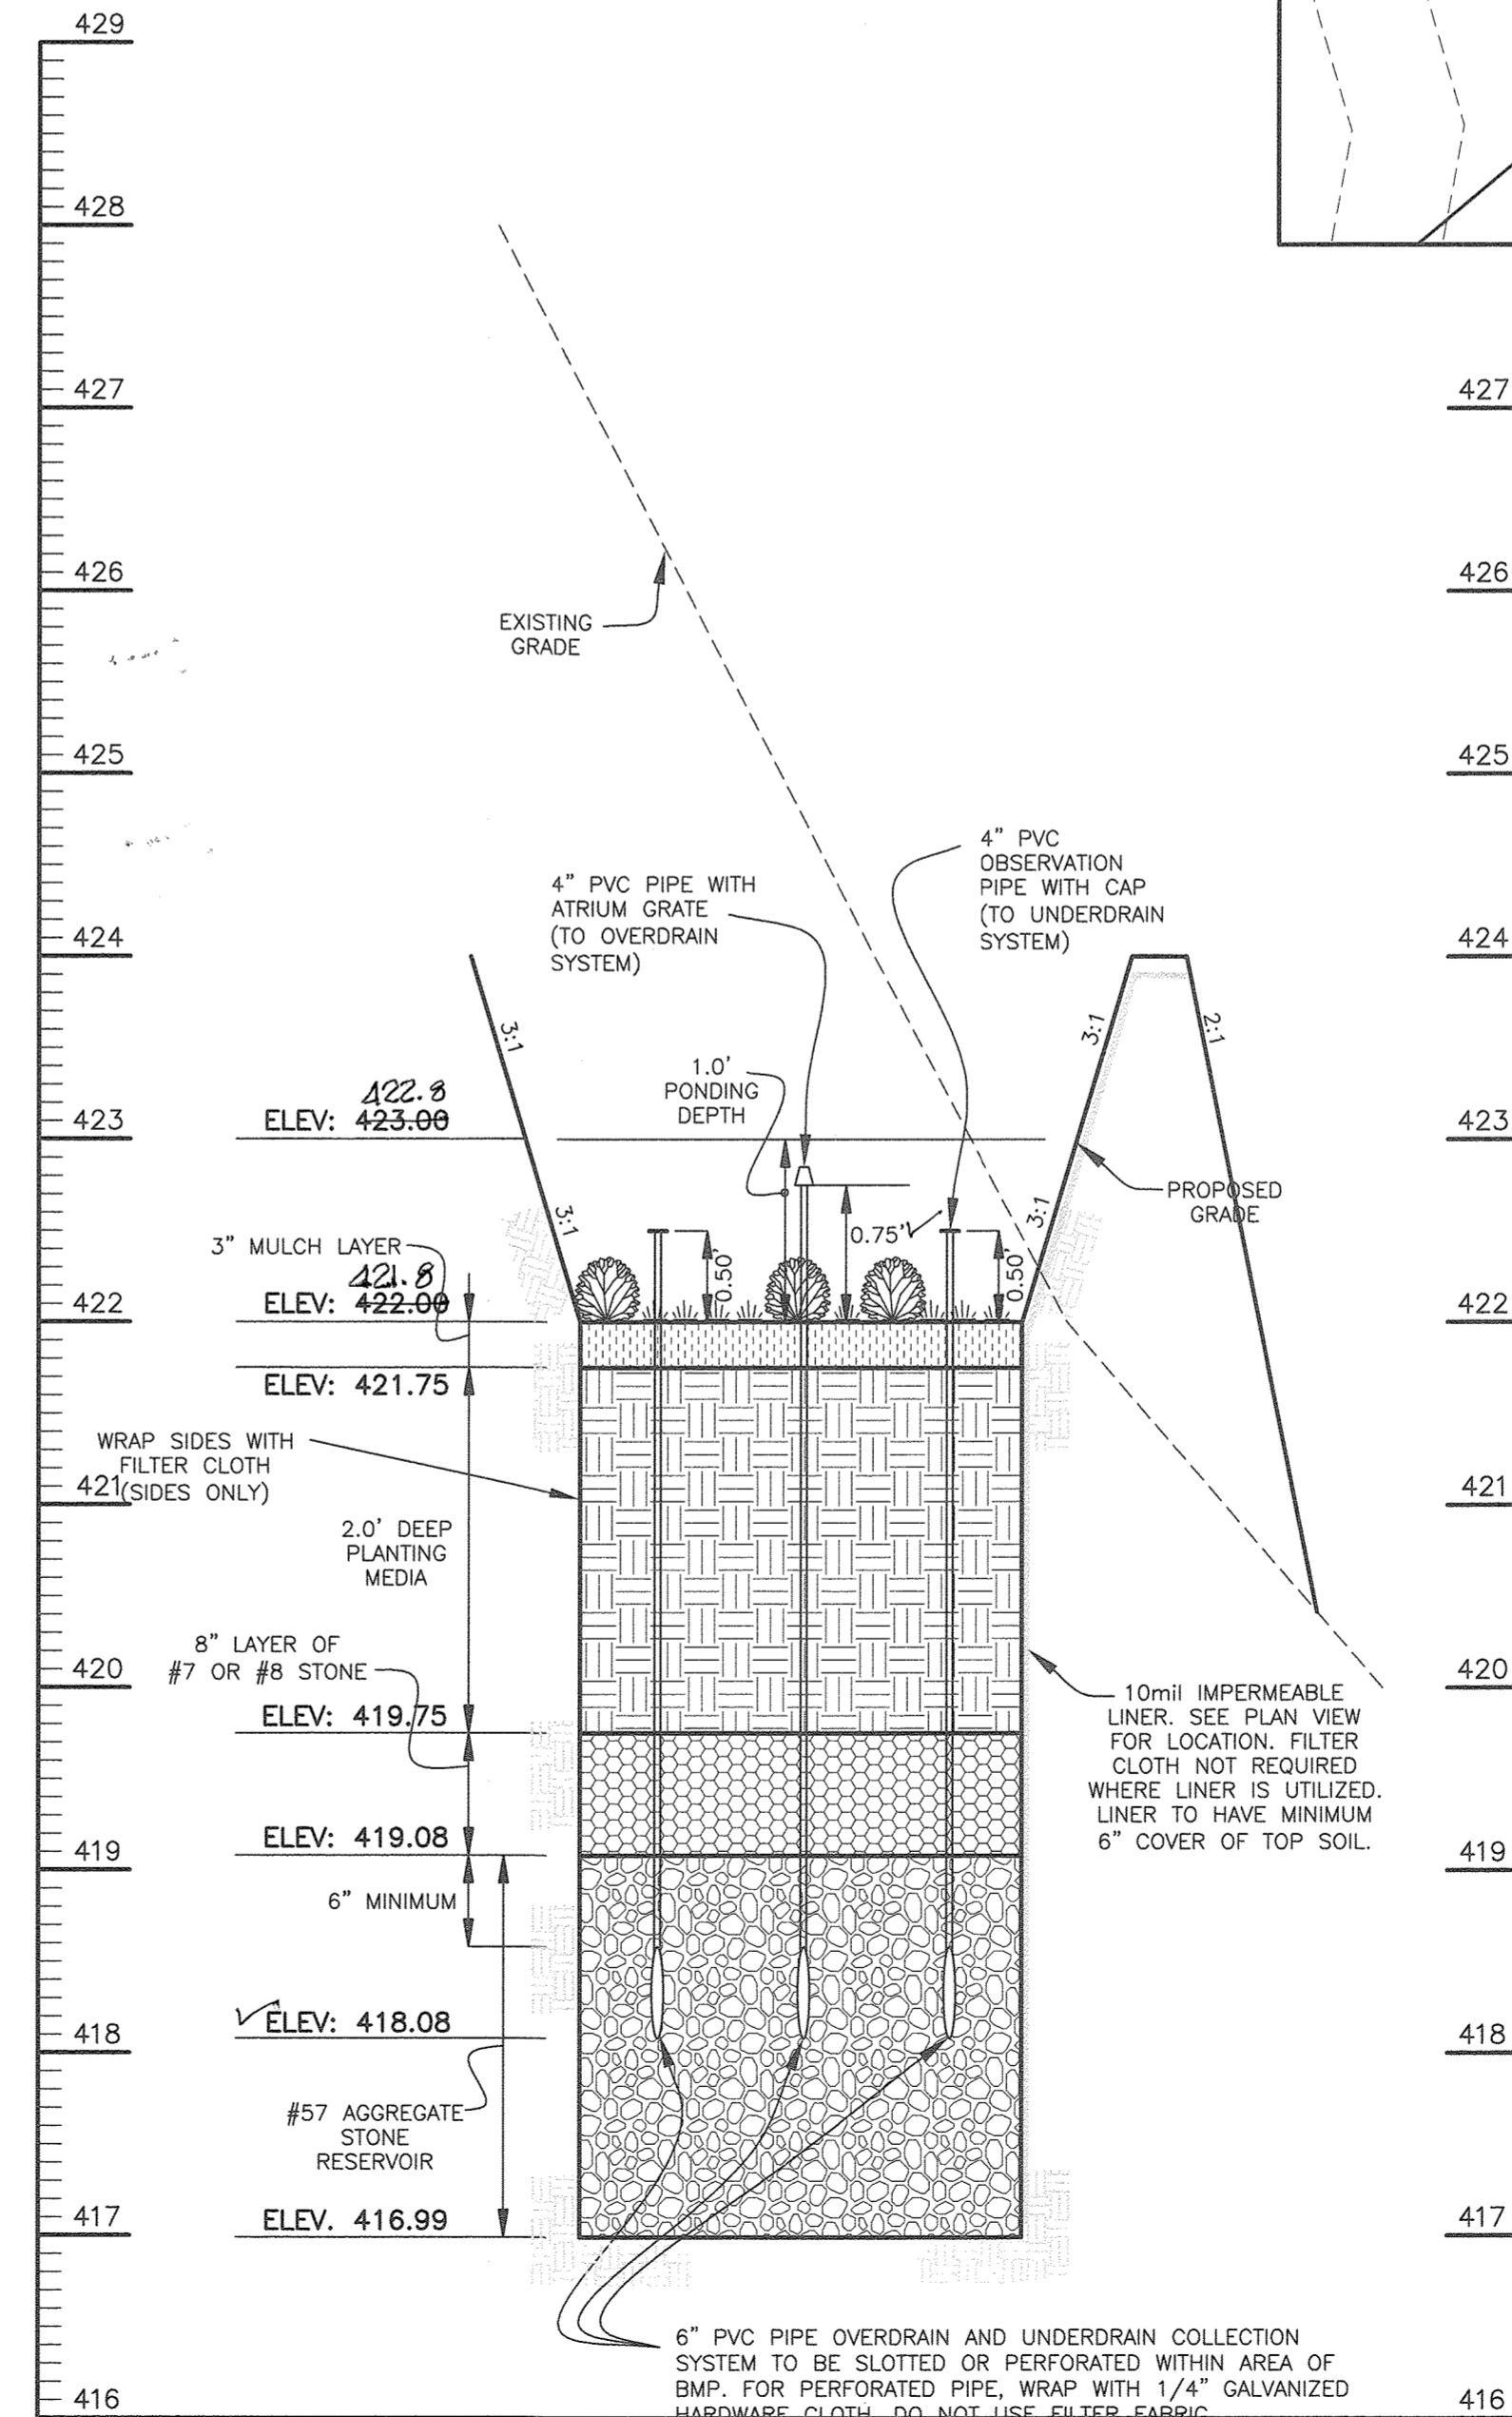

(M-6) MICRO BIO-RETENTION #4
CROSS SECTION
SCALE: 1"=20'H; 1"=2'V

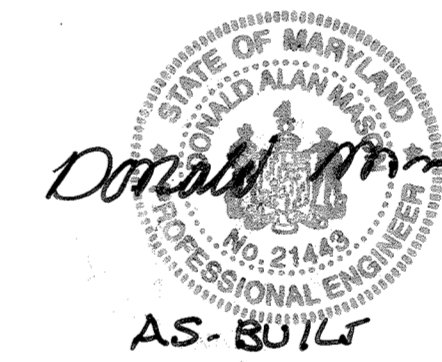

Professional Certification. I hereby certify that these documents were prepared or approved by me, and that I am a duly licensed professional engineer under the laws of the State of Maryland.
License No. 21443 Expiration Date: 12-21-24

AS-BUILT

I hereby certify, by my seal, that to the best of my knowledge and belief the facilities shown on this "AS-BUILT" Plan meet the Approved Plans and Specifications




Donald Mason, P.E.

Date: 5/21/24


NOTES:

1. TOP OF GABION BASKETS TO BE SET AT PONDING ELEVATION OR 1-FOOT ABOVE SURFACE ELEVATION OF MICRO BIO-RETENTION.
2. BEEHIVE GRATES TO BE NDS 6" ROUND GRATE, GREEN, OR EQUIVALENT.

APPROVED
PLANNING BOARD OF HOWARD COUNTY
DATE AUGUST 20, 2020


APPROVED: HOWARD COUNTY DEPARTMENT OF PLANNING AND ZONING
 10/5/20
 CHIEF, DEVELOPMENT ENGINEERING DIVISION DATE
 10/28/20
 CHIEF, DIVISION OF LAND DEVELOPMENT DATE
 10/29/20
 DIRECTOR DATE

NO.	DATE	REVISION



BENCHMARK ENGINEERS & LAND SURVEYORS & PLANNERS 8480 BALTIMORE NATIONAL PIKE & SUITE 315 A ELLICOTT CITY, MARYLAND 21043 (P) 410-465-6105 (F) 410-465-8644 WWW.BEI-CIVILENGINEERING.COM		
OWNER: MANGIONE ENTERPRISES OF TURF VALLEY, LIMITED PARTNERSHIP 1205 YORK ROAD, PENTHOUSE LUTHERVILLE, MARYLAND 21093 410-825-8400	RESIDENTIAL - SINGLE FAMILY ATTACHED AND MULTI-FAMILY RAVENWOOD CONDOMINIUMS AT TURF VALLEY LOTS 1 thru 7 AND BUILDABLE BULK PARCEL 'AA'	
BUILDER: NV HOMES 9720 PATUXENT WOODS DIVE COLUMBIA, MARYLAND 21046 410-379-3385	TAX MAP: 17, PARCEL: 706, GRID: 13 ELECTION DISTRICT NO. 2 - HOWARD COUNTY, MARYLAND ZONED: PGCC	
STORMWATER MANAGEMENT DETAILS CONDOMINIUMS		
DATE: AUGUST 27, 2020	BEI PROJECT NO. 2931	
DESIGN: DBT	DRAFT: DBT	SCALE: AS SHOWN
		SHEET 8 OF 23

AS-BUILT



SDP-20-036

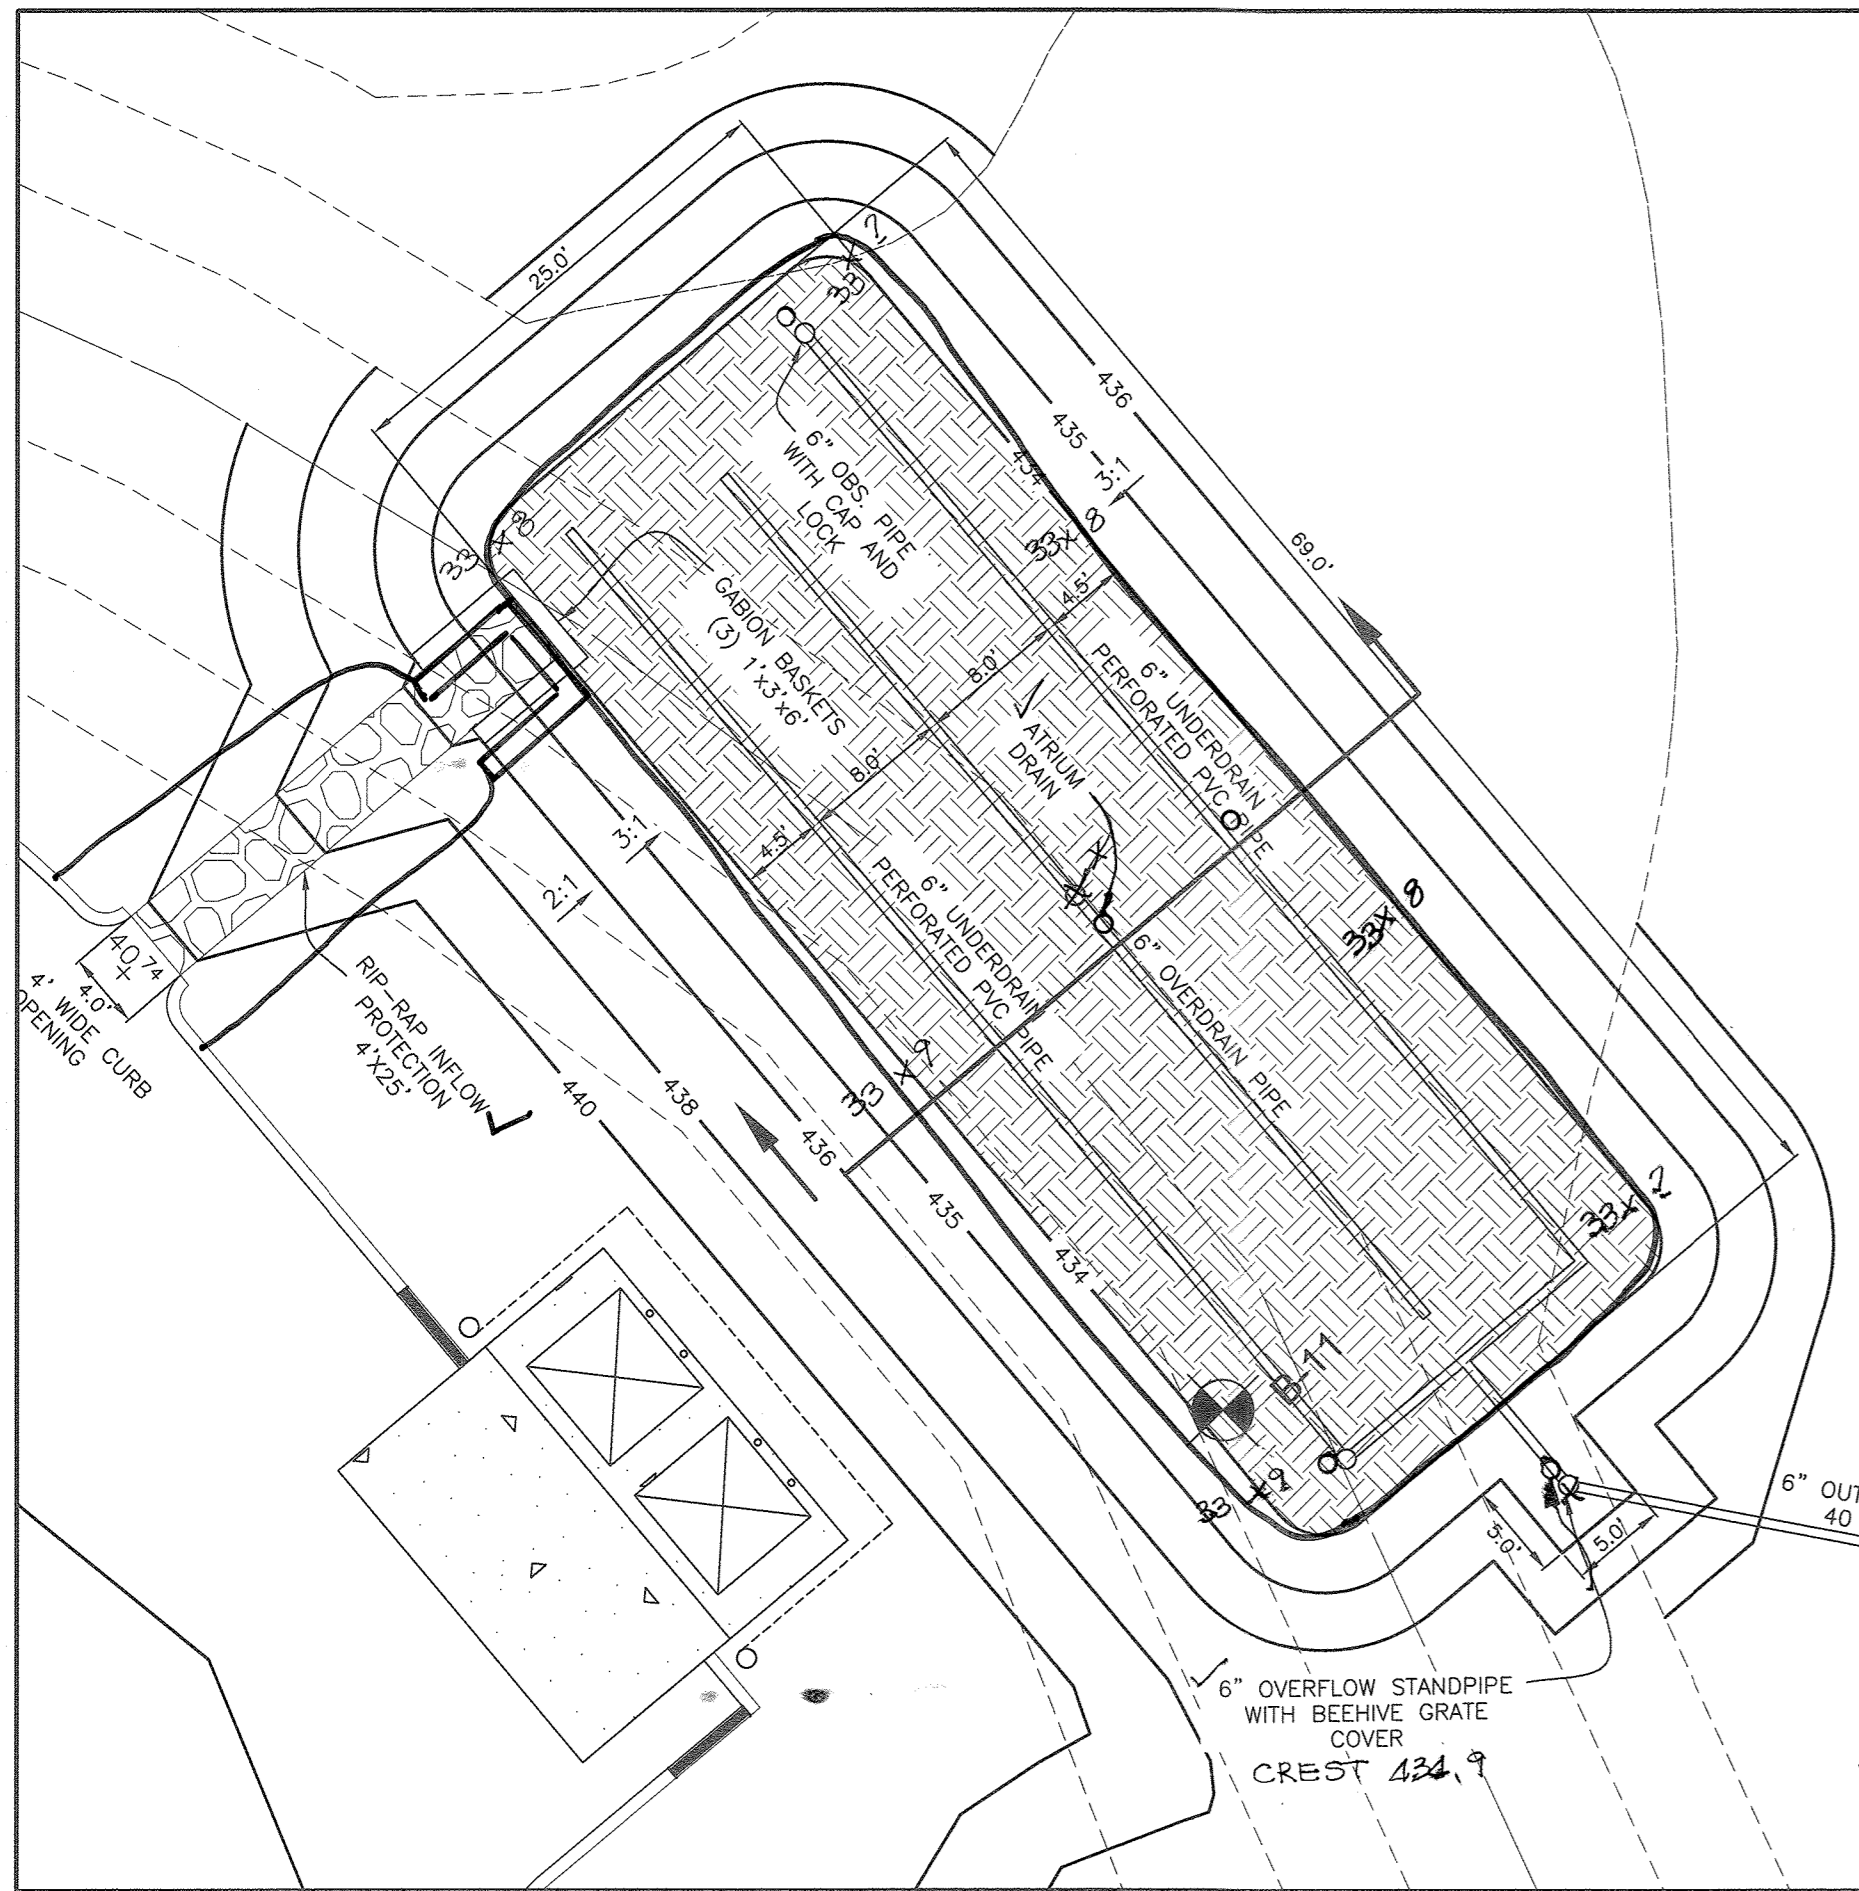


(M-6) MICRO BIO-RETENTION #5

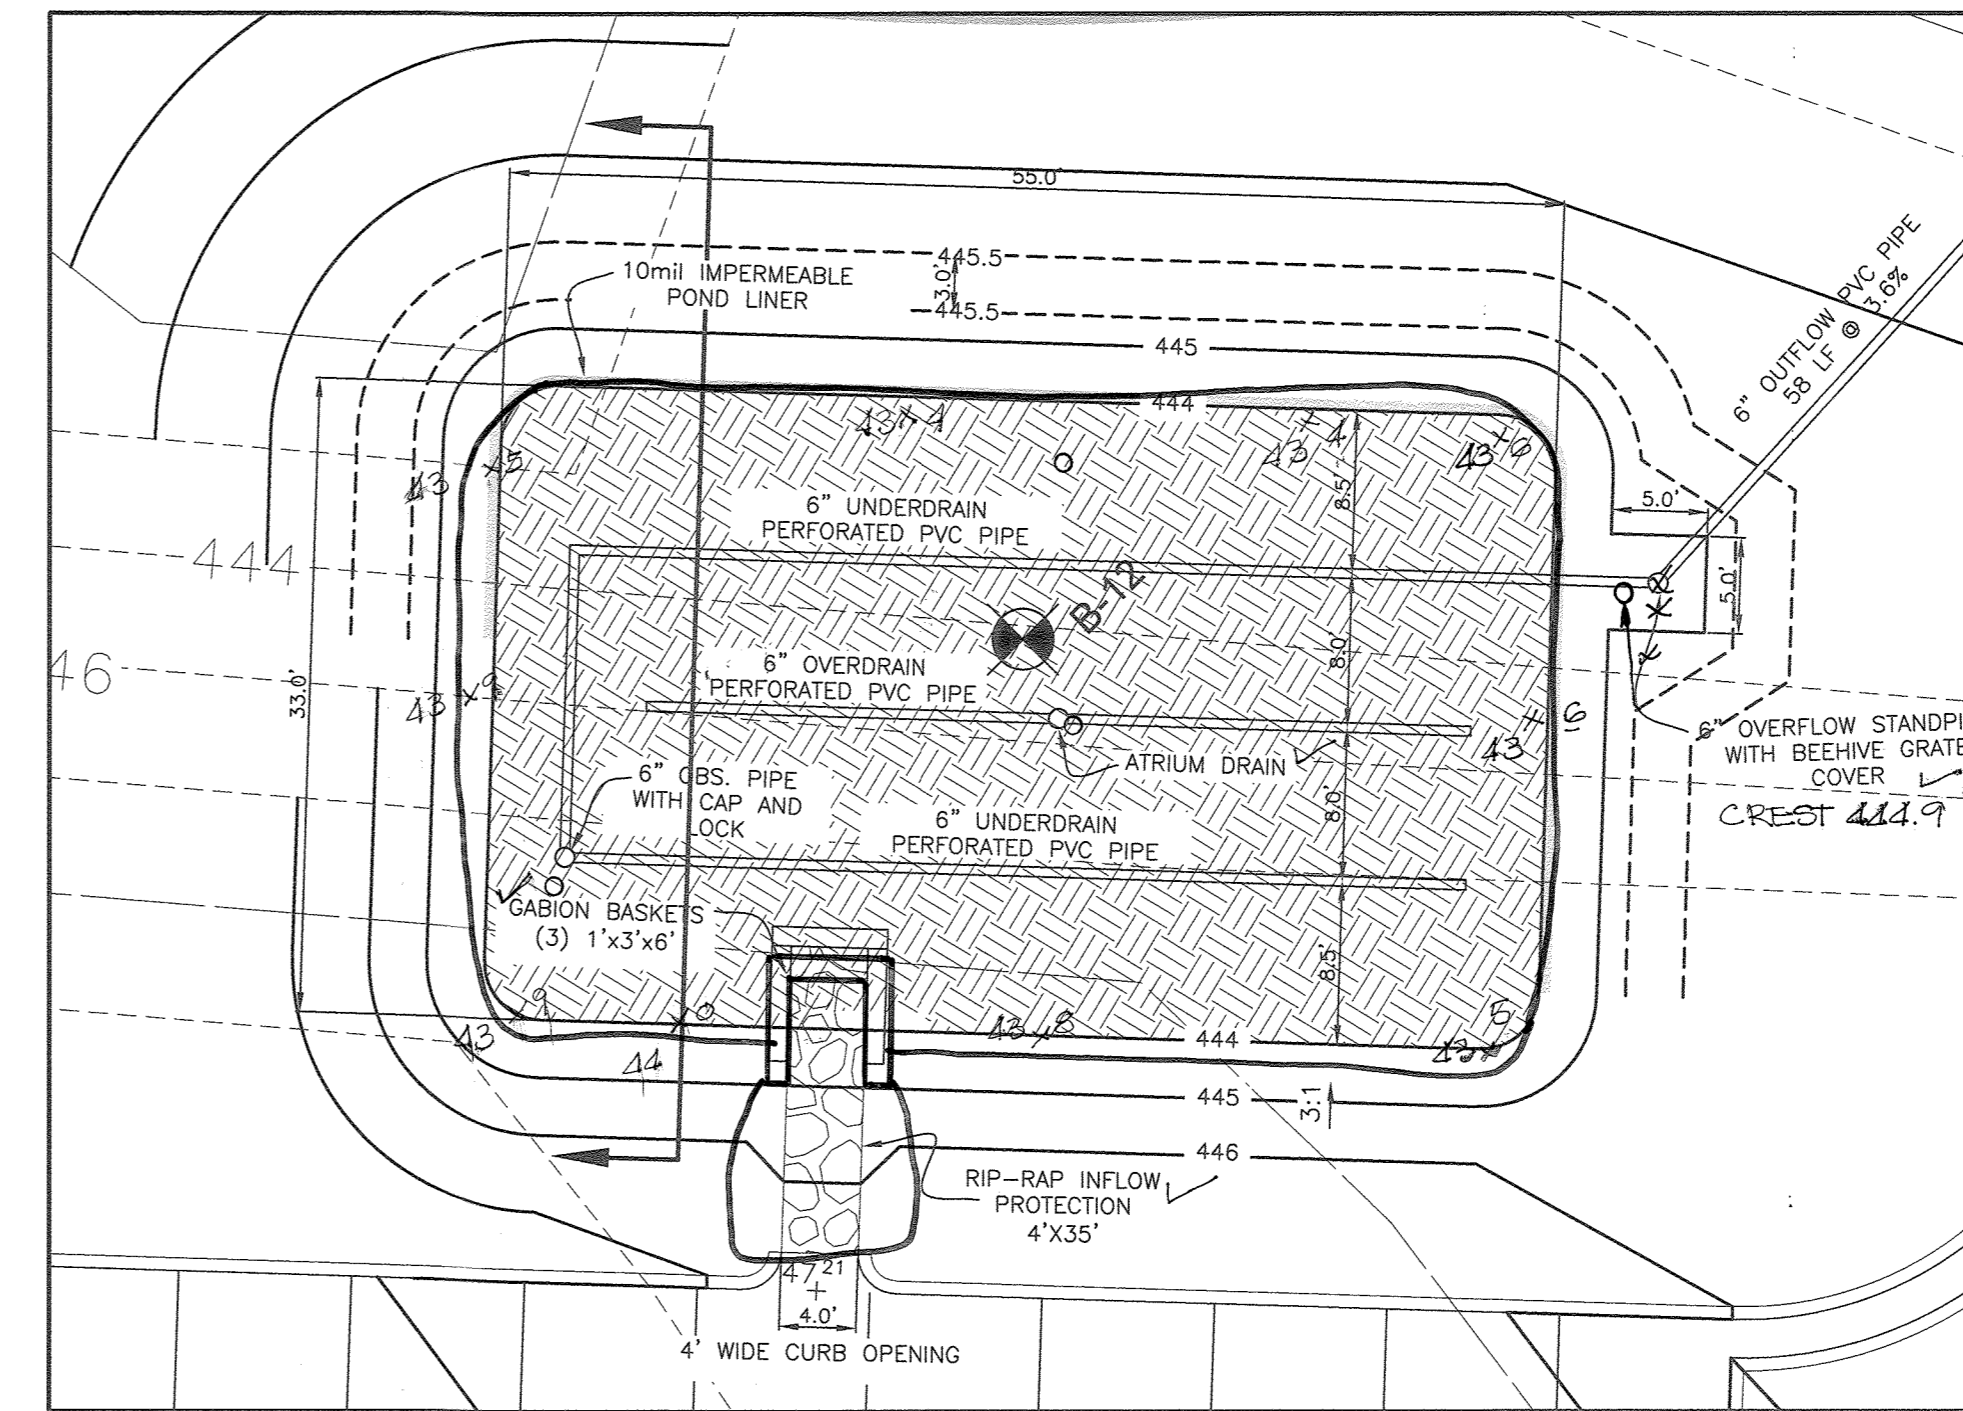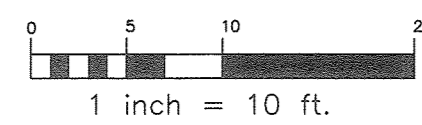

(M-6) MICRO BIO-RETENTION #6

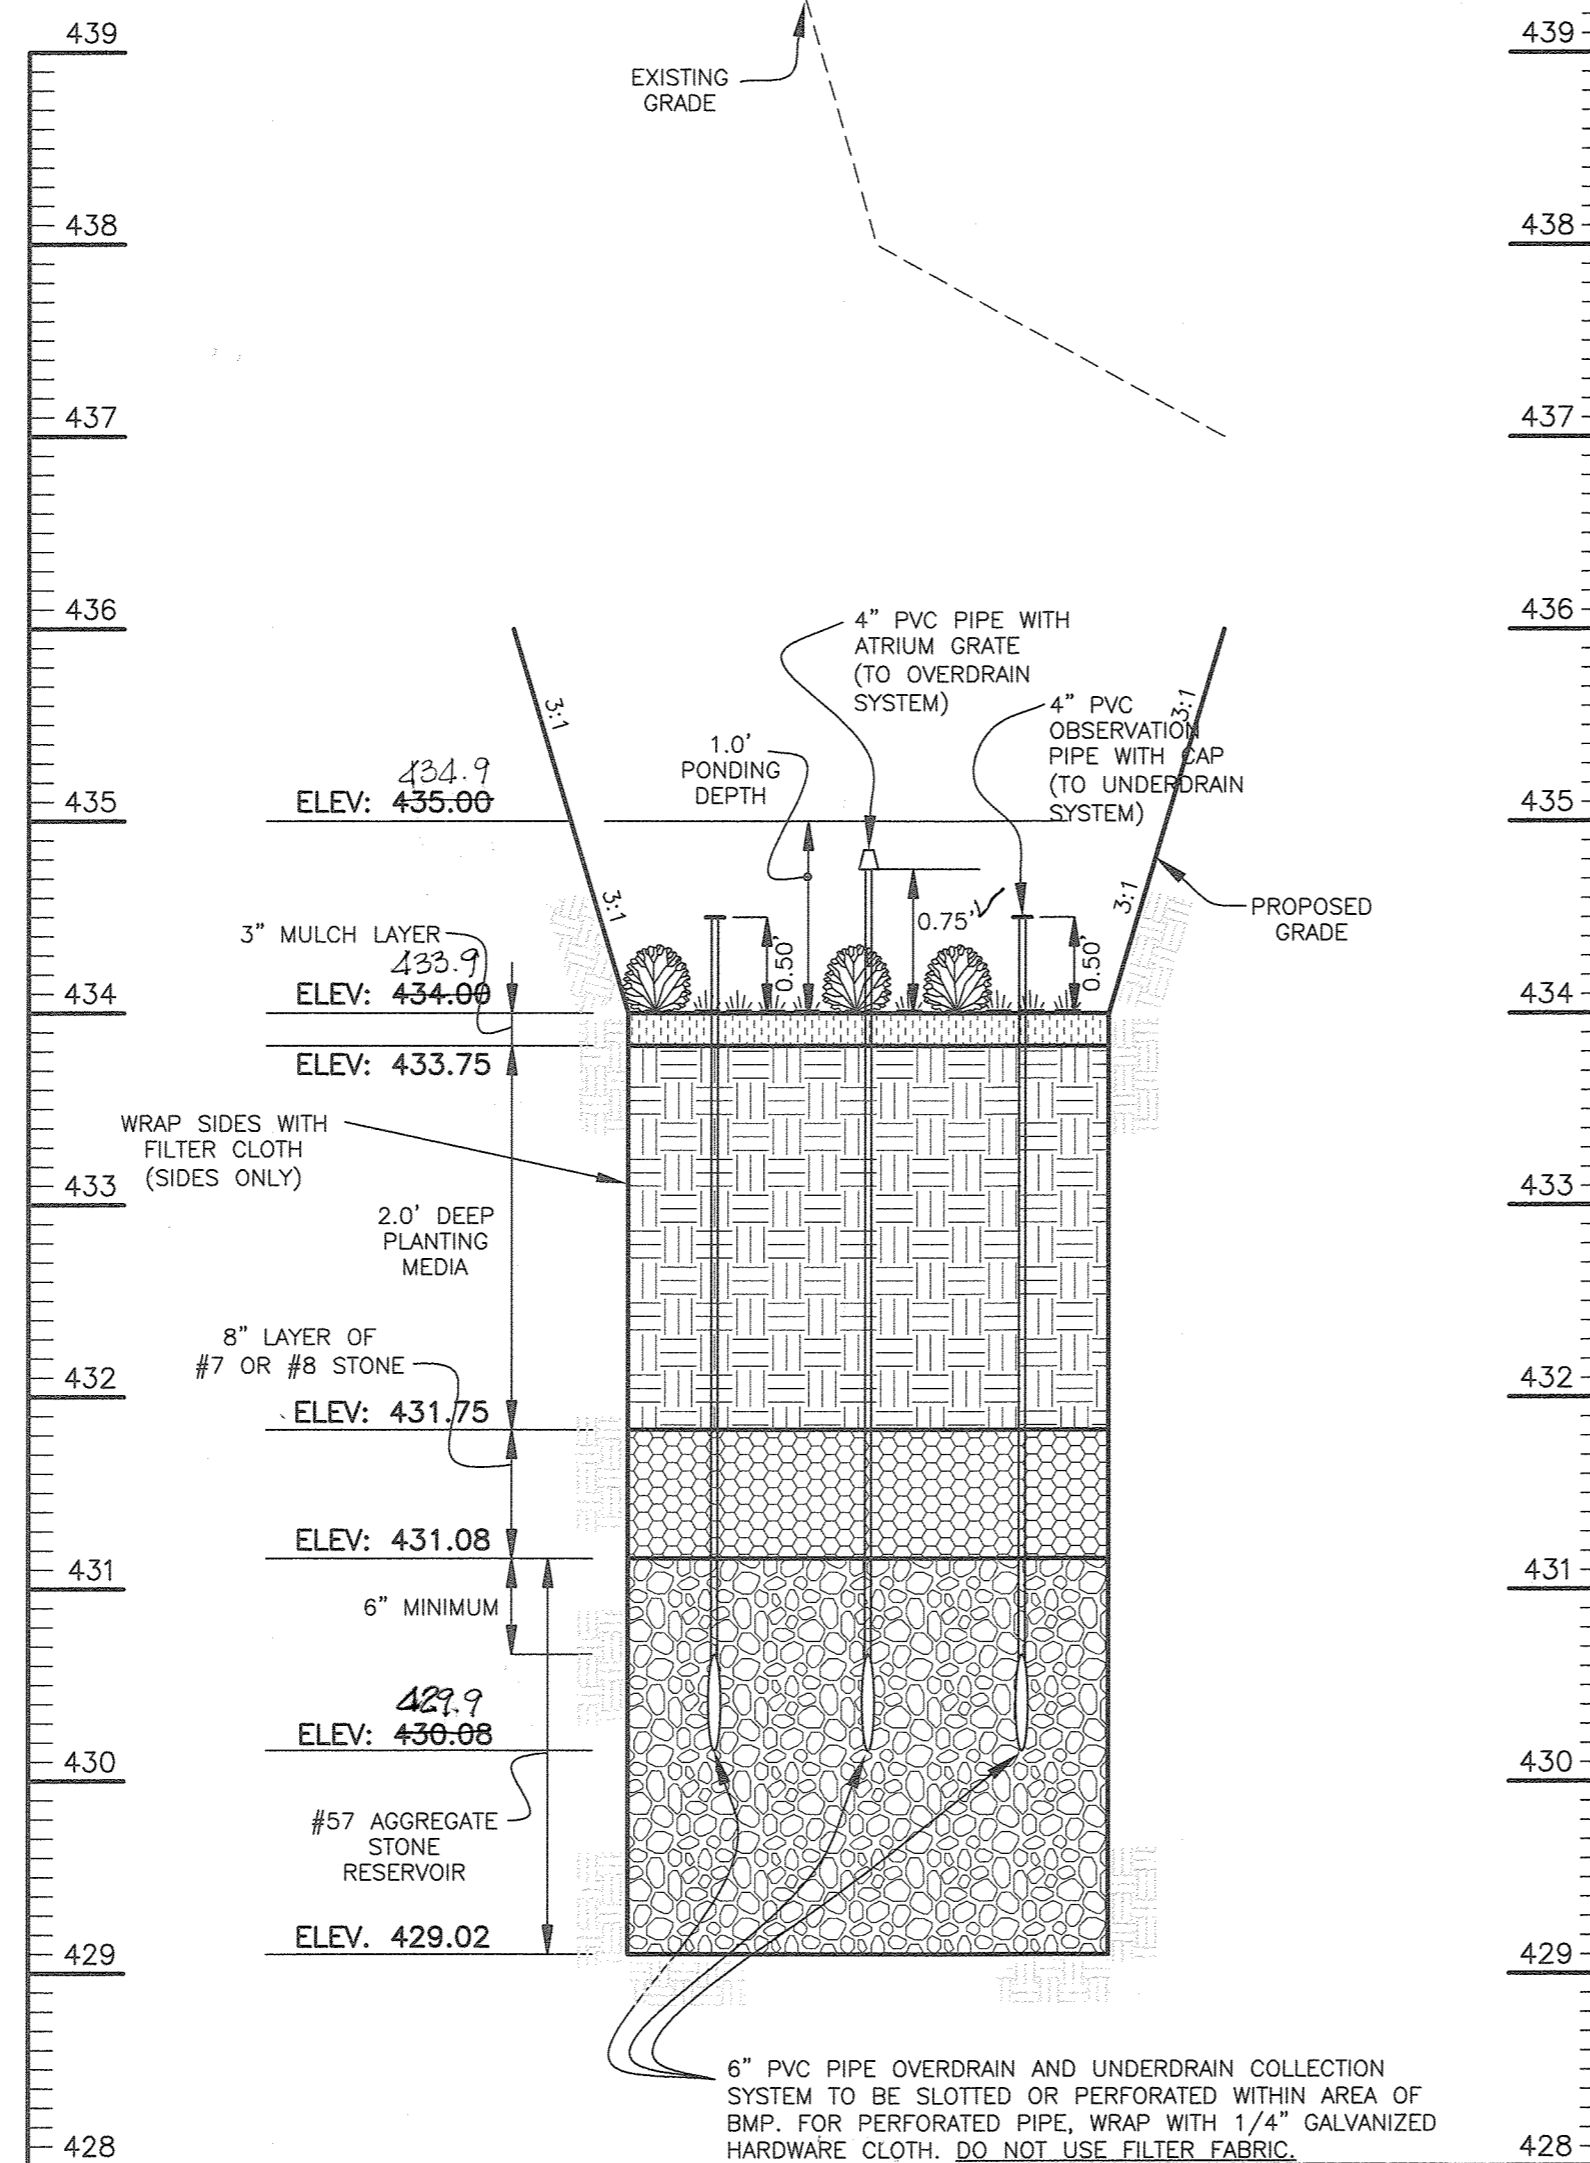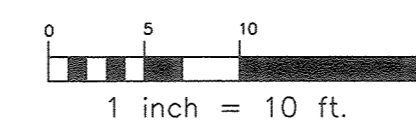

(M-6) MICRO BIO-RETENTION #5
CROSS SECTION
SCALE: 1"=20'H; 1"=2'V

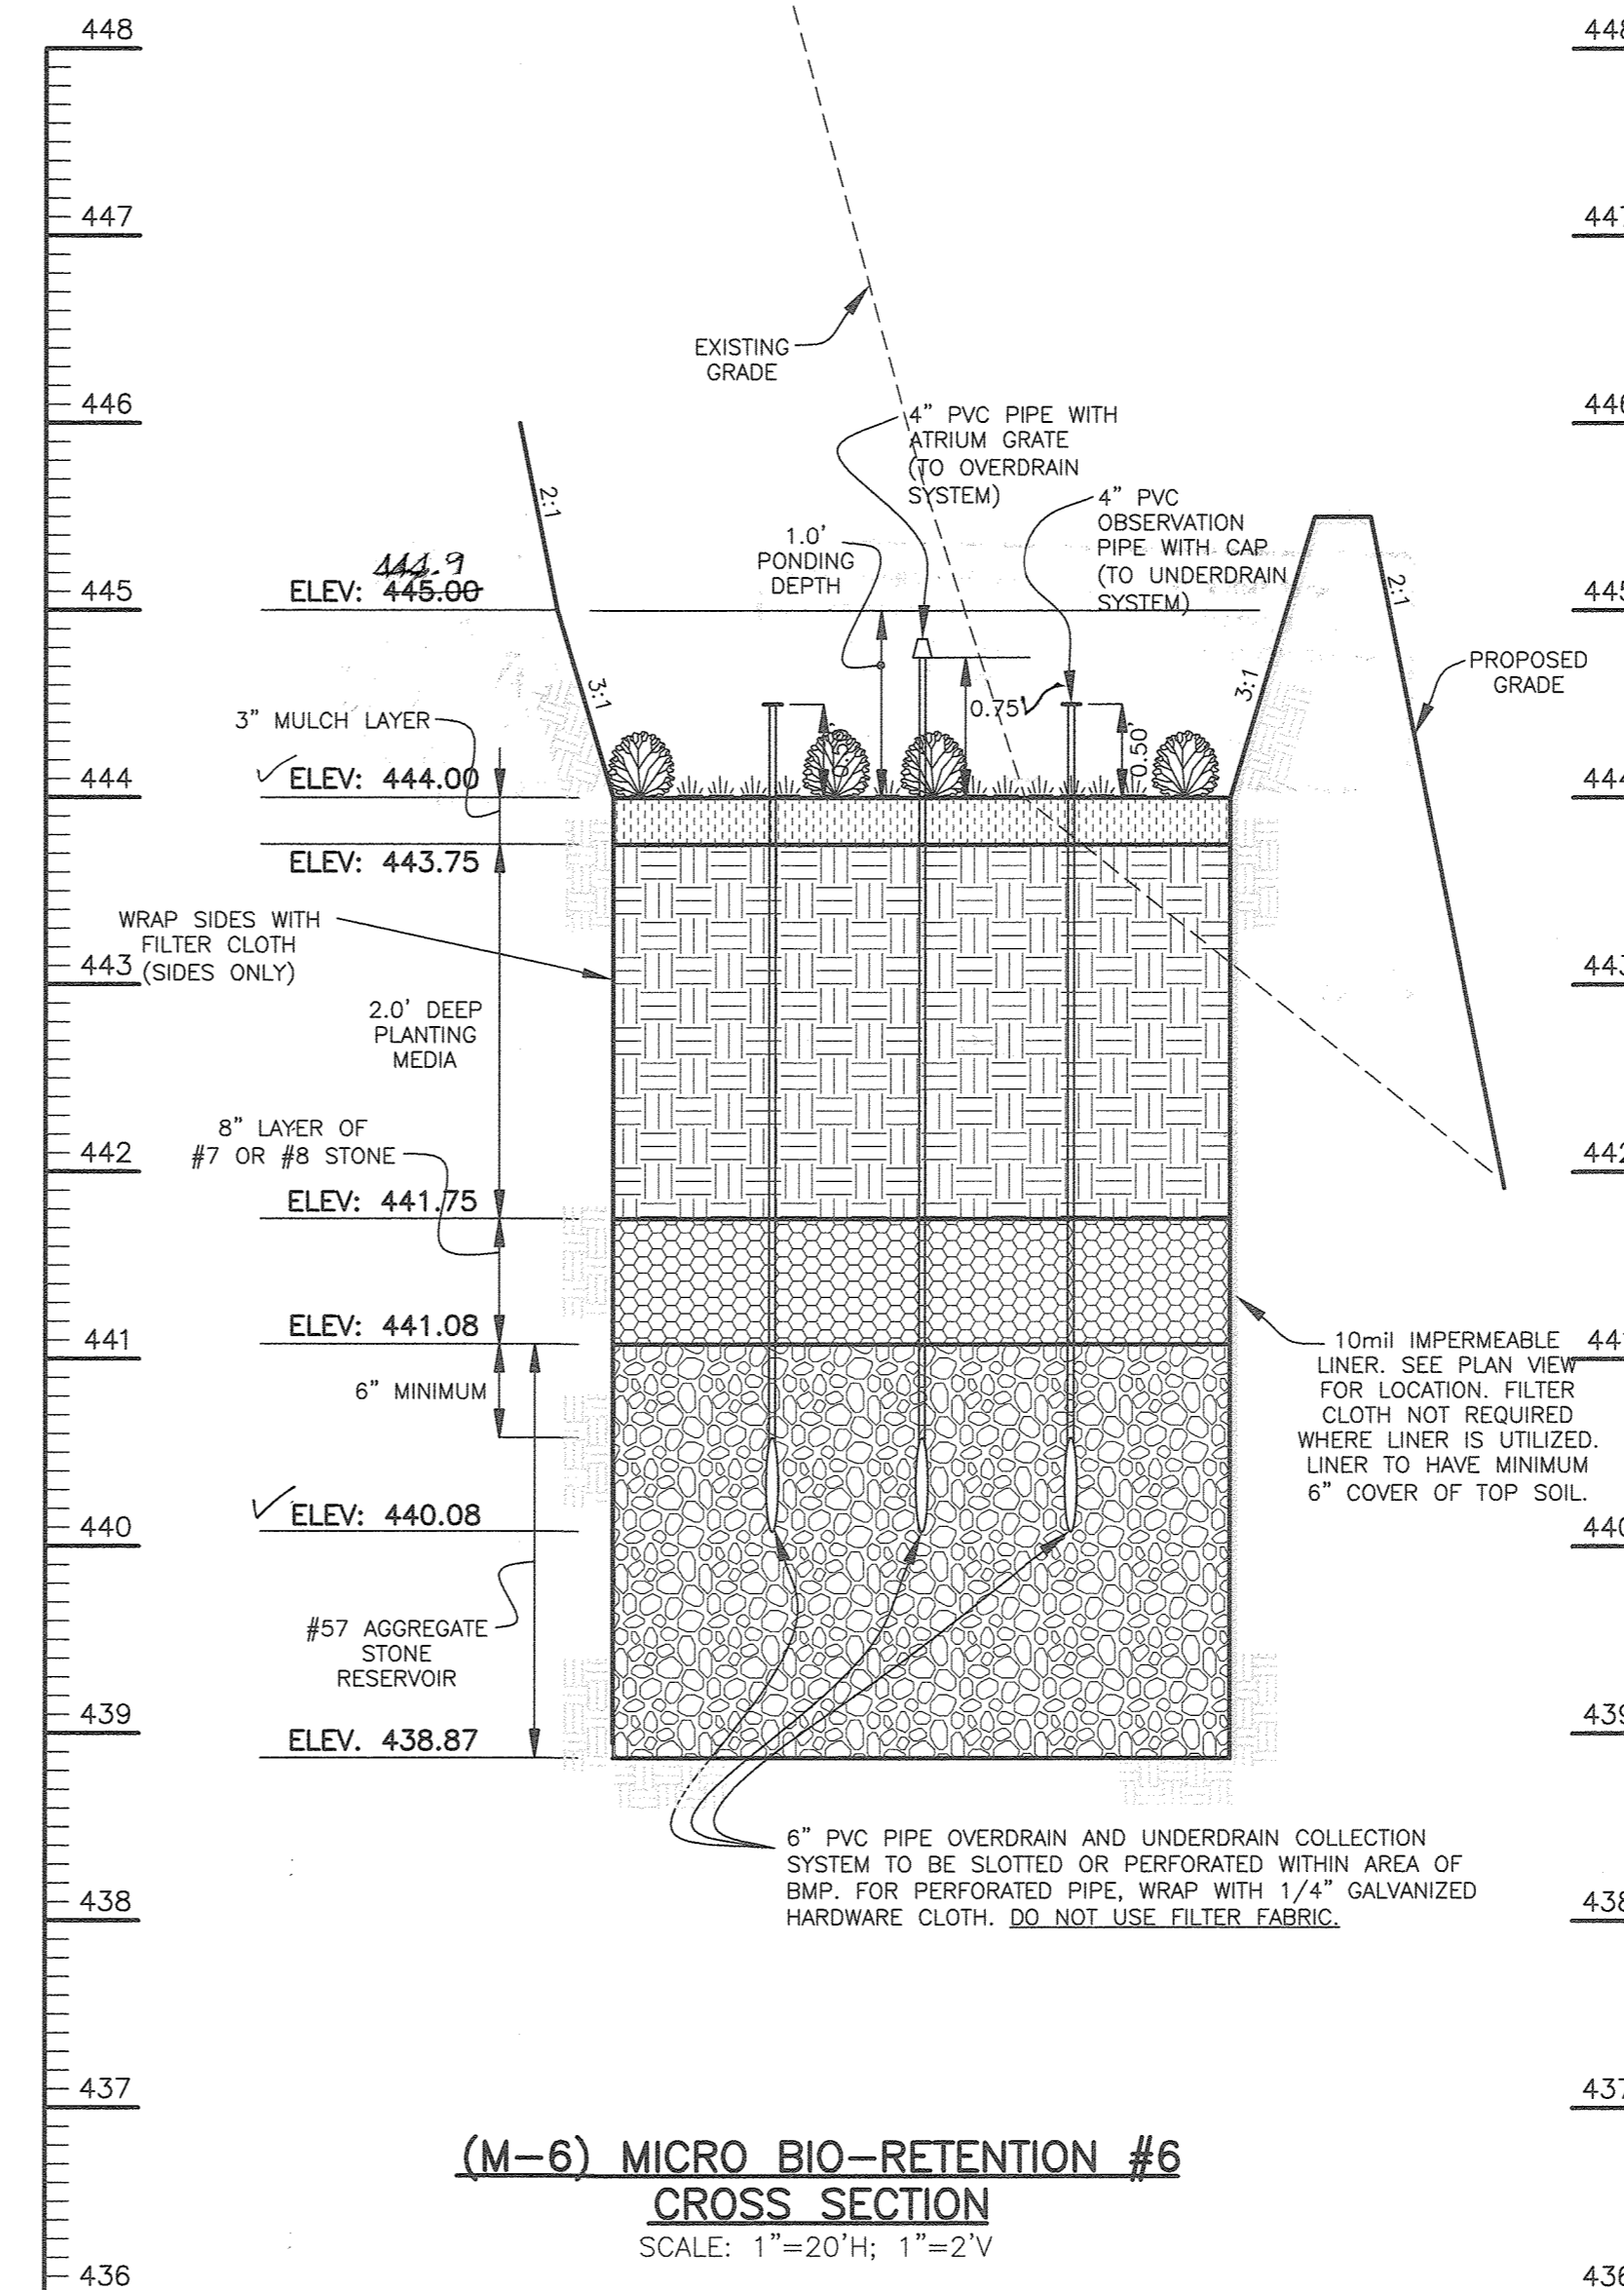

(M-6) MICRO BIO-RETENTION #6
CROSS SECTION
SCALE: 1"=20'H; 1"=2'V

APPROVED
PLANNING BOARD OF HOWARD COUNTY
DATE AUGUST 20, 2020

APPROVED: HOWARD COUNTY DEPARTMENT OF PLANNING AND ZONING
[Signature] 10/5/20
 CHIEF, DEVELOPMENT ENGINEERING DIVISION DATE
[Signature] 10/28/20
 CHIEF, DIVISION OF LAND DEVELOPMENT DATE
[Signature] 10/29/20
 DIRECTOR DATE



AS-BUILT

Professional Certification. I hereby certify that these documents were prepared or approved by me, and that I am a duly licensed professional engineer under the laws of the State of Maryland.
 License No. 21443, Expiration Date: 12-31-24

AS-BUILT CERTIFICATION
 I hereby certify, by my seal, that to the best of my knowledge and belief the facilities shown on this "AS-BUILT" Plan meet the Approved Plans and Specifications
 Donald Mason, P.E. Date: 5/21/24

NOTES:

- TOP OF GABIION BASKETS TO BE SET AT PONDING ELEVATION OR 1-FOOT ABOVE SURFACE ELEVATION OF MICRO BIO-RETENTION.
- BEEHIVE GRATES TO BE NDS 6" ROUND GRATE, GREEN, OR EQUIVALENT.

NO. DATE REVISION	
BENCHMARK ENGINEERS & LAND SURVEYORS & PLANNERS ENGINEERING, INC. 8480 BALTIMORE NATIONAL PIKE & SUITE 315 ELLICOTT CITY, MARYLAND 21043 (P) 410-465-6105 (F) 410-465-6644 WWW.BEI-CIVILENGINEERING.COM	
OWNER: MANGIONE ENTERPRISES OF TURF VALLEY, LIMITED PARTNERSHIP 1205 YORK ROAD, PENTHOUSE LUTHERVILLE, MARYLAND 21093 410-825-8400	RESIDENTIAL - SINGLE FAMILY ATTACHED AND MULTI-FAMILY RAVENWOOD CONDOMINIUMS AT TURF VALLEY LOTS 1 thru 7 AND BUILDABLE BULK PARCEL 'AA' TAX MAP: 17, PARCEL: 706, GRID: 13 ELECTION DISTRICT NO. 2 - HOWARD COUNTY, MARYLAND ZONED: PGCC
BUILDER: NV HOMES 9720 PATUXENT WOODS DVE COLUMBIA, MARYLAND 21046 410-379-3385	STORMWATER MANAGEMENT DETAILS CONDOMINIUMS DATE: AUGUST 27, 2020 BEI PROJECT NO. 2931 DESIGN: DBT DRAFT: DBT SCALE: AS SHOWN SHEET 9 OF 23

AS-BUILT

SDP-20-036

CONSTRUCTION SPECIFICATIONS

B.4.C Specifications for Micro-Bioretenion, Rain Gardens, Landscape Infiltration & Infiltration Berms

- Material Specifications:**
The allowable materials to be used in these practices are detailed in Table B.4.1.
- Filtering Media or Planting Soil:**
The soil shall be a uniform mix, free of stones, slumps, roots or other similar objects larger than two inches. No other materials or substances shall be mixed or dumped within the micro-bioretenion practice that may be harmful to plant growth, or prove a hindrance to the planting or maintenance operations. The planting soil shall be free of Bermuda grass, Quackgrass, Johnson grass, or other noxious weeds as specified under COMAR 15.08.01.05. The planting soil shall be tested and shall meet the following criteria:

Soil Component - Loamy Sand or Sandy Loam (USDA Soil Textural Classification)
Organic Content - Minimum 10% by dry weight (ASTM D 2974). In general, this can be met with a mixture of loamy and (60%-65%) and compost (35% to 40%) or sandy loam (30%), coarse sand (30%), and compost (40%).
Clay Content - Media shall have a clay content of less than 5%.
pH Range - Should be between 5.5 - 7.0. Amendments (e.g., lime, iron sulfate plus sulfur) may be mixed into the soil to increase or decrease pH.

There shall be at least one soil test per project. Each test shall consist of both the standard soil test for pH, and additional tests of organic matter, and soluble salts. A textural analysis is required from the site stockpiled topsoil. If topsoil is imported, then a texture analysis shall be performed for each location where the topsoil was excavated.

3. **Compaction:**
It is very important to minimize compaction of both the base of bioretention practices and the required backfill. When possible, use excavation hoses to remove original soil. If practices are excavated using a loader, the contractor should use wide track or marsh track equipment, or light equipment with turf type tires. Use of equipment with narrow tracks or narrow tires, rubber tires with large lugs, or high-pressure tires will cause excessive compaction resulting in reduced infiltration rates and is not acceptable. Compaction will significantly contribute to design failure.

Compaction can be alleviated at the base of the bioretention facility by using a primary tilling operation such as a chisel plow, ripper, or subsoiler. These tilling operations are to restructure the soil profile through the 12 inch compaction zone. Substitute methods must be approved by the engineer. Rototillers typically do not till deep enough to reduce the effects of compaction from heavy equipment.

Rototill 2 to 3 inches of sand into the base of the bioretention facility before backfilling the optional sand layer. Pump any ponded water before preparing (rototilling) base.

When backfilling the topsoil over the sand layer, first place 3 to 4 inches of topsoil over the sand, then rototill the sand/topsoil to create a gradation zone. Backfill the remainder of the topsoil to final grade.

When backfilling the bioretention facility, place soil in lifts 12" to 18". Do not use heavy equipment within the bioretention basin. Heavy equipment can be used around the perimeter of the basin to supply soils and sand. Grade bioretention materials with light equipment such as a compact loader or a dozer/loader with marsh tracks.

4. **Plant Material:**
Recommended plant material for micro-bioretenion practices can be found in Appendix A, Section A.2.3.

5. **Plant Installation:**
Compost is a better organic material source, is less likely to float, and should be placed in the invert and other low areas. Mulch should be placed in surrounding to a uniform thickness of 2" to 3". Shredded or chipped hardwood mulch is the only accepted mulch. Pine mulch and wood chips will float and move to the perimeter of the bioretention area during a storm event and are not acceptable. Shredded mulch must be well aged (6 to 12 months) for acceptance.

Rootstock of the plant material shall be kept moist during transport and on-site storage. The plant root ball should be planted so 1/8th of the ball is above final grade surface. The diameter of the planting pit shall be at least six inches larger than the diameter of the planting ball. Set and maintain the plant straight during the entire planting process. Thoroughly water ground bed cover after installation.

Trees shall be braced using 2" by 2" stakes only as necessary and for the first growing season only. Stakes are to be equally spaced on the outside of the tree ball.

Grasses and legume seed should be drilled into the soil to a depth of at least one inch. Grass and legume plugs shall be planted following the non-grass ground cover planting specifications.

The topsoil specifications provide enough organic material to adequately supply nutrients from natural cycling. The primary function of the bioretention structure is to improve water quality. Adding fertilizers defeats, or at a minimum, impedes this goal. Only add fertilizer if wood chips or mulch are used to amend the soil. Rototill urea fertilizer at a rate of 2 pounds per 1000 square feet.

6. **Underdrains:**
Underdrains should meet the following criteria:

- Pipe- Should be 4" to 6" diameter, slotted or perforated rigid plastic pipe (ASTM F 758, Type PS 28, or AASHTO-M-278) in a gravel layer. The preferred material is slotted, 4" rigid pipe (e.g., PVC or HDPE).
- Perforations - If perforated pipe is used, perforations should be 3/4" diameter located 6" on center with a minimum of four holes per row. Pipe shall be wrapped with a 1/4" (No. 4 or 4x4) galvanized hardware cloth.
- Gravel - The gravel layer (No. 57 stone preferred) shall be at least 3" thick above and below the underdrain
- The main collector pipe shall be at a minimum 0.5% slope.
- A rigid, non-perforated observation well must be provided (one per every 1,000 square feet) to provide a clean-out port and monitor performance of the filter.
- A 4" layer of pea gravel (3/4" to 1" stone) shall be located between the filter media and underdrain to prevent migration of fines into the underdrain. This layer may be considered part of the filter bed when bed thickness exceeds 24".


The main collector pipe for underdrain systems shall be constructed at a minimum slope of 0.5%. Observation wells and/or clean-out pipes must be provided (one minimum per every 1000 square feet of surface area).

7. **Miscellaneous:**
These practices may not be constructed until all contributing drainage area has been stabilized.



Appendix B.4. Construction Specifications for Environmental Site Design Practices

Material	Specification	Size	Notes
Plantings	see Appendix A, Table A.4	n/a	plantings are site-specific
Planting soil [2' to 4' deep]	loamy sand (60 - 65%) & compost (35 - 40%) or sandy loam (30%), coarse sand (30%) & compost (40%)	n/a	USDA soil types loamy sand or sandy loam; clay content < 5%
Organic content	Min. 10% by dry weight (ASTM D 2974)		
Mulch	shredded hardwood		aged 6 months, minimum; no pine or wood chips
Pea gravel diaphragm	pea gravel: ASTM-D-448	NO. 8 OR NO. 9 (1.8" TO 3.8")	
Curtain drain	ornamental stone: washed cobbles	stone: 2" to 5"	
Geotextile	AASHTO M-43	n/a	PE Type 1 nonwoven
Gravel (underdrains and infiltration berms)		NO. 57 OR NO. 6 AGGREGATE (3/8" to 3/4")	
Underdrain piping	F 758, Type PS 28 or AASHTO M-278	4" to 6" rigid schedule 40 PVC or SDR35	Slotted or perforated pipe; 3/8" perf. @ 6" on center, 4 holes per row; minimum of 3" of gravel over pipes; not necessary underneath pipes. Perforated pipe shall be wrapped with 1/4-inch galvanized hardware cloth
Poured in place concrete (if required)	MISHA Mix No. 3, f'c = 3500 psi @ 28 days, normal weight, air-entrained, reinforcing to meet ASTM-615-60	n/a	on-site testing of poured-in-place concrete required; 28 day strength and slump test; all concrete design (cast-in-place or pre-cast) not using previously approved State or local standards requires design drawings sealed and approved by a professional structural engineer licensed in the State of Maryland -design to include meeting ACI Code 308.1R.99; vertical loading [H-10 or H-20]; allowable horizontal loading (based on soil pressure); and analysis of potential cracking
Sand	AASHTO-M-6 or ASTM-C-33	0.02" to 0.04"	Sand substitutions such as Diabase and Graystone (AASHTO) #10 are not acceptable. No calcium carbonated or dolomitic sand substitutions are acceptable. No "rock dust" can be used for sand.


B.4.7 Supp. 1

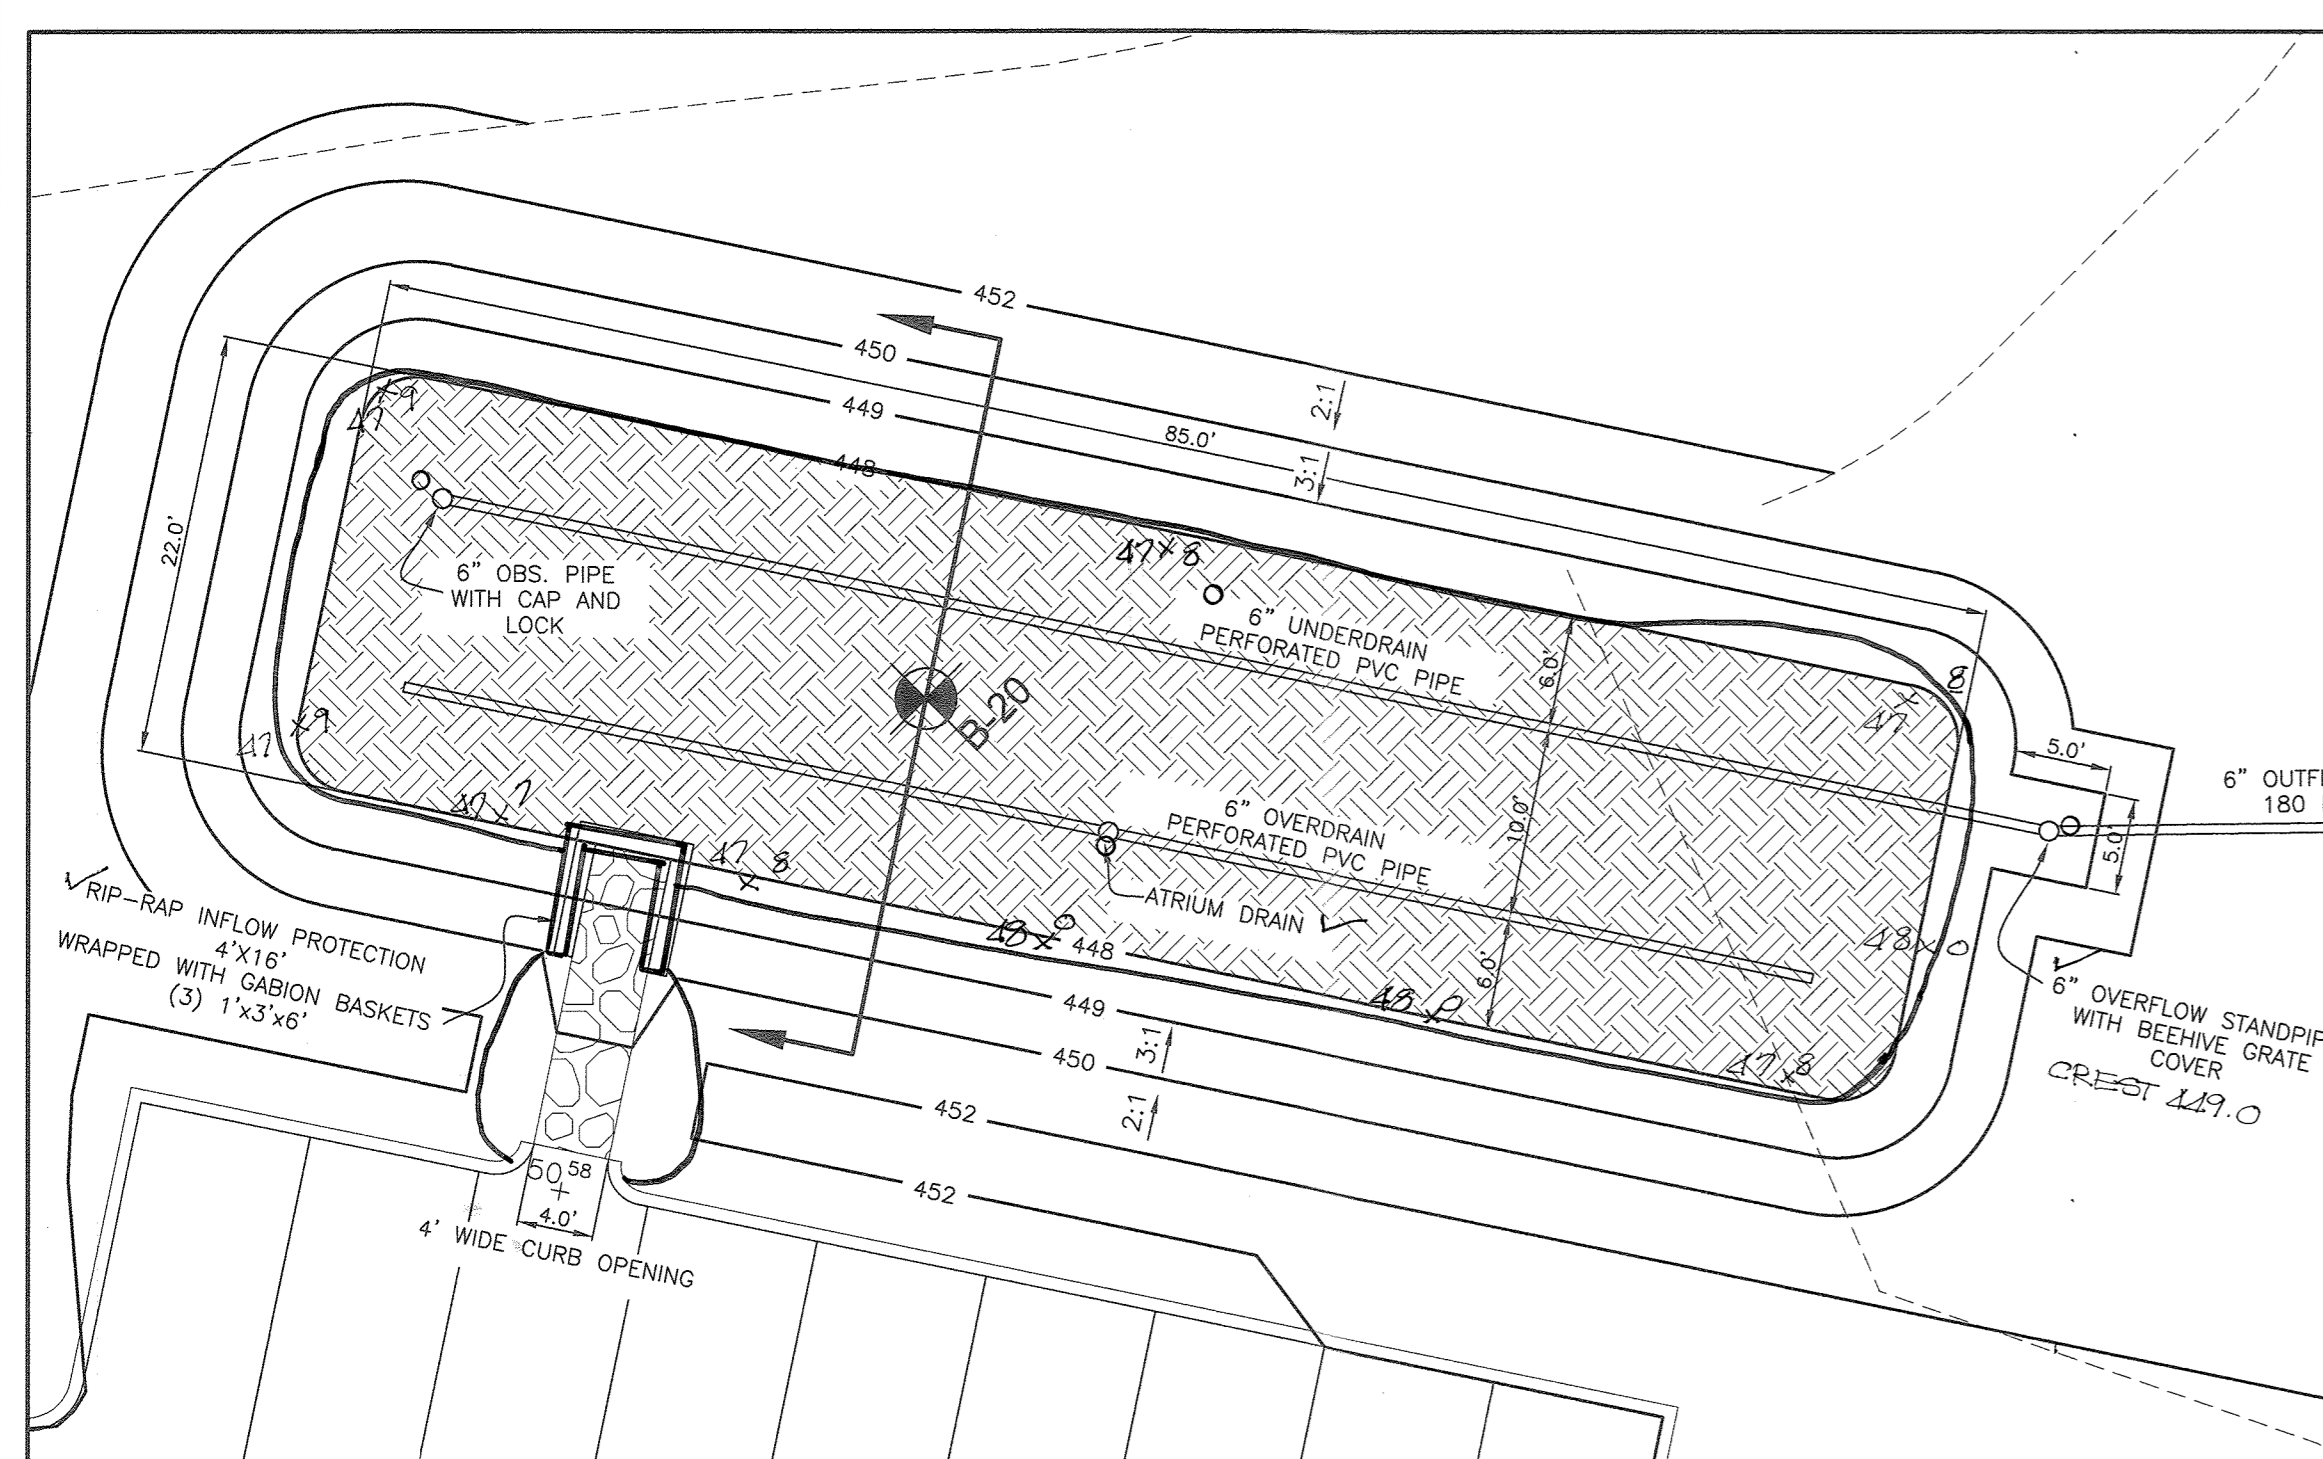

(M-6) MICRO BIO-RETENTION #7

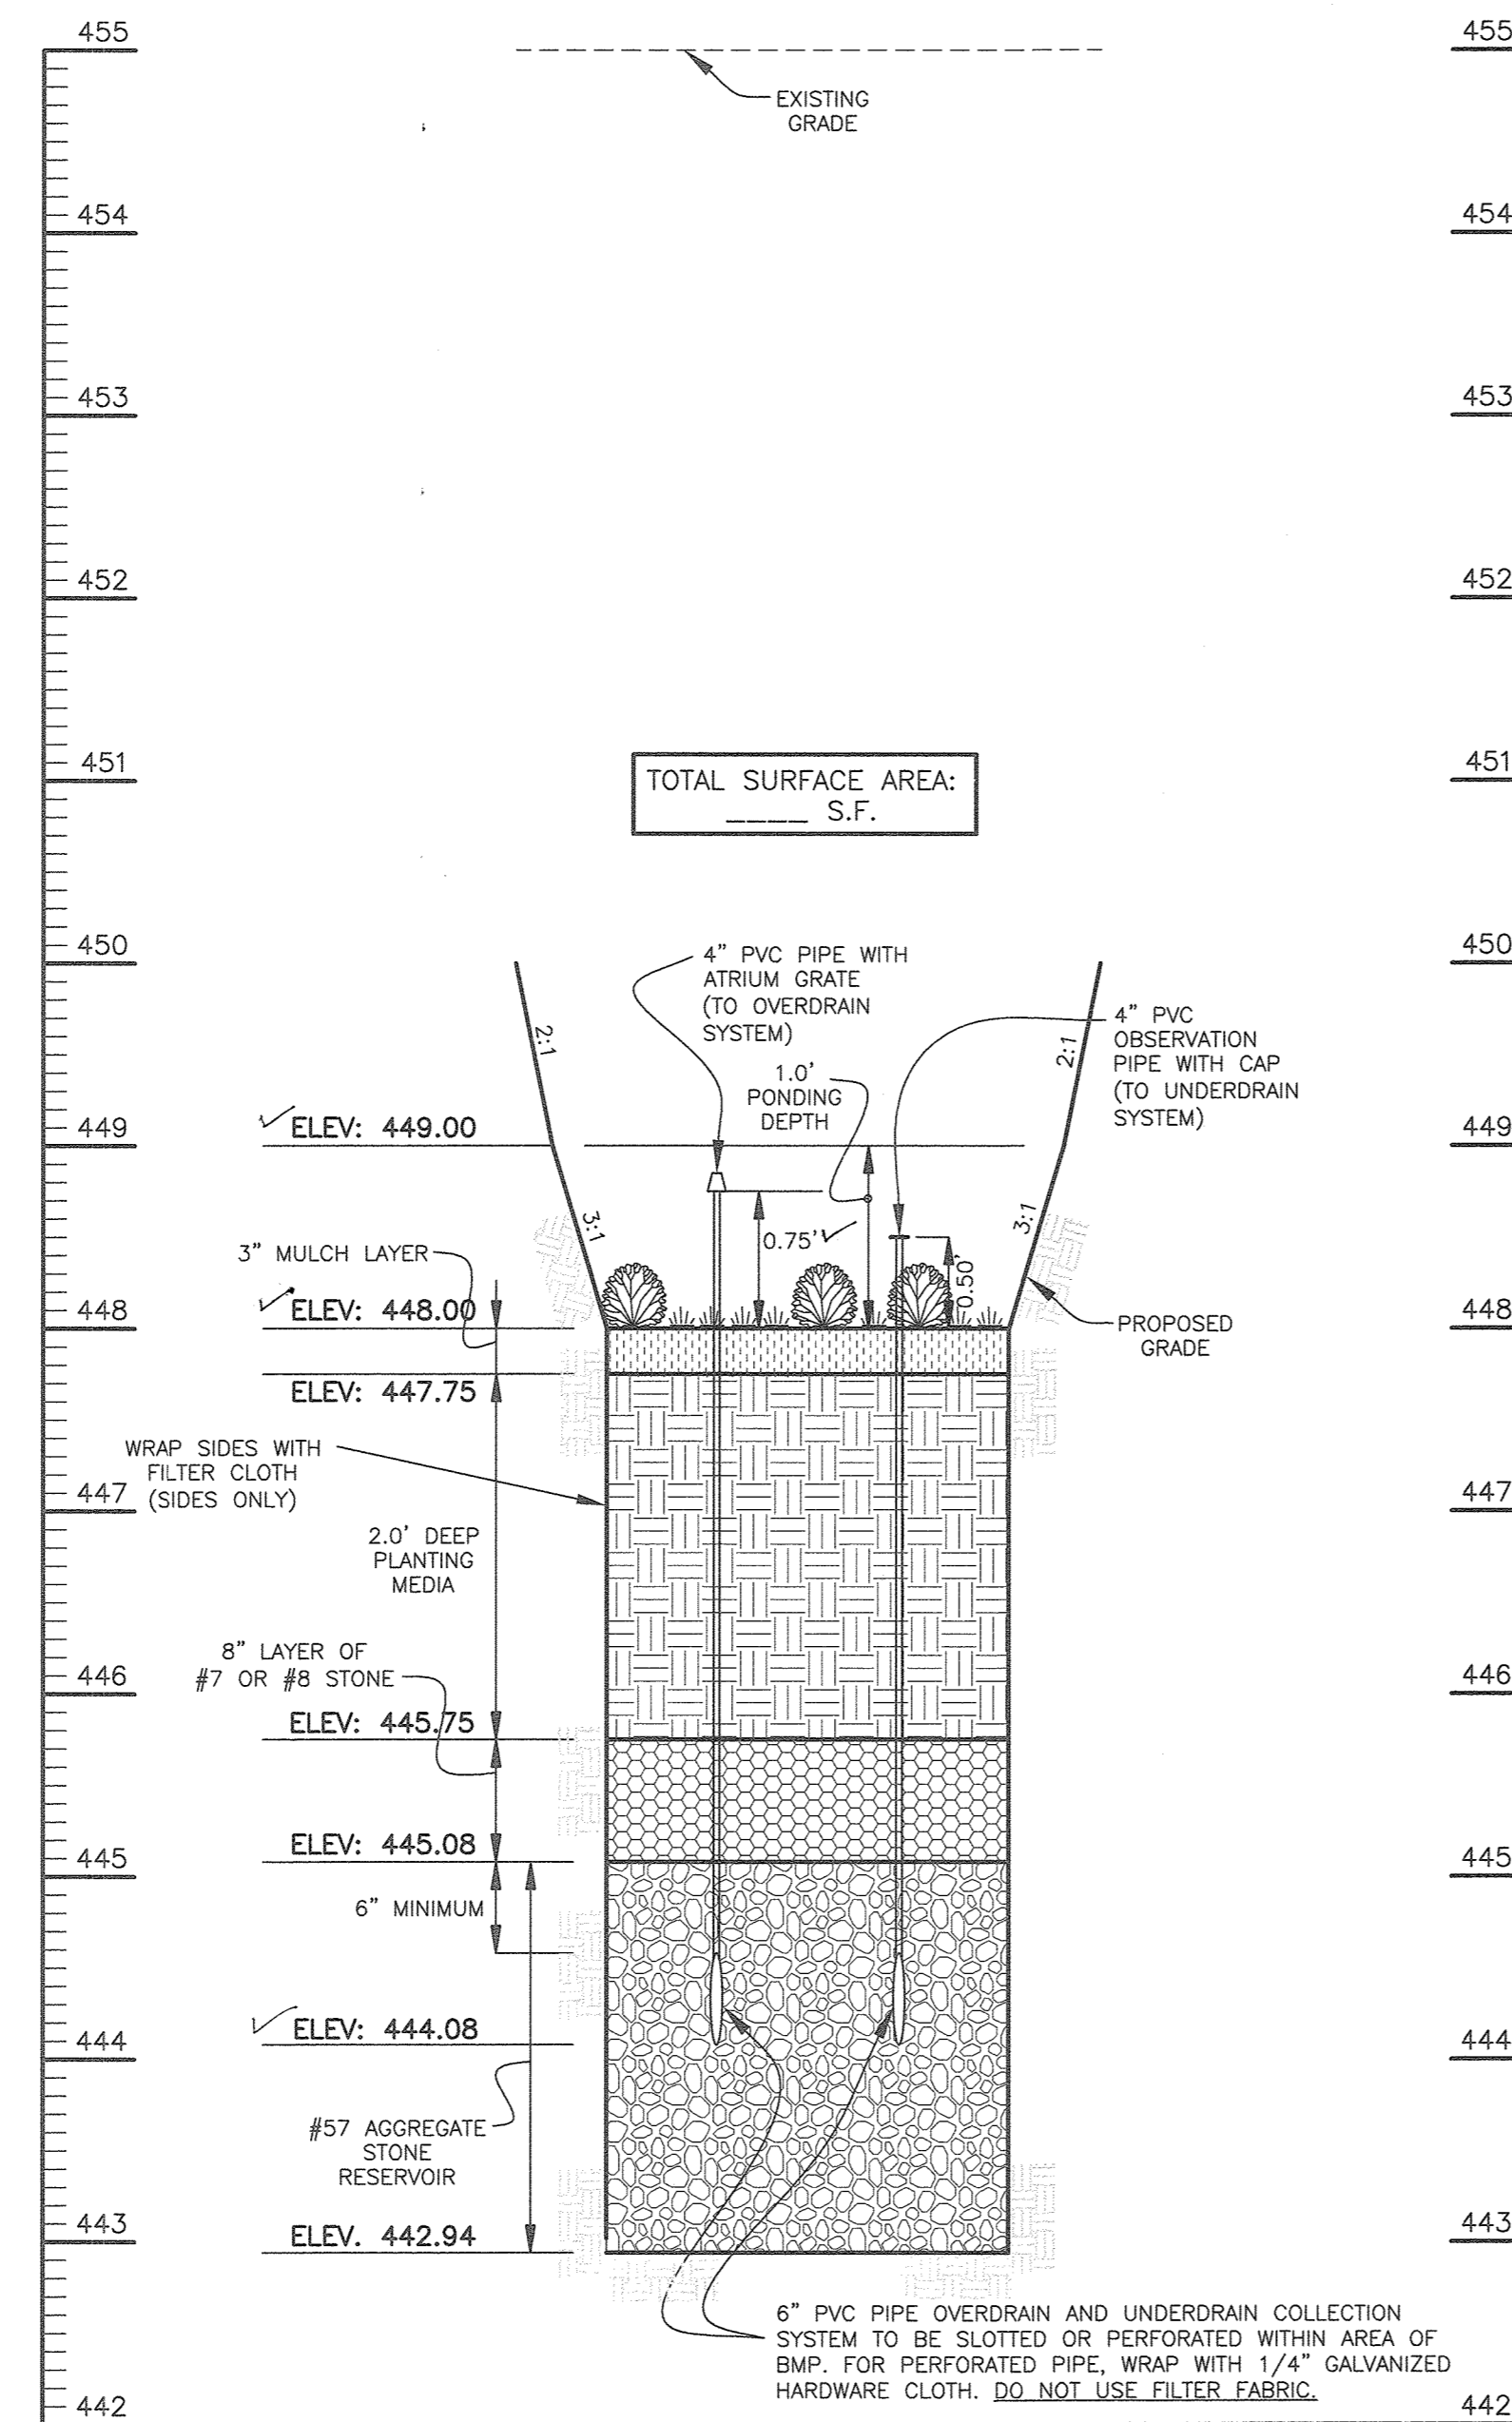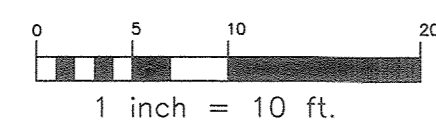

(M-6) MICRO BIO-RETENTION #7
CROSS SECTION
SCALE: 1"=20'H; 1"=2'V

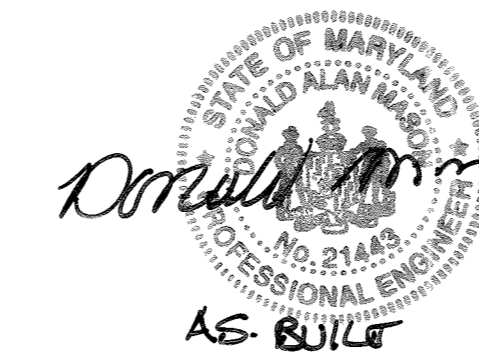

Professional Certification. I hereby certify that these documents were prepared or approved by me, and that I am a duly licensed professional engineer under the laws of the State of Maryland.
License No. 21443, Expiration Date: 12-31-24

AS-BUILT CERTIFICATION
I hereby certify, by my seal, that to the best of my knowledge and belief the facilities shown on this "AS-BUILT" Plan meet the Approved Plans and Specifications
Donald Mason, P.E. Date: 5/21/24

OPERATION AND MAINTENANCE SCHEDULE FOR MICRO-BIORETENTION (M-6)

- The Owner shall maintain the plant material, mulch layer and soil layer annually. Maintenance of mulch and soil is limited to correcting areas of erosion or wash out. Any mulch replacement shall be done in the spring. Plant material shall be checked for disease and insect infestation and maintenance will address dead material and pruning. Acceptable replacement plant material is limited to the following: 2000 Maryland Stormwater Design Manual Volume II, Table A.4.1 and 2.
- The Owner shall perform a plant inspection in the spring and in the fall of each year. During the inspection, the Owner shall remove dead and diseased vegetation considered beyond treatment, replace dead plant material with acceptable replacement plant material, treat diseased trees and shrubs, and replace all deficient stakes and wires.
- The Owner shall inspect the mulch each spring. The mulch shall be replaced every two to three years. The previous mulch layer shall be removed the new layer is applied.
- The Owner shall correct soil erosion on an as needed basis, with a minimum of once per month and after each heavy storm.

NOTE:
SEE SHEET 15 FOR LANDSCAPE INFORMATION.

APPROVED
PLANNING BOARD OF HOWARD COUNTY
DATE AUGUST 20, 2020

APPROVED: HOWARD COUNTY DEPARTMENT OF PLANNING AND ZONING
Chief, Development Engineering Division: *Ad. Eblen* 10/5/20
Chief, Division of Land Development: *[Signature]* 10/20/20
Director: *[Signature]* 10/29/20


NO. DATE REVISION		 PROFESSIONAL CERTIFICATION. I hereby certify that these documents were prepared or approved by me, and that I am a duly licensed professional engineer under the laws of the State of Maryland. License No. 22389, Expiration Date: 6-30-2021
 8480 BALTIMORE NATIONAL PIKE & SUITE 315 A ELLICOTT CITY, MARYLAND 21043 (P) 410-485-6105 (F) 410-485-8644 WWW.BE-CIVILENGINEERING.COM		
OWNER:	RESIDENTIAL - SINGLE FAMILY ATTACHED AND MULTI-FAMILY RAVENWOOD CONDOMINIUMS AT TURF VALLEY LOTS 1 thru 7 AND BUILDABLE BULK PARCEL 'AA'	
BUILDER:	TAX MAP: 17, PARCEL: 706, GRID: 13 ELECTION DISTRICT NO. 7 - HOWARD COUNTY, MARYLAND ZONED: PGCC STORMWATER MANAGEMENT DETAILS CONDOMINIUMS	
DATE:	AUGUST 27, 2020	BEI PROJECT NO. 2931
DESIGN:	DBT	DRAFT: DBT
SCALE:	AS SHOWN	SHEET 10 OF 23

AS-BUILT

SDP-20-036

NRCS SOILS CHART - HoCo Soils Map No. 12				
SYMBOL	HYDRIC	GROUP	Kw	MAP UNIT NAME
GgB		B	0.37	GLENELG LOAM, 3 TO 8 PERCENT SLOPES
GgC		B	0.37	GLENELG LOAM, 8 TO 15 PERCENT SLOPES
BaA	YES	C	0.43	GLENVILLE SILT LOAM, 0 TO 3 PERCENT SLOPES

SWM Drainage Info		
	DA (acres)	% Imp
MB #1	0.44	95%
MB #2	0.38	92%
MB #3	0.43	93%
MB #4	0.40	94%
MB #5	0.47	93%
MB #6	0.43	95%
MB #7	0.49	91%

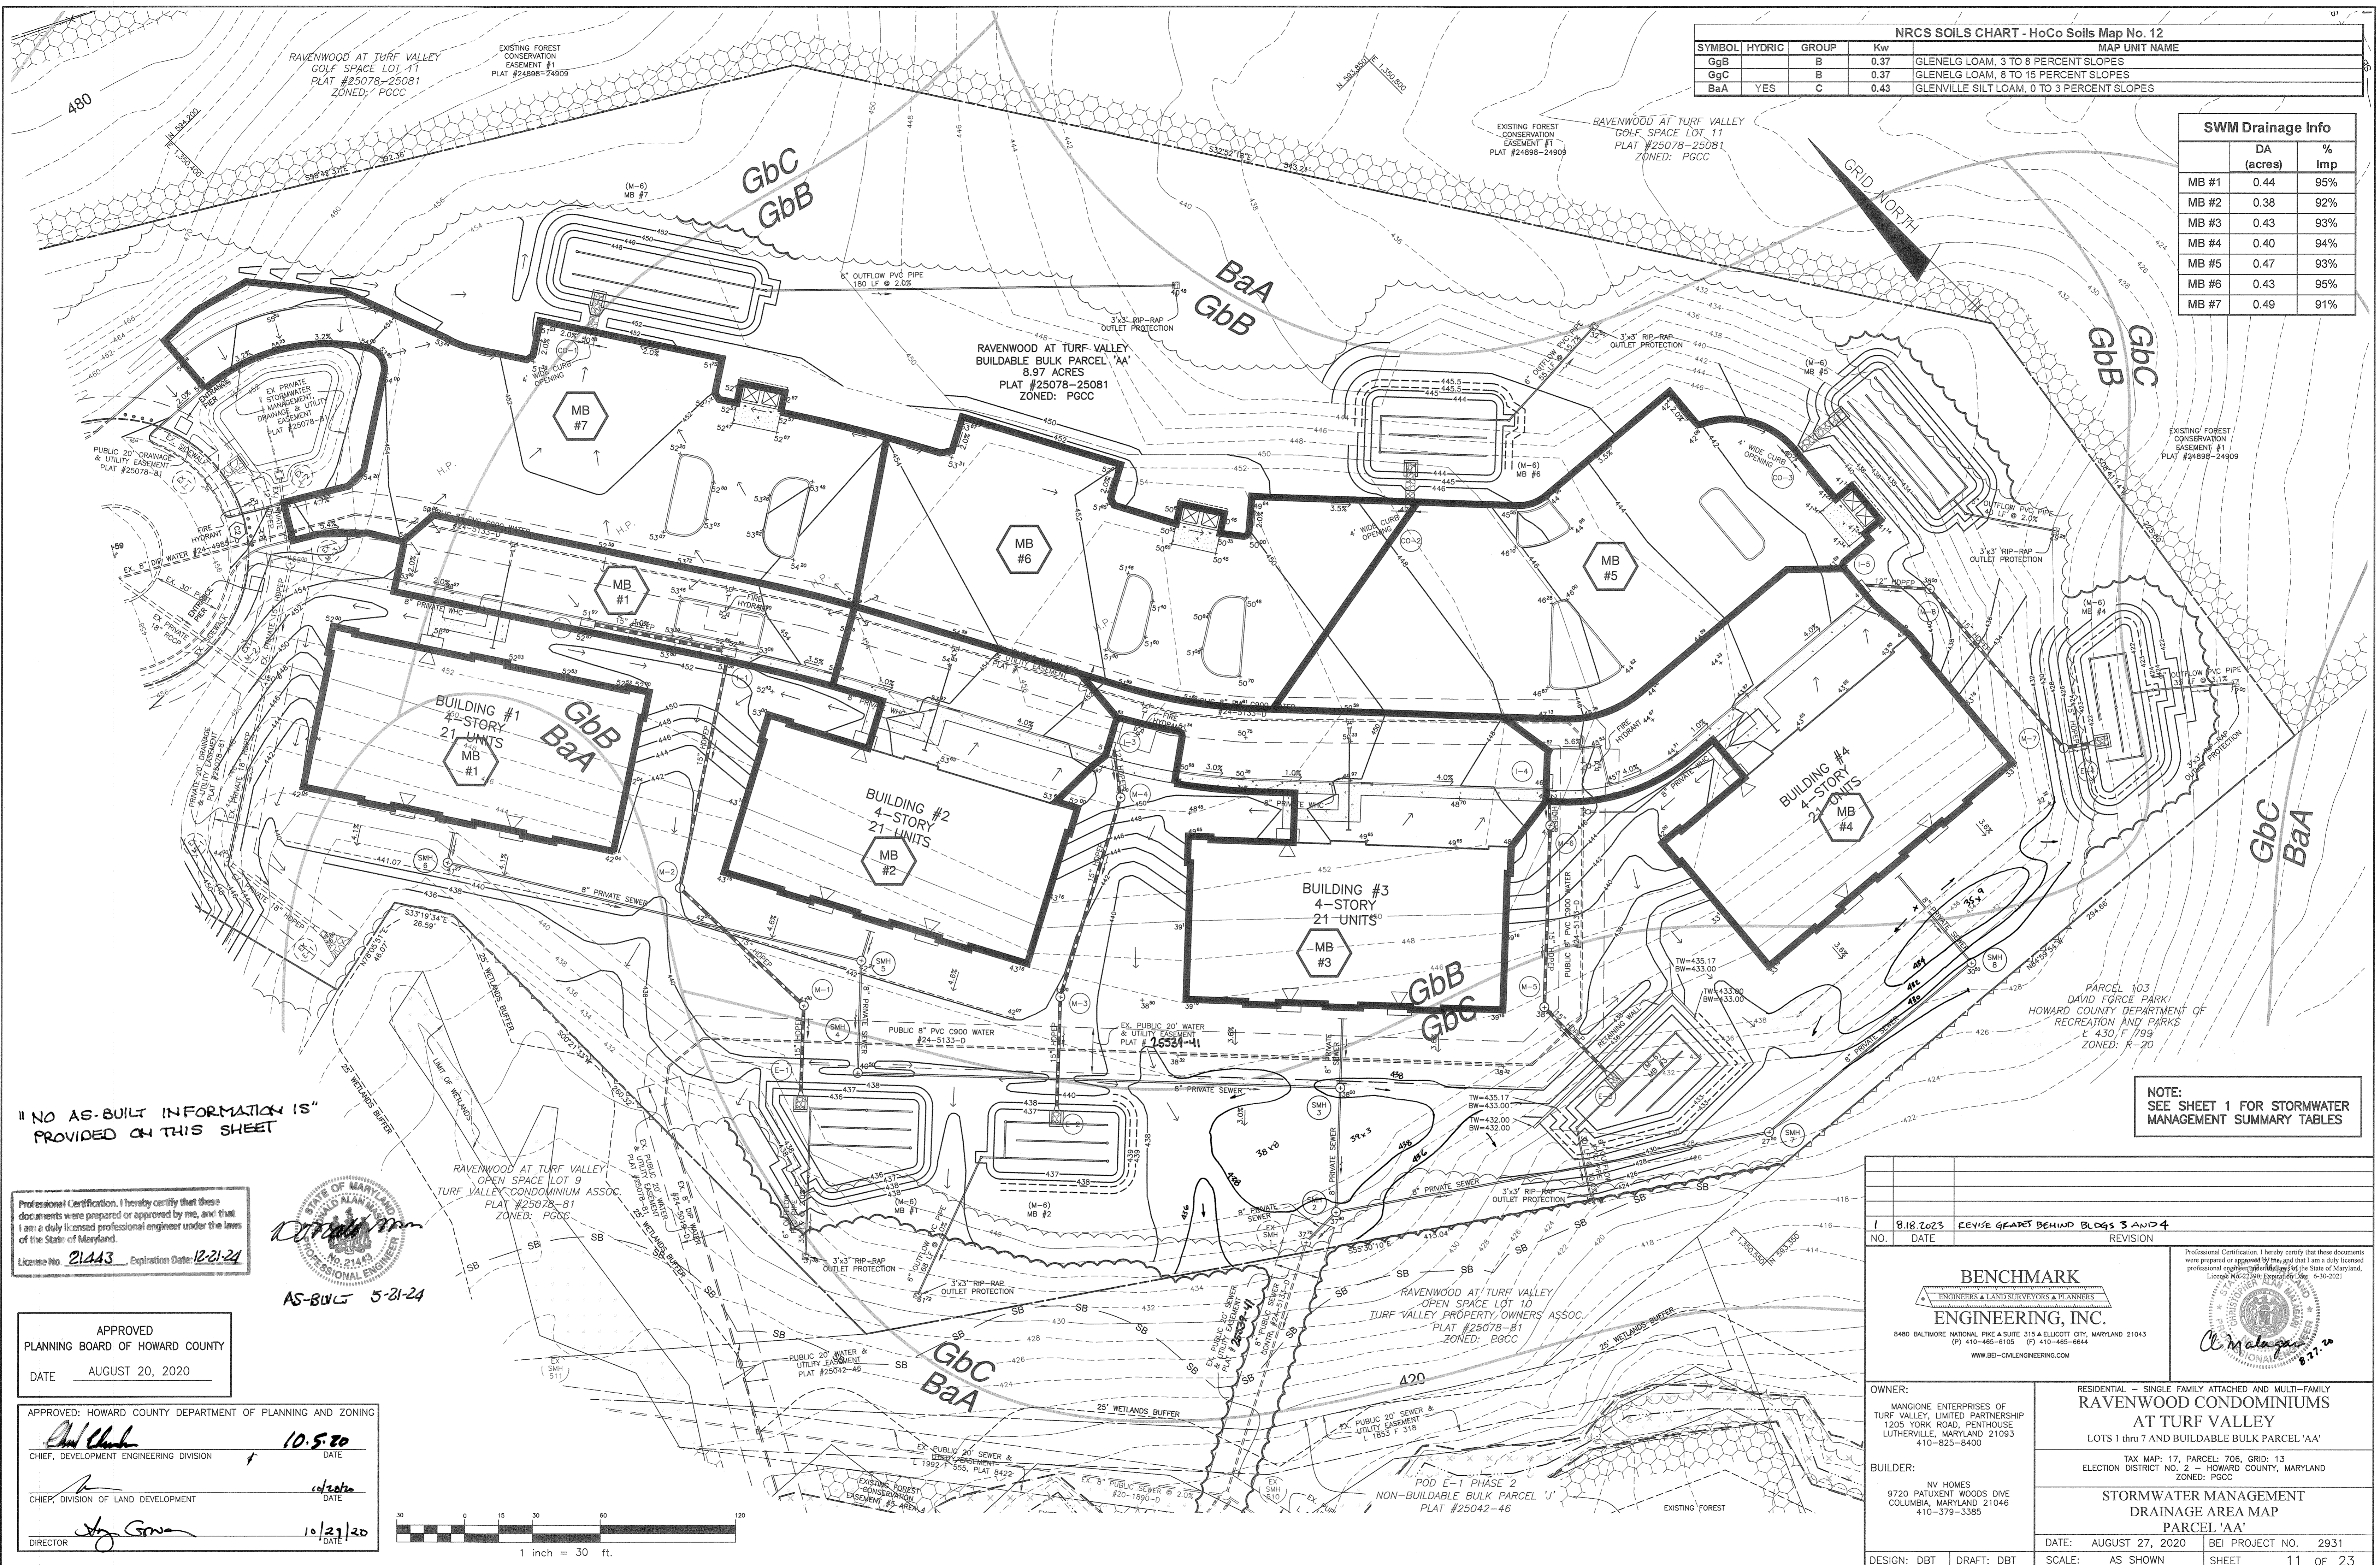


"NO AS-BUILT INFORMATION IS PROVIDED ON THIS SHEET"

Professional Certification. I hereby certify that these documents were prepared or approved by me, and that I am a duly licensed professional engineer under the laws of the State of Maryland.
 License No. 21443, Expiration Date: 12-21-24



APPROVED
 PLANNING BOARD OF HOWARD COUNTY
 DATE AUGUST 20, 2020


APPROVED: HOWARD COUNTY DEPARTMENT OF PLANNING AND ZONING
 Chief, Development Engineering Division: 10.5.20
 Chief, Division of Land Development: 10/29/20
 Director: 10/29/20

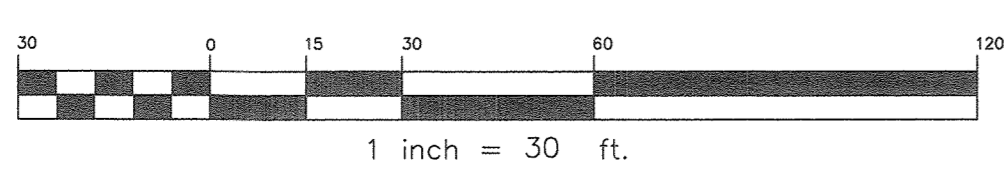


NOTE: SEE SHEET 1 FOR STORMWATER MANAGEMENT SUMMARY TABLES

1	8.18.2023	REVISE GRADET BEHIND BLDGS 3 AND 4
NO.	DATE	REVISION
BENCHMARK ENGINEERS & LAND SURVEYORS & PLANNERS ENGINEERING, INC. 8490 BALTIMORE NATIONAL PIKE & SUITE 315 & ELLICOTT CITY, MARYLAND 21043 (P) 410-465-6105 (F) 410-465-6644 WWW.BEI-CIVILENGINEERING.COM		
OWNER:	MANGIONE ENTERPRISES OF TURF VALLEY, LIMITED PARTNERSHIP 1205 YORK ROAD, PENTHOUSE LUTHERVILLE, MARYLAND 21093 410-825-8400	
BUILDER:	NV HOMES 9720 PATUXENT WOODS DIVE COLUMBIA, MARYLAND 21046 410-379-3385	
RESIDENTIAL - SINGLE FAMILY ATTACHED AND MULTI-FAMILY RAVENWOOD CONDOMINIUMS AT TURF VALLEY LOTS 1 thru 7 AND BUILDABLE BULK PARCEL 'AA' TAX MAP: 17, PARCEL: 706, GRID: 13 ELECTION DISTRICT NO. 2 - HOWARD COUNTY, MARYLAND ZONED: PGCC STORMWATER MANAGEMENT DRAINAGE AREA MAP PARCEL 'AA' DATE: AUGUST 27, 2020 BEI PROJECT NO. 2931 DESIGN: DBT DRAFT: DBT SCALE: AS SHOWN SHEET 11 OF 23		




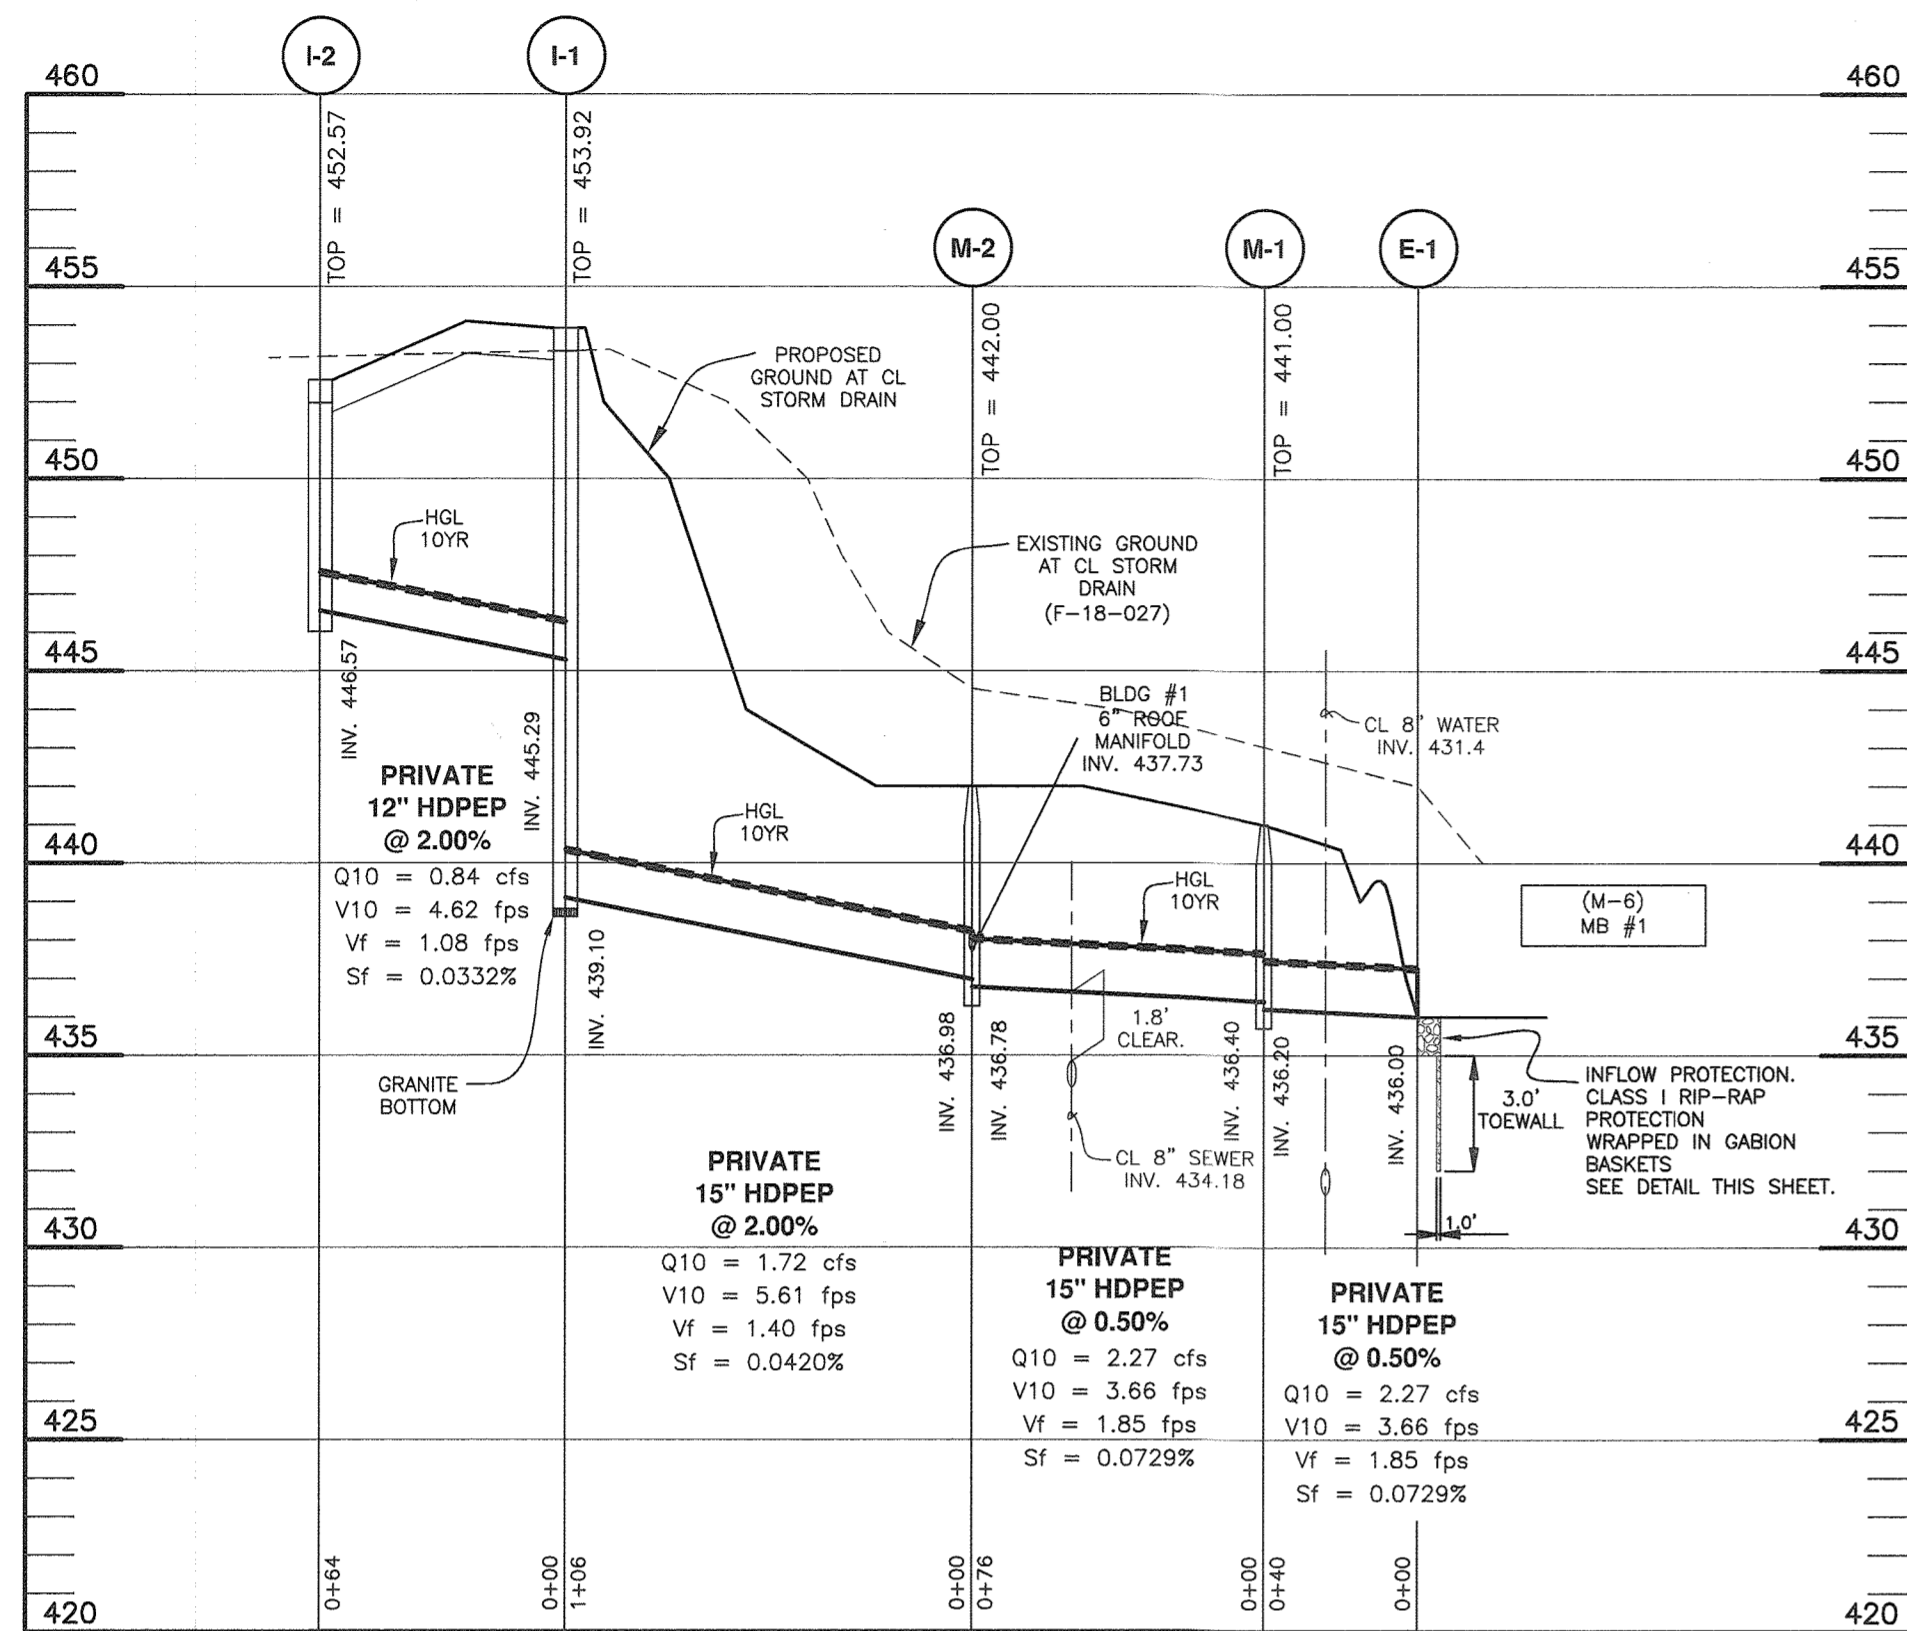


STORM DRAIN PROFILE
SCALE: 1"=50' HORIZ., 1"=5' VERT.

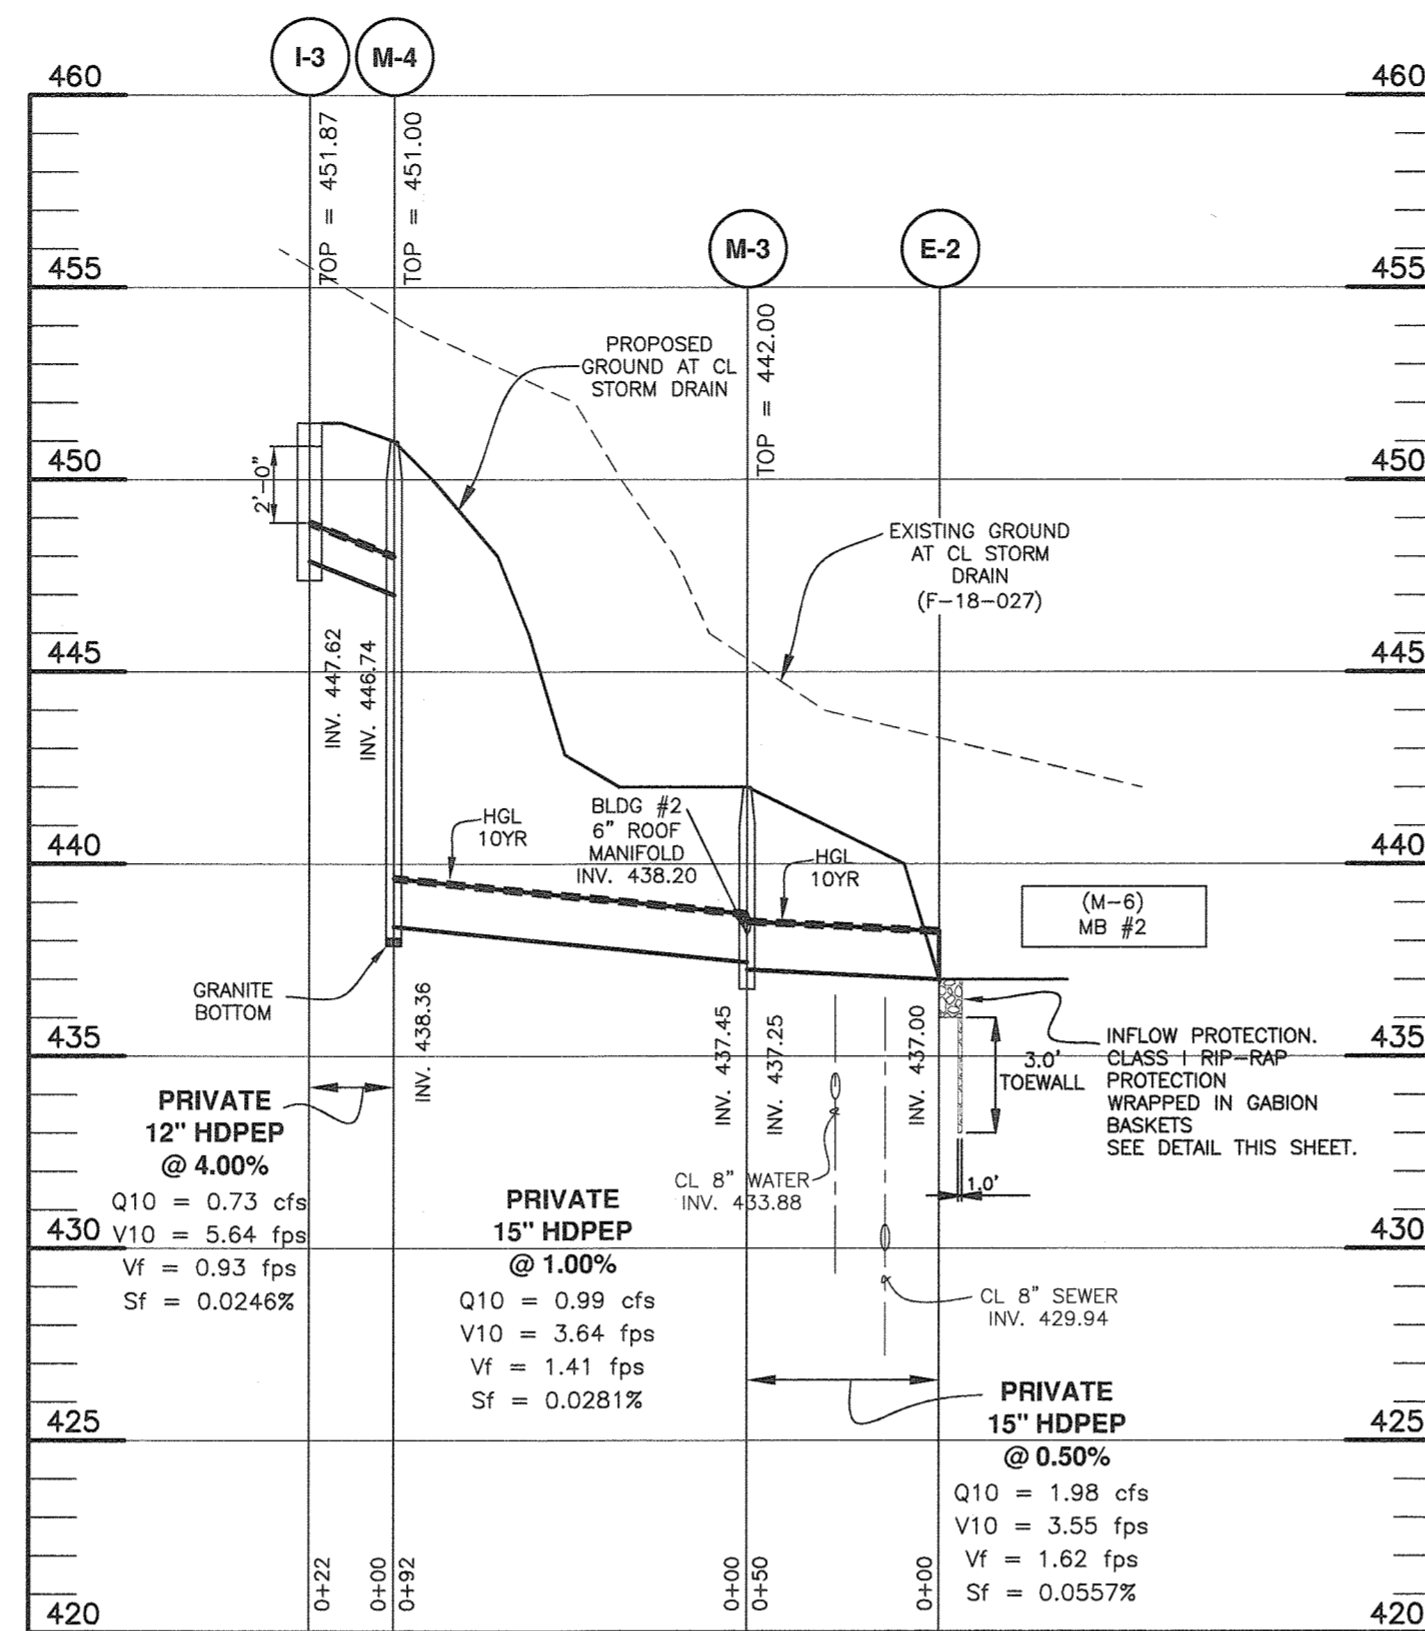


STORM DRAIN PROFILE
SCALE: 1"=50' HORIZ., 1"=5' VERT.

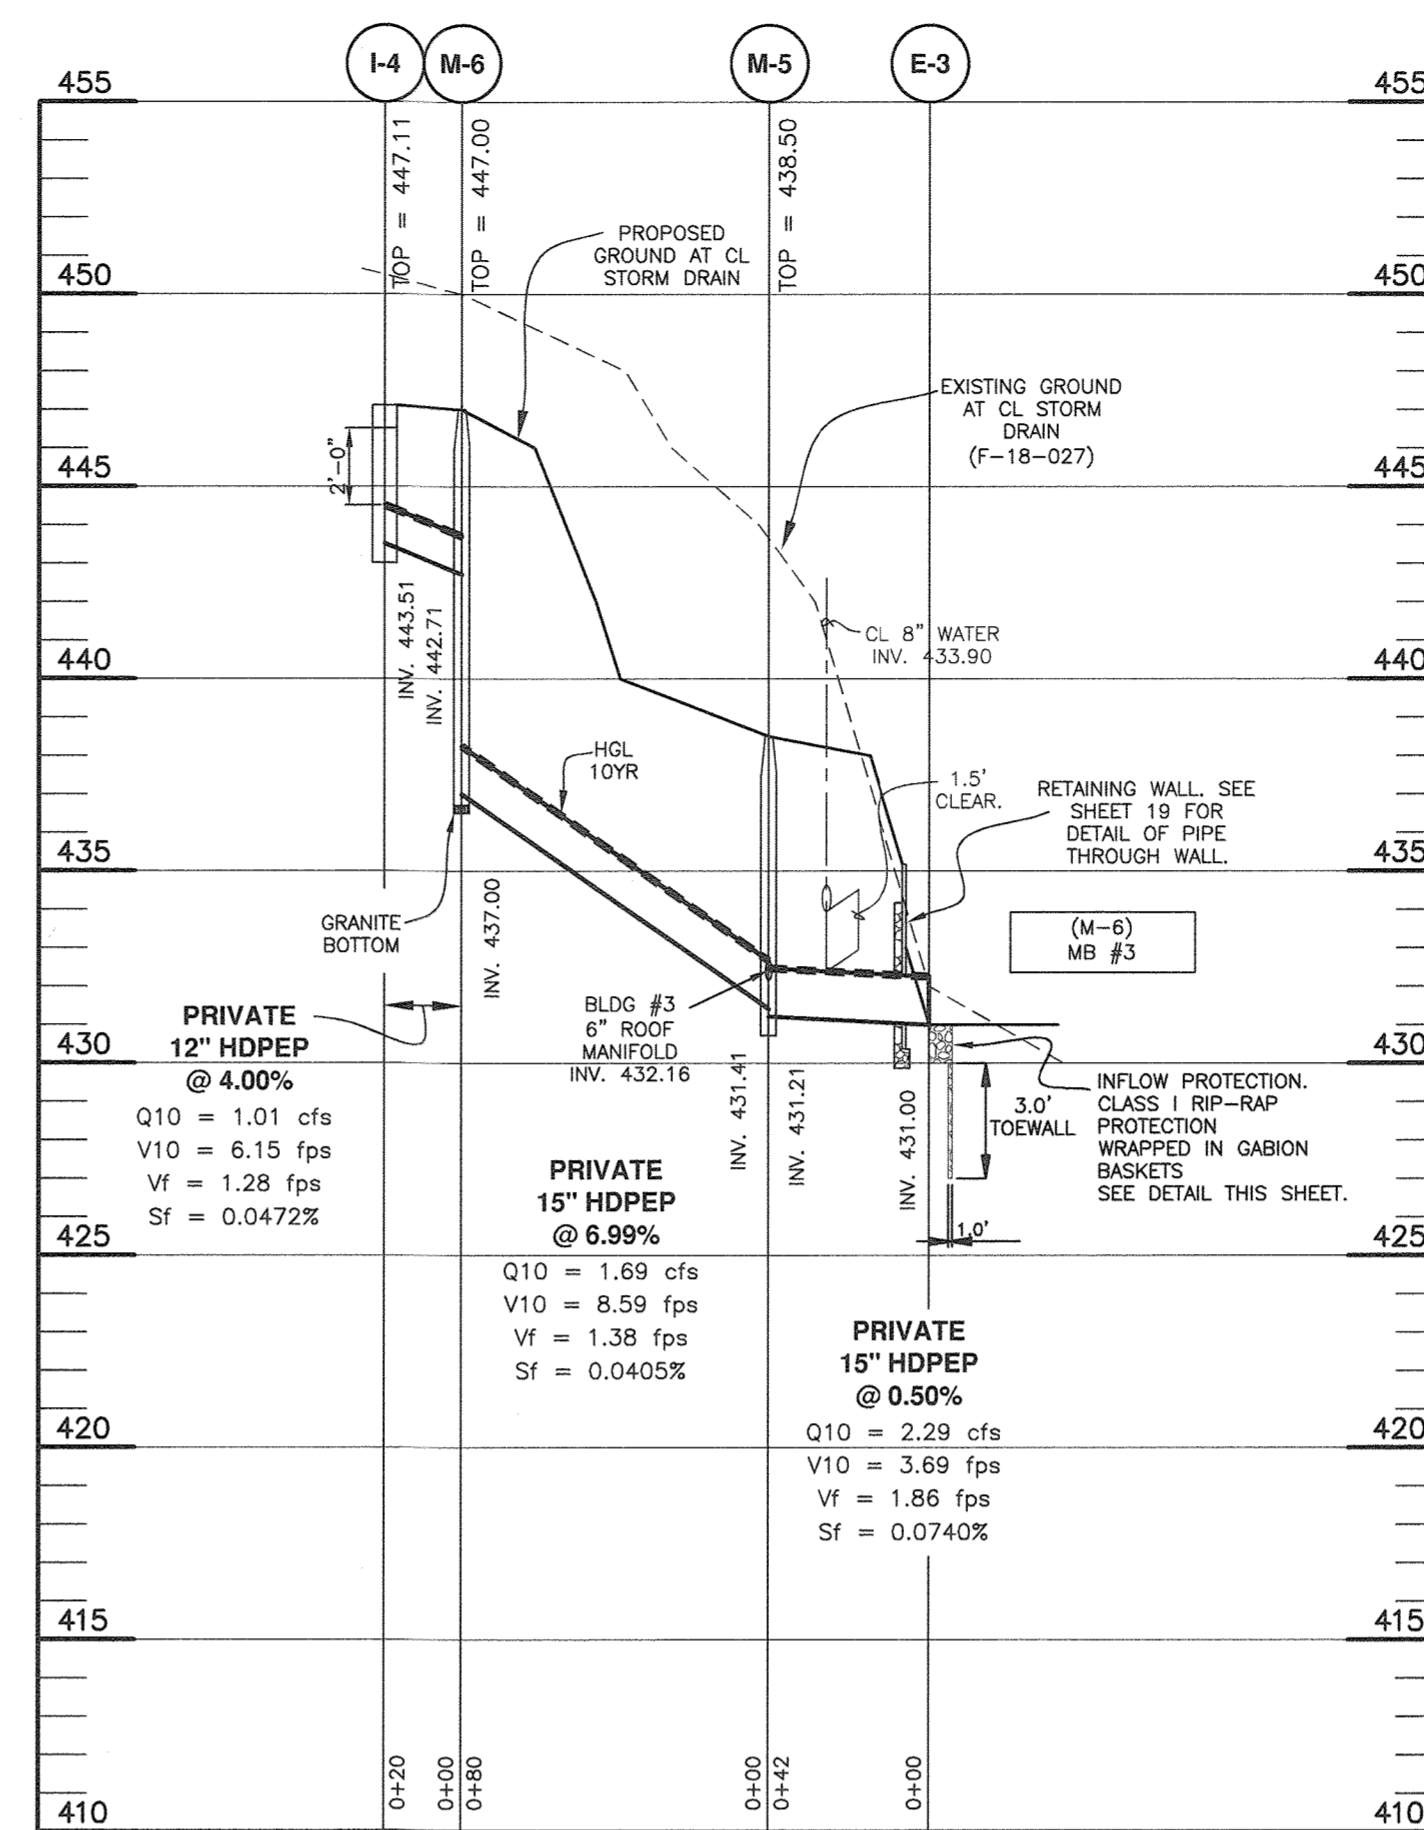

STORM DRAIN PROFILE
SCALE: 1"=50' HORIZ., 1"=5' VERT.

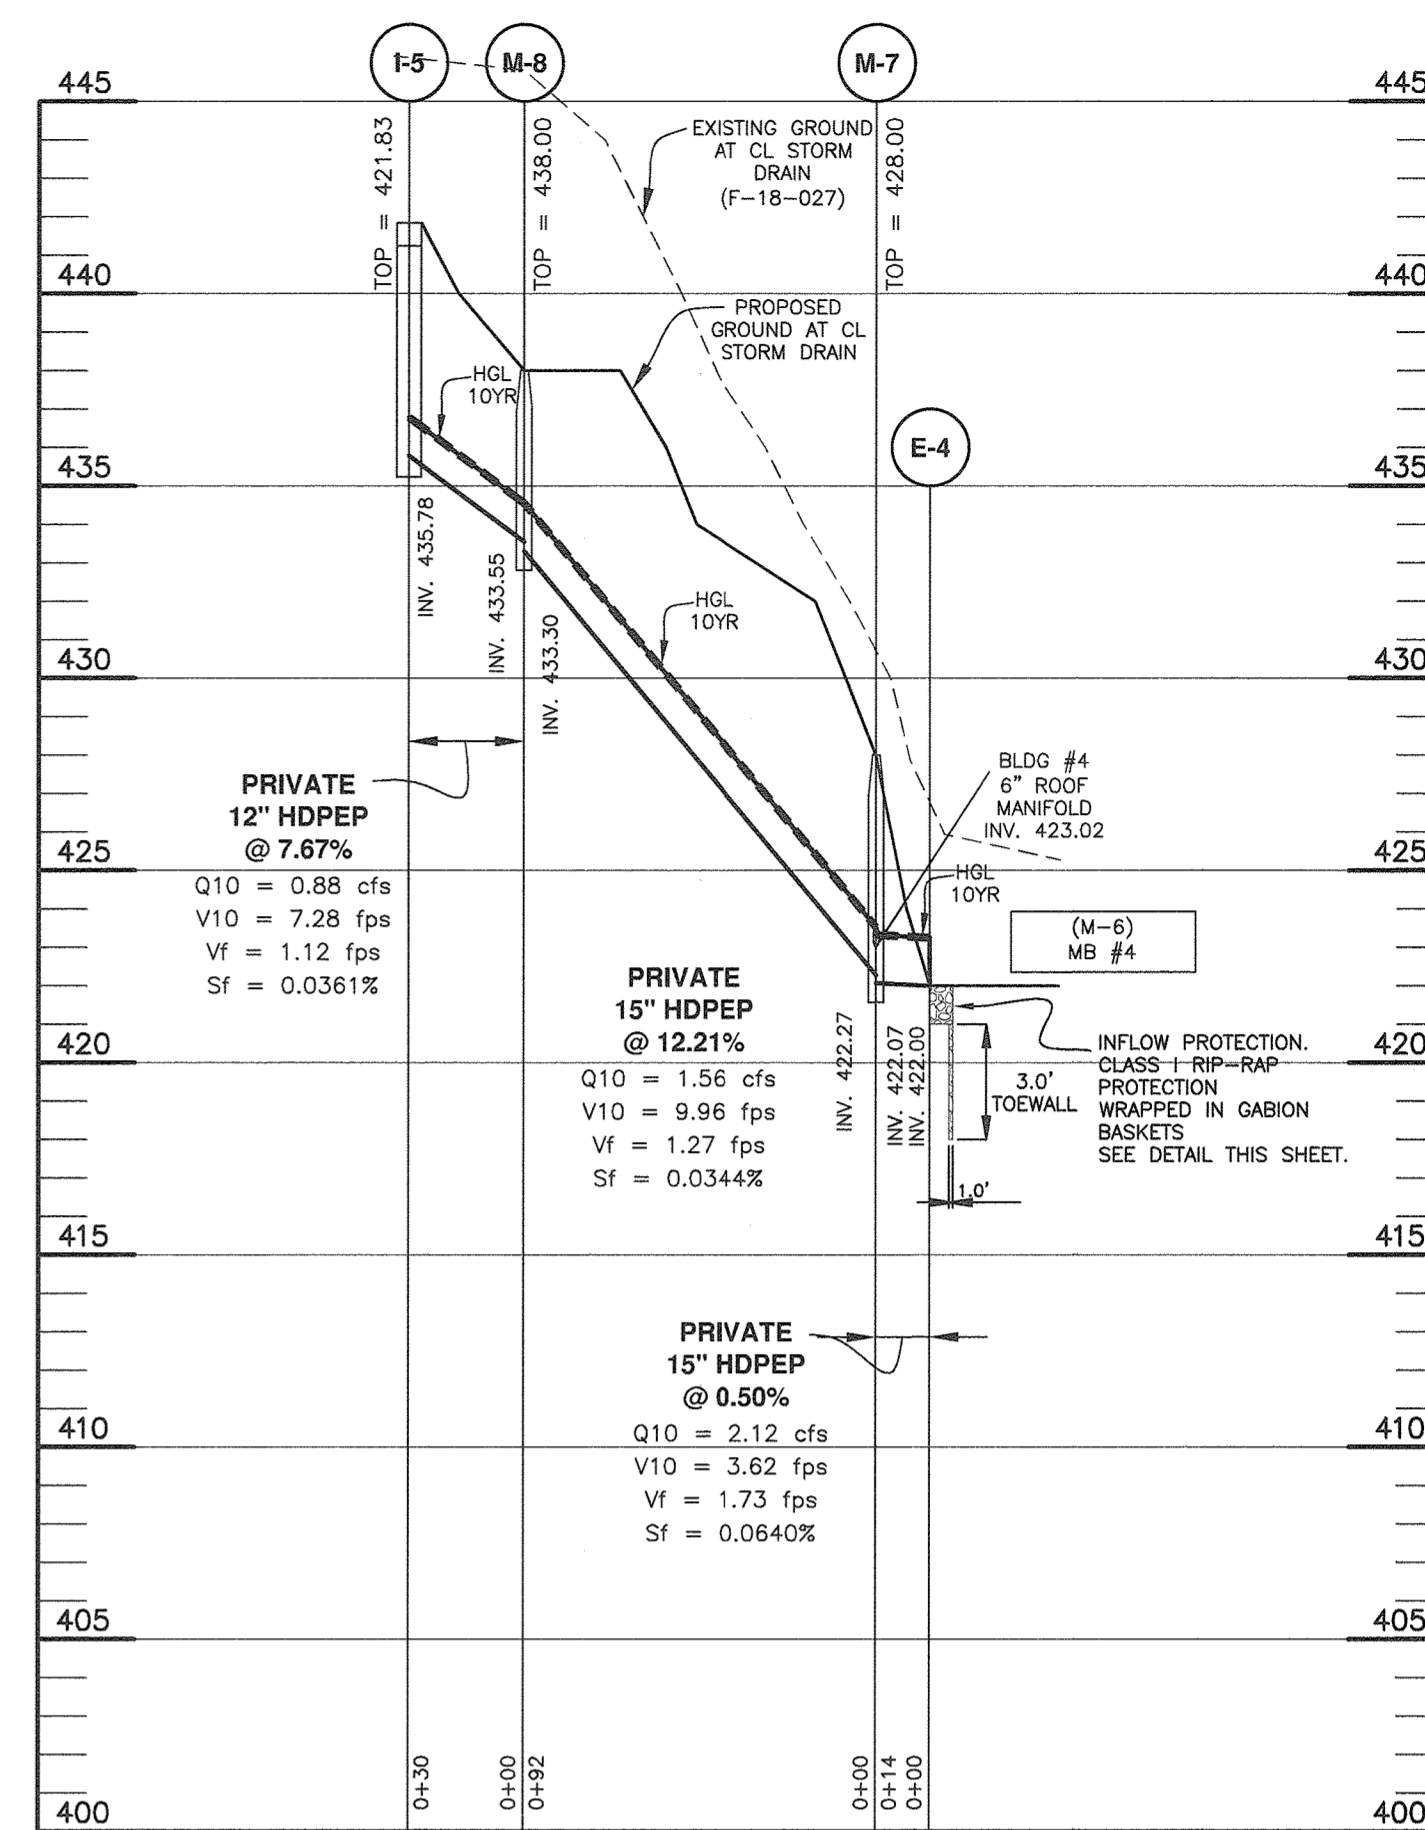

STORM DRAIN PROFILE
SCALE: 1"=50' HORIZ., 1"=5' VERT.

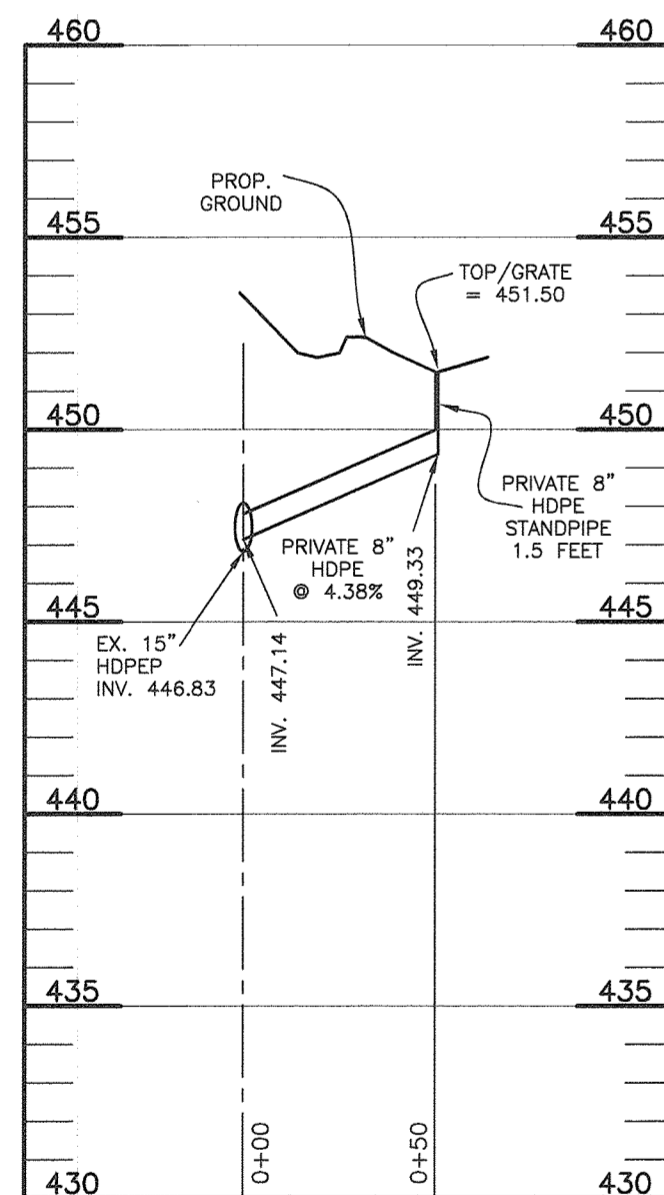

8" STORM DRAIN PROFILE
SCALE: 1"=50' HORIZ., 1"=5' VERT.

ADS, Inc. Drainage Handbook Specifications • 1-36

ADS FLARED END SECTION SPECIFICATION

Scope
This specification describes 12- through 36-inch (300 to 900mm) ADS Flared End Sections for use in culvert and drainage outlet applications.

Requirements
The ADS Flared End Section shall be high density polyethylene meeting ASTM D3350 minimum cell classification 213320C, contact manufacturer for additional cell classification information. When provided, the metal threaded fastening rod shall be stainless steel.

Installation
Installation shall be in accordance with ADS installation instructions and with those issued by state or local authorities. Contact your local ADS representative or visit www.ads-pipe.com for the latest installation instructions.

Element	12	18	24	30	36
A (in)	(30)	(45)	(60)	(75)	(90)
B (in)	(18)	(27)	(36)	(45)	(54)
C (in)	(12)	(18)	(24)	(30)	(36)
D (in)	(12)	(18)	(24)	(30)	(36)
Product detail may differ slightly from actual product appearance.

© ADS, Inc., January 2019

STRUCTURE	TYPE	HO.CO. STD. DETAIL	LOCATION	INVERT IN	INVERT OUT	TOP ELEVATION	MAINTENANCE
INLETS							
I-1	A-5	D-4.02	N 593866.27 E 1350416.59	445.29 (12")	-	439.10 (15")	PRIVATE
I-2	A-5	D-4.02	N 593919.55 E 1350381.55	446.57 (12")	-	446.57 (12")	PRIVATE
I-3	A-5	D-4.02	N 593717.26 E 1350503.35	-	-	447.62 (12")	PRIVATE
I-4	A-5	D-4.02	N 593569.60 E 1350630.11	-	-	443.51 (12")	PRIVATE
I-5	A-5	D-4.02	N 593530.72 E 1350788.48	-	-	435.78 (12")	PRIVATE
CO-1	4" curb opening	N/A	N 594009.39 E 1350473.28	450.58	-	TC=451.18	PRIVATE
CO-2	4" curb opening	N/A	N 593700.10 E 1350676.07	447.21	-	TC=447.81	PRIVATE
CO-3	4" curb opening	N/A	N 593593.66 E 1350813.06	440.74	-	TC=441.34	PRIVATE
MANHOLES							
M-1	4' Diameter Pre-Cast	G-5.12	N 593731.24 E 1350328.21	436.40 (15")	-	436.20	PRIVATE
M-2	4' Diameter Pre-Cast	G-5.12	N 593806.82 E 1350326.18	436.98 (15")	437.73 (6")	436.78	PRIVATE
M-3	4' Diameter Pre-Cast	G-5.12	N 593653.61 E 1350411.10	437.45 (15")	438.20 (6")	437.25 (15")	PRIVATE
M-4	4' Diameter Pre-Cast	G-5.12	N 593697.08 E 1350492.18	446.74 (12")	447.49 (6")	438.36 (15")	PRIVATE
M-5	4' Diameter Pre-Cast	G-5.12	N 593499.16 E 1350559.49	431.41 (15")	432.16 (6")	431.21 (15")	PRIVATE
M-6	4' Diameter Pre-Cast	G-5.12	N 593554.15 E 1350818.04	442.71 (12")	443.21 (6")	437.00 (15")	PRIVATE
M-7	4' Diameter Pre-Cast	G-5.12	N 593417.66 E 1350802.89	422.27 (15")	423.02 (6")	422.07 (15")	PRIVATE
M-8	4' Diameter Pre-Cast	G-5.12	N 593509.34 E 1350810.53	433.55 (12")	434.05 (6")	433.30 (15")	PRIVATE
END SECTIONS							
E-1	15" HDPEP see detail	N/A	N 593703.90 E 1350299.07	N/A	N/A	436.00	PRIVATE
E-2	15" HDPEP see detail	N/A	N 593619.22 E 1350374.46	N/A	N/A	437.00	PRIVATE
E-3	15" HDPEP see detail	N/A	N 593457.50 E 1350558.70	N/A	N/A	431.00	PRIVATE
E-4	15" HDPEP see detail	N/A	N 593409.68 E 1350814.30	N/A	N/A	422.00	PRIVATE


STRUCTURE LOCATION FOR MANHOLES IS AT THE CENTER OF THE MANHOLE.
STRUCTURE LOCATION FOR TYPE 'A-5' INLETS IS AT THE FRONT CENTER OF THE INLET.
PRECAST STRUCTURES MEETING HS-20 LOADING MAY BE USED.

SIZE	TYPE	LENGTH (LF)	MAINTENANCE
6"	HDPEP	726	PRIVATE
12"	HDPEP	136	PRIVATE
15"	HDPEP	591	PRIVATE

All HDPE pipes shall have smooth interior. No interior corrugations.

"NO AS-BUILT INFORMATION IS PROVIDED ON THIS SHEET"

Professional Certification: I hereby certify that these documents were prepared or approved by me, and that I am a duly licensed professional engineer under the laws of the State of Maryland.
License No. 21443 Expiration Date: 12-21-21

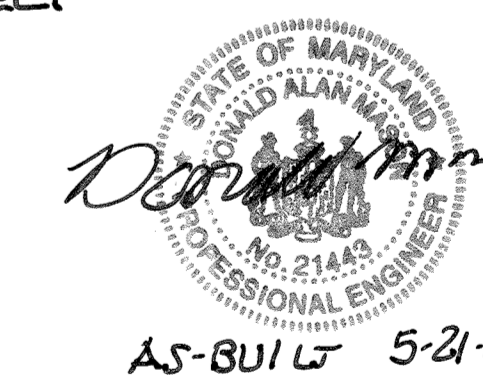


APPROVED
PLANNING BOARD OF HOWARD COUNTY
DATE AUGUST 20, 2020

APPROVED: HOWARD COUNTY DEPARTMENT OF PLANNING AND ZONING

CHIEF, DEVELOPMENT ENGINEERING DIVISION *[Signature]* 5/9/22 DATE

CHIEF, DIVISION OF LAND DEVELOPMENT *[Signature]* 5/10/22 DATE

DIRECTOR *[Signature]* 5/10/22 DATE

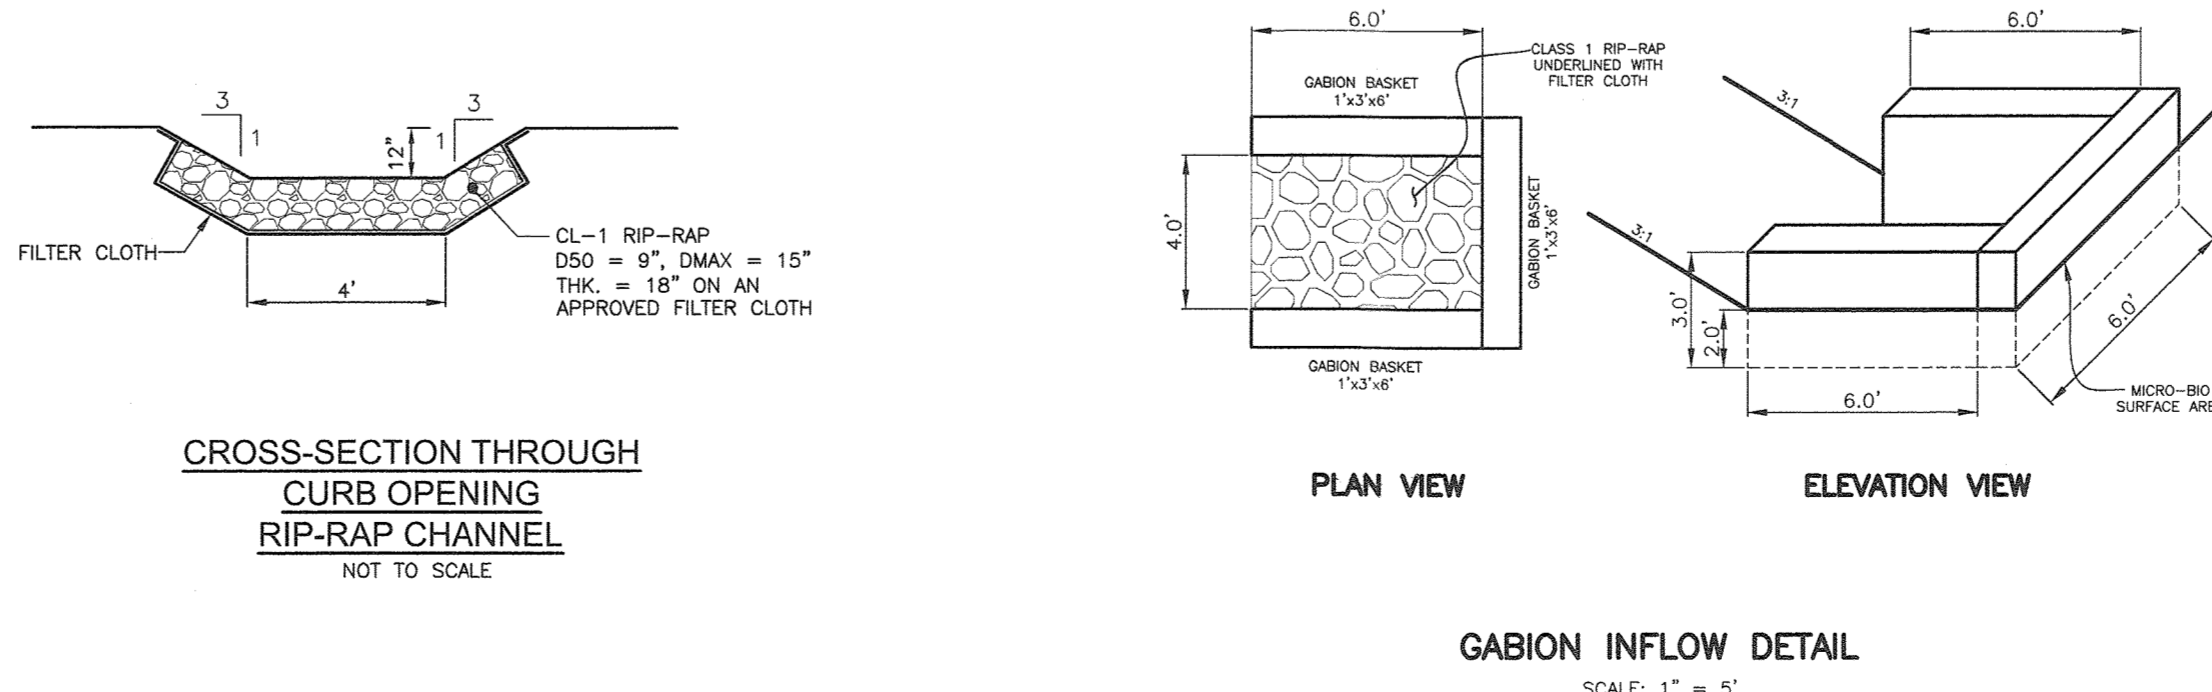

1 4.25.2022 ADD PROFILE FOR 8" HDPE. REVISE PROPOSED GROUND IN STORM DRAIN PROFILE.
NO. DATE REVISION

BENCHMARK ENGINEERING, INC.
8480 BALTIMORE NATIONAL PIKE & SUITE 315 A ELLICOTT CITY, MARYLAND 21043
(P) 410-465-6105 (F) 410-465-8644
WWW.BEI-CIVILENGINEERING.COM


RESIDENTIAL - SINGLE FAMILY ATTACHED AND MULTI-FAMILY
RAVENWOOD CONDOMINIUMS AT TURF VALLEY
LOTS 1 thru 7 AND BUILDABLE BULK PARCEL 'AA'

TAX MAP: 17, PARCEL: 706, GRID: 13
ELECTION DISTRICT NO. 2 - HOWARD COUNTY, MARYLAND
ZONED: PCCC

STORM DRAIN PROFILES AND DETAILS PARCEL 'AA'


DATE: AUGUST 27, 2020 BEI PROJECT NO. 2931
DESIGN: DBT DRAFT: DBT SCALE: AS SHOWN SHEET 12 OF 23

NRCS SOILS CHART - HoCo Soils Map No. 12			
SYMBOL	HYDRIC	GROUP	MAP UNIT NAME
GbB		B	GLENELG LOAM, 3 TO 8 PERCENT SLOPES
GcC		B	GLENELG LOAM, 8 TO 15 PERCENT SLOPES
BaA	YES	C	GLENVILLE SILT LOAM, 0 TO 3 PERCENT SLOPES

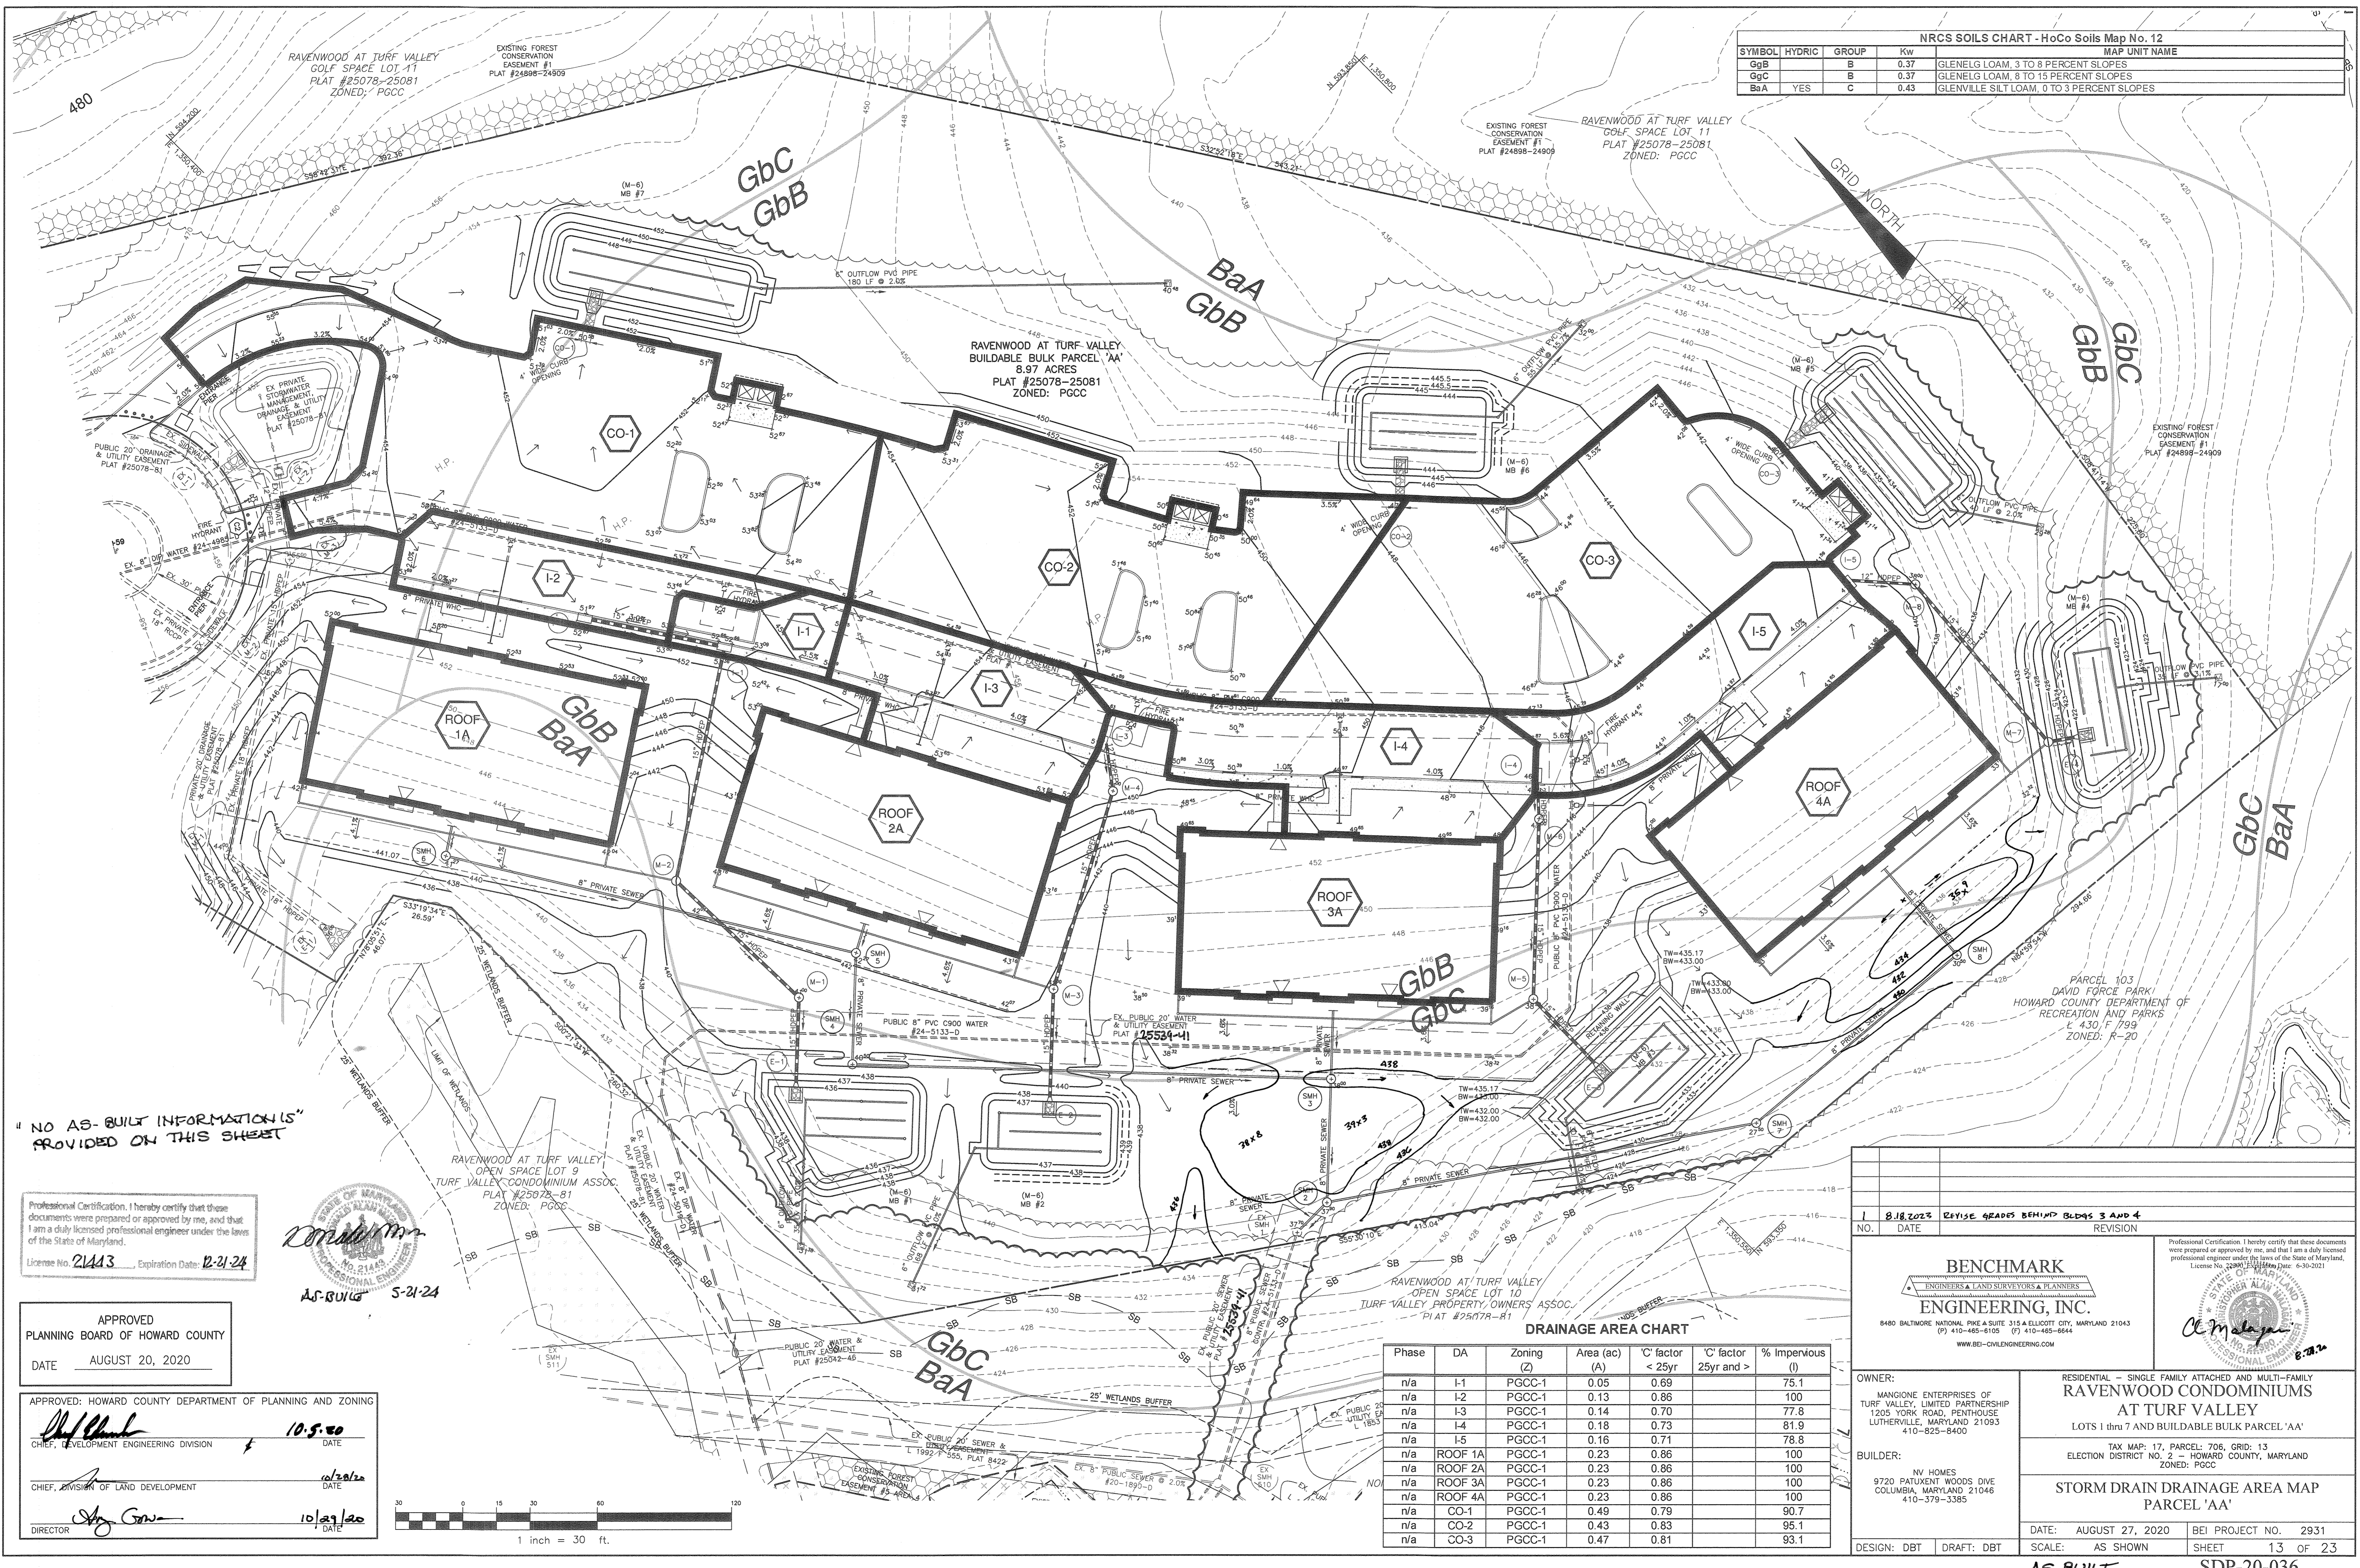


"NO AS-BUILT INFORMATION IS PROVIDED ON THIS SHEET"

Professional Certification. I hereby certify that these documents were prepared or approved by me, and that I am a duly licensed professional engineer under the laws of the State of Maryland.
 License No. 21443 Expiration Date: 12-21-24

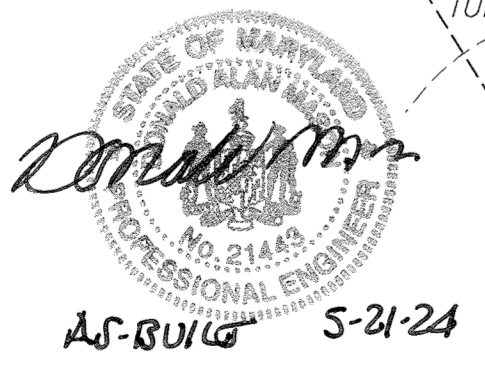

APPROVED
 PLANNING BOARD OF HOWARD COUNTY
 DATE AUGUST 20, 2020



APPROVED: HOWARD COUNTY DEPARTMENT OF PLANNING AND ZONING
 Chief, Development Engineering Division: 10/5/20
 Chief, Division of Land Development: 10/20/20
 Director: 10/29/20

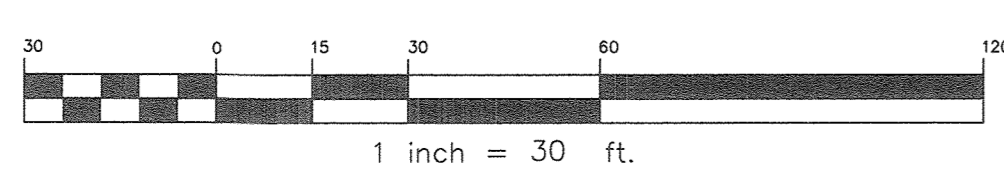




DRAINAGE AREA CHART

Phase	DA	Zoning (Z)	Area (ac) (A)	'C' factor < 25yr	'C' factor 25yr and >	% Impervious (I)
n/a	I-1	PGCC-1	0.05	0.69		75.1
n/a	I-2	PGCC-1	0.13	0.86		100
n/a	I-3	PGCC-1	0.14	0.70		77.8
n/a	I-4	PGCC-1	0.18	0.73		81.9
n/a	I-5	PGCC-1	0.16	0.71		78.8
n/a	ROOF 1A	PGCC-1	0.23	0.86		100
n/a	ROOF 2A	PGCC-1	0.23	0.86		100
n/a	ROOF 3A	PGCC-1	0.23	0.86		100
n/a	ROOF 4A	PGCC-1	0.23	0.86		100
n/a	CO-1	PGCC-1	0.49	0.79		90.7
n/a	CO-2	PGCC-1	0.43	0.83		95.1
n/a	CO-3	PGCC-1	0.47	0.81		93.1

8.18.2023 REVISE GRADES BEHIND BLDGS 3 AND 4 NO. DATE REVISION	
BENCHMARK ENGINEERING, INC. ENGINEERS & LAND SURVEYORS & PLANNERS 8480 BALTIMORE NATIONAL PIKE & SUITE 315 ELLICOTT CITY, MARYLAND 21043 (P) 410-465-6105 (F) 410-465-6644 WWW.BEI-CIVILENGINEERING.COM	
OWNER: MANGIONE ENTERPRISES OF TURF VALLEY, LIMITED PARTNERSHIP 1205 YORK ROAD, PENTHOUSE LUTHERVILLE, MARYLAND 21093 410-825-8400	RESIDENTIAL - SINGLE FAMILY ATTACHED AND MULTI-FAMILY RAVENWOOD CONDOMINIUMS AT TURF VALLEY LOTS 1 thru 7 AND BUILDABLE BULK PARCEL 'AA' TAX MAP: 17, PARCEL: 706, GRID: 13 ELECTION DISTRICT NO. 2 - HOWARD COUNTY, MARYLAND ZONED: PGCC
BUILDER: NV HOMES 9720 PATUXENT WOODS DIVE COLUMBIA, MARYLAND 21046 410-379-3385	STORM DRAIN DRAINAGE AREA MAP PARCEL 'AA' DATE: AUGUST 27, 2020 BEI PROJECT NO. 2931 SCALE: AS SHOWN SHEET 13 OF 23 DESIGN: DBT DRAFT: DBT

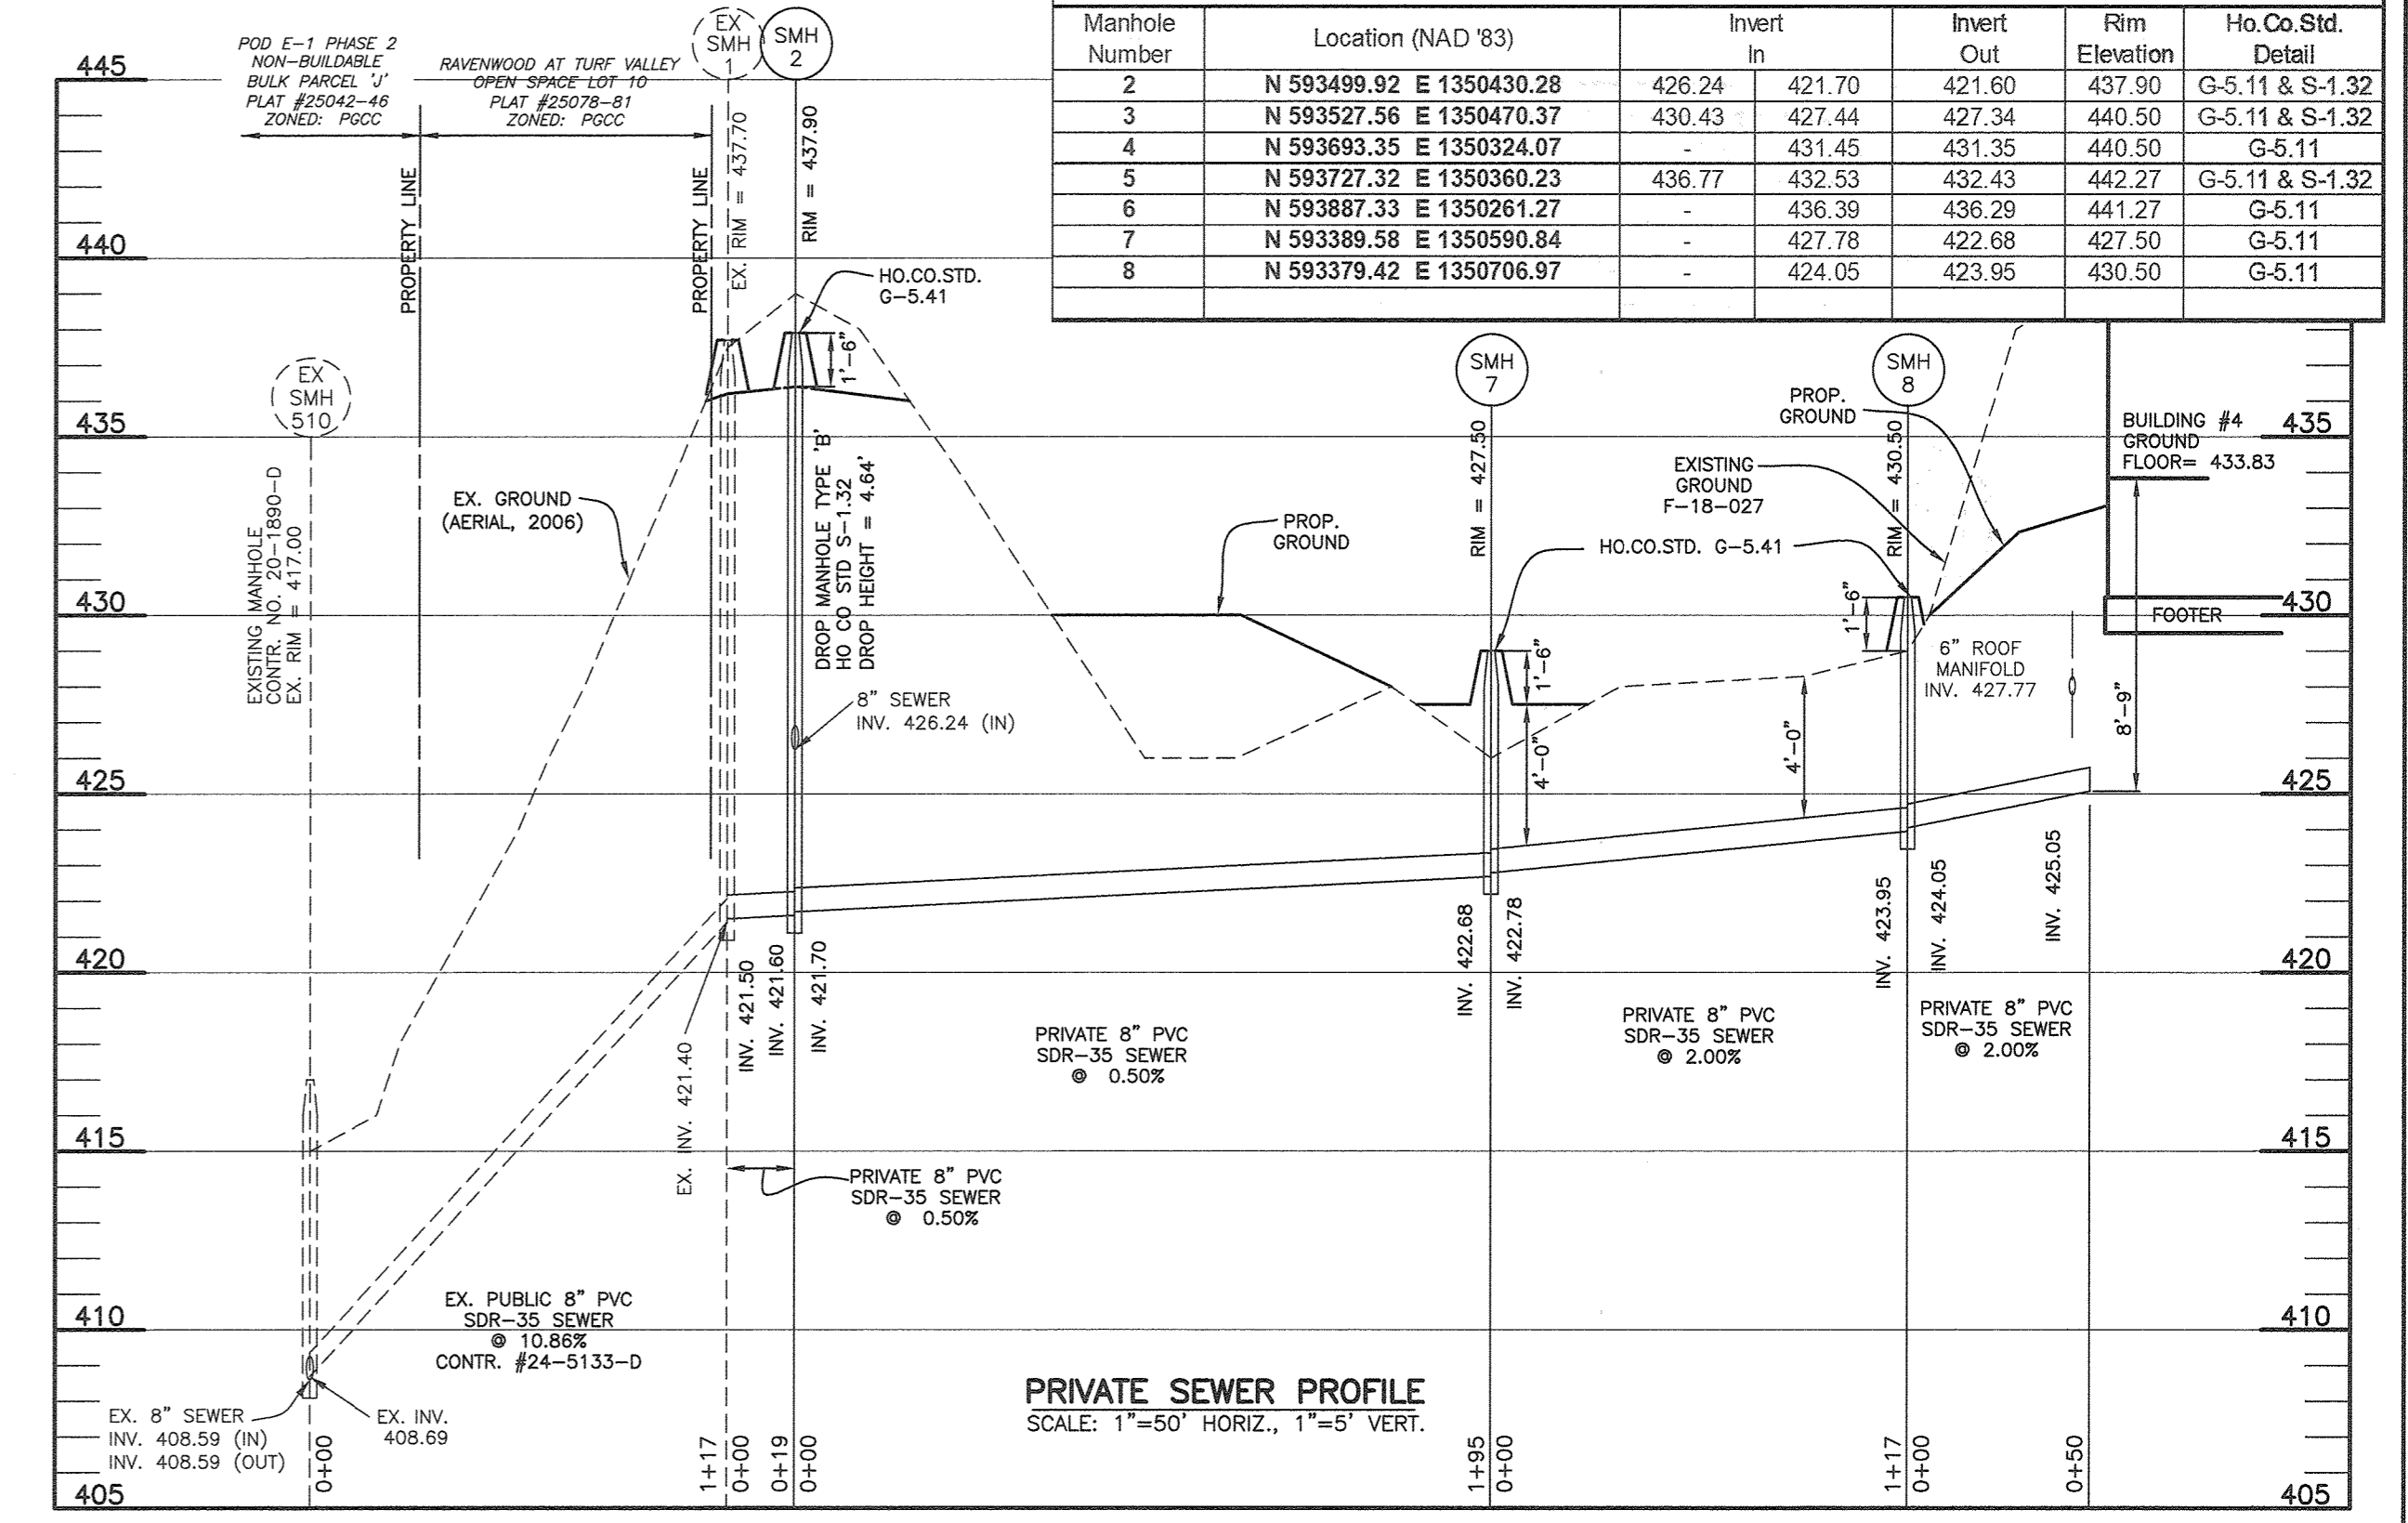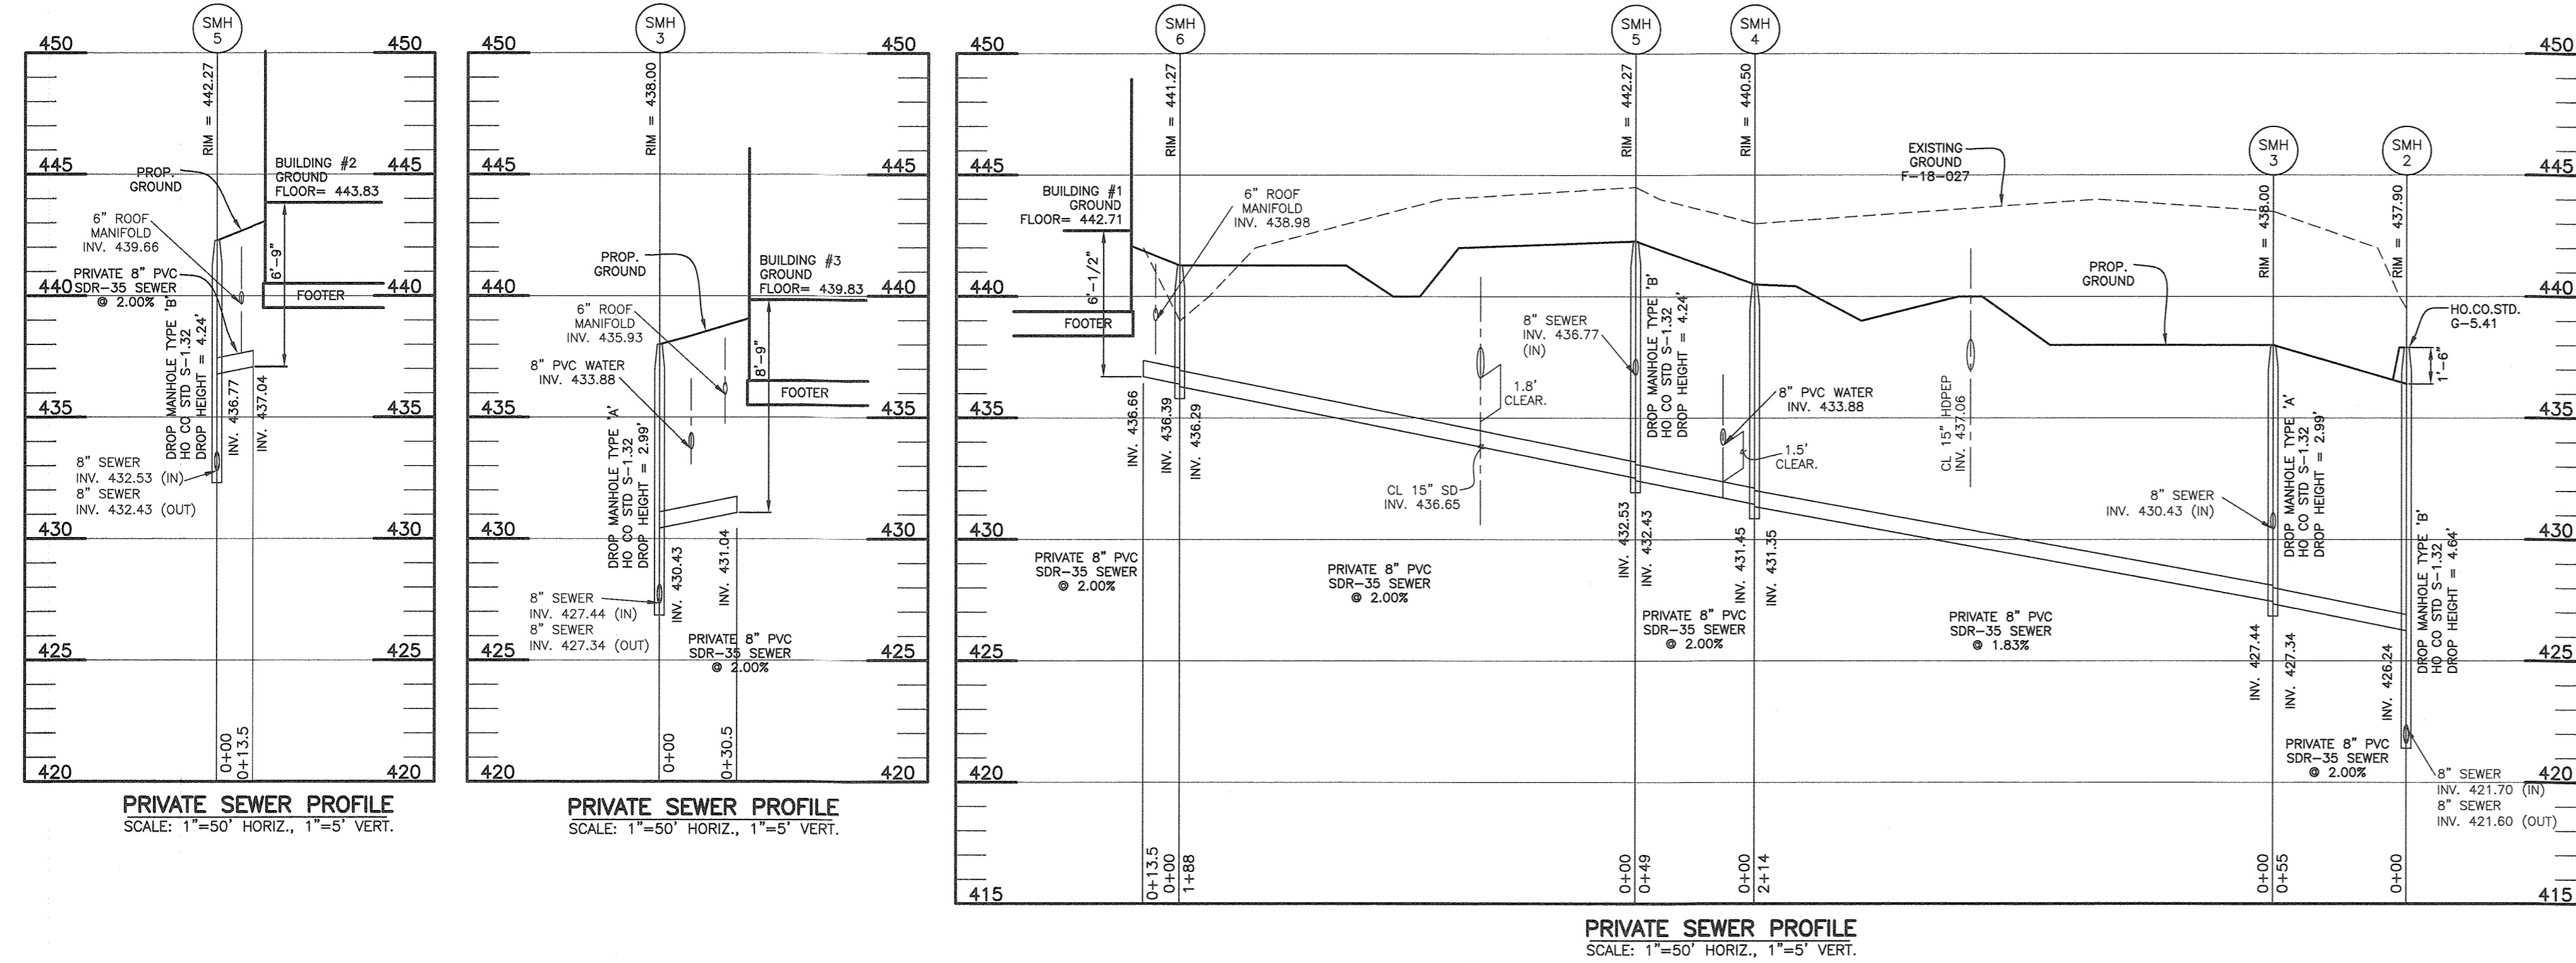


PRIVATE SEWER MANHOLE SCHEDULE						
Manhole Number	Location (NAD '83)	Invert In	Invert Out	Rim Elevation	Ho.Co.Std. Detail	
2	N 593499.92 E 1350430.28	426.24	421.70	421.60	G-5.11 & S-1.32	
3	N 593527.56 E 1350470.37	430.43	427.44	427.34	G-5.11 & S-1.32	
4	N 593693.35 E 1350324.07	-	431.45	431.35	G-5.11	
5	N 593727.32 E 1350360.23	436.77	432.83	432.43	G-5.11 & S-1.32	
6	N 593887.33 E 1350261.27	-	436.39	436.29	G-5.11	
7	N 593389.58 E 1350590.84	-	427.78	422.68	G-5.11	
8	N 593379.42 E 1350706.97	-	424.05	423.95	G-5.11	

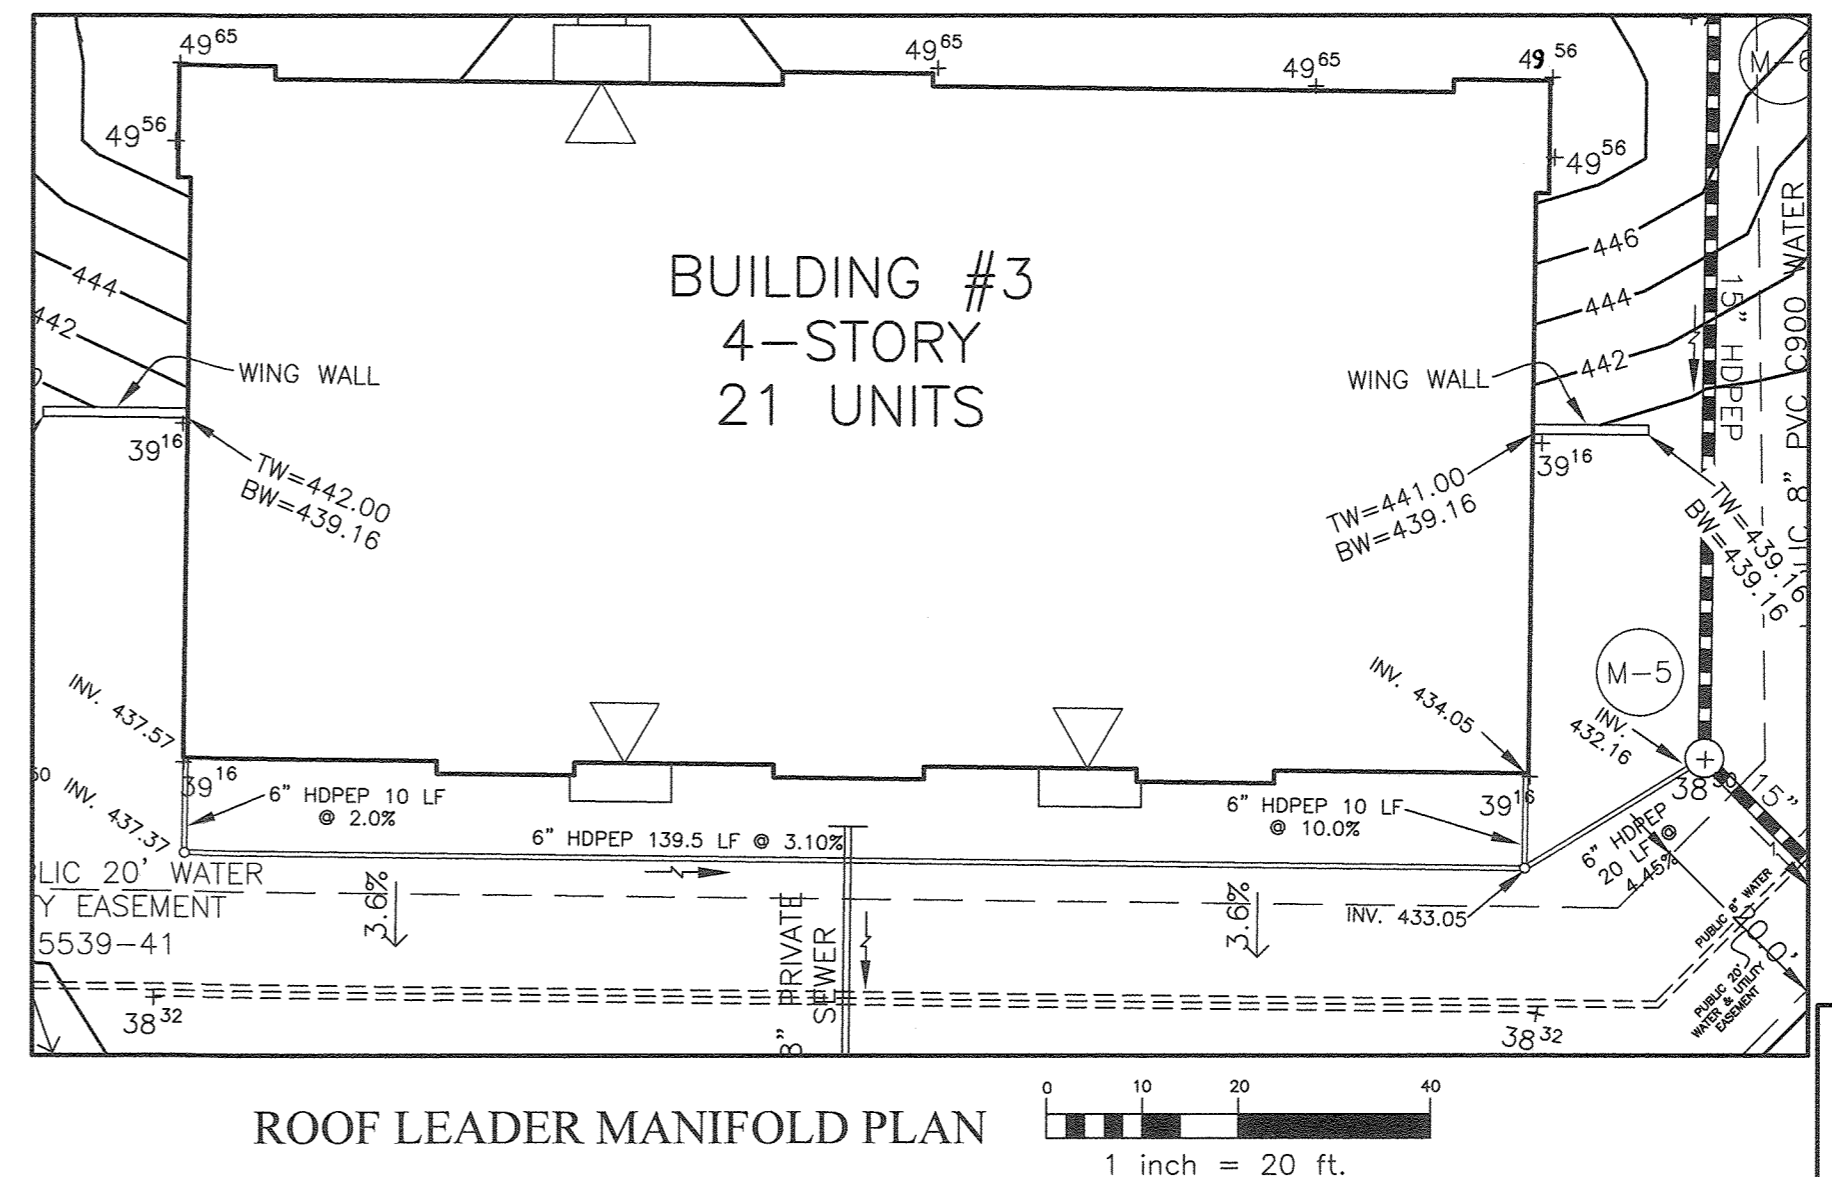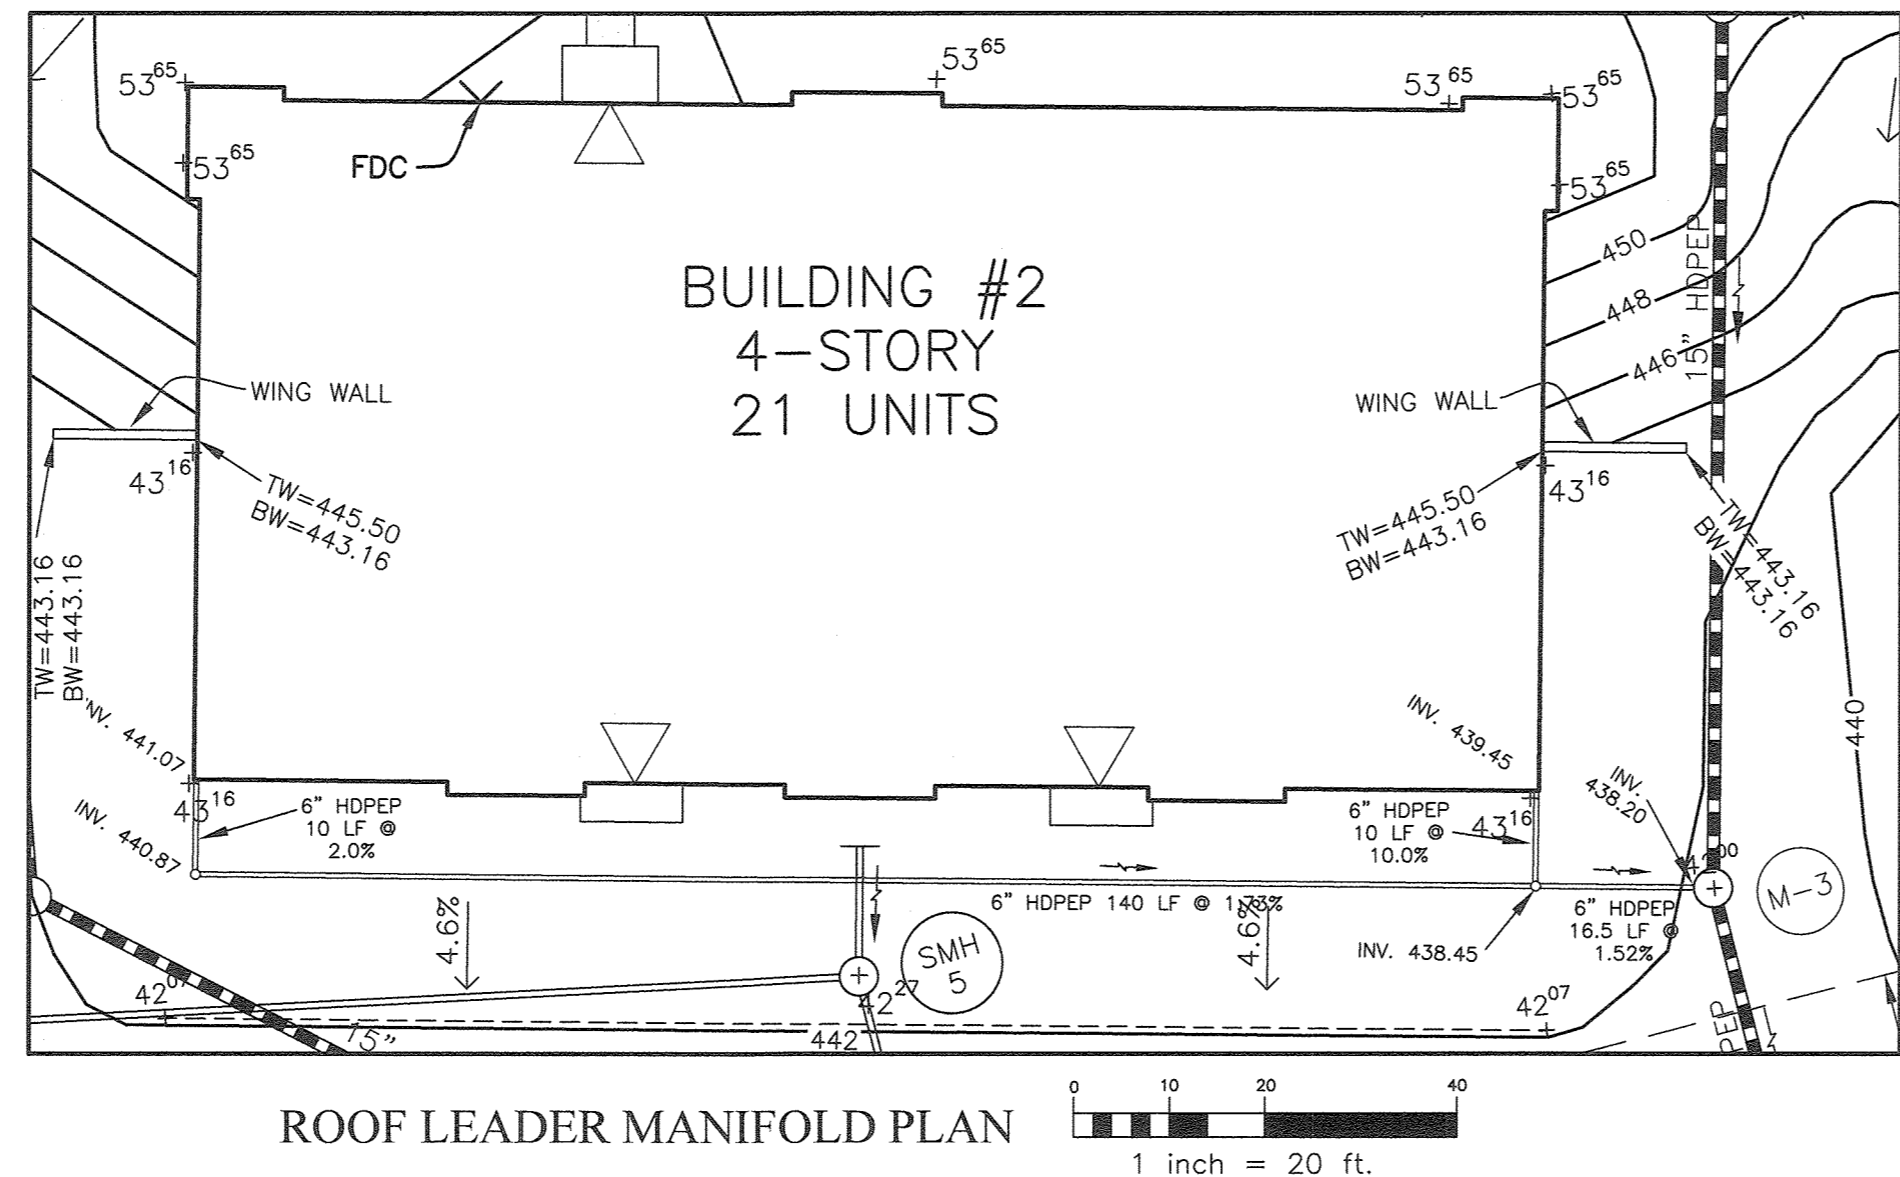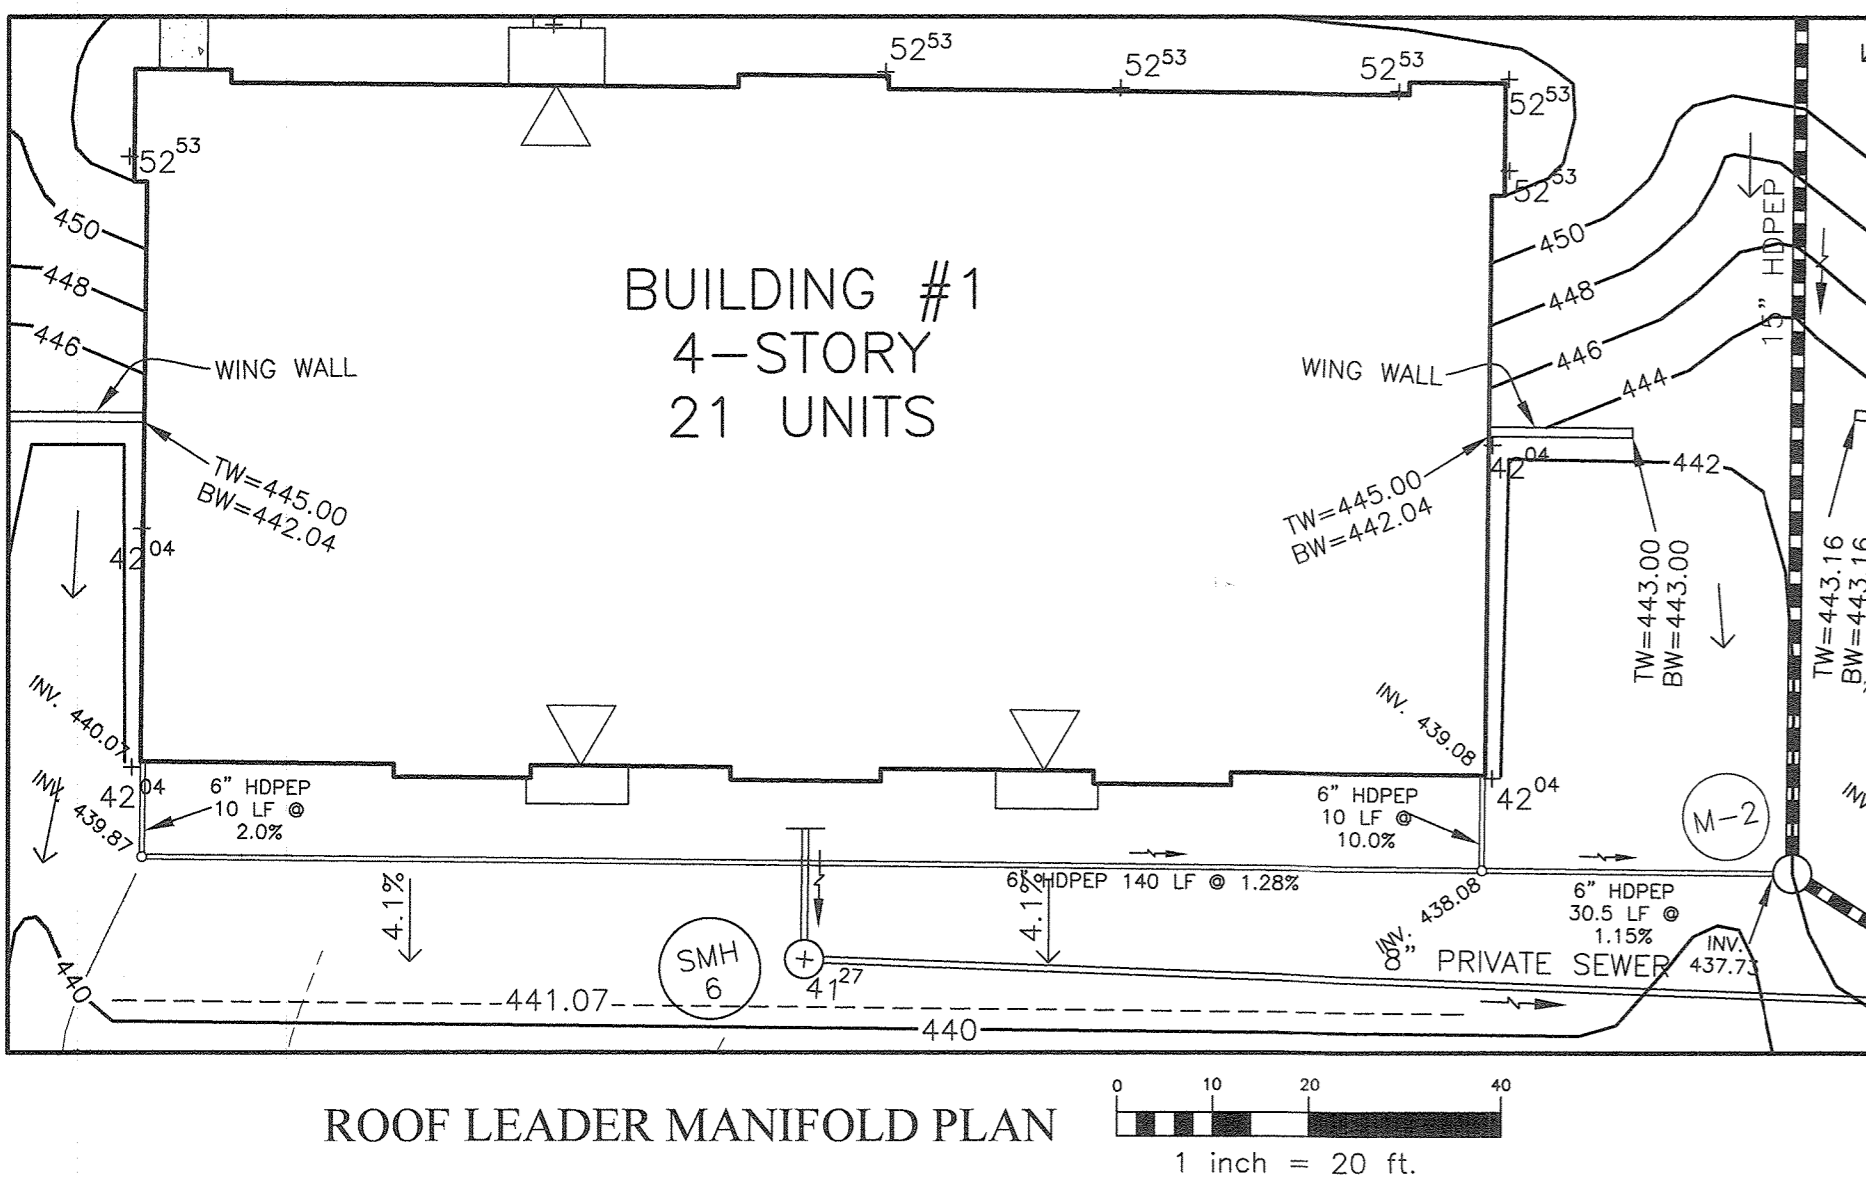






"NO AS-BUILT INFORMATION IS PROVIDED ON THIS SHEET"

Professional Certification. I hereby certify that these documents were prepared or approved by me, and that I am a duly licensed professional engineer under the laws of the State of Maryland.
 License No. 21443, Expiration Date: 12-21-24

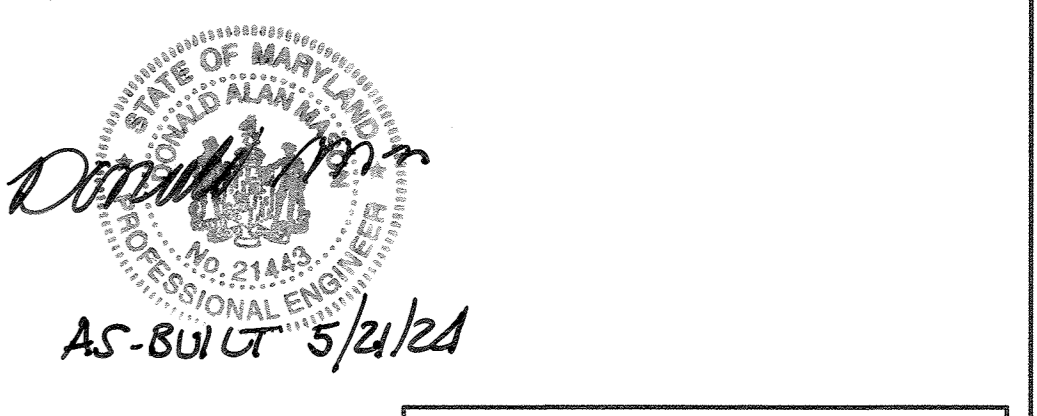

APPROVED
 PLANNING BOARD OF HOWARD COUNTY
 DATE AUGUST 20, 2020

APPROVED: HOWARD COUNTY DEPARTMENT OF PLANNING AND ZONING
 Chief, Development Engineering Division: 5/2/22
 Chief, Division of Land Development: 5/10/22
 Director: 5/10/22

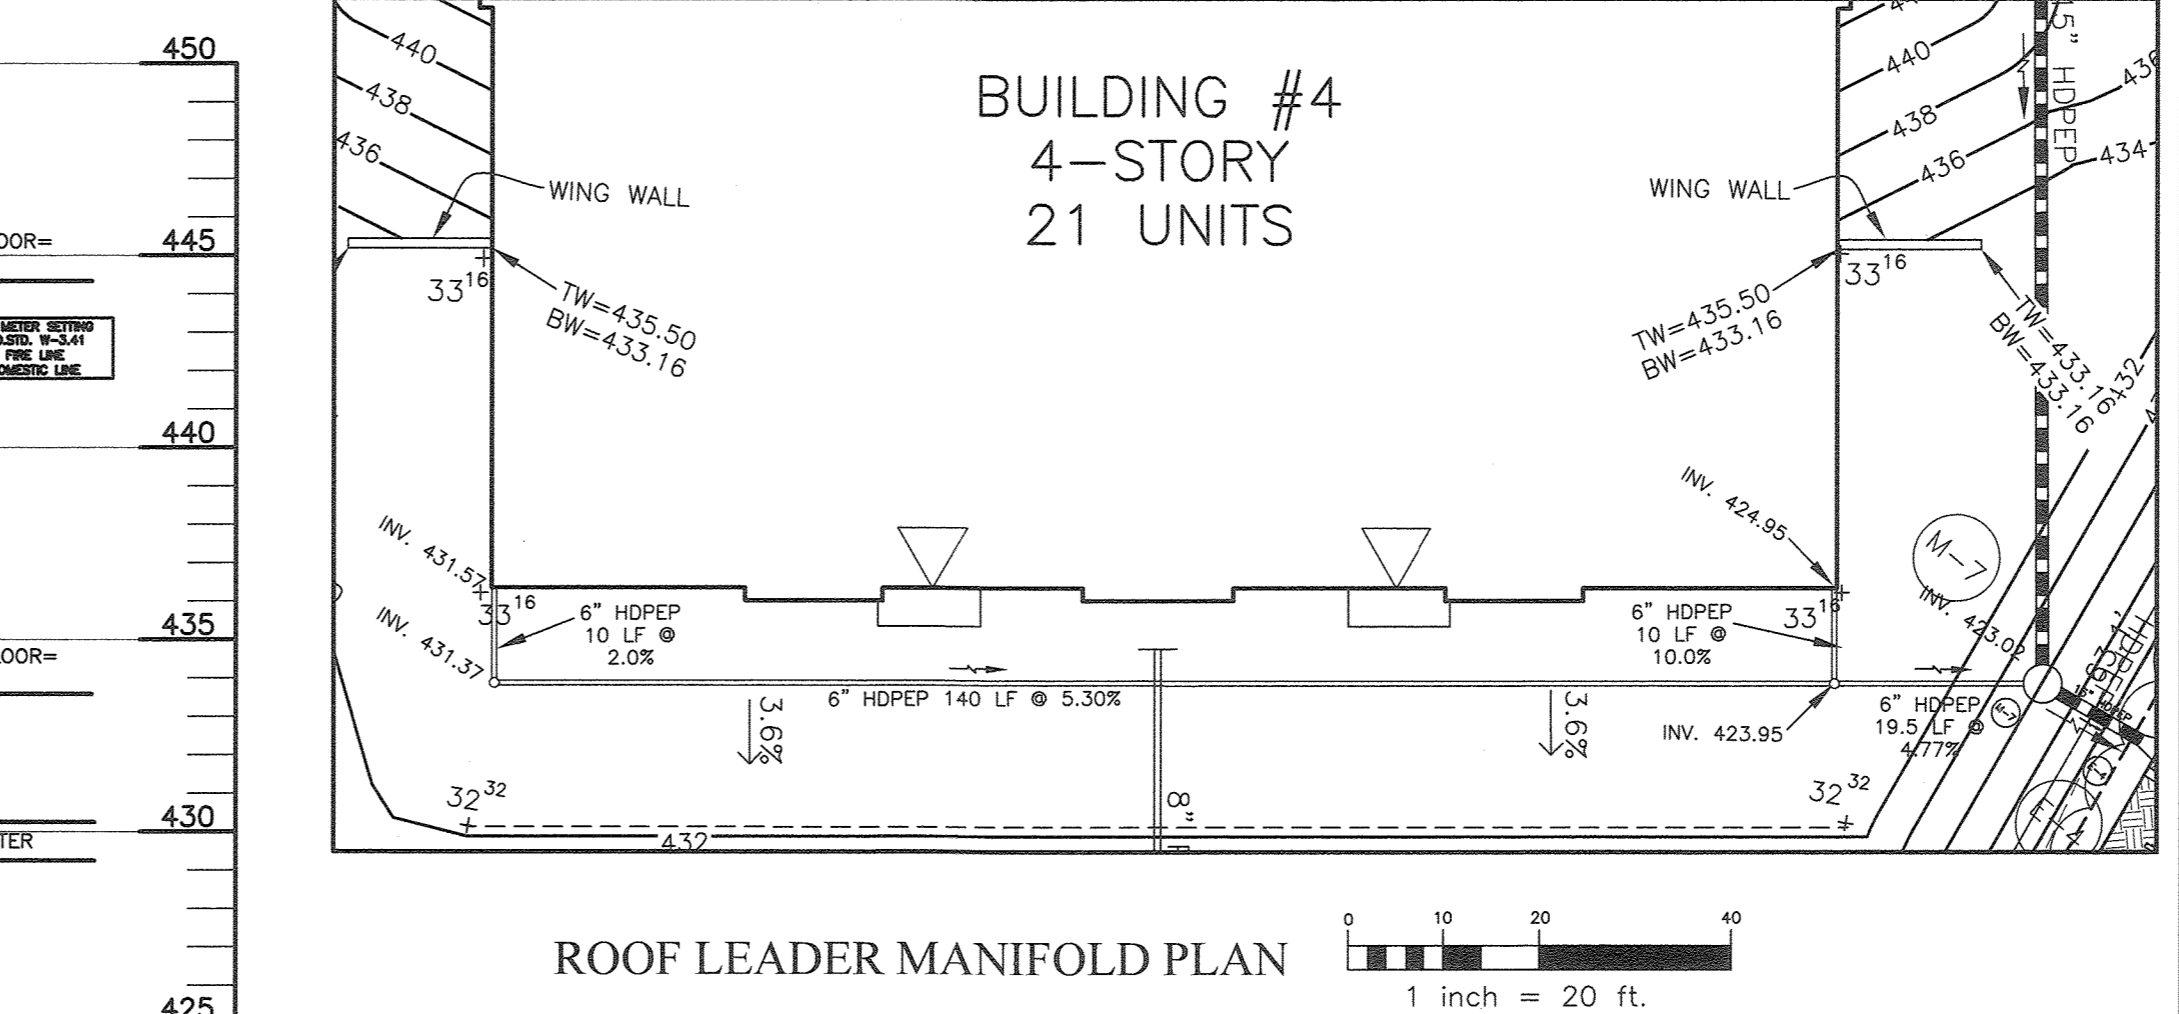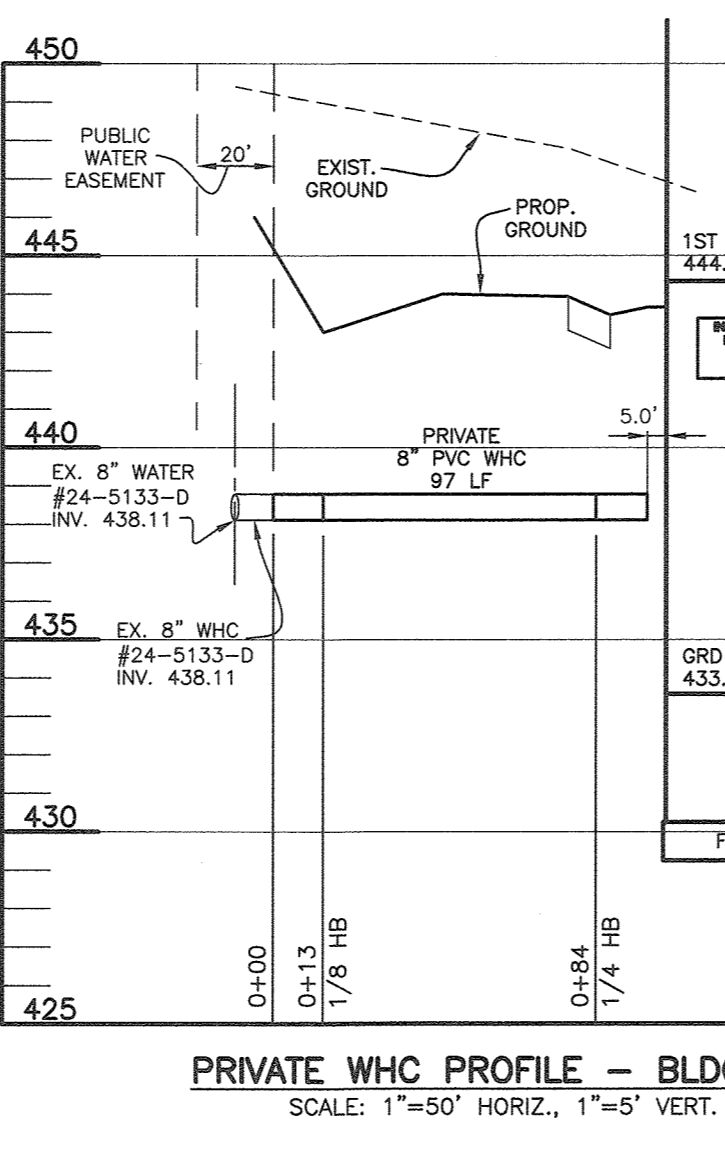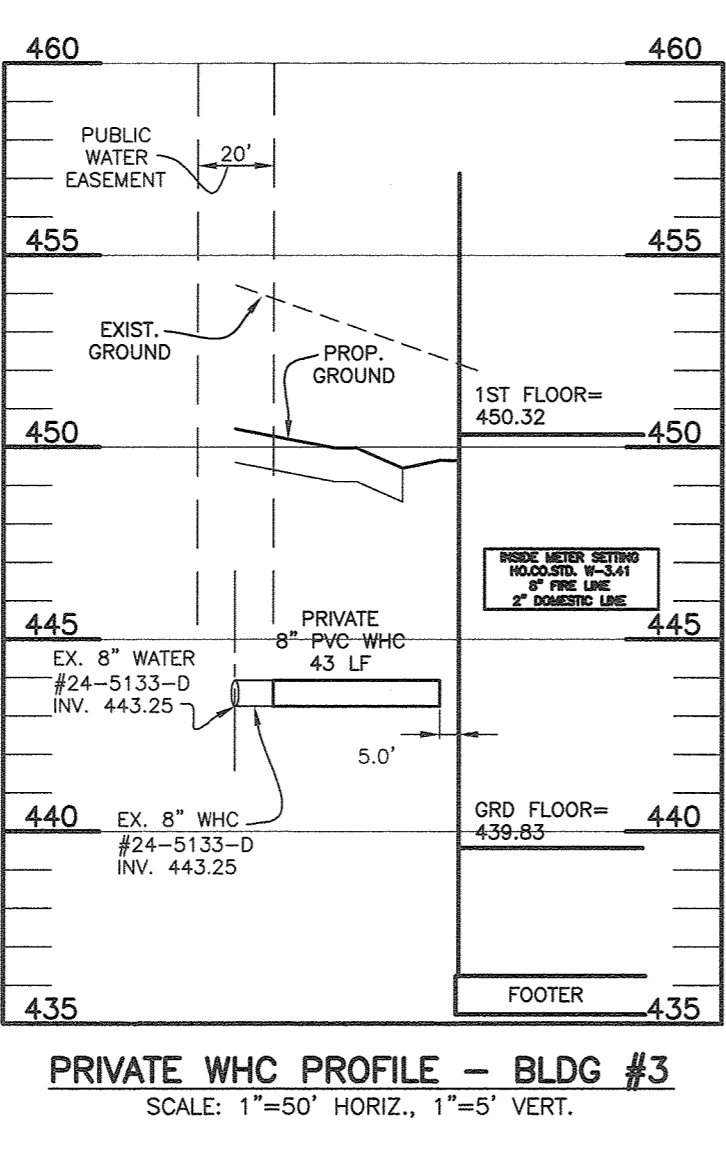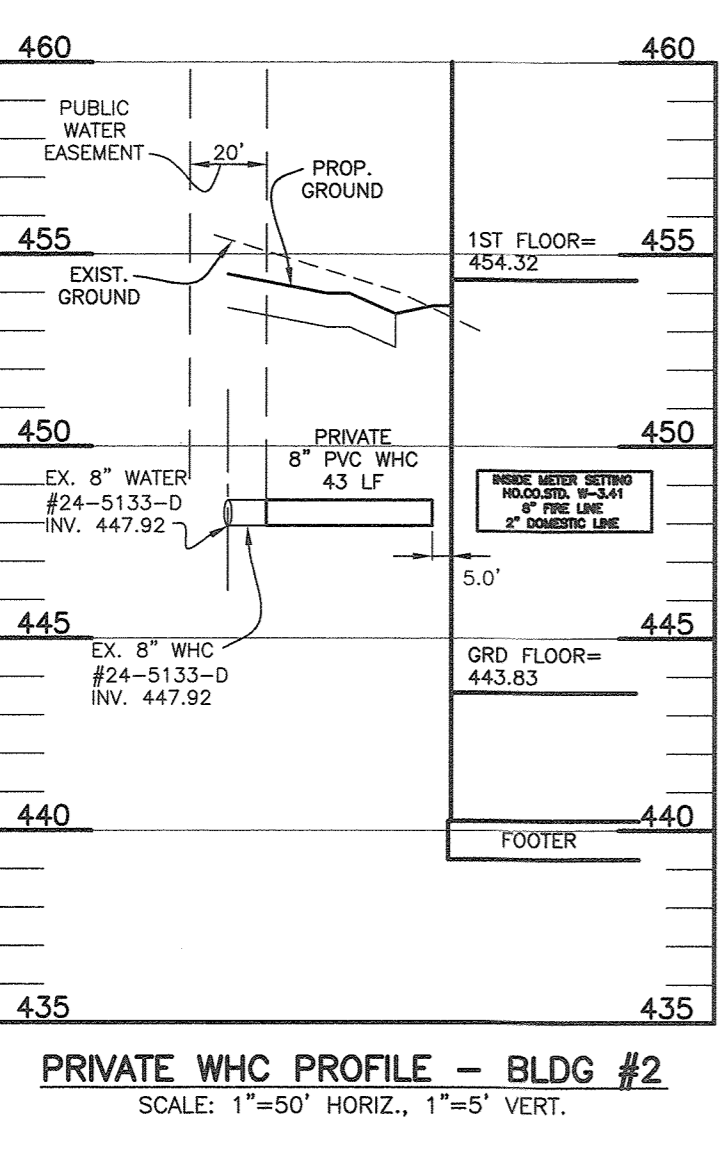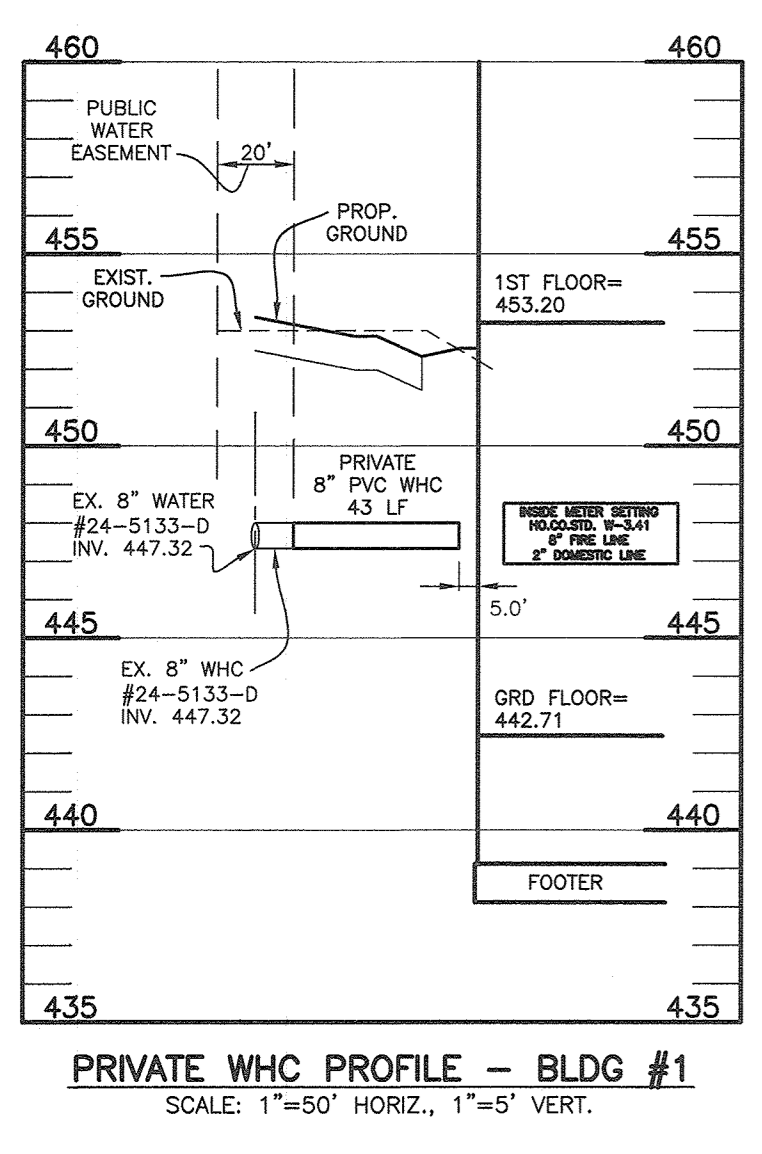

1 4.25.2022 ADD WING WALLS TO SIDES OF BUILDINGS. REVISE GRADES

BENCHMARK ENGINEERING, INC.
 8480 BALTIMORE NATIONAL PIKE SUITE 315 ELLICOTT CITY, MARYLAND 21043
 (P) 410-465-6105 (F) 410-465-6644
 WWW.BE-CIVILENGINEERING.COM

Professional Certification. I hereby certify that these documents were prepared or approved by me, and that I am a duly licensed professional engineer under the laws of the State of Maryland.
 License No. 21443, Expiration Date: 6-30-2023

OWNER: MANGIONE ENTERPRISES OF TURF VALLEY, LIMITED PARTNERSHIP
 1205 YORK ROAD, PENTHOUSE LUTHERVILLE, MARYLAND 21093
 410-825-8400

RESIDENTIAL - SINGLE FAMILY ATTACHED AND MULTI-FAMILY
RAVENWOOD CONDOMINIUMS AT TURF VALLEY
 LOTS 1 thru 7 AND BUILDABLE BULK PARCEL 'AA'

TAX MAP: 17, PARCEL: 706, GRID: 13
 ELECTION DISTRICT NO. 2 - HOWARD COUNTY, MARYLAND
 ZONED: PG00

WATER AND SEWER PROFILES AND ROOF LEADER MANIFOLD PLAN
 PARCEL 'AA'

DATE: AUGUST 27, 2020 BEI PROJECT NO. 2931
 SCALE: AS SHOWN SHEET 14 OF 23


DESIGN: DBT DRAFT: DBT

AS-BUILT SDP-20-036

NO AS-BUILT INFORMATION IS PROVIDED ON THIS SHEET

Professional Certification. I hereby certify that these documents were prepared or approved by me, and that I am a duly licensed professional engineer under the laws of the State of Maryland.
 License No. 21443 Expiration Date: 12-21-24

Professional Engineer
 David Force
 License No. 21443
 AS-BUILT 5-21-24

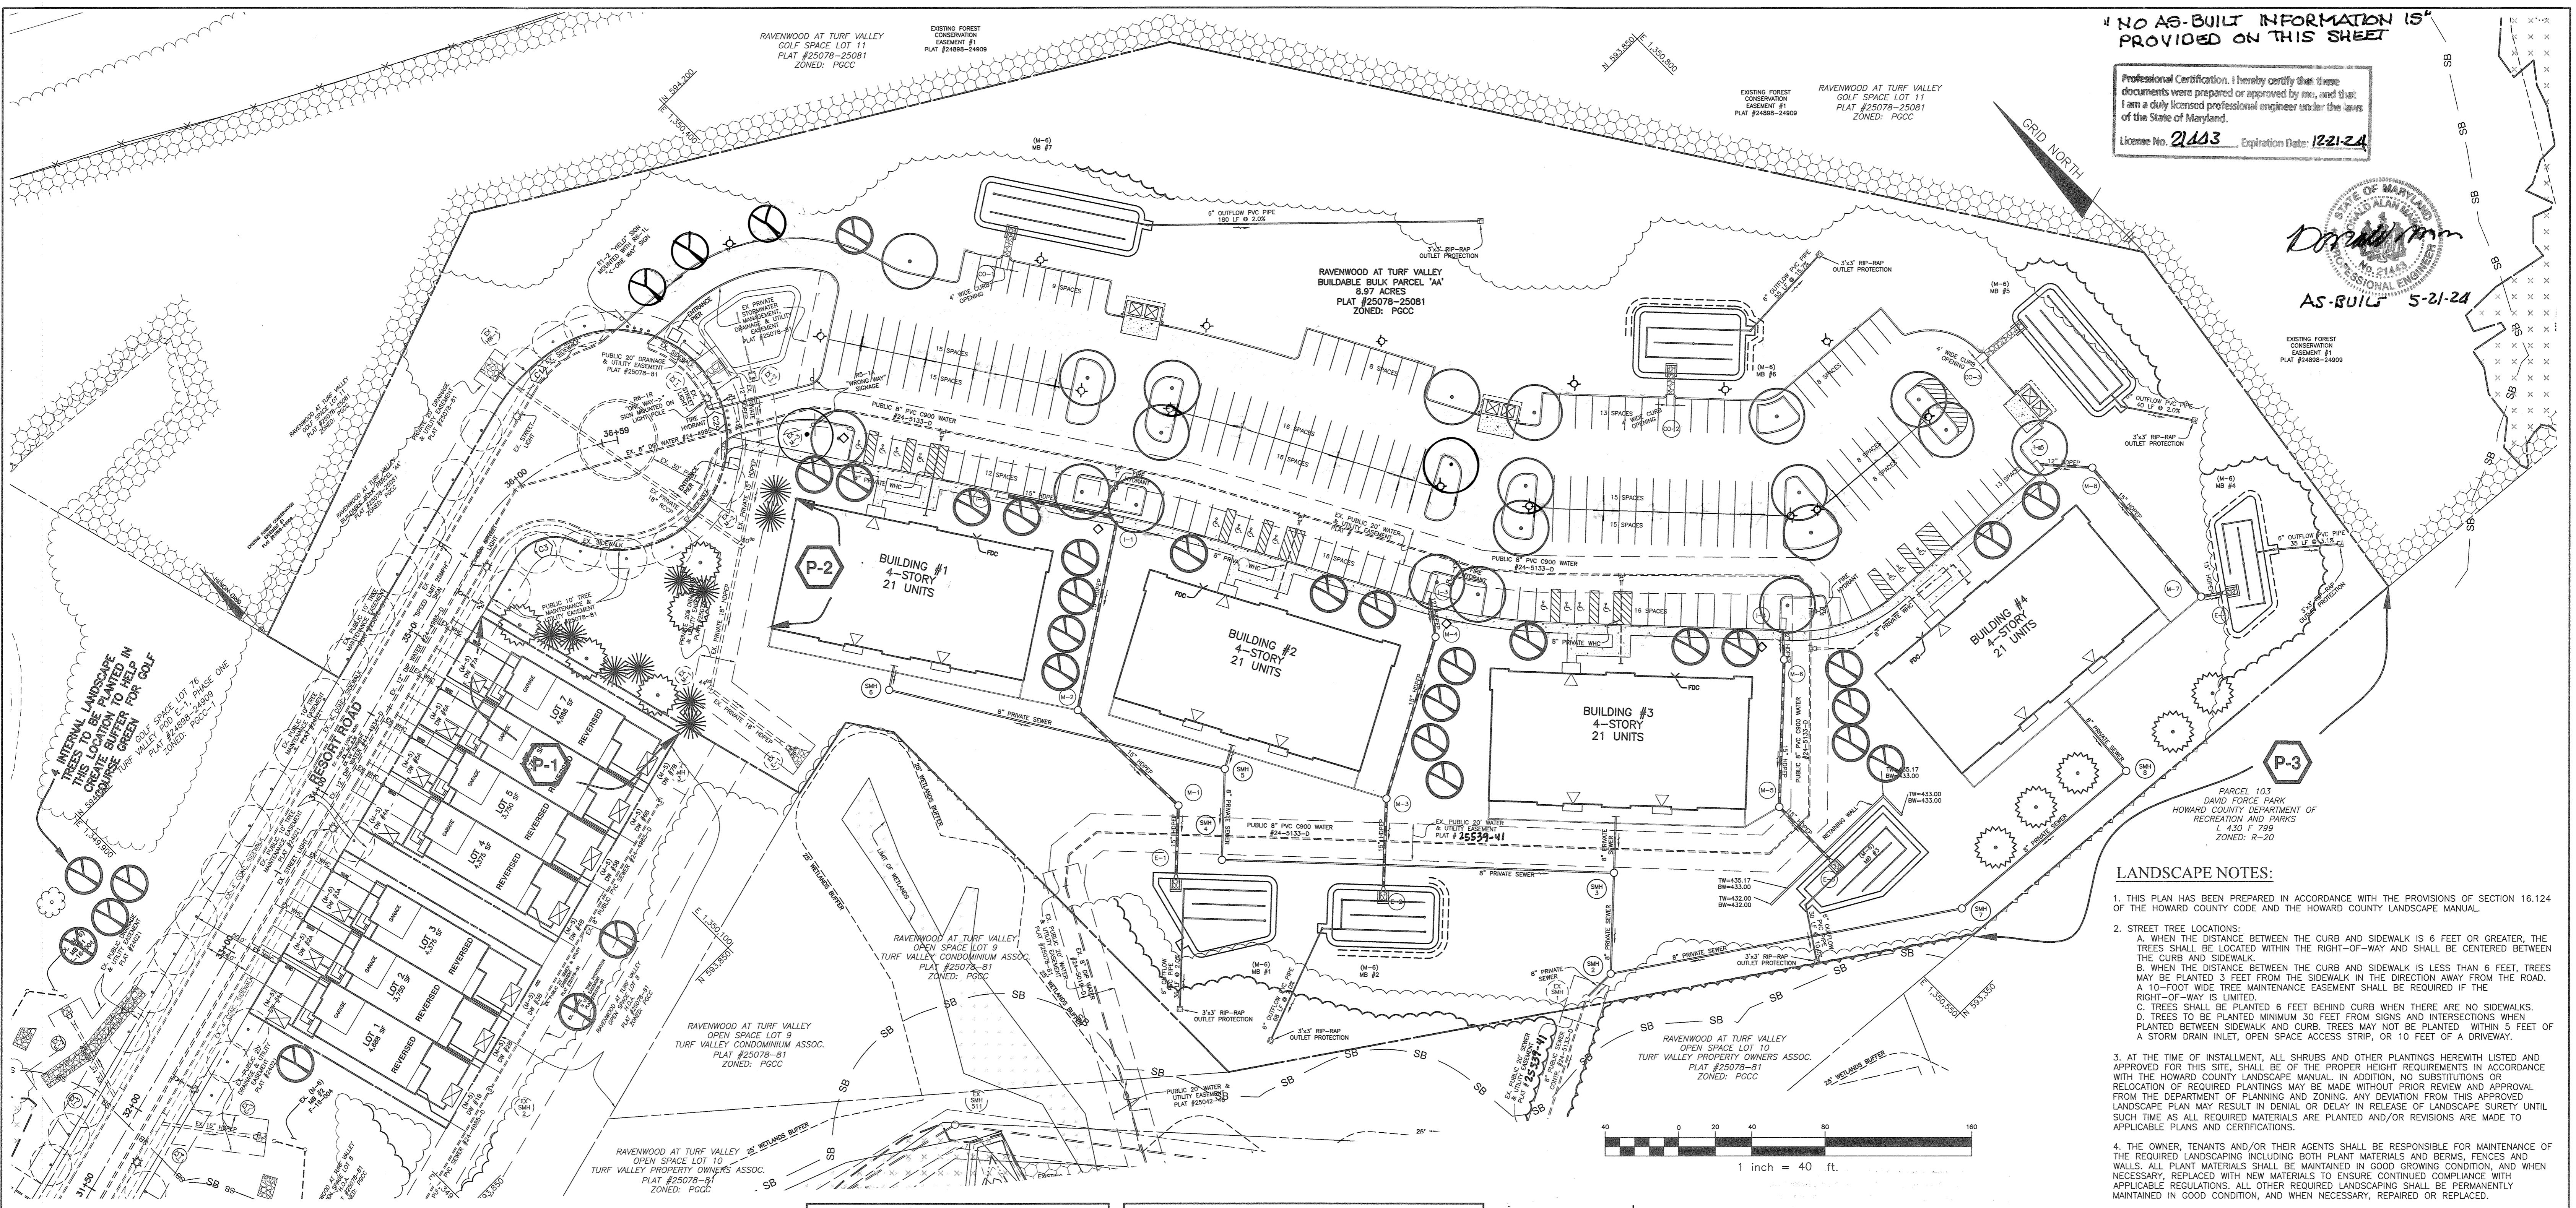

LANDSCAPE NOTES:

- THIS PLAN HAS BEEN PREPARED IN ACCORDANCE WITH THE PROVISIONS OF SECTION 16.124 OF THE HOWARD COUNTY CODE AND THE HOWARD COUNTY LANDSCAPE MANUAL.
- STREET TREE LOCATIONS:
 A. WHEN THE DISTANCE BETWEEN THE CURB AND SIDEWALK IS 6 FEET OR GREATER, THE TREES SHALL BE LOCATED WITHIN THE RIGHT-OF-WAY AND SHALL BE CENTERED BETWEEN THE CURB AND SIDEWALK.
 B. WHEN THE DISTANCE BETWEEN THE CURB AND SIDEWALK IS LESS THAN 6 FEET, TREES MAY BE PLANTED 3 FEET FROM THE SIDEWALK IN THE DIRECTION AWAY FROM THE ROAD. A 10-FOOT WIDE TREE MAINTENANCE EASEMENT SHALL BE REQUIRED IF THE RIGHT-OF-WAY IS LIMITED.
 C. TREES SHALL BE PLANTED 6 FEET BEHIND CURB WHEN THERE ARE NO SIDEWALKS.
 D. TREES TO BE PLANTED MINIMUM 30 FEET FROM SIGNS AND INTERSECTIONS WHEN PLANTED BETWEEN SIDEWALK AND CURB. TREES MAY NOT BE PLANTED WITHIN 5 FEET OF A STORM DRAIN INLET, OPEN SPACE ACCESS STRIP, OR 10 FEET OF A DRIVEWAY.
- AT THE TIME OF INSTALLMENT, ALL SHRUBS AND OTHER PLANTINGS HEREWITH LISTED AND APPROVED FOR THIS SITE, SHALL BE OF THE PROPER HEIGHT REQUIREMENTS IN ACCORDANCE WITH THE HOWARD COUNTY LANDSCAPE MANUAL. IN ADDITION, NO SUBSTITUTIONS OR RELOCATION OF REQUIRED PLANTINGS MAY BE MADE WITHOUT PRIOR REVIEW AND APPROVAL FROM THE DEPARTMENT OF PLANNING AND ZONING. ANY DEVIATION FROM THIS APPROVED LANDSCAPE PLAN WILL RESULT IN DENIAL OR DELAY IN RELEASE OF LANDSCAPE SURETY UNTIL SUCH TIME AS ALL REQUIRED MATERIALS ARE PLANTED AND/OR REVISIONS ARE MADE TO APPLICABLE PLANS AND CERTIFICATIONS.
- THE OWNER, TENANTS AND/OR THEIR AGENTS SHALL BE RESPONSIBLE FOR MAINTENANCE OF THE REQUIRED LANDSCAPING INCLUDING BOTH PLANT MATERIALS AND BERMS, FENCES AND WALLS. ALL PLANT MATERIALS SHALL BE MAINTAINED IN GOOD GROWING CONDITION, AND WHEN NECESSARY, REPLACED WITH NEW MATERIALS TO ENSURE CONTINUED COMPLIANCE WITH APPLICABLE REGULATIONS. ALL OTHER REQUIRED LANDSCAPING SHALL BE PERMANENTLY MAINTAINED IN GOOD CONDITION, AND WHEN NECESSARY, REPAIRED OR REPLACED.
- FINANCIAL SURETY IN THE AMOUNT OF \$21,300.00 FOR THE REQUIRED 66 SHADE TREES AND 10 EVERGREEN TREES SHALL BE PAID AS PART OF THE DPW DEVELOPERS AGREEMENT.


BUILDER'S CERTIFICATE

I/WE CERTIFY THAT THE LANDSCAPING SHOWN ON THIS PLAN WILL BE DONE ACCORDING TO THE PLAN, SECTION 16.124 OF THE HOWARD COUNTY SUBDIVISION AND LAND DEVELOPMENT REGULATIONS AND LANDSCAPE MANUAL. I/WE FURTHER CERTIFY THAT UPON COMPLETION OF A LETTER OF LANDSCAPE INSTALLATION, ACCOMPANIED BY AN EXECUTED ONE-YEAR GUARANTEE OF PLANT MATERIALS, WILL BE SUBMITTED TO THE DEPARTMENT OF PLANNING AND ZONING.

LOUIS MANGIONE
 MANGIONE ENTERPRISES OF TURF VALLEY, LP
 DATE: 8/27/20

APPROVED
 PLANNING BOARD OF HOWARD COUNTY
 DATE: AUGUST 20, 2020

APPROVED: HOWARD COUNTY DEPARTMENT OF PLANNING AND ZONING
 CHIEF, DEVELOPMENT ENGINEERING DIVISION
 DATE: 10.5.20
 CHIEF, DIVISION OF LAND DEVELOPMENT
 DATE: 10/29/20
 DIRECTOR

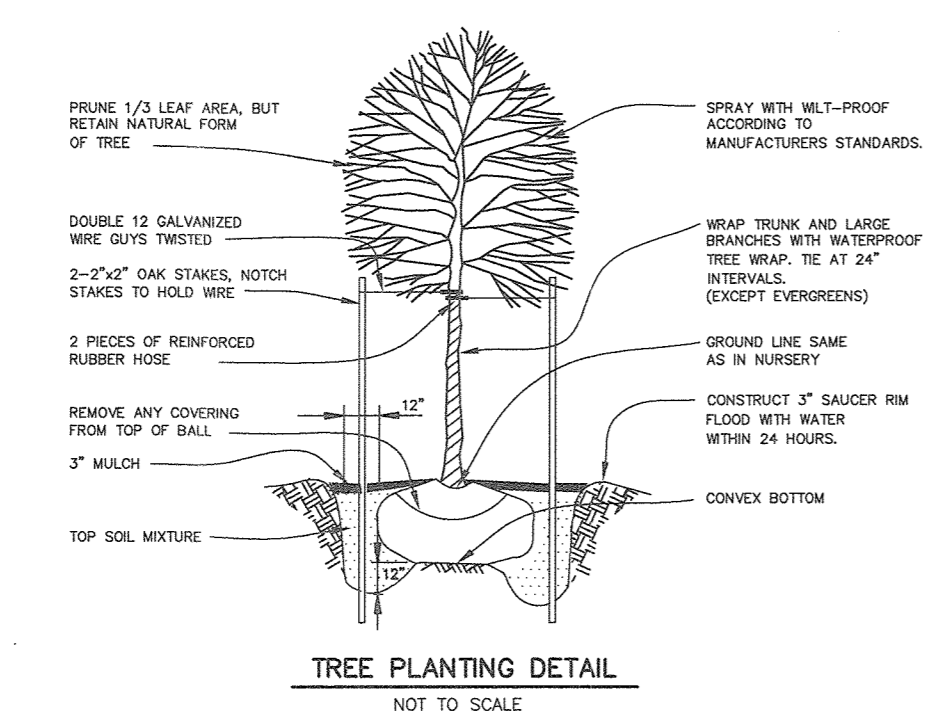

**SCHEDULE C
 RESIDENTIAL DEVELOPMENT
 INTERNAL LANDSCAPING**

	SFA	APTS
NUMBER OF DWELLING UNITS	7	84
NUMBER OF TREES REQUIRED (1:10 SFA; 1:3 DU APTS)	7	28
NUMBER OF TREES PROVIDED		
SHADE TREES	7	28
OTHER (2:1 RATIO)	0	0

**RESIDENTIAL DEVELOPMENT
 PARKING LOT LANDSCAPING**

NUMBER OF PARKING SPACES	203
REQUIREMENT	LARGE (2.5" cal) 1:10 SPACES
NUMBER OF TREES REQUIRED	21
NUMBER OF TREES PROVIDED	21

**SCHEDULE A
 PERIMETER LANDSCAPE EDGE**

CATEGORY	SFA LOT SIDE TO ROAD		APT SIDE TO ROAD		APT ADJ PROP		TOTALS
	P-1	P-2	P-2	P-3	A	B	
LANDSCAPE TYPE	C	C	C	A	A		
LINEAR FEET OF ROADWAY FRONTAGE/PERIMETER	125'	72'	1:40 shade 1:20 evergreen	1:40 shade 1:60 shade	295'		
CREDIT FOR EXISTING VEGETATION (YES, NO, LINEAR FEET) (DESCRIBE BELOW IF NEEDED)	NO	NO	NO	NO	NO		
CREDIT FOR WALL, FENCE OR BERM (YES, NO, LINEAR FEET) (DESCRIBE BELOW IF NEEDED)	NO	NO	NO	NO	NO		
NUMBER OF PLANTS REQUIRED							
SHADE TREES	3	2	5	5	10		
EVERGREEN TREES	6	4	0	0	10		
OTHER TREES (2:1 SUBSTITUTE)	0	0	0	0	0		
SHRUBS	0	0	0	0	0		
NUMBER OF PLANTS PROVIDED							
SHADE TREES	3	2	5	5	10		
EVERGREEN TREES	6	4	0	0	10		
OTHER TREES (2:1 SUBSTITUTE)	0	0	0	0	0		
SHRUBS (10:1 SUBSTITUTE)	0	0	0	0	0		

(M-6) Micro Bio-Retention Landscaping Chart

PLANT NAME	COMMON NAME	Surface Area TYPE	SIZE	MB #1 1838 QUANTITY	MB #2 1540 QUANTITY	MB #3 1483 QUANTITY	MB #4 1497 QUANTITY	MB #5 1717 QUANTITY	MB #6 1807 QUANTITY	MB #6 1862 QUANTITY
Cornus Amomum	Silky Dogwood	deciduous shrub	18-24" ht. #3 CAN	18	154	148	150	172	181	186
Echinacea Purpurea	Purple Coneflower	perennial	2 gal. container	184	154	148	150	172	181	186
Juncus Effusus	Common Rush	perennial	1 qt.	919	770	742	749	859	904	931

LANDSCAPE PLANTING LIST

SYMBOL	QUANTITY	NAME	REMARKS	DESCRIPTION
(Symbol)	35	TILIA CORDATA 'GREENSPIRE' (Greenspire Littleleaf Linden)	2.5" - 3" cal.	SHADE TREES FOR RESIDENTIAL INTERNAL LANDSCAPING TO BE PROVIDED BY THE BUILDER.
(Symbol)	21	ACER RUBRUM 'RED SUNSET' (Red Sunset Red Maple)	2.5" - 3" cal.	PARKING LOT SHADE TREES TO BE PROVIDED BY THE BUILDER.
(Symbol)	10	THUJA PLICATA 'GIANT ARBORVITAE' (Green Giant)	5' - 6' ht.	EVERGREEN TREES ALONG PERIMETER EDGES TO BE PROVIDED BY THE BUILDER.
(Symbol)	10	CLADRASIS KENTUKEA LUTEA (Yellowwood)	2.5" - 3" cal.	SHADE TREES ALONG PERIMETER EDGES TO BE PROVIDED BY THE BUILDER.
(Symbol)				EXISTING STREET TREES PER F-16-004 AND F-18-027

BENCHMARK ENGINEERING, INC.
 ENGINEERS & LAND SURVEYORS & PLANNERS
 8400 BALTIMORE NATIONAL PIKE & SUITE 315 & ELLICOTT CITY, MARYLAND 21043
 (P) 410-465-6105 (F) 410-465-6644
 WWW.BEI-CIVLENGINEERING.COM

OWNER:
 MANGIONE ENTERPRISES OF TURF VALLEY, LIMITED PARTNERSHIP
 1205 YORK ROAD, PENTHOUSE LUTHERVILLE, MARYLAND 21093
 410-825-8400








BUILDER:
 NV HOMES
 9720 PATUXENT WOODS DIVE COLUMBIA, MARYLAND 21046
 410-379-3385

**RESIDENTIAL - SINGLE FAMILY ATTACHED AND MULTI-FAMILY
 RAVENWOOD CONDOMINIUMS
 AT TURF VALLEY
 LOTS 1 thru 7 AND BUILDABLE BULK PARCEL 'AA'**


TAX MAP: 17, PARCEL: 706, GRID: 13
 ELECTION DISTRICT NO. 2 - HOWARD COUNTY, MARYLAND
 ZONED: PGCC

LANDSCAPE PLAN

DATE: AUGUST 27, 2020 BEI PROJECT NO. 2931
 SCALE: AS SHOWN SHEET 15 OF 23
 DESIGN: DBT DRAFT: DBT

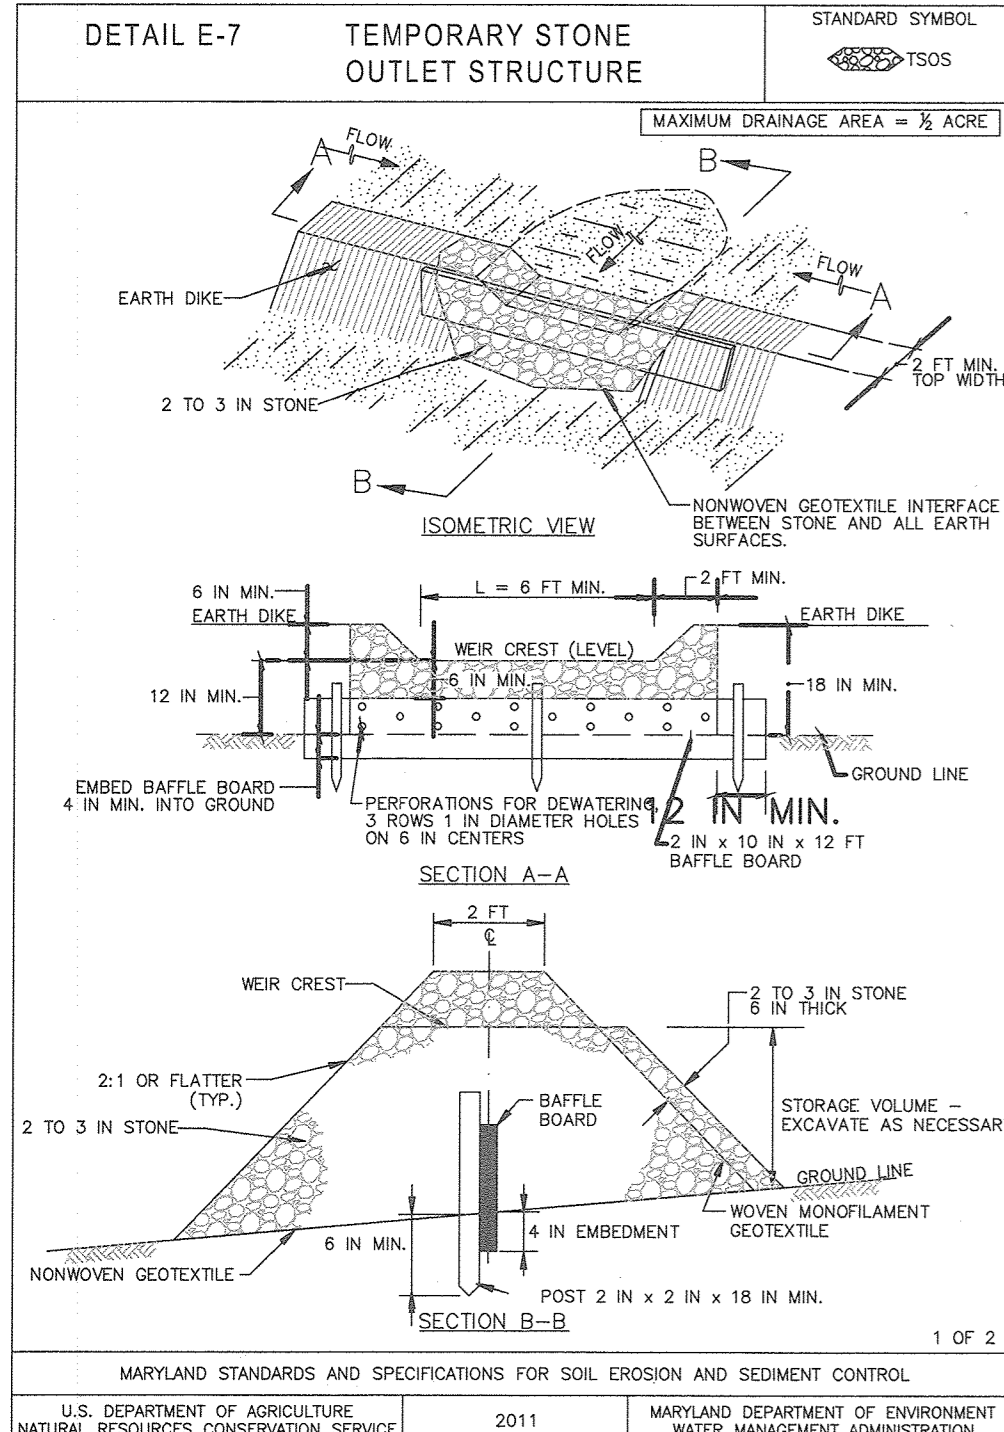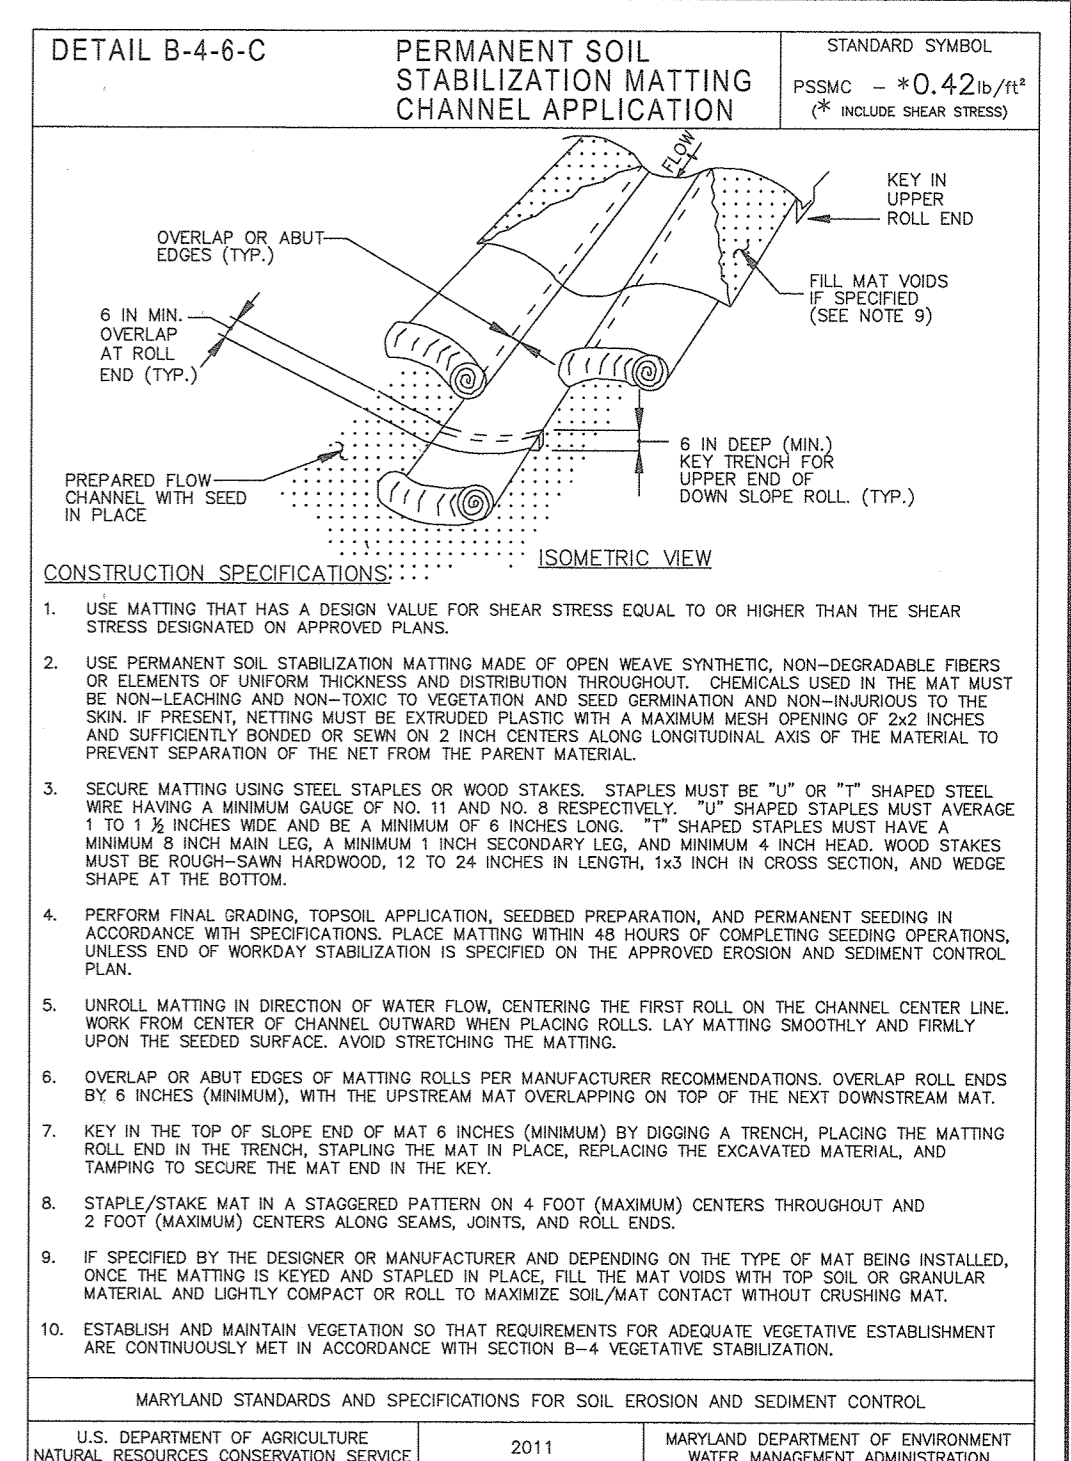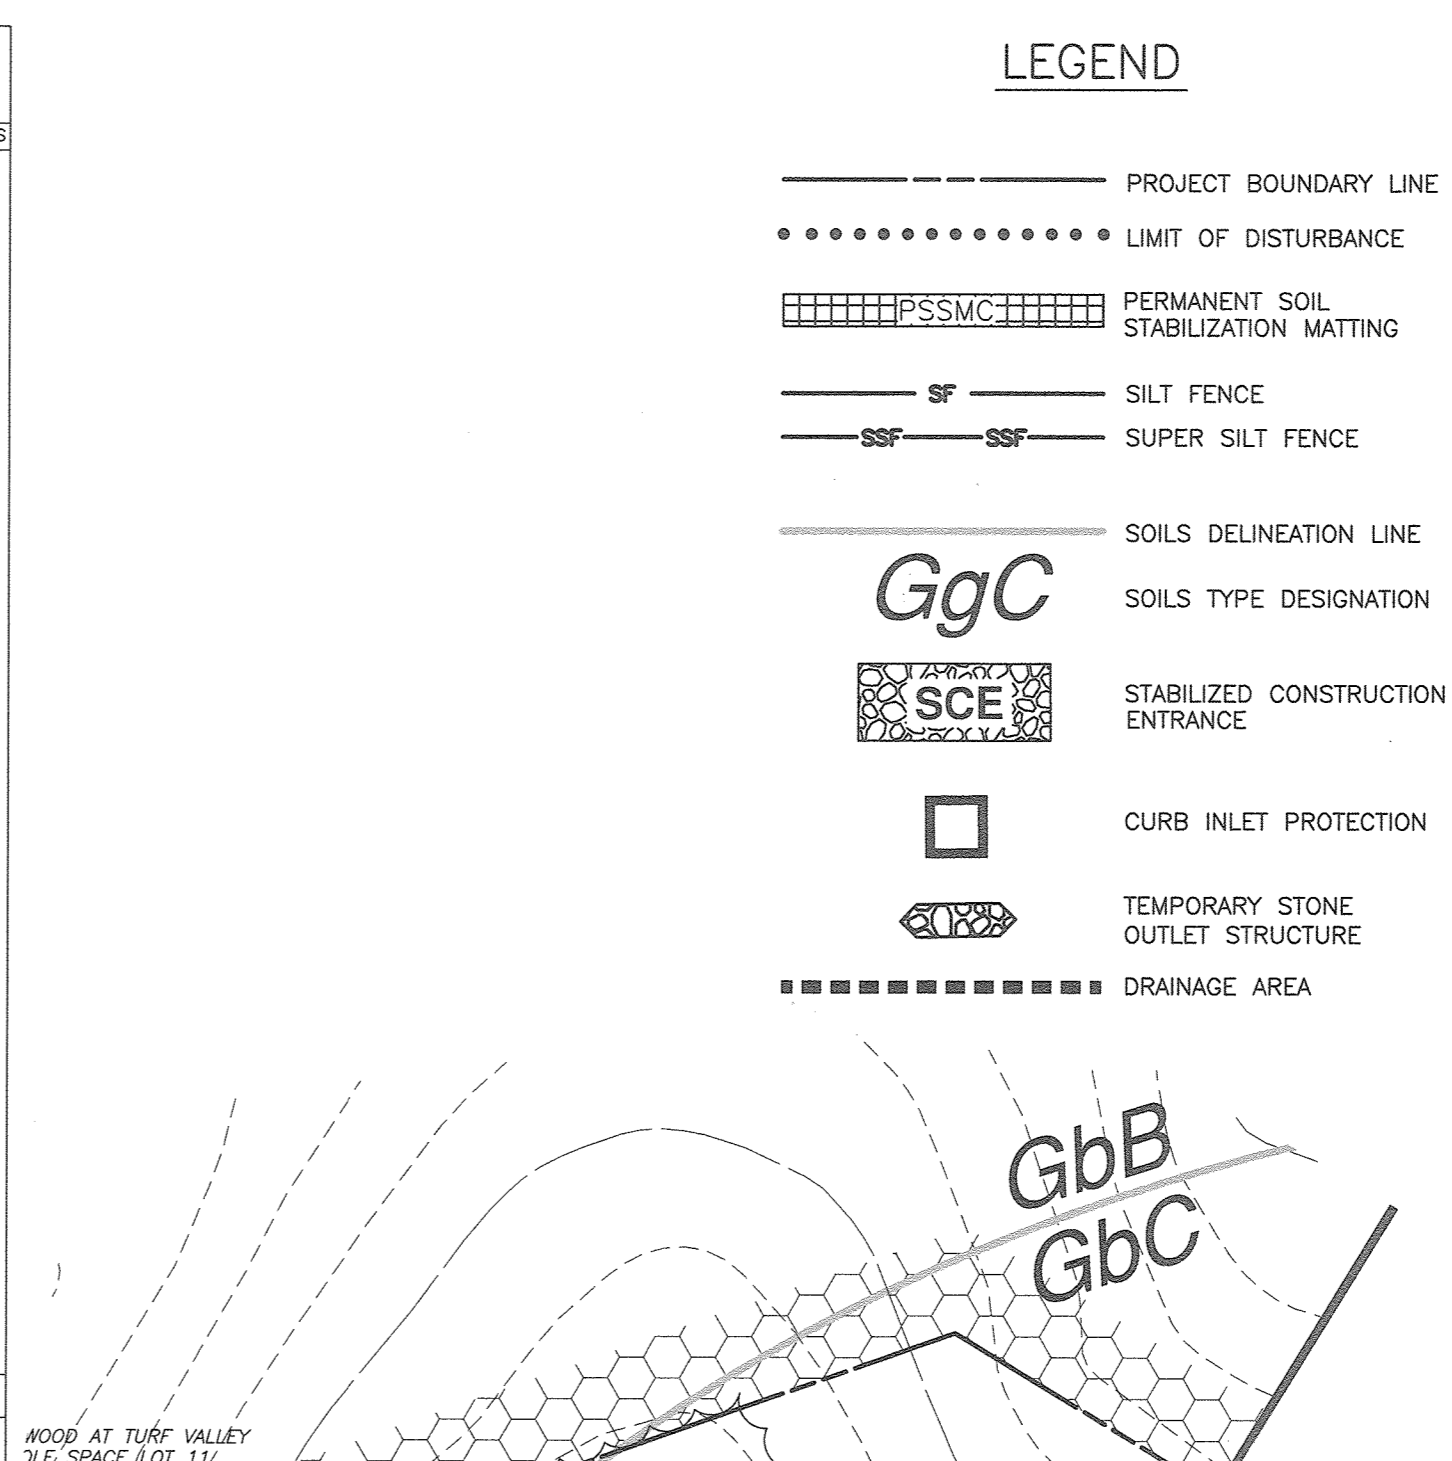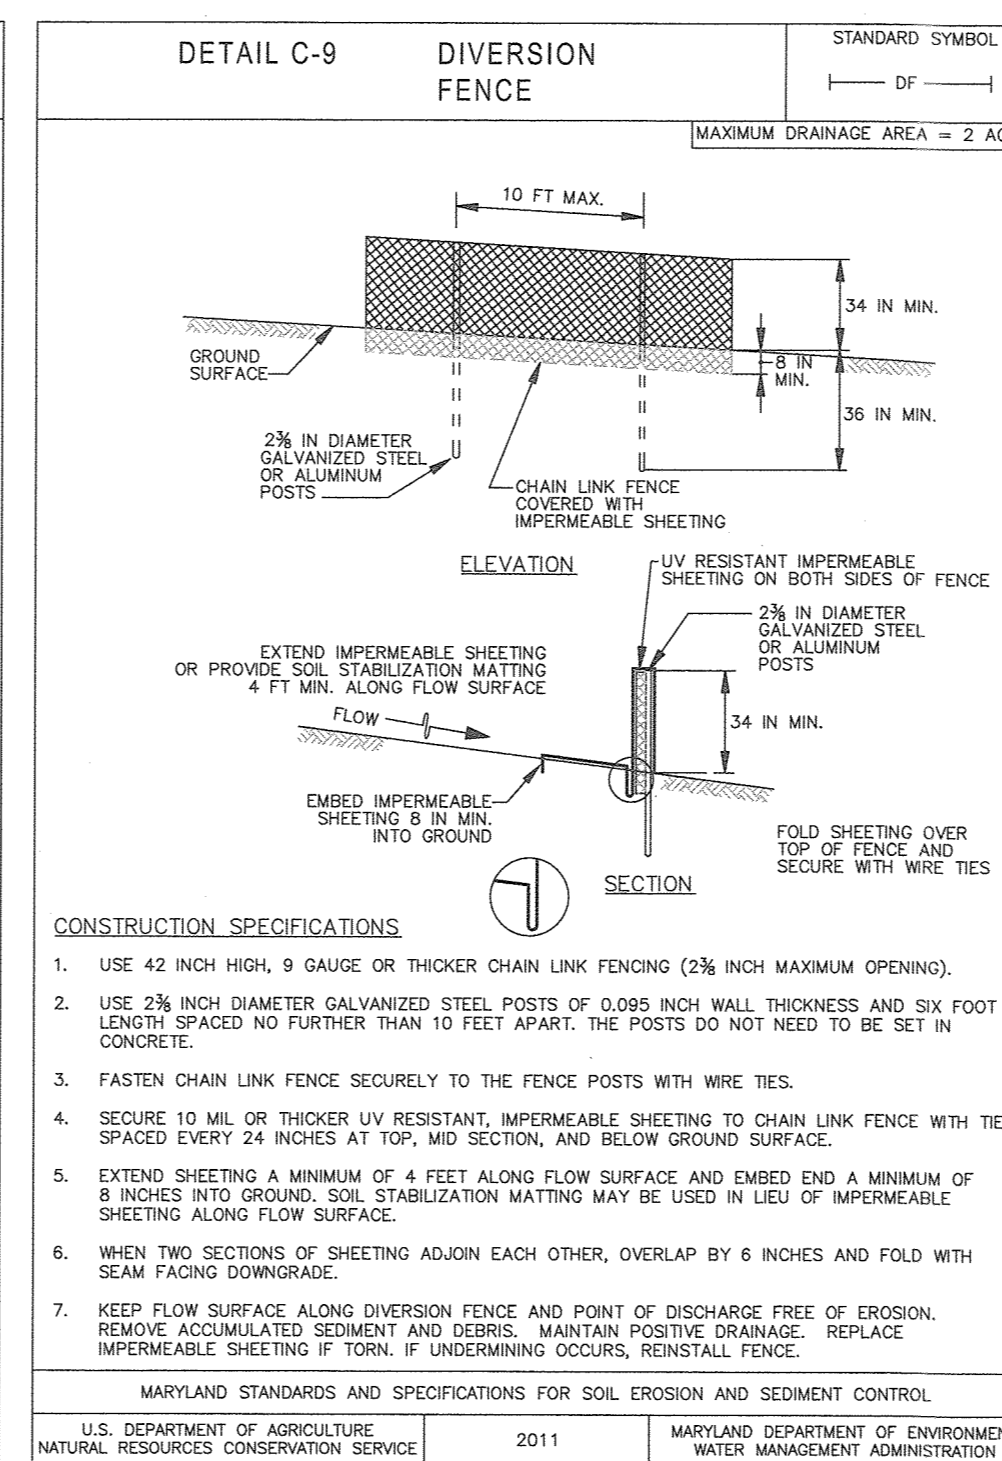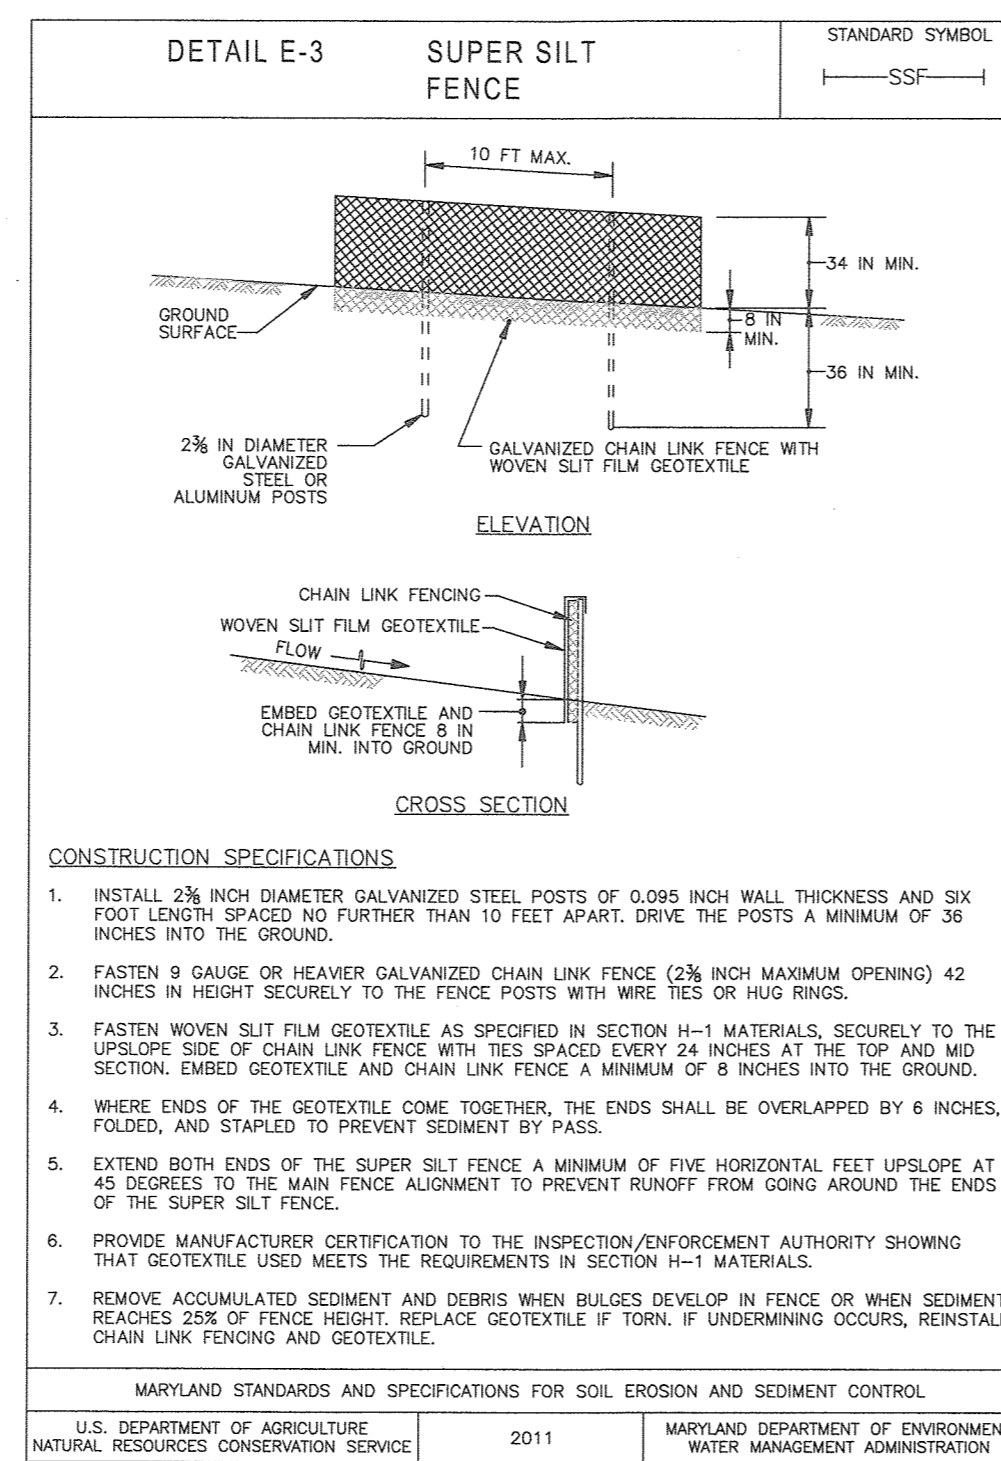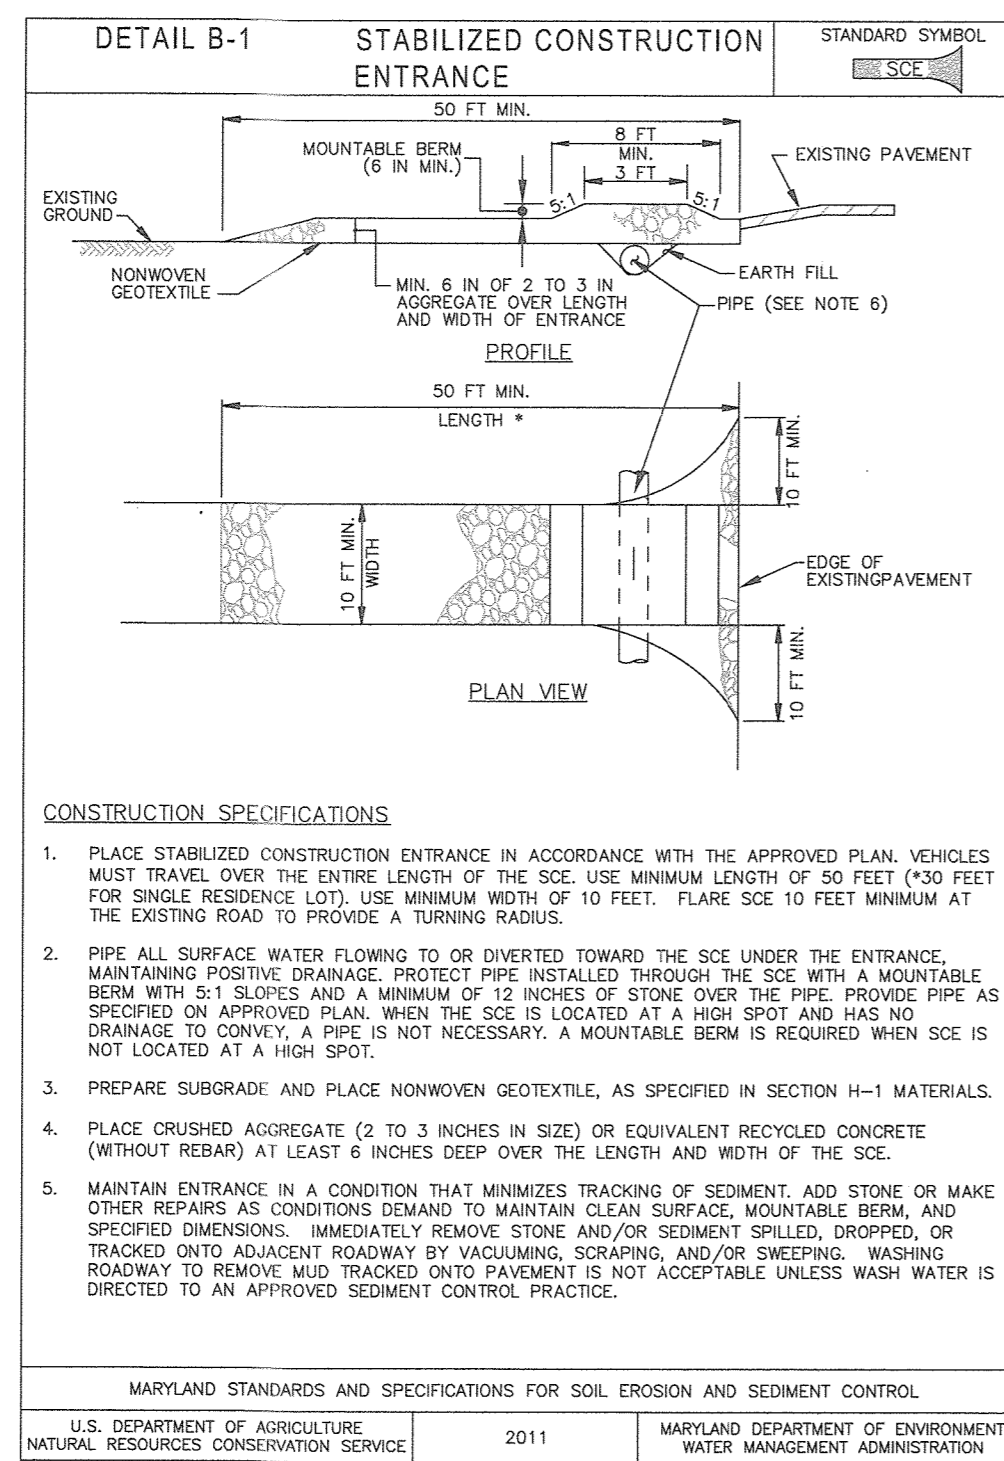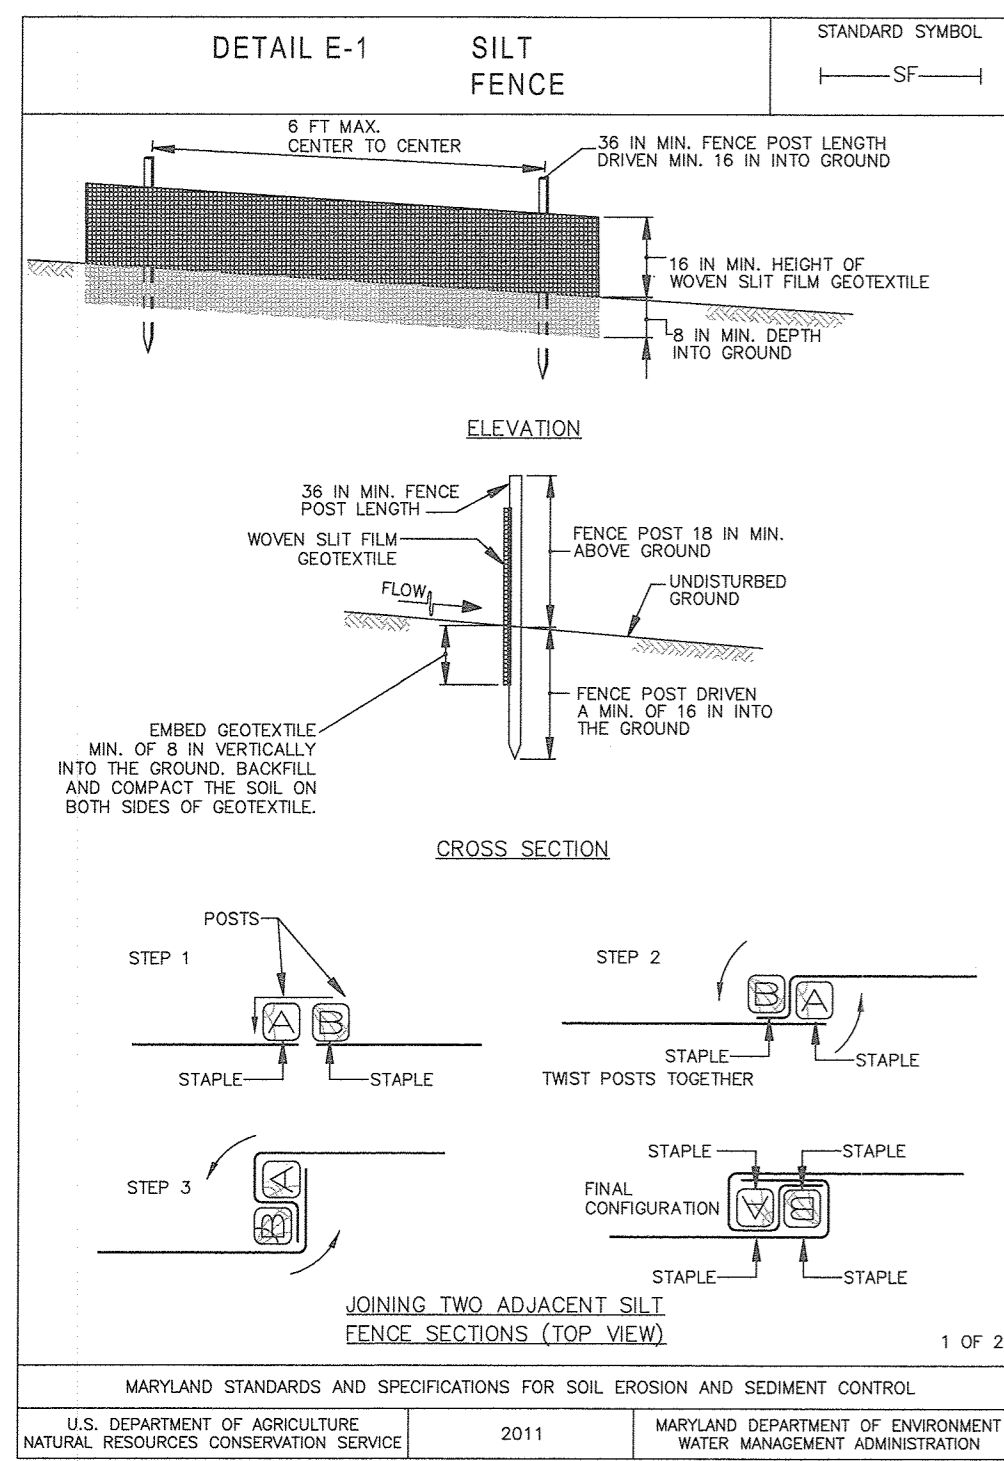

Designation	D.A. Acres	Practice	Volume Required	Ground Elev.	Embankment Elev.	Weir Elev.	Weir Length	Uphill Length	Volume Provided	Adequate Volume?
#1	0.06	TSOS	108	448.00	450.50	438.00	8	10	160	Yes
#2	0.39	TSOS	702	436.00	438.50	432.00	12	30	720	Yes
#3	0.21	TSOS	378	430.00	432.50	432.00	10	20	400	Yes
#4	0.29	TSOS	522	435.00	437.50	437.00	10	30	600	Yes
#5	0.23	TSOS	414	422.00	425.50	425.00	10	15	450	Yes

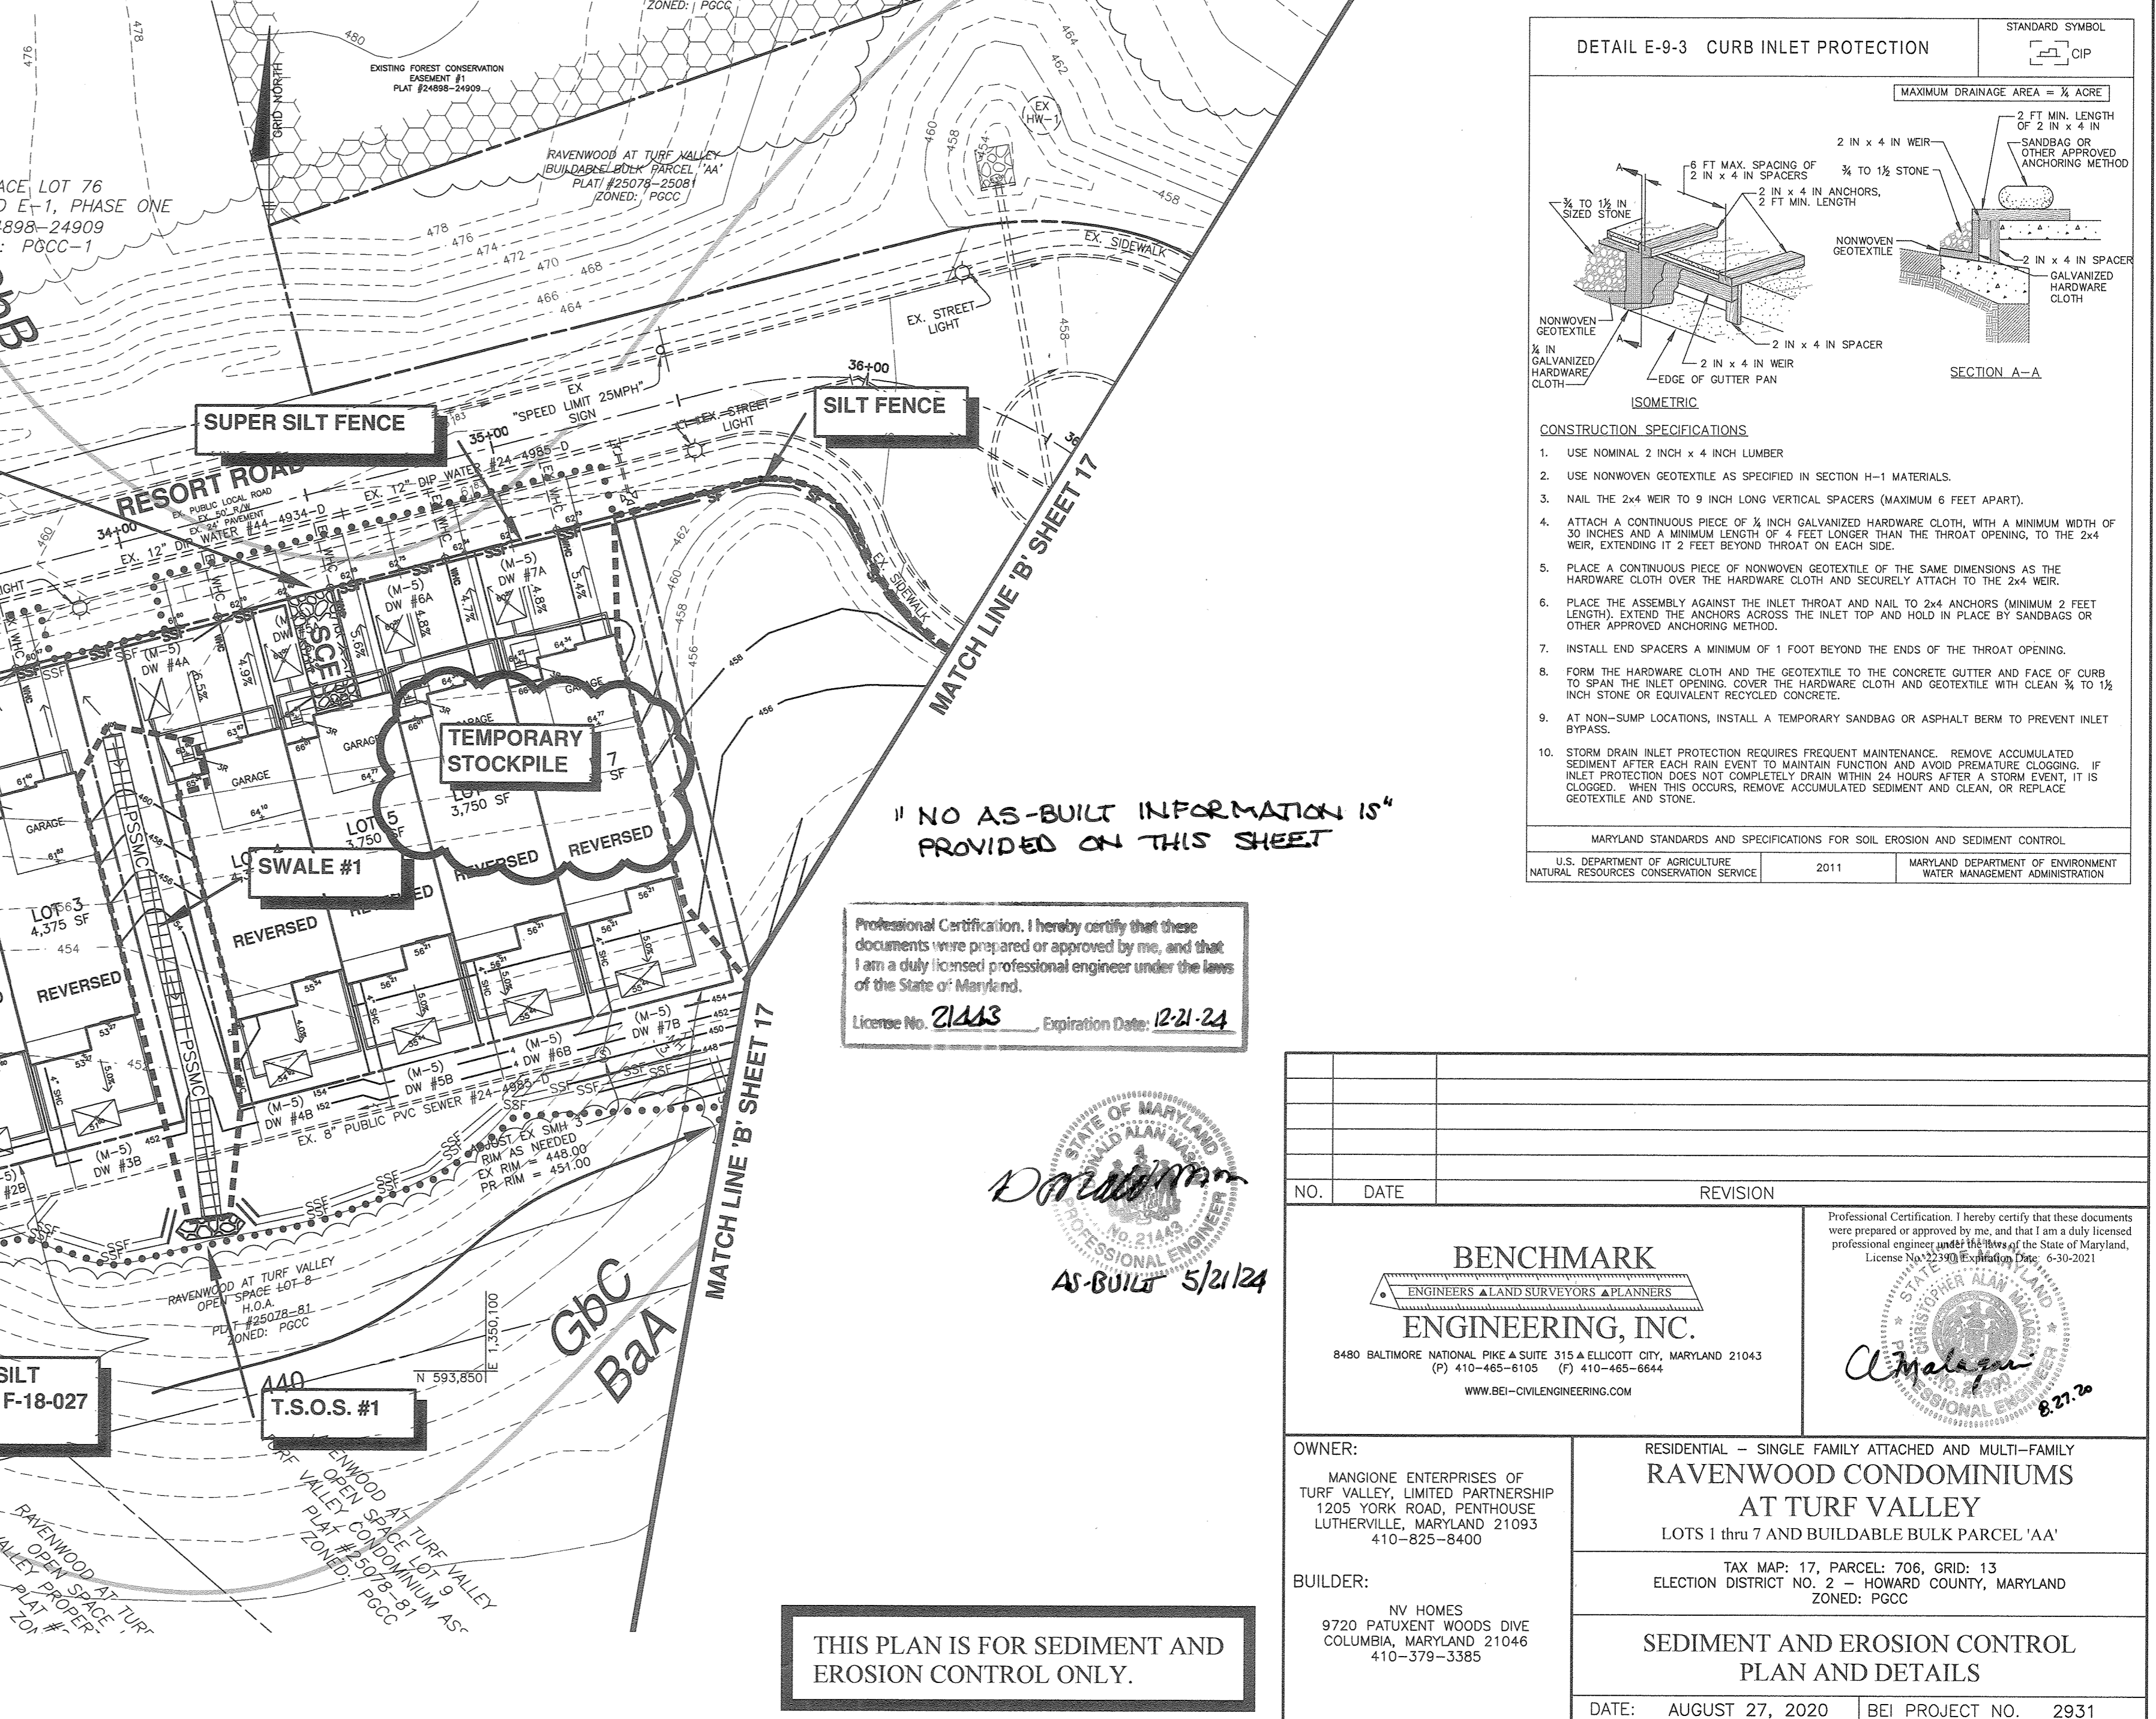

ENGINEER'S CERTIFICATE
I, CERTIFY THAT THIS PLAN FOR SEDIMENT AND EROSION CONTROL REPRESENTS A PRACTICAL AND WORKABLE PLAN BASED ON MY PERSONAL KNOWLEDGE OF THE SITE CONDITIONS AND THAT IT WAS PREPARED IN ACCORDANCE WITH THE REQUIREMENTS OF THE HOWARD SOIL CONSERVATION DISTRICT.

Cl Malagan 8/27/20
ENGINEER DATE

DEVELOPER'S CERTIFICATE
I, WE CERTIFY THAT ALL DEVELOPMENT AND CONSTRUCTION WILL BE DONE ACCORDING TO THIS PLAN FOR SEDIMENT AND EROSION CONTROL, AND THAT ALL PERSONNEL INVOLVED IN THE CONSTRUCTION PROJECT WILL HAVE A CERTIFICATE OF ATTENDANCE AT A DEPARTMENT OF THE ENVIRONMENT APPROVED TRAINING PROGRAM FOR THE CONTROL OF SEDIMENT AND EROSION BEFORE BEGINNING THE PROJECT. I ALSO AUTHORIZE PERIODIC ON-SITE INSPECTION BY THE HOWARD SOIL CONSERVATION DISTRICT.

John K. Blanton 8/27/20
DEVELOPER DATE

THIS DEVELOPMENT PLAN IS APPROVED FOR SOIL EROSION AND SEDIMENT CONTROL BY THE HOWARD SOIL CONSERVATION DISTRICT.

John K. Blanton 9/12/20
HOWARD SOIL CONSERVATION DISTRICT DATE

APPROVED: HOWARD COUNTY DEPARTMENT OF PLANNING AND ZONING

John K. Blanton 10.5.20
CHIEF, DEVELOPMENT ENGINEERING DIVISION DATE

John K. Blanton 10/29/20
DIRECTOR DATE

APPROVED
PLANNING BOARD OF HOWARD COUNTY

DATE AUGUST 20, 2020

1 inch = 30 ft.

Professional Certification. I hereby certify that these documents were prepared or approved by me, and that I am a duly licensed professional engineer under the laws of the State of Maryland.
License No. 21443 Expiration Date: 12-31-24



NO. DATE REVISION

BENCHMARK ENGINEERING, INC.
8480 BALTIMORE NATIONAL PIKE & SUITE 315 A ELICOTT CITY, MARYLAND 21043
(P) 410-465-6105 (F) 410-465-6644
WWW.BE-CIVILENGINEERING.COM

OWNER: MANGIONE ENTERPRISES OF TURF VALLEY, LIMITED PARTNERSHIP
1205 YORK ROAD, PENTHOUSE LUTHERVILLE, MARYLAND 21093
410-825-8400

BUILDER: NV HOMES
9720 PATUXENT WOODS DIVE COLUMBIA, MARYLAND 21046
410-379-3385

RESIDENTIAL - SINGLE FAMILY ATTACHED AND MULTI-FAMILY
RAVENWOOD CONDOMINIUMS AT TURF VALLEY
LOTS 1 thru 7 AND BUILDABLE BULK PARCEL 'A'

TAX MAP: 17, PARCEL: 706, GRID: 13
ELECTION DISTRICT NO. 2 - HOWARD COUNTY, MARYLAND
ZONED: PGCC

SEDIMENT AND EROSION CONTROL PLAN AND DETAILS

DATE: AUGUST 27, 2020 BEI PROJECT NO. 2931
SCALE: AS SHOWN SHEET 16 OF 23

DESIGN: DBT DRAFT: DBT

AS-BUILT SDP-20-036

THIS PLAN IS FOR SEDIMENT AND EROSION CONTROL ONLY.

HOWARD SOIL CONSERVATION DISTRICT (HSCD) STANDARD SEDIMENT CONTROL NOTES

1. A pre-construction meeting must occur with the Howard County Department of Public Works, Construction Inspection Division (CID), 410-313-1855 after the future LOO and protected areas are marked clearly in the field. A minimum of 48 hours notice to CID must be given at the following stages:
a. Prior to the start of earth disturbance,
b. Upon completion of the installation of perimeter erosion and sediment controls, but before proceeding with any other earth disturbance or grading,
c. Prior to the start of another phase of construction or opening of another grading unit,
d. Prior to the removal or modification of sediment control practices.

2. All vegetative and structural practices are to be installed according to the provisions of this plan and are to be in conformance with the 2011 MARYLAND STANDARDS AND SPECIFICATIONS FOR SOIL EROSION AND SEDIMENT CONTROL, and revisions thereto.
3. Following initial soil disturbance or re-disturbance, permanent or temporary stabilization is required within three (3) calendar days as to the surface of all perimeter controls, dikes, swales, ditches, perimeter slopes, and all slopes steeper than 3 horizontal to 1 vertical (3:1); and seven (7) calendar days as to all other disturbed areas on the project site except for these areas under active grading.

4. All disturbed areas must be stabilized within the time period specified above in accordance with the 2011 MARYLAND STANDARDS AND SPECIFICATIONS FOR SOIL EROSION AND SEDIMENT CONTROL, for topsoil (Sec. B-4-2), permanent seeding (Sec. B-4-5), temporary seeding (Sec. B-4-4) and mulching (Sec. B-4-3). Temporary stabilization with mulch alone can only be applied between the fall and spring seeding dates if the ground is frozen. Incremental stabilization (Sec. B-4-1) specifications shall be enforced in areas with >15% of cut and/or fill. Stockpiles (Sec. B-4-3) in excess of 20 feet must be banded with stable silt cloth. All concentrated flow, steep slope, and highly erodible areas shall receive soil stabilization matting (Sec. B-4-6).
5. All sediment control structures are to remain in place, and are to be maintained in operative condition until permission for their removal has been obtained from the CID.

Table with 2 columns: Area and Value. Includes rows for Total Area of Site (9.54 Acres), Area Disturbed (8.24 Acres), Area to be seeded or paved (3.23 Acres), Area to be vegetatively stabilized (5.01 Acres), Total cut (8,111 Cu Yds), Total fill (8,111 Cu Yds), and Off-site waste/borrow area location.

7. Any sediment control practice which is disturbed by grading activity for placement of utilities must be repaired on the same day of disturbance.
8. Additional sediment control must be provided, if deemed necessary by the CID. The site and all controls shall be inspected by the contractor weekly, and the next day after each rain event. A written report by the contractor, made available upon request, is part of every inspection and should include:
• Inspection date
• Inspection type (routine, pre-storm event, during rain event)
• Name and title of inspector
• Weather information (current conditions as well as time and amount of last recorded precipitation)
• Brief description of project's status (e.g. percent complete) and/or current activities
• Evidence of sediment discharges
• Identification of plan deficiencies
• Identification of sediment controls that require maintenance
• Identification of missing or improperly installed sediment controls
• Compliance status regarding the sequence of construction and stabilization requirements (if applicable)
• Monitoring/sampling
• Maintenance and/or corrective action performed
• Other inspection items required by the General Permit for Stormwater Associated with Construction Activities (NPDES, MDC).

9. Trenches for the construction of utilities is limited to three pipe lengths or that which can and shall be back filled and stabilized by the end of each work day, whichever is shorter.
10. Any major changes or revisions to the plan or sequence of construction must be reviewed and approved by the HSCD prior to proceeding with construction. Minor revisions may be allowed by the CID per the list of HSCD-approved field changes.

11. Disturbance shall not occur outside the L.O.D. A project is to be sequenced so that grading activities begin on one grading unit (maximum acreage of 20 acres per grading unit) at a time. Work may proceed to a subsequent grading unit when at least 50 percent of the disturbed area in the preceding grading unit has been stabilized and approved by the CID. Unless otherwise specified and approved by the HSCD, no more than 20 acres constructively may be disturbed at a given time.
12. Wash water from any equipment, vehicles, wheels, pavement, and other sources must be treated in a sediment basin or other approved wastewater structure.
13. Topsoil shall be stockpiled and preserved on-site for redistribution onto final grade.
14. All silt fence and super silt fence shall be placed on-the-contour, and be impregnated at 25' minimum intervals, with lower ends curled up by 2' in elevation.
15. Stream channels must not be disturbed during the following restricted time periods (inclusive):
• Use I and IP March 1 - June 15
• Use III and IP October 1 - April 30
• Use IV March 1 - May 31

16. A copy of this plan, the 2011 MARYLAND STANDARDS AND SPECIFICATIONS FOR SOIL EROSION AND SEDIMENT CONTROL, and associated permits shall be on-site and available when the site is active.
17. Wash water from any equipment, vehicles, wheels, pavement, and other sources must be treated in a sediment basin or other approved wastewater structure.
18. Topsoil shall be stockpiled and preserved on-site for redistribution onto final grade.
19. All silt fence and super silt fence shall be placed on-the-contour, and be impregnated at 25' minimum intervals, with lower ends curled up by 2' in elevation.
20. Stream channels must not be disturbed during the following restricted time periods (inclusive):
• Use I and IP March 1 - June 15
• Use III and IP October 1 - April 30
• Use IV March 1 - May 31

"NO AS-BUILT INFORMATION IS PROVIDED ON THIS SHEET"

Professional Certification. I hereby certify that these documents were prepared or approved by me, and that I am a duly licensed professional engineer under the laws of the State of Maryland. License No. 21483, Expiration Date: 12-21-24



SEQUENCE OF CONSTRUCTION

NOTIFY SEDIMENT CONTROL DIVISION 48 HOURS PRIOR TO START OF WORK

PARCEL 'AA' - APARTMENT

- 1. Obtain grading/building permit. Notify D.I.L.P. at 410-313-1880 at least 24 hours before starting any work. (1 day)
2. Hold on-site pre-construction meeting. (day 2)
3. Install/adjust perimeter controls. (day 3)
4. Bring parking lot up to subgrade, install public water, storm drain, and curb and gutter. Install micro bio-retention facilities. Cover filter media with filter fabric. Do not install mulch or plantings at this time.
5. Excavate for apartment building foundation, rough grade, and stabilize in accordance with the temporary seedbed notes. (day 31-45)
6. Construct building, water and sewer house connections, roof leader manifold system. (day 46-120)
7. Once building construction is complete, and newly graded areas have been stabilized, remove filter fabric over micro bio-retentions, install mulch, and plantings.
8. Upon approval from the Howard County Sediment Control Inspector, remove all sediment control devices and stabilize any remaining disturbed areas in accordance with the permanent seedbed notes. (day 91-100)

Note: Following initial soil disturbance or any re-disturbances, permanent or temporary stabilization shall be completed within:
A. 3 calendar days for all perimeter sediment control structures, dikes, swales and all slopes greater than 3:1.
B. 7 calendar days for all other disturbed areas.
During grading and after each rainfall, contractor will inspect and provide necessary maintenance to the sediment control measures of this plan.

Note: Following initial soil disturbance or any re-disturbances, permanent or temporary stabilization shall be completed within:
A. 3 calendar days for all perimeter sediment control structures, dikes, swales and all slopes greater than 3:1.
B. 7 calendar days for all other disturbed areas.
During grading and after each rainfall, contractor will inspect and provide necessary maintenance to the sediment control measures of this plan.

SEQUENCE OF CONSTRUCTION

NOTIFY SEDIMENT CONTROL DIVISION 48 HOURS PRIOR TO START OF WORK

LOTS 1-7: TOWNHOUSES.

- 1. Obtain grading/building permit. Notify D.I.L.P. at 410-313-1880 at least 24 hours before starting any work. (1 day)
2. Hold on-site pre-construction meeting. (day 2)
3. Install individual lot perimeter controls (i.e. stabilized construction entrance). (day 3)
4. Excavate for foundation, rough grade lot, and stabilize in accordance with the temporary seedbed notes. (day 4-10)
5. Construct house, install water and sewer house connections from easement/right-of-way up to house, backfill, and construct driveway. Install on-lot dry wells and connect roof leaders for lots that require them. (day 11-90)
6. Upon approval from the Howard County Sediment Control Inspector, remove all sediment control devices and stabilize any remaining disturbed areas in accordance with the permanent seedbed notes. (day 91-100)

Note: Following initial soil disturbance or any re-disturbances, permanent or temporary stabilization shall be completed within:
A. 3 calendar days for all perimeter sediment control structures, dikes, swales and all slopes greater than 3:1.
B. 7 calendar days for all other disturbed areas.
During grading and after each rainfall, contractor will inspect and provide necessary maintenance to the sediment control measures of this plan.

B-4-2 STANDARDS AND SPECIFICATIONS FOR SOIL PREPARATION, TOPSOILING, AND SOIL AMENDMENTS

The process of preparing the soils to sustain adequate vegetative stabilization. To provide a suitable soil medium for vegetative growth.
Criteria:
A. Soil Preparation
1. Topsoil Stabilization
a. Seedbed preparation consists of loosening soil to a depth of 3 to 5 inches by means of suitable agricultural or construction equipment...

2. Permanent Stabilization
a. A soil test is required for any earth disturbance of 5 acres or more. The minimum soil conditions required for permanent vegetative establishment are:
i. Soil pH between 6.0 and 7.0.
ii. Soluble salts less than 500 parts per million (ppm).
iii. Soil contains less than 40 percent clay but enough fine grained material (greater than 30 percent silt plus clay) to provide the capacity to hold a moderate amount of moisture.
iv. An exception: if topsoils will be planted, then a sandy soil (less than 30 percent silt plus clay) would be acceptable.
v. Soil contains 1.5 percent minimum organic matter by weight.
vi. Soil contains sufficient pore space to permit adequate root penetration.
vii. Application of amendments or topsoil is required if on-site soils do not meet the above conditions.

3. Mulching
a. Dry Seeding: This includes use of conventional drop or broadcast spreaders.
i. Incorporate seed into the subsoil at the rates prescribed on Temporary Seeding Table B.1.
ii. Apply seed in two directions, perpendicular to each other.
iii. Apply soil amendments as specified on the approved plan or as indicated by the results of a soil test.

4. Topsoil Application
a. Erosion and sediment control practices must be maintained when applying topsoil. Uniformly distribute topsoil to a 3 to 4 inch layer and lightly compact to a minimum thickness of 4 inches. Spreading is to be performed in such a manner that sodding or seeding can proceed with a minimum of additional soil preparation and tillage.

5. Soil Amendments (Fertilizer and Lime Specifications)
a. Soil tests must be performed to determine the exact ratios and application rates for both lime and fertilizer on sites having disturbed areas of 5 acres or more.
b. Fertilizers must be uniform in composition, free flowing and suitable for accurate application by appropriate equipment.
c. Lime materials must be ground limestone (hydrated or burnt lime may be substituted except when hydroseeding) which contains at least 50 percent total oxides (calcium oxide plus magnesium oxide).

6. Anchoring
a. Perform mulch anchoring immediately following application of mulch to minimize loss by wind or water.
b. A mulch anchoring tool is a tractor drawn implement designed to punch and anchor mulch into the soil surface a minimum of 2 inches.
c. Do not mow until the soil is firmly rooted. No more than 1/3 of the grass leaf must be removed by the initial cutting or subsequent cuttings.

Table: Permanent Seeding Summary. Columns: Hardness Zone, Seeding Rate, Seeding Date, Seeding Depth, Fertilizer Rate, Lime Rate.

Table B.1: Temporary Seeding for Site Stabilization. Columns: Plant Species, Seeding Rate, Seeding Date, Seeding Depth, Recommended Seeding Dates.

1/ For seeding rates on the warm season grasses are in pounds of pure live seed (PLS). Actual planting rates shall be adjusted to reflect percent seed germination and purity, as noted. Adjustments are usually not needed for the cool-season grasses.
2/ For seeding rates on the cool-season grasses (annual ryegrass, pearl millet, hybrid millet), do not exceed more than 50% (by weight) of the cover all permanent seeding rate.
3/ For seeding rates on the warm season grasses (browns top millet, bermudagrass, and St. Augustine), do not exceed more than 50% (by weight) of the cover all permanent seeding rate.

APPROVED PLANNING BOARD OF HOWARD COUNTY DATE AUGUST 20, 2020

B-4 STANDARDS AND SPECIFICATIONS FOR VEGETATIVE STABILIZATION

Using vegetation as cover to protect exposed soil from erosion. To promote the establishment of vegetation on exposed soil.
Criteria:
A. Adequate Vegetative Establishment
1. Inspect seeded areas for vegetative establishment and make necessary repairs, replacements, and reseedings within the planting season.

2. If an area has less than 40 percent groundcover, restabilize following the original recommendations for lime, fertilizer, seedbed preparation, and seeding.
3. If an area has between 40 and 94 percent groundcover, over-seed and fertilize using half of the rates originally specified.
4. Maintenance fertilizer rates for permanent seeding are shown in Table B.6.

B-4-1 STANDARDS AND SPECIFICATIONS FOR STOCKPILE STABILIZATION

Establishment of vegetative cover on cut and fill slopes. Purpose: To provide timely vegetative cover on cut and fill slopes as work progresses.
Criteria:
A. Incremental Stabilization - Cut Slopes
1. Excavate and stabilize cut slopes in increments not to exceed 15 feet in height.

2. Construction sequence example (Refer to Figure B.1):
a. Construct and stabilize all temporary swales or dikes that will be used to convey runoff around the excavation.
b. Perform Phase 1 excavation, prepare seedbed, and stabilize.
c. Perform Phase 2 excavation, prepare seedbed, and stabilize.
d. Perform final phase excavation, prepare seedbed, and stabilize.







3. At the end of each day, install temporary water conveyance practice(s), as necessary, to intercept surface runoff and convey it down the slope in a non-erosive manner.
4. Construction sequence example (Refer to Figure B.2):
a. Construct and stabilize all temporary swales or dikes that will be used to divert runoff around the fill.
b. At the end of each day, install temporary water conveyance practice(s), as necessary, to intercept surface runoff and convey it down the slope in a non-erosive manner.

5. Note: Once excavation has begun the operation should be continuous from grubbing through the completion of grading and placement of topsoil (if required) and permanent seed and mulch. Any interruptions in the operation or completing the operation out of the seeding season will necessitate the application of temporary stabilization.

ENGINEER'S CERTIFICATE: I CERTIFY THAT THIS PLAN FOR SEDIMENT AND EROSION CONTROL REPRESENTS A PRACTICAL AND WORKABLE PLAN BASED ON MY PERSONAL KNOWLEDGE OF THE SITE CONDITIONS AND THAT IT WAS PREPARED IN ACCORDANCE WITH THE REQUIREMENTS OF THE HOWARD SOIL CONSERVATION DISTRICT.

DEVELOPER'S CERTIFICATE: I/WE CERTIFY THAT ALL DEVELOPMENT AND CONSTRUCTION WILL BE DONE ACCORDING TO THIS PLAN FOR SEDIMENT AND EROSION CONTROL, AND THAT ALL RESPONSIBLE PERSONNEL INVOLVED IN THE CONSTRUCTION PROJECT WILL HAVE A CERTIFICATE OF ATTENDANCE AT A DEPARTMENT OF THE ENVIRONMENT APPROVED TRAINING PROGRAM FOR THE CONTROL OF SEDIMENT AND EROSION BEFORE BEGINNING THE PROJECT.

APPROVED: HOWARD COUNTY DEPARTMENT OF PLANNING AND ZONING. CHIEF, DEVELOPMENT ENGINEERING DIVISION. DATE: 10/29/20

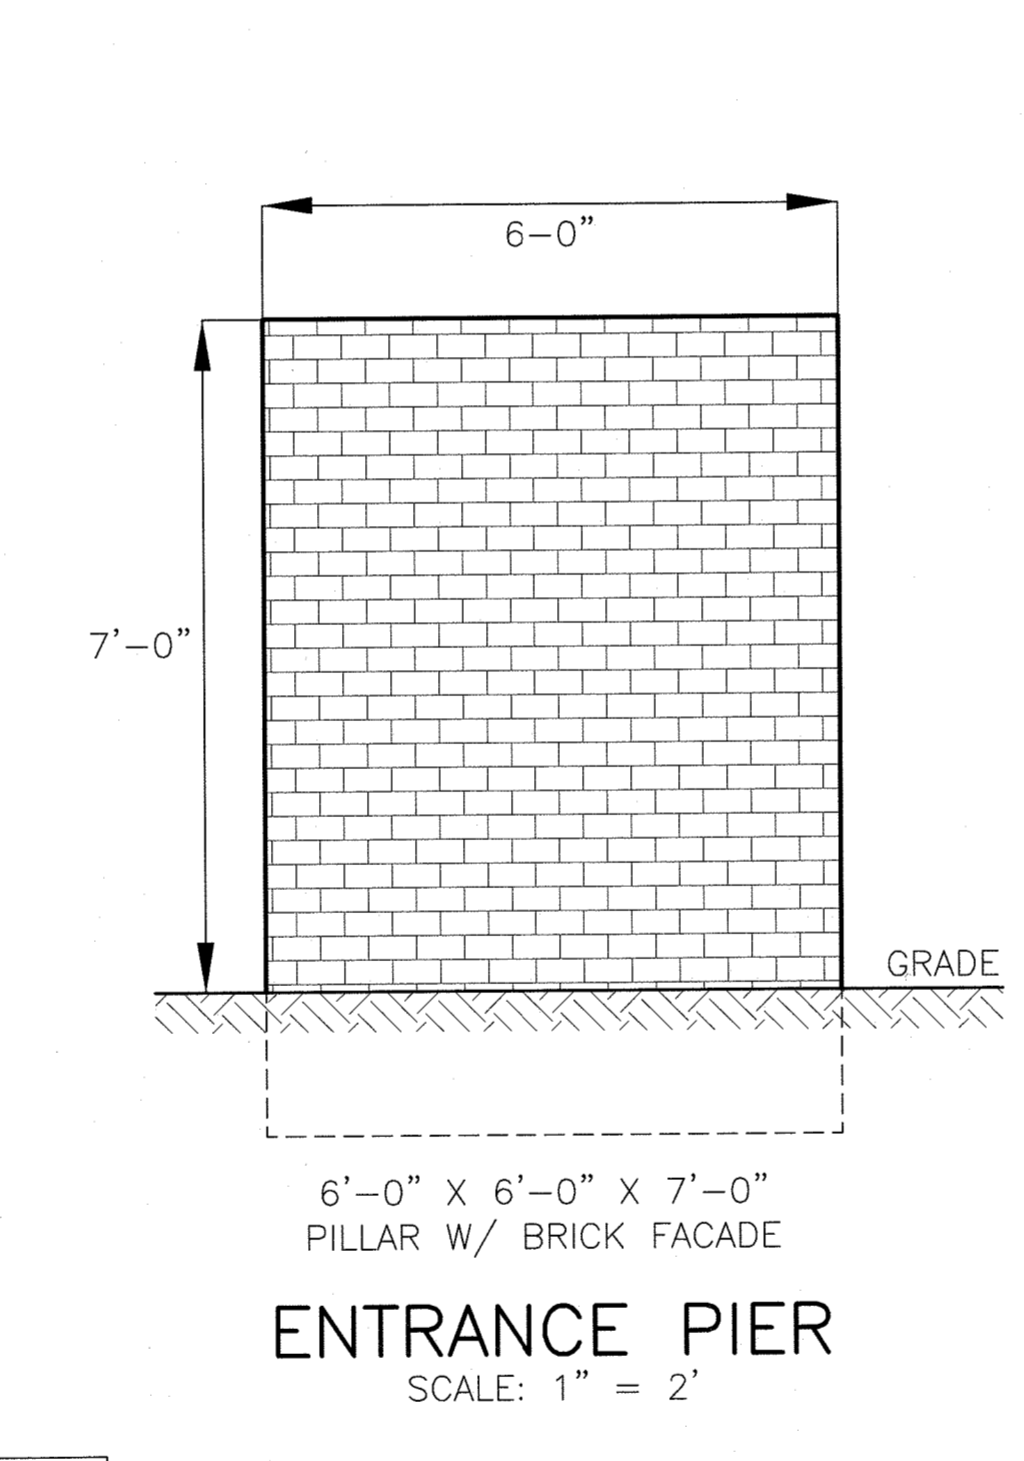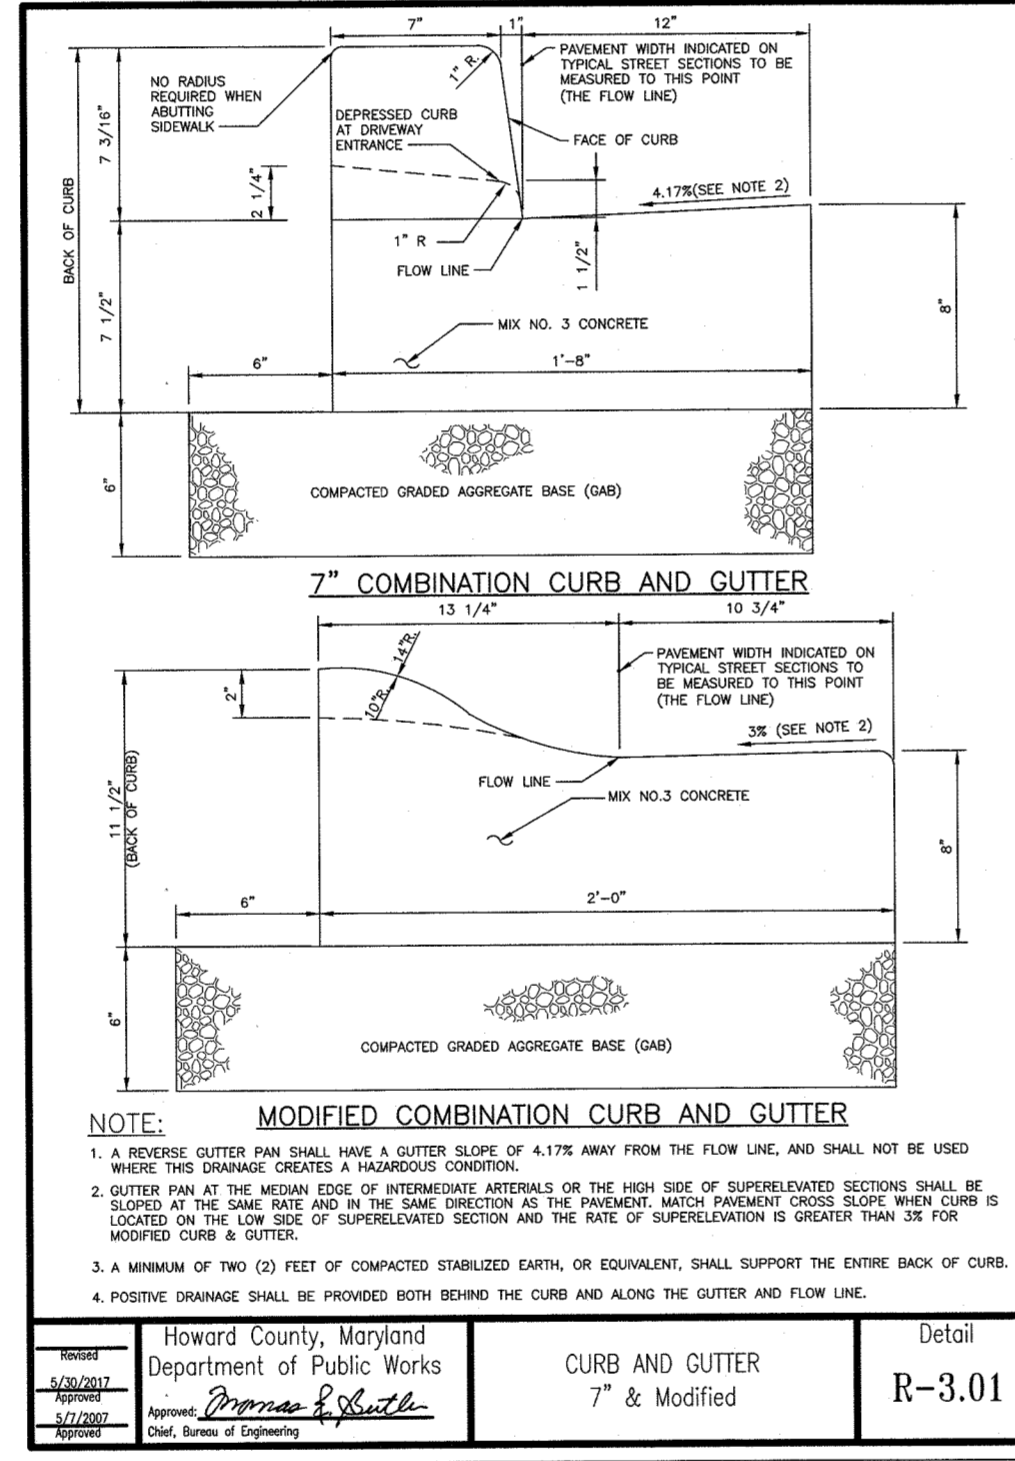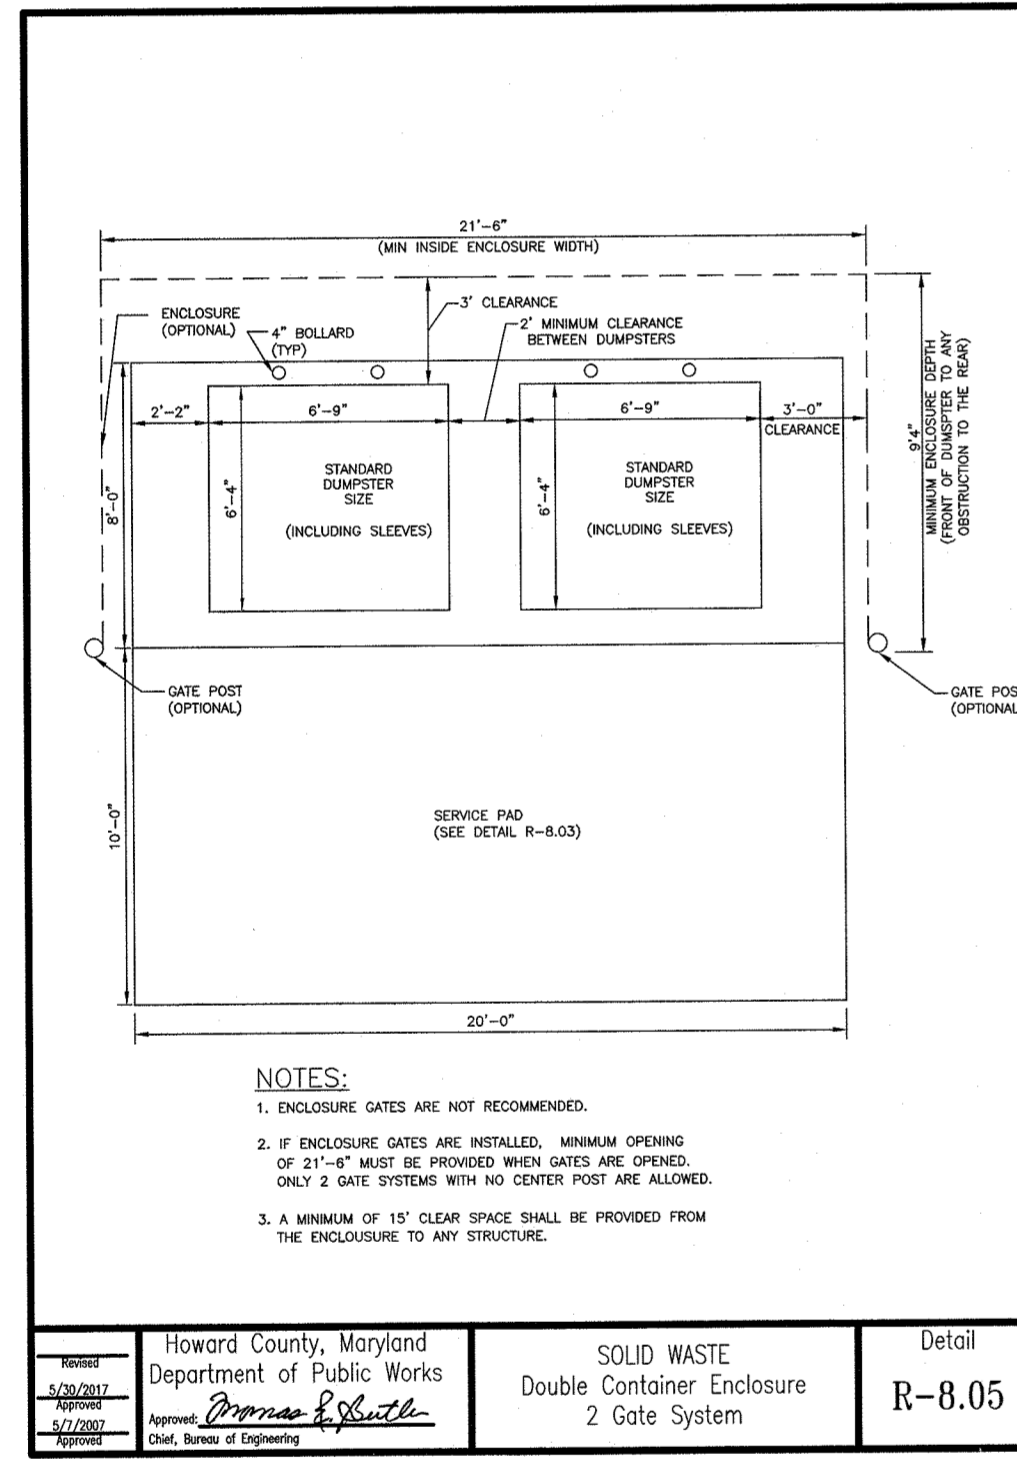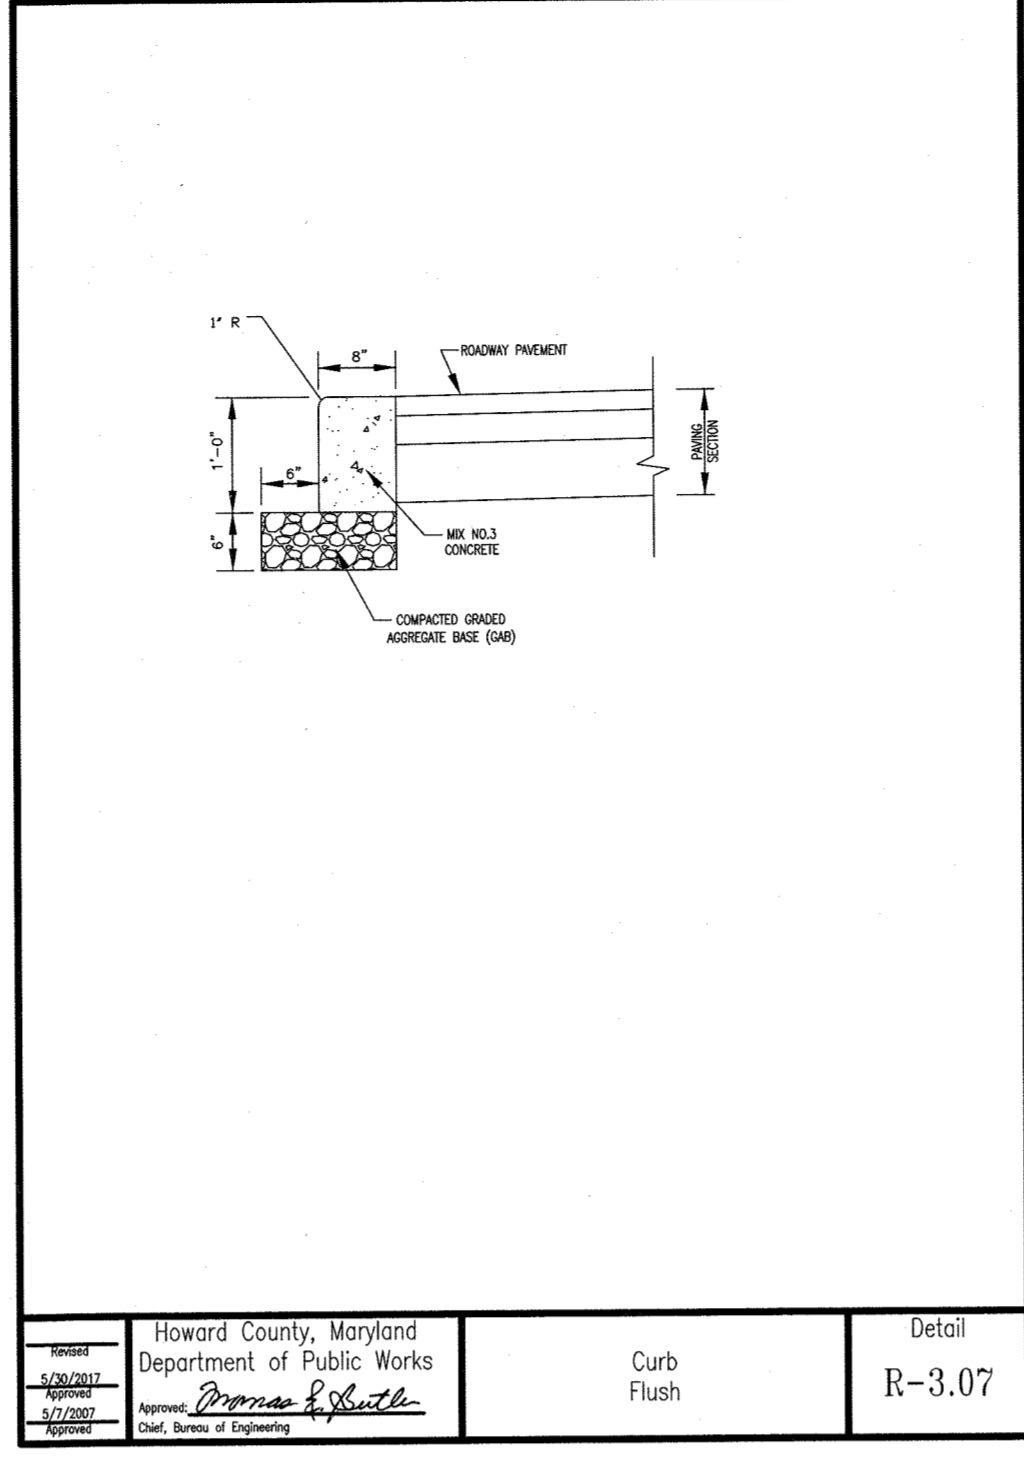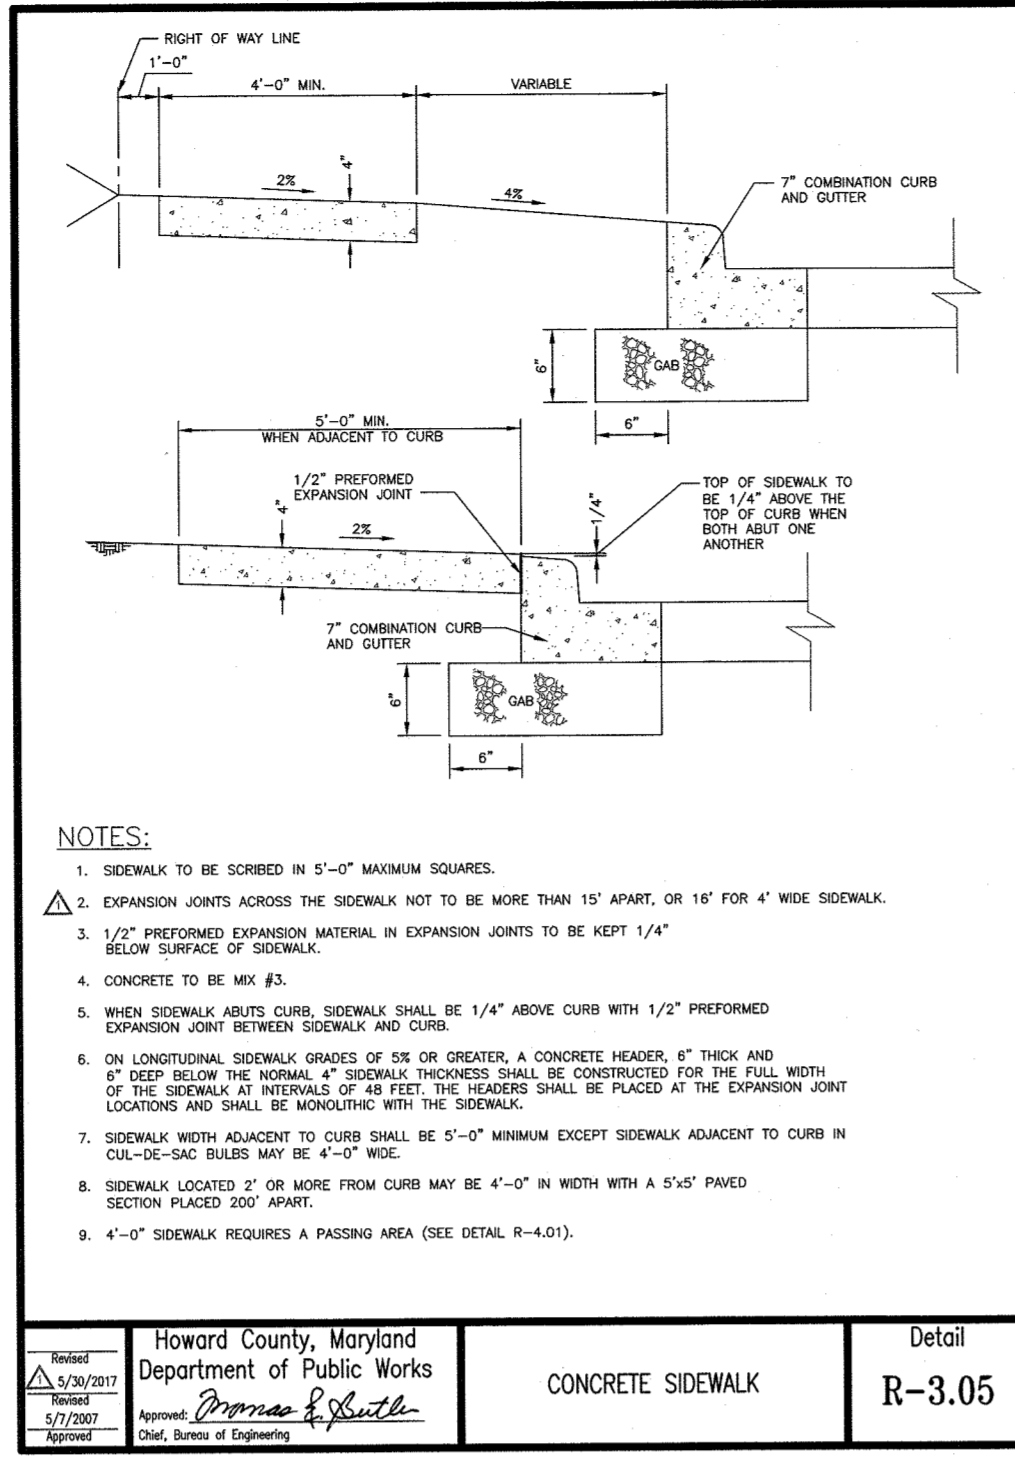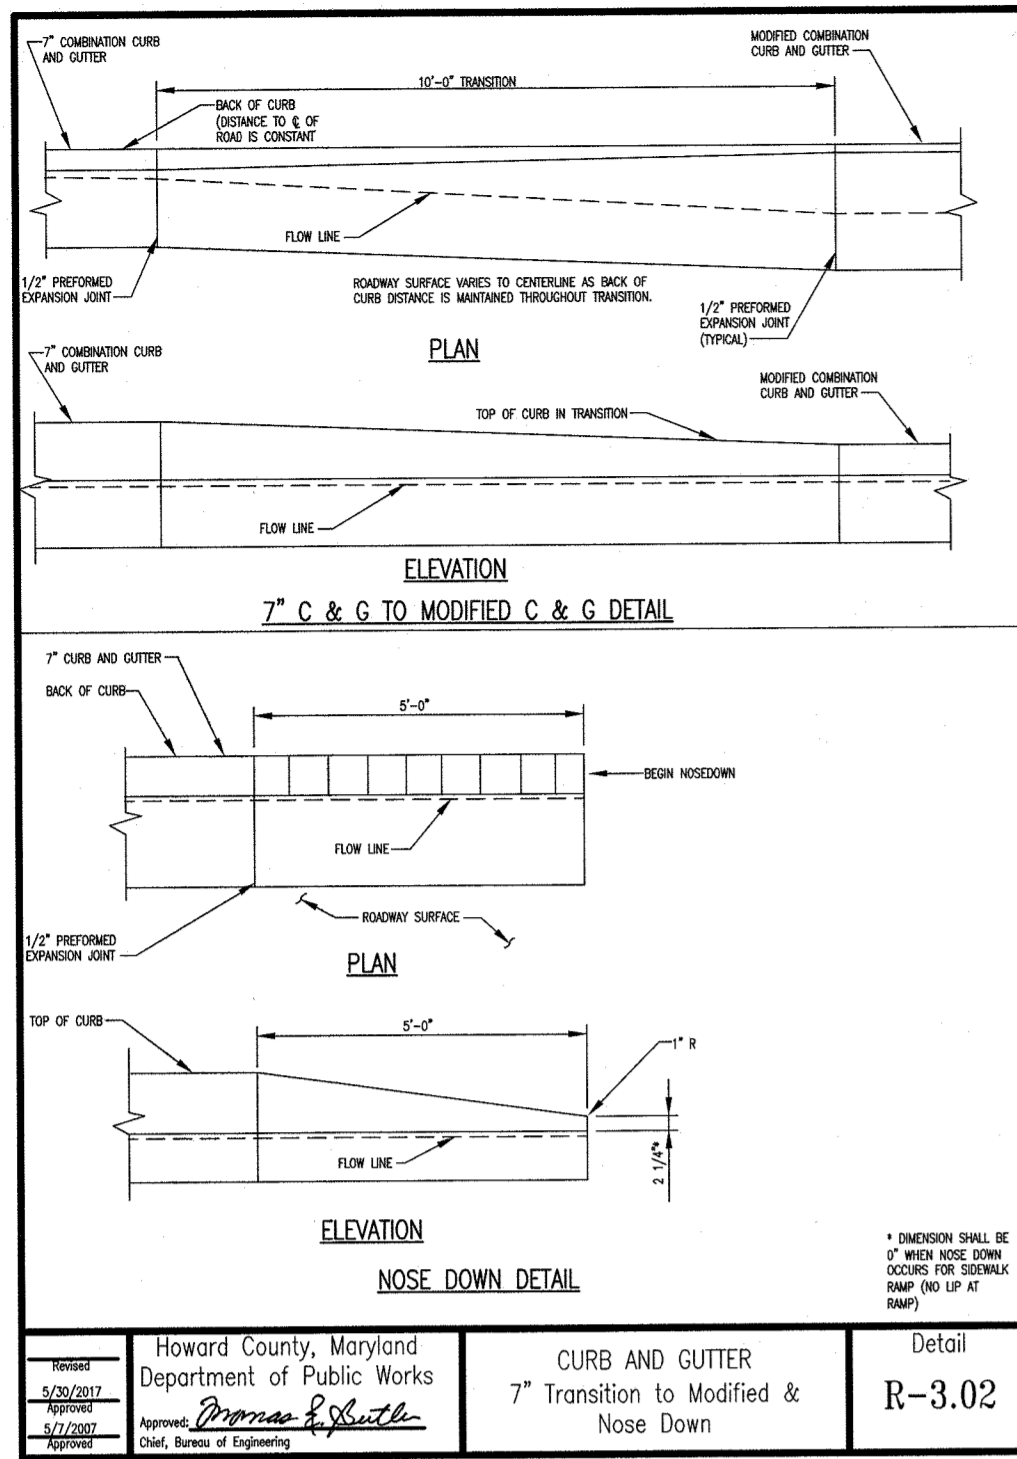

Valiant™ LED Series AVPL2 (with XL option for Utility)

PRODUCT OVERVIEW

Features:

- Colorful LED lantern, replaces HID models up to 150W HPS for street and area lighting applications
- Eleven (11) LED performance packages deliver just the right amount of light for any given application up to 13,000 lumens
- Available in color temperature choices of 2700K, 3000K, 4000K, and 5000K
- Four (4) distinct light distribution options provide design flexibility, available in Type II, Type III, Type IV, and Type V
- Die-cast aluminum housing with choice of acrylic or polycarbonate panel reflectors, engineered for energy life-long performance
- Die-cast aluminum hood features a trigger latch (TL) option and captive thumb screws for fast, easy electrical and optical chamber access
- Standard black finish in textured "matte" - all other finishes are smooth / gloss
- Housing is tenor pole mounted and designed for use with a 2" tall by 2-3/8" x 2" diameter tenon, and secured by three set screws.
- Rated L70, LED life greater than 100,000 hours at 25°C
- Complies with all applicable ANSI C136 standards
- Suitable for up to 40° ambient
- Surge protection device (standard) exceeds ANSI/IEEE C82.41:2002 Category C High (10kV/10kA) and ANSI C136.2-2015 Enhanced (10kV/5kA) 20kV Option exceeds ANSI/IEEE C82.41:2002 Category C High (10kV/10kA) and ANSI C136.2-2015 Enhanced (10kV/5kA)
- Equipped with LED electronic 0-10V dimmable driver

Applications: Streetscapes, Walkways, Pathways, Parks

Dimensions:

Effective Protection Area (EPA) The EPA for the AVPL2 is 6.5 ft x 7 ft (option and height to 31' (34ft) height, 10' - 12' height)

Installation Instructions:

- Poles stored at Central Warehouse
- See UG 275-1 for instructions for locations of street light poles.
- Pole to be set to a depth of 5'. Pole to be plumbed while backfilling with best of excavated material and topped well.
- See UG 271-1 Page 1 for details of the termination in base of pole.
- The lamp will not be fused when connected to a street light circuit. Use a fuseholder (part # 11-889) when the lamp is connected to secondary mains. See UG 272-1 for fuse connector details.
- Use a photocell when the lamp is fed from a street light circuit.
- Install pole tag (non-stock) 12" above ground level.

Item Bill of Material

Item	Description	Unit	Mat'l. No.	Quantity	Assembly Types
1	Pole, 30' bronze embedded fiberglass	Each	21-151	1	1
2	Shorting Cap	Each	11-048	1	2
3	Luminaire, 400 Watt sodium vapor reballer	Each	21-073	1	2
	400 Watt, metal halide reballer	Each	21-340	1	2
4	Lamp, 400 Watt sodium vapor	Each	11-130	1	2
	400 Watt metal halide	Each	66-488	1	2
5	Photocell	Each	11-307	30	7
6	Wire, #12 1/2in	Each	11-888	1	1
8	Fuse cartridge	Each	11-857	1	1
9	Wire nut	Each	32-001	2	4

UG 275-2 STREET AND PRIVATE AREA LIGHTING POLE WITH RECTILINEAR LUMINAIRE

Installation Instructions:

- Poles stored at Central Warehouse
- See UG 275-1 for instructions for locations of street light poles.
- Pole to be set to a depth of 5'. Pole to be plumbed while backfilling with best of excavated material and topped well.
- See UG 271-1 Page 1 for details of the termination in base of pole.
- The lamp will not be fused when connected to a street light circuit. Use a fuseholder (part # 11-889) when the lamp is connected to secondary mains. See UG 272-1 for fuse connector details.
- Use a photocell when the lamp is fed from a street light circuit.
- Install pole tag (non-stock) 12" above ground level.

Luminaire Installation Instructions:

- Insert bolster plate in top of pole.
- Hold bolster plate in position and align upper thru-bolt in fixture arm with upper hole in pole. Insert bolt through pole and bolster plate.
- Install nut on thru-bolt and tighten.
- Insert lower thru-bolt in lower hole in pole and screw into bolster plate.
- Install nut on the lower thru-bolt and tighten.
- Connect wire inside terminal on luminaire.
- Pole will accommodate 2 fuses 180° apart.

Item Description

Item	Description	Unit	Mat'l. No.	Quantity	Assembly Types
1	Pole, 30' bronze embedded fiberglass	Each	21-151	1	1
2	Shorting Cap	Each	11-048	1	2
3	Luminaire, 400 Watt sodium vapor reballer	Each	21-073	1	2
	400 Watt, metal halide reballer	Each	21-340	1	2
4	Lamp, 400 Watt sodium vapor	Each	11-130	1	2
	400 Watt metal halide	Each	66-488	1	2
5	Photocell	Each	11-307	30	7
6	Wire, #12 1/2in	Each	11-888	1	1
8	Fuse cartridge	Each	11-857	1	1
9	Wire nut	Each	32-001	2	4

BGE UNDERGROUND CONSTRUCTION STANDARDS

ATB2 SERIES LED 1300MA TYPE 3 4000K/5000K CCT

QUANTITY: 15 LOCATED WITHIN PARKING LOT SEE PLAN FOR LOCATIONS

TO: PROCUREMENT COORDINATOR, PURCHASING & MATERIALS MANAGEMENT DEPARTMENT

LOC. MATERIAL NUMBER UMA

ABBREVIATED DESCRIPTION

ESTIMATED MONTHLY USAGE

NEW ADDITION **DESCRIPTION CHANGE** (attach old description) **MR. OR RN CHANGE** **OBSCOLETE**

QUANTITY ORDERED NON-STOCK: MINIMUM QUANTITY: _____ MAXIMUM QUANTITY: _____

HAZARDOUS MATERIAL: NO IF YES YES/NO _____ STORED LAST? _____

CHECK ONE IF A NEW ADDITION TO STOCK:

MATERIAL REPLACES EXISTING STOCK ITEM

RECORD CHECKED FOR SUPPLIERS.

ITEM HAS NO EFFECT ON EXISTING STOCK

CHECK ONE IF A DESCRIPTION CHANGE:

CHANGE URGENT APPLIES TO OPEN ORDERS

CHANGE NOT URGENT APPLY TO NEXT ORDER

RECEIPT INSPECTION: BOE Eng. Standards & Refurbishment

D.M.I.S. NOTIFIED: _____

APPROVED BY: _____

PREPARED BY: William Kruse E19267 **VENDOR LEAD TIME:** _____ (DAYS)

APPROVED BY: _____

SECTION NUMBER	ROAD AND STREET CLASSIFICATION	CALIFORNIA BEARING RATIO (CBR)	3 TO <5	5 TO <7	7 TO <9	9 TO <11	11 TO <13	13 TO <15	15 TO <17	17 TO <19	19 TO <21	21 TO <23	23 TO <25
P-1	PARKING DRIVE ANGLES RESIDENTIAL AND NON-RESIDENTIAL WITH NO MORE THAN 2 HEAVY TRUCKS PER DAY	SUPERFINE ASPHALT MIX FINAL SURFACE	1.5	1.5	1.5	1.5	1.5	1.5	1.5	1.5	1.5	1.5	1.5
		SUPERFINE ASPHALT MIX INTERMEDIATE SURFACE	NA	NA	NA	NA	NA	NA	NA	NA	NA	NA	NA
P-2	PARKING DRIVE ANGLES LOCAL BOARDS ACCESS PLACE, ACCESS STREET COLLECTOR MAJOR COLLECTOR RESIDENTIAL	SUPERFINE ASPHALT MIX FINAL SURFACE	2.0	2.0	2.0	2.0	2.0	2.0	2.0	2.0	2.0	2.0	2.0
		SUPERFINE ASPHALT MIX INTERMEDIATE SURFACE	1.5	1.5	1.5	1.5	1.5	1.5	1.5	1.5	1.5	1.5	1.5
P-3	PARKING DRIVE ANGLES LOCAL BOARDS ACCESS PLACE, ACCESS STREET COLLECTOR MAJOR COLLECTOR RESIDENTIAL	SUPERFINE ASPHALT MIX FINAL SURFACE	1.5	1.5	1.5	1.5	1.5	1.5	1.5	1.5	1.5	1.5	1.5
		SUPERFINE ASPHALT MIX INTERMEDIATE SURFACE	1.0	1.0	1.0	1.0	1.0	1.0	1.0	1.0	1.0	1.0	1.0
P-4	MAJOR COLLECTORS MAJOR COLLECTORS	SUPERFINE ASPHALT MIX FINAL SURFACE	2.0	2.0	2.0	2.0	2.0	2.0	2.0	2.0	2.0	2.0	2.0
		SUPERFINE ASPHALT MIX INTERMEDIATE SURFACE	1.5	1.5	1.5	1.5	1.5	1.5	1.5	1.5	1.5	1.5	1.5

NOTES:

- HEAVY TRUCKS ARE DEFINED AS THOSE WITH SIX (6) WHEELS OR MORE INCLUDING GARAGE TRUCKS.
- SUPERFINE ASPHALT MIX LAYERS SHALL BE PLACED IN APPROPRIATE COMPACTED LIFT THICKNESS LAYERS (12" MIN. TO 4" MAX), 12.5 MM SURFACE (1.2" MIN. TO 0.7" MAX), AND 9.5 MM SURFACE (0.7" MIN. TO 0.5" MAX).
- THE INTERMEDIATE SURFACE COURSE LAYER MUST BE PLACED WITHIN 2" OF PLACEMENT OF BASE COURSE, AND IS REQUIRED PRIOR TO SUBSEQUENT COMPACTED LIFT THICKNESS LAYERS AND FINE REDUCTION.
- IN LIFT THICKNESS LAYERS, SUPERFINE ASPHALT MIX SHALL BE PLACED WITHIN 2" OF PLACEMENT OF BASE COURSE, AND IS REQUIRED PRIOR TO SUBSEQUENT COMPACTED LIFT THICKNESS LAYERS AND FINE REDUCTION.
- THE COUNTY'S PLANNING AND ZONING DEPARTMENT'S OFFICIAL RECORDING MAP IS THE AUTHORITY FOR THE PLANNING AND ZONING DEPARTMENT'S OFFICIAL RECORDING MAP. THE PLANNING AND ZONING DEPARTMENT'S OFFICIAL RECORDING MAP IS THE AUTHORITY FOR THE PLANNING AND ZONING DEPARTMENT'S OFFICIAL RECORDING MAP.
- THE CONSTRUCTION DRAWINGS SHALL SHOW THE PAVING SECTION, ROAD CLASSIFICATION AND CURB VALUE FOR EACH ROADWAY.

Howard County, Maryland
Department of Public Works
PAVING SECTIONS
P-1 to P-4
Detail
R-2.01

APPROVED

PLANNING BOARD OF HOWARD COUNTY

DATE: AUGUST 20, 2020

APPROVED: HOWARD COUNTY DEPARTMENT OF PLANNING AND ZONING

[Signature] **2/17/21** DATE

CHIEF, DEVELOPMENT ENGINEERING DIVISION

[Signature] **3/3/21** DATE

CHIEF, DIVISION OF LAND DEVELOPMENT

[Signature] **3/3/21** DATE

DIRECTOR

AVPL2 VALIANT LED WITH R3 DISTRIBUTION, CLEAR ACRYLIC (PRISMATIC) OPTIC

QUANTITY: 5 LOCATED IN FRONT OF BUILDINGS SEE PLAN FOR LOCATIONS

"NO AS-BUILT INFORMATION IS PROVIDED ON THIS SHEET"

Professional Certification: I hereby certify that these documents were prepared or approved by me, and that I am a duly licensed professional engineer under the laws of the State of Maryland.

License No. 21443, Expiration Date: 12-21-24

Professional Engineer

AS-BUILT 5-21-24

BENCHMARK ENGINEERING, INC.

8480 BALTIMORE NATIONAL PIKE SUITE 315 A ELICOTT CITY, MARYLAND 21043
(P) 410-465-6100 (F) 410-465-6144
WWW.BE-ENGINEERING.COM

RESIDENTIAL - SINGLE FAMILY ATTACHED AND MULTI-FAMILY RAVENWOOD CONDOMINIUMS AT TURF VALLEY

LOTS 1 thru 7 AND BUILDABLE BULK PARCEL 'AA'


TAX MAP: 17, PARCEL: 706, GRID: 13
ELECTION DISTRICT NO. 2 - HOWARD COUNTY, MARYLAND
ZONED: PGCC

REVISION

DATE: AUGUST 27, 2020 BEI PROJECT NO. 2931

DESIGN: DBT DRAFT: DBT SCALE: AS SHOWN SHEET 19 OF 23


AS-BUILT SDP-20-036

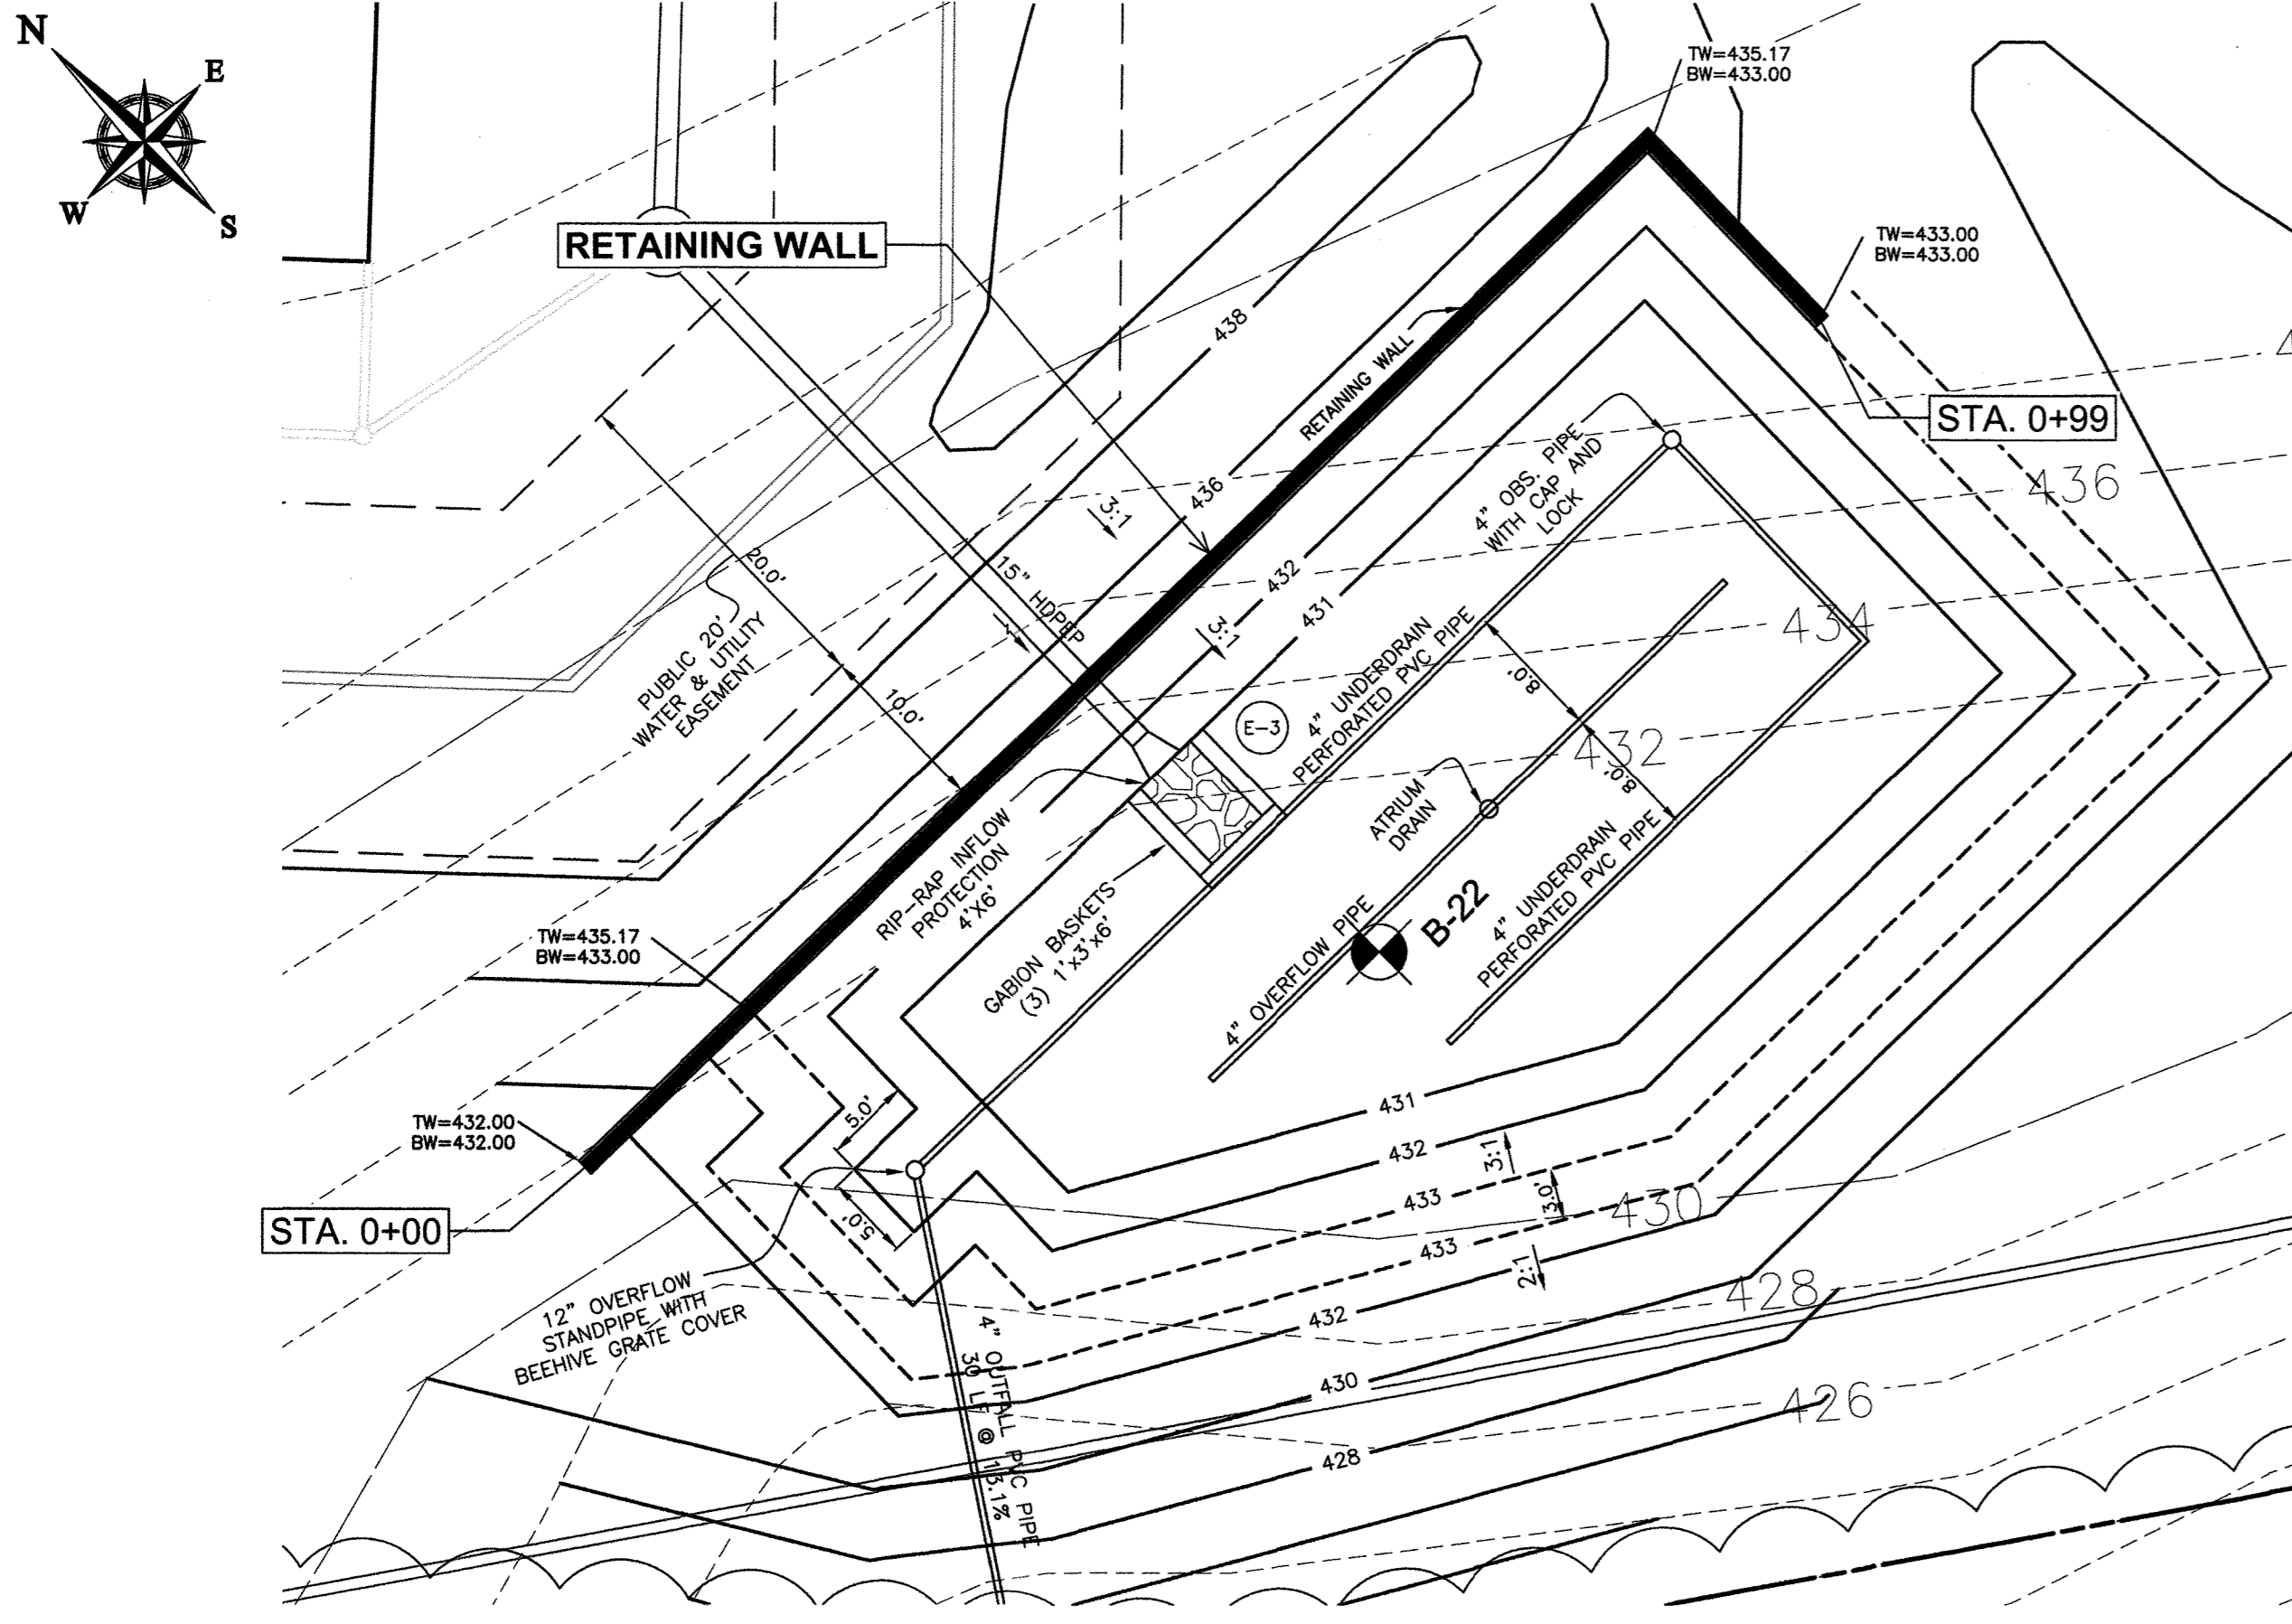

SOURCE: PLAN ADAPTED FROM A PREVIOUS UNTITLED PLAN PREPARED BY BENCHMARK ENGINEERING, INC.

WALL LOCATION PLAN

SCALE: 1" = 10'

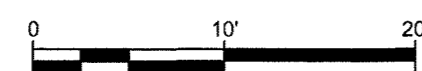

NOTES:

- NO TREES SHALL BE PLANTED WITHIN 10 FEET OF THE TOP OF THE RETAINING WALL.
- RETAINING WALLS SHALL ONLY BE CONSTRUCTED UNDER THE OBSERVATION OF A REGISTERED PROFESSIONAL ENGINEER AND A (NICET, WACEL, OR EQUIV.) CERTIFIED SOILS TECHNICIAN.
- ONE SOIL BORING SHALL BE REQUIRED EVERY ONE HUNDRED FEET ALONG THE ENTIRE LENGTH OF THE WALL. COPIES OF ALL BORING REPORTS SHALL BE PROVIDED TO THE HOWARD COUNTY INSPECTOR PRIOR TO THE START OF CONSTRUCTION.
- THE REQUIRED BEARING PRESSURE BENEATH THE WALL SYSTEM SHALL BE VERIFIED IN THE FIELD BY A CERTIFIED SOILS TECHNICIAN. TESTING DOCUMENTATION MUST BE PROVIDED TO THE HOWARD COUNTY INSPECTOR PRIOR TO START OF CONSTRUCTION. THE REQUIRED BEARING TEST SHALL BE THE DYNAMIC CONE PENETROMETER TEST ASTM STP-399.
- THE SUITABILITY OF FILL MATERIAL SHALL BE CONFIRMED BY THE ON-SITE SOILS TECHNICIAN. EACH 8" LIFT MUST BE COMPACTED TO A MINIMUM 95% STANDARD PROCTOR DENSITY AND THE TESTING REPORT SHALL BE MADE AVAILABLE TO THE HOWARD COUNTY INSPECTOR UPON COMPLETION OF CONSTRUCTION.
- WALLS SHALL NOT BE CONSTRUCTED ON UNCERTIFIED FILL MATERIALS.
- WALLS SHALL NOT BE CONSTRUCTED WITHIN A HOWARD CO. RIGHT-OF-WAY OR EASEMENT.

**SPECIFICATIONS
MODULAR CONCRETE BLOCK RETAINING WALL**

PART 1: GENERAL

1.01 DESCRIPTION

- WORK SHALL CONSIST OF FURNISHING AND CONSTRUCTION OF A MODULAR RETAINING WALL SYSTEM IN ACCORDANCE WITH THESE SPECIFICATIONS AND IN REASONABLY CLOSE CONFORMITY WITH THE LINES, GRADES, DESIGN, AND DIMENSIONS SHOWN ON THE PLANS.
- WORK INCLUDES PREPARING FOUNDATION SOIL, FURNISHING AND INSTALLING LEVELING PAD, UNIT FACING SYSTEM, UNIT DRAINAGE FILL AND REINFORCED BACKFILL TO THE LINES AND GRADES SHOWN ON THE CONSTRUCTION DRAWINGS.
- WORK INCLUDES FURNISHING AND INSTALLING GEOGRID SOIL REINFORCEMENT OF THE TYPE, SIZE, LOCATION, AND LENGTHS DESIGNATED ON THE CONSTRUCTION DRAWINGS.

1.02 DELIVERY, STORAGE AND HANDLING

- CONTRACTOR SHALL CHECK ALL MATERIALS UPON DELIVERY TO ASSURE THAT THE PROPER TYPE, GRADE, COLOR, AND CERTIFICATION HAS BEEN RECEIVED.
- CONTRACTOR SHALL PROTECT ALL MATERIALS FROM DAMAGE DUE TO JOB SITE CONDITIONS AND IN ACCORDANCE WITH MANUFACTURER'S RECOMMENDATIONS. DAMAGED MATERIALS SHALL NOT BE INCORPORATED INTO THE WORK.

PART 2: PRODUCTS

2.01 MODULAR CONCRETE RETAINING WALL UNITS

- MODULAR CONCRETE UNITS SHALL CONFORM TO THE FOLLOWING ARCHITECTURAL REQUIREMENTS:
FACE COLOR - COLOR MAY BE SPECIFIED BY THE OWNER.
FACE FINISH - HARD SPLIT IN ANGULAR TRI-PLANE OR STRAIGHT FACE CONFIGURATION. OTHER FACE FINISHES WILL NOT BE ALLOWED WITHOUT WRITTEN APPROVAL OF OWNER.

BOND CONFIGURATION - RUNNING WITH BONDS NOMINALLY LOCATED AT MIDPOINT IN VERTICALLY ADJACENT UNITS, IN BOTH STRAIGHT AND CURVED ALIGNMENTS.

EXPOSED SURFACES OF UNITS SHALL BE FREE OF CHIPS, CRACKS OR OTHER IMPERFECTIONS WHEN VIEWED FROM A DISTANCE OF 20 FEET UNDER DIFFUSED LIGHTING.

- MODULAR CONCRETE UNITS SHALL CONFORM TO THE REQUIREMENTS OF ASTM C1372 - STANDARD SPECIFICATIONS FOR SEGMENTAL RETAINING WALL UNITS.

- MODULAR CONCRETE UNITS SHALL CONFORM TO THE FOLLOWING STRUCTURAL AND GEOMETRIC REQUIREMENTS MEASURED IN ACCORDANCE WITH ASTM C140 SAMPLING & TESTING CONCRETE MASONRY UNITS.

COMPRESSIVE STRENGTH = 3000 PSI MINIMUM;
ABSORPTION = 8% MAXIMUM (6% MAXIMUM IN NORTHERN STATES) FOR STANDARD WEIGHT AGGREGATES;

DIMENSIONAL TOLERANCES = ±1/8" FROM NOMINAL UNIT DIMENSIONS NOT INCLUDING ROUGH SPLIT FACE ±1/4" FROM NOMINAL UNIT HEIGHT; UNIT SIZE - 8" (H) X 18" (W) X 12" (D) MINIMUM FOR COMPACT III UNITS; [UNIT SIZE - 8" (H) X 18" (W) X 18" (D) MINIMUM FOR STANDARD UNITS.]

INTER-UNIT SHEAR STRENGTH - 1000 PLF MINIMUM AT 2 PSI NORMAL PRESSURE; AT 2 PSI NORMAL FORCE.

[GEOGRID/UNIT PEAK CONNECTION STRENGTH - 1000 PLF MINIMUM.]

- MODULAR CONCRETE UNITS SHALL CONFORM TO THE FOLLOWING CONSTRUCTABILITY REQUIREMENTS:

VERTICAL SETBACK = 1/8" PER COURSE (NEAR VERTICAL) OR (1/4" PER COURSE) PER TYPICAL WALL SECTION; ALIGNMENT AND GRID ATTACHING MECHANISM - FIBERGLASS PINS, TWO PER UNIT MINIMUM; MAXIMUM HORIZONTAL GAP BETWEEN ERECTED UNITS SHALL BE 1/2 INCH.

2.02 SHEAR AND REINFORCEMENT PIN CONNECTORS

- SHEAR AND REINFORCEMENT PIN CONNECTORS SHALL BE 1/2 INCH DIAMETER THERMOSET ISOPHTHALIC POLYESTER RESIN PULTRUDED FIBERGLASS REINFORCEMENT RODS OR EQUIVALENT TO PROVIDE CONNECTION BETWEEN VERTICALLY AND HORIZONTALLY ADJACENT UNITS AND GEOSYNTHETIC REINFORCEMENT WITH THE FOLLOWING REQUIREMENTS: FLEXURAL STRENGTH IN ACCORDANCE WITH ASTM D4476; 128,000 PSI MINIMUM; SHORT BEAM SHEAR IN ACCORDANCE WITH ASTM D4475; 6,400 PSI MINIMUM.
- SHEAR CONNECTORS SHALL BE CAPABLE OF HOLDING THE GEOGRID IN THE PROPER DESIGN POSITION DURING GRID

PRE-TENSIONING AND BACKFILLING.

2.03 BASE LEVELING PAD MATERIAL

- MATERIAL SHALL CONSIST OF A COMPACTED #57 CRUSHED STONE BASE OR CONCRETE AS SHOWN ON THE CONSTRUCTION DRAWINGS.

2.04 UNIT DRAINAGE FILL

- UNIT DRAINAGE FILL SHALL CONSIST OF #57 CRUSHED STONE.

2.05 REINFORCED BACKFILL

- REINFORCED BACKFILL SHALL BE TYPE SM, FREE OF DEBRIS AND MEET THE FOLLOWING GRADATION TESTED IN ACCORDANCE WITH ASTM D422 AND MEET OTHER PROPERTIES SHOWN ON THE PLAN:

SIEVE SIZE	PERCENT PASSING
1 1/2 INCH	100
3/4 INCH	100-75
NO. 40	0-60
NO. 200	0-35

PLASTICITY INDEX (PI) <15 AND LIQUID LIMIT <40, PER ASTM D4318.

- MATERIAL CAN BE SITE EXCAVATED SOILS WHERE THE ABOVE REQUIREMENTS CAN BE MET. UNSUITABLE SOILS FOR BACKFILL (HIGHLY PLASTIC CLAYS OR ORGANIC SOILS) SHALL NOT BE USED IN THE REINFORCED SOIL MASS.

- CONTRACTOR SHALL SUBMIT REINFORCED FILL SAMPLE AND LABORATORY TEST RESULTS FOR APPROVAL PRIOR TO THE USE OF ANY REINFORCED BACKFILL MATERIAL.

2.06 GEOGRID SOIL REINFORCEMENT

- GEOSYNTHETIC REINFORCEMENT SHALL CONSIST OF GEOTEXTILES MANUFACTURED SPECIFICALLY FOR SOIL REINFORCEMENT APPLICATIONS AND SHALL BE MANUFACTURED FROM HIGH TENACITY POLYESTER (PET) YARN.

2.07 DRAINAGE PIPE

- THE DRAINAGE PIPE SHALL BE PERFORATED CORRUGATED HDPE PIPE MANUFACTURED IN ACCORDANCE WITH ASTM D1248.

2.08 GEOTEXTILE FILTER FABRIC

- WHEN REQUIRED, FILTER FABRIC SHALL BE A NEEDLE-PUNCHED NONWOVEN FABRIC MEETING REQUIREMENTS OF AASHTO M288.

PART 3 EXECUTION

3.01 EXCAVATION

- CONTRACTOR SHALL EXCAVATE TO THE LINES AND GRADES SHOWN ON THE CONSTRUCTION DRAWINGS. OWNER'S REPRESENTATIVE SHALL BE RESPONSIBLE FOR INSPECTING AND APPROVING THE SUBGRADE PRIOR TO PLACEMENT OF LEVELING MATERIAL OR FILL SOILS.

3.02 BASE LEVELING PAD

- LEVELING PAD MATERIAL SHALL BE PLACED TO THE LINES AND GRADES SHOWN ON THE CONSTRUCTION DRAWINGS, TO A MINIMUM THICKNESS OF 6 INCHES AND EXTEND Laterally A MINIMUM OF 6" IN FRONT AND BEHIND THE MODULAR WALL UNIT.

- LEVELING PAD SHALL BE PREPARED TO INSURE FULL CONTACT TO THE BASE SURFACE OF THE CONCRETE UNITS.

- COMPACT TO MINIMUM 95% OF STANDARD PROCTOR DENSITY PER ASTM D698.

3.03 MODULAR UNIT INSTALLATION

- FIRST COURSE OF UNITS SHALL BE PLACED ON THE LEVELING PAD AT THE APPROPRIATE LINE AND GRADE. ALIGNMENT AND LEVEL SHALL BE CHECKED IN ALL DIRECTIONS AND INSURE THAT ALL UNITS ARE IN FULL CONTACT WITH THE BASE AND PROPERLY SEATED.

- PLACE THE FRONT OF UNITS SIDE-BY-SIDE. DO NOT LEAVE GAPS BETWEEN ADJACENT UNITS. LAYOUT OF CORNERS AND CURVES SHALL BE IN ACCORDANCE WITH MANUFACTURER'S RECOMMENDATIONS.

- INSTALL SHEAR/CONNECTING DEVICES PER MANUFACTURER'S RECOMMENDATIONS.

- PLACE AND COMPACT DRAINAGE FILL WITHIN AND BEHIND WALL UNITS; NOT LESS THAN 1.3 CU. FT. OF DRAINAGE FILL SHALL BE USED FOR EACH SQ. FT. OF WALL FACE, UNLESS NOTED OTHERWISE.

- PLACE AND COMPACT REINFORCED BACKFILL SOIL BEHIND DRAINAGE FILL. FOLLOW WALL ERECTION AND DRAINAGE FILL CLOSELY WITH BACKFILL.

- MAXIMUM STACKED VERTICAL HEIGHT OF WALL UNITS, PRIOR TO UNIT DRAINAGE FILL AND BACKFILL PLACEMENT AND COMPACTION, SHALL NOT EXCEED TWO COURSES.

3.04 STRUCTURAL GEOGRID INSTALLATION

- GEOGRID SHALL BE ORIENTED WITH THE HIGHEST STRENGTH AXIS PERPENDICULAR TO THE WALL ALIGNMENT.

- GEOGRID REINFORCEMENT SHALL BE PLACED AT THE STRENGTHS, LENGTHS, AND ELEVATIONS SHOWN ON THE CONSTRUCTION DRAWINGS OR AS DIRECTED BY THE ENGINEER.

- THE GEOGRID SHALL BE LAID HORIZONTALLY ON COMPACTED BACKFILL AND ATTACHED TO THE MODULAR WALL UNIT PINS AND WITHIN 1 INCH OF THE FACE OF THE UNITS. PLACE THE NEXT COURSE OF MODULAR CONCRETE UNITS OVER THE GEOGRID. THE GEOGRID SHALL BE PULLED TAUT, AND ANCHORED PRIOR TO BACKFILL PLACEMENT ON THE GEOGRID.

- GEOGRID REINFORCEMENTS SHALL BE CONTINUOUS THROUGHOUT THEIR EMBEDMENT LENGTHS AND PLACED SIDE-BY-SIDE TO PROVIDE 100% COVERAGE AT EACH LEVEL. SPLICED CONNECTIONS BETWEEN SHORTER PIECES OF GEOGRID OR GAPS GREATER THAN 2 INCHES BETWEEN ADJACENT PIECES OF GEOGRID ARE NOT PERMITTED.

3.05 REINFORCED BACKFILL PLACEMENT

- REINFORCED BACKFILL SHALL BE PLACED, SPREAD, AND COMPACTED IN SUCH A MANNER THAT MINIMIZES THE DEVELOPMENT OF SLACK IN THE GEOGRID AND INSTALLATION DAMAGE TO GEOGRID.

- REINFORCED BACKFILL SHALL BE PLACED AND COMPACTED IN LIFTS NOT TO EXCEED 6 INCHES WHERE HAND OPERATED COMPACTION EQUIPMENT IS USED, OR 8 - 10 INCHES WHERE HEAVY COMPACTION EQUIPMENT IS USED. LIFT THICKNESS SHALL BE DECREASED TO ACHIEVE THE REQUIRED DENSITY AS REQUIRED.

- REINFORCED BACKFILL SHALL BE COMPACTED TO 95% OF THE MAXIMUM DENSITY AS DETERMINED BY ASTM D698. THE MOISTURE CONTENT OF THE BACKFILL MATERIAL PRIOR TO AND DURING COMPACTION SHALL BE UNIFORMLY DISTRIBUTED THROUGHOUT EACH LAYER AND SHALL BE + 0% TO - 3% OF OPTIMUM.

- ONLY LIGHTWEIGHT HAND-OPERATED COMPACTION EQUIPMENT SHALL BE ALLOWED WITHIN 3 FEET FROM THE BACK OF THE MODULAR CONCRETE UNIT.

- TRACKED CONSTRUCTION EQUIPMENT SHALL NOT BE OPERATED DIRECTLY UPON THE GEOGRID REINFORCEMENT. A MINIMUM FILL THICKNESS OF 6 INCHES IS REQUIRED PRIOR TO OPERATION OF TRACKED VEHICLES OVER THE GEOGRID. TRACKED VEHICLE TURNING SHOULD BE KEPT TO A MINIMUM TO PREVENT TRACKS FROM DISPLACING THE FILL AND DAMAGING OR DISPLACING THE MODULAR CONCRETE UNITS OR GEOGRID.

- RUBBER Tired EQUIPMENT MAY PASS OVER GEOGRID REINFORCEMENT AT SLOW SPEEDS, LESS THAN 10 MPH. SUDDEN BRAKING AND TURNING SHALL BE AVOIDED.

- AT THE END OF EACH DAY'S OPERATION, THE CONTRACTOR SHALL SLOPE THE LAST LIFT OF REINFORCED BACKFILL AWAY FROM THE WALL UNITS TO DIRECT RUNOFF AWAY FROM WALL FACE. THE CONTRACTOR SHALL NOT ALLOW SURFACE RUNOFF FROM ADJACENT AREAS TO ENTER THE WALL CONSTRUCTION SITE.

3.06 CAP INSTALLATION

- PRIOR TO PLACEMENT OF CAP UNITS, THE UPPER SURFACE OF THE TOP COURSE WALL UNITS SHALL BE CLEANED OF SOIL AND ANY OTHER MATERIAL.

- CAP UNITS SHALL BE GLUED TO UNDERLYING UNITS WITH AN ALL-WEATHER EXTERIOR CONSTRUCTION ADHESIVE RECOMMENDED BY THE MANUFACTURER.

3.07 FIELD QUALITY CONTROL

- THE OWNER SHALL ENGAGE INSPECTION AND TESTING SERVICES, INCLUDING INDEPENDENT LABORATORIES, TO PROVIDE QUALITY ASSURANCE AND TESTING SERVICES DURING CONSTRUCTION.

- AS A MINIMUM, QUALITY ASSURANCE TESTING SHOULD INCLUDE FOUNDATION SOIL INSPECTION, RETAINED SOIL AND BACKFILL TESTING, VERIFICATION OF DESIGN PARAMETERS, AND OBSERVATION OF CONSTRUCTION FOR GENERAL COMPLIANCE WITH DESIGN DRAWINGS AND SPECIFICATIONS.

"NO AS-BUILT INFORMATION IS PROVIDED ON THIS SHEET"

Professional Certification. I hereby certify that these documents were prepared or approved by me, and that I am a duly licensed professional engineer under the laws of the State of Maryland.
License No. 21443, Expiration Date: 12-21-24



AS-BUILT 5-21-20

APPROVED
PLANNING BOARD OF HOWARD COUNTY
DATE August 20, 2020

APPROVED: DEPARTMENT OF PLANNING AND ZONING
10-5-20
10-28-20
10-29-20

**HILLIS-CARNES
ENGINEERING ASSOCIATES**
10975 Guilford Road, Suite A
Annapolis Junction, Maryland
Phone: (410) 880-4788 www.hcea.com Fax: (410) 880-4098


**RETAINING WALL PLAN AND SPECIFICATIONS
RAVENWOOD CONDOMINIUMS AT TURF VALLEY
HOWARD COUNTY, MARYLAND**

REVISION NO.	DESCRIPTION	DATE	JOB NUMBER:	DESIGNED BY:	AM
			19453A	DRAWN BY:	AM
			SCALE:	APPROVED BY:	HM
			AS SHOWN		
			DATE:		
			7/21/20		




PROFESSIONAL CERTIFICATION
I HEREBY CERTIFY THAT THESE PLANS WERE PREPARED OR APPROVED BY ME, AND THAT I AM A DULY LICENSED PROFESSIONAL ENGINEER UNDER THE LAWS OF THE STATE OF MARYLAND.
LICENSE NO. 12012
EXPIRATION DATE: 06/16/22


21
SHEET

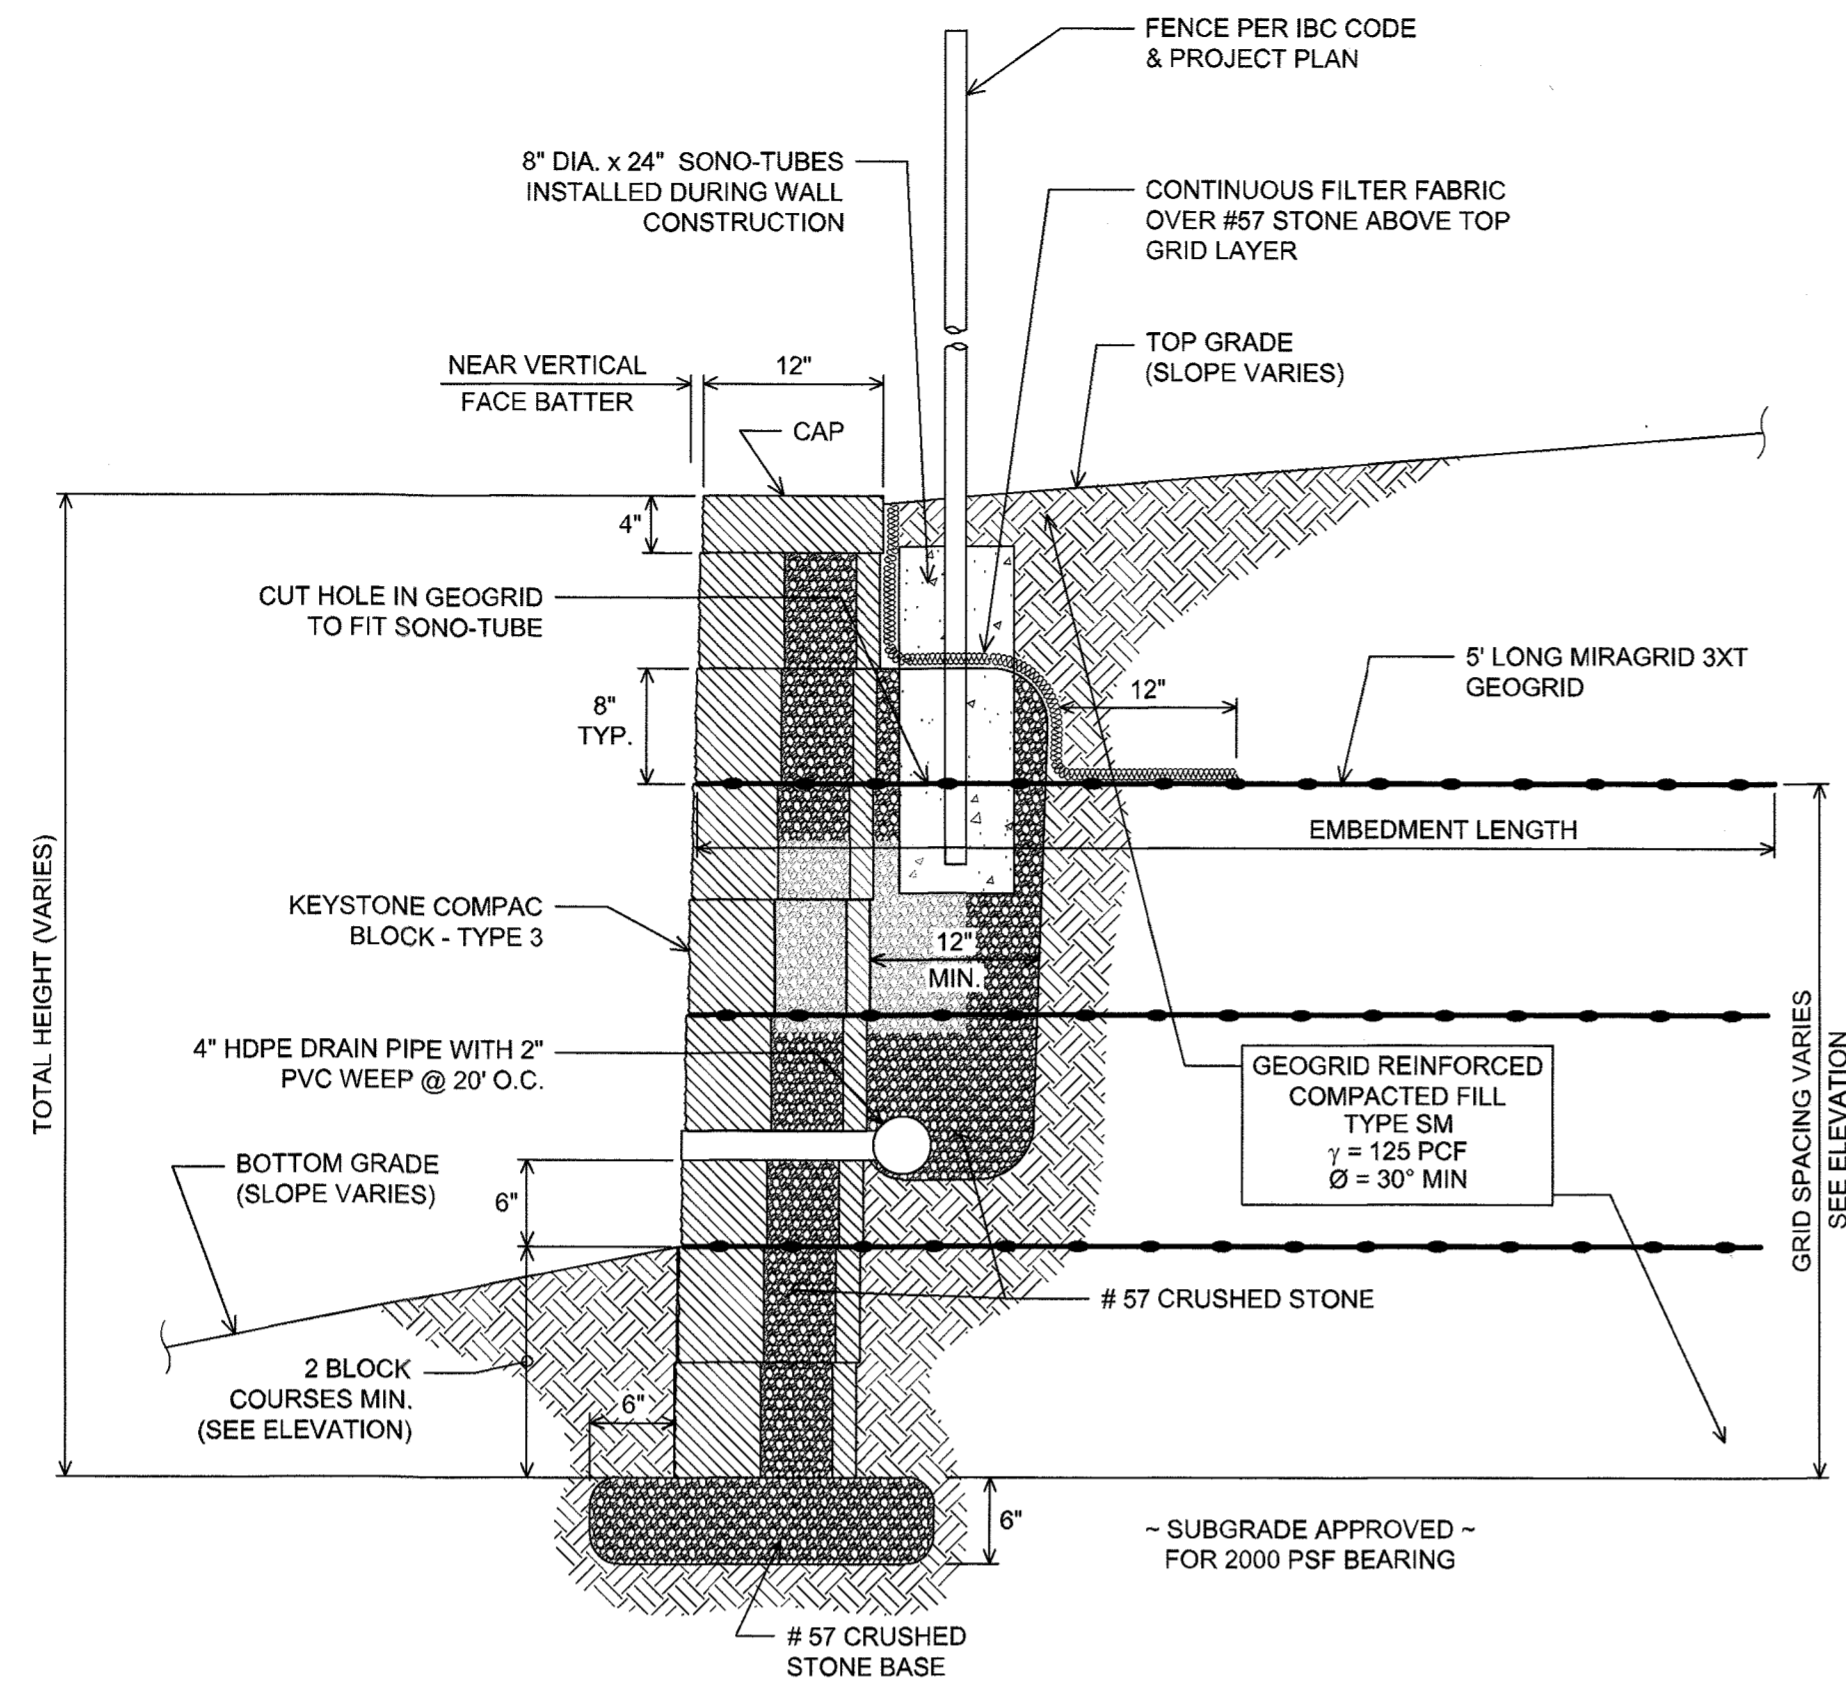



TYPICAL WALL SECTION
STA. 0+00 TO 0+19±
N.T.S.

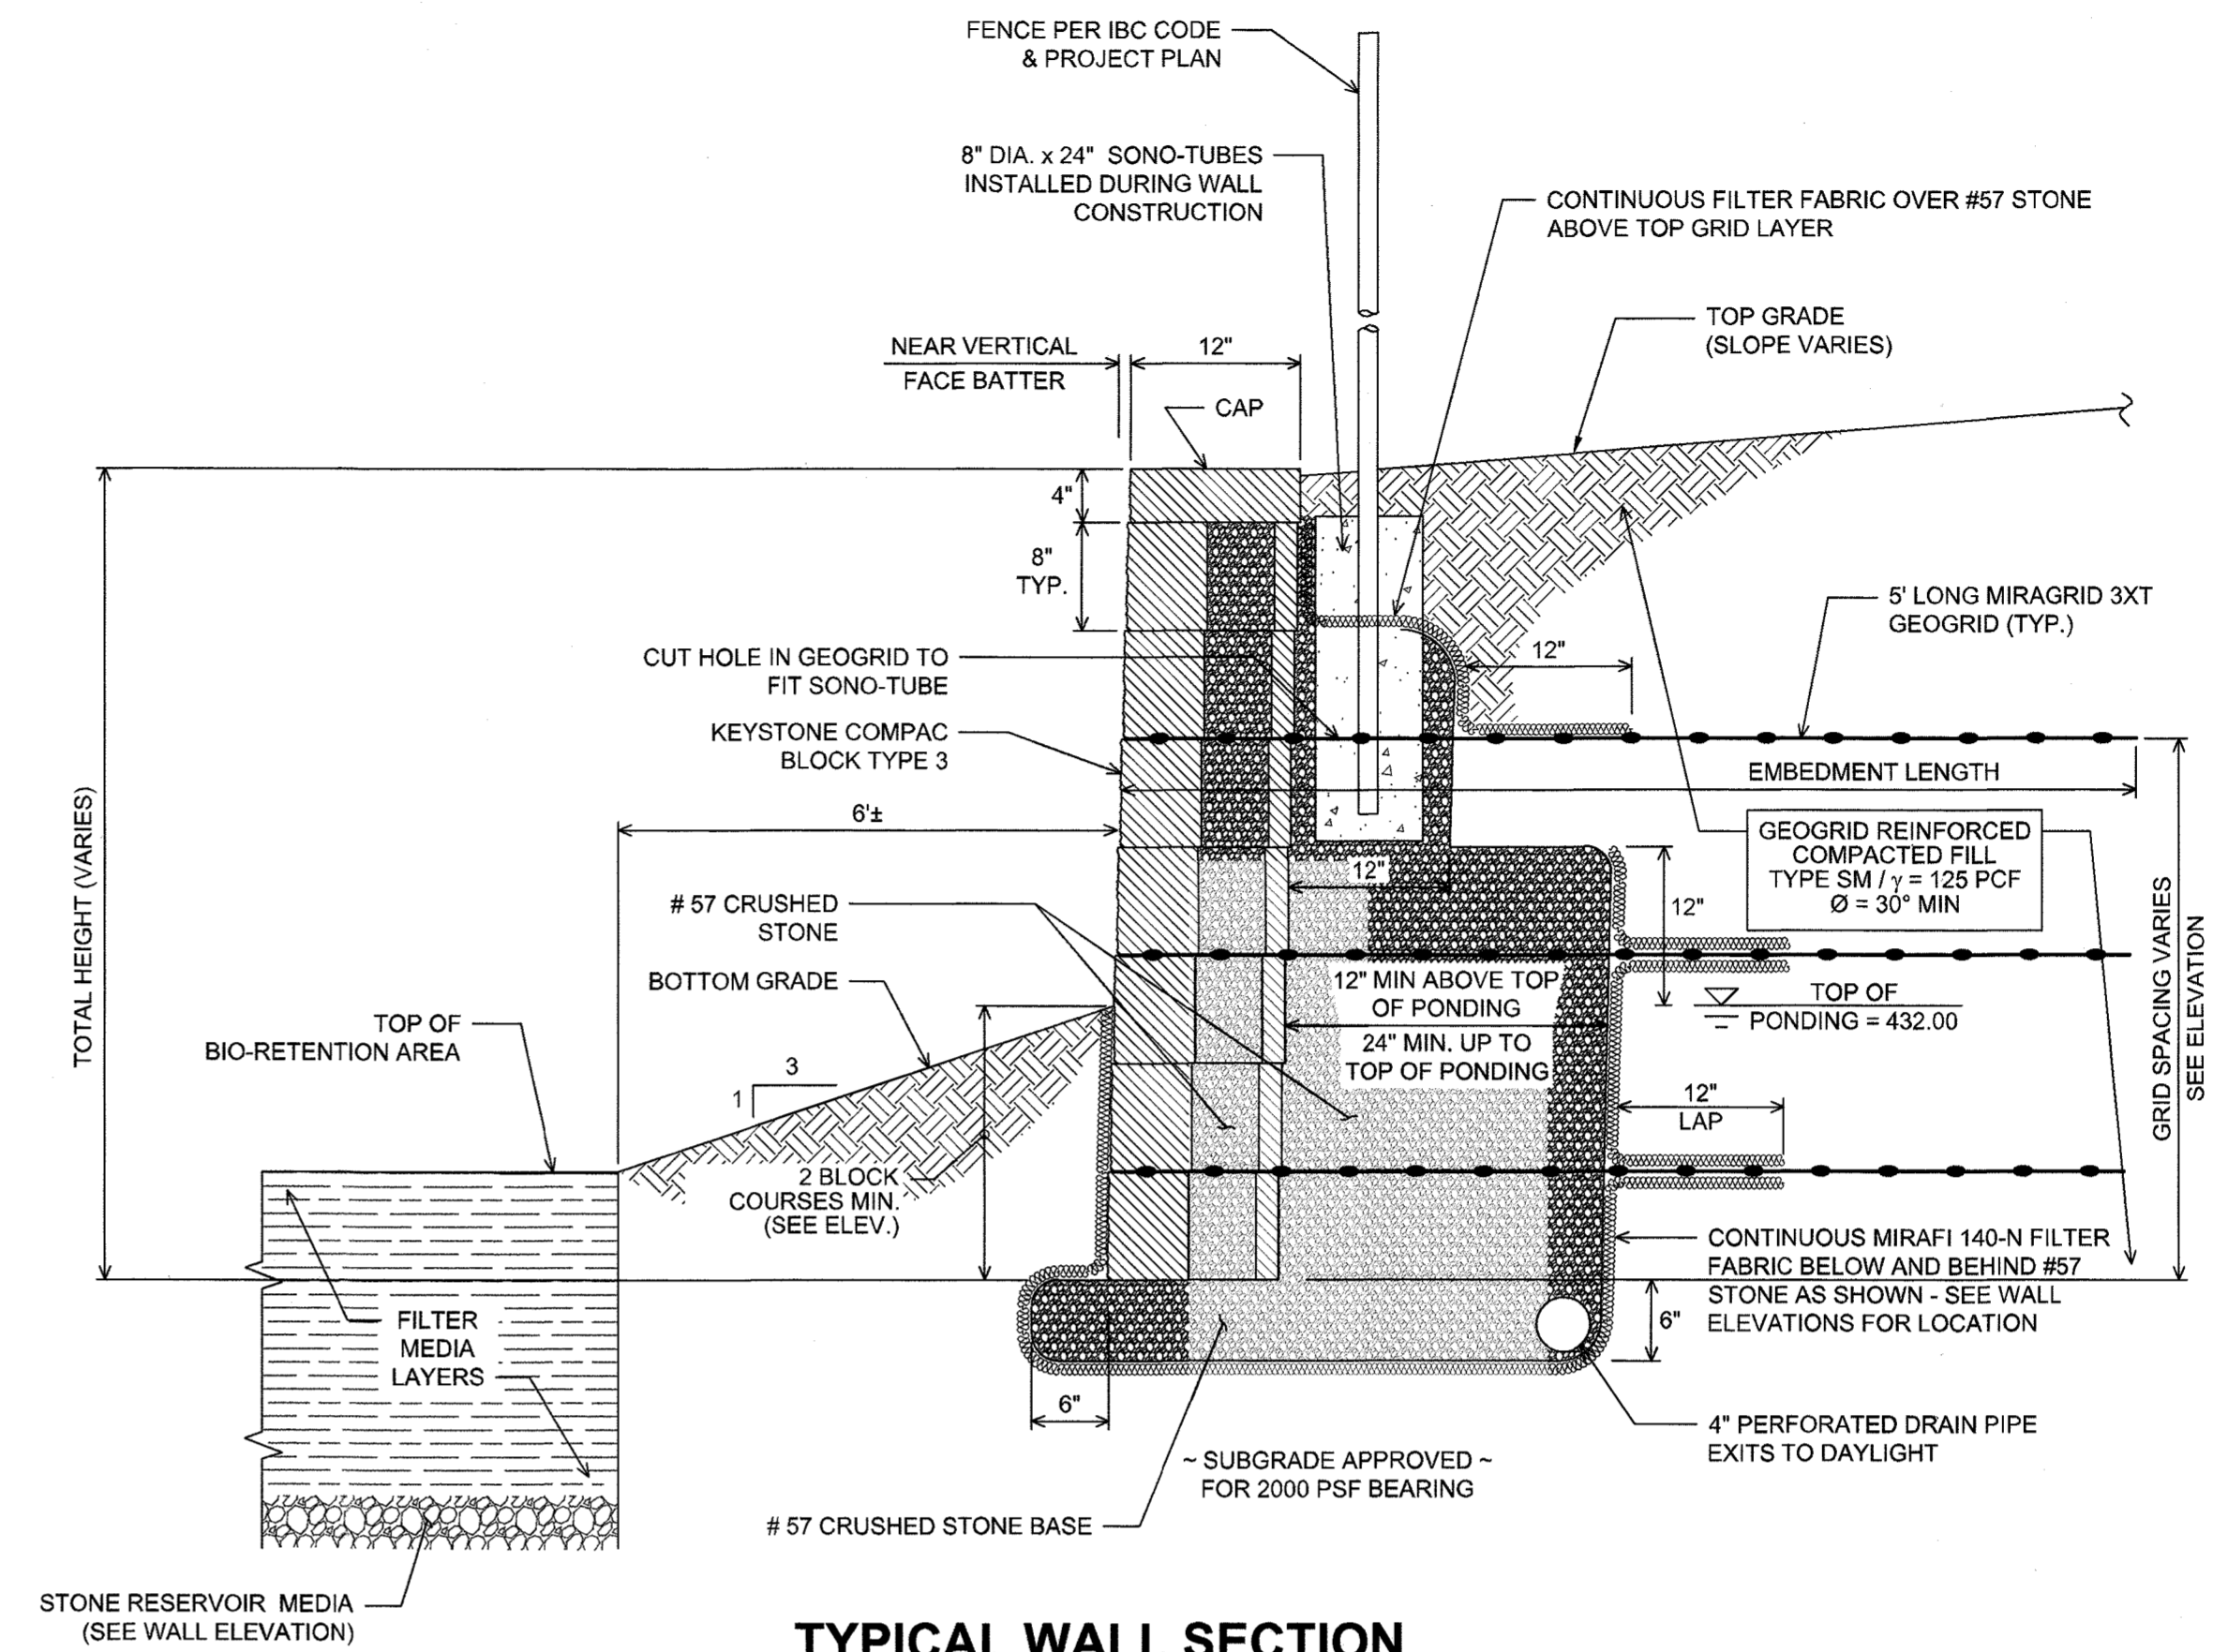


TYPICAL WALL SECTION
STA. 0+19± TO 0+99
N.T.S.

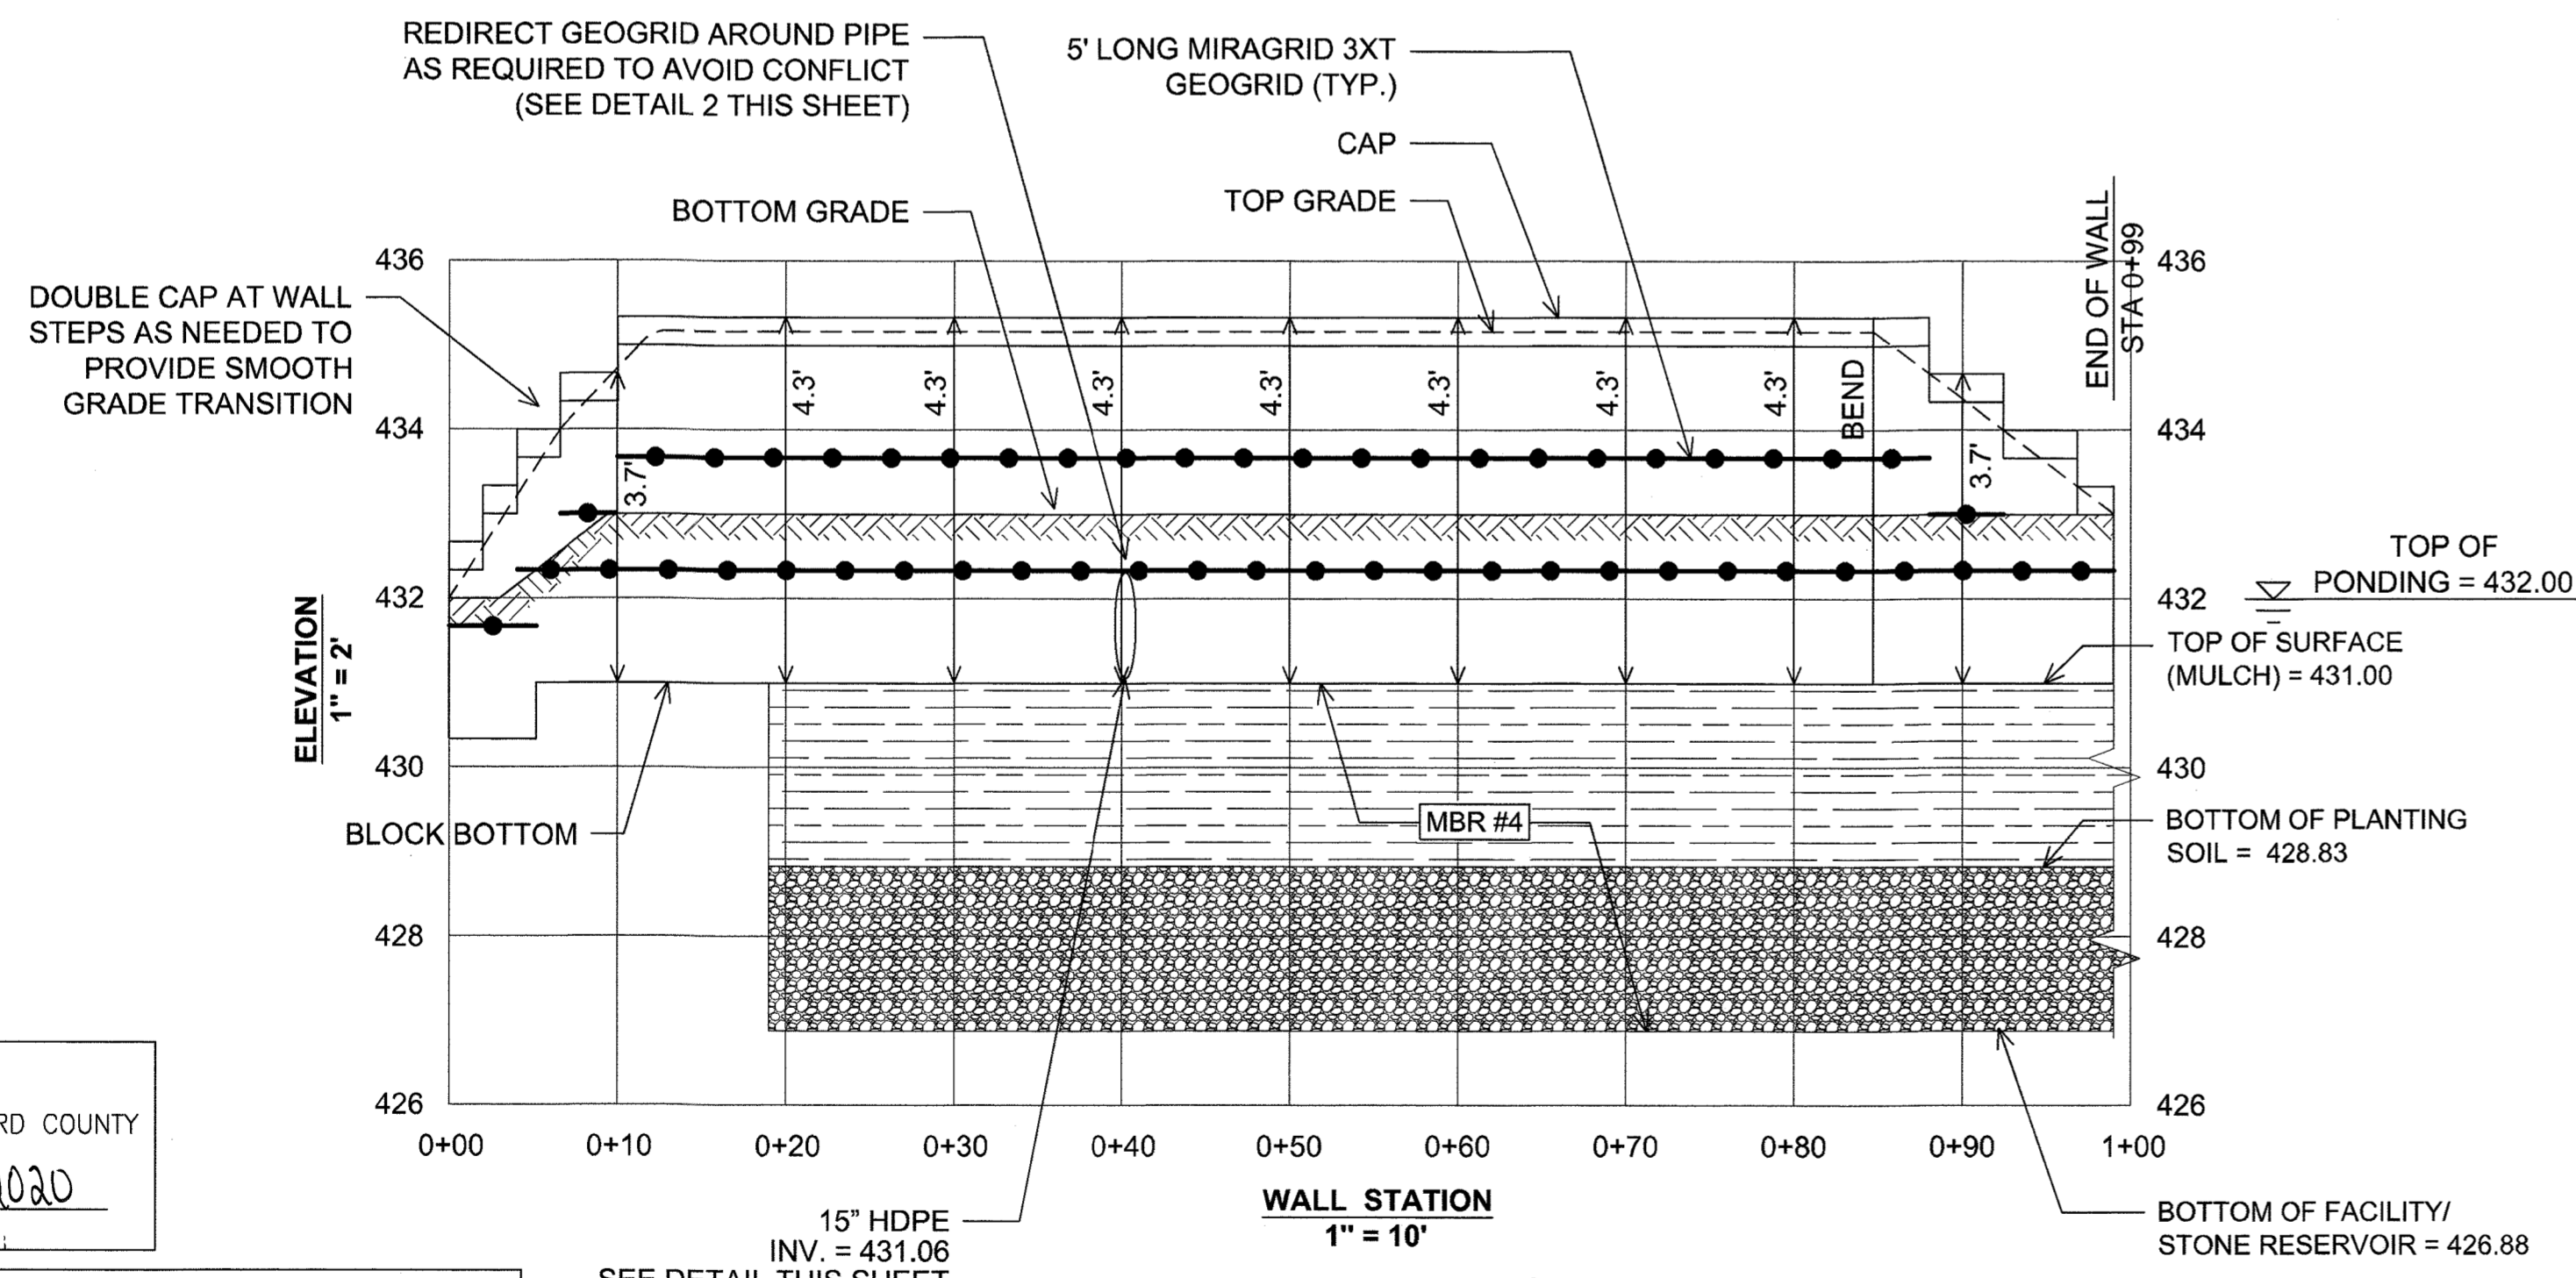

WALL ELEVATION

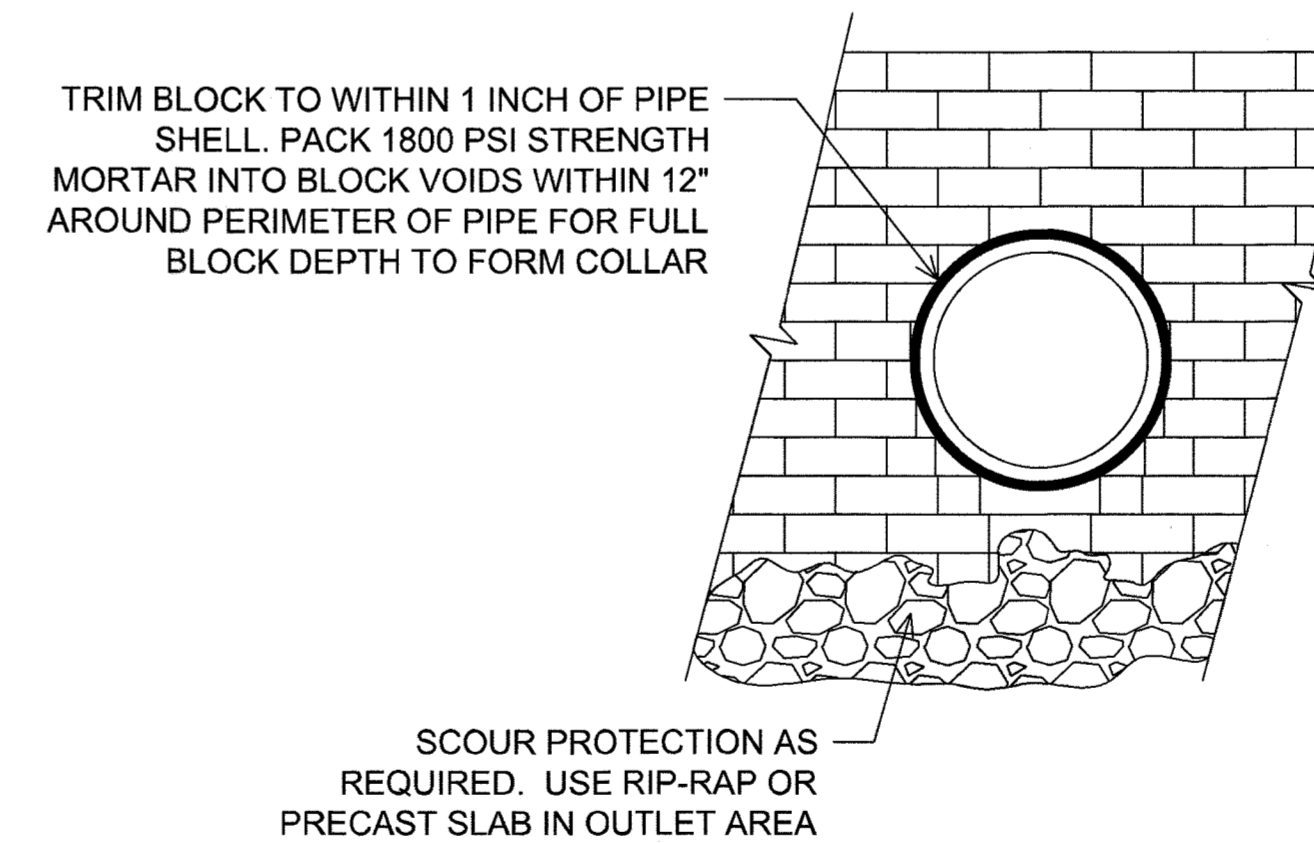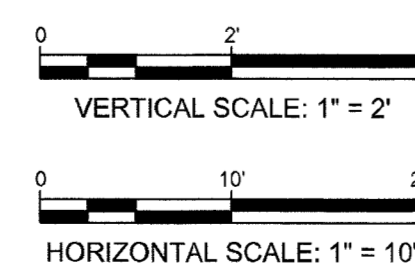

DETAIL 1 - PIPE THRU WALL
N.T.S.

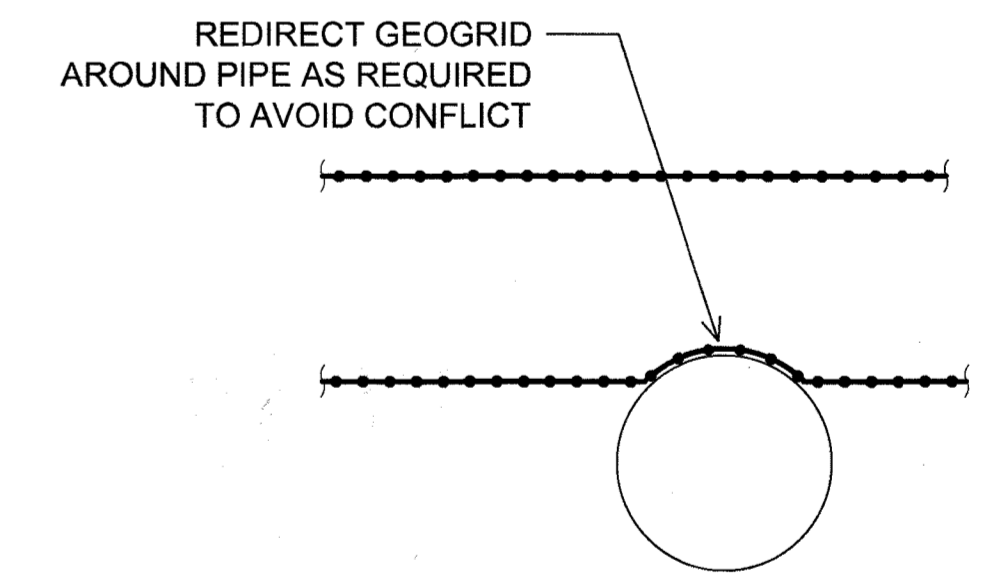

DETAIL 2 - PIPE IN REINFORCED ZONE
RUNNING PERPENDICULAR TO WALL
N.T.S.

APPROVED
 PLANNING BOARD OF HOWARD COUNTY
 DATE August 20, 2020

APPROVED: DEPARTMENT OF PLANNING AND ZONING
 Chief, Development Engineering Division 10/5/20 DATE
 Chief, Division of Land Development 10/26/20 DATE
 Director 10/29/20 DATE

Professional Engineer
 State of Maryland
 No. 21443
 AS-BUILT 5-21-24

Professional Certification. I hereby certify that these documents were prepared or approved by me, and that I am a duly licensed professional engineer under the laws of the State of Maryland.
 License No. 21443 Expiration Date: 12-31-24

PROFESSIONAL CERTIFICATION
 I HEREBY CERTIFY THAT THESE PLANS WERE PREPARED OR APPROVED BY ME, AND THAT I AM A DULY LICENSED PROFESSIONAL ENGINEER UNDER THE LAWS OF THE STATE OF MARYLAND.
 LICENSE NO. 12012
 EXPIRATION DATE: 06/16/22

HILLIS-CARNES
ENGINEERING ASSOCIATES
 10975 Guilford Road, Suite A Annapolis Junction, Maryland
 Phone: (410) 880-4788 www.hcea.com Fax: (410) 880-4098


RETAINING WALL ELEVATION AND DETAILS
RAVENWOOD CONDOMINIUMS AT TURF VALLEY
 HOWARD COUNTY, MARYLAND

REVISION NO.	DESCRIPTION	DATE	JOB NUMBER:	DESIGNED BY:
			19453A	AM
			SCALE: AS SHOWN	DRAWN BY: AM
			DATE: 7/21/20	APPROVED BY: HM

22
 SHEET




FRONT ELEVATION

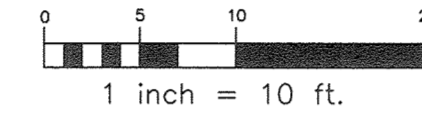


BUILDING HEIGHT CALCULATION
 TOP OF ROOF PARAPET TO GRADE AT FRONT = 35'-8"
 TOP OF ROOF FASCIA TO GRADE AT REAR = 43'-8"
 MEAN HEIGHT = (35'-8" + 43'-8") / 2
 = 79'-4" / 2 = 39'-8"


SIDE ELEVATION

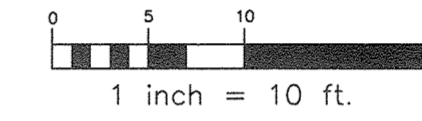


REAR ELEVATION

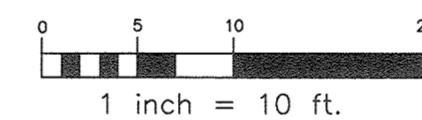

"NO AS-BUILT INFORMATION IS PROVIDED ON THIS SHEET"

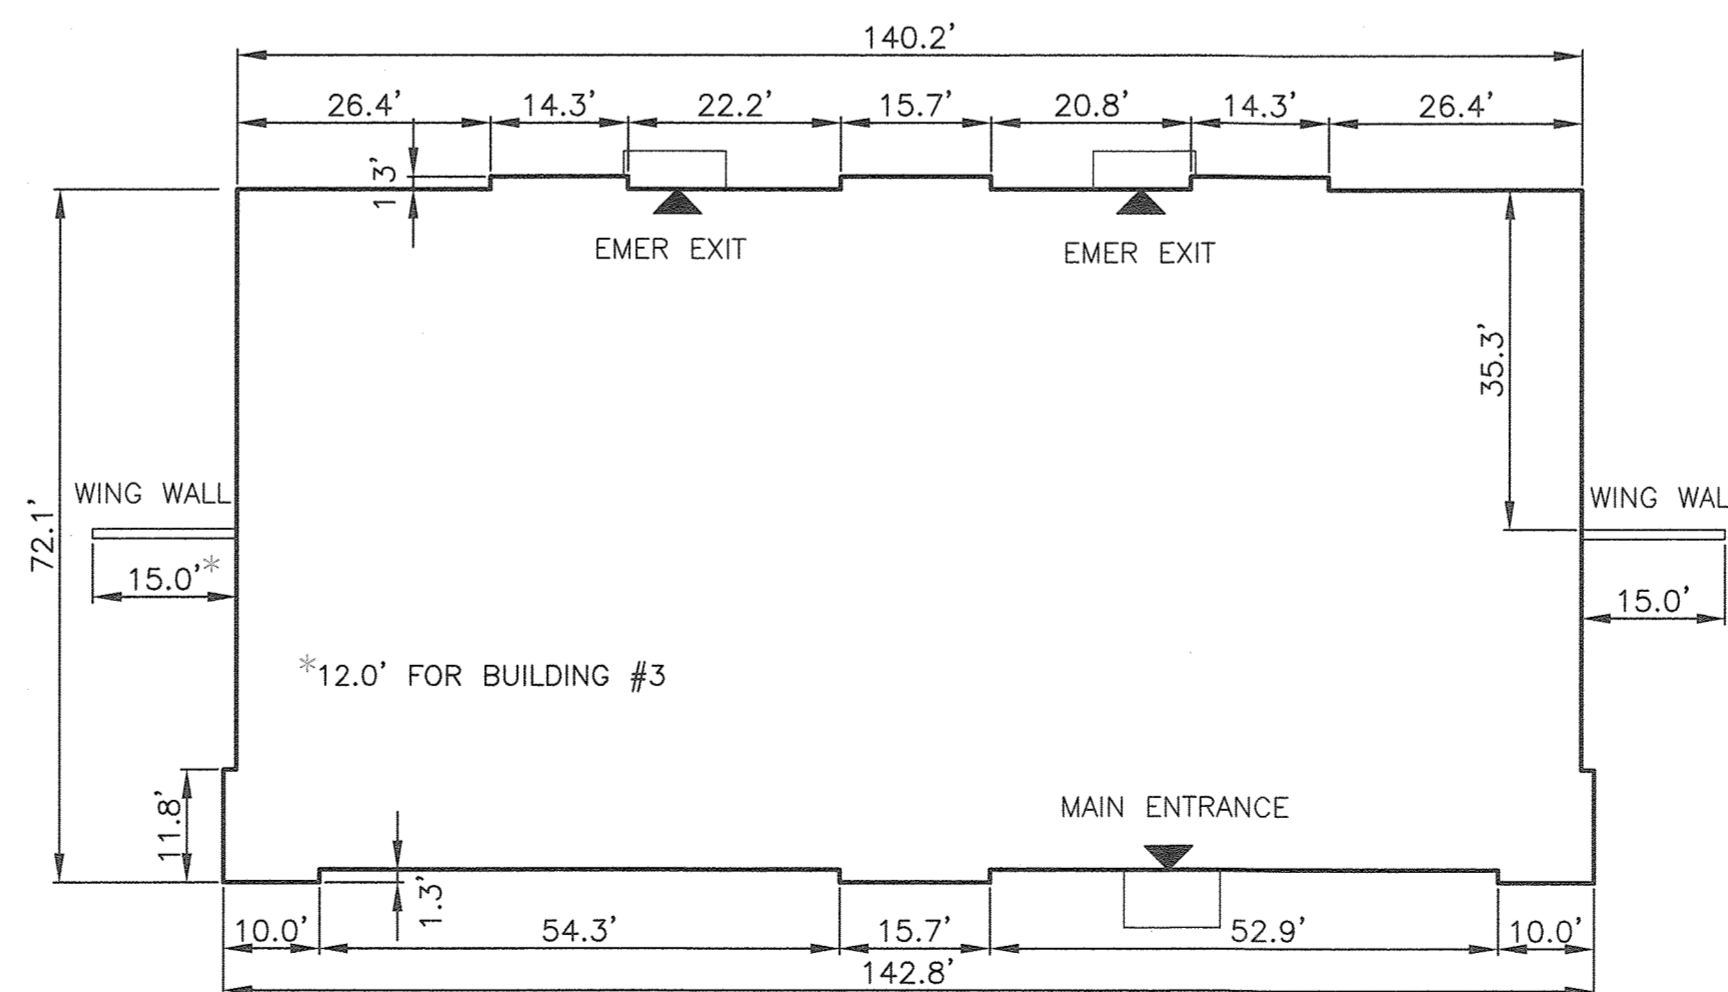

FOOTPRINT

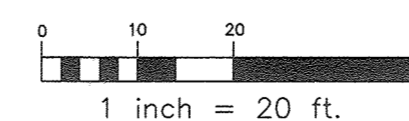

Dorian M...
 AS-BUILT 5-21-22

Professional Certification. I hereby certify that these documents were prepared or approved by me, and that I am a duly licensed professional engineer under the laws of the State of Maryland.
 License No. 21448 Expiration Date: 12-31-24

NO.	DATE	REVISION
1	4.25.2022	ADD WING WALLS.

BENCHMARK ENGINEERING, INC.
 ENGINEERS & LAND SURVEYORS & PLANNERS
 8480 BALTIMORE NATIONAL PIKE & SUITE 315 & ELLICOTT CITY, MARYLAND 21043
 (P) 410-465-6105 (F) 410-465-6644
 WWW.BE-CIVILENGINEERING.COM

OWNER/BUILDER: MANGIONE ENTERPRISES OF TURF VALLEY, LIMITED PARTNERSHIP 1205 YORK ROAD, PENTHOUSE LUTHERVILLE, MARYLAND 21093 410-825-8400	RESIDENTIAL - SINGLE FAMILY ATTACHED AND MULTI-FAMILY RAVENWOOD CONDOMINIUMS AT TURF VALLEY LOTS 1 thru 7 AND BUILDABLE BULK PARCEL 'AA'
DATE: AUGUST 27, 2020	BEI PROJECT NO. 2931
SCALE: AS SHOWN	SHEET 23 OF 23
DESIGN: DBT	DRAFT: DBT

APPROVED
 PLANNING BOARD OF HOWARD COUNTY
 DATE AUGUST 20, 2020

APPROVED: DEPARTMENT OF PLANNING AND ZONING
Chad Clark 5/9/22
 CHIEF, DEVELOPMENT ENGINEERING DIVISION DATE
Steve... 5/10/22
 CHIEF, DIVISION OF LAND DEVELOPMENT DATE
Angela... 5/10/22
 DIRECTOR DATE