

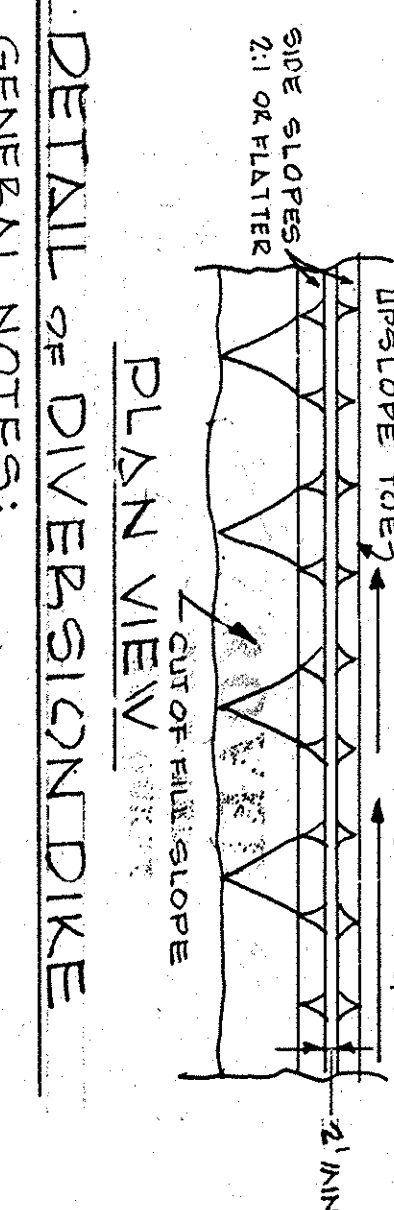
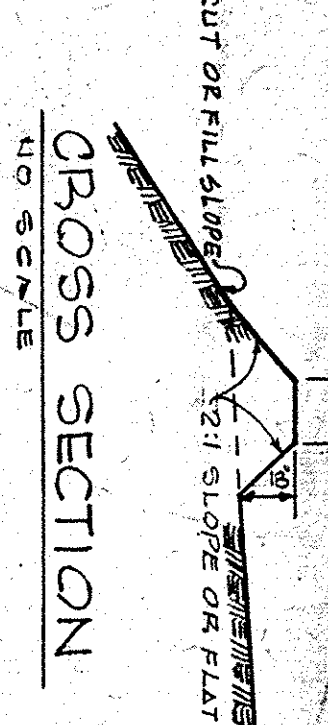
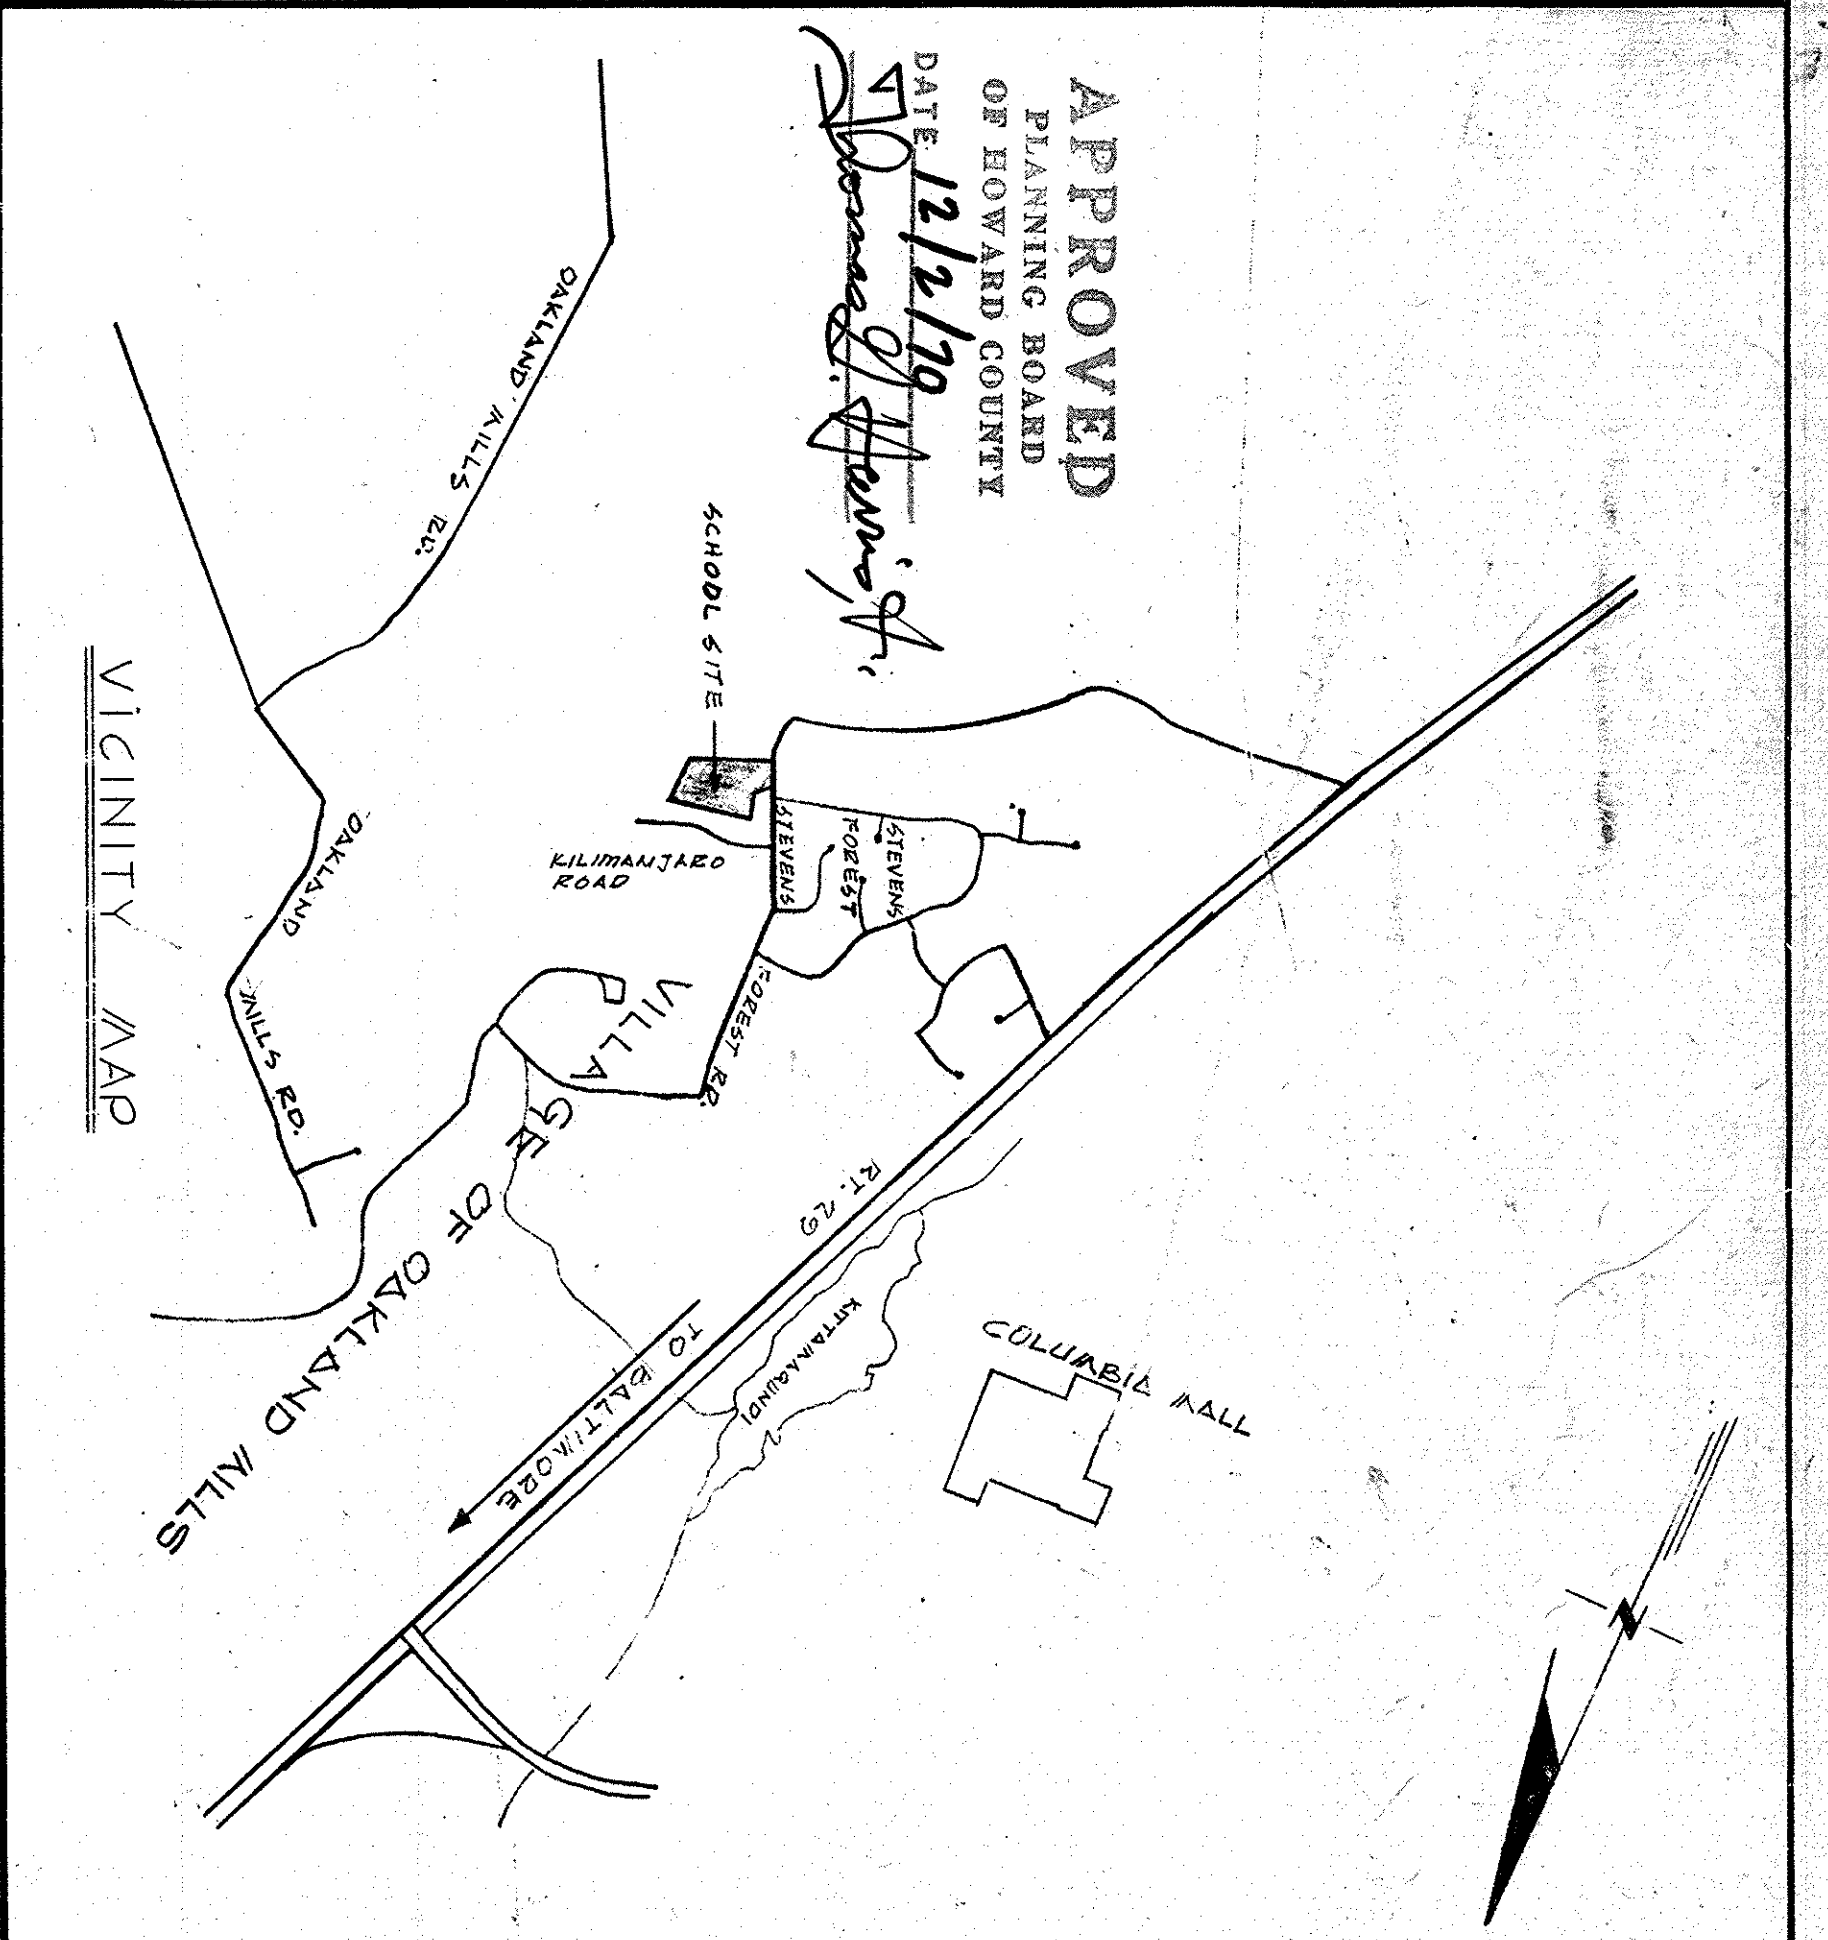
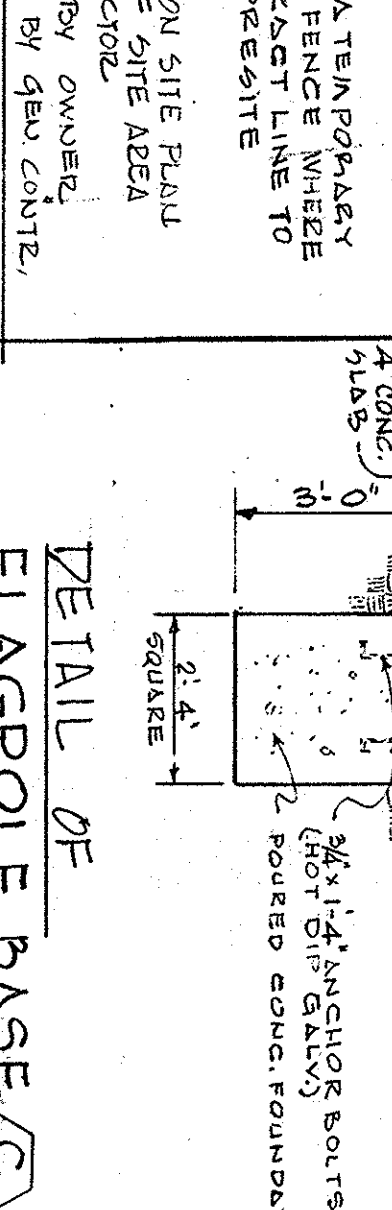
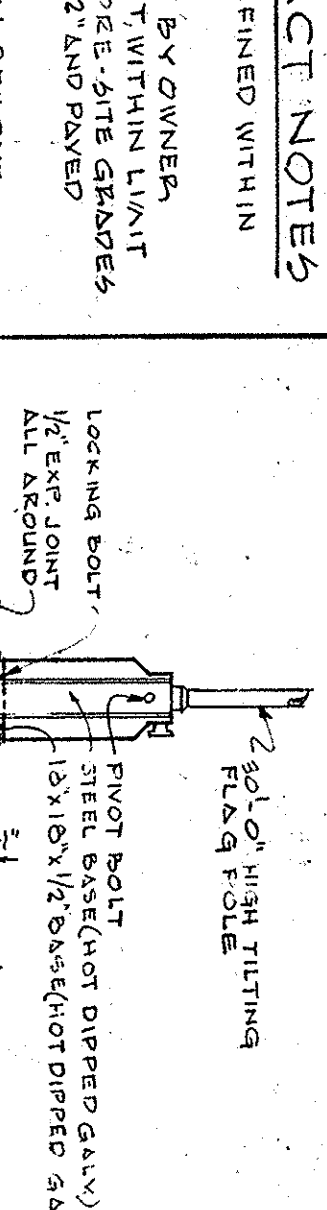


PRE-SITE CONTACT WORK BY OWNER
 (NOT IN BLDG. CONTRACT)

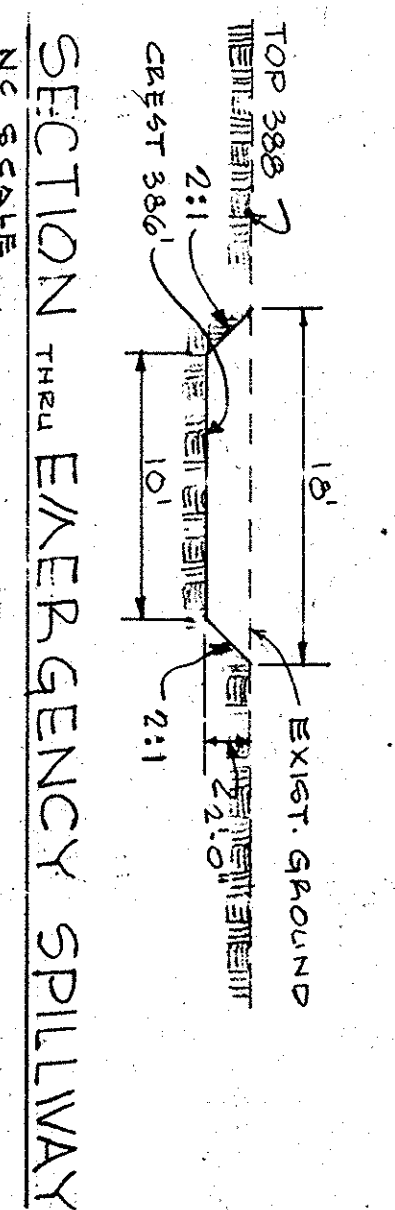

GENERAL NOTES:
 1. ALL DIKES MUST BE ACCURATELY CONSTRUCTED.
 2. ALL DIKES MUST BE CONSTRUCTED WITH POSITIVE GRADE DRAINAGE.
 3. DIVERSION DIKES WILL BE CONSTRUCTED WITH POSITIVE GRADE DRAINAGE.
 4. PERIODIC INSPECTION AND MAINTENANCE MUST BE PROVIDED.

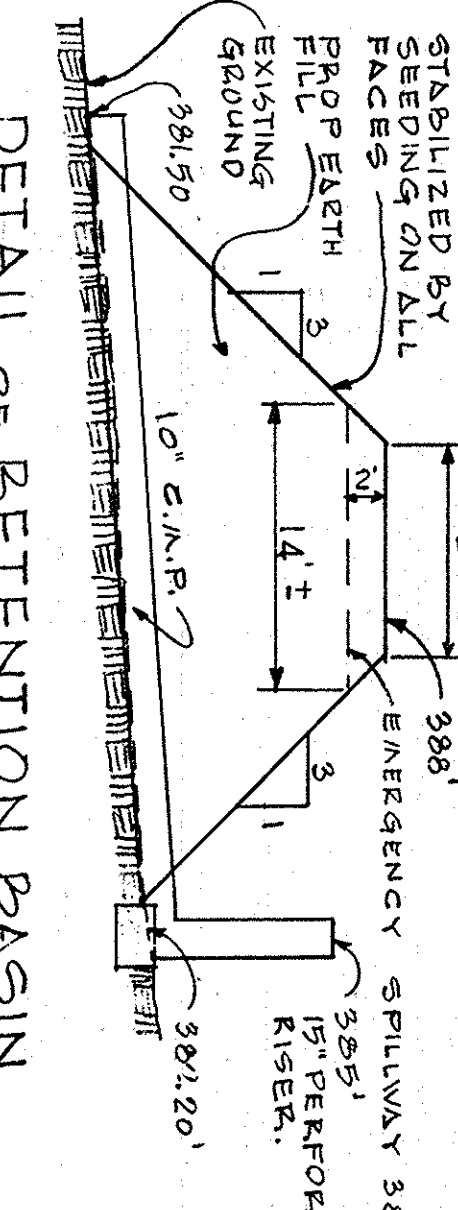

GENERAL NOTES:
 1. CONTRACTOR SHALL VERIFY ALL INFORMATION INDICATED ON THIS CONTRACT DRAWING.
 2. TEMPORARY SEDIMENT CONTROL STRUCTURES SHALL BE LOCATED AS SHOWN ON THIS DRAWING.
 3. NEW GRASSES SHALL BE PLANTED TO MEET THE REQUIREMENTS OF THE DISTRICT.
 4. ALL EXISTING UTILITIES SHALL BE MAINTAINED AND PROTECTED.
 5. ALL UTILITIES SHALL BE DEEPENED TO A MINIMUM OF 48 INCHES.
 6. ALL UTILITIES SHALL BE COVERED WITH 18 INCH CONCRETE SLABS.
 7. ALL UTILITIES SHALL BE PROTECTED BY 18 INCH CONCRETE SLABS.
 8. ALL UTILITIES SHALL BE PROTECTED BY 18 INCH CONCRETE SLABS.
 9. ALL UTILITIES SHALL BE PROTECTED BY 18 INCH CONCRETE SLABS.
 10. ALL UTILITIES SHALL BE PROTECTED BY 18 INCH CONCRETE SLABS.

NOTES:
 1. ALL sediment controls must be constructed prior to site grading.
 2. No temporary sediment control structure may be removed or destroyed without approval of the Howard Soil Conservation District.
 3. Area to be seeded within road R/W's shall use a seed mixture as follows: annual ryegrass (20%), Kentucky bluegrass (20%), and Kentucky 31 fescue (60%) at the rate of 200#/A. Sow with mechanical spreader, rate minimum of two (2) passes with "V" pattern, cover and compact with roller. Surface preparation to include ground limestone over topsoil surface area at the rate of 1/4 TON (50#/1000#) commercial fertilizer (5-0-0) at the rate of 3/4 TON (150#/1000#) and Super-phosphate at the rate of 600#/A (60#/1000#).

CERTIFICATION BY THE PROFESSIONAL ENGINEER:
 I, certify that the plan of development and the plan for control of silt and erosion meets the requirements, standards, and specifications of the Howard Soil Conservation District.
 Date: 9-13-71
 Signature: [Signature]
 Title: Professional Engineer

CERTIFICATION BY THE DEVELOPER:
 This development plan is approved for soil erosion and sediment control by the Howard Soil Conservation District.
 Date: 9-13-71
 Signature: [Signature]
 Title: Developer

APPROVAL SIGNATURE BLOCK FOR SITE DEVELOPMENT PLANS:
 APPROVED: [Signature] DATE: 9-15-71
 APPROVED: [Signature] DATE: 9/14/71
 APPROVED: [Signature] DATE: 9/13/71

APPROVED: HOWARD COUNTY OFFICE OF PLANNING & ZONING
 DATE: 9-15-71
 APPROVED: [Signature] DATE: 9/14/71
 APPROVED: [Signature] DATE: 9/13/71

APPROVED: [Signature] DATE: 9-13-71
 APPROVED: [Signature] DATE: 9-13-71

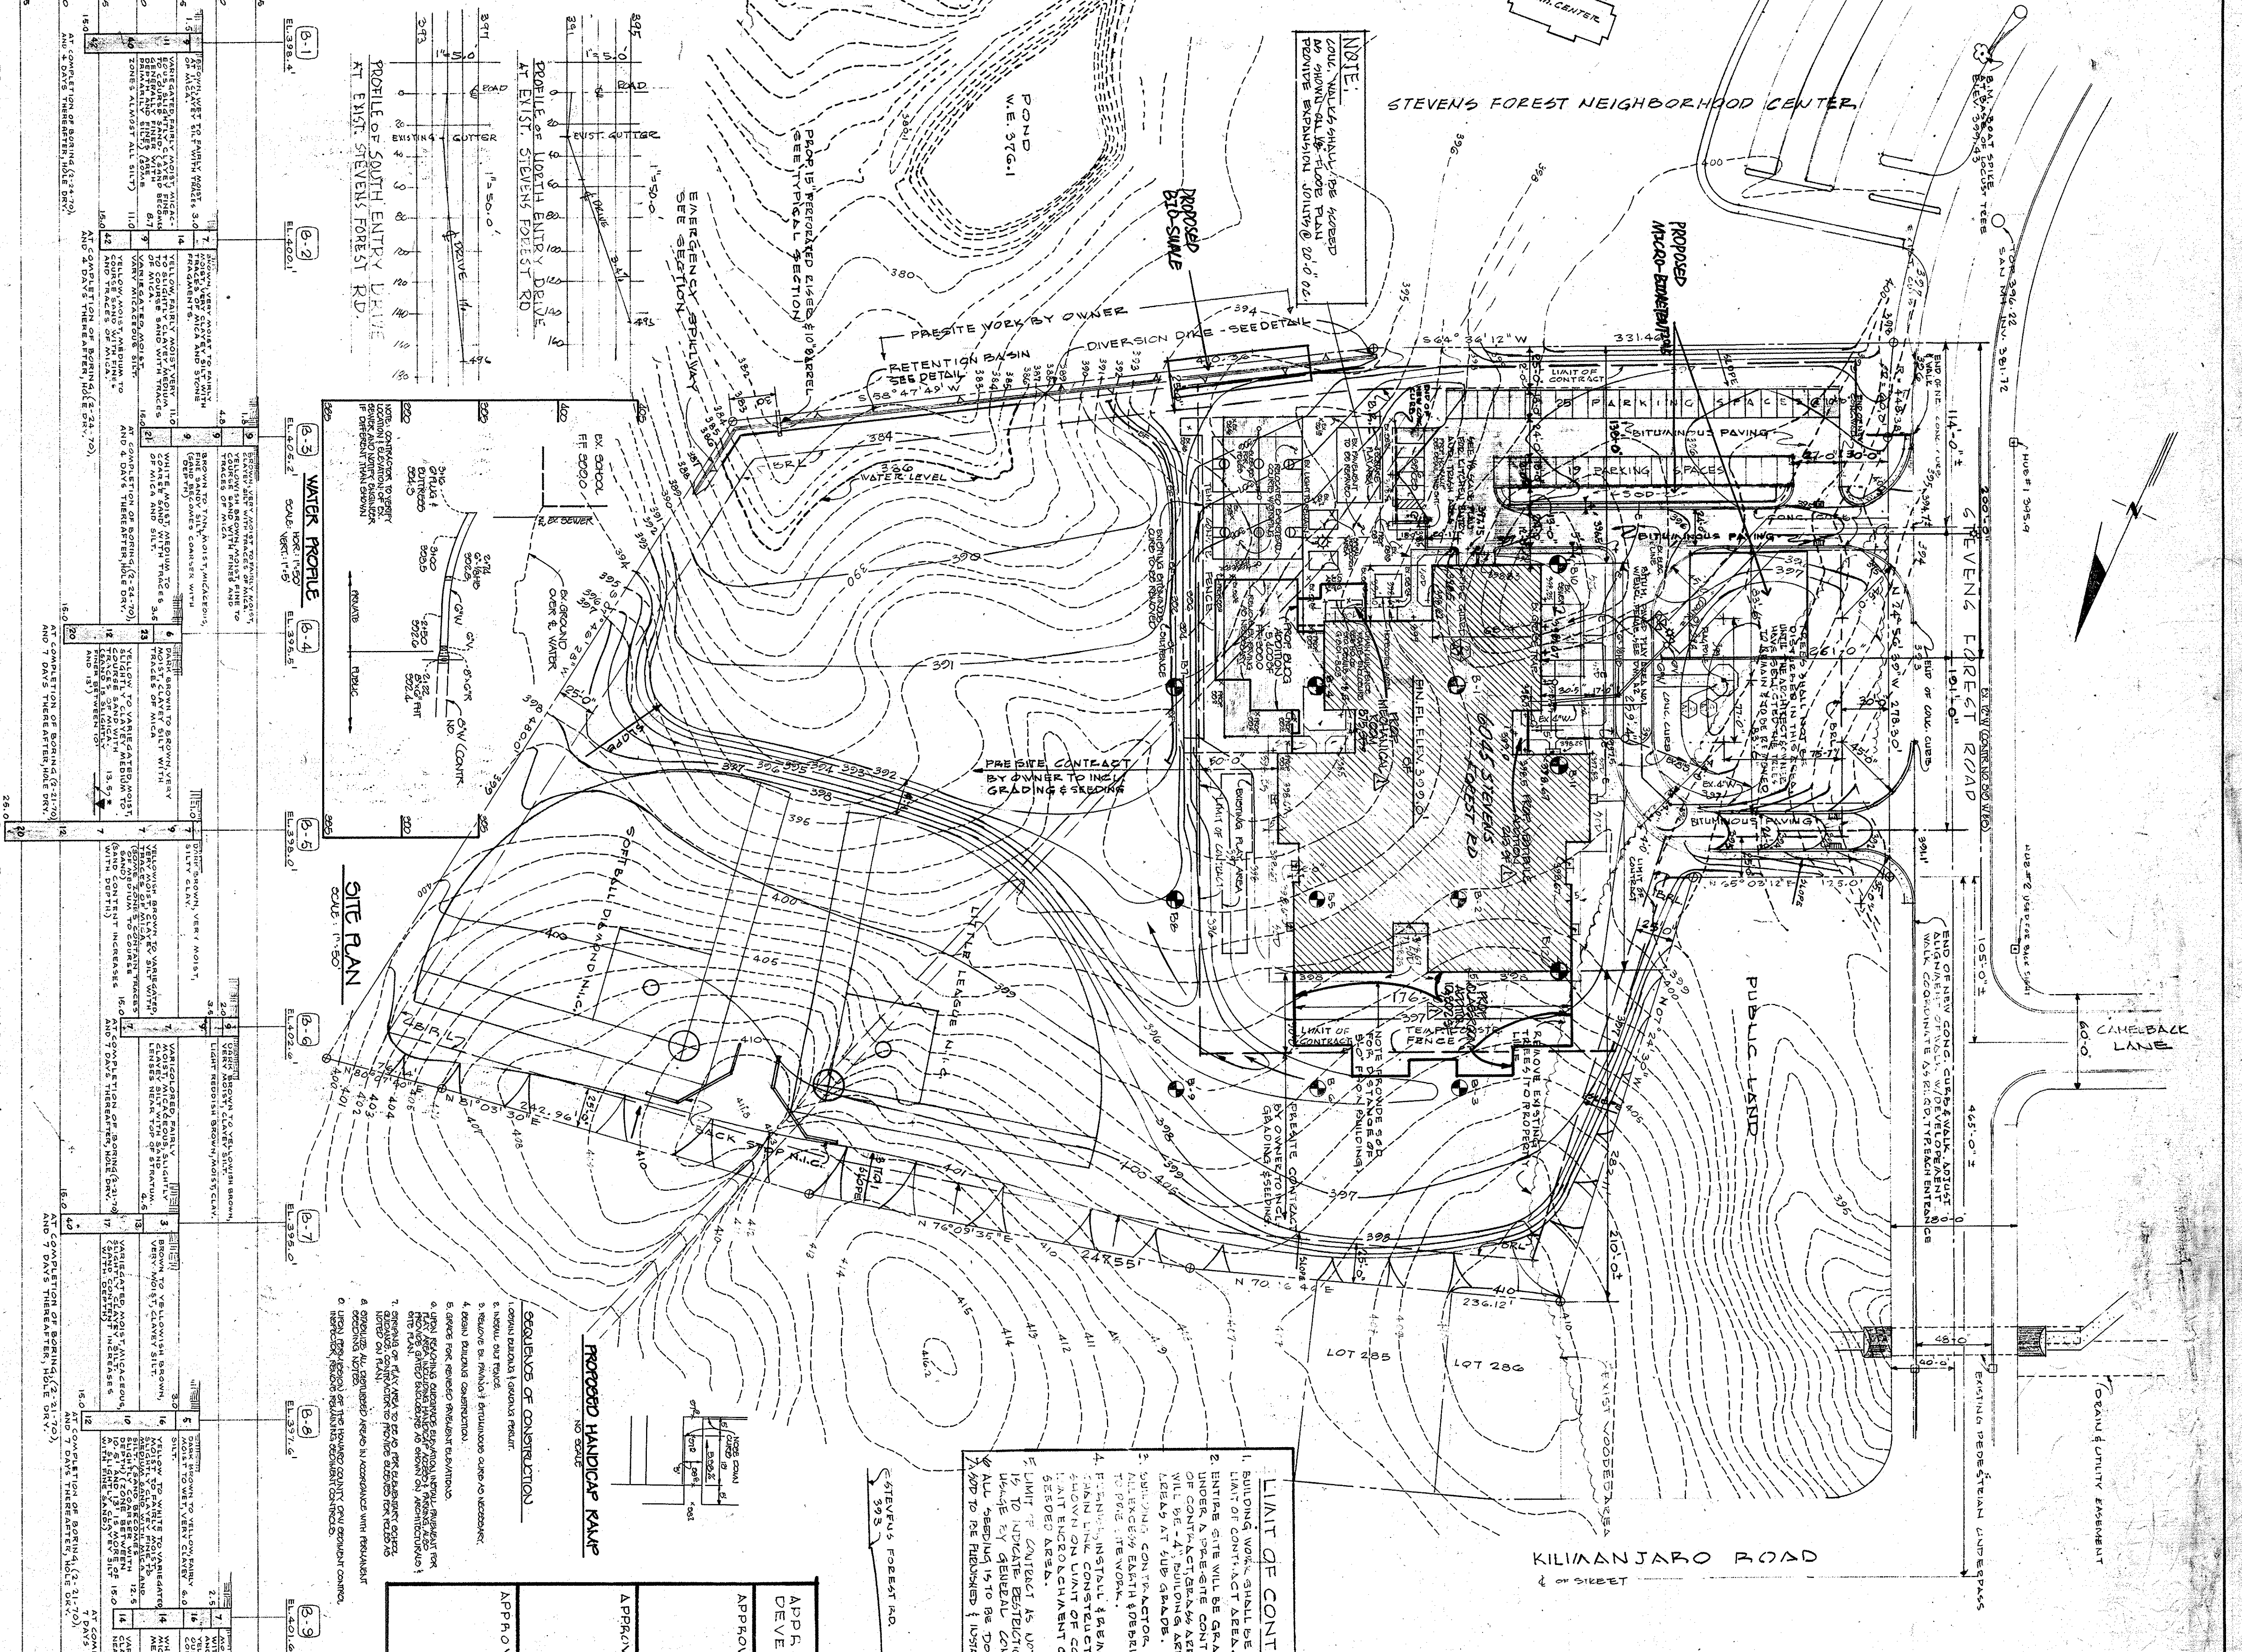


TABLE OF ELEVATIONS

POINT	ELEVATION
1	392.0
2	391.5
3	391.0
382	201.5


BMP MICRO-BIORETENTION PLANTING SCHEDULE			
PLANT NAME	FORM	QUANTITY	SYMBOL
SWITCH GRASS (<i>panicum virgatum</i>)	Grass	100 Qts ^a	
FOX SEDGE (<i>carex vulpinoidea</i>)	Grass	100 Qts ^a	
RED MAPLE (<i>acer rubrum</i>)	Tree (4-6', 1" cal.)	2	
BLACKGUM (<i>nyssa sylvatica</i>)	Tree (5-8', 1" cal.)	2	
RED OSIER DOGWOOD (<i>cornus sericea</i>)	Shrub	6	

^a Plant BMP level surface only (i.e., at elev. 395.5). Distribute evenly. Stabilize side slopes w/ permanent grass seed per NRCS specs.

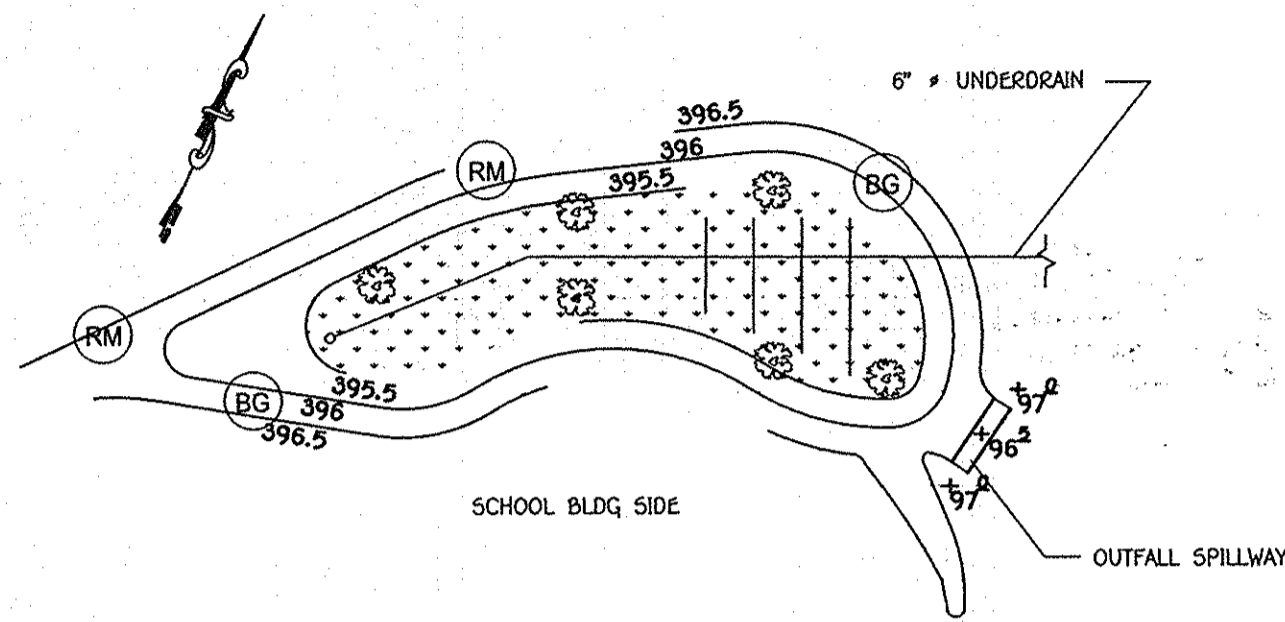

BMP PLANTING PLAN

SCALE:
HORIZ. 1" = 20'

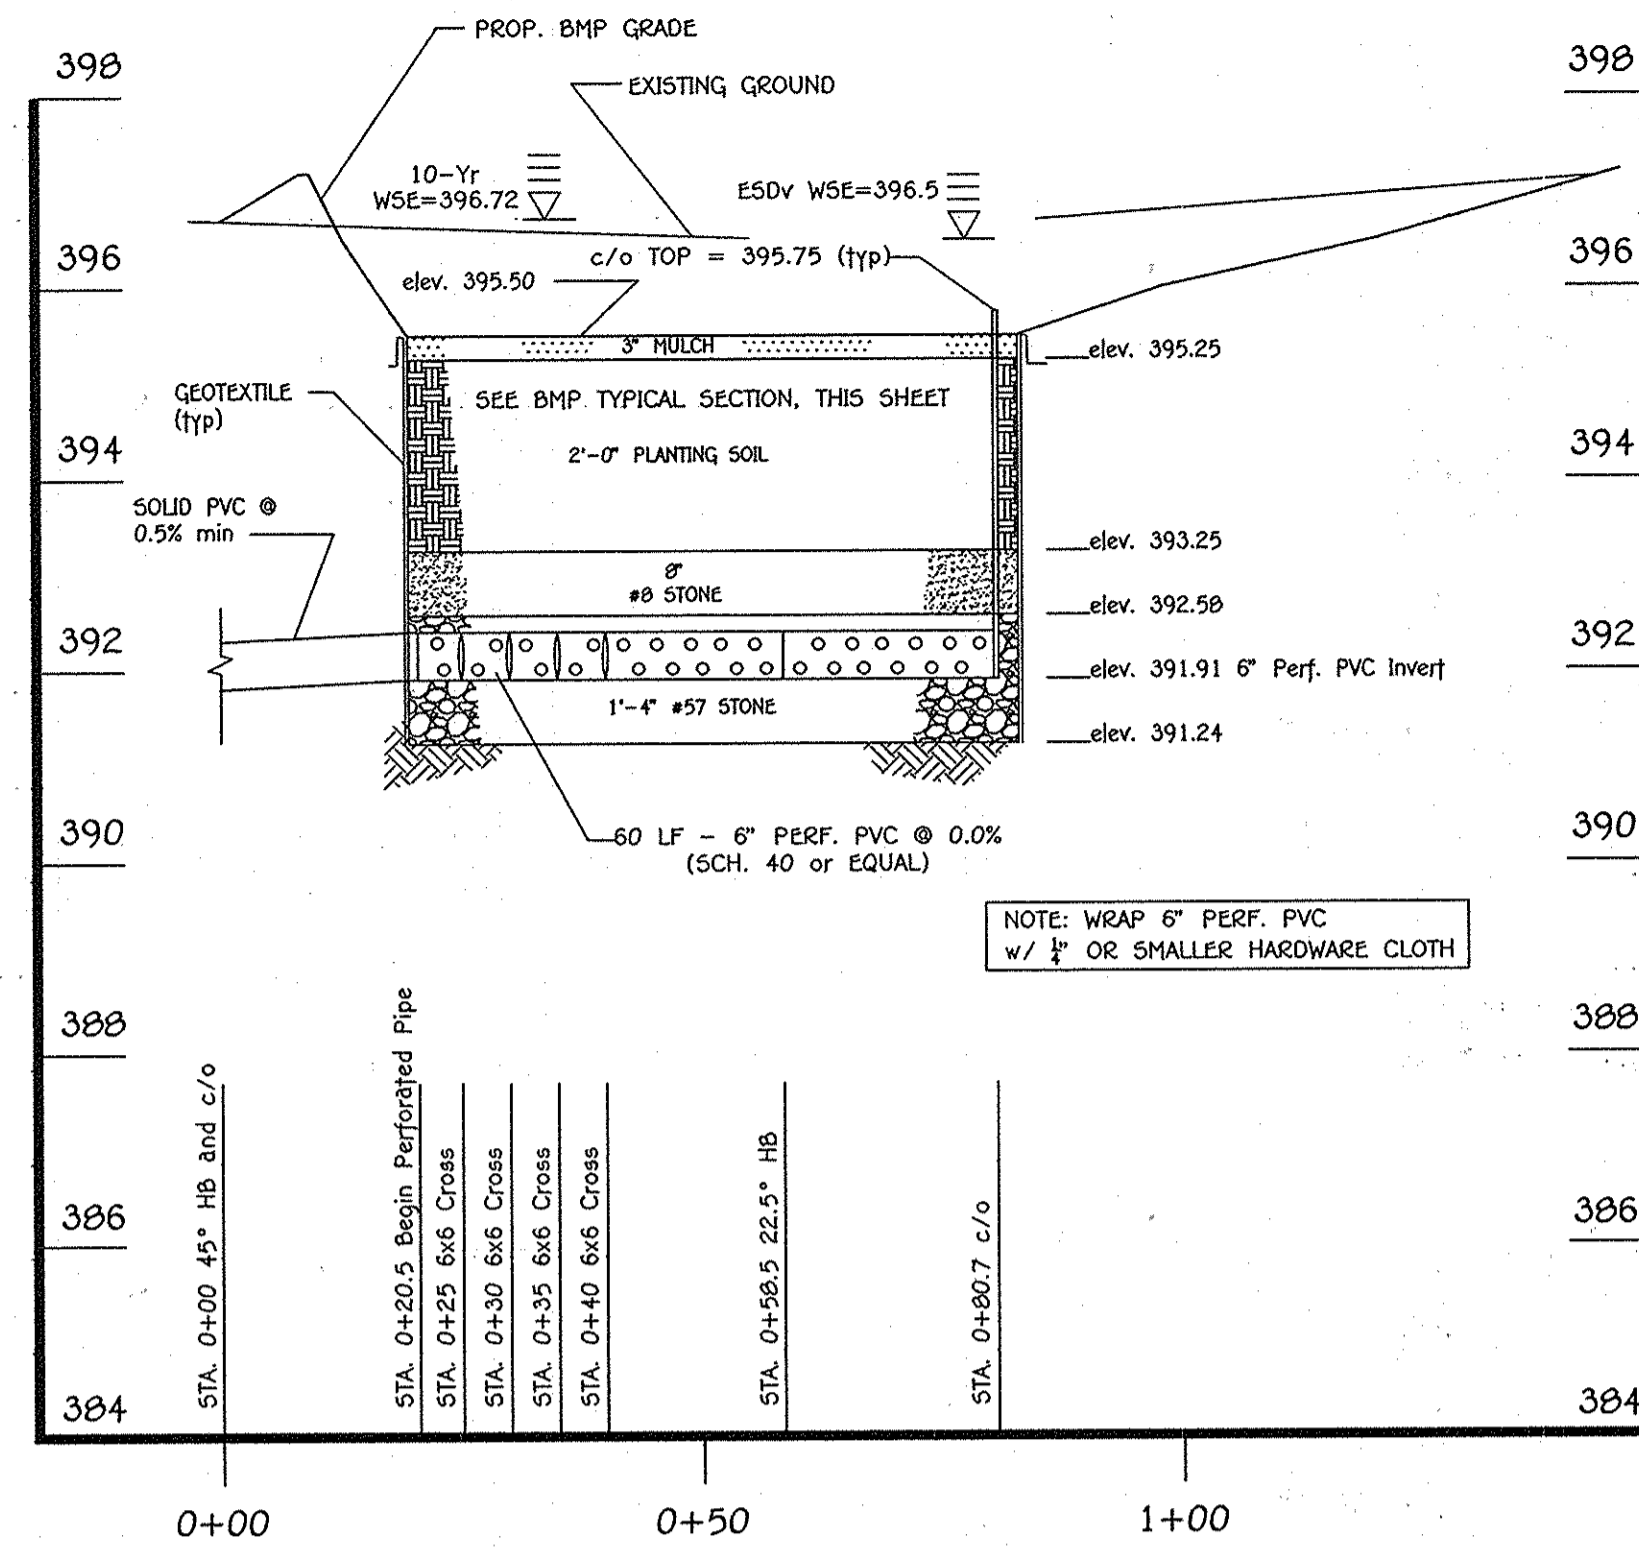

BMP UNDERDRAIN PROFILE

SCALE:
HORIZ. 1" = 20'
VERT. 1" = 2'


OPERATION AND MAINTENANCE SCHEDULE FOR BIO-RETENTION BMP (M-6)
THE MICRO-BIORETENTION FACILITY SHALL BE INSPECTED AT LEAST TWICE PER YEAR (ONCE EACH IN THE SPRING AND FALL) AND AFTER HEAVY STORMS. THE OWNER IS RESPONSIBLE FOR MAINTAINING A DETAILED LOG OF THE MAINTENANCE INSPECTION FINDINGS AND A HISTORY OF THE COMPLETED WORK. THE LOG SHALL BE MADE AVAILABLE TO HOWARD COUNTY DPZ AND/OR THE MARYLAND DEPARTMENT OF THE ENVIRONMENT UPON REQUEST.

MICRO-BIORETENTION FACILITY COMPONENTS TO BE INSPECTED AND MAINTAINED INCLUDE THE ITEMS AS FOLLOWS:

1. PLANT MATERIAL: PLANTS SHALL BE CHECKED FOR DISEASE AND INSECT INFESTATION. REMOVE AND REPLACE DEAD OR DYING VEGETATION CONSIDERED BEYOND TREATMENT (SEE NOTE #1 BELOW). MAINTENANCE INCLUDES PRUNING, AND REPLACEMENT OF DEFICIENT STAKES AND WIRE.
 2. MULCH LAYER: SHALL BE REPLACED ONCE EVERY SPRING DUE TO THE HEAVY METALS GENERATED FROM THE PARKING LOT. THE OWNER SHALL PROPERLY DISPOSE OF THE OLD MULCH SO AS NOT TO CAUSE STORMWATER CONTAMINATION ELSEWHERE. WASHED OUT AREAS SHALL BE REPAIRED AS NECESSARY.
 3. SOIL LAYER: SHOULD STORMWATER POND FOR MORE THE 48 HOURS, THE TOP 6 INCHES (MINIMUM) OF THE SOIL LAYER SHALL BE REPLACED. THE OLD SOILS SHALL BE PROPERLY DISPOSED.
 4. SPILLWAY OUTFALL INTERIOR SLOPES: ERODED AREAS SHALL BE REPAIRED (FILLED IN AND SEEDED) AS NEEDED. BARE AREAS SHALL BE TREATED AND RE-SEEDED.
 5. INLET: REPAIR CRACKS, DAMAGED CONCRETE, ETC. AS NECESSARY.
 6. REMOVE AND PROPERLY DISPOSE ACCUMULATED SEDIMENT GREATER THAN ONE (1) INCH.
- NOTES:
1. IF SPECIFIC PLANTS ARE NOT SURVIVING, THE PLANT TYPE SHALL BE CHANGED TO BETTER SUITED SPECIES.
 2. PLANT WATERING MAY BE NEEDED DURING PROLONGED DRY PERIODS.


GENERAL STORMWATER MANAGEMENT NOTES

1. STORMWATER MANAGEMENT HAS BEEN PROVIDED WITH A MICRO-BIORETENTION (M-6) FACILITY. PLEASE REFER TO THE SWM REPORT PREPARED BY FISHER, COLLINS, & CARTER, INC. DATED MARCH 4, 2011.
2. ALL CONSTRUCTION SHALL MEET THE LATEST EDITION OF THE HOWARD COUNTY STANDARDS AND SPECIFICATIONS, SMALL EARTHEN DAM SPECIFICATION MD-378, AND THE MARYLAND DEPARTMENT OF THE ENVIRONMENT'S CURRENT STORMWATER DESIGN MANUAL, OR AS SHOWN ON THESE PLANS. THE CONTRACTOR SHALL CONSULT THE ENGINEER SHOULD THERE BE ANY DISCREPANCIES.
3. THE UTILITY LOCATIONS ARE APPROXIMATE. CONTRACTOR SHALL TEST PIT ALL KNOWN EXISTING UTILITIES TO VERIFY, SIZE, SHAPE, LOCATION, AND TYPE PRIOR TO PERFORMING CONSTRUCTION. UTILITY RELOCATIONS, WHETHER SHOWN OR NOT, ARE THE RESPONSIBILITY OF THE OWNER. ANY UTILITY DAMAGED DUE TO CONSTRUCTION MUST BE REPAIRED IMMEDIATELY.
4. SHOULD THE CONTRACTOR DISCOVER DISCREPANCIES BETWEEN THE PLANS AND FIELD CONDITIONS, THE ENGINEER IS TO BE NOTIFIED IMMEDIATELY TO RESOLVE THE SITUATION. IF THE CONTRACTOR MAKES FIELD CORRECTIONS OR ADJUSTMENTS WITHOUT NOTIFYING THE ENGINEER, THEN THE CONTRACTOR ASSUMES ALL RESPONSIBILITY FOR THOSE CHANGES.
5. CONTRACTOR SHALL NOTIFY MISS UTILITY 1-800-257-7777 AND THE HOWARD COUNTY DEPARTMENT OF INSPECTION LICENSES & PERMITS THREE (3) WORKING DAYS BEFORE BEGINNING CONSTRUCTION.
6. FISHER, COLLINS & CARTER, INC. IS NOT RESPONSIBLE FOR THE CONTRACTOR'S UTILIZATION OF MEN, MATERIALS, EQUIPMENT, OR SAFETY MEASURES IN THE PERFORMANCE OF ANY WORK FOR THIS PROJECT. THE CONTRACTOR ASSUMES ALL RESPONSIBILITY FOR PERFORMING THE WORK CORRECTLY AND IN CONFORMANCE WITH CODE/SPECIFICATION REQUIREMENTS.
7. THE BMP MAY BE GRADED, HOWEVER, THE PLANTING SOIL IN THE BMP SHALL NOT BE INSTALLED UNTIL ALL UPSTREAM AREAS HAVE BEEN STABILIZED (I.E., THICK GRASS COVER, OR PAVED).
8. THE STORMWATER MANAGEMENT MICRO-BIORETENTION BMP SHOWN ON THIS SHEET WILL BE PRIVATELY OWNED AND MAINTAINED.

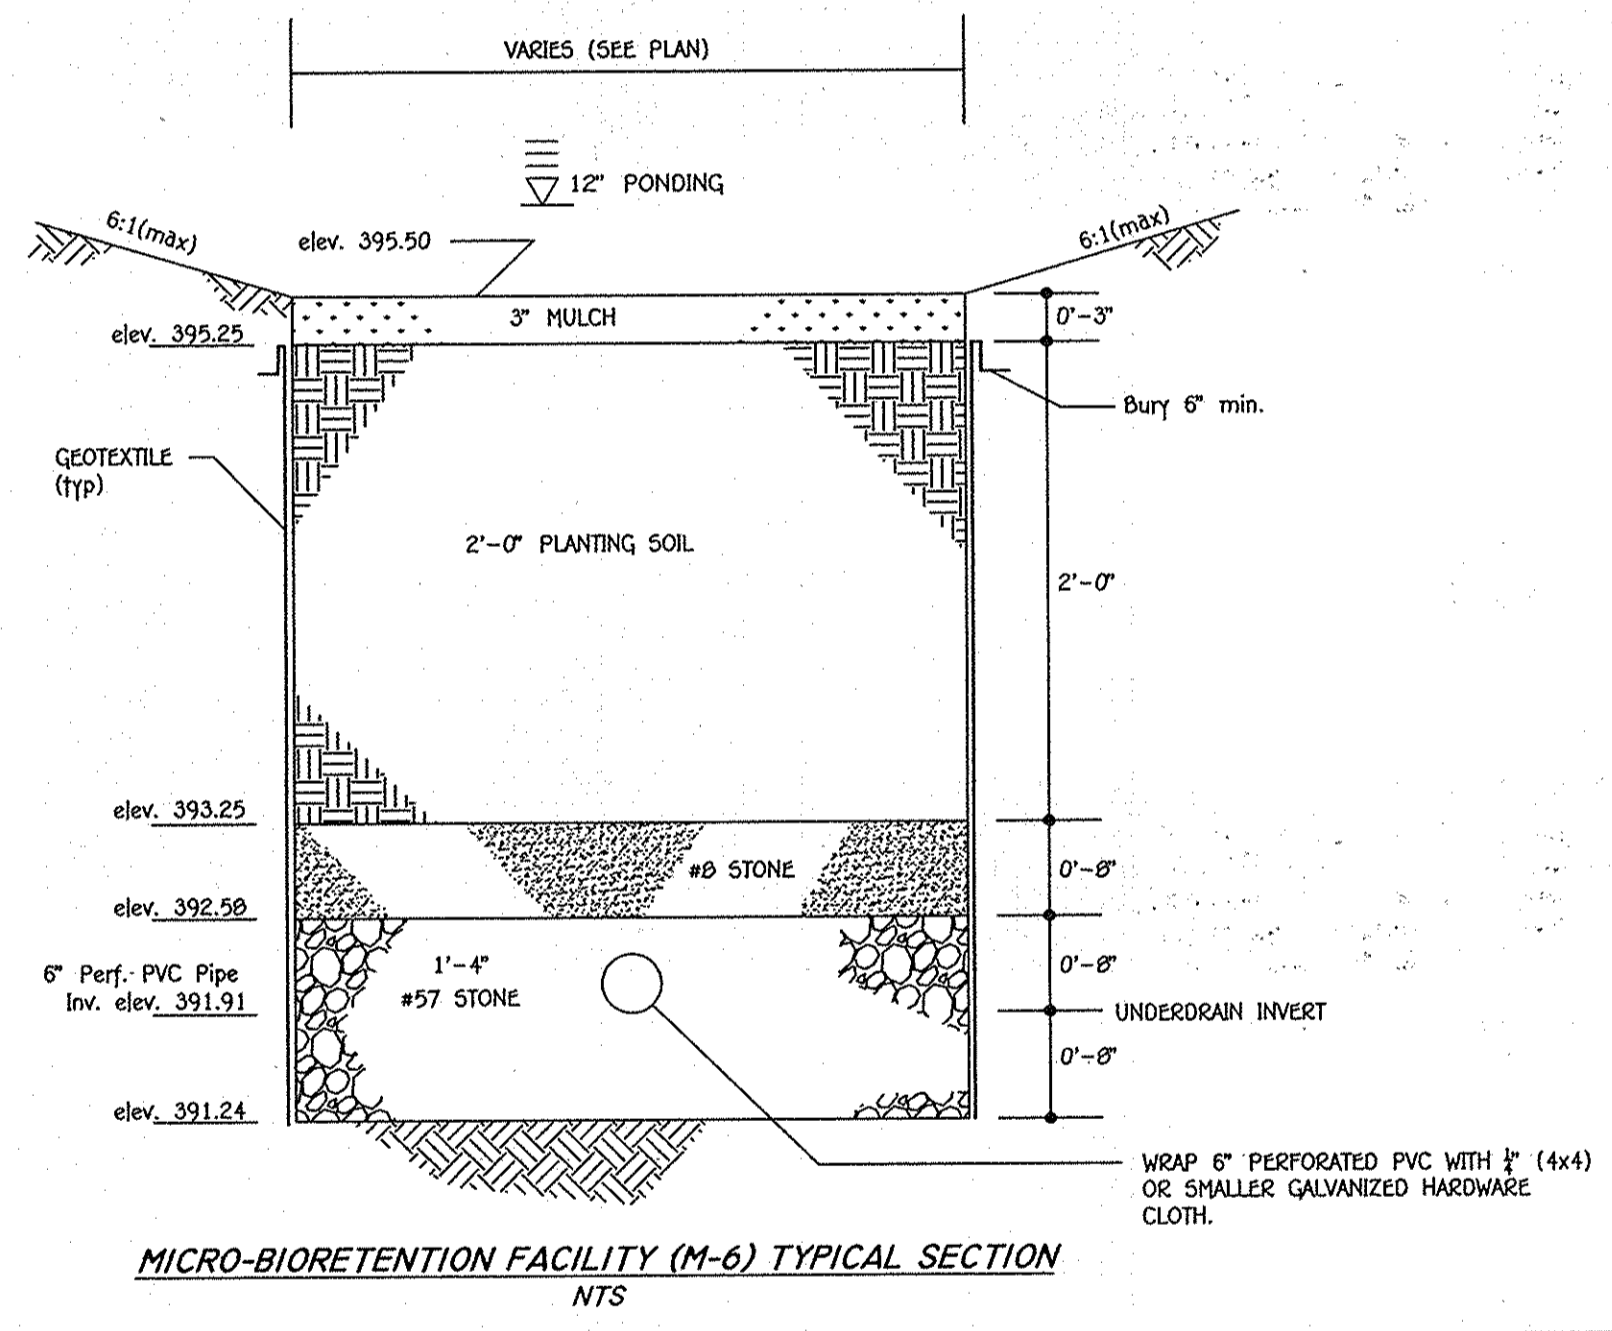


MICRO-BIORETENTION FACILITY (M-6) TYPICAL SECTION

NTS

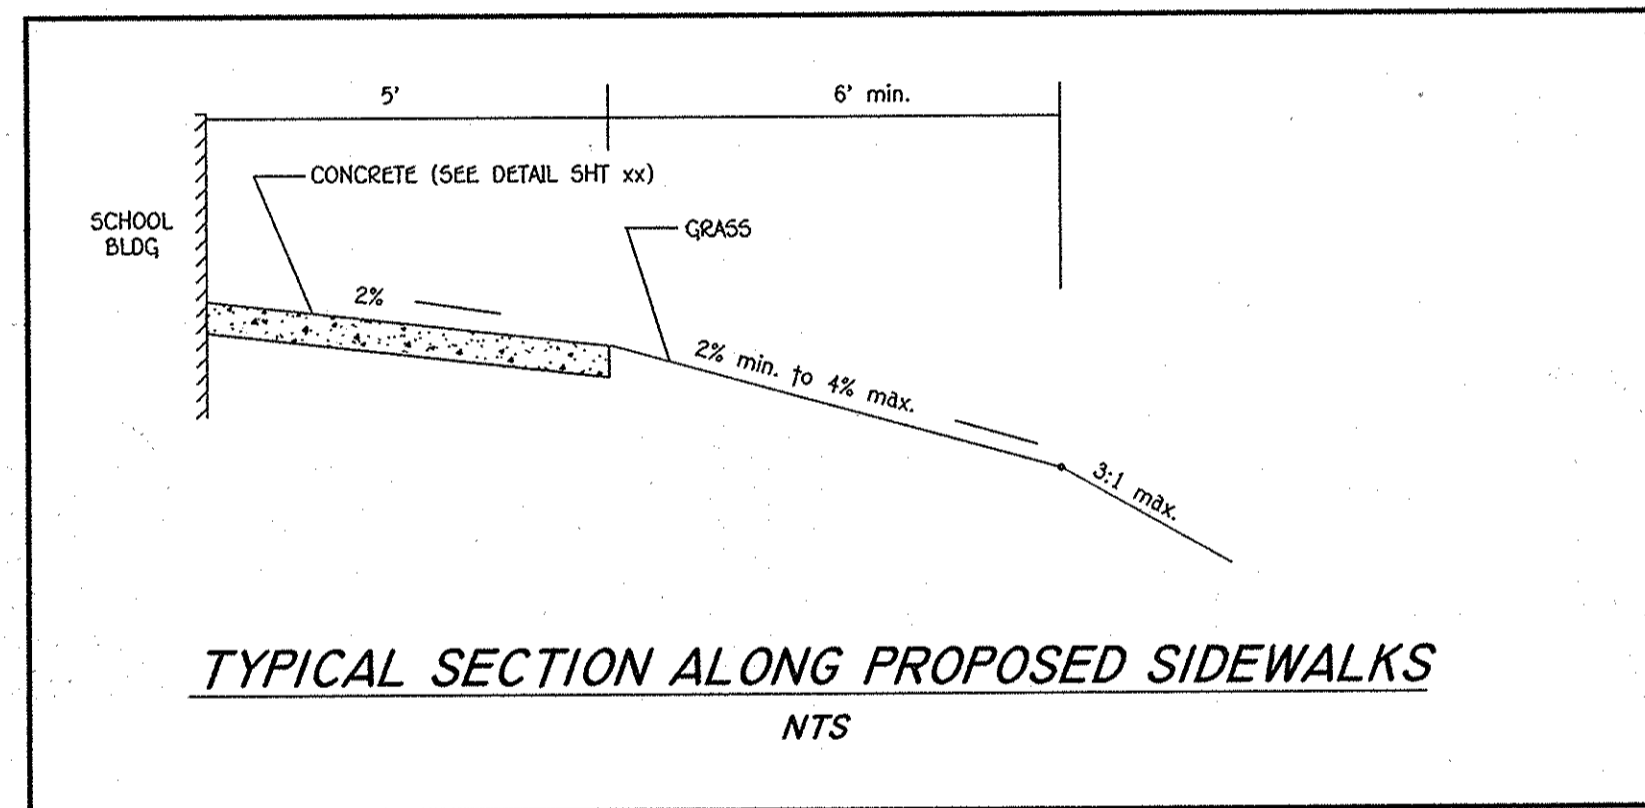

TYPICAL SECTION ALONG PROPOSED SIDEWALKS

NTS

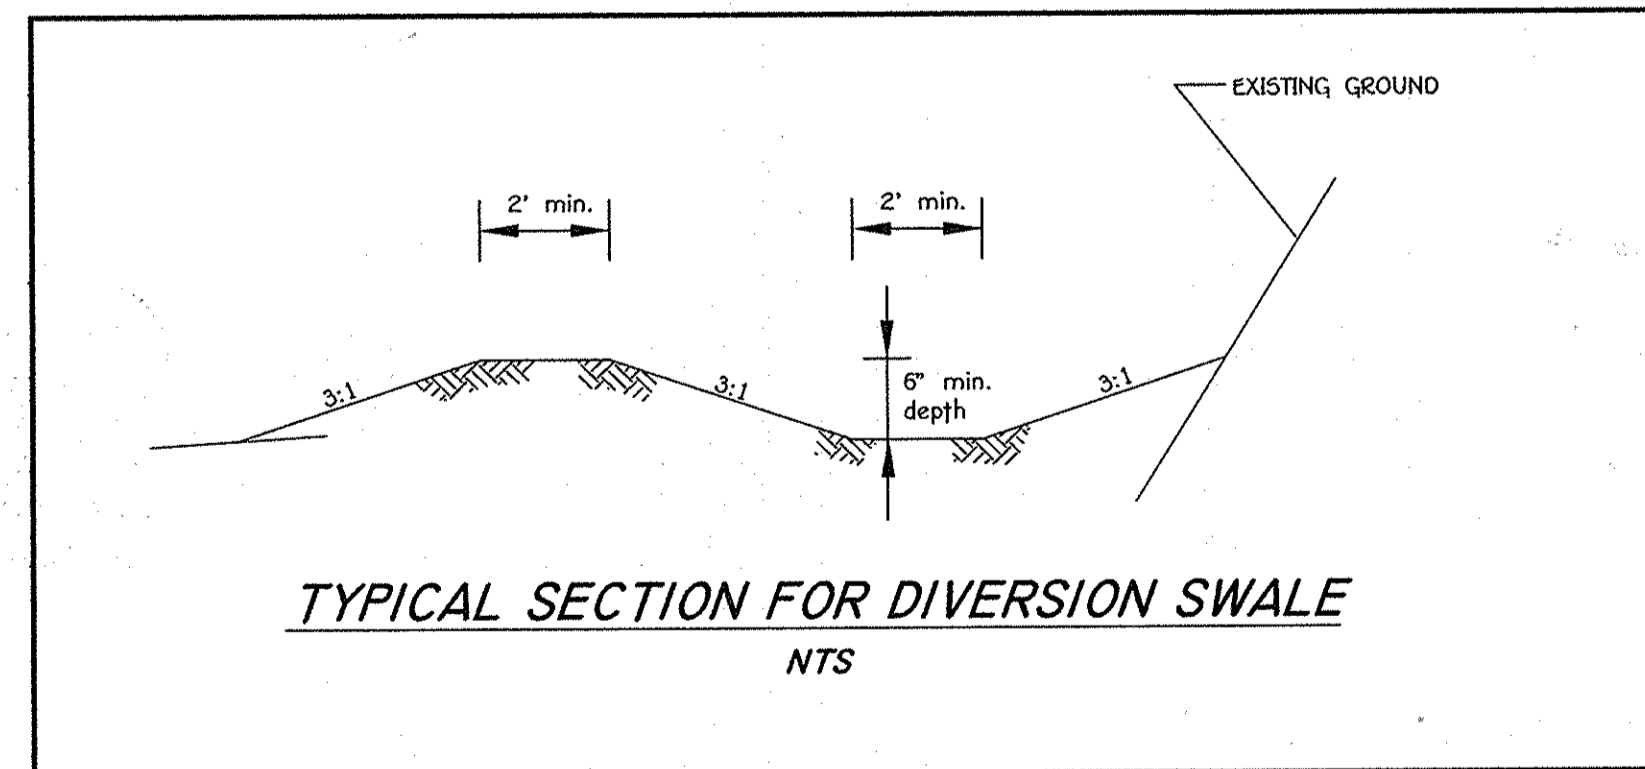

TYPICAL SECTION FOR DIVERSION SWALE

NTS

BIORETENTION BMP NOTES AND SPECIFICATIONS

1. REFER TO THE 2000 MARYLAND SWM DESIGN MANUAL FOR BIORETENTION SPECIFICATIONS (PG. B.3.7) NOT LISTED HEREIN AND FOR ADDITIONAL INFORMATION.
2. THE BIORETENTION BMP MATERIALS ARE AS FOLLOWS:
- PLANTING SOIL: SHALL MEET PLANTING SOIL SPECIFICATIONS OUTLINED IN MDE'S 2000 SWM MANUAL. SEE PLANTING SCHEDULE THIS SHEET FOR VEGETATION STABILIZATION. - SAND: ASTM C33 "CONCRETE SAND" VERY CLEAN; FREE OF ALL DIRT AND DEBRIS.
- PVC PIPE: SCHEDULE 40. PERFORATED PORTION TO BE HAVE NO SLOPE (0.0%).
- STONE AGGREGATE: MSHA SPECIFICATIONS AS SPECIFIED ON TYPICAL SECTION; AGGREGATE MUST BE FREE OF FINES, DIRT AND DEBRIS.
- GEOTEXTILE: PER MDE SWM MANUAL OR MIRAFT 140N.
- MULCH: SHREDDED, WELL-AGED (6-12 MONTHS) HARDWOOD MULCH; NO WOOD CHIPS OR PINE MULCH.
3. THE CONTRACTOR SHALL UNDER NO CIRCUMSTANCES ALLOW SURFACE DRAINAGE INTO THE MICRO-BIORETENTION BMPs UNTIL ALL UPSTREAM AREAS HAVE BEEN STABILIZED (I.E., PAVED OR HAVE WELL-ESTABLISHED VEGETATION).
4. BOARDS SHALL NOT BE LEFT IN PLACE DURING THE CONSTRUCTION OF THE BIORETENTION BMP.
5. GEOTEXTILE (FILTER FABRIC) SHALL BE PLACED AGAINST EXCAVATED SURFACES. SCARIFY EARTH PRIOR TO GEOTEXTILE PLACEMENT. INSTALL GEOTEXTILE PER MANUFACTURER'S SPECIFICATIONS/RECOMMENDATIONS AND USE A 2 FT MINIMUM OVERLAP AND NOTCH ENDS WITH A 6" MINIMUM BURY OR EQUIVALENT ANCHORING METHOD.
6. THE CONTRACTOR SHALL OBTAIN INDEPENDENT CERTIFICATION THAT THE SOILS AND OTHER MATERIALS MEET THE SPECIFICATIONS DURING THE AS-BUILT STAGE.
7. THE BIORETENTION FACILITIES SHALL BE VEGETATED (TOP LEVEL SURFACE ONLY) IN ACCORDANCE WITH THE PLANTING SCHEDULE.
8. USE PERFORATED PVC PIPE UNDER THE BMP AND USE SOLID PVC PIPE (SCHEDULE 40) OUTSIDE OF THE BMP (IN NATURAL SOIL) TO OUTLET/DAYLIGHT. BEGIN PERFORATED PVC PIPE 1' INSIDE BMP AGGREGATE. WRAP PVC PIPE WITH HARDWARE CLOTH TO PREVENT AGGREGATE FROM ENTERING THE PERFORATIONS.
9. INSTALL CLEANOUT (SOLID PVC PIPE) AS SHOWN. THE CLEANOUT TOP SHALL EXTEND 3" ABOVE TOP OF MULCH.
10. USE CURLEX MATTING/STAKES TO STABILIZE ALL DISTURBED AREAS BELOW THE MICRO-BIORETENTION (BMP) OUTFALL.
11. ROOF LEADER(S) SHALL DISCHARGE INTO THE BMP WITH A RIPRAP LEVEL SPREADER OR SMALL PLUNGE POOL. THIS IS NEEDED TO PRECLUDE MULCH DISTURBANCE DURING A STORM.
12. GRADE AREA SURROUNDING MICRO-BIORETENTION FACILITY SUCH THAT POSITIVE FLOW IS MAINTAINED INTO THE FACILITY.
13. REMOVE TOPSOIL WHEN PLACING FILL AROUND THE MICRO-BIORETENTION FACILITY. ALL SOIL WITHIN 5 FT OF THE 396.5 CONTOUR (I.E., TOP OF BMP (M-6)) SHALL MEET MD-378 FILL REQUIREMENTS FOR SOIL TYPES (GC, SC, CH, CL) AND 95% COMPACTION.

NOTE: THE HOWARD COUNTY PLANNING BOARD ON JUNE 16, 2011 APPROVED THE REQUEST FOR A RED-LINE REVISION OF THE SITE DEVELOPMENT PLAN TO CONSTRUCT THREE ADDITIONS TO THE EXISTING STEVENS FOREST ELEMENTARY SCHOOL. THE THREE ADDITIONS RESULTED IN LOT COVERAGE OF 13% EXCEEDING THE MAXIMUM COVERAGE OF 10% ALLOWED BY THE APPLICABLE FINAL DEVELOPMENT PLAN.

NOTE: THE PURPOSE OF THIS PLAN IS TO SHOW DETAILS FOR SWM CONSTRUCTION.



PLANNING BOARD APPROVED BUILDING ADDITIONS (REVISION NO. 1) ON _____ (date) TO EXCEED 10% LOT COVERAGE.



PREPARED FOR HOWARD COUNTY PUBLIC SCHOOL SYSTEM 10910 Maryland Route 109 Ellicott City, Maryland 21042 Attention Bruce Gist 410-313-6605	
Parcel Number	Street Address
P. 324	6045 STEVENS FOREST ROAD COLUMBIA, MD. 21045
PROJECT	SECTION/AREA
VONI/STEVENS FOREST ELEM. SCHOOL	5 / 5
LOT/PARCEL	LOT 1
PLAT REF.	BLOCK NO.
P.B.18, F.72	9
ZONE	TAX MAP
NT	36
ELEC. DIST.	CENSUS TR.
SIXTH	6066.03
WATER CODE	SEWER CODE
E09	5631200

APPROVED: DEPARTMENT OF PLANNING AND ZONING Director - Department of Planning and Zoning Chief, Development Engineering Division	
DATE	REVISION BLOCK
3-15-11	BLOG. ADDITIONS AS APP'D. BY PB AND ADD NEW SHEETS 2 TO 6.

PREPARED FOR HOWARD COUNTY PUBLIC SCHOOL SYSTEM 10910 Maryland Route 109 Ellicott City, Maryland 21042 Attention Bruce Gist 410-313-6605 PENZA+BAILEY ARCHITECTS 401 WOODBOURNE AVENUE BALTIMORE, MARYLAND 21212 TEL 410.435.6677/FAX 410.435.6868 www.PenzaBailey.com	
--	--

MICRO-BIORETENTION (M-6) FACILITY NOTES & DETAILS "REVISED SITE DEVELOPMENT PLAN" STEVENS FOREST ELEMENTARY SCHOOL CLASSROOM ADDITIONS AND IMPROVEMENTS VILLAGE OF OAKLAND MILLS, SECTION 5, AREA 5, LOT 1 PARCEL No.: 324 TAX MAP No.: 36 GRID No.: 9 SIXTH ELECTION DISTRICT HOWARD COUNTY, MARYLAND SCALE: AS SHOWN DATE: APRIL 26, 2011 SHEET 5 OF 14	
--	--

SDP 71-020C

