

IF ANY CHANGES ARE MADE TO THIS PLAN, THE ARCHITECT SHALL BE FULLY RESPONSIBLE FOR THE ACCURACY OF THE PLAN. THE ARCHITECT SHALL BE RESPONSIBLE FOR THE ACCURACY OF THE PLAN. THE ARCHITECT SHALL BE RESPONSIBLE FOR THE ACCURACY OF THE PLAN.

REVISION AND DISTRIBUTION RECORD			
NO.	DATE	PR.	DISTRIBUTION
1	10/10/68	RD	REVISE FOR CONSTRUCTION
2	03/1/69	MS	RELOCATED PERMANENT SIGNAGE & CONC.
3	2/19/69	MS	REVISE ROAD DIMENSIONS AT FUTURE WY
4	3/29/69	KM	MOVED PLUMBING SOUTH



SHEET INDEX	
1	SPP: SITE PLAN (ORIGINAL SHEET 1)
2	RSPP: SITE PLAN (REVISED SHEET 1)
3	RSPP: SPLASH PAD ENLARGEMENT
4	RSPP: EX. CONDITIONS & SEC. DETAILS
5	RSPP: SHAPE STRUCT. & CURB DETAILS

APPROVED
PLANNING BOARD
OF HOWARD COUNTY
DATE NOV 18 1970

CONCRETE
BY TUMBLIOUS
RAILROAD TIE
WOOD FENCE
CHAIN LINK FENCE

COLUMBIA
MARYLAND

THE ROUSE COMPANY
THE VILLAGE OF CROSS KEYS, BALTIMORE, MD. 21210

PROJECT TITLE
RUNNING BROOK NEIGHBORHOOD CENTER
5TH ELECTION DISTRICT OF HOWARD COUNTY

SUBJECT: **SITE PLAN**

SCALE: 1" = 20'

DATE: 1/25/68

DES. BY: [Signature]

DWN. BY: [Signature]

CK. BY: [Signature]

APP. BY: [Signature]

ARCHITECT 19026

RB11

DWG. 1 OF X5
REVISED NOVEMBER 1970
SHOWING NEW ADDITION

S.D.P. 71-033

REVISION AND DISTRIBUTION RECORD			
NO.	DATE	PR.	DESCRIPTION
1	01/06/82	RC	REVISE FOR CONSTRUCTION
2	10/21/83	MC	RELOCATED EXISTING SHEDS & RCAD
3	1-00	RC	REVISED POOL & DELETED DIMENSIONS AT FILTER TANK
4	5/29/29	RM	MOVED PHONE B. WITH
5	3-1-19	FSH	Replaced wading pool with splash pad. Added two shade structures.



E. J. J. J.
2/6/2019 FOR REV.#5 ONLY

APPROVED: HOWARD COUNTY DEPARTMENT OF PLANNING AND ZONING

[Signature] 3-28-19
CHIEF, DEVELOPMENT ENGINEERING DIVISION DATE

[Signature] 4-01-19
CHIEF, DIVISION OF LAND DEVELOPMENT DATE

[Signature] 4-2-19
DIRECTOR DATE

GENERAL NOTES:
For SDP General Notes, see sheet 5 of 5.

PURPOSE NOTE:
The purpose of this SDP redline revision is to depict the replacement of the wading pool with a splash pad and shade structure, to depict the removal of an ex. shade structure, and replacement with a new shade structure.

ADDITIONAL SHEETS NOTE:
The sheets added to this redline do not replace the original sheets 2-4, but they were added due to the sheets not being available.

APPROVED
PLANNING BOARD
OF HOWARD COUNTY
DATE NOV 18 1970

ADDRESS CHART	
LOT/PARCEL	STREET
79	5730 Columbia Road

PERMIT INFORMATION CHART						
Name:	Section/Area	Lot/Parcel No.				
Running Brook Neighborhood Center	Section 9 Area 5	Lot 79 Parcel 117				
Plot # 13/82	Deed Ref. L.3324 F.191	Grid. 6-44 14	Zoning NT	Tax Map No. 30	Elect. District 5TH	Census Tract 605401

2 of 5
DWG. 1 of 4
REVISED NOVEMBER 1970
SHOWING NEW ADDITION

CONCRETE BY TURNING OF CHAIN LEAD TO WOOD FENCE & 2" W/ LINK FENCE

COLUMBIA
MARYLAND

THE ROUSE COMPANY
THE VILLAGE OF CROSS KEYS, BALTIMORE, MD 21290


PROJECT TITLE
RUNNING BROOK NEIGHBORHOOD CENTER
5TH ELECTION DISTRICT OF HOWARD COUNTY

SUBJECT: **SITE PLAN**

SCALE 1" = 20'
DATE 4/25/19
DES. BY C. H. HANBY
DWN. BY C. H. HANBY
CK. BY B. E. HANBY
APP. BY

RBI

ARCHITECT 1902B

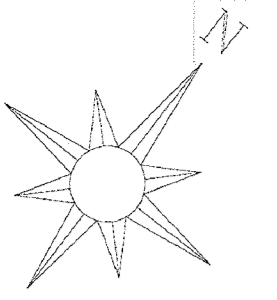

LEGEND

- Rectangular Drain Grate
- Circular Drain Grate
- ▨ Proposed Shade Structure

10' wide temporary construction access road ±186' long

(2) 1,500 Gallon plastic water storage tank (Underground) with manhole access

parking lot to remain usable for daycare facility while construction is underway.

Splash Pad to replace existing in-ground wading pool.

Existing concrete pool is 695 F² of water area inside of 2392 F² of concrete patio.

ADA accessible grades for all new areas within the splash pad.

10' Proposed replacement splash pad has no standing water inside of 2051 F² of concrete patio (impervious reduced). Pre-formed splash pad (Water Journeys) manufactured by Vortex Aquatics is to be installed on frost depth footers (18"Ø).


Surrounding patios and site formed splash pads are to be "floating" with no footer.

Proposed concrete curb along the side of the pad against the hill, typical 6" tall 6" wide (see detail, sheet 4) above patio grade. This will form edge of the patio and hold back storm waters from coming downhill - area drains to be directed to existing concrete storm drain system. Area outside of curb to be planted with grass or sod.

An existing wood framed, trellis type shade structure with benches exists. - to be razed.

A tensile sail / metal post shade structure is to be erected over the new splash pad. The metal poles (9-12' tall) will be anchored in concrete footers (frost depth) 5 posts and 3 fabric sails to be installed. (See detail, sheet 4)

There will be a pair of plastic underground water storage tanks with manhole access. One tank will be for the collection, filtration, sanitization and re-circulation of the splash pad water, the other tank will be to hold filter backwash discharge and allow a slow connection to sanitary drainage.

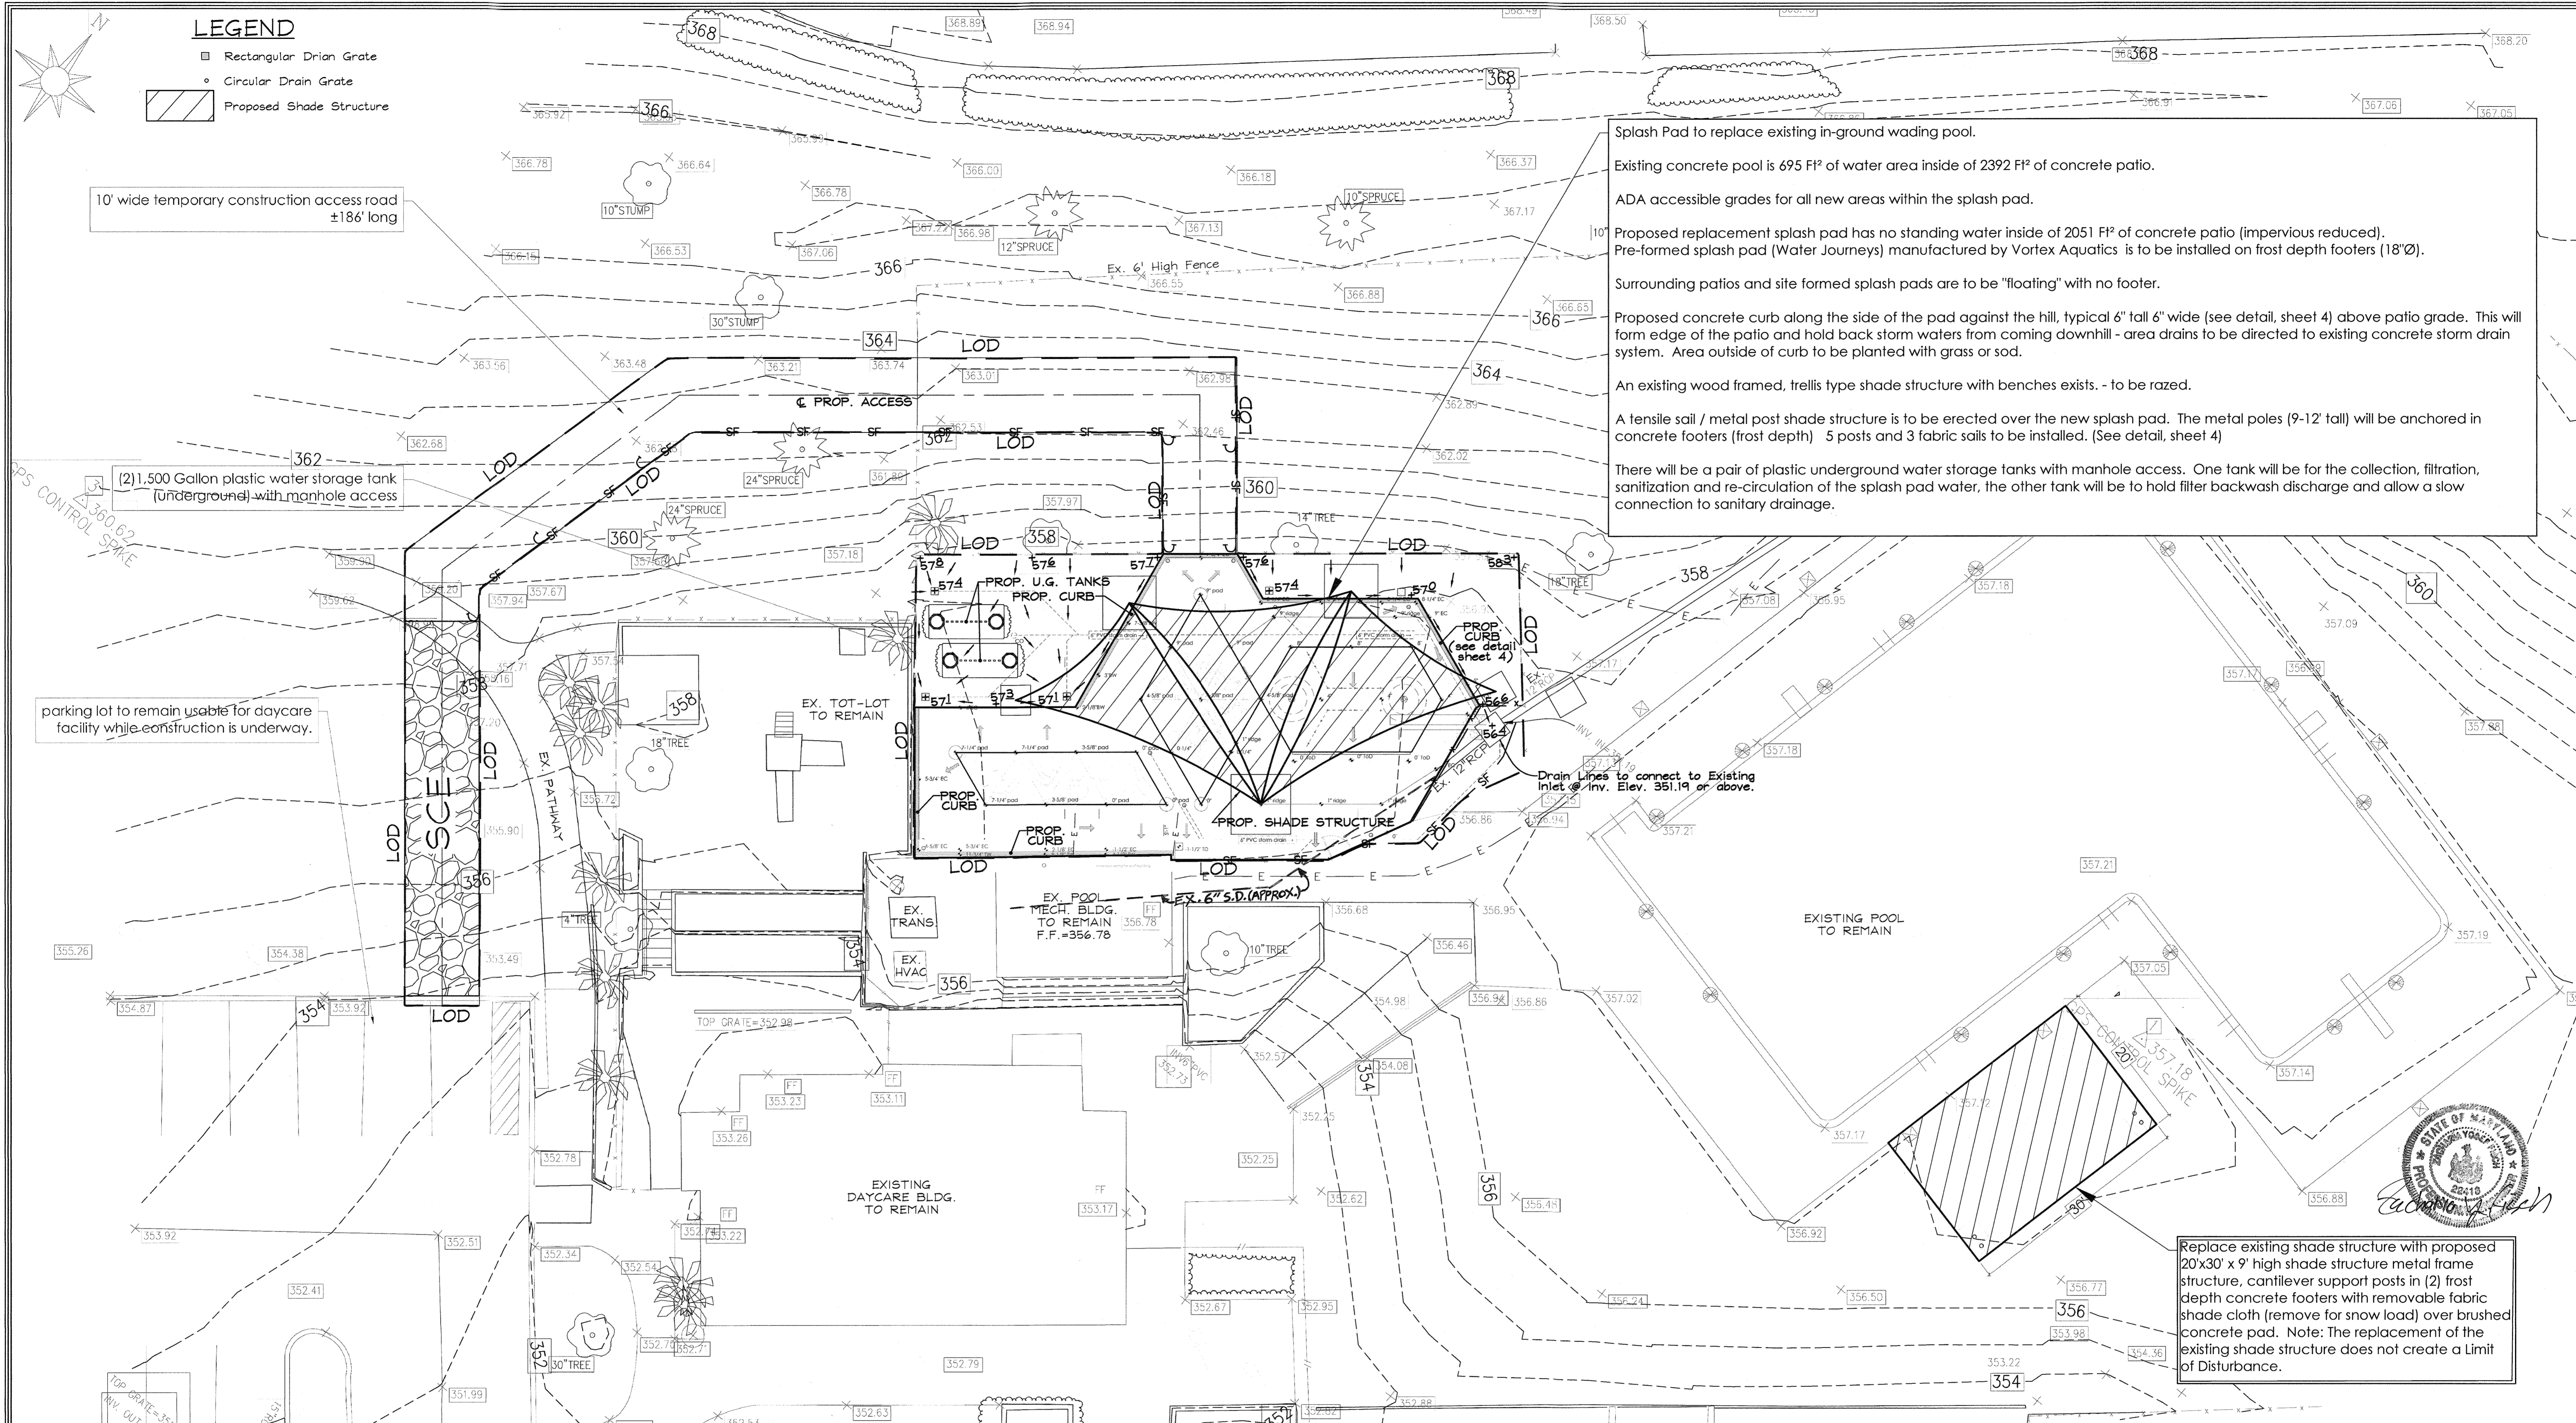

Drain Lines to connect to Existing Inlet @ Inv. Elev. 351.19 or above.

Replace existing shade structure with proposed 20'x30' x 9' high shade structure metal frame structure, cantilever support posts in (2) frost depth concrete footers with removable fabric shade cloth (remove for snow load) over brushed concrete pad. Note: The replacement of the existing shade structure does not create a Limit of Disturbance.

PLANNING BOARD REVIEW:
This addition was not reviewed by the Planning Board because it is a minor structure, under Section 125.0.G.3.b.

LIMITS OF DISTURBANCE:
The limits of disturbance area is 4,999 square feet, and is exempt from Storm-water management requirements. Any future disturbance where the total exceeds 5,000 s.f., SWM will need to be addressed.

OWNER
COLUMBIA ASSOCIATION, INC.
6310 HILLSIDE COURT
SUITE 100
COLUMBIA, MARYLAND 21046

PURPOSE NOTE:
The purpose of this SDP redline revision is to depict the replacement of the wading pool with a splash pad and shade structure, and to depict the removal of an ex. shade structure, and replacement with a new shade structure.

PROFESSIONAL CERTIFICATION
I hereby certify that these documents were prepared or approved by me, and that I am a duly licensed professional engineer under the laws of the State of Maryland, License No. #22418, Expiration Date: 07/29/2019.

REVISED SITE DEVELOPMENT PLAN
SPLASH PAD ENLARGEMENT
RUNNING BROOK
NEIGHBORHOOD CENTER
COLUMBIA, MARYLAND
TAX MAP 30 GRID 14
5TH ELECTION DISTRICT
PARCEL 117
HOWARD COUNTY, MARYLAND

APPROVED: HOWARD COUNTY DEPARTMENT OF PLANNING AND ZONING
Howard
CHIEF, DEVELOPMENT ENGINEERING DIVISION
DATE: 3-28-19
Kathleen
CHIEF, DIVISION OF LAND DEVELOPMENT
DATE: 4-2-19
Walter
DIRECTOR
DATE: 4-2-19

ENGINEERS CERTIFICATE
"I CERTIFY THAT THIS PLAN FOR SEDIMENT AND EROSION CONTROL REPRESENTS A PRACTICAL AND WORKABLE PLAN BASED ON MY PERSONAL KNOWLEDGE OF THE SITE CONDITIONS AND THAT IT WAS PREPARED IN ACCORDANCE WITH THE REQUIREMENTS OF THE HOWARD SOIL CONSERVATION DISTRICT."
Zacharia Y. Fisch
SIGNATURE OF ENGINEER
ZACHARIA Y. FISCH, P.E.
DATE: 3/4/2019

DEVELOPER'S CERTIFICATE
"I/WE CERTIFY THAT ALL DEVELOPMENT AND CONSTRUCTION WILL BE DONE ACCORDING TO THIS PLAN FOR SEDIMENT AND EROSION CONTROL, AND THAT ALL RESPONSIBLE PERSONNEL INVOLVED IN THE CONSTRUCTION PROJECT WILL HAVE A CERTIFICATE OF ATTENDANCE AT A DEPARTMENT OF THE ENVIRONMENT APPROVED TRAINING PROGRAM FOR THE CONTROL OF SEDIMENT AND EROSION BEFORE BEGINNING THE PROJECT. I ALSO AUTHORIZE PERIODIC ON-SITE INSPECTION BY THE HOWARD SOIL CONSERVATION DISTRICT."
John P. Robertson
SIGNATURE OF DEVELOPER
DATE: 3-1-2019

HOWARD SOIL CONSERVATION DISTRICT
THIS DEVELOPMENT PLAN IS APPROVED FOR SOIL EROSION AND SEDIMENT CONTROL BY THE HOWARD SOIL CONSERVATION DISTRICT
John P. Robertson
HOWARD SCD
DATE: 3/4/19

FSH Associates
Engineers Planners Surveyors
6339 Howard Lane, Elkridge, MD 21075
Tel: 410-567-5200 Fax: 410-796-1562
E-mail: info@fshri.com
DESIGN BY: -
DRAWN BY: GRH2
CHECKED BY: ZYF
SCALE: 1" = 10'
DATE: Mar. 1, 2019
W.O. No.: 4065
SHEET No. 3 OF 5
(Additional Sheet)

B-3 STANDARDS AND SPECIFICATIONS

SOIL PREPARATION, TOPSOILING, AND SOIL AMENDMENTS
Definition
Purpose
Conditions Where Practice Applies

The process of preparing the soils to sustain adequate vegetative stabilization.
To provide a suitable soil medium for vegetative growth.

Criteria
Where vegetative stabilization is to be established.

A. Soil Preparation
1. Temporary Stabilization

- a. Seeded preparation consists of loosening soil to a depth of 3 to 5 inches by means of suitable agricultural or construction equipment...

- b. Apply fertilizer and lime as prescribed on the plans.

- 2. Permanent Stabilization

- a. A soil test is required for any earth disturbance of 5 acres or more.

- iv. Soil contains sufficient pore space to permit adequate root penetration.

- 3. Graded areas must be maintained in a true and even grade as specified on the approved plan...

- 4. Mix soil amendments into the top 3 to 5 inches of soil by disking or other suitable means.

- B. Topsoiling

- 1. Topsoil to be placed over prepared subsoil prior to establishment of permanent vegetation.

- 2. Topsoil salvaged from an existing site may be used provided it meets the standards as set forth in these specifications.

- 3. Topsoiling is limited to areas having 2:1 or flatter slopes where:

- a. The texture of the exposed subsoil/parent material is not adequate to produce vegetative growth.

- b. The soil material is so shallow that the rooting zone is not deep enough to support plants or furnish continuing supplies of moisture and plant nutrients.

- c. The original soil to be vegetated contains material toxic to plant growth.

- d. The soil is so acidic that treatment with limestone is not feasible.

- 4. Areas having slopes steeper than 2:1 require special consolidation and design.

- 5. Topsoil Specifications: Soil to be used as topsoil must meet the following criteria:

- a. Topsoil must be a loam, sandy loam, clay loam, silt loam, sandy clay loam, or loamy sand.

- b. Topsoil must be free of noxious plants or plant parts such as thistles, grasses, weeds, and other plants.

- c. Topsoil substitutes or amendments, as recommended by a qualified agronomist or soil scientist and approved by the appropriate approval authority, may be used in lieu of natural topsoil.

- 6. Topsoil Application

- a. Erosion and sediment control practices must be maintained when applying topsoil.

- b. Uniformly distribute topsoil in a 2 to 4 inch layer and lightly compact to a minimum thickness of 1/2 inch.

- c. Topsoil must not be placed if the operation or subsoil is in a frozen or muddy condition, when the subsoil is excessively wet or in a condition that may otherwise be detrimental to proper grading and seeded preparation.

- C. Soil Amendments (Fertilizer and Lime Specifications)

- 1. Soil tests must be performed to determine the exact rates and application rates for both lime and fertilizer on sites having disturbed areas of 5 acres or more.

- 2. Fertilizers must be uniform in composition, free flowing and suitable for accurate application by appropriate equipment.

- 3. Lime materials must be ground limestone (hydrated or burnt lime may be substituted except when hydroxylic) which contains at least 90 percent total oxidium (calcium oxide plus magnesium oxide).

- 4. Lime and fertilizer are to be evenly distributed and incorporated into the top 3 to 5 inches of soil by disking or other suitable means.

- 5. Where the subsoil is either highly acidic or composed of heavy clays, spread ground limestone at the rate of 4 to 8 tons/acre (200-400 pounds per 1,000 square feet) prior to the placement of topsoil.

Permanent Seeding Summary table with columns for Species, Application Rate, Seeding Dates, Seeding Depths, N, P2O5, K2O, and Lime Rate.

Temporary Seeding Summary table with columns for Species, Application Rate, Seeding Dates, Seeding Depths, N, P2O5, K2O, and Lime Rate.

Hardiness Zone (from Figure B.3) table with columns for No., Species, Application Rate, Seeding Dates, Seeding Depths, N, P2O5, K2O, and Lime Rate.

Annual Ryegrass table with columns for No., Species, Application Rate, Seeding Dates, Seeding Depths, N, P2O5, K2O, and Lime Rate.

Fescue Hybrid table with columns for No., Species, Application Rate, Seeding Dates, Seeding Depths, N, P2O5, K2O, and Lime Rate.

HOWARD SOIL CONSERVATION DISTRICT
THIS DEVELOPMENT PLAN IS APPROVED FOR SOIL EROSION AND SEDIMENT CONTROL BY THE HOWARD SOIL CONSERVATION DISTRICT

John R. Blanton, 3/4/19, HARD SCD, DATE

APPROVED: HOWARD COUNTY DEPARTMENT OF PLANNING AND ZONING

Chief, Development Engineering Division, 3-20-19, DATE

Chief, Division of Land Development, 4-01-19, DATE

Director, 4-2-19, DATE

B-4 STANDARDS AND SPECIFICATIONS

SEEDING AND MULCHING
Definition
Purpose
Conditions Where Practice Applies

The application of seed and mulch to establish vegetative cover.
To protect disturbed soils from erosion during and at the end of construction.

Criteria
To the surface of all perimeter controls, slopes, and any disturbed area not under active grading.

A. Seeding

- 1. Specifications

- a. All seed must meet the requirements of the Maryland State Seed Law.

- b. Mulch alone may be applied between the fall and spring seeding dates only if the ground is frozen.

- c. Inoculants: The inoculant for treating legume seed in the seed mixture must be a pure culture of nitrogen fixing bacteria prepared specifically for the species.

- d. Soil or seed must not be placed on soil which has been treated with soil sterilants or chemicals used for weed control until sufficient time has elapsed (14 days min) to permit dissipation of phytotoxic materials.

- 2. Application

- i. Incorporate seed into the subsoil at the rates prescribed on Temporary Seeding Table B.1.

- ii. Apply seed in two directions, perpendicular to each other.

- iii. Hydro-seeding: Apply seed uniformly with hydro-seeder (slurry includes seed and fertilizer).

- iv. If fertilizer is being applied at the time of seeding, the application rates should not exceed the following: Nitrogen, 200 pounds per acre; Phosphorus, 200 pounds per acre; Potassium, 200 pounds per acre.

- v. Mix seed and fertilizer on site and seed immediately and without interruption.

- vi. When hydro-seeding do not incorporate seed into the soil.

- B. Mulching

- 1. Mulch Materials (in order of preference)

- a. Straw consisting of thoroughly threshed wheat, rye, oat, or barley and reasonably bright in color.

- b. Wood Cellulose Fiber Mulch (WCFFM) consisting of specially prepared wood cellulose processed into a uniform fibrous physical state.

- c. WCFFM is to be dyed green or contain a green dye in the package that will provide an appropriate color to facilitate visual inspection of the uniformly spread slurry.

- d. WCFFM including dye, must contain no germination or growth inhibiting factors.

- e. WCFFM materials are to be manufactured and processed in such a manner that the wood cellulose fiber mulch will remain in uniform suspension in water under agitation and will blend with seed, fertilizer and other additives to form a homogeneous slurry.

- f. WCFFM material must conform to the following physical requirements: fiber length of approximately 10 millimeters, diameter approximately 1 millimeter, pH range of 4.0 to 8.5, and contain a percent maximum water holding capacity of 90 percent minimum.

- 2. Application

- a. Apply mulch to all seeded areas immediately after seeding.

- b. When straw mulch is used, spread 10 over all seeded areas at the rate of 2 tons per acre to a uniform loose depth of 1 to 2 inches.

- c. Wood cellulose fiber used as mulch must be applied at a net dry weight of 1500 pounds per acre. Mix the wood cellulose fiber with water to attain a mixture with a maximum of 50 pounds of wood cellulose fiber per 100 gallons of water.

- 3. Anchoring

- a. Perform mulch anchoring immediately following application of mulch to minimize loss by wind or water.

- b. A mulch anchoring tool is a tractor drawn implement designed to punch and anchor mulch into the soil surface to a minimum of 2 inches.

- c. Wood cellulose fiber may be used for anchoring straw.

- d. Synthetic binders such as Acrylic DLR (Ago-Tack), DCA-70, Permatex, T-11, Terra Tack, AK or other approved equal may be used.

- e. Lightweight plastic netting may be applied over the mulch according to manufacturer's recommendations.

- f. Netting is usually available in rolls 4 to 15 feet wide and 300 to 3,000 feet long.

Controlling the dispersion of dust particles from construction activities.

To prevent blowing and movement of dust from exposed soil surfaces to reduce on- and off-site damage including dust and noise hazards.

- 1. Mulches: See Section B-4-3 Soil Preparation, Topsoiling, and Soil Amendments, Section B-4-3 Seeding and Mulching, and Section B-4-4 Temporary Stabilization.

- 2. Yoniflour Cover: See Section B-4-4 Temporary Stabilization.

- 3. Tillage: Till to roughen surface and bring clods to the surface.

- 4. Barriers: Solid board fences, six foot, snow fences, torii fences, straw bales, and similar materials can be used to control air currents and soil blowing.




























- 5. Chemical Treatments: Use of chemical treatment requires approval by the appropriate plan review authority.

ENGINEERS CERTIFICATE
I CERTIFY THAT THIS PLAN FOR SEDIMENT AND EROSION CONTROL REPRESENTS AN APPROXIMATE PLAN BASED ON MY PERSONAL KNOWLEDGE OF THE SITE CONDITIONS AND THAT IT WAS PREPARED IN ACCORDANCE WITH THE REQUIREMENTS OF THE HOWARD SOIL CONSERVATION DISTRICT.






































Zacharia Y. Fisch, 3/4/2019, SIGNATURE OF ENGINEER

DATE

DETAIL E-1 SILT FENCE

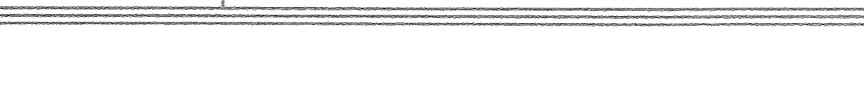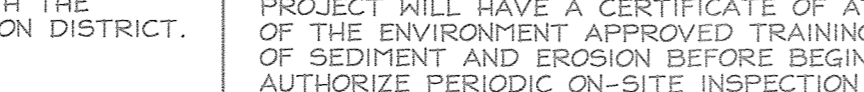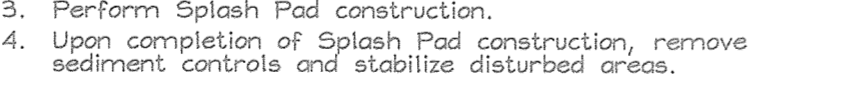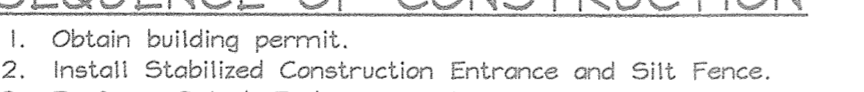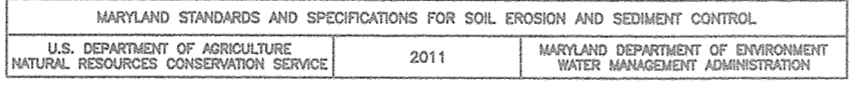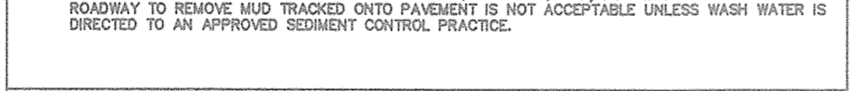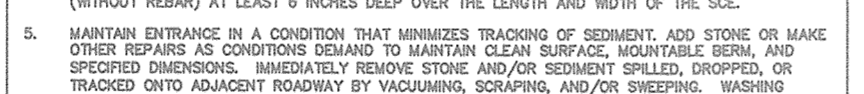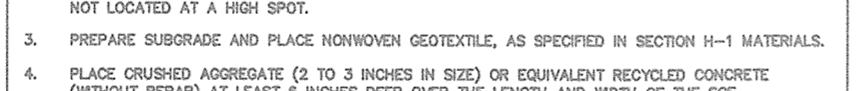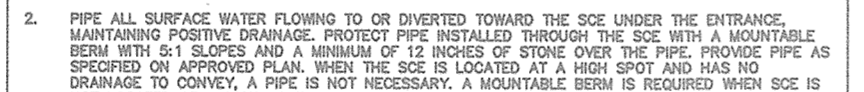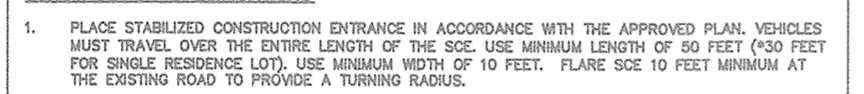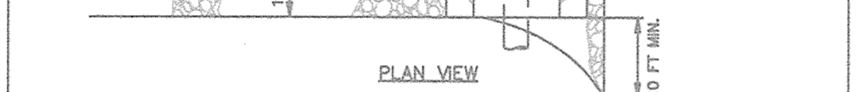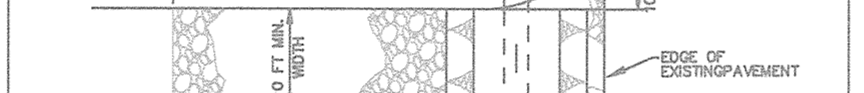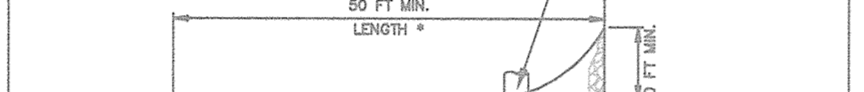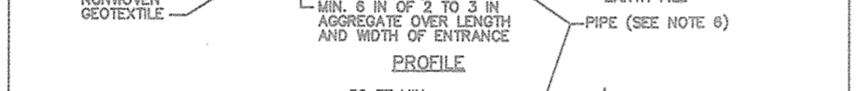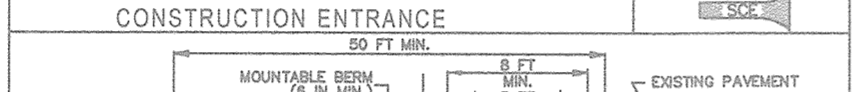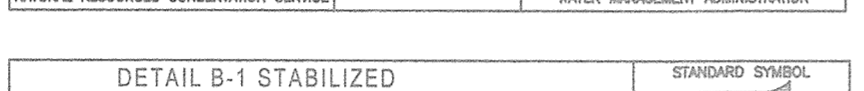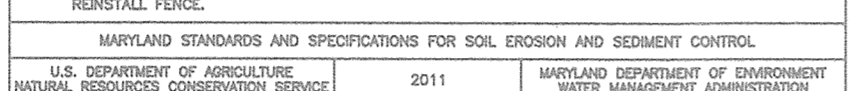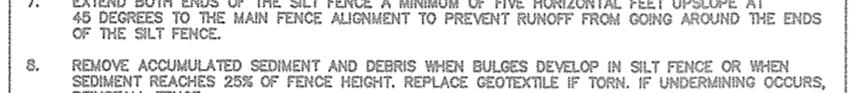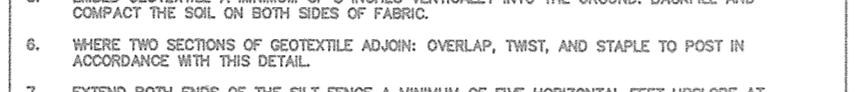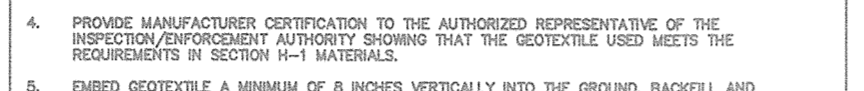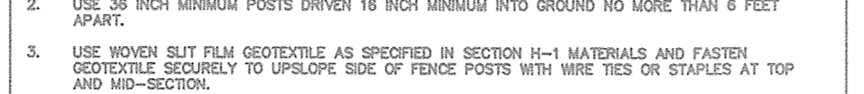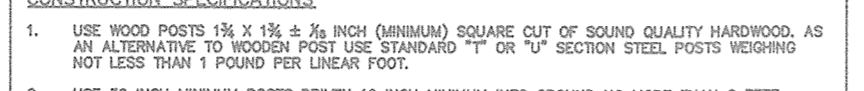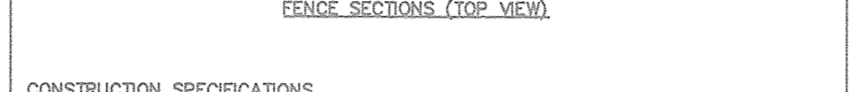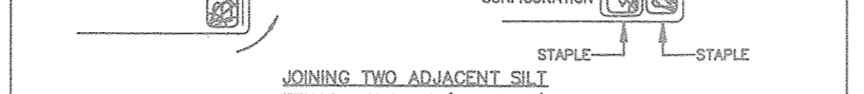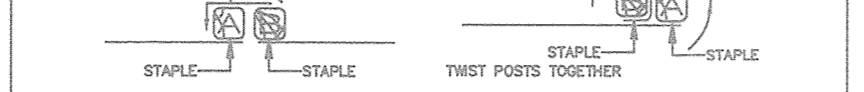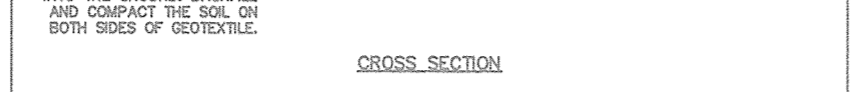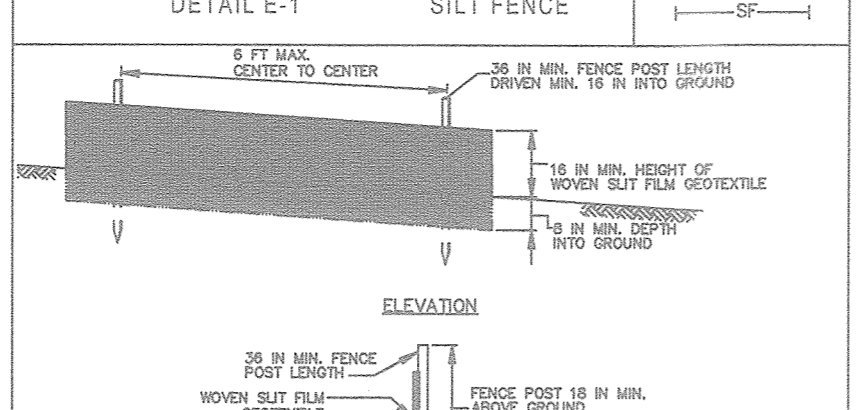

DETAIL E-2 SILT FENCE ON PAVEMENT

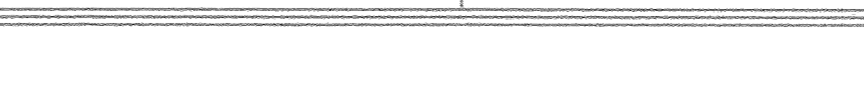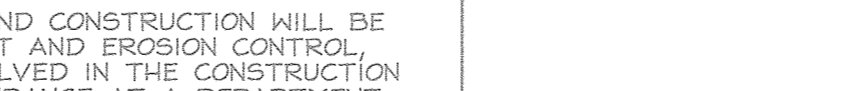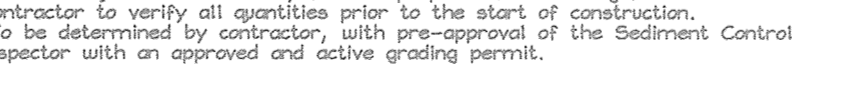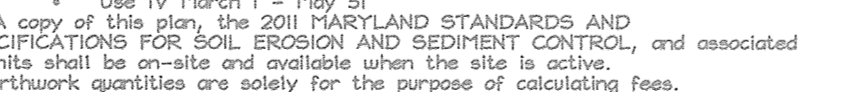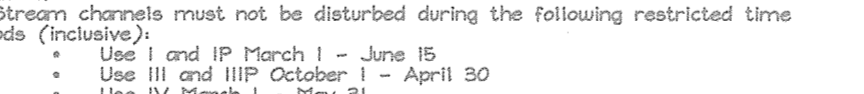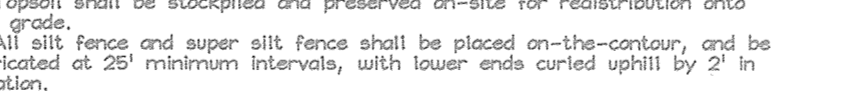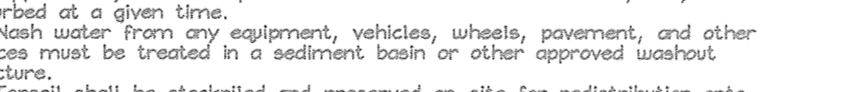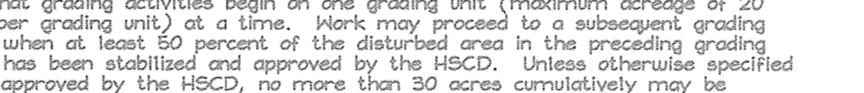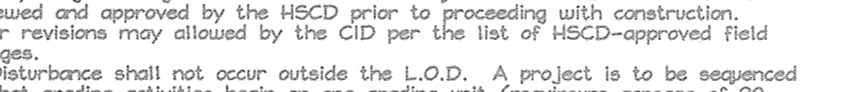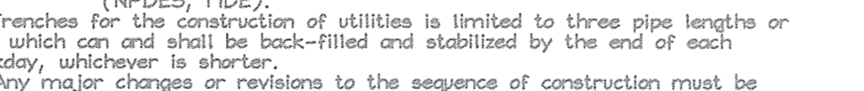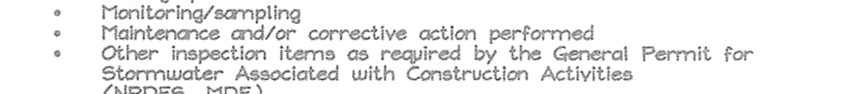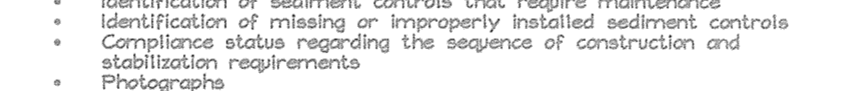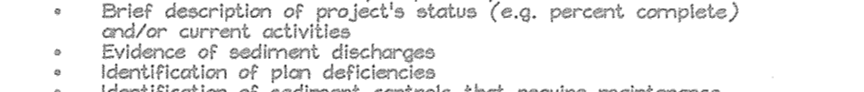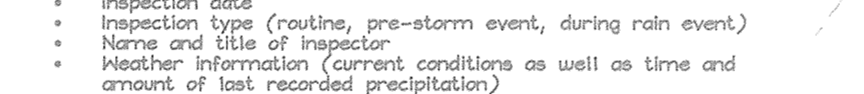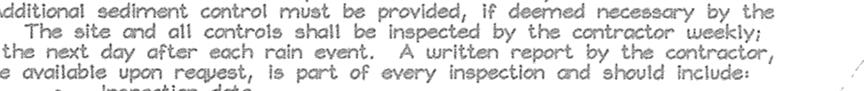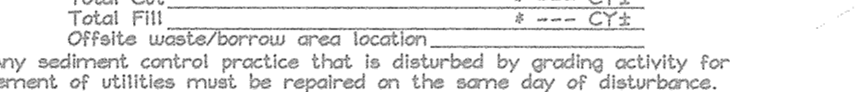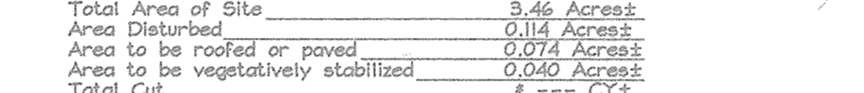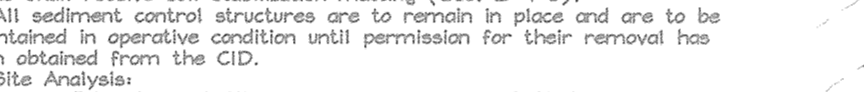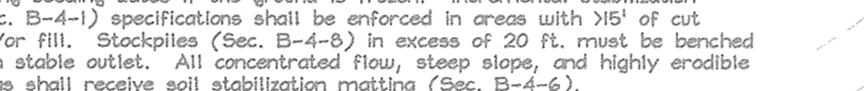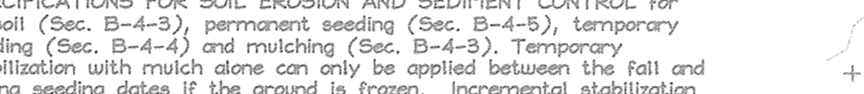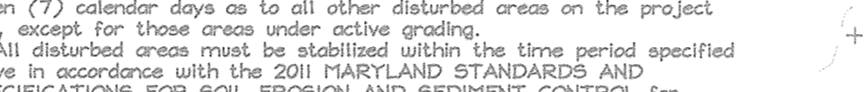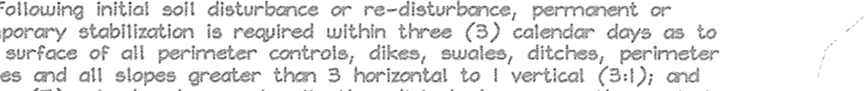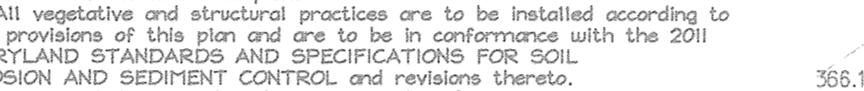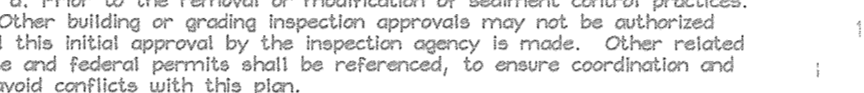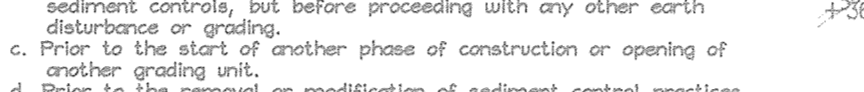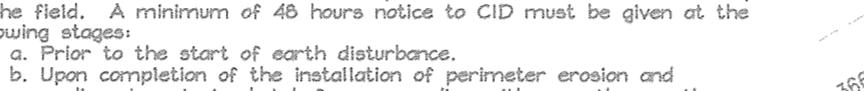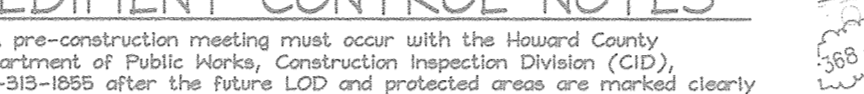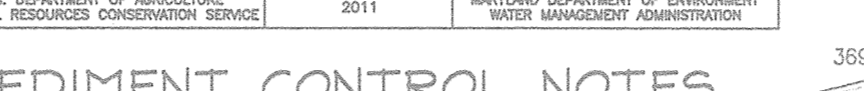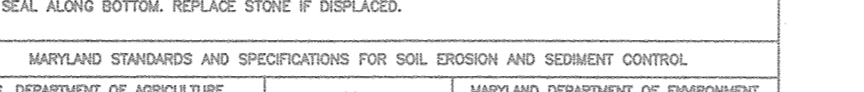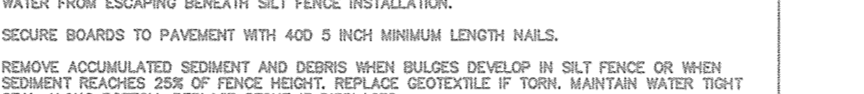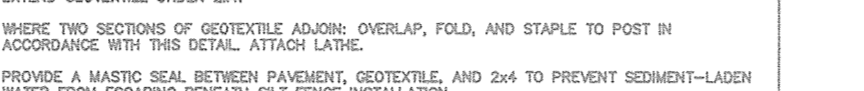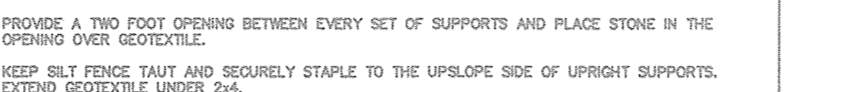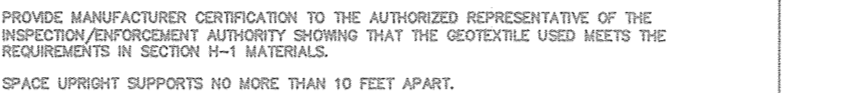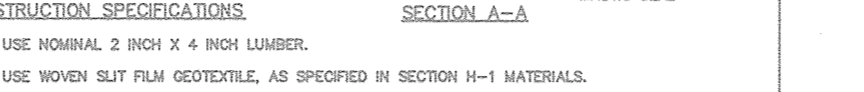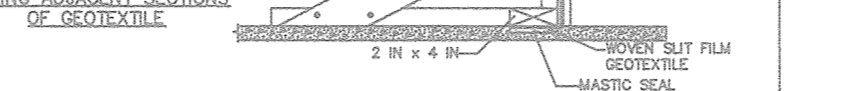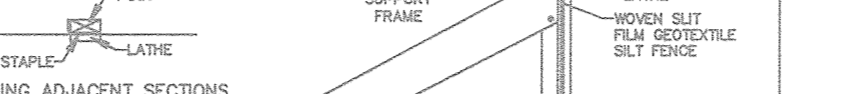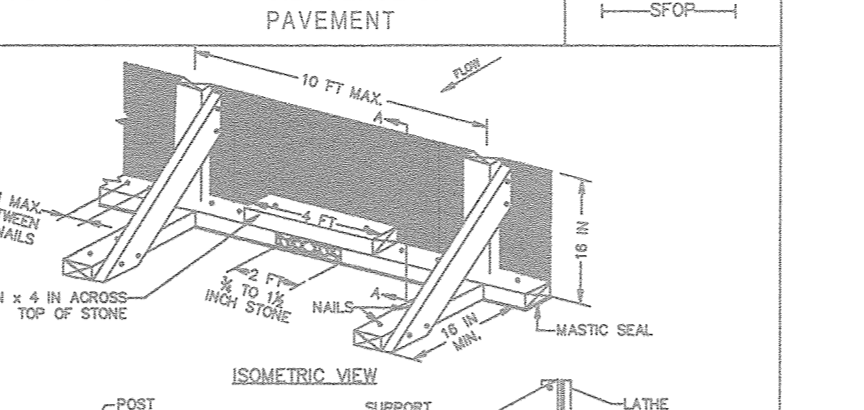

CONSTRUCTION SPECIFICATIONS

- 1. USE NOMINAL 2 INCH X 4 INCH LUMBER, AS SPECIFIED IN SECTION H-1 MATERIALS.

- 2. PROVIDE MANUFACTURER CERTIFICATION TO THE AUTHORIZED REPRESENTATIVE OF THE INSPECTION AUTHORITY SHOWING THAT THE GEOTEXTILE MEETS THE REQUIREMENTS IN SECTION H-1 MATERIALS.

- 3. PROVIDE A TWO FOOT SPACING BETWEEN EVERY SET OF SUPPORTS AND PLACE STONE IN THE OPENING OVER SCOTCHES.

- 4. KEEP SILT FENCE TIGHT AND SECURELY STAPLE TO THE UPLAP SIDE OF UPRIGHT SUPPORTS. EXTERIOR GEOTEXTILE SHOULD BE:

- a. WHERE TWO SECTIONS OF GEOTEXTILE ADJOIN, OVERLAP, FOLD, AND STAPLE TO POST IN ACCORDANCE WITH THIS DETAIL ATTACH LATE.

- b. PROVIDE A MASTIC SEAL BETWEEN PAVEMENT, GEOTEXTILE, AND 2x4 TO PREVENT SEDIMENT-LOADED WATER FROM ESCAPING THROUGH SILT FENCE INSTALLATION.

- c. SECURE BOARD TO PAVEMENT WITH 400 5 INCH MINIMUM LENGTH NAILS.

- d. REMOVE ACCUMULATED SEDIMENT AND DEBRIS WHEN BUILDS DEVELOP IN SILT FENCE OR WHEN SEDIMENT REACHES 20% OF FENCE HEIGHT. REPLACE GEOTEXTILE IF TORN. MAINTAIN WATER TIGHT SEAL ALONG BOTTOM. REPLACE STAPLE IF DISPLACED.

- 5. HARBORLAND STANDARDS AND SPECIFICATIONS FOR SOIL EROSION AND SEDIMENT CONTROL.

- 6. U.S. DEPARTMENT OF AGRICULTURE NATURAL RESOURCES CONSERVATION SERVICE 2011.

SEDIMENT CONTROL NOTES

- 1. A pre-construction meeting must occur with the Howard County Department of Public Works, Construction Inspection Division (CID) 410-351-1858 after the future LOD and protected areas are marked clearly in the minimum of 48 hours notice to CID must be given at the following stages:

- a. Prior to the start of earth disturbance.

- b. Prior to the start of another phase of construction or opening of another grading unit.

- c. Prior to the start of another phase of construction or opening of another grading unit.






- x. Prior to the start of another phase of construction or opening of another grading unit.

- y. Prior to the start of another phase of construction or opening of another grading unit.

- z. Prior to the start of another phase of construction or opening of another grading unit.

- aa. Prior to the start of another phase of construction or opening of another grading unit.

- ab. Prior to the start of another phase of construction or opening of another grading unit.

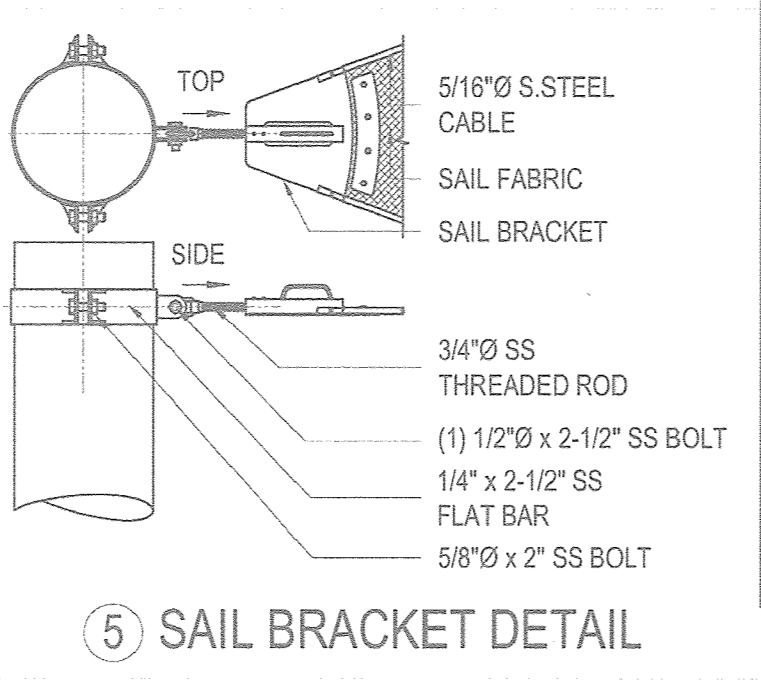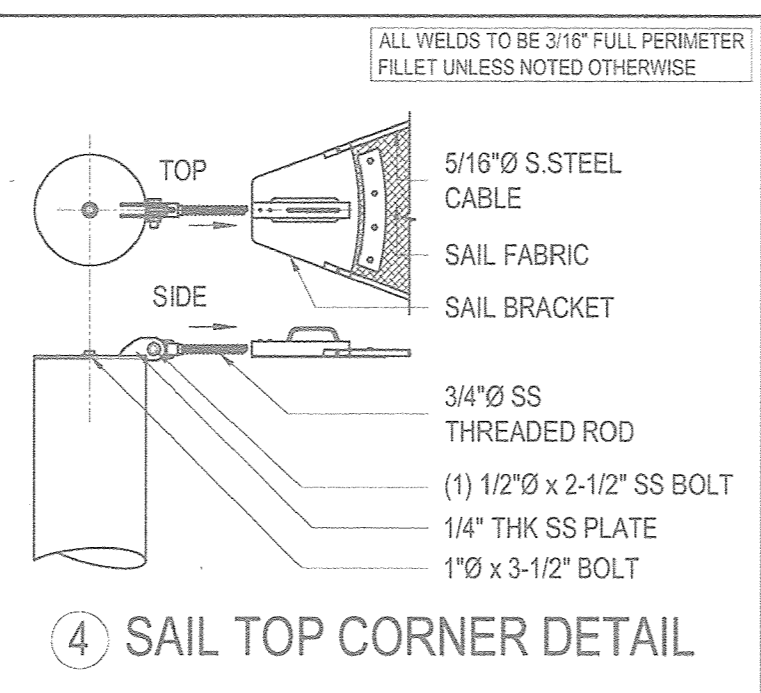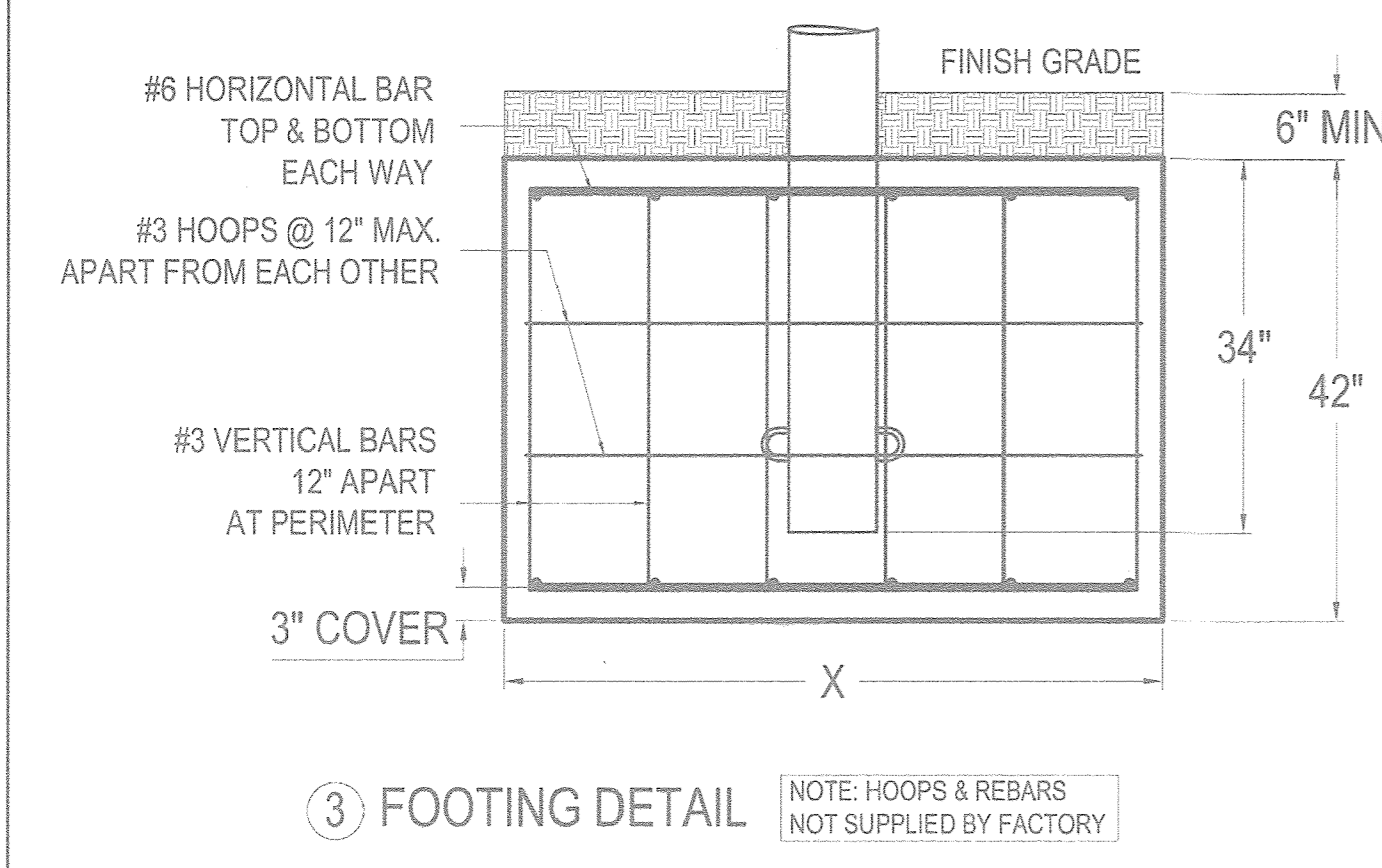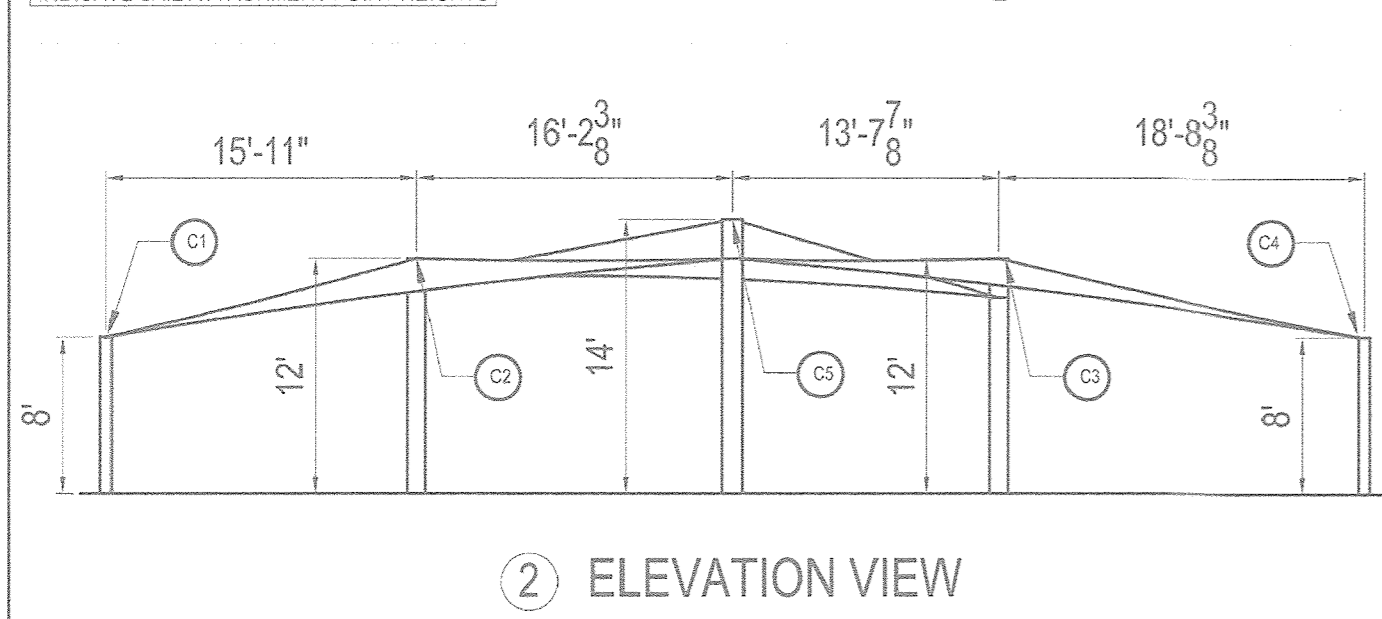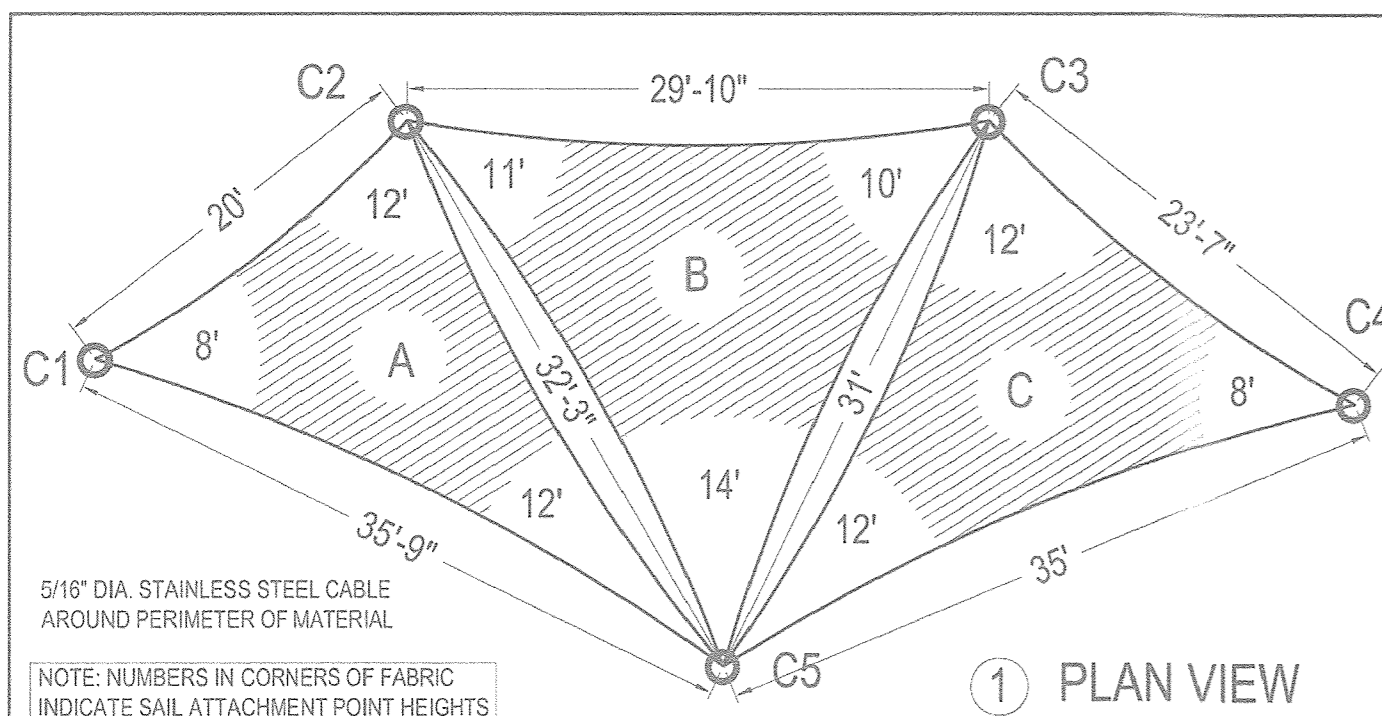

	STEEL COLUMN	FOOTER	NUMBER OF HORIZONTAL REBARS EACH WAY
C1	6-5/8" DIA. X .280" WALL	56" X 56"	4
C2	10-3/4" DIA. X .365" WALL	86" X 86"	7
C3	10-3/4" DIA. X .365" WALL	86" X 86"	7
C4	6-5/8" DIA. X .280" WALL	56" X 56"	4
C5	12-3/4" DIA. X .375" WALL	96" X 96"	8

GENERAL NOTES

- THE SHADE SYSTEMS, INC. STRUCTURE HAS BEEN DESIGNED IN ACCORDANCE WITH THE 2015 IBC CODES INCLUDING WITH ANY APPLICABLE IBC BUILDING CODES SUBJECT TO THE FOLLOWING REVISIONS:
- THE FOUNDATION ASSUMES A MINIMUM SOIL BEARING CAPACITY OF 1500 PSF.
- ALL FABRICATORS SHALL BE STAINLESS STEEL.
- THE FABRIC SYSTEM IS DESIGNED TO WITHSTAND WINDS UP TO 100 MPH WITH THE FABRIC ATTACHED. THE FABRIC MAY BE REMOVED TO EXPOSE THE UNDERLYING STRUCTURE.

REVISIONS

- STEEL PIPES SHALL HAVE A MINIMUM WELD STRENGTH OF 45 KSI. STEEL PLATES SHALL CONFORM TO ASTM A572.
- ALL WELDS SHALL BE FULL PENETRATION WELDS TO AMERICAN WELDING SOCIETY (AWS) SPECIFICATIONS AND SHALL BE WELDED BY A LICENSED WELDER WHO SHALL BE QUALIFIED FOR THE JOINT AND MATERIALS.
- ALL WELDS SHALL BE FULL PENETRATION WELDS TO AMERICAN WELDING SOCIETY (AWS) SPECIFICATIONS AND SHALL BE WELDED BY A LICENSED WELDER WHO SHALL BE QUALIFIED FOR THE JOINT AND MATERIALS.
- CONCRETE SHALL BE STRENGTH AND PLACED IN ACCORDANCE WITH THE LATEST EDITION OF ACI 308.3R.
- CONCRETE SHALL HAVE A MINIMUM 28 DAY COMPRESSIVE STRENGTH OF 4000 PSI. FOR ALL OTHERS THE MINIMUM 28 DAY COMPRESSIVE STRENGTH SHALL BE 3000 PSI. ALL WELDS SHALL BE FULL PENETRATION WELDS TO AMERICAN WELDING SOCIETY (AWS) SPECIFICATIONS AND SHALL BE WELDED BY A LICENSED WELDER WHO SHALL BE QUALIFIED FOR THE JOINT AND MATERIALS.
- FINISHING STEEL SHALL BE WITH A FINISH GRADE OF 0.00' WITH A MINIMUM WIND STRENGTH OF 45 KSI.
- UNLESS OTHERWISE SPECIFIED, CONCRETE COVER SHALL BE 3" MIN.

NOTE TO OWNER:
OWNER ACCEPTS FULL RESPONSIBILITY FOR REMOVING THE FABRIC SHADE MATERIAL FROM THE STEEL FRAME WHEN SEVERE WEATHER CONDITIONS ARE PREDICTED. SUCH CONDITIONS INCLUDE PREDICTED WIND SPEEDS IN EXCESS OF 90 MPH. ALSO, AS STRUCTURE IS NOT DESIGNED FOR ANY SNOW LOAD, IT IS RECOMMENDED THAT CANOPY BE REMOVED WHEN SNOWFALL IS EXPECTED.

Shade Systems
4150 S.W. 18 Street
Ocala, FL 34474
Tel: 1-800-609-6066

Running Brook Pool
5730 Columbia Road
Columbia, MD 21046

Approved: [Professional Engineer Seal]







Model Name: CUSTOM SAIL SHADE SYSTEM STRUCTURE
Model No.: SAIL

Revisions:

REP: []

REP QTY. NO. AG110218-A

Approved: JMS Job: 6427
Checked: MG
Date: 01/31/2019 Sheet: 1 OF 1

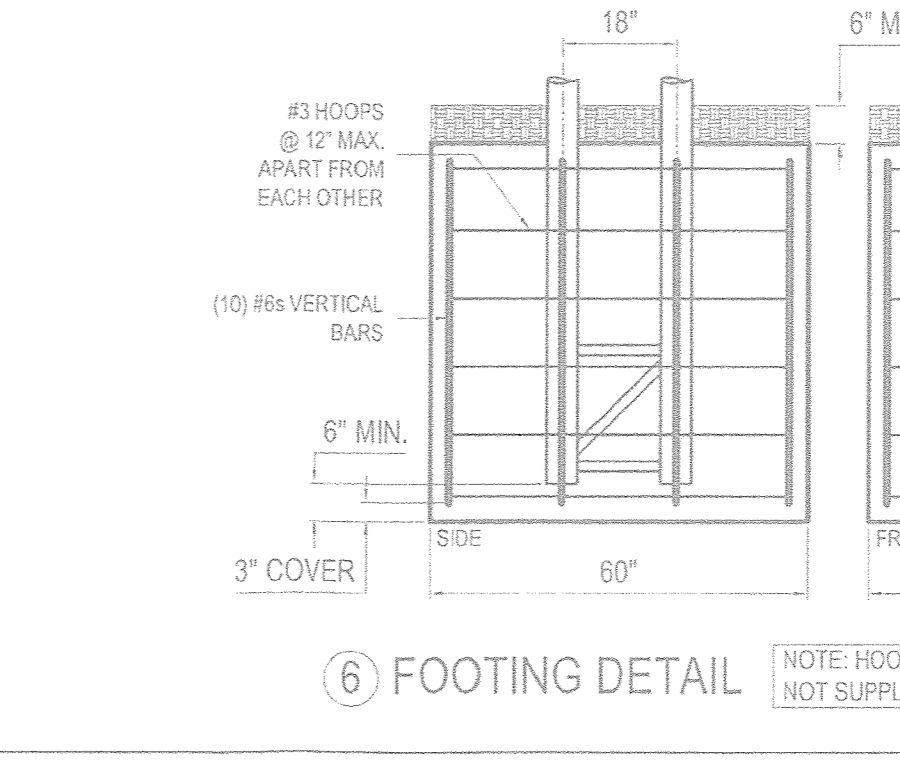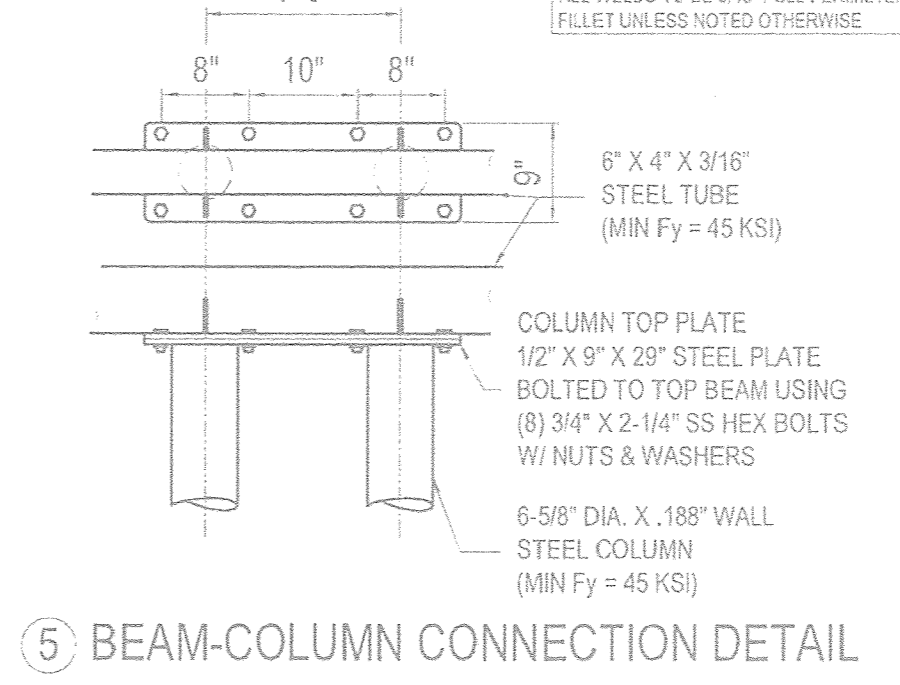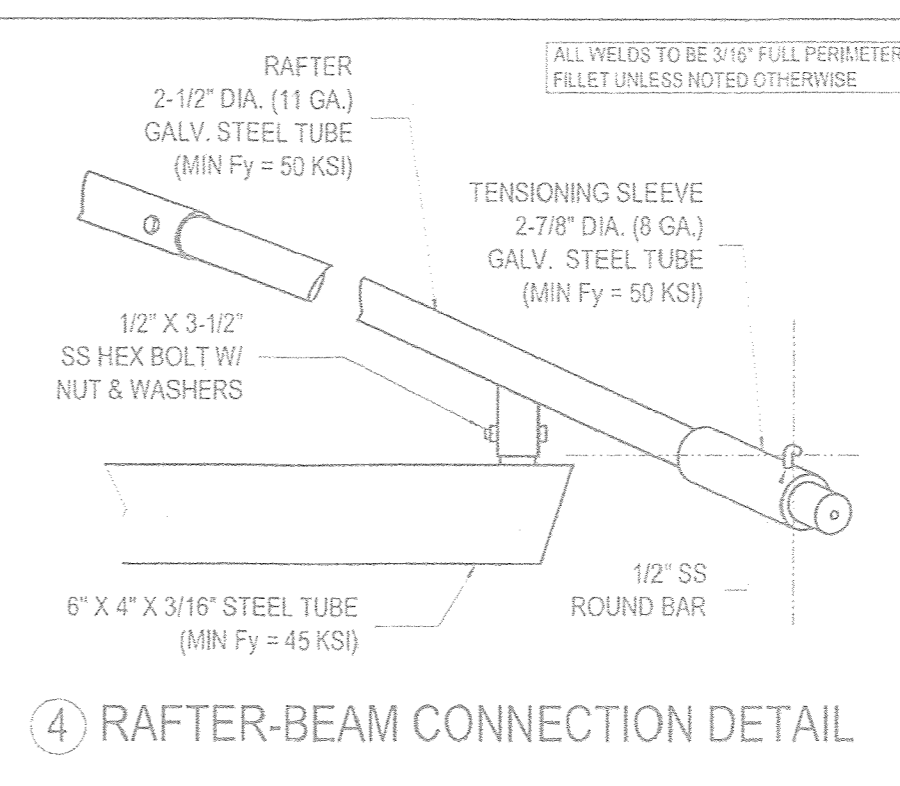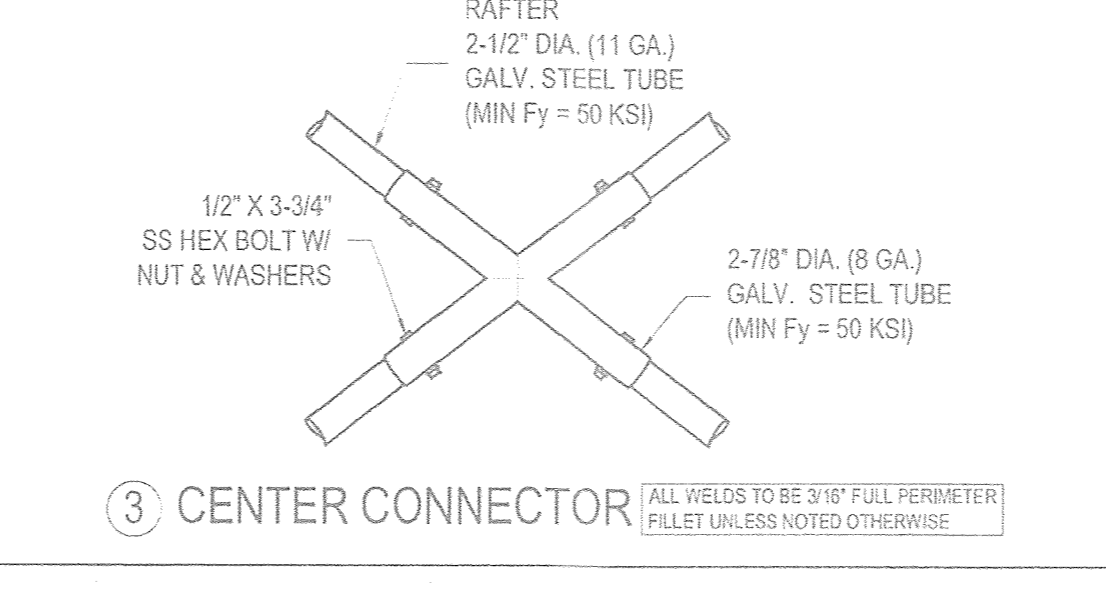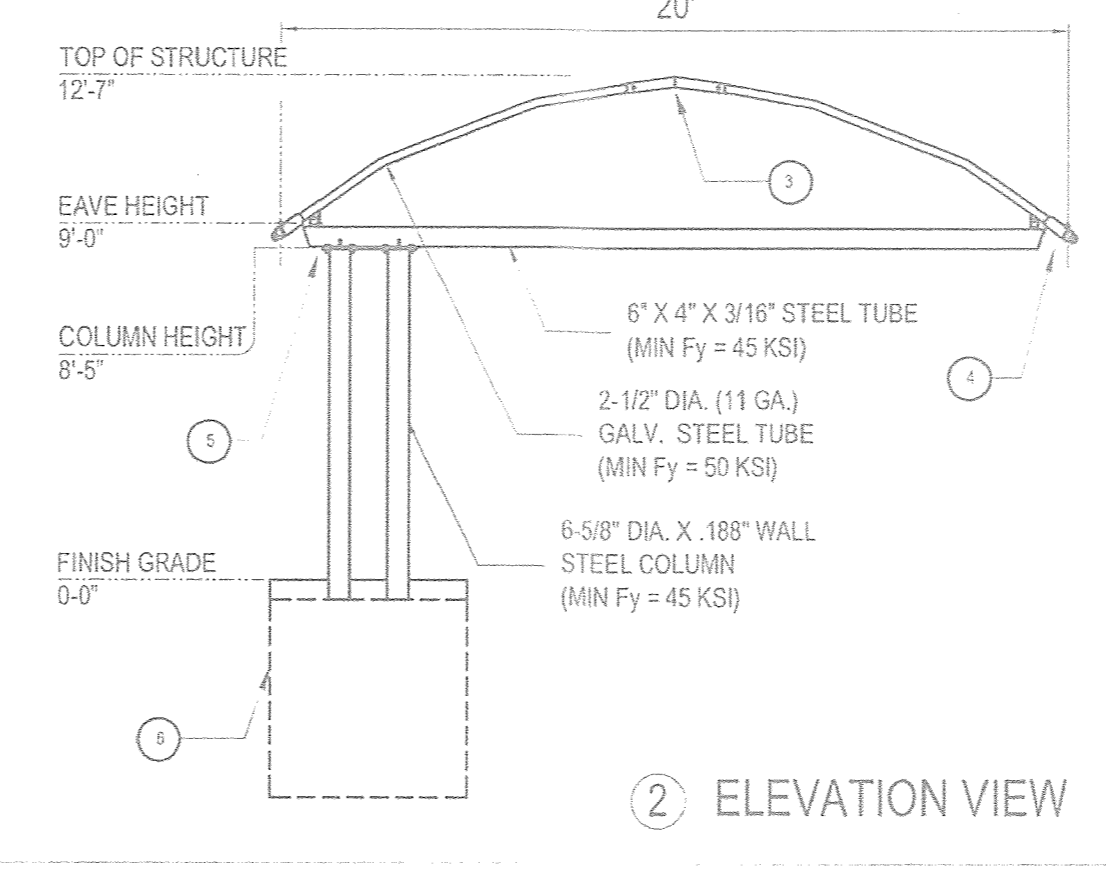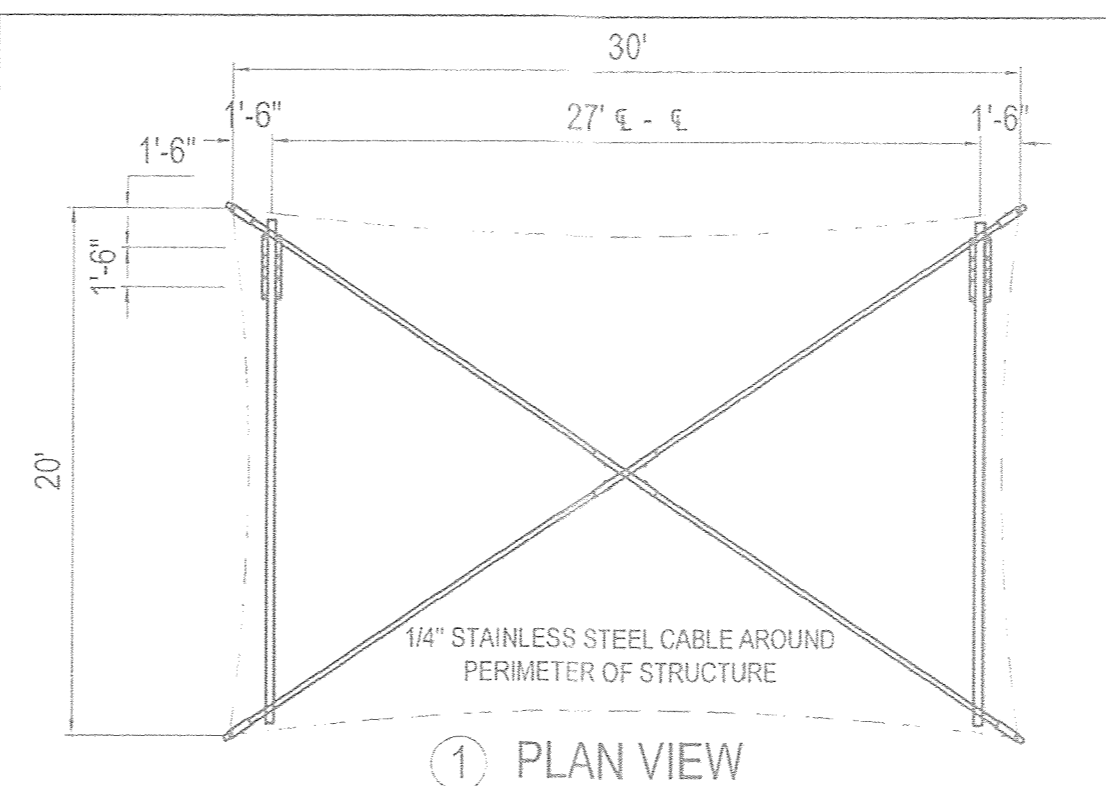

GENERAL NOTES

- THE SHADE SYSTEMS, INC. STRUCTURE HAS BEEN DESIGNED IN ACCORDANCE WITH THE 2015 IBC CODES INCLUDING WITH ANY APPLICABLE IBC BUILDING CODES SUBJECT TO THE FOLLOWING REVISIONS:
- THE FOUNDATION ASSUMES A MINIMUM SOIL BEARING CAPACITY OF 1500 PSF.
- ALL FABRICATORS SHALL BE STAINLESS STEEL.
- THE FABRIC SYSTEM IS DESIGNED TO WITHSTAND WINDS UP TO 100 MPH WITH THE FABRIC ATTACHED. THE FABRIC MAY BE REMOVED TO EXPOSE THE UNDERLYING STRUCTURE.

REVISIONS

- STEEL PIPES SHALL HAVE A MINIMUM WELD STRENGTH OF 45 KSI. STEEL PLATES SHALL CONFORM TO ASTM A572.
- ALL WELDS SHALL BE FULL PENETRATION WELDS TO AMERICAN WELDING SOCIETY (AWS) SPECIFICATIONS AND SHALL BE WELDED BY A LICENSED WELDER WHO SHALL BE QUALIFIED FOR THE JOINT AND MATERIALS.
- ALL WELDS SHALL BE FULL PENETRATION WELDS TO AMERICAN WELDING SOCIETY (AWS) SPECIFICATIONS AND SHALL BE WELDED BY A LICENSED WELDER WHO SHALL BE QUALIFIED FOR THE JOINT AND MATERIALS.
- CONCRETE SHALL BE STRENGTH AND PLACED IN ACCORDANCE WITH THE LATEST EDITION OF ACI 308.3R.
- CONCRETE SHALL HAVE A MINIMUM 28 DAY COMPRESSIVE STRENGTH OF 4000 PSI. FOR ALL OTHERS THE MINIMUM 28 DAY COMPRESSIVE STRENGTH SHALL BE 3000 PSI. ALL WELDS SHALL BE FULL PENETRATION WELDS TO AMERICAN WELDING SOCIETY (AWS) SPECIFICATIONS AND SHALL BE WELDED BY A LICENSED WELDER WHO SHALL BE QUALIFIED FOR THE JOINT AND MATERIALS.
- FINISHING STEEL SHALL BE WITH A FINISH GRADE OF 0.00' WITH A MINIMUM WIND STRENGTH OF 45 KSI.
- UNLESS OTHERWISE SPECIFIED, CONCRETE COVER SHALL BE 3" MIN.

NOTE TO OWNER:
OWNER ACCEPTS FULL RESPONSIBILITY FOR REMOVING THE FABRIC SHADE MATERIAL FROM THE STEEL FRAME WHEN SEVERE WEATHER CONDITIONS ARE PREDICTED. SUCH CONDITIONS INCLUDE PREDICTED WIND SPEEDS IN EXCESS OF 90 MPH. ALSO, AS STRUCTURE IS NOT DESIGNED FOR ANY SNOW LOAD, IT IS RECOMMENDED THAT CANOPY BE REMOVED WHEN SNOWFALL IS EXPECTED.

Shade Systems
4150 S.W. 18 Street
Ocala, FL 34474
Tel: 1-800-609-6066

Running Brook Pool
5730 Columbia Road
Columbia, MD 21046

Approved: [Professional Engineer Seal]

Model Name: SINGLE CANTILEVER SHADE SYSTEM STRUCTURE
Model No.: SC203009




Revisions:

REP: []

REP QTY. NO. AG110218-A

Approved: JMS Job: 6427-2
Checked: MG
Date: 01/02/2019 Sheet: 1 OF 1

NOTE: For construction plans and details, please seek information from Shade Systems, Inc.

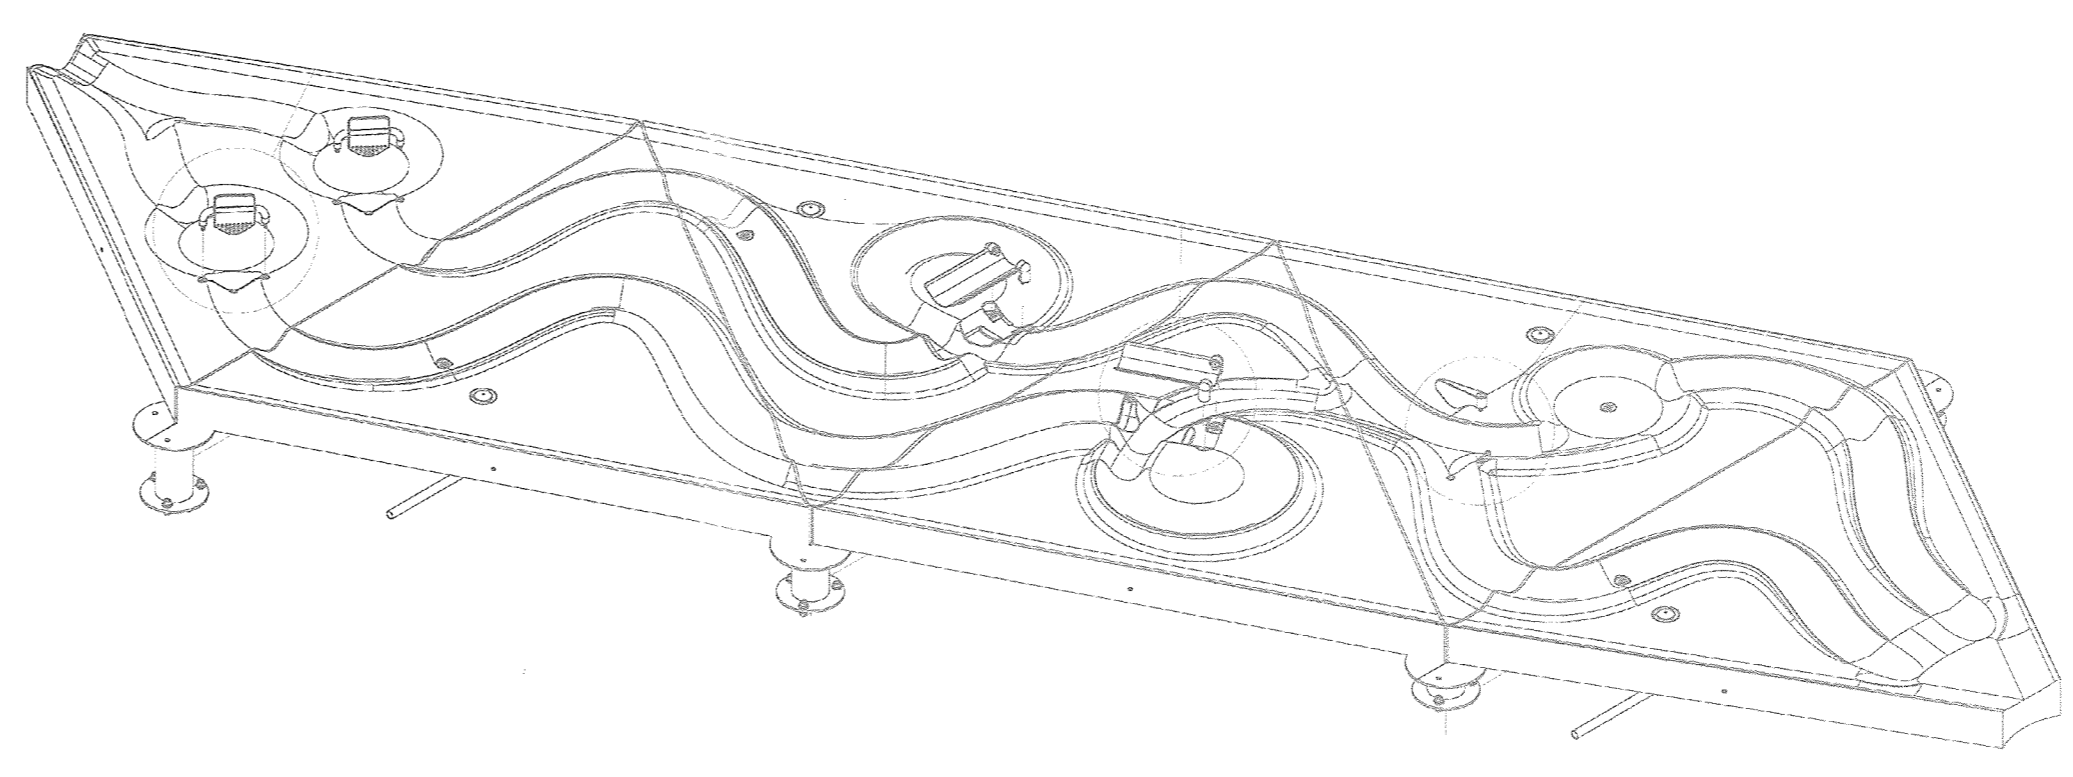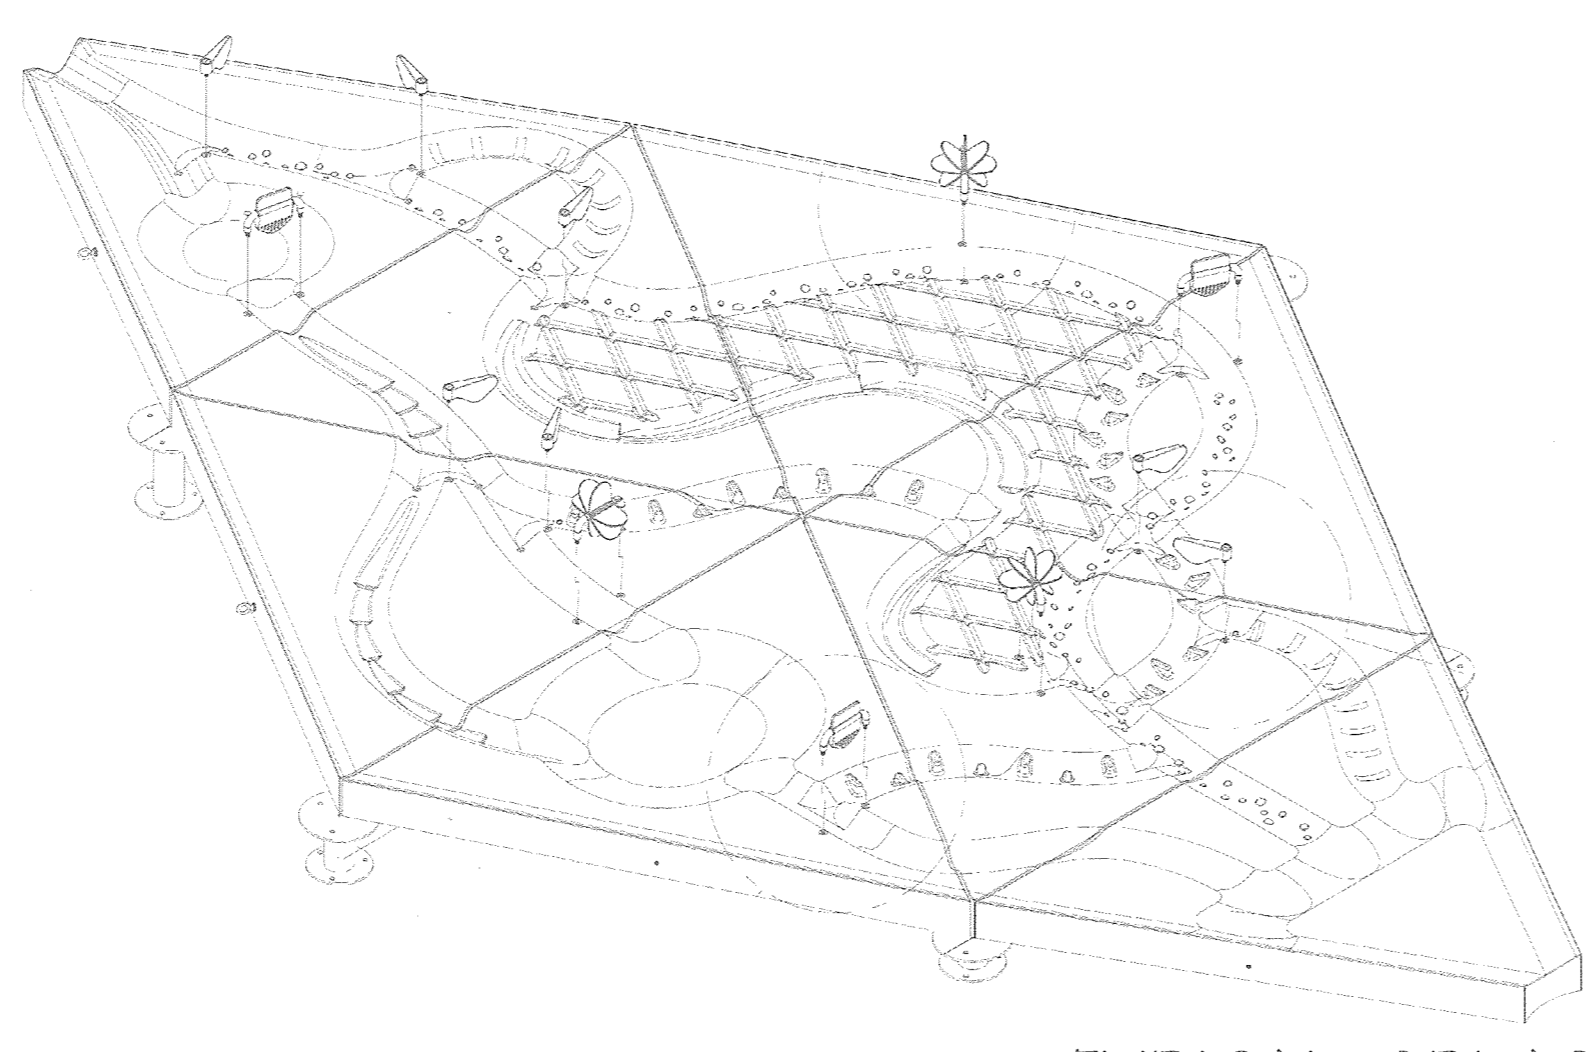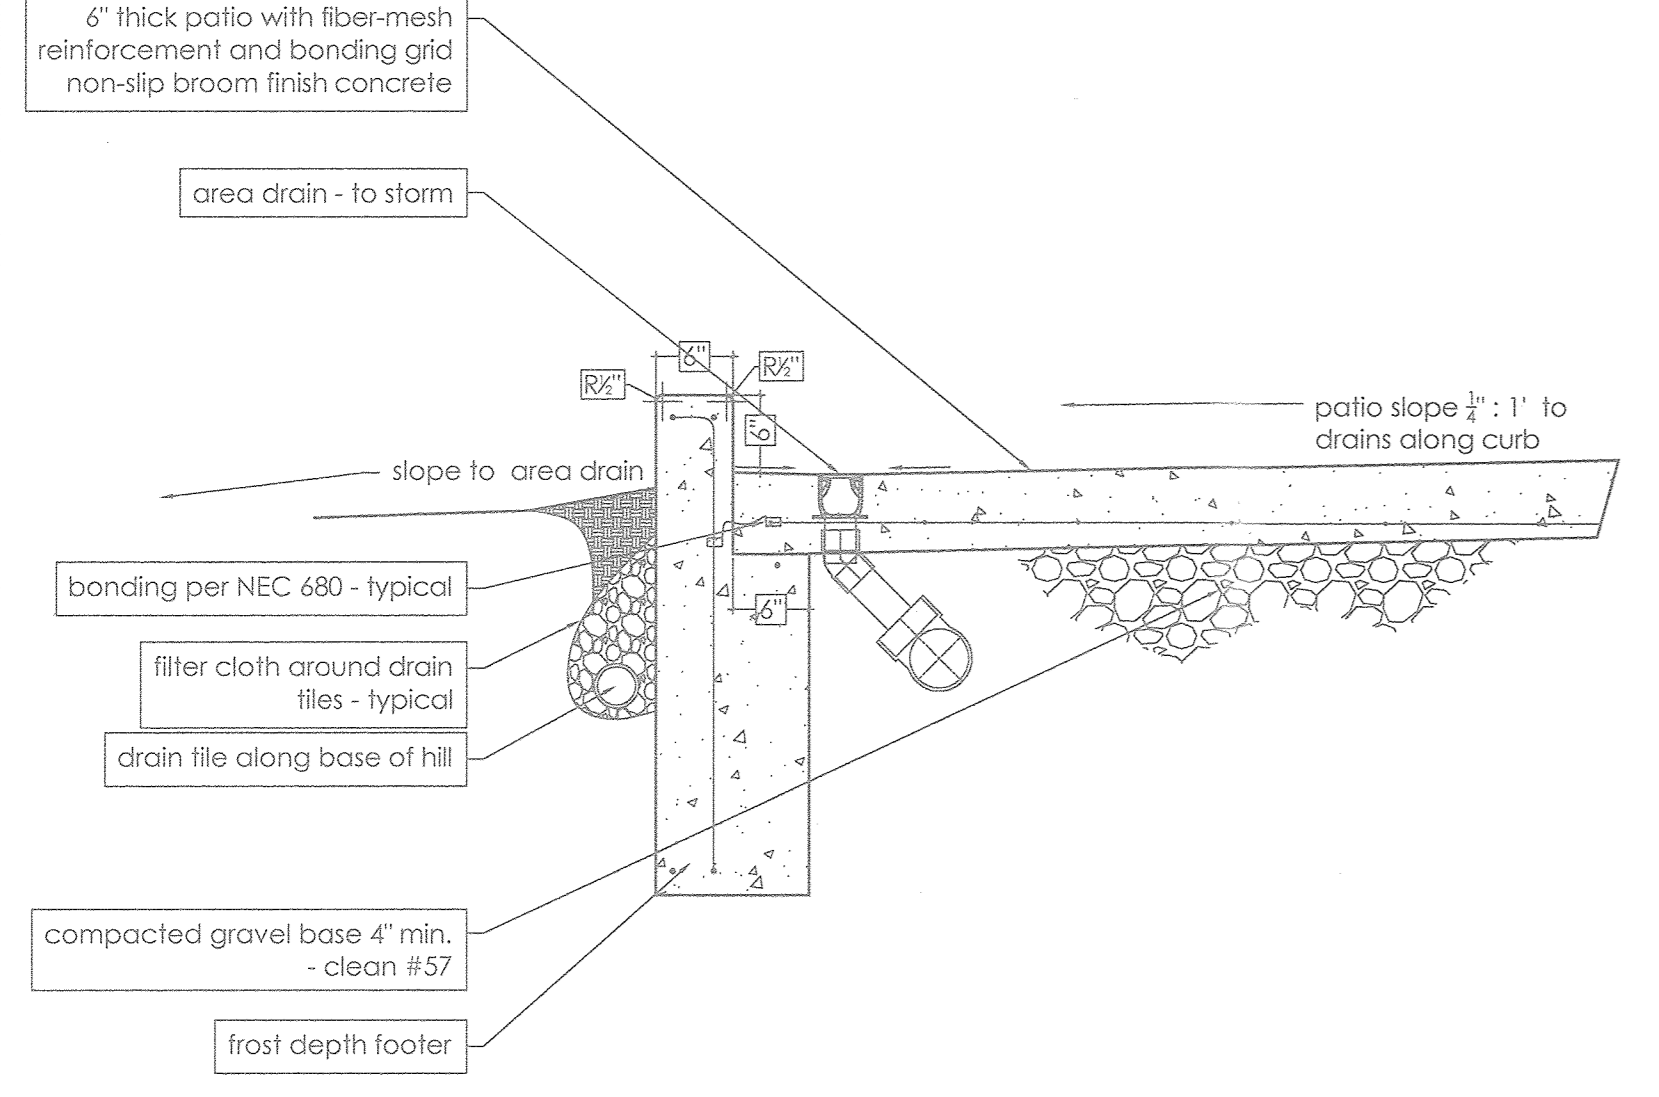

TYPICAL SPLASH PAD CURB DETAIL
Scale: None
NOTE: Use Splash Pad plans for construction.

TYPICAL SPLASH PAD ILLUSTRATIONS
Scale: None

TYPICAL SPLASH PAD ILLUSTRATIONS
Scale: None

APPROVED: HOWARD COUNTY DEPARTMENT OF PLANNING AND ZONING

[Signature] 3-28-19
CHIEF, DEVELOPMENT ENGINEERING DIVISION DATE

[Signature] 4-01-19
CHIEF, DIVISION OF LAND DEVELOPMENT DATE

[Signature] 4-2-19
DIRECTOR DATE

PURPOSE NOTE:
The purpose of this SDP redline revision is to depict the replacement of the wading pool with a splash pad and shade structure, and to depict the removal of an ex. shade structure, and replacement with a new shade structure.

PROFESSIONAL CERTIFICATION
I hereby certify that these documents were prepared or approved by me, and that I am a duly licensed professional engineer under the laws of the State of Maryland, License No. #22418, Expiration Date: 07/24/2019.

SDP - GENERAL NOTES

- The subject property consists of 3.46 ac.± and is zoned NT.
- All construction shall be in accordance with the latest standards and specifications of Howard County plus MSHA standards and specifications if applicable.
- The contractor shall notify the Department of Public Works/Bureau of Engineering/Construction Inspection Division at (410)315-1880 at least five (5) working days prior to the start of work and the contractor shall notify "Miss Utility" at 1-800-257-777 at least 48 hours prior to any excavation work being done.
- All plan dimensions are more or less (+/-).
- The existing topography is taken from field run survey with two (2) foot contour intervals prepared by NJR & Associates, LLC in December 2017.
- The coordinates shown herein are based upon the Howard County Geodetic Control which is based on the Maryland State Plane Coordinate System.

REVISED SITE DEVELOPMENT PLAN
SHADE STRUCTURES & CURB DETAILS
RUNNING BROOK
NEIGHBORHOOD CENTER
COLUMBIA, MARYLAND

TAX MAP 30 GRID 14 PARCEL 117
5TH ELECTION DISTRICT HOWARD COUNTY, MARYLAND

FSH Associates
Engineers Planners Surveyors
8339 Howard Lane, Elkridge, MD 21075
Tel: 410-567-5200 Fax: 410-796-1592
E-mail: info@fshri.com

DESIGN BY: []
DRAWN BY: CRH2
CHECKED BY: ZYF
SCALE: None
DATE: Mar. 1, 2019
W.O. No.: 4065
SHEET No. 5 OF 5

(Additional Sheet)