

I CERTIFY THAT THE PLAN OF DEVELOPMENT AND THE PLAN FOR CONTROL OF SILT AND EROSION MEETS THE REQUIREMENTS, STANDARDS, & SPECIFICATIONS OF THE HOWARD SOIL CONSERVATION DISTRICT.

H. Byron Gates, Jr. 2/3/72  
H. BYRON GATES JR. A.I.A., ARCHITECT DATE:


I CERTIFY THAT ALL DEVELOPMENT AND/OR CONSTRUCTION WILL BE DONE ACCORDING TO THIS PLAN OF DEVELOPMENT AND PLAN OF SILT AND SEDIMENT CONTROL.

C.M. Hale 2-3-72  
C.M. HALE CO., CONTRACTOR DATE:


THIS DEVELOPMENT PLAN IS APPROVED FOR SOIL EROSION AND SEDIMENT CONTROL BY THE HOWARD SOIL CONSERVATION DISTRICT.

REVIEWED James P. Helm 2-11-72  
DIST. CONSERVATIONIST DATE

APPROVED Robert W. Ziskow 2-11-72  
HOWARD SOIL CONSERVATION DISTRICT DATE

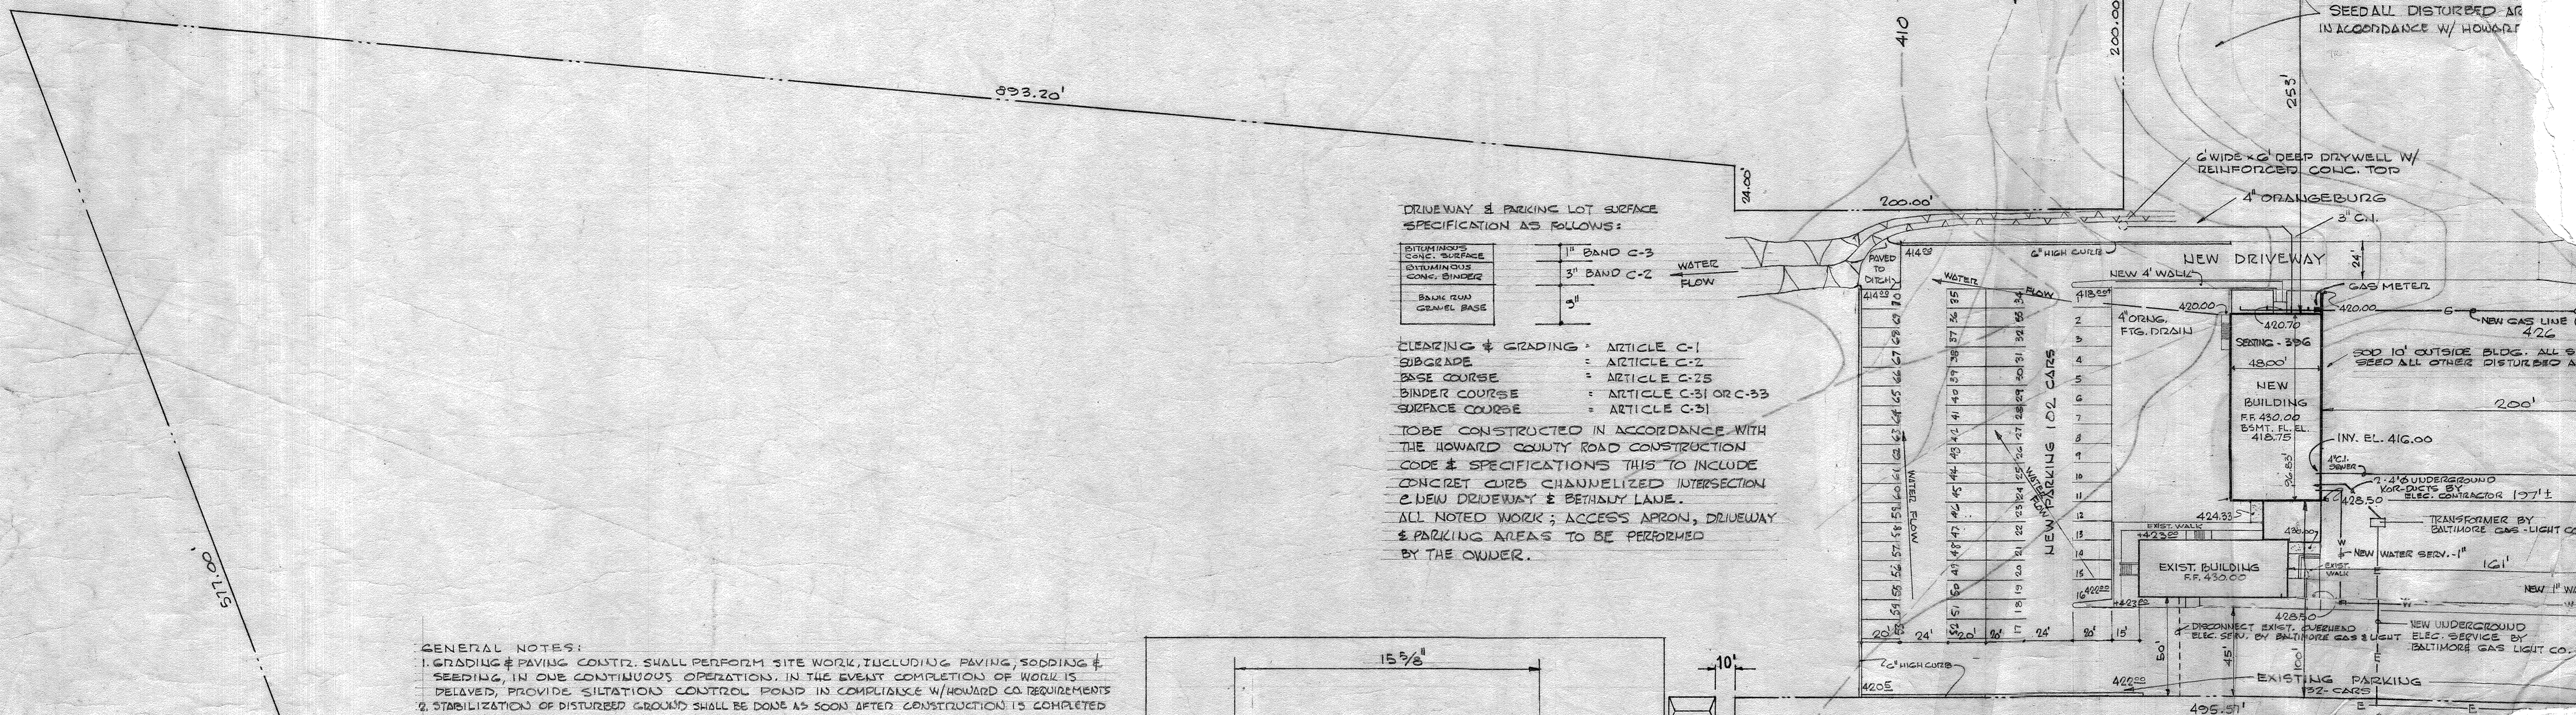

- GENERAL NOTES:
1. GRADING & PAVING CONSTR. SHALL PERFORM SITE WORK, INCLUDING PAVING, SODDING & SEEDING, IN ONE CONTINUOUS OPERATIONS. IN THE EVENT COMPLETION OF WORK IS DELAYED, PROVIDE SILTATION CONTROL POND IN COMPLIANCE W/HOWARD CO REQUIREMENTS
  2. STABILIZATION OF DISTURBED GROUND SHALL BE DONE AS SOON AFTER CONSTRUCTION IS COMPLETED AS PRACTICABLE.
  3. BERMS & LEVEL SPREADERS SHALL NOT BE REMOVED WITHOUT WRITTEN APPROVAL FROM THE HOWARD CO. SOIL CONSERVATION DISTRICT.
  4. SLOPE & CRITICAL AREA STABILIZATION SHALL ADHERE TO METHODS OUTLINED IN THE "EROSION & SEDIMENT CONTROL TECHNICAL HANDBOOK", PUBLISHED BY HOWARD CO. SOIL CONSERV. DIST.
  5. THE CONSTR. SHALL NOTIFY THE HOWARD CO. SOIL CONSERV. DIST. 24 HOURS PRIOR TO START OF CONSTRUCTION.

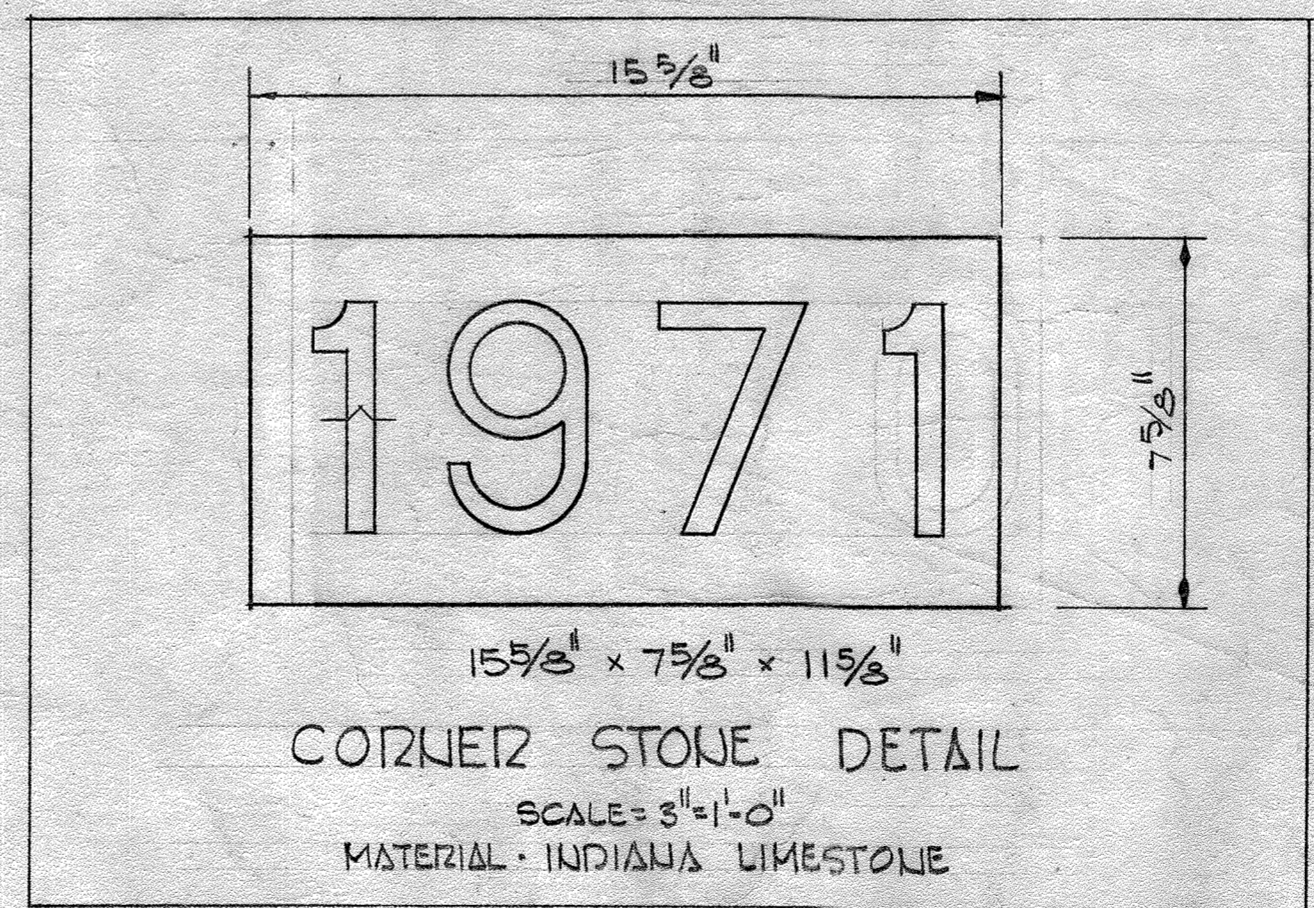


PARKING AREA - SPACE 10'x20'  
PARKING REQ'D - 30 SPACES  
PARKING PROVIDED - 102 SPACES

NEW PARKING AREA & DRIVEWAY ROLLED & COMPACTED.

PROPOSED 14'x24' PREFABRICATED SHED BY HIGH POINT BUILDINGS w/BLACK SHINGLE ROOF, GRAY SIDING AND WHITE TRIM.

THESE PLANS ARE DRAWN IN ACCORDANCE WITH THE BUILDING CODE OF HOWARD CO., MARYLAND.  
H. Byron Gates, Jr.  
H. BYRON GATES, JR. MD. REG. NO. 61

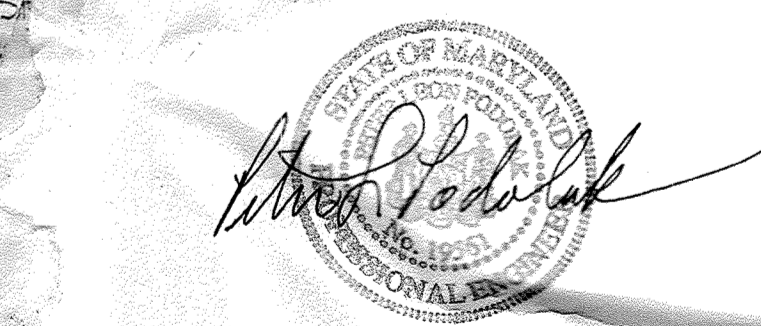

PURPOSE NOTE  
THE PURPOSE OF THIS RED-LINED SITE DEVELOPMENT PLAN IS TO DEPICT THE LOCATION OF A PROPOSED 336 SQ. FT. PREFABRICATED FRAME SHED TO BE USED BY THE CHURCH TO STORE MAINTENANCE AND OTHER EQUIPMENT.

DATE - SEPTEMBER 13, 2023 SCALE - 1" = 40'

RED-LINED PLAN PREPARED BY  
LEON A. PODLAK AND ASSOCIATES, LLC  
147 EAST MAIN STREET P.O. BOX 266  
WESTMINSTER, MARYLAND 21157  
(410) 848-2129 (410) 876-1226  
email - drawings@lapodlak.com

9-13-2023 - RED-LINE REVISION - DEPICT PREFABRICATED SHED LOCATION

PROPOSED INTERIM SANCTUARY AND EDUCATIONAL BUILDING BETHANY LAKE BAPTIST CHURCH, ELLICOTT CITY, MARYLAND 21043 REV. MARVIN G. SIMPSON, PASTOR	PREPARED FOR C.M. HALE ASSOCIATES, INC. 8525 COLESVILLE ROAD SILVER SPRING, MARYLAND 20910 301-589-9658	H. BYRON GATES, JR. A.I.A. ARCHITECT 8525 COLESVILLE ROAD SILVER SPRING, MARYLAND 20910 301-589-3377
-----------------------------------------------------------------------------------------------------------------------------------------------------	---------------------------------------------------------------------------------------------------------------------	---------------------------------------------------------------------------------------------------------------

SDP 71-105