
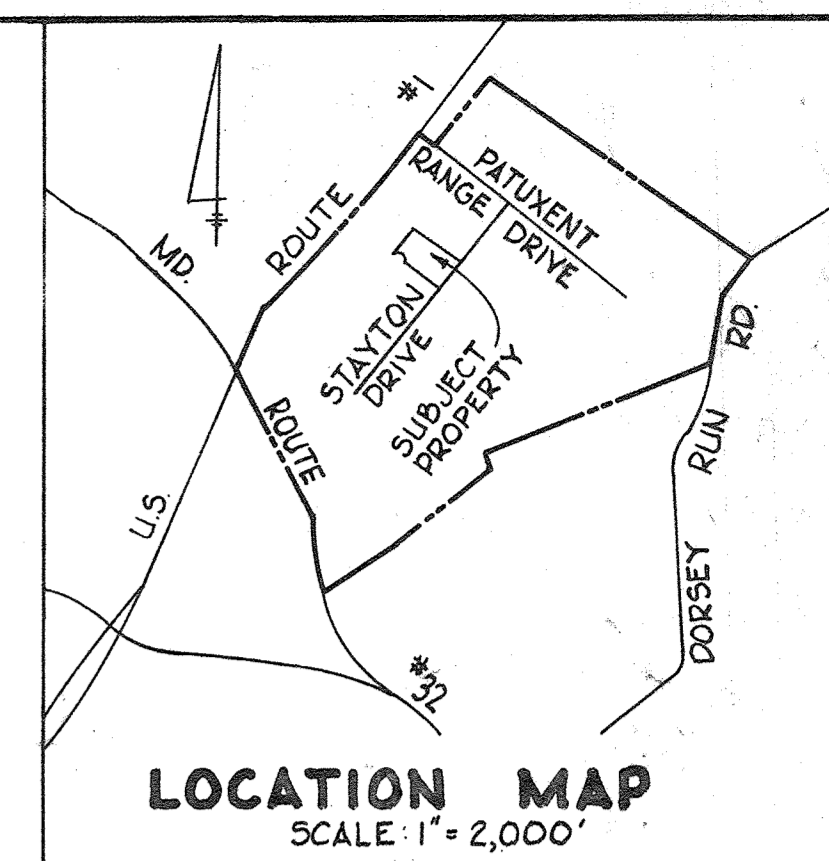


ALL WORK ON 42" R.C.C.P. AND DRAINAGE DITCH IN REAR OF BLDG. COMPLETED IN NOV., 1971

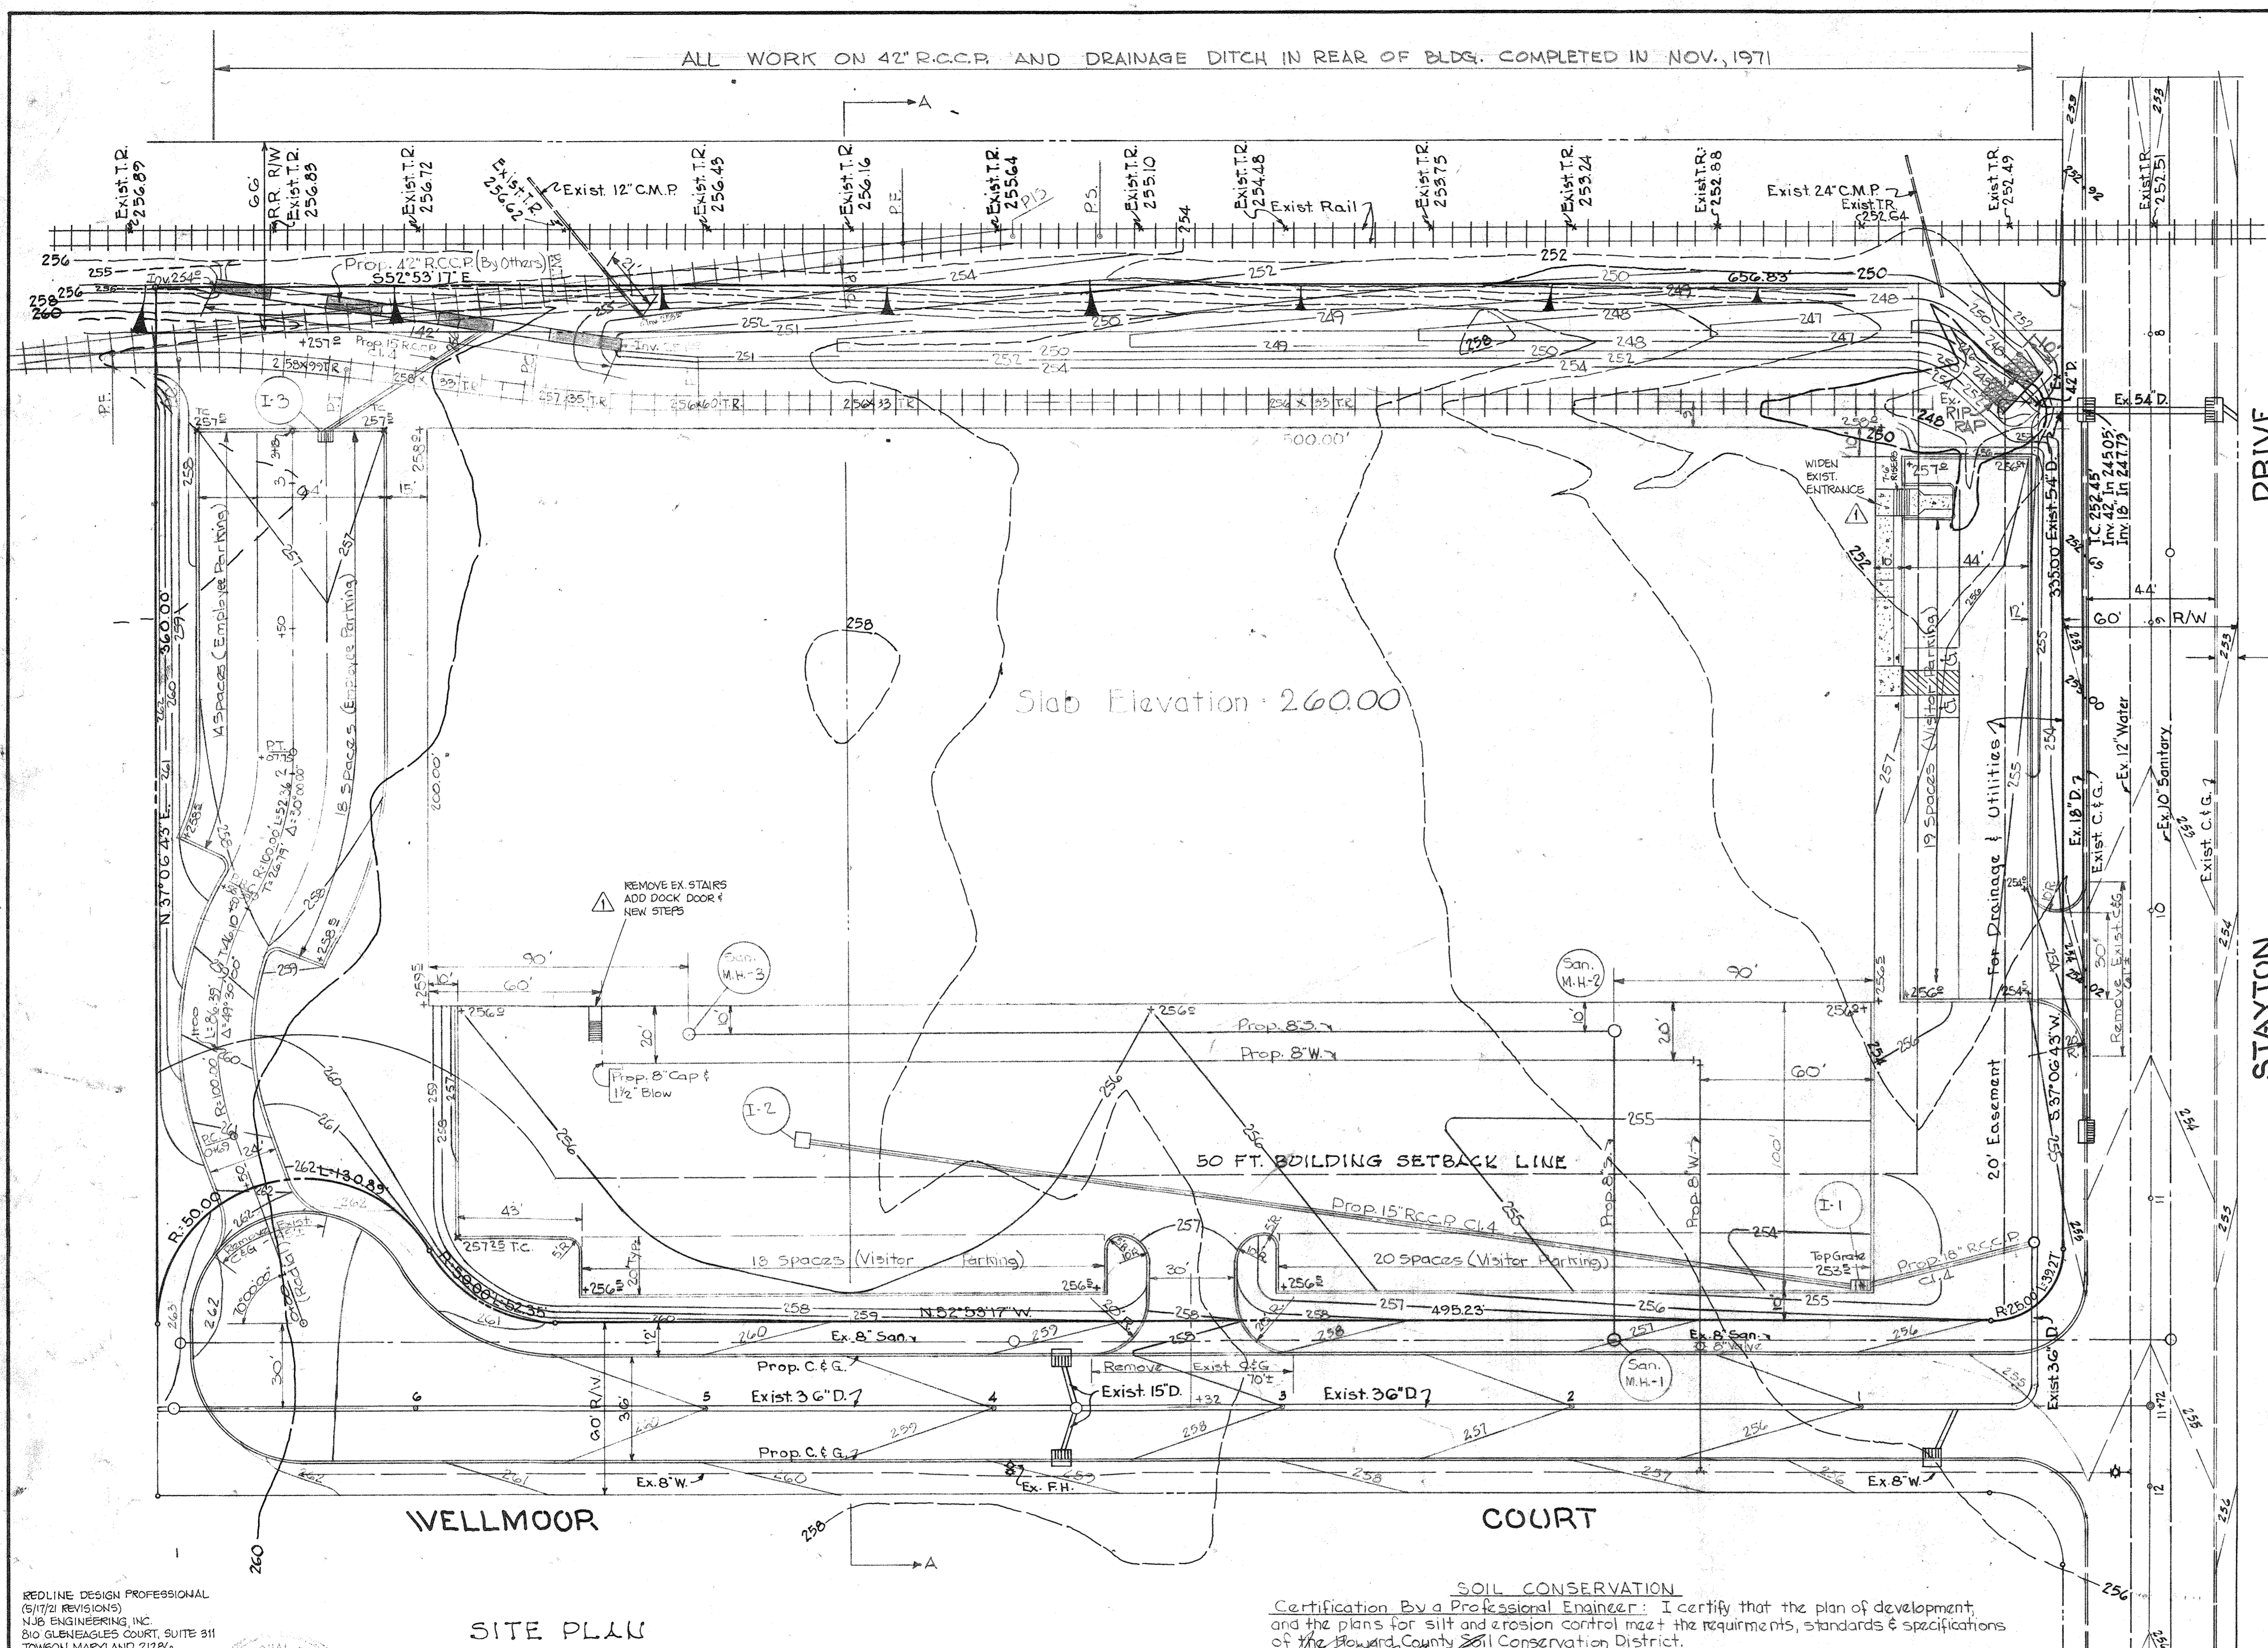

SCHEDULE OF CONSTRUCTION FOR EROSION CONTROL

- 1) Contractor to notify the Howard County Soil Conservation District Office (Phone 465-3180) 24 hours before starting work on this project.
- 2) All areas to be paved, to have base course material and storm drain systems installed as soon as possible.
- 3) All slope areas to be sodded as soon as possible after grading.

APPROVED
 DIVISION OF PLANNING AND DEVELOPMENT
 AND PUBLIC PLANNING
 HOWARD COUNTY, MARYLAND
 DATE JAN 14 1972

J.H. Clowry

SEDIMENT CONTROL PLAN
 RAIL SPEC BLDG #1
 SECTION ONE BLOCK 'B' PARCEL 'B'
 BALTIMORE WASHINGTON INDUSTRIAL PARK
 HOWARD CO, MD
 SCALE: 1" = 30'
 ELECTION DIST. #2
 DATE: JULY 2, 1971

OWNER & DEVELOPER
 PATAPSCO PROPERTIES INC.
 501 ST. PAUL STREET
 BALTIMORE, MARYLAND 21202

ENGINEERS
 AND ASSOCIATES, INC.
 303 ALLEGHENY AVE.
 TOWSON 4, MARYLAND

SOIL CONSERVATION
 Certification By a Professional Engineer: I certify that the plan of development and the plans for silt and erosion control meet the requirements, standards & specifications of the Howard County Soil Conservation District.
 Signature: *John Hochstadt* 4407 P.E. # 4407 Date: 1/6/72

Certification By The Developer: I certify that all development and/or construction will be done according to this plan of development and plan of silt and sediment control.
 By: *John Hochstadt* President PatapSCO Properties

Howard County Soil Conservation District: This development plan is approved for soil erosion and sediment control by Howard County Soil Conservation District.
 District Conservationist: *John Hochstadt* Date: 1-12-72
Walter A. Dove Date: 1-13-72
 Howard Soil Conservation District

SITE PLAN

Total Area Of Tract 533 Ac ±
 Existing Zoning M-2
 Total Floor Area 100,000 F ±
 Tax Map No 4B
 Parking Spaces Provided 89
 Parking Spaces Provided For Employees @ 2 / Space = 32
 Total Sales Area None @ Present

REVISION	DATE
1	5/17/71
2	
3	
John Hochstadt 7-30-71
 Reg. No 4407 P.E. DATE

REDLINE DESIGN PROFESSIONAL
 (5/17/71 REVISIONS)
 NLS ENGINEERING, INC.
 810 GLENEAGLES COURT, SUITE 311
 TOWSON, MARYLAND 21286
 (410) 832-7691

NICHOLAS J. BRADER III
 PROFESSIONAL ENGINEER
 MD LIC # 10558

