
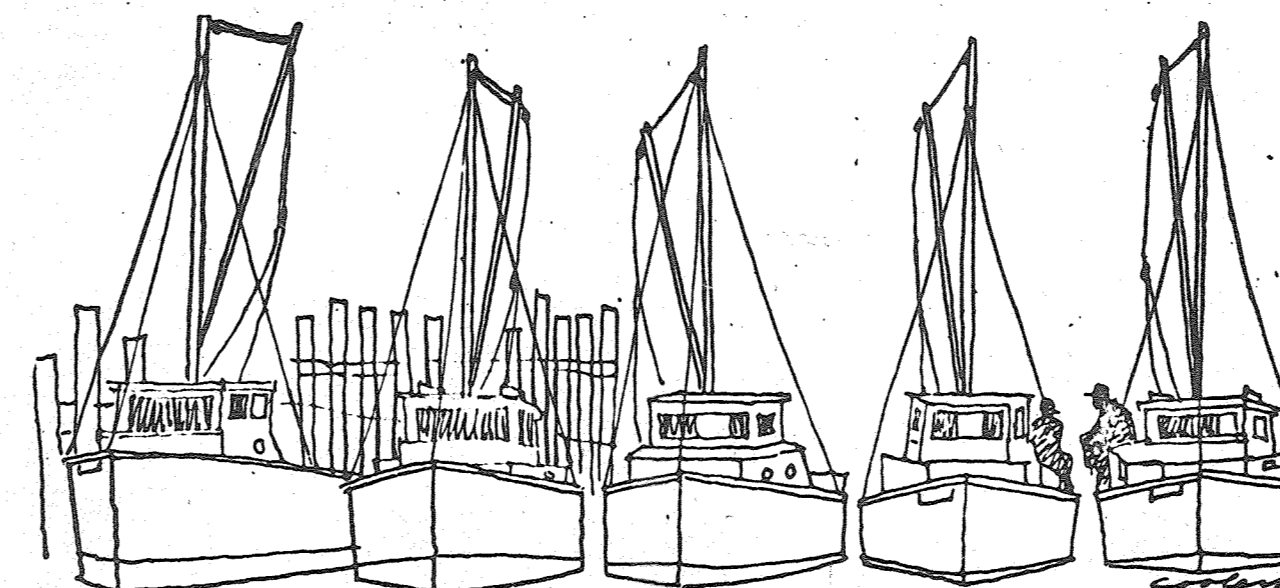



VICINITY MAP  
SCALE 1" = 2000'

LIST OF DRAWINGS

SHEET NO.	TITLE
S-1	COVER SHEET
S-2	SITE & GRADING PLAN
S-3	SITE & GRADING PLAN
S-4	SITE IMPROVEMENT DETAILS
S-5	BUILDING LOCATION PLAN
S-6	BUILDING LOCATION PLAN
S-7	DRIVEWAY PROFILES
S-8	STORM DRAIN PROFILES
SCS-1	SEDIMENT CONTROL PLAN
SCS-2	SEDIMENT CONTROL PLAN
SCS-3	SEDIMENT CONTROL PLAN
SCS-4	SEDIMENT CONTROL PLAN

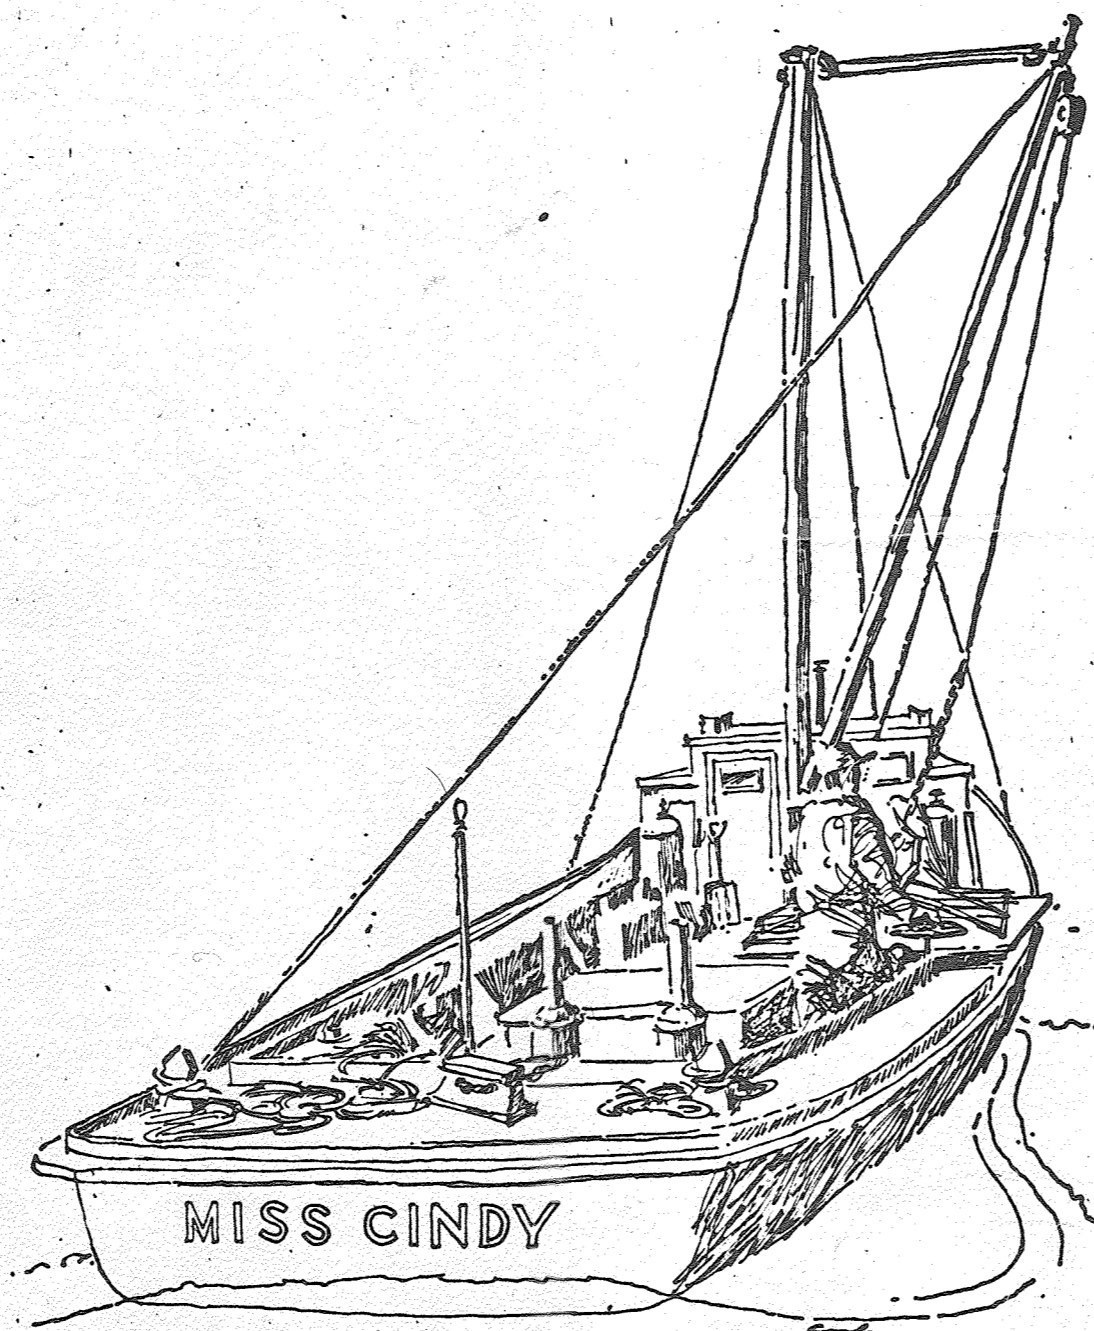

Oyster tonging on the Chesapeake Bay at the peak of the winter season seems as ageless—and as ingrained in Maryland folklore—as the Eastern Shore itself.

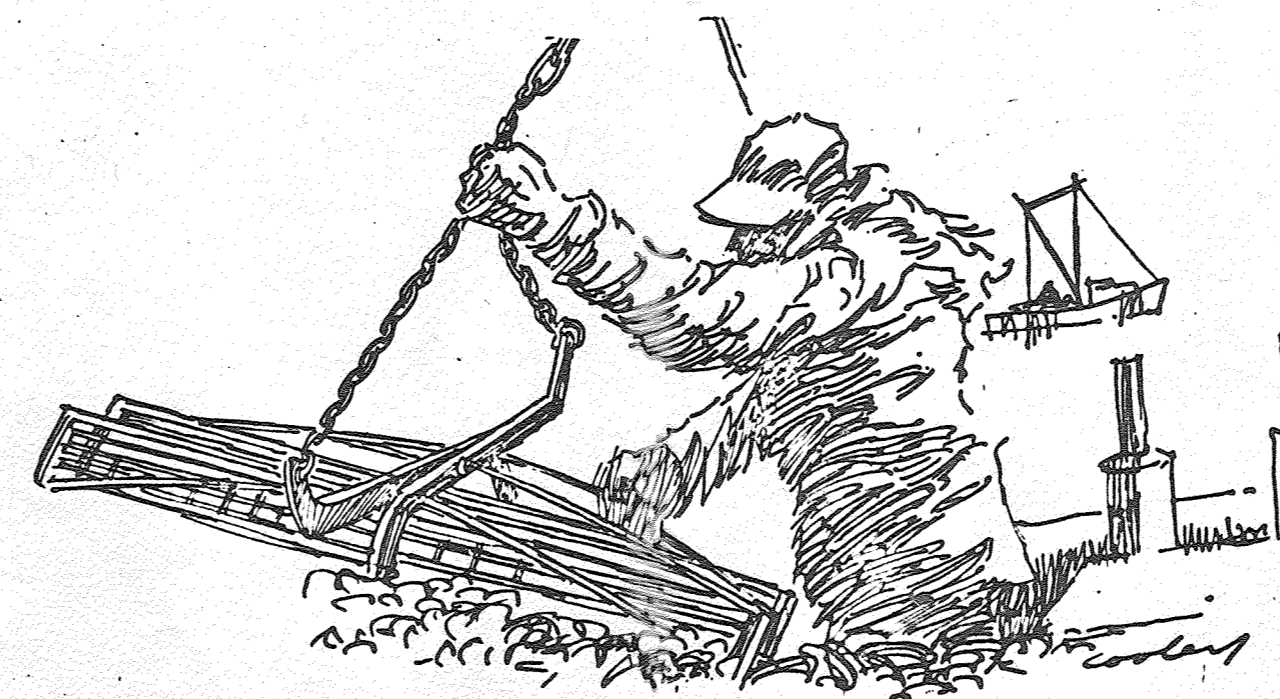

ON MAY 21, 2021 THE DIRECTOR OF THE DEPARTMENT OF PLANNING AND ZONING APPROVED THE ALTERNATIVE COMPLIANCE (NDP-21-121) SUBJECT TO THE FOLLOWING CONDITIONS:

1. ALL DISTURBED AREAS WITHIN THE STREAM, STREAM BANK BUFFER AND 100-YEAR FLOODPLAIN SHALL BE STABILIZED, SEEDING AND/OR PLANTED AFTER CONSTRUCTION IS COMPLETE. THE SITE DEVELOPMENT PLAN, SDP-72-084, SHALL BE REVISED TO INCLUDE ALL REQUIRED STABILIZATION, SEEDING AND PLANTING DETAILS FOR THE PROPOSED PROJECT. THE DISTURBED AREAS WITHIN THE STREAM BUFFER SHALL BE REPLANTED AT A RATE OF AT LEAST 100 TREES PER ACRE.

2. THE APPLICANT SHALL OBTAIN ALL REQUIRED AUTHORIZATIONS AND PERMITS FROM THE MARYLAND DEPARTMENT OF THE ENVIRONMENT (MDE) AND THE U.S. ARMY CORPS OF ENGINEERS FOR DISTURBANCES WITHIN THE STREAM AND FLOODPLAIN. THE APPLICANT SHALL COORDINATE WITH MDE TO REVISE THE EXISTING AUTHORIZATION (2019G113 (19-NF-3160)) TO BE CONSISTENT WITH THE STREAM BANK AND FLOODPLAIN IMPACTS AS SHOWN ON THE ALTERNATIVE COMPLIANCE PLAN EXHIBIT AND SDP-72-084. REFERENCE THE MDE AUTHORIZATION NUMBERS ON SDP-72-084 AND PROVIDE COPIES OF THE APPROVED MDE AUTHORIZATIONS WITH THE GRADING PERMIT APPLICATION.

SHEET NO.	TITLE
S-9	RETAINING WALL REPLACEMENT
S-10	RETAINING WALL REPLACEMENT EXISTING
S-11	PROPOSED RETAINING WALL SITE PLAN
S-12	PROPOSED RETAINING WALL SEDIMENT AND EROSION CONTROL PLAN
S-13	PROPOSED RETAINING WALL SEDIMENT AND EROSION CONTROL NOTES & DETAILS
S-14	PROPOSED RETAINING WALL SEDIMENT AND EROSION CONTROL NOTES & DETAILS
S-15	EXISTING PROPOSED RETAINING WALL
S-16	EXISTING PROPOSED RETAINING WALL
S-17	EXISTING PROPOSED RETAINING WALL
S-18	EXISTING PROPOSED RETAINING WALL
S-19	EXISTING PROPOSED RETAINING WALL
S-20	STREAM STABILIZATION GABION WALL - A, SECTIONS & ELEVATIONS
S-21	STREAM STABILIZATION GABION WALL - B, SECTIONS & ELEVATIONS
S-22	STREAM RESTORATION PLANTING PLAN
S-23	STREAM RESTORATION PLANTING NOTES
S-24	STREAM STABILIZATION EROSION & SEDIMENT CONTROL PLAN
S-25	STREAM STABILIZATION EROSION & SEDIMENT CONTROL ENLARGEMENT
S-26	STREAM STABILIZATION EROSION & SEDIMENT CONTROL NOTES & DETAILS
S-27	STREAM STABILIZATION EROSION & SEDIMENT CONTROL NOTES & DETAILS
S-28	STREAM STABILIZATION EROSION & SEDIMENT CONTROL NOTES & DETAILS
S-29	STREAM STABILIZATION EROSION & SEDIMENT CONTROL NOTES & DETAILS


SECTION TWO

WHISKEY BOTTOM

APARTMENTS

SIXTH ELECTION DISTRICT, HOWARD COUNTY, MARYLAND


PROFESSIONAL CERTIFICATION  
I HEREBY CERTIFY THAT THESE DOCUMENTS WERE PREPARED OR APPROVED BY ME, AND THAT I AM A FULLY LICENSED PROFESSIONAL ENGINEER UNDER THE LAWS OF THE STATE OF MARYLAND, LICENSE NO. 11124, EXPIRATION DATE: OCTOBER 3, 2022.

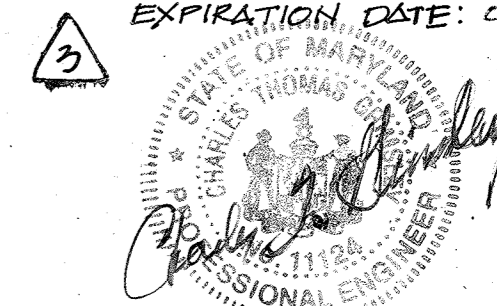


<p>HOWARD COUNTY HEALTH DEPT. PUBLIC WATER AND SEWER SYSTEMS APPROVED _____ COUNTY HEALTH OFFICER</p> <p>HOWARD COUNTY OFFICE OF PLANNING AND ZONING APPROVED _____ DATE 9-14-72 PLANNING DIRECTOR</p> <p>HOWARD COUNTY DEPARTMENT OF PUBLIC WORKS PUBLIC WATER, SEWER, AND STORM DRAINAGE SYSTEMS AND ROADS APPROVED _____ DATE 9/17/72 DIRECTOR</p>	<p>THIS DEVELOPMENT PLAN IS APPROVED FOR SOIL EROSION AND SEDIMENT CONTROL BY THE HOWARD SOIL CONSERVATION DISTRICT.</p> <p>REVIEWED: 9-1-72 DATE</p> <p>APPROVED: 9-1-72 DATE</p> <p>HOWARD SOIL CONSERVATION DISTRICT</p>
---	---

APPROVED  
PLANNING BOARD  
OF HOWARD COUNTY  
DATE 6/28/72  
THOMAS J. HARRIS ARCHITECT  
RONALD S. SENSEMAN, FAIA  
7676 NEW HAMPSHIRE AVENUE  
LANGLEY PARK, MD. 20783

LANDMARK ENGINEERING, INC.  
13722 LAMBERTINA PLACE  
ROCKVILLE, MARYLAND 20850  
CONSULTING ENGINEERS PLANNERS SURVEYORS  
PHONE: (301) 230-5881  
FAX: (301) 230-9884  
OWNER AND DEVELOPER  
WHISKEY BOTTOM CONDOMINIUM, INC.  
1720 WISCONSIN AVENUE, N.W.  
WASHINGTON, D.C. 20007

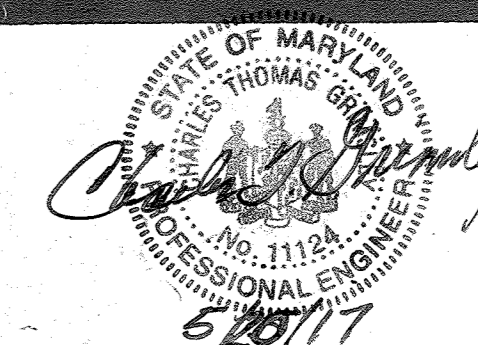

JEROME J. NORRIS AND ASSOCIATES  
LAND PLANNING - HOUSING CONSULTANTS  
6001 32ND STREET, N.W.  
WASHINGTON, D.C. 20015

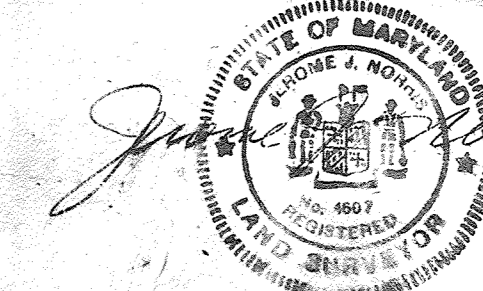


LANDMARK ENGINEERING, INC.  
6110 EXECUTIVE BLVD., STE. 110  
ROCKVILLE, MD. 20852  
PHONE: (301) 230-5881

REVISIONS
2 MAY 20, 2017 - RENUMBERED AND ADDED NEW SHEETS ON LIST OF DRAWINGS
3 MAR. 28, 2022 - RENUMBERED AND ADDED NEW SHEETS ON LIST OF DRAWINGS

SDP-72-84  
SHEET 1 OF 12 47 24

SDP-72-84

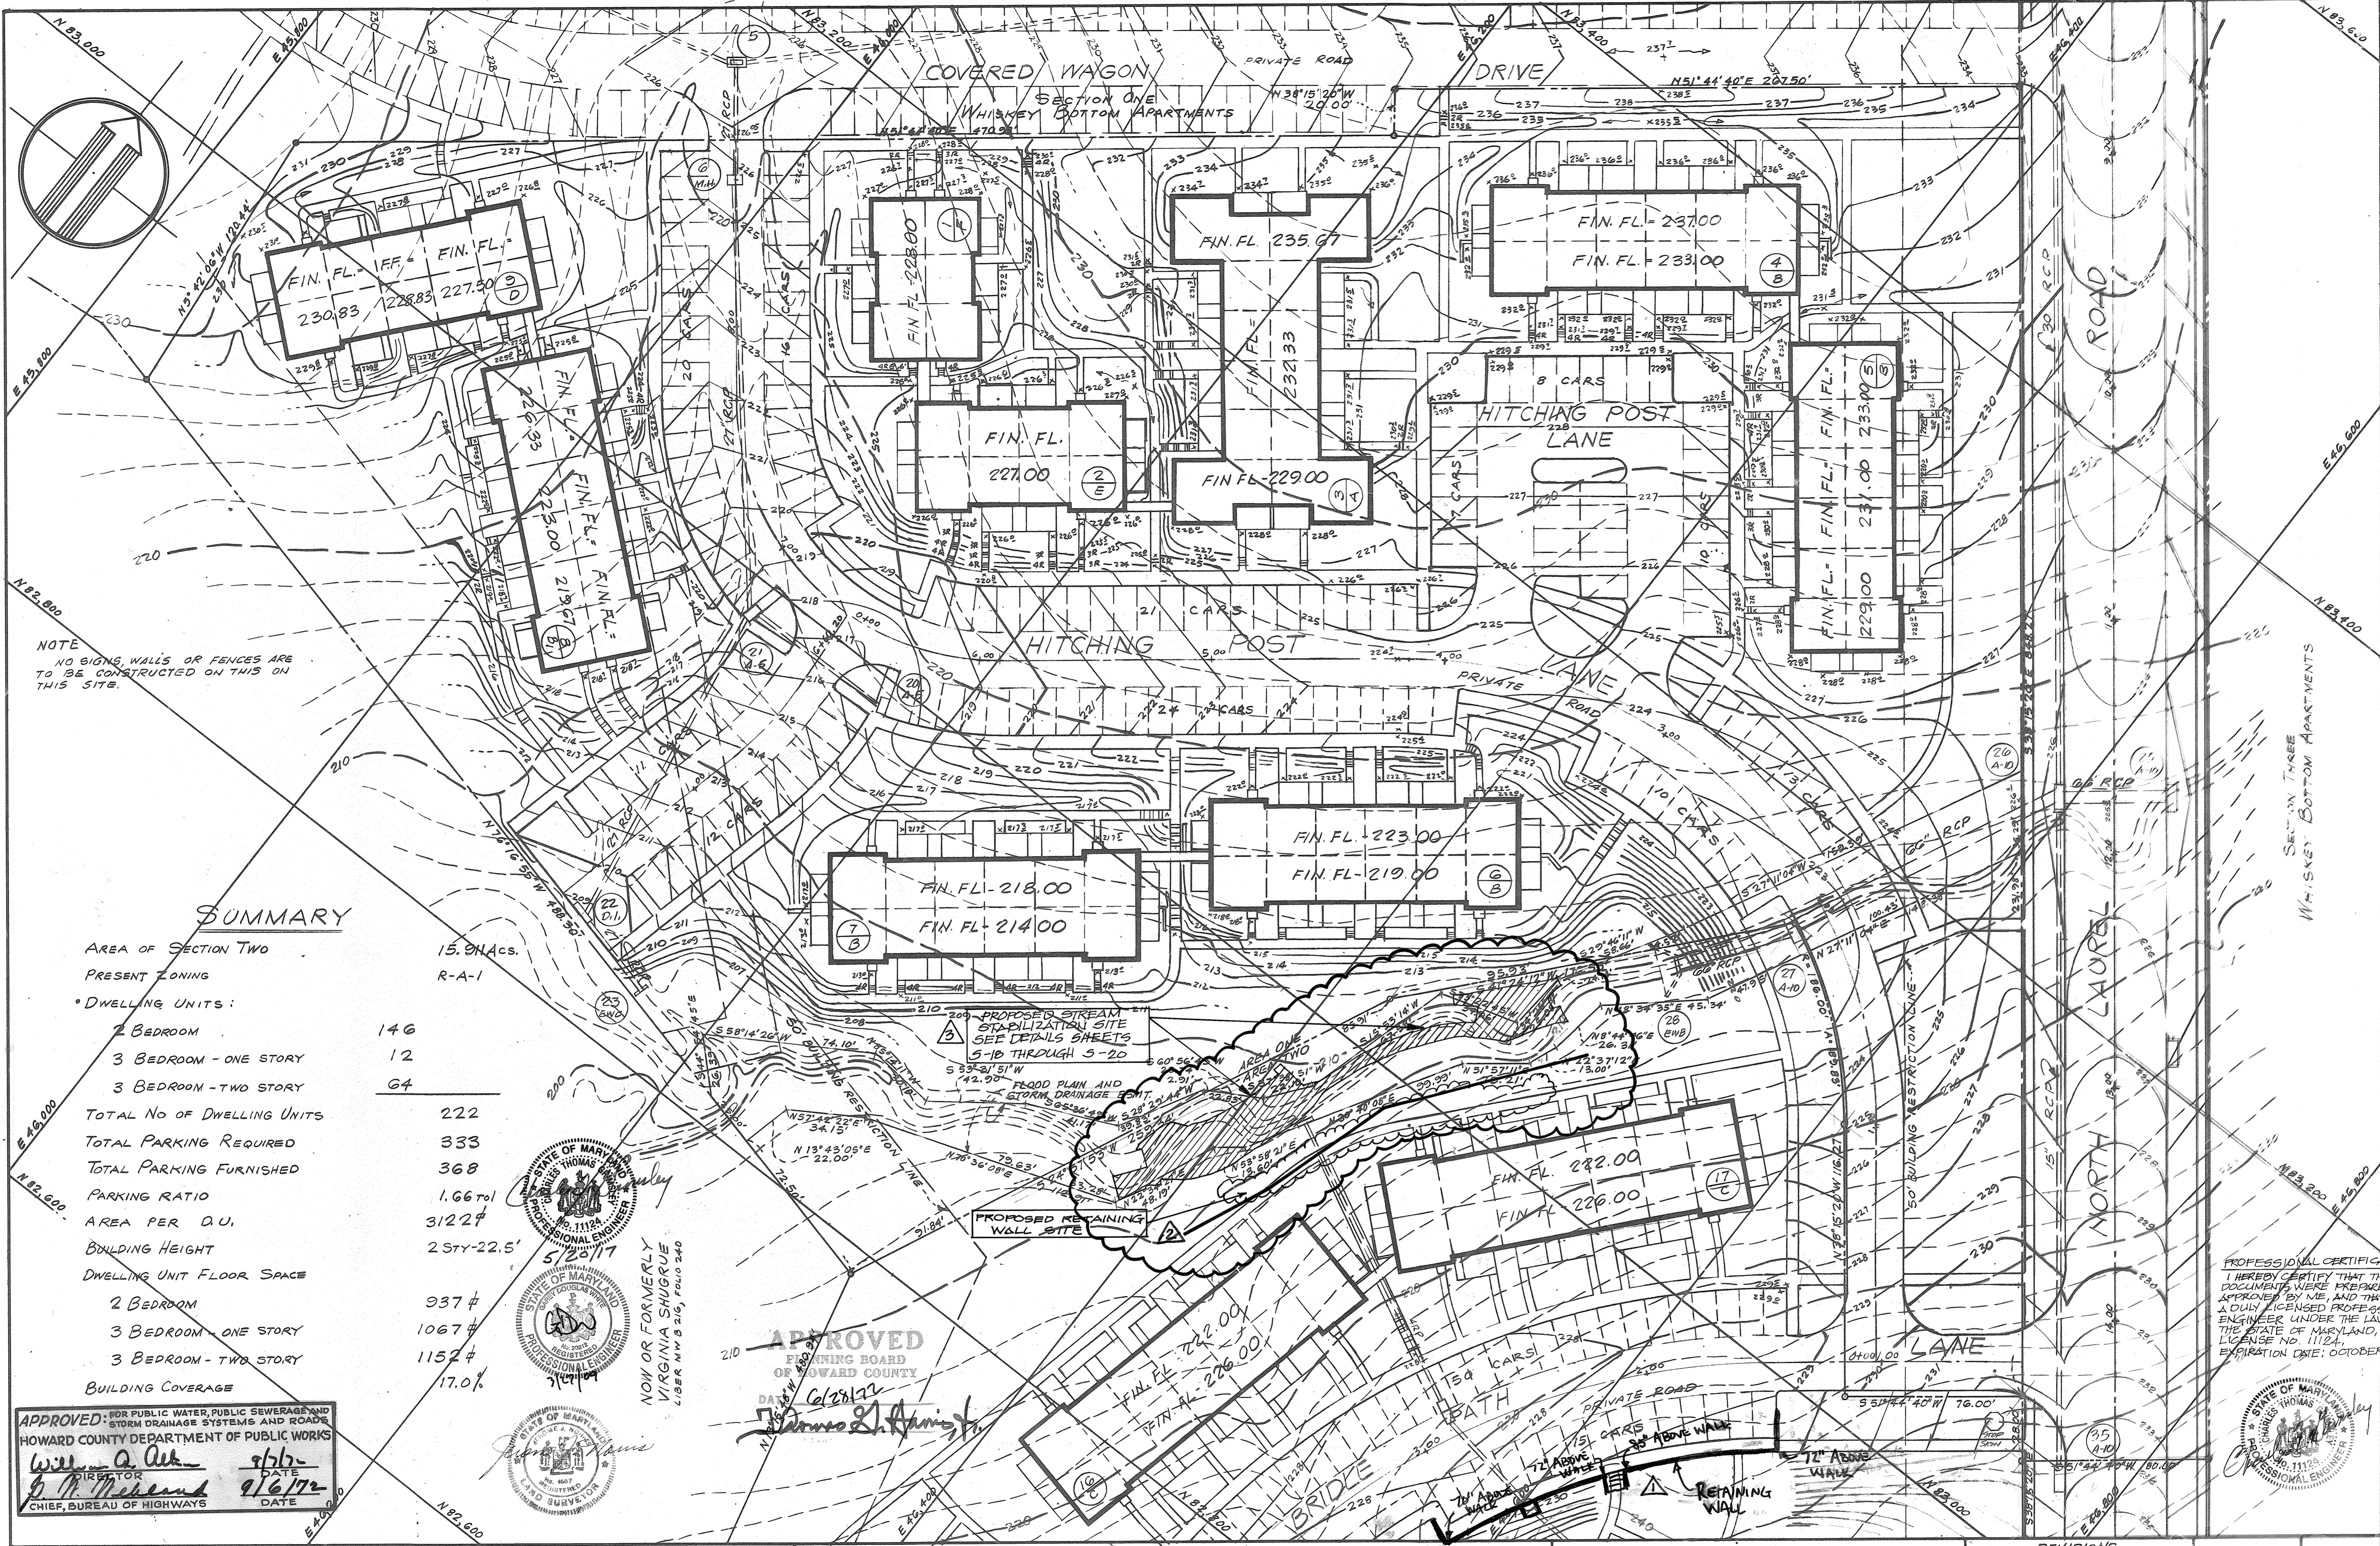


NOTE  
NO SIGNS, WALLS OR FENCES ARE TO BE CONSTRUCTED ON THIS ON THIS SITE.

**SUMMARY**

AREA OF SECTION TWO	15.9 ACs.
PRESENT ZONING	R-A-1
* DWELLING UNITS:	
2 BEDROOM	146
3 BEDROOM - ONE STORY	12
3 BEDROOM - TWO STORY	64
TOTAL NO OF DWELLING UNITS	222
TOTAL PARKING REQUIRED	333
TOTAL PARKING FURNISHED	368
PARKING RATIO	1.66 to 1
AREA PER D.U.	3122 sq ft
BUILDING HEIGHT	2 STY-22.5'
DWELLING UNIT FLOOR SPACE	
2 BEDROOM	937 sq ft
3 BEDROOM - ONE STORY	1067 sq ft
3 BEDROOM - TWO STORY	1152 sq ft
BUILDING COVERAGE	17.0%


**APPROVED**  
PLANNING BOARD OF HOWARD COUNTY  
DATE: 6/28/17  
*Jerome J. Norris*

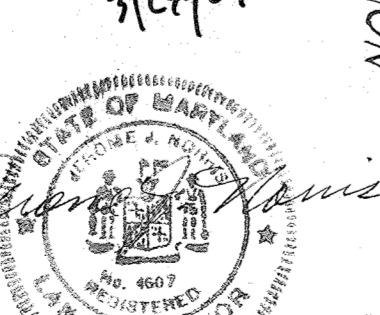

NOW OR FORMERLY  
VIRGINIA SHUGRUE  
LIBER N.W. 210, FOLIO 240

**APPROVED:** FOR PUBLIC WATER, PUBLIC SEWERAGE AND STORM DRAINAGE SYSTEMS AND ROADS  
HOWARD COUNTY DEPARTMENT OF PUBLIC WORKS  
*William A. Aik*  
DIRECTOR  
*John H. Heberland*  
CHIEF, BUREAU OF HIGHWAYS  
DATE: 9/16/17

PROFESSIONAL CERTIFICATION  
I HEREBY CERTIFY THAT THESE DOCUMENTS WERE PREPARED OR APPROVED BY ME, AND THAT I AM A QUALIFIED PROFESSIONAL ENGINEER UNDER THE LAWS OF THE STATE OF MARYLAND, LICENSE NO. 11124, EXPIRATION DATE: OCTOBER 3, 2022

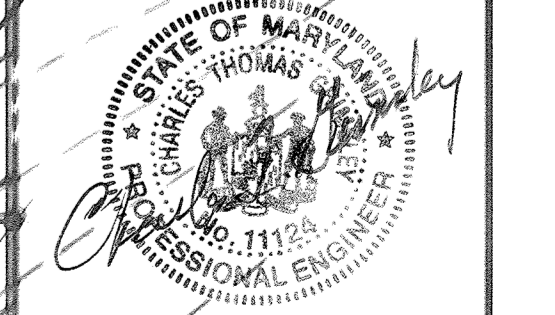

OWNER-DEVELOPER  
WHISKEY BOTTOM CONDOMINIUMS, INC.  
1720 WISCONSIN AVENUE, N.W.  
WASHINGTON, D.C. 20007

JEROME J. NORRIS & ASSOCIATES  
LAND PLANNING - HOUSING CONSULTANTS  
6001 32ND STREET, N.W.  
WASHINGTON, D.C.

**WHISKEY BOTTOM APARTMENTS**  
SIXTH ELECTION DISTRICT  
HOWARD COUNTY MARYLAND

**SECTION TWO**  
SITE & GRADING PLAN

REVISIONS  
1. APRIL 2009 ADD RET. WALL  
2. MAY 20, 2017 ADD PROP RET. WALL SITE  
3. MAR. 20, 2022 - STREAM STABILIZATION

SCALE: 1"=30'  
DRAWING No. 5-2  
DATE: JULY 3, 1972  
OF 12/17 24



APPROVED FOR PUBLIC WATER, PUBLIC SEWERAGE AND STORM DRAINAGE SYSTEMS AND ROADS  
 HOWARD COUNTY DEPARTMENT OF PUBLIC WORKS  
 WILLIAM O. AUSTIN 9/7/72  
 DIRECTOR DATE  
 J. M. NEBEL 9/6/72  
 CHIEF, BUREAU OF HIGHWAYS DATE



APPROVED  
 PLANNING BOARD  
 OF HOWARD COUNTY  
 DATE 6/28/72  
 Thomas G. Harris, Jr.



OWNER-DEVELOPER  
 WHISKEY BOTTOM CONDOMINIUMS, INC.  
 1720 WISCONSIN AVENUE, N.W.  
 WASHINGTON, D.C. 20007

JEROME J. NORRIS & ASSOCIATES  
 LAND PLANNING - HOUSING CONSULTANTS  
 6001 32ND STREET, N.W.  
 WASHINGTON, D.C.













**WHISKEY BOTTOM APARTMENTS**  
 SIXTH ELECTION DISTRICT  
 HOWARD COUNTY MARYLAND

**SECTION TWO**  
**SITE & GRADING PLAN**

REVISIONS	SCALE: 1"=30'	DRAWING No. 5-3
	JULY 3, 1972	of 12 1/2 24

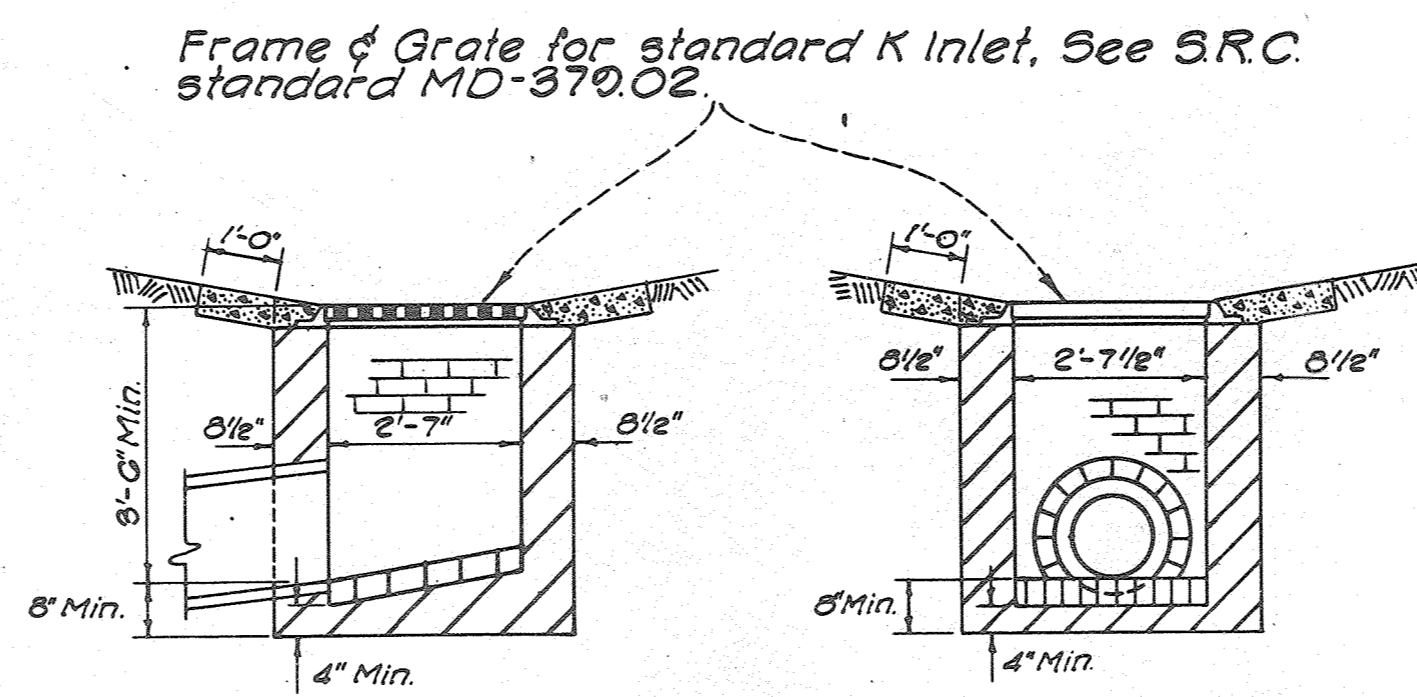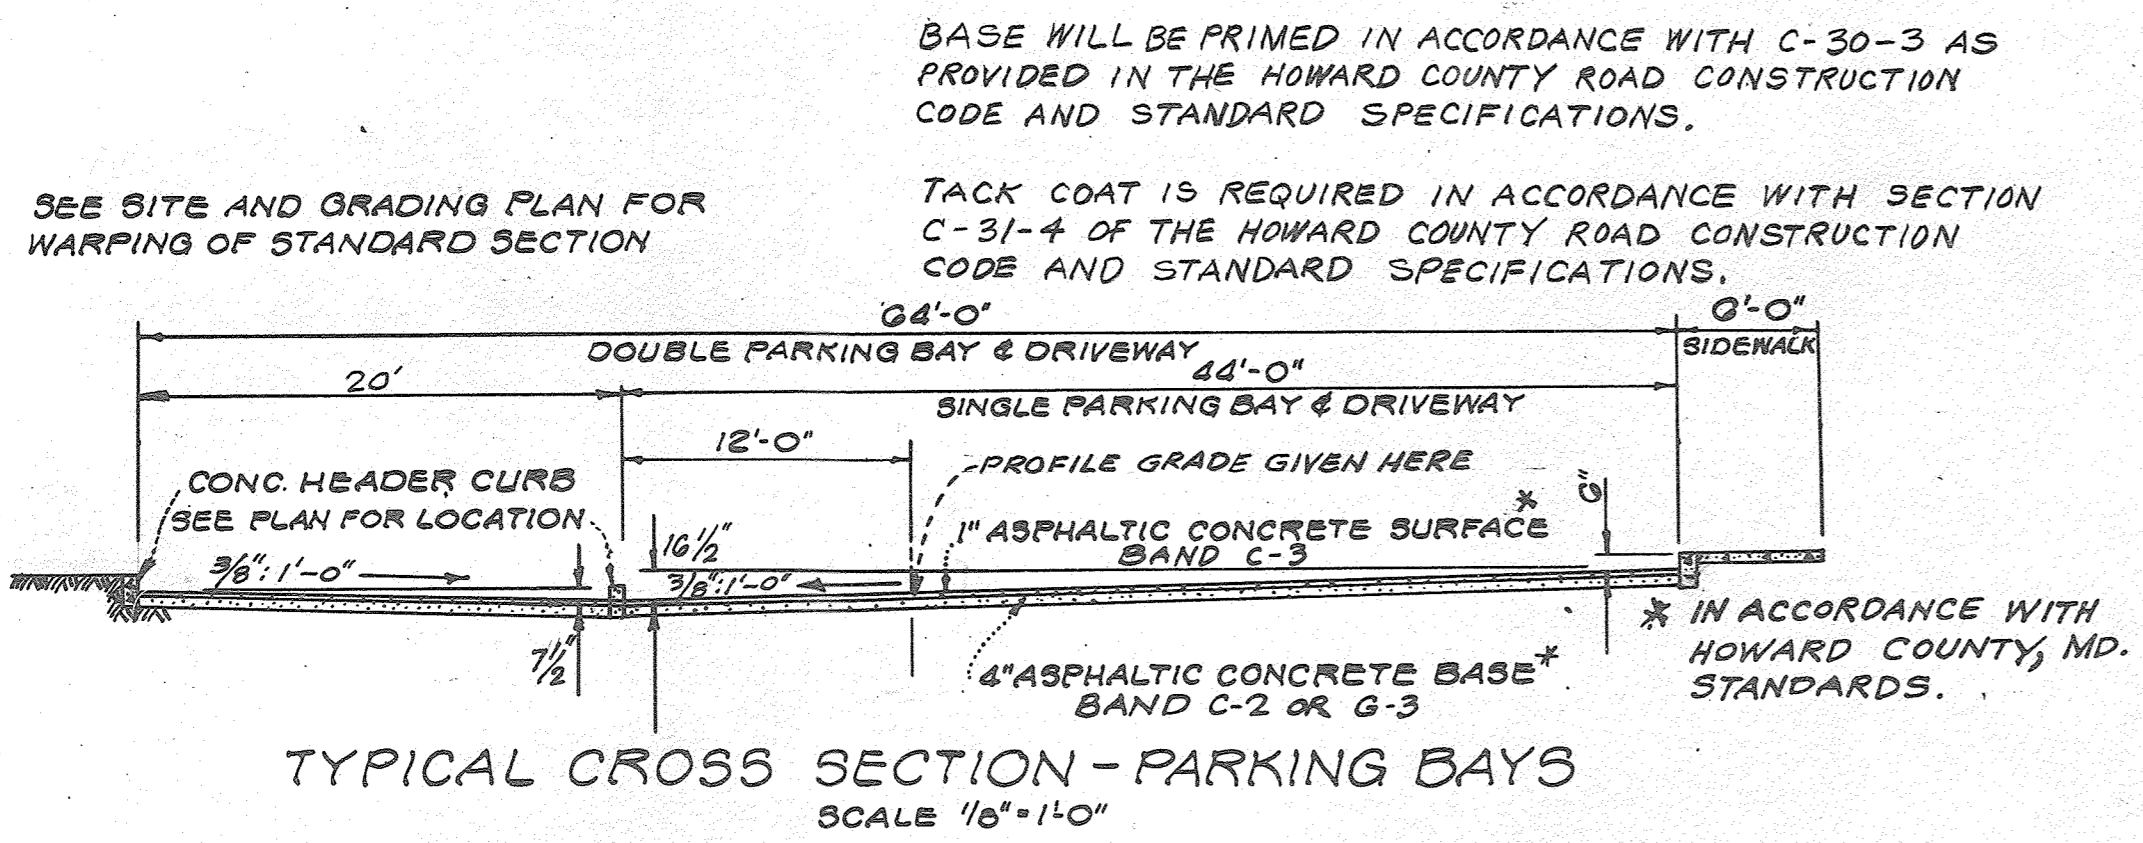

- Inlet may be constructed of standard concrete block or brick. Size, type & direction of inlet connection will vary to suit conditions.
- Top 4" of walls may be brick masonry. Additional brick may be used to bring the grate to grade if required.
- Brick for masonry to comply with latest S.R.C. specifications.
- Invert may be plain concrete or 4" brick laid on edge. Invert to slope down toward outlet at the rate of two (2) inches per foot, or as directed.
- See Md. S.R.C. standard MD-378.01 for information not shown hereon.

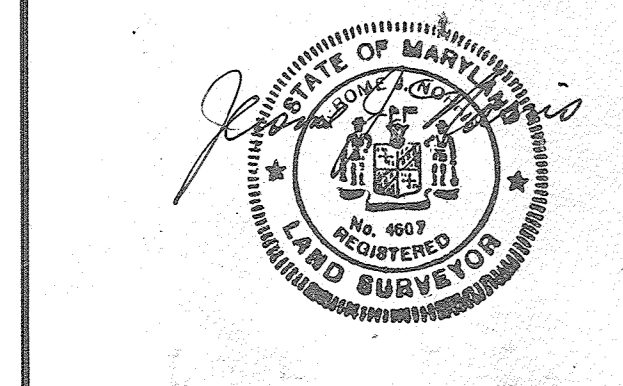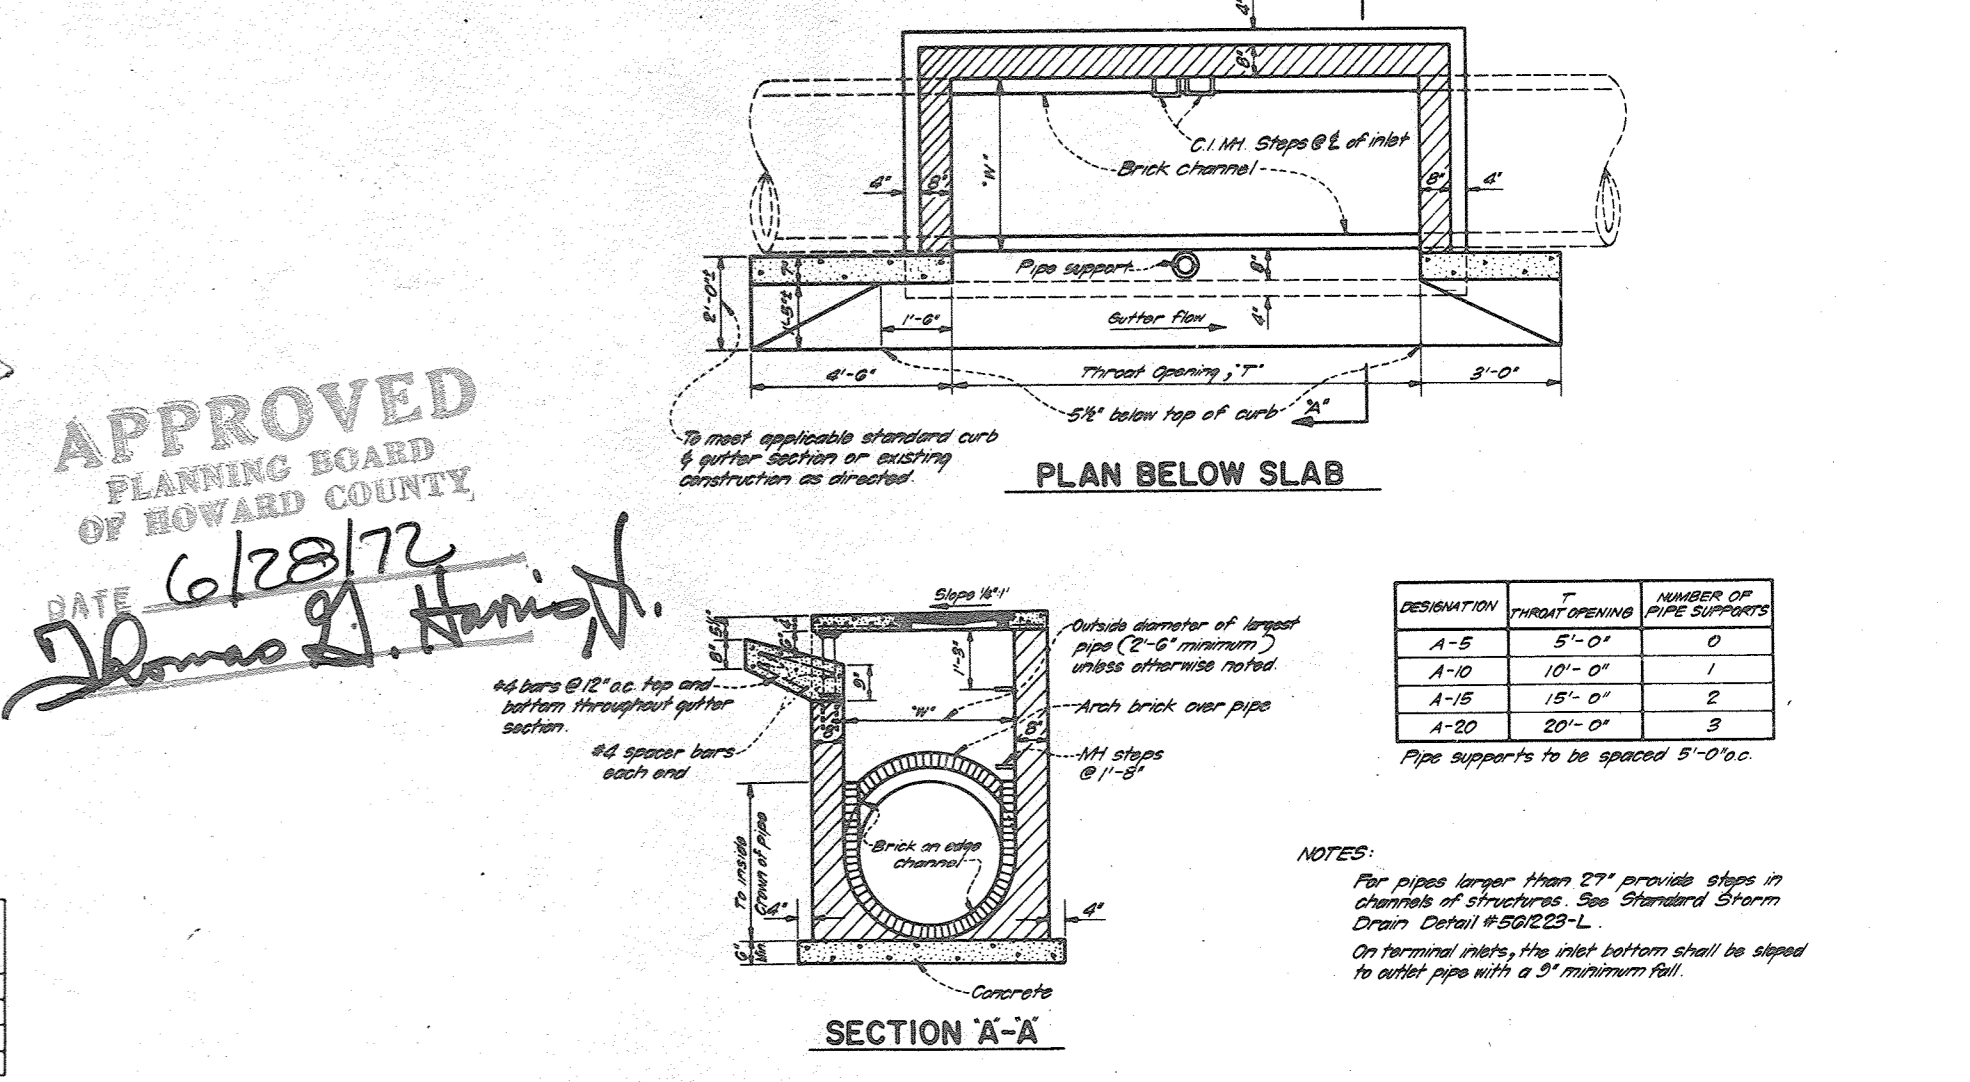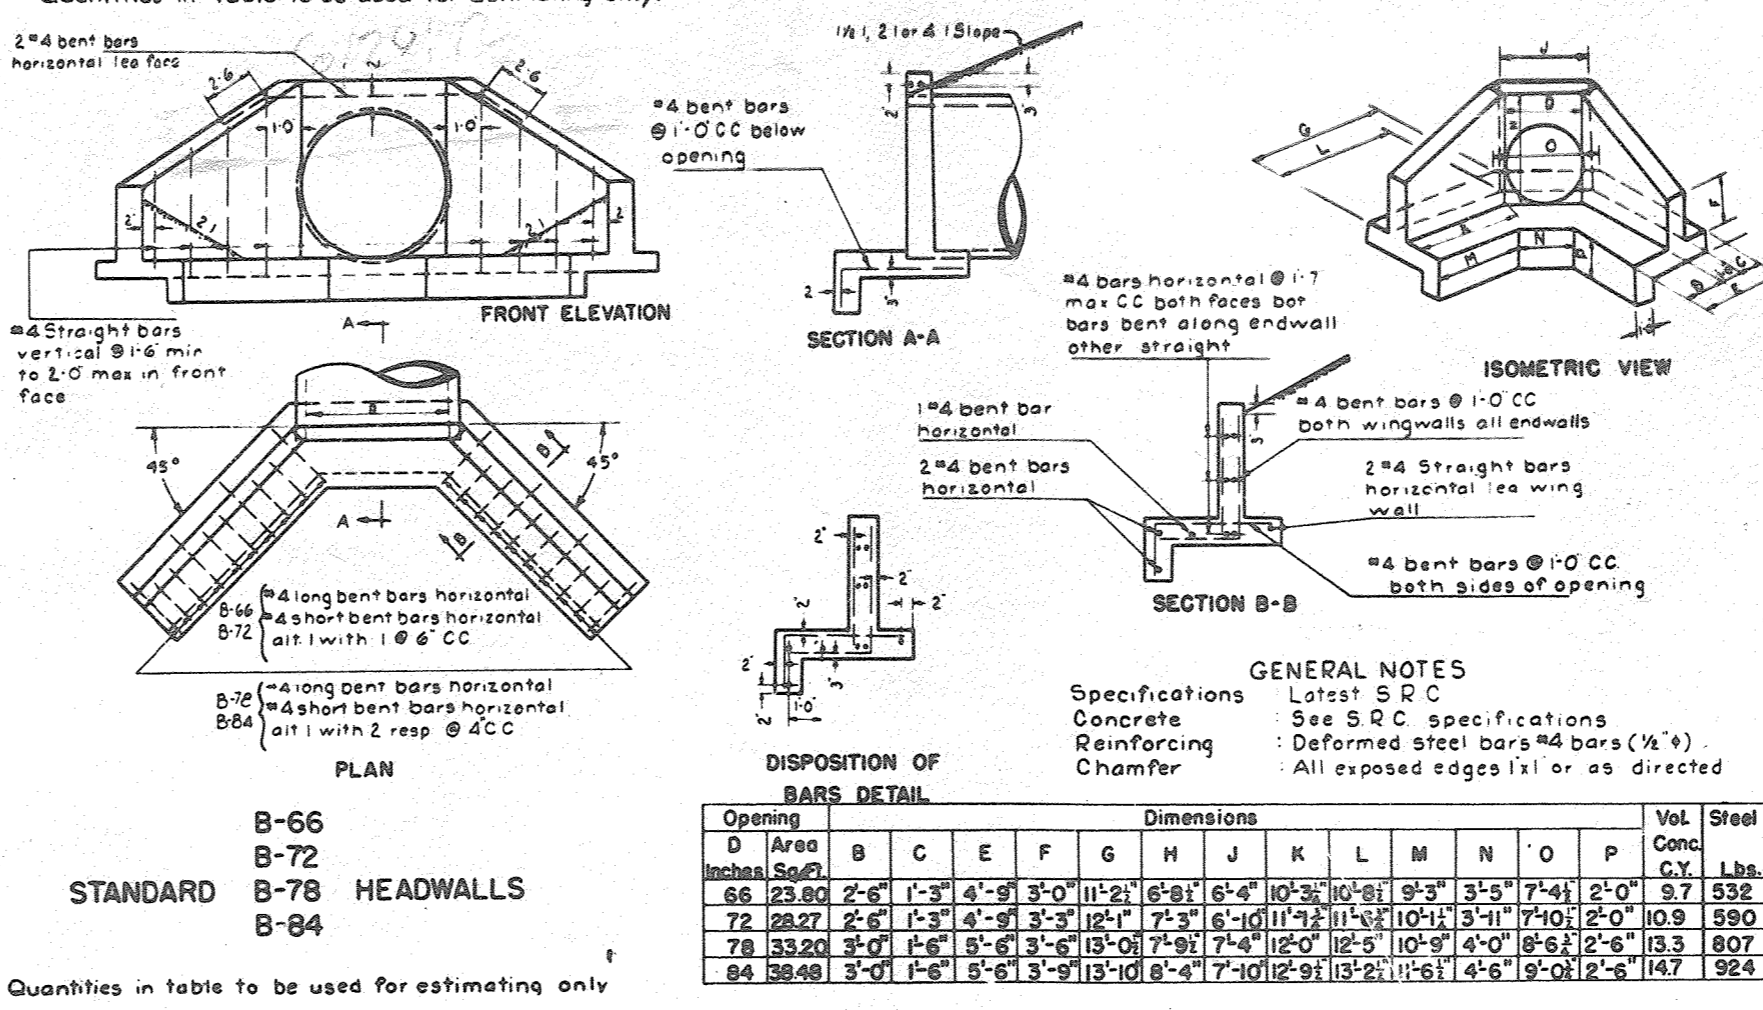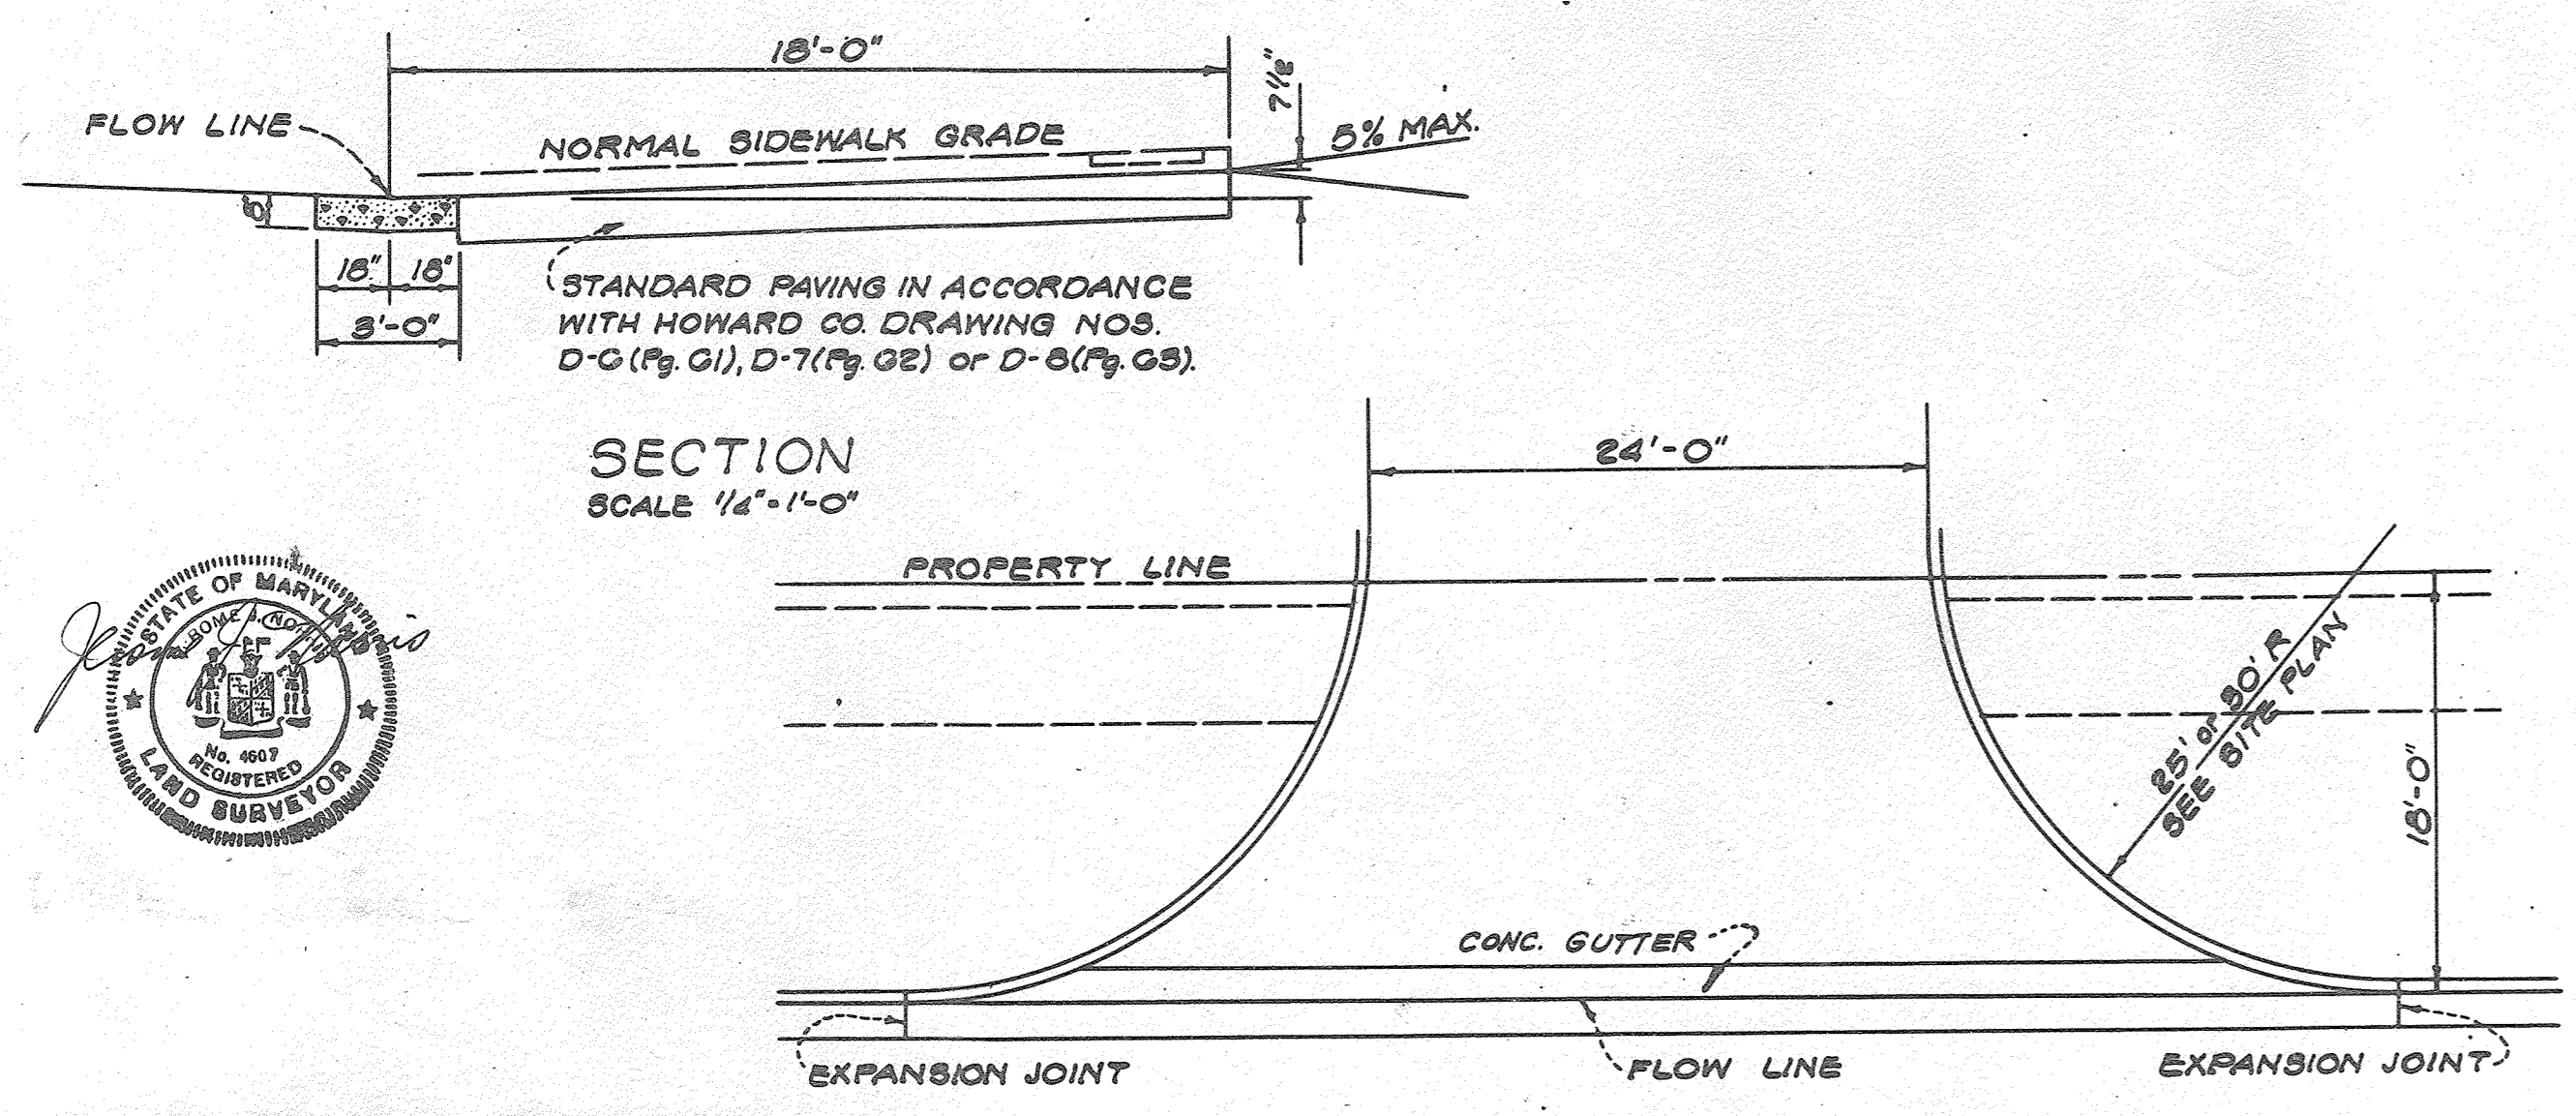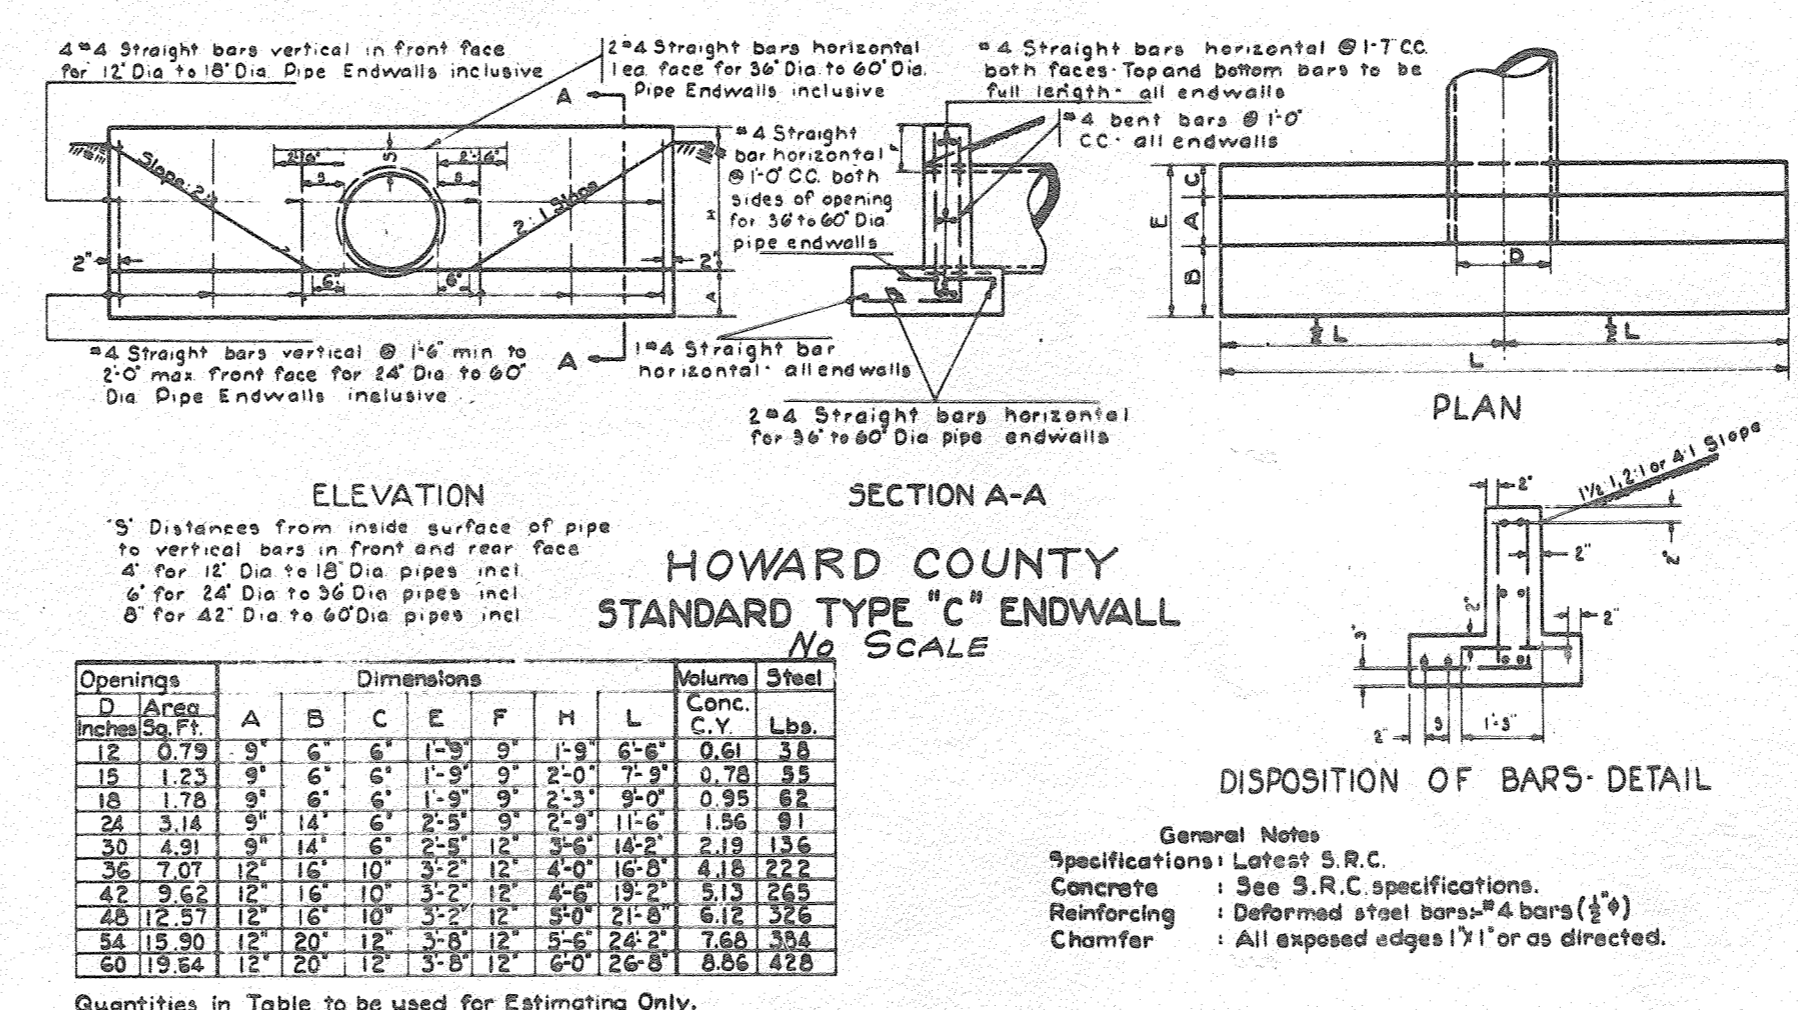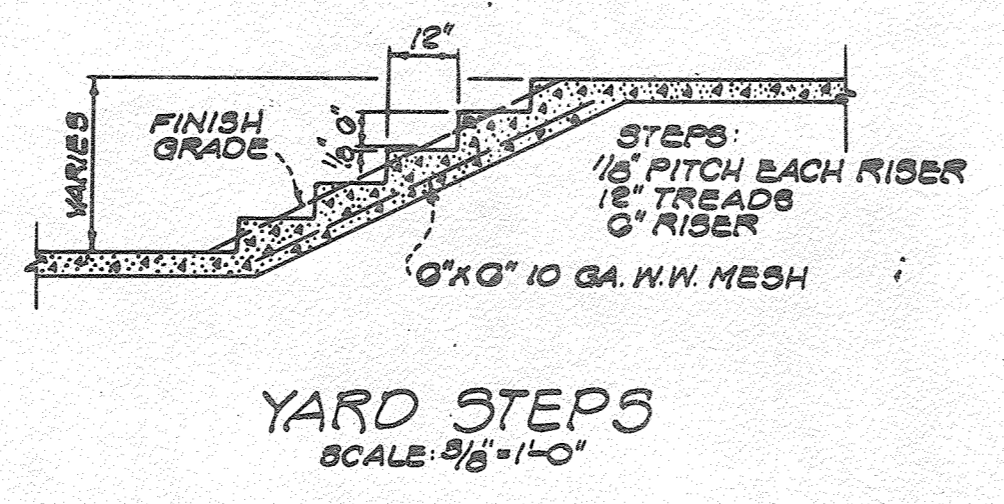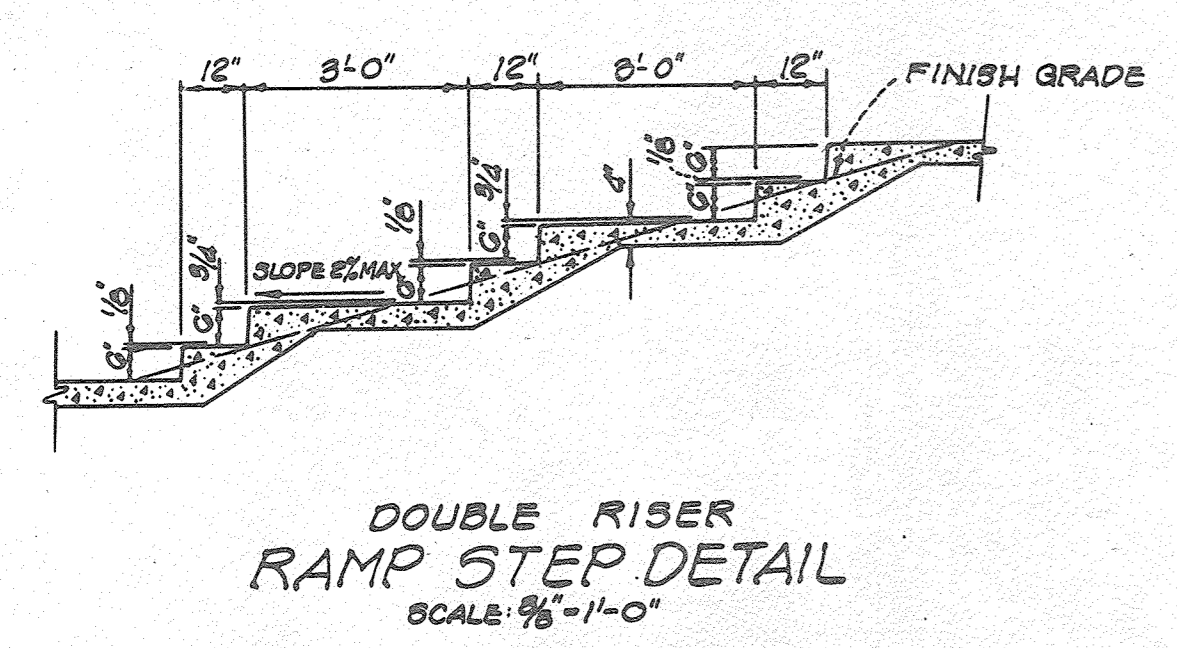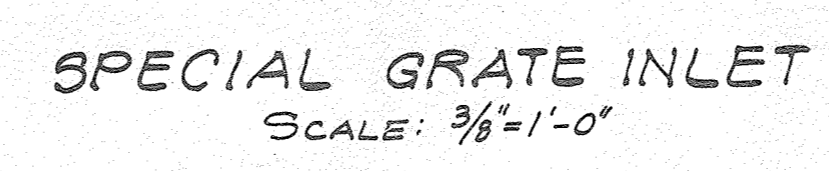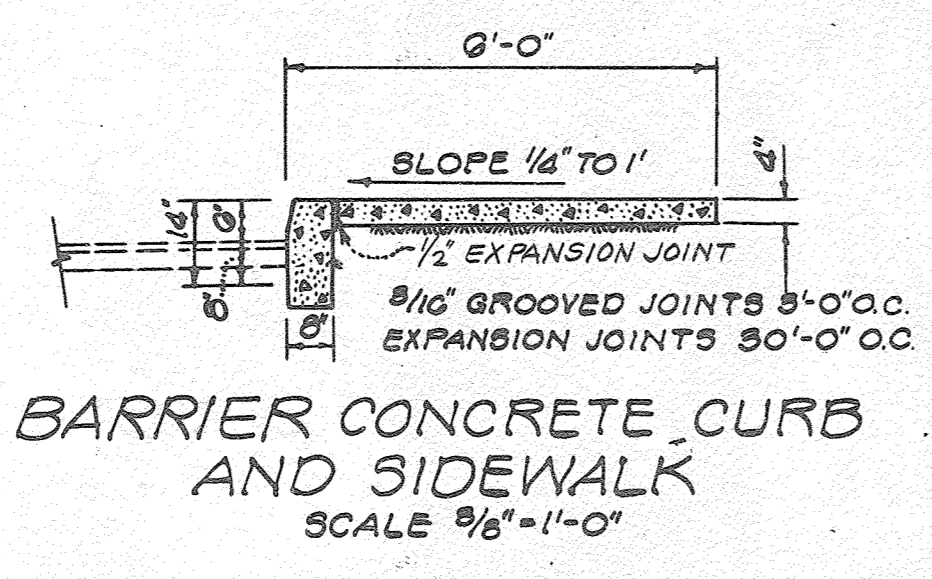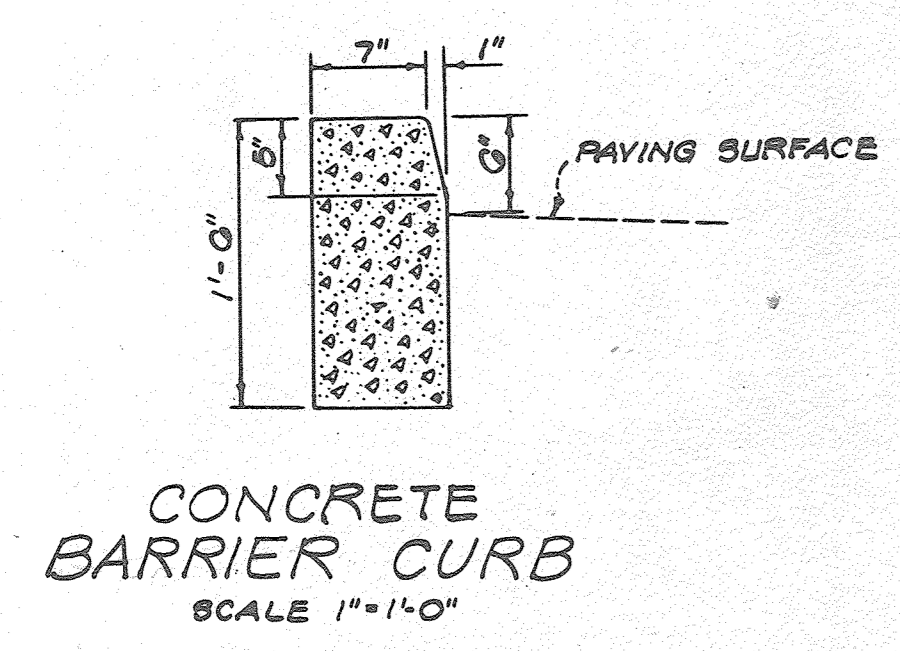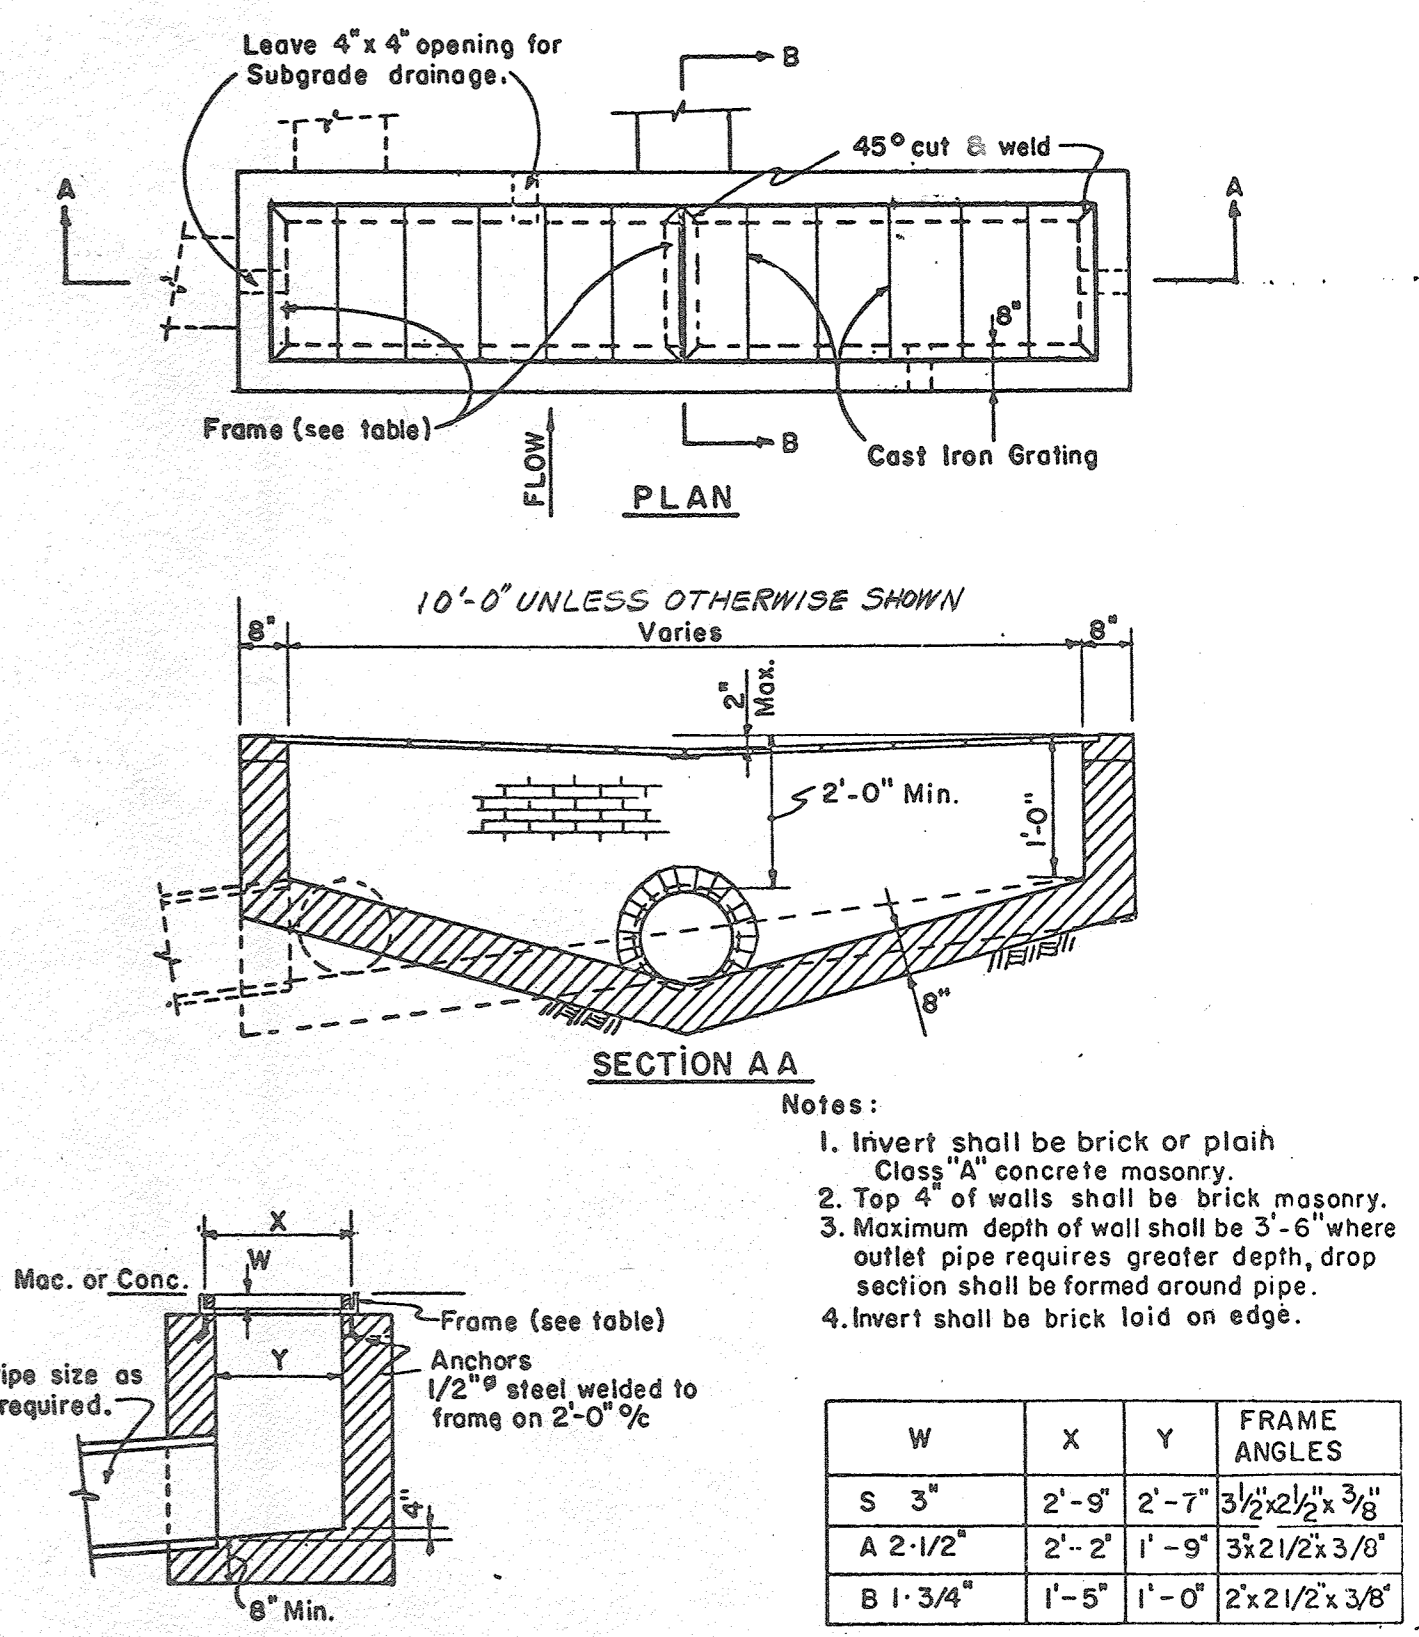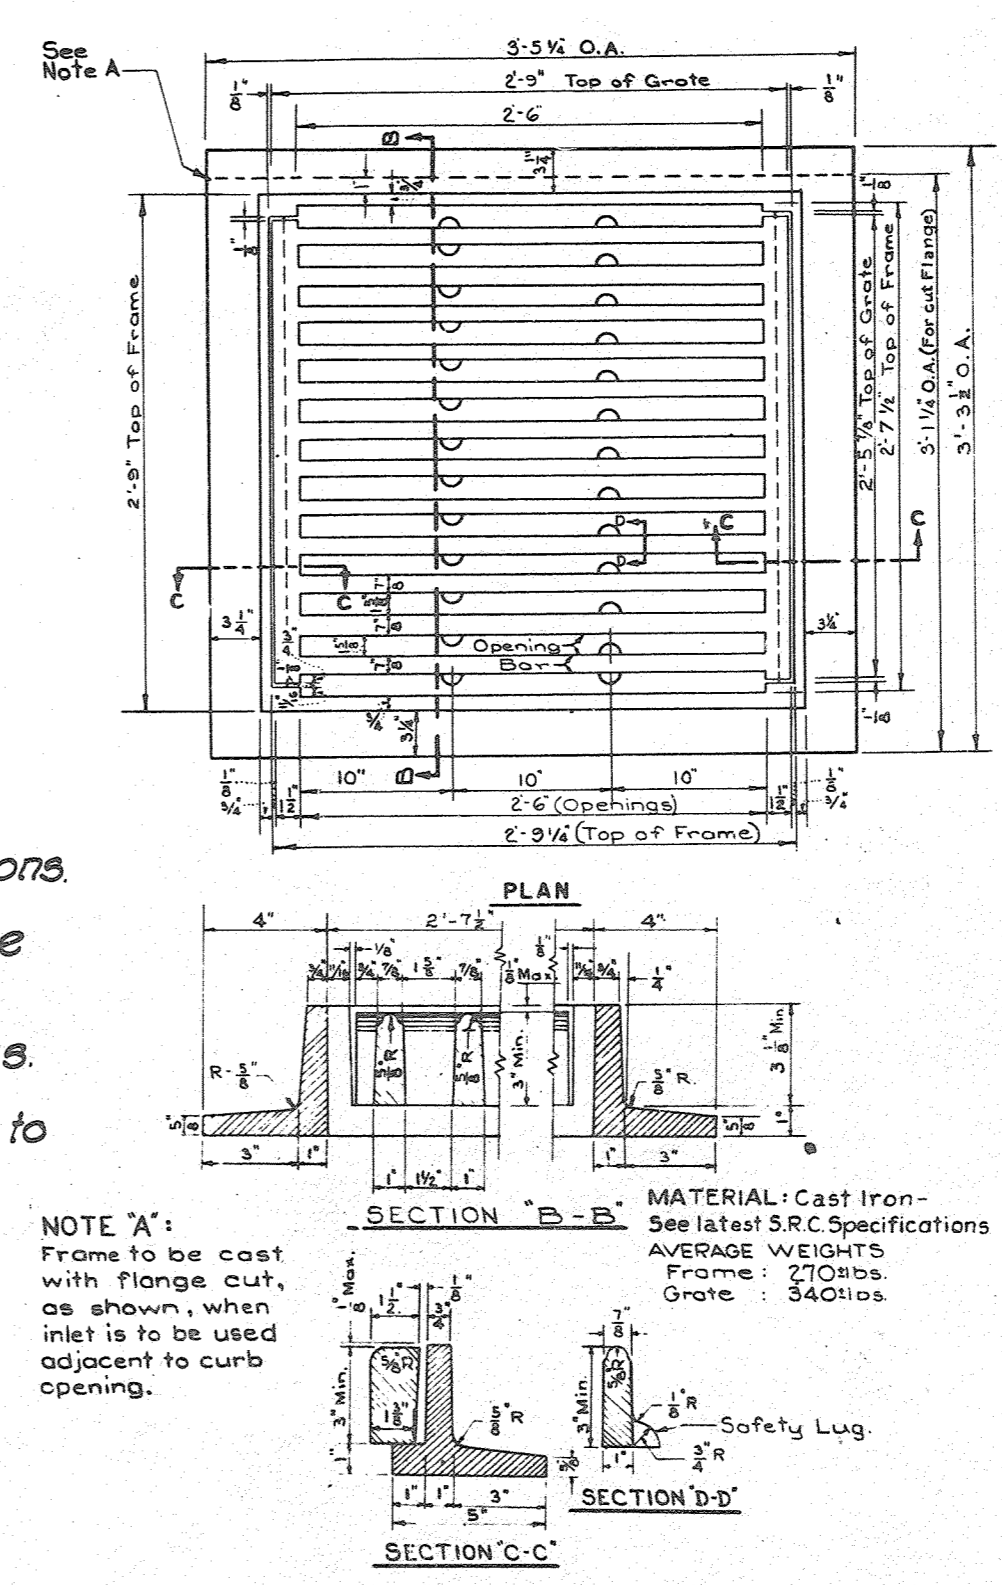

APPROVED FOR PUBLIC WATER, PUBLIC SEWERAGE AND STORM DRAINAGE SYSTEMS AND ROADS  
HOWARD COUNTY DEPARTMENT OF PUBLIC WORKS

Will A. Oates 9/17/72  
D. M. McLeod 9/16/72  
CHIEF, BUREAU OF HIGHWAYS DATE

JEROME J. NORRIS & ASSOCS.  
LAND PLANNING - HOUSING CONSULTANTS  
6001 32<sup>ND</sup> STREET, N.W.  
WASHINGTON, D.C.


**WHISKEY BOTTOM APARTMENTS**  
SIXTH ELECTION DISTRICT  
HOWARD COUNTY, MARYLAND

SECTION TWO  
SITE IMPROVEMENT  
DETAILS

REVISIONS


SCALE: NOTED  
JULY 3, 1972

DRAWING No. S-4  
OF 12-17

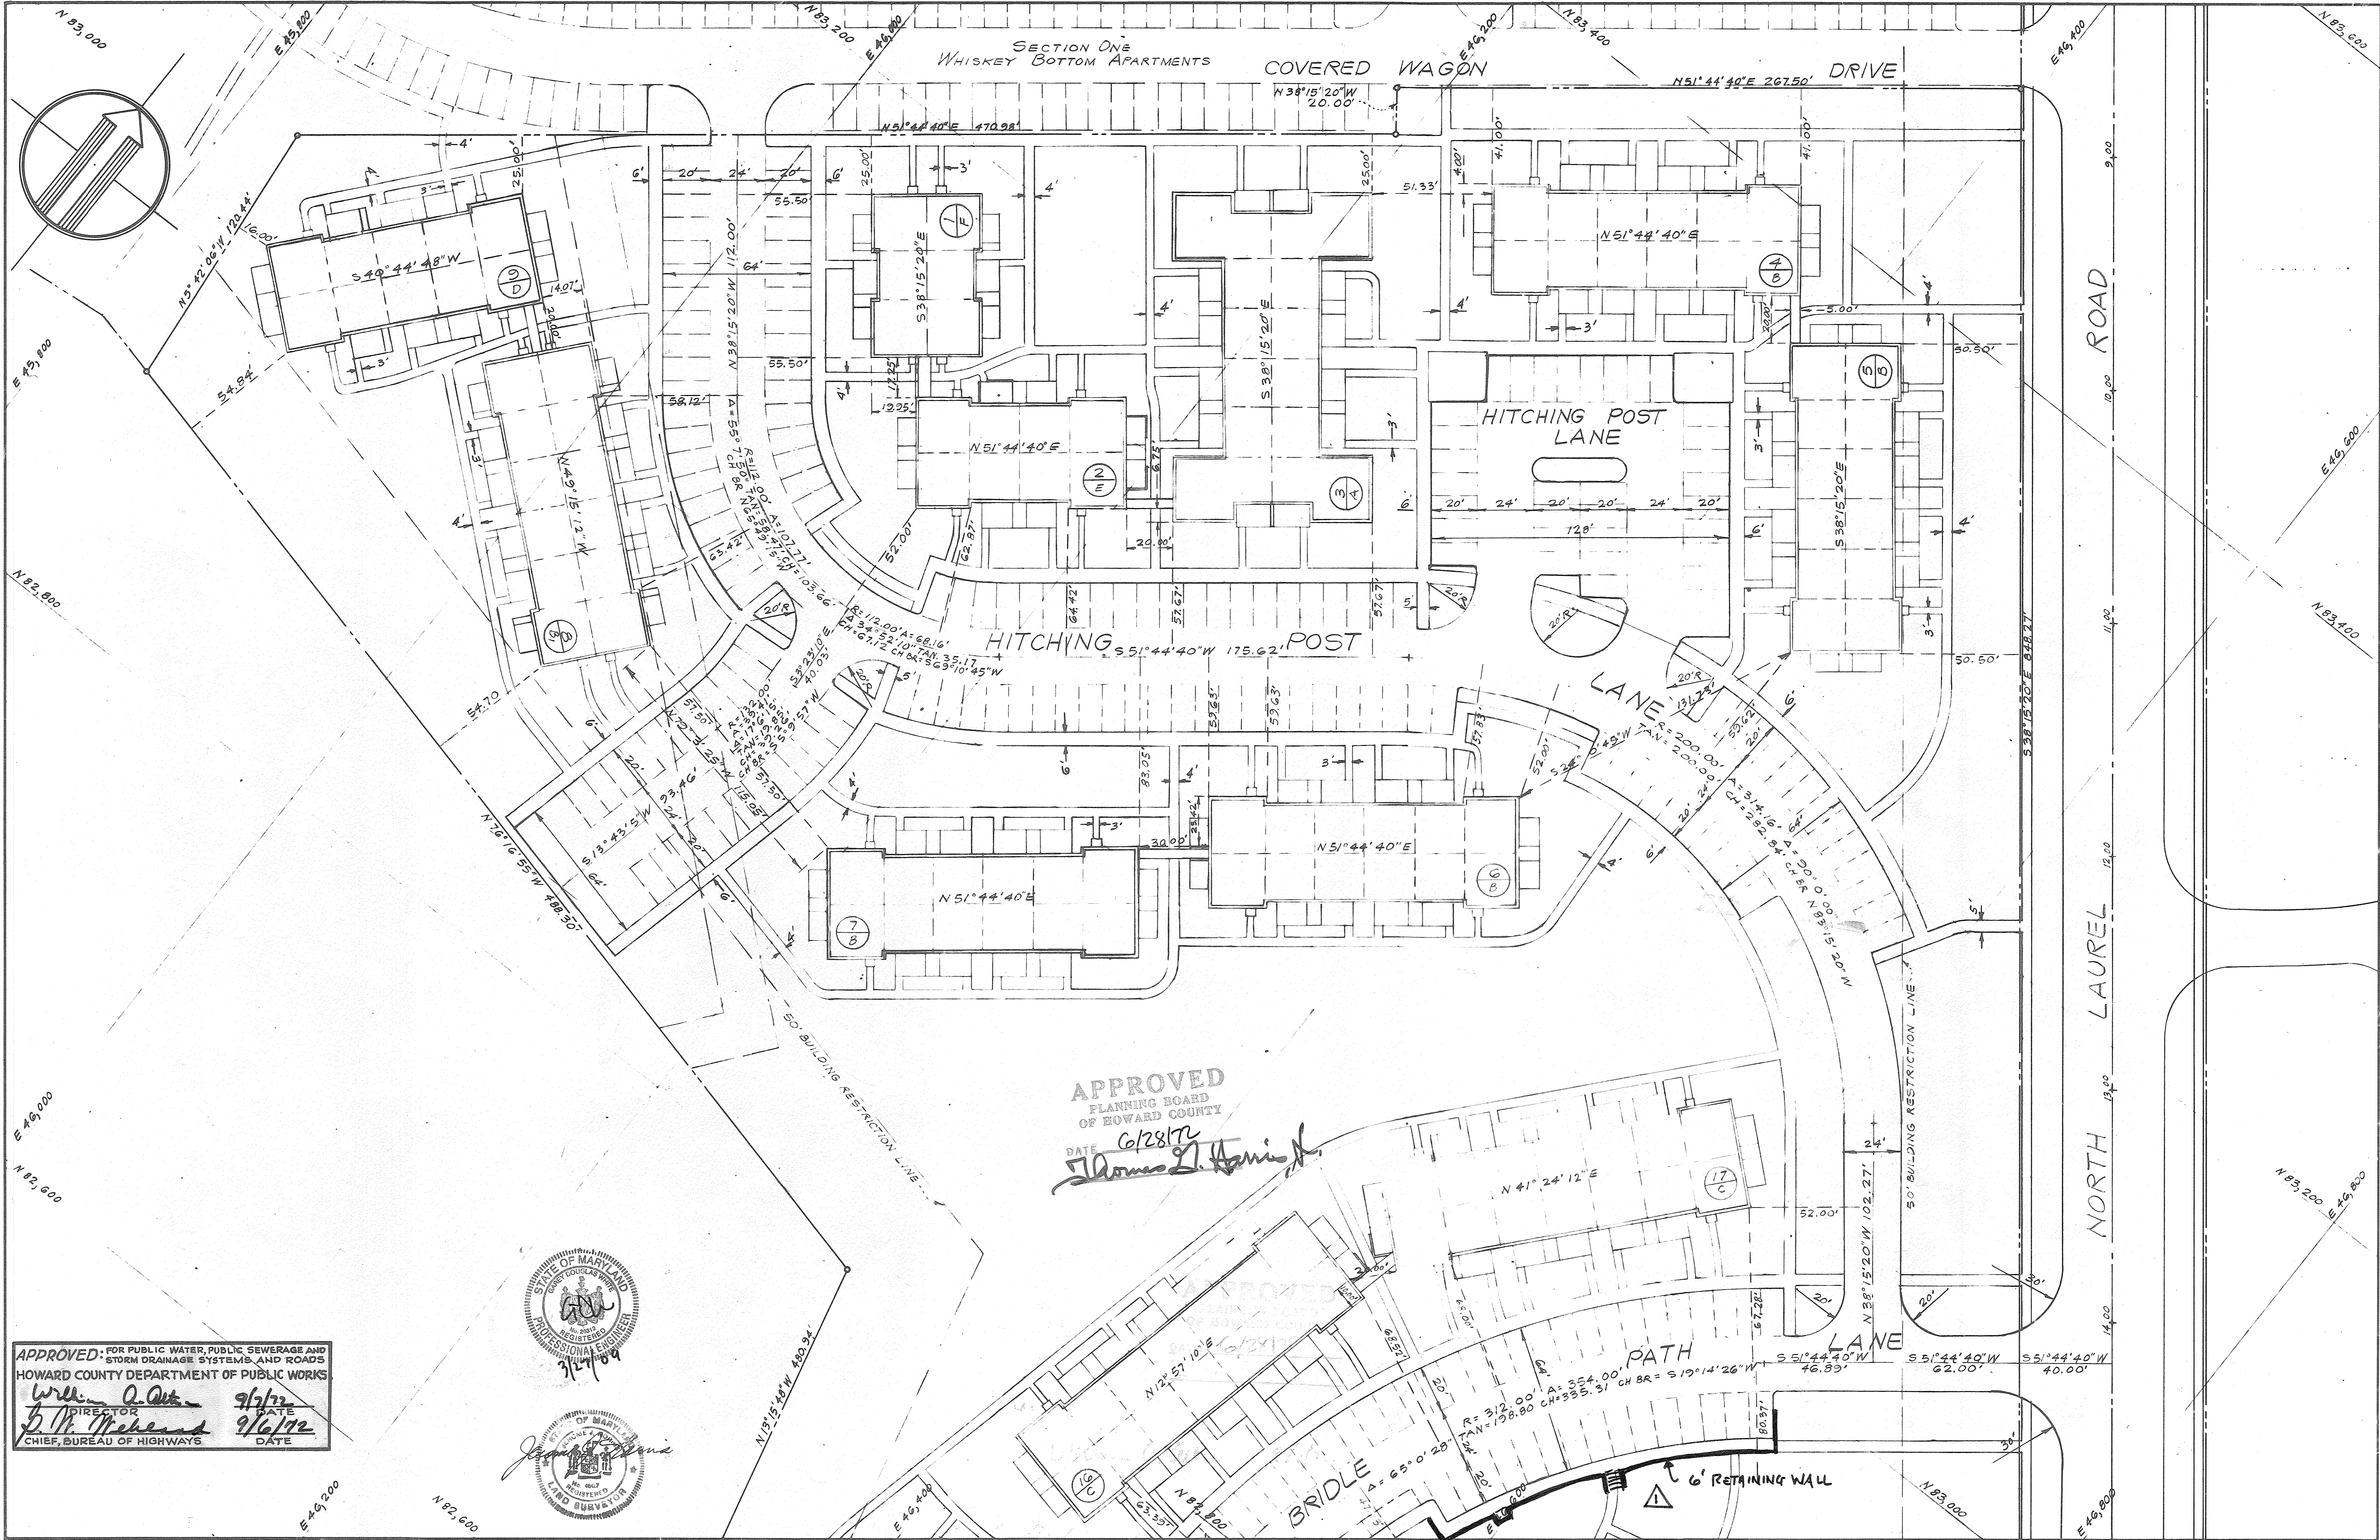

APPROVED  
 PLANNING BOARD  
 OF HOWARD COUNTY  
 DATE 6/28/72  
*Thomas L. Harris*

APPROVED FOR PUBLIC WATER, PUBLIC SEWERAGE AND STORM DRAINAGE SYSTEMS, AND ROADS  
 HOWARD COUNTY DEPARTMENT OF PUBLIC WORKS  
 WILLIAM O. QUINN 9/7/72  
 DIRECTOR DATE  
 D. M. McNEEL 9/6/72  
 CHIEF, BUREAU OF HIGHWAYS DATE

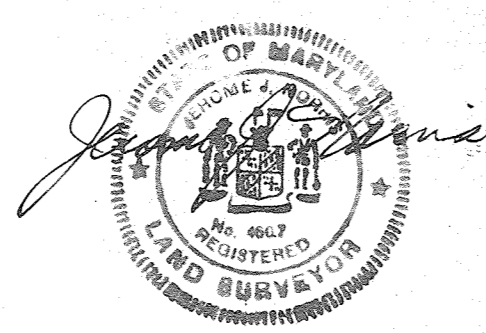

OWNER-DEVELOPER  
 WHISKEY BOTTOM CONDOMINIUMS, INC.  
 1720 WISCONSIN AVENUE, N.W.  
 WASHINGTON, D.C. 20007

JEROME J. NORRIS & ASSOCIATES  
 LAND PLANNING - HOUSING CONSULTANTS  
 6001 32<sup>ND</sup> STREET, N.W.  
 WASHINGTON, D.C.




**WHISKEY BOTTOM APARTMENTS**  
 SIXTH ELECTION DISTRICT  
 HOWARD COUNTY MARYLAND

**SECTION TWO**  
**BUILDING LOCATION PLAN**

REVISIONS  
 March 27, 2009 ADD RET. WALL


SCALE: 1"=30'  
 JULY 3, 1972  
 DRAWING No. 5-5  
 OF 1217 24

SDP-72-84

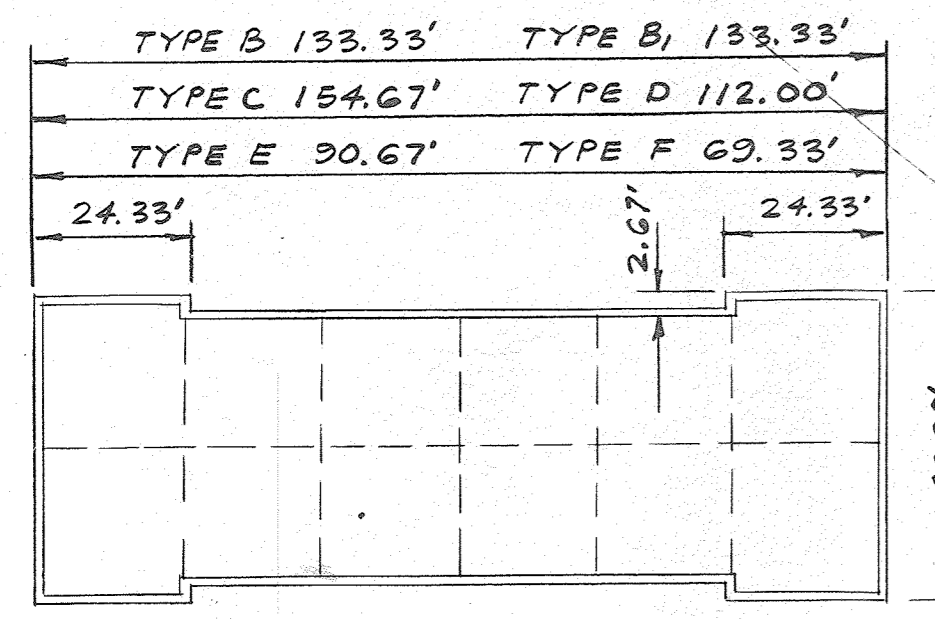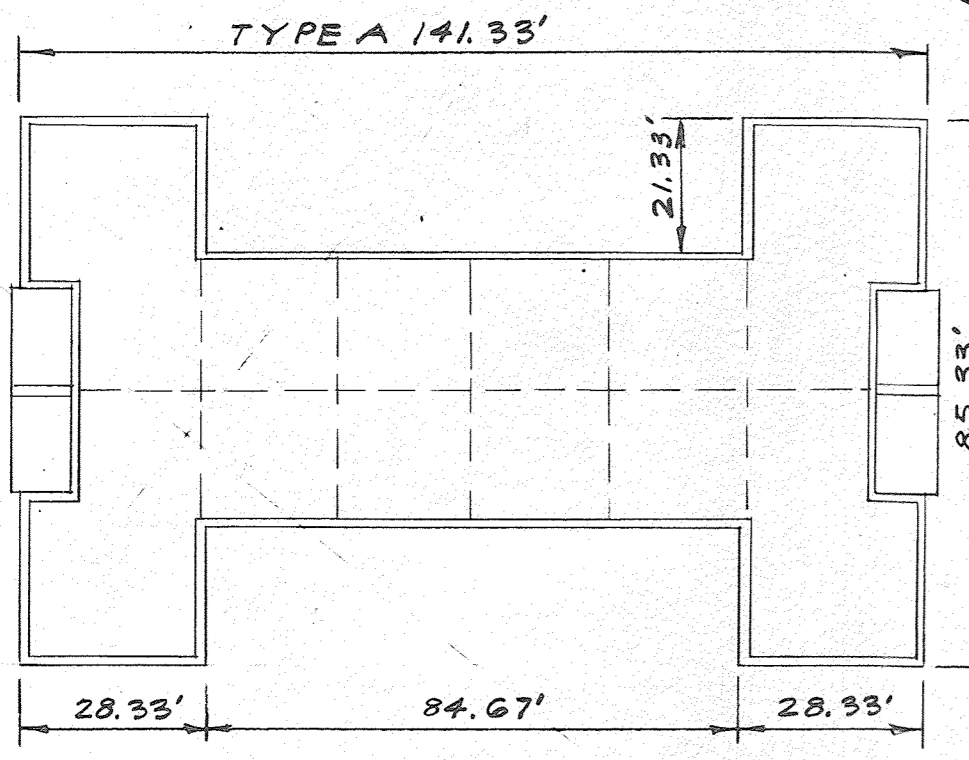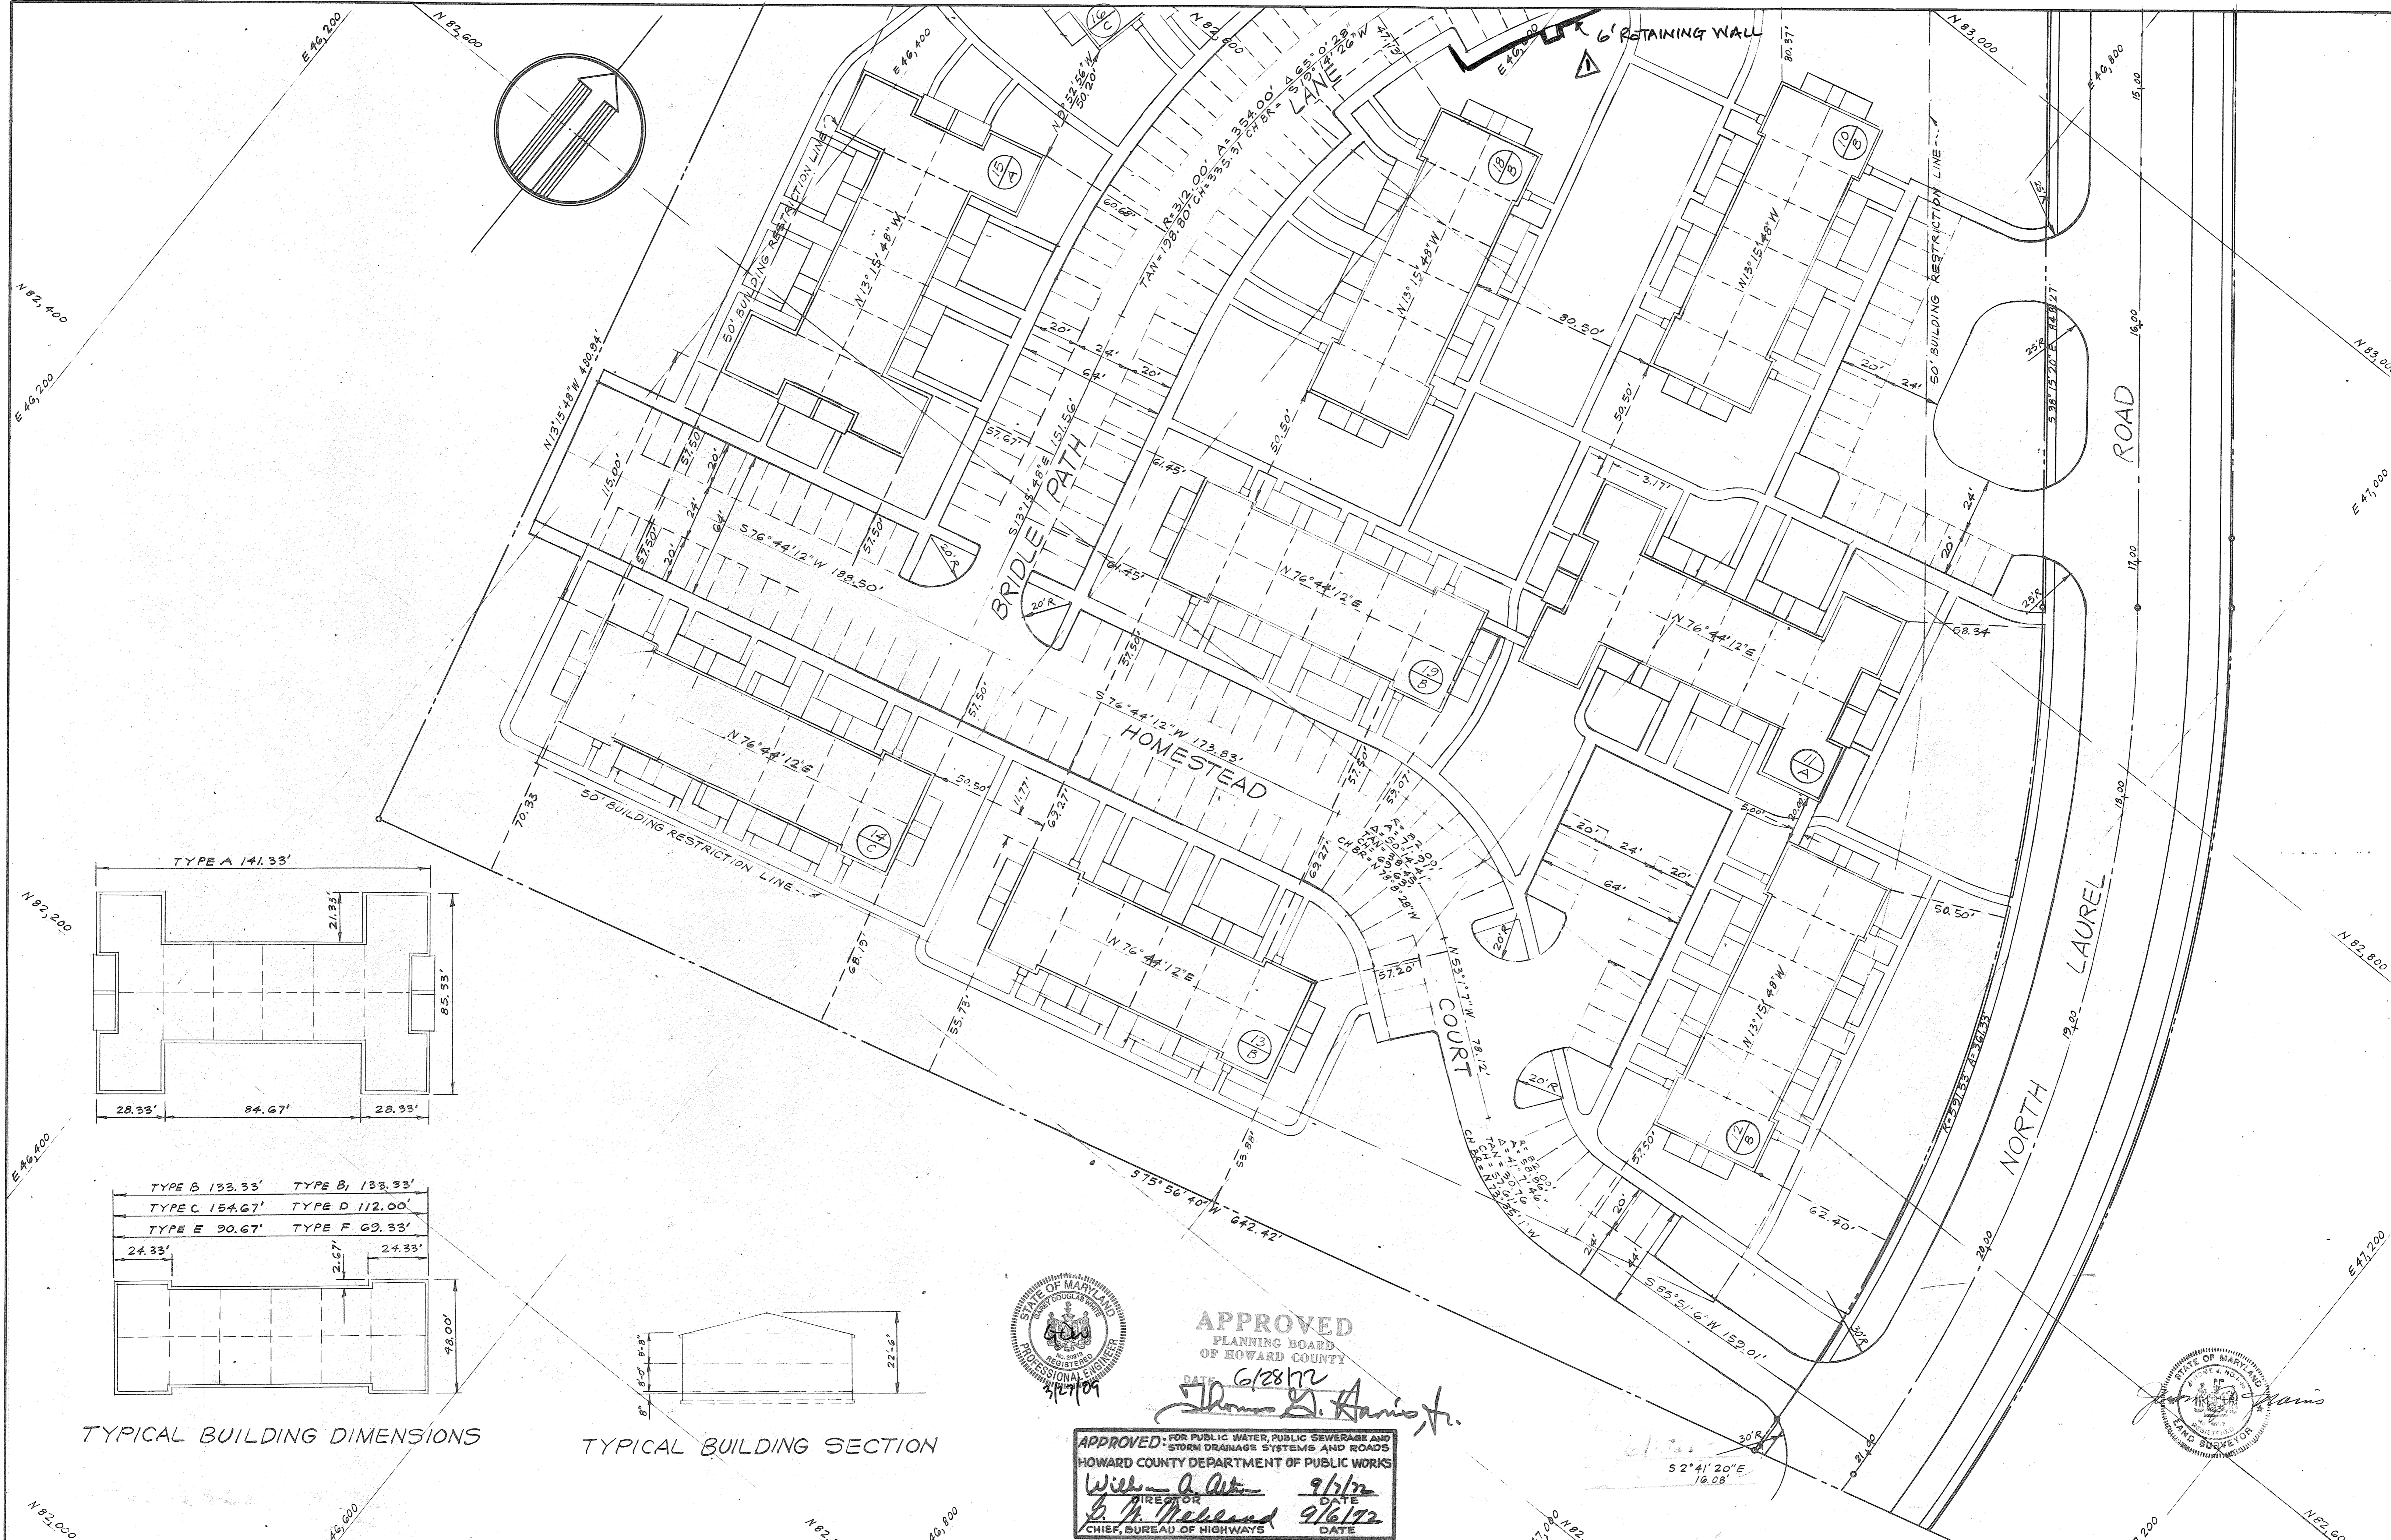

TYPICAL BUILDING DIMENSIONS


TYPICAL BUILDING SECTION

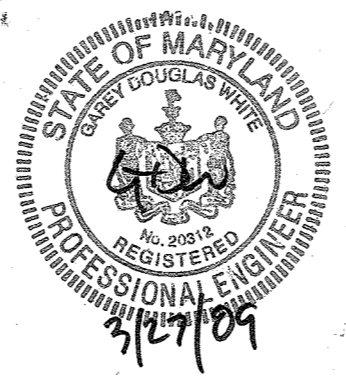

APPROVED  
PLANNING BOARD  
OF HOWARD COUNTY

DATE 6/28/72  
*Thomas D. Harris, Jr.*

APPROVED FOR PUBLIC WATER, PUBLIC SEWERAGE AND STORM DRAINAGE SYSTEMS AND ROADS  
HOWARD COUNTY DEPARTMENT OF PUBLIC WORKS  
*William A. Ault* 9/5/72  
DIRECTOR DATE  
*E. H. McKeand* 9/6/72  
CHIEF, BUREAU OF HIGHWAYS DATE

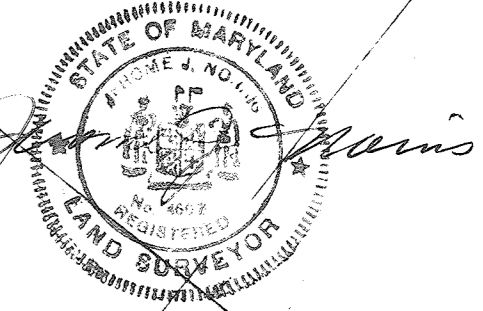

OWNER-DEVELOPER  
WHISKEY BOTTOM CONDOMINIUMS, INC.  
1720 WISCONSIN AVENUE, N.W.  
WASHINGTON, D.C. 20007

JEROME J. NORRIS & ASSOCIATES  
LAND PLANNING - HOUSING CONSULTANTS  
6001 32<sup>ND</sup> STREET, N.W.  
WASHINGTON, D.C.


**WHISKEY BOTTOM APARTMENTS**  
SIXTH ELECTION DISTRICT  
HOWARD COUNTY MARYLAND

**SECTION TWO**  
**BUILDING LOCATION PLAN**


REVISIONS  
MARCH 27, 2007 ADD RET. WALL

SCALE: 1"=30'  
DRAWING No. S-6  
JULY 3, 1972 OF 12-17 2A

DATE: \_\_\_\_\_ BY: \_\_\_\_\_  
 PROFILE SURVEYED: \_\_\_\_\_  
 BRADIS CHECKED: \_\_\_\_\_  
 NOTE BOOK NO. \_\_\_\_\_  
 STRUCTURE: \_\_\_\_\_

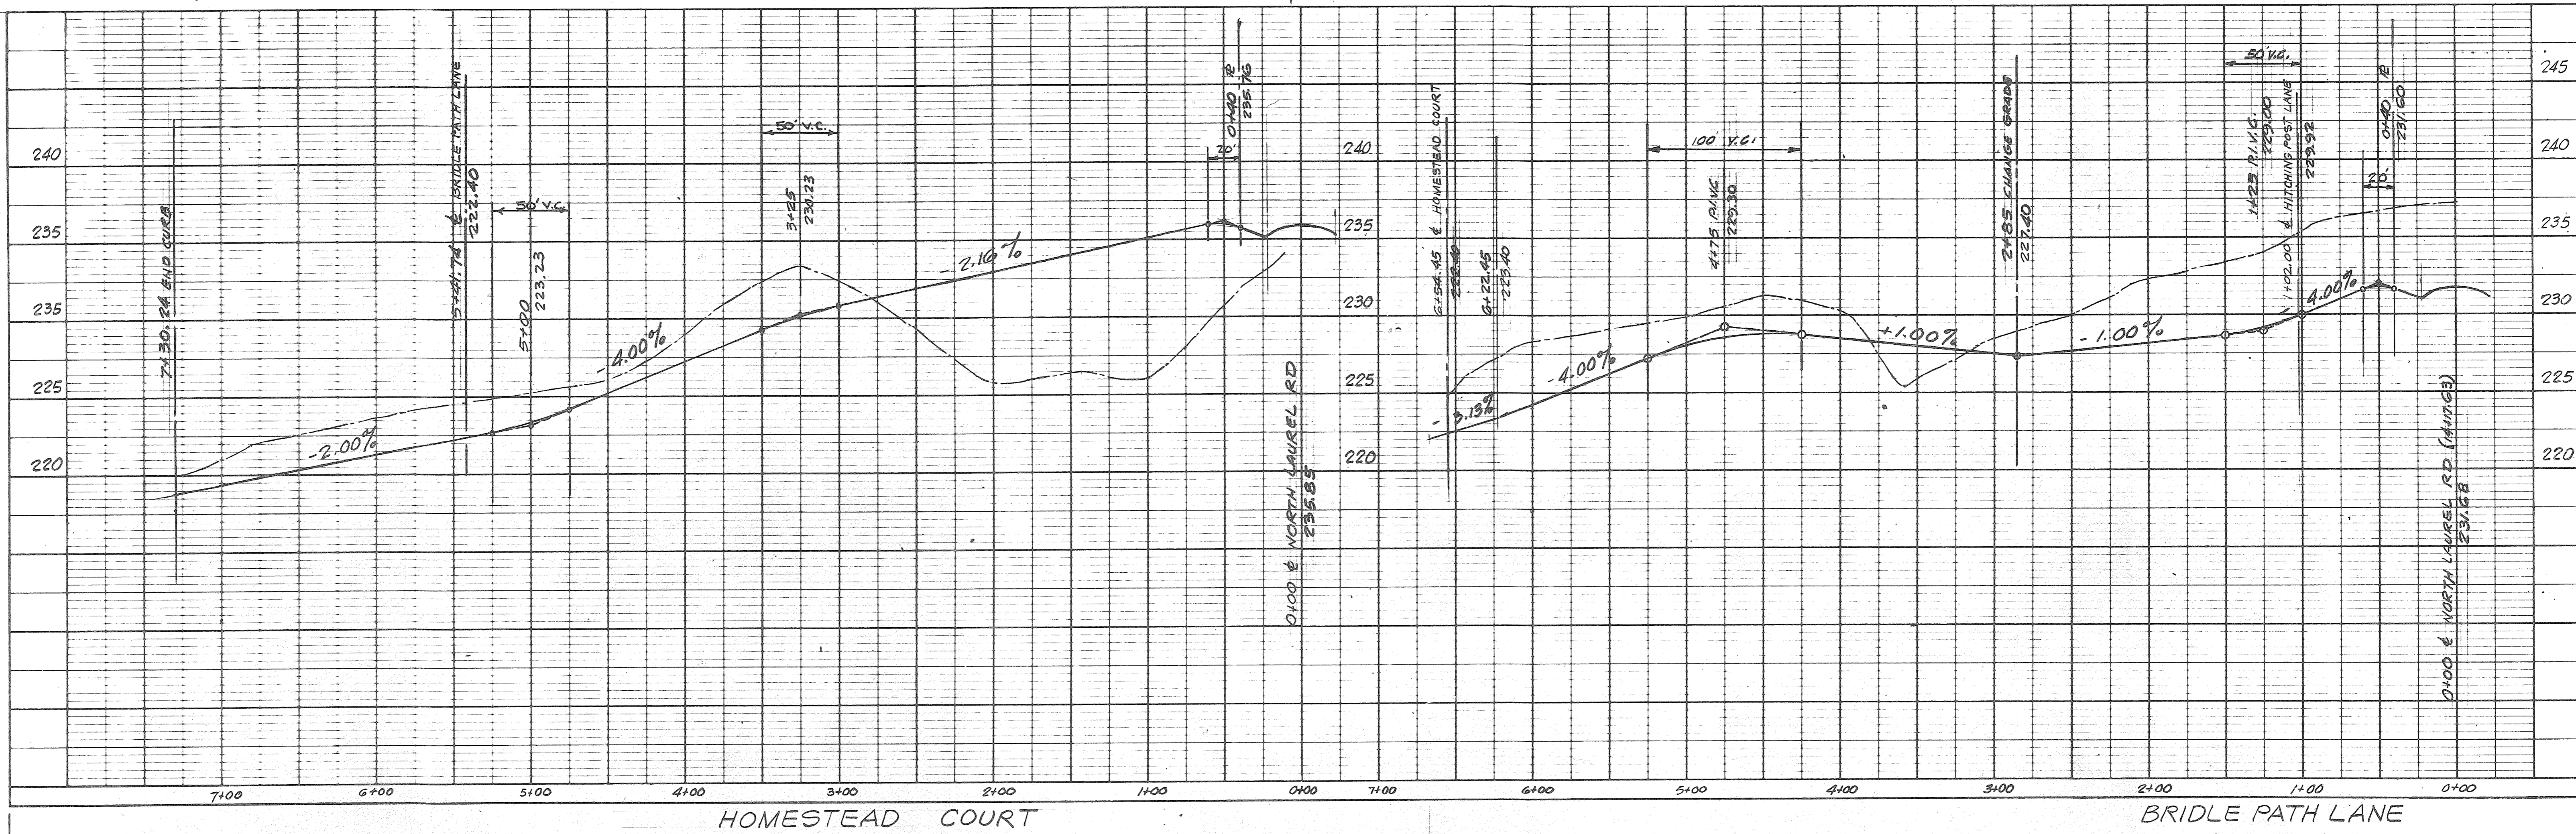


DATE: \_\_\_\_\_ BY: \_\_\_\_\_  
 PROFILE SURVEYED: \_\_\_\_\_  
 BRADIS CHECKED: \_\_\_\_\_  
 NOTE BOOK NO. \_\_\_\_\_  
 STRUCTURE: \_\_\_\_\_

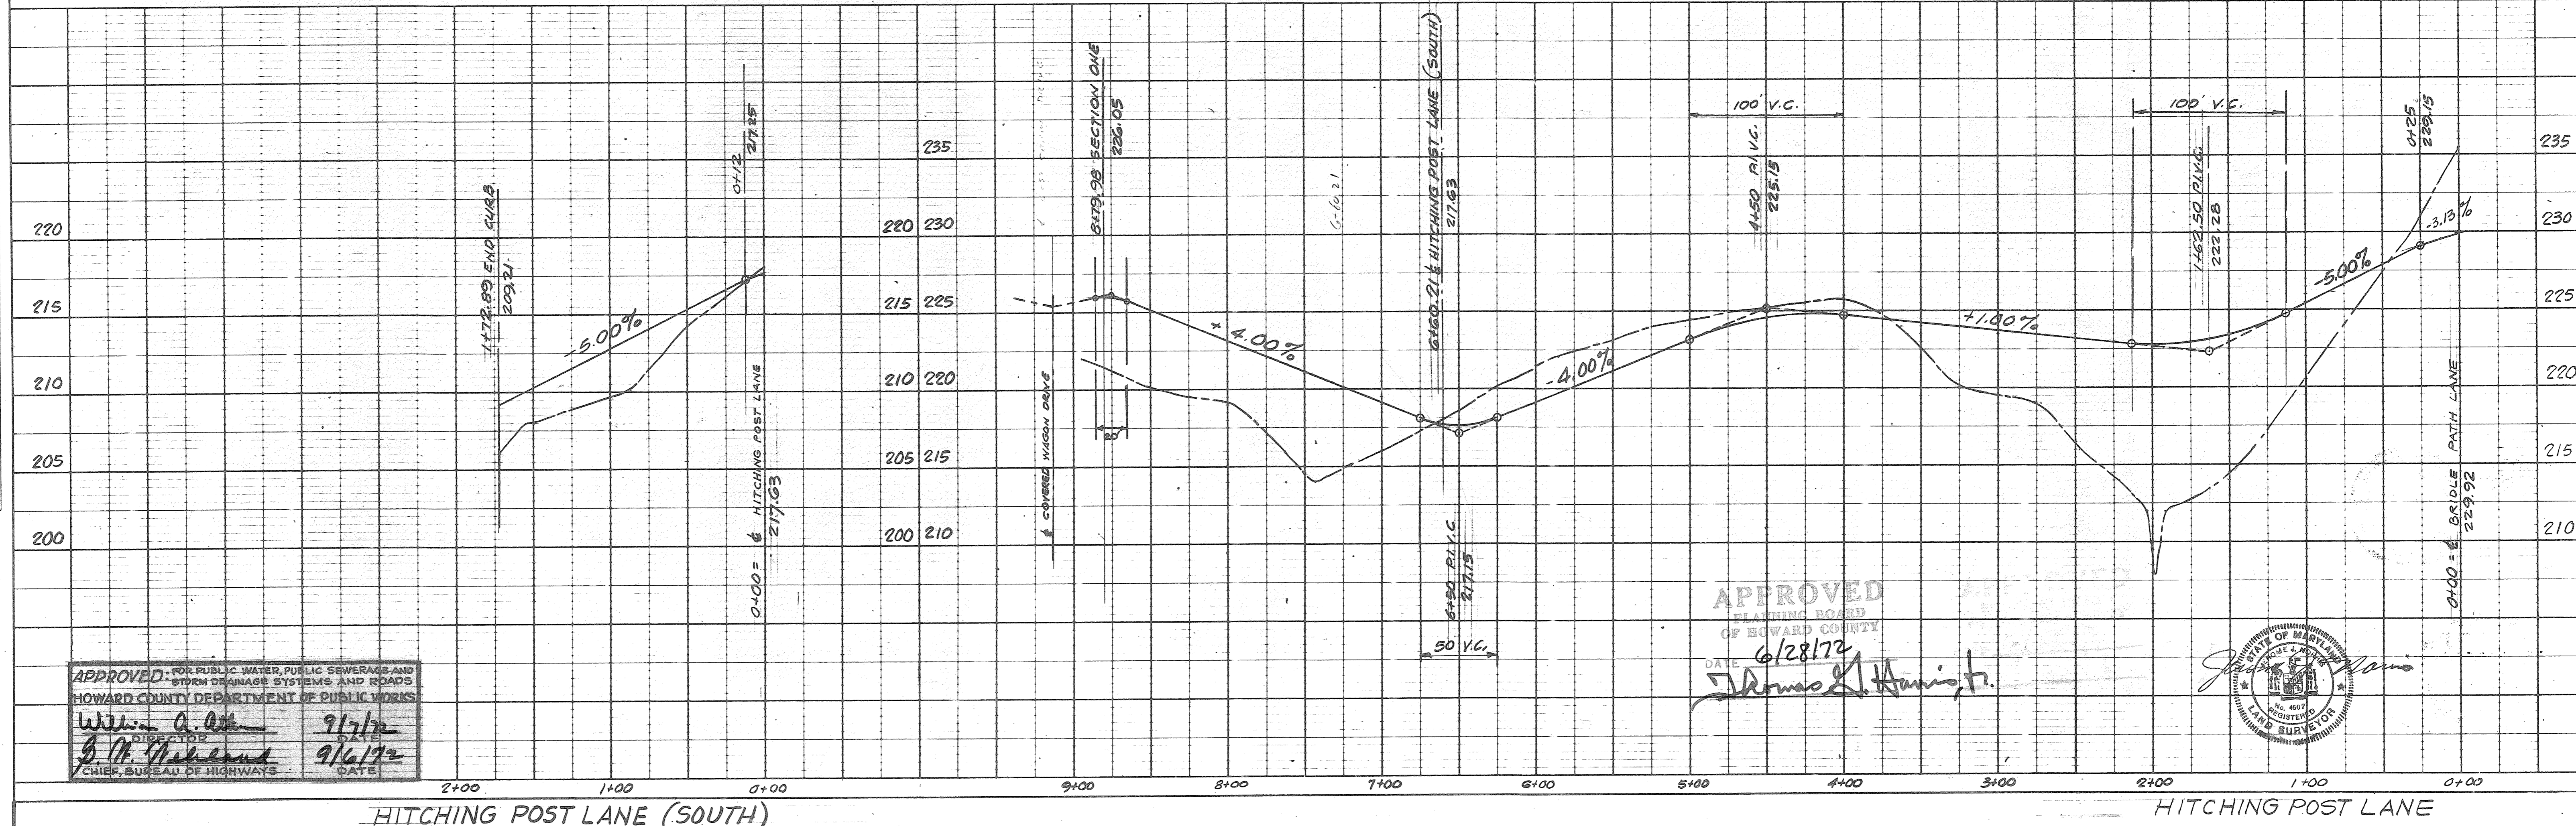

APPROVED FOR PUBLIC WATER, PUBLIC SEWERAGE AND STORM DRAINAGE SYSTEMS AND ROADS  
 HOWARD COUNTY DEPARTMENT OF PUBLIC WORKS  
 William A. ... 9/7/72  
 Chief, Bureau of Highways 9/6/72

APPROVED  
 PLANNING BOARD  
 OF HOWARD COUNTY  
 DATE 6/28/72  
 James L. ...

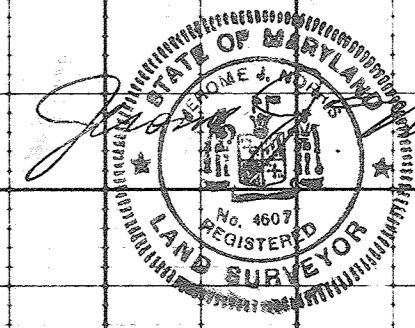

OWNER-DEVELOPER  
 WHISKEY BOTTOM CONDOMINIUMS, INC.  
 1720 WISCONSIN AVENUE, N.W.  
 WASHINGTON, D.C. 20007

JEROME J. NORRIS & ASSOCS.  
 LAND PLANNING - HOUSING CONSULTANTS  
 6001 32<sup>ND</sup> STREET, N.W.  
 WASHINGTON, D.C.


**WHISKEY BOTTOM APARTMENTS**  
 SIXTH ELECTION DISTRICT  
 HOWARD COUNTY MARYLAND

**SECTION TWO**  
**DRIVEWAY PROFILES**

REVISIONS: \_\_\_\_\_  
 SCALE: 1"=50'  
 JULY 3, 1972  
 DRAWING No. S-7 OF 1217

DATE  
BY  
SURVEYED  
PLOTTED  
CHECKED  
NOTE BOOK  
NO.

DATE  
BY  
SURVEYED  
PLOTTED  
CHECKED  
NOTE BOOK  
NO.

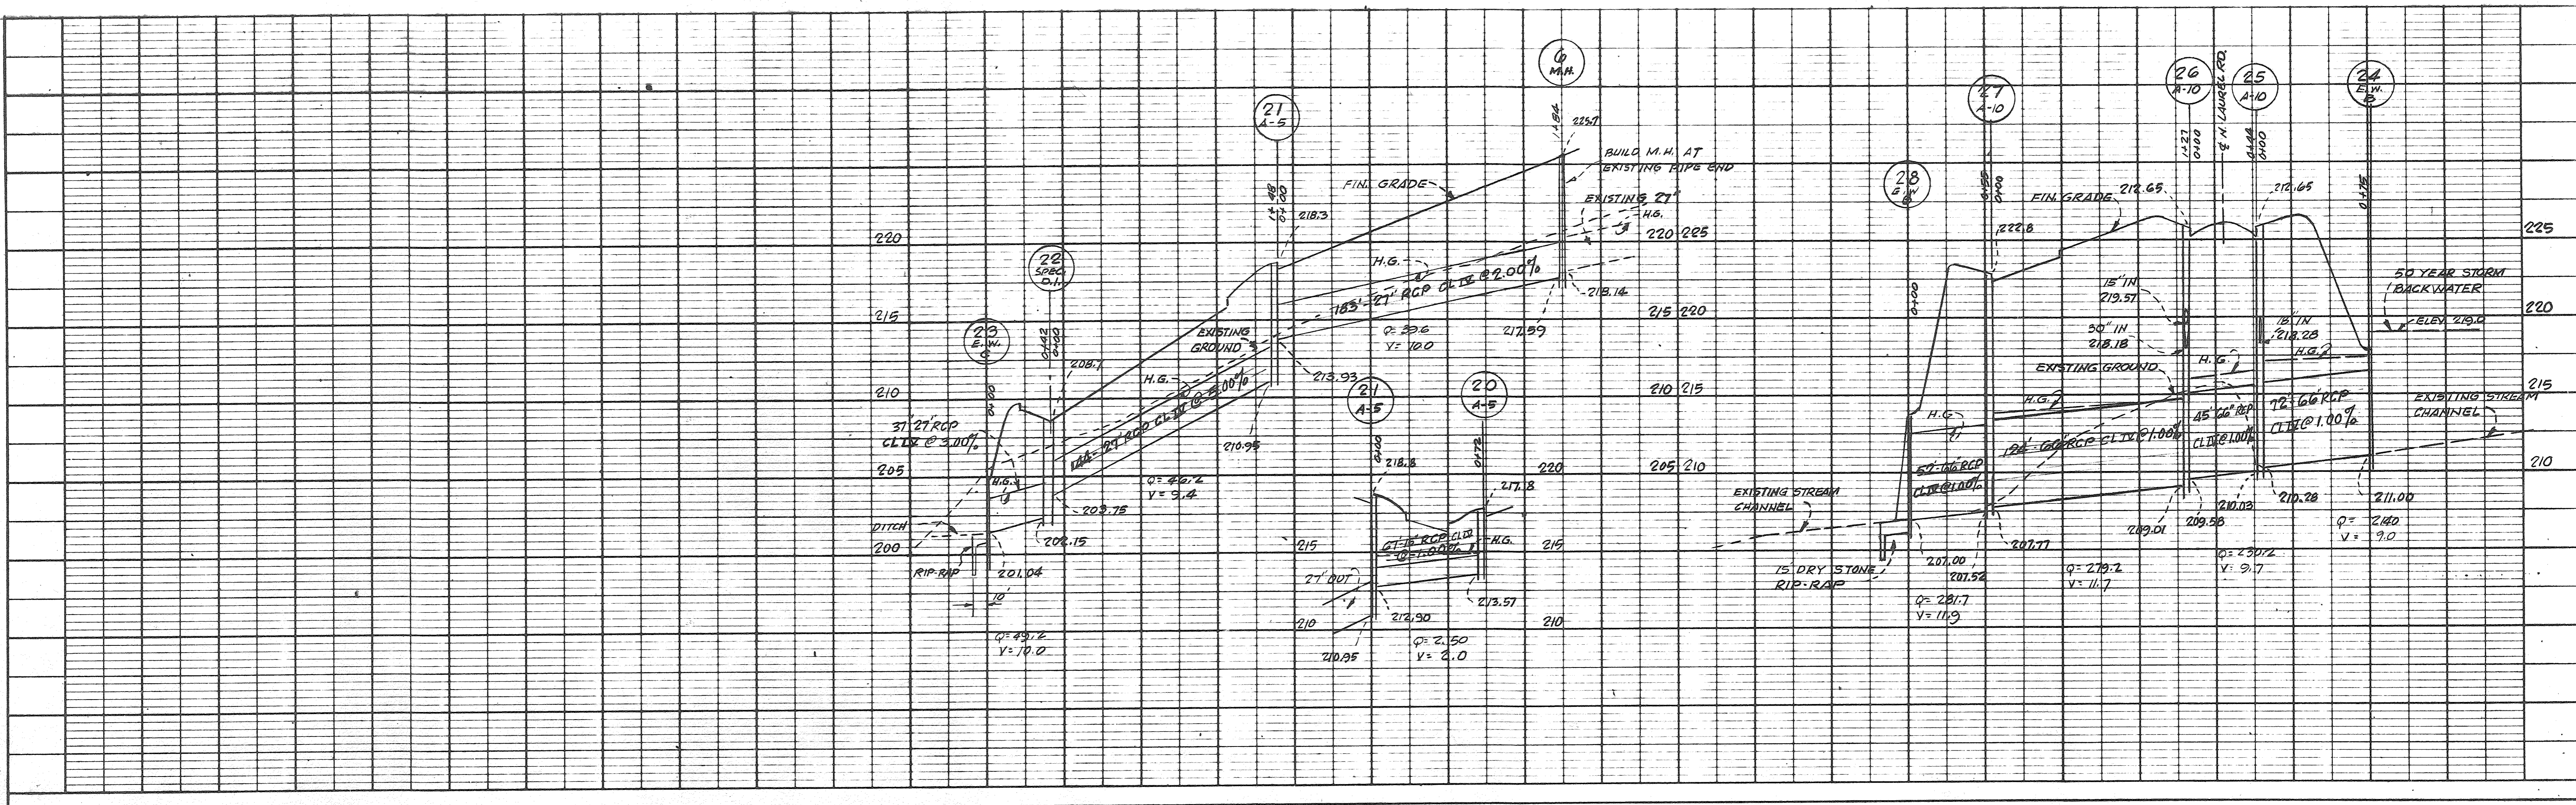


STRUCTURE SCHEDULE			
No.	TYPE	TOP ELEV.	REMARKS
4	M.H.	225.7	
20	A-5	217.8	
21	A-5	218.8	
22	SPEC. D.I.	208.7	SEE DETAIL SHEET NO. 4
23	E.W.-C		10' DRY STONE RIP-RAP
24	E.W.-B		
25	A-10	212.65	
26	A-10	212.65	
27	A-10	222.8	
28	E.W.-B		15' DRY STONE RIP-RAP
47	SPEC. G.I.	238.9	SEE DETAIL SHEET 4
48	SPEC. G.I.	235.2	SEE DETAIL SHEET 4
48A	M.H.	229.5	
49	SPEC. D.I.	227.1	SEE DETAIL SHEET 4
50	E.W.-C		10' DRY STONE RIP-RAP
51	SPEC. D.I.	225.0	SEE DETAIL SHEET 4
51A	M.H.	221.8	
52	SPEC. D.I.	218.3	SEE DETAIL SHEET 4
53	E.W.-C		10' DRY STONE RIP-RAP

NOTE: STORM DRAIN STRUCTURES ARE HOWARD COUNTY STANDARD UNLESS OTHERWISE NOTED.

APPROVED FOR PUBLIC WATER, PUBLIC SEWERAGE AND STORM DRAINAGE SYSTEMS AND ROADS  
 HOWARD COUNTY DEPARTMENT OF PUBLIC WORKS  
 W. A. [Signature]  
 DIRECTOR  
 D. H. [Signature]  
 CHIEF, BUREAU OF HIGHWAYS  
 DATE 9/6/72

APPROVED  
 PLANNING BOARD  
 OF HOWARD COUNTY  
 6/28/72  
 [Signature]

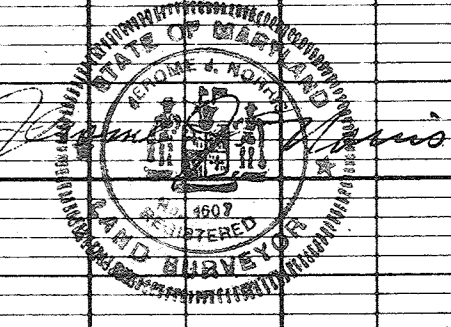

OWNER-DEVELOPER  
 WHISKEY BOTTOM CONDOMINIUMS, INC.  
 1720 WISCONSIN AVENUE, N.W.  
 WASHINGTON, D.C. 20007



JEROME J. NORRIS & ASSOC.  
 LAND PLANNING - HOUSING CONSULTANTS  
 6001 32<sup>ND</sup> STREET, N.W.  
 WASHINGTON, D.C.

**WHISKEY BOTTOM APARTMENTS**  
 SIXTH ELECTION DISTRICT  
 HOWARD COUNTY MARYLAND

SECTION TWO  
**STORM DRAIN PROFILES**

REVISIONS  
 SCALE: 1"=50'  
 DRAWING No. S-8  
 JULY 3, 1972 OF 12-17 24  
 SDD-72-84



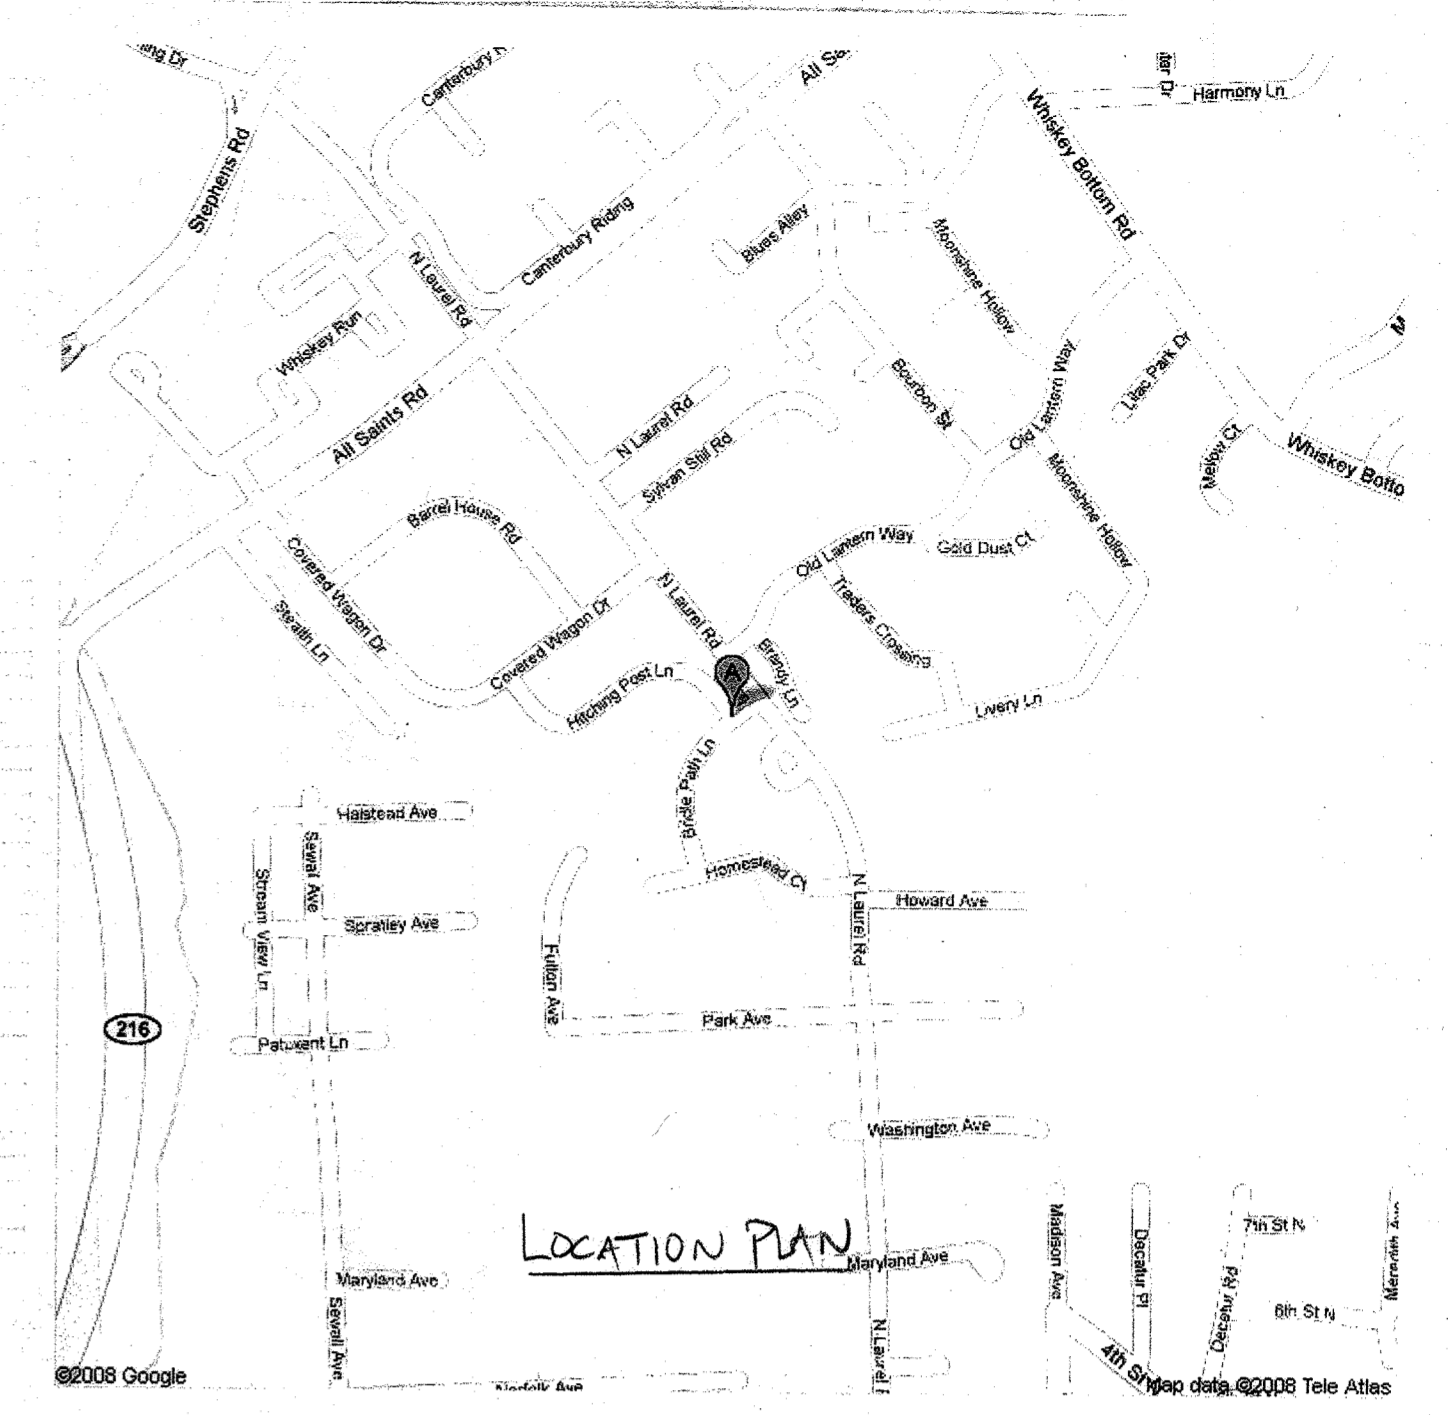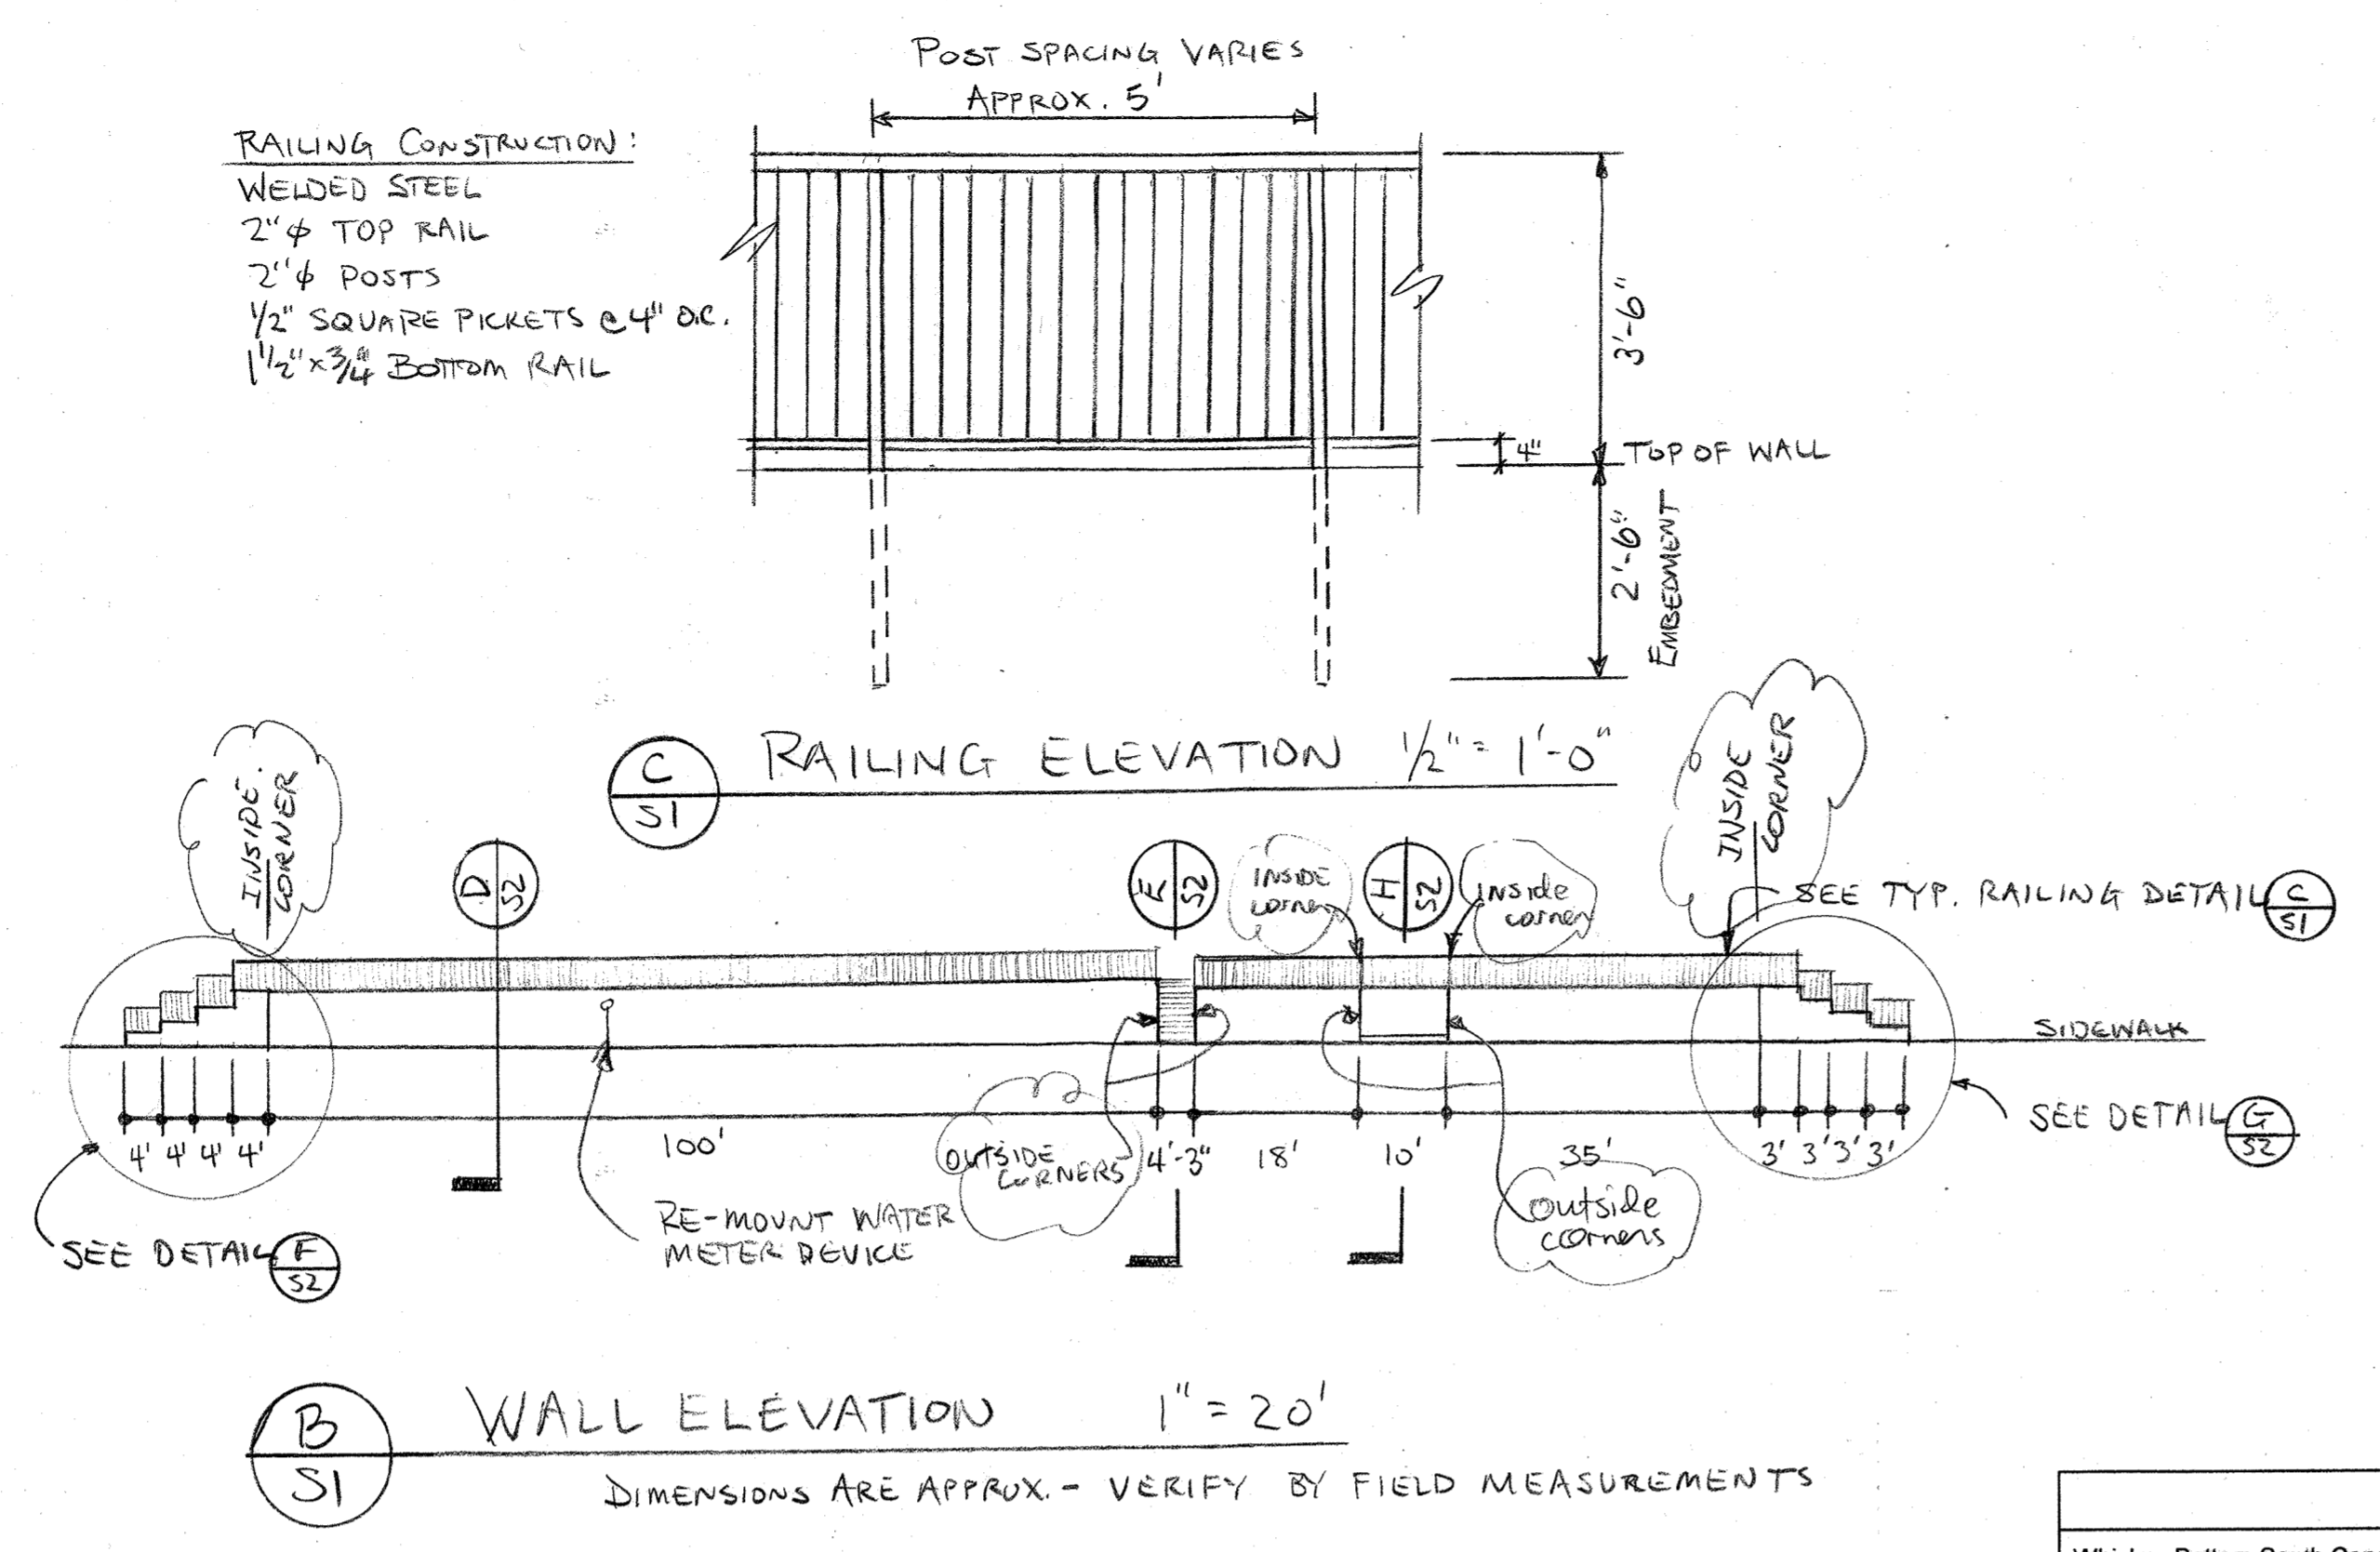


PERMIT INFORMATION CHART				
Whiskey Bottom South Condominiums	Section 2			
SDP-72-084	Residential	Tax Map 50	Election District 6	Parcel 479

**ENGINEER'S CERTIFICATE**  
 I certify that this plan for sediment and erosion control represents a practical and workable plan based on my personal knowledge of the site conditions and that it was prepared in accordance with the requirements of the Howard Soil Conservation District.

*G. Douglas White*  
 G. Douglas White, P.E., No. 20312 Date 4/2/09

**OWNER:** Whiskey Bottom South Condominium Association  
 c/o Site Realty Group, 2141 Industrial Parkway, Silver Spring, Maryland 20904 WHITE 200  
 (301) 622-9300

**ENGINEER:** Thomas Downey, Ltd.  
 301 N. Fairfax Street, Suite 108, Alexandria, Virginia 22314  
 703-548-3403

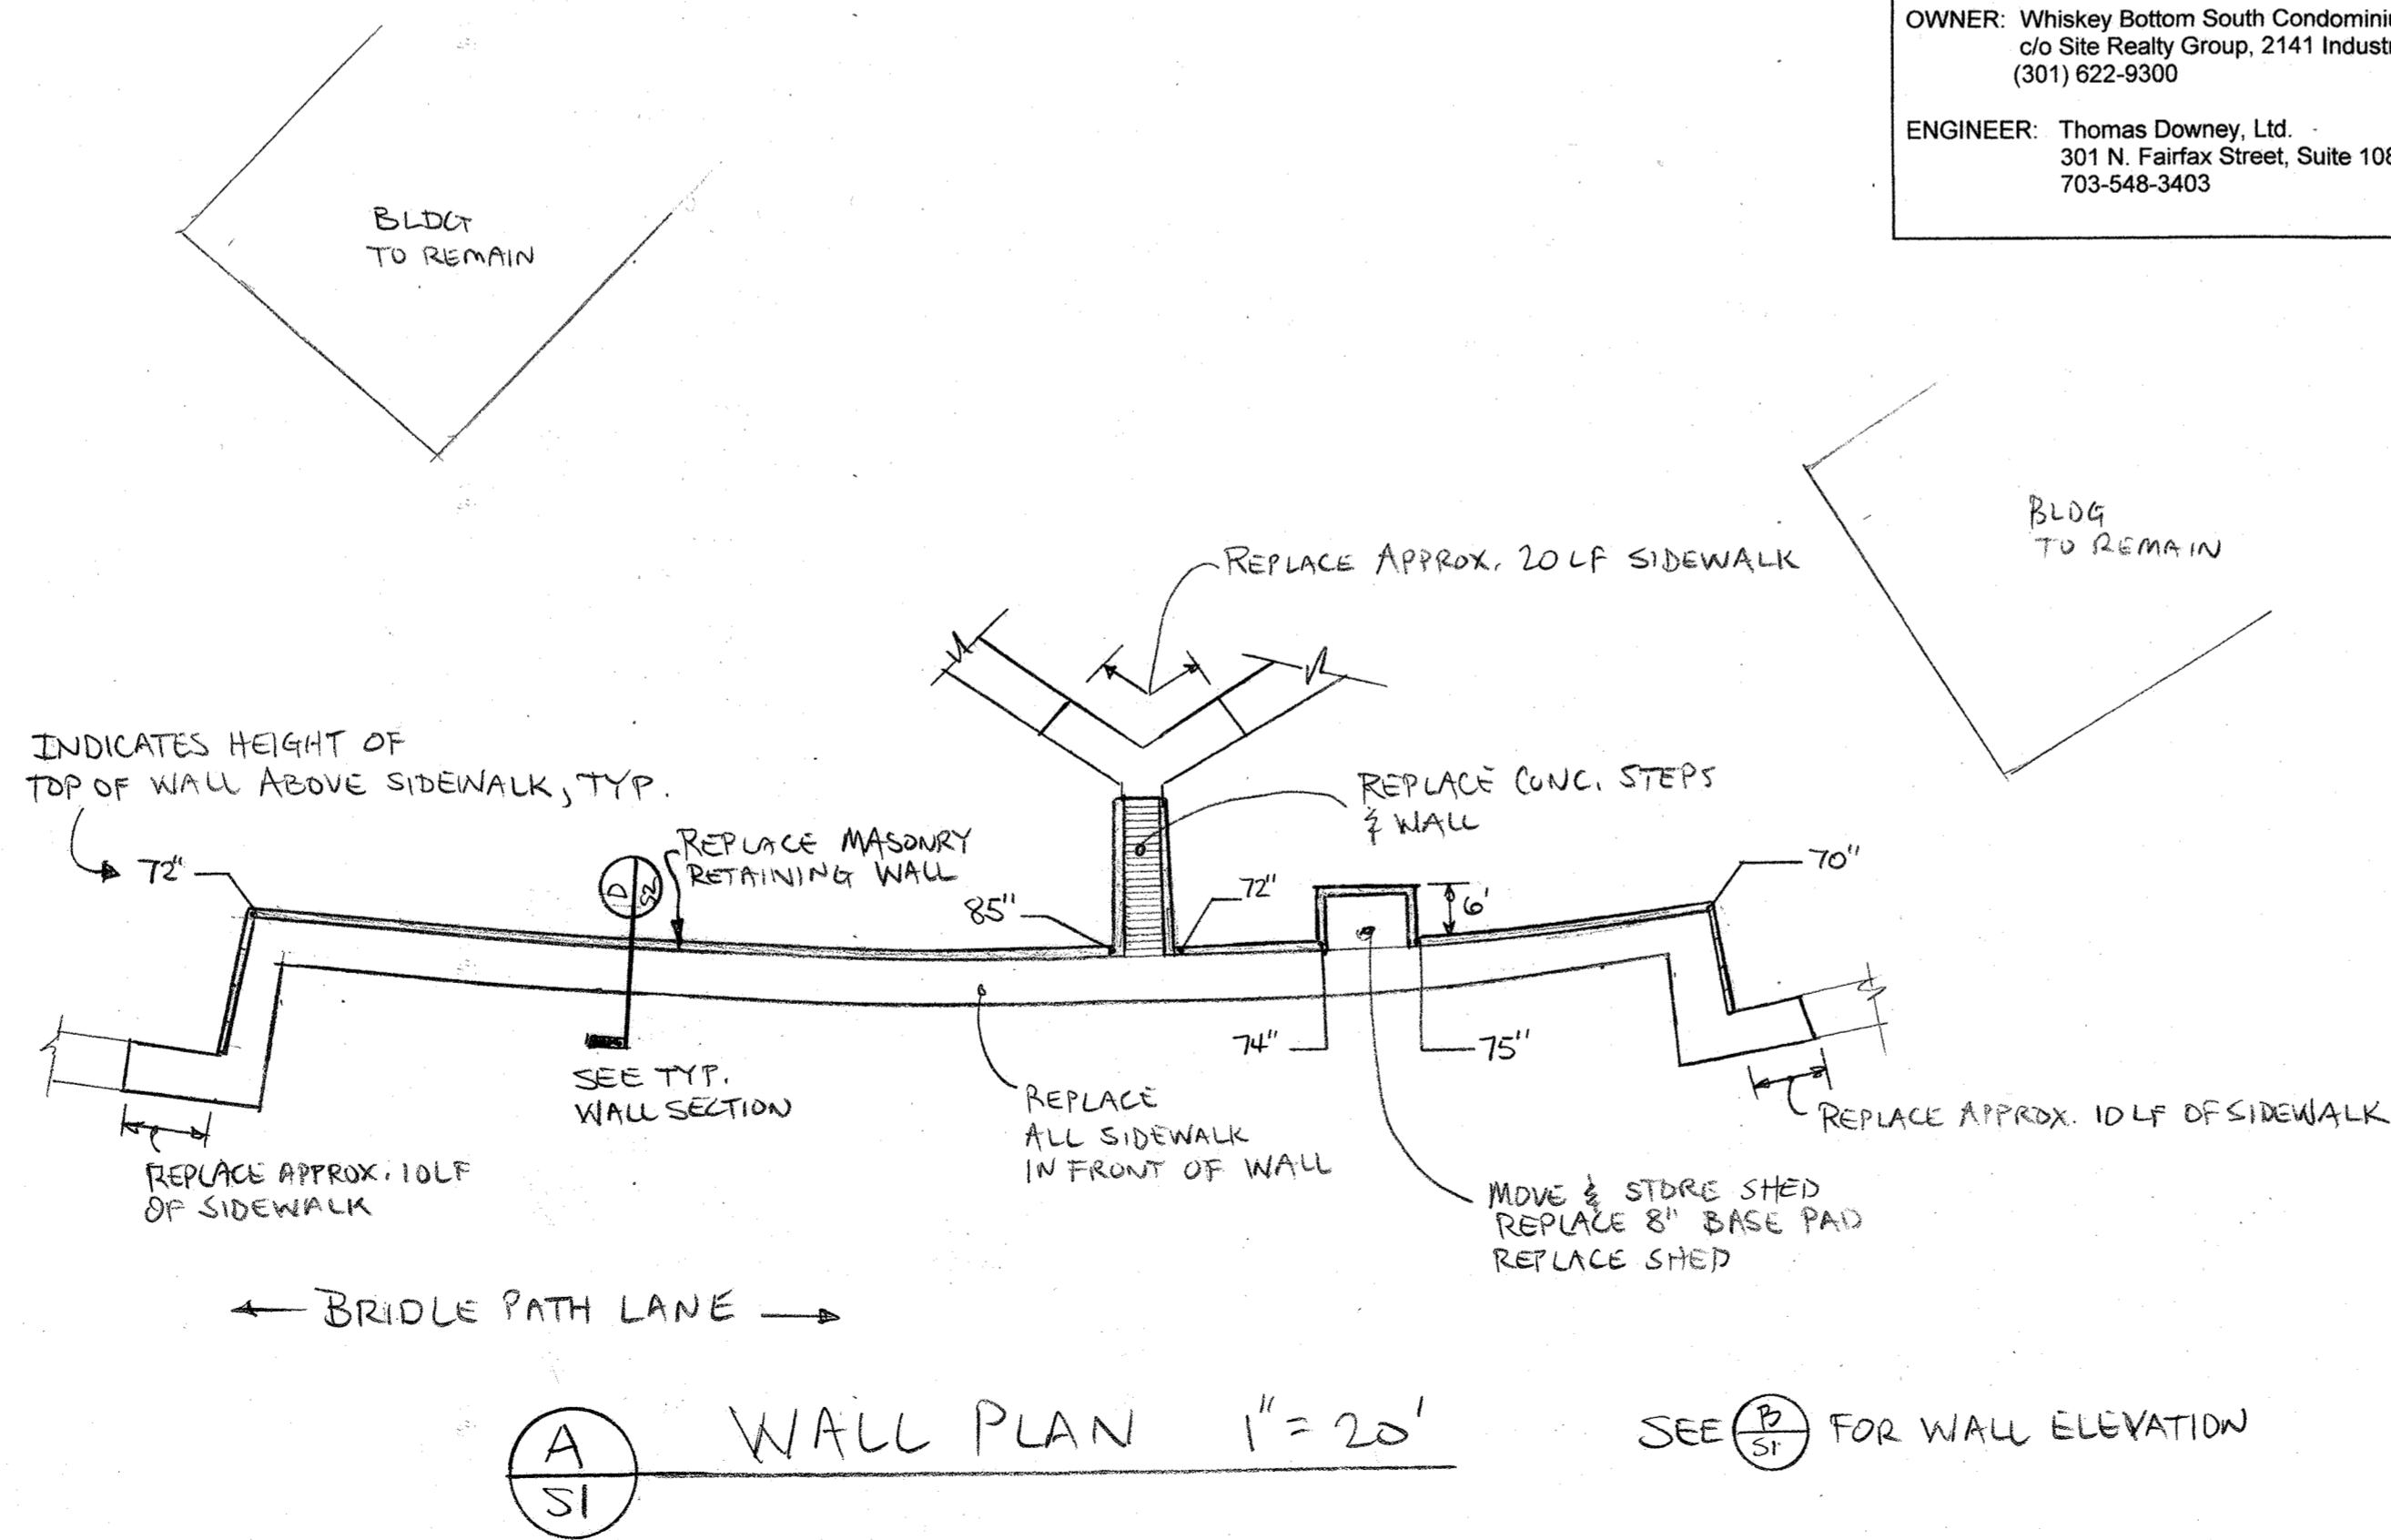

**SCOPE OF WORK**

Remove and replace the brick and concrete masonry retaining wall across from 9200 Bridle Path Lane, Laurel, Maryland.

**STRUCTURAL NOTES**

Code: Work shall comply with the 2006 International Building Code (IBC).  
 Dimensions: Dimensions of existing construction are shown for information only. Verify dimensions before beginning work.  
 Differing Conditions: If conditions differing from those shown on the drawings are encountered, or if unforeseen conditions are uncovered that prevent performing the work as shown, consult the Engineer for direction.

**SPECIFICATIONS**

**Soil Value.** Assumed soil bearing capacity is 3,000 psf. Wall footings are to bear on undisturbed soil.  
**Soil for backfilling.** Clean granular soil fill. Install in 8" layers. Mechanically compact each layer. It is not acceptable to use the excavated material unless it is granular fill free from contamination.  
**Concrete Materials.** Comply with ACI 318-95 code requirements. Concrete design compressive strength,  $f_c$ , is 3,500 psi. Coarse aggregate shall be stone (regular weight concrete). Cement content shall be a minimum of 540 pounds per cubic yard of concrete. Water cement ratio shall not exceed 0.45. Water reducing admixtures are acceptable. No admixtures shall contain chlorides. Concrete shall be air entrained. Submit mix design to Engineer for approval.  
**Concrete Forms.** Construct per ACI recommended practices. Forms for new slab soffit shall be plywood with B grade facing on concrete side.  
**Concreting Operations.** Comply with ACI recommended practices.  
**Finishing And Curing Concrete.** Concrete shall be wet-cured with wet burlap covered with plastic sheeting for a minimum of seven days, or cured using a colorless membrane curing compound. Exposed concrete surfaces shall have a light broomed finish.

**Reinforcing Steel.** Reinforcing bars shall be Grade 60 conforming to ASTM A615.  
**Masonry Installation.** Per the recommended practices in ACI 530-99, and ACI 530.1-99, Building Code Requirements and Specifications for Masonry Structures.  
**Concrete Masonry.** Type II normal weight concrete masonry units per ASTM C90. Sizes per drawings.  
**Brick Masonry.** Solid building brick per ASTM C62, size and type to match existing.  
**Mortar.** Type N per ACI 530.1.  
**Grout.** Fine grout per ASTM C476.  
**Masonry Accessories.** Galvanized wire truss type joint reinforcement per ASTM A951 in concrete masonry every other course.

**Waterproofing membrane.** Bituthene 3000 manufactured by W.R. Grace or approved equal. Accessories such as termination bars, mastic, liquid membrane, patching material, and primers by membrane manufacturer and installed per manufacturer's details.  
**Drainage board.** Hydrocut 2 manufactured by W.R. Grace or approved equal. Install per manufacturer's details.  
**Caulk.** Dow 795 Silicone Sealant. Color: to match mortar.  
**Drainage pipes.** Schedule 40 PVC with solvent welded joints and molded fittings. Sizes are shown on the plans.  
**Filter cloth.** Non-woven synthetic fabric filter cloth designed for buried applications.  
**Handrails and railings.** Fabricated from A36 steel and welded. Prime painted with one coat of zinc rich primer and 2 finish coats of alkyl exterior enamel. Details per IBC sections 1012 and 1013.

**APPROVED: DEPARTMENT OF PLANNING AND ZONING**

*Chad Edwards*  
 Chief, Development Engineering Division Date 5/4/09

*Cindy Hanna*  
 Chief, Division of Land Development Date 5/5/09


*Mark Loyell*  
 Director Date 5/3/09



Professional Certification  
 I certify that these documents were prepared or approved by me, and that I am a duly licensed professional engineer under the laws of the State of Maryland, license number 20312, expiration date January 7, 2010.

<b>THOMAS DOWNEY, LTD.</b> <b>CONSULTING ENGINEERS</b> 301 N. FAIRFAX ST., SUITE 108, ALEXANDRIA, VIRGINIA 22314 OFFICE (703) 548-3403 FAX (703) 548-3715	<b>WHISKEY BOTTOM SOUTH</b> 9200 Bridle Path Lane Laurel, Maryland 20723
	<b>RETAINING WALL REPLACEMENT</b>
<b>PLANS, SPECIFICATIONS AND NOTES</b> ISSUED FOR REVIEW 10-23-2008 Issued for Construction 2-9-2009 REV. 4-2-09 TO SHOW INSIDE CORNERS	
SHEET <b>SI</b> SDP-72-084	6-9 OF 17 24


TIE FACE BRICK TO CMU  
W/ GALV. ADJ. BRICK TIES.  
GALVANIZED TRUSS  
TYPE JOINT REINF. W/  
CMU @ 16" OC. HORIZ.

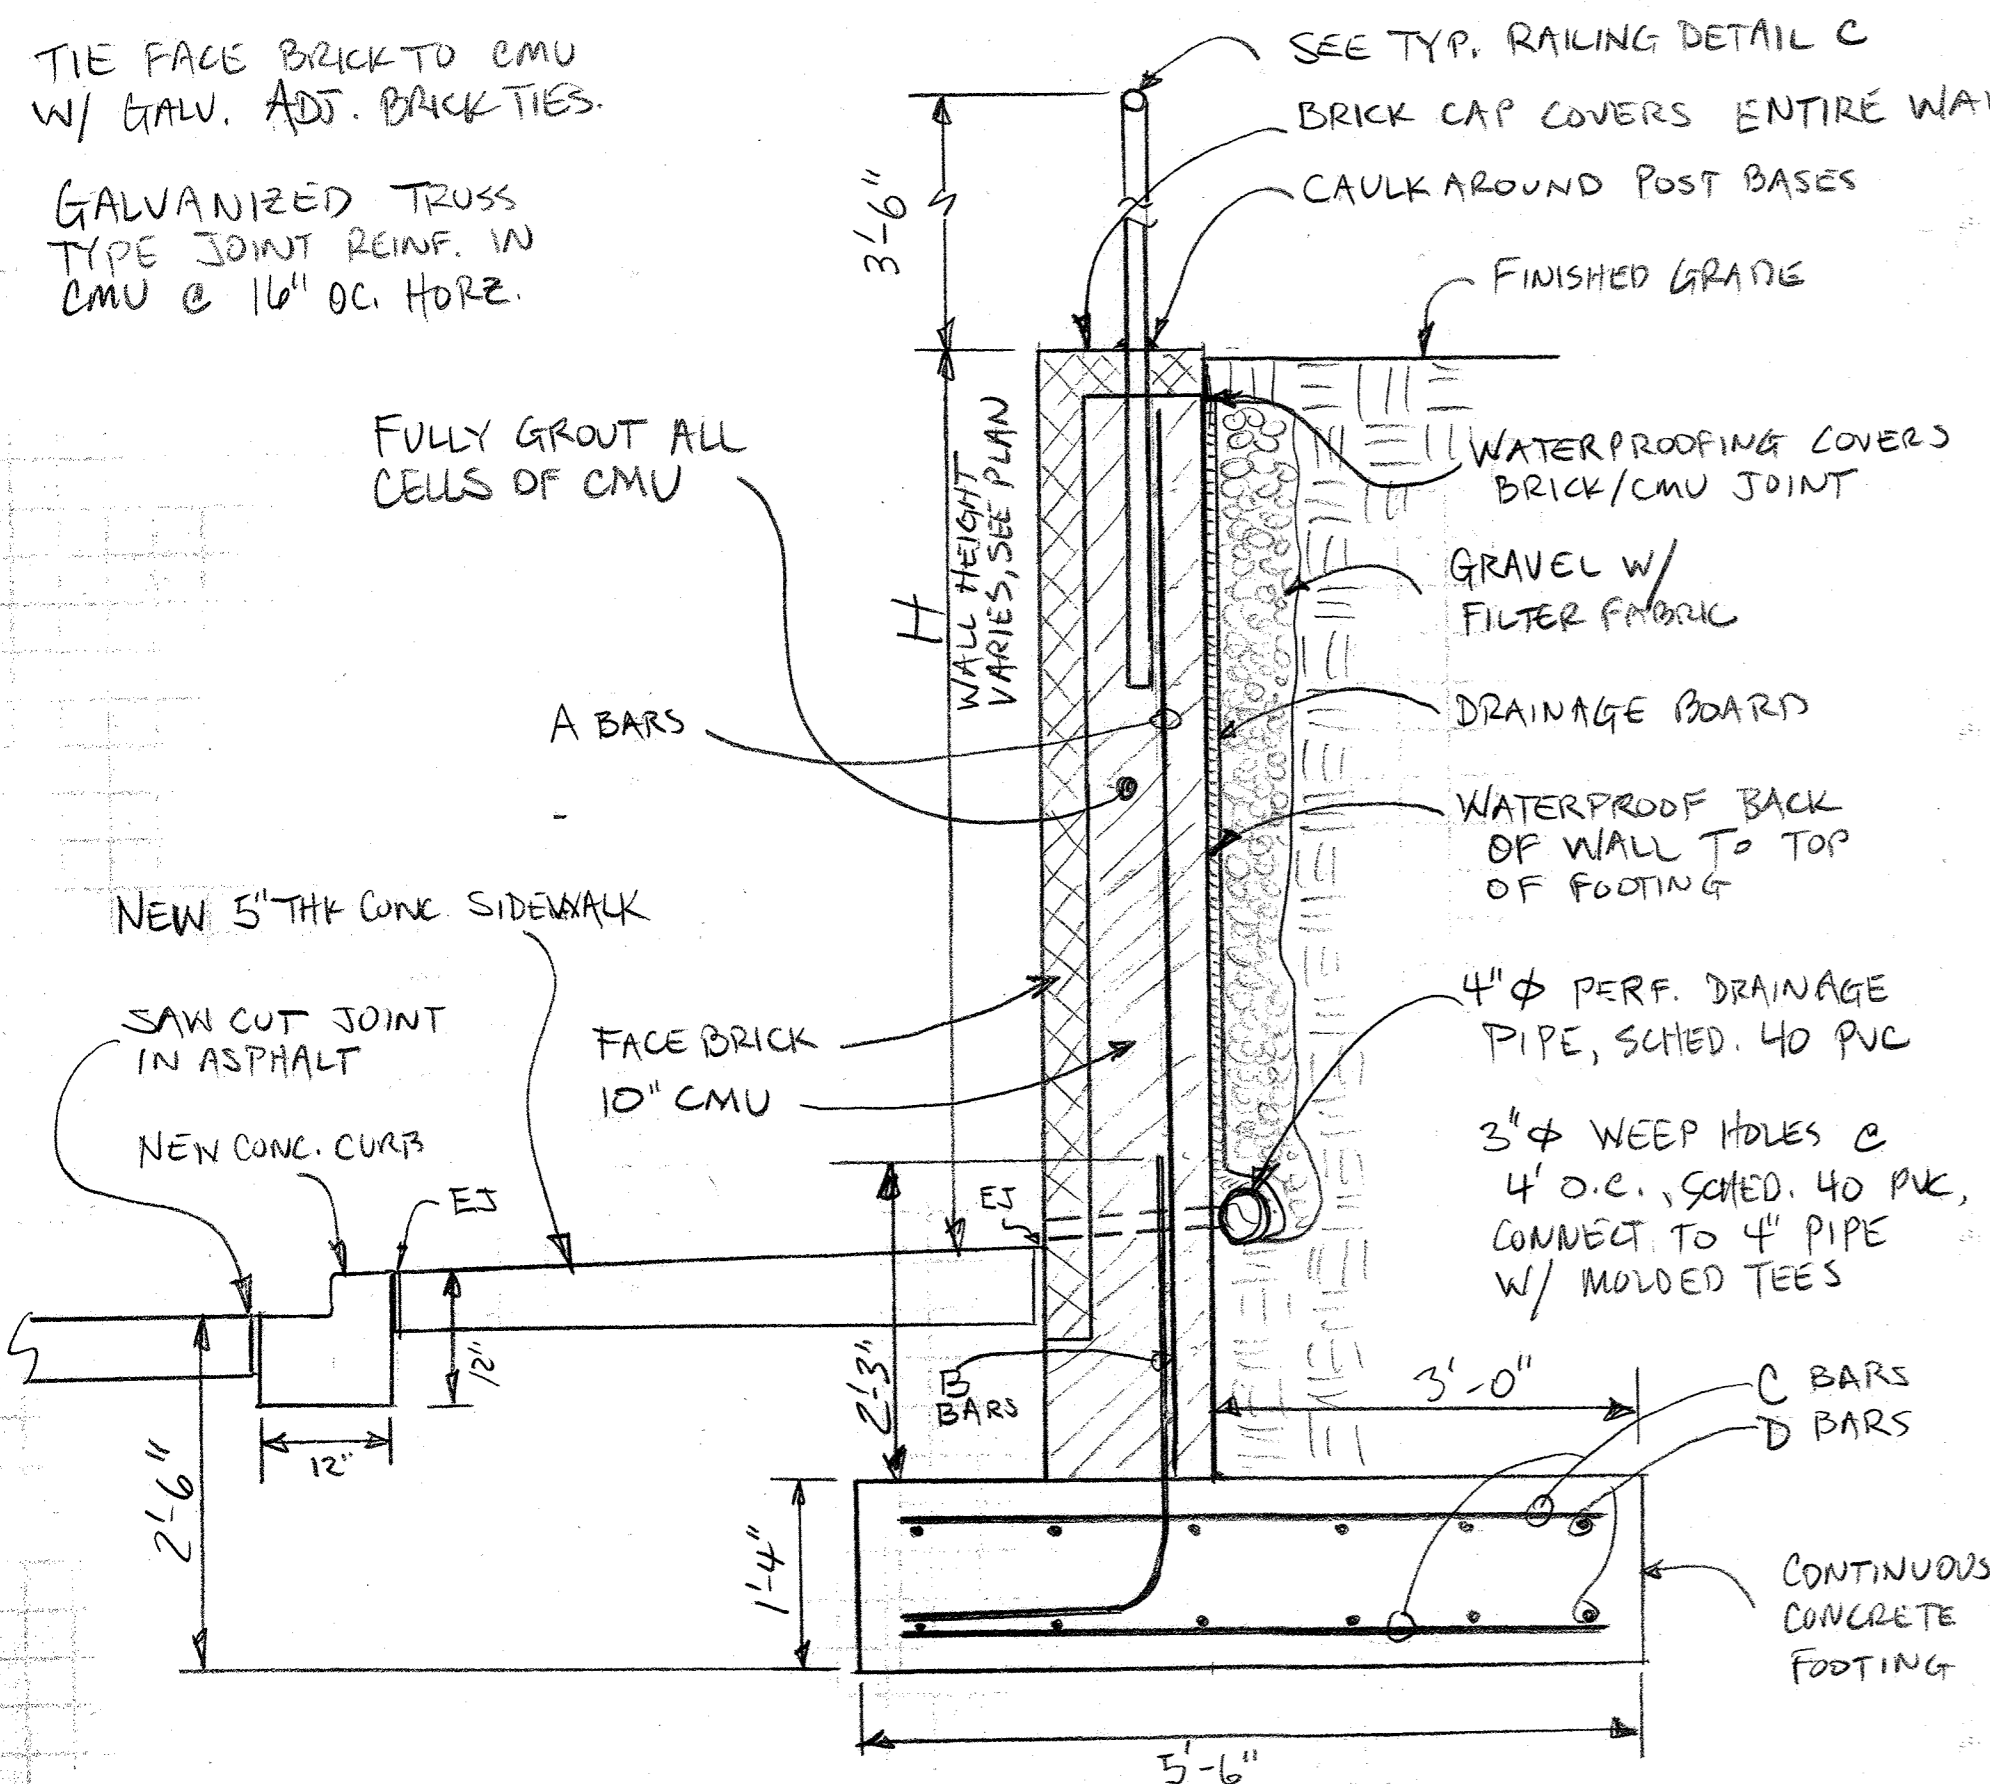

WALL REINFORCING SCHEDULE


HEIGHT H	A BARS	B BARS	C BARS	D BARS
4'-0"	#4@16"	#4@8"	#4@12"	#3@12"
5'-0"	#4@16"	#4@8"		
6'-0"	#5@16"	#4@8"		
7'-0"	#5@8"	#5@8"		

ALL CELLS OF CMU SHALL  
BE FULLY GROUTED

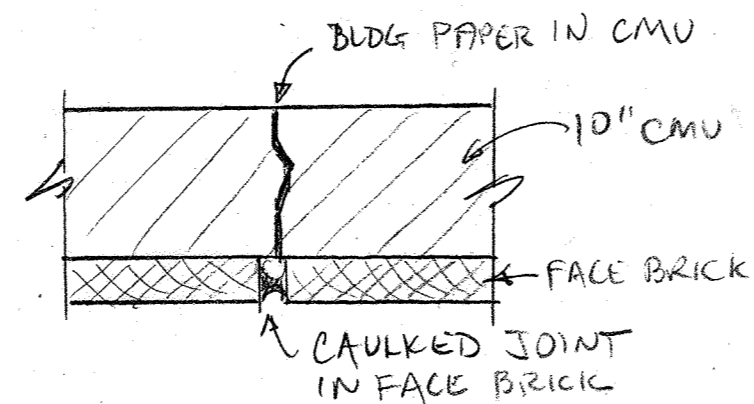

PLAN SECTION - CONTROL JOINT NTS  
INSTALL CONTROL JOINTS  
VERTICALLY AT APPROX. 20' O.C.

(D) S2 RETAINING WALL SECTION 3/4" = 1'-0"

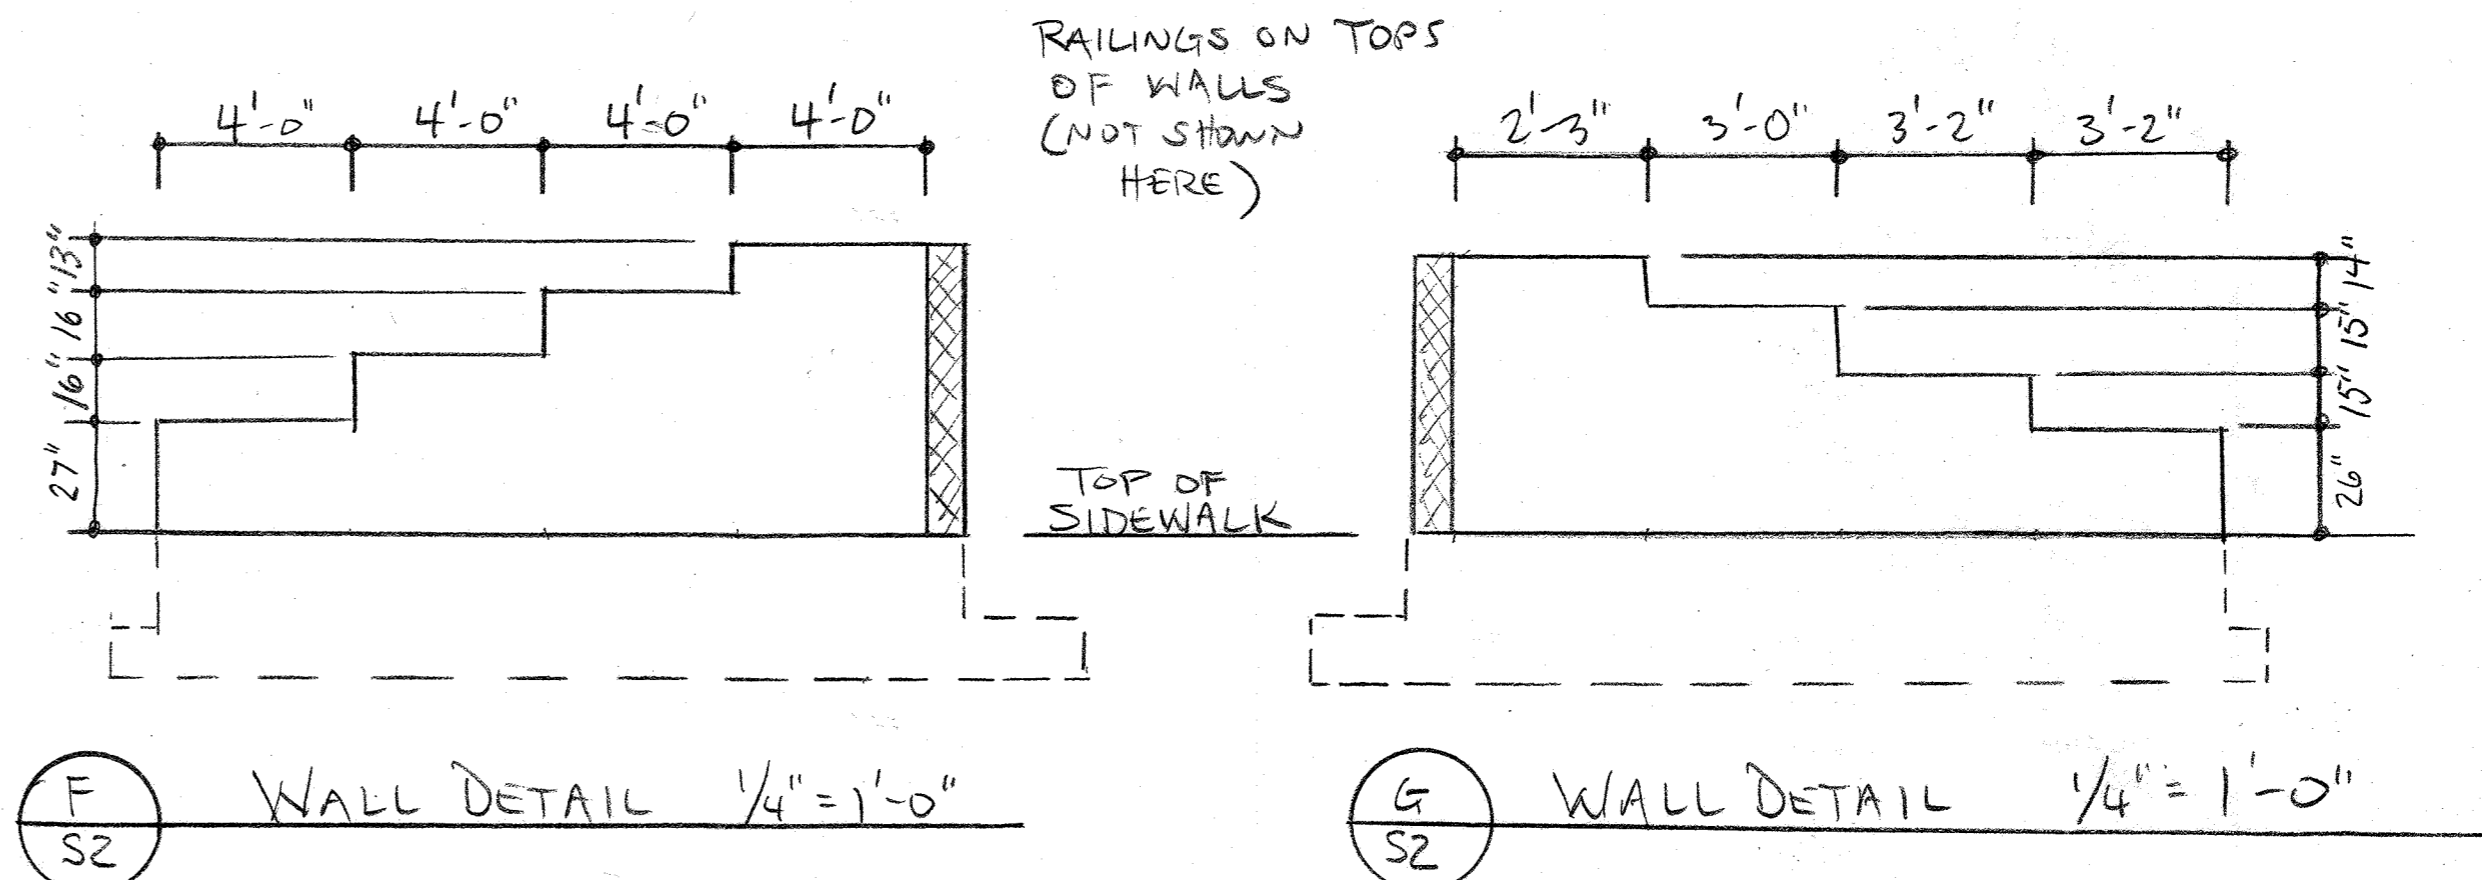


(F) S2 WALL DETAIL 1/4" = 1'-0"


(G) S2 WALL DETAIL 1/4" = 1'-0"

ADJUST RISER/TREAD DIMENSIONS  
TO BE CONSISTENT FOR ALL STEPS

RISERS MIN. 5" MAX. 7"  
TREADS MIN. 11" MAX. 13"

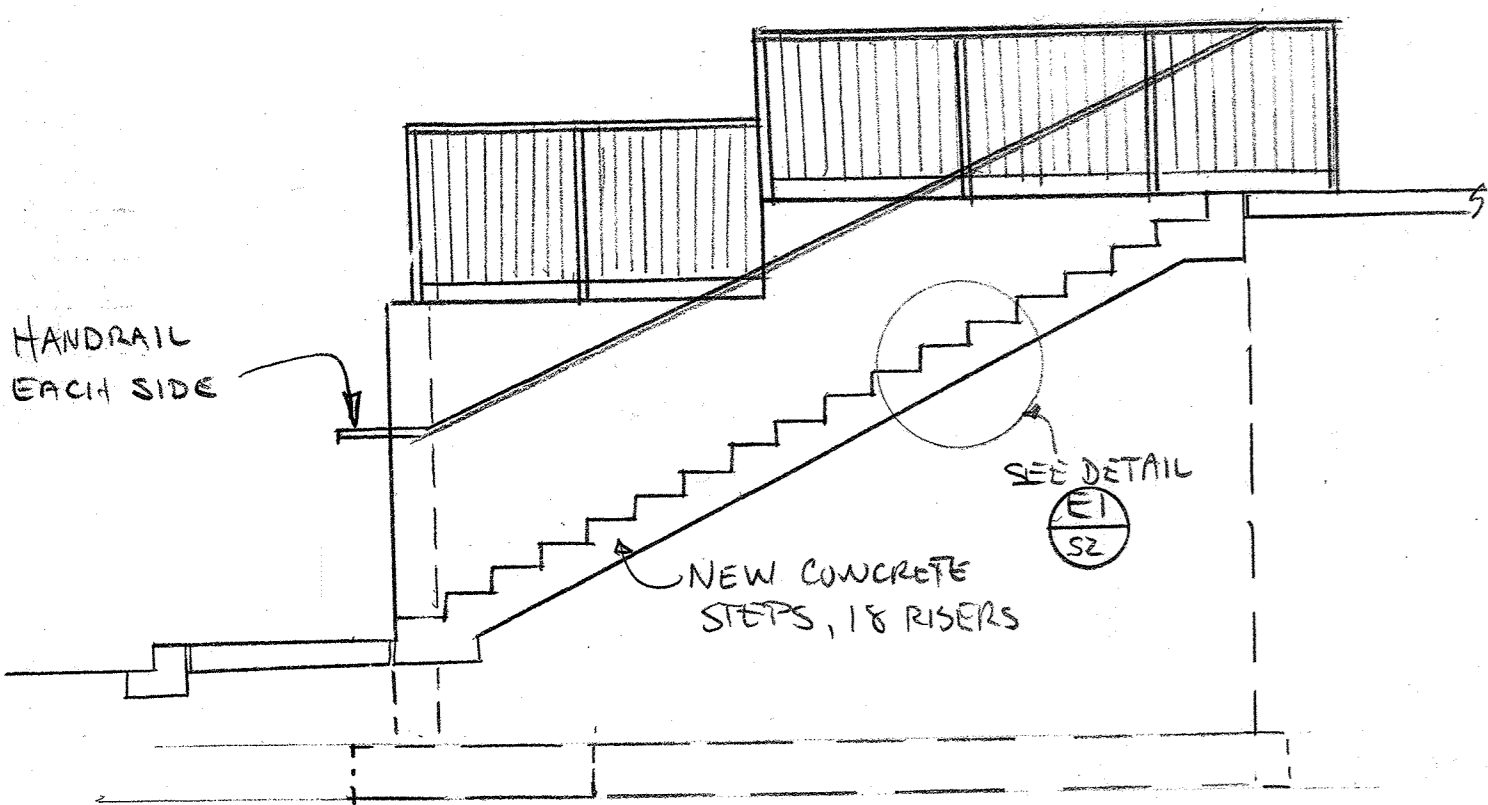

(E) S2 STEP DETAILS 1/4" = 1'-0"

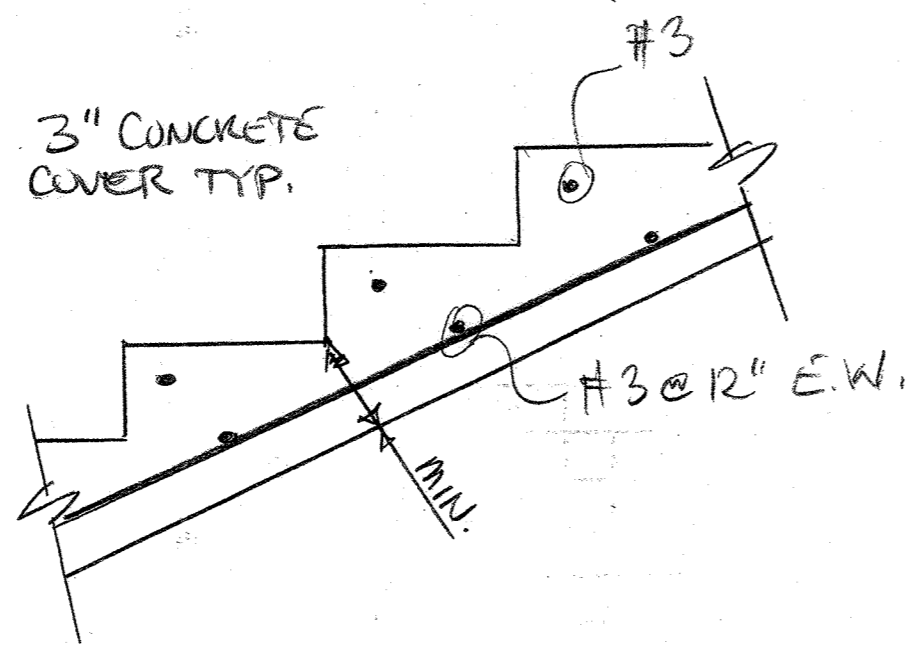


(E1) S2 STEP DETAILS NTS

APPROVED: DEPARTMENT OF PLANNING AND ZONING

*[Signature]* 5/4/09  
Chief, Development Engineering Division Date

*[Signature]* 5/5/09  
Chief, Division of Land Development Date

*[Signature]* 5/7/09  
Director Date

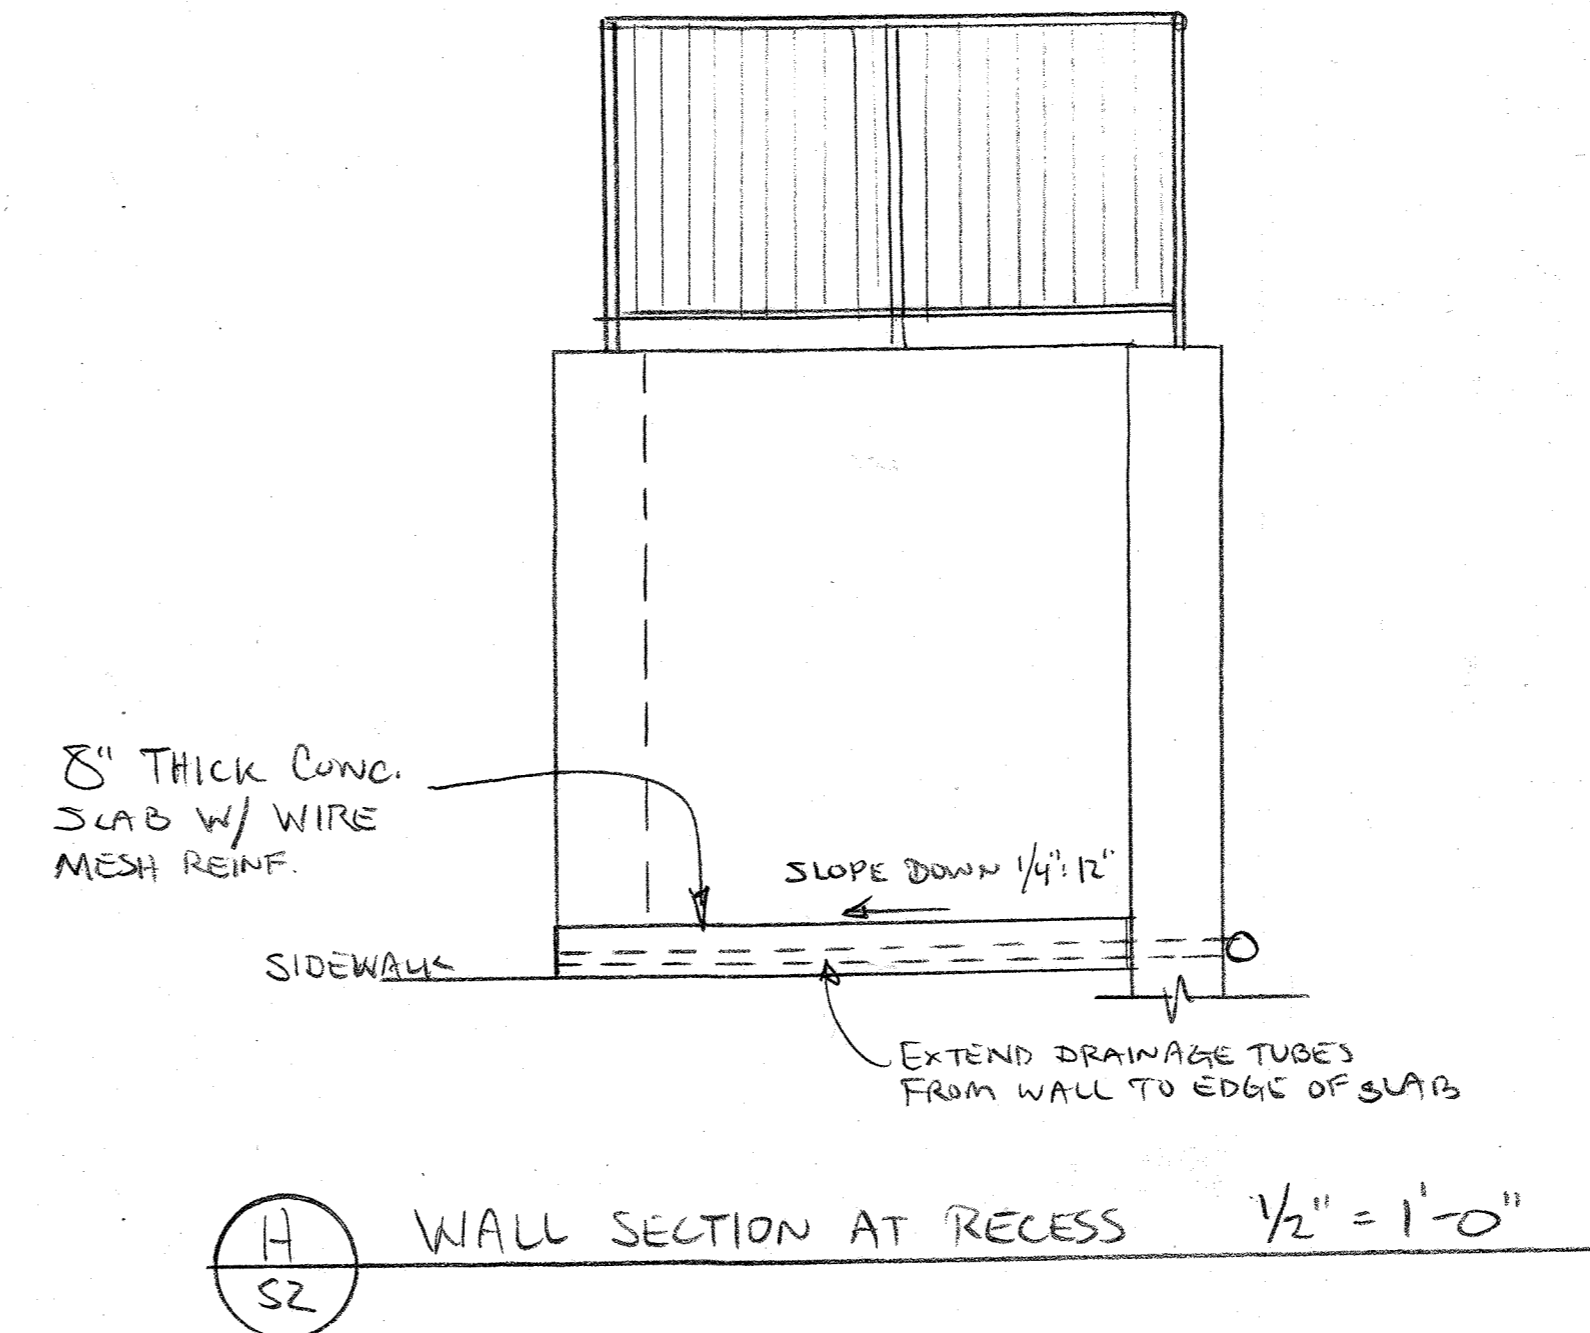

(A) S2 WALL SECTION AT RECESS 1/2" = 1'-0"

PERMIT INFORMATION CHART				
Whiskey Bottom South Condominiums	Section 2			
SDP-72-084	Residential	Tax Map 50	Election District 6	Parcel 479

ENGINEER'S CERTIFICATE  
I certify that this plan for sediment and erosion control represents a practical and workable plan based on my personal knowledge of the site conditions and that it was prepared in accordance with the requirements of the Howard Soil Conservation District.

*[Signature]* 4/2/09  
G. Douglas White, P.E., No. 20312 Date

OWNER: Whiskey Bottom South Condominium Association  
c/o Site Realty Group, 2141 Industrial Parkway, Silver Spring, Maryland 20904 54176 200  
(301) 622-9300

ENGINEER: Thomas Downey, Ltd.  
301 N. Fairfax Street, Suite 108, Alexandria, Virginia 22314  
703-548-3403



Professional Certification  
I certify that these documents were prepared or approved by me, and that I am a duly licensed professional engineer under the laws of the State of Maryland, license number 20312, expiration date January 7, 2010.

**THOMAS DOWNEY, LTD.**  
CONSULTING ENGINEERS  
301 N. FAIRFAX ST., SUITE 108, ALEXANDRIA, VIRGINIA 22314  
OFFICE (703) 548-3403  
FAX (703) 548-3715

WHISKEY BOTTOM SOUTH  
9200 Bridle Path Lane  
Laurel, Maryland 20723


DETAILS  
ISSUED FOR REVIEW 10-23-2008  
Issued for construction 2-9-2009

RETAINING WALL REPLACEMENT

SHEET S2 OF 17

SDP-72-084

S-10 OF 17 24

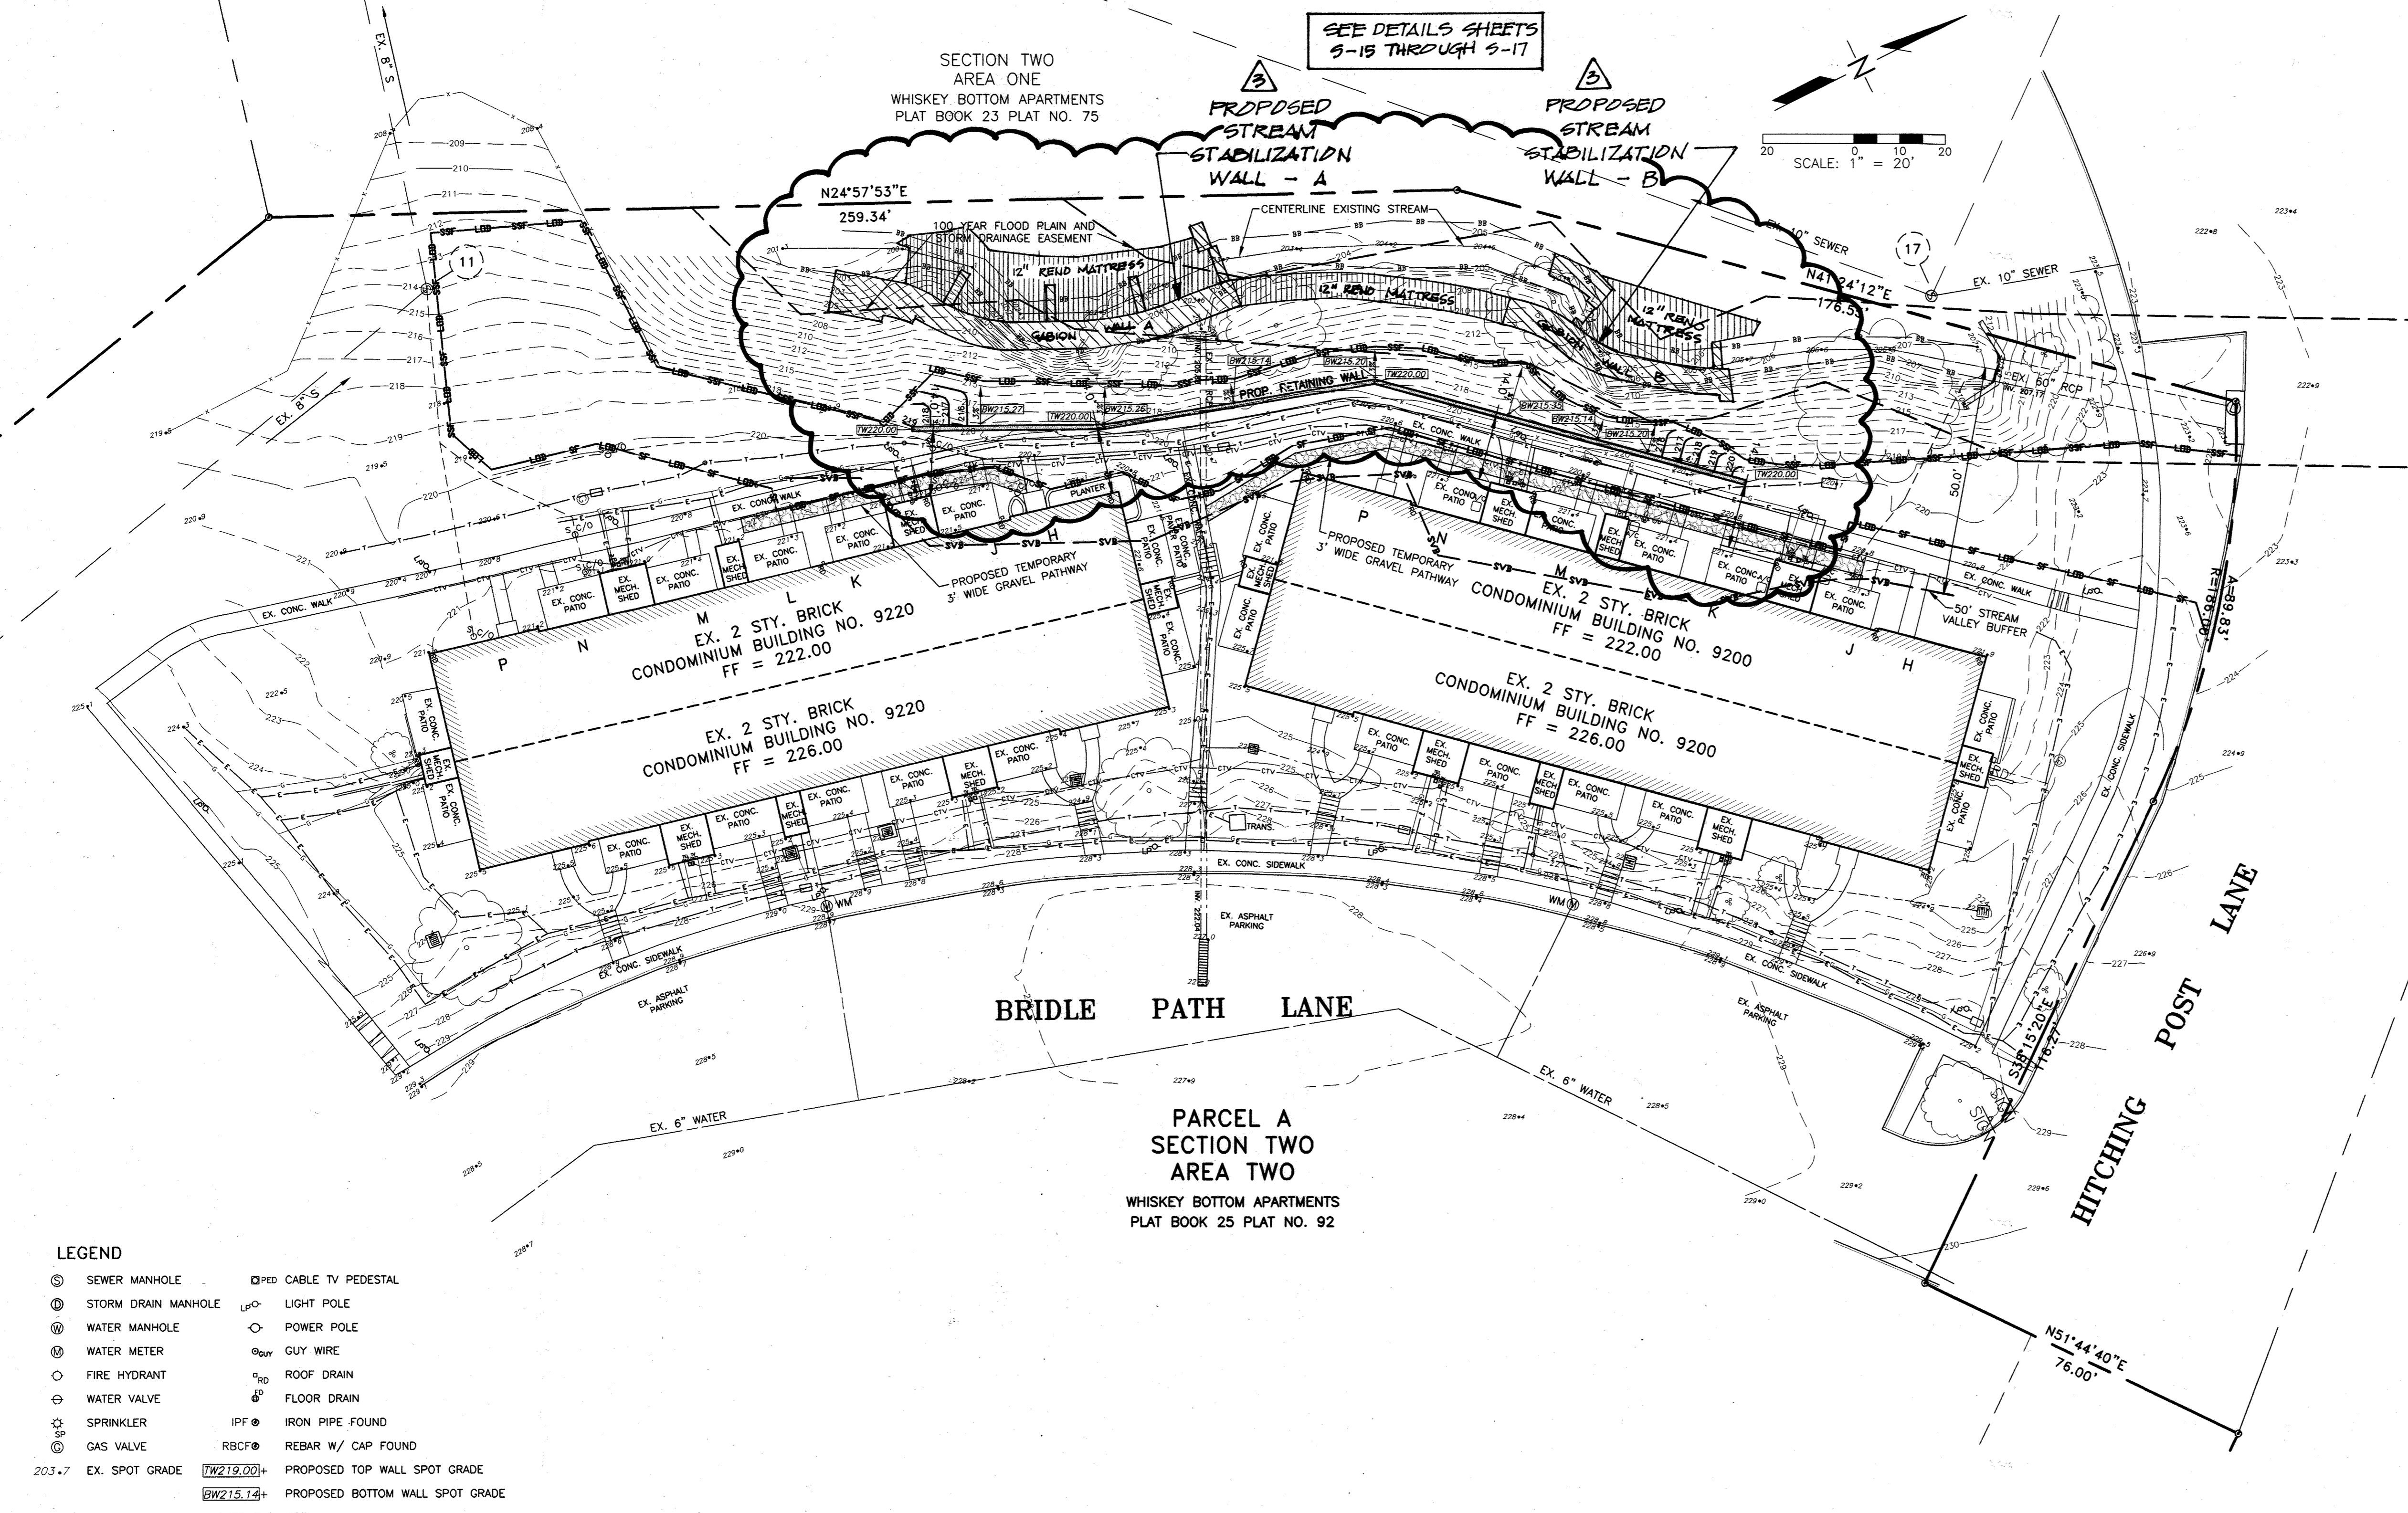

SEE DETAILS SHEETS  
S-15 THROUGH S-17

SECTION TWO  
AREA ONE  
WHISKEY BOTTOM APARTMENTS  
PLAT BOOK 23 PLAT NO. 75

PROPOSED  
STREAM  
STABILIZATION  
WALL - A

PROPOSED  
STREAM  
STABILIZATION  
WALL - B

SCALE: 1" = 20'

BRIDLE PATH LANE

PARCEL A  
SECTION TWO  
AREA TWO  
WHISKEY BOTTOM APARTMENTS  
PLAT BOOK 25 PLAT NO. 92

HITCHING POST LANE

**GENERAL NOTES:**

1. Site property is known as Section Two - Area Two, Whiskey Bottom Apartments recorded Plat Book 25 at Plat No. 92. Current Zoning: R-A-15
2. The site lies within the Patuxent River Watershed.
3. Topographic information from survey conducted in the field August and September, 2015 by Landmark Engineering, Inc. Horizontal Data per Plat No. 92. Vertical Datum per previous approved Site and Grading Plan.
4. No Significant and Specimen trees observed on site or on immediately adjacent property within 100' of the property boundary. The tree diameters were measured using diameter tape or estimated for inaccessible trees.
5. The property is not located within a FEMA mapped 100-year floodplain as determined in review of Howard County, Maryland Community Panel No. 24027C0230D with effective date of November 6, 2013.
6. The proposed retaining wall is for stabilization of unstable slope caused by the erosion of the toe of the slope by water flowing from the creek at rear of the existing condominium building numbers 9200 and 9220. Due to this eroded slope, settlement of the sidewalks, lamp poles, fences and lawn areas has been observed. Also observed are interior and exterior cracks on some of the units of the two buildings are present due to this unstable slope. Installing this wall will stabilize the grade settlement and also prevent further structural damages to the two existing condominium buildings.
7. Wall design to be per plan by Professional Consulting Corporation. Proposed wall to be gravity wall. Work to be executed under guidance of geotechnical engineer.
8. Activities located within stream buffer are considered necessary in accordance with Subsection 16.116(c).
9. Relocation of underground and above ground utilities to be coordinated with the utility companies.
10. Temporary access pathway closure and route will be in coordination with the general contractor.

**LEGEND**

SM	SEWER MANHOLE	CPED	CABLE TV PEDESTAL
SDM	STORM DRAIN MANHOLE	LP	LIGHT POLE
WM	WATER MANHOLE	PP	POWER POLE
WMT	WATER METER	GUY	GUY WIRE
FH	FIRE HYDRANT	RD	ROOF DRAIN
WV	WATER VALVE	FD	FLOOR DRAIN
SP	SPRINKLER	IPF	IRON PIPE FOUND
GV	GAS VALVE	RBCF	REBAR W/ CAP FOUND
203.7	EX. SPOT GRADE	TW219.00	PROPOSED TOP WALL SPOT GRADE
		TW215.14	PROPOSED BOTTOM WALL SPOT GRADE
OH	OVERHEAD WIRE		
G	UNDERGROUND GAS		
T	UNDERGROUND TELECOMMUNICATION		
CTV	UNDERGROUND CABLE TV		
E	UNDERGROUND ELECTRIC		
W	WATER		
S	SEWER		
S-S	SEWER HOUSE CONNECTION		
SD	STORM DRAIN		
IC	INDEX CONTOUR		
INT	INTERMEDIATE CONTOUR		
SV	STREAM		
SVB	STREAM VALLEY BUFFER		
216	PROPOSED CONTOUR		
LDB	PROPOSED LIMITS OF DISTURBANCE		
SF	PROPOSED SILT FENCE		
SSF	PROPOSED SUPER SILT FENCE		


HOWARD COUNTY OFFICE OF PLANNING AND ZONING APPROVED

*[Signature]* 7-11-17  
CHIEF, LAND DEVELOPMENT DATE

*[Signature]* 7-7-17  
CHIEF, DEVELOPMENT ENGINEERING DIVISION DATE

*[Signature]* 7-11-17  
DIRECTOR OF PLANNING AND ZONING DATE

**PROFESSIONAL CERTIFICATION**  
I HEREBY CERTIFY THAT THESE DOCUMENTS WERE PREPARED OR APPROVED BY ME, AND THAT I AM A DULY LICENSED PROFESSIONAL ENGINEER UNDER THE LAWS OF THE STATE OF MARYLAND, LICENSE NO. 11124, EXPIRATION DATE: OCTOBER 3, 2022.

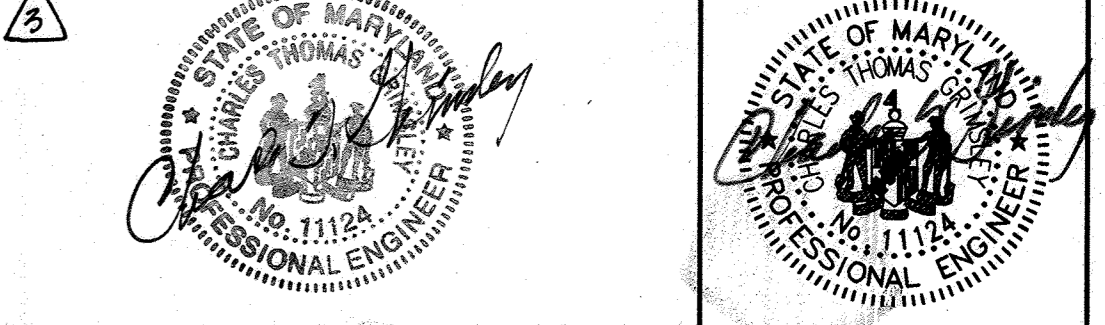


OWNER-DEVELOPER  
WHISKEY BOTTOM CONDOMINIUMS, ASSOC.  
c/o MR. ARTHUR F. BLUME, PRESIDENT  
WHISKEY BOTTOM SOUTH, BOARD OF DIRECTORS  
9220 BRIDLE PATH LANE, UNIT F  
LAUREL, MD. 20723

**LANDMARK ENGINEERING, INC.**  
6110 EXECUTIVE BLVD, SUITE 110 PHONE: (301) 230-5881  
ROCKVILLE, MARYLAND 20852 FAX: (301) 230-5884  
CONSULTING ENGINEERS PLANNERS SURVEYORS

**WHISKEY BOTTOM APARTMENTS**  
SIXTH ELECTION DISTRICT  
HOWARD COUNTY, MARYLAND

**EXISTING PROPOSED RETAINING WALL**  
SITE PLAN, GRADING PLAN AND PROFILE

REVISIONS		DRN: DCV	CK: CTG
MAY 10, 2022 ADD PROP STREAM STABILIZATION SITES		PROJECT NO.: 1530	DRAWING NO. S-11
		SCALE: AS SHOWN	OF 47-24
		DATE: MAY 5, 2017	

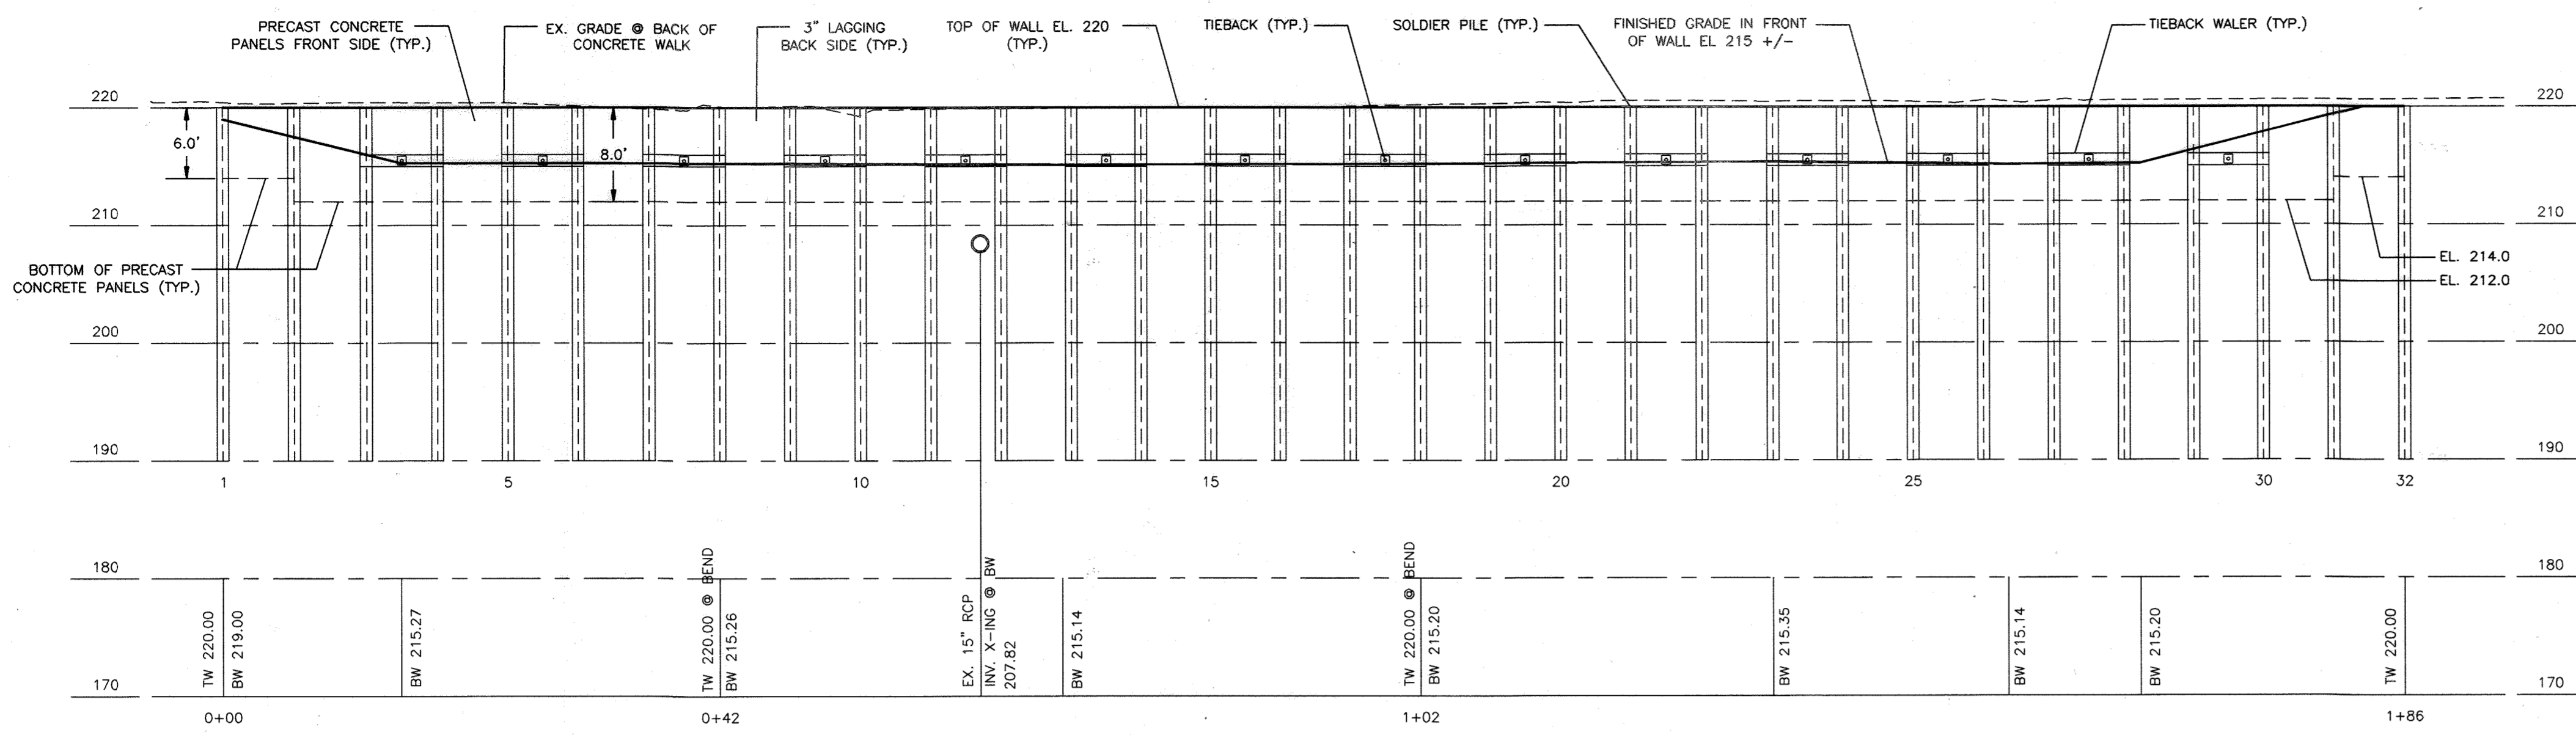

**WALL PROFILE VIEW**


HORIZONTAL & VERTICAL  
SCALE: 1" = 10'

**SEQUENCE OF CONSTRUCTION**

1. ALL SEDIMENT CONTROL MEASURES TO BE INSTALLED. LAYOUT SOLDIER PILES. CONTRACTOR TO NOTIFY "MISS UTILITY" AND VERIFY ALL UTILITY LOCATIONS AND RESOLVE ALL POTENTIAL CONFLICTS PRIOR TO DRILLING SOLDIER PILES. SEE CIVIL DRAWINGS FOR ADDITIONAL INFORMATION.
2. INSTALL ALL SOLDIER PILES DOING EVERY OTHER PILE AT A TIME. ADDITIONAL HOLES ARE NOT TO BE DRILLED UNTIL ADJACENT HOLES ARE SET & FILLED.
3. INSTALL SAFETY RAIL. NOTE THAT SAFETY RAIL IS FOR WORKER PROTECTION ONLY. INSTALL TEMPORARY FENCE A FEW FEET INSIDE WALL FOR PUBLIC SAFETY. INSTALL ALL WALERS AND LAGGING ABOVE WALERS DOING EVERY OTHER BAY AT A TIME. FULLY BACKFILL AND COMPACT EACH COMPLETED BAY BEFORE EXCAVATING ADJACENT BAYS.
4. INSTALL AND TEST ALL TIEBACKS. INSTALL TRUMPETS, TOP GROUT, CAPS AND CAP GREASE.
5. COMPLETE EXCAVATION AND LAGGING TO BOTTOM OF NEW PANELS.
6. POWER WASH, PRIME AND PAINT ALL EXPOSED STEEL. INSTALL FILTER FABRIC OVER ENTIRE WALL FULLY COVERING ALL LAGGING.
7. INSTALL CONCRETE PANELS AND #57 STONE FROM THE BOTTOM UP. NOTE PANELS MUST BE LEVEL AND BEAR ON THE PILE TOE CONCRETE.
8. PERMANENT FENCE BY OTHERS TO BE INSTALLED IMMEDIATELY UPON COMPLETION OF THIS WORK.

**PLAN VIEW**


SCALE: 1" = 10'

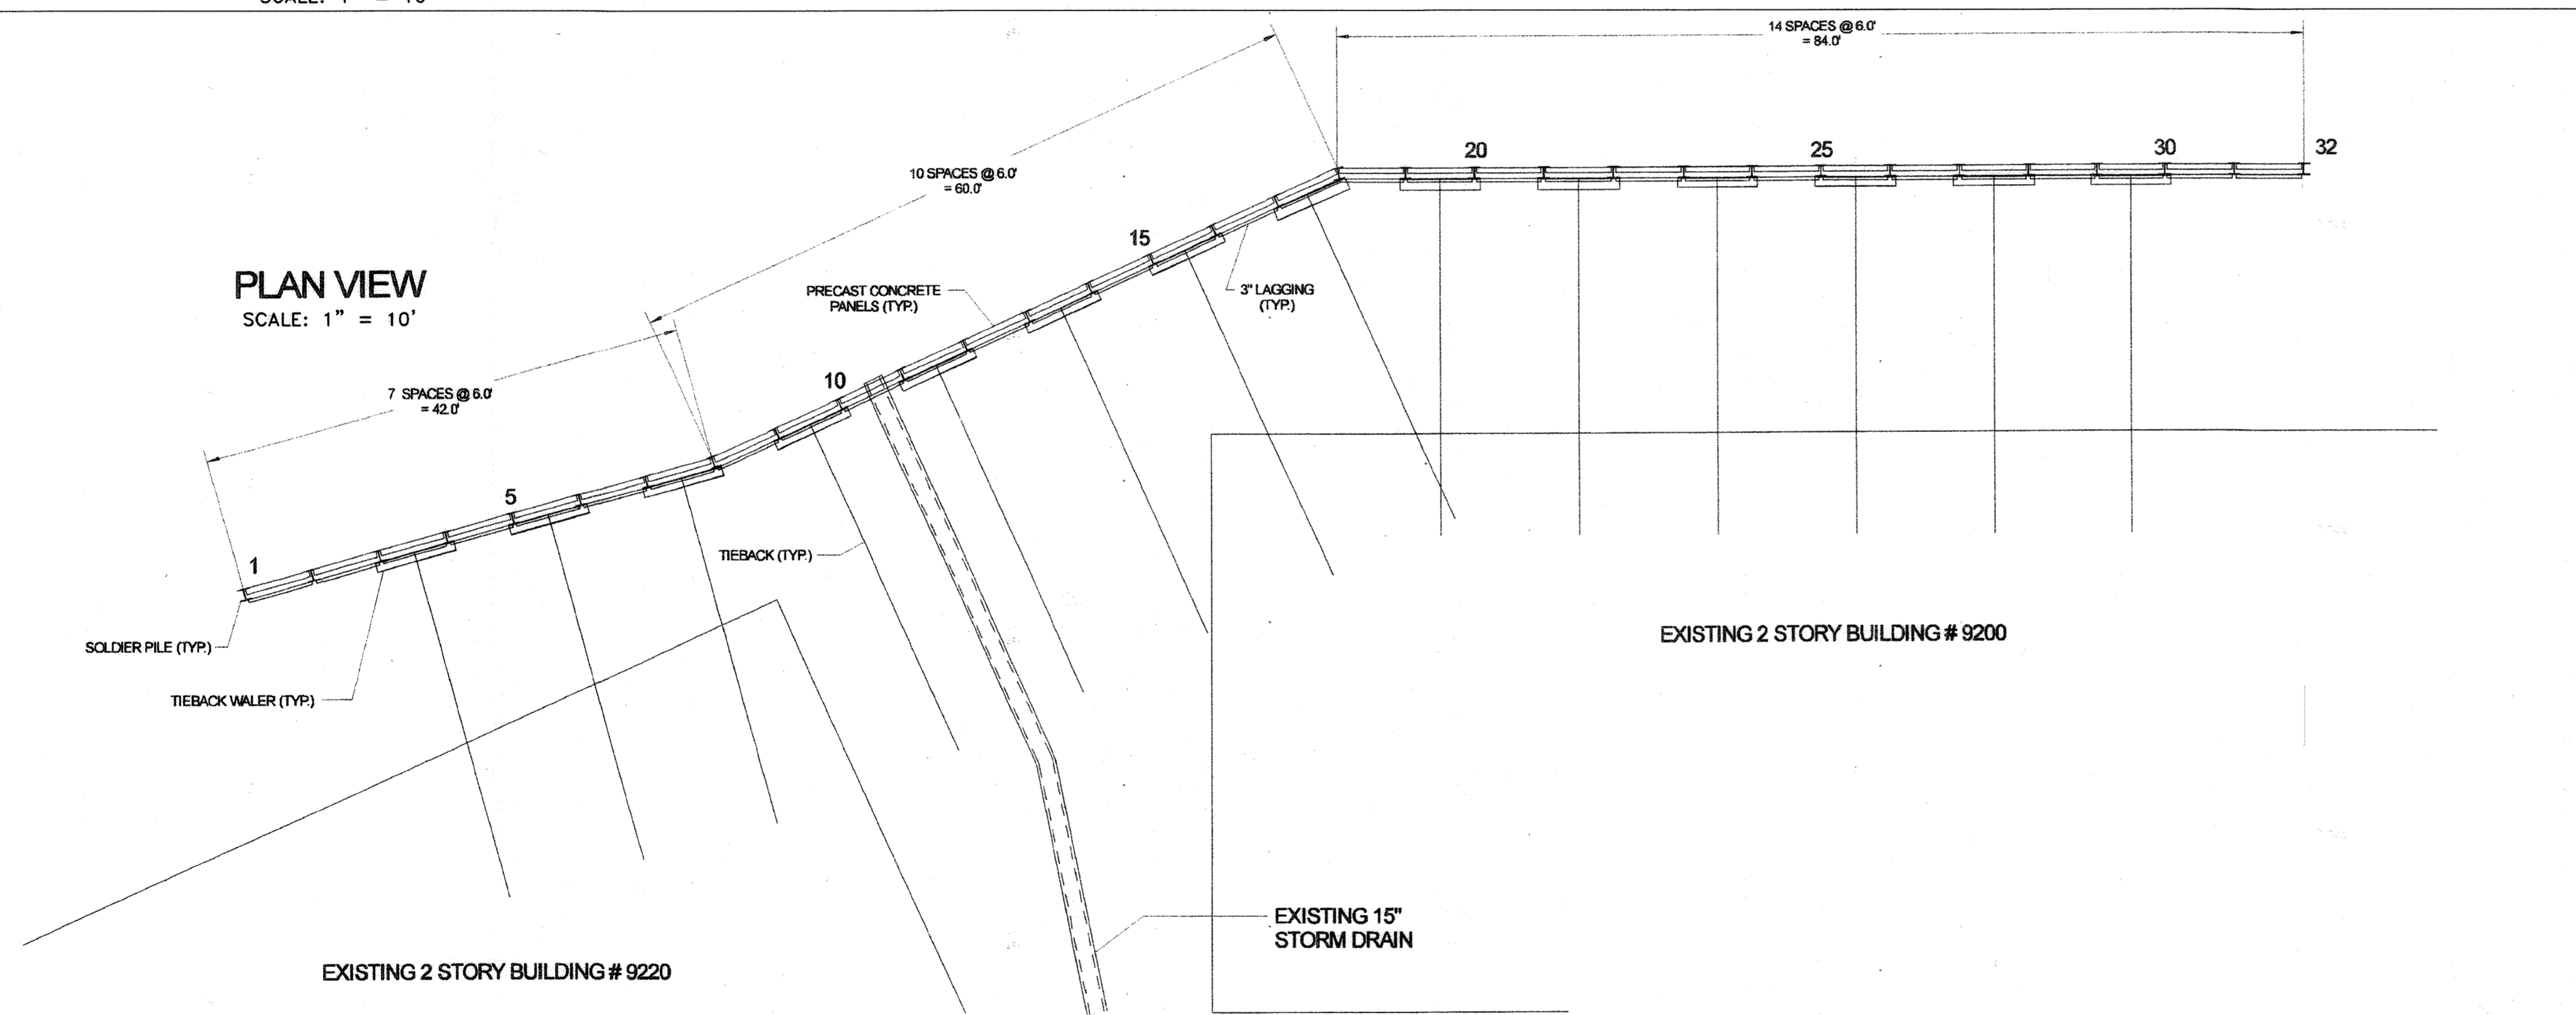

<b>OWNER</b>	WHISKEY BOTTOM SOUTH C/O SIMMONS MGMT. GROUP COLLEGE, MARYLAND 20740
<b>ENGINEER</b>	PROFESSIONAL CONSULTING CORP. PO BOX 129 DUNKIRK, MARYLAND 20754 301-980-4672
<b>PROJECT</b>	WHISKEY BOTTOM APARTMENTS HOWARD COUNTY, MD.
<b>RETAINING WALL</b>	DATE 10/11/2016 REVISION #1 10/23/2016
	DWG. 101

I HEREBY CERTIFY THAT THESE DOCUMENTS WERE PREPARED OR APPROVED BY ME, AND THAT I AM A DULY LICENSED PROFESSIONAL ENGINEER UNDER THE LAWS OF THE STATE OF MARYLAND, LICENSE # 14246, EXPIRATION 12/23/2018

NICHOLAS J. A. WHITE, PE  
301-980-4672

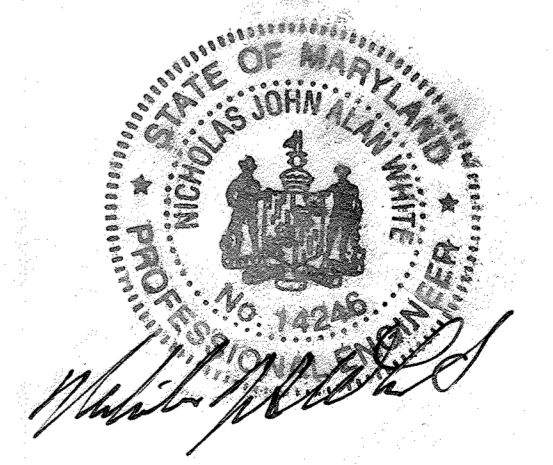

HOWARD COUNTY OFFICE OF PLANNING AND ZONING APPROVED

*Veronica Lewis* 7-11-17  
CHIEF, LAND DEVELOPMENT DIVISION DATE

*Chad Edwards* 7-11-17  
CHIEF, DEVELOPMENT ENGINEERING DIVISION DATE

*Arthur Blume* 7-11-17  
DIRECTOR OF PLANNING AND ZONING DATE

**Owners/Developer Certification:**

"I/We hereby certify that any clearing, grading, construction, or development will be done pursuant to this approved erosion and sediment control plan, including inspecting and maintaining controls, and that the responsible personnel involved in the construction project will have a Certificate of Training at a Maryland Department of the Environment (MDE) approved training program for the control on erosion and sediment prior to beginning the project. I certify right-of-entry for the periodic on-site evaluation by Howard County, the Howard Soil Conservation District and/or MDE."

*Arthur Blume* 4/4/17  
Owner's/ Developer's Signature Date  
ARTHUR BLUME - PRESIDENT  
Printed Name & Title

**Design Certification:**

"I hereby certify that this plan has been designed in accordance with the current Maryland erosion and sediment control laws, regulations, and standards, that it represents a practical and workable plan based on my personal knowledge of the site, and that it was prepared in accordance with the requirements of the Howard Soil Conservation District."

*Charles T. Grimsley* 6/19/17  
Designer's Signature Date  
Charles T. Grimsley  
Printed Name MD P.E. Registration No. 11124

**Howard SCD Signature Block:**

This plan is approved for soil erosion and sediment control by the Howard Soil Conservation District.

*[Signature]*  
Howard Soil Conservation District Date


OWNER-DEVELOPER  
WHISKEY BOTTOM CONDOMINIUMS, ASSOC.  
c/o MR. ARTHUR F. BLUME, PRESIDENT  
WHISKEY BOTTOM SOUTH, BOARD OF DIRECTORS  
9220 BRIDLE PATH LANE, UNIT F  
LAUREL, MD. 20723

**LANDMARK ENGINEERING, INC.**  
6110 EXECUTIVE BLVD, SUITE 110 PHONE: (301) 230-5881  
ROCKVILLE, MARYLAND 20852 FAX: (301) 230-5884  
CONSULTING ENGINEERS PLANNERS SURVEYORS

SECTION TWO  
**WHISKEY BOTTOM APARTMENTS**  
SIXTH ELECTION DISTRICT, HOWARD COUNTY, MARYLAND


SITE DEVELOPMENT PLAN  
**PROPOSED RETAINING WALL**  
**EXISTING**

<b>REVISIONS</b>	DRN: DCV CK: CTG PROJECT NO.: 1530 SCALE: AS SHOWN DATE: MAY 5, 2017	DRAWING NO. S-15 OF 17 12 24
------------------	---	--

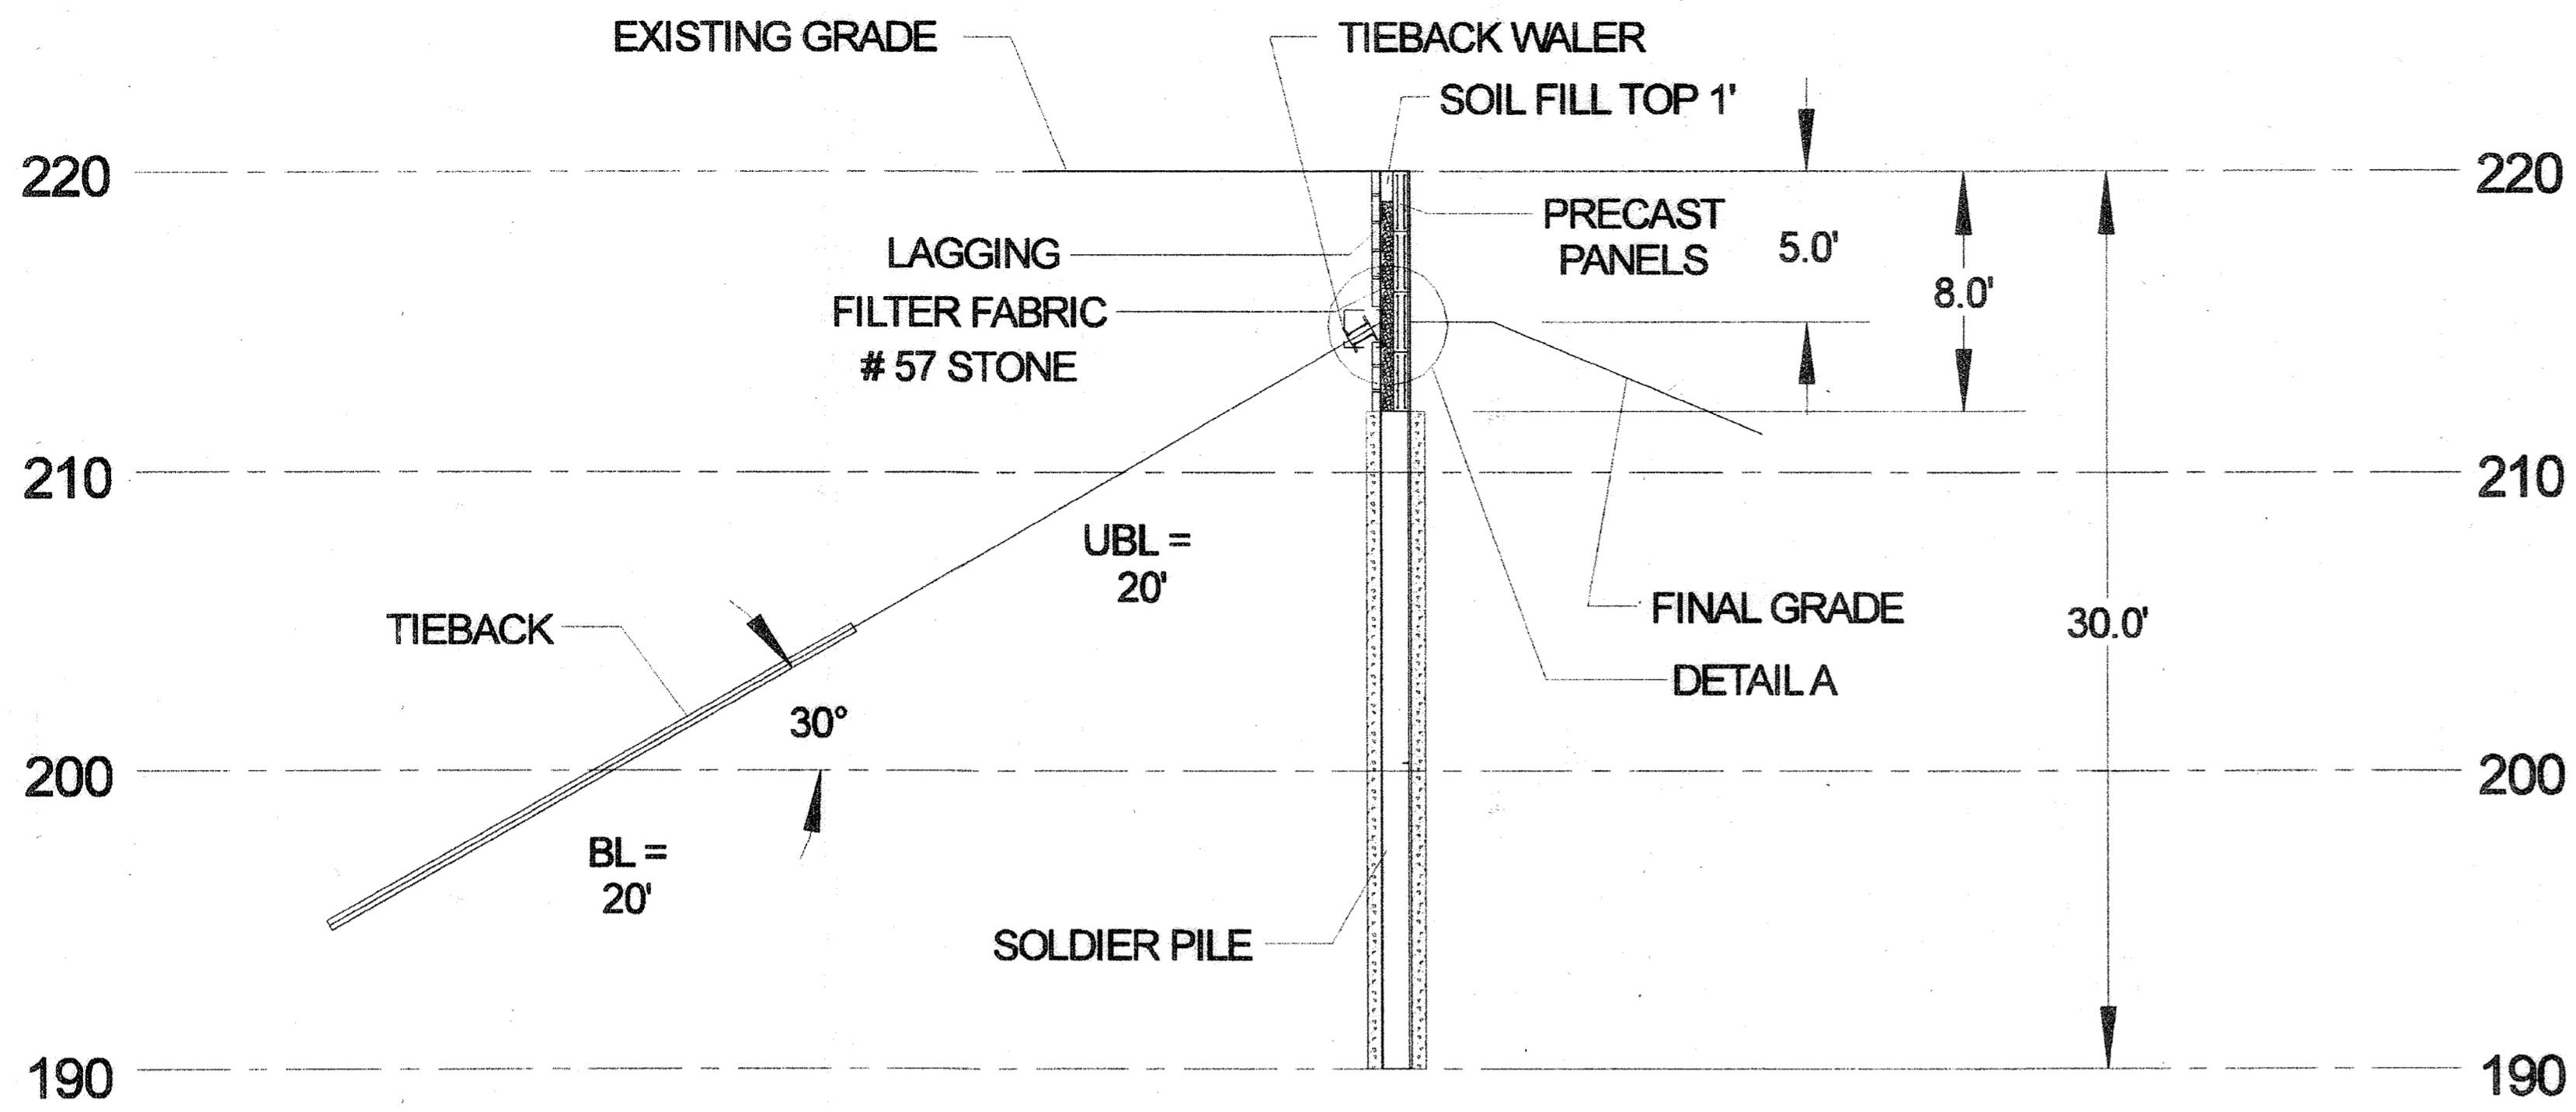


**TYPICAL SECTION**


(SEE CIVIL DRAWINGS FOR DETAILS NOT CONTAINED HEREIN)

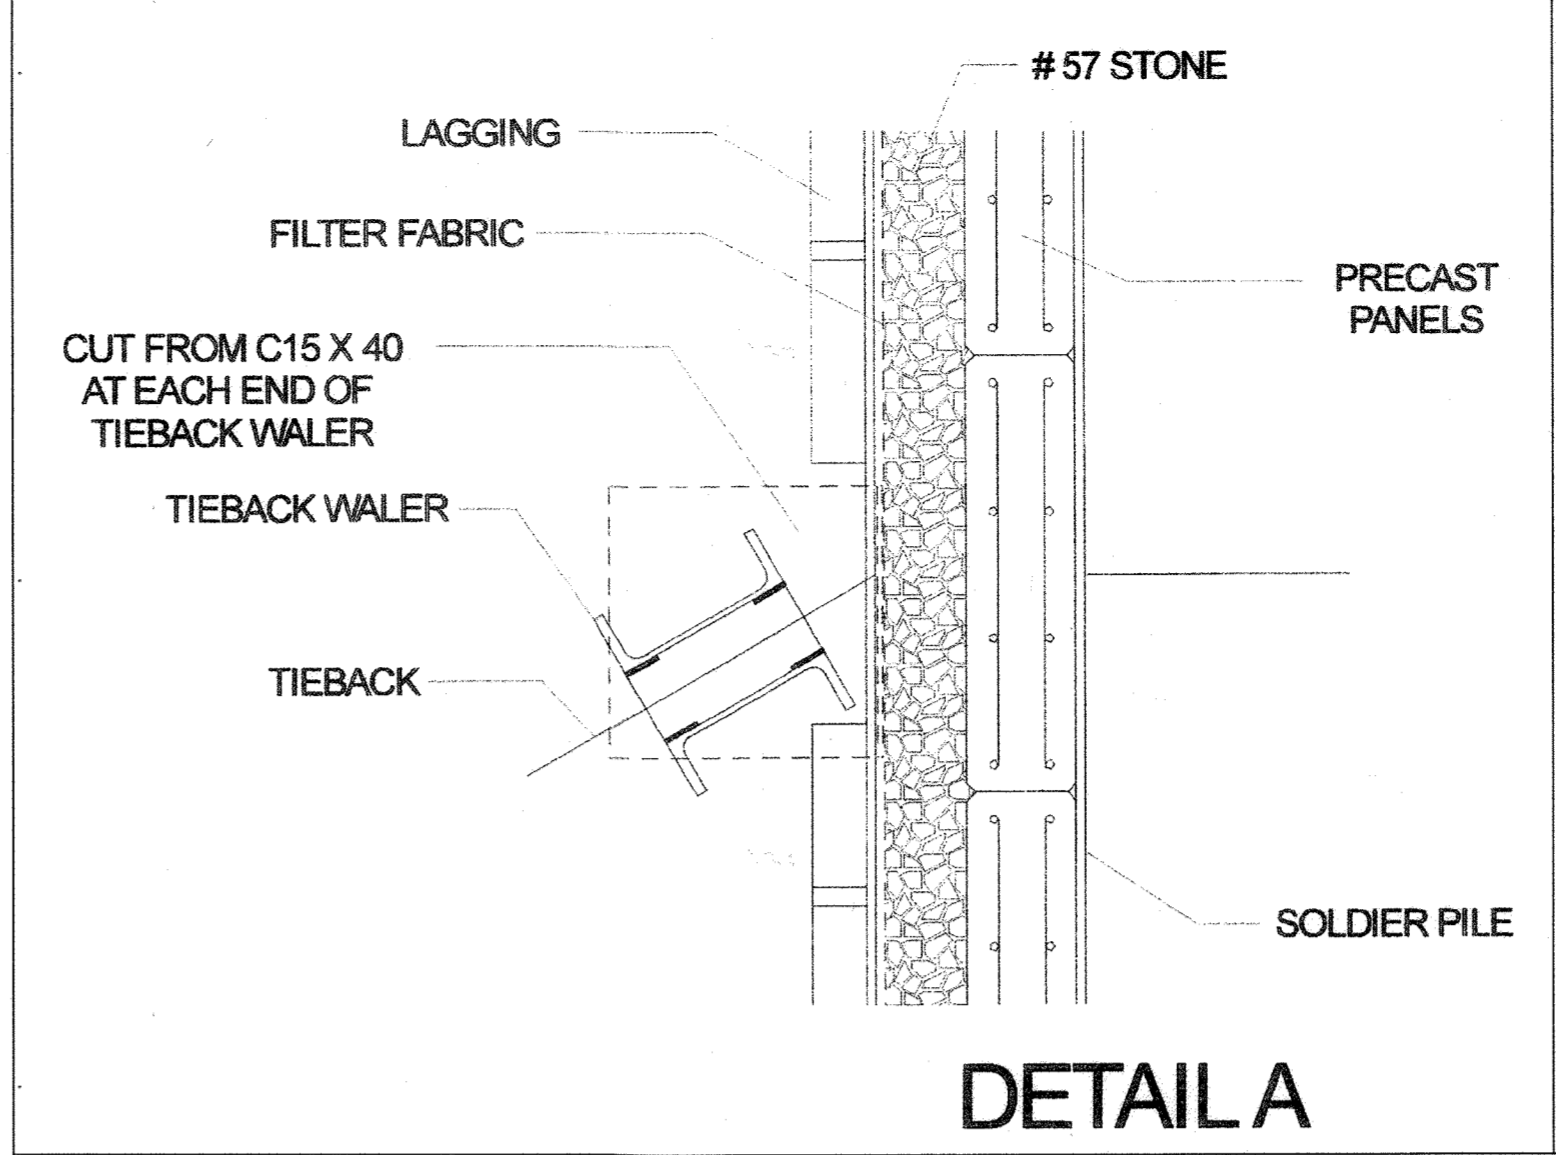

**DETAIL A**

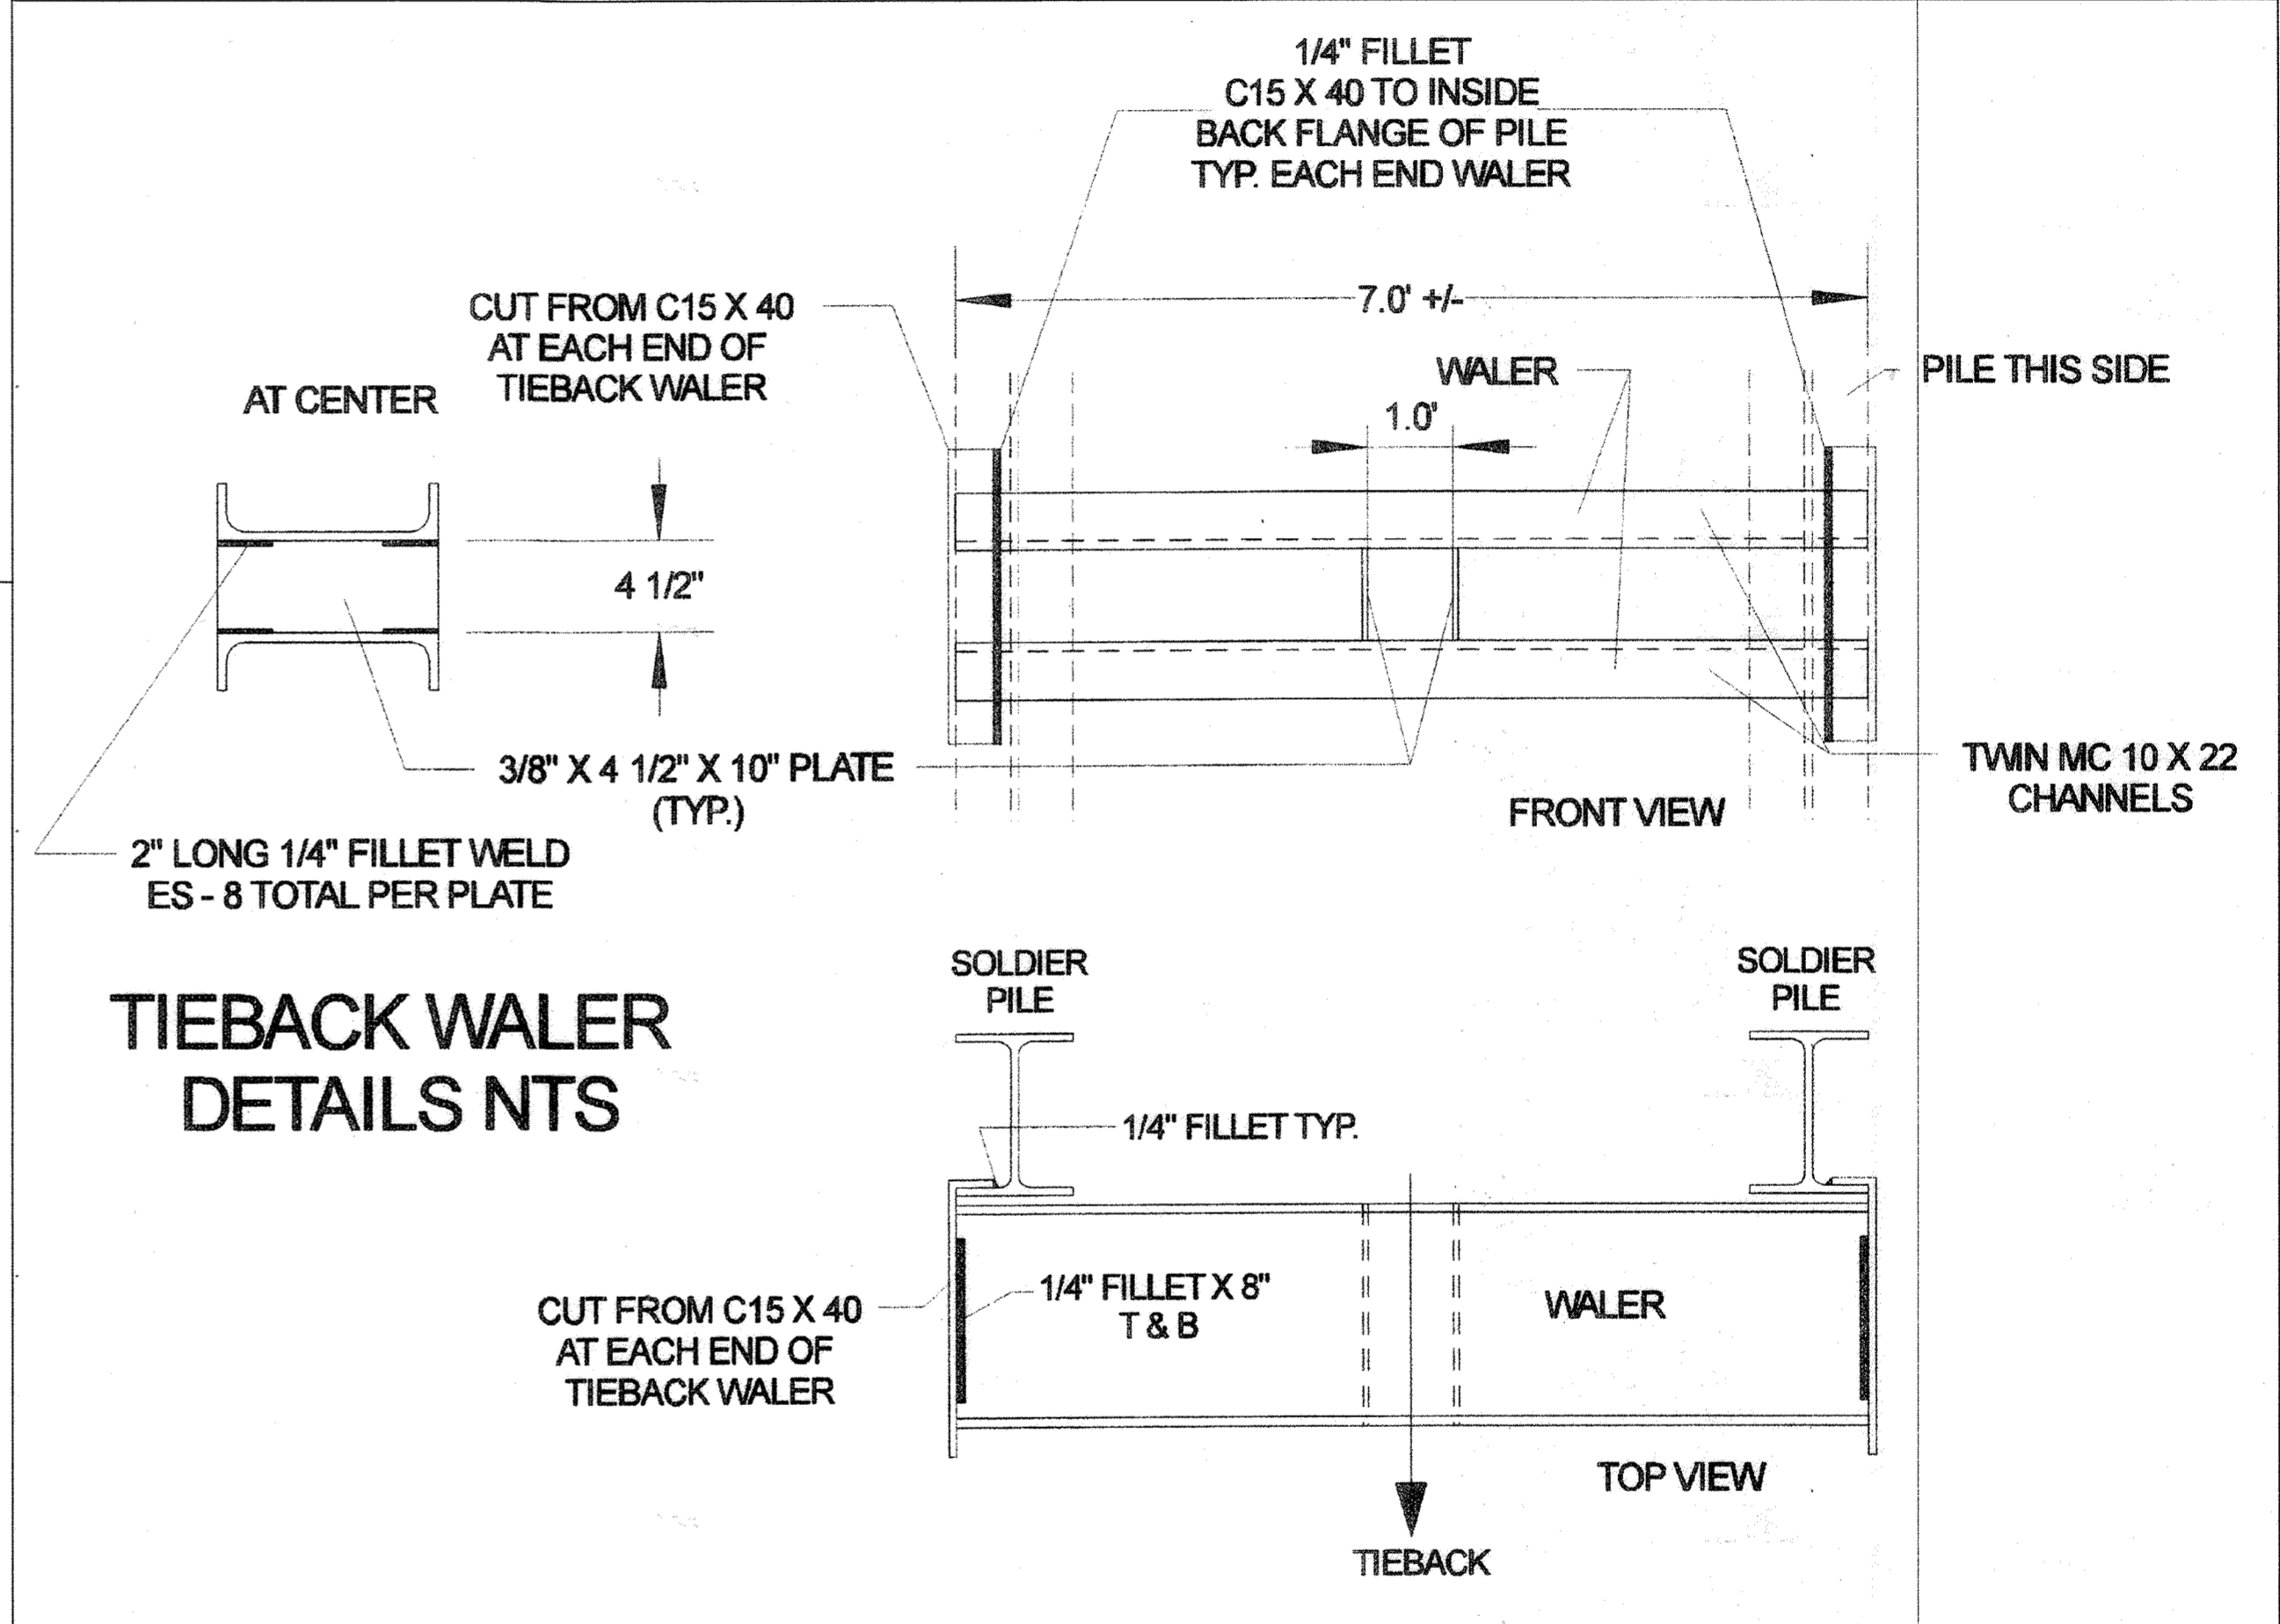

**TIEBACK WALER DETAILS NTS**

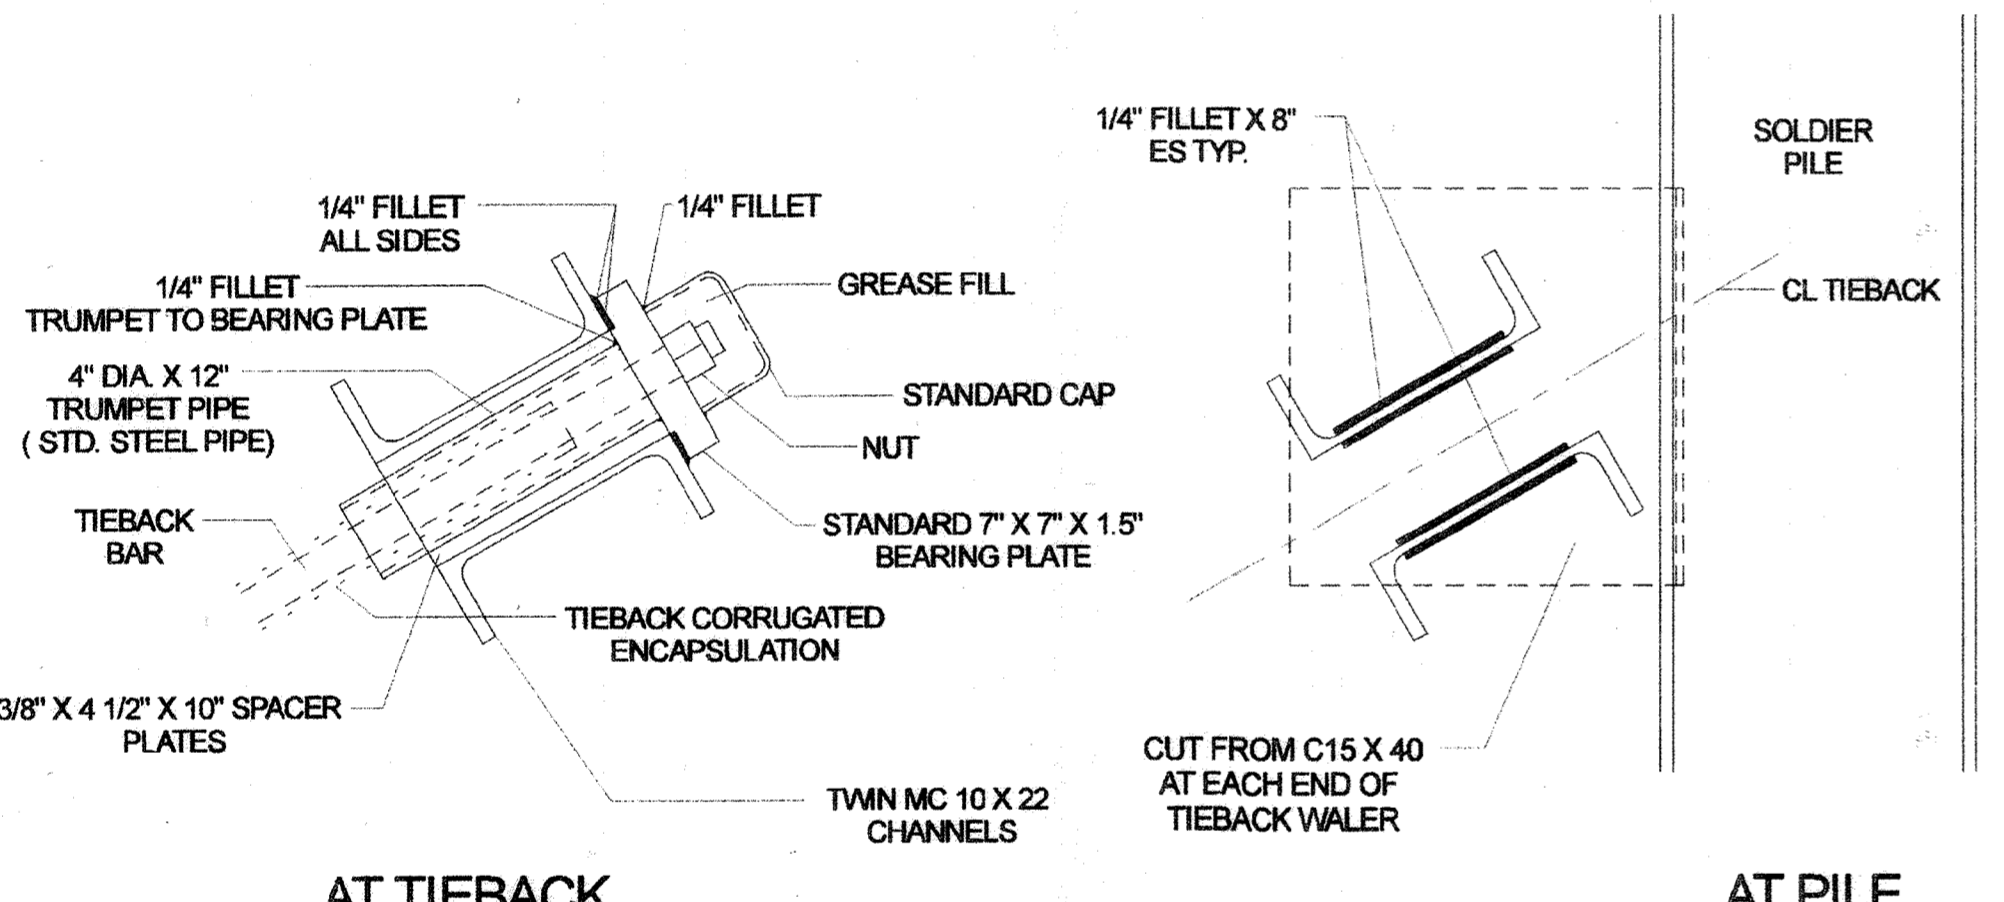

**TIEBACK WALER CONNECTION SECTION VIEW**

**TIEBACK SCHEDULE**

TIEBACK NUMBER	QUANTITY / TYPE	DESIGN LOAD KIPS	UNBONDED LENGTH	MIN. BONDED LENGTH	MIN. DRILL LENGTH	BAR SIZE
ALL	14	65	20'	20'	40'	1.25" DIA.

TIEBACK BARS TO BE 150 KSI STEEL MINIMUM

<b>OWNER</b>	WHISKEY BOTTOM SOUTH C/O SIMMONS MGMT. GROUP COLLEGE, MARYLAND 20740
<b>ENGINEER</b>	PROFESSIONAL CONSULTING CORP. PO BOX 129 DUNKIRK, MARYLAND 20754 301-980-4672
<b>PROJECT</b>	WHISKEY BOTTOM APARTMENTS HOWARD COUNTY, MD.
<b>RETAINING WALL</b>	DATE 10/11/2016 REVISION # 1 10/23/2016
<b>DWG. 102</b>	

I HEREBY CERTIFY THAT THESE DOCUMENTS WERE PREPARED OR APPROVED BY ME, AND THAT I AM A DULY LICENSED PROFESSIONAL ENGINEER UNDER THE LAWS OF THE STATE OF MARYLAND, LICENSE # 14246, EXPIRATION 12/23/2018

NICHOLAS J. A. WHITE PE  
301-980-4672

HOWARD COUNTY OFFICE OF PLANNING AND ZONING APPROVED

*K. Blume* 7-11-17  
CHIEF, LAND DEVELOPMENT DIVISION

*W. J. Blume* 7-7-17  
CHIEF, DEVELOPMENT ENGINEERING DIVISION

*W. J. Blume* 7-11-17  
DIRECTOR OF PLANNING AND ZONING

**Owners/Developer Certification:**

"I/We hereby certify that any clearing, grading, construction, or development will be done pursuant to this approved erosion and sediment control plan, including inspecting and maintaining controls, and that the responsible personnel involved in the construction project will have a Certificate of Training at a Maryland Department of the Environment (MDE) approved training program for the control on erosion and sediment prior to beginning the project. I certify right-of-entry for the periodic on-site evaluation by Howard County, the Howard Soil Conservation District and/or MDE."

*Arthur Blume* 4/1/17  
Owner's/ Developer's Signature  
ARTHUR BLUME - PRESIDENT  
Printed Name & Title

**Design Certification:**


"I hereby certify that this plan has been designed in accordance with the current Maryland erosion and sediment control laws, regulations, and standards, that it represents a practical and workable plan based on my personal knowledge of the site, and that it was prepared in accordance with the requirements of the Howard Soil Conservation District."

*Charles T. Grimley* 5/19/17  
Designer's Signature  
Charles T. Grimley  
Printed Name  
MD P.E. Registration No., 11124

**Howard SCD Signature Block:**

This plan is approved for soil erosion and sediment control by the Howard Soil Conservation District.

*[Signature]*  
Howard Soil Conservation District  
Date

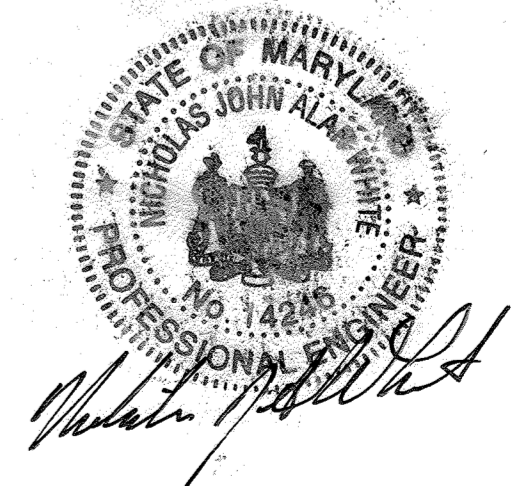


OWNER-DEVELOPER  
WHISKEY BOTTOM CONDOMINIUMS, ASSOC.  
c/o MR. ARTHUR F. BLUME, PRESIDENT  
WHISKEY BOTTOM SOUTH, BOARD OF DIRECTORS  
9220 BRIDLE PATH LANE, UNIT F  
LAUREL, MD. 20723

**LANDMARK ENGINEERING, INC.**  
CONSULTING ENGINEERS PLANNERS SURVEYORS  
6110 EXECUTIVE BLVD, SUITE 110  
ROCKVILLE, MARYLAND 20852  
PHONE: (301) 230-5881  
FAX: (301) 230-5884

**SECTION TWO**  
**WHISKEY BOTTOM APARTMENTS**  
SIXTH ELECTION DISTRICT, HOWARD COUNTY, MARYLAND

**SITE DEVELOPMENT PLAN**  
**PROPOSED RETAINING WALL**  
**EXISTING**

<b>REVISIONS</b>	DRN: DCV PROJECT NO.: 1530 SCALE: AS SHOWN DATE: MAY 5, 2017	CK: CTG	DRAWING NO. S-16 OF 17
------------------	---	---------	---------------------------

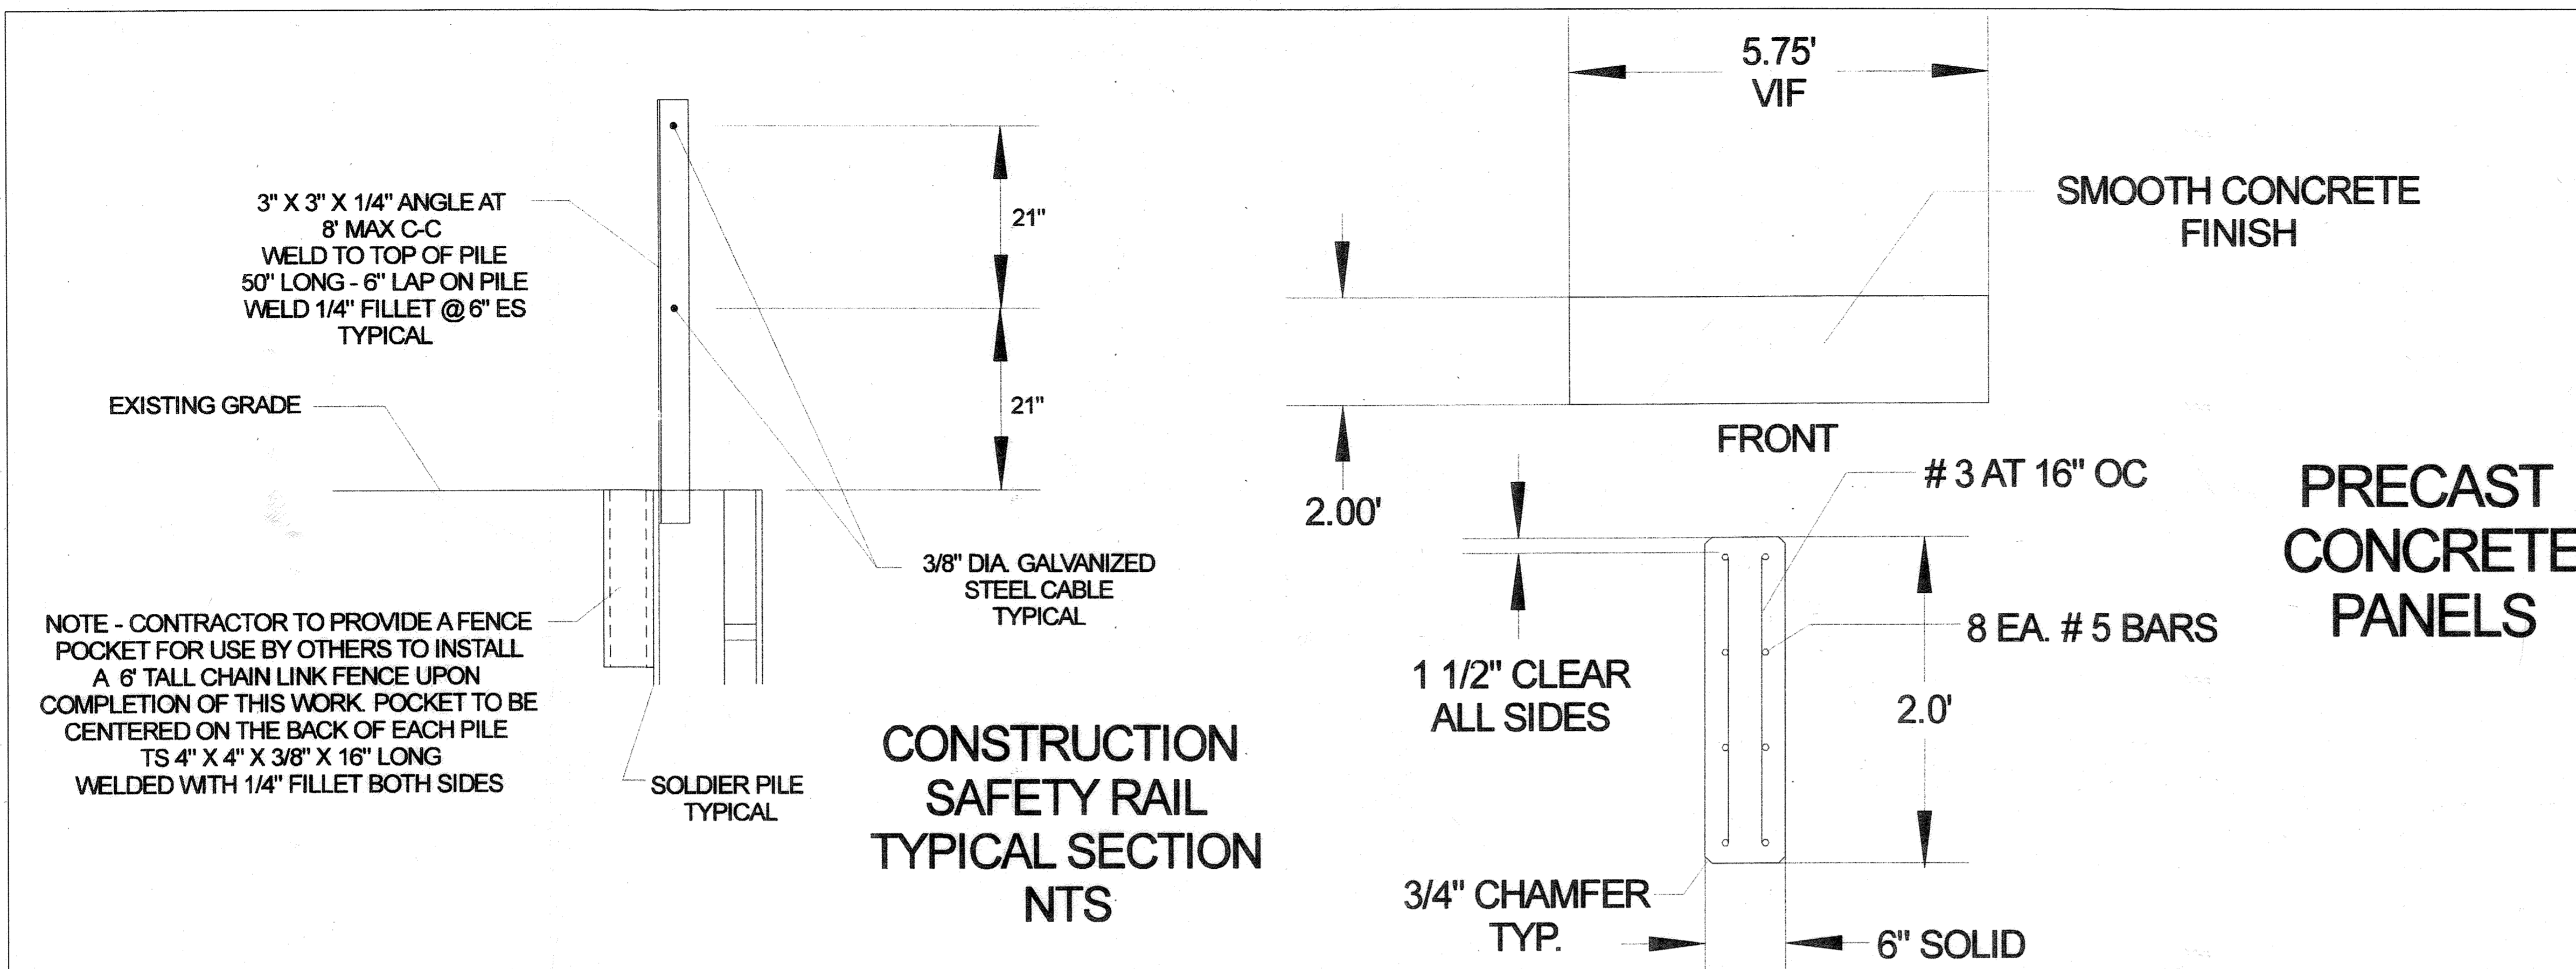

NOTE - CONTRACTOR TO PROVIDE A FENCE POCKET FOR USE BY OTHERS TO INSTALL A 6' TALL CHAIN LINK FENCE UPON COMPLETION OF THIS WORK. POCKET TO BE CENTERED ON THE BACK OF EACH PILE TS 4" X 4" X 3/8" X 16" LONG WELDED WITH 1/4" FILLET BOTH SIDES

**GENERAL NOTES**

- ALL SOLDIER PILES ARE TO BE MINIMUM 30' LONG HP 12 X 53 GRADE 50 (A572) STEEL. MINIMUM ALL PILES ARE TO BE SET INTO 24" DIAMETER PRE DRILLED FULL DEPTH HOLES AND THEN BACKFILLED WITH 3000 PSI CONCRETE IN THE PILE TOE. THE REMAINDER OF THE HOLES ARE TO BE FILLED TO GRADE WITH FLOWABLE FILL OR STONE DUST. HOLES TO BE DRILLED EVERY OTHER HOLE, SET & FILLED BEFORE DRILLING ADJACENT HOLE. PILES TO BEAR ON DENSE DISINTEGRATED ROCK OR SOLID ROCK.
- ALL STRUCTURAL STEEL TO BE MIN. 50 KSI STEEL. ALL REINFORCING STEEL TO BE 60 KSI AND ALL CONCRETE FOR CONCRETE PANELS TO BE 3500 PSI MINIMUM. ALL EXPOSED STEEL IS TO BE COATED WITH RUST RESISTANT PRIMER AND BLACK ENAMEL PAINT. WELDED OR DISTURBED STEEL AREAS TO BE CLEANED AND RECOATED AS NEEDED TO ASSURE COMPLETE COVERAGE.
- ALL WELDING TO BE PER AWS REQUIREMENTS. ALL WELDING RODS TO BE E70XX.
- THE UNDERSIGNED ENGINEER IS TO BE NOTIFIED IMMEDIATELY UPON ANY CHANGE OF ANTICIPATED CONDITIONS THAT DIFFER FROM THESE DRAWING DETAILS. NICHOLAS J. A. WHITE 301-980-4672
- ALL TIEBACKS ARE TO CLASS 1 FULLY ENCAPSULATED SOLID THREAD BAR PERMANENT TIES IN ACCORDANCE WITH FHWA & PTI REQUIREMENTS. MINIMUM DRILL HOLE DIAMETER IS 4". THE UNBONDED LENGTH OF THE BAR IS TO BE COVERED IN PE PLASTIC TUBING BEFORE ENCAPSULATION. LENGTHS SHOWN ARE MINIMUM LENGTHS TO BE INCREASED AS NEEDED TO PROVIDE THE CAPACITY INDICATED.
- TIEBACK GROUT IS TO BE NEAT CEMENT GROUT USING A MIXTURE OF 1 BAG OF PORTLAND TYPE 3 CEMENT TO 5 1/2 GALLONS OF POTABLE WATER. TIEBACK GROUT TO BE PUMPED FROM THE BOTTOM OF THE HOLE UP BEFORE INSERTING THE ENCAPSULATED TIEBACKS MAKING SURE THAT CLEAN GROUT RETURNS TO THE SURFACE BEFORE STOPPING GROUTING.
- ALL TIEBACKS ARE TO BE PROOF TESTED TO 133% OF DESIGN LOAD, AND LOCKED OFF AT 100% OF DESIGN LOAD. THE MAXIMUM INCREMENTAL MOVEMENT OF A TIEBACK IS 0.04" DURING A 10 MINUTE HOLD AT 133% TEST LOAD IN ORDER THAT THE TIEBACK BE DEEMED ACCEPTABLE. MOVEMENT TO BE MEASURED USING A DIAL GAUGE OF 0.001" ACCURACY.
- CONTRACTOR TO NOTIFY "MISS UTILITY". VERIFICATION OF ALL UTILITY LOCATIONS & ELEVATIONS, UTILITY TEST PITS AND UTILITY RELOCATIONS AS REQUIRED TO SAFELY PERFORM THIS WORK IS THE RESPONSIBILITY OF OTHERS.
- EXCAVATION SHALL BE MADE IN MAXIMUM LIFT HEIGHTS OF 4 FEET TO FACILITATE PLACEMENT OF LAGGING. EXCAVATION AND LAGGING IS TO BE DONE ON AN ALTERNATE BAY BASIS. WALERS ARE TO BE INSTALLED, LAGGING COMPLETE AND PROPERLY BACKFILLED ABOVE THE WALERS BEFORE THE ADJACENT BAY IS EXCAVATED. BACKFILL AROUND WALER AND LAGGING ABOVE TO BE SM MATERIAL OR BETTER COMPACTED TO AT LEAST 95% MAXIMUM DRY DENSITY PER ASTM D698. BACKFILL OPERATIONS TO BE OBSERVED AND TESTED BY THIRD PARTY INSPECTOR. TIEBACKS ARE TO BE FULLY COMPLETED AND TESTED PRIOR TO LAGGING BELOW THE WALER ELEVATION.
- ALL LAGGING TO BE 3" THICK MINIMUM TREATED BOARDS. 1" THICK LOUVER BLOCKS TO BE USED TO ASSURE PROPER DRAINAGE.

OWNER	WHISKEY BOTTOM SOUTH C/O SIMMONS MGMT. GROUP COLLEGE, MARYLAND 20740
ENGINEER	PROFESSIONAL CONSULTING CORP. PO BOX 129 DUNKIRK, MARYLAND 20754 301-980-4672
PROJECT	WHISKEY BOTTOM APARTMENTS HOWARD COUNTY, MD.
	RETAINING WALL
	DATE 10/11/2016 REVISION #1 10/23/2016
	DWG. 103


I HEREBY CERTIFY THAT THESE DOCUMENTS WERE PREPARED OR APPROVED BY ME AND THAT I AM A DULY LICENSED PROFESSIONAL ENGINEER UNDER THE LAWS OF THE STATE OF MARYLAND, LICENSE # 14246, EXPIRATION 12/23/2018  
NICHOLAS J. A. WHITE, PE  
301-980 - 4672

HOWARD COUNTY OFFICE OF PLANNING AND ZONING APPROVED  
  
 CHIEF, LAND DEVELOPMENT DIVISION  
 DATE 7/11/17  
  
 CHIEF, DEVELOPMENT ENGINEERING DIVISION  
 DATE 7.7.17  
  
 DIRECTOR OF PLANNING AND ZONING  
 DATE 7-11-17

**Owners/Developer Certification:**  
 "I/We hereby certify that any clearing, grading, construction, or development will be done pursuant to this approved erosion and sediment control plan, including inspecting and maintaining controls, and that the responsible personnel involved in the construction project will have a Certificate of Training at a Maryland Department of the Environment (MDE) approved training program for the control on erosion and sediment prior to beginning the project. I certify right-of-entry for the periodic on-site evaluation by Howard County, the Howard Soil Conservation District and/or MDE."  
  
 Owner's/ Developer's Signature  
 ARTHUR BLUME - PRESIDENT  
 DATE 4/21/17

**Design Certification:**  
 "I hereby certify that this plan has been designed in accordance with the current Maryland erosion and sediment control laws, regulations, and standards, that it represents a practical and workable plan based on my personal knowledge of the site, and that it was prepared in accordance with the requirements of the Howard Soil Conservation District."  
  
 Designer's Signature  
 Charles T. Givens  
 Printed Name  
 MD P.E. Registration No. 11124  
 DATE 5/19/17

**Howard SCD Signature Block:**  
 This plan is approved for soil erosion and sediment control by the Howard Soil Conservation District.  
  
 Date

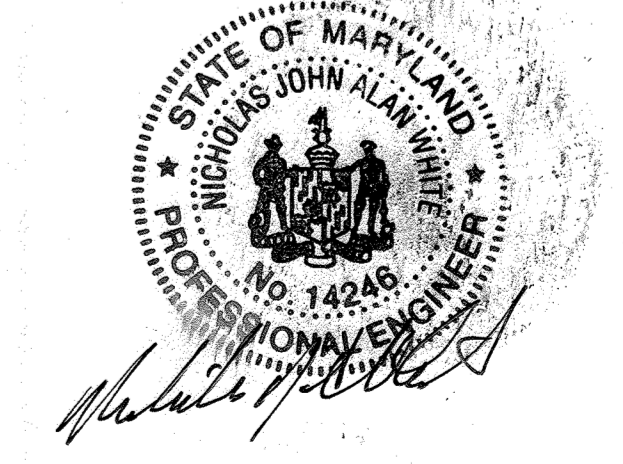


OWNER-DEVELOPER  
 WHISKEY BOTTOM CONDOMINIUMS, ASSOC.  
 c/o MR. ARTHUR F. BLUME, PRESIDENT  
 WHISKEY BOTTOM SOUTH, BOARD OF DIRECTORS  
 9220 BRIDLE PATH LANE, UNIT F  
 LAUREL, MD. 20723


**LANDMARK ENGINEERING, INC.**  
 6110 EXECUTIVE BLVD, SUITE 110 PHONE: (301) 230-5881  
 ROCKVILLE, MARYLAND 20852 FAX: (301) 230-5884  
 CONSULTING ENGINEERS PLANNERS SURVEYORS

SECTION TWO  
**WHISKEY BOTTOM APARTMENTS**  
 SIXTH ELECTION DISTRICT, HOWARD COUNTY, MARYLAND

SITE DEVELOPMENT PLAN  
**PROPOSED RETAINING WALL**  
 EXISTING

REVISIONS	DRN: DCV CK: CTG	DRAWING NO. SDP-17 OF 17
	PROJECT NO.: 1530	DATE: MAY 5, 2017
	SCALE: AS SHOWN	


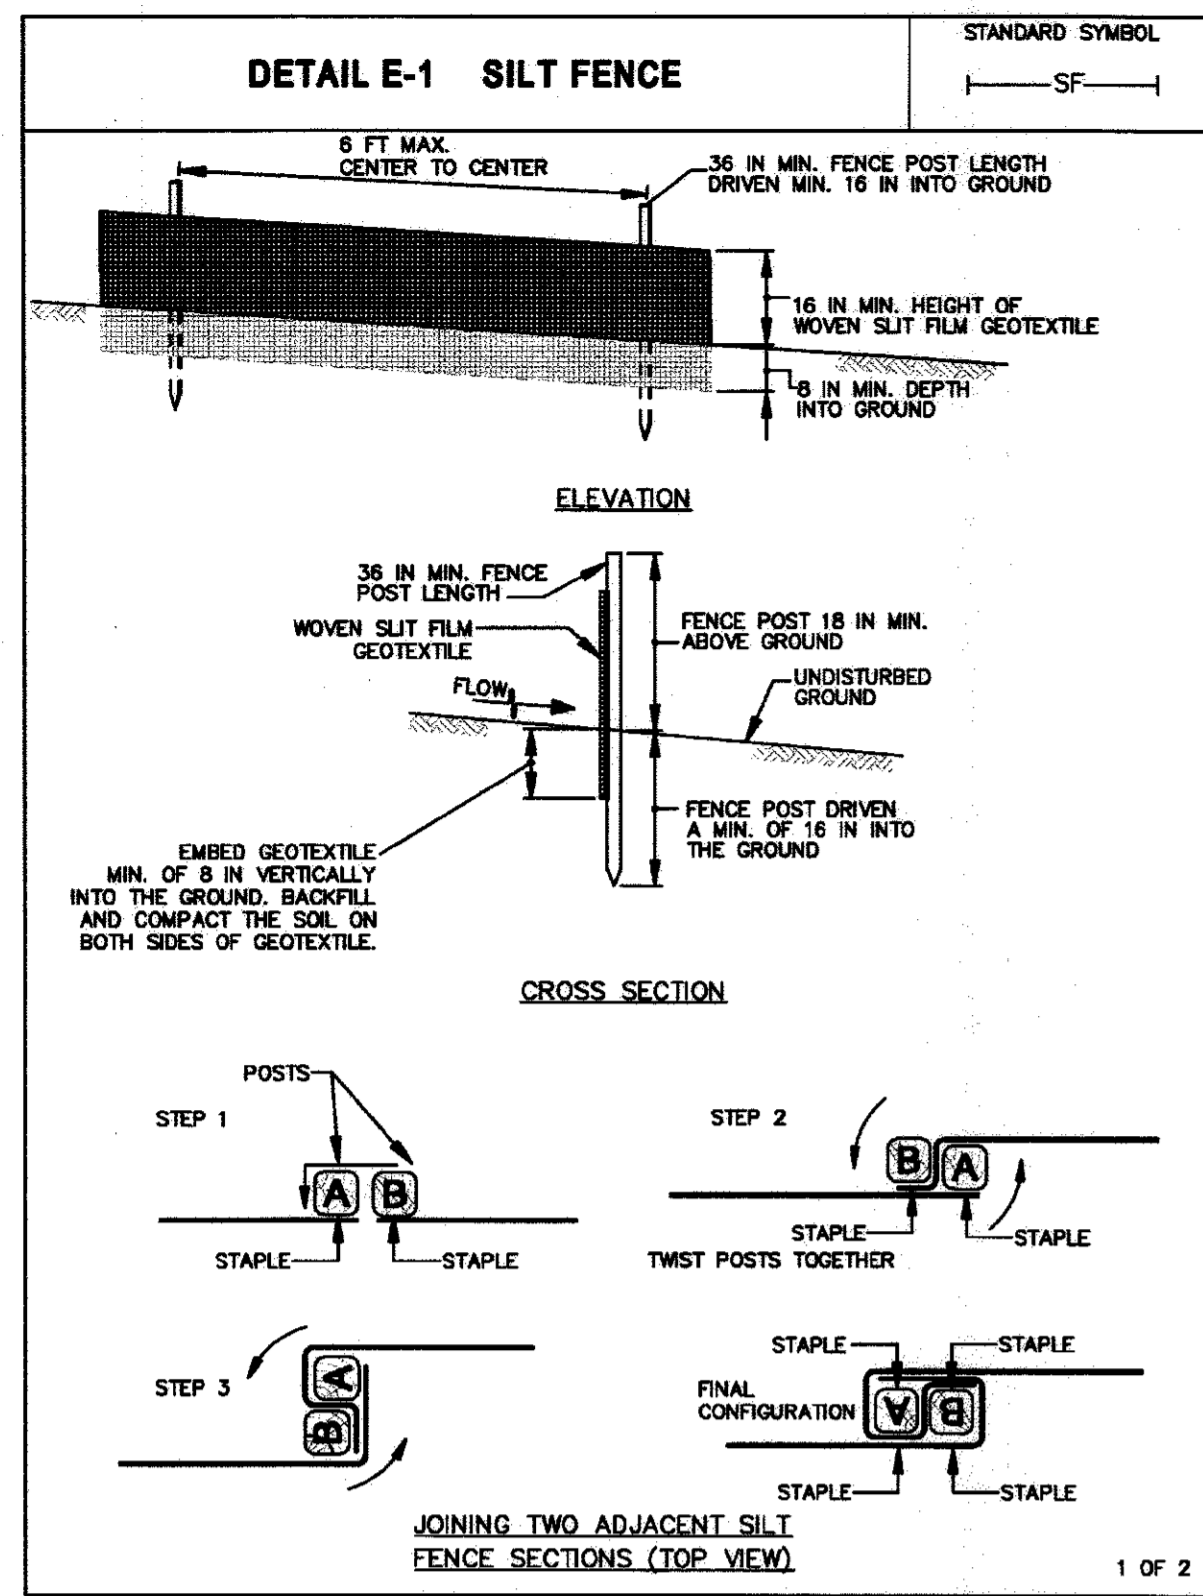


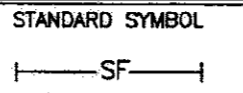**DETAIL E-1 SILT FENCE** STANDARD SYMBOL 

**CONSTRUCTION SPECIFICATIONS**

- USE WOOD POSTS 1 1/4 X 1 1/4 X 3/8 INCH (MINIMUM) SQUARE CUT OF SOUND QUALITY HARDWOOD. AS AN ALTERNATIVE TO WOODEN POST USE STANDARD "T" OR "U" SECTION STEEL POSTS WEIGHING NOT LESS THAN 1 POUND PER LINEAR FOOT.
- USE 36 INCH MINIMUM POSTS DRIVEN 16 INCH MINIMUM INTO GROUND NO MORE THAN 6 FEET APART.
- USE WOVEN SLIT FILM GEOTEXTILE AS SPECIFIED IN SECTION H-1 MATERIALS AND FASTEN GEOTEXTILE SECURELY TO UPSLOPE SIDE OF FENCE POSTS WITH WIRE TIES OR STAPLES AT TOP AND MID-SECTION.
- PROVIDE MANUFACTURER CERTIFICATION TO THE AUTHORIZED REPRESENTATIVE OF THE INSPECTION/ENFORCEMENT AUTHORITY SHOWING THAT THE GEOTEXTILE USED MEETS THE REQUIREMENTS IN SECTION H-1 MATERIALS.
- EMBED GEOTEXTILE A MINIMUM OF 8 INCHES VERTICALLY INTO THE GROUND, BACKFILL AND COMPACT THE SOIL ON BOTH SIDES OF FABRIC.
- WHERE TWO SECTIONS OF GEOTEXTILE ADJOIN: OVERLAP, TWIST, AND STAPLE TO POST IN ACCORDANCE WITH THIS DETAIL.
- EXTEND BOTH ENDS OF THE SILT FENCE A MINIMUM OF FIVE HORIZONTAL FEET UPSLOPE AT 45 DEGREES TO THE MAIN FENCE ALIGNMENT TO PREVENT RUNOFF FROM GOING AROUND THE ENDS OF THE SILT FENCE.
- REMOVE ACCUMULATED SEDIMENT AND DEBRIS WHEN BULGES DEVELOP IN SILT FENCE OR WHEN SEDIMENT REACHES 25% OF FENCE HEIGHT. REPLACE GEOTEXTILE IF TORN. IF UNDERMINING OCCURS, REINSTALL FENCE.

2 OF 2

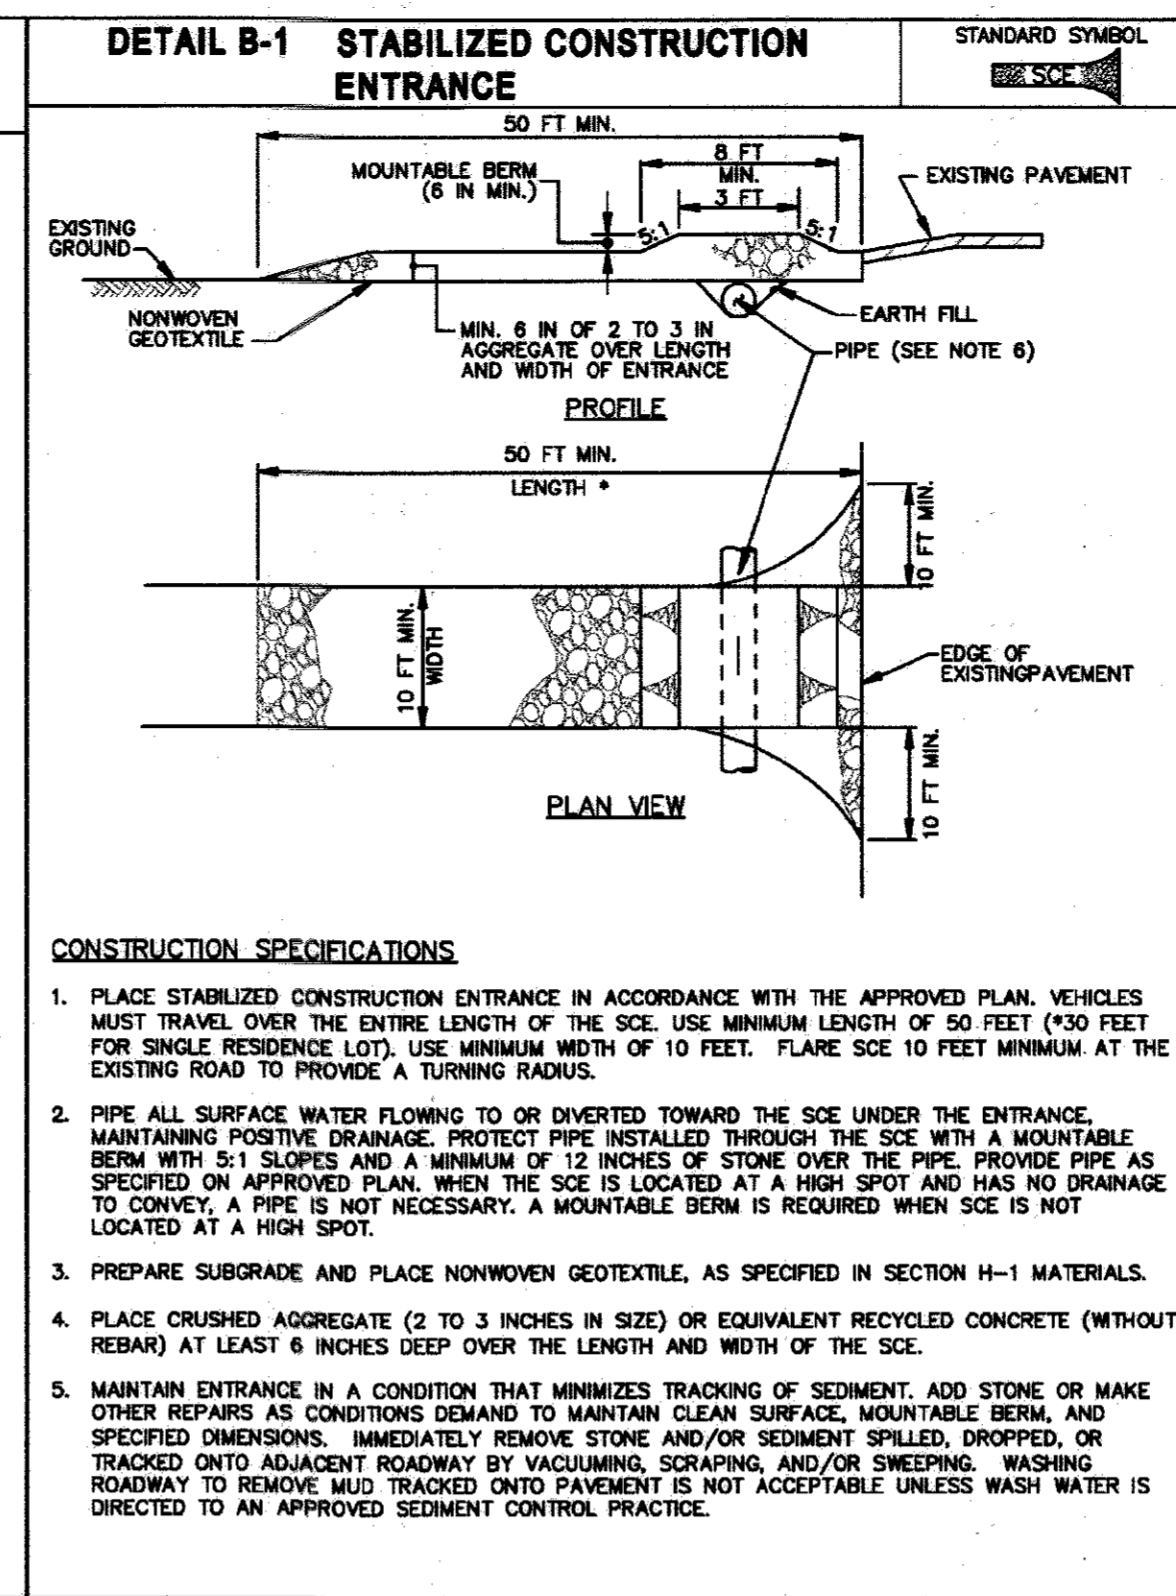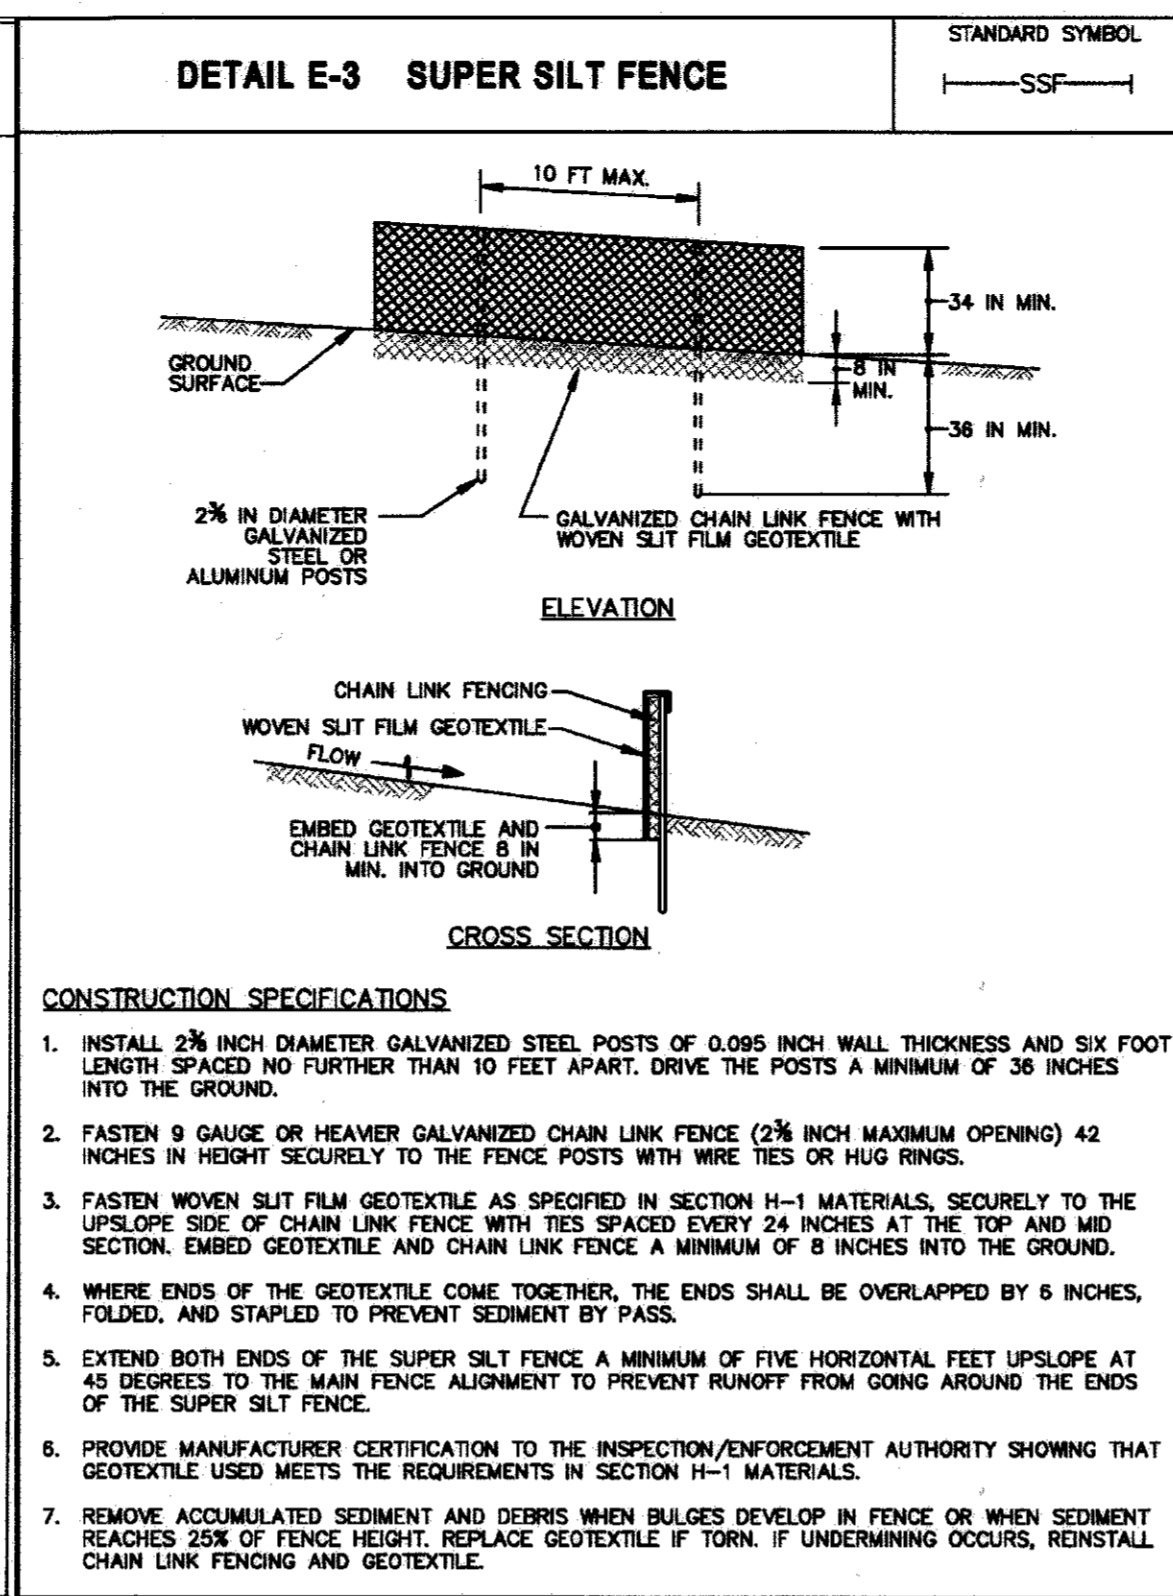

MARYLAND STANDARDS AND SPECIFICATIONS FOR SOIL EROSION AND SEDIMENT CONTROL  
U.S. DEPARTMENT OF AGRICULTURE NATURAL RESOURCES CONSERVATION SERVICE 2011 MARYLAND DEPARTMENT OF ENVIRONMENT WATER MANAGEMENT ADMINISTRATION

HOWARD COUNTY OFFICE OF PLANNING AND ZONING APPROVED

*Paul Slavovick* 7-11-17  
CHIEF, LAND DEVELOPMENT DATE

*Charles T. Grimsley* 7-7-17  
CHIEF, DEVELOPMENT ENGINEERING DIVISION DATE

*Arthur Blume* 7-11-17  
DIRECTOR OF PLANNING AND ZONING DATE

**Owners/Developer Certification:**

"I/We hereby certify that any clearing, grading, construction, or development will be done pursuant to this approved erosion and sediment control plan, including inspecting and maintaining controls, and that the responsible personnel involved in the construction project will have a Certificate of Training at a Maryland Department of the Environment (MDE) approved training program for the control on erosion and sediment prior to beginning the project. I certify right-of-entry for the periodic on-site evaluation by Howard County, the Howard Soil Conservation District and/or MDE."

*Arthur Blume* 6/19/17  
Owner's/Developer's Signature Date

ARTHUR BLUME - PRESIDENT  
Printed Name & Title

**Design Certification:**

"I hereby certify that this plan has been designed in accordance with the current Maryland erosion and sediment control laws, regulations, and standards, that it represents a practical and workable plan based on my personal knowledge of the site, and that it was prepared in accordance with the requirements of the Howard Soil Conservation District."

*Charles T. Grimsley* 6/19/17  
Designer's Signature Date

Charles T. Grimsley  
Printed Name MD P.E. Registration No. 11124

**Howard SCD Signature Block:**

This plan is approved for soil erosion and sediment control by the Howard Soil Conservation District.


*[Signature]*  
Howard Soil Conservation District Date

**PROFESSIONAL CERTIFICATION**

I HEREBY CERTIFY THAT THESE DOCUMENTS WERE PREPARED OR APPROVED BY ME, AND THAT I AM A DULY LICENSED PROFESSIONAL ENGINEER UNDER THE LAWS OF THE STATE OF MARYLAND, LICENSE NO. 11124, EXPIRATION DATE: OCTOBER 3, 2018.

*Charles T. Grimsley*  
PROFESSIONAL ENGINEER

OWNER-DEVELOPER  
WHISKEY BOTTOM CONDOMINIUMS, ASSOC.  
c/o MR. ARTHUR F. BLUME, PRESIDENT  
WHISKEY BOTTOM SOUTH, BOARD OF DIRECTORS  
9220 BRIDLE PATH LANE, UNIT F  
LAUREL, MD. 20723

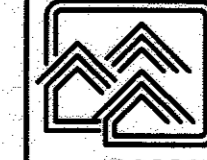 **LANDMARK ENGINEERING, INC.**  
6110 EXECUTIVE BLVD, SUITE 110 PHONE: (301) 230-5881  
ROCKVILLE, MARYLAND 20852 FAX: (301) 230-5884  
CONSULTING ENGINEERS PLANNERS SURVEYORS


SECTION TWO  
**WHISKEY BOTTOM APARTMENTS**  
SIXTH ELECTION DISTRICT, HOWARD COUNTY, MARYLAND

SITE DEVELOPMENT PLAN  
**PROPOSED RETAINING WALL**  
SEDIMENT AND EROSION CONTROL NOTES & DETAILS


REVISIONS

DRN: DCV	CK: CTG
PROJECT NO.: 1530	DRAWING NO. S-14
SCALE: AS SHOWN	OF 17
DATE: MAY 5, 2017	

SDP-72-84

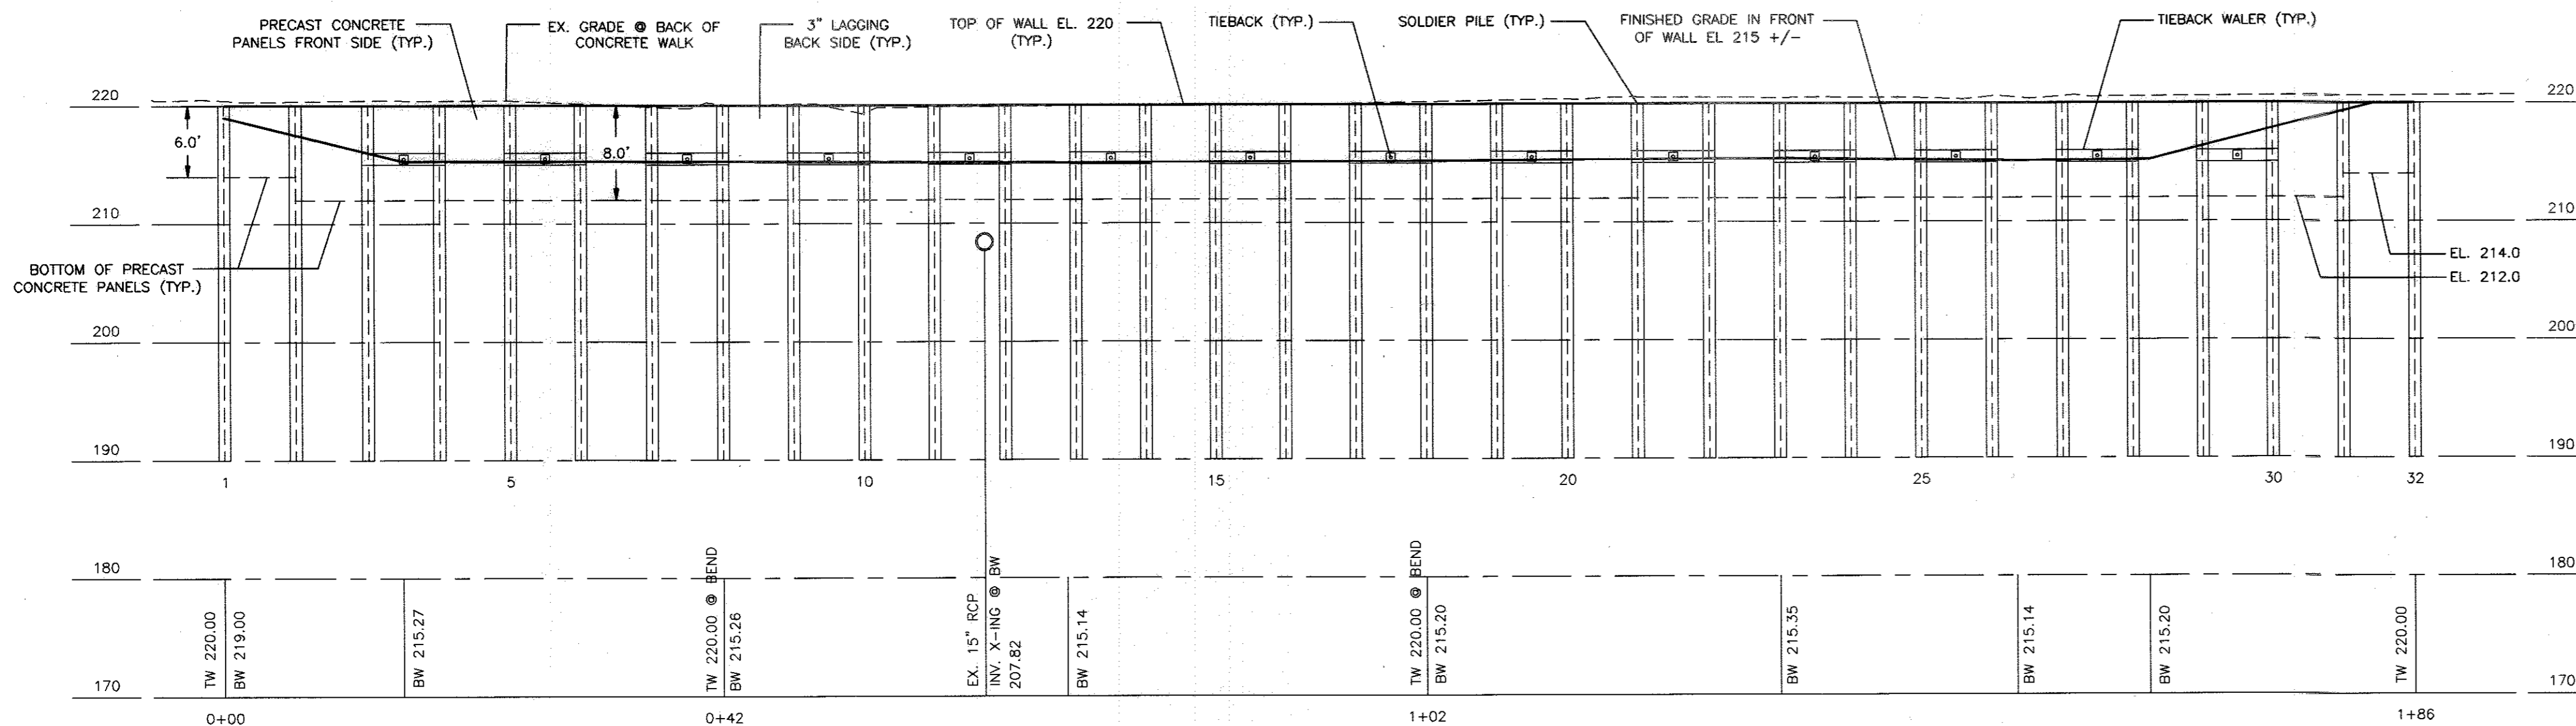

**WALL PROFILE VIEW**  
HORIZONTAL & VERTICAL  
SCALE: 1" = 10'

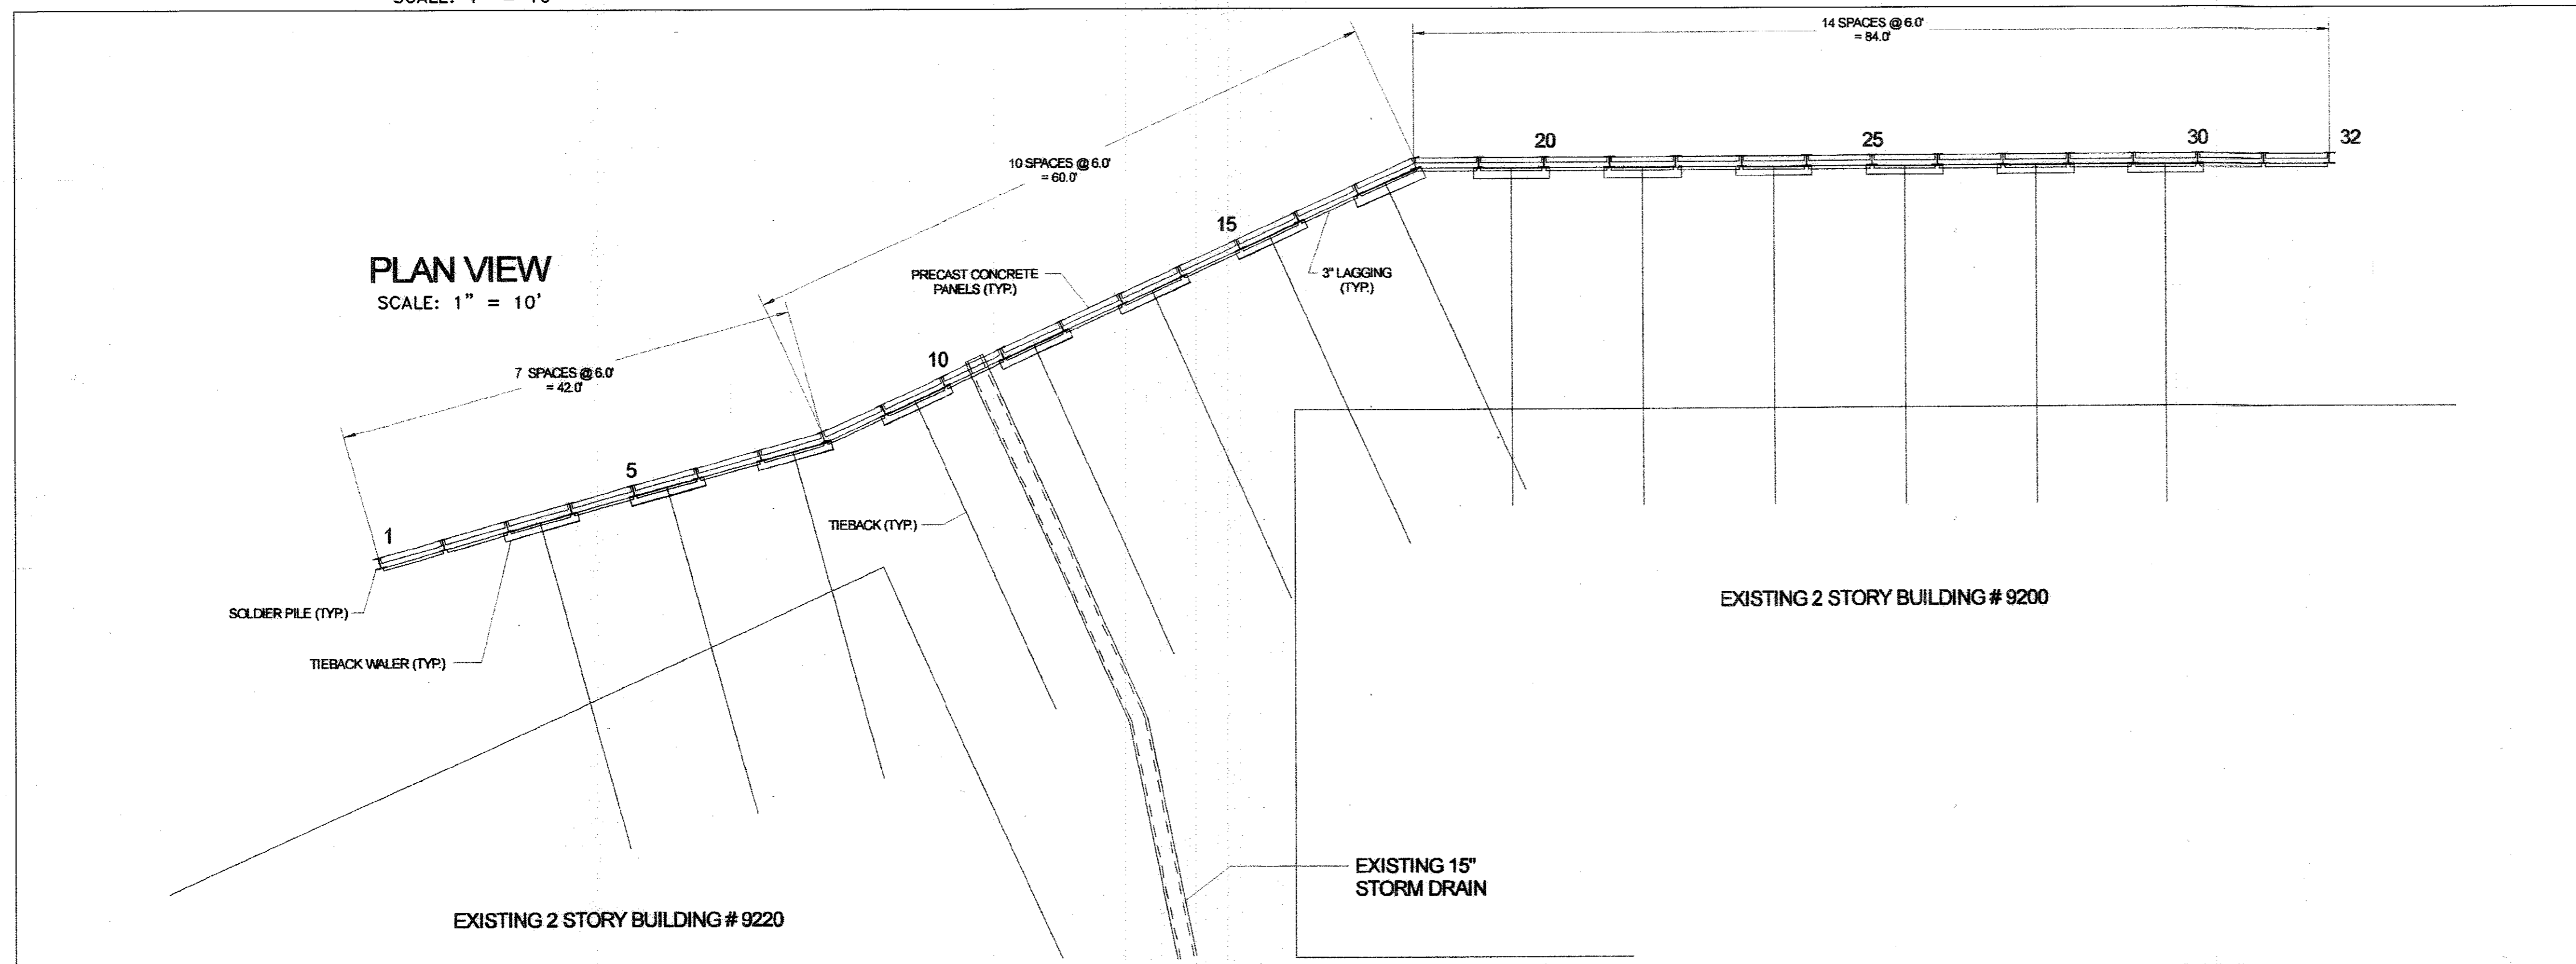

**PLAN VIEW**  
SCALE: 1" = 10'

**SEQUENCE OF CONSTRUCTION**

1. ALL SEDIMENT CONTROL MEASURES TO BE INSTALLED. LAYOUT SOLDIER PILES. CONTRACTOR TO NOTIFY "MISS UTILITY" AND VERIFY ALL UTILITY LOCATIONS AND RESOLVE ALL POTENTIAL CONFLICTS PRIOR TO DRILLING SOLDIER PILES. SEE CIVIL DRAWINGS FOR ADDITIONAL INFORMATION.
2. INSTALL ALL SOLDIER PILES DOING EVERY OTHER PILE AT A TIME. ADDITIONAL HOLES ARE NOT TO BE DRILLED UNTIL ADJACENT HOLES ARE SET & FILLED.
3. INSTALL SAFETY RAIL. NOTE THAT SAFETY RAIL IS FOR WORKER PROTECTION ONLY. INSTALL TEMPORARY FENCE A FEW FEET INSIDE WALL FOR PUBLIC SAFETY. INSTALL ALL WALERS AND LAGGING ABOVE WALERS DOING EVERY OTHER BAY AT A TIME. FULLY BACKFILL AND COMPACT EACH COMPLETED BAY BEFORE EXCAVATING ADJACENT BAYS.
4. INSTALL AND TEST ALL TIEBACKS. INSTALL TRUMPETS, TOP GROUT, CAPS AND CAP GREASE.
5. COMPLETE EXCAVATION AND LAGGING TO BOTTOM OF NEW PANELS.
6. POWER WASH, PRIME AND PAINT ALL EXPOSED STEEL. INSTALL FILTER FABRIC OVER ENTIRE WALL FULLY COVERING ALL LAGGING.
7. INSTALL CONCRETE PANELS AND #5 STONE FROM THE BOTTOM UP. NOTE PANELS MUST BE LEVEL AND BEAR ON THE PILE TOE CONCRETE.
8. PERMANENT FENCE BY OTHERS TO BE INSTALLED IMMEDIATELY UPON COMPLETION OF THIS WORK.

OWNER

WHISKEY BOTTOM SOUTH  
C/O SIMMONS MGMT. GROUP  
COLLEGE, MARYLAND 20740

ENGINEER

PROFESSIONAL  
CONSULTING CORP.  
PO BOX 129  
DUNKIRK, MARYLAND  
20754  
301-980-4672

PROJECT

WHISKEY BOTTOM  
APARTMENTS  
HOWARD COUNTY, MD.

RETAINING WALL

DATE 10/11/2016  
REVISION # 1 10/23/2016

DWG. 101

I HEREBY CERTIFY THAT THESE DOCUMENTS WERE PREPARED OR APPROVED BY ME, AND THAT I AM A DULY LICENSED PROFESSIONAL ENGINEER UNDER THE LAWS OF THE STATE OF MARYLAND, LICENSE # 14246, EXPIRATION 12/23/2018  
  
NICHOLAS J. A. WHITE, PE  
301-980-4672



HOWARD COUNTY OFFICE OF PLANNING AND ZONING APPROVED  
  
 CHIEF, LAND DEVELOPMENT DIVISION  
 DATE: 7-11-17  
  
 CHIEF, DEVELOPMENT ENGINEERING DIVISION  
 DATE: 7-11-17  
 DIRECTOR OF PLANNING AND ZONING

**Owners/Developer Certification:**  
 "I/We hereby certify that any clearing, grading, construction, or development will be done pursuant to this approved erosion and sediment control plan, including inspecting and maintaining controls, and that the responsible personnel involved in the construction project will have a Certificate of Training at a Maryland Department of the Environment (MDE) approved training program for the control on erosion and sediment prior to beginning the project. I certify right-of-entry for the periodic on-site evaluation by Howard County, the Howard Soil Conservation District and/or MDE."  
  
 Owner's/ Developer's Signature  
 ARTHUR BLUME - PRESIDENT  
 Printed Name & Title  
 Date: 6/19/17

**Design Certification:**  
 "I hereby certify that this plan has been designed in accordance with the current Maryland erosion and sediment control laws, regulations, and standards, that it represents a practical and workable plan based on my personal knowledge of the site, and that it was prepared in accordance with the requirements of the Howard Soil Conservation District."  
  
 Designer's Signature  
 Charles T. Grimsley  
 Printed Name  
 Date: 6/19/17  
 MD P.E. Registration No. 11124

**Howard SCD Signature Block:**  
 This plan is approved for soil erosion and sediment control by the Howard Soil Conservation District.  
  
 Howard Soil Conservation District  
 Date

OWNER-DEVELOPER  
 WHISKEY BOTTOM CONDOMINIUMS, ASSOC.  
 c/o MR. ARTHUR F. BLUME, PRESIDENT  
 WHISKEY BOTTOM SOUTH, BOARD OF DIRECTORS  
 9220 BRIDLE PATH LANE, UNIT F  
 LAUREL, MD. 20723


**LANDMARK ENGINEERING, INC.**  
 6110 EXECUTIVE BLVD, SUITE 110 PHONE: (301) 230-5881  
 ROCKVILLE, MARYLAND 20852 FAX: (301) 230-5884  
 CONSULTING ENGINEERS PLANNERS SURVEYORS

SECTION TWO  
**WHISKEY BOTTOM APARTMENTS**  
 SIXTH ELECTION DISTRICT, HOWARD COUNTY, MARYLAND

SITE DEVELOPMENT PLAN  
**PROPOSED RETAINING WALL**


REVISIONS		DRN: DCV	CK: CTG	DRAWING NO. S-15 OF 17
		PROJECT NO.: 1530		
		SCALE: AS SHOWN		
		DATE: MAY 5, 2017		



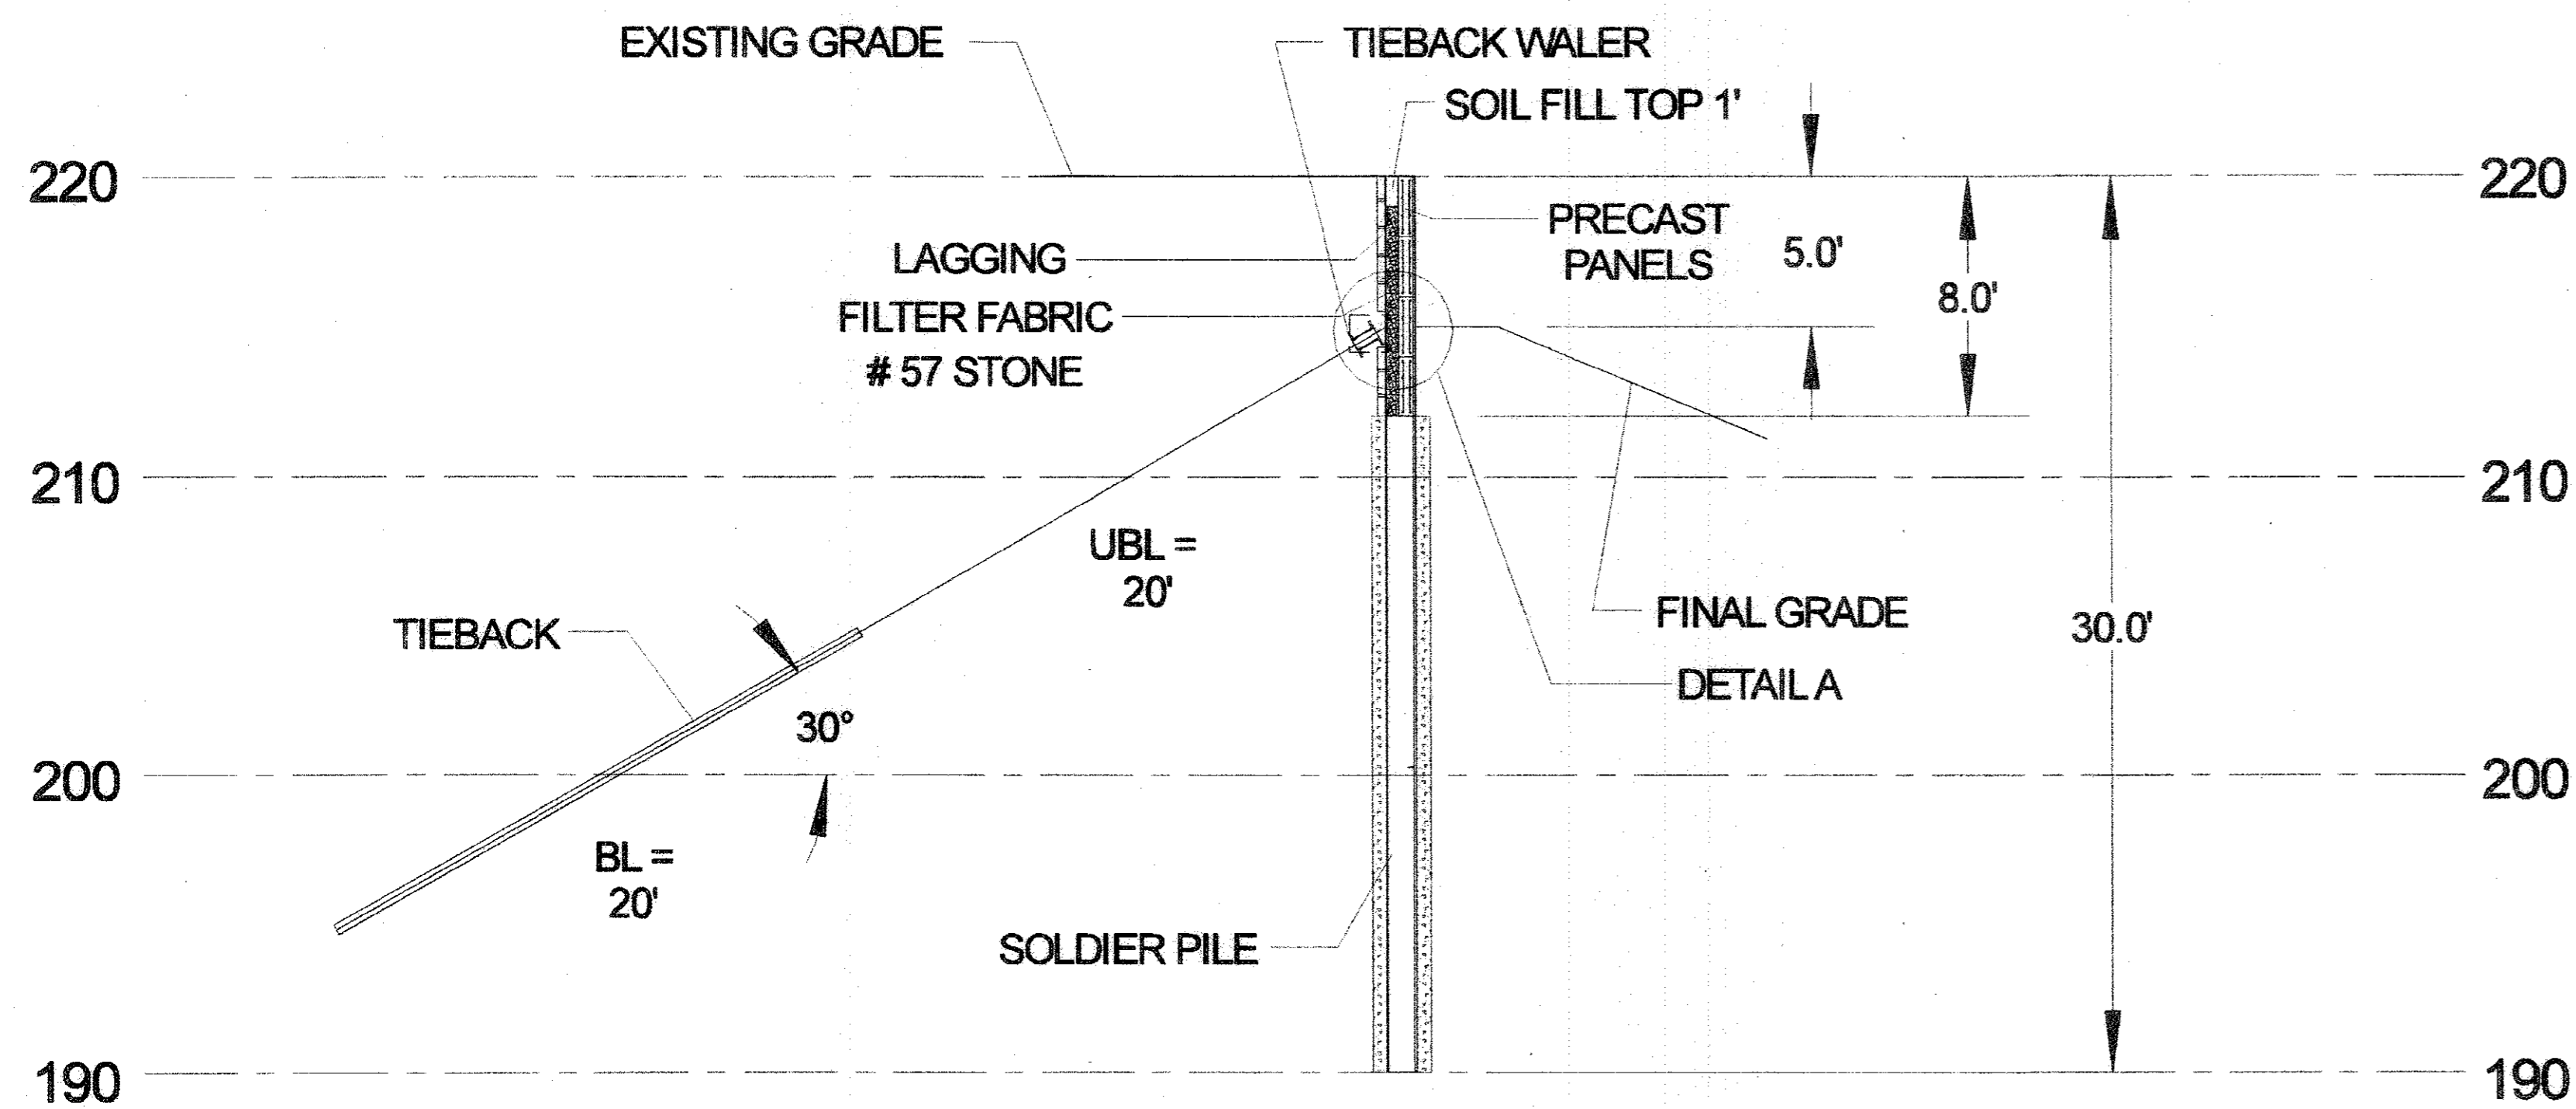


### TYPICAL SECTION


(SEE CIVIL DRAWINGS FOR DETAILS NOT CONTAINED HEREIN)

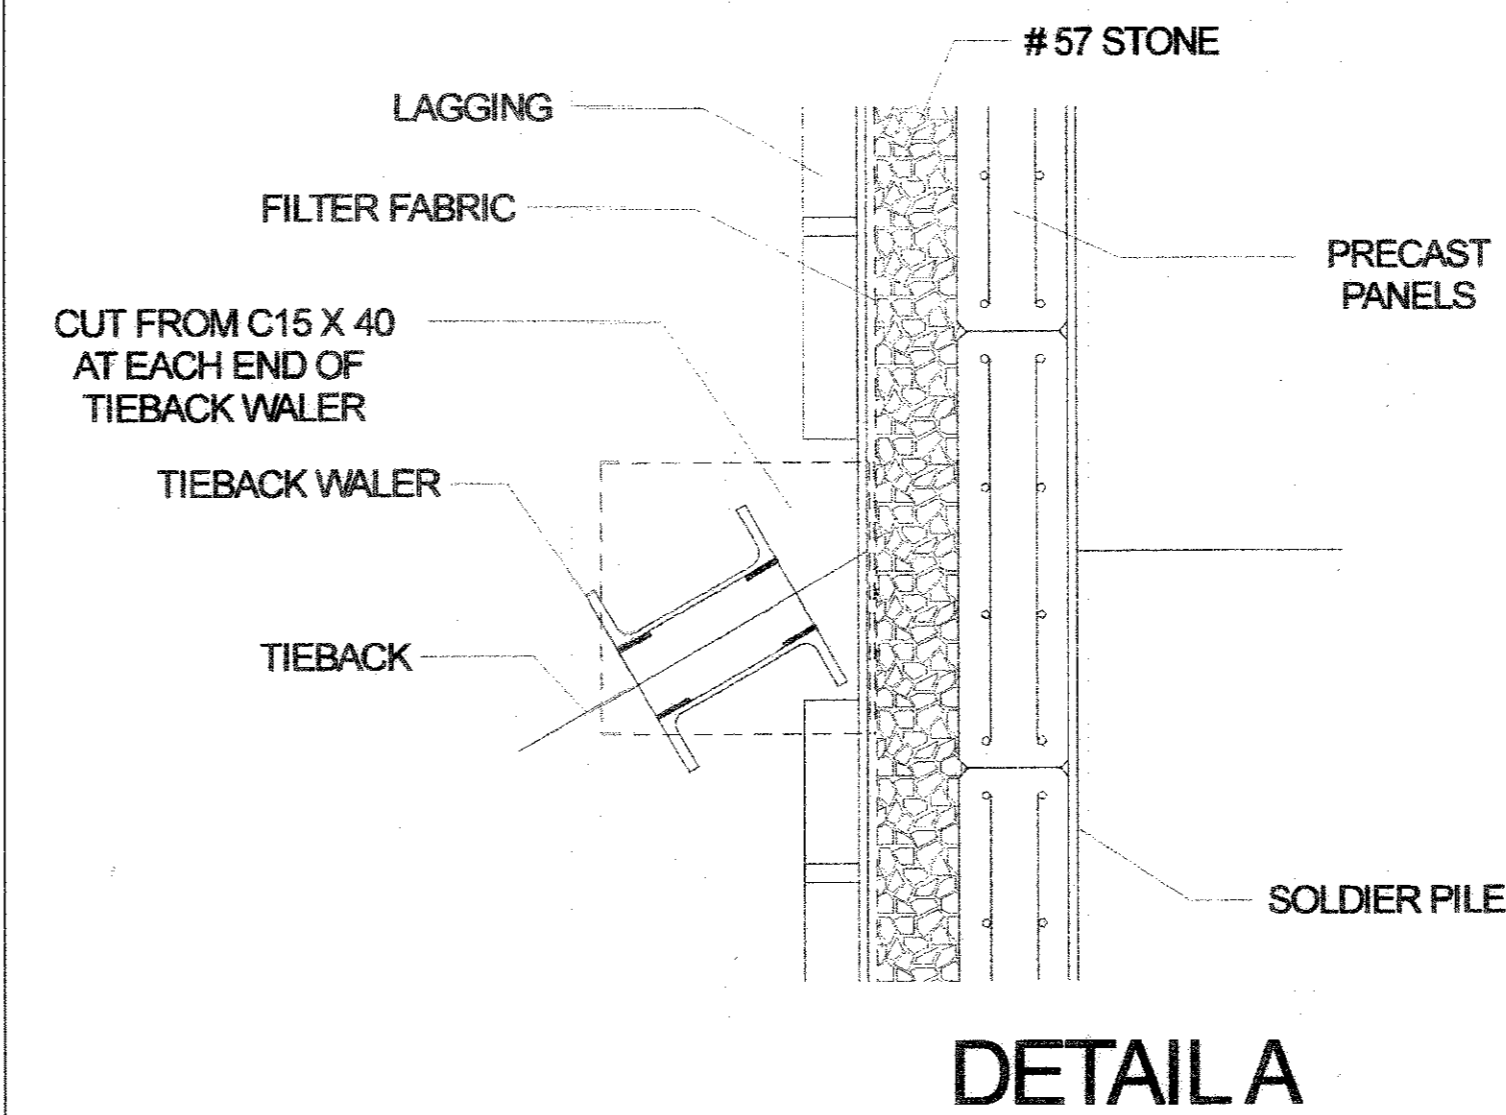

DETAIL A

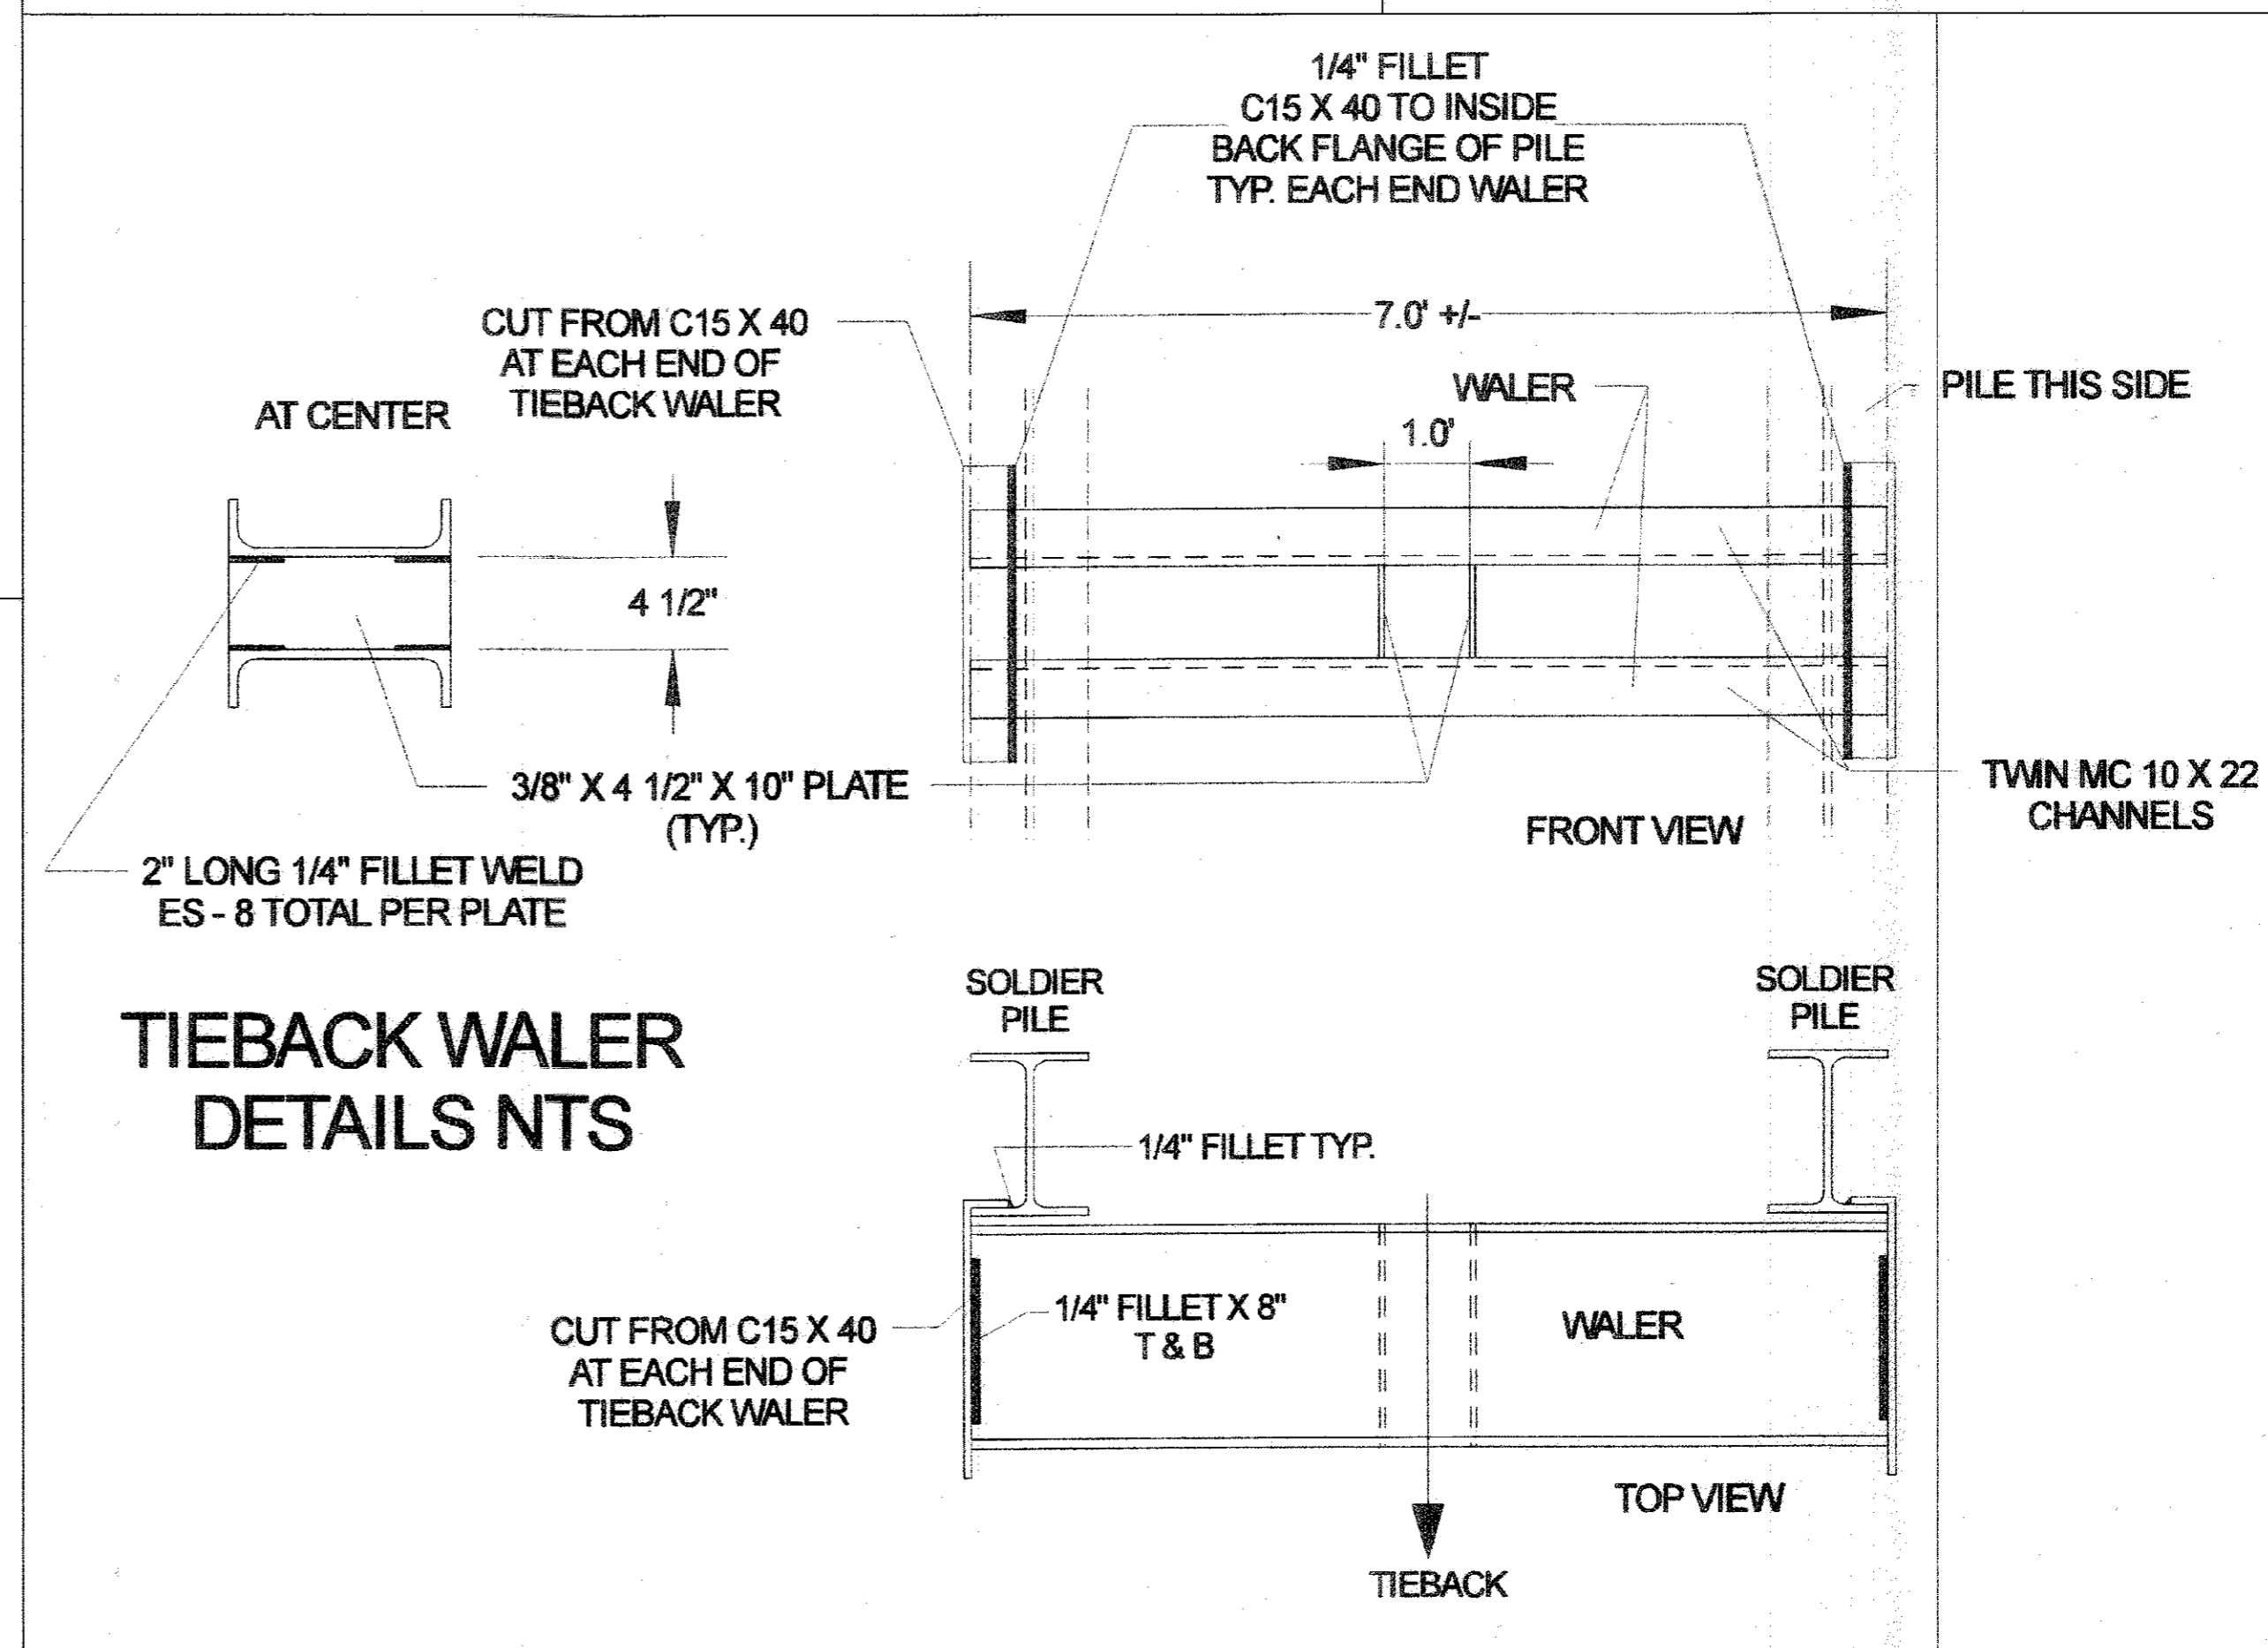

### TIEBACK WALER DETAILS NTs

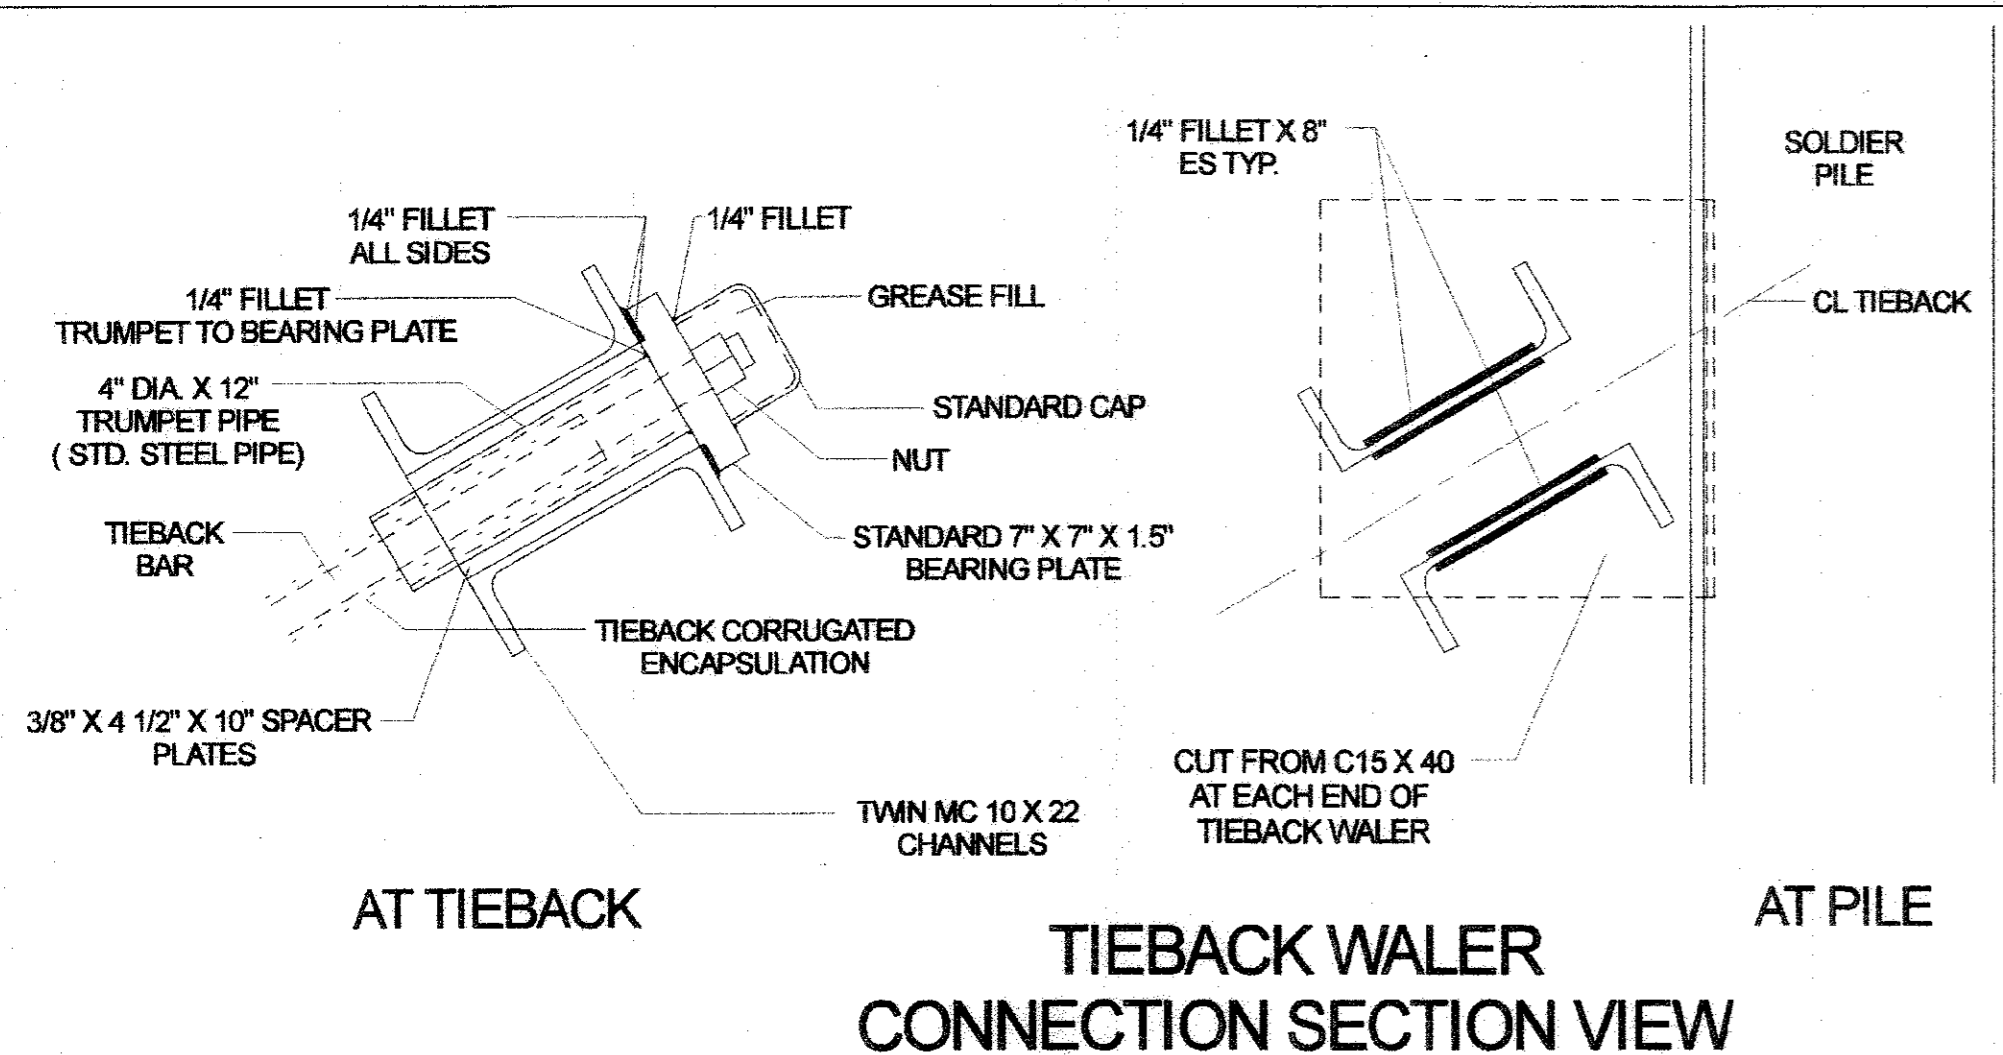

### TIEBACK WALER CONNECTION SECTION VIEW

### TIEBACK SCHEDULE

TIEBACK NUMBER	QUANTITY / TYPE	DESIGN LOAD KIPS	UNBONDED LENGTH	MIN. BONDED LENGTH	MIN. DRILL LENGTH	BAR SIZE
ALL	14	65	20'	20'	40'	1.25" DIA.

TIEBACK BARS TO BE 150 KSI STEEL MINIMUM


I HEREBY CERTIFY THAT THESE DOCUMENTS WERE PREPARED OR APPROVED BY ME, AND THAT I AM A DULY LICENSED PROFESSIONAL ENGINEER UNDER THE LAWS OF THE STATE OF MARYLAND, LICENSE # 14246, EXPIRATION 12/23/2018  
 NICHOLAS J. A. WHITE, PE  
 301-980-4672

HOWARD COUNTY OFFICE OF PLANNING AND ZONING APPROVED  
 CHIEF, LAND DEVELOPMENT: *[Signature]* 7-11-17 DATE  
 CHIEF, DEVELOPMENT ENGINEERING DIVISION: *[Signature]* 7-7-17 DATE  
 DIRECTOR OF PLANNING AND ZONING: *[Signature]* 7-11-17 DATE

Owners/Developer Certification:  
 "I/We hereby certify that any clearing, grading, construction, or development will be done pursuant to this approved erosion and sediment control plan, including inspecting and maintaining controls, and that the responsible personnel involved in the construction project will have a Certificate of Training at a Maryland Department of the Environment (MDE) approved training program for the control on erosion and sediment prior to beginning the project. I certify right-of-entry for the periodic on-site evaluation by Howard County, the Howard Soil Conservation District and/or MDE."  
 Arthur Blume - President  
 4/1/17 Date

Design Certification:  
 "I hereby certify that this plan has been designed in accordance with the current Maryland erosion and sediment control laws, regulations, and standards, and that it represents a practical and workable plan based on my personal knowledge of the site, and that it was prepared in accordance with the requirements of the Howard Soil Conservation District."  
 Charles T. Grimsley  
 5/19/17 Date  
 MD P.E. Registration No. 11124

Howard SCD Signature Block:  
 This plan is approved for soil erosion and sediment control by the Howard Soil Conservation District.  
*[Signature]*  
 Date

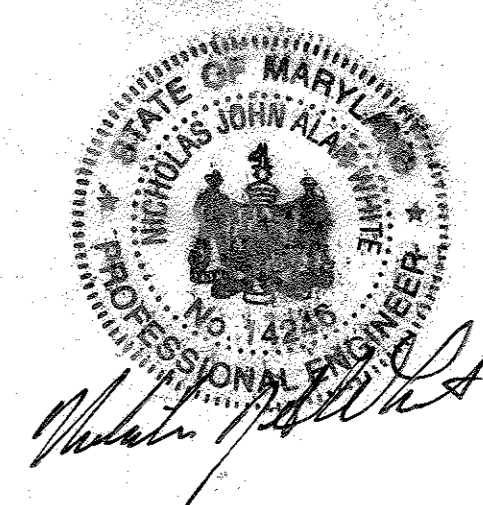


OWNER-DEVELOPER  
 WHISKEY BOTTOM CONDOMINIUMS, ASSOC.  
 c/o MR. ARTHUR F. BLUME, PRESIDENT  
 WHISKEY BOTTOM SOUTH, BOARD OF DIRECTORS  
 9220 BRIDLE PATH LANE, UNIT F  
 LAUREL, MD. 20723

LANDMARK ENGINEERING, INC.  
 6110 EXECUTIVE BLVD, SUITE 110 PHONE: (301) 230-5881  
 ROCKVILLE, MARYLAND 20852 FAX: (301) 230-5884  
 CONSULTING ENGINEERS PLANNERS SURVEYORS

SECTION TWO  
 WHISKEY BOTTOM APARTMENTS  
 SIXTH ELECTION DISTRICT, HOWARD COUNTY, MARYLAND

SITE DEVELOPMENT PLAN  
 PROPOSED RETAINING WALL

REVISIONS	DRN: DCV	CK: CTG	DRAWING NO.
			5-16
			OF 17
			DATE: MAY 5, 2017

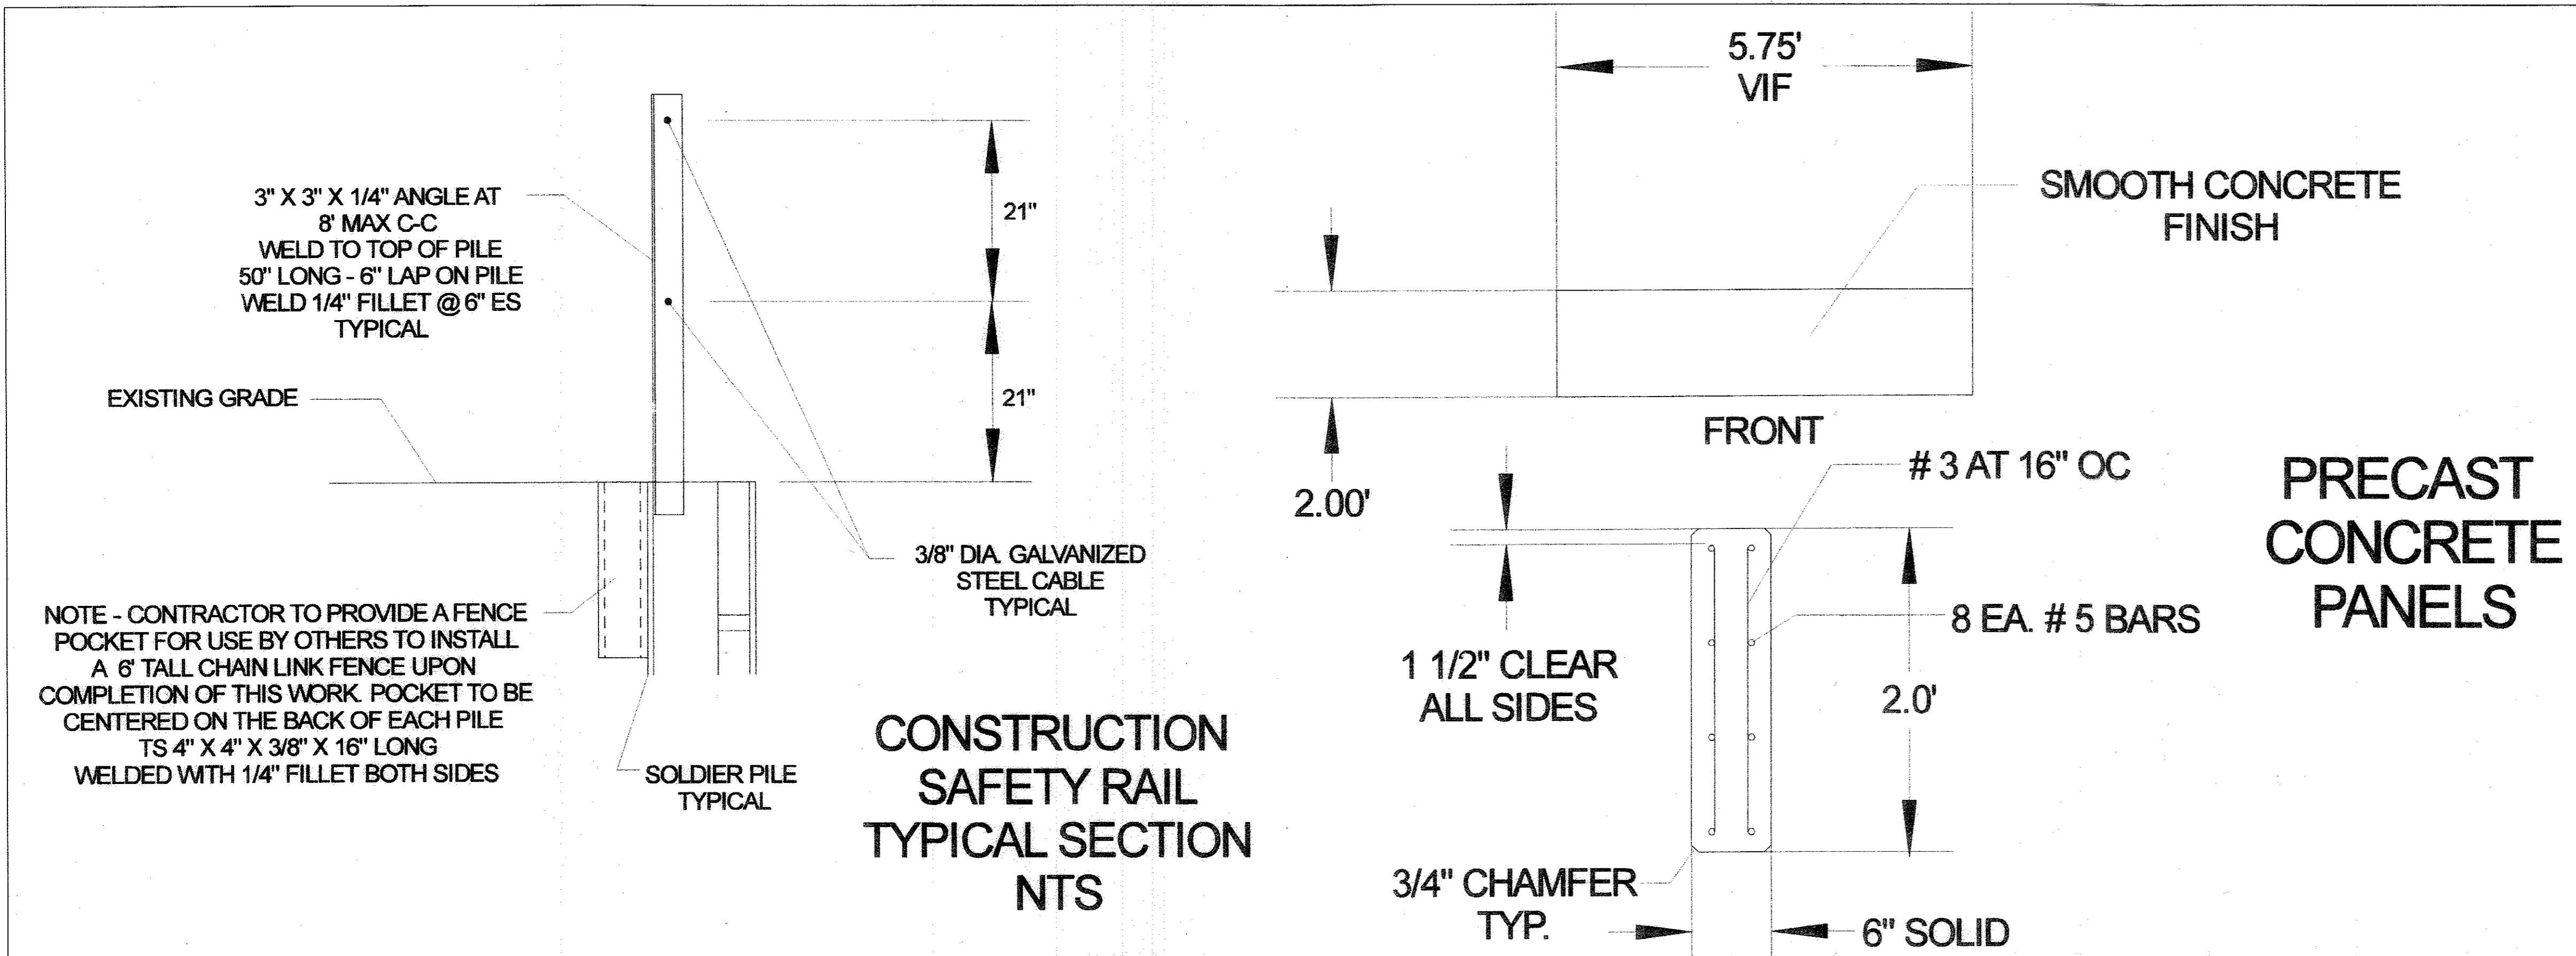

**GENERAL NOTES**

1. ALL SOLDIER PILES ARE TO BE MINIMUM 30' LONG HP 12 X 53 GRADE 50 (A572) STEEL. MINIMUM ALL PILES ARE TO BE SET INTO 24" DIAMETER PRE DRILLED FULL DEPTH HOLES AND THEN BACKFILLED WITH 3000 PSI CONCRETE IN THE PILE TOE. THE REMAINDER OF THE HOLES ARE TO BE FILLED TO GRADE WITH FLOWABLE FILL OR STONE DUST. HOLES TO BE DRILLED EVERY OTHER HOLE, SET & FILLED BEFORE DRILLING ADJACENT HOLE. PILES TO BEAR ON DENSE DISINTEGRATED ROCK OR SOLID ROCK.
2. ALL STRUCTURAL STEEL TO BE MIN. 50 KSI STEEL. ALL REINFORCING STEEL TO BE 60 KSI AND ALL CONCRETE FOR CONCRETE PANELS TO BE 3500 PSI MINIMUM. ALL EXPOSED STEEL IS TO BE COATED WITH RUST RESISTANT PRIMER AND BLACK ENAMEL PAINT. WELDED OR DISTURBED STEEL AREAS TO BE CLEANED AND RECOATED AS NEEDED TO ASSURE COMPLETE COVERAGE.
3. ALL WELDING TO BE PER AWS REQUIREMENTS. ALL WELDING RODS TO BE E70XX.
4. THE UNDERSIGNED ENGINEER IS TO BE NOTIFIED IMMEDIATELY UPON ANY CHANGE OF ANTICIPATED CONDITIONS THAT DIFFER FROM THESE DRAWING DETAILS. NICHOLAS J. A. WHITE 301-980-4672
5. ALL TIEBACKS ARE TO CLASS 1 FULLY ENCAPSULATED SOLID THREAD BAR PERMANENT TIES IN ACCORDANCE WITH FHWA & PTI REQUIREMENTS. MINIMUM DRILL HOLE DIAMETER IS 4". THE UNBONDED LENGTH OF THE BAR IS TO BE COVERED IN PE PLASTIC TUBING BEFORE ENCAPSULATION. LENGTHS SHOWN ARE MINIMUM LENGTHS TO BE INCREASED AS NEEDED TO PROVIDE THE CAPACITY INDICATED.
6. TIEBACK GROUT IS TO BE NEAT CEMENT GROUT USING A MIXTURE OF 1 BAG OF PORTLAND TYPE 3 CEMENT TO 5 1/2 GALLONS OF POTABLE WATER. TIEBACK GROUT TO BE PUMPED FROM THE BOTTOM OF THE HOLE UP BEFORE INSERTING THE ENCAPSULATED TIEBACKS MAKING SURE THAT CLEAN GROUT RETURNS TO THE SURFACE BEFORE STOPPING GROUTING.
7. ALL TIEBACKS ARE TO BE PROOF TESTED TO 133% OF DESIGN LOAD, AND LOCKED OFF AT 100% OF DESIGN LOAD. THE MAXIMUM INCREMENTAL MOVEMENT OF A TIEBACK IS 0.04" DURING A 10 MINUTE HOLD AT 133% TEST LOAD IN ORDER THAT THE TIEBACK BE DEEMED ACCEPTABLE. MOVEMENT TO BE MEASURED USING A DIAL GAUGE OF 0.001" ACCURACY.
8. CONTRACTOR TO NOTIFY "MISS UTILITY". VERIFICATION OF ALL UTILITY LOCATIONS & ELEVATIONS, UTILITY TEST PITS AND UTILITY RELOCATIONS AS REQUIRED TO SAFELY PERFORM THIS WORK IS THE RESPONSIBILITY OF OTHERS.
9. EXCAVATION SHALL BE MADE IN MAXIMUM LIFT HEIGHTS OF 4 FEET TO FACILITATE PLACEMENT OF LAGGING. EXCAVATION AND LAGGING IS TO BE DONE ON AN ALTERNATE BAY BASIS. WALERS ARE TO BE INSTALLED, LAGGING COMPLETE AND PROPERLY BACKFILLED ABOVE THE WALERS BEFORE THE ADJACENT BAY IS EXCAVATED. BACKFILL AROUND WALTER AND LAGGING ABOVE TO BE SM MATERIAL OR BETTER COMPACTED TO AT LEAST 95% MAXIMUM DRY DENSITY PER ASTM D698. BACKFILL OPERATIONS TO BE OBSERVED AND TESTED BY THIRD PARTY INSPECTOR. TIEBACKS ARE TO BE FULLY COMPLETED AND TESTED PRIOR TO LAGGING BELOW THE WALTER ELEVATION.
10. ALL LAGGING TO BE 3" THICK MINIMUM TREATED BOARDS. 1" THICK LOUVER BLOCKS TO BE USED TO ASSURE PROPER DRAINAGE.

<b>OWNER</b>	WHISKEY BOTTOM SOUTH C/O SIMMONS MGMT. GROUP COLLEGE, MARYLAND 20740
<b>ENGINEER</b>	PROFESSIONAL CONSULTING CORP. PO BOX 129 DUNKIRK, MARYLAND 20754 301-980-4672
<b>PROJECT</b>	WHISKEY BOTTOM APARTMENTS HOWARD COUNTY, MD.
<b>RETAINING WALL</b>	

DATE 10/11/2016  
REVISION #1 10/23/2016

DWG. 103

I HEREBY CERTIFY THAT THESE DOCUMENTS WERE PREPARED OR APPROVED BY ME, AND THAT I AM A DULY LICENSED PROFESSIONAL ENGINEER UNDER THE LAWS OF THE STATE OF MARYLAND, LICENSE # 14246, EXPIRATION 12/23/2018

NICHOLAS J. A. WHITE, PE  
301-980-4672

HOWARD COUNTY OFFICE OF PLANNING AND ZONING APPROVED

*Nick Stalio* 7/18/17  
CHIEF, LAND DEVELOPMENT DIVISION

*John P. ...* 7-7-17  
CHIEF, DEVELOPMENT ENGINEERING DIVISION

*Nicholas J. A. White* 7-11-17  
DIRECTOR OF PLANNING AND ZONING

**Owners/Developer Certification:**

"I/We hereby certify that any clearing, grading, construction, or development will be done pursuant to this approved erosion and sediment control plan, including inspecting and maintaining controls, and that the responsible personnel involved in the construction project will have a Certificate of Training at a Maryland Department of the Environment (MDE) approved training program for the control on erosion and sediment prior to beginning the project. I certify right-of-entry for the periodic on-site evaluation by Howard County, the Howard Soil Conservation District and/or MDE."

*Arthur Blume* 4/2/17  
Owner's/ Developer's Signature  
ARTHUR BLUME - PRESIDENT  
Printed Name & Title

**Design Certification:**


"I hereby certify that this plan has been designed in accordance with the current Maryland erosion and sediment control laws, regulations, and standards, that it represents a practical and workable plan based on my personal knowledge of the site, and that it was prepared in accordance with the requirements of the Howard Soil Conservation District."

*Charles T. Givinsky* 5/19/17  
Designer's Signature  
Charles T. Givinsky  
Printed Name MD P.E. Registration No. 11124

**Howard SCD Signature Block:**

This plan is approved for soil erosion and sediment control by the Howard Soil Conservation District.

*[Signature]*  
Howard Soil Conservation District Date

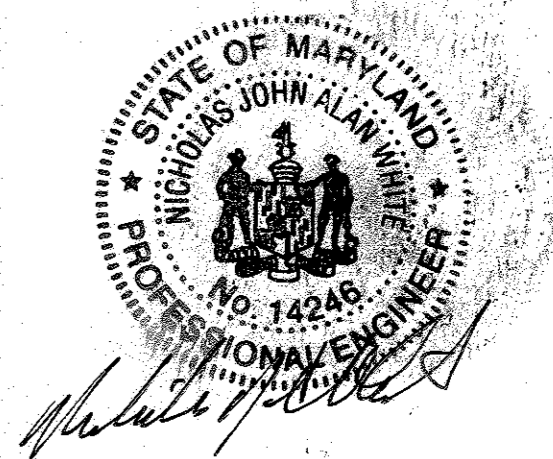



OWNER-DEVELOPER  
WHISKEY BOTTOM CONDOMINIUMS, ASSOC.  
c/o MR. ARTHUR F. BLUME, PRESIDENT  
WHISKEY BOTTOM SOUTH, BOARD OF DIRECTORS  
9220 BRIDLE PATH LANE, UNIT F  
LAUREL, MD. 20723

**LANDMARK ENGINEERING, INC.**  
6110 EXECUTIVE BLVD, SUITE 110 PHONE: (301) 230-5881  
ROCKVILLE, MARYLAND 20852 FAX: (301) 230-5884  
CONSULTING ENGINEERS PLANNERS SURVEYORS

**SECTION TWO**  
**WHISKEY BOTTOM APARTMENTS**  
SIXTH ELECTION DISTRICT, HOWARD COUNTY, MARYLAND

**SITE DEVELOPMENT PLAN**  
**PROPOSED RETAINING WALL**


<b>REVISIONS</b>	DRN: DCV CK: CTG	<b>DRAWING</b>
	PROJECT NO.: 1530	NO. 5-17
	SCALE: AS SHOWN	OF 17
	DATE: MAY 5, 2017	

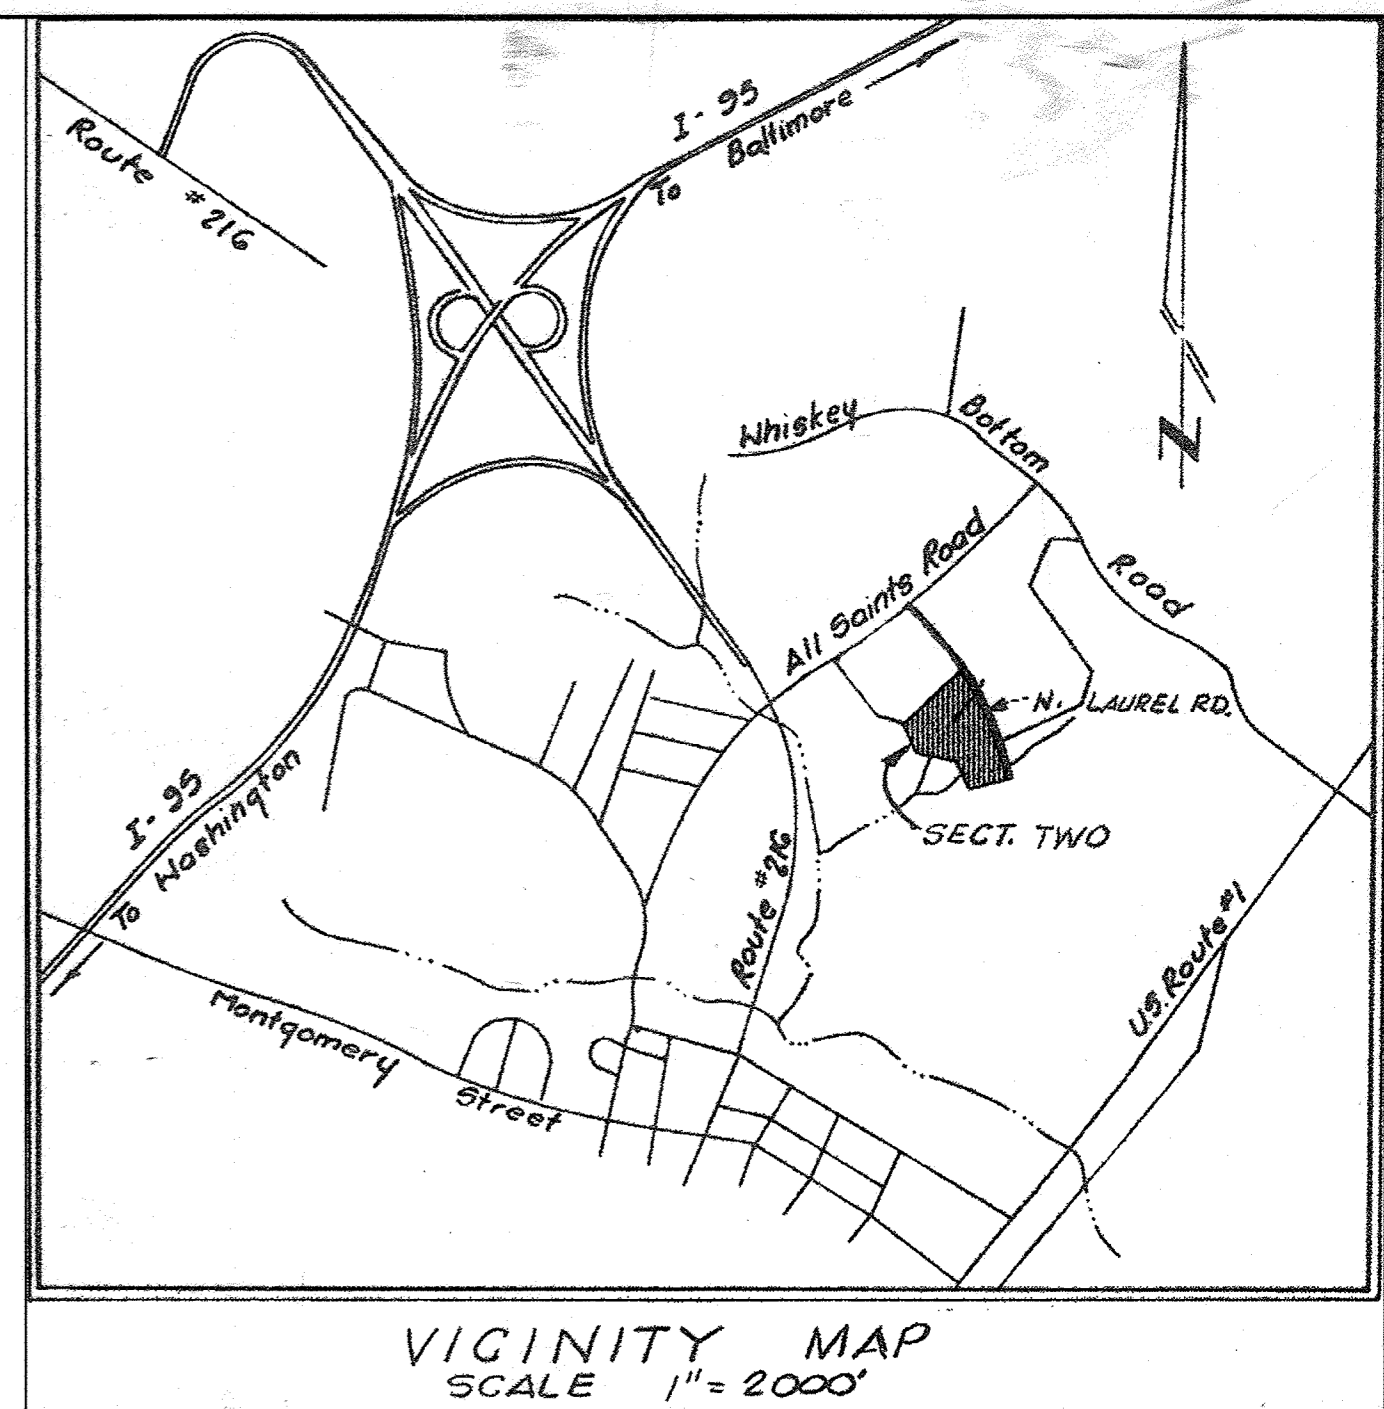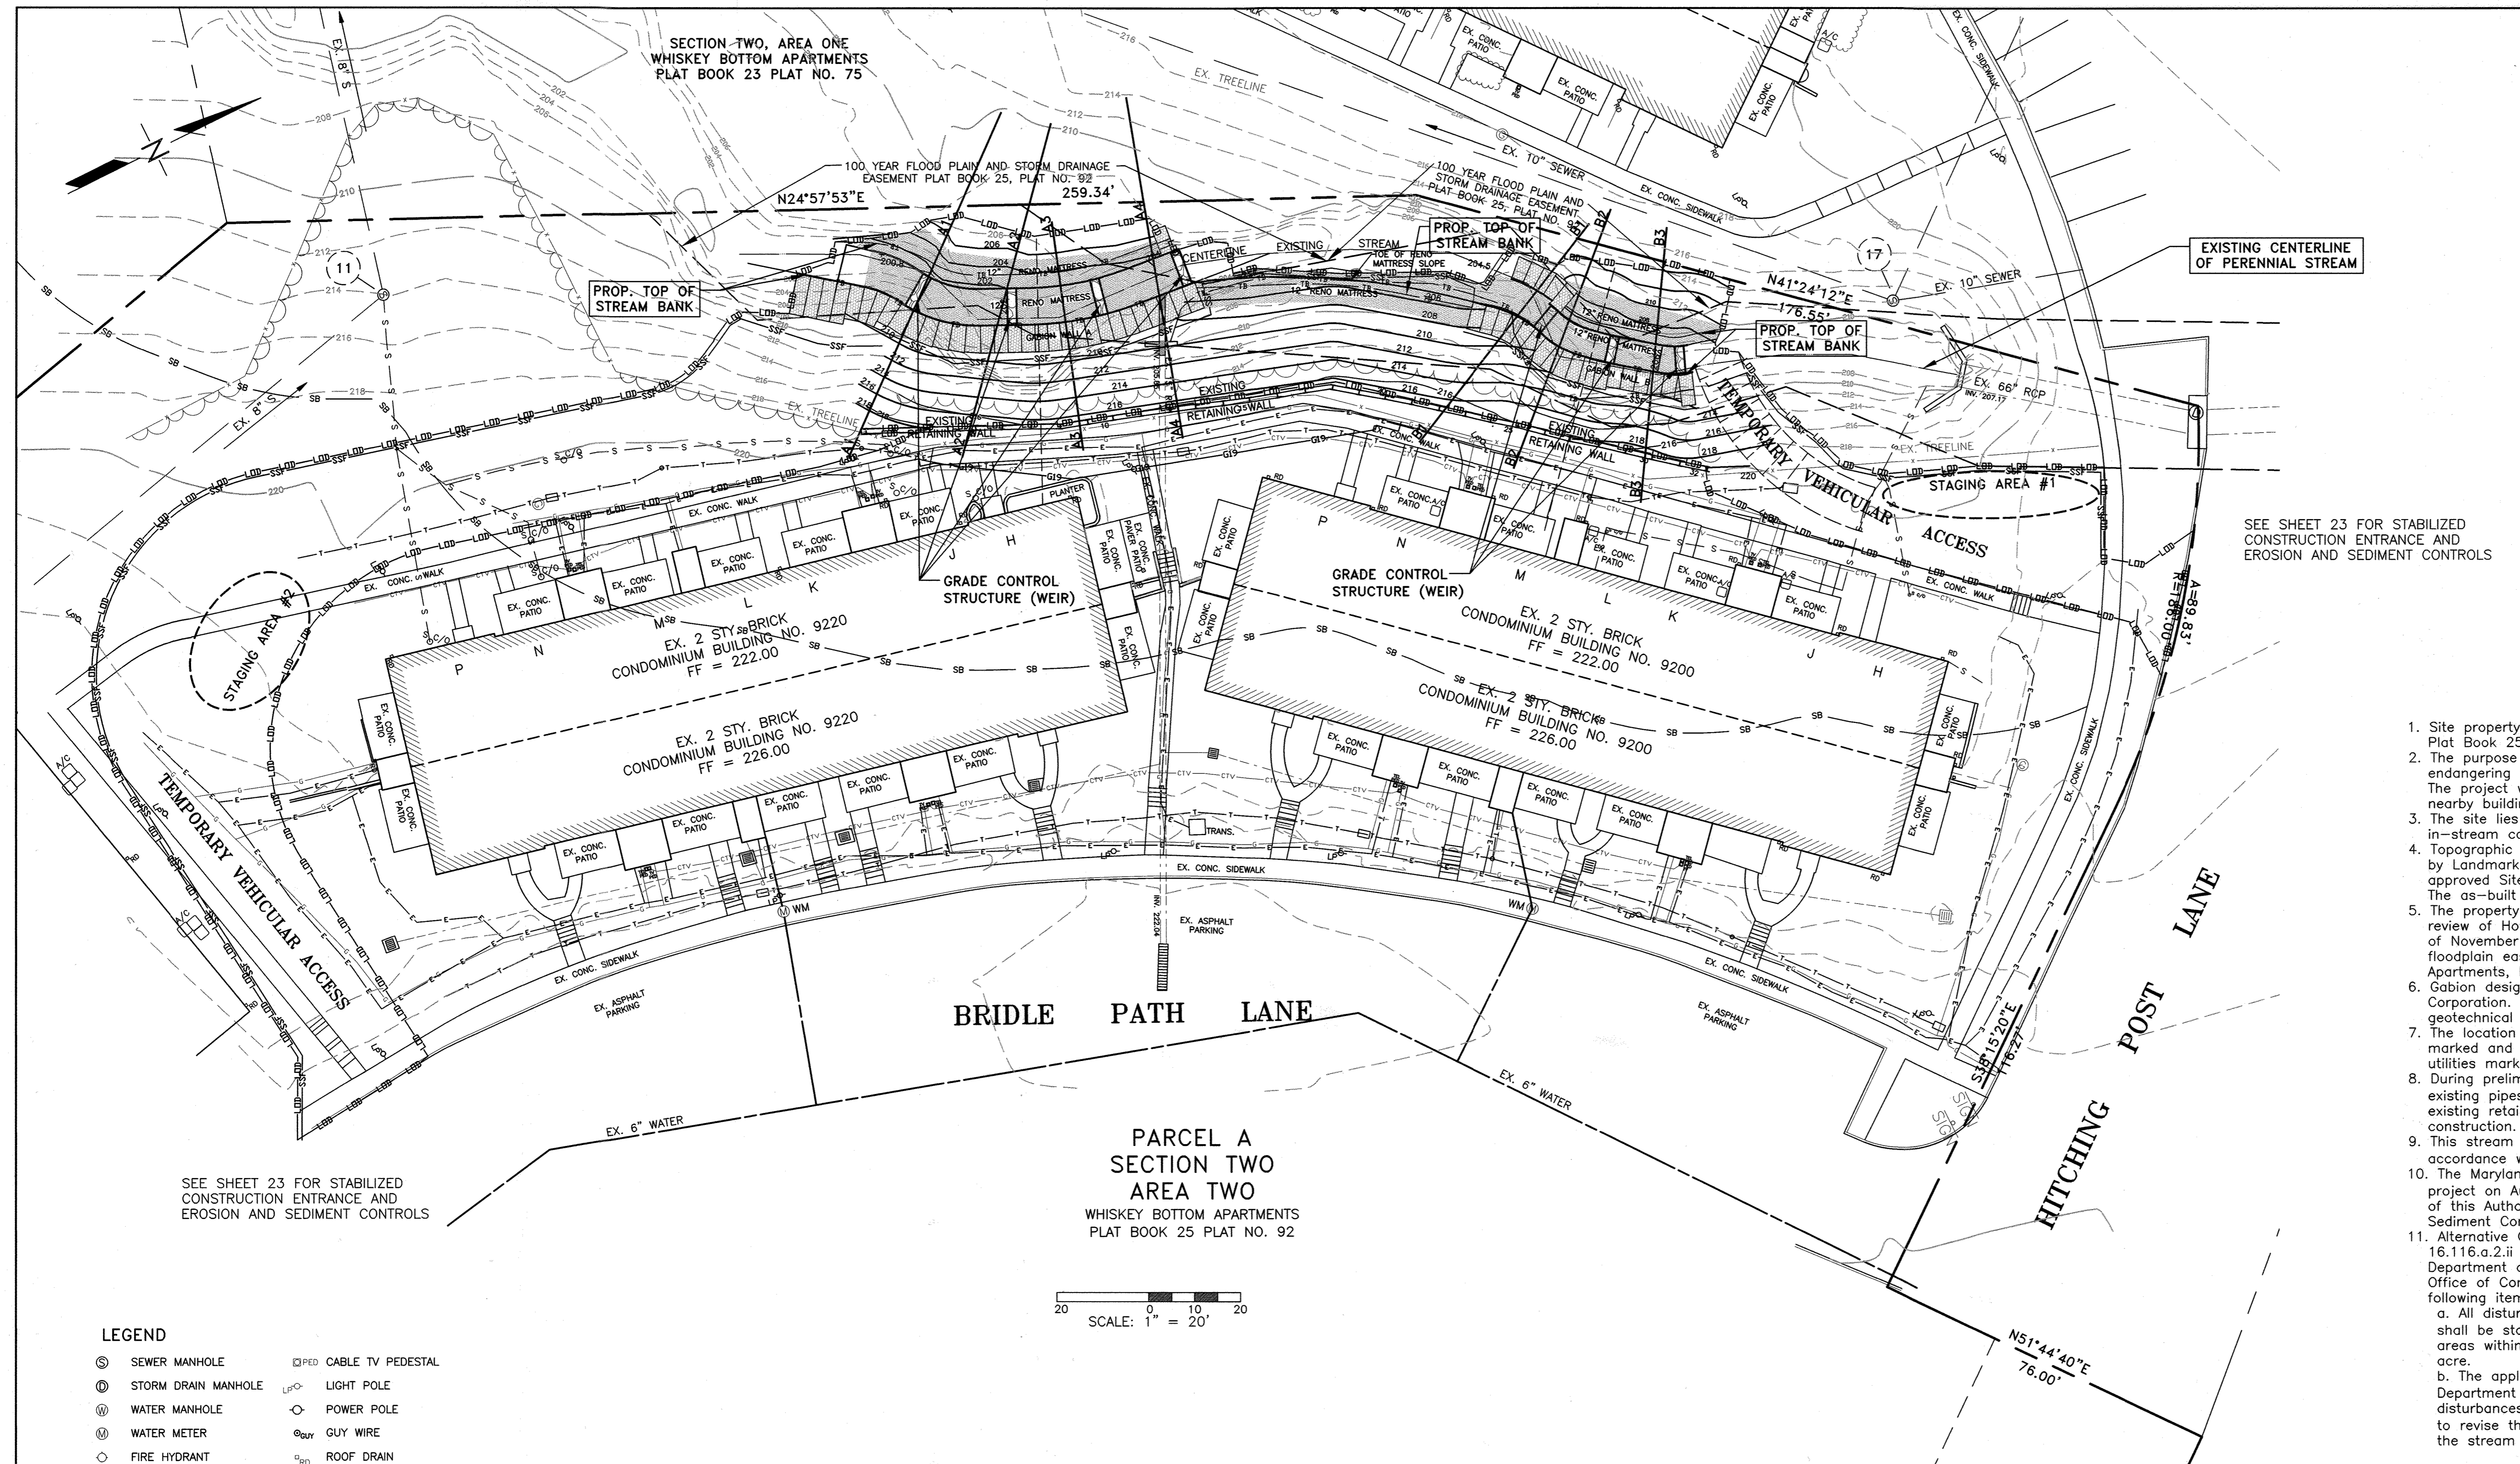

- GENERAL NOTES:**
- Site property is known as Section Two - Area Two, Whiskey Bottom Apartments recorded Plat Book 25 at Plat No. 92. Current Zoning: R-A-15.
  - The purpose of this project is to remediate for shifts in the stream centerline which is endangering the stability of 28 units of single family attached dwellings. The project will stabilize stream bank erosion and assign global stability with respect to the nearby buildings. The total disturbed area is 17,490 sq. ft.
  - The site lies within the Patuxent River Watershed which is Maryland Class Use I with no in-stream construction permitted from March 1 to June 15, inclusive.
  - Topographic information from survey conducted in the field August and September, 2015 by Landmark Engineering, Inc. Horizontal Datum per Plat No. 92. Vertical Datum per previous approved Site & Grading Plan. Field work in 2019 documented further streambank erosion. The as-built location of the retaining wall was done by field survey in July 2020.
  - The property is not located within a FEMA mapped 100-year floodplain as determined in review of Howard County, Maryland Community Panel No. 24027C0230D with effective date of November 6, 2013. The drainage area to the work area is 83.26 ac. The existing floodplain easement was established by record plat Section Two, Area Two Whiskey Bottom Apartments, Plat Book 25, Plat No. 92.
  - Gabion design to be per plan by the geotechnical engineer, Professional Consulting Corporation. The proposed wall to be gravity wall constructed under guidance of the geotechnical engineer.
  - The location of underground and above ground utilities as shown on this plan were field marked and survey located. This does not relieve the contractor for requirements to have utilities marked by Miss Utility. Any conflicts to be coordinated with the utility companies.
  - During preliminary investigations cameras were used to examine the conditions of the existing pipes. It was determined that the 15" RCP had a joint offset very close to the existing retaining wall. This pipe will get repaired and extended as part of this construction.
  - This stream restoration project is exempt from forest Conservation requirements in accordance with Section 16.1202(b)(1)(xv) of the Howard County Code.
  - The Maryland Department of the Environment issued an Authorization to Proceed for this project on August 5, 2019, Authorization Number 201961118/19/NT-3160. A modification of this Authorization as approved by this site plan revision will be obtained prior to final Sediment Control Permit Issuance.
  - Alternative Compliance WP-21-121 for this project was approved under Section 16.116.a.2.ii and Section 16.115.c of the County Code by the The Director of the Department of Planning and Zoning, Director of Public Works and Administrator of the Office of Community Sustainability on May 21, 2021. The approval is conditioned on the following items:
    - All disturbed areas within the stream, stream bank buffer and 100-year floodplain shall be stabilized, seeded and/or planted after construction is complete. The disturbed areas within the stream buffer shall be replanted at a rate of at least 100 trees per acre.
    - The applicant shall obtain all required authorizations and permits from the Maryland Department of the Environment (MDE) and the U.S. Army Corps of Engineers for disturbances within the stream and floodplain. The applicant shall coordinate with MDE to revise the existing authorization (201961118/19-NT-3160) to be consistent with the stream bank and floodplain impacts as shown on SDP-72-084.

SEE SHEET 23 FOR STABILIZED CONSTRUCTION ENTRANCE AND EROSION AND SEDIMENT CONTROLS

PARCEL A  
SECTION TWO  
AREA TWO  
WHISKEY BOTTOM APARTMENTS  
PLAT BOOK 25 PLAT NO. 92

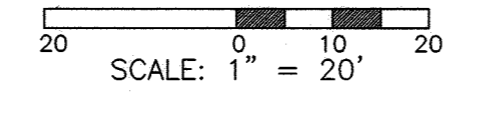

**LEGEND**

⊙ SEWER MANHOLE	□ CABLE TV PEDESTAL
⊕ STORM DRAIN MANHOLE	⊕ LIGHT POLE
⊖ WATER MANHOLE	⊖ POWER POLE
⊗ WATER METER	⊗ GUY WIRE
⊘ FIRE HYDRANT	⊘ ROOF DRAIN
⊙ WATER VALVE	⊙ FLOOR DRAIN
⊙ SPRINKLER	⊙ IRON PIPE FOUND
⊙ GAS VALVE	⊙ REBAR W/ CAP FOUND
203.7 EX. SPOT GRADE	203.7 EX. SPOT GRADE
202.7 EX. SPOT GRADE	202.7 EX. SPOT GRADE
— PROPERTY LINE	— CTV UNDERGROUND CABLE TV
— INDEX CONTOUR	— E UNDERGROUND ELECTRIC
— INTERMEDIATE CONTOUR	— W WATER
— TREELINE	— S SEWER
— PERENNIAL STREAM	— S-H SCHEMATIC HOUSE CONNECTION
— 75' STREAM BANK BUFFER	— S-S STORM DRAIN
— PROPOSED CONTOUR	— LLD PROPOSED LIMITS OF DISTURBANCE
— TOP OF BANK	— SF PROPOSED SILT FENCE
— BOTTOM OF BANK	— SSF PROPOSED SUPER SILT FENCE
— OVERHEAD WIRE	
— UNDERGROUND GAS	
— UNDERGROUND TELECOMMUNICATION	

HOWARD COUNTY DEPARTMENT OF PLANNING AND ZONING  
APPROVED

CHIEF, LAND DEVELOPMENT    6/21/22    DATE

CHIEF, DEVELOPMENT ENGINEERING DIVISION    6-9-22    DATE

DIRECTOR OF PLANNING AND ZONING    6/22/22    DATE

**PROJECT DESCRIPTION**

This project is the second of two phases of work to provide structural stability and stream restoration for two of the Whiskey Bottom South Condominium Buildings - 9200 and 9220 Bridle Path Lane. The geotechnical engineers, Professional Consulting Corporation, determined from their analyses that these two buildings were susceptible to global instability due to the severe eroding of the stream channel and the ground slope which has significant sloughing. The first phase of work consisted of a structural retaining wall system, located at the top of the stream bank near the rear of the two buildings. This wall was approved in the prior SDP Revision in July 2017 and permitted by Howard County. Construction is complete for the first phase.

The second phase of the work being proposed by this plan will stabilize the stream channel and banks below the structural retaining wall. There are two pronounced areas of erosion and sloughing where improvements are being proposed. The plan proposes to utilize gabion walls to shift the alignment of the stream channel and provide bank and channel bottom stabilization with Reno Mattresses (or equivalent) and supplemental riprap stone.

Maryland Department of the Environment (MDE) provided Authorization to proceed No. 201961118/19-NT-3160 for work in the regulated stream and floodplain. There were no wetlands identified in the project construction limits by the MDE staff during a field meeting on February 19, 2019. These plans are submitted to Howard County Department of Planning and Zoning as a Redline Revision to Site Plan SDP 72-84. Approval of this SDP Revision will include the approval of the Sediment Control plans as part of this Site Development Plan.


OWNER-DEVELOPER  
WHISKEY BOTTOM CONDOMINIUM, ASSOC.  
c/o MR. ARTHUR F. BLUME, PRESIDENT  
WHISKEY BOTTOM SOUTH, BOARD OF DIRECTORS  
9220 BRIDLE PATH LANE, UNIT F  
LAUREL, MD. 20723


**LANDMARK ENGINEERING, INC.**  
13722 LAMBERTINA PLACE    PHONE: (301) 230-5881  
ROCKVILLE, MARYLAND 20850    FAX: (301) 230-5884  
CONSULTING ENGINEERS    PLANNERS    SURVEYORS

SECTION TWO  
**WHISKEY BOTTOM APARTMENTS**  
SIXTH ELECTION DISTRICT, HOWARD COUNTY, MARYLAND


SITE DEVELOPMENT PLAN  
**STREAM STABILIZATION**

<b>REVISIONS</b> 6-9-22 SHEETS 15-24 WERE REVISED FOR STREAM RESTORATION DESIGN.	DRN: DCV    CK: CTG PROJECT NO: 1530 SCALE: AS SHOWN DATE: MAR. 28, 2022	DRAWING NO. S-15 OF 24 SDP-72-84
---	---	-------------------------------------

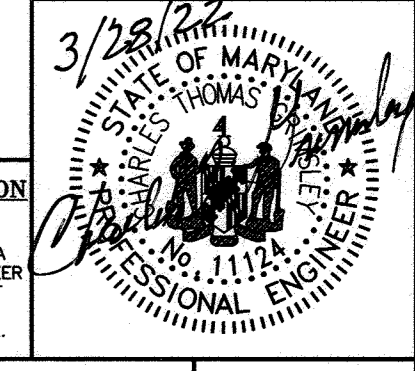


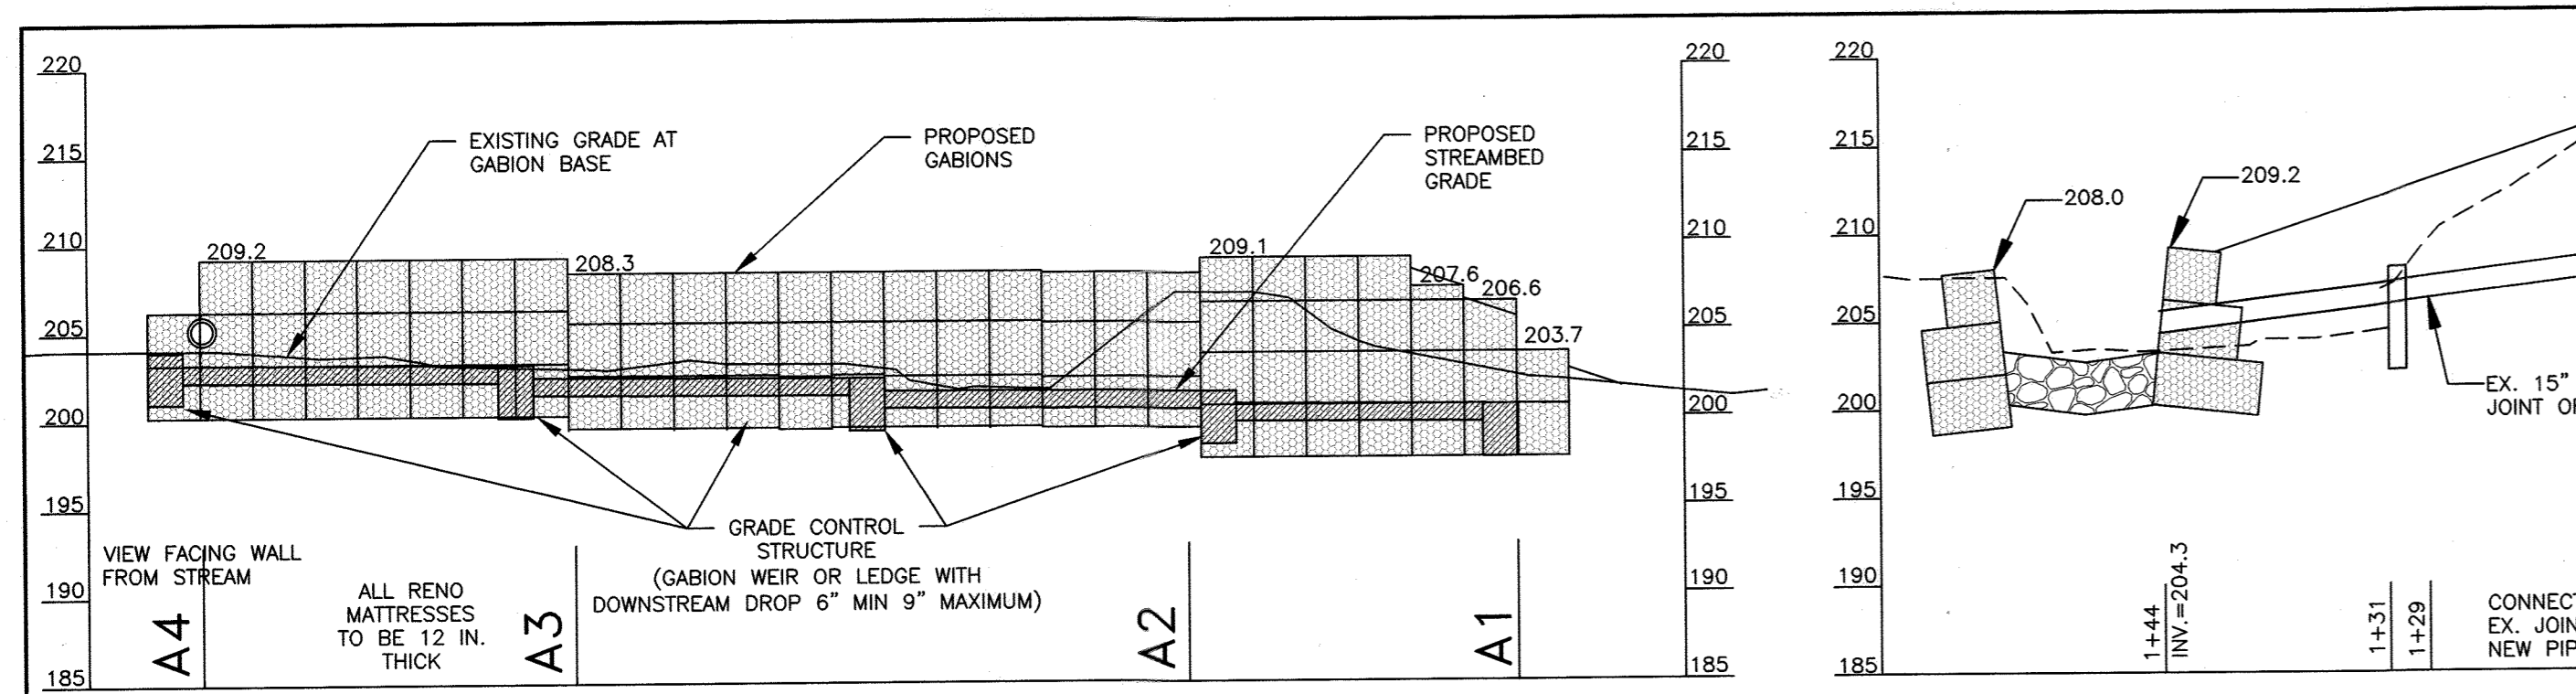


**GABION WALL A ELEVATION**  
SCALE: 1" = 10' HORIZ.  
1" = 10' VERT.

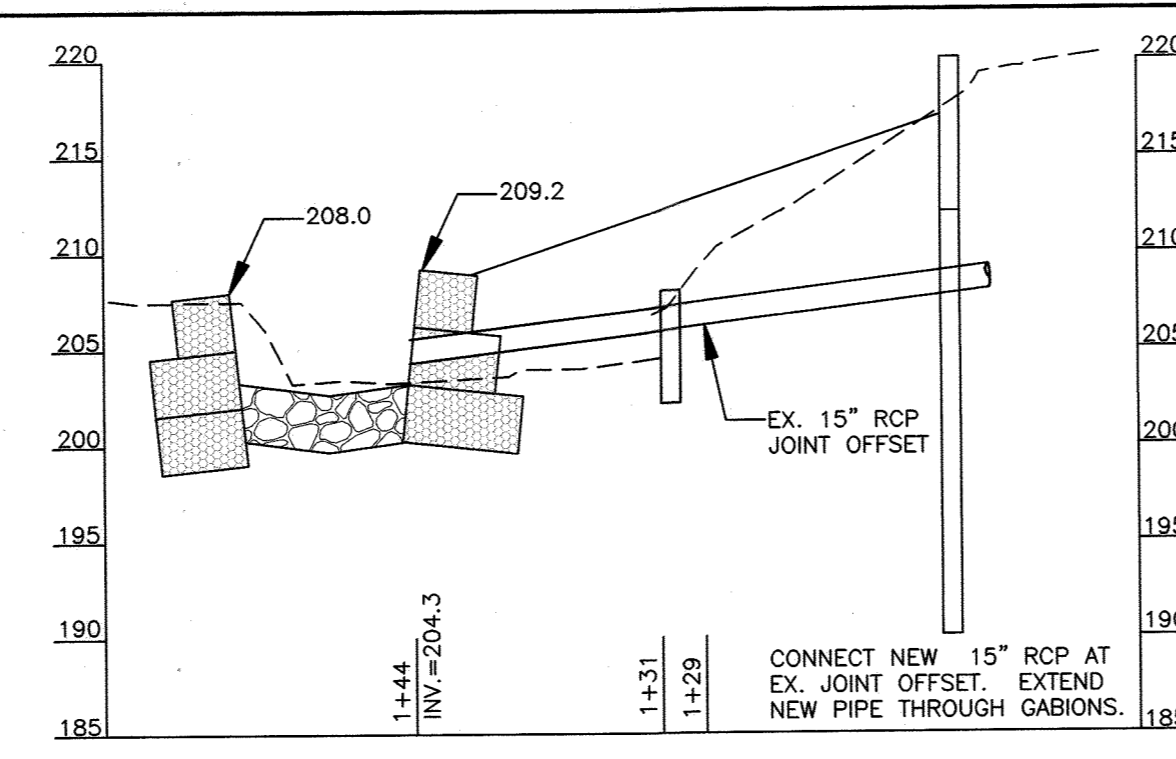


**PARTIAL PROFILE AT EXISTING 15" RCP OUTFALL**  
SCALE: 1" = 10' HORIZ.  
1" = 10' VERT.

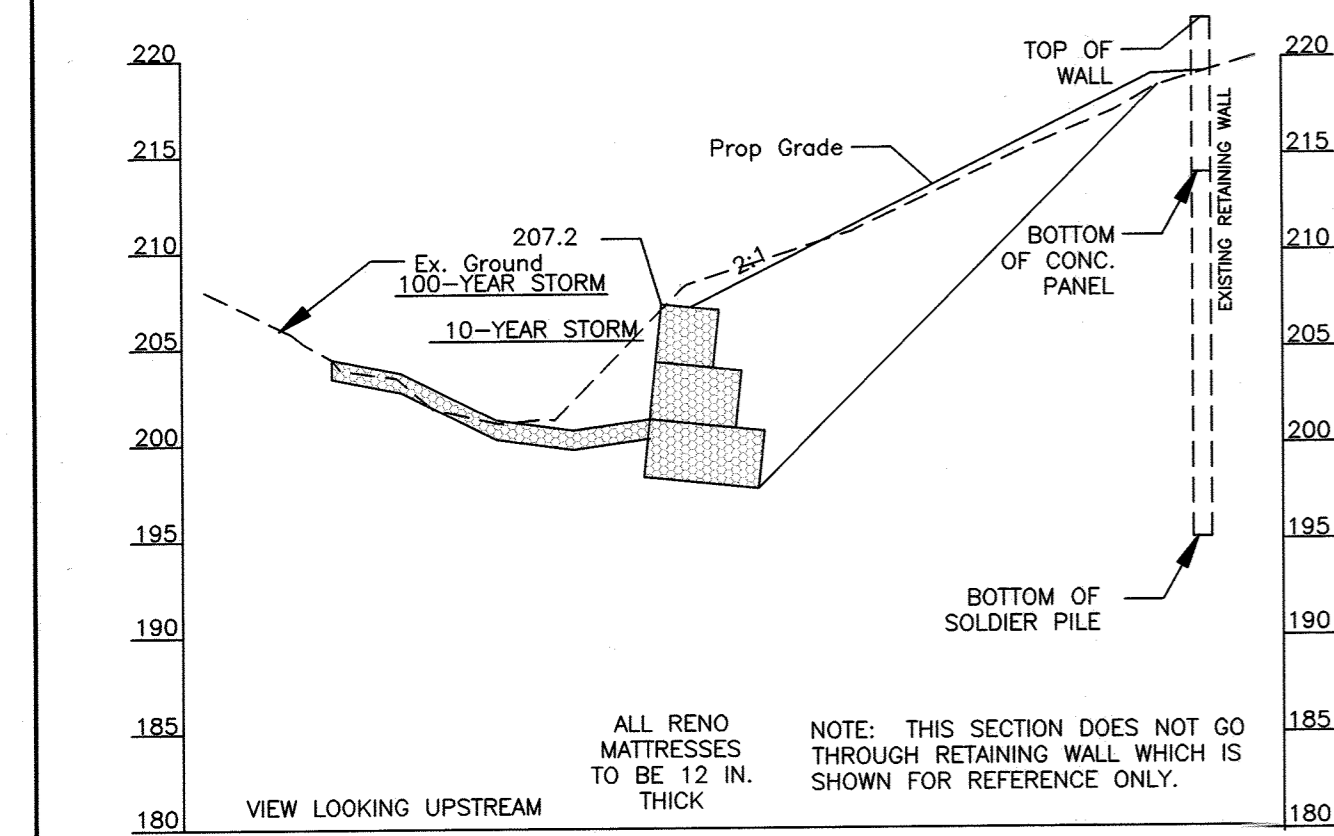


**STREAM CROSS SECTION A1**  
SCALE: 1" = 10' HORIZ.  
1" = 10' VERT.

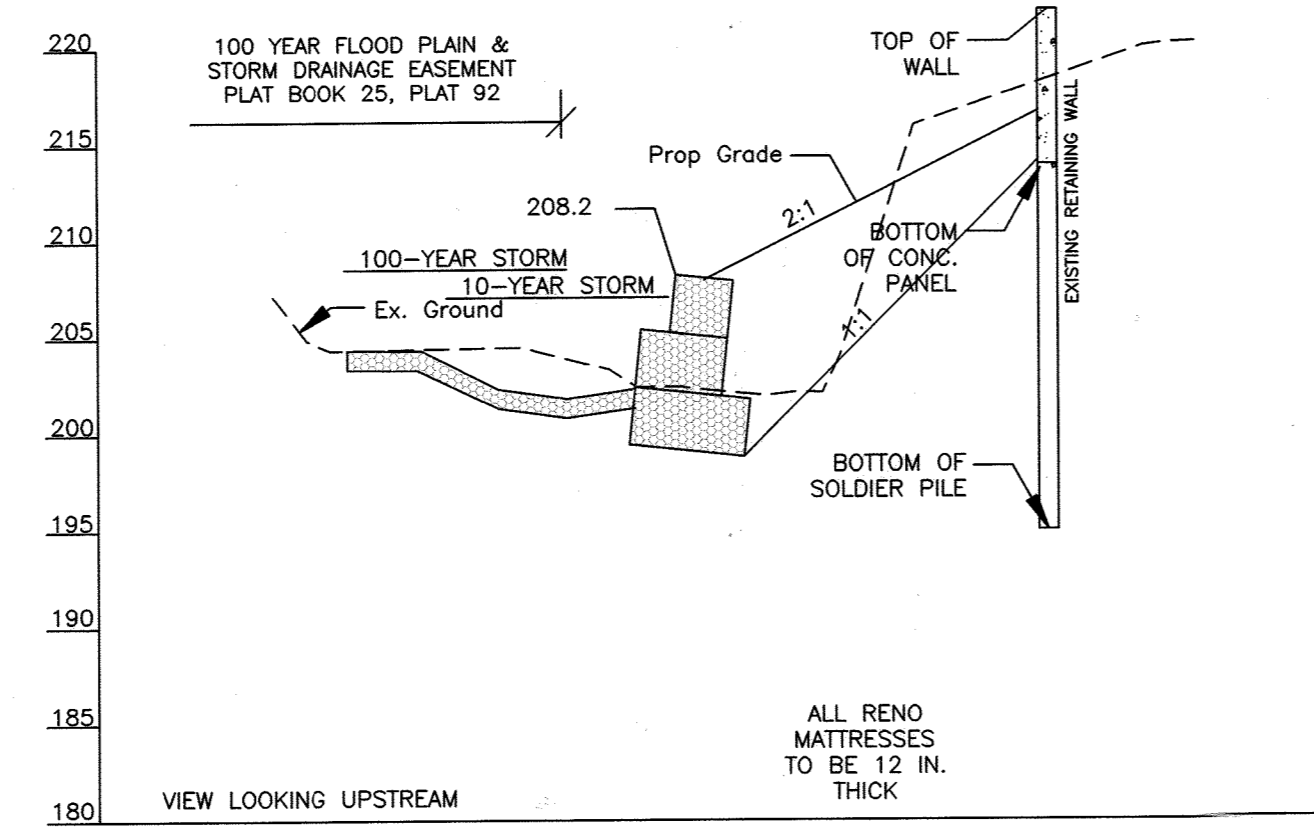


**STREAM CROSS SECTION A2**  
SCALE: 1" = 10' HORIZ.  
1" = 10' VERT.

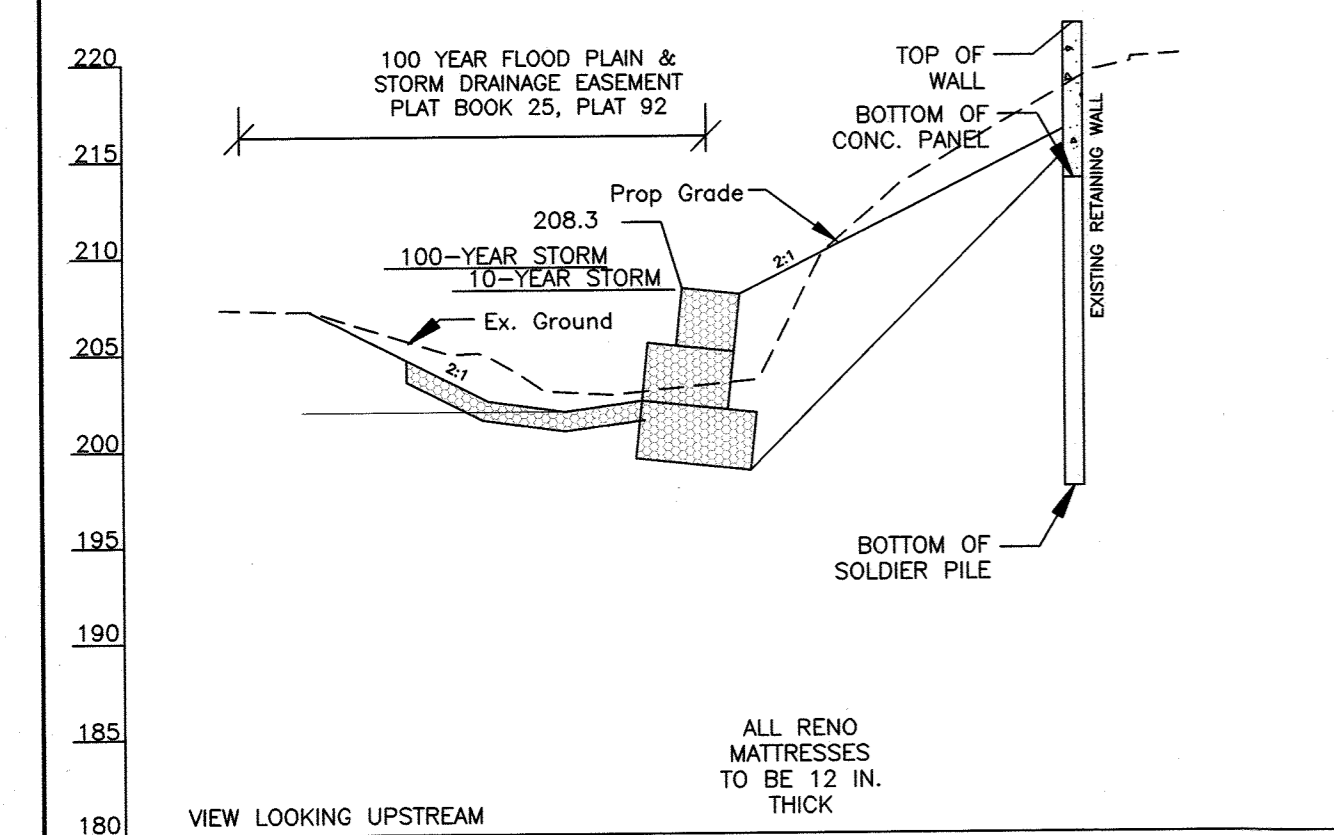

**STREAM CROSS SECTION A3**  
SCALE: 1" = 10' HORIZ.  
1" = 10' VERT.

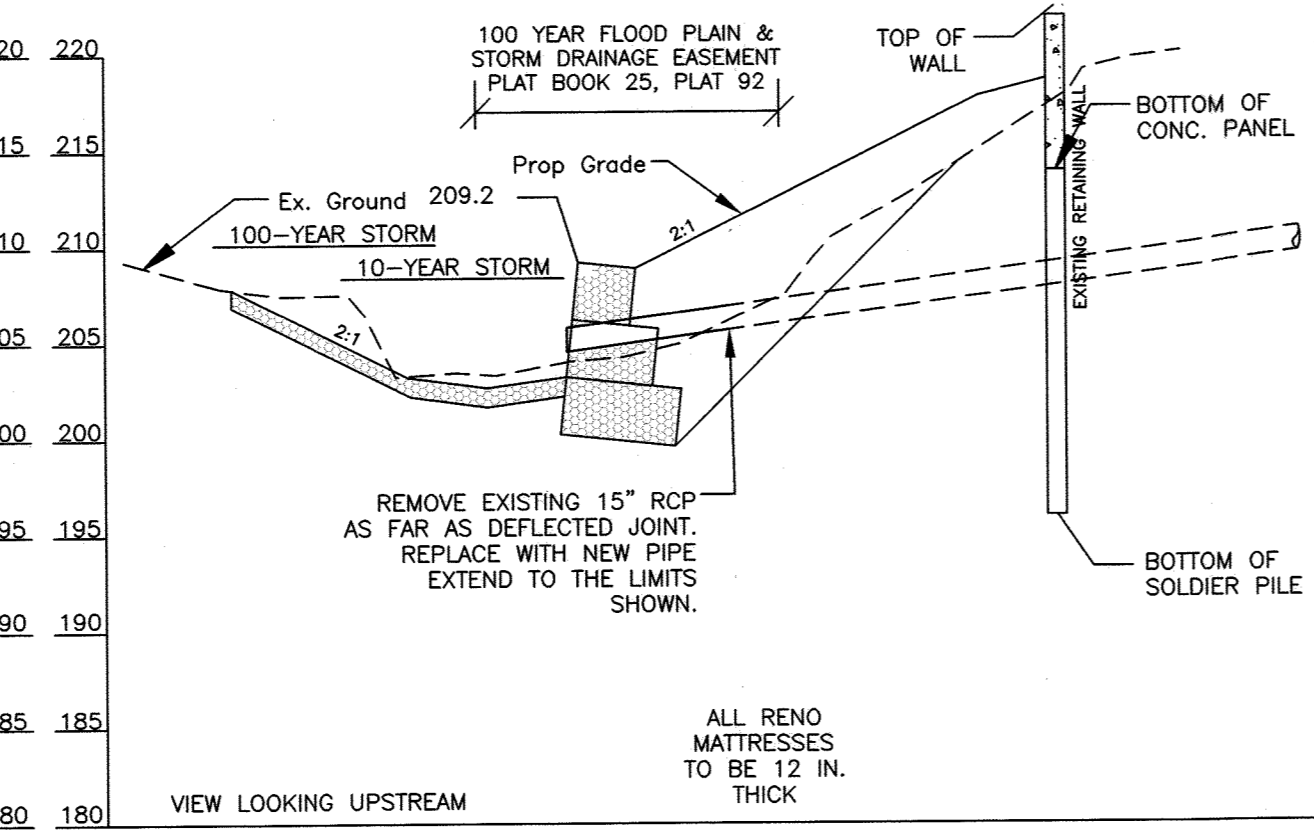

**STREAM CROSS SECTION A4**  
SCALE: 1" = 10' HORIZ.  
1" = 10' VERT.

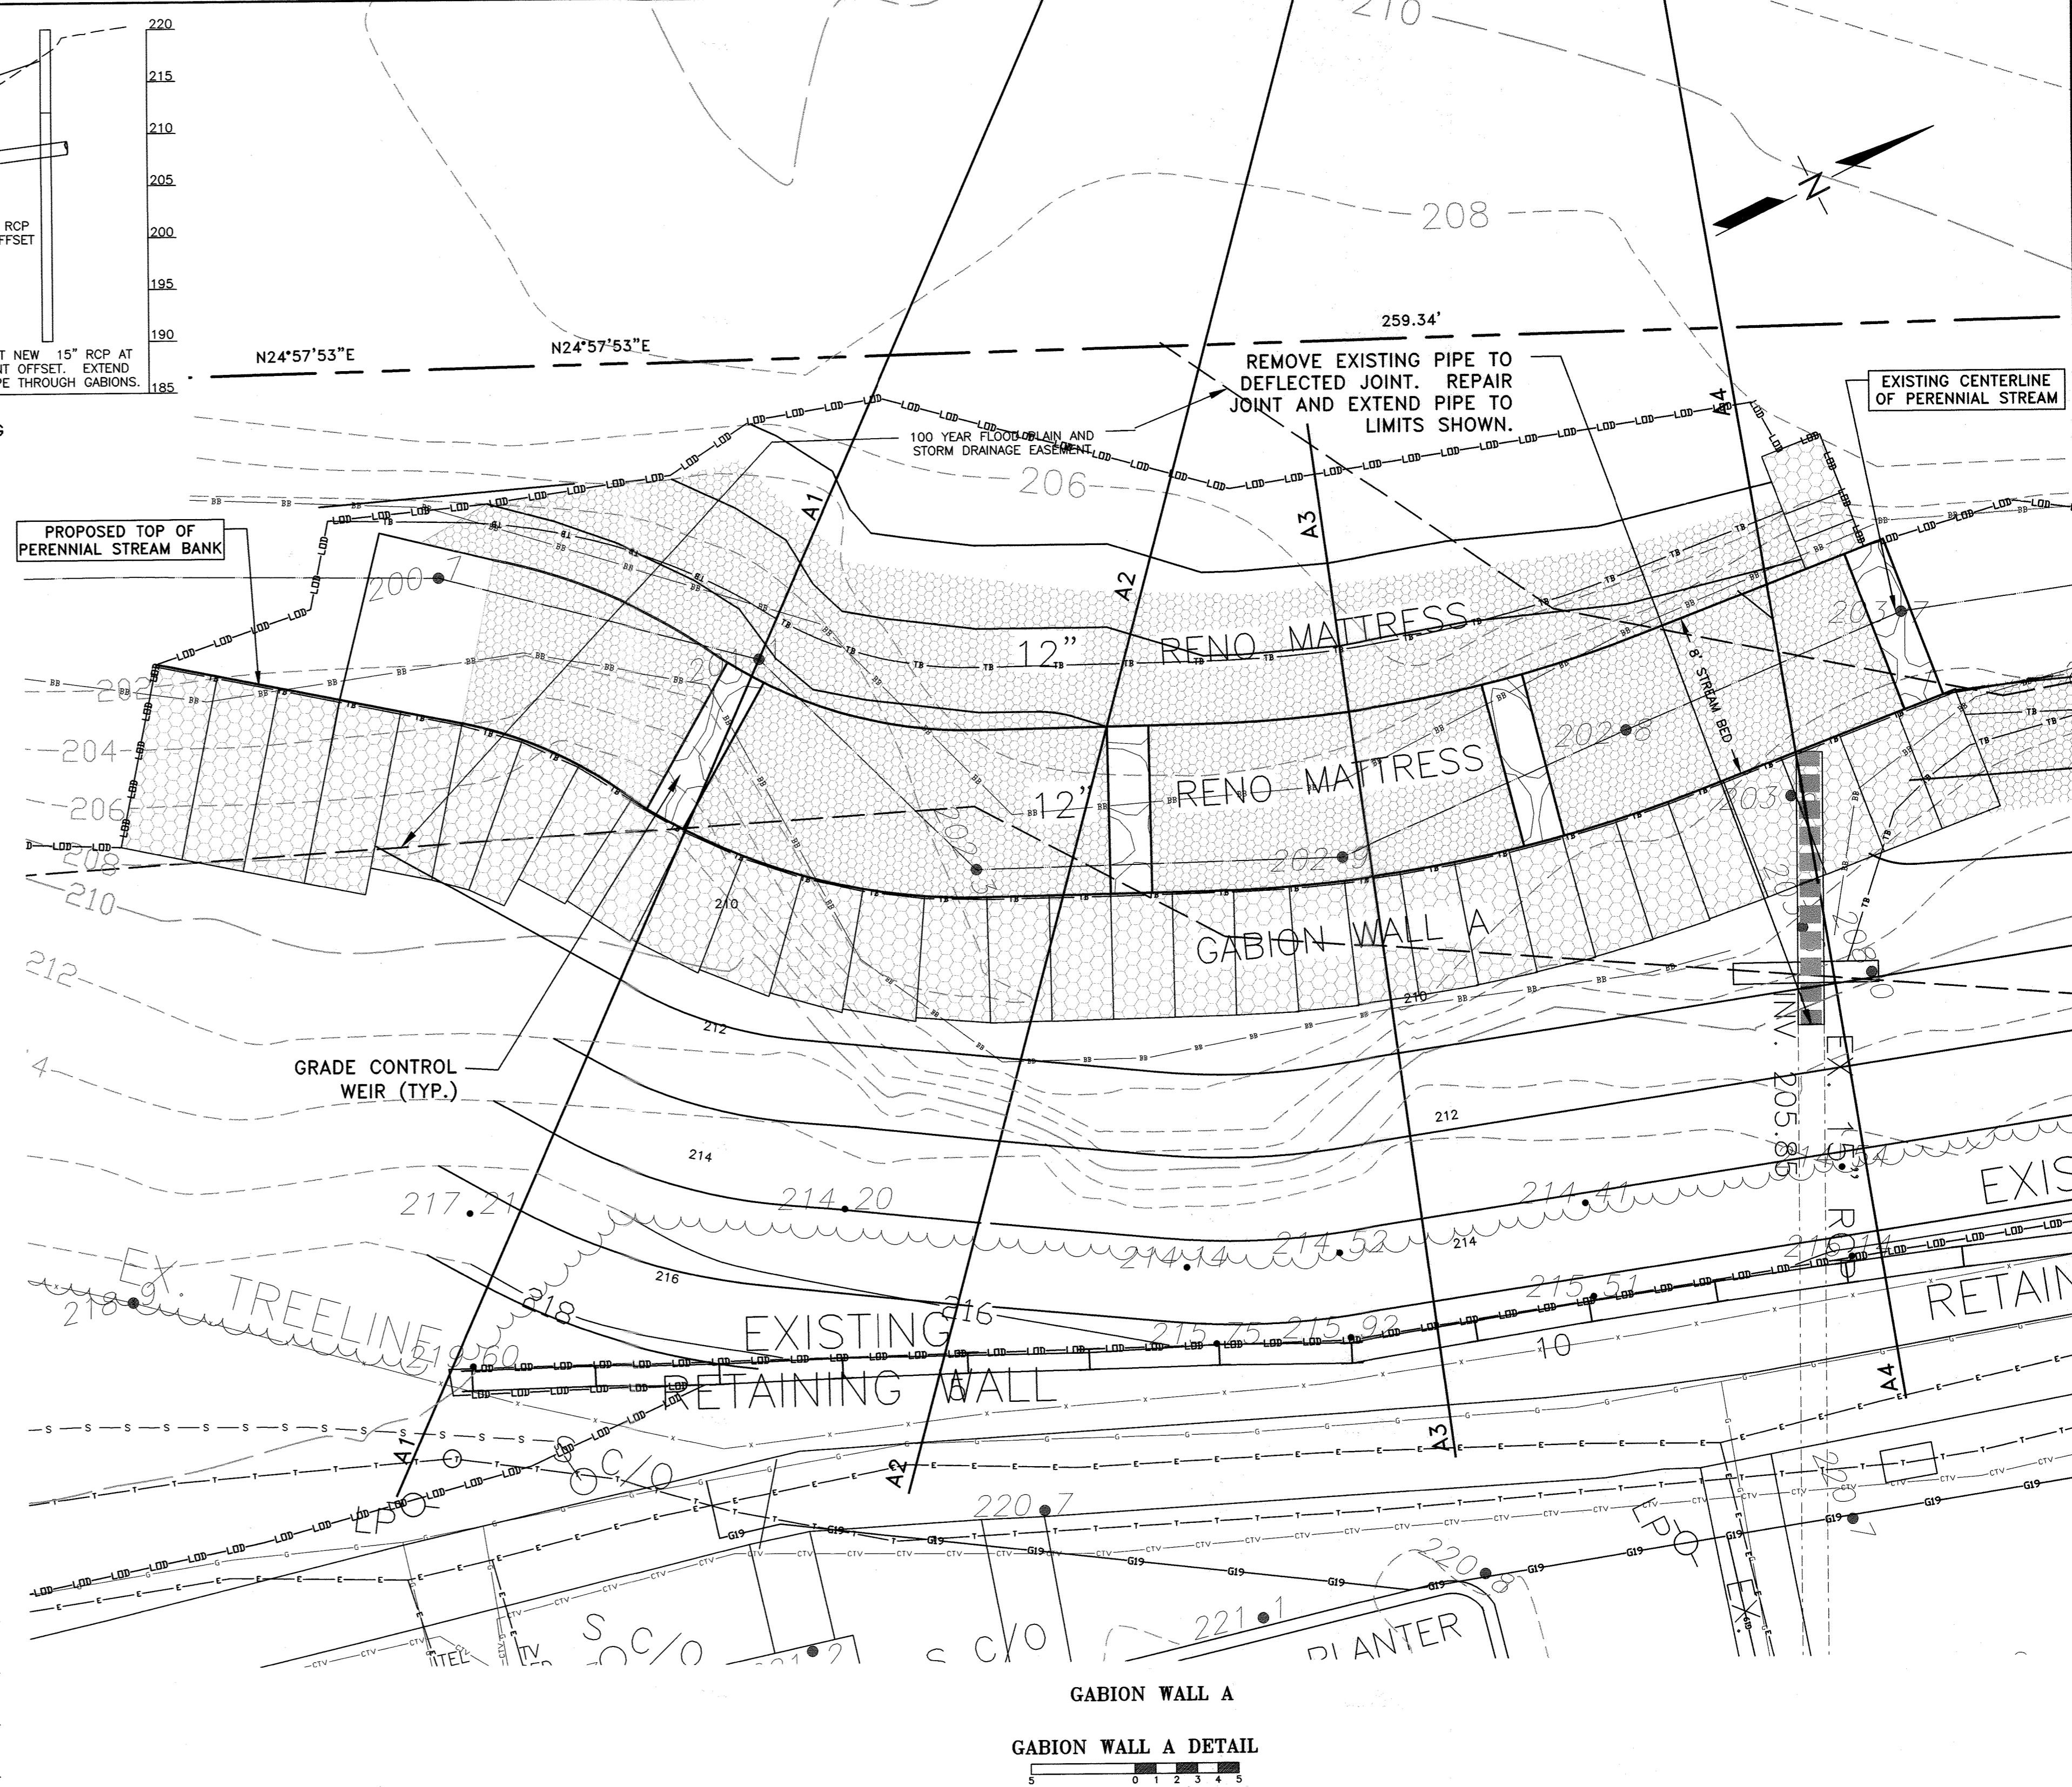


**GABION WALL A GABION WALL A DETAIL**  
SCALE: 1" = 5'  
**NOT FOR CONSTRUCTION**

ALL CROSS SECTIONS LOOKING DOWNSTREAM OR AS LABELED

HOWARD COUNTY DEPARTMENT OF PLANNING AND ZONING APPROVED  
 CHIEF, LAND DEVELOPMENT 06 6/13/22 DATE  
 CHIEF, DEVELOPMENT ENGINEERING DIVISION 6/9/22 DATE  
 DIRECTOR OF PLANNING AND ZONING 6/22/22 DATE

- LEGEND**
- SM SEWER MANHOLE
  - SDM STORM DRAIN MANHOLE
  - WM WATER MANHOLE
  - WATER METER
  - FH FIRE HYDRANT
  - WV WATER VALVE
  - SPRINKLER
  - GV GAS VALVE
  - IPF IRON PIPE FOUND
  - RBCF REBAR W/ CAP FOUND
  - EX. SPOT GRADE
  - CBP CABLE TV PEDESTAL
  - LP LIGHT POLE
  - PP POWER POLE
  - GW GUY WIRE
  - RD ROOF DRAIN
  - FD FLOOR DRAIN
  - IPF IRON PIPE FOUND
  - RBCF REBAR W/ CAP FOUND
  - PL PROPERTY LINE
  - IC INDEX CONTOUR
  - INT INTERMEDIATE CONTOUR
  - TR TREELINE
  - PS PERENNIAL STREAM
  - 75' SB 75' STREAM BANK BUFFER
  - PC PROPOSED CONTOUR
  - TOB TOP OF BANK
  - BOB BOTTOM OF BANK
  - OW OVERHEAD WIRE
  - UG UNDERGROUND GAS
  - UT UNDERGROUND TELECOMMUNICATION
  - CTV UNDERGROUND CABLE TV
  - UE UNDERGROUND ELECTRIC
  - W WATER
  - S SEWER
  - SHS SEWER HOUSE CONNECTION
  - SD STORM DRAIN
  - LDL PROPOSED LIMITS OF DISTURBANCE
  - SF PROPOSED SILT FENCE
  - SSF PROPOSED SUPER SILT FENCE

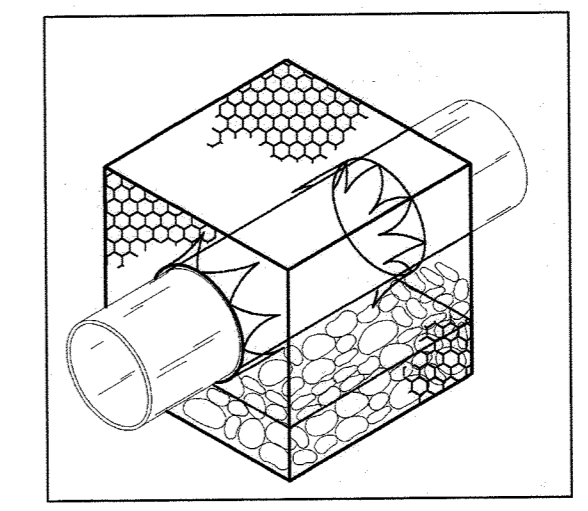

REPLACEMENT/EXTENSION OF PIPE TO BE FITTED TROUGH GABION WALL. MANUFACTURER TO PROVIDE SHOP DRAWING PRIOR FOR REVIEW /APPROVAL BY PROJECT ENGINEER.

PROFESSIONAL CERTIFICATION  
 I HEREBY CERTIFY THAT THESE DOCUMENTS WERE PREPARED OR APPROVED BY ME AND THAT I AM A DULY LICENSED PROFESSIONAL ENGINEER UNDER THE LAWS OF THE STATE OF MARYLAND, LICENSE NO. 11124, EXPIRATION DATE: OCTOBER 3, 2022.


OWNER-DEVELOPER  
 WHISKEY BOTTOM CONDOMINIUM, ASSOC.  
 c/o MR. ARTHUR F. BLUME, PRESIDENT  
 WHISKEY BOTTOM SOUTH, BOARD OF DIRECTORS  
 9220 BRIDLE PATH LANE, UNIT F  
 LAUREL, MD. 20723

**LANDMARK ENGINEERING, INC.**  
 13722 LAMBERTINA PLACE  
 ROCKVILLE, MARYLAND 20850  
 CONSULTING ENGINEERS PLANNERS SURVEYORS  
 PHONE: (301) 230-5881  
 FAX: (301) 230-5884


**SECTION TWO**  
**WHISKEY BOTTOM APARTMENTS**  
 SIXTH ELECTION DISTRICT, HOWARD COUNTY, MARYLAND

**SITE DEVELOPMENT PLAN**  
**STREAM STABILIZATION**  
**GABION WALL A SECTIONS AND ELEVATIONS**


REVISIONS	DRN: DCV CK: CTG	DRAWING NO. S-16 OF 24
	PROJECT NO.: 1530	SCALE: AS SHOWN
	DATE: MAR. 28, 2022	SDP-72-84

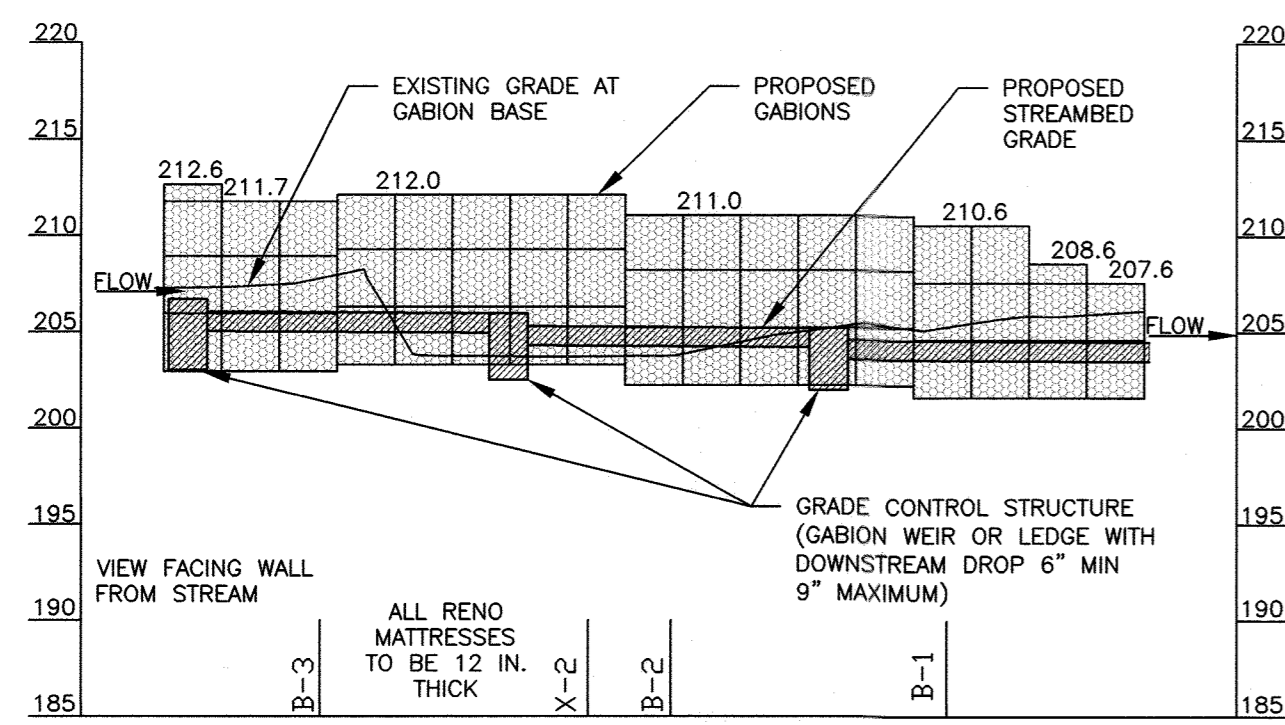


GABION WALL B ELEVATION  
SCALE: 1" = 10' HORIZ.  
1" = 10' VERT.

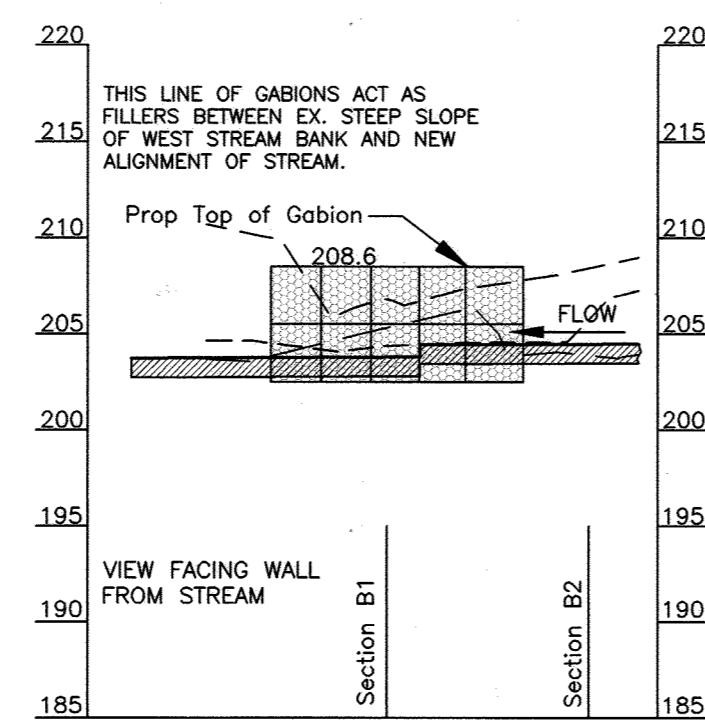


GABION WALL B WEST SIDE ELEVATION  
SCALE: 1" = 10' HORIZ.  
1" = 10' VERT.

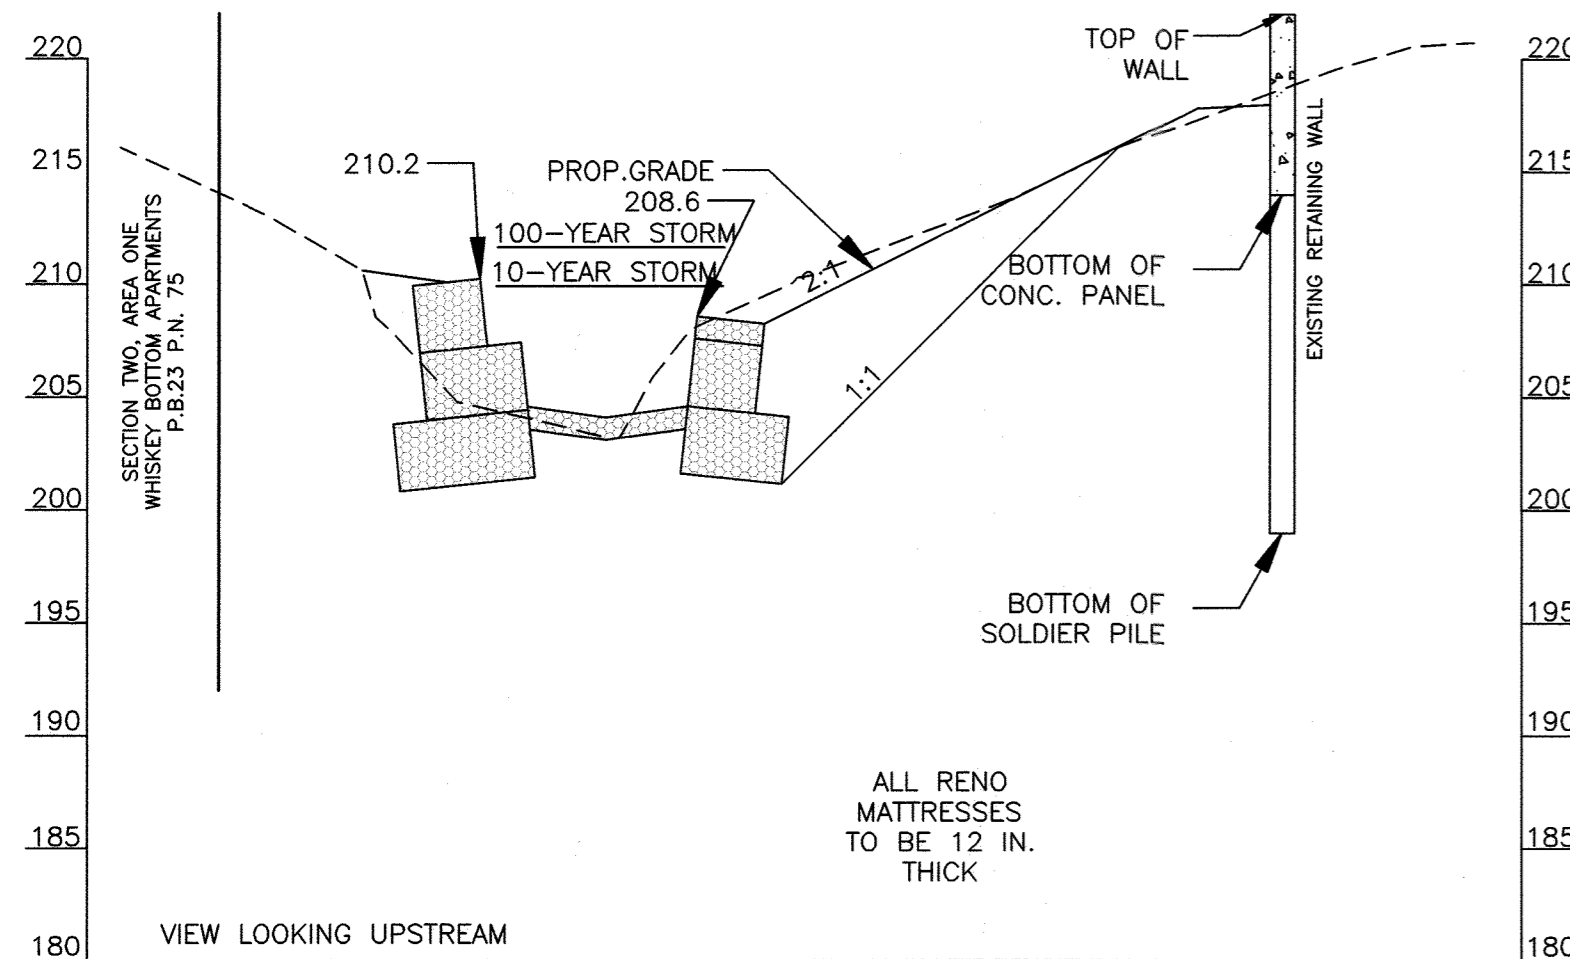


STREAM CROSS SECTION B1  
SCALE: 1" = 10' HORIZ.  
1" = 10' VERT.

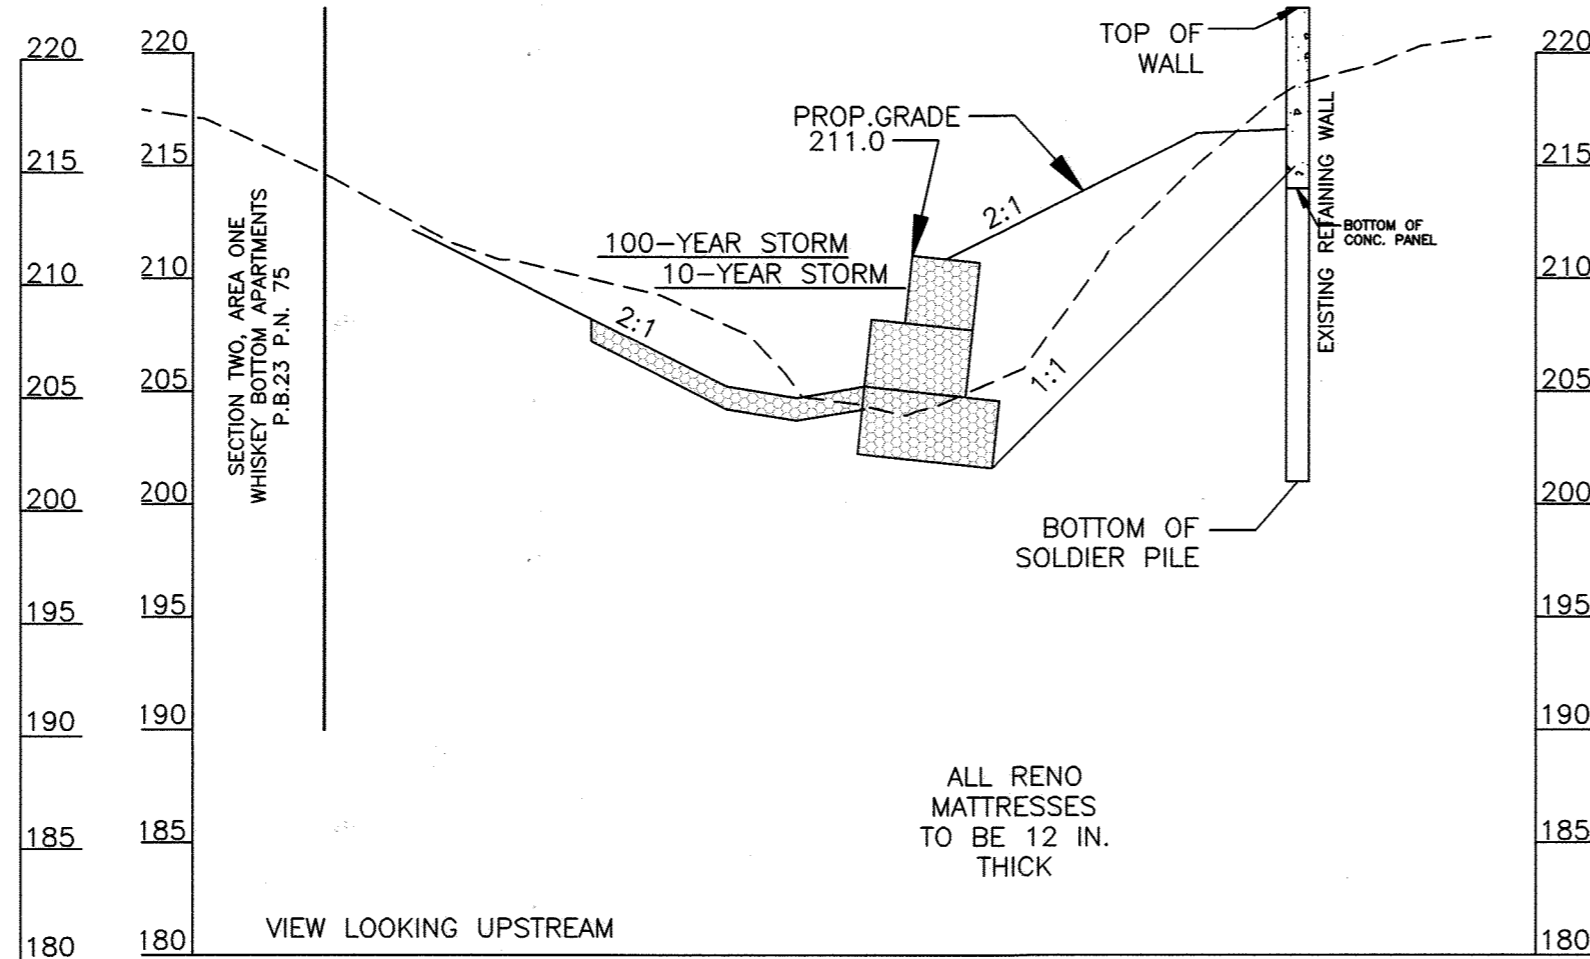


STREAM CROSS SECTION B2  
SCALE: 1" = 10' HORIZ.  
1" = 10' VERT.

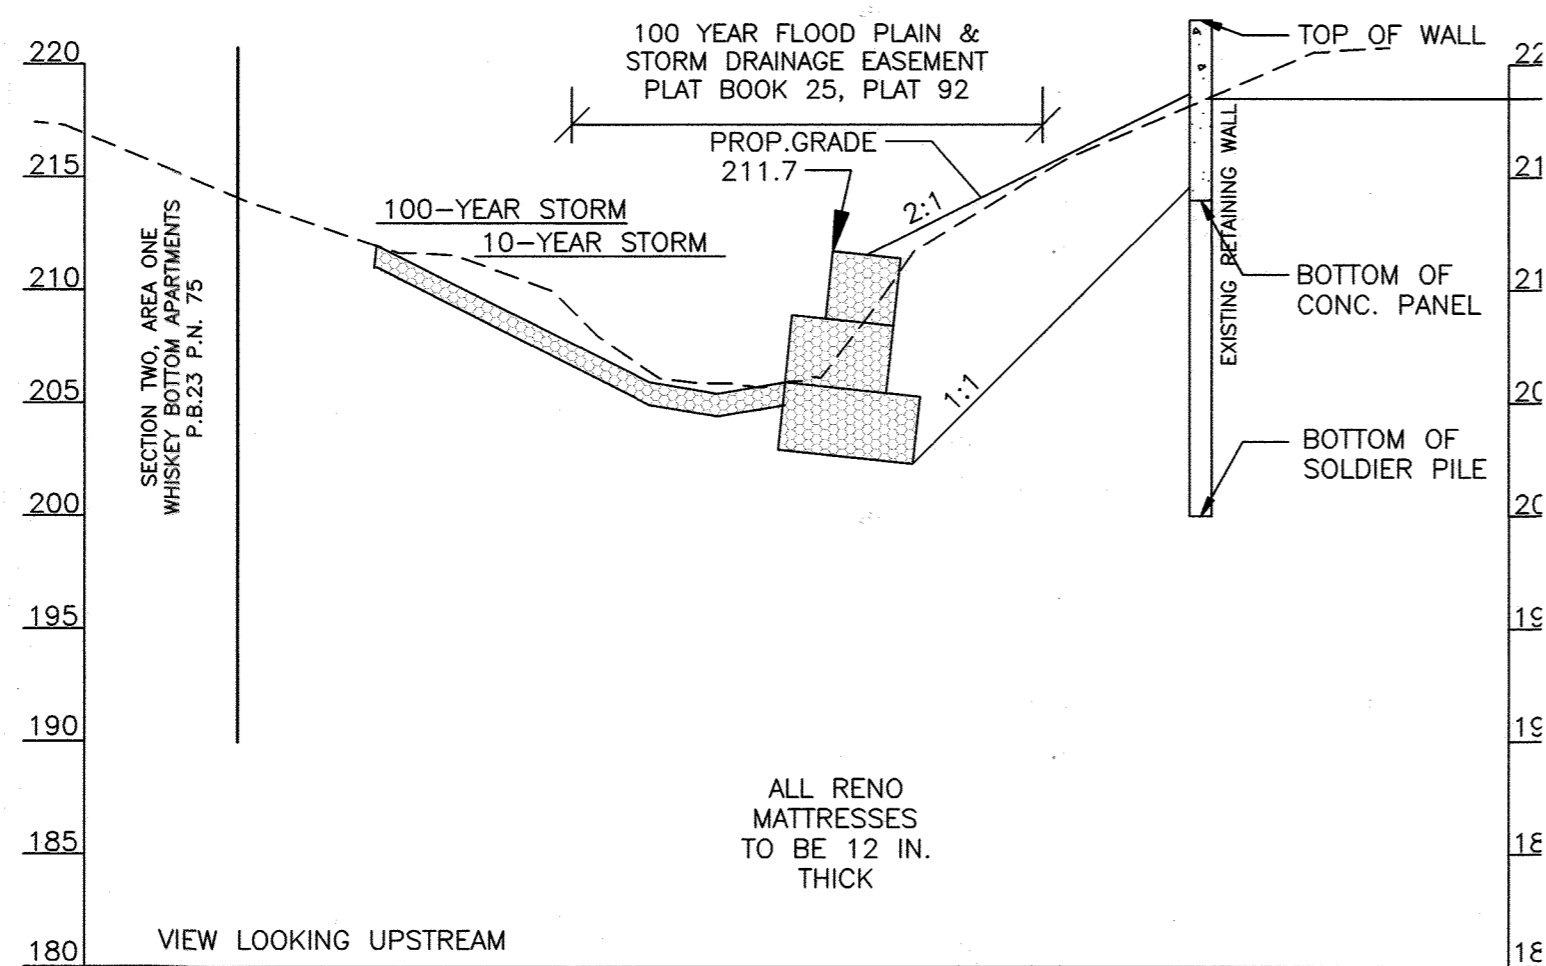

STREAM CROSS SECTION B3  
SCALE: 1" = 10' HORIZ.  
1" = 10' VERT.

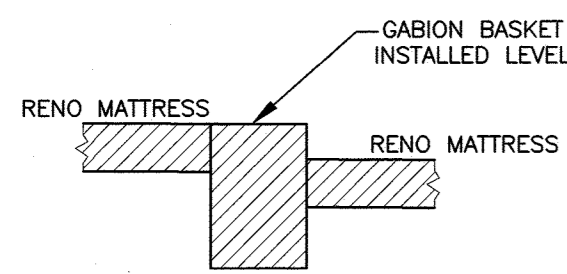

GRADE CONTROL STRUCTURE  
SCALE: 1" = 4'

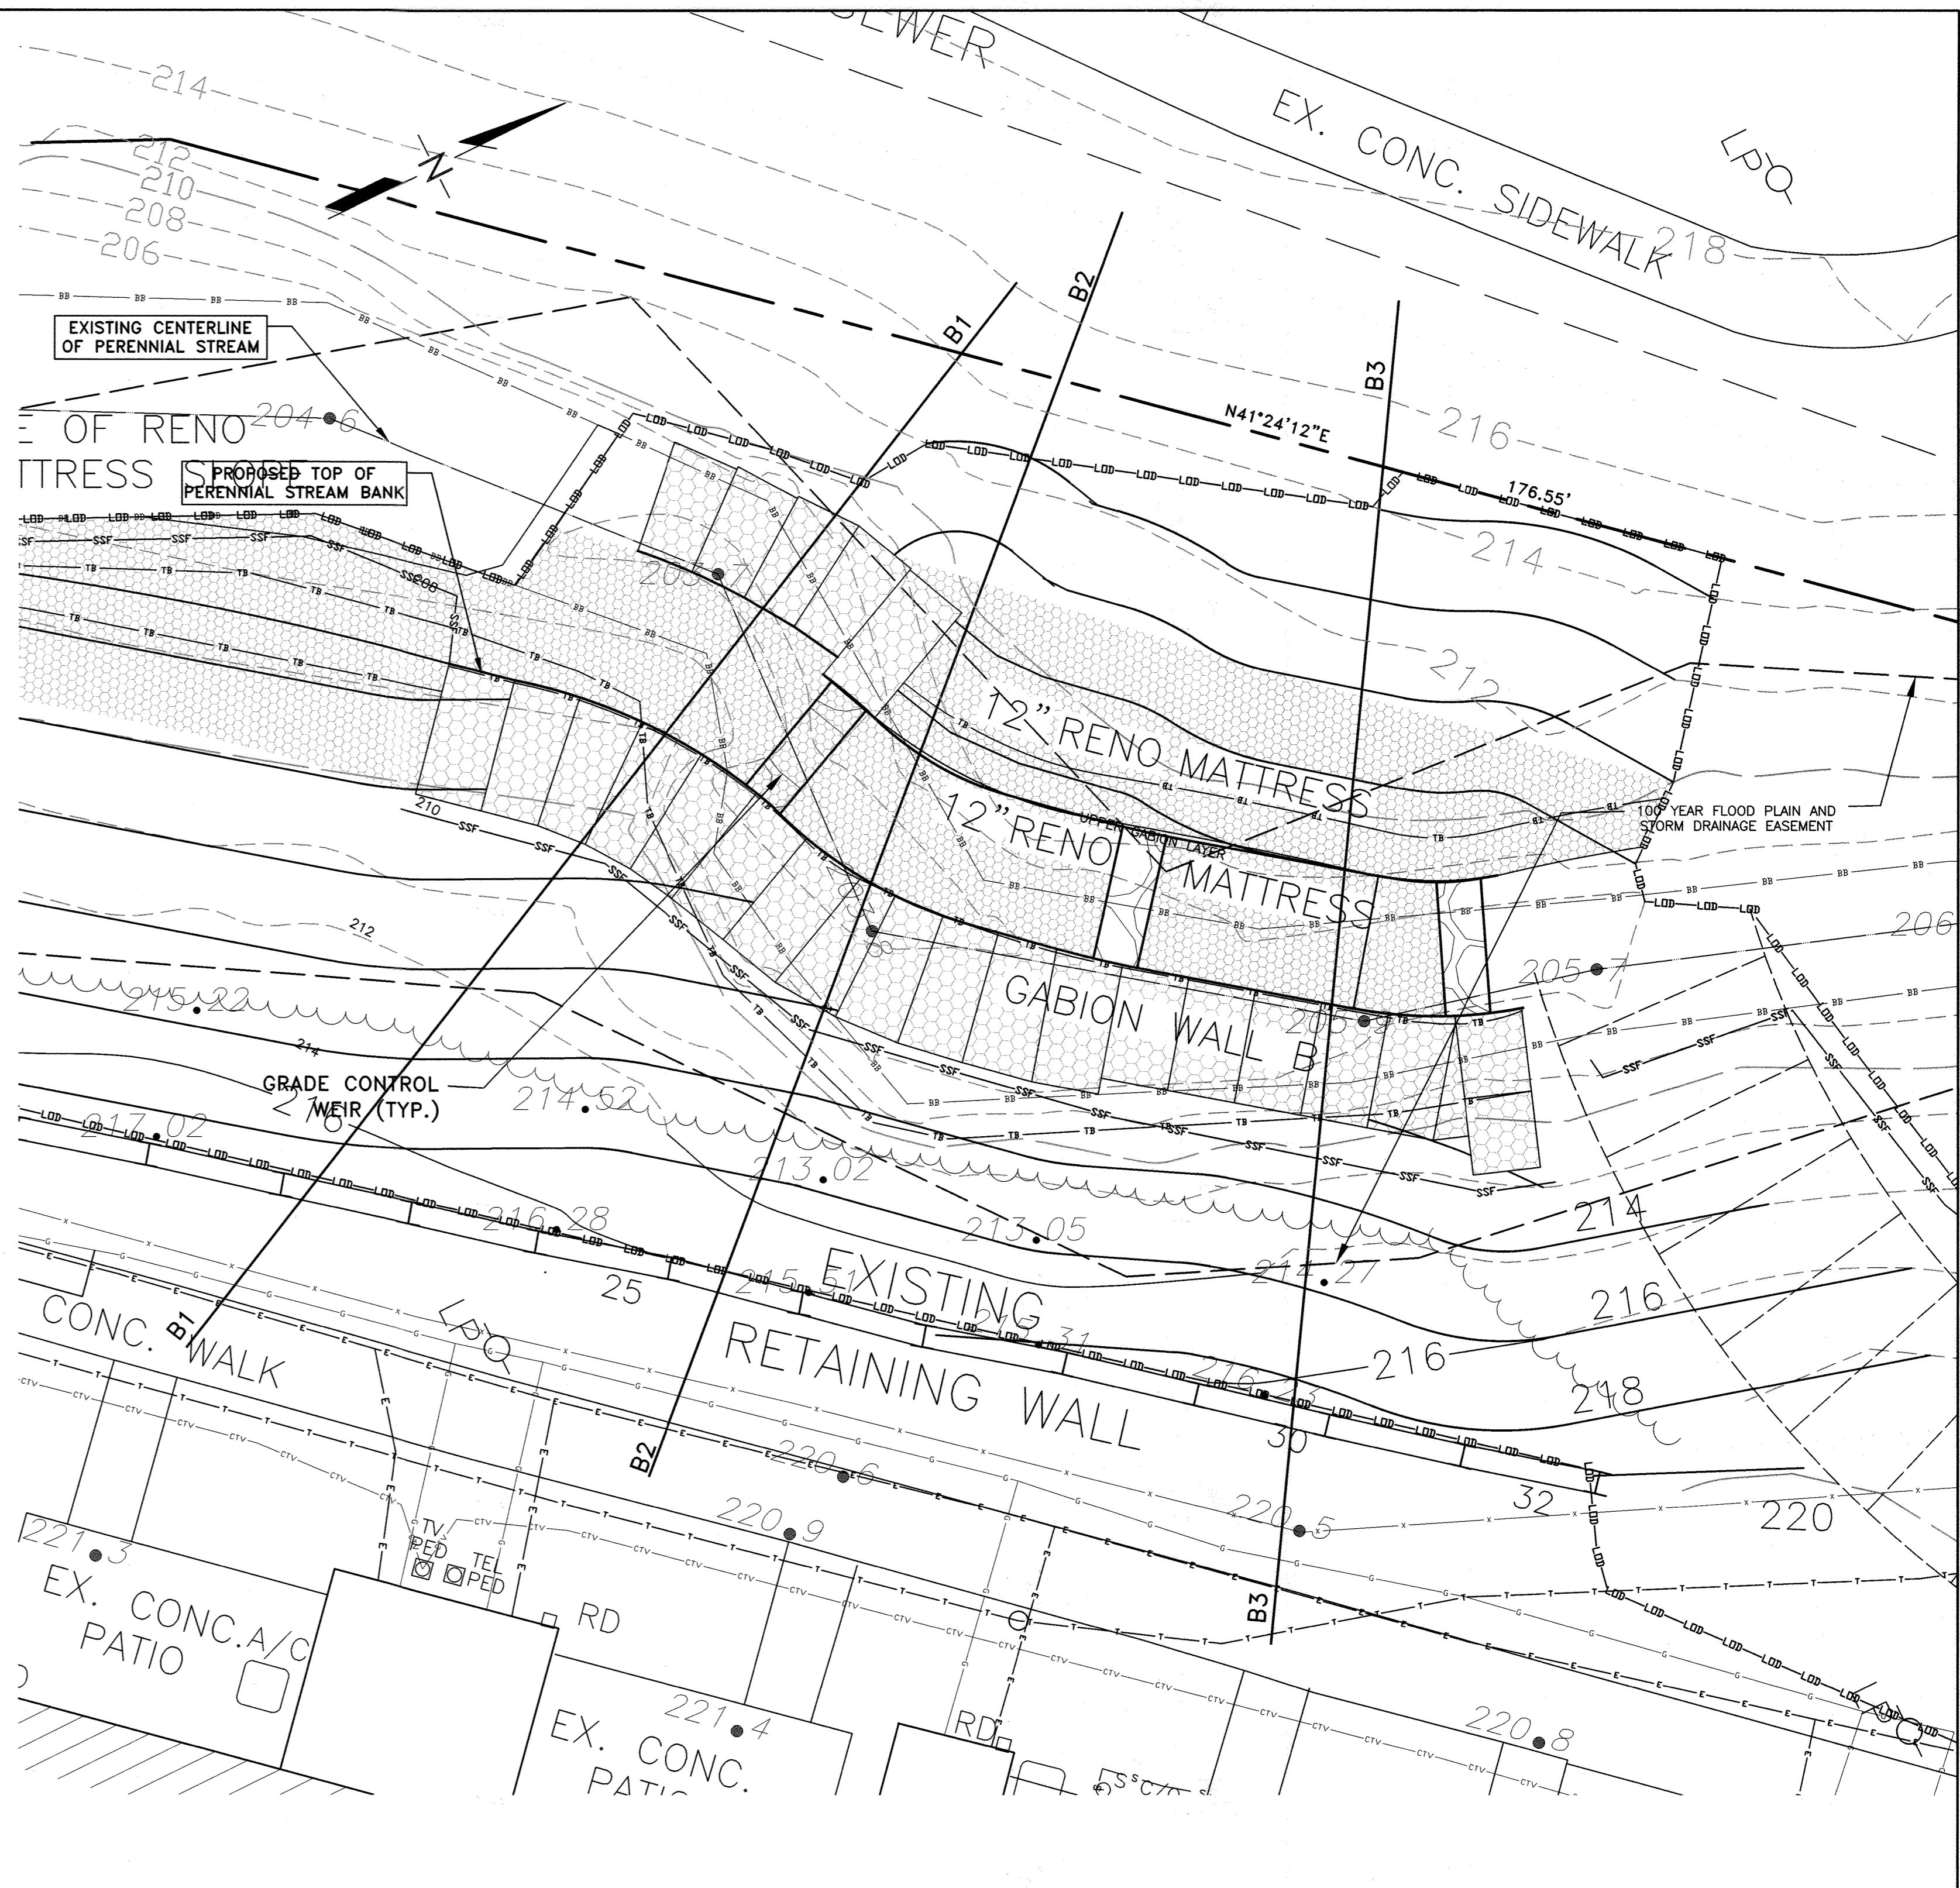

GABION WALL B DETAIL  
SCALE: 1" = 5'

NOT FOR CONSTRUCTION

ALL CROSS SECTIONS  
LOOKING DOWNSTREAM OR AS LABELED

HOWARD COUNTY DEPARTMENT OF PLANNING AND ZONING APPROVED	
CHIEF, LAND DEVELOPMENT	6/1/22
CHIEF, DEVELOPMENT ENGINEERING DIVISION	6/2/22
DIRECTOR OF PLANNING AND ZONING	6/22/22

LEGEND

- ⊙ SEWER MANHOLE
- ⊙ STORM DRAIN MANHOLE
- ⊙ WATER MANHOLE
- ⊙ WATER METER
- ⊙ FIRE HYDRANT
- ⊙ WATER VALVE
- ⊙ SPRINKLER
- ⊙ GAS VALVE
- ⊙ CABLE TV PEDESTAL
- ⊙ LIGHT POLE
- ⊙ POWER POLE
- ⊙ GUY WIRE
- ⊙ ROOF DRAIN
- ⊙ FLOOR DRAIN
- ⊙ IRON PIPE FOUND
- ⊙ REBAR W/ CAP FOUND

203.7 EX. SPOT GRADE

- PROPERTY LINE
- INDEX CONTOUR
- INTERMEDIATE CONTOUR
- TREELINE
- PERENNIAL STREAM
- 75' STREAM BANK BUFFER
- PROPOSED CONTOUR
- TOP OF BANK
- BOTTOM OF BANK
- OVERHEAD WIRE
- UNDERGROUND GAS
- UNDERGROUND TELECOMMUNICATION
- CTV — CTV — CTV UNDERGROUND CABLE TV
- E — E — E — E UNDERGROUND ELECTRIC
- WATER
- SEWER
- S — S — S — S — S SEWER HOUSE CONNECTION
- STORM DRAIN
- L — L — L — L — L PROPOSED LIMITS OF DISTURBANCE
- SF — SF — SF — SF — SF PROPOSED SILT FENCE
- SSF — SSF — SSF — SSF — SSF PROPOSED SUPER SILT FENCE

OWNER-DEVELOPER  
WHISKEY BOTTOM CONDOMINIUM, ASSOC.  
c/o MR. ARTHUR F. BLUME, PRESIDENT  
WHISKEY BOTTOM SOUTH, BOARD OF DIRECTORS  
9220 BRIDLE PATH LANE, UNIT F  
LAUREL, MD. 20723



**LANDMARK ENGINEERING, INC.**  
13722 LAMBERTINA PLACE  
ROCKVILLE, MARYLAND 20850  
PHONE: (301) 230-5881  
FAX: (301) 230-5884  
CONSULTING ENGINEERS PLANNERS SURVEYORS


SECTION TWO  
**WHISKEY BOTTOM APARTMENTS**  
SIXTH ELECTION DISTRICT, HOWARD COUNTY, MARYLAND

SITE DEVELOPMENT PLAN  
STREAM STABILIZATION  
GABION WALL B SECTIONS AND ELEVATIONS

REVISIONS

DRN: DCV	CK: CTG	DRAWING NO. S-17
PROJECT NO.: 1530	SCALE: AS SHOWN	OF 24
DATE: MAR. 28, 2022		

PROFESSIONAL CERTIFICATION  
I HEREBY CERTIFY THAT THESE DOCUMENTS WERE PREPARED OR APPROVED BY ME, AND THAT I AM A DAILY LICENSED PROFESSIONAL ENGINEER UNDER THE LAWS OF THE STATE OF MARYLAND, LICENSE NO. 11124, EXPIRATION DATE: OCTOBER 3, 2022.  
3/28/22  
STATE OF MARYLAND  
THOMAS M. [Signature]  
PROFESSIONAL ENGINEER

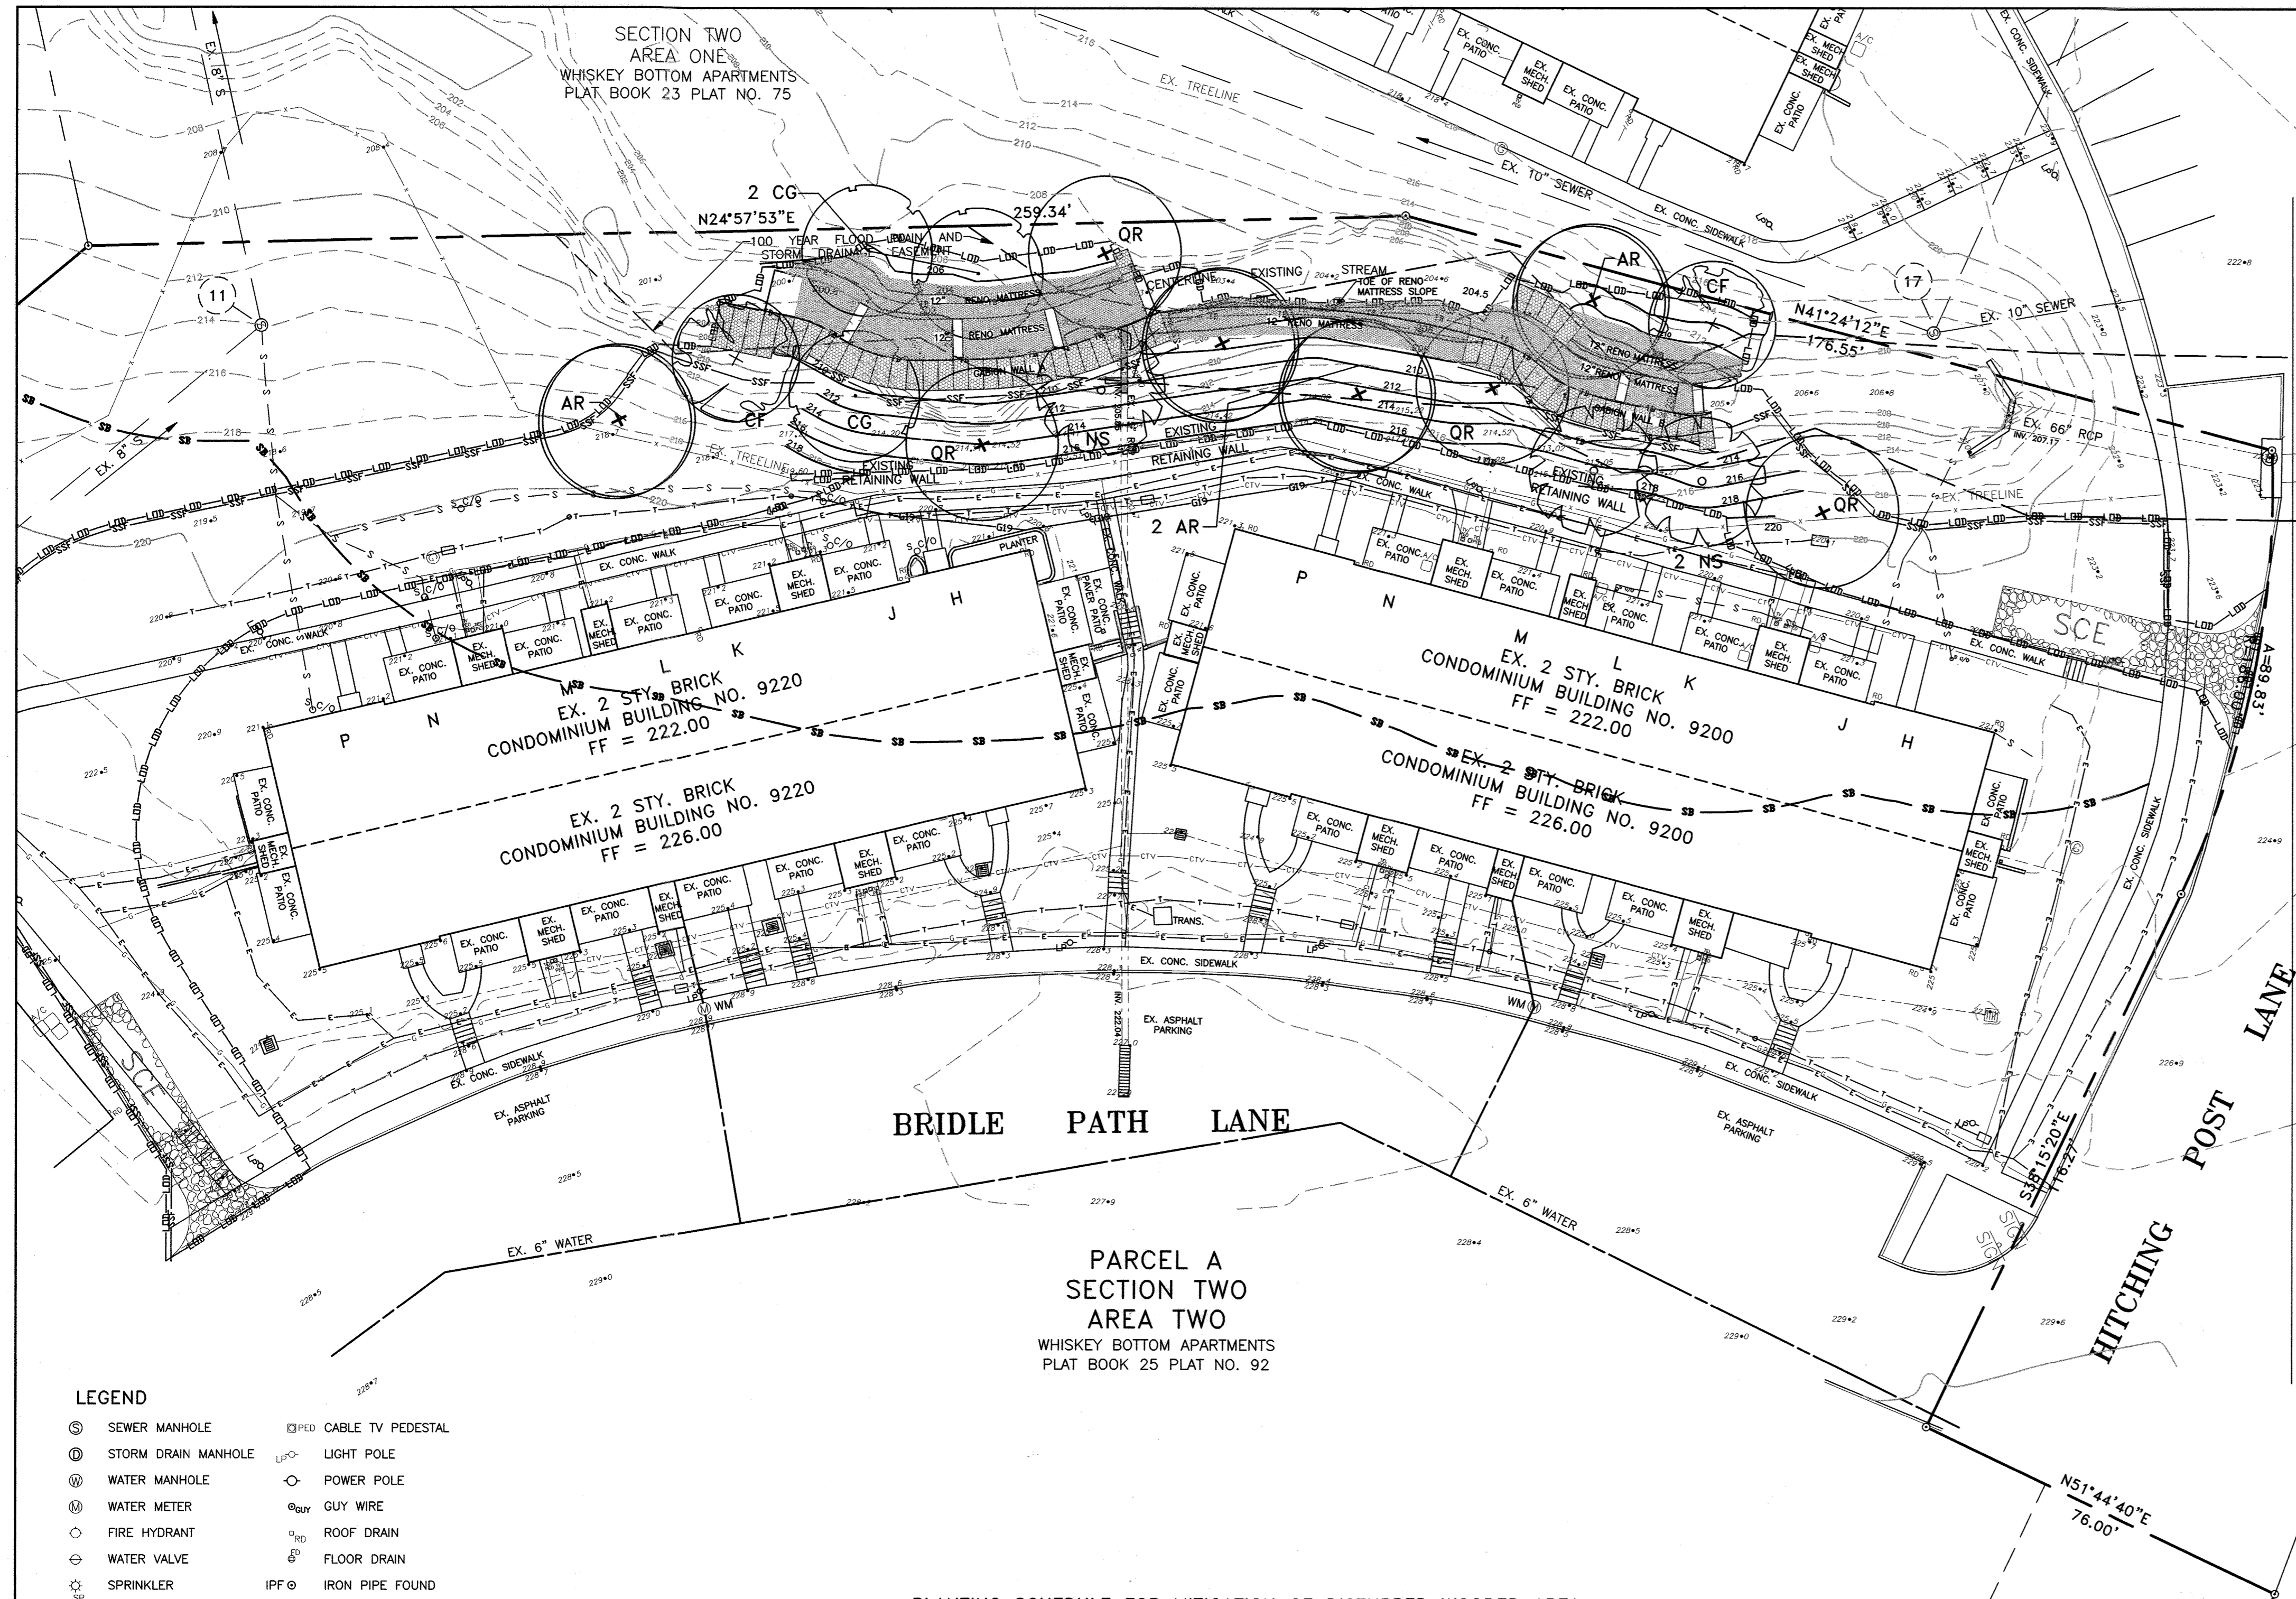

**FOREST CONSERVATION NOTES:**

This project involves streambed realignment necessary to maintain the structural safety of 28 units of single family attached housing. This stream restoration project is exempt from forest conservation requirements in accordance with Section 16.1202(b)(1)(xv) of the Howard County Code. As part of this work we are proposing tree planting at the normal reforestation planting level of 100 tree per acre.

**GENERAL NOTES:**

1. Site property is known as Section Two - Area Two, Whiskey Bottom Apartments recorded Plat Book 25 at Plat No. 92. Current Zoning: R-A-15
2. The purpose of this project is to remediate for shifts in the stream centerline which is endangering the stability of 28 units of single family attached dwellings. The project will stabilize stream bank erosion and assign global stability with respect to the nearby buildings. The total disturbed area is 17,490 sq. ft.
3. The site lies within the Patuxent River Watershed which is Maryland Class Use I with no in-stream construction permitted from March 1 to June 15, inclusive.
4. Topographic information from survey conducted in the field August and September, 2015 by Landmark Engineering, Inc. Horizontal Data per Plat No. 92. Vertical Datum per previous approved Site & Grading Plan. Field work in 2019 documented further streambank erosion. The as-built location of the retaining wall was done by field survey in July 2020.
5. The property is not located within a FEMA mapped 100-year floodplain as determined in review of Howard County, Maryland Community Panel No. 24027002300 with effective date of November 6, 2013. The drainage area to the work area is 83.25 ac. The existing floodplain easement was established by record plat Section Two, Area Two Whiskey Bottom Apartments, Plat Book 25, Plat No. 92.
6. Gabion design to be per plan by the geotechnical engineer, Professional Consulting Corporation. The proposed wall to be gravity wall constructed under guidance of the geotechnical engineer.
7. The location of underground and above ground utilities as shown on this plan were field marked and survey located. This does not relieve the contractor for requirements to have utilities marked by Miss Utility. Any conflicts to be coordinated with the utility companies.
8. During preliminary investigations cameras were used to examine the conditions of the existing pipes. It was determined that the 15" RCP had a joint offset very close to the existing retaining wall. This pipe will get repaired and extended as part of this construction.
9. This stream restoration project is exempt from forest conservation requirements in accordance with Section 16.1202(b)(1)(xv) of the Howard County Code.
10. The Maryland Department of the Environment issued an Authorization to Proceed for this project on August 5, 2019, Authorization Number 201961118/19-NT-3160. A modification of this Authorization as approved by this site plan revision will be obtained prior to final Sediment Control Permit Issuance.
11. Alternative Compliance WP-21-121 for this project was approved under Section 16.116.0.2.ii and Section 16.115.0 of the County Code by the The Director of the Department of Planning and Zoning, Director of Public Works and Administrator of the Office of Community Sustainability on May 21, 2021. The approval is conditioned on the following items:
  - a. All disturbed areas within the stream, stream bank buffer and 100-year floodplain shall be stabilized, seeded and/or planted after construction is complete. The disturbed areas within the stream buffer shall be replanted at a rate of at least 100 trees per acre.
  - b. The applicant shall obtain all required authorizations and permits from the Maryland Department of the Environment (MDE) and the U.S. Army Corps of Engineers for disturbances within the stream and floodplain. The applicant shall coordinate with MDE to revise the existing authorization (201961118/19-NT-3160) to be consistent with the stream bank and floodplain impacts as shown on SDP-72-084.

**SEQUENCE OF EVENTS**

Reforestation Sequence of Events

1. An on-site pre-construction meeting is required after the limits of disturbance have been staked and flagged, but before any clearing or grading begins. An ISA certified arborist or Maryland-licensed tree expert that will implement the tree protection measures should also attend this pre-construction meeting.
2. No clearing or grading shall begin before stress-reduction measures have been implemented. Appropriate measures may include, but are not limited to Root pruning, Crown reduction or pruning, Watering, fertilizing, Vertical mulching, Root aeration matting
3. A Maryland-licensed tree expert or an ISA certified arborist must perform all stress reduction measures. The tree expert or arborist will determine the exact method to convey the stress reductions measures during the pre-construction meeting.
4. Temporary tree protection devices shall be installed per the Forest Conservation Plan/Tree Save Plan and prior to any construction activities. Tree protection fencing locations should be staked prior to the pre-construction meeting. The tree expert or arborist may make field adjustments to increase the survivability of trees and forest shown as saved on the approved plan. Temporary tree protect devices may include chain link fence (four feet high), super silt fence with wire strung between support poles with high visibility flagging, 14 gauge 2 inch x 4 inch welded wire fencing supported by steel T-bar posts with high visibility flagging.

**LEGEND**


⊙	SEWER MANHOLE	⊙	CABLE TV PEDESTAL
⊙	STORM DRAIN MANHOLE	⊙	LIGHT POLE
⊙	WATER MANHOLE	⊙	POWER POLE
⊙	WATER METER	⊙	GUY WIRE
⊙	FIRE HYDRANT	⊙	ROOF DRAIN
⊙	WATER VALVE	⊙	FLOOR DRAIN
⊙	SPRINKLER	⊙	IRON PIPE FOUND
⊙	GAS VALVE	⊙	REBAR W/ CAP FOUND
•	EX. SPOT GRADE		

—DH—	OVERHEAD WIRE	▨	DISTURBED WOODED AREA
—G—	UNDERGROUND GAS	⊙	SOIL STABILIZATION MATTING
—T—	UNDERGROUND TELECOMMUNICATION		
—CTV—	UNDERGROUND CABLE TV		
—E—	UNDERGROUND ELECTRIC		
—S—	SEWER		
—SS—	SEWER HOUSE CONNECTION		
—SD—	STORM DRAIN		
—IC—	INDEX CONTOUR		
—IC—	INTERMEDIATE CONTOUR		
—S—	STREAM		
—SB—	75' STREAM BANK BUFFER		
—LDB—	PROPOSED LIMITS OF DISTURBANCE		
—SF—	PROPOSED SILT FENCE		
—SSF—	PROPOSED SUPER SILT FENCE		

**PLANTING SCHEDULE FOR MITIGATION OF DISTURBED WOODED AREA**  
 PLANTING OF 16 TREES PROPOSED AT 100 TREES PER ACRE BASED ON IMPACT TO EXISTING FOREST OF 7,017 SQ. FT. OR 0.16 AC.

Symbol	Quantity	Botanical Name	Common Name	Size	Cond.	Comments
AR	4	Acer rubrum	October Glory Red Maple	2-1/2" cal.	B & B	
QR	4	Quercus alba	White Oak	2-1/2" cal.	B & B	
CG	3	Carya glabra	Pignut Hickory	2-1/2" cal.	B & B	
NS	3	Nyssa sylvatica	Black Gum	2-1/2" cal.	B & B	
CF	2	Cornus florida	Flowering Dogwood	2-1/2" cal.	B & B	

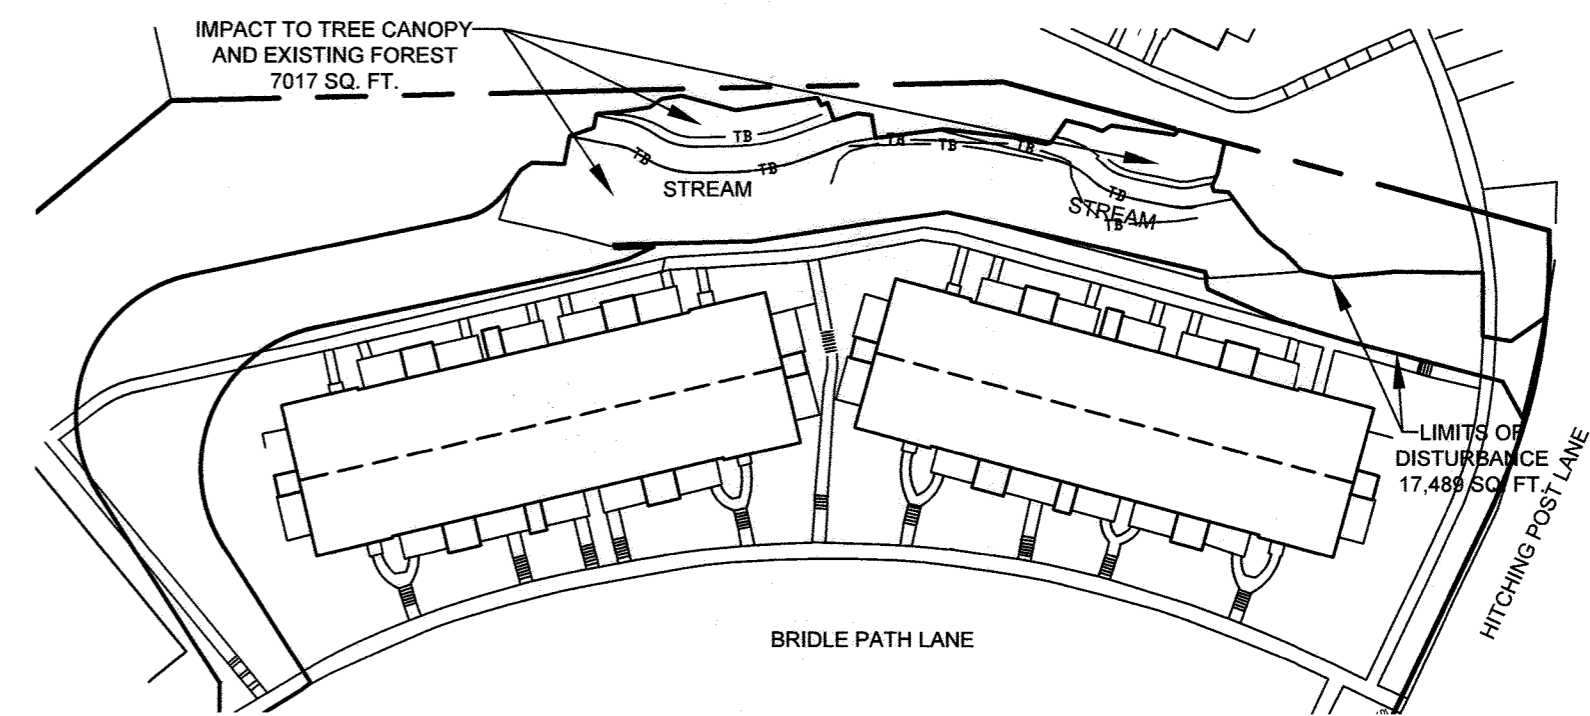

**PROFESSIONAL CERTIFICATION**  
 I HEREBY CERTIFY THAT THESE DOCUMENTS WERE PREPARED OR APPROVED BY ME, AND THAT I AM A DULY LICENSED PROFESSIONAL ENGINEER UNDER THE LAWS OF THE STATE OF MARYLAND, LICENSE NO. 11124, EXPIRATION DATE: OCTOBER 3, 2022.  
 3/28/22  
 [Signature]  
 PROFESSIONAL ENGINEER

All areas within the Limits of Disturbance shall be stabilized, seeded and/or planted after construction is complete.

HOWARD COUNTY DEPARTMENT OF PLANNING AND ZONING APPROVED  
 CHIEF, LAND DEVELOPMENT 6/22/22 DATE  
 CHIEF, DEVELOPMENT ENGINEERING DIVISION 6-9-22 DATE  
 DIRECTOR OF PLANNING AND ZONING 6/22/22 DATE

OWNER-DEVELOPER  
 WHISKEY BOTTOM CONDOMINIUMS, ASSOC.  
 c/o MR. ARTHUR F. BLUME, PRESIDENT  
 WHISKEY BOTTOM SOUTH, BOARD OF DIRECTORS  
 9220 BRIDLE PATH LANE, UNIT F  
 LAUREL, MD. 20723

**LANDMARK ENGINEERING, INC.**  
 13722 LAMBERTINA PLACE  
 ROCKVILLE, MARYLAND 20850  
 CONSULTING ENGINEERS PLANNERS SURVEYORS  
 PHONE: (301) 230-5881  
 FAX: (301) 230-5884

**SECTION TWO**  
**WHISKEY BOTTOM APARTMENTS**  
 SIXTH ELECTION DISTRICT, HOWARD COUNTY, MARYLAND

**SITE DEVELOPMENT PLAN**  
**STREAM RESTORATION & PLANTING PLAN**

REVISIONS	DRN: DCV CK: CTG	DRAWING NO. S-18 OF 24
	PROJECT NO.: 1530	
	SCALE: AS SHOWN	
	DATE: MAR. 28, 2022	

Reforestation Sequence of Events

1. An on-site pre-construction meeting is required after the limits of disturbance have been staked and flagged, but before any clearing or grading begins. The Howard County Construction Inspection Division staff shall be at the Erosion and Sediment Control preconstruction meeting to discuss tree care measures. An ISA certified arborist or Maryland-licensed tree expert that will implement the tree protection measures should also attend this pre-construction meeting.

2. No clearing or grading shall begin before stress-reduction measures have been implemented. Appropriate measures may include, but are not limited to Root pruning, Crown reduction or pruning, Watering, fertilizing, Vertical mulching, Root aeration matting

Measures not specified on this plan may be required by the arborist.

3. A Maryland-licensed tree expert or an International Society of Arboriculture-certified arborist must perform all stress reduction measures. Documentation of stress reduction measures must be either observed by the arborist. The arborist will determine the exact method to convey the stress reductions measures during the pre-construction meeting.

4. Temporary tree protection devices shall be installed per the Forest Conservation Plan/Tree Save Plan and prior to any construction activities. Tree protection fencing locations should be staked prior to the pre-construction meeting. The arborist, in coordination with the Construction Inspection Division sediment control inspector, may make field adjustments to increase the survivability of trees and forest shown as saved on the approved plan.

Temporary tree protect devices may include chain link fence (four feet high), super silt fence with wire strung between support poles (minimum 4 feet high) with high visibility flagging, or 14 gauge 2 inch x 4 inch welded wire fencing supported by steel T-bar posts (minimum 4 feet high) with high visibility flagging.

5. Temporary protection devices shall be maintained and installed by the contractor for the duration of construction project and must not be altered without prior approval from the forest conservation inspector. No equipment, trucks, materials, or debris may be stored within the tree protection fence areas during the entire construction project. No vehicle or equipment access to the fenced area will be permitted. Tree protection shall not be removed without prior approval of the arborist.

6. Forest retention area signs shall be installed as required, or as shown on the approved plan.

7. Long-term protection devices will be installed per the Forest Conservation Plan/Tree Save Plan and attached details. Installation will occur at the appropriate time during the construction project. Refer to the plan drawing for long-term protection measures to be installed.

During Construction

8. Periodic inspections by the arborist will occur during the construction project. Corrections and repairs to all tree protection devices, as determined by the arborist, must be made within the timeframe established by the arborist.

Post-Construction

9. After construction is completed, an inspection shall be requested. Corrective measures may include:

- a. Removal and replacement of dead and dying trees
- b. Pruning of dead or declining limbs
- c. Soil aeration
- d. Fertilization
- e. Watering
- f. Wound repair
- g. Clean up of retention areas

10. After inspection and completion of corrective measures have been undertaken, all temporary protection devices shall be removed from the site. Removal of tree protection devices that also operate for erosion and sediment control must be coordinated with the Construction Inspection Division. No additional grading, sodding, or burial may take place after the tree protection fencing is removed.

SITE PREPARATION FOR PLANTING

Disturbed Areas

Soils should be treated by incorporating natural mulch within the top 12 inches or by amendments as determined by a soils analysis. Soil amendments, by definition, include modifications of soils to improve such structural characteristics as bulk density or porosity. On development sites, the common use of fill materials may increase the need for such amendments. Natural amendments such as organic mulch or leaf mold compost are preferred. When fill material is used at the planting site, it should be clean fill topped with 12 inches of native soil. Stockpiling of native top soils must be done in such way that the height of the pile does not damage the seed bank.

Planting period

Planting windows for 2 inch container grown stock is January 1 through June 15 and October 15 through December 31. Planting in the summer months is discouraged to improve the survivability of the planting stock.

Plant Material Storage

Planting should occur within 24 hours of delivery to the site. Plant materials left unplanted for more than 24 hours should be protected from direct sun and weather and kept moist. Bare root stock unplanted for more than 24 hours should be heeled in as shown in Exhibit H-2. Nursery stock should be planted within 2 weeks. On-site or local transplanted materials should be stored in tree banks if unplanted for more than 24 hours, following the example in Exhibit H-3. Planting stock should be inspected prior to planting. Plants not conforming to standard nurseryman specifications for size, form, vigor, roots, trunk wounds, insects and disease should be replaced.

PLANT MATERIAL SIZE AND DENSITY

Plant Size

Nursery grown plant materials greater than 1" caliper should meet or exceed the requirements of American Association of Nurserymen specifications, i.e. should be typical of the species and variety, have a normal habit of growth, be first quality, sound, vigorous, well-branched, have healthy, well furnished root systems, and be free of disease, insect pests and mechanical injuries.

The spacings identified above are not meant to imply that trees must be planted in a grid pattern. A more natural appearance is desired.

Container Grown Stock

Successful planting of container grown stock requires careful site preparation and inspection of the plant material root system. Caution when using plants grown in a soil medium differing from the soil on the planting site. The plant should be removed from the container and the roots gently loosened from the soil. If the roots encircle the root ball, substitution is strongly recommended. J-shaped or kinked root systems should also be noted, and the plants replaced if necessary. Roots may not be trimmed on-site, due to the increased chances of soil borne diseases. (See Exhibit H-7.) Balled and Burlapped Trees

Balled and burlapped trees greater than 2" caliper and usually planted using tree spades. This technique is particularly when suited for transplanting On-site or with local plant materials. For trees larger than 6" caliper, specialized equipment is recommended. Balled and burlapped trees must be handled with care while planting. Trees should not be picked up by the trunk or dropped; both these practices may separate the trunk from the root ball. priority planting, root balls should be kept moist. (See Exhibit H-7.)

Planting fields

The planting field should be prepared and native stockpiled soils should be used to backfill the planting field. Rake Soils evenly over the planting field and cover with 2 to 4 inches of mulch. Use watering to settle soil backfilled around trees. Amendments are not recommended in the planting field; studies have shown that roots will be encouraged to stay within the amended soils. Staking of larger trees is not recommended except in areas of high winds. Staking may be used for trees larger than 8 feet in height. Movement is necessary to strengthen the trunk of the planted tree. When stakes are used, the post-construction period management plan should specify their removal after the first growing season (See Exhibit H-8).

GENERAL GUIDANCE FOR MAINTENANCE OF PLANTED AREAS

Watering

A watering plan should only be implemented to compensate for deficient rainfall patterns. Trees can die from too much water as well as too little. Newly planted trees may need water as much as once a week for the entire first growing season. The next two years, in contrast, may require watering only a few times a year (one a month during July and August). After that, trees should only need water in severe droughts. Bare root transplants, if sufficiently watered during planting, may not need water for almost 2-4 weeks after growth begins. Balled and burlap material may require more frequent watering.

Soil and Watering: Soil texture influences the downward flow of water. Soils with more clay tend to retain more water and can be watered less often; soils with more sand drain more quickly and need to be watered more often. For examples of on-site evaluation recommendations. If the soil was well prepared before planting, there should be few drainage problems. Restricted downward penetration indicates the soil may have been compacted during construction and not aerated before planting, or there may be a clay hardpan.

How to Water. The best way to water is deeply and slowly using a regular hose, a soaker hose, or drip irrigation. For larger trees, start by watering the root ball thoroughly. The watered area shall be enlarged to include the whole root zone as the tree becomes more established. Mulching around the base of newly transplanted trees prevents roots from drying too quickly while still providing air movement to the roots.

Fertilizing

Fertilizing is the chemical modification of soils to correct for a specific nutrient deficiency. These deficiencies are most effectively identified in a laboratory soils analysis. Nothing should be added to the soil without first testing to determine any nutrient needs.

What Nutrients to Apply: Trees depend on three major nutrients, nitrogen, phosphorus, and potassium and a host of other minor ones (or micronutrients) such as calcium. When to Fertilize: Even when soils are deficient in nitrogen, fertilizing within the first growing season after planting is not recommended. Too much nitrogen may cause a spurt of canopy growth which the roots cannot support. It is, therefore, best to wait until after the end of the first growing season, either in the late fall or early spring. What Type of Fertilizer: Organic fertilizers are preferred to synthetic fertilizers. Bone meal or seaweed based products are available commercially. Organic fertilizers have a slow release effect that can supply nutrients to the plant as needed while minimizing the risk of excess nutrients entering the forest system and the water supply. Some synthetic fertilizers can mimic this slow-release action and may be appropriate for use.

Control of Competing Vegetation


Unfortunately, good sites for reforestation and afforestation are generally good sites for unwanted vegetation as well. Unwanted vegetation growing near newly planted trees can take over the site. The need to control this problem depends on the ability of the planted material to withstand the intrusion. Smaller trees may need more care, although some seedlings survive with the overgrowth and will shade it out as the trees grow. As a preventative measure, consider the potential for growth of invasive species while choosing a reforestation or afforestation area. Mulch is one of the best weed deterrents. Spread a 2" to 4" layer of mulch over the root area of the newly planted trees avoiding direct contact with the trunk, a prime spot for fungal growth. (Mulch also helps maintain the soil moisture level and may provide a buffer for any equipment such as mowers that may be used to maintain the area.) Mulching and manual control of competing vegetation is more compatible with the long term forest health than the use of herbicides.

Protection: Pests, Diseases and Mechanical Injury.


Integrated Pest Management (IPM) is one of the most effective and safest approaches for maintaining a healthy forest. IPM basics include proper species selection for the site, good pruning, mulching and fertilizing practices, regular monitoring, and proper timing of necessary sprays. Good cultural practices will minimize the amount of spraying. Professional IPM programs have reduced pesticide use by 90%. Some aspects of a full IPM program include:

- 1) Elimination of some low vegetation before planting to help control the rodent population which thrives in brushy environments.
- 2) Use of tree shelters to protect the trunks of seedlings or whips from animal damage. The shelters act as mini-greenhouses to speed growth. (These trees need more water than those planted without tree shelters, however.)
- 3) Mulching around the trees to minimize trunk damage from mowers. Wounds provide an entry way for pests.
- 4) Pruning dead and diseased branches with a clean cut to prevent establishment or spreading of disease.

Sun scald is a problem for thin barked young trees. Tree wrap was commonly used to protect trees from sun scald but is no longer recommended due to the increased opportunities for insect infestation and disease. An alternative to wrapping is to allow small non-competitive branches, commonly pruned during or before planting, to grow on the sunny side of the trunk to help shade the trunk.

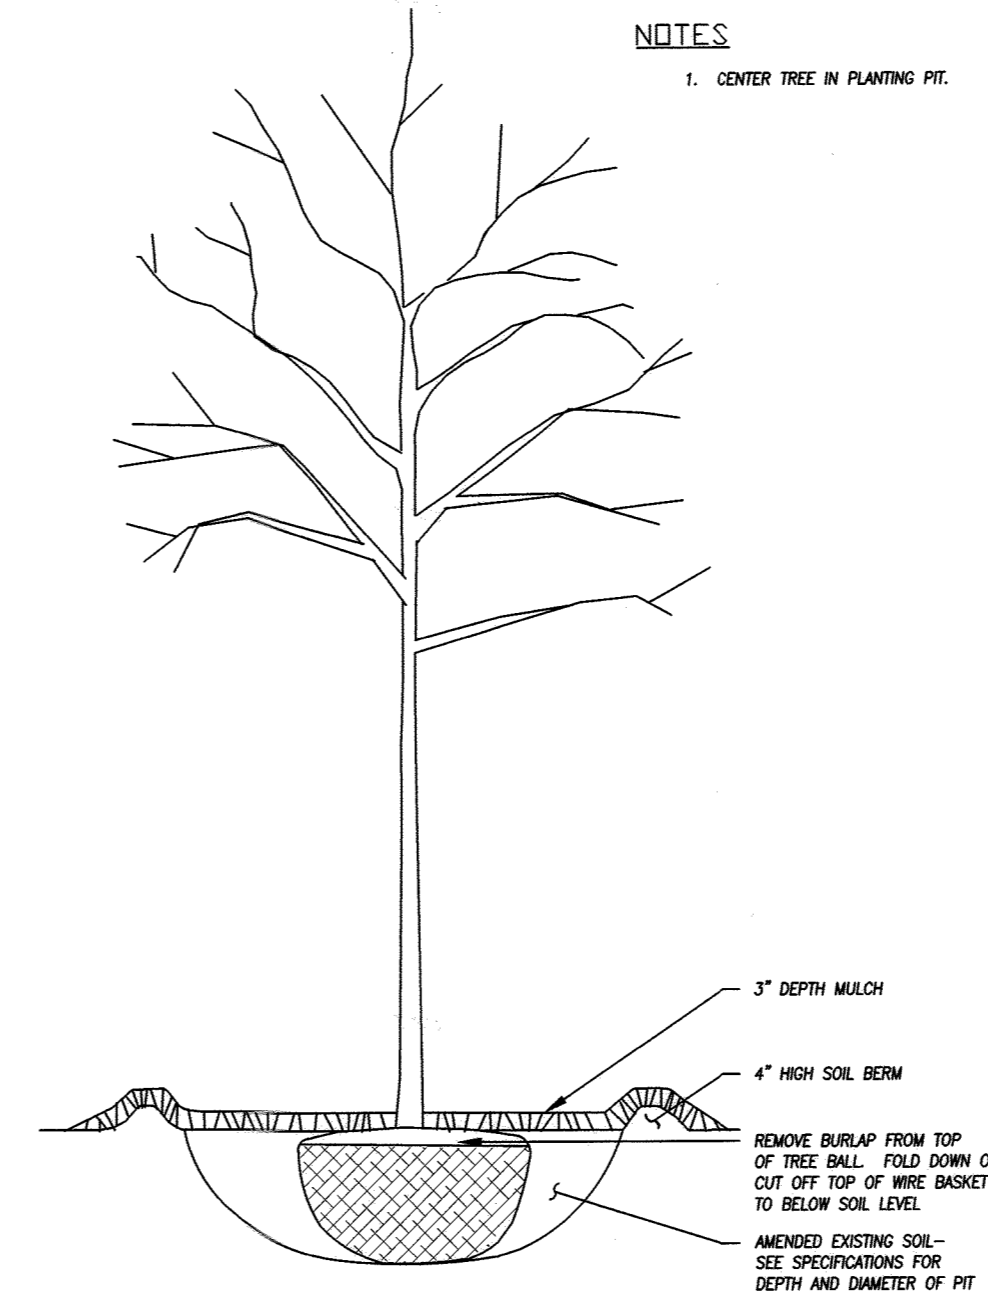

PLANTING SHADE TREES  
2 1/2" CALIPER TO 3 1/2" CALIPER

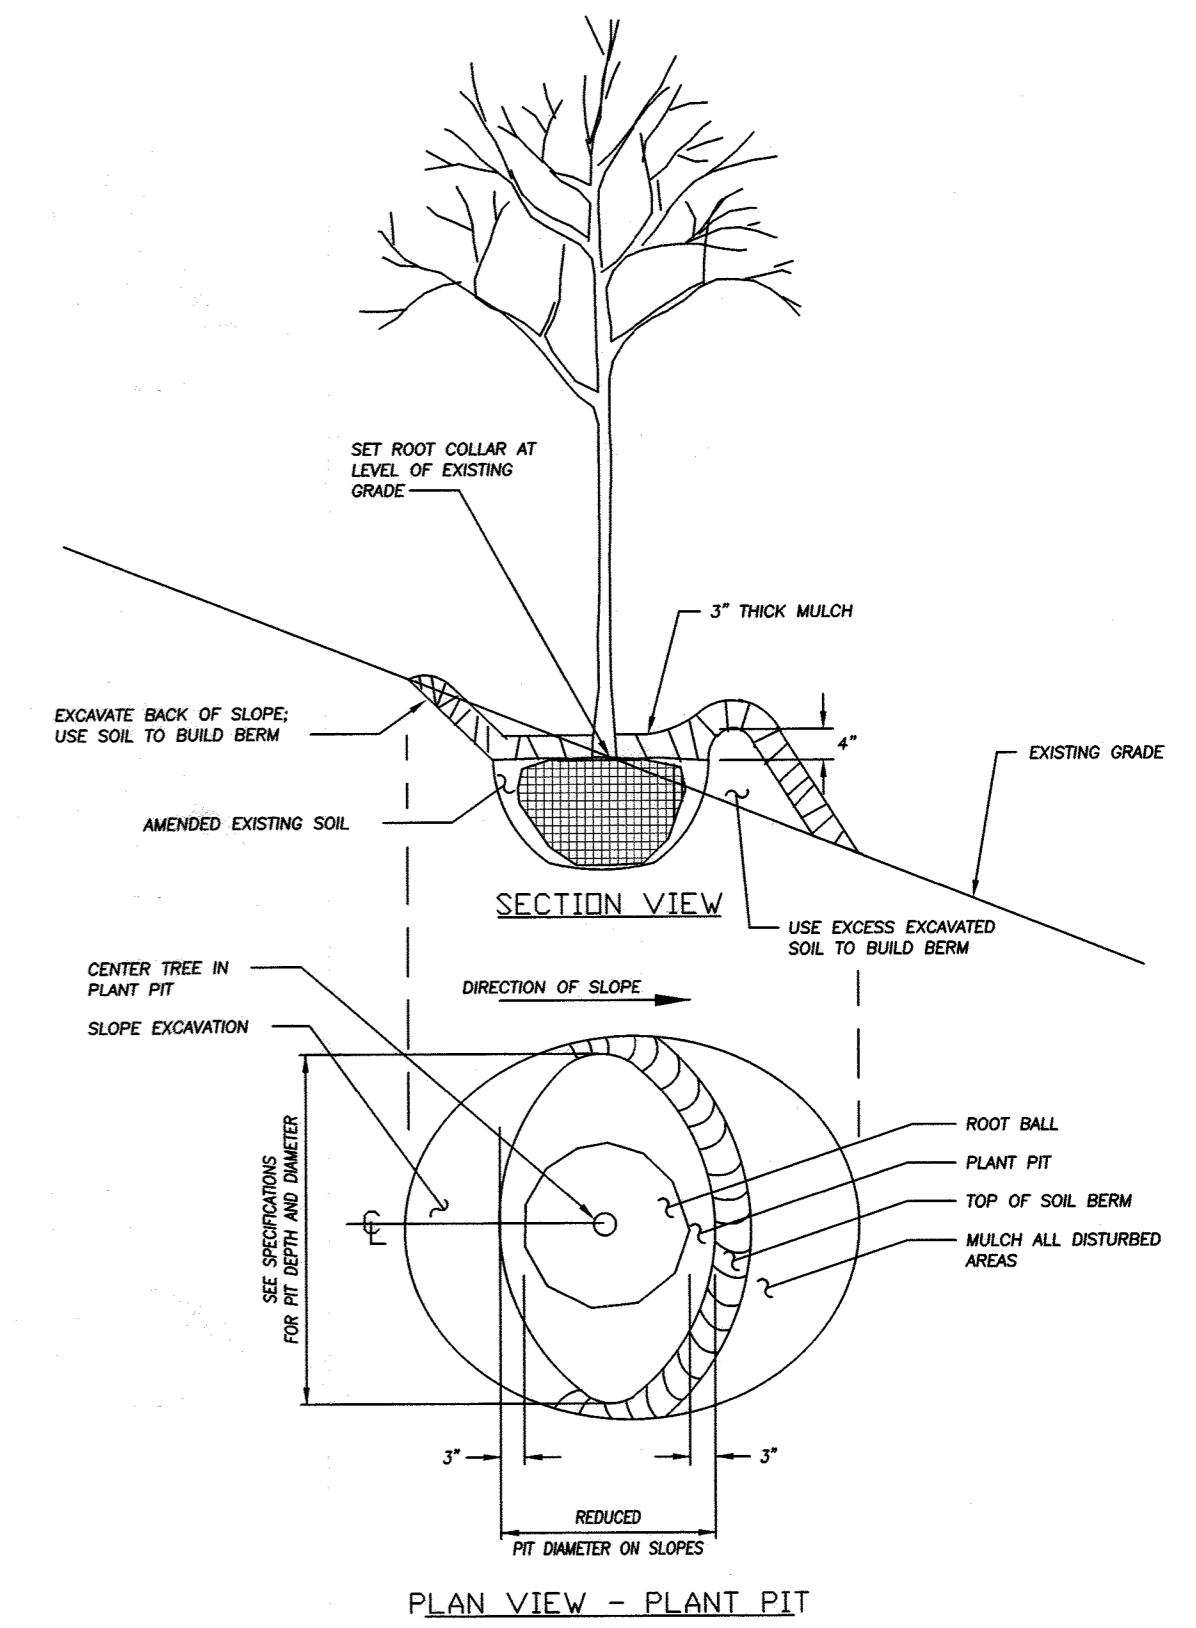

PLANTING TREES ON SLOPES  
FROM 3:1 TO 2:1

NOTES  
1. CENTER TREE IN PLANTING PIT.

HOWARD COUNTY DEPARTMENT OF PLANNING AND ZONING APPROVED	
<i>[Signature]</i> CHIEF, LAND DEVELOPMENT	6/21/22 DATE
<i>[Signature]</i> CHIEF, DEVELOPMENT ENGINEERING DIVISION	6/22/22 DATE
<i>[Signature]</i> DIRECTOR OF PLANNING AND ZONING	6/22/22 DATE


OWNER-DEVELOPER  
WHISKEY BOTTOM CONDOMINIUMS, ASSOC.  
c/o MR. ARTHUR F. BLUME, PRESIDENT  
WHISKEY BOTTOM SOUTH, BOARD OF DIRECTORS  
9220 BRIDLE PATH LANE, UNIT F  
LAUREL, MD. 20723

**LANDMARK ENGINEERING, INC.**  
13722 LAMBERTINA PLACE PHONE: (301) 230-5881  
ROCKVILLE, MARYLAND 20850 FAX: (301) 230-5884  
CONSULTING ENGINEERS PLANNERS SURVEYORS


SECTION TWO  
**WHISKEY BOTTOM APARTMENTS**  
SIXTH ELECTION DISTRICT, HOWARD COUNTY, MARYLAND

SITE DEVELOPMENT PLAN  
STREAM RESTORATION  
PLANTING NOTES

REVISIONS	DRN: DCV CK: CTG	DRAWING NO. S-19 OF 24
	PROJECT NO.: 1530	
	SCALE: AS SHOWN DATE: MAR. 28, 2022	

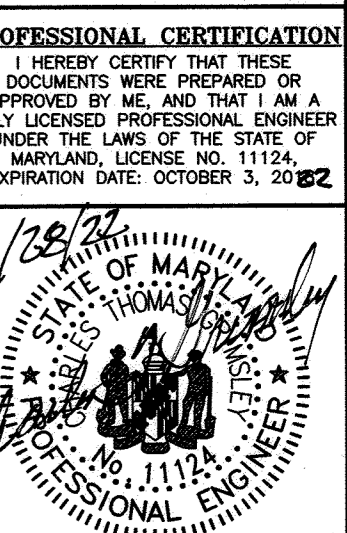

All areas within the Limits of Disturbance shall be stabilized, seeded and/or planted after construction is complete.

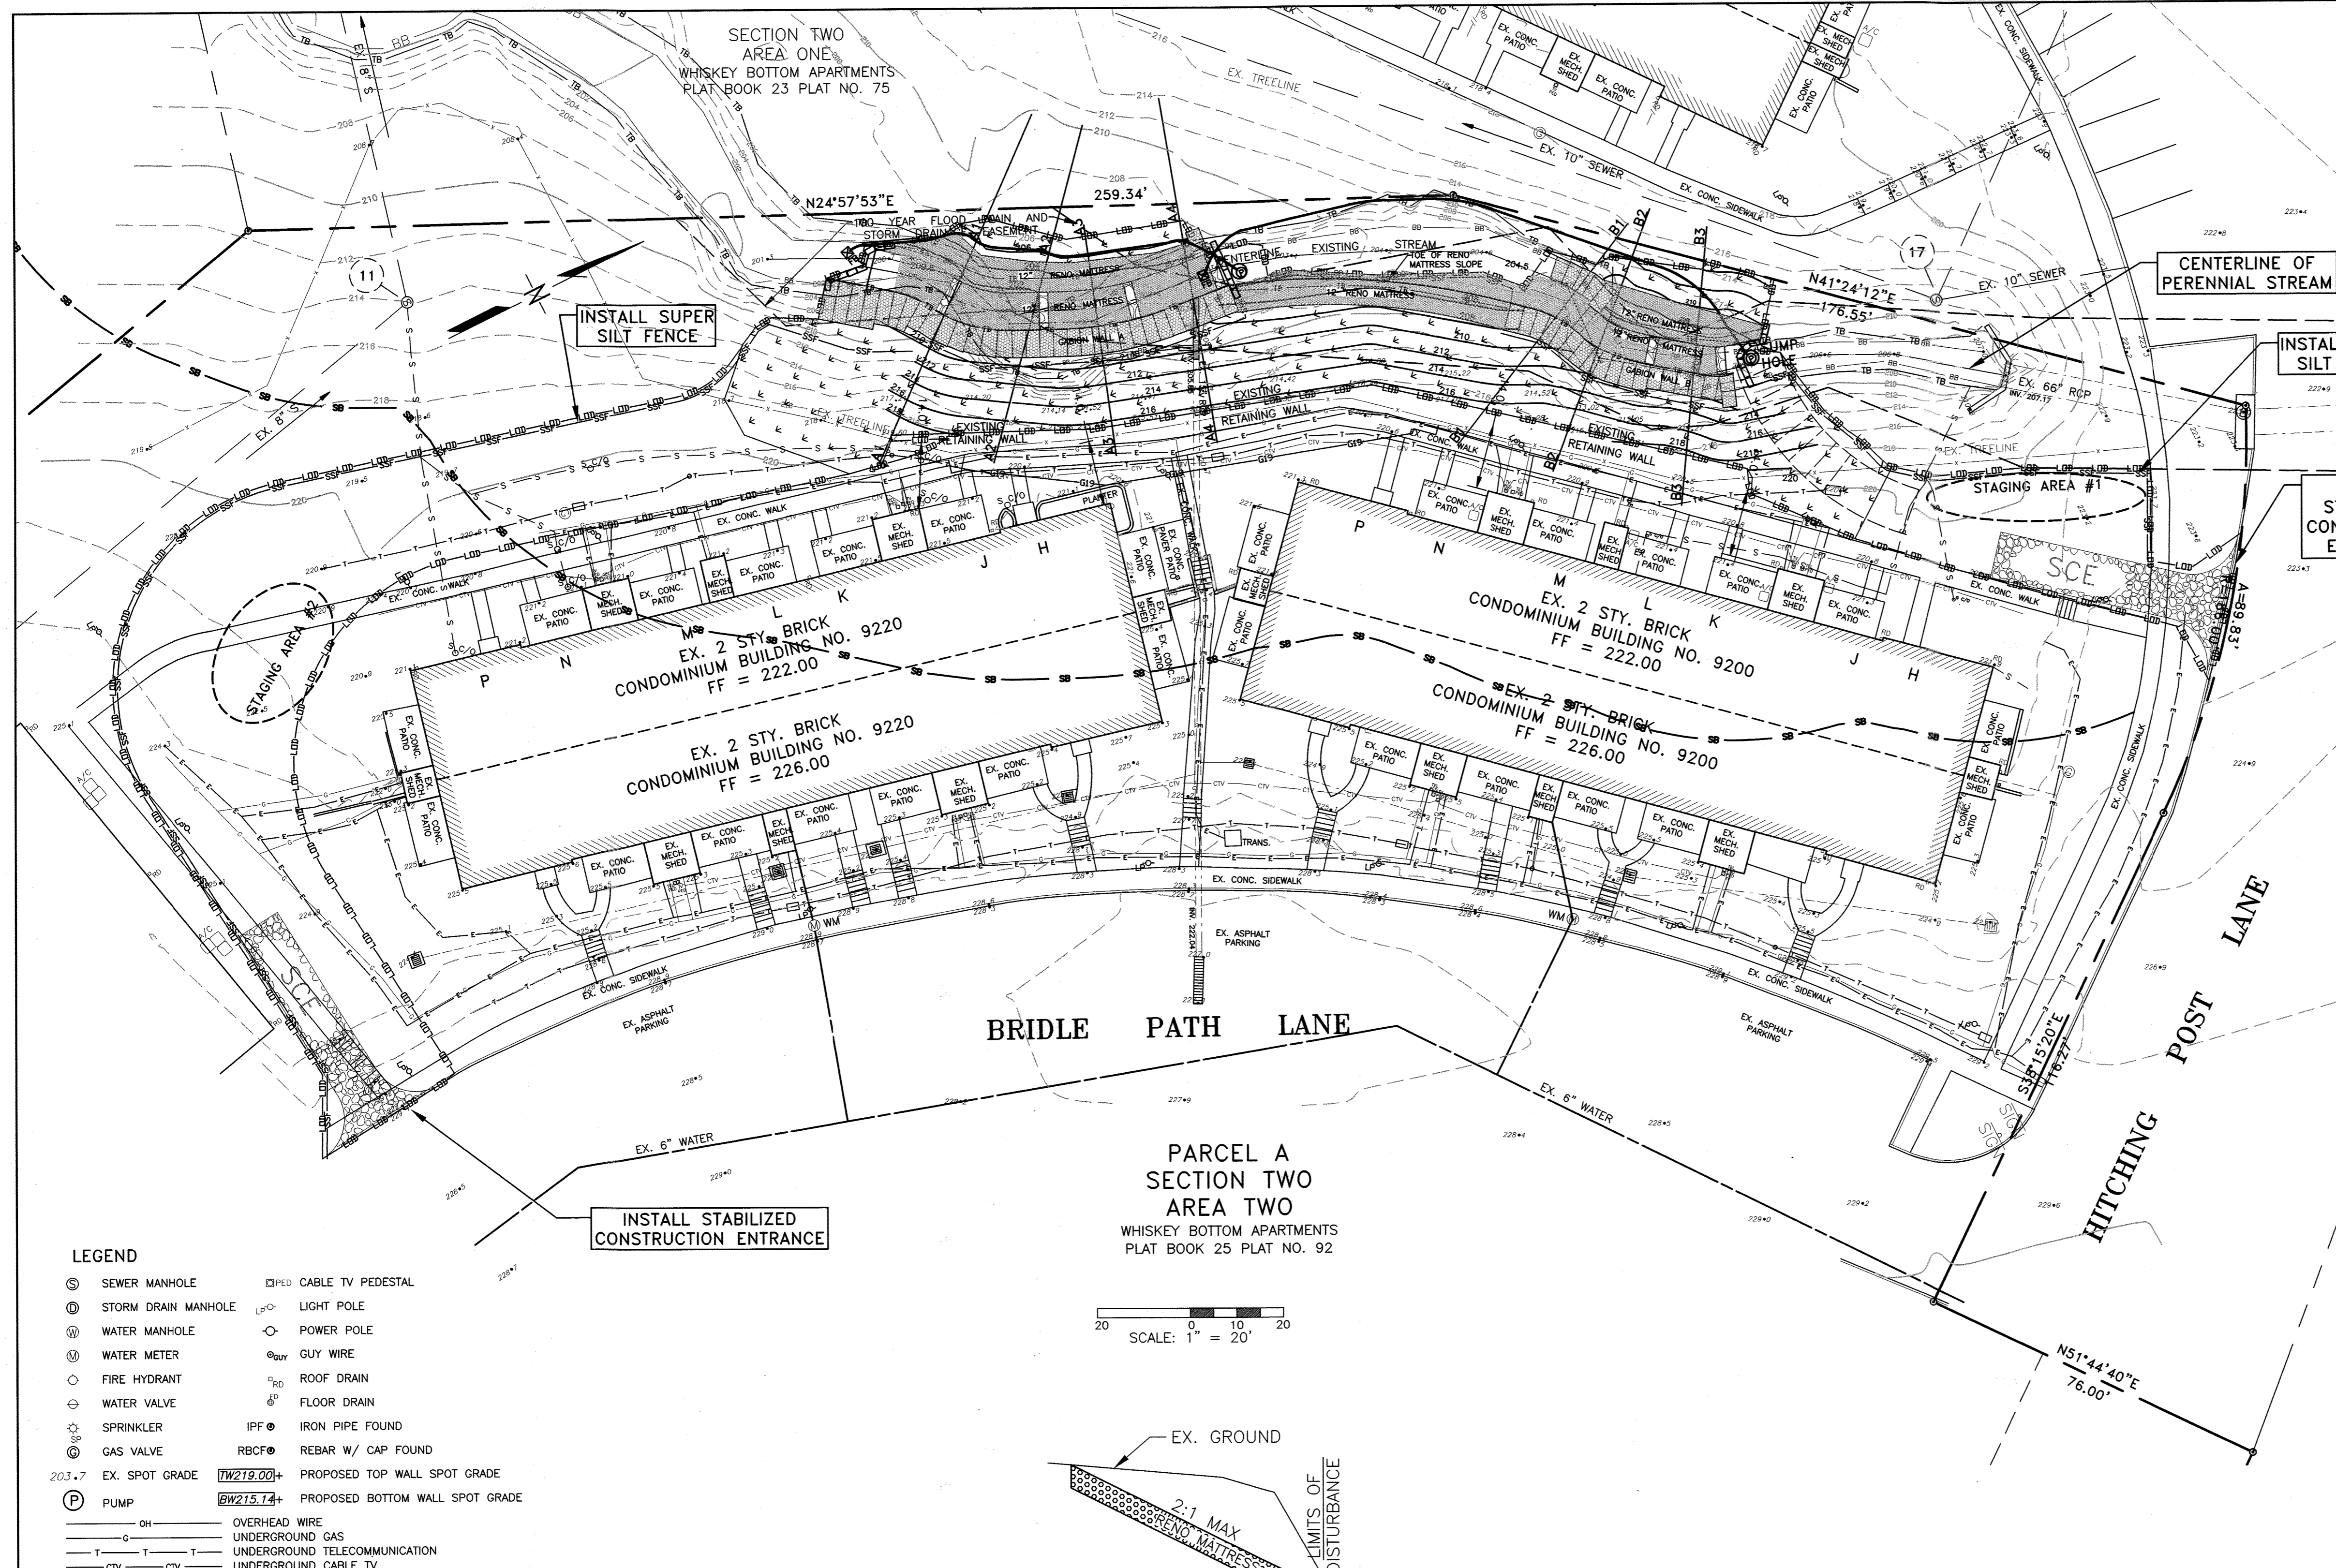

**GENERAL NOTES:**

1. Site property is known as Section Two - Area Two, Whiskey Bottom Apartments recorded Plat Book 25 at Plat No. 92. Current Zoning: R-A-15
2. The purpose of this project is to remediate for shifts in the stream centerline which is endangering the stability of 28 units of single family attached dwellings. The project will stabilize stream bank erosion and assign global stability with respect to the nearby buildings. The total disturbed area is 17,490 sq. ft.
3. The site lies within the Patuxent River Watershed which is Maryland Class Use I with no in-stream construction permitted from March 1 to June 15, inclusive.
4. Topographic information from survey conducted in the field August and September, 2015 by Landmark Engineering, Inc. Horizontal Data per Plat No. 92. Vertical Datum per previous approved Site & Grading Plan. Field work in 2019 documented further streambank erosion. The as-built location of the retaining wall was done by field survey in July 2020.
5. The property is not located within a FEMA mapped 100-year floodplain as determined in review of Howard County, Maryland Community Panel No. 2402700230D with effective date of November 6, 2013. The drainage area to the work area is 83.26 ac. The existing floodplain easement was established by record plat Section Two, Area Two Whiskey Bottom Apartments, Plat Book 25, Plat No. 92.
6. Gabion design to be per plan by the geotechnical engineer, Professional Consulting Corporation. The proposed wall to be gravity wall constructed under guidance of the geotechnical engineer.
7. The location of underground and above ground utilities as shown on this plan were field marked and survey located. This does not relieve the contractor for requirements to have utilities marked by Miss Utility. Any conflicts to be coordinated with the utility companies.
8. During preliminary investigations cameras were used to examine the conditions of the existing pipes. It was determined that the 15" RCP had a joint offset very close to the existing retaining wall. This pipe will get repaired and extended as part of this construction.
9. This stream restoration project is exempt from forest Conservation requirements in accordance with Section 16.1202(b)(1)(xv) of the Howard County Code.
10. The Maryland Department of the Environment issued an Authorization to Proceed for this project on August 5, 2019, Authorization Number 201961118/19/NT-3160. A modification of this Authorization as approved by this site plan revision will be obtained prior to final Sediment Control Permit Issuance.
11. Alternative Compliance WP-21-121 for this project was approved under Section 16.116.a.2.ii and Section 16.115.c of the County Code by the Director of the Department of Planning and Zoning, Director of Public Works and Administrator of the Office of Community Sustainability on May 21, 2021. The approval is conditioned on the following items:
  - a. All disturbed areas within the stream, stream bank buffer and 100-year floodplain shall be stabilized, seeded and/or planted after construction is complete. The disturbed areas within the stream buffer shall be replanted at a rate of at least 100 trees per acre.
  - b. The applicant shall obtain all required authorizations and permits from the Maryland Department of the Environment (MDE) and the U.S. Army Corps of Engineers for disturbances within the stream and floodplain. The applicant shall coordinate with MDE to revise the existing authorization (201961118/19-NT-3160) to be consistent with the stream bank and floodplain impacts as shown on SDP-72-084.

**SEQUENCE OF CONSTRUCTION**



1. Obtain Grading Permit.
2. The contractor shall have all existing utilities marked in the field prior to construction. The contractor is responsible for any damage to existing utilities that may result from construction and should repair the damage at his/her own expense to the county's or utility company's satisfaction. The contractor shall have Limits of Disturbance and Tree Protection areas field staked by Design Engineer.
3. The contractor shall notify the Maryland Department of the Environment or WMA sediment control inspector at least 5 days prior to construction. Contact Howard County Department of Public Works Construction Inspection Division (CID) at 410-313-1855 (48 hours notice required), Landmark Engineering, Inc. at 301-240-5881 (48 hours notice required), Professional Consulting Corporation at (48 hours notice required) and owners representative (48 hours notice required) to conduct pre-construction meeting.
4. After the preconstruction meeting and with written consent of the CID inspector, install Stabilized Construction Entrance, Silt Fence and/or Super Silt Fence and other Sediment Control measures per approved Sediment Control Plan. Sediment control devices are to remain in place until all disturbed areas are stabilized and the inspecting authority approves their removal.

- WORK AREA A: Downstream gabion walls**
5. Starting at the upstream barrier and working downstream, install pump around practice and pipe as shown on detail 1.2, sheet S-24. Height of barrier to be per MGWC 1.2 Pump-Around Practice.
  6. Install filter bags (Detail Sheet S-24) and pump from work area to filter bag to provide dry area for construction.
  7. Excavate and install gabion walls per plan. Install Reno mattress on stream bed. All excavated material should be deposited and stabilized in an approved area outside the 100-year floodplain.
  8. Provide temporary stabilization of areas around gabions per schedule on approved Sediment Control Plan.
- WORK AREA B: Upstream gabion walls**
9. Starting at the upstream barrier and working downstream, install pump around practice as shown on detail 1.2 sheet S-24. Height of barrier to be per MGWC 1.5 Sandbag/Stone Channel Diversion
  10. Install filter bags (Detail Sheet S-24) and pump from work area to filter bag to provide dry area for construction.
  11. Excavate and install gabion walls per plan. Install Reno mattress on stream bed. Continue downstream to install gabion walls on 2:1 slope between Gabion Wall A and Gabion Wall B. All excavated material should be deposited and stabilized in an approved area outside the 100-year floodplain.
  12. Provide permanent stabilization for areas around gabions per schedule on approved Sediment Control Plan.
  13. Plant trees per approved planting plan. All areas within the Limits of Disturbance shall be stabilized, seeded and/or planted after construction is complete.
  14. With written permission from Howard County Sediment Control Inspector, remove sediment control practices.

**LEGEND**

⊙	SEWER MANHOLE	⊙	CABLE TV PEDESTAL
⊙	STORM DRAIN MANHOLE	⊙	LIGHT POLE
⊙	WATER MANHOLE	⊙	POWER POLE
⊙	WATER METER	⊙	GUY WIRE
⊙	FIRE HYDRANT	⊙	ROOF DRAIN
⊙	WATER VALVE	⊙	FLOOR DRAIN
⊙	SPRINKLER	⊙	IRON PIPE FOUND
⊙	GAS VALVE	⊙	REBAR W/ CAP FOUND
⊙	EX. SPOT GRADE	⊙	PROPOSED TOP WALL SPOT GRADE
⊙	PUMP	⊙	PROPOSED BOTTOM WALL SPOT GRADE
—	OH	—	OVERHEAD WIRE
—	G	—	UNDERGROUND GAS
—	T	—	UNDERGROUND TELECOMMUNICATION
—	CTV	—	UNDERGROUND CABLE TV
—	E	—	UNDERGROUND ELECTRIC
—	W	—	WATER
—	S	—	SEWER
—	SH	—	SEWER HOUSE CONNECTION
—	SD	—	STORM DRAIN
—	IC	—	INDEX CONTOUR
—	IM	—	INTERMEDIATE CONTOUR
—	ST	—	STREAM
—	TB	—	75' STREAM BANK BUFFER
—	TOB	—	TOP OF BANK
—	BOB	—	BOTTOM OF BANK
—	PC	—	PROPOSED CONTOUR
—	PLD	—	PROPOSED LIMITS OF DISTURBANCE
—	SF	—	PROPOSED SUPER SILT FENCE
—	SSF	—	PROPOSED SUPER SILT FENCE

**PARCEL A SECTION TWO AREA TWO**  
WHISKEY BOTTOM APARTMENTS  
PLAT BOOK 25 PLAT NO. 92

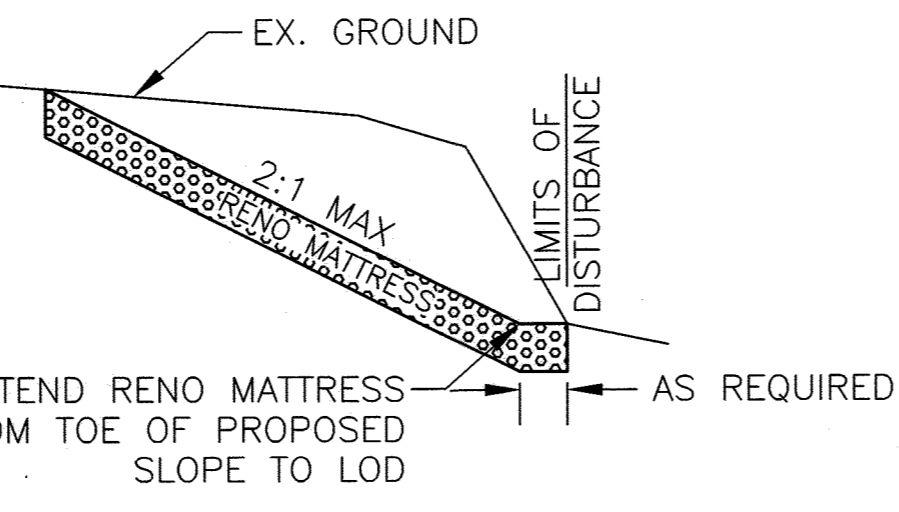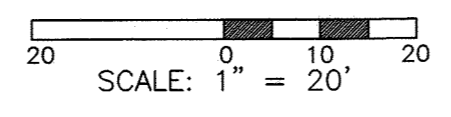

RENO MATTRESS BETWEEN GABION WALL A AND GABION WALL B PROVIDES SMOOTH TRANSITION BETWEEN WALLS AND EXPAND FLOW AREA

**RENO MATTRESS BETWEEN GABION WALL A AND GABION WALL B**  
NOT TO SCALE

This project is located in the Patuxent River watershed which is a Maryland Class Use I stream. Disturbance within the stream is restricted from March 1 to June 15, inclusive.

All areas within the Limits of Disturbance shall be stabilized, seeded and/or planted after construction is complete.

**HOWARD COUNTY DEPARTMENT OF PLANNING AND ZONING APPROVED**

CHIEF, LAND DEVELOPMENT *CS* DATE *6/1/22*

CHIEF, DEVELOPMENT ENGINEERING DIVISION *HSB* DATE *6/9/22*

DIRECTOR OF PLANNING AND ZONING *AC* DATE *6/22/22*

**Owners/Developer Certification:**

"I/We hereby certify that any clearing, grading, construction, or development will be done pursuant to this approved erosion and sediment control plan, including inspecting and maintaining controls, and that the responsible personnel involved in the construction project will have a Certificate of Training at a Maryland Department of the Environment (MDE) approved training program for the control on erosion and sediment prior to beginning the project. I certify right-of-entry for the periodic on-site evaluation by Howard County, the Howard Soil Conservation District and/or MDE."

*Arthur Blume*  
Owner's/Developer's Signature  
**ARTHUR BLUME - PRESIDENT**  
Printed Name & Title

*6/17/22*  
Date

**Design Certification:**

"I hereby certify that this plan has been designed in accordance with the current Maryland erosion and sediment control laws, regulations, and standards, that it represents a practical and workable plan based on my personal knowledge of the site, and that it was prepared in accordance with the requirements of the Howard Soil Conservation District."


*Charles J. Grimsley*  
Designer's Signature  
Charles T. Grimsley, P.E.  
Printed Name

*3/28/22*  
Date  
MD P.E. Registration No. 11124

**Howard SCD Signature Block:**

This plan is approved for soil erosion and sediment control by the Howard Soil Conservation District."

*Howard Batches*  
Howard Soil Conservation District  
Date *06/06/22*

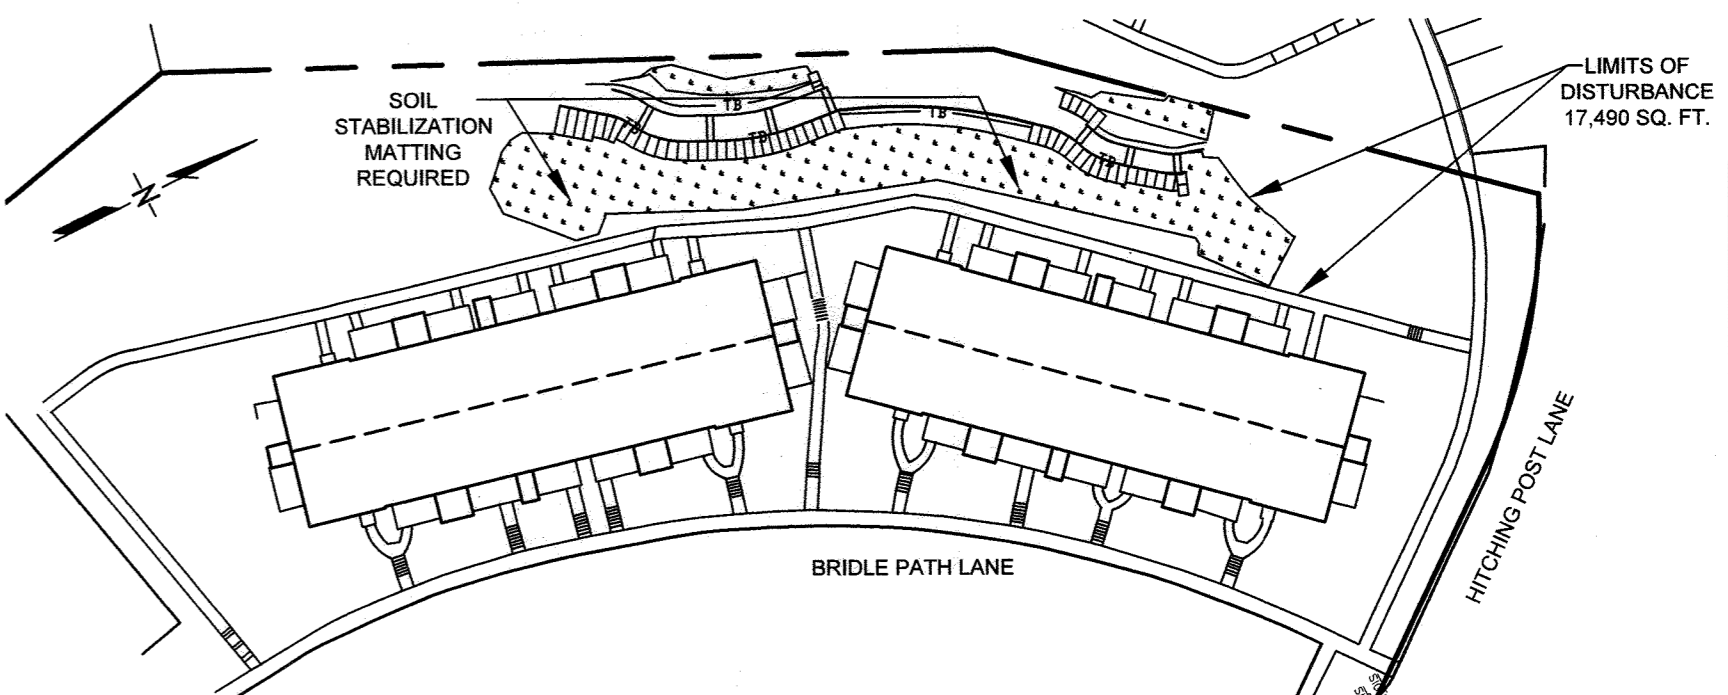

**PROFESSIONAL CERTIFICATION**

I HEREBY CERTIFY THAT THESE DOCUMENTS WERE PREPARED OR APPROVED BY ME, AND THAT I AM A DULY LICENSED PROFESSIONAL ENGINEER UNDER THE LAWS OF THE STATE OF MARYLAND, LICENSE NO. 11124, EXPIRATION DATE: OCTOBER 3, 2022.

*3/28/22*  
*Charles T. Grimsley*  
Professional Engineer

**OWNER-DEVELOPER**  
WHISKEY BOTTOM CONDOMINIUMS, ASSOC.  
c/o MR. ARTHUR F. BLUME, PRESIDENT  
WHISKEY BOTTOM SOUTH, BOARD OF DIRECTORS  
9220 BRIDLE PATH LANE, UNIT F  
LAUREL, MD. 20723

**LANDMARK ENGINEERING, INC.**  
13722 LAMBERTINA PLACE  
ROCKVILLE, MARYLAND 20850  
CONSULTING ENGINEERS PLANNERS SURVEYORS

PHONE: (301) 230-5881  
FAX: (301) 230-5884

**SECTION TWO WHISKEY BOTTOM APARTMENTS**  
SIXTH ELECTION DISTRICT, HOWARD COUNTY, MARYLAND

**SITE DEVELOPMENT PLAN  
STREAM STABILIZATION  
SEDIMENT AND EROSION CONTROL PLAN**


REVISIONS	
3	ESC TO SUPPORT STREAM STABILIZATION REPLACES SHEET S-12 OF PRIOR SDP PLAN SET 03/28/2022

DRN: DCV CK: CTG  
PROJECT NO.: 1530  
SCALE: 1" = 20'  
DATE: MAR. 28, 2022

**DRAWING NO. S-20 OF 24**

SDP-72-84



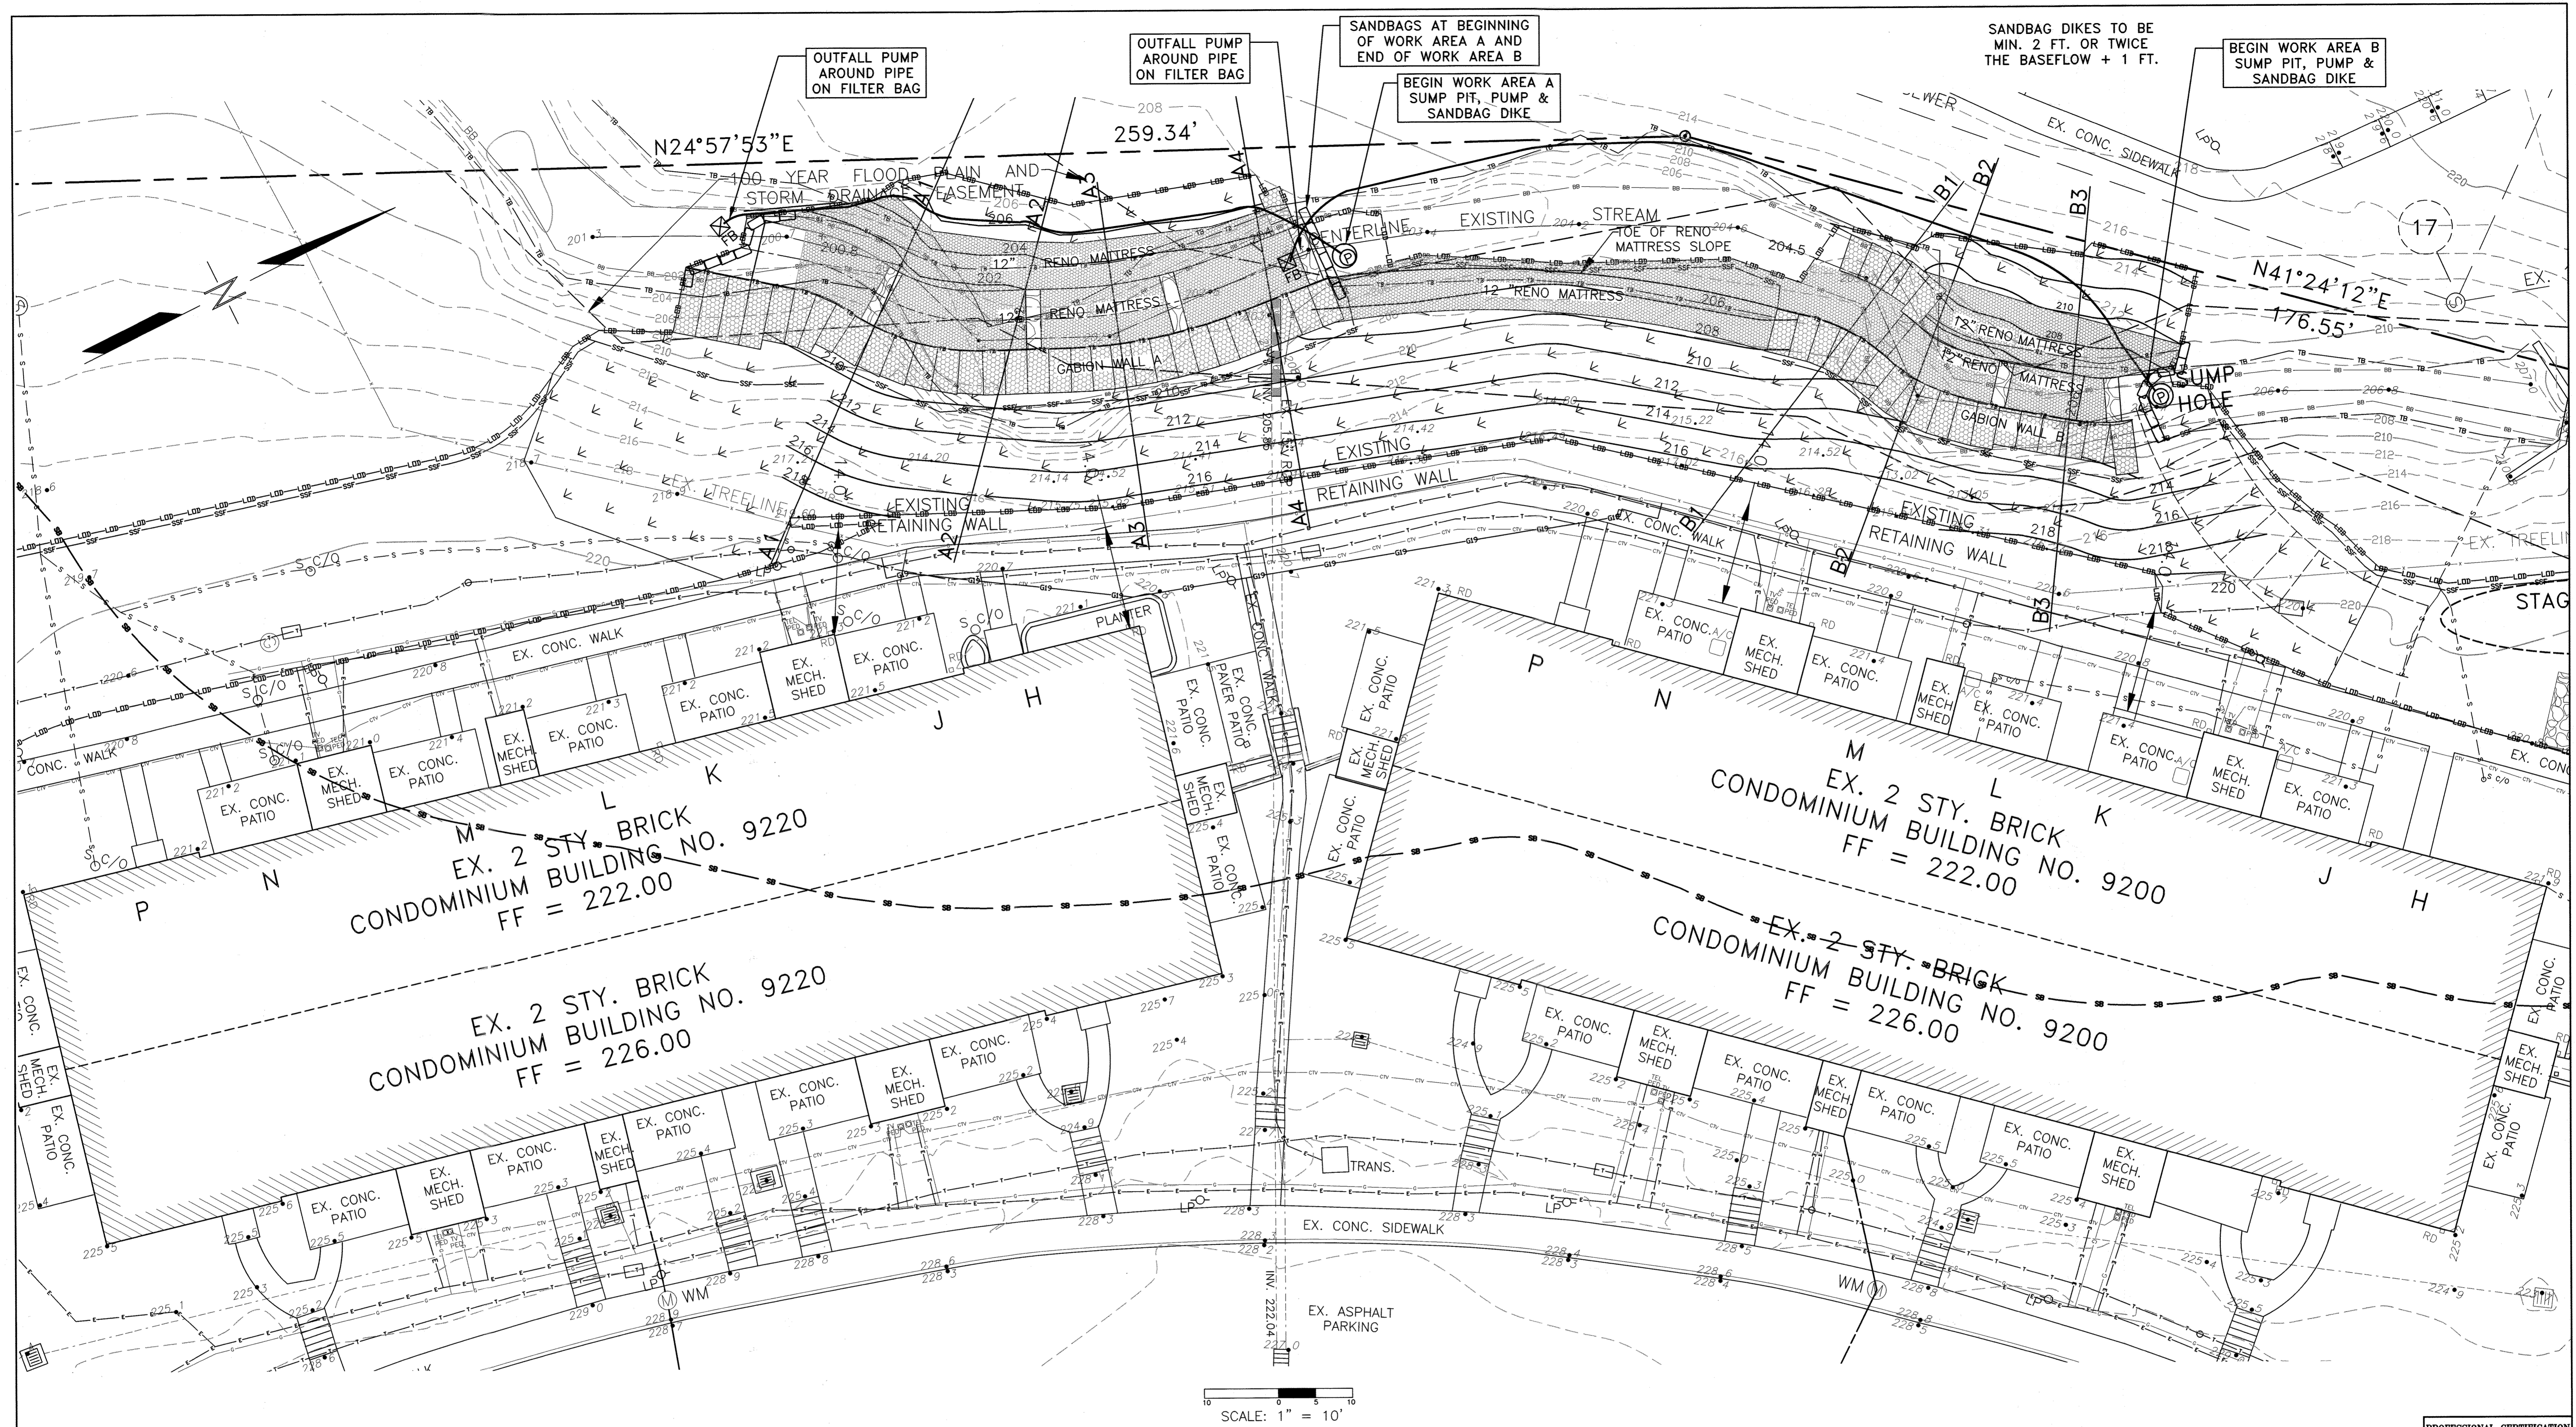

SCALE: 1" = 10'

HOWARD COUNTY DEPARTMENT OF PLANNING AND ZONING APPROVED

CHIEF, LAND DEVELOPMENT 06/22/22 DATE

CHIEF, DEVELOPMENT ENGINEERING DIVISION 06/22/22 DATE

DIRECTOR OF PLANNING AND ZONING 06/22/22 DATE

Owners/Developer Certification:

"I/We hereby certify that any clearing, grading, construction, or development will be done pursuant to this approved erosion and sediment control plan, including inspecting and maintaining controls, and that the responsible personnel involved in the construction project will have a Certificate of Training at a Maryland Department of the Environment (MDE) approved training program for the control on erosion and sediment prior to beginning the project. I certify right-of-entry for the periodic on-site evaluation by Howard County, the Howard Soil Conservation District and/or MDE."

Arthur Blume  
Owner's/Developer's Signature  
ARTHUR BLUME - PRESIDENT  
Printed Name & Title  
NBS - BOD

06/22/22 Date

Design Certification:

"I hereby certify that this plan has been designed in accordance with the current Maryland erosion and sediment control laws, regulations, and standards, that it represents a practical and workable plan based on my personal knowledge of the site, and that it was prepared in accordance with the requirements of the Howard Soil Conservation District."

Charles T. Grimsley  
Designer's Signature  
Charles T. Grimsley, P.E.  
Printed Name  
MD P.E. Registration No. 11124

03/08/22 Date

Howard SCD Signature Block:

This plan is approved for soil erosion and sediment control by the Howard Soil Conservation District."

Alexander Bratchai  
Howard Soil Conservation District  
06/06/22 Date

PROFESSIONAL CERTIFICATION

I HEREBY CERTIFY THAT THESE DOCUMENTS WERE PREPARED OR APPROVED BY ME AND THAT I AM A DULY LICENSED PROFESSIONAL ENGINEER UNDER THE LAWS OF THE STATE OF MARYLAND, LICENSE NO. 11124. EXPIRATION DATE: OCTOBER 3, 2022.

3/28/22

Professional Engineer Seal

All areas within the Limits of Disturbance shall be stabilized, seeded and/or planted after construction is complete.

OWNER-DEVELOPER  
WHISKEY BOTTOM CONDOMINIUMS, ASSOC.  
c/o MR. ARTHUR F. BLUME, PRESIDENT  
WHISKEY BOTTOM SOUTH, BOARD OF DIRECTORS  
9220 BRIDLE PATH LANE, UNIT F  
LAUREL, MD. 20723

LANDMARK ENGINEERING, INC.  
13722 LAMBERTINA PLACE  
ROCKVILLE, MARYLAND 20850  
CONSULTING ENGINEERS PLANNERS SURVEYORS

PHONE: (301) 230-5881  
FAX: (301) 230-5884

SECTION TWO  
WHISKEY BOTTOM APARTMENTS  
SIXTH ELECTION DISTRICT, HOWARD COUNTY, MARYLAND

SITE DEVELOPMENT PLAN  
STREAM STABILIZATION  
SEDIMENT AND EROSION CONTROL ENLARGEMENT

REVISIONS		DRN: DCV	CK: CTG	DRAWING NO. S-21 OF 24
3	ESC TO SUPPORT STREAM STABILIZATION NEW SHEET FOR SDP PLAN SET	03/28/2022		
		PROJECT NO.: 1530	SCALE: 1" = 10'	
		DATE: MAR. 28, 2022		

**HOWARD SOIL CONSERVATION DISTRICT (HSCD) STANDARD SEDIMENT CONTROL NOTES**

1. A pre-construction meeting must occur with the Howard County Department of Public Works, Construction Inspection Division (CID), 410-313-1855 after the future LOD and protected areas are marked clearly in the field. A minimum of 48 hour notice to CID must be given at the following stages:

- Prior to the start of earth disturbance.
- Upon completion of the installation of perimeter erosion and sediment controls, but before proceeding with any other earth disturbance or grading.
- Prior to the start of another phase of construction or opening of another grading unit.
- Prior to the removal or modification of sediment control practices.

Other building or grading inspection approvals may not be authorized until this initial approval by the inspection agency is made. Other related state and federal permits shall be referenced, to ensure coordination and to avoid conflicts with this plan.

2. All vegetative and structural practices are to be installed according to the provisions of this plan and are to be in conformance with the 2011 MARYLAND STANDARDS AND SPECIFICATIONS FOR SOIL EROSION AND SEDIMENT CONTROL, and revisions thereto.

3. Following initial soil disturbance or re-disturbance, permanent or temporary stabilization is required within three (3) calendar days as to the surface of all perimeter controls, dikes, swales, ditches, perimeter slopes, and all slopes steeper than 3:1 horizontal to 1 vertical (3:1); and seven (7) calendar days as to all other disturbed areas on the project site except for those areas under active grading.

4. All disturbed areas must be stabilized within the time period specified above in accordance with the 2011 MARYLAND STANDARDS AND SPECIFICATIONS FOR SOIL EROSION AND SEDIMENT CONTROL for topsoil (Sec. B-4-2), permanent seeding (Sec. B-4-5), temporary seeding (Sec. B-4-4) and mulching (Sec. B-4-3). Temporary stabilization with mulch alone can only be applied between the fall and spring seeding dates if the ground is frozen. Incremental stabilization (Sec. B-4-1) specifications shall be enforced in areas with >15' of cut and/or fill. Stockpiles (Sec. B-4-8) in excess of 20 ft. must be benched with stable outlet. All concentrated flow, steep slope, and highly erodible areas shall receive soil stabilization matting (Sec. B-4-6).

5. All sediment control structures are to remain in place, and are to be maintained in operative condition until permission for their removal has been obtained from the CID.

6. Site Analysis:

Total Area of Site:	15.911	Acres
Area Disturbed:	0.402	Acres
Area to be roofed or paved:	0.000	Acres
Area to be vegetatively stabilized:	0.359	Acres
Total Cut:	432	Cu. Yds.
Total Fill:	110	Cu. Yds.

Offsite waste/borrow area location: To be determined  
\* Within the LOD 0.043 acres are streambed, gabions or riprap.

7. Any sediment control practice which is disturbed by grading activity for placement of utilities must be repaired on the same day of disturbance.

8. Additional sediment control must be provided, if deemed necessary by the CID. The site and all controls shall be inspected by the contractor weekly; and the next day after each rain event. A written report by the contractor, made available upon request, is part of every inspection and should include:

- Inspection date
  - Inspection type (routine, pre-storm event, during rain event)
  - Name and title of inspector
  - Weather information (current conditions as well as time and amount of last recorded precipitation)
  - Brief description of project's status (e.g., percent complete) and/or current activities
  - Evidence of sediment discharges
  - Identification of plan deficiencies
  - Identification of sediment controls that require maintenance
  - Identification of missing or improperly installed sediment controls
  - Compliance status regarding the sequence of construction and stabilization requirements
  - Photographs
  - Monitoring/sampling
  - Maintenance and/or corrective action performed
  - Other inspection items as required by the General Permit for Stormwater Associated with Construction Activities (NPDDES, MDE).
9. Trenches for the construction of utilities is limited to three pipe lengths or that which can and shall be back-filled and stabilized by the end of each workday, whichever is shorter.
10. Any major changes or revisions to the plan or sequence of construction must be reviewed and approved by the HSCD prior to proceeding with construction. Minor revisions may be allowed by the CID per the list of HSCD-approved field changes.
11. Disturbance shall not occur outside the L.O.D. A project is to be sequenced so that grading activities begin on one grading unit (maximum acreage of 20 ac. per grading unit) at a time. Work may proceed to a subsequent grading unit when at least 50 percent of the disturbed area in the preceding grading unit has been stabilized and approved by the CID. Unless otherwise specified and approved by the HSCD, no more than 30 acres cumulatively may be disturbed at a given time.
12. Wash water from any equipment, vehicles, wheels, pavement, and other sources must be treated in a sediment basin or other approved washout structure.
13. Topsoil shall be stockpiled and preserved on-site for redistribution onto final grade.
14. All Silt Fence and Super Silt Fence shall be placed on-the-contour, and be imbricated at 25' minimum intervals, with lower ends curled uphill by 2' in elevation.
15. Stream channels must not be disturbed during the following restricted time periods (inclusive):
- Use I and IP March 1 - June 15
  - Use III and IIP October 1 - April 30
  - Use IV March 1 - May 31
16. A copy of this plan, the 2011 MARYLAND STANDARDS AND SPECIFICATIONS FOR SOIL EROSION AND SEDIMENT CONTROL, and associated permits shall be on-site and available when the site is active.

HOWARD COUNTY DEPARTMENT OF PLANNING AND ZONING APPROVED

CHIEF, LAND DEVELOPMENT DATE: 6/22/22

CHIEF, DEVELOPMENT ENGINEERING DIVISION DATE: 6/22/22

DIRECTOR OF PLANNING AND ZONING DATE: 6/22/22

Owners/Developer Certification:

"I/we hereby certify that any clearing, grading, construction, or development will be done pursuant to this approved erosion and sediment control plan, including inspecting and maintaining controls, and that the responsible personnel involved in the construction project will have a Certificate of Training at a Maryland Department of the Environment (MDE) approved training program for the control on erosion and sediment prior to beginning the project. I certify right-of-entry for the periodic on-site evaluation by Howard County, the Howard Soil Conservation District and/or MDE."

Owner's/ Developer's Signature: ARTHUR BLUME - PRESIDENT  
Printed Name & Title: NBS-80D

Date: 6/17/22

Design Certification:

"I hereby certify that this plan has been designed in accordance with the current Maryland erosion and sediment control laws, regulations, and standards, that it represents a practical and workable plan based on my personal knowledge of the site, and that it was prepared in accordance with the requirements of the Howard Soil Conservation District."

Designer's Signature: Charles T. Grimley  
Printed Name: Charles T. Grimley, P.E.  
Date: 3/28/22  
MD P.E. Registration No. 11124

Howard SCD Signature Block:

This plan is approved for soil erosion and sediment control by the Howard Soil Conservation District.

Signature: Alexander Bratschi  
Date: 06/06/22

OWNER-DEVELOPER  
WHISKEY BOTTOM CONDOMINIUMS, ASSOC.  
c/o MR. ARTHUR F. BLUME, PRESIDENT  
WHISKEY BOTTOM SOUTH, BOARD OF DIRECTORS  
9220 BRIDLE PATH LANE, UNIT F  
LAUREL, MD, 20723

**LANDMARK ENGINEERING, INC.**  
CONSULTING ENGINEERS PLANNERS SURVEYORS

13722 LAMBERTINA PLACE  
ROCKVILLE, MARYLAND 20850  
PHONE: (301) 230-5881  
FAX: (301) 230-5884

SECTION TWO  
**WHISKEY BOTTOM APARTMENTS**  
SIXTH ELECTION DISTRICT, HOWARD COUNTY, MARYLAND

SITE DEVELOPMENT PLAN  
**STREAM STABILIZATION**  
SEDIMENT AND EROSION CONTROL NOTES & DETAILS

REVISIONS

3	ESC TO SUPPORT STREAM STABILIZATION REPLACES SHEET S-13 OF PRIOR SDP PLAN SET	03/28/2022
---	---	------------

DRN: DCV CK: CTG  
PROJECT NO.: 1530  
SCALE: AS SHOWN  
DATE: MAR. 28, 2022

DRAWING NO. S-22 OF 24

**B-4-2 STANDARDS AND SPECIFICATIONS FOR SOIL PREPARATION, TOPSOILING, AND SOIL AMENDMENTS**

**Definition**  
The process of preparing the soils to sustain adequate vegetative stabilization.

**Purpose**  
To provide a suitable soil medium for vegetative growth.

**Conditions Where Practice Applies**  
Where vegetative stabilization is to be established.

**Criteria**

A. Soil Preparation

- Temporary Stabilization
  - Seedbed preparation consists of loosening soil to a depth of 3 to 5 inches by means of suitable agricultural or construction equipment, such as disc harrows or chisel plows or rippers mounted on construction equipment. After the soil is loosened, it must not be rolled or dragged smooth but left in the roughened condition. Slopes 3:1 or flatter are to be tracked with ridges running parallel to the contour of the slope.
  - Apply fertilizer and lime as prescribed on the plans.
  - Incorporate lime and fertilizer into the top 3 to 5 inches of soil by disking or other suitable means.
- Permanent Stabilization
  - A soil test is required for any earth disturbance of 5 acres or more. The minimum soil conditions required for permanent vegetative establishment are:
    - Soil pH between 6.0 and 7.0.
    - Soluble salts less than 500 parts per million (ppm).
    - Soil contains less than 40 percent clay but enough fine grained material (greater than 30 percent silt plus clay) to provide the capacity to hold a moderate amount of moisture. An exception: if lovegrass will be planted, then a sandy soil (less than 30 percent silt plus clay) would be acceptable.
    - Soil contains 1.5 percent minimum organic matter by weight.
    - Soil contains sufficient pore space to permit adequate root penetration.
  - Application of amendments or topsoil is required if on-site soils do not meet the above conditions.
  - Graded areas must be maintained in a true and even grade as specified on the approved plan, then scarified or otherwise loosened to a depth of 3 to 5 inches.

**B.12**

d. Apply soil amendments as specified on the approved plan or as indicated by the results of a soil test.

e. Mix soil amendments into the top 3 to 5 inches of soil by disking or other suitable means. Rake lawn areas to smooth the surface, remove large objects like stones and branches, and ready the area for seed application. Loosen surface soil by dragging with a heavy chain or other equipment to roughen the surface where site conditions will not permit normal seedbed preparation. Track slopes 3:1 or flatter with tracked equipment leaving the soil in an irregular condition with ridges running parallel to the contour of the slope. Leave the top 1 to 3 inches of soil loose and friable. Seedbed loosening may be unnecessary on newly disturbed areas.

B. Topsoiling

- Topsoil is placed over prepared subsoil prior to establishment of permanent vegetation. The purpose is to provide a suitable soil medium for vegetative growth. Soils of concern have low moisture content, low nutrient levels, low pH, materials toxic to plants, and/or unacceptable soil gradation.
- Topsoil salvaged from an existing site may be used provided it meets the standards as set forth in these specifications. Typically, the depth of topsoil to be salvaged for a given soil type can be found in the representative soil profile section in the Soil Survey published by USDA-NRCS.
- Topsoiling is limited to areas having 2:1 or flatter slopes where:
  - The texture of the exposed subsoil/parent material is not adequate to produce vegetative growth.
  - The soil material is so shallow that the rooting zone is not deep enough to support plants or furnish continuing supplies of moisture and plant nutrients.
  - The original soil to be vegetated contains material toxic to plant growth.
  - The soil is so acidic that treatment with limestone is not feasible.
- Areas having slopes steeper than 2:1 require special consideration and design.
- Topsoil Specifications: Soil to be used as topsoil must meet the following criteria:
  - Topsoil must be a loam, sandy loam, clay loam, silt loam, sandy clay loam, or loamy sand. Other soils may be used if recommended by an agronomist or soil scientist and approved by the appropriate approval authority. Topsoil must not be a mixture of contrasting textured subsoils and must contain less than 5 percent by volume of cinders, stones, slag, coarse fragments, gravel, sticks, roots, trash, or other materials larger than 1 1/2 inches in diameter.
  - Topsoil must be free of noxious plants or plant parts such as Bermuda grass, quack grass, Johnson grass, nut sedge, poison ivy, thistle, or others as specified.
  - Topsoil substitutes or amendments, as recommended by a qualified agronomist or soil scientist and approved by the appropriate approval authority, may be used in lieu of natural topsoil.
- Topsoil Application
  - Erosion and sediment control practices must be maintained when applying topsoil.
  - Uniformly distribute topsoil in a 5 to 8 inch layer and lightly compact to a minimum thickness of 4 inches. Spreading is to be performed in such a manner that sodding or seeding can proceed with a minimum of additional soil preparation and tillage. Any irregularities in the surface resulting from topsoiling or other operations must be corrected in order to prevent the formation of depressions or water pockets.
  - Topsoil must not be placed if the topsoil or subsoil is in a frozen or muddy condition, when the subsoil is excessively wet or in a condition that may otherwise be detrimental to proper grading

**B.13**

and seedbed preparation.

C. Soil Amendments (Fertilizer and Lime Specifications)

- Soil tests must be performed to determine the exact ratios and application rates for both lime and fertilizer on sites having disturbed areas of 5 acres or more. Soil analysis may be performed by a recognized private or commercial laboratory. Soil samples taken for engineering purposes may also be used for chemical analyses.
- Fertilizers must be uniform in composition, free flowing and suitable for accurate application by appropriate equipment. Manure may be substituted for fertilizer with prior approval from the appropriate approval authority. Fertilizers must all be delivered to the site fully labeled according to the applicable laws and must bear the name, trade name or trademark and warranty of the producer.
- Lime materials must be ground limestone (hydrated or burnt lime may be substituted except when hydrosedding) which contains at least 50 percent total oxides (calcium oxide plus magnesium oxide). Limestone must be ground to such fineness that at least 50 percent will pass through a #100 mesh sieve and 98 to 100 percent will pass through a #20 mesh sieve.
- Lime and fertilizer are to be evenly distributed and incorporated into the top 3 to 5 inches of soil by disking or other suitable means.
- Where the subsoil is either highly acidic or composed of heavy clays, spread ground limestone at the rate of 4 to 8 tons/acre (200-400 pounds per 1,000 square feet) prior to the placement of topsoil.

**B.14**

**B-4-3 STANDARDS AND SPECIFICATIONS FOR SEEDING AND MULCHING**

**Definition**  
The application of seed and mulch to establish vegetative cover.

**Purpose**  
To protect disturbed soils from erosion during and at the end of construction.

**Conditions Where Practice Applies**  
To the surface of all perimeter controls, slopes, and any disturbed area not under active grading.

**Criteria**

A. Seeding

- Specifications
  - All seed must meet the requirements of the Maryland State Seed Law. All seed must be subject to re-testing by a recognized seed laboratory. All seed used must have been tested within the 6 months immediately preceding the date of sowing such material on any project. Refer to Table B.4 regarding the quality of seed. Seed tags must be available upon request to the inspector to verify type of seed and seeding rate.
  - Mulch alone may be applied between the fall and spring seeding dates only if the ground is frozen. The appropriate seeding mixture must be applied when the ground thaws.
  - Inoculants: The inoculant for treating legume seed in the seed mixtures must be a pure culture of nitrogen fixing bacteria prepared specifically for the species. Inoculants must not be used later than the date indicated on the container. Add fresh inoculants as directed on the package. Use four times the recommended rate when hydrosedding. Note: It is very important to keep inoculant as cool as possible until used. Temperatures above 75 to 80 degrees Fahrenheit can weaken bacteria and make the inoculant less effective.
  - Sod or seed must not be placed on soil which has been treated with soil sterilants or chemicals used for weed control until sufficient time has elapsed (14 days min.) to permit dissipation of phyto-toxic materials.
- Application
  - Dry Seeding: This includes use of conventional drop or broadcast spreaders.
    - Incorporate seed into the subsoil at the rates prescribed on Temporary Seeding Table B.1, Permanent Seeding Table B.3, or site-specific seeding summaries.
    - Apply seed in two directions, perpendicular to each other. Apply half the seeding rate in each direction. Roll the seeded area with a weighted roller to provide good seed to soil contact.

**B.15**

B. Mulching

- Mulch Materials (in order of preference)
  - Straw consisting of thoroughly threshed wheat, rye, oat, or barley and reasonably bright in color. Straw is to be free of noxious weed seeds as specified in the Maryland Seed Law and not musty, moldy, caked, decayed, or excessively dusty. Note: Use only sterile straw mulch in areas where one species of grass is desired.
  - Wood Cellulose Fiber Mulch (WCFM) consisting of specially prepared wood cellulose processed into a uniform fibrous physical state.
    - WCFM is to be dyed green or contain a green dye in the package that will provide an appropriate color to facilitate visual inspection of the uniformly spread slurry.
    - WCFM, including dye, must contain no germination or growth inhibiting factors.
    - WCFM materials are to be manufactured and processed in such a manner that the wood cellulose fiber mulch will remain in uniform suspension in water under agitation and will blend with seed, fertilizer and other additives to form a homogeneous slurry. The mulch material must form a blotter-like ground cover, on application, having moisture absorption and percolation properties and must cover and hold grass seed in contact with the soil without inhibiting the growth of the grass seedlings.
    - WCFM material must not contain elements or compounds at concentration levels that will be phytotoxic.
    - WCFM must conform to the following physical requirements: fiber length of approximately 10 millimeters, diameter approximately 1 millimeter, pH range of 4.0 to 8.5, ash content of 1.6 percent maximum and water holding capacity of 90 percent minimum.
- Application
  - Apply mulch to all seeded areas immediately after seeding.
  - When straw mulch is used, spread it over all seeded areas at the rate of 2 tons per acre to a uniform loose depth of 1 to 2 inches. Apply mulch to achieve a uniform distribution and depth so that the soil surface is not exposed. When using a mulch anchoring tool, increase the application rate to 2.5 tons per acre.
  - Wood cellulose fiber used as mulch must be applied at a net dry weight of 1500 pounds per acre. Mix the wood cellulose fiber with water to attain a mixture with a maximum of 50 pounds of wood cellulose fiber per 100 gallons of water.
- Anchoring
  - Perform mulch anchoring immediately following application of mulch to minimize loss by wind or water. This may be done by one of the following methods (listed by preference), depending upon the size of the area and erosion hazard:
    - A mulch anchoring tool is a tractor drawn implement designed to punch and anchor mulch into the soil surface a minimum of 2 inches. This practice is most effective on large areas, but is limited to flatter slopes where equipment can operate safely. If used on sloping land, this practice should follow the contour.
    - Wood cellulose fiber may be used for anchoring straw. Apply the fiber binder at a net dry weight of 750 pounds per acre. Mix the wood cellulose fiber with water at a maximum of 50 pounds of wood cellulose fiber per 100 gallons of water.
    - Synthetic binders such as Acrylic DLR (Agro-Tack), DCA-70, Petro-Terra, Terra Tax II, Terra Tack AR or other approved equal may be used. Follow application rates as specified by the manufacturer. Application of liquid binders needs to be heavier at the edges where wind catches mulch, such as in valleys and on crests of banks. Use of asphalt binders is strictly prohibited.
    - Lightweight plastic netting may be stapled over the mulch according to manufacturer recommendations. Netting is usually available in rolls 4 to 15 feet wide and 300 to 3,000 feet long.

**B.16**

**B.17**

**B-4-4 STANDARDS AND SPECIFICATIONS FOR TEMPORARY STABILIZATION**

**Definition**  
To stabilize disturbed soils with vegetation for up to 6 months.

**Purpose**  
To use fast growing vegetation that provides cover on disturbed soils.

**Conditions Where Practice Applies**  
Exposed soils where ground cover is needed for a period of 6 months or less. For longer duration of time, permanent stabilization practices are required.

**Criteria**

- Select one or more of the species or seed mixtures listed in Table B.1 for the appropriate Plant Hardness Zone (from Figure B.3), and enter them in the Temporary Seeding Summary below along with application rates, seeding dates and seeding depths. If this Summary is not put on the plan and completed, then Table B.1 plus fertilizer and lime rates must be put on the plan.
- For sites having soil tests performed, use and show the recommended rates by the testing agency. Soil tests are not required for Temporary Seeding.
- When stabilization is required outside of a seeding season, apply seed and mulch or straw mulch alone as prescribed in Section B-4-3.A.1.b and maintain until the next seeding season.

**Temporary Seeding Summary**

No.	Species	Application Rate (lb/acre)	Seeding Dates	Seeding Depths	Hardness Zone (from Figure B.3):	
					6b	7a
	Annual Ryegrass	40	Mar 1-May 15	0.5 in.	436 lb/ac (10 lb/1000 sf)	2 tons/ac (90 lb/1000 sf)
	Foxtail Millet	30	May 16-Jul 31	0.5 in.		

**Table B.1: Temporary Seeding for Site Stabilization**

Plant Species	Seeding Rate <sup>1/2</sup>		Seeding Depth <sup>3</sup> (inches)	Recommended Seeding Dates by Plant Hardness Zone <sup>1/2</sup>		
	lb/acre	lb/1000 sf		5b and 6a	6b	7a and 7b
<b>Crop-Seedless Grasses</b>						
Annual Ryegrass ( <i>Lolium perenne</i> spp. <i>multiflorum</i> )	40	1.0	0.5	Mar 15 to May 31; Aug 1 to Sep 30	Mar 1 to May 15; Aug 1 to Oct 15	Feb 15 to Apr 30; Aug 15 to Nov 30
Barley ( <i>Hordeum vulgare</i> )	96	2.2	1.0	Mar 15 to May 31; Aug 1 to Sep 30	Mar 1 to May 15; Aug 1 to Oct 15	Feb 15 to Apr 30; Aug 15 to Nov 30
Oat ( <i>Avena sativa</i> )	72	1.7	1.0	Mar 15 to May 31; Aug 1 to Sep 30	Mar 1 to May 15; Aug 1 to Oct 15	Feb 15 to Apr 30; Aug 15 to Nov 30
Wheat ( <i>Triticum aestivum</i> )	120	2.8	1.0	Mar 15 to May 31; Aug 1 to Sep 30	Mar 1 to May 15; Aug 1 to Oct 15	Feb 15 to Apr 30; Aug 15 to Nov 30
Orchard Ryegrass ( <i>Lolium perenne</i> )	112	2.8	1.0	Mar 15 to May 31; Aug 1 to Oct 31	Mar 1 to May 15; Aug 1 to Nov 15	Feb 15 to Apr 30; Aug 15 to Dec 15
<b>Warm-Season Grasses</b>						
Foxtail Millet ( <i>Setaria italica</i> )	30	0.7	0.5	Jun 1 to Jul 31	May 16 to Jul 31	May 1 to Aug 14
Foxtail Millet ( <i>Pennisetum glaucum</i> )	20	0.5	0.5	Jun 1 to Jul 31	May 16 to Jul 31	May 1 to Aug 14

NOTES:  
1/ Seeding rates for the warm-season grasses are in pounds of Pure Live Seed (PLS). Actual planting rates shall be adjusted to reflect percent seed germination and purity, as needed. Adjustments are usually not needed for the cool-season grasses.  
2/ For sandy soils, plant seeds at twice the depth listed above.  
3/ The planting dates listed are averages for each Zone and may require adjustment to reflect local conditions, especially near the boundaries of the zones.  
One acre is the recommended acre crop for warm-season grasses.

PROFESSIONAL CERTIFICATION

I HEREBY CERTIFY THAT THESE DOCUMENTS WERE PREPARED OR APPROVED BY ME, AND THAT I AM A DULY LICENSED PROFESSIONAL ENGINEER UNDER THE LAWS OF THE STATE OF MARYLAND, LICENSE NO. 11124, EXPIRATION DATE: OCTOBER 3, 2022.

3/28/22

ALL NOTES AND DETAILS ON THIS SHEET WERE REPLACED WITH STANDARD NOTES AND DETAILS TO ENSURE COMPLIANCE WITH REVISIONS BY MARYLAND DEPARTMENT OF THE ENVIRONMENT TO THE EROSION AND SEDIMENT CONTROL MANUAL.

B-4-5 STANDARDS AND SPECIFICATIONS	
FOR PERMANENT STABILIZATION	
Definition	
To stabilize disturbed soils with permanent vegetation.	
Purpose	
To use long-lived perennial grasses and legumes to establish permanent ground cover on disturbed soils.	
Conditions Where Practice Applies	
Exposed soils where ground cover is needed for 6 months or more.	
Criteria	
A. Seed Mixtures	
1. General Use	
a. Select one or more of the species or mixtures listed in Table B.3 for the appropriate Plant Hardiness Zone (from Figure B.3) and based on the site condition or purpose found on Table B.2. Enter selected mixture(s), application rates, and seeding dates in the Permanent Seeding Summary. The Summary is to be placed on the plan.	
b. Additional planting specifications for exceptional sites such as shorelines, stream banks, or dunes or for special purposes such as wildlife or aesthetic treatment may be found in USDA-NRCS Technical Field Office Guide, Section 342 - Critical Area Planting.	
c. For sites having disturbed area over 5 acres, use and show the rates recommended by the soil testing agency.	
d. For areas receiving low maintenance, apply urea form fertilizer (46-0-0) at 3 1/2 pounds per 1000 square feet (150 pounds per acre) at the time of seeding in addition to the soil amendments shown in the Permanent Seeding Summary.	
2. Turfgrass Mixtures	
a. Areas where turfgrass may be desired include lawns, parks, playgrounds, and commercial sites which will receive a medium to high level of maintenance.	
b. Select one or more of the species or mixtures listed below based on the site conditions or purpose. Enter selected mixture(s), application rates, and seeding dates in the Permanent Seeding Summary. The summary is to be placed on the plan.	
i. Kentucky Bluegrass: Full Sun Mixture: For use in areas that receive intensive management. Irrigation required in the areas of central Maryland and Eastern Shore. Recommended Certified Kentucky Bluegrass Cultivars Seeding Rate: 1.5 to 2.0 pounds per 1000 square feet. Choose a minimum of three Kentucky bluegrass cultivars with each ranging from 10 to 35 percent of the total mixture by weight.	
ii. Kentucky Bluegrass/Perennial Ryegrass: Full Sun Mixture: For use in full sun areas where	

Permanent Seeding Summary									
Hardiness Zone (from Figure B.3): <u>6b</u>					Fertilizer Rate (10-20-20)				
Seed Mixture (from Table B.3): <u>1</u>					Lime Rate				
No.	Species	Application Rate (lb/ac)	Seeding Dates	Seeding Depths	N	P <sub>2</sub> O <sub>5</sub>	K <sub>2</sub> O		
	Switchgrass	40	Mar 1-May 15 Aug 1-Oct 15	1/4 - 1/2 in	45 pounds per acre (1.0 lb/1000 sf)	90 lb/ac (2 lb/1000 sf)	90 lb/ac (2 lb/1000 sf)	2 tons/ac (90 lb/1000 sf)	
	Creeping Red Fescue	30	Mar 1-May 15 Aug 1-Oct 15	1/4 - 1/2 in					
	Partridge Peas	30	Mar 1-May 15 Aug 1-Oct 15	1/4 - 1/2 in					

B. Sod: To provide quick cover on disturbed areas (2:1 grade or flatter).

1. General Specifications

- Class of turfgrass sod must be Maryland State Certified. Sod labels must be made available to the job foreman and inspector.
- Sod must be machine cut at a uniform soil thickness of 3/4 inch, plus or minus 1/8 inch, at the time of cutting. Measurement for thickness must exclude top growth and thatch. Broken pads and torn or uneven ends will not be acceptable.
- Standard size sections of sod must be strong enough to support their own weight and retain their size and shape when suspended vertically with a firm grasp on the upper 10 percent of the section.
- Sod must not be harvested or transplanted when moisture content (excessively dry or wet) may adversely affect its survival.
- Sod must be harvested, delivered, and installed within a period of 36 hours. Sod not transplanted within this period must be approved by an agronomist or soil scientist prior to its installation.


2. Sod Installation

- During periods of excessively high temperature or in areas having dry soil, lightly irrigate the subsoil immediately prior to laying the sod.
- Lay the first row of sod in a straight line with subsequent rows placed parallel to it and tightly wedged against each other. Stagger lateral joints to promote more uniform growth and strength. Ensure that sod is not stretched or overlapped and that all joints are butted tight in order to prevent voids which would cause air drying of the roots.
- Wherever possible, lay sod with the long edges parallel to the contour and with staggering joints. Roll and tamp, peg or otherwise secure the sod to prevent slippage on slopes. Ensure solid contact exists between sod roots and the underlying soil surface.
- Water the sod immediately following rolling and tamping until the underside of the new sod pad and soil surface below the sod are thoroughly wet. Complete the operations of laying, tamping and irrigating for any piece of sod within eight hours.

3. Sod Maintenance

- In the absence of adequate rainfall, water daily during the first week or as often and sufficiently as necessary to maintain moist soil to a depth of 4 inches. Water sod during the heat of the day to prevent wilting.
- After the first week, sod watering is required as necessary to maintain adequate moisture content.
- Do not mow until the sod is firmly rooted. No more than 1/2 of the grass leaf must be removed by the initial cutting or subsequent cuttings. Maintain a grass height of at least 3 inches unless otherwise specified.

B-4-8 STANDARDS AND SPECIFICATIONS	
FOR STOCKPILE AREA	
Definition	
A mound or pile of soil protected by appropriately designed erosion and sediment control measures.	
Purpose	
To provide a designated location for the temporary storage of soil that controls the potential for erosion, sedimentation, and changes to drainage patterns.	
Conditions Where Practice Applies	
Stockpile areas are utilized when it is necessary to salvage and store soil for later use.	
Criteria	
1. The stockpile location and all related sediment control practices must be clearly indicated on the erosion and sediment control plan.	
2. The footprint of the stockpile must be sized to accommodate the anticipated volume of material and based on a side slope ratio no steeper than 2:1. Benching must be provided in accordance with Section B-3 Land Grading.	
3. Runoff from the stockpile area must drain to a suitable sediment control practice.	
4. Access the stockpile area from the upgrade side.	
5. Clear water runoff into the stockpile area must be minimized by use of a diversion device such as an earth dike, temporary swale or diversion fence. Provisions must be made for discharging concentrated flow in a non-erosive manner.	
6. Where runoff concentrates along the toe of the stockpile fill, an appropriate erosion/sediment control practice must be used to intercept the discharge.	
7. Stockpiles must be stabilized in accordance with the 3/7 day stabilization requirement as well as Standard B-4-1 Incremental Stabilization and Standard B-4-4 Temporary Stabilization.	
8. If the stockpile is located on an impervious surface, a liner should be provided below the stockpile to facilitate cleanup. Stockpiles containing contaminated material must be covered with impermeable sheeting.	
Maintenance	
The stockpile area must continuously meet the requirements for Adequate Vegetative Establishment in accordance with Section B-4 Vegetative Stabilization. Side slopes must be maintained at no steeper than a 2:1 ratio. The stockpile area must be kept free of erosion. If the vertical height of a stockpile exceeds 20 feet for 2:1 slopes, 30 feet for 3:1 slopes, or 40 feet for 4:1 slopes, benching must be provided in accordance with Section B-3 Land Grading.	

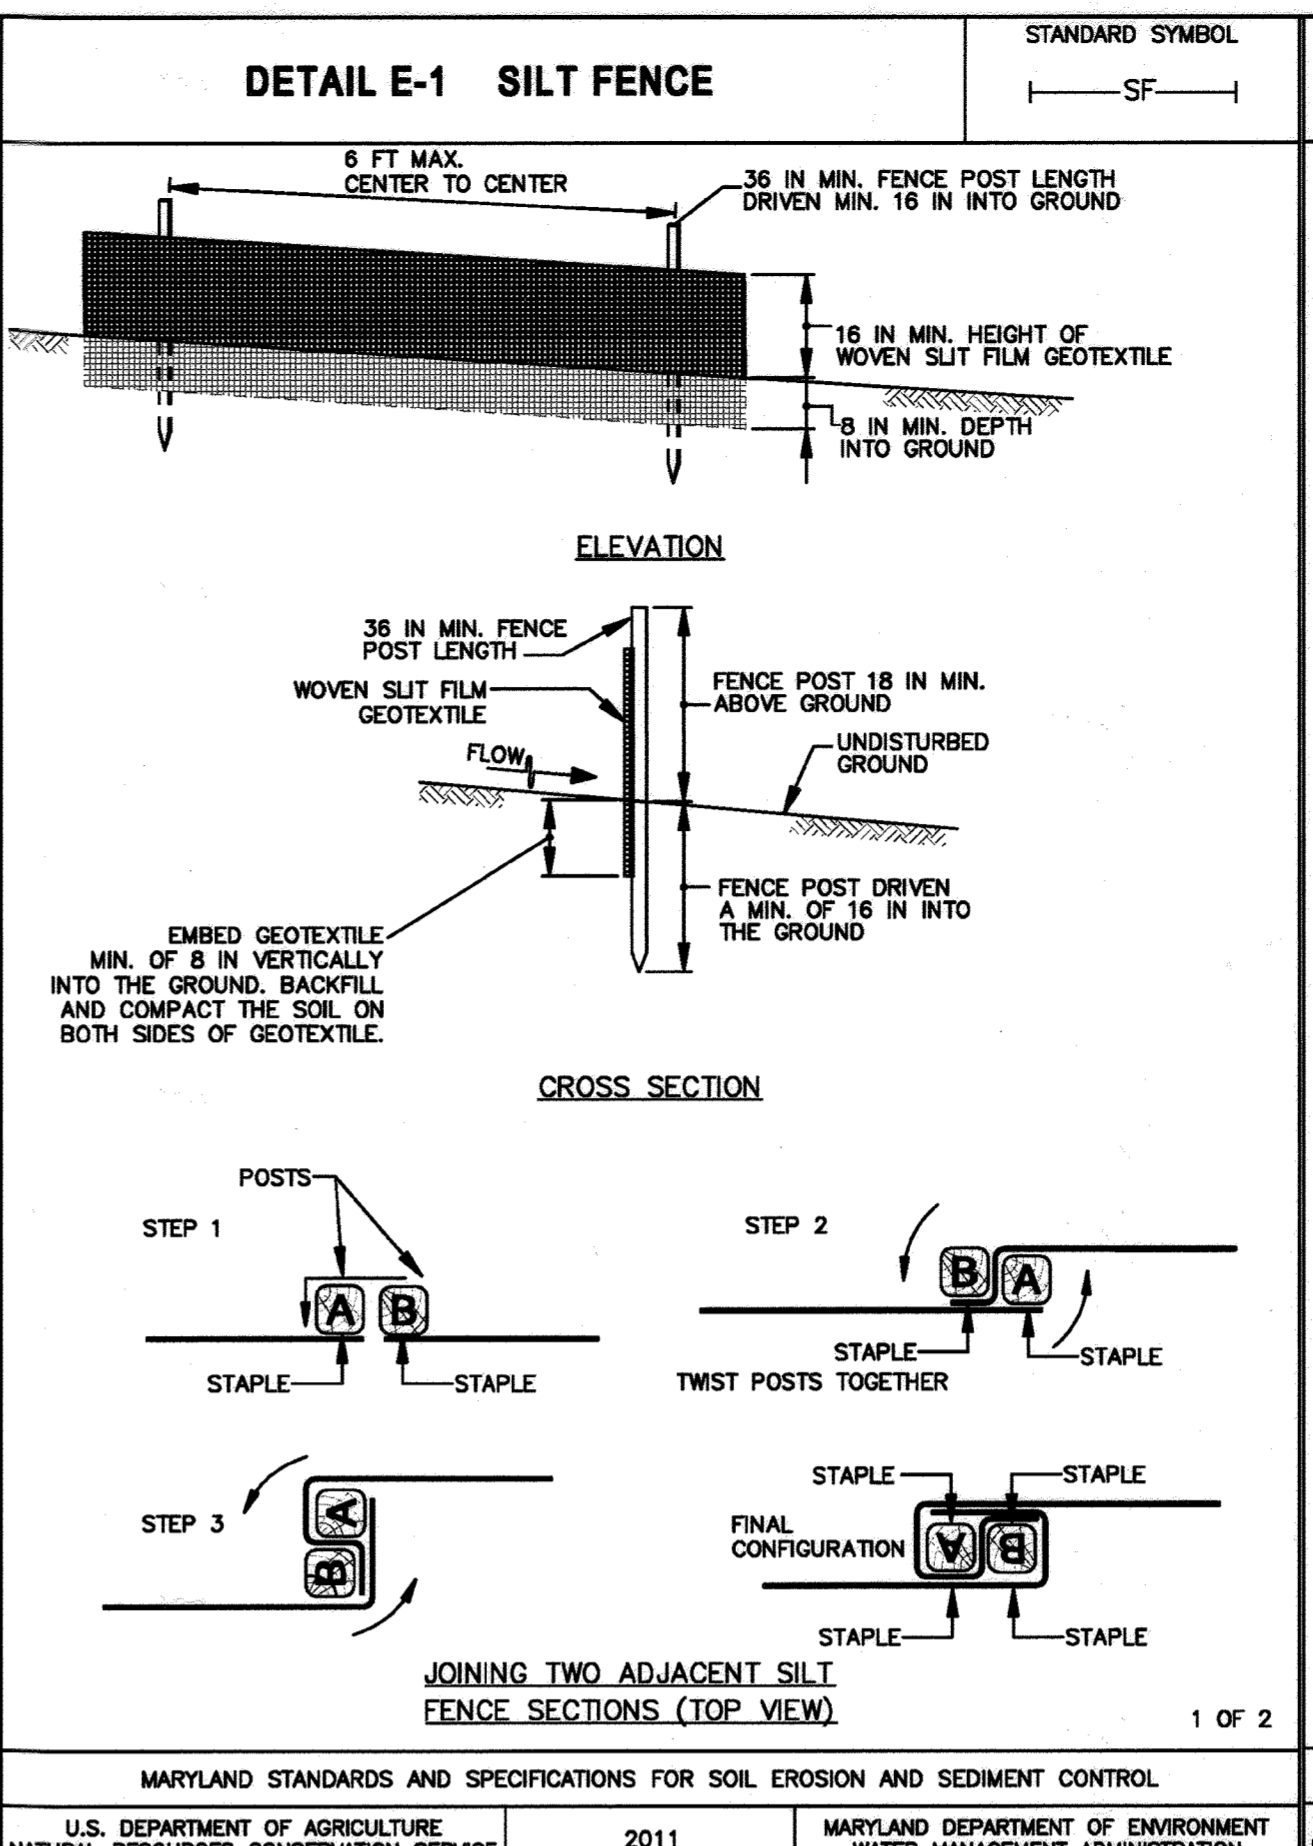

DETAIL E-1 SILT FENCE	
CONSTRUCTION SPECIFICATIONS	
1. USE WOOD POSTS 1 1/2 x 1 1/2 INCH (MINIMUM) SQUARE CUT OF SOUND QUALITY HARDWOOD. AS AN ALTERNATIVE TO WOODEN POST USE STANDARD "T" OR "U" SECTION STEEL POSTS WEIGHING NOT LESS THAN 1 POUND PER LINEAR FOOT.	
2. USE 36 INCH MINIMUM POSTS DRIVEN 16 INCH MINIMUM INTO GROUND NO MORE THAN 6 FEET APART.	
3. USE WOVEN SLIT FILM GEOTEXTILE AS SPECIFIED IN SECTION H-1 MATERIALS AND FASTEN GEOTEXTILE SECURELY TO UPSLOPE SIDE OF FENCE POSTS WITH WIRE TIES OR STAPLES AT TOP AND MID-SECTION.	
4. PROVIDE MANUFACTURER CERTIFICATION TO THE AUTHORIZED REPRESENTATIVE OF THE INSPECTION/ENFORCEMENT AUTHORITY SHOWING THAT THE GEOTEXTILE USED MEETS THE REQUIREMENTS IN SECTION H-1 MATERIALS.	
5. EMBED GEOTEXTILE A MINIMUM OF 8 INCHES VERTICALLY INTO THE GROUND. BACKFILL AND COMPACT THE SOIL ON BOTH SIDES OF FABRIC.	
6. WHERE TWO SECTIONS OF GEOTEXTILE ADJOIN: OVERLAP, TWIST, AND STAPLE TO POST IN ACCORDANCE WITH THIS DETAIL.	
7. EXTEND BOTH ENDS OF THE SILT FENCE A MINIMUM OF FIVE HORIZONTAL FEET UPSLOPE AT 45 DEGREES TO THE MAIN FENCE ALIGNMENT TO PREVENT RUNOFF FROM GOING AROUND THE ENDS OF THE SILT FENCE.	
8. REMOVE ACCUMULATED SEDIMENT AND DEBRIS WHEN BULGES DEVELOP IN SILT FENCE OR WHEN SEDIMENT REACHES 25% OF FENCE HEIGHT. REPLACE GEOTEXTILE IF TORN. IF UNDERMINING OCCURS, REINSTALL FENCE.	

B.21

rapid establishment is necessary and when turf will receive medium to intensive management. Certified Perennial Ryegrass Cultivars/Certified Kentucky Bluegrass Seeding Rate: 2 pounds mixture per 1000 square feet. Choose a minimum of three Kentucky bluegrass cultivars with each ranging from 10 to 35 percent of the total mixture by weight.

iii. Tall Fescue/Kentucky Bluegrass: Full Sun Mixture: For use in drought prone areas and/or for areas receiving low to medium management in full sun to medium shade. Recommended mixture includes: Certified Tall Fescue Cultivars 95 to 100 percent, Certified Kentucky Bluegrass Cultivars 0 to 5 percent. Seeding Rate: 5 to 8 pounds per 1000 square feet. One or more cultivars may be blended.

iv. Kentucky Bluegrass/Fine Fescue: Shade Mixture: For use in areas with shade in Bluegrass lawns. For establishment in high quality, intensively managed turf area. Mixture includes: Certified Kentucky Bluegrass Cultivars 30 to 40 percent and Certified Fine Fescue and 60 to 70 percent. Seeding Rate: 1 1/2 to 3 pounds per 1000 square feet.

Notes: Select turfgrass varieties from those listed in the most current University of Maryland Publication, Agronomy Memo #77, "Turfgrass Cultivar Recommendations for Maryland"

Choose certified material. Certified material is the best guarantee of cultivar purity. The certification program of the Maryland Department of Agriculture, Turf and Seed Section provides a reliable means of consumer protection and assures a pure genetic line

c. Ideal Times of Seeding for Turf Grass Mixtures

Western MD: March 15 to June 1, August 1 to October 1 (Hardiness Zones: 5b, 6a)

Central MD: March 1 to May 15, August 15 to October 15 (Hardiness Zone: 6b)

Southern MD, Eastern Shore: March 1 to May 15, August 15 to October 15 (Hardiness Zones: 7a, 7b)




d. Till areas to receive seed by disking or other approved methods to a depth of 2 to 4 inches, level and rake the areas to prepare a proper seedbed. Remove stones and debris over 1 1/2 inches in diameter. The resulting seedbed must be in such condition that future mowing of grasses will pose no difficulty.

e. If soil moisture is deficient, supply new seedlings with adequate water for plant growth (1/2 to 1 inch every 3 to 4 days depending on soil texture) until they are firmly established. This is especially true when seedlings are made late in the planting season, in abnormally dry or hot seasons, or on adverse sites.

B.23

3. Sod Maintenance

- In the absence of adequate rainfall, water daily during the first week or as often and sufficiently as necessary to maintain moist soil to a depth of 4 inches. Water sod during the heat of the day to prevent wilting.
- After the first week, sod watering is required as necessary to maintain adequate moisture content.
- Do not mow until the sod is firmly rooted. No more than 1/2 of the grass leaf must be removed by the initial cutting or subsequent cuttings. Maintain a grass height of at least 3 inches unless otherwise specified.

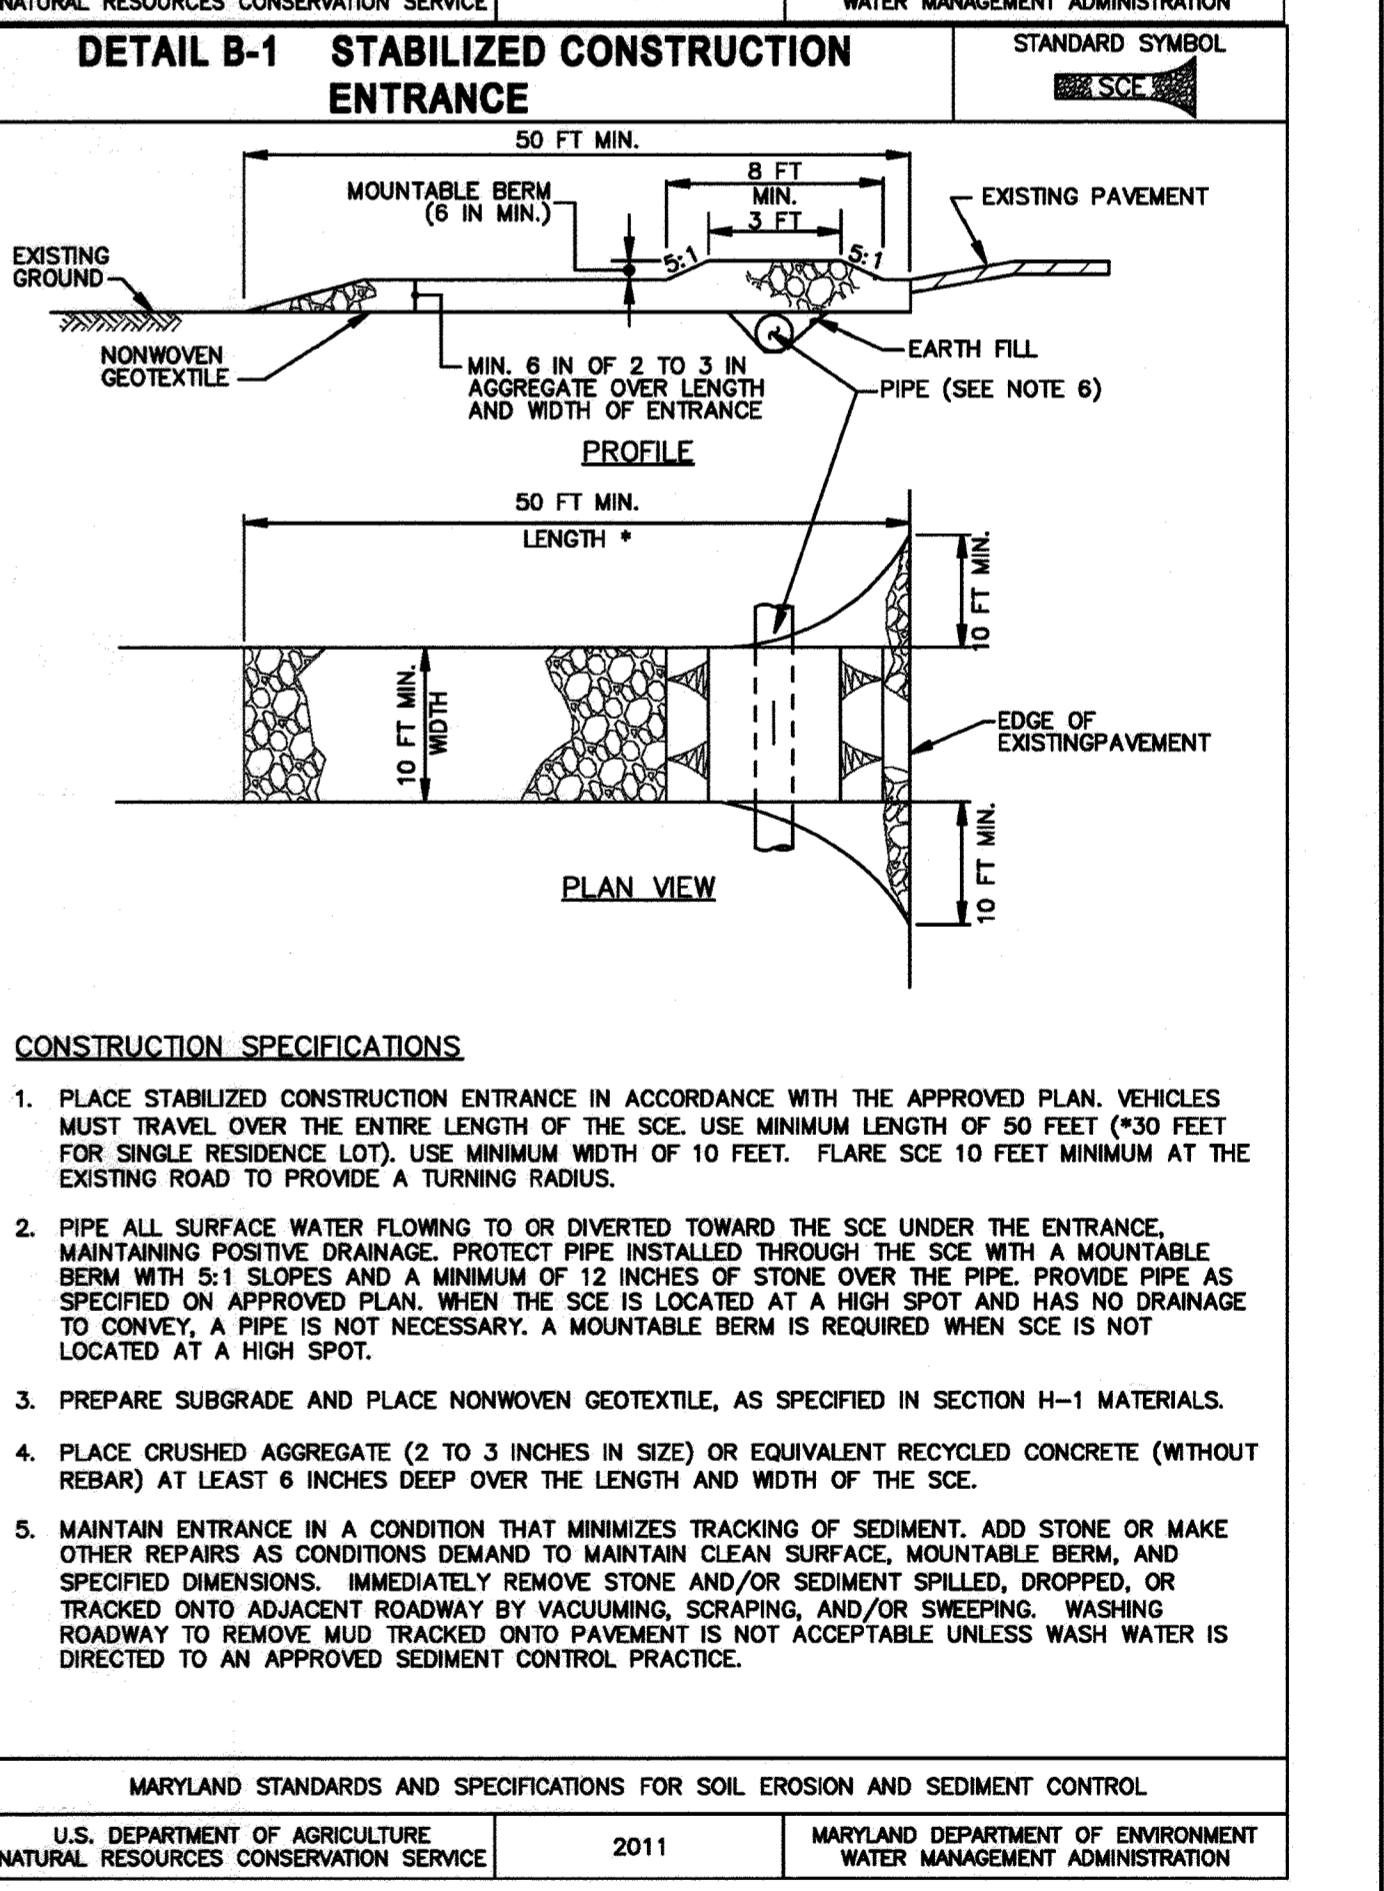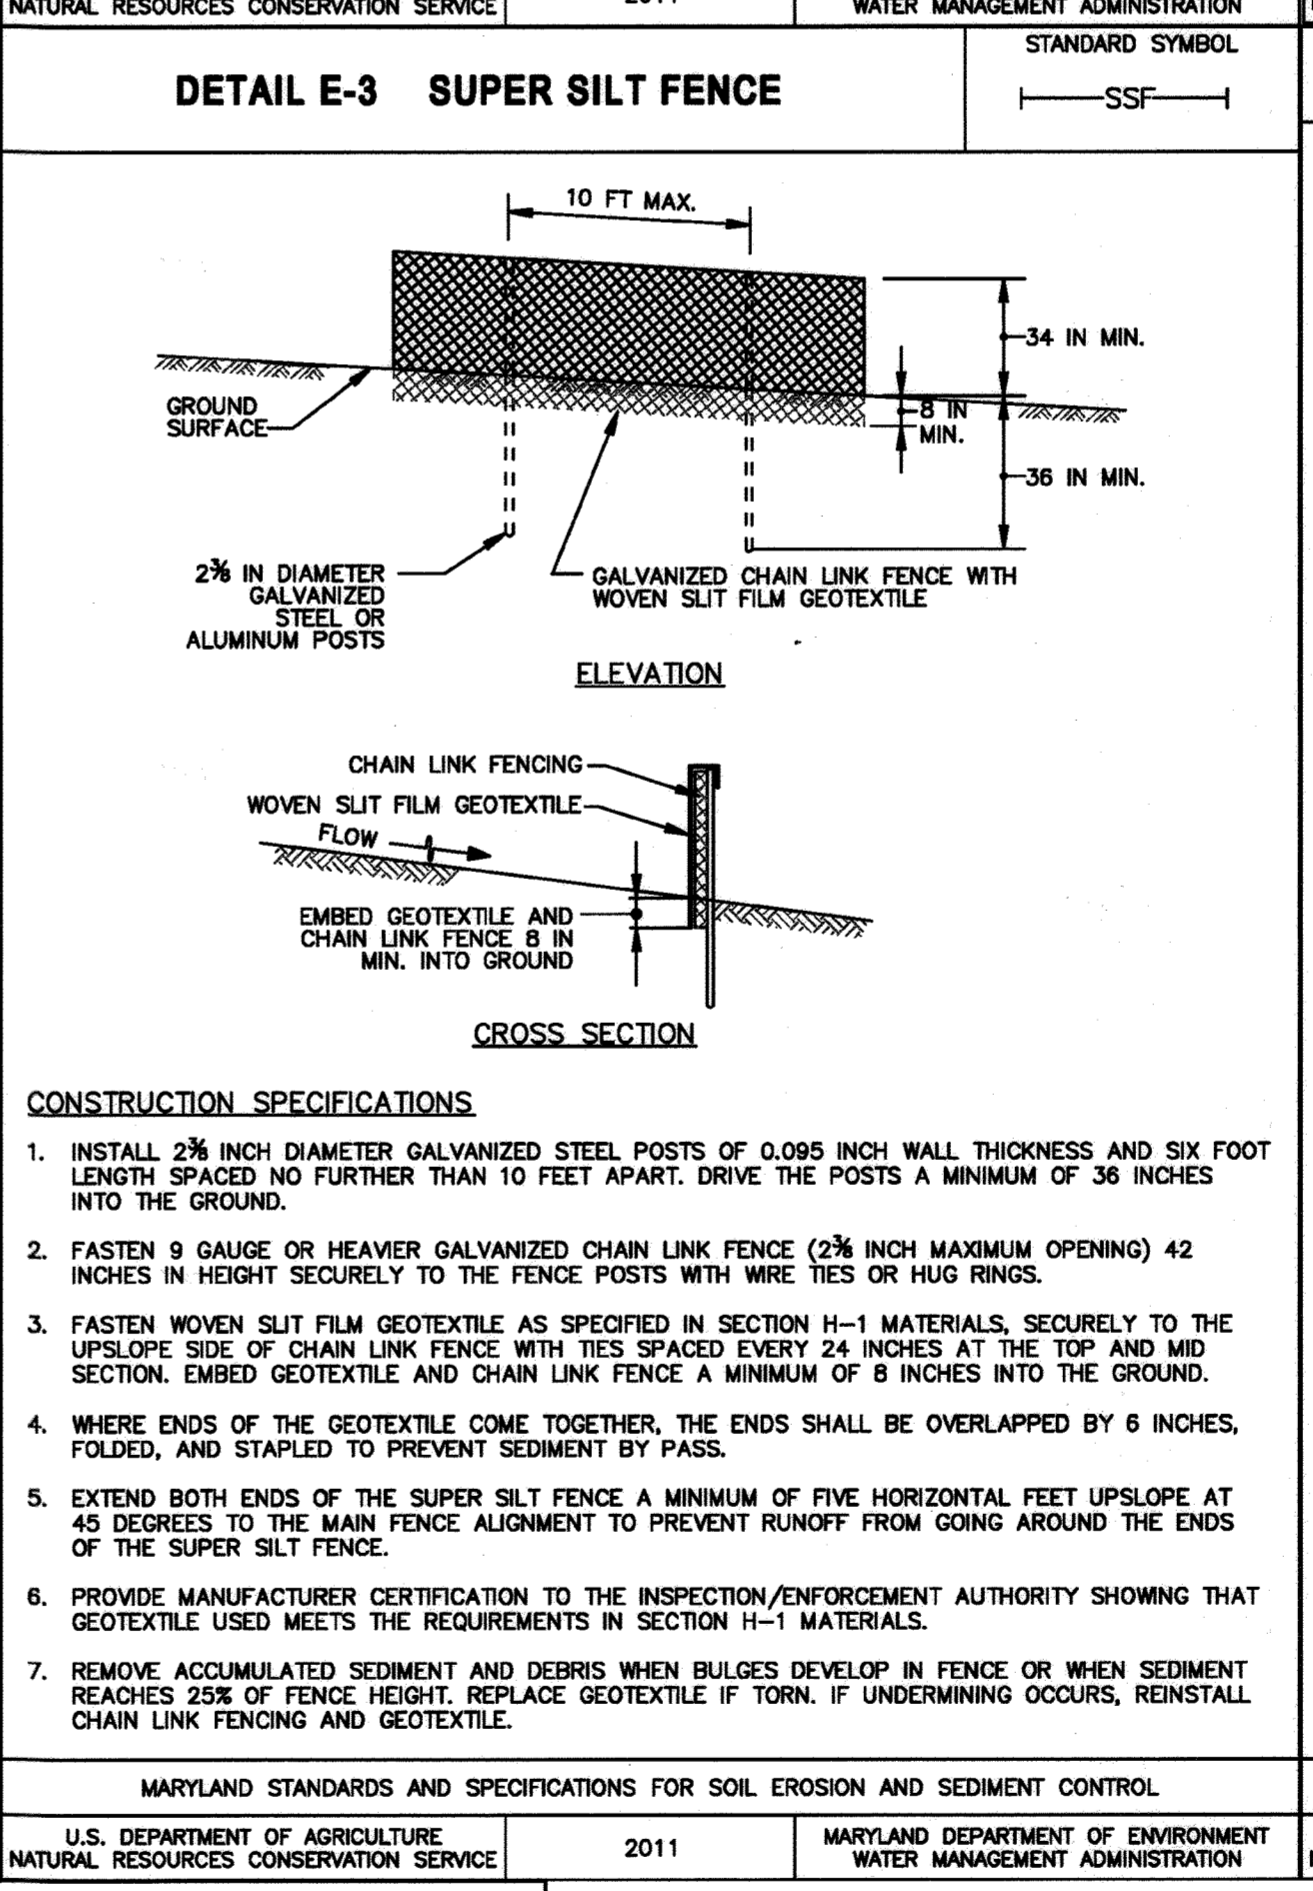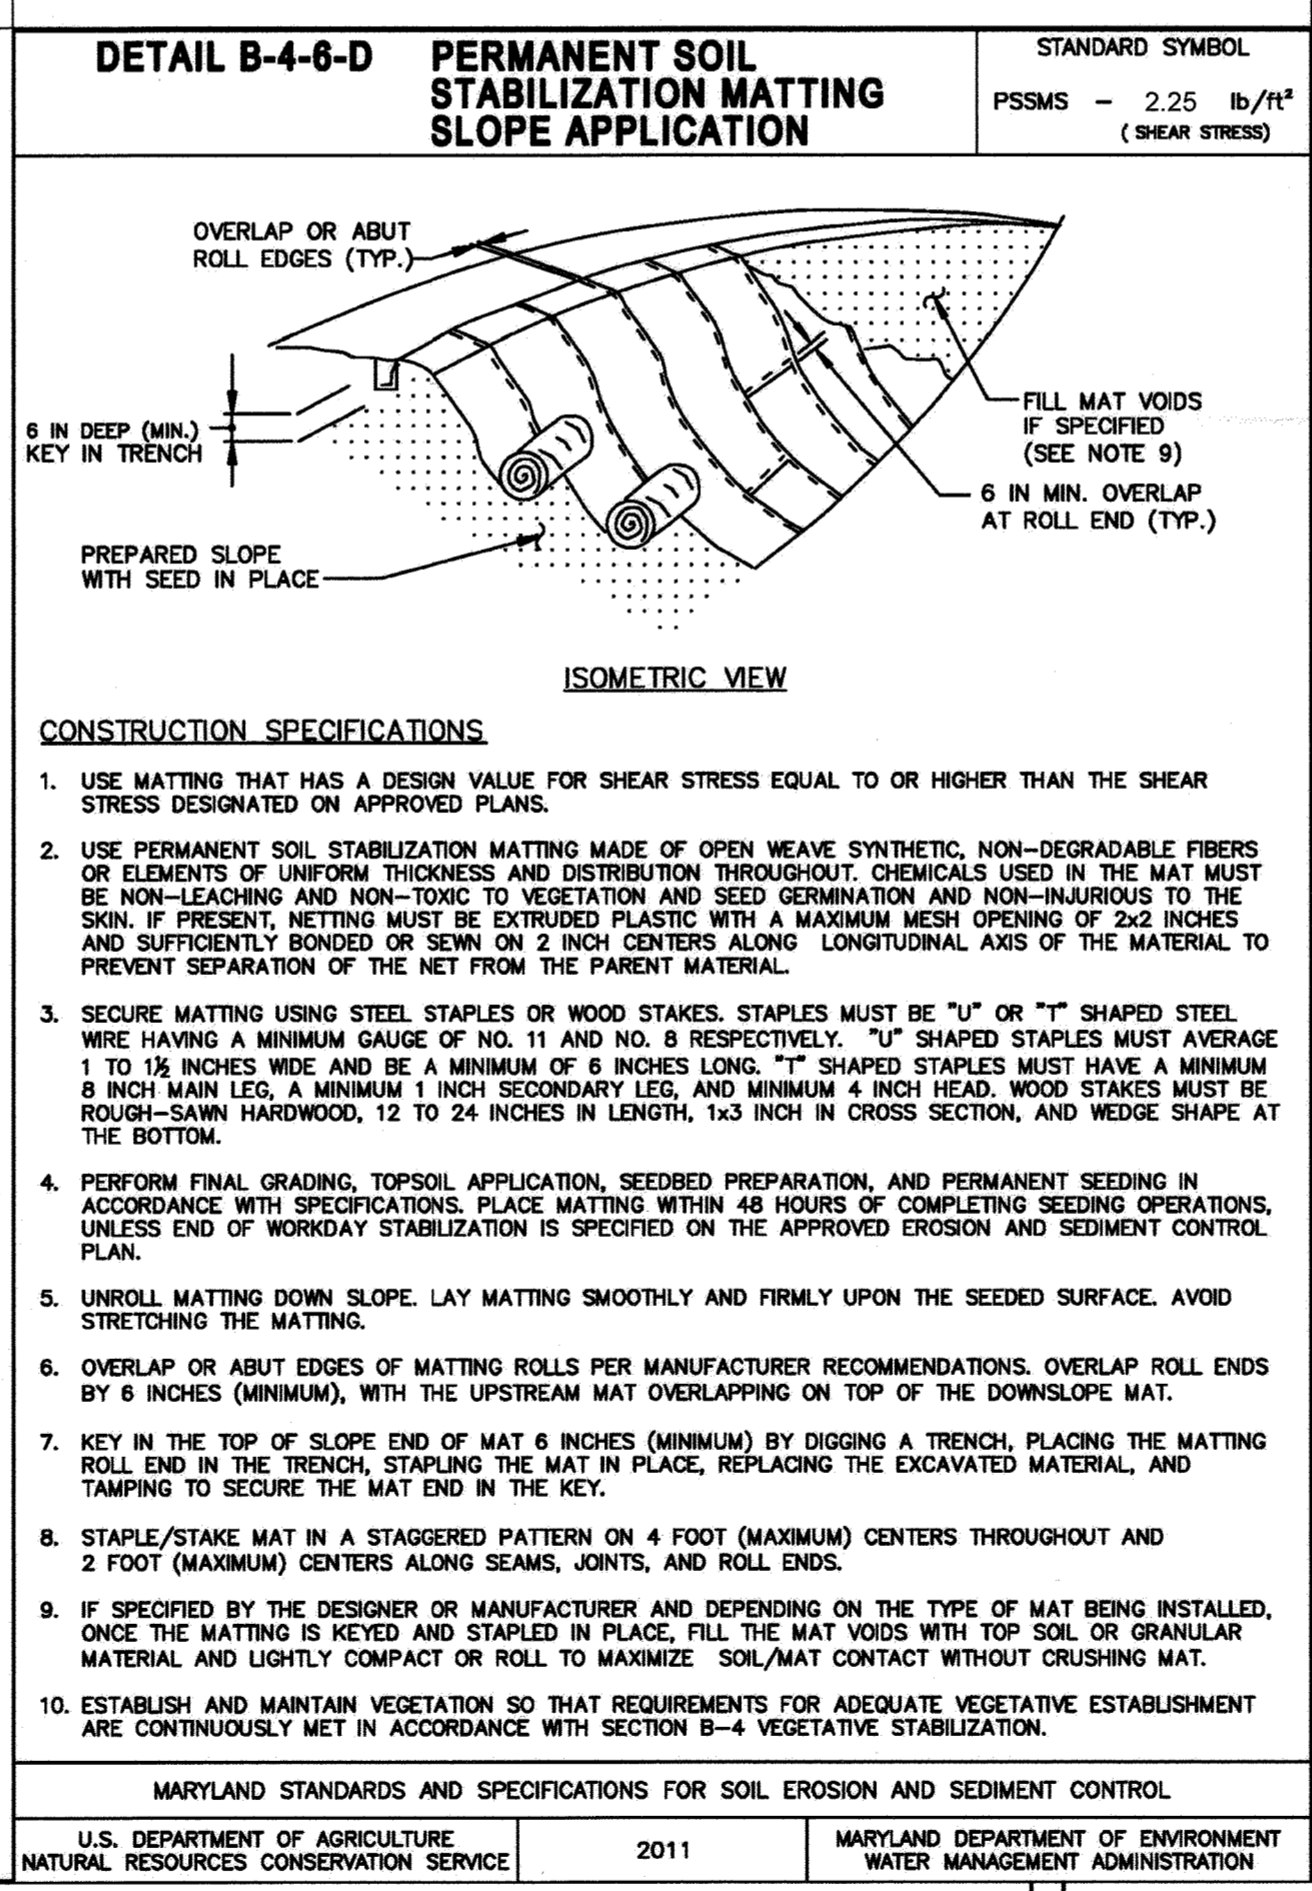

HOWARD COUNTY DEPARTMENT OF PLANNING AND ZONING APPROVED

CHIEF, LAND DEVELOPMENT: *[Signature]* 6/21/22 DATE

CHIEF, DEVELOPMENT ENGINEERING DIVISION: *[Signature]* 6/22/22 DATE

DIRECTOR OF PLANNING AND ZONING: *[Signature]* 6/22/22 DATE

Owners/Developer Certification:

"I hereby certify that any clearing, grading, construction, or development will be done pursuant to this approved erosion and sediment control plan, including inspecting and maintaining controls, and that the responsible personnel involved in the construction project will have a Certificate of Training at a Maryland Department of the Environment (MDE) approved training program for the control on erosion and sediment prior to beginning the project. I certify right-of-entry for the periodic on-site evaluation by Howard County, the Howard Soil Conservation District and/or MDE."

*[Signature]* 5/17/22 DATE

Arthur Blume - President  
Printed Name & Title: ARTHUR BLUME - PRESIDENT, 025-802

Design Certification:

"I hereby certify that this plan has been designed in accordance with the current Maryland erosion and sediment control laws, regulations, and standards, that it represents a practical and workable plan based on my personal knowledge of the site, and that it was prepared in accordance with the requirements of the Howard Soil Conservation District."

*[Signature]* 3/28/22 DATE

Charles T. Grimsley, P.E.  
Printed Name: Charles T. Grimsley, P.E., MD P.E. Registration No. 11124

Howard SCD Signature Block:

"This plan is approved for soil erosion and sediment control by the Howard Soil Conservation District."

*[Signature]* 06/06/22 DATE

Alexander Botalchi  
Howard Soil Conservation District

PROFESSIONAL CERTIFICATION

I HEREBY CERTIFY THAT THESE DOCUMENTS WERE PREPARED OR APPROVED BY ME AND THAT I AM A DULY LICENSED PROFESSIONAL ENGINEER UNDER THE LAWS OF THE STATE OF MARYLAND, LICENSE NO. 11124, EXPIRATION DATE: OCTOBER 3, 2022.

*[Signature]* 3/28/22 DATE

THOMAS G. ... PROFESSIONAL ENGINEER

THIS IS A NEW SHEET OF EROSION AND SEDIMENT CONTROL NOTES AND DETAILS TO SUPPORT THE CONSTRUCTION OF STREAM RESTORATION IMPROVEMENTS.

OWNER-DEVELOPER

WHISKEY BOTTOM CONDOMINIUMS, ASSOC.  
c/o MR. ARTHUR F. BLUME, PRESIDENT  
WHISKEY BOTTOM SOUTH, BOARD OF DIRECTORS  
9220 BRIDLE PATH LANE, UNIT F  
LAUREL, MD. 20723

LANDMARK ENGINEERING, INC.

13722 LAMBERTINA PLACE  
ROCKVILLE, MARYLAND 20850  
CONSULTING ENGINEERS PLANNERS SURVEYORS

PHONE: (301) 230-5881  
FAX: (301) 230-5884

SECTION TWO

WHISKEY BOTTOM APARTMENTS

SIXTH ELECTION DISTRICT, HOWARD COUNTY, MARYLAND

SITE DEVELOPMENT PLAN

STREAM STABILIZATION

SEDIMENT AND EROSION CONTROL NOTES & DETAILS

REVISIONS

3	ESC TO SUPPORT STREAM STABILIZATION REPLACES SHEET S-14 OF PRIOR SDP PLAN SET.	03/28/2022
---	--	------------

DRN: DCV CK: CTG  
PROJECT NO.: 1530  
SCALE: AS SHOWN  
DATE: MAR. 28, 2022

DRAWING NO. S-23 OF 24

SDP-72-84

**F-4 STANDARDS AND SPECIFICATIONS**

**FOR  
FILTER BAG**

**Definition**

A geotextile bag through which sediment-laden water is pumped.

**Purpose**

To filter sediment-laden water prior to discharge.

**Conditions Where Practice Applies**

When dewatering is needed in association with excavations, trenches, cofferdams, sediment traps or basins.

**Design Criteria**


The filter bag should be placed in a location that allows for ease of disposal of the trapped sediment and has minimal interference with construction activities and pedestrian traffic.

**Maintenance**

If the filter bag clogs, it needs to be replaced. Rips, tears, and punctures also necessitate replacement of the filter bag. The connection between the pump hose and the filter bag needs to be kept water tight during operation. If the bedding becomes displaced, it must be replaced.

**DETAIL F-4 FILTER BAG**

STANDARD SYMBOL  
☒FB

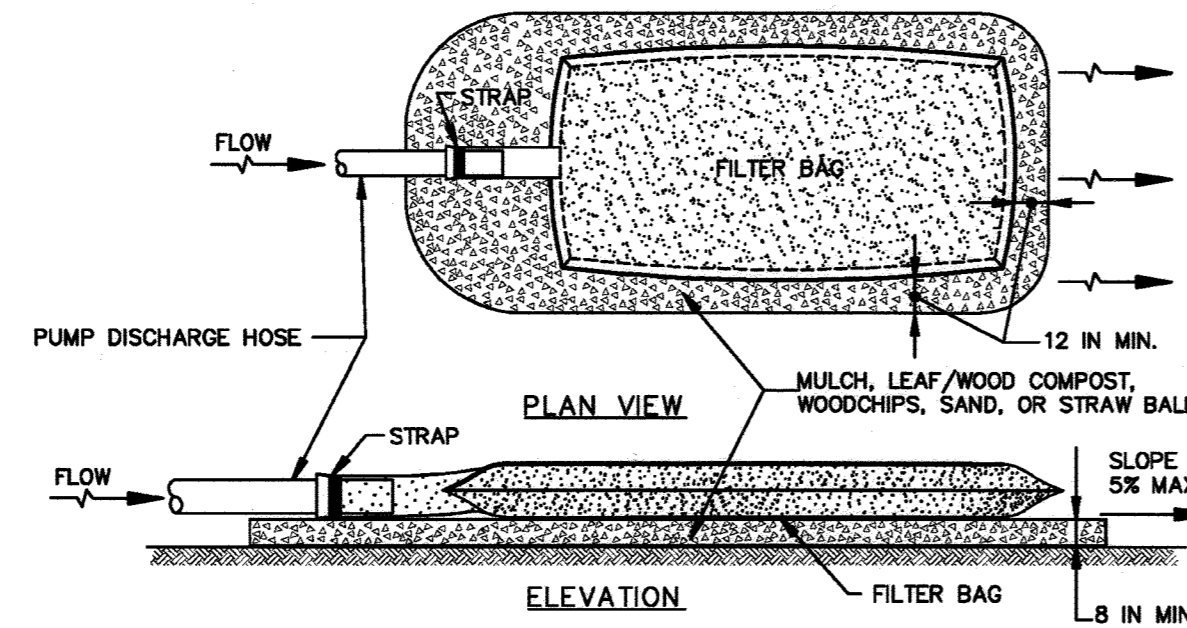

**CONSTRUCTION SPECIFICATIONS**

- TIGHTLY SEAL SLEEVE AROUND THE PUMP DISCHARGE HOSE WITH A STRAP OR SIMILAR DEVICE.
- PLACE FILTER BAG ON SUITABLE BASE (E.G., MULCH, LEAF/WOOD COMPOST, WOODCHIPS, SAND, OR STRAW BALES) LOCATED ON A LEVEL OR 5% MAXIMUM SLOPING SURFACE DISCHARGE TO A STABILIZED AREA. EXTEND BASE A MINIMUM OF 12 INCHES FROM EDGES OF BAG.
- CONTROL PUMPING RATE TO PREVENT EXCESSIVE PRESSURE WITHIN THE FILTER BAG IN ACCORDANCE WITH THE MANUFACTURER RECOMMENDATIONS. AS THE BAG FILLS WITH SEDIMENT, REDUCE STAMPING RATE.
- REMOVE AND PROPERLY DISPOSE OF FILTER BAG UPON COMPLETION OF PUMPING OPERATIONS OR AFTER BAG HAS REACHED CAPACITY, WHICHEVER OCCURS FIRST. SPREAD THE DEWATERED SEDIMENT FROM THE BAG IN AN APPROVED UPLAND AREA AND STABILIZE WITH SEED AND MULCH BY THE END OF THE WORK DAY. RESTORE THE SURFACE AREA BENEATH THE BAG TO ORIGINAL CONDITION UPON REMOVAL OF THE DEVICE.
- USE NONWOVEN GEOTEXTILE WITH DOUBLE STITCHED SEAMS USING HIGH STRENGTH THREAD. SIZE SLEEVE TO ACCOMMODATE A MAXIMUM 4 INCH DIAMETER PUMP DISCHARGE HOSE. THE BAG MUST BE MANUFACTURED FROM A NONWOVEN GEOTEXTILE THAT MEETS OR EXCEEDS MINIMUM AVERAGE ROLL VALUES (MARV) FOR THE FOLLOWING:
 

GRAB TENSILE	250 LB	ASTM D-4632
PUNCTURE	150 LB	ASTM D-4833
FLOW RATE	70 GAL./MIN./FT <sup>2</sup>	ASTM D-4491
PERMITTIVITY (SEC <sup>-1</sup> )	1.2 SEC <sup>-1</sup>	ASTM D-4491
UV RESISTANCE	70% STRENGTH @ 500 HOURS	ASTM D-4355
APPARENT OPENING SIZE (AOS)	0.15-0.18 MM	ASTM D-4751
SEAM STRENGTH	90%	ASTM D-4632
- REPLACE FILTER BAG IF BAG CLOGS OR HAS RIPS, TEARS, OR PUNCTURES. DURING OPERATION KEEP CONNECTION BETWEEN PUMP HOSE AND FILTER BAG WATER TIGHT. REPLACE BEDDING IF IT BECOMES DISPLACED.

MARYLAND STANDARDS AND SPECIFICATIONS FOR SOIL EROSION AND SEDIMENT CONTROL		
U.S. DEPARTMENT OF AGRICULTURE NATURAL RESOURCES CONSERVATION SERVICE	2011	MARYLAND DEPARTMENT OF ENVIRONMENT WATER MANAGEMENT ADMINISTRATION

F.8

**BEST MANAGEMENT PRACTICES FOR WORKING IN  
NONTIDAL WETLANDS, WETLAND BUFFERS,  
WATERWAYS AND 100-YEAR FLOODPLAINS**

- No excess fill, construction material, or debris shall be stockpiled or stored in nontidal wetlands, nontidal wetland buffers, waterways, or the 100-year floodplain.
- Place materials in a location and manner which does not adversely impact surface or subsurface water flow into or out of nontidal wetlands, nontidal wetland buffers, waterways, or the 100-year floodplain.
- Do not use the excavated material as backfill if it contains waste metal products, unsightly debris, toxic material, or any other deleterious substance. If additional backfill is required, use clean material free of waste metal products, unsightly debris, toxic material, or any other deleterious substance.
- Place heavy equipment on mats or suitably operate the equipment to prevent damage to nontidal wetlands, nontidal wetland buffers, waterways, or the 100-year floodplain.
- Repair and maintain any serviceable structure or fill so there is no permanent loss of nontidal wetlands, nontidal wetland buffers, or waterways, or permanent modification of the 100-year floodplain in excess of that lost under the originally authorized structure or fill.
- Rectify any nontidal wetlands, wetland buffers, waterways, or 100-year floodplain temporarily impacted by any construction.
- All stabilization in the nontidal wetland and nontidal wetland buffer shall consist of the following species: Annual Ryegrass (*Lolium multiflorum*), Millet (*Schizanthus*), Barley (*Hordeum sp.*), Oats (*Avena sp.*), and/or Rye (*Scaevola*). These species will allow for the stabilization of the site while also allowing for the voluntary revegetation of natural wetland species. Other non-persistent vegetation may be acceptable, but must be approved by the Nontidal Wetlands and Waterways Division. Kentucky 31 fescue shall not be utilized in wetland or buffer areas. The area should be seeded and mulched to reduce erosion after construction activities have been completed.
- After installation has been completed, make post-construction grades and elevations the same as the original grades and elevations in temporarily impacted areas.
- To protect aquatic species, in-stream work is prohibited as determined by the classification of the stream:
  - Use I waters: In-stream work shall not be conducted during the period March 1 through June 15, inclusive, during any year.
  - Use III waters: In-stream work shall not be conducted during the period October 1 through April 30, inclusive, during any year.
  - Use IV waters: In-stream work shall not be conducted during the period March 1 through May 31, inclusive, during any year.
- Stormwater runoff from impervious surfaces shall be controlled to prevent the washing of debris into the waterway.
- Culverts shall be constructed and any riprap placed so as not to obstruct the movement of aquatic species, unless the purpose of the activity is to impound water.

**MGWC 1.2: PUMP-AROUND PRACTICE**



**DESCRIPTION**

The work should consist of installing a temporary pump around and supporting measures to divert flow around in-stream construction sites.

**IMPLEMENTATION SEQUENCE**

Sediment control measures, pump-around practices, and associated channel and bank construction should be completed in the following sequence (refer to Detail 1.2):


- Construction activities including the installation of erosion and sediment control measures should not begin until all necessary easements and/or rights-of-ways have been acquired. All existing utilities should be marked in the field prior to construction. The contractor is responsible for any damage to existing utilities that may result from construction and should repair the damage at his/her own expense to the county's or utility company's satisfaction.
- The contractor should notify the Maryland Department of the Environment or WMA sediment control inspector at least 5 days before beginning construction. Additionally, the contractor should inform the local environmental protection and resource management inspection and enforcement division and the provider of local utilities a minimum of 48 hours before starting construction.
- The contractor should conduct a pre-construction meeting on site with the WMA sediment control inspector, the county project manager, and the engineer to review limits of disturbance, erosion and sediment control requirements, and the sequence of construction. The contractor should take out all limits of disturbance prior to the pre-construction meeting so they may be reviewed. The participants will also designate the contractor's staging areas and flag all trees within the limit of disturbance which will be removed for construction access. Trees should not be removed within the limit of disturbance without approval from the WMA or local authority.
- Construction should not begin until all sediment and erosion control measures have been installed and approved by the engineer and the sediment control inspector. The contractor should stay within the limits of the disturbance as shown on the plans and minimize disturbance within the work area whenever possible.
- Upon installation of all sediment control measures and approval by the sediment control inspector and the local environmental protection and resource management inspection and enforcement division, the contractor should begin work at the upstream section and proceed downstream beginning with the establishment of stabilized construction entrances. In some cases, work may begin downstream if appropriate. The sequence of construction must be followed unless the contractor gets written approval for deviations from the WMA or local authority. The contractor should only begin work in an area which can be completed by the end of the day including grading adjacent to the channel. At the end of each work day, the work area must be stabilized and the pump around removed from the channel. Work should not be conducted in the channel during rain events.
- Sandbag dikes should be situated at the upstream and downstream ends of the work area as shown on the plans, and stream flow should be pumped around the work area. The pump should discharge onto a stable velocity dissipater made of riprap or sandbags.

**MGWC 1.2: PUMP-AROUND PRACTICE**


- Water from the work area should be pumped to a sediment filtering measure such as a dewatering basin, sediment bag, or other approved source. The measure should be located such that the water drains back into the channel below the downstream sandbag dike.
- Traversing a channel reach with equipment within the work area where no work is proposed should be avoided. If equipment has to traverse such a reach for access to another area, then timber mats or similar measures should be used to minimize disturbance to the channel. Temporary stream crossings should be used only when necessary and only where noted on the plans or specified. (See Section 4, Stream Crossings, Maryland Guidelines to Waterway Construction).
- All stream restoration measures should be installed as indicated by the plans and all banks graded in accordance with the grading plans and typical cross-sections. All grading must be stabilized at the end of each day with seed and mulch or seed and matting as specified on the plans.
- After an area is completed and stabilized, the clean water dike should be removed. After the first sediment flush, a new clean water dike should be established upstream from the old sediment dike. Finally, upon establishment of a new sediment dike below the old one, the old sediment dike should be removed.
- A pump around must be installed on any tributary or storm drain outfall which contributes baseflow to the work area. This should be accomplished by locating a sandbag dike at the downstream end of the tributary or storm drain outfall and pumping the stream flow around the work area. This water should discharge onto the same velocity dissipater used for the main stem pump around.
- If a tributary is to be restored, construction should take place on the tributary before work on the main stem reaches the tributary confluence. Construction in the tributary, including pump around practices, should follow the same sequence as for the main stem of the river or stream. When construction on the tributary is completed, work on the main stem should resume. Water from the tributary should continue to be pumped around the work area in the main stem.
- The contractor is responsible for providing access to and maintaining all erosion and sediment control devices until the sediment control inspector approves their removal.
- After construction, all disturbed areas should be regraded and revegetated as per the planting plan.

**Maryland's Guidelines To Waterway Construction  
DETAIL 1.2: PUMP-AROUND PRACTICE**

**PLAN VIEW**

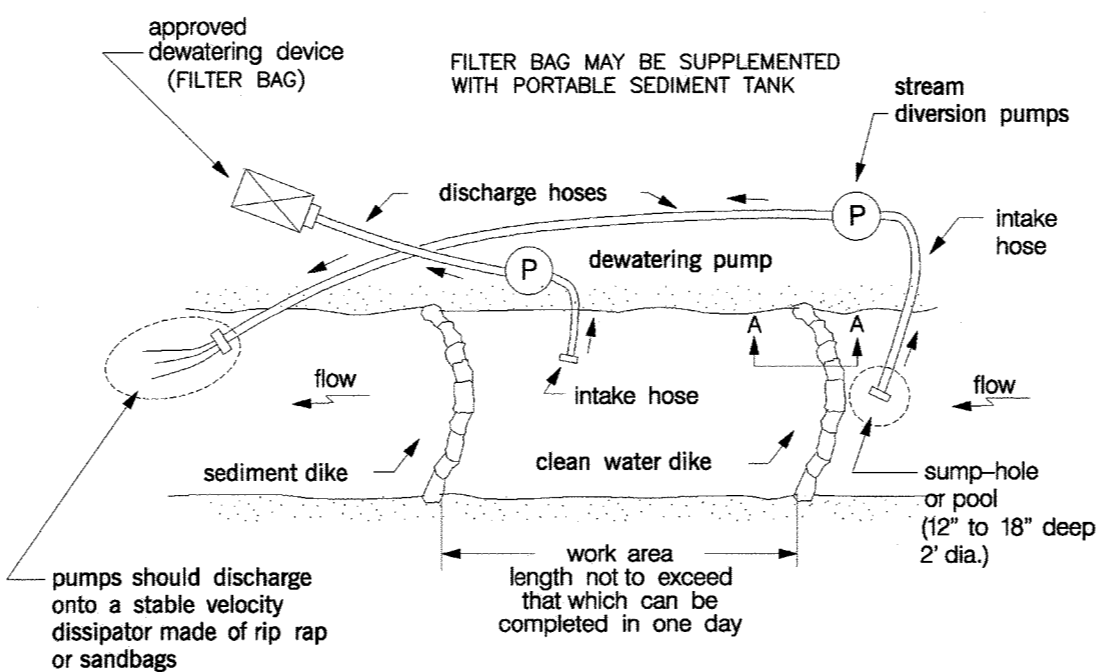

**SECTION A-A**

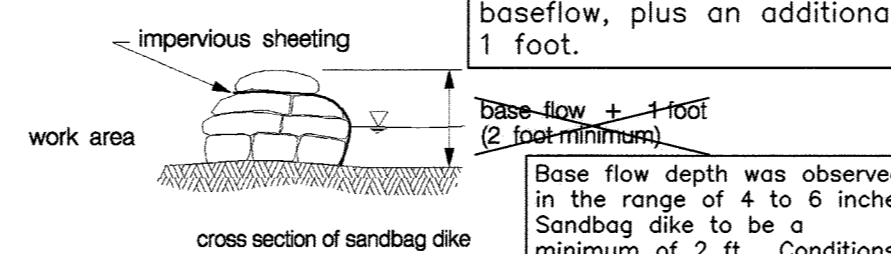

**SEE EROSION AND SEDIMENT CONTROL PLAN FOR DETAILS  
ON PUMP STATION, SUMP PIT, AND FILTRATION**

**HOWARD COUNTY DEPARTMENT OF PLANNING AND ZONING  
APPROVED**

CHIEF, LAND DEVELOPMENT 6/16/22 DATE  
CHIEF, DEVELOPMENT ENGINEERING DIVISION 6/27/22 DATE  
DIRECTOR OF PLANNING AND ZONING 6/22/22 DATE

**Owners/Developer Certification:**

"I hereby certify that any clearing, grading, construction, or development will be done pursuant to this approved erosion and sediment control plan, including inspecting and maintaining controls, and that the responsible personnel involved in the construction project will have a Certificate of Training at a Maryland Department of the Environment (MDE) approved training program for the control on erosion and sediment prior to beginning the project. I certify right-of-entry for the periodic on-site evaluation by Howard County, the Howard Soil Conservation District and/or MDE."  
Owner's/ Developer's Signature: ARTHUR BLUME - PRESIDENT  
Date: 5/17/22

**Design Certification:**

"I hereby certify that this plan has been designed in accordance with the current Maryland erosion and sediment control laws, regulations, and standards, that it represents a practical and workable plan based on my personal knowledge of the site, and that it was prepared in accordance with the requirements of the Howard Soil Conservation District."  
Designer's Signature: Charles T. Grimley  
Date: 3/28/22  
Charles T. Grimley, P.E. MD P.E. Registration No. 11124

**Howard SCD Signature Block:**

This plan is approved for soil erosion and sediment control by the Howard Soil Conservation District.  
Howard SCD Signature: Alexander Bratchki  
Date: 06/06/22

**PROFESSIONAL CERTIFICATION**

I HEREBY CERTIFY THAT THESE DOCUMENTS WERE PREPARED OR APPROVED BY ME, AND THAT I AM A DULY LICENSED PROFESSIONAL ENGINEER UNDER THE LAWS OF THE STATE OF MARYLAND, LICENSE NO. 11124, EXPIRATION DATE: OCTOBER 3, 2022.  
3/28/22  
Charles T. Grimley  
Professional Engineer  
No. 11124

OWNER-DEVELOPER  
WHISKEY BOTTOM CONDOMINIUM, ASSOC.  
c/o MR. ARTHUR F. BLUME, PRESIDENT  
WHISKEY BOTTOM SOUTH BOARD OF DIRECTORS  
9220 BRIDLE PATH LANE, UNIT F  
LAUREL, MD. 20723



**LANDMARK ENGINEERING, INC.**  
13722 LAMBERTINA PLACE PHONE: (301) 230-5881  
ROCKVILLE, MARYLAND 20850 FAX: (301) 230-5884  
CONSULTING ENGINEERS PLANNERS SURVEYORS

**SECTION TWO**  
**WHISKEY BOTTOM APARTMENTS**  
SIXTH ELECTION DISTRICT, HOWARD COUNTY, MARYLAND

**SITE DEVELOPMENT PLAN**  
**STREAM STABILIZATION**  
**SEDIMENT AND EROSION CONTROL NOTES & DETAILS**

**REVISIONS**

DRN: DCV CK: CTG  
PROJECT NO.: 1530  
SCALE: AS SHOWN  
DATE: MAR. 28, 2022

DRAWING  
NO. S-24  
OF 24