
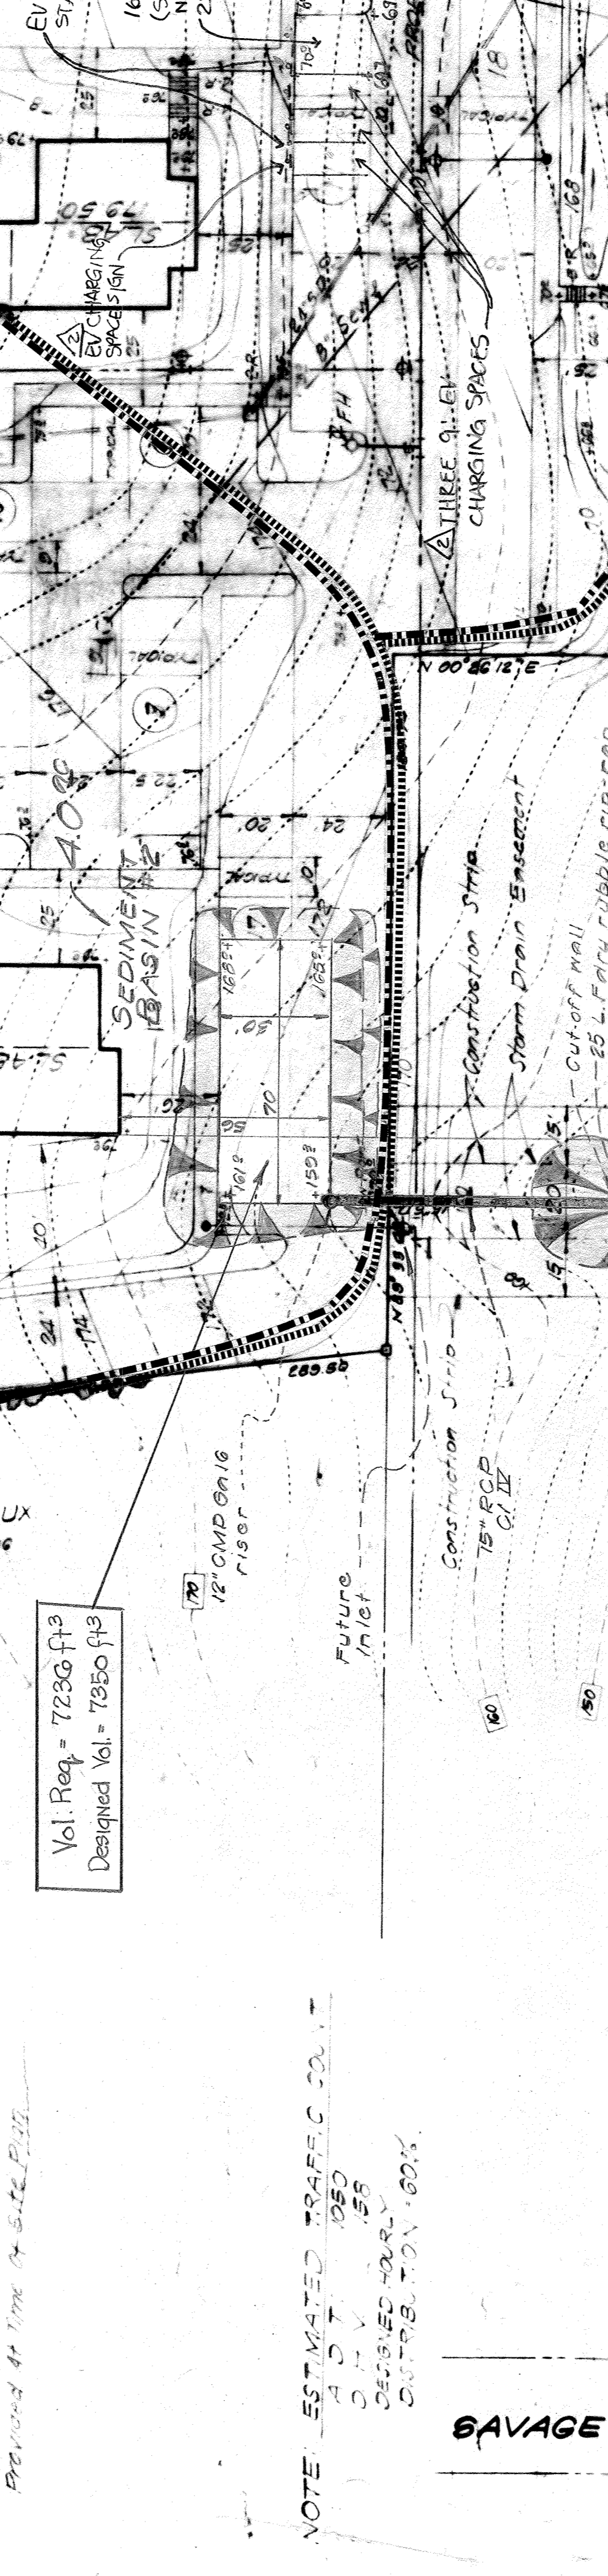
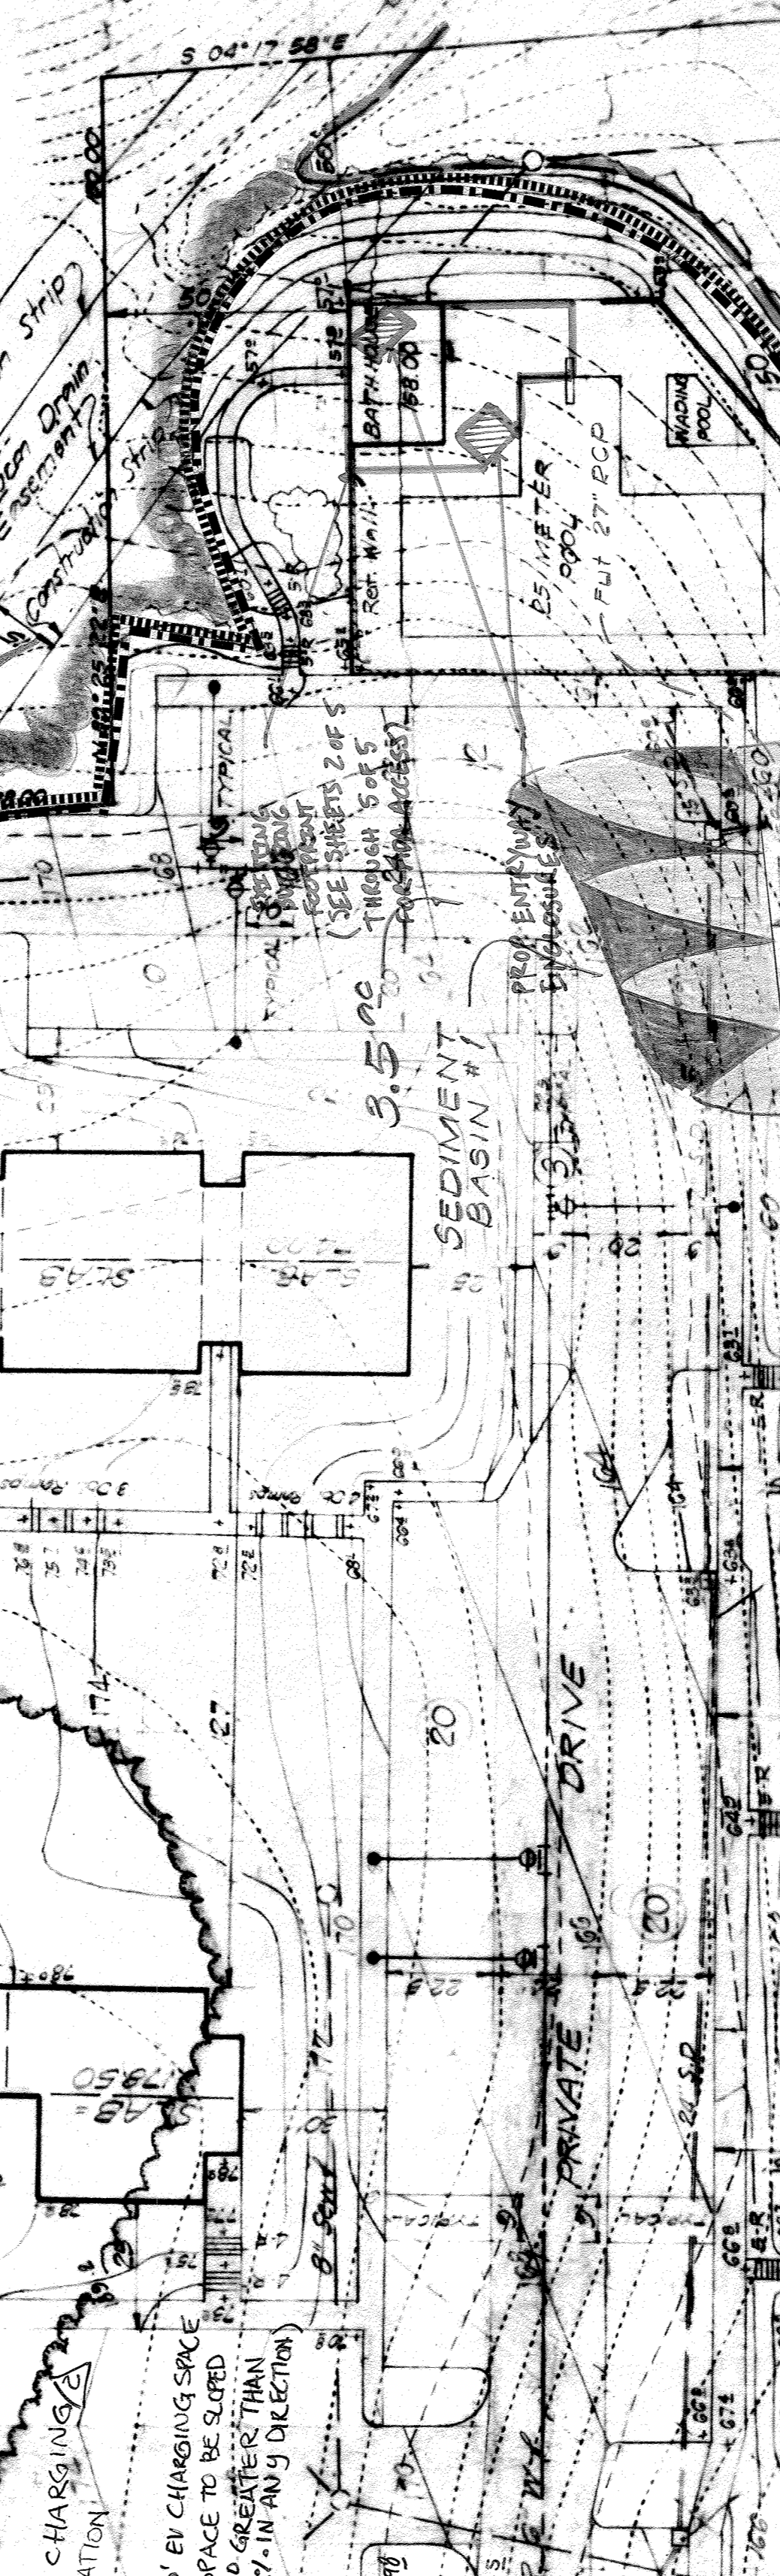
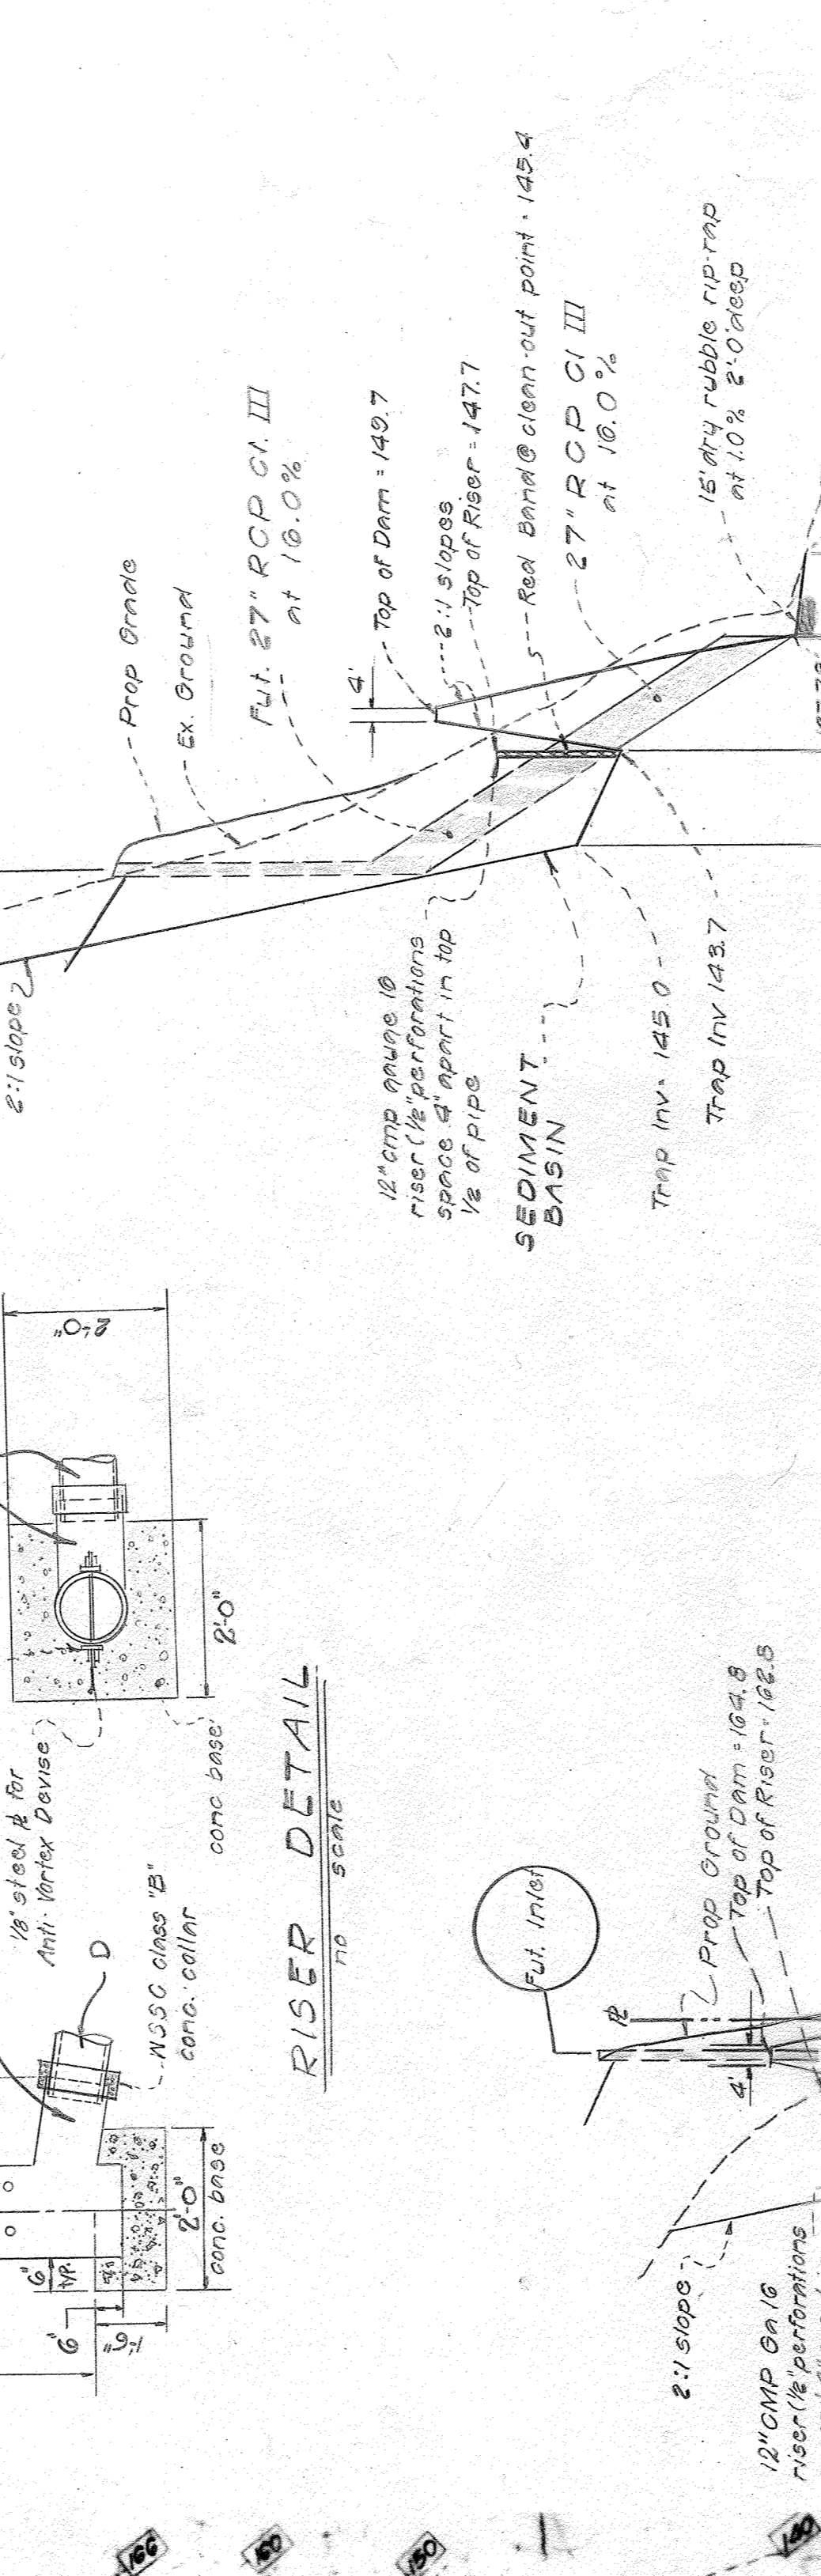
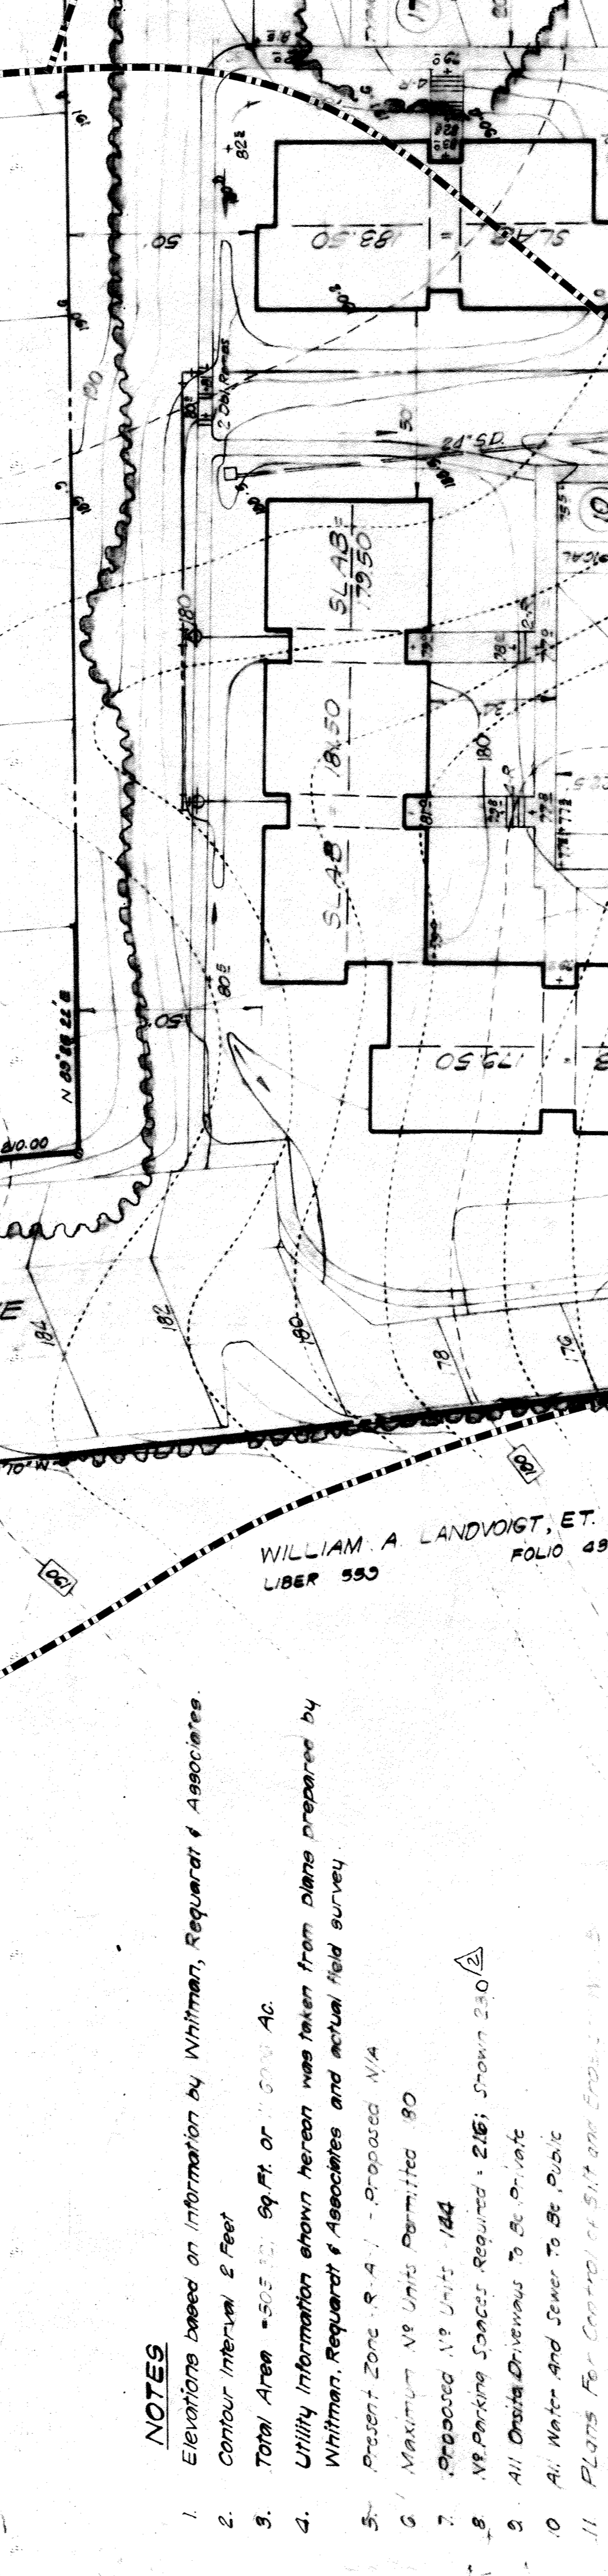
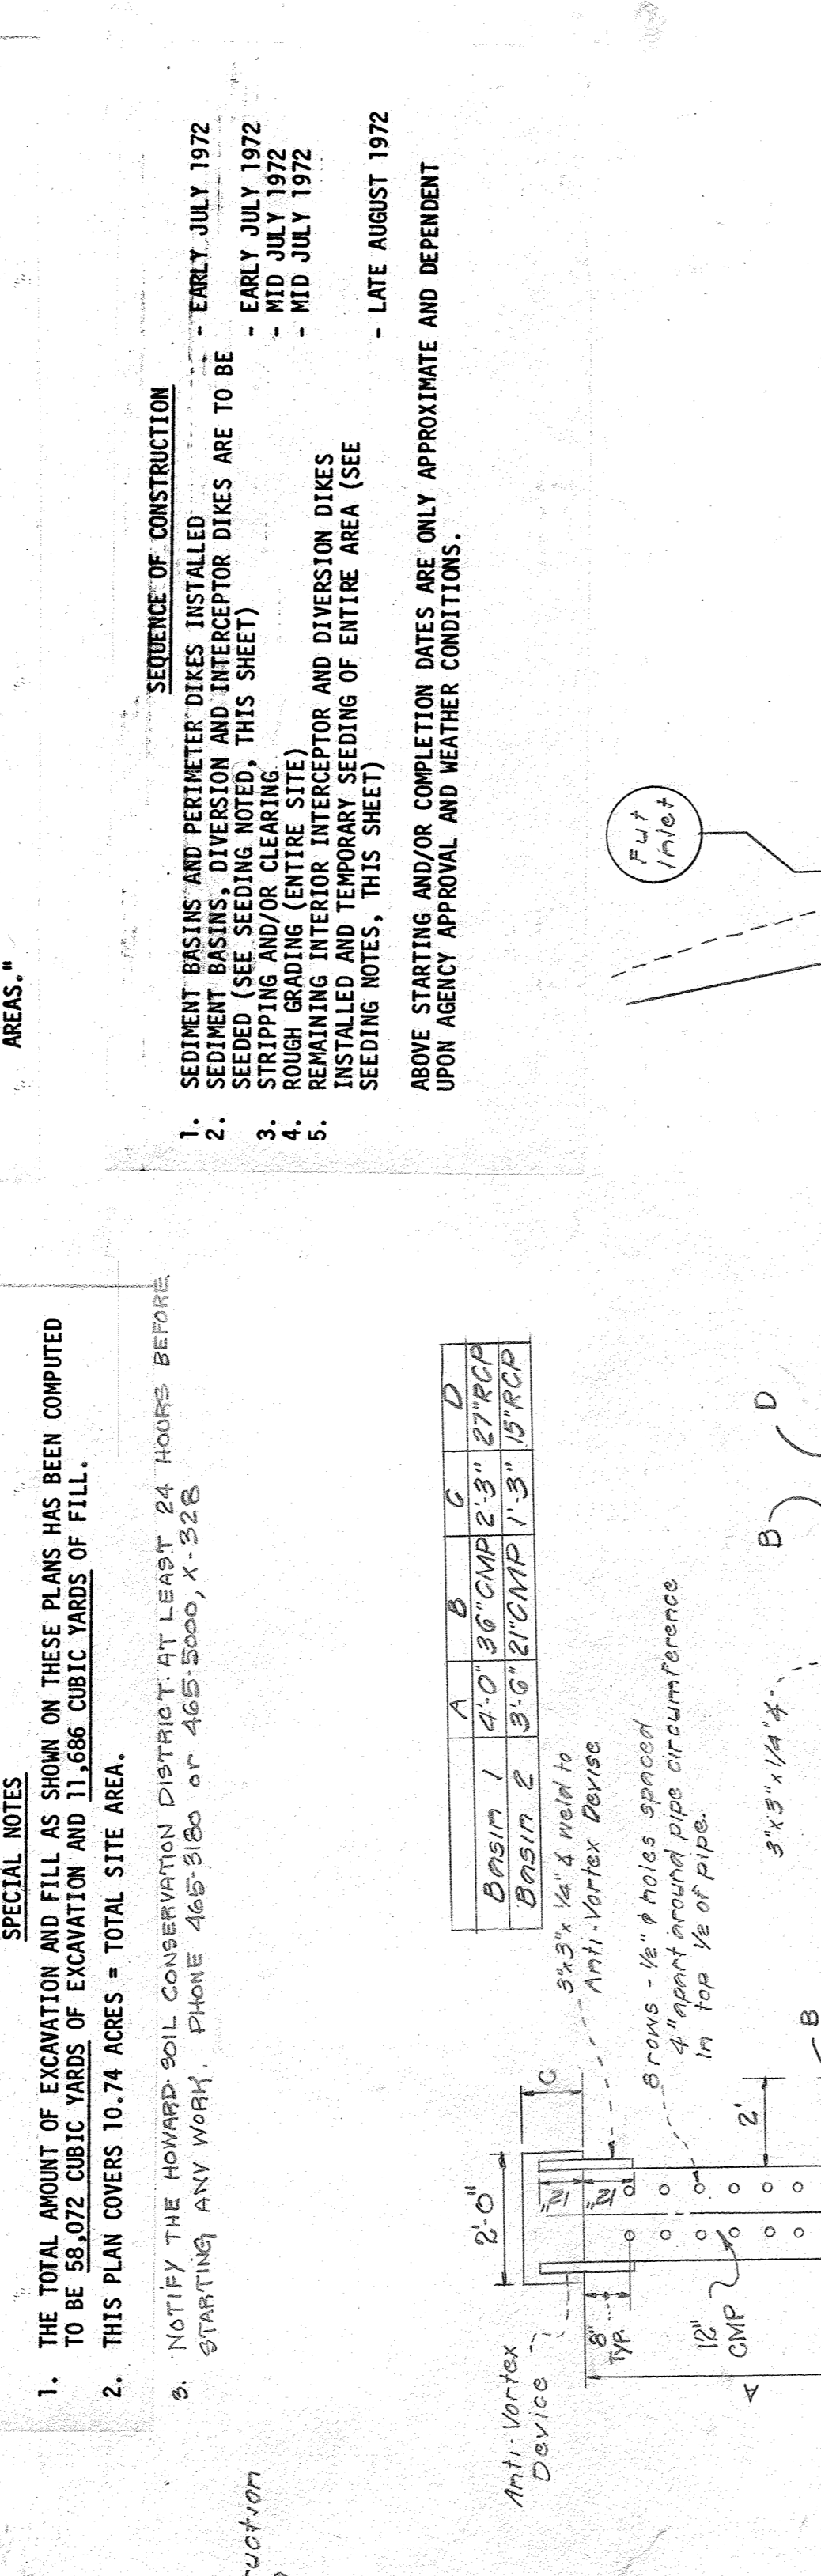
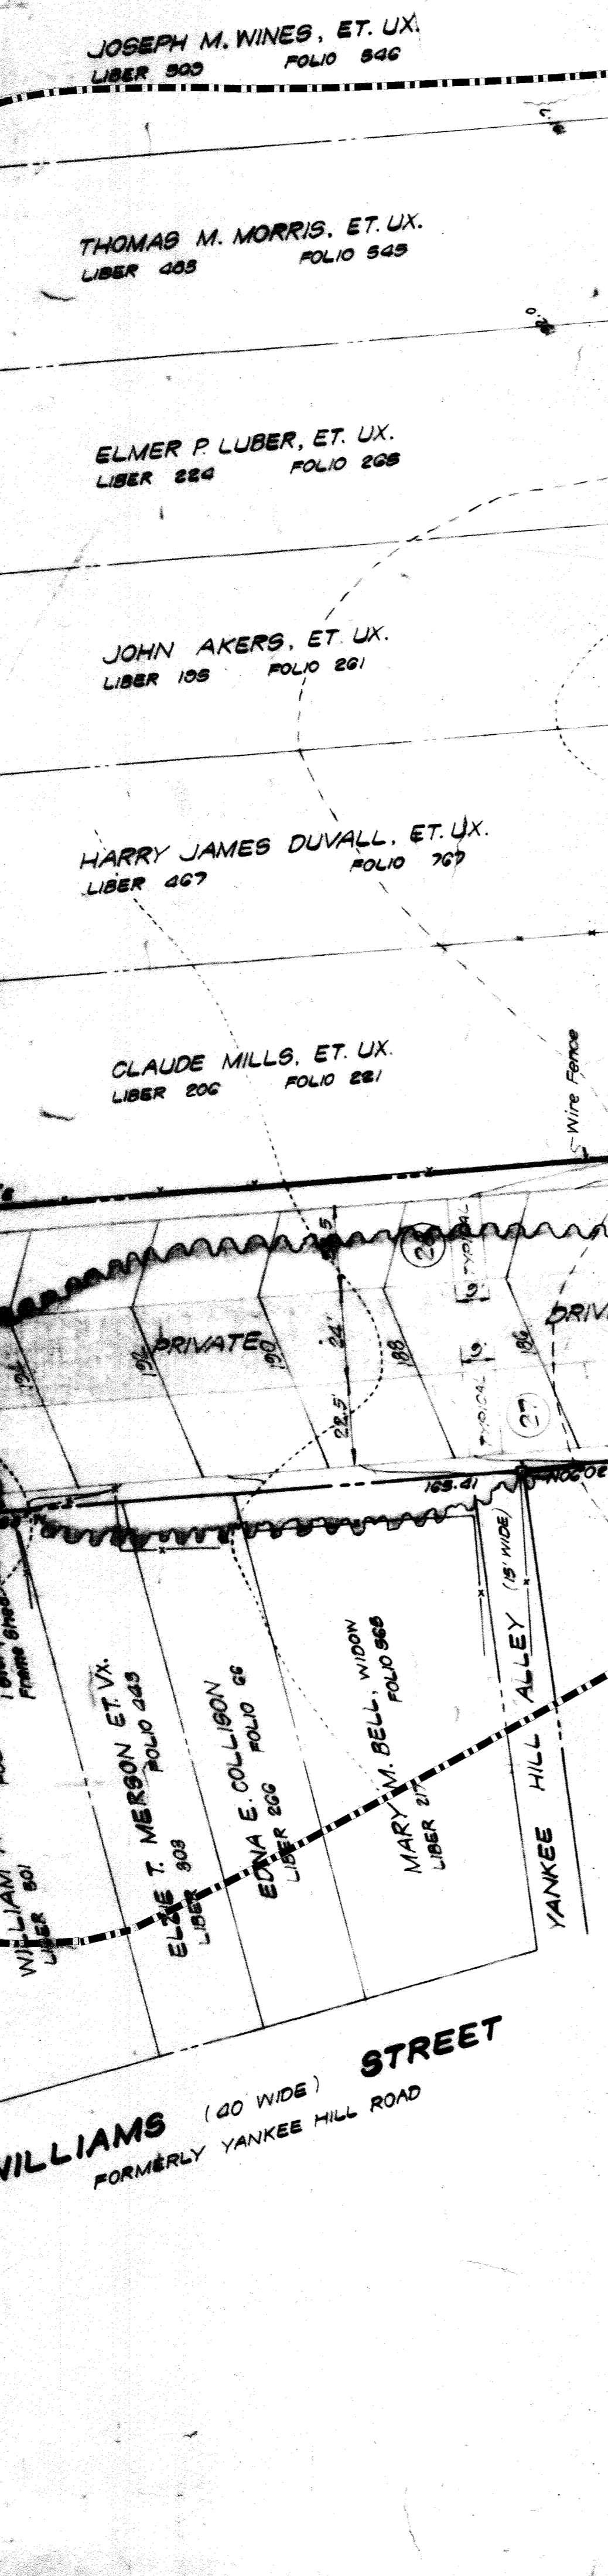
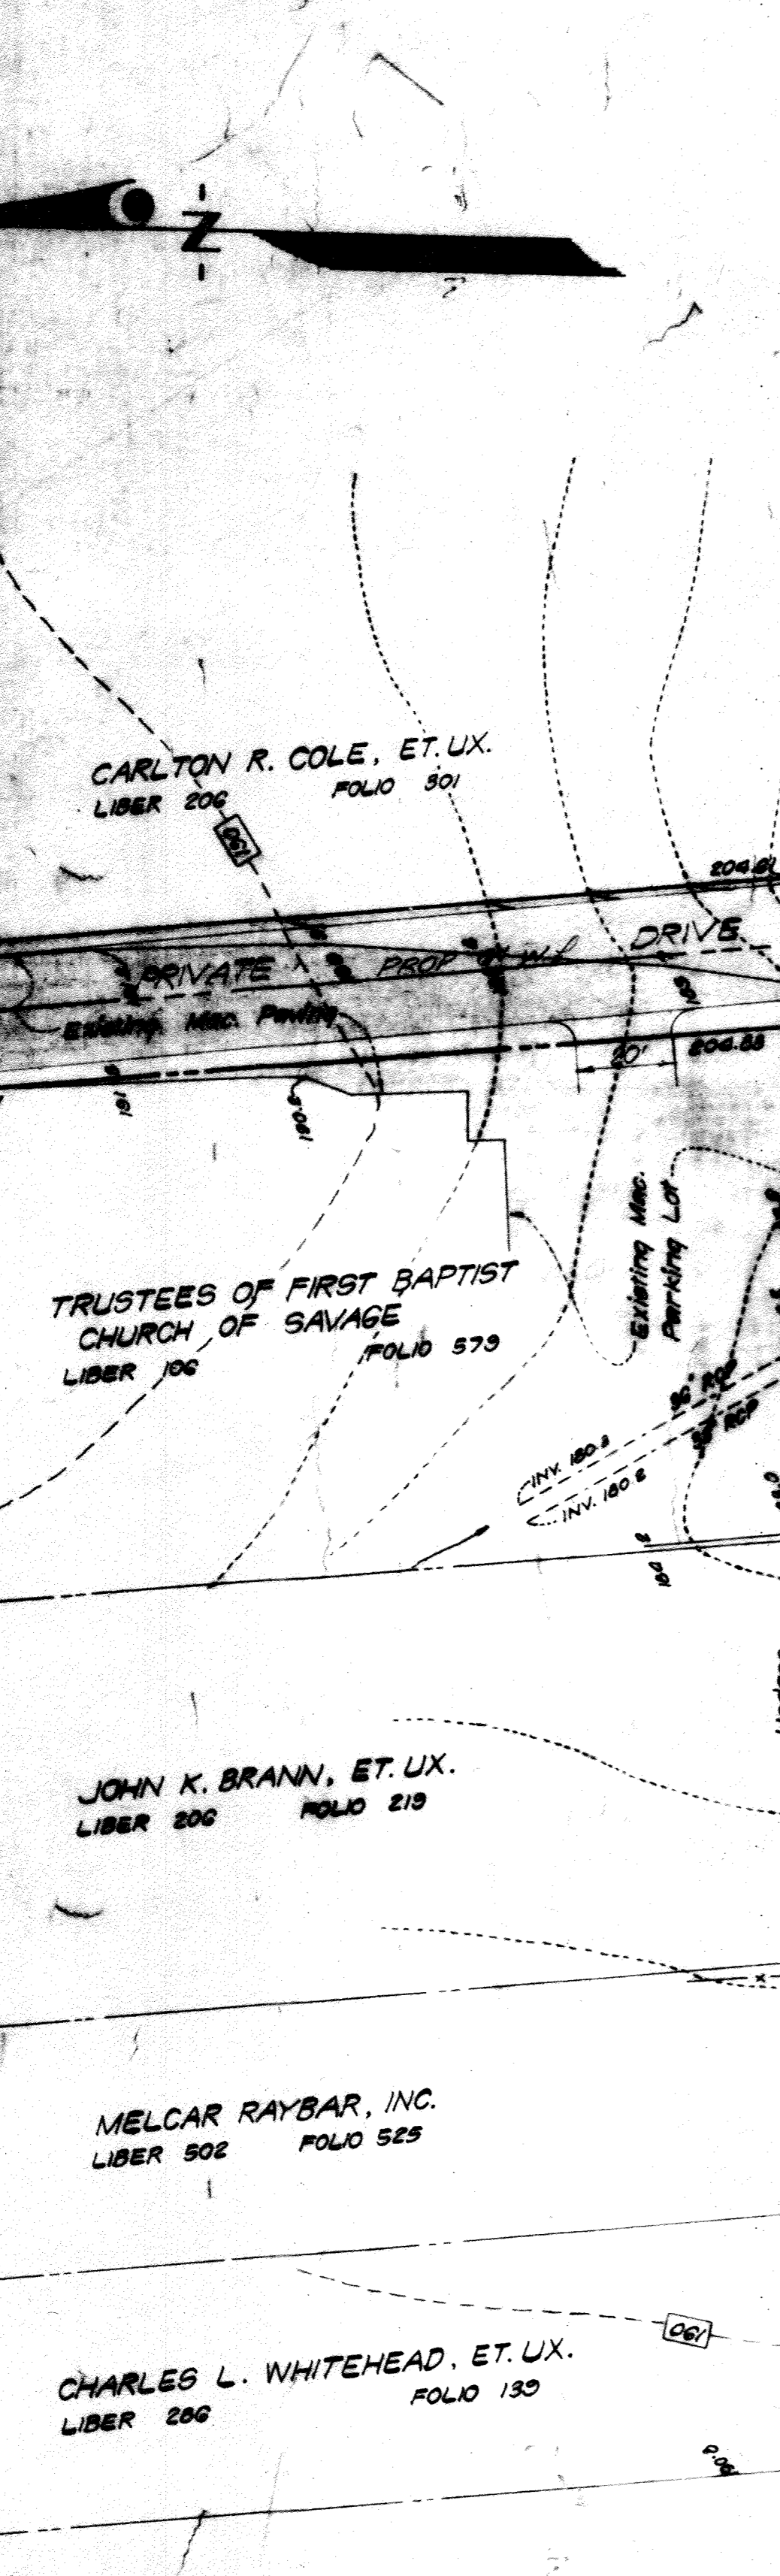


- ### SEEDING NOTES
- ALL DISTURBED AREAS STEEPER THAN OR EQUAL TO 3:1 SHALL BE TEMPORARILY STABILIZED WITH PROTECTIVE MULCH IMMEDIATELY UPON COMPLETION OF ROUGH GRADING IN ACCORDANCE WITH THE FOLLOWING SPECIFICATIONS:
 - USE 1-1/2 TO 2 TONS OF CLEAN, UNWEATHERED SMALL GRAIN STRAW PER ACRE (WEIGHT PREFERRED).
 - APPLY MULCH WITH SPREADER, PEE AND TRINE, PLASTIC NETS OR BY A MACH ANDROWING TOOL.
 - ALL AREAS DISTURBED BY ON-SITE GRADING THAT WILL NOT BE CONSTRUCTED UPON WITHIN 180 DAYS SHALL BE STABILIZED WITH A SOIL-EROSION-CONTROL TYPE SEEDING AND MULCHING WITH THE FOLLOWING PROCEDURE:
 - LIME IS TO BE APPLIED AT THE RATE OF 46 LBS. PER 1000 SQ. FT.
 - SEED SHALL BE SPRUNG OATS APPLIED AT THE RATE OF 11.5 TO 18.4 LBS. PER 1000 SQ. FT.
 - SEED SHALL BE SPRUNG OATS APPLIED AT THE RATE OF 2.172 BUL./AC.
 - MULCH MATERIALS SHOULD BE UNWEATHERED, UNCHIPPED, SMALL GRAIN STRAW 1/2 TO 1 1/2 IN. LONG AND 1/4 TO 3/8 IN. WIDE, APPLIED AT THE RATE OF 40 LBS. PER 1000 SQ. FT.
 - ALL AREAS DISTURBED BY ON-SITE GRADING THAT WILL NOT BE CONSTRUCTED UPON WITHIN 180 DAYS SHALL BE STABILIZED WITH A SOIL-EROSION-CONTROL TYPE SEEDING AND MULCHING WITH THE FOLLOWING PROCEDURE:
 - LIME IS TO BE APPLIED AT THE RATE OF 46 LBS. PER 1000 SQ. FT.
 - SEED SHALL BE SPRUNG OATS APPLIED AT THE RATE OF 11.5 TO 18.4 LBS. PER 1000 SQ. FT.
 - SEED SHALL BE SPRUNG OATS APPLIED AT THE RATE OF 2.172 BUL./AC.
 - MULCH MATERIALS SHOULD BE UNWEATHERED, UNCHIPPED, SMALL GRAIN STRAW 1/2 TO 1 1/2 IN. LONG AND 1/4 TO 3/8 IN. WIDE, APPLIED AT THE RATE OF 40 LBS. PER 1000 SQ. FT.
 - IMMEDIATELY AFTER SEEDING, UNIFORM MULCH THICKNESS WITH UNWEATHERED SMALL GRAIN STRAW (PREFERABLE) AT THE RATE OF 1-1/2 TO 2 TONS PER ACRE.
 - SEEDING (LATER THAN OCTOBER 15) OR TEMPORARY SEEDING (LATER THAN OCTOBER 15) CANNOT BE MADE, WILL BE TREATED BY MULCHING IN ACCORDANCE WITH THE FOLLOWING PROCEDURE:
 - AT THE RATE OF 1-1/2 TO 2 TONS PER ACRE, UNCHIPPED, SMALL GRAIN STRAW, SPREAD AT THE RATE OF 1-1/2 TO 2 TONS PER ACRE.
 - AND/OR MULCH WITH ASPHALT, PEE AND TRINE, PLASTIC NETTING, OR BY A MACH ANDROWING TOOL.
 - ALL DISTURBED AREAS TO BE STABILIZED BY SEEDING WILL BE TREATED IN ACCORDANCE WITH THE FOLLOWING PROCEDURE:
 - SEED SHALL BE SPRUNG OATS APPLIED AT THE RATE OF 11.5 TO 18.4 LBS. PER 1000 SQ. FT.
 - SEED SHALL BE SPRUNG OATS APPLIED AT THE RATE OF 2.172 BUL./AC.
 - MULCH MATERIALS SHOULD BE UNWEATHERED, UNCHIPPED, SMALL GRAIN STRAW 1/2 TO 1 1/2 IN. LONG AND 1/4 TO 3/8 IN. WIDE, APPLIED AT THE RATE OF 40 LBS. PER 1000 SQ. FT.
 - IMMEDIATELY AFTER SEEDING, UNIFORM MULCH THICKNESS WITH UNWEATHERED SMALL GRAIN STRAW (PREFERABLE) AT THE RATE OF 1-1/2 TO 2 TONS PER ACRE.
 - SEEDING NOTES, THIS SHEET

- ### GENERAL NOTES
- ALL REFERENCES TO DRAWINGS, SPECIFICATIONS AND PERMITS SHALL BE TO THE LATEST EDITIONS UNLESS OTHERWISE SPECIFIED.
 - THE INITIAL SEEDING AND EROSION CONTROL FACILITIES ARE TO BE CONSTRUCTED IN CONNECTION WITH THE START OF THE CLEARING OPERATION.
 - ALL SEEDING CONTROL FACILITIES TO REMAIN IN PLACE UNTIL PERMISSIBLE FOR THEIR REMOVAL. THEY SHALL BE MAINTAINED AND REPAIRED AS NECESSARY TO ENSURE PROPER OPERATION.
 - SEEDING BASINS ARE TO BE CLEANED OUT WHEN THE SEEDING LEVEL REACHES THE RED BAND PAINTED ON THE PIPE RISER.
 - THE FILL MATERIALS TO BE USED SHALL BE OF THE BEST AVAILABLE LOCAL MATERIALS OF THE FOLLOWING SPECIFICATIONS:
 - NO DISTURBED AREAS ARE TO BE ALLOWED TO DRAIN DIRECTLY OFF THE SITE.
 - THE SEEDING BASINS SHALL BE CONSTRUCTED COMPLETE WITH DIVERSION DICES, SLOPE PROTECTIVE MULCH, SEEDING AND MULCHING FACILITIES AND ALL OTHER NECESSARY FACILITIES TO REMAIN IN PLACE UNTIL ALL DISTURBED AREAS ARE RESTORED TO ORIGINAL OR BETTER CONDITION.
 - CONSTRUCTED BERMS, DICES, DAMS, ETC., WILL BE COMPLETED BY SEVERAL PASSES WITH A TRACTOR, TRUCK, (BULLDOZER, BACKHOE OR OTHER HEAVY EQUIPMENT, OR BY THE USE OF A SUITABLE EXCAVATOR).
 - THE DEVELOPER SHALL PROVIDE SWEET SHEET SPECIFICATIONS FOR THE SEEDING BASINS. SUGGESTED FORCE IS 15 TONS PER LINEAL FOOT, HIGHWAY TYPE SLOPE FINISH WITH MINIMUM BOTTOM ABOVE GRADE INSTALLATION.
 - ALL SEEDING CONTROL FACILITIES TO BE ADJUSTED AS NECESSARY TO MEET EXISTING CONDITIONS AND TO BE MAINTAINED AS NECESSARY TO INSURE THAT THE SEEDING CONTROL FACILITIES ARE OPERATING PROPERLY.
 - MEASUREMENTS SHALL BE RECHECKED AT 24 HOURS AFTER CONSTRUCTION OF EACH FACILITY TO BE ADJUSTED AS NECESSARY TO MEET EXISTING CONDITIONS.
 - ALL SEEDING CONTROL FACILITIES TO BE ADJUSTED AS NECESSARY TO MEET EXISTING CONDITIONS.
 - ALL SEEDING CONTROL FACILITIES TO BE ADJUSTED AS NECESSARY TO MEET EXISTING CONDITIONS.
 - ALL SEEDING CONTROL FACILITIES TO BE ADJUSTED AS NECESSARY TO MEET EXISTING CONDITIONS.
 - ALL SEEDING CONTROL FACILITIES TO BE ADJUSTED AS NECESSARY TO MEET EXISTING CONDITIONS.
 - ALL FILL MATERIAL USED ON THIS SITE SHALL BE FREE OF RESPONSIBLE MATERIAL.

- ### SPECIAL NOTES
- THE TOTAL AMOUNT OF EXCAVATION AND FILL ON THESE BASINS HAS BEEN COMPUTED TO BE 50,000 CUBIC YARDS OF EXCAVATION AND 11,800 CUBIC YARDS OF FILL.
 - NOTIFY THE HOWARD COUNTY SUPERVISOR AT 448-8800, 24 HOURS BEFORE STARTING ANY WORK.
 - STARTING ANY WORK AT 448-8800, 24 HOURS BEFORE.

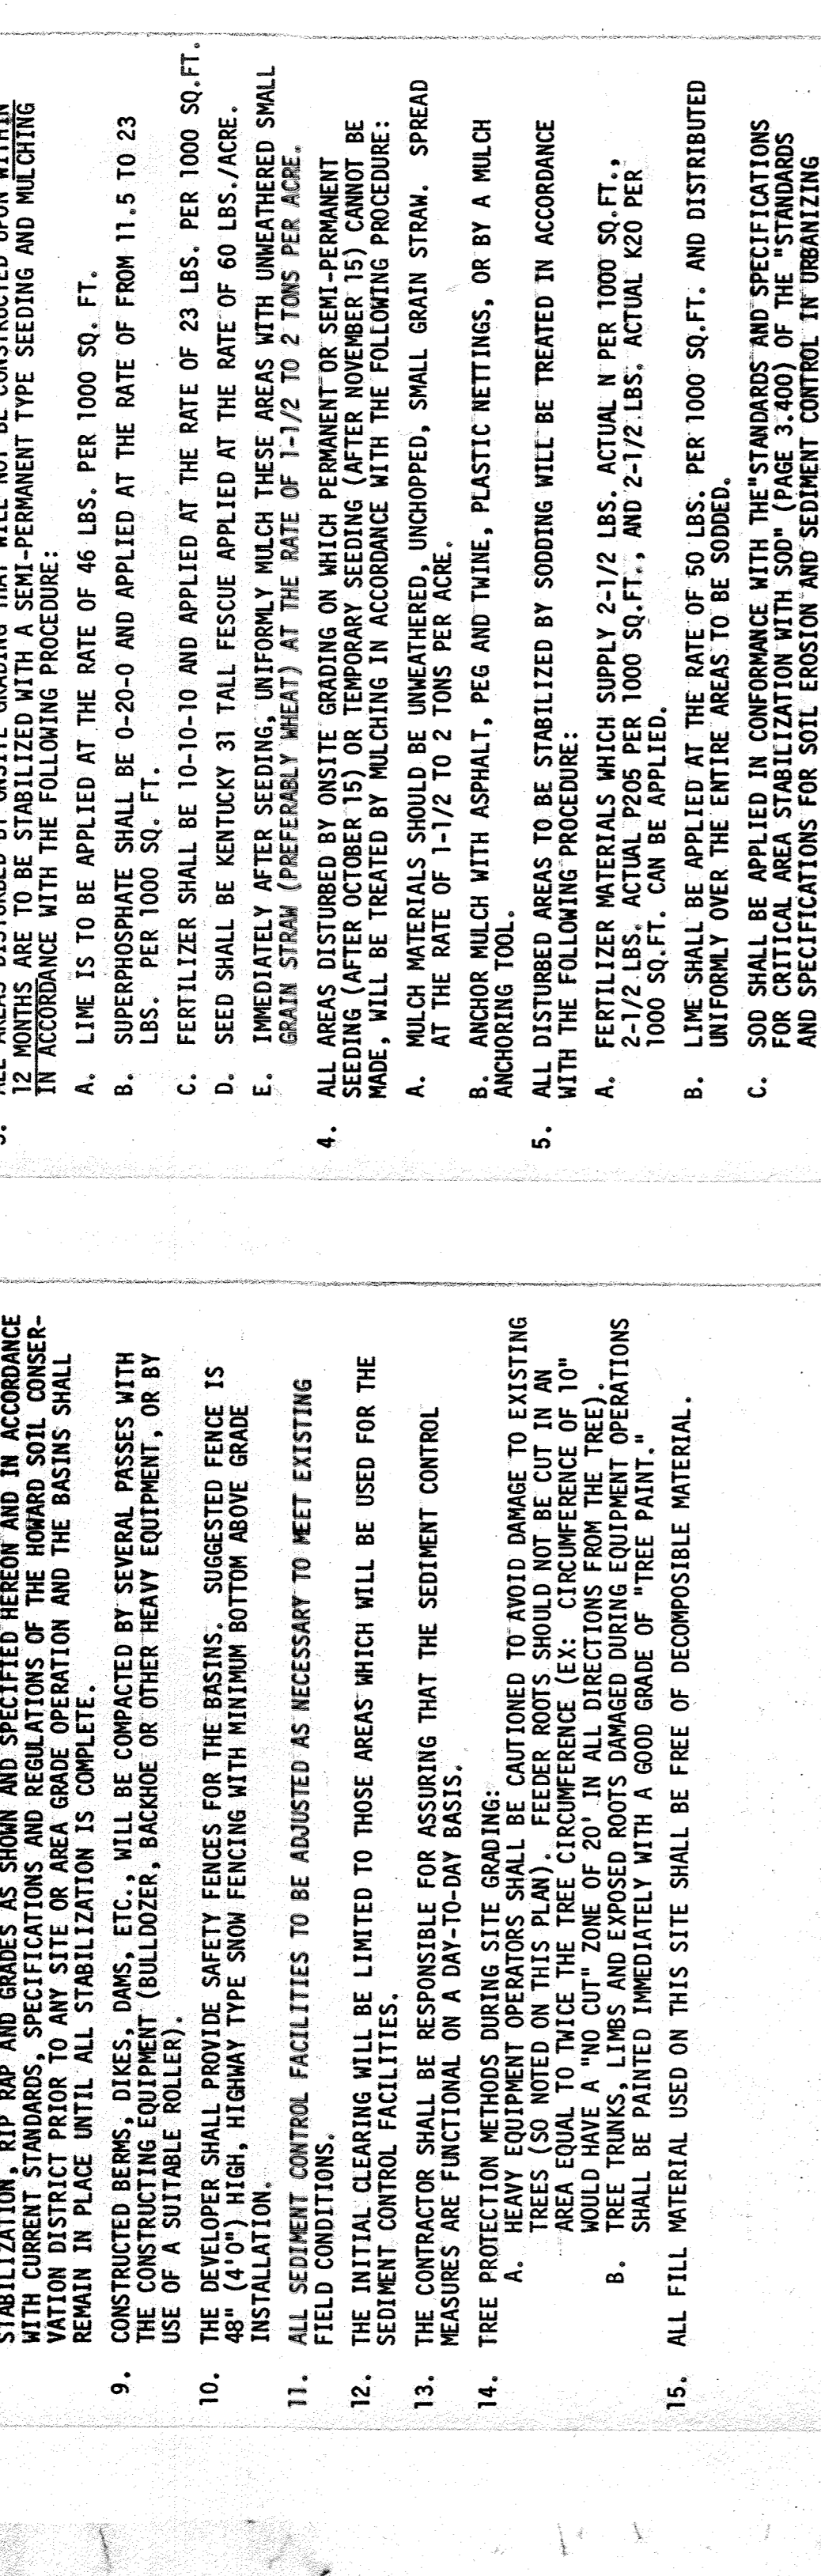

SEDIMENT CONTROL PLAN

OWNER: RIVER ISLAND APARTMENTS

DEVELOPER: RIVER ISLAND LIMITED PARTNERSHIP

SCALE: 1"=50'

DATE: FEBRUARY, 1972

HOWARD COUNTY, MARYLAND

PROFESSIONAL ENGINEER: [Signature]

APPROVED BY: [Signature]

CLARK | AZAR & ASSOCIATES
 20440 Century Blvd, Suite 220
 Germantown, MD, 20874
 T(301) 528-2010
 www.clarkazar.com
 A Woman Owned Small Business




PROFESSIONAL CERTIFICATION:
 I CERTIFY THAT THESE DOCUMENTS WERE PREPARED
 OR APPROVED BY ME AND THAT I AM A DULY
 LICENSED PROFESSIONAL ENGINEER UNDER THE
 LAWS OF THE STATE OF MARYLAND.
 LICENSE NO. 311168
 EXPIRATION DATE: 01/12/2023

**RIVER FRONT APARTMENTS
 POOL HOUSE REMODEL**

8905 RIVER ISLAND DRIVE
 SAVAGE, MD 20763

NO.	DATE	DESCRIPTION
1	10/05/21	REVISION #3 Parking / Sidewalk

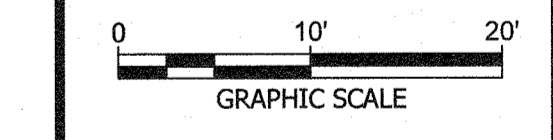

DATE: AUG 2021
 CAA PROJECT NO.: 715.001
 DRAWN BY: MD
 CHECKED BY: JA
 SHEET TITLE

DEMOLITION PLAN

SHEET
 2 OF 5
 SDP-73-011

CONCRETE DEMOLITION (Cross-hatched pattern)


CURB AND GUTTER DEMOLITION (Diagonal hatched pattern)

FENCE LINE REMOVAL (Dashed line)

GENERAL DEMOLITION NOTES

1. THE CONTRACTOR SHALL BE LIMITED TO STORING MATERIALS WITHIN THE LIMITS OF DISTURBANCE FOR THIS PROJECT.
2. ALL CONSTRUCTION ACTIVITY SHALL BE COORDINATED WITH HCPSS.
3. CONTRACTOR SHALL PROVIDE REQUIRED SIGNAGE AND FLAGMEN ALONG ALL PUBLIC STREETS ADJACENT TO THE SITE, TO ASSURE THE SAFETY OF ALL VEHICULAR AND PEDESTRIAN TRAFFIC IF REQUIRED. ALL TRAFFIC CONTROLS MUST BE IN ACCORDANCE WITH THE MOST CURRENT MUTCD AND MDMUTCD REQUIREMENTS AND WITH THE MOST CURRENT HOWARD COUNTY DOT WORK ZONE TRAFFIC CONTROL STANDARDS AND DETAILS.
4. ALL WORK SHALL BE PERFORMED IN STRICT CONFORMANCE WITH THE MOST CURRENT APPLICABLE EPA, OSHA, AND MSHA REGULATIONS AND MUST COMPLY WITH THE MOST CURRENT FEDERAL, STATE AND/OR LOCAL REGULATIONS AND CODES APPLICABLE TO SAID WORK.
5. THE CONTRACTOR IS RESPONSIBLE FOR COORDINATING WORK WITH REPRESENTATIVE UTILITY COMPANIES AND IMPLEMENTING REQUIRED UTILITY-RELATED WORK ACCORDINGLY.
6. THE CONTRACTOR SHALL NOTIFY THE OWNER AND/OR OWNERS REPRESENTATIVE IMMEDIATELY UPON ENCOUNTERING ANY HAZARDOUS MATERIALS. THE CONTRACTOR SHALL DOCUMENT SAME TO THE OWNER TO OBTAIN DIRECTION AS TO THE APPROPRIATE ACTION(S) TO BE TAKEN.
7. WHERE NEW WORK IS TO BE DONE, CARE SHALL BE TAKEN TO PROTECT ALL EXISTING ADJACENT SURFACES, STRUCTURES, AND AREAS FROM DAMAGE. ANY ITEM SHOWN TO REMAIN THAT IS DAMAGED DURING CONSTRUCTION SHALL BE RESTORED TO THEIR ORIGINAL CONDITION AT NO ADDITIONAL COST TO THE OWNER.
8. CONTRACTOR SHALL BACKFILL EXCAVATED AREAS WITH ACCEPTABLE MATERIAL, AS SPECIFIED IN THE CONTRACT DOCUMENTS.
9. THE CONTRACTOR SHALL SHEET/SHORE AND BRACE ANY AND ALL STRUCTURES EXPOSED BY EXCAVATION/CONSTRUCTION IF REQUIRED AND SHALL CONTAIN ALL EXCAVATION WITHIN THE LIMITS OF DISTURBANCE. CONTRACTOR SHALL BE RESPONSIBLE FOR DESIGN OF SHEETING AND SHORING IN ACCORDANCE WITH LOCAL, STATE, OR FEDERAL REQUIREMENTS.
10. IN THE EVENT THAT, DURING DEMOLITION OR CONSTRUCTION ACTIVITIES THE CONTRACTOR ENCOUNTERS ANY EXISTING UTILITIES/STRUCTURES NOT SHOWN ON THESE DRAWINGS, THE CONTRACTOR SHALL NOTIFY THE OWNER FOR DIRECTIONS PRIOR TO PROCEEDING WITH ANY WORK.
11. ALL SAWCUTS ARE TO BE STRAIGHT AND EVEN, JAGGED EDGES WILL NOT BE ACCEPTED.

ASPHALT PAVEMENT DEMOLITION (Solid grey fill)


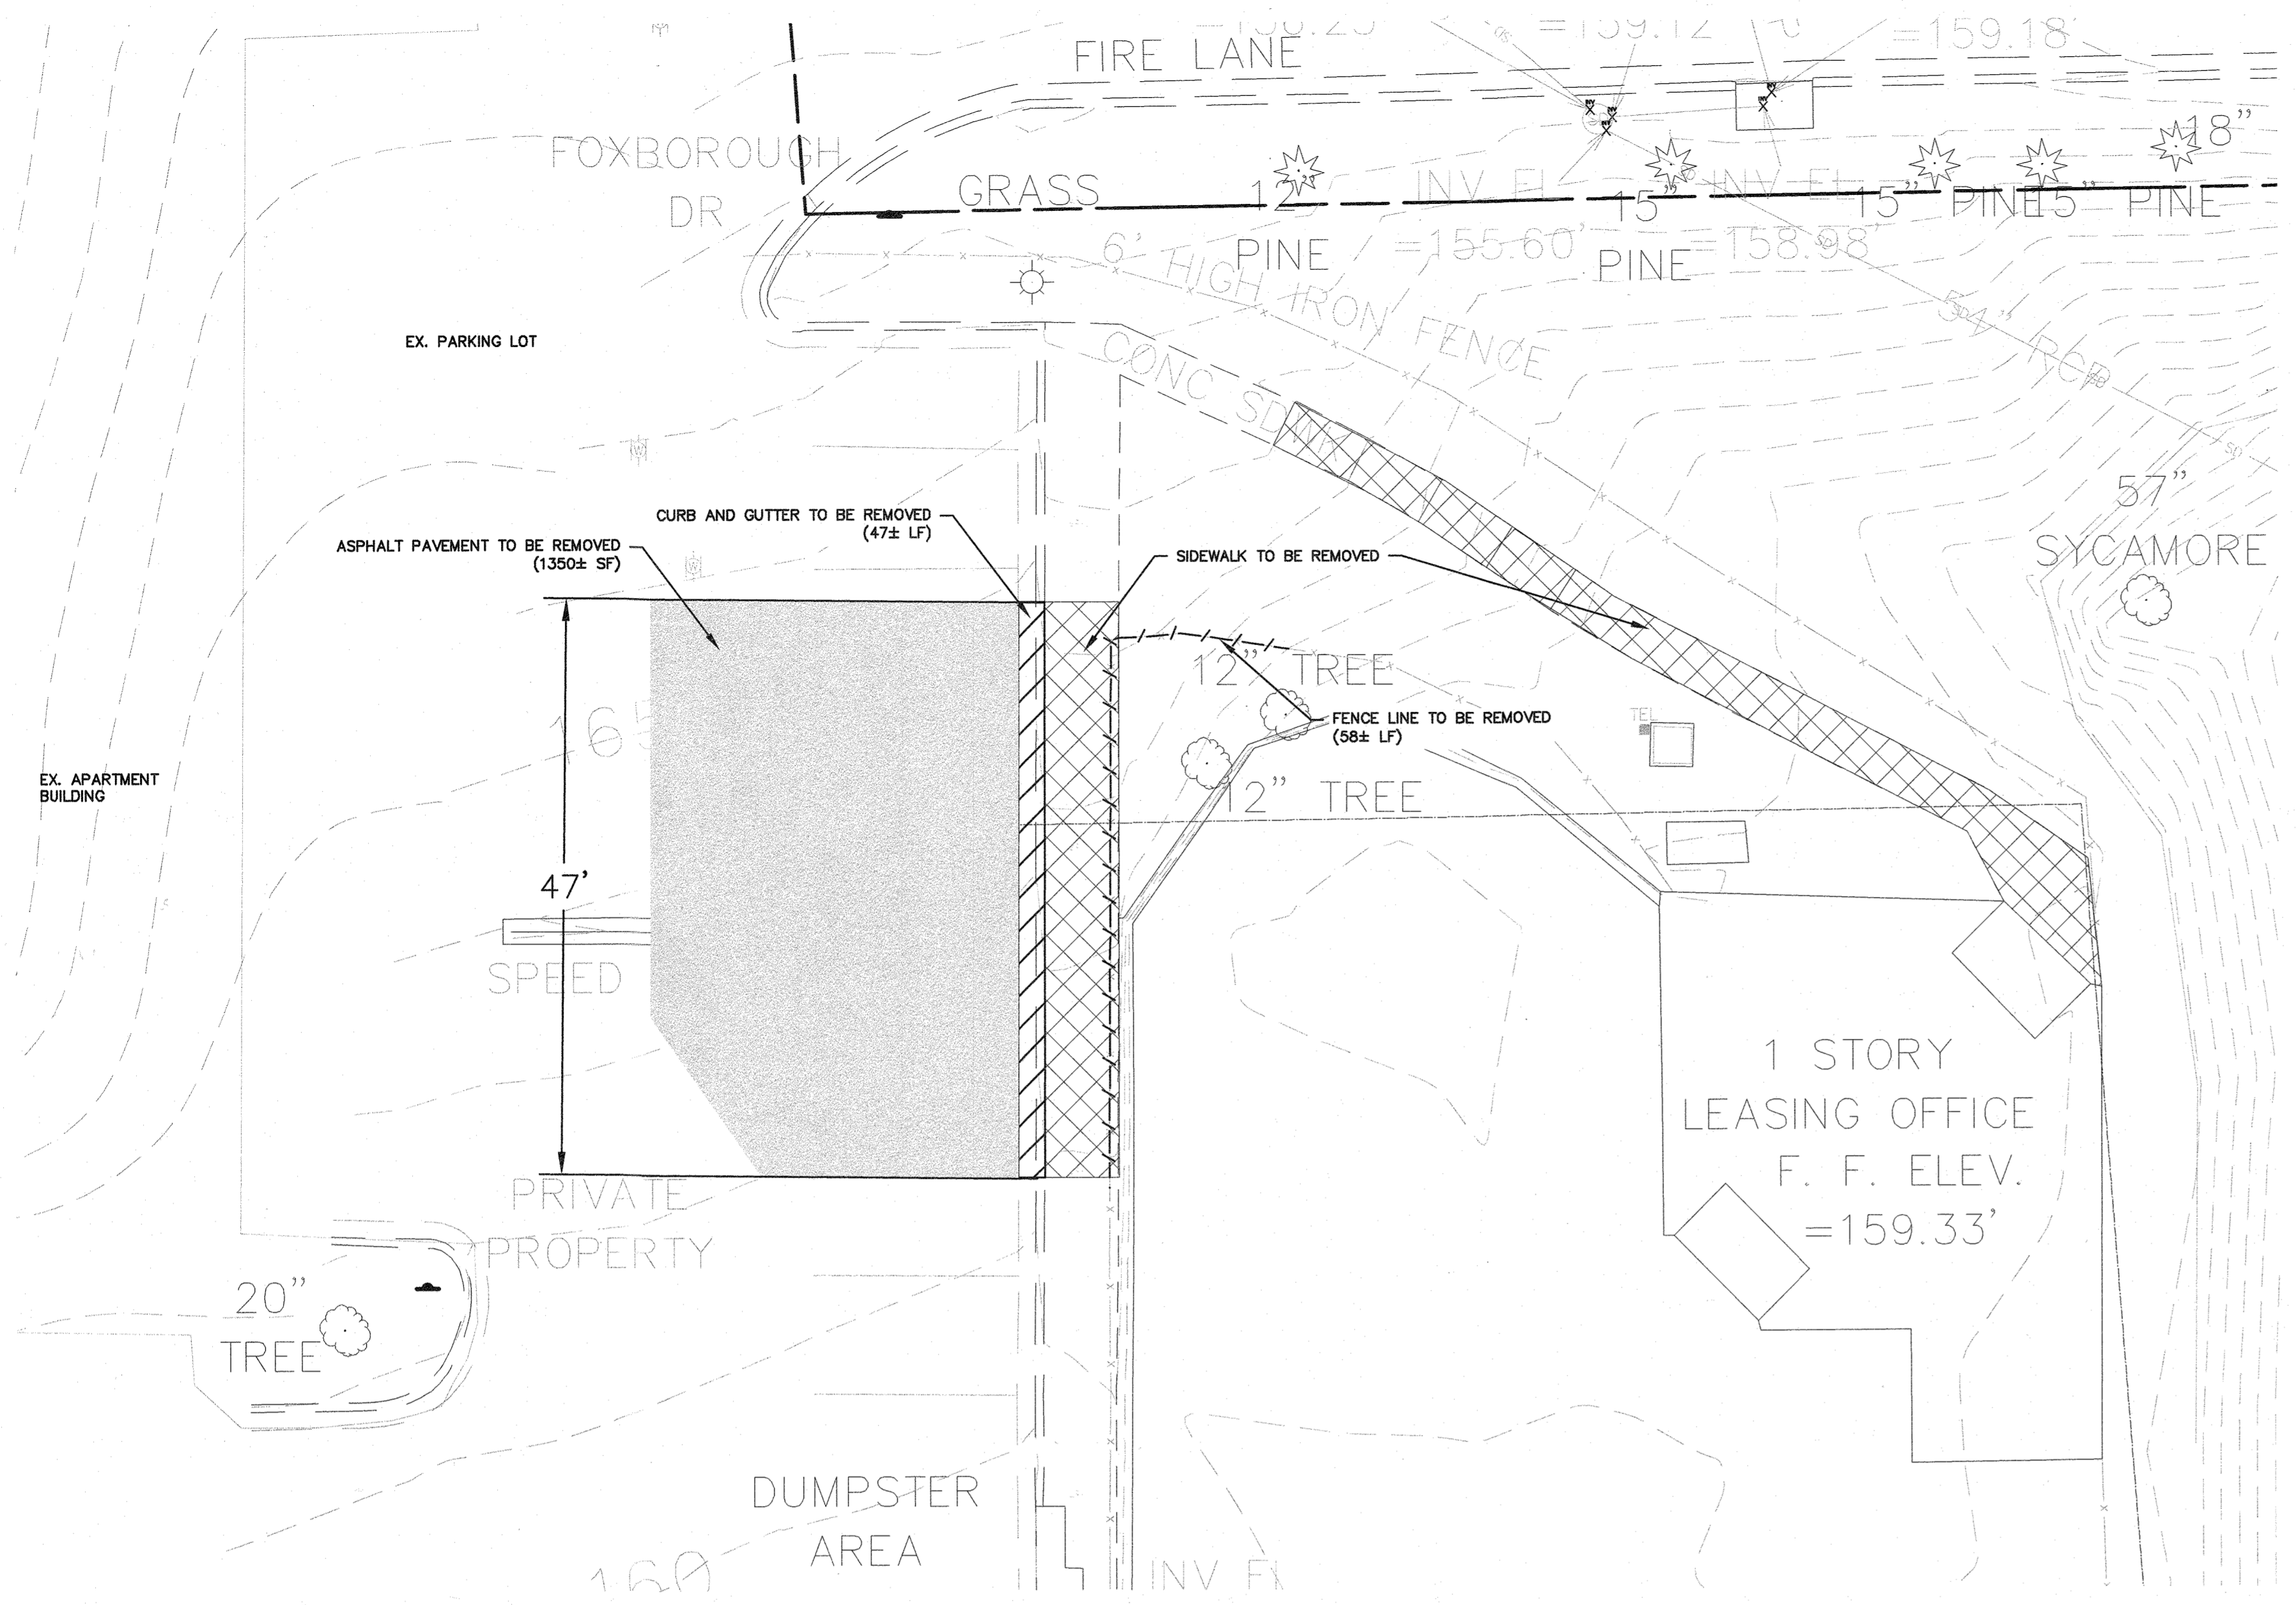


DEMOLITION PLAN
 1" = 10'

J:\175.001 - River Island Direct Care\SDP\73-011 - EXISTING CONDITIONS AND DEMO PLANS.dwg 11/18/2021 9:12 AM

APPROVED: DEPARTMENT OF PLANNING AND ZONING

<i>[Signature]</i>	11.29.21
Chief, Development Engineering Division	Date
<i>[Signature]</i>	12/2/21
Chief, Division of Land Development	Date
<i>[Signature]</i>	12/2/21
Director	Date

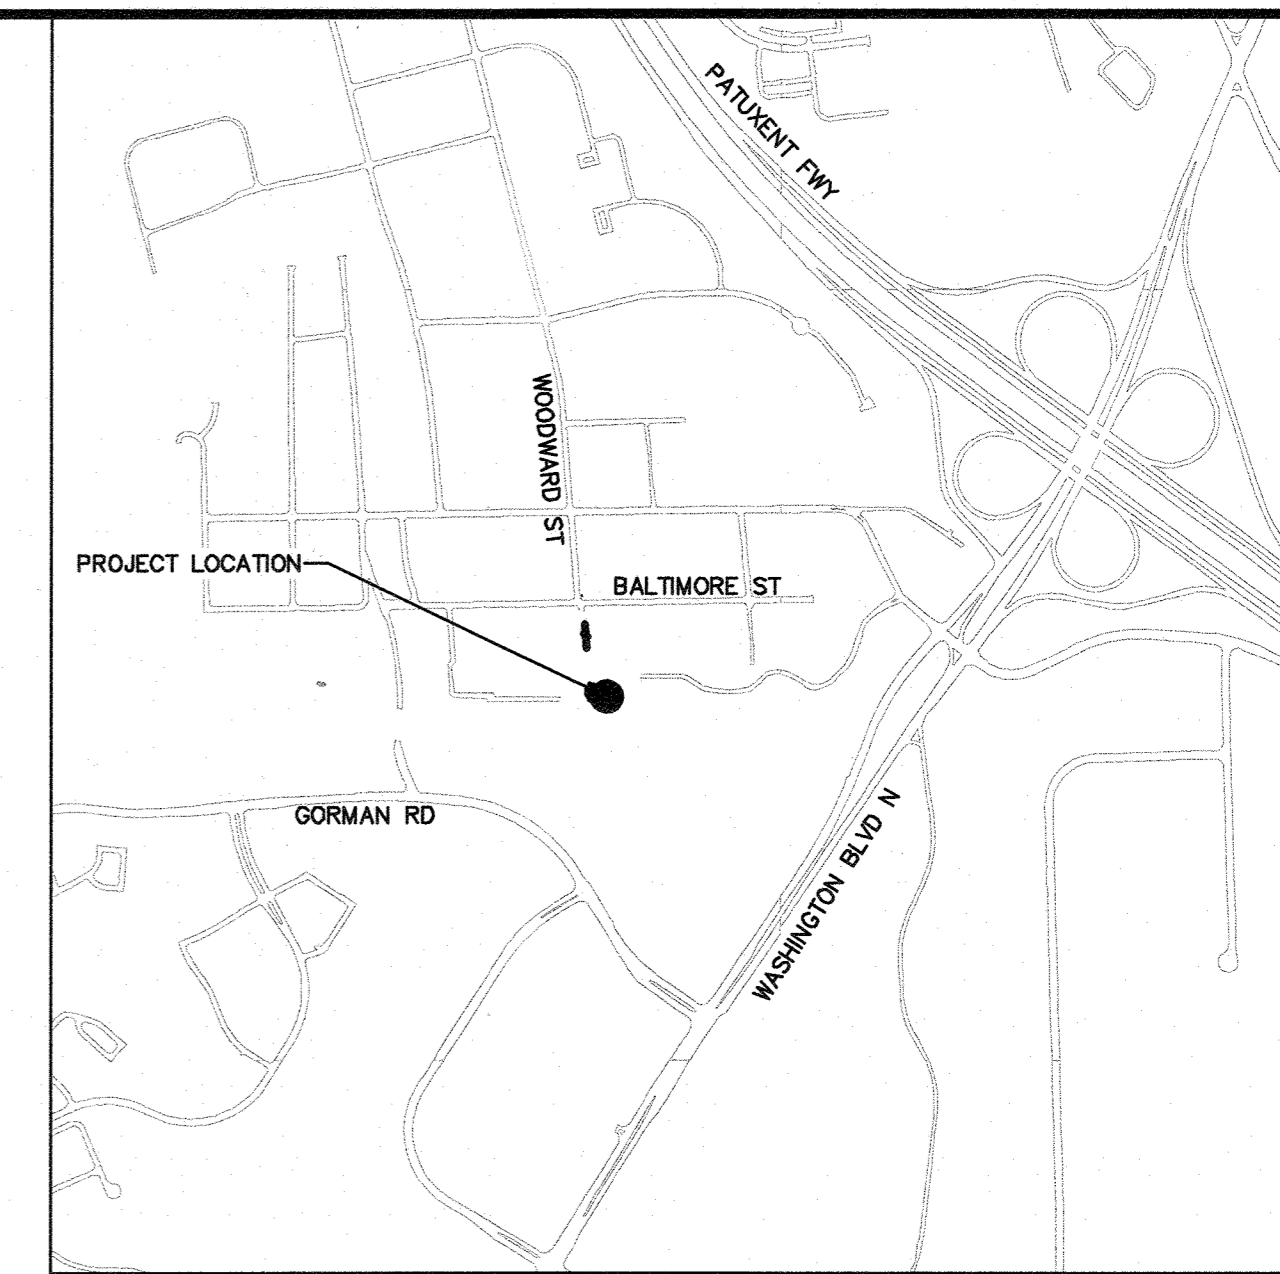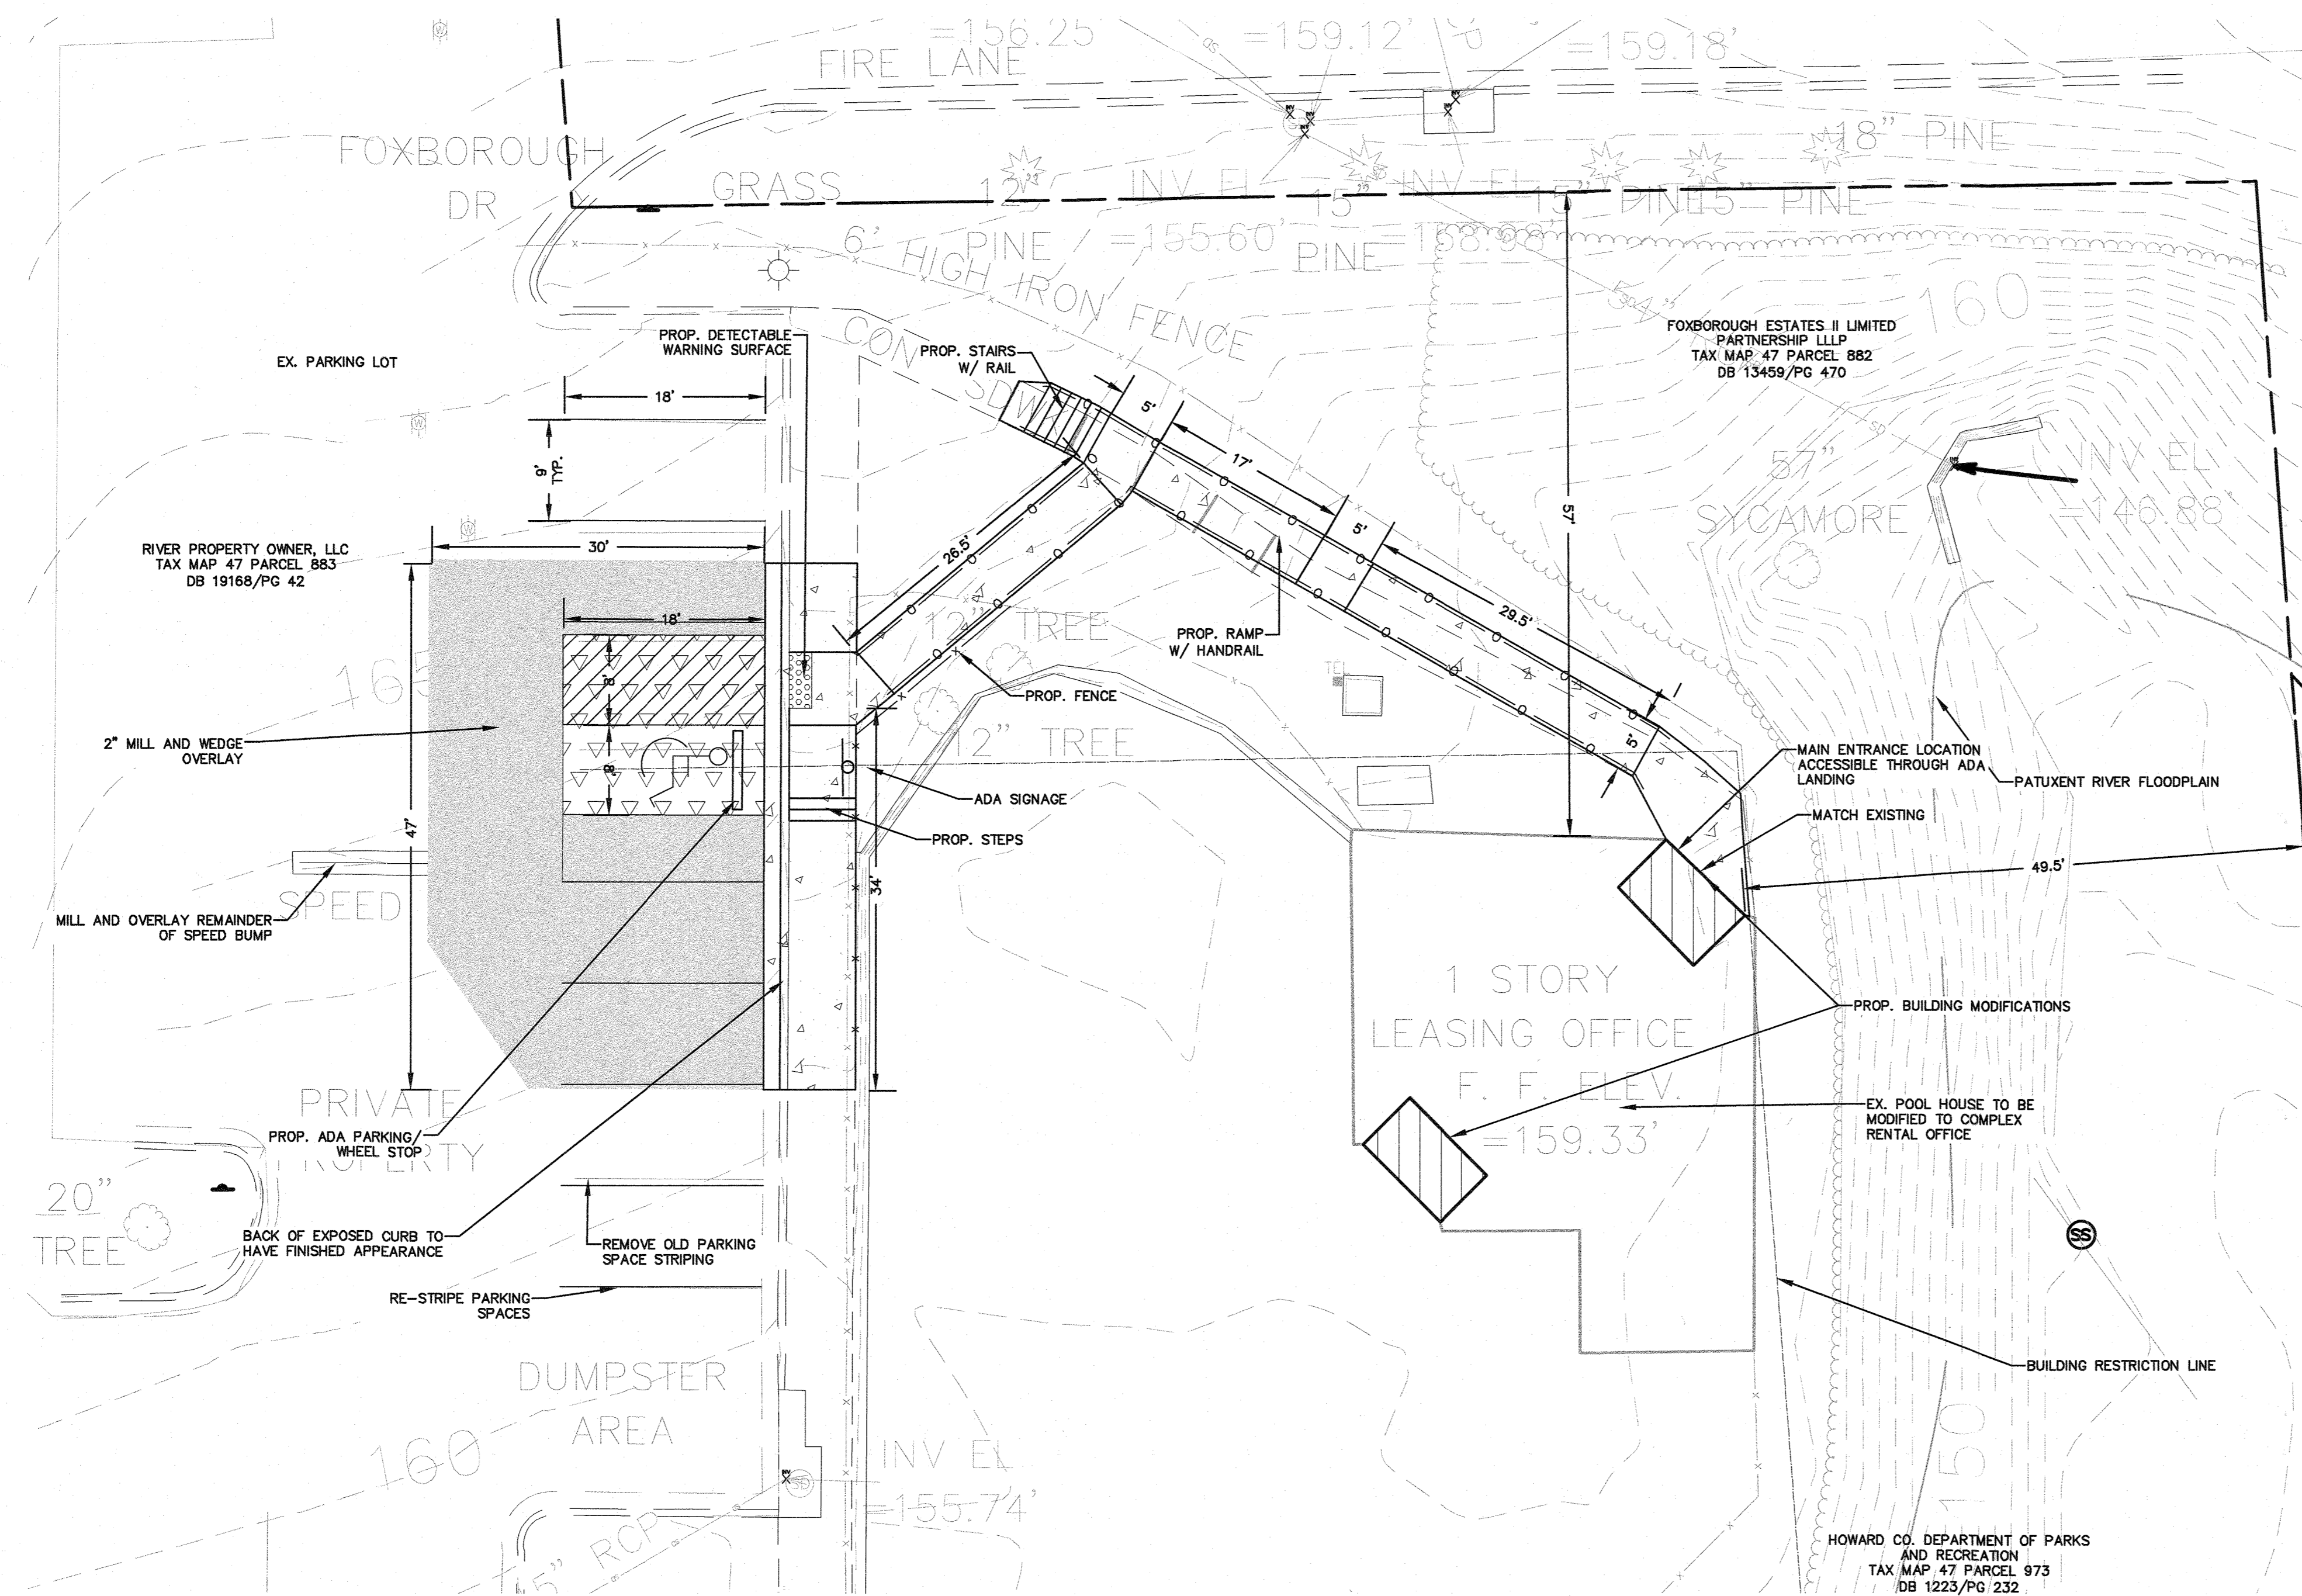

CLARK | AZAR & ASSOCIATES
 20440 Century Blvd, Suite 220
 Germantown, MD, 20874
 T(301) 528-2010
 www.clarkazar.com
 A Woman Owned Small Business



PROFESSIONAL CERTIFICATION:
 I CERTIFY THAT THESE DOCUMENTS WERE PREPARED
 OR APPROVED BY ME, AND THAT I AM A DULY
 LICENSED PROFESSIONAL ENGINEER, UNDER THE
 LAWS OF THE STATE OF MARYLAND.
 LICENSE NO. 31168
 EXPIRATION DATE: 01/12/2023

VICINITY MAP
 1" = 1000'


- GENERAL NOTES:**
- SCOPE OF WORK: REMODEL AN EXISTING POOL HOUSE AT RIVER FRONT APARTMENTS INTO A NEW LEASING OFFICE FOR THE APARTMENT COMPLEX.
 - TAX ACCOUNT: 421281
 - ELECTION DISTRICT: 06
 - ZONING: R-A-15
 - PARCEL: 883
 - LOT AREA: 6.92 AC
 - L. 19168 F.42
 - TOPOGRAPHIC SURVEY BASED OFF SURVEY COMPLETED BY WALLACE MONTGOMERY IN OCTOBER 2020 AND SUPPLEMENTED WITH PUBLICLY AVAILABLE GIS INFORMATION.
 - ALL CONSTRUCTION ACTIVITY SHALL BE COORDINATED WITH PROPERTY OWNER.
 - ALL WORK SHALL BE PERFORMED IN STRICT CONFORMANCE WITH THE MOST CURRENT APPLICABLE EPA, OSHA, AND MSHA REGULATIONS AND MUST COMPLY WITH THE MOST CURRENT FEDERAL, STATE AND/OR LOCAL REGULATIONS AND CODES APPLICABLE TO SAID WORK.
 - THE CONTRACTOR SHALL NOTIFY THE OWNER AND/OR OWNERS REPRESENTATIVE IMMEDIATELY UPON ENCOUNTERING ANY HAZARDOUS MATERIALS. THE CONTRACTOR SHALL DOCUMENT SAME TO THE OWNER TO OBTAIN DIRECTION AS TO THE APPROPRIATE ACTION(S) TO BE TAKEN.
 - WHERE NEW WORK IS TO BE DONE, CARE SHALL BE TAKEN TO PROTECT ALL EXISTING ADJACENT SURFACES, STRUCTURES, AND AREAS FROM DAMAGE. EXISTING PAVEMENT AND TURF TO BE COVERED WITH PROTECTIVE MATTING TO PREVENT DAMAGE. ANY ITEM TO SHOWN TO REMAIN THAT IS DAMAGED DURING CONSTRUCTION SHALL BE RESTORED TO THEIR ORIGINAL CONDITION AT NO ADDITIONAL COST TO THE OWNER.
 - THE CONTRACTOR SHALL SHEET/SHORE AND BRACE ANY AND ALL STRUCTURES EXPOSED BY EXCAVATION/CONSTRUCTION IF REQUIRED AND SHALL CONTAIN ALL EXCAVATION WITHIN THE LIMITS OF DISTURBANCE. CONTRACTOR SHALL BE RESPONSIBLE FOR DESIGN OF SHEETING AND SHORING IN ACCORDANCE WITH LOCAL, STATE, OR FEDERAL REQUIREMENTS.
 - IN THE EVENT THAT, DURING DEMOLITION OR CONSTRUCTION ACTIVITIES THE CONTRACTOR ENCOUNTERS ANY EXISTING UTILITIES/STRUCTURES NOT SHOWN ON THESE DRAWINGS, THE CONTRACTOR SHALL NOTIFY THE OWNER FOR DIRECTIONS PRIOR TO PROCEEDING WITH ANY WORK.
 - IT IS THE INTENT OF THIS DEMOLITION PHASE TO PROVIDE A SITE CLEAR OF ALL PHYSICAL CONSTRUCTIONS THAT WILL IMPEDE NEW CONSTRUCTION.
 - PRIOR TO THE START OF CONSTRUCTION AN ON-SITE MEETING WITH THE PROPERTY OWNER AND THEIR GENERAL CONTRACTOR SHALL BE HELD TO DISCUSS TIMING OF OPERATIONS AND CONSTRUCTION COORDINATION.
 - BEFORE ANY EXCAVATION BELOW SUBGRADE IS ALLOWED, THE CONTRACTOR SHALL VERIFY THAT NO UTILITY PIPING IS IN THE VICINITY OF EXCAVATION.
 - THE CONTRACTOR SHALL CALL "MISS UTILITY" AT 1-800-257-7777, 48 HOURS PRIOR TO THE START OF WORK. THE CONTRACTOR IS RESPONSIBLE FOR ENSURING THAT ALL UNDERGROUND UTILITIES IN THE AREA OF PROPOSED WORK ARE LOCATED PRIOR TO COMMENCING CONSTRUCTION WORK. THE CONTRACTOR IS RESPONSIBLE FOR COMPLIANCE WITH REQUIREMENTS OF HOWARD COUNTY CODE.
 - THE CONTRACTOR IS ALSO RESPONSIBLE FOR LOCATING ALL UNDERGROUND UTILITIES (NOT LOCATED BY MISS UTILITY) WITHIN THE PROPERTY AT THEIR EXPENSE. ALL UTILITIES SHOWN ON THE PLANS ARE PROVIDED FOR INFORMATION ONLY AND SHALL BE CONSIDERED APPROXIMATE. THE OWNER WILL NOT LOCATE ANY OF THE EXISTING UNDERGROUND UTILITIES. ANY UTILITIES OR OTHER UNDERGROUND FACILITIES DAMAGED DURING CONSTRUCTION SHALL BE REPAIRED/REPLACED AT THE CONTRACTOR'S EXPENSE.
 - WHEN AN ITEM IS STATED TO BE REMOVED, IT SHALL INCLUDE REMOVAL OF ANY AND ALL APPURTENANCES ABOVE OR BELOW GRADE ASSOCIATED WITH SAID ITEM.
 - ALL GRASS AREAS TO BE DISTURBED ARE TO BE STABILIZED WITH SOD OR AS INDICATED.
 - ALL MANHOLES, VALVES, OR OTHER UTILITY STRUCTURES LOCATED WITHIN THE LIMITS OF DISTURBANCE SHALL HAVE THEIR LIDS MODIFIED TO MEET PROPOSED GRADES.
 - CONTRACTOR SHALL PREVENT SEDIMENT FROM LEAVING PROJECT SITE OR ENTERING STORM DRAINS. PROVIDE SEDIMENT CONTROLS AS NECESSARY.

**RIVER FRONT APARTMENTS
 POOL HOUSE REMODEL**
 8905 RIVER ISLAND DRIVE
 SAVAGE, MD 20763


SITE PLAN
 1" = 10'

LEGEND

	EXISTING SIDEWALK		PROPOSED CONCRETE SIDEWALK
	EXISTING FENCE		PROPOSED HEAVY DUTY CONCRETE PAVEMENT
	EXISTING CURB		PROPOSED ASPHALT PAVEMENT
	EXISTING ROAD MARKING		PROPOSED MILL AND OVERLAY
	EXISTING PROPERTY LINE		
	EXISTING EDGE OF PAVEMENT		
	EXISTING BUILDING		
	EXISTING TREE LINE		
	EXISTING CURB INLET		
	EXISTING GRATE INLET		
	EXISTING MANHOLE		
	EXISTING TREE		
	EXISTING LIGHT POLE		
	EXISTING FIRE HYDRANT		
	EXISTING SIGN		
	PROPOSED CURB & GUTTER		
	PROPOSED FENCE		
	PROPOSED SIGN		
	PROPOSED HANDRAIL		

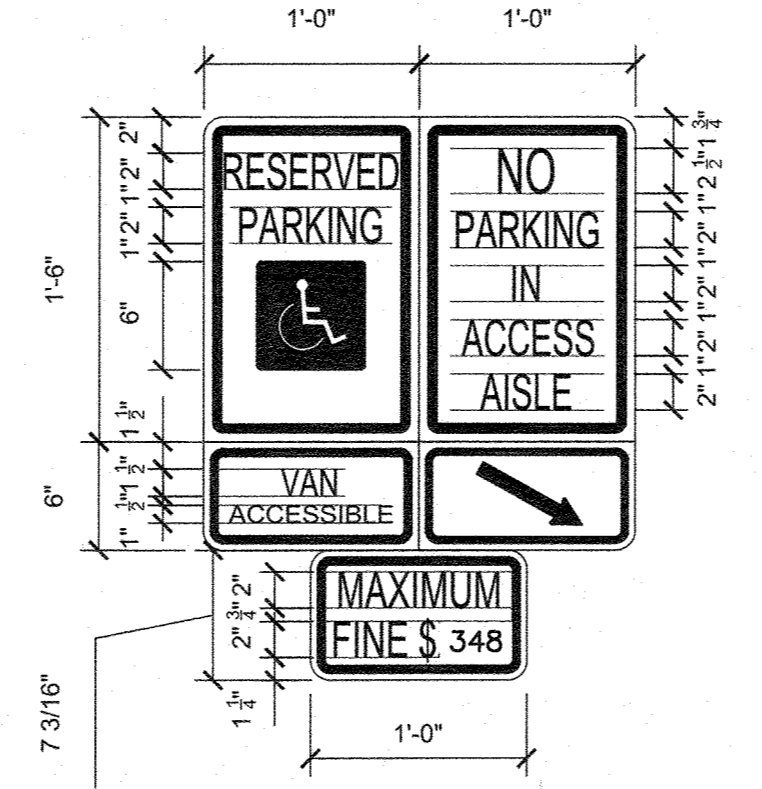

1 COMBINED ADA SIGN DETAIL
 NOT TO SCALE

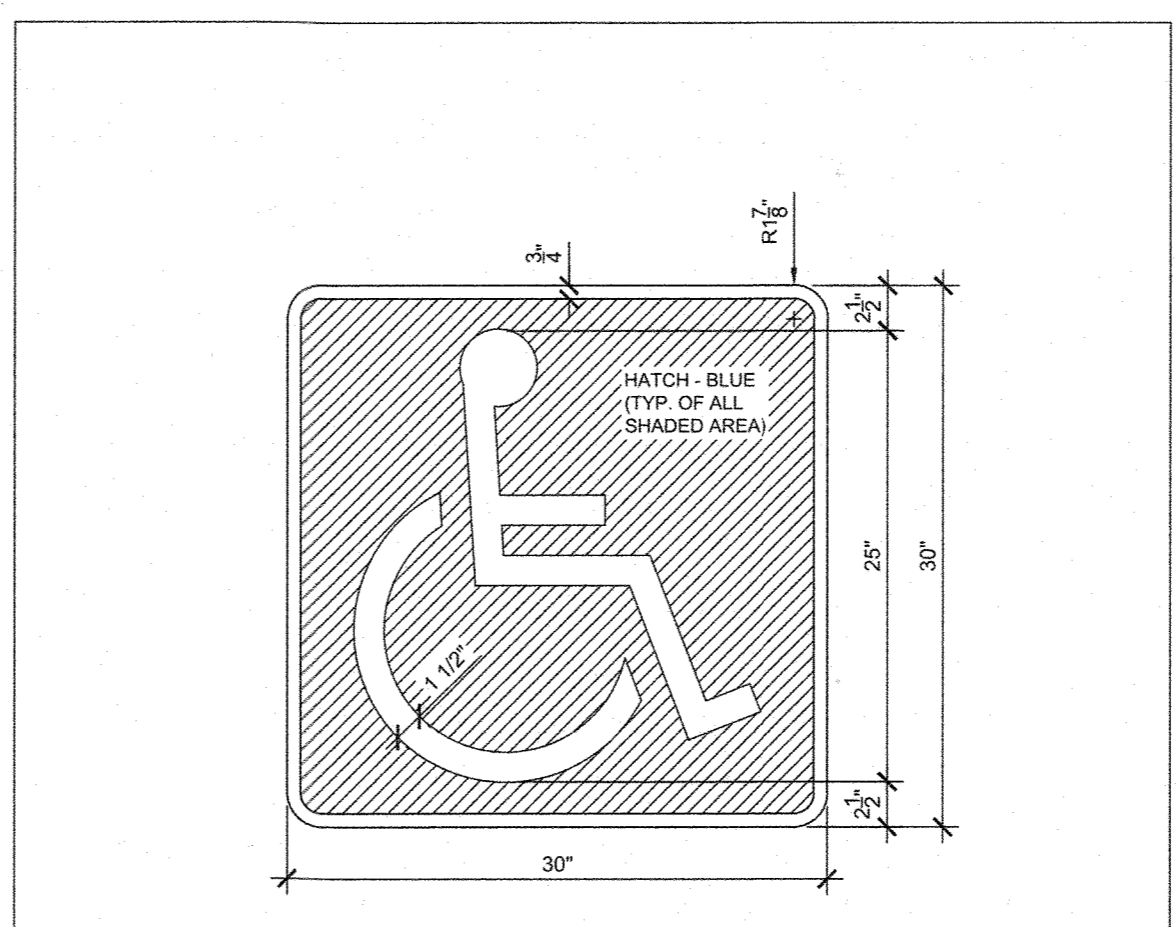

ACCESSIBLE PARKING SPACE SYMBOL LAYOUT
 Scale: 1/2" = 1'-0"

- NOTES:**
- PLACE TEMPLATE @ CENTERLINE OF STALL REFER TO PARKING STRIPING DETAIL THIS SHEET FOR DIMENSIONS.
 - SYMBOL AND BORDER COLOR: WHITE (RETRO-REFLECTIVE)
 BACKGROUND COLOR: BLUE (RETRO-REFLECTIVE)
 - THIS DETAIL CONFORMS TO THE MOST CURRENT MARYLAND STATE HIGHWAY ADMINISTRATION DETAIL D94.
 - OPTIMUM APPLICATION OF PAINT AFTER CONCRETE CURE: 14 (DAYS).

2 ACCESSIBLE PARKING SPACE SYMBOL
 The Maryland-National Capital Park and Planning Commission
 Montgomery County Department of Parks
 Detail No. **402**
 MARCH 2019

J:\715.001 - River Island Drive\CAD\DWG\C-200 - SITE PLAN.dwg 11/18/2021 9:12 AM

APPROVED: DEPARTMENT OF PLANNING AND ZONING

 Chief, Development Engineering Division
 Date: 11/29/21

 Chief, Division of Land Development
 Date: 12/2/21


 Director
 Date: 12/2/21

NO.	DATE	DESCRIPTION
1	10/05/21	Revised #3, Parking / sidewalk

0 10' 20'
 GRAPHIC SCALE

DATE: AUG 2021
 CAA PROJECT NO.: 715.001
 DRAWN BY: MD
 CHECKED BY: JA

SHEET TITLE
SITE PLAN
 SHEET
3 OF 5
SDP-73-011

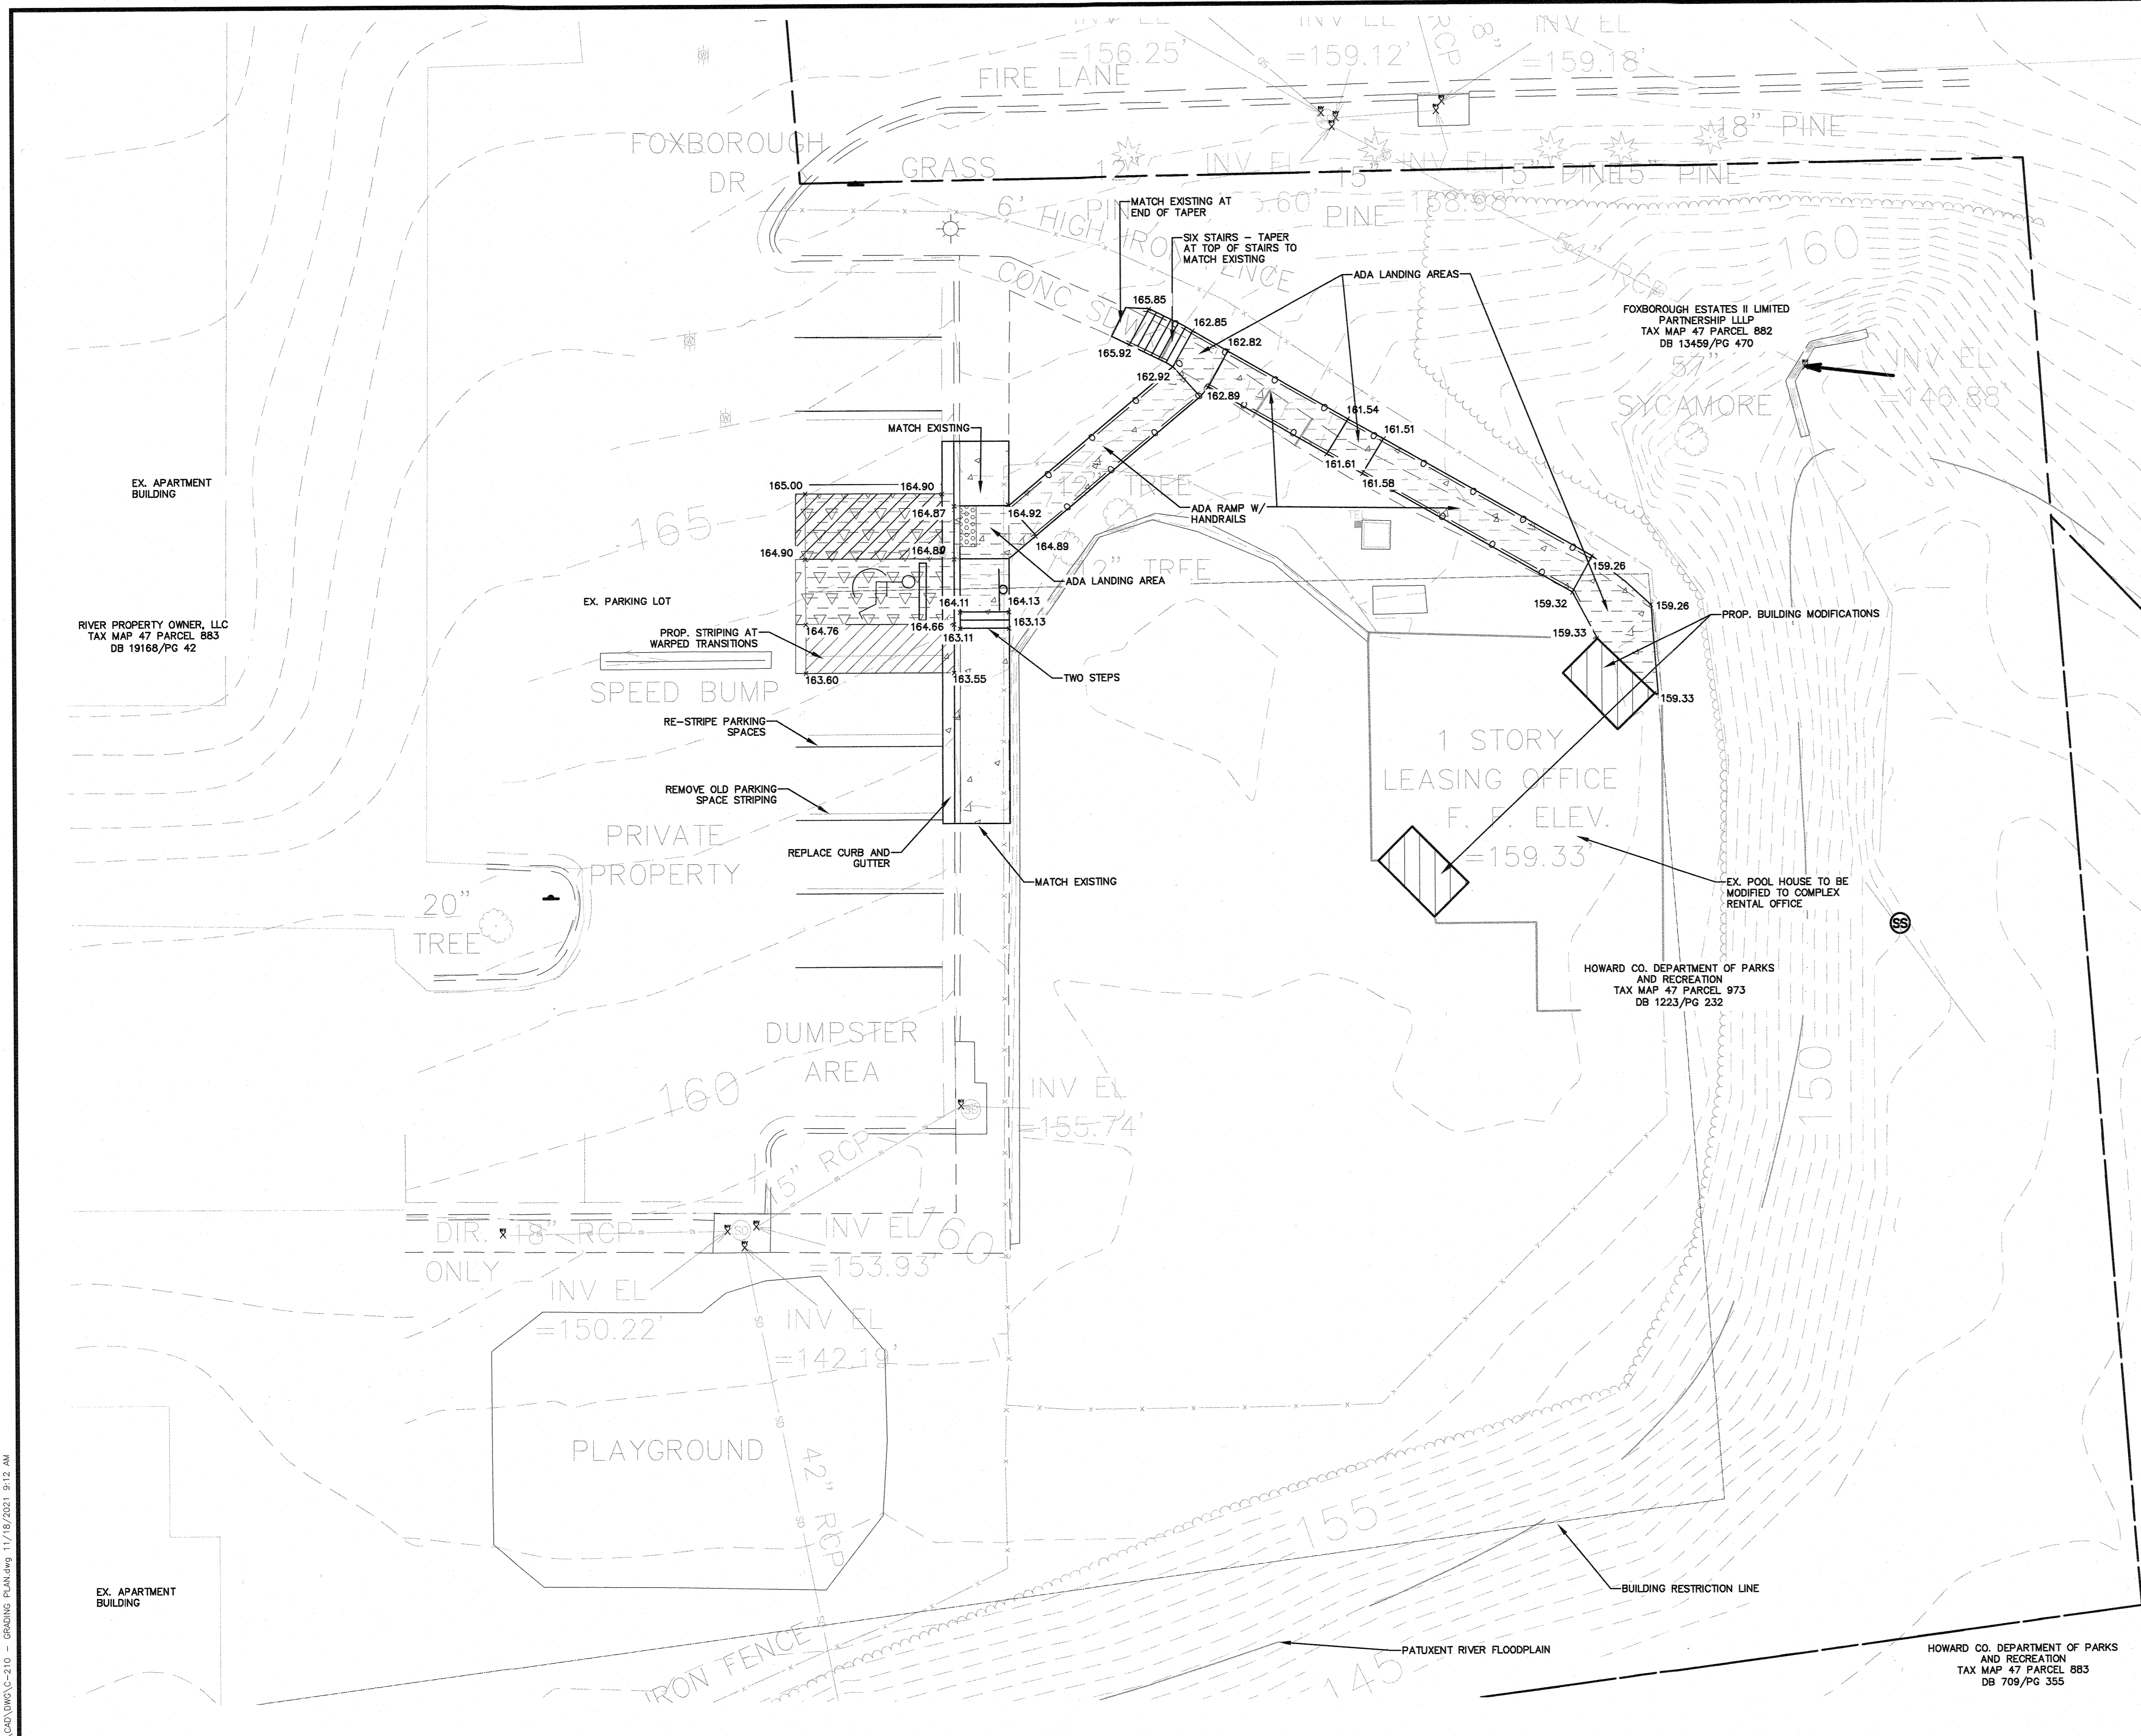

ADA GRADING LEGEND

	SIDEWALK LANDING, 1.75% MAX DESIGN SLOPE IN ANY DIRECTION
	SIDEWALK RAMP, 8.0% MAX DESIGN LONGITUDINAL SLOPE AND 1.5% MAX DESIGN CROSS SLOPE

CLARK | AZAR & ASSOCIATES
 20440 Century Blvd, Suite 220
 Germantown, MD, 20874
 T(301) 528-2010
 www.clarkazar.com
 A Woman Owned Small Business

STATE OF MARYLAND
 PROFESSIONAL ENGINEER
 PROFESSIONAL CERTIFICATION:
 I CERTIFY THAT THESE DOCUMENTS WERE PREPARED OR APPROVED BY ME, AND THAT I AM A DULY LICENSED PROFESSIONAL ENGINEER UNDER THE LAWS OF THE STATE OF MARYLAND.
 LICENSE NO. 31168
 EXPIRATION DATE: 01/12/2023

**RIVER FRONT APARTMENTS
 POOL HOUSE REMODEL**
 8905 RIVER ISLAND DRIVE
 SAVAGE, MD 20763

NO.	DATE	DESCRIPTION
1	10/05/21	REVISION #3 Parking/sidewalk

0 10' 20'
 GRAPHIC SCALE

DATE:	AUG 2021
CAA PROJECT NO.:	715.001
DRAWN BY:	MD
CHECKED BY:	JA
SHEET TITLE	

GRADING PLAN





SHEET
 4 OF 5
 SDP-73-011

APPROVED: DEPARTMENT OF PLANNING AND ZONING

	11.29.21
Chief, Development Engineering Division	Date
	12/2/21
Chief, Division of Land Development	Date
	12/2/21
Director	Date





GRADING PLAN
 1" = 10'

J:\715001 - River Island Drive\CD\DWG\0-210 - 080216.dwg 11/18/2021 9:12 AM

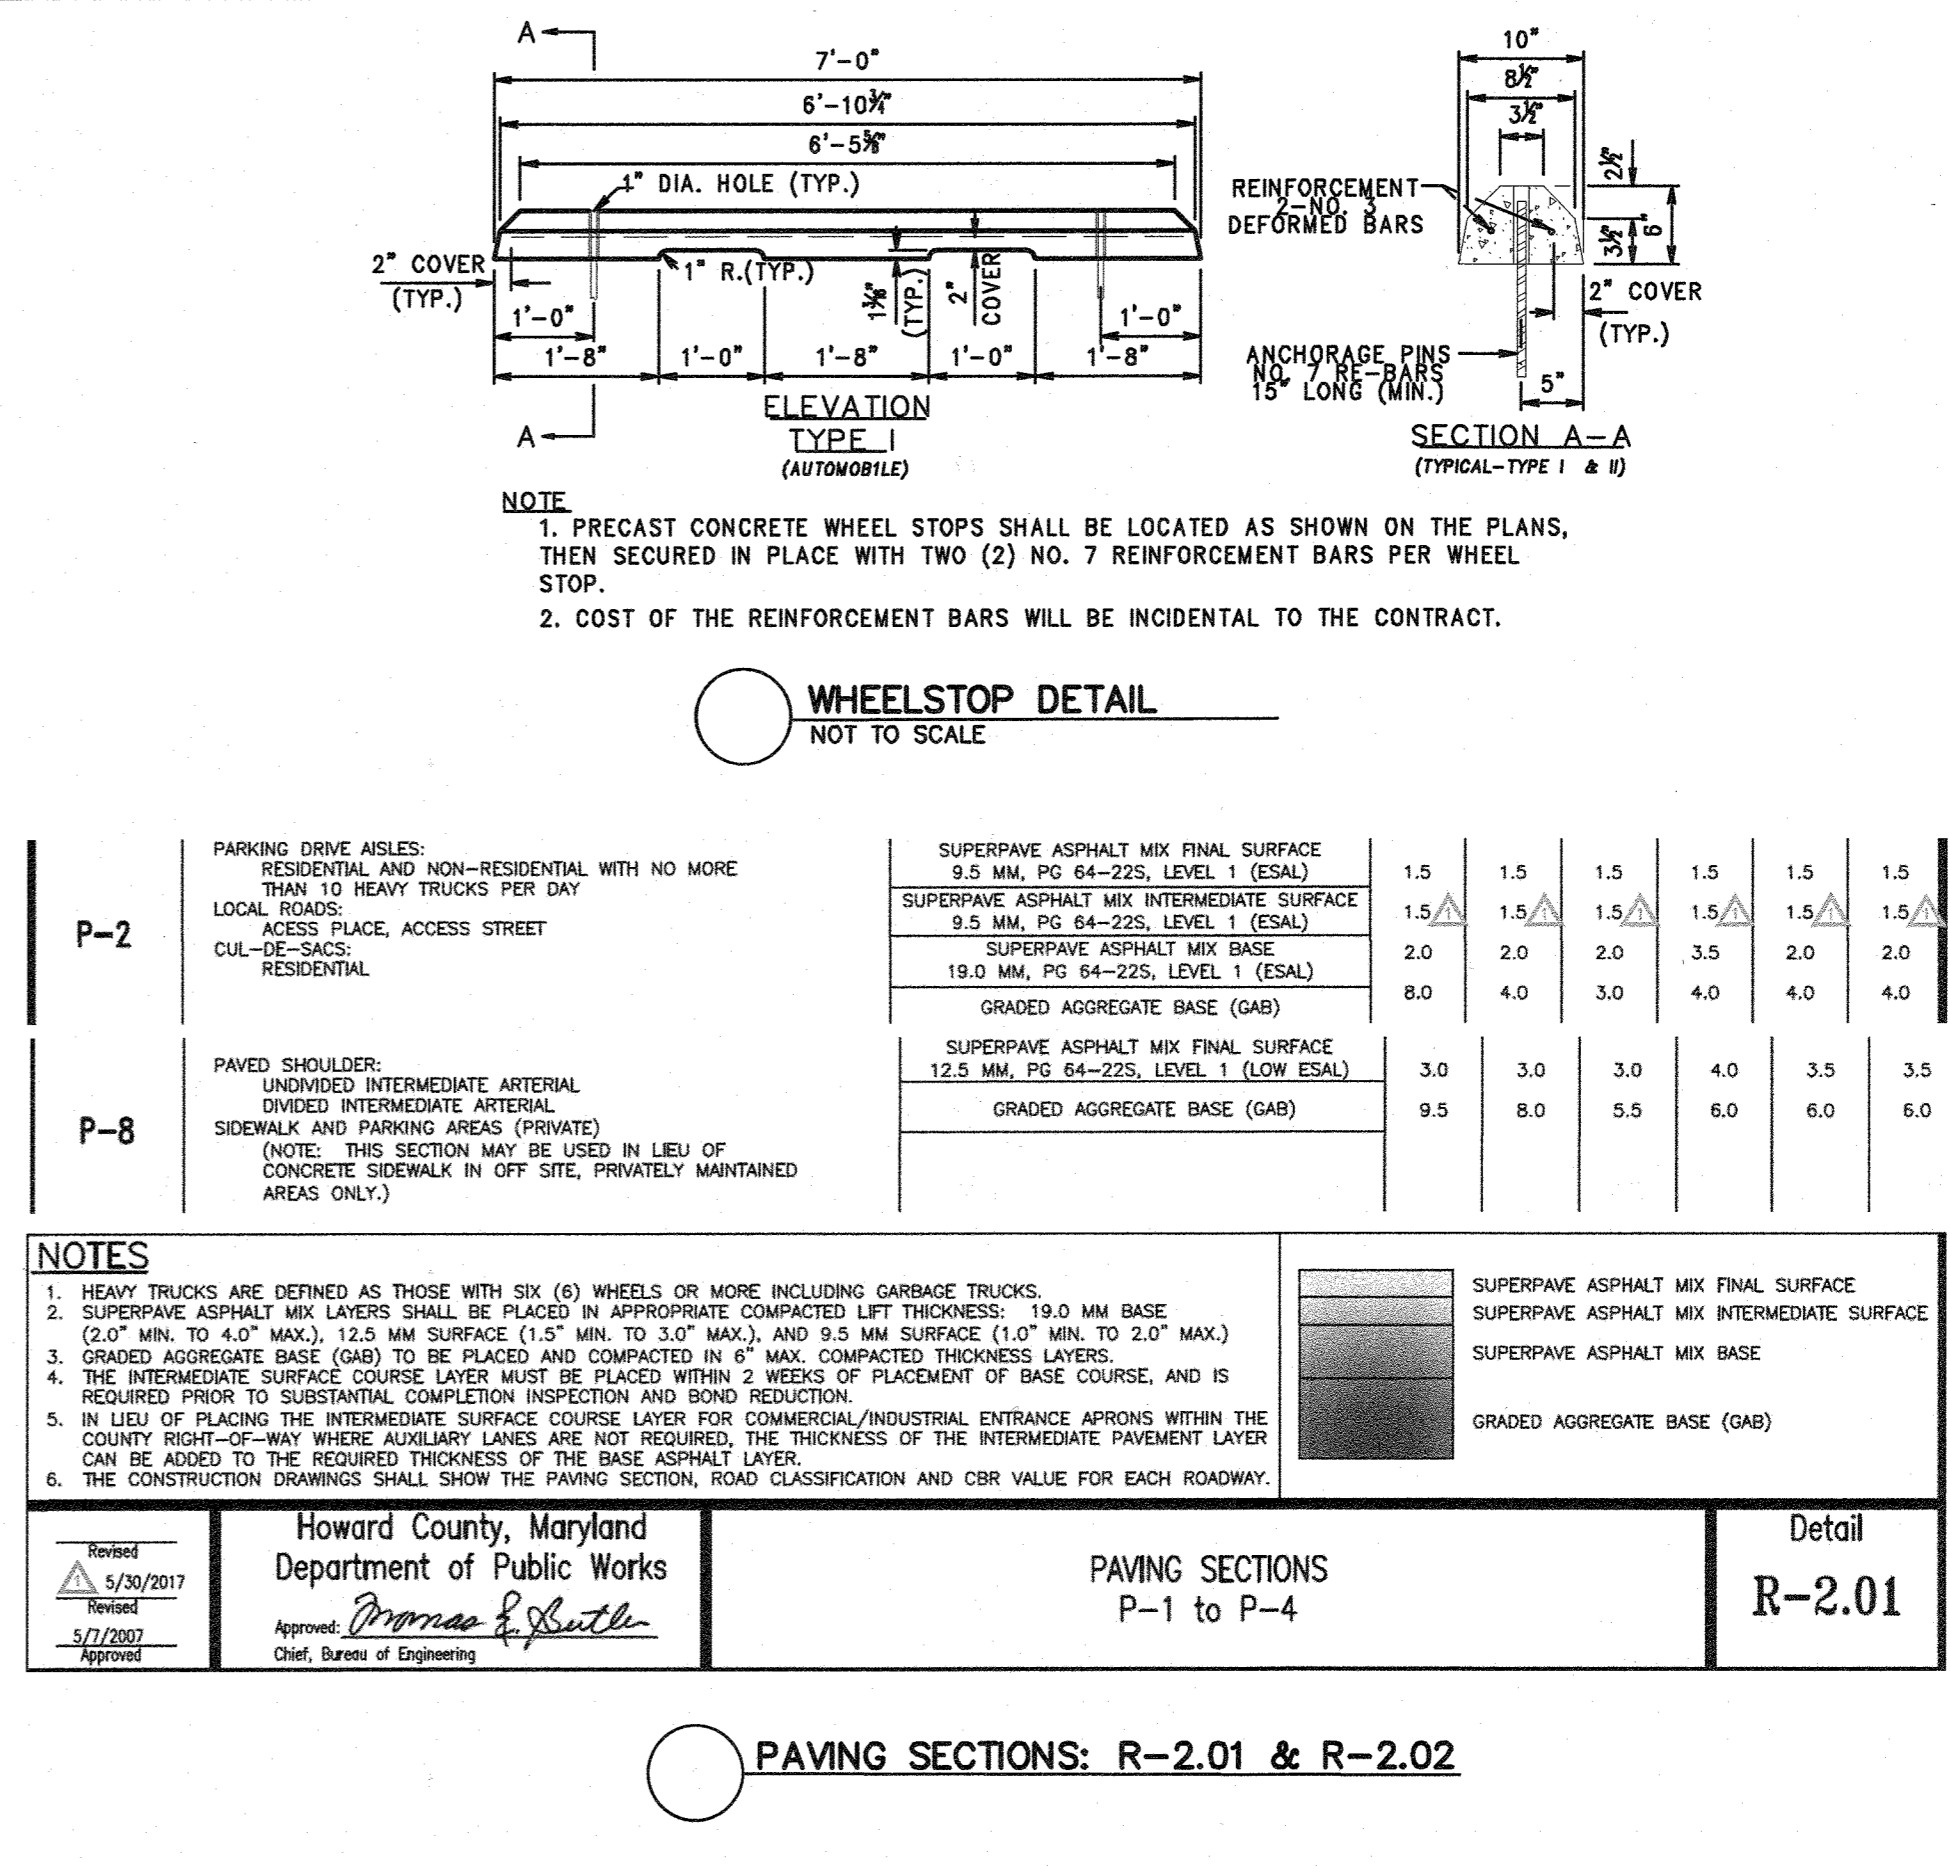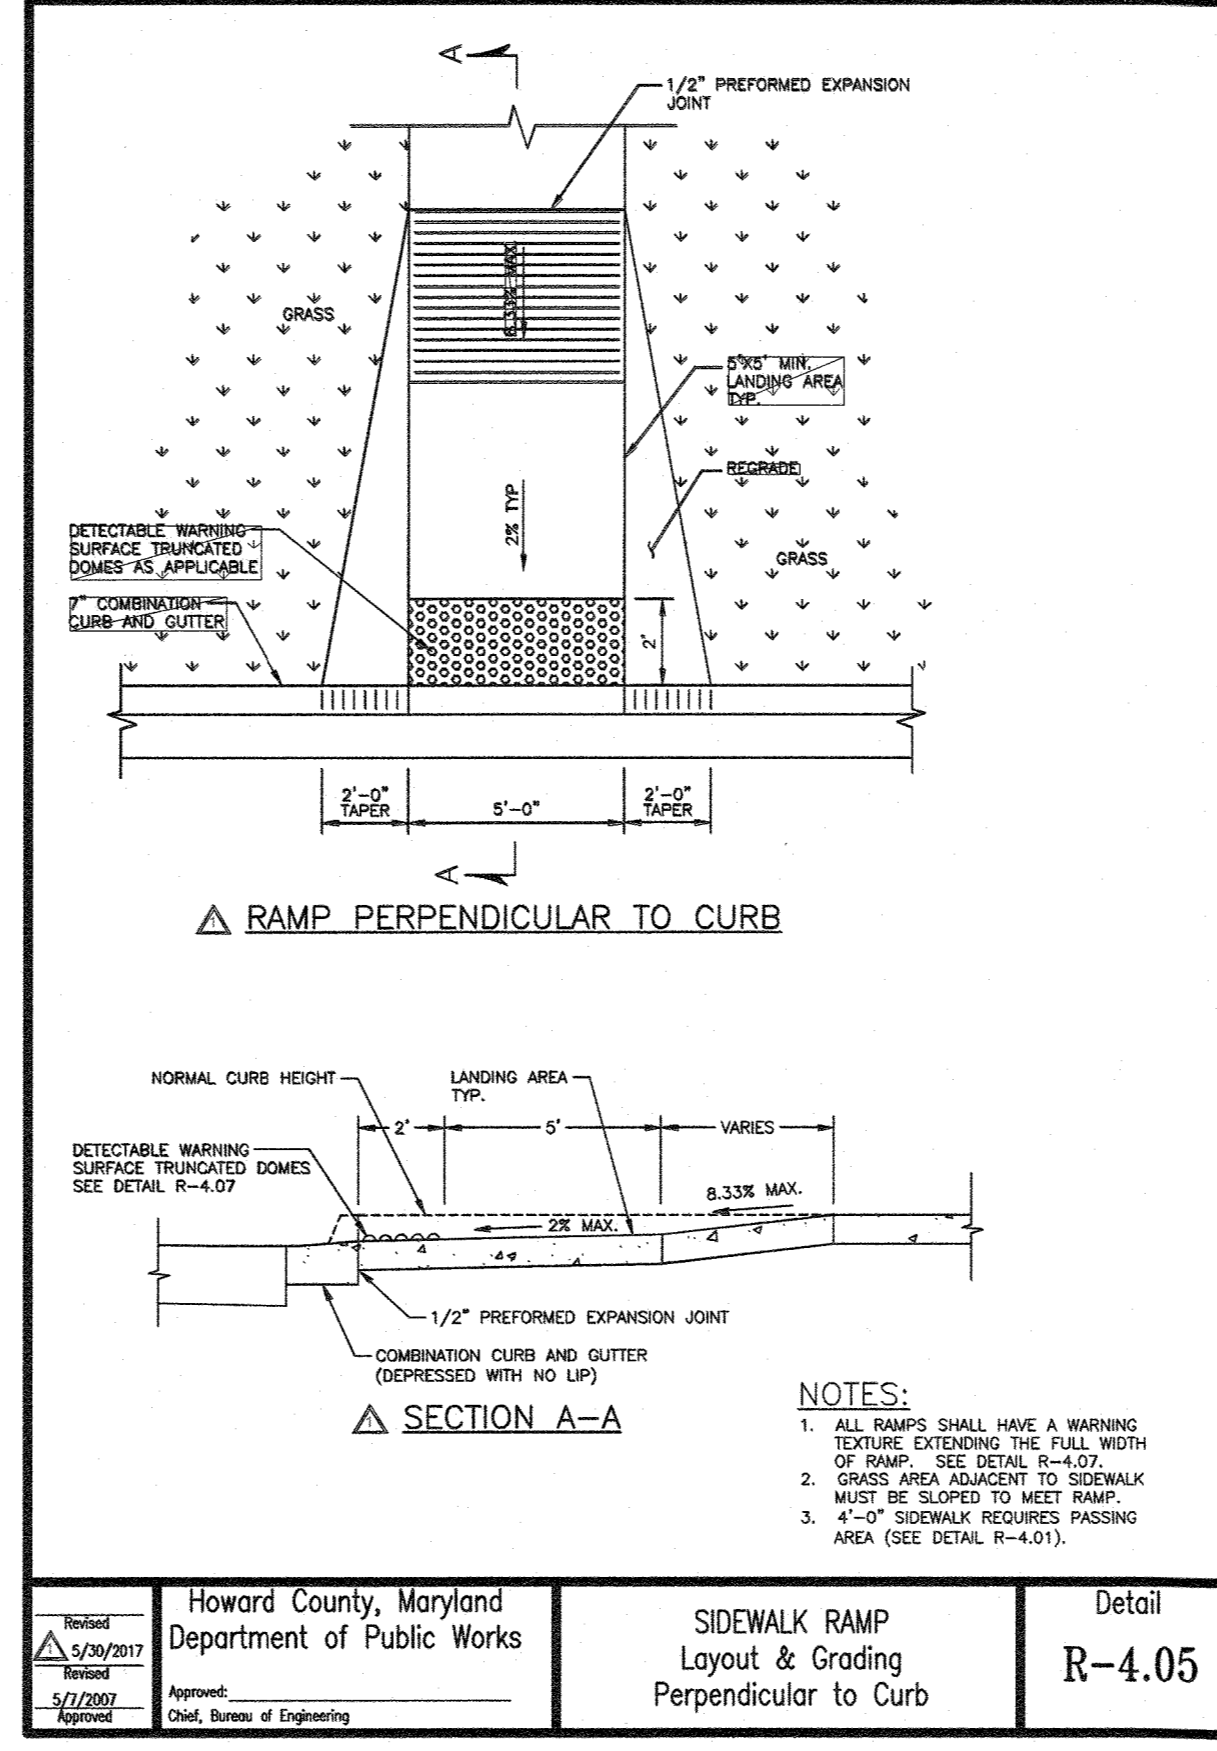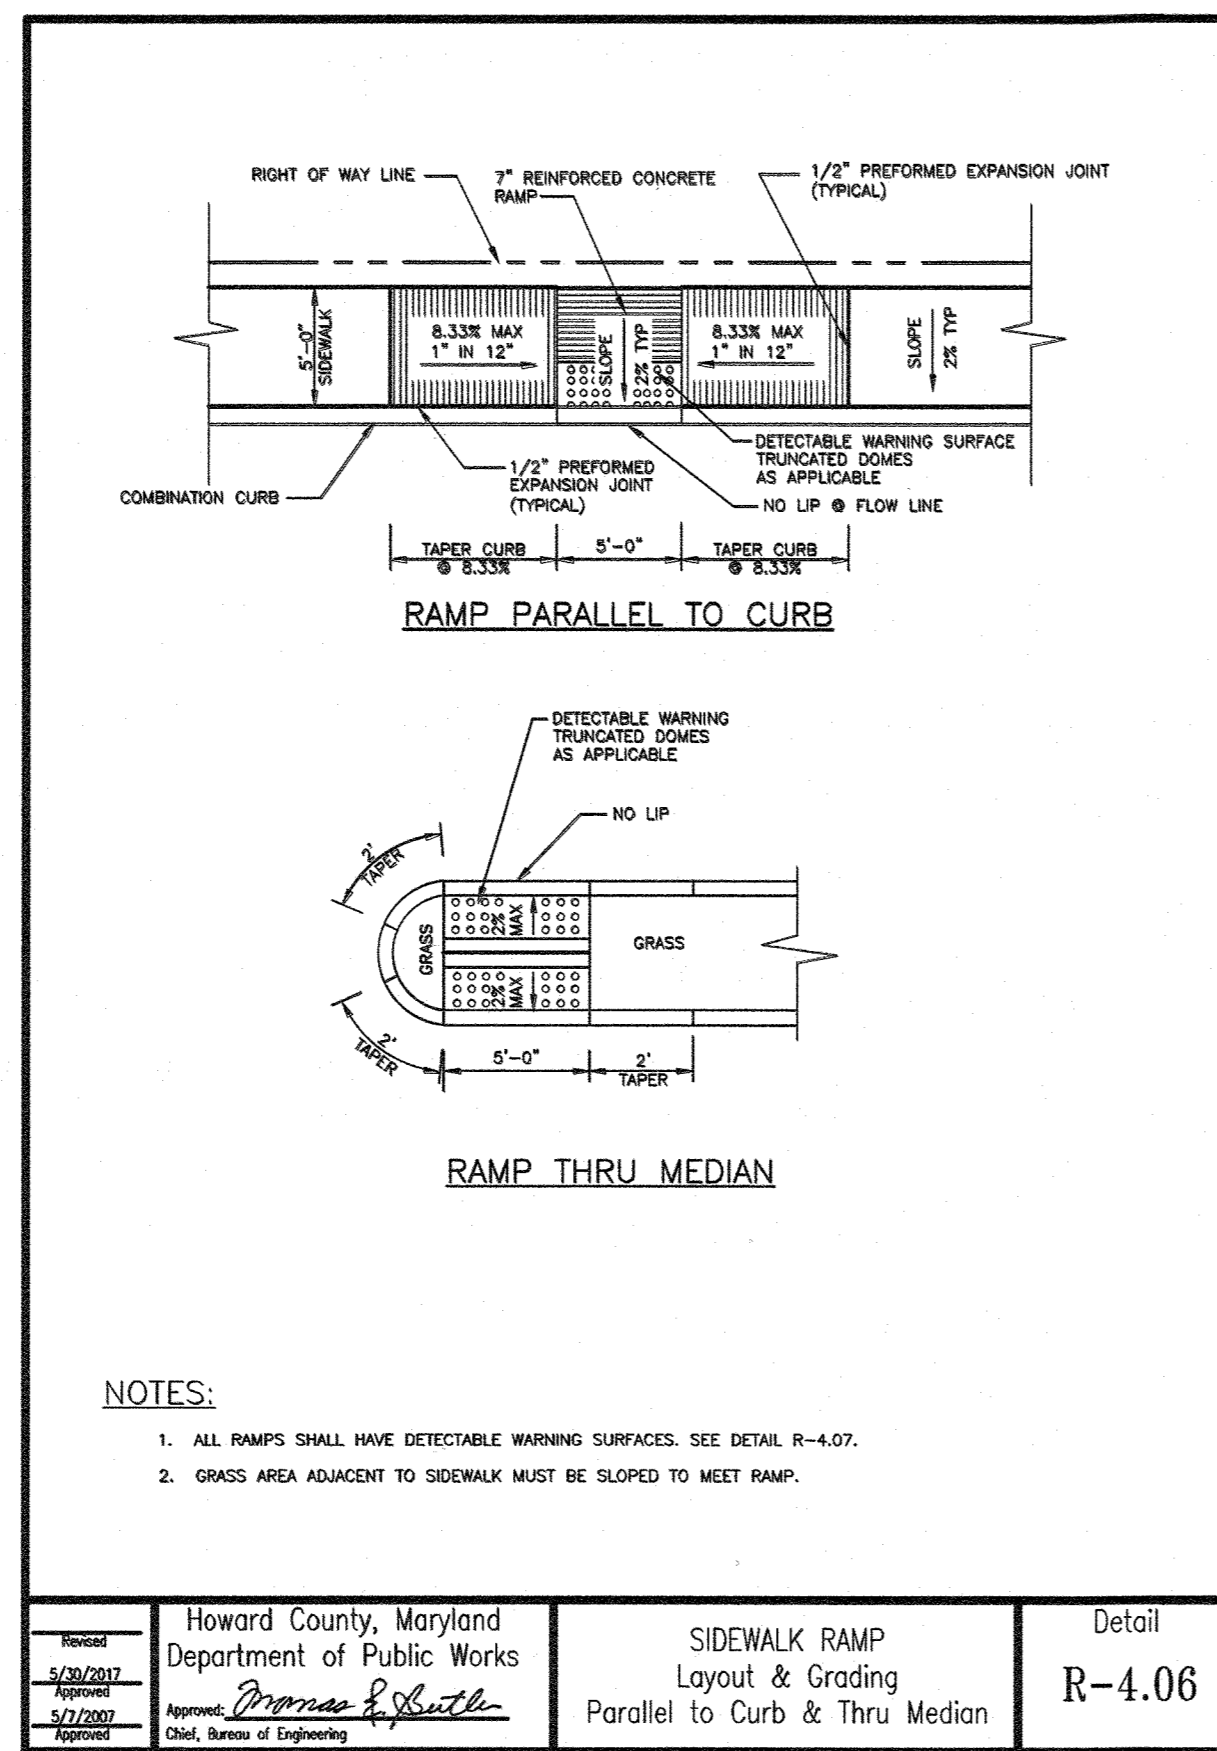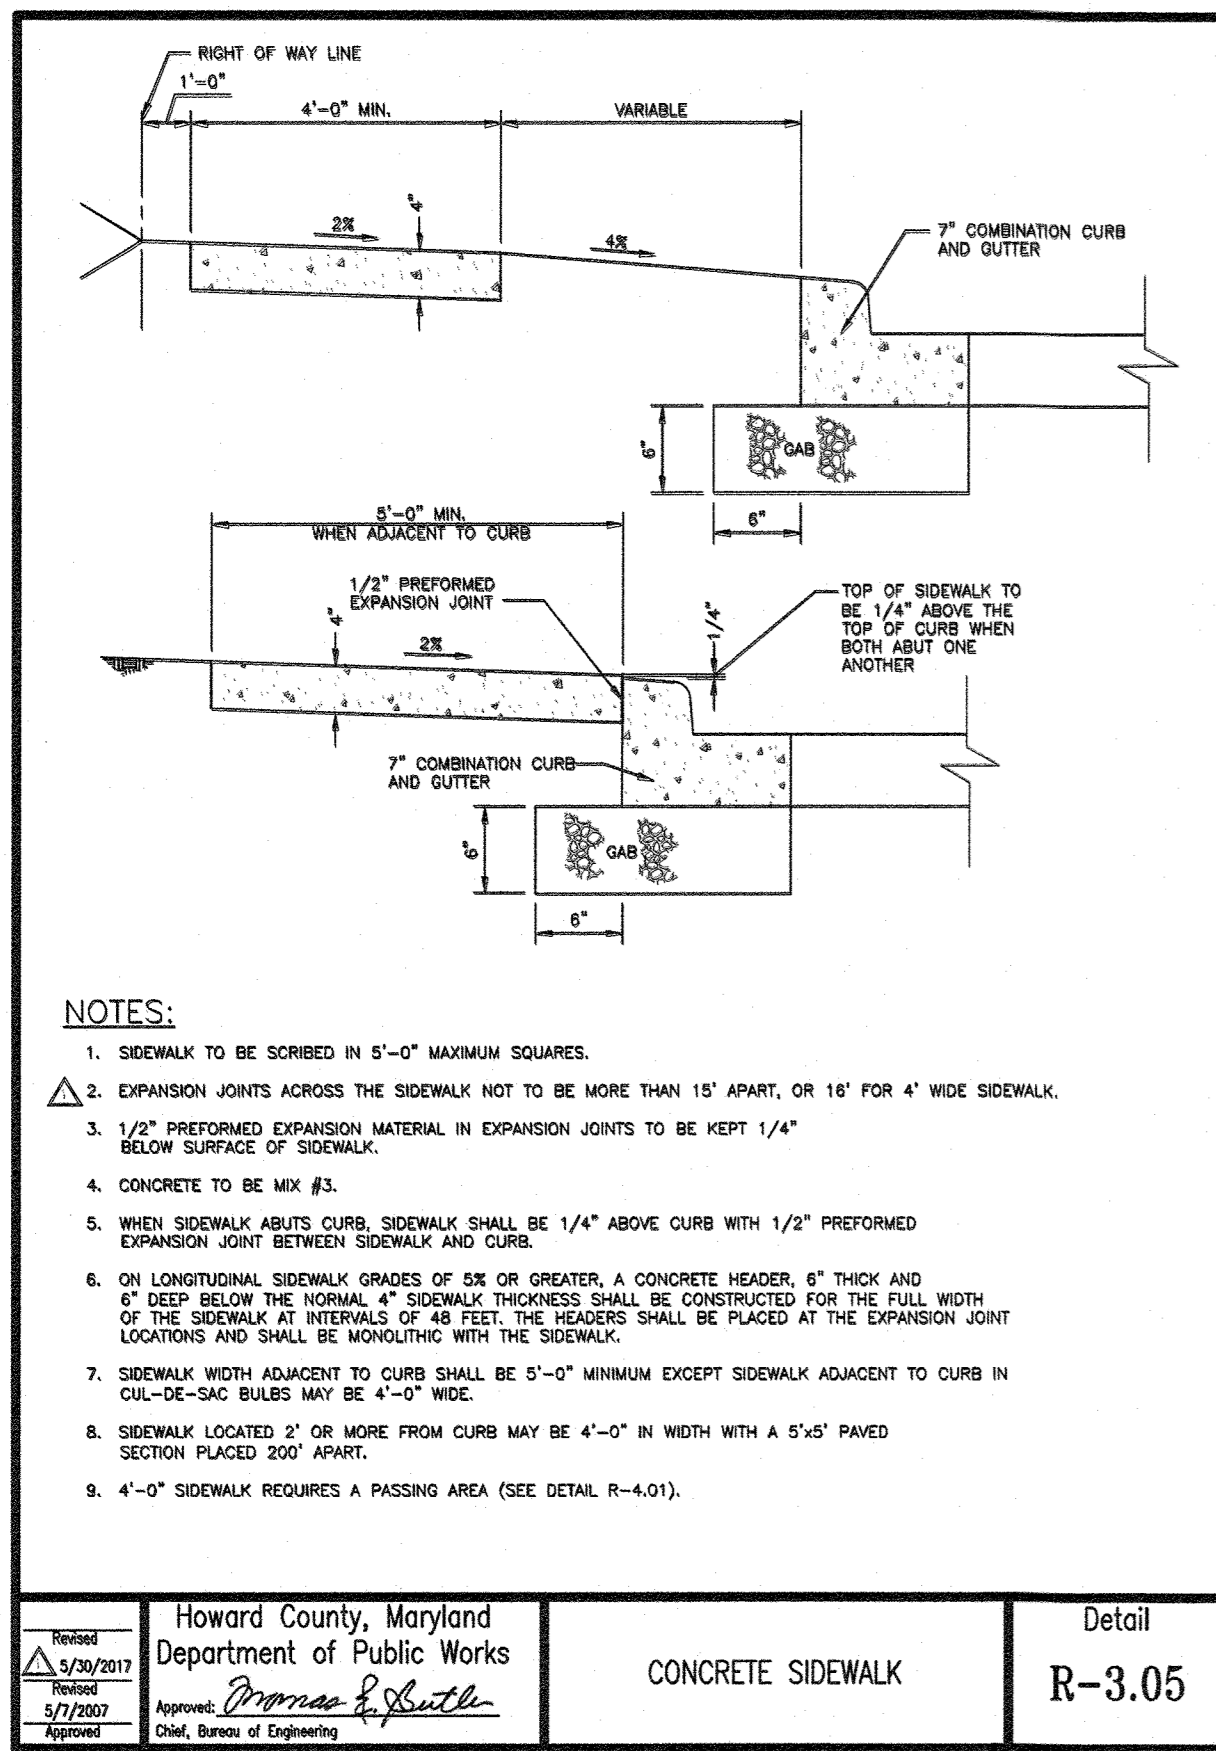

PROFESSIONAL CERTIFICATION:
I CERTIFY THAT THESE DOCUMENTS WERE PREPARED OR APPROVED BY ME, AND THAT I AM A DULY LICENSED PROFESSIONAL ENGINEER UNDER THE LAWS OF THE STATE OF MARYLAND.
LICENSE NO. 31168
EXPIRATION DATE: 01/12/2023

**RIVER FRONT APARTMENTS
POOL HOUSE REMODEL**
8905 RIVER ISLAND DRIVE
SAVAGE, MD 20763

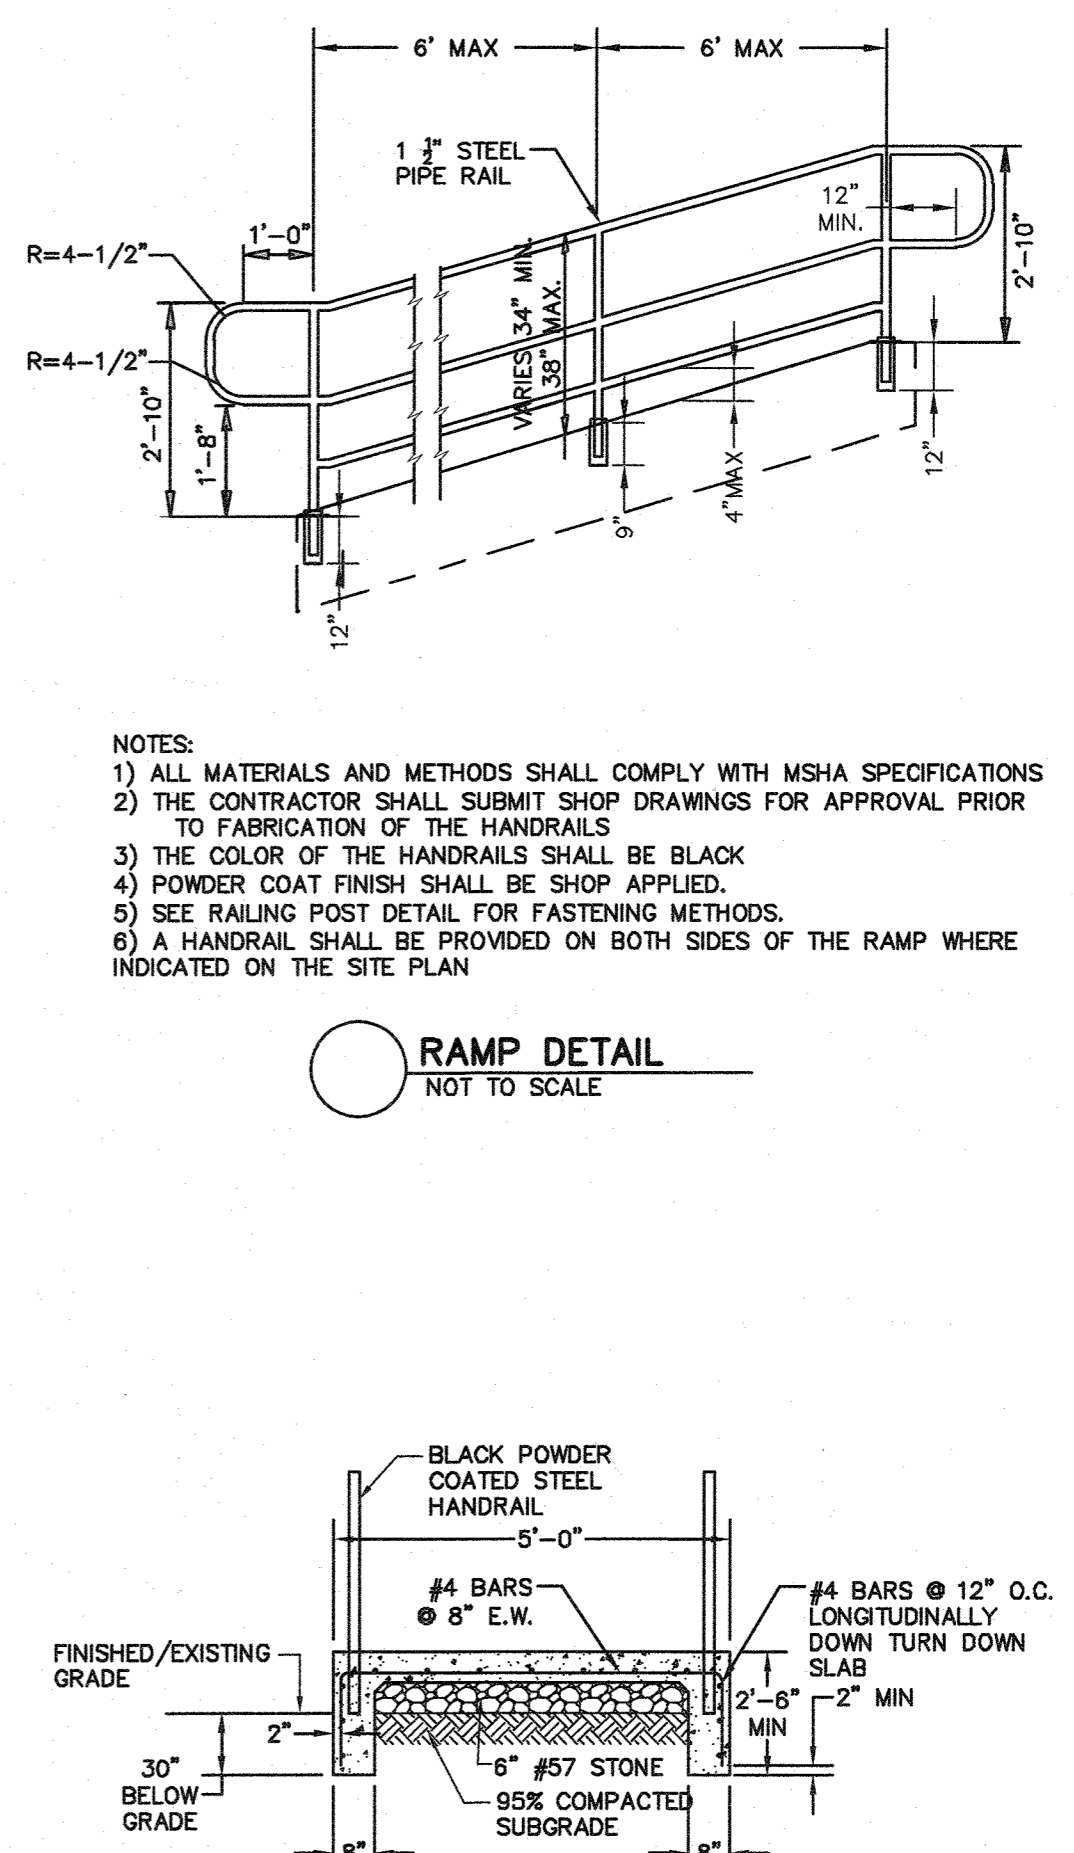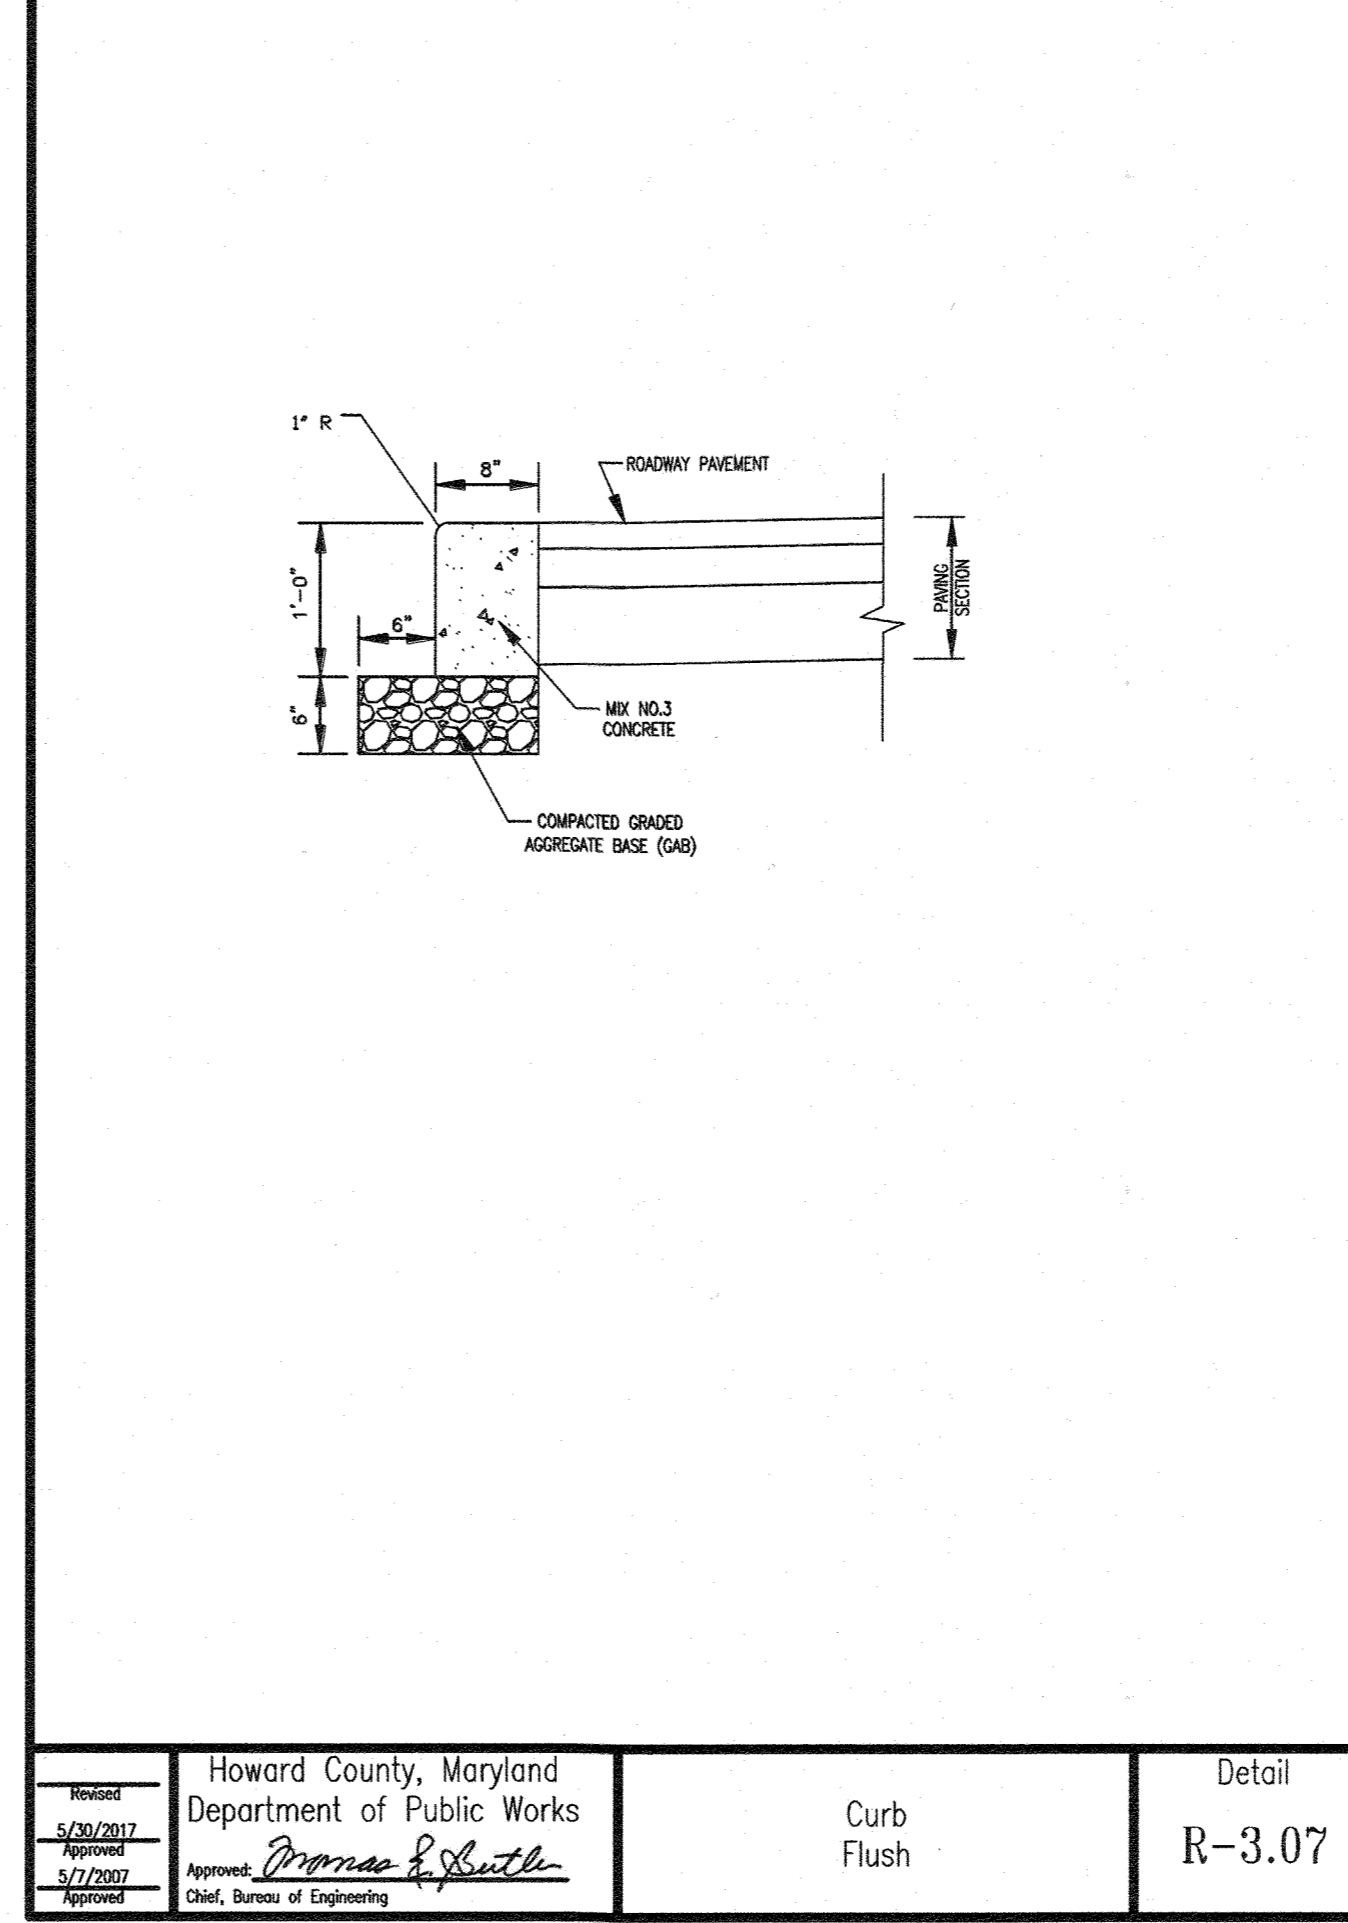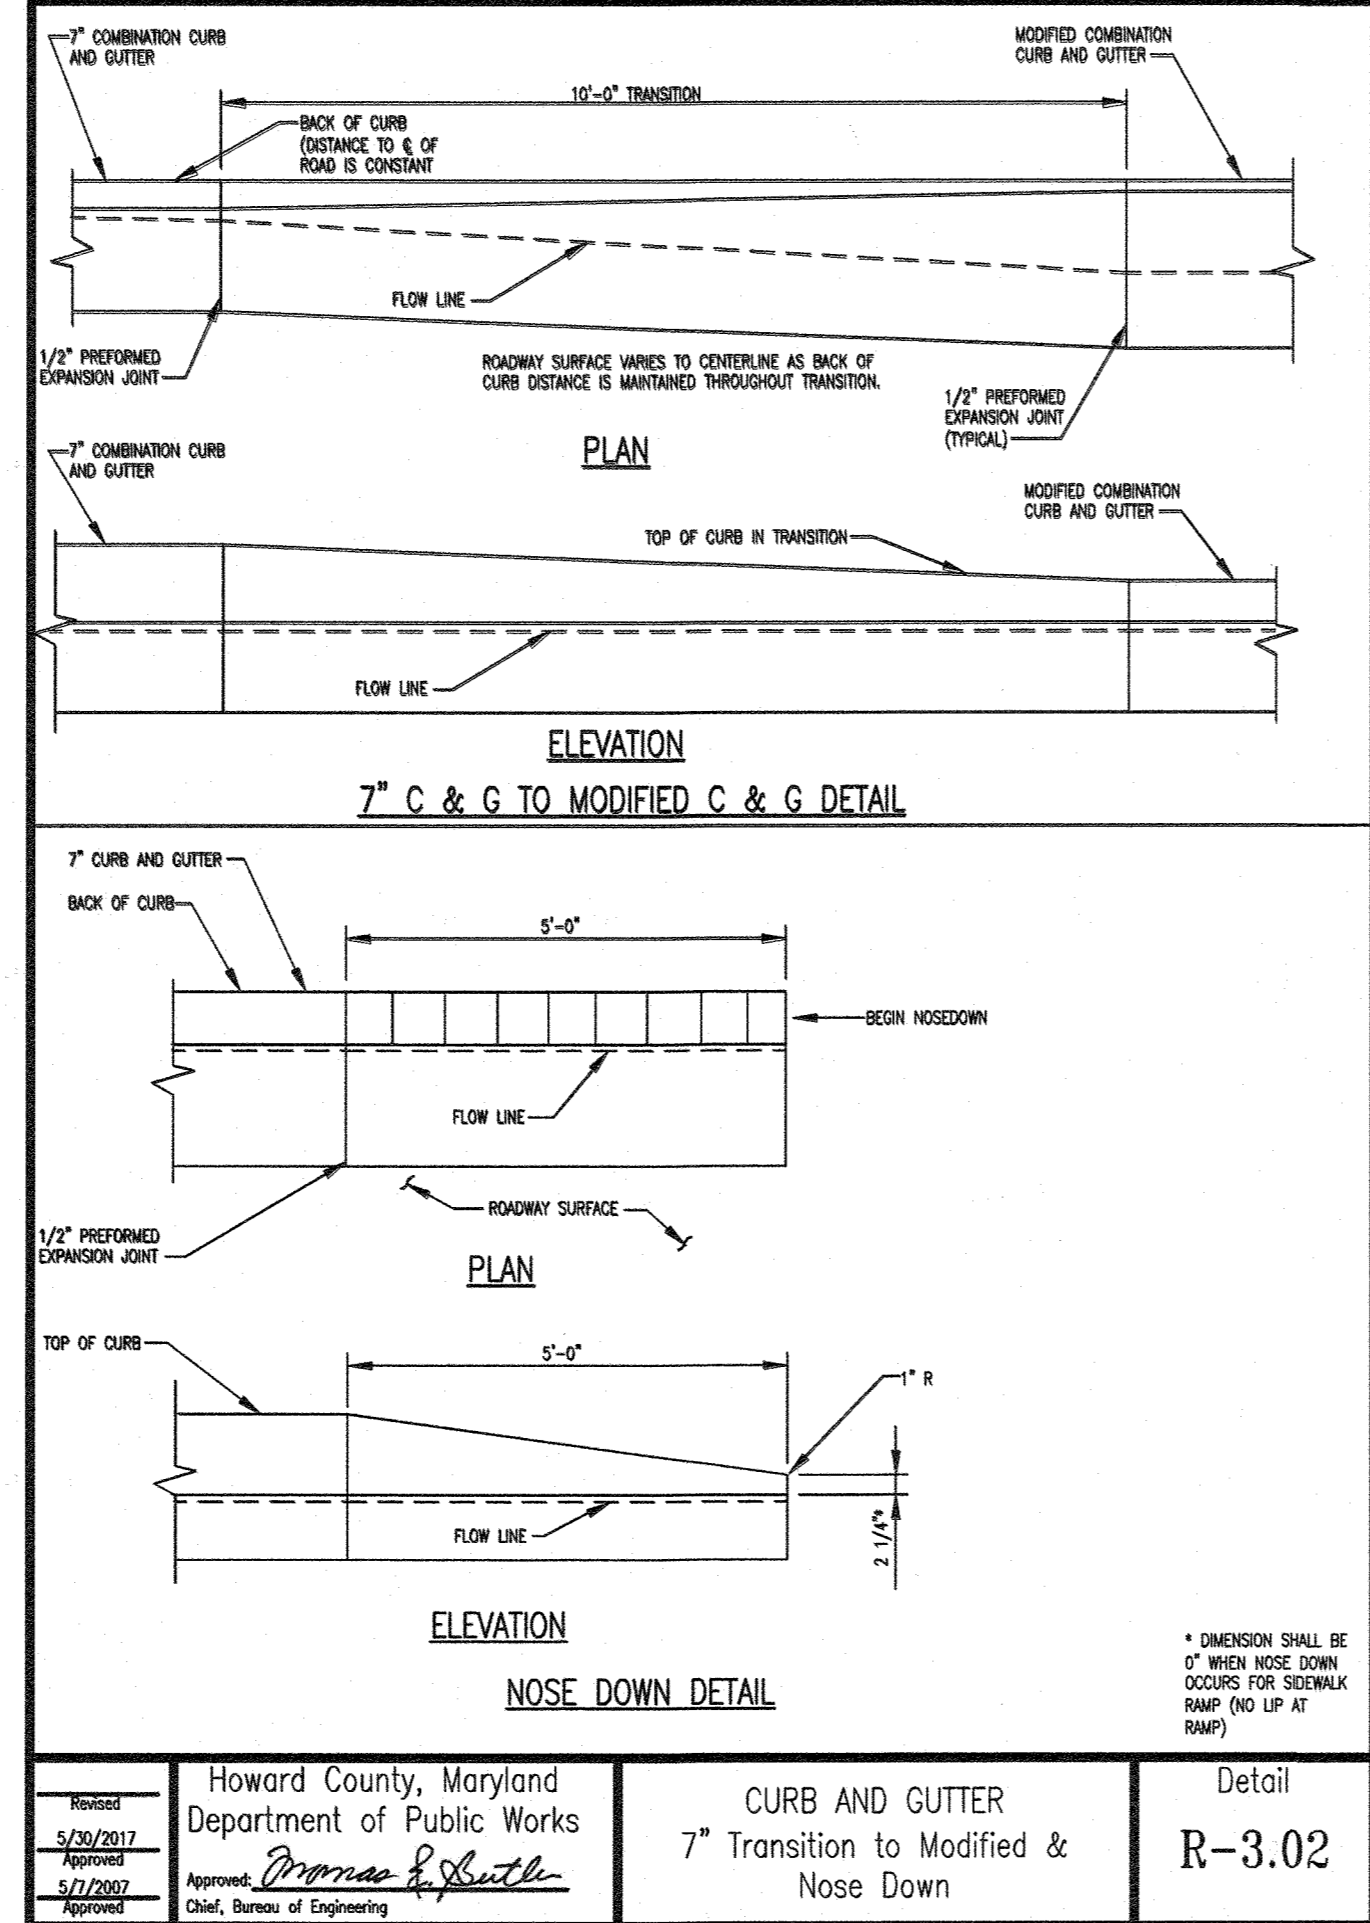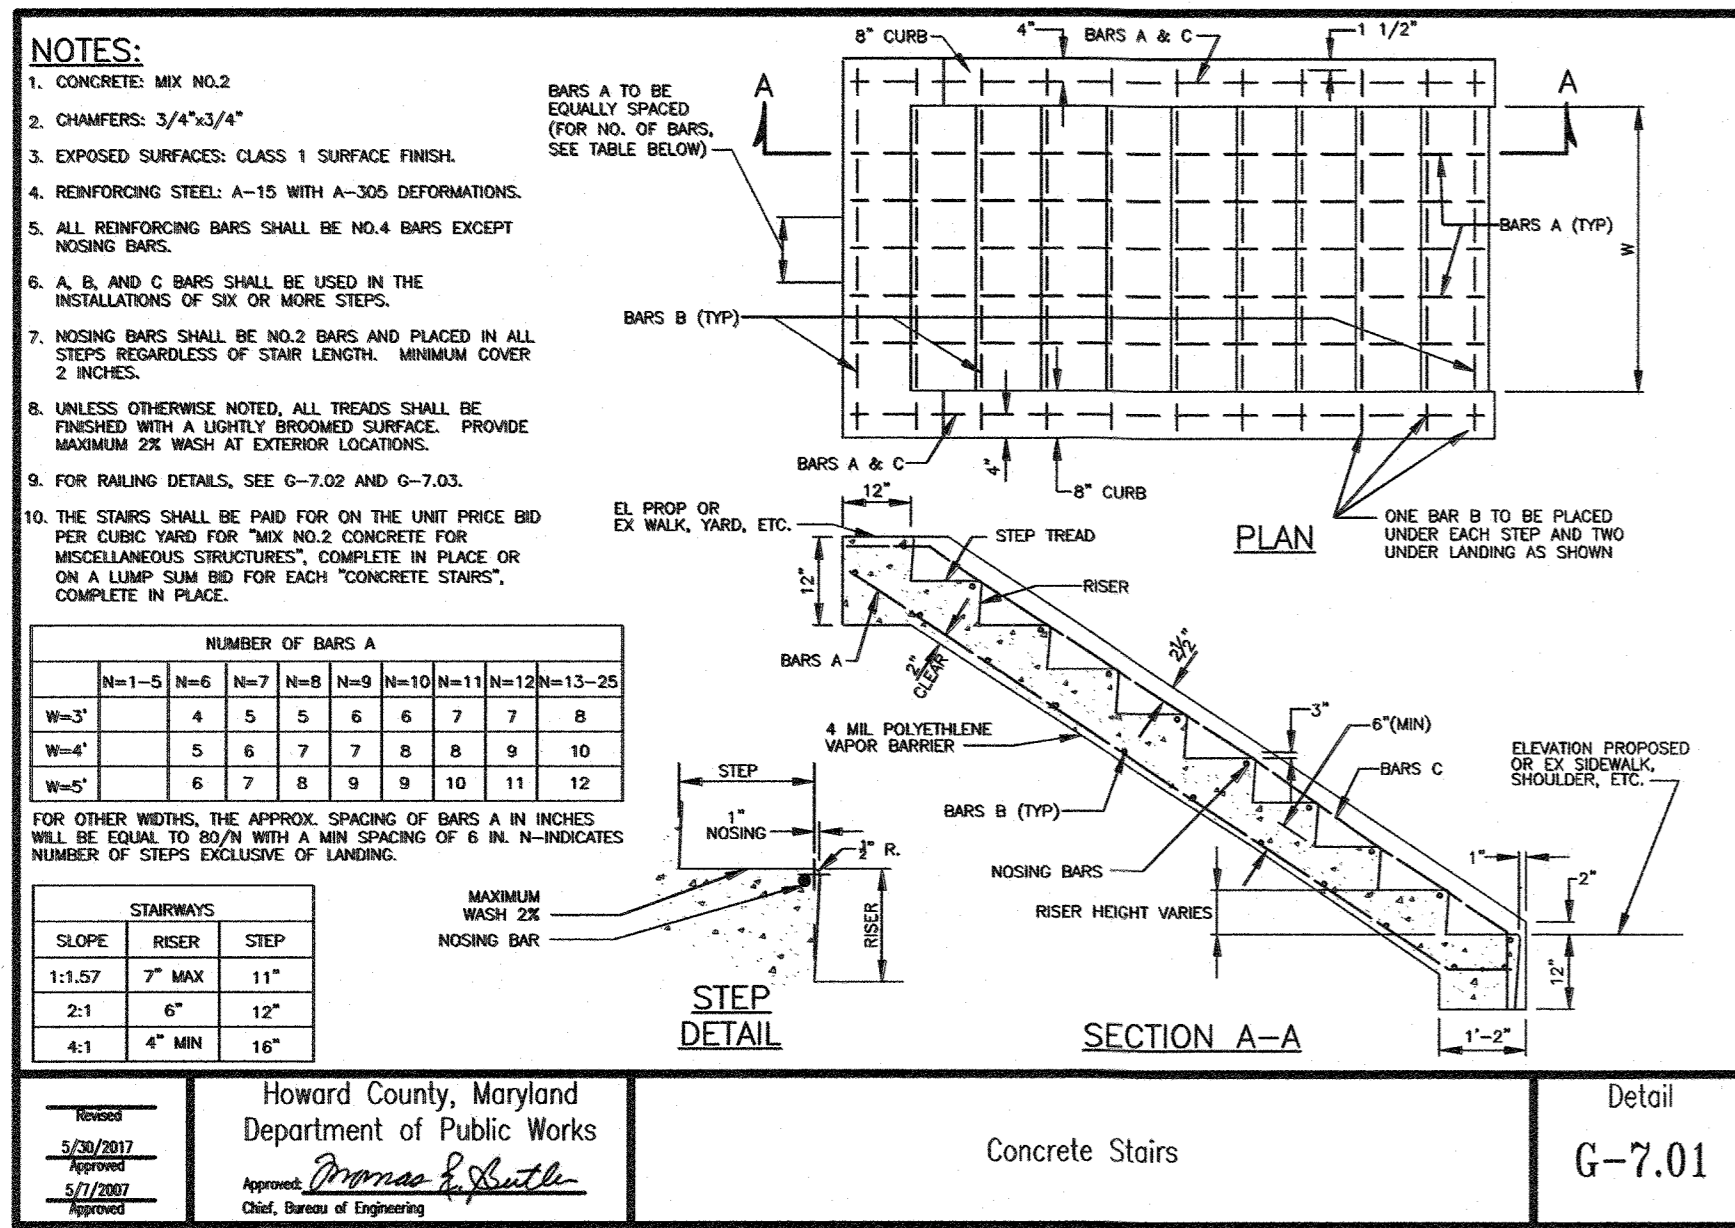

NO.	DATE	DESCRIPTION
1	10/05/21	REVISION #3: Re-bar layout / sidewalk

DATE: AUG 2021
CAA PROJECT NO.: 715.001
DRAWN BY: MD
CHECKED BY: JA
SHEET TITLE

SITE DETAILS
SHEET
5 OF 5
SDP-73-011

APPROVED: DEPARTMENT OF PLANNING AND ZONING
Chief Development Engineering Division
Chief Division of Land Development
Director

11-29-21
12/2/21
12/2/21