


NOTE: THE LOTS OR PARCELS SHOWN ON THIS PLAN ARE SUBJECT TO THE SUPPLEMENTAL SEWER IN-AID-OF-CONSTRUCTION CHARGE CREATED BY SECTION 20.311A OF THE HOWARD COUNTY CODE AND TO EXECUTIVE ORDER NO. 72-2.

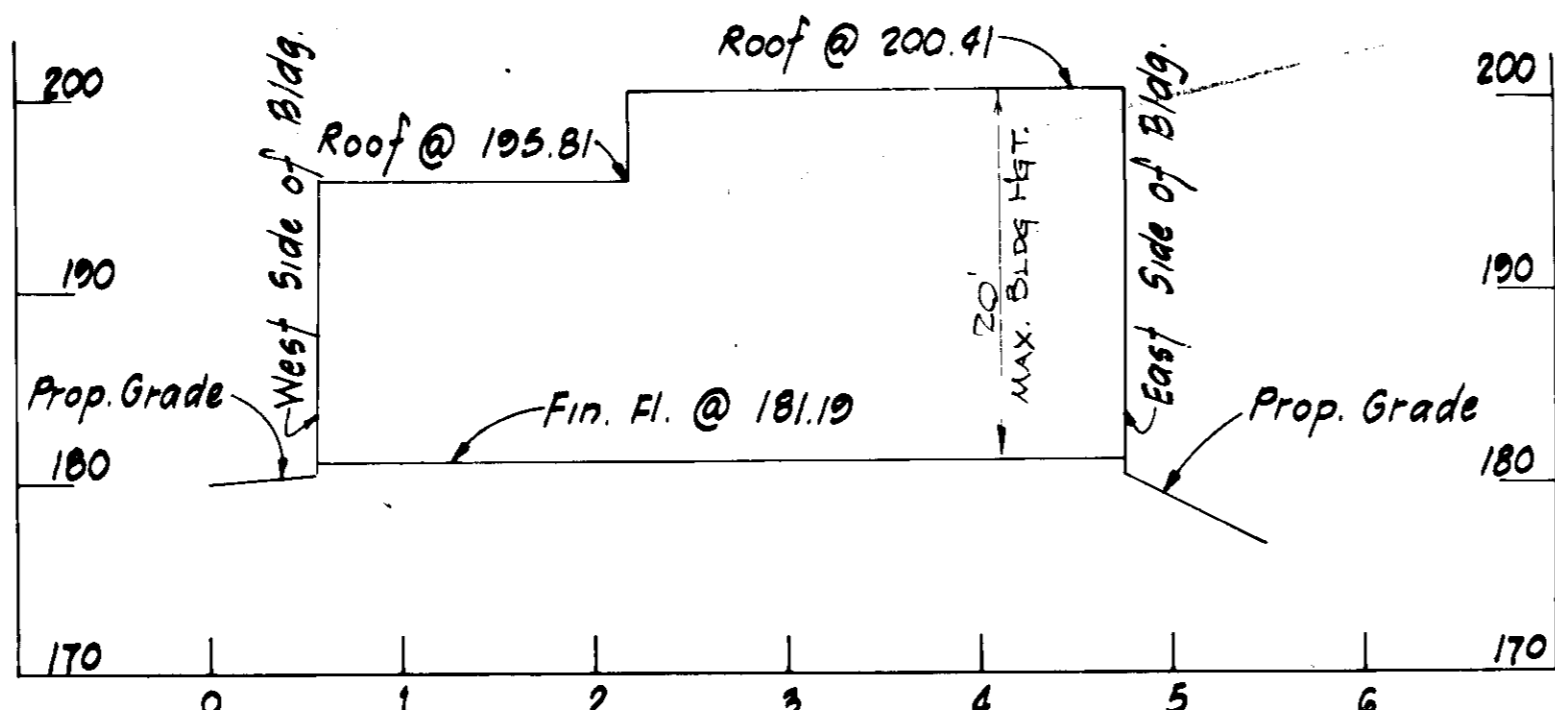

SHEET NO.	DESCRIPTION
1	GENERAL PLAN & DRAINAGE AREA MAP
2	SITE PLAN - GRADING
3	SITE PLAN - GRADING
4	PROFILES
5	PROFILES
6	SOIL STABILIZATION NOTES & PROFILES
7	PROFILES & SECTIONS
8	SECTIONS
9	FIRE LOOP PROFILES & DETAILS
10	STORM DRAIN PROFILES
11	STORM DRAIN PROFILES
12	DRAINAGE INFORMATION
13	DETAILS
14	DETAILS
15	DETAILS
16	STORM WATER DETENTION & SEDIMENT BASIN

APPROVED: FOR PUBLIC WATER AND PUBLIC SEWERAGE SYSTEMS, HOWARD COUNTY HEALTH DEPARTMENT
[Signature] 10/1/74
 COUNTY HEALTH OFFICER DATE

APPROVED: HOWARD COUNTY OFFICE OF PLANNING AND ZONING
[Signature] 10-8-74
 PLANNING DIRECTOR DATE
[Signature] 10/8/74
 CHIEF, DIVISION OF LAND DEVELOPMENT AND TRANSPORTATION PLANNING DATE

APPROVED: FOR PUBLIC WATER, PUBLIC SEWERAGE AND STORM DRAINAGE SYSTEMS AND ROADS, HOWARD COUNTY DEPARTMENT OF PUBLIC WORKS
[Signature] 10/4/74
 DIRECTOR DATE
[Signature] 10/4/74
 CHIEF, BUREAU OF HIGHWAYS DATE

Reviewed for: Howard S. C. D. NAME
 and meets Technical Requirements
[Signature] Date: 9-30-74
 Signature
 S. Soil Conservation Service

THIS DEVELOPMENT PLAN IS APPROVED FOR SOIL EROSION AND SEDIMENT CONTROL BY THE HOWARD SOIL CONSERVATION DISTRICT

Approved: *[Signature]* Date: 9-30-74
 Howard S. C. D.

By the Developer:
 "I certify that all development and/or construction will be done according to this plan of development and plan for Erosion and Sediment Control, and I also authorize periodic on-site inspection by the Howard Soil Conservation District or their authorized agents, as are deemed necessary." Deviation from this plan will not be made unless authorized by the Howard Soil Conservation District.

[Signature] 4-2-74
 Signature of Developer Date

By the Engineer:
 "I certify that this plan for Erosion and Sediment Control represents a practical and workable plan based on my personal knowledge of the site conditions and that it was prepared in accordance with the requirements of the Howard Soil Conservation District."

[Signature] 4-2-74
 Signature of Engineer Date

SITE ANALYSIS	
AREA	34.8073 Ac. Δ
ZONING	M-1 & M-2
EMPLOYEES	650
FLOOR SPACE	242,000 s.f.
PARKING SPACES REQ'D	325
PARKING SPACES PROVIDED	501

OWNER: AMERICAN INSTRUMENT CO.
 3239 WASHINGTON BLVD.
 US RTE. 1
 SAVAGE, MARYLAND 20863

DEVELOPER: SAME AS ABOVE

ENGINEER: DALTON-DALTON-LITTLE-NEWPORT
 7315 WISCONSIN AVE.
 BETHESDA, MARYLAND 20814

AREAS SHOWN THUS INDICATE PROPOSED PAVING (ALONG US ROUTE #1)
 PROPOSED SANITARY SEWER
 RIGHT-OF-WAY AND PROPERTY LINE
 PROPOSED DITCH
 DIRECTION OF DRAINAGE
 PROPOSED WATER
 PROPOSED STORM DRAIN & INLET
 PROPOSED INLET
 PROPOSED S.D. HEADWALL

SCALE: 1"=100'

ISSUED FOR BIDDING		
NO.	DATE	BY
ADDENDA REVISIONS		

ISSUED FOR CONSTRUCTION		
NO.	DATE	BY
REVISIONS		
1	5/13/74	W.B.
2	7/15/74	M.W.
3	9/3/74	M.W.

AS BUILT DRAWINGS		
NO.	DATE	BY

[Signature] 9/17/74
 J.H. Clawson
 PE


AMERICAN INSTRUMENT CO.
 DIVISION OF
 TRAVENOL LABORATORIES INC.
 HOWARD COUNTY, MD.
 ELECTION DISTRICT NO. 6
 TAX MAP 47, PARCEL NO. 145

ERUCTION CONTROL
 NOTION OR
 DETAIL: N

DRAWN F.W.G. DATE 4-12-74
 CHECKED L.C.P. JOB No. 736640

GENERAL PLAN
 DRAINAGE AREA MAP
 ADDITION & ALTERATIONS
 PLANT & OFFICE BUILDING
 AMINCO
 SAVAGE MARYLAND


SHEET 1 OF 16

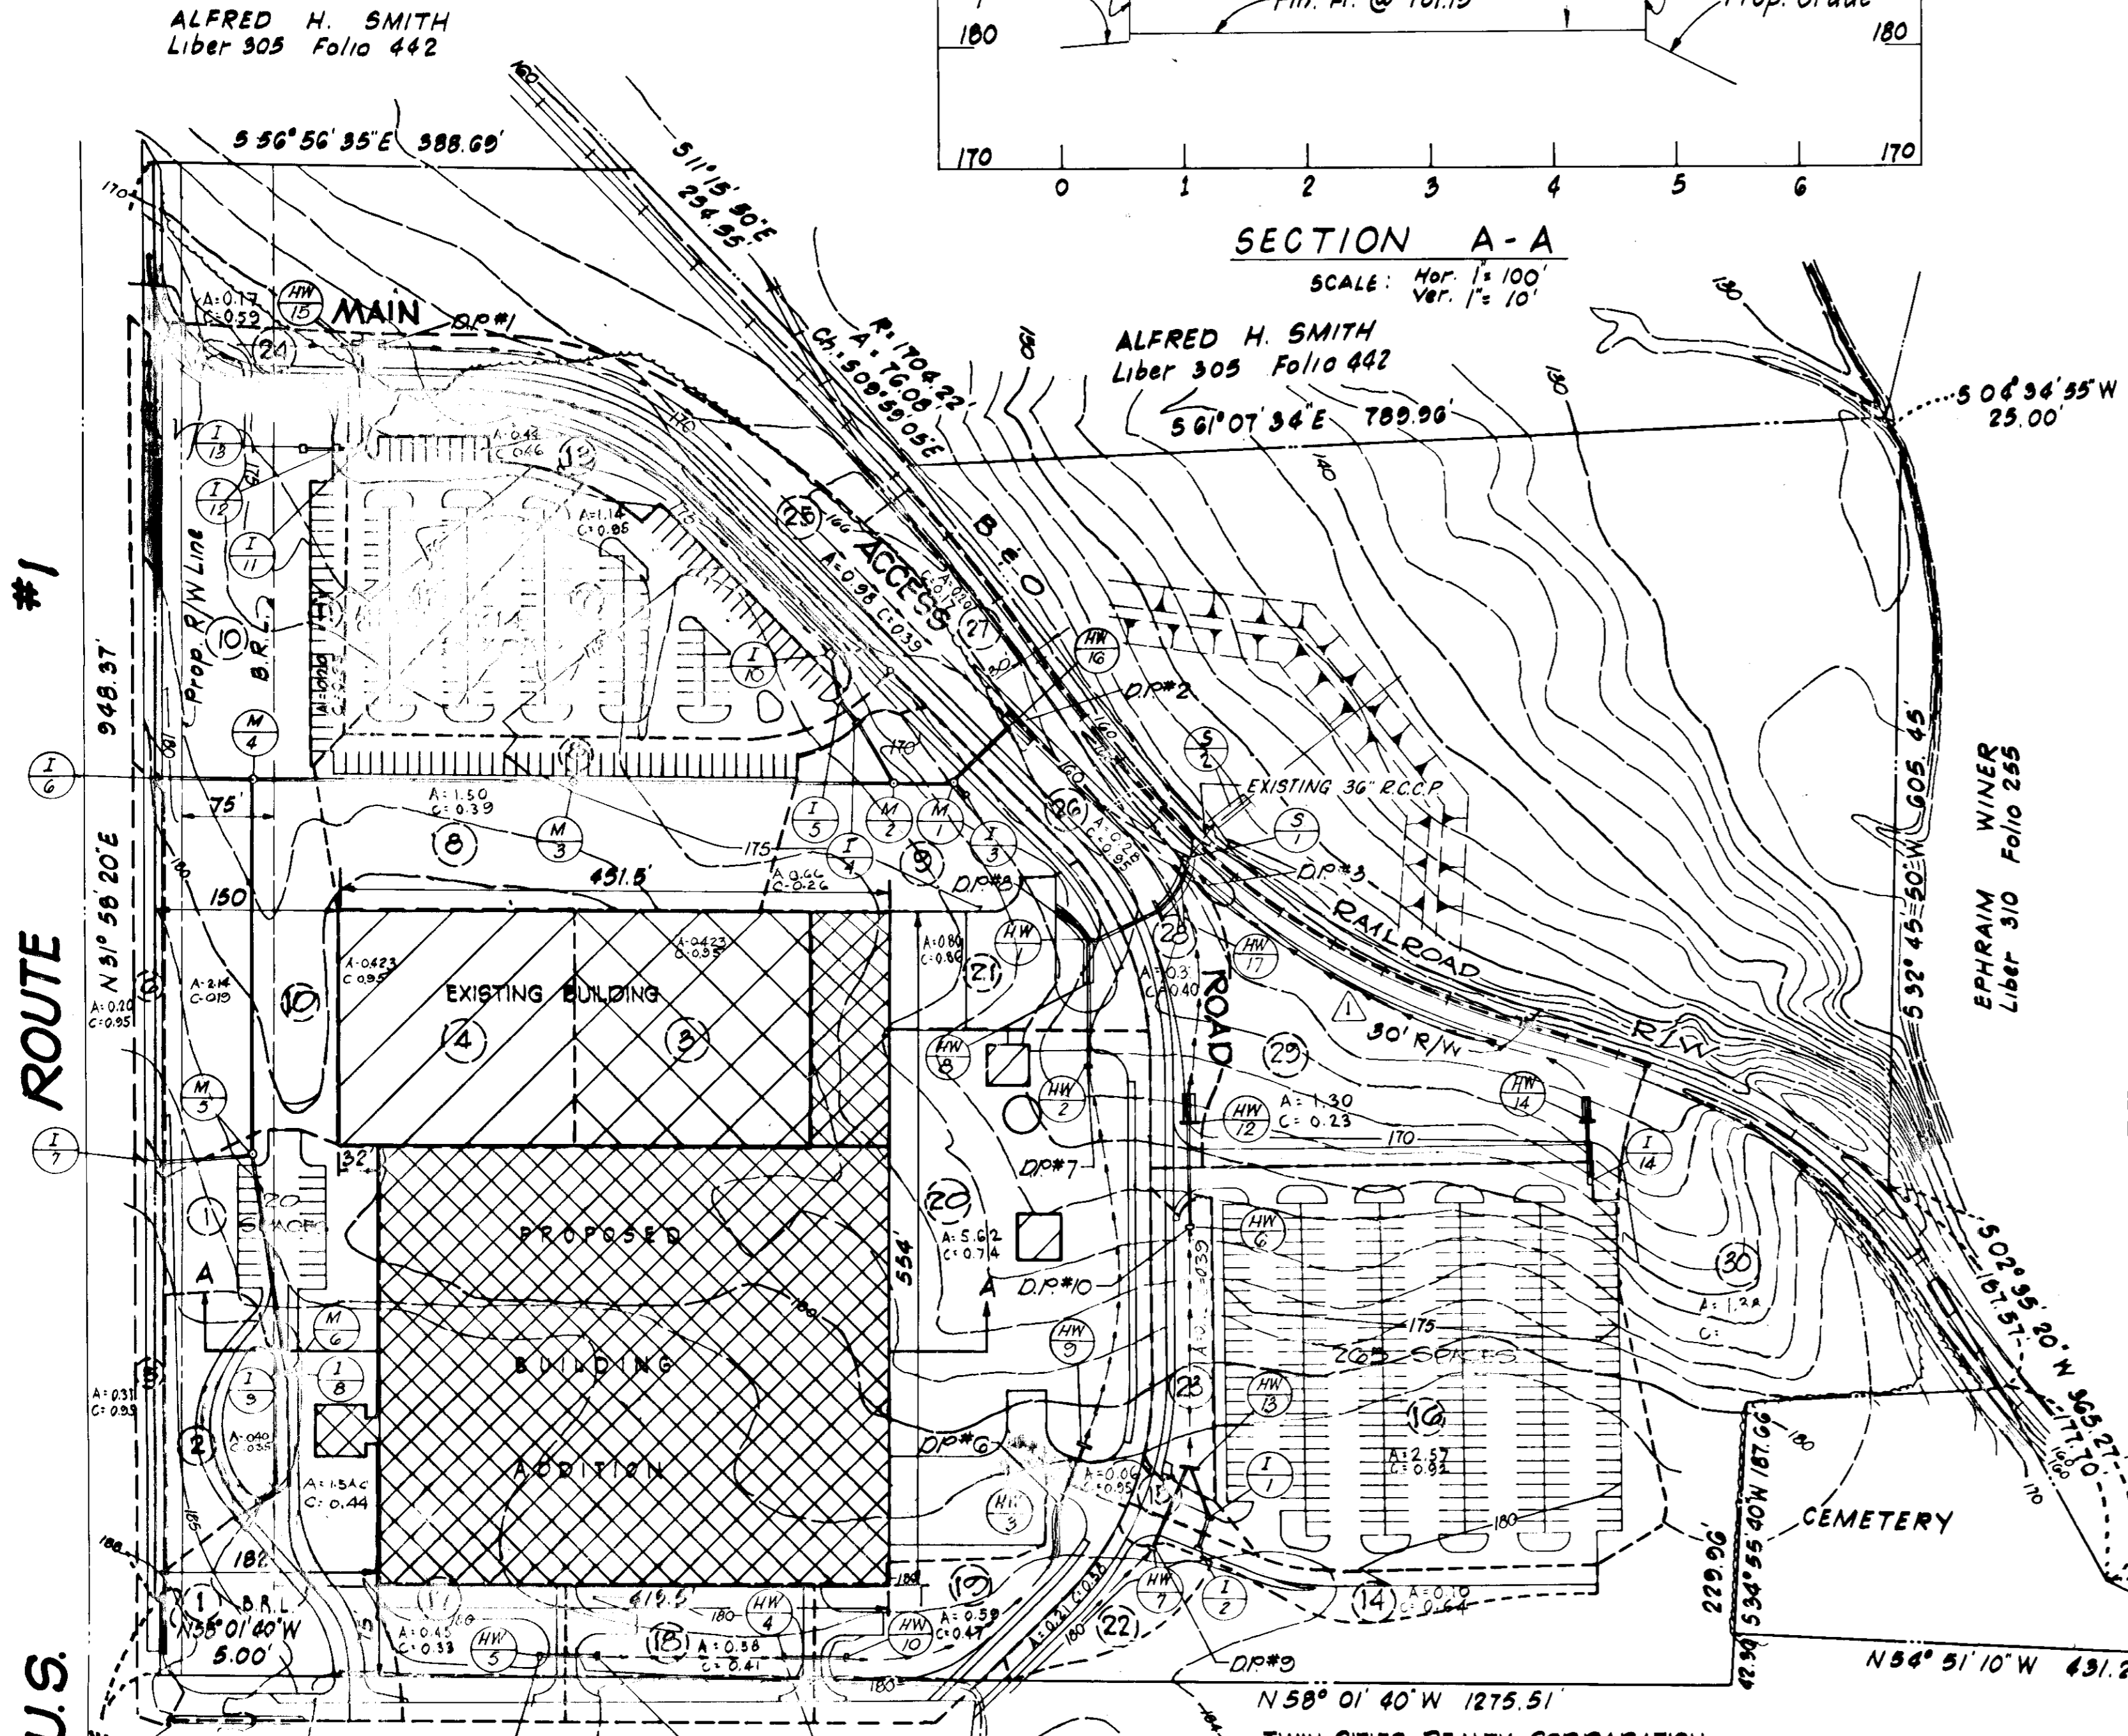

CONSTRUCTION SCHEDULE	
BEGIN	DECEMBER 1974
END	DECEMBER 1975

Symbol	Description
	EXISTING WATER FIRE HYDRANT
	EXISTING RAILROAD TRACKS
	EXCAVATION OR CUT
	EMBANKMENT OR FILL
	EXISTING POWER POLES
	DRAINAGE AREA
	FUTURE SEWER MAIN
	CONCRETE
	PROPOSED WATER AND FIRE HYDRANT
	EXISTING CONCRETE CURB
	EXISTING WATER MAIN
	EXISTING GAS
	EXISTING TELEPHONE CONDUIT
	EXISTING CONTOUR
	PROPOSED CONTOUR
	BENCH MARK
	PROPOSED CONCRETE CURB
	PROPOSED PAINTED LINE ISLAND (PARKING LOTS)
	AREA SHOWN THUS INDICATE PROPOSED PAVING (ON SITE)

DALTON-DALTON-LITTLE-NEWPORT
 ENGINEERS & ARCHITECTS
 7315 WISCONSIN AVE.
 BETHESDA, MARYLAND 20814

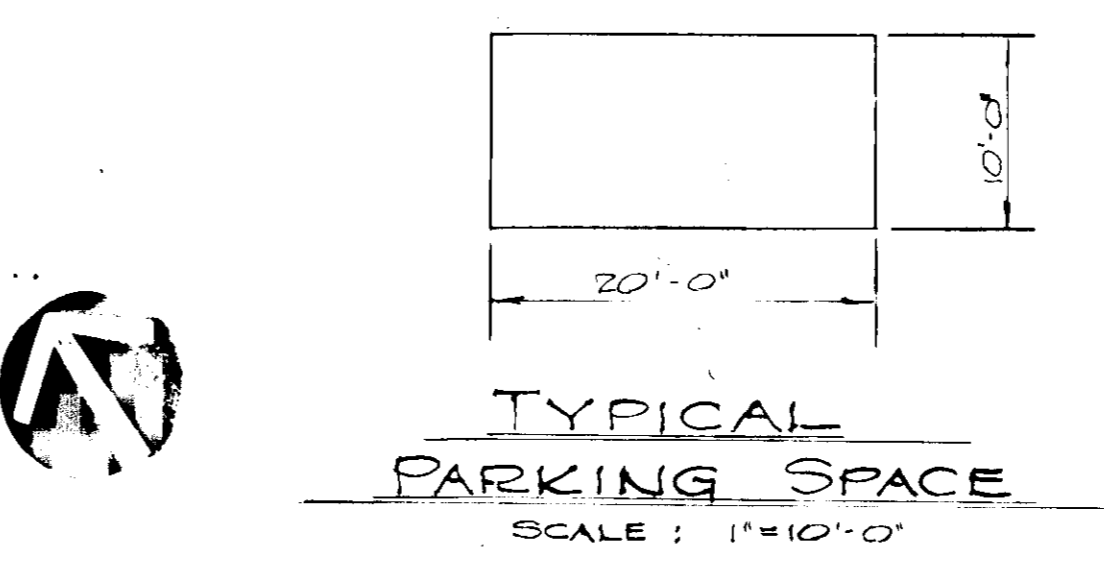

NOTE: ALL ROADS AND PARKING AREAS EXCEPT US ROUTE #1 R/W ARE TO BE MAINTAINED BY THE OWNER.

EXISTING TOPOGRAPHIC FEATURES AND CONTOUR ELEVATIONS HAVE BEEN SHOWN ACCORDING TO SURVEYS CONDUCTED BY BEN DYER ASSOC. INC. 4705 QUEENSBURY RD, RIVERDALE, MD. MAY, 1973

LEGEND

Symbol	Description
	EXISTING WATER FIRE HYDRANT
	EXISTING RAILROAD TRACKS
	EXCAVATION OR CUT
	EMBANKMENT OR FILL
	EXISTING POWER POLES
	DRAINAGE AREA
	FUTURE SEWER MAIN
	CONCRETE
	PROPOSED WATER AND FIRE HYDRANT
	EXISTING CONCRETE CURB
	EXISTING WATER MAIN
	EXISTING GAS
	EXISTING TELEPHONE CONDUIT
	EXISTING CONTOUR
	PROPOSED CONTOUR
	BENCH MARK
	PROPOSED CONCRETE CURB
	PROPOSED PAINTED LINE ISLAND (PARKING LOTS)
	AREA SHOWN THUS INDICATE PROPOSED PAVING (ON SITE)

DALTON-DALTON-LITTLE-NEWPORT
 ENGINEERS & ARCHITECTS
 7315 WISCONSIN AVE.
 BETHESDA, MARYLAND 20814

Note: For Typical Section Along US Route #1 See Sheet #7 of 16

CURVE DATA


NOTE: TRAFFIC CONTROL SIGNS - REFER TO FH.A. MANUAL ON UNIFORM TRAFFIC CONTROL DEVICES

CURVE NO. 2
 $\Delta: 45^{\circ}00'00''$
 $D: 22^{\circ}55'06''$
 $R: 250.0'$
 $T: 103.55'$
 $L: 196.35'$

CURVE NO. 3
 $\Delta: 45^{\circ}00'00''$
 $D: 22^{\circ}55'06''$
 $R: 250.0'$
 $T: 103.55'$
 $L: 196.35'$

NOTE: THE LOTS OR PARCELS SHOWN ON THIS PLAN ARE SUBJECT TO THE SUPPLEMENTAL SEWER IN-AID-CONSTRUCTION CHARGE CREATED BY SECTION 20.81A OF THE HOWARD COUNTY CODE AND TO EXECUTIVE ORDER NO. 72-9.

(ACCESS RD. STA 15+70-42' RT. TO ACCESS RD. STA 15+20-27' RT. CONSTRUCT SEED & MULCH V SIDE DITCH WITH 3:1 SIDE SLOPES Q=0.48 CFS S=2% V=2.35 FPS)

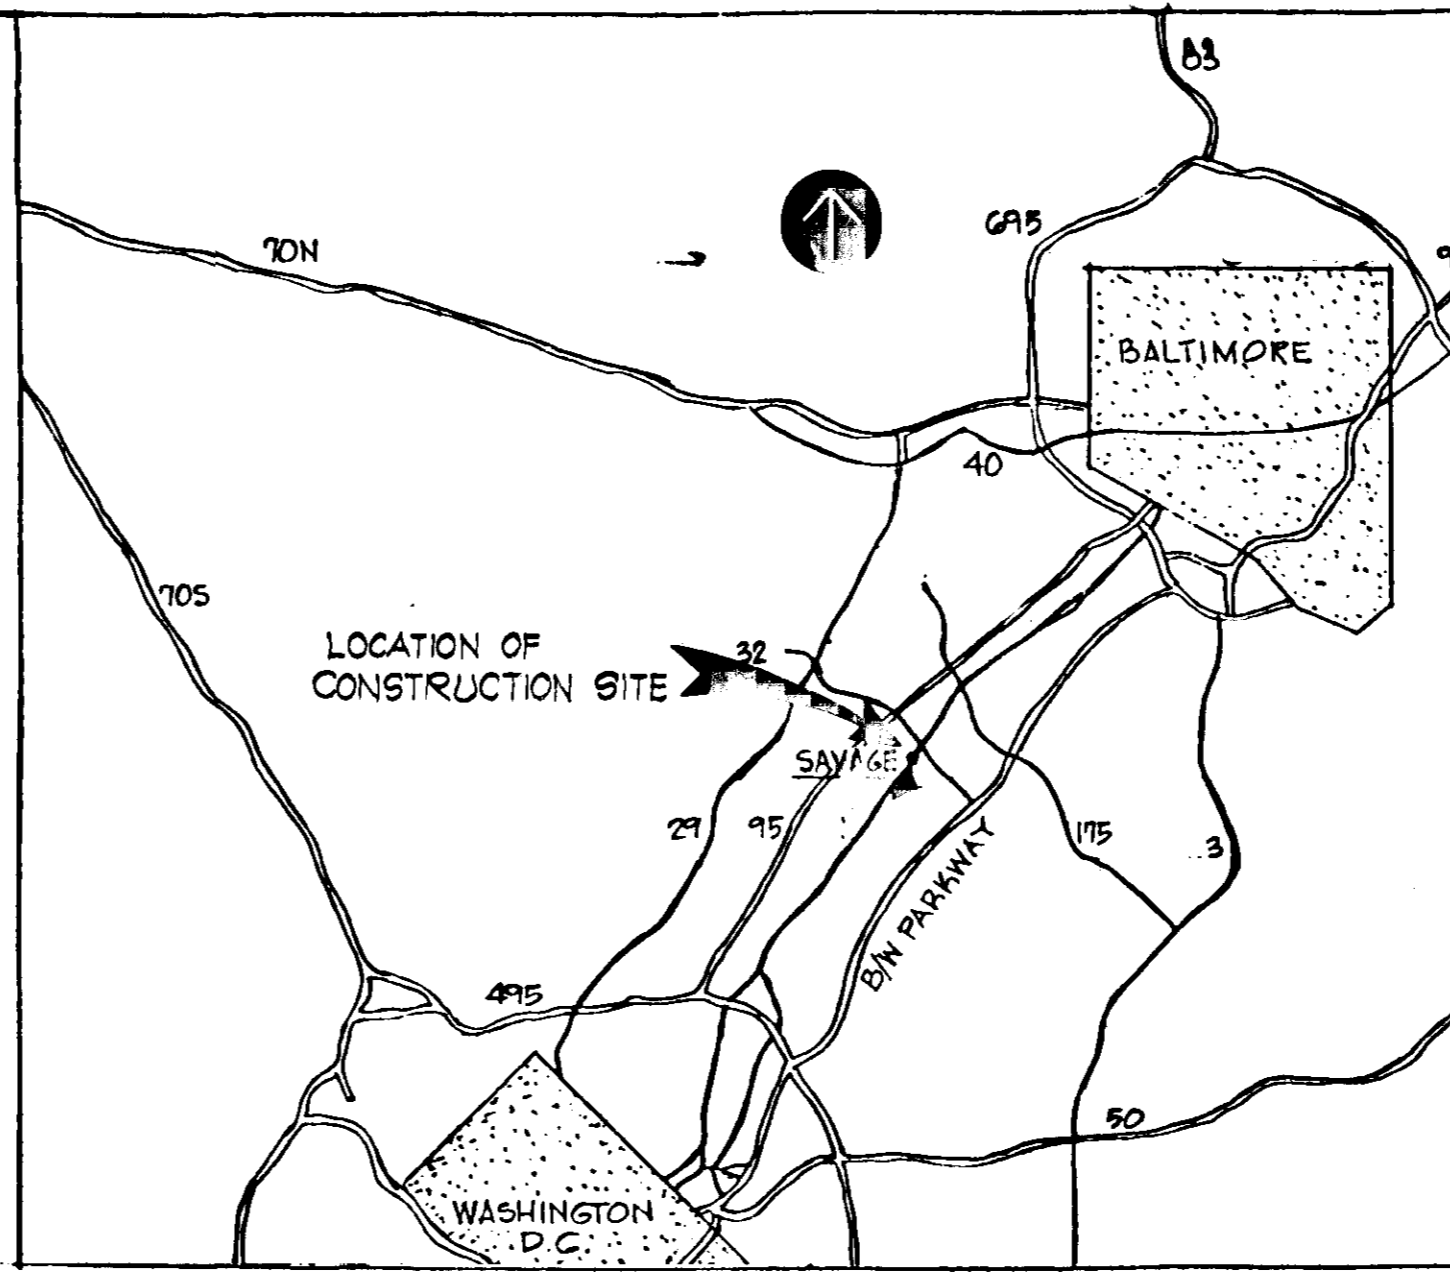

LOCATION MAP
SCALE IN MILES

APPROVED: FOR PUBLIC WATER AND PUBLIC SEWERAGE SYSTEMS, HOWARD COUNTY HEALTH DEPARTMENT
W. J. ... COUNTY HEALTH OFFICER DATE 10/8/74

APPROVED: HOWARD COUNTY OFFICE OF PLANNING AND ZONING
Thomas L. Harris PLANNING DIRECTOR DATE 10-8-74
J. ... CHIEF, DIVISION OF LAND DEVELOPMENT AND TRANSPORTATION PLANNING DATE 10/8/74

APPROVED: FOR PUBLIC WATER, PUBLIC SEWERAGE AND STORM DRAINAGE SYSTEMS AND ROADS HOWARD COUNTY DEPARTMENT OF PUBLIC WORKS
Willie ... DIRECTOR DATE 10/4/74
P. H. ... CHIEF, BUREAU OF HIGHWAYS DATE 10/4/74

Reviewed for: *Howard* S.C.D. NAME and meets Technical Requirements Date 9-30-74
James M. ... Signature S. S. Soil Conservation Service

THIS DEVELOPMENT PLAN IS APPROVED FOR SOIL EROSION AND SEDIMENT CONTROL BY THE HOWARD SOIL CONSERVATION DISTRICT
 Approved: *Bretter ...* Date 9-30-74
 Howard S.C.D.


By the Developer:
Joe Paul ... Signature of Developer Date 9-14-74

"I certify that all development and/or construction will be done according to this plan of development and plan for Erosion and Sediment Control, and I also authorize periodic on-site inspection by the Howard Soil Conservation District or their authorized agents, as are deemed necessary." Deviation from this plan will not be made unless authorized by the Howard Soil Conservation District.

By the Engineer:
Joe Paul ... Signature of Engineer Date 9-14-74

"I certify that this plan for Erosion and Sediment Control represents a practical and workable plan based on my personal knowledge of the site conditions and that it was prepared in accordance with the requirements of the Howard Soil Conservation District."

ISSUED FOR BIDDING			
NO.	DESCRIPTION	DATE	BY
ADDENDA REVISIONS			
ISSUED FOR CONSTRUCTION			
REVISIONS			
1	STORM WATER BASIN NOT TO BE MOVED, SEDIMENT BASIN RELOCATED, DATE CORRECTED	5/13/74	W.B.
2	REVISED IN ACCORDANCE WITH HOWARD COUNTY COMMENTS	7/15/74	M.W.
3	REVISED IN ACCORDANCE WITH HOWARD COUNTY COMMENTS	9/13/74	M.W.

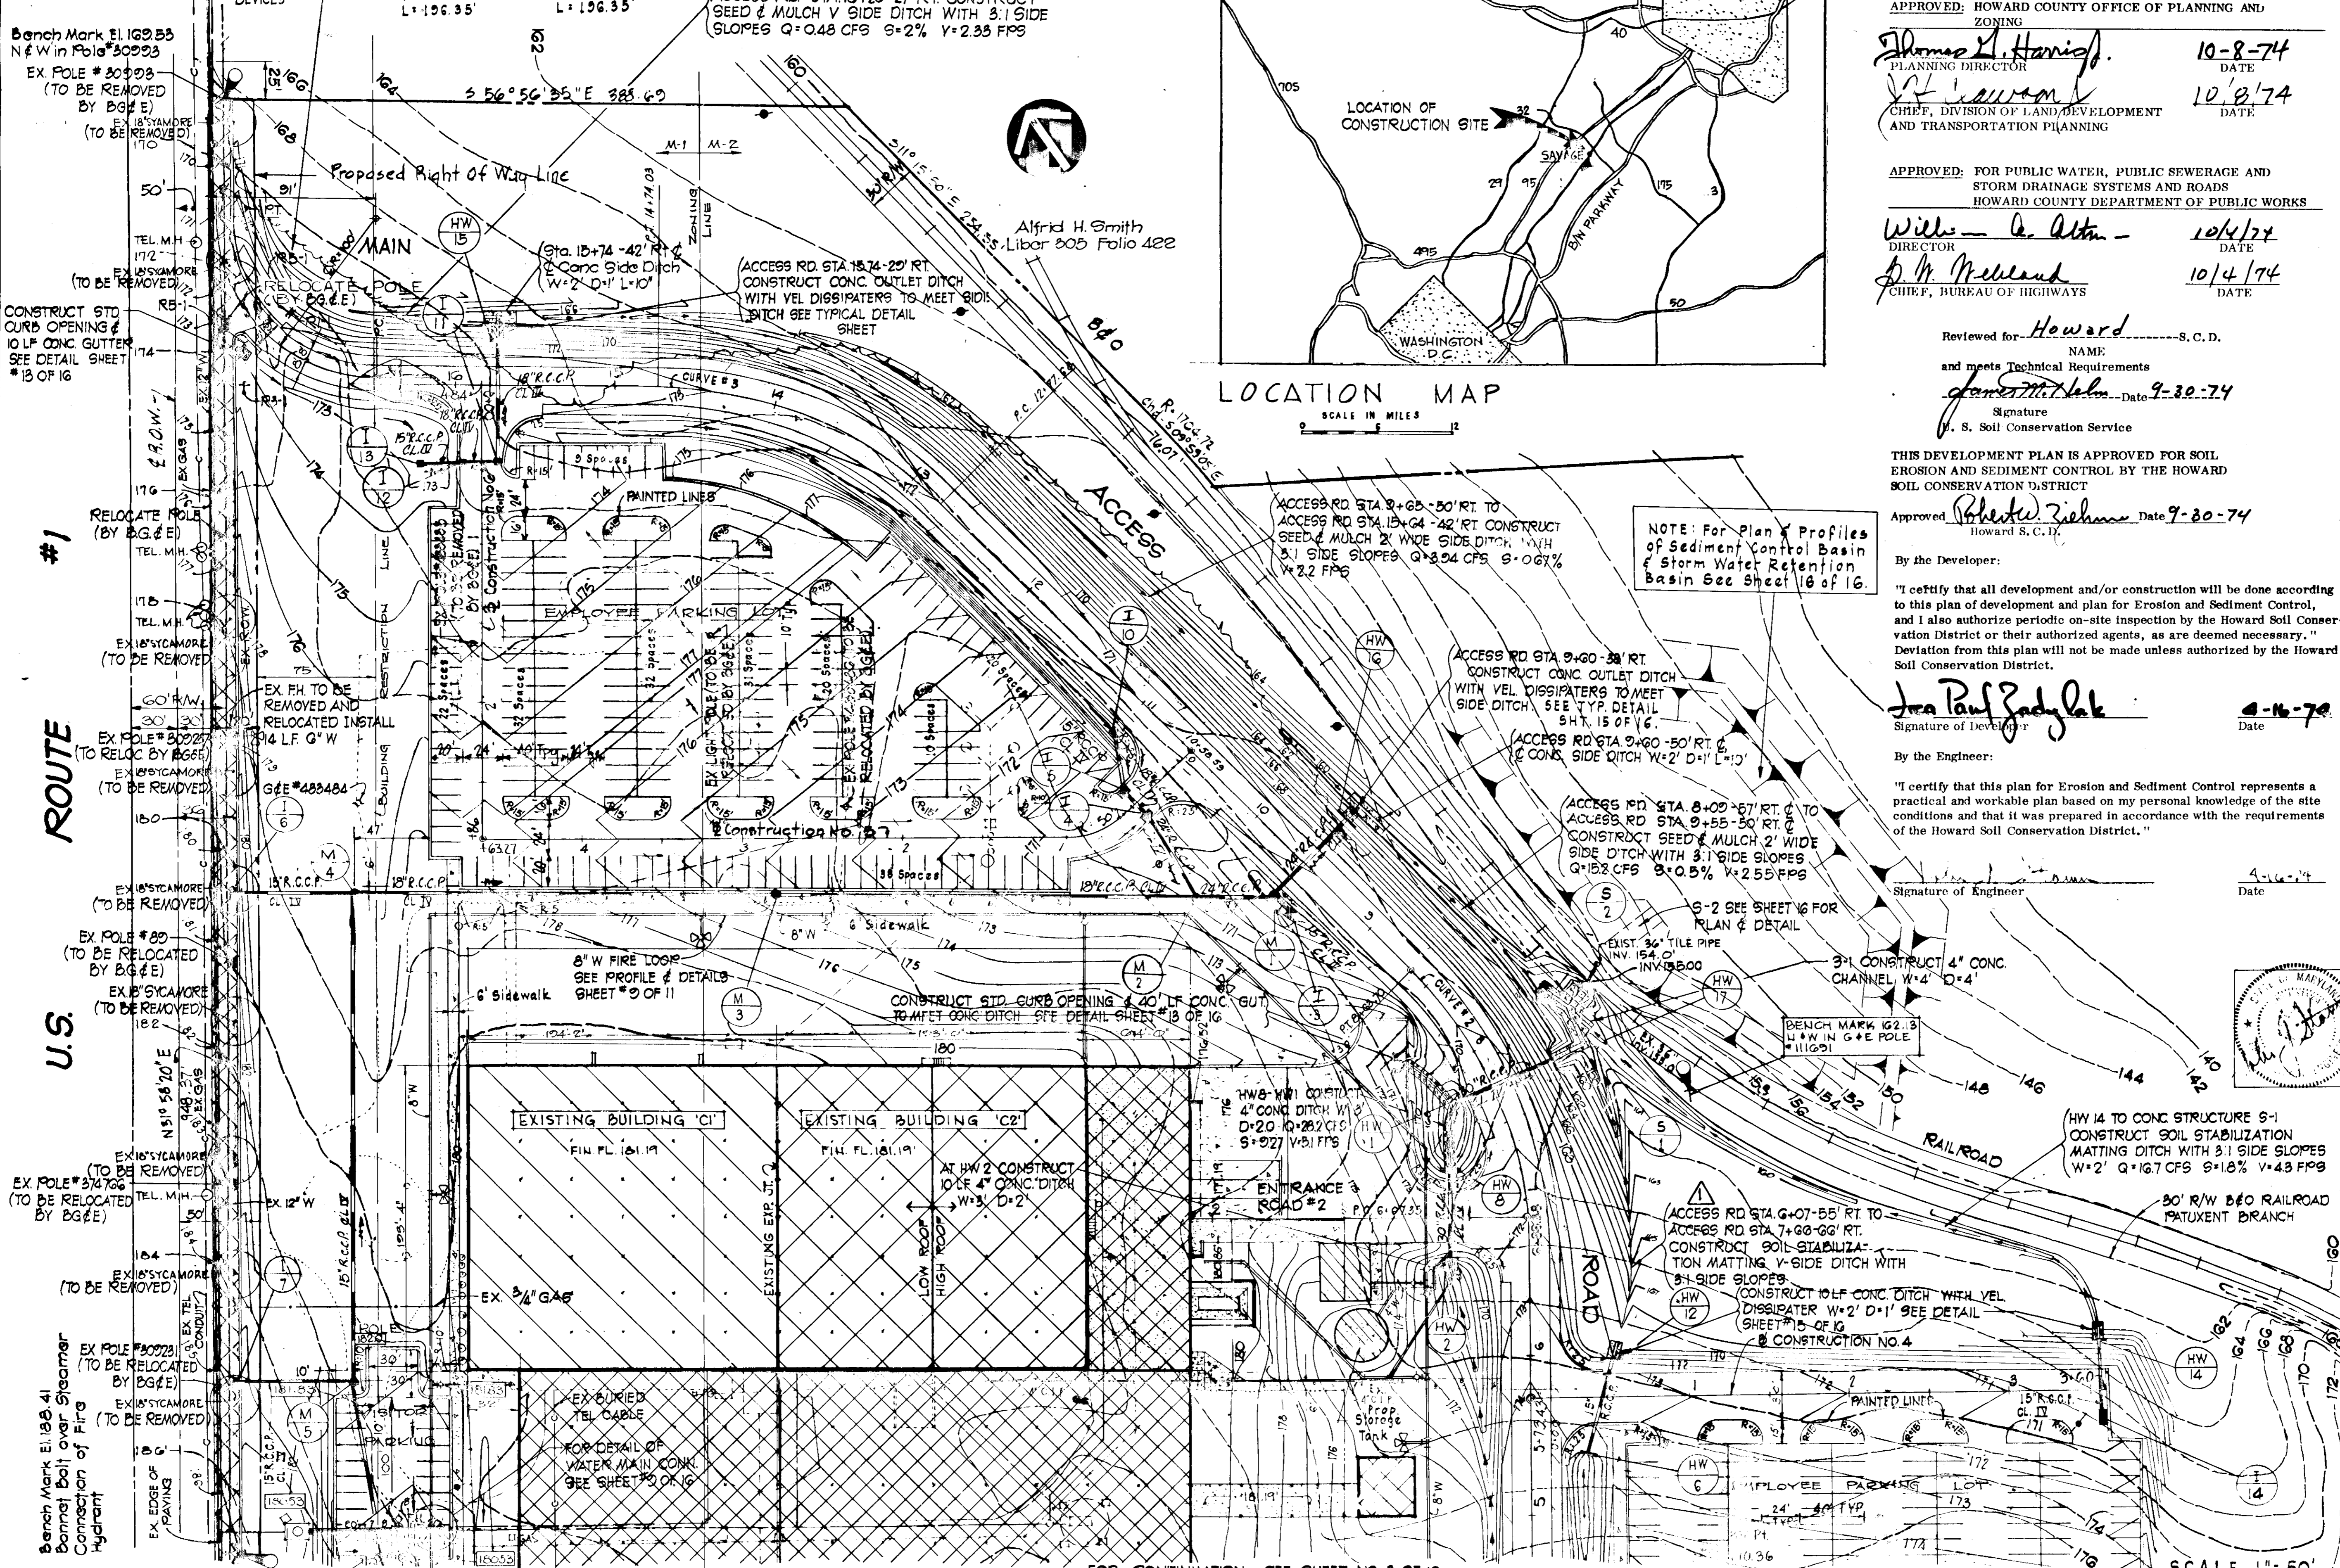

AS BUILT DRAWINGS

9/17/74
J. H. Clawson

AMERICAN INSTRUMENT CO. DIVISION OF TRAVENOL LABORATORIES INC. HOWARD COUNTY, MD. ELECTION DISTRICT NO. 6 TAX MAP 47, PARCEL NO. 145

SECTION CONTROL

DRAWN F.W.G. DATE 4-12-74
 CHECKED L.C.P. JOB No. 736640


SITE PLAN GRADING

ADDITION & ALTERATIONS PLANT & OFFICE BUILDING
AMINCO
 SAVAGE MARYLAND

SHEET 2 OF 16
 SPP-74-100

DALTON, DALTON, ... ARCHITECTS & ENGINEERS & PLANNERS

FOR CONTINUATION SEE SHEET NO 2 OF 16

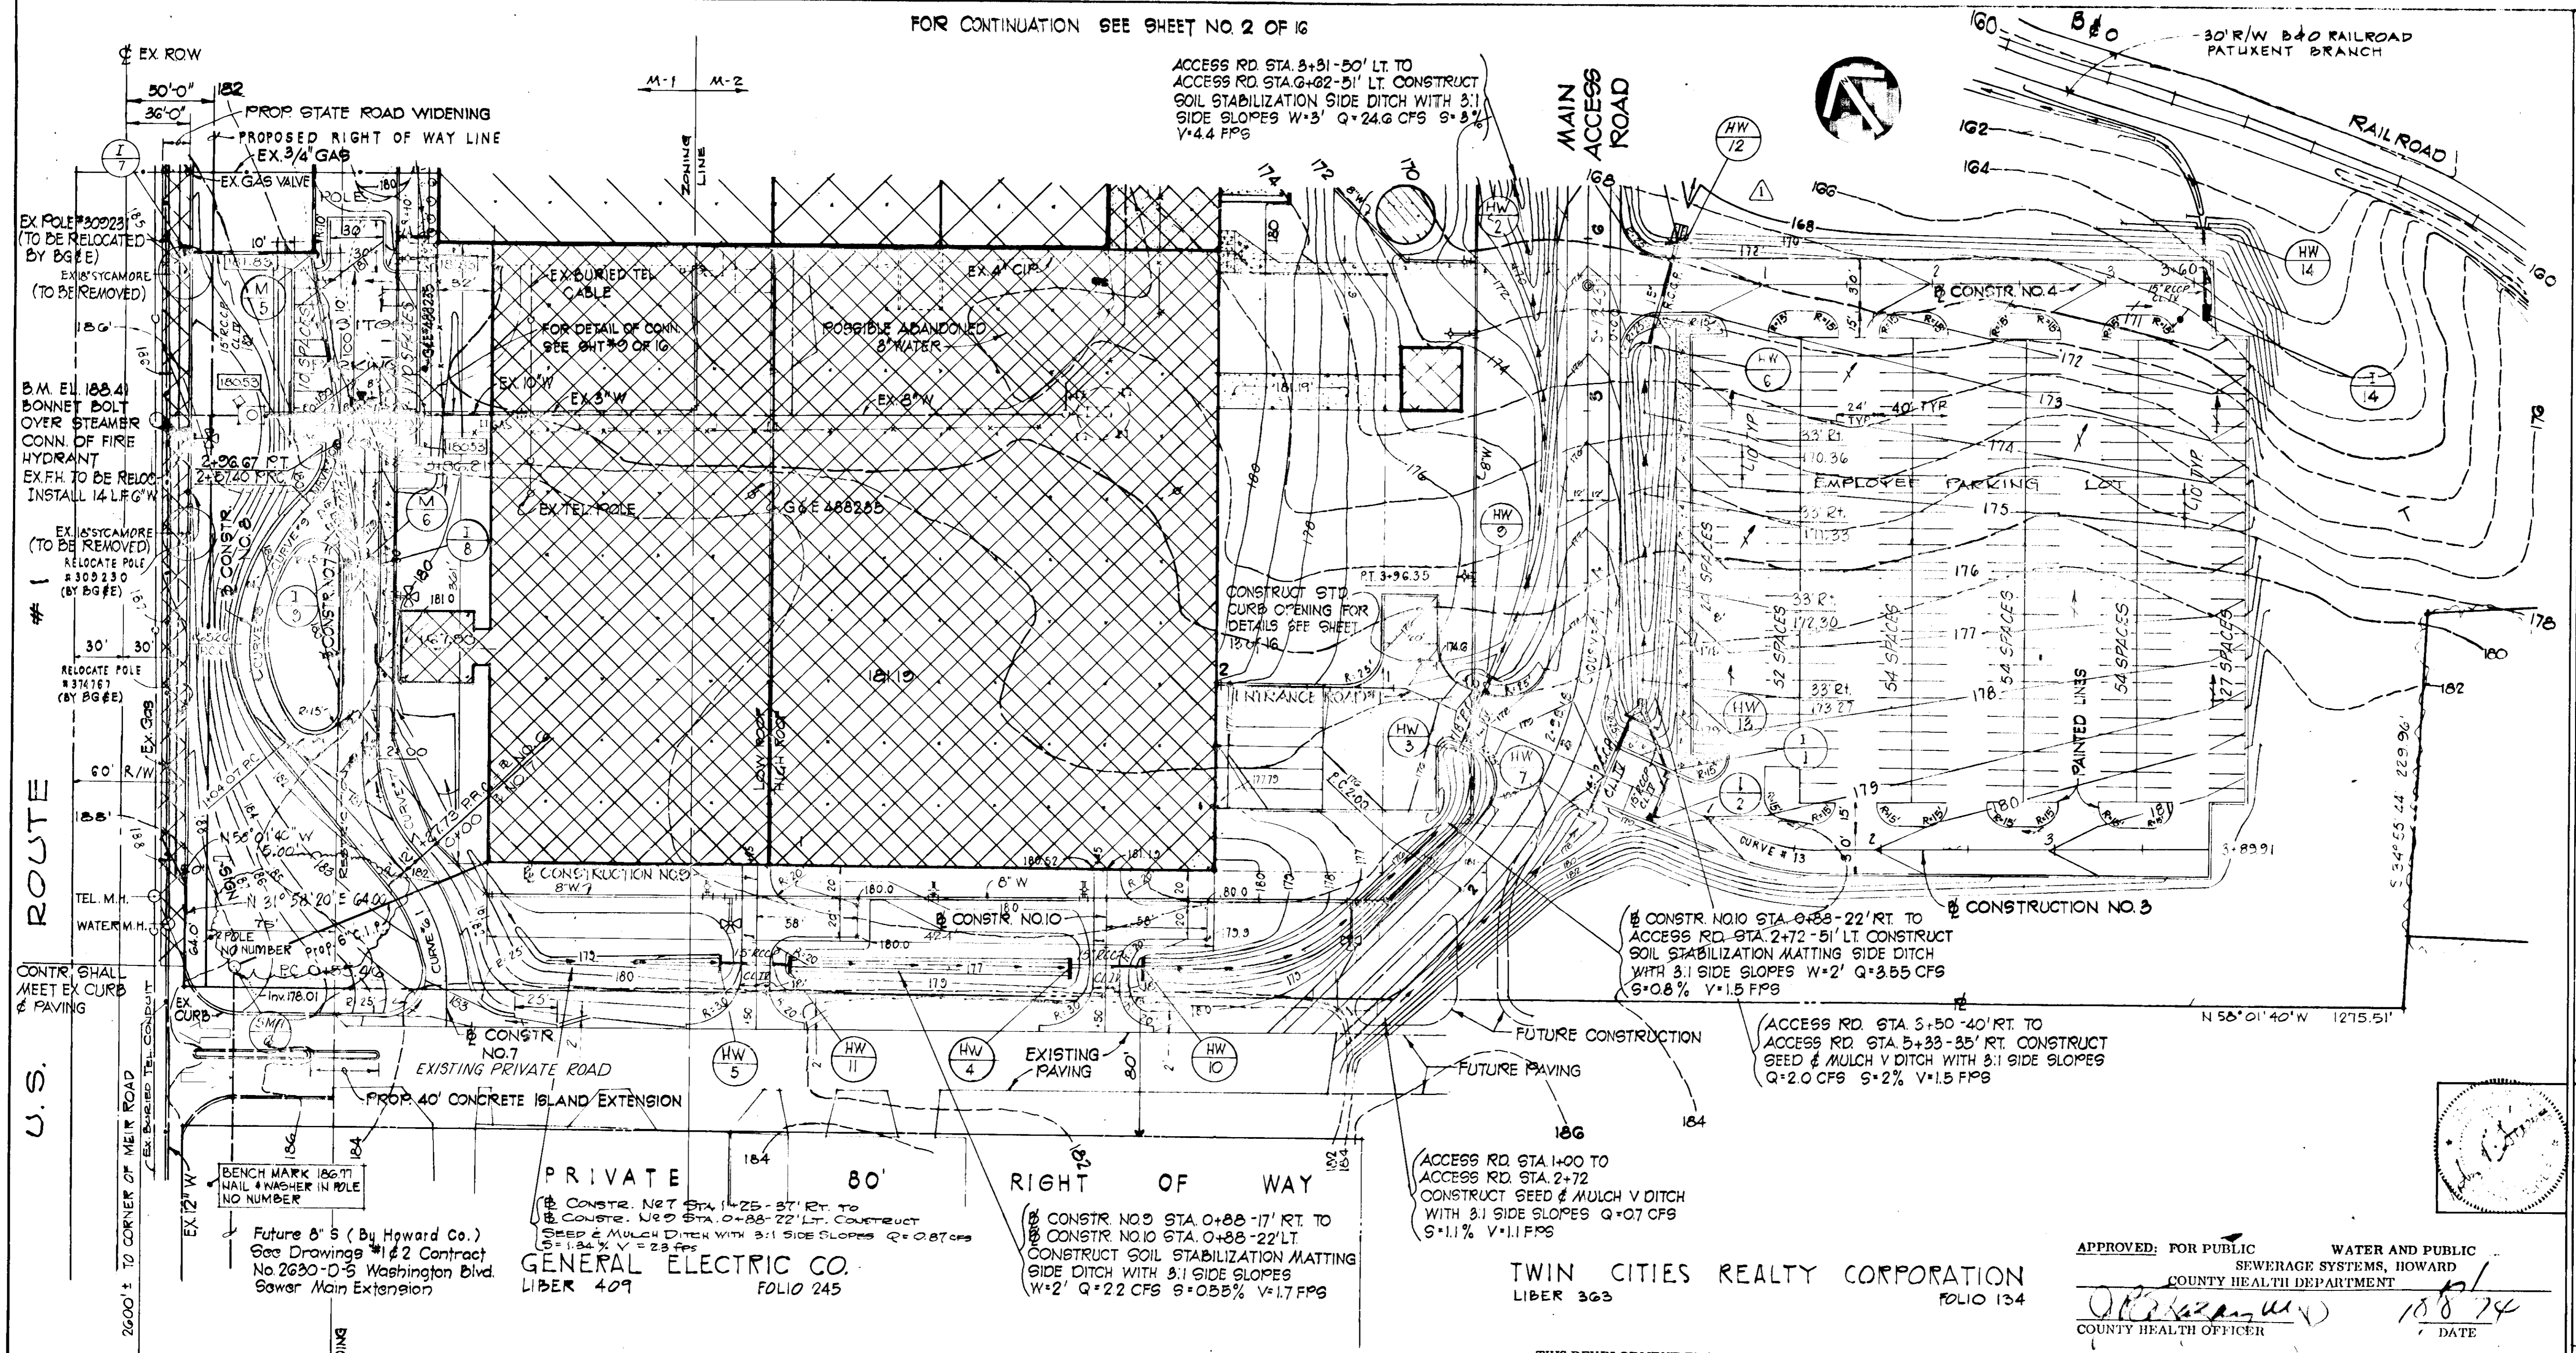

U.S. ROUTE #1

EX ROW 50'-0" 36'-0" 182

PROPOSED STATE ROAD WIDENING
EX. 3/4" GAS

PROPOSED RIGHT OF WAY LINE
EX. 3/4" GAS

EX. GAS VALVE

EX. POLE #30923 (TO BE RELOCATED BY BGE)

EX. STICAMORE (TO BE REMOVED)

B.M. EL. 188.4 BONNET BOLT OVER STEAMER CONN. OF FIRE HYDRANT EX. F.H. TO BE RELOC. INSTALL 14 L.F.G.W.

EX. STICAMORE (TO BE REMOVED) RELOCATE POLE #31923 (BY BGE)

RELOCATE POLE #37678 (BY BGE)

TEL. M.H. WATER M.H.

CONTR. SHALL MEET EX CURB & PAVING

EX. CURB

EX. CONCRETE ISLAND EXTENSION

BENCH MARK 186.71 NAIL & WASHER IN HOLE NO NUMBER

Future 8' S (By Howard Co.) See Drawings #162 Contract No 2630-D-5 Washington Blvd. Sewer Main Extension

NOTE: Access to U.S. Route #1 is Restricted to Entrances Shown Only.

For Typical Section Along U.S. Route #1 See Sheet #7 of 16.

NOTE: THE LOTS OR PARCELS SHOWN ON THIS PLAN ARE SUBJECT TO THE SUPPLEMENTAL SEWER IN-ADDITION-CONSTRUCTION CHARGE CREATED BY SECTION 2031A OF THE HOWARD COUNTY CODE AND TO EXECUTIVE ORDER NO 72-2.

NOTE: Contractor Shall Call C&P Tel. Co. 725-9976 30 Days Prior To Beginning Work In The Vicinity Of Buried Telephone Cables.

NOTE: Ex. Poles As Noted Shall Be Removed And Relocated By The Baltimore Gas And Electric Company. Contractor Shall Call Miss Utility At 1-801-559-0100 60 Days Prior To Beginning Work In The Vicinity Of Ex. Poles, Buried Gas Main And Elec. Cables. The Utilities Shown On These Plans Are From Most Recent Information Available. The Engineer Does Not Warrant Their Exact Location And Recommends Field Location And Stakeout Prior To Any Construction.

PRIVATE RIGHT OF WAY

80'

GENERAL ELECTRIC CO. LIBER 409 FOLIO 245

CONSTR. NO. 7 STA. 1+25-57' RT. TO CONSTR. NO. 8 STA. 0+88-22' LT. CONSTRUCT SEED & MULCH DITCH WITH 3:1 SIDE SLOPES Q=0.87 CFS S=1.84% V=2.8 FPS

CONSTR. NO. 9 STA. 0+88-17' RT. TO CONSTR. NO. 10 STA. 0+88-22' LT. CONSTRUCT SOIL STABILIZATION MATTING SIDE DITCH WITH 3:1 SIDE SLOPES W=2' Q=2.2 CFS S=0.55% V=1.7 FPS

CONSTR. NO. 10 STA. 0+88-22' RT. TO ACCESS RD. STA. 2+72-51' LT. CONSTRUCT SOIL STABILIZATION MATTING SIDE DITCH WITH 3:1 SIDE SLOPES W=2' Q=3.55 CFS S=0.8% V=1.5 FPS

CONSTR. NO. 11 STA. 5+50-40' RT. TO ACCESS RD. STA. 5+33-35' RT. CONSTRUCT SEED & MULCH V DITCH WITH 3:1 SIDE SLOPES Q=2.0 CFS S=2% V=1.5 FPS

CONSTR. NO. 12 STA. 1+00 TO ACCESS RD. STA. 2+72 CONSTRUCT SEED & MULCH V DITCH WITH 3:1 SIDE SLOPES Q=0.7 CFS S=1.1% V=1.1 FPS

CURVE DATA

CURVE NO. 1 Δ: 45°00'00" D: 22°55'06" R: 250.0' T: 103.55' L: 156.35'	CURVE NO. 6 Δ: 41°24'35" R: 100.00' T: 37.80' L: 72.21'	CURVE NO. 7 Δ: 41°24'35" R: 100.00' T: 37.80' L: 72.21'	CURVE NO. 8 Δ: 41°24'35" R: 84.66' T: 32.00' L: 61.19'
CURVE NO. 9 Δ: 45°00'00" R: 117.31' T: 48.59' L: 92.14'	CURVE NO. 10 Δ: 45°00'00" R: 50.00' T: 20.71' L: 39.27'	CURVE NO. 13 Δ: 22°30'00" R: 100.00' T: 13.89' L: 39.27'	

TWIN CITIES REALTY CORPORATION
LIBER 363 FOLIO 134

THIS DEVELOPMENT PLAN IS APPROVED FOR SOIL EROSION AND SEDIMENT CONTROL BY THE HOWARD SOIL CONSERVATION DISTRICT

Approved Robert W. Zichem Date 9-30-74
Howard S. C. J.

By the Developer:
Jean Paul Godylak 4-16-74
Signature of Developer Date

"I certify that all development and/or construction will be done according to this plan of development and plan for Erosion and Sediment Control, and I also authorize periodic on-site inspection by the Howard Soil Conservation District or their authorized agents, as are deemed necessary." Deviation from this plan will not be made unless authorized by the Howard Soil Conservation District.

By the Engineer:
James M. Heh 9-30-74
Signature of Engineer Date

APPROVED: FOR PUBLIC WATER AND PUBLIC SEWERAGE SYSTEMS, HOWARD COUNTY HEALTH DEPARTMENT

J.P. Kozan 10-8-74
COUNTY HEALTH OFFICER DATE

APPROVED: HOWARD COUNTY OFFICE OF PLANNING AND ZONING

Thomas G. Hanning 10-8-74
PLANNING DIRECTOR DATE

J.H. Clawson 10/8/74
CHIEF, DIVISION OF LAND DEVELOPMENT AND TRANSPORTATION PLANNING DATE

APPROVED: FOR PUBLIC WATER, PUBLIC SEWERAGE AND STORM DRAINAGE SYSTEMS AND ROADS HOWARD COUNTY DEPARTMENT OF PUBLIC WORKS

William G. Alt 10/4/74
DIRECTOR DATE

S. H. McKeand 10/4/74
CHIEF, BUREAU OF HIGHWAYS DATE


Reviewed for Howard S.C.D.
NAME and meets Technical Requirements
James M. Heh Date 9-30-74
Signature S. Soil Conservation Service

SCALE 1"=50'


ISSUED FOR BIDDING		DATE	BY
ADDENDA REVISIONS			
ADDENDA NO.	ADDENDA DATE	BY	
ISSUED FOR CONSTRUCTION			
DATE			
BY			
REVISIONS			
NO.	DESCRIPTION	DATE	BY
1	REVISED CONTOURS AND DATE CORRECTED	5/13/74	WB
2	REVISED IN ACCORDANCE WITH HOWARD COUNTY COMMENTS	7/15/74	MW
3	REVISED IN ACCORDANCE WITH HOWARD COUNTY COMMENTS	9/3/74	MW
AS BUILT DRAWINGS			
DATE			
BY			
SECTION SYMBOL			
DRAWN F.W.G. DATE 4-12-74			
CHECKED L.C.P. JOB No. 73664C			
SITE PLAN GRADING			
ADDITION & ALTERATIONS PLANT & OFFICE BUILDING			
AMINCO			
SAVAGE, MARYLAND			
SHEET 3 OF 16			

DALTON & DALTON ENGINEERS & PLANNERS


ARCHITECTS & ENGINEERS & PLANNERS

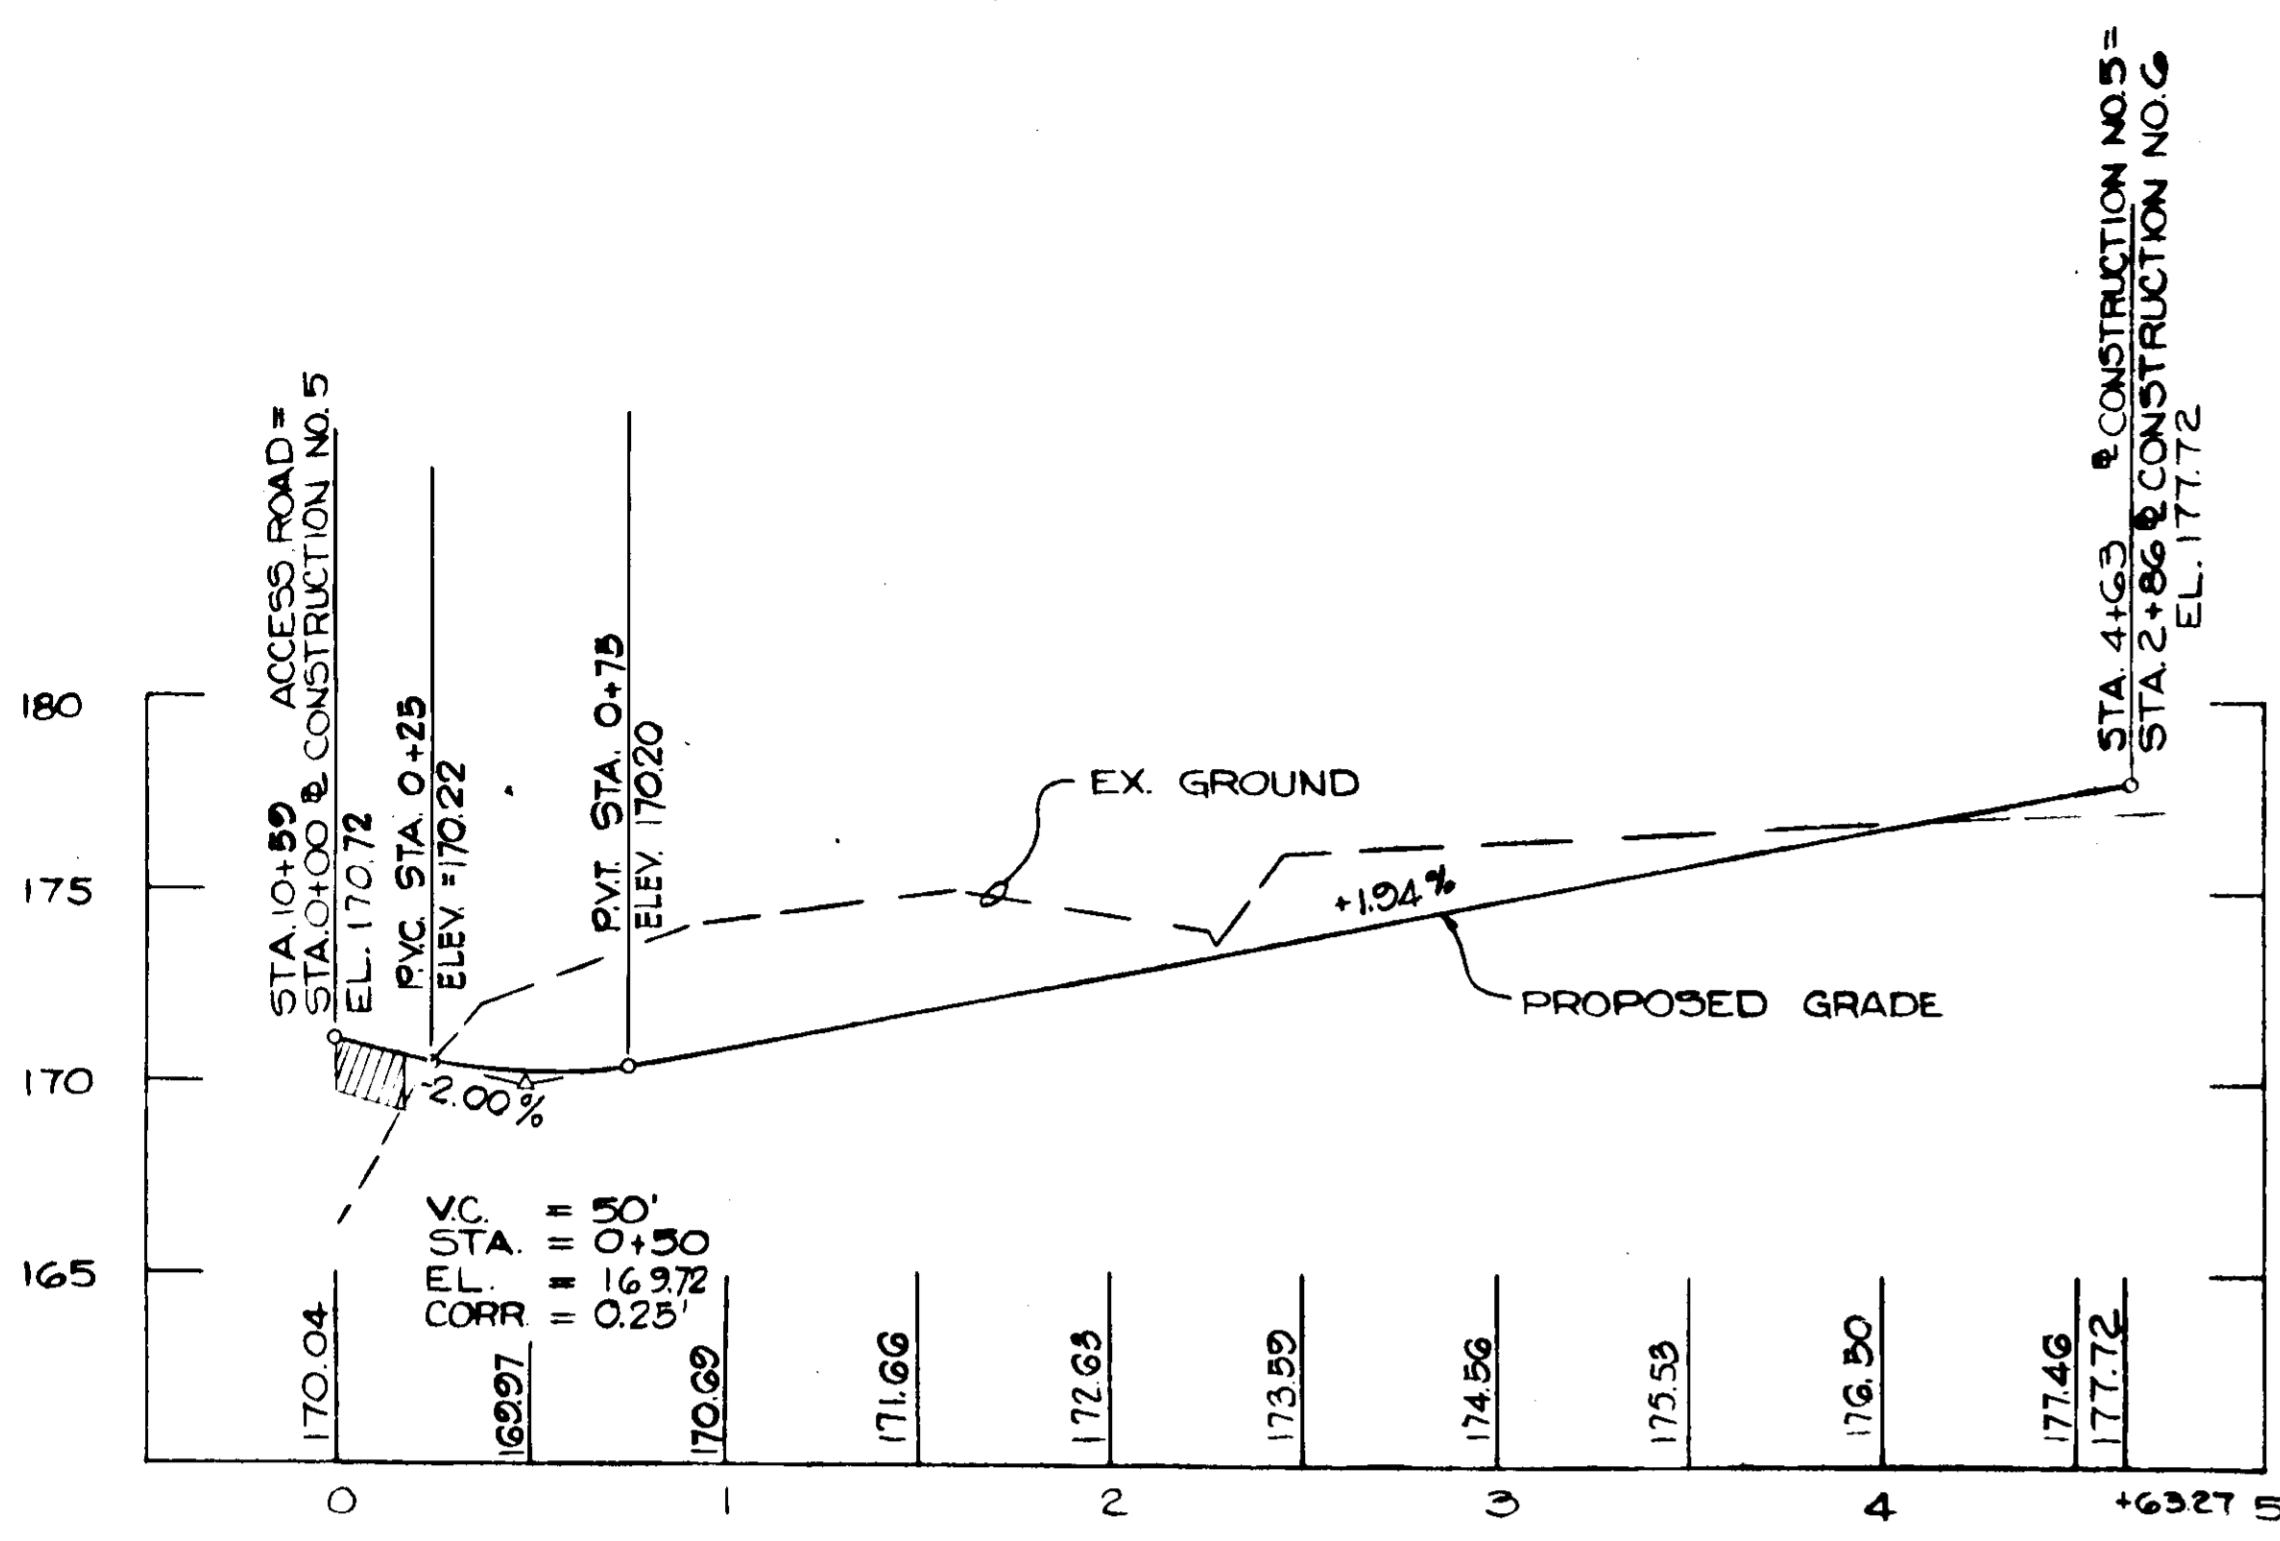


CONSTRUCTION NO. 5

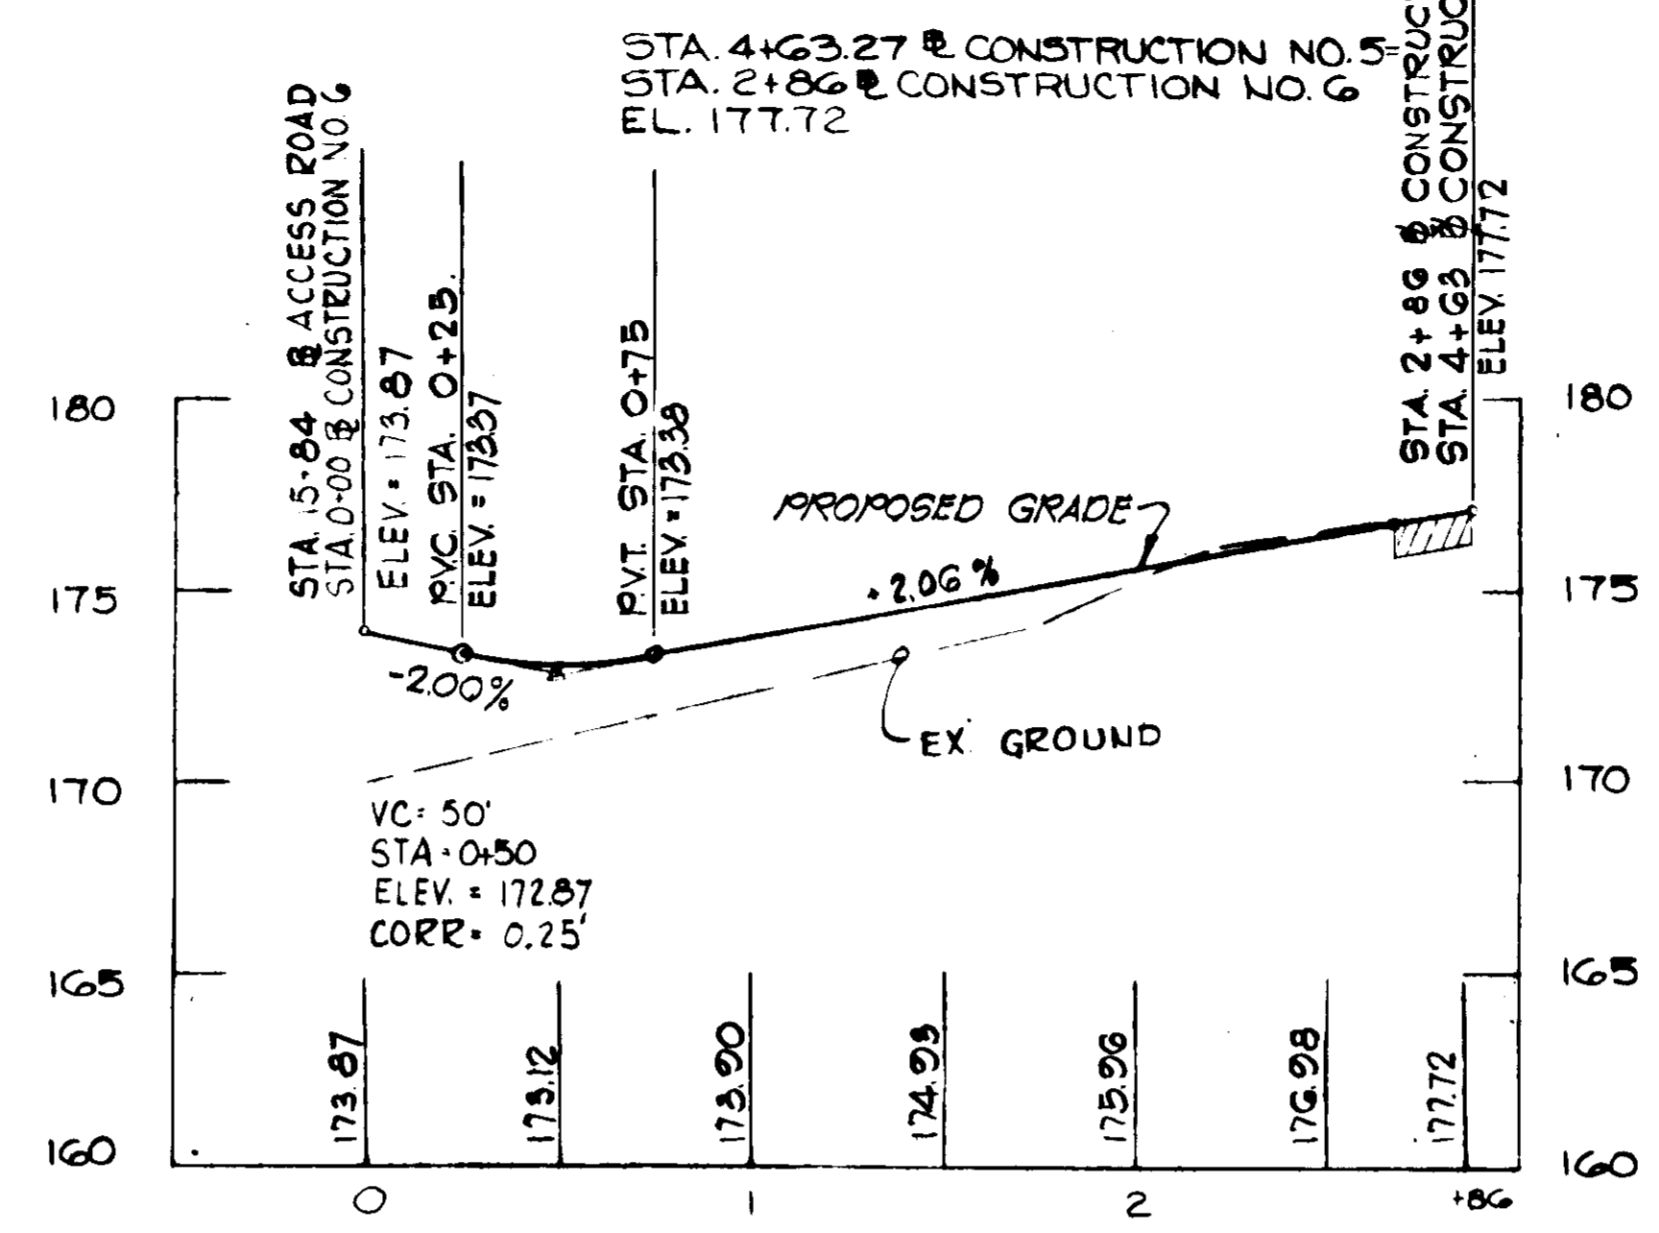

CONSTRUCTION NO. 6

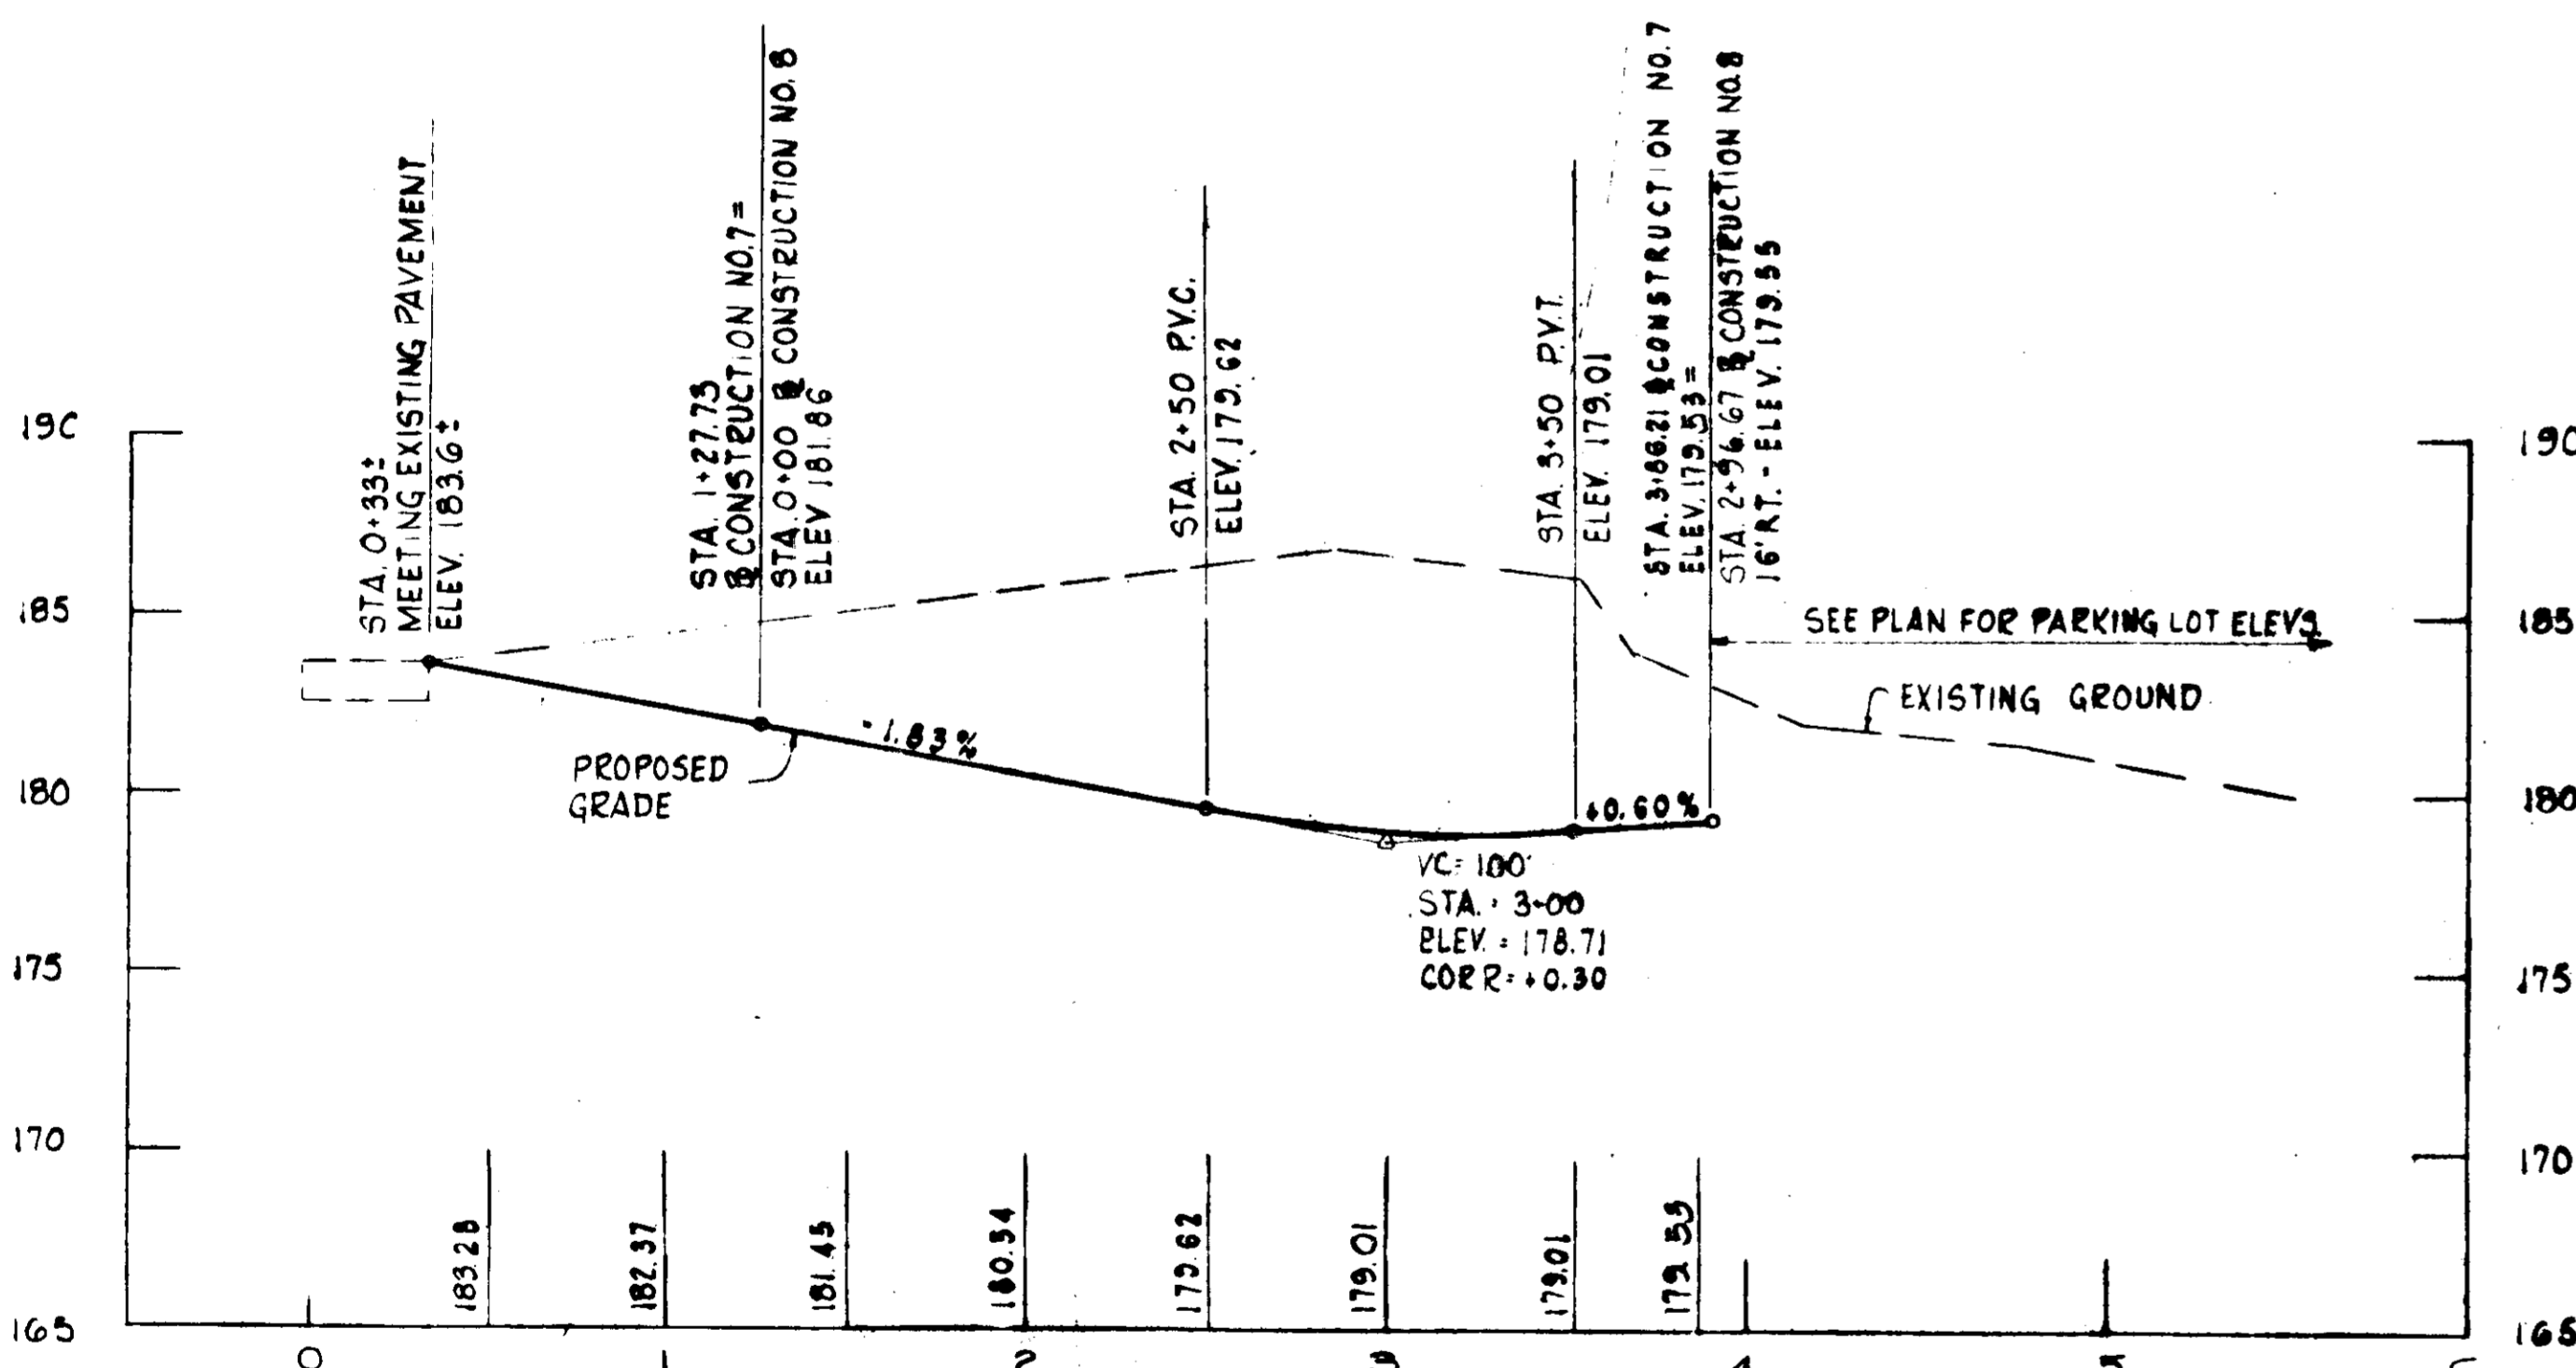

CONSTRUCTION NO. 7

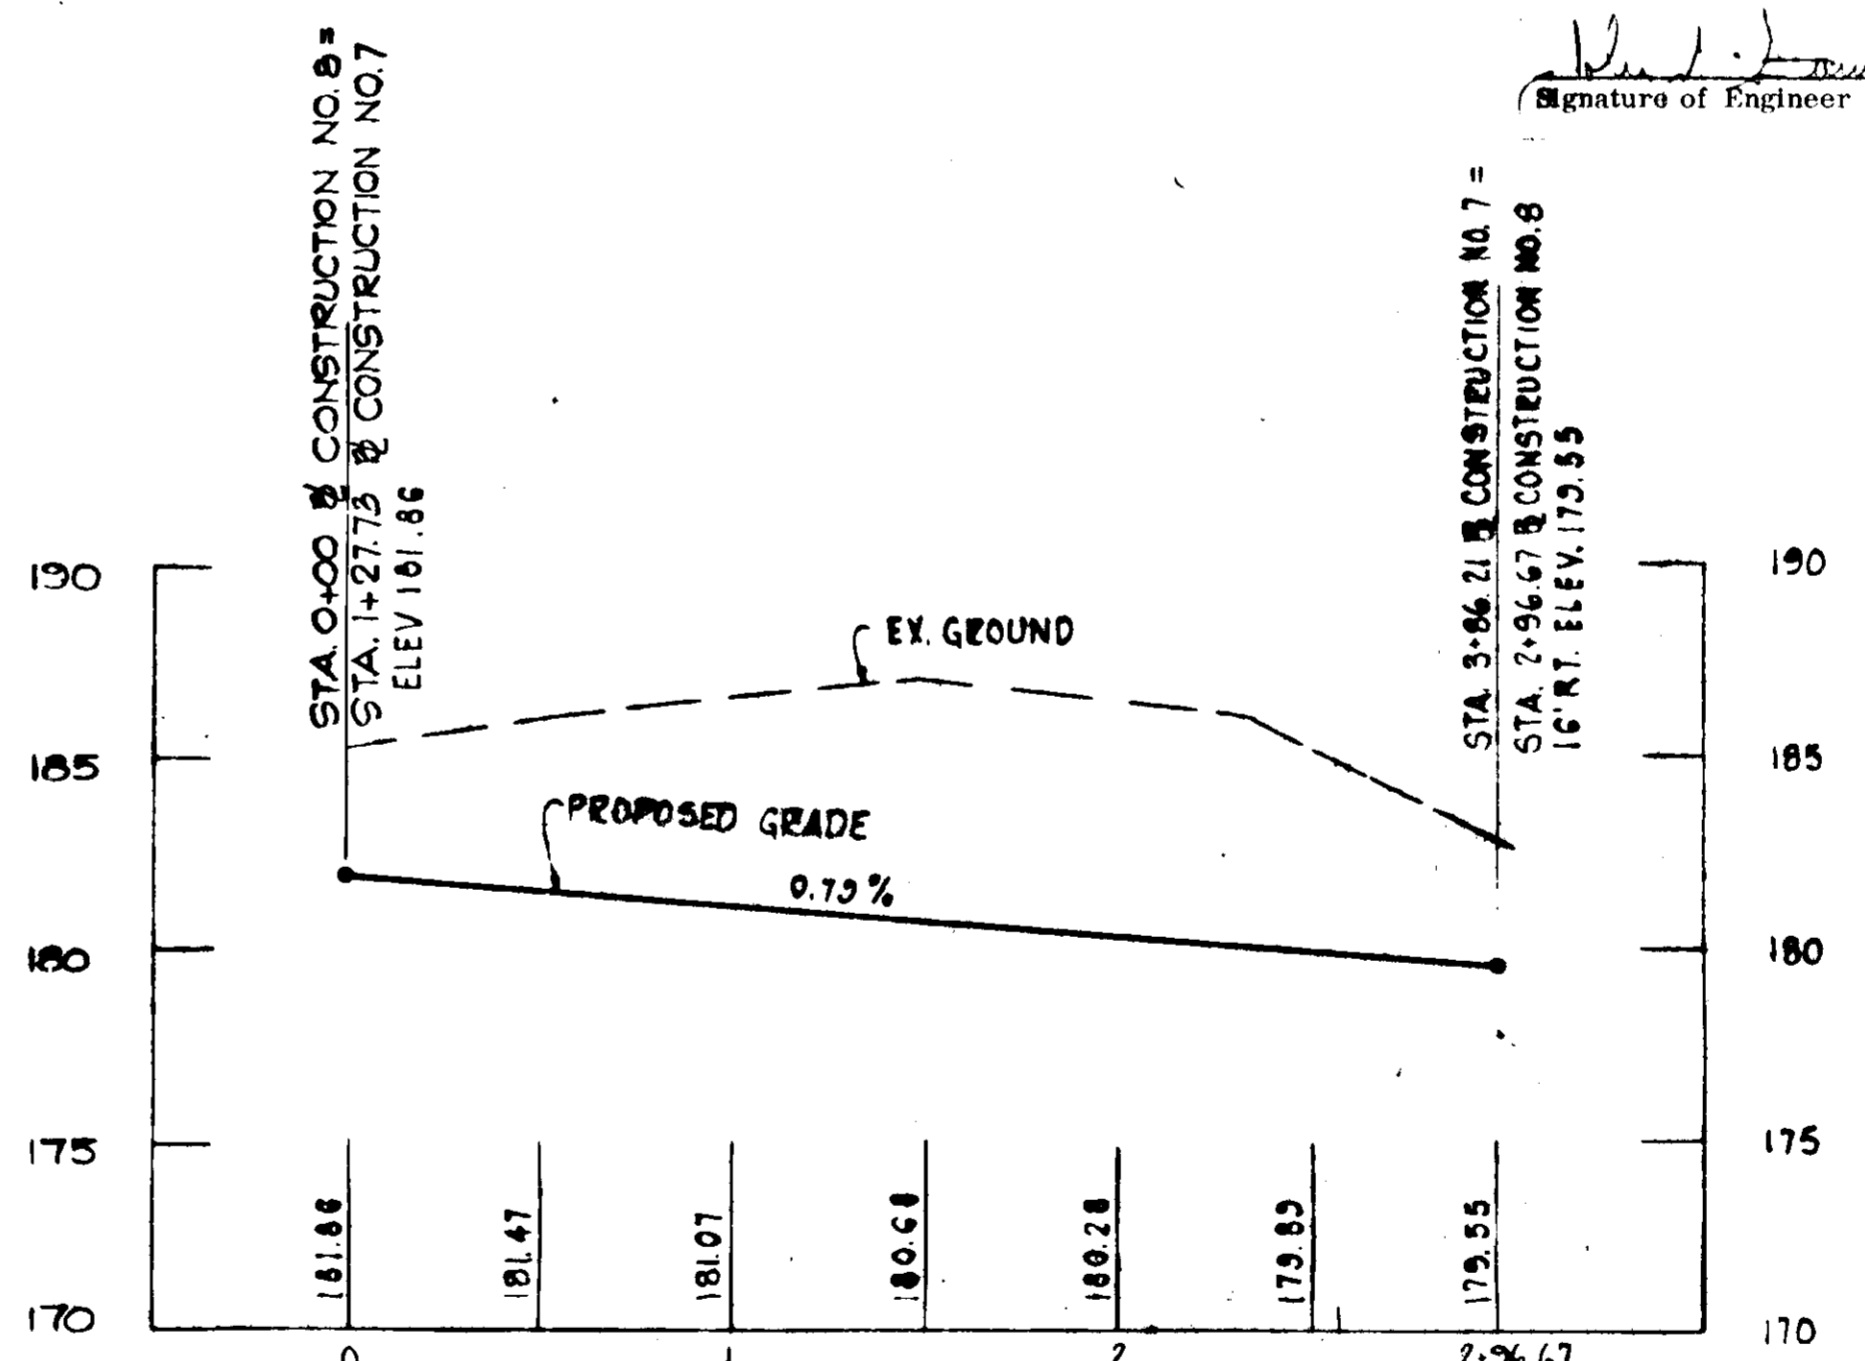

CONSTRUCTION NO. 8

PROFILE	PLAN SHT.
Constr. No. 5	2
Constr. No. 6	2
Constr. No. 7	3
Constr. No. 8	3

SCALE: HORIZ. 1" = 50'
VERT. 1" = 5'

APPROVED: FOR PUBLIC WATER AND PUBLIC SEWERAGE SYSTEMS, HOWARD COUNTY HEALTH DEPARTMENT
[Signature] 10/18/74
 COUNTY HEALTH OFFICER DATE

APPROVED: HOWARD COUNTY OFFICE OF PLANNING AND ZONING
[Signature] 10-8-74
 PLANNING DIRECTOR DATE

[Signature] 10/21/74
 CHIEF, DIVISION OF LAND DEVELOPMENT AND TRANSPORTATION PLANNING DATE

APPROVED: FOR PUBLIC WATER, PUBLIC SEWERAGE AND STORM DRAINAGE SYSTEMS AND ROADS
 HOWARD COUNTY DEPARTMENT OF PUBLIC WORKS
[Signature] 10/15/74
 DIRECTOR DATE

[Signature] 10/14/74
 CHIEF, BUREAU OF HIGHWAYS DATE

Reviewed for: Howard S. C. D.
 NAME
 and meets Technical Requirements
[Signature] Date 9-30-74
 Signature
 S. Soil Conservation Service

THIS DEVELOPMENT PLAN IS APPROVED FOR SOIL EROSION AND SEDIMENT CONTROL BY THE HOWARD SOIL CONSERVATION DISTRICT
 Approved: *[Signature]* Date 9-10-74
 Howard S. C. D.

By the Developer:
 "I certify that all development and/or construction will be done according to this plan of development and plan for Erosion and Sediment Control, and I also authorize periodic on-site inspection by the Howard Soil Conservation District or their authorized agents, as are deemed necessary." Deviation from this plan will not be made unless authorized by the Howard Soil Conservation District.
[Signature] 4-2-74
 Signature of Developer Date

By the Engineer:
 "I certify that this plan for Erosion and Sediment Control represents a practical and workable plan based on my personal knowledge of the site conditions and that it was prepared in accordance with the requirements of the Howard Soil Conservation District."
[Signature] 4-2-74
 Signature of Engineer Date

ISSUED FOR BIDDING

ADDENDA REVISIONS

ISSUED FOR CONSTRUCTION

REVISIONS

NO.	DESCRIPTION	DATE	BY
1	REVISED IN ACCORDANCE WITH HOWARD COUNTY COMMENTS	7/15/74	MW

AS BUILT DRAWINGS

APPROVED
 DIVISION OF PLANNING AND ZONING
 HOWARD COUNTY
 9/17/74
[Signature]

AMERICAN INSTRUMENT CO.
 DIVISION OF
 TRAVENOL LABORATORIES INC.
 HOWARD COUNTY, MD.
 ELECTION DISTRICT NO. 6
 TAX MAP 47, PARCEL NO. 145

SECTION SYMBOL


DRAWN F.W.G.	DATE 4-12-74
CHECKED L.C.P.	JOB NO. 736600

PROFILES

ADDITION & ALTERATIONS
 PLANT & OFFICE BUILDING
AMINCO
 SAVAGE MARYLAND

SHEET 4 OF 10

SOP-74-100

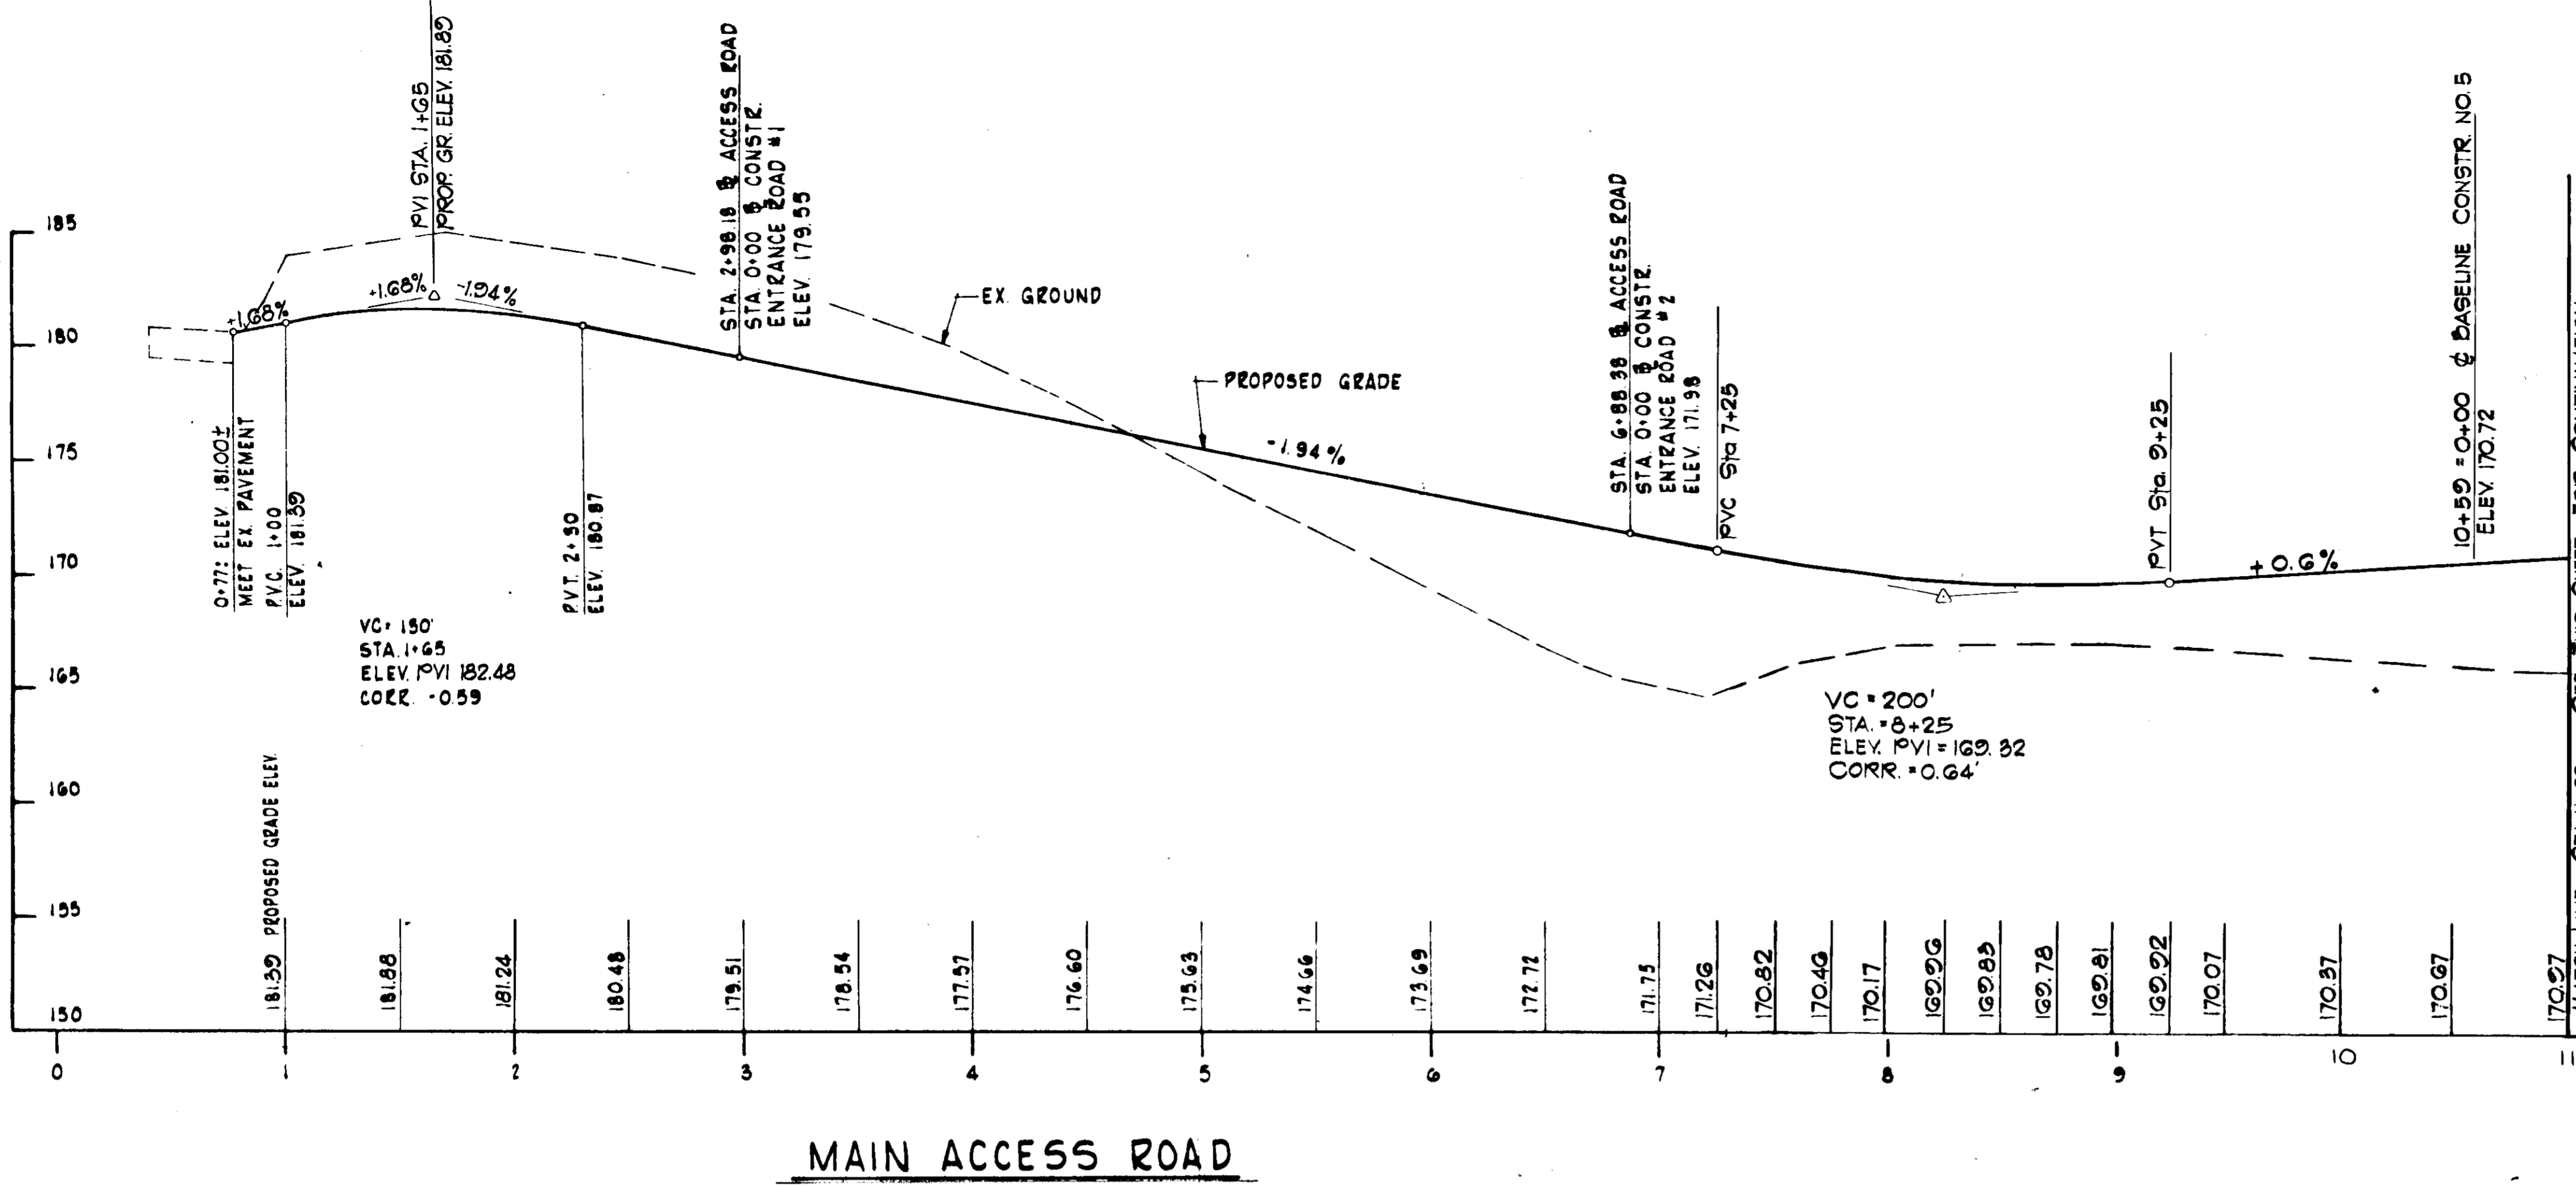

MAIN ACCESS ROAD

APPROVED: FOR PUBLIC WATER AND PUBLIC SEWERAGE SYSTEMS, HOWARD COUNTY HEALTH DEPARTMENT
[Signature] 10/8/74
 COUNTY HEALTH OFFICER DATE

APPROVED: HOWARD COUNTY OFFICE OF PLANNING AND ZONING
[Signature] 10-8-74
 PLANNING DIRECTOR DATE
[Signature] 10/8/74
 CHIEF, DIVISION OF LAND DEVELOPMENT AND TRANSPORTATION PLANNING DATE

APPROVED: FOR PUBLIC WATER, PUBLIC SEWERAGE AND STORM DRAINAGE SYSTEMS AND ROADS HOWARD COUNTY DEPARTMENT OF PUBLIC WORKS
[Signature] 10/4/74
 DIRECTOR DATE
[Signature] 10/4/74
 CHIEF, BUREAU OF HIGHWAYS DATE


Reviewed for: Howard NAME S. C. D.
 and meets Technical Requirements
[Signature] Date 9-30-74
 Signature
 S. Soil Conservation Service

THIS DEVELOPMENT PLAN IS APPROVED FOR SOIL EROSION AND SEDIMENT CONTROL BY THE HOWARD SOIL CONSERVATION DISTRICT
 Approved: *[Signature]* Date 9-30-74
 Howard S. C. D.


By the Developer:
 "I certify that all development and/or construction will be done according to this plan of development and plan for Erosion and Sediment Control, and I also authorize periodic on-site inspection by the Howard Soil Conservation District or their authorized agents, as are deemed necessary." Deviation from this plan will not be made unless authorized by the Howard Soil Conservation District.
[Signature] 4-11-74
 Signature of Developer Date

By the Engineer:
 "I certify that this plan for Erosion and Sediment Control represents a practical and workable plan based on my personal knowledge of the site conditions and that it was prepared in accordance with the requirements of the Howard Soil Conservation District."
[Signature] 4-10-74
 Signature of Engineer Date

ISSUED FOR BIDDING	DATE	BY	
ADDENDA REVISIONS			
NO.	DESCRIPTION	DATE	BY
1	REVISED IN ACCORDANCE WITH HOWARD COUNTY COMMENTS	7/15/74	M.W.
2	REVISED IN ACCORDANCE WITH HOWARD COUNTY COMMENTS	9/3/74	M.W.

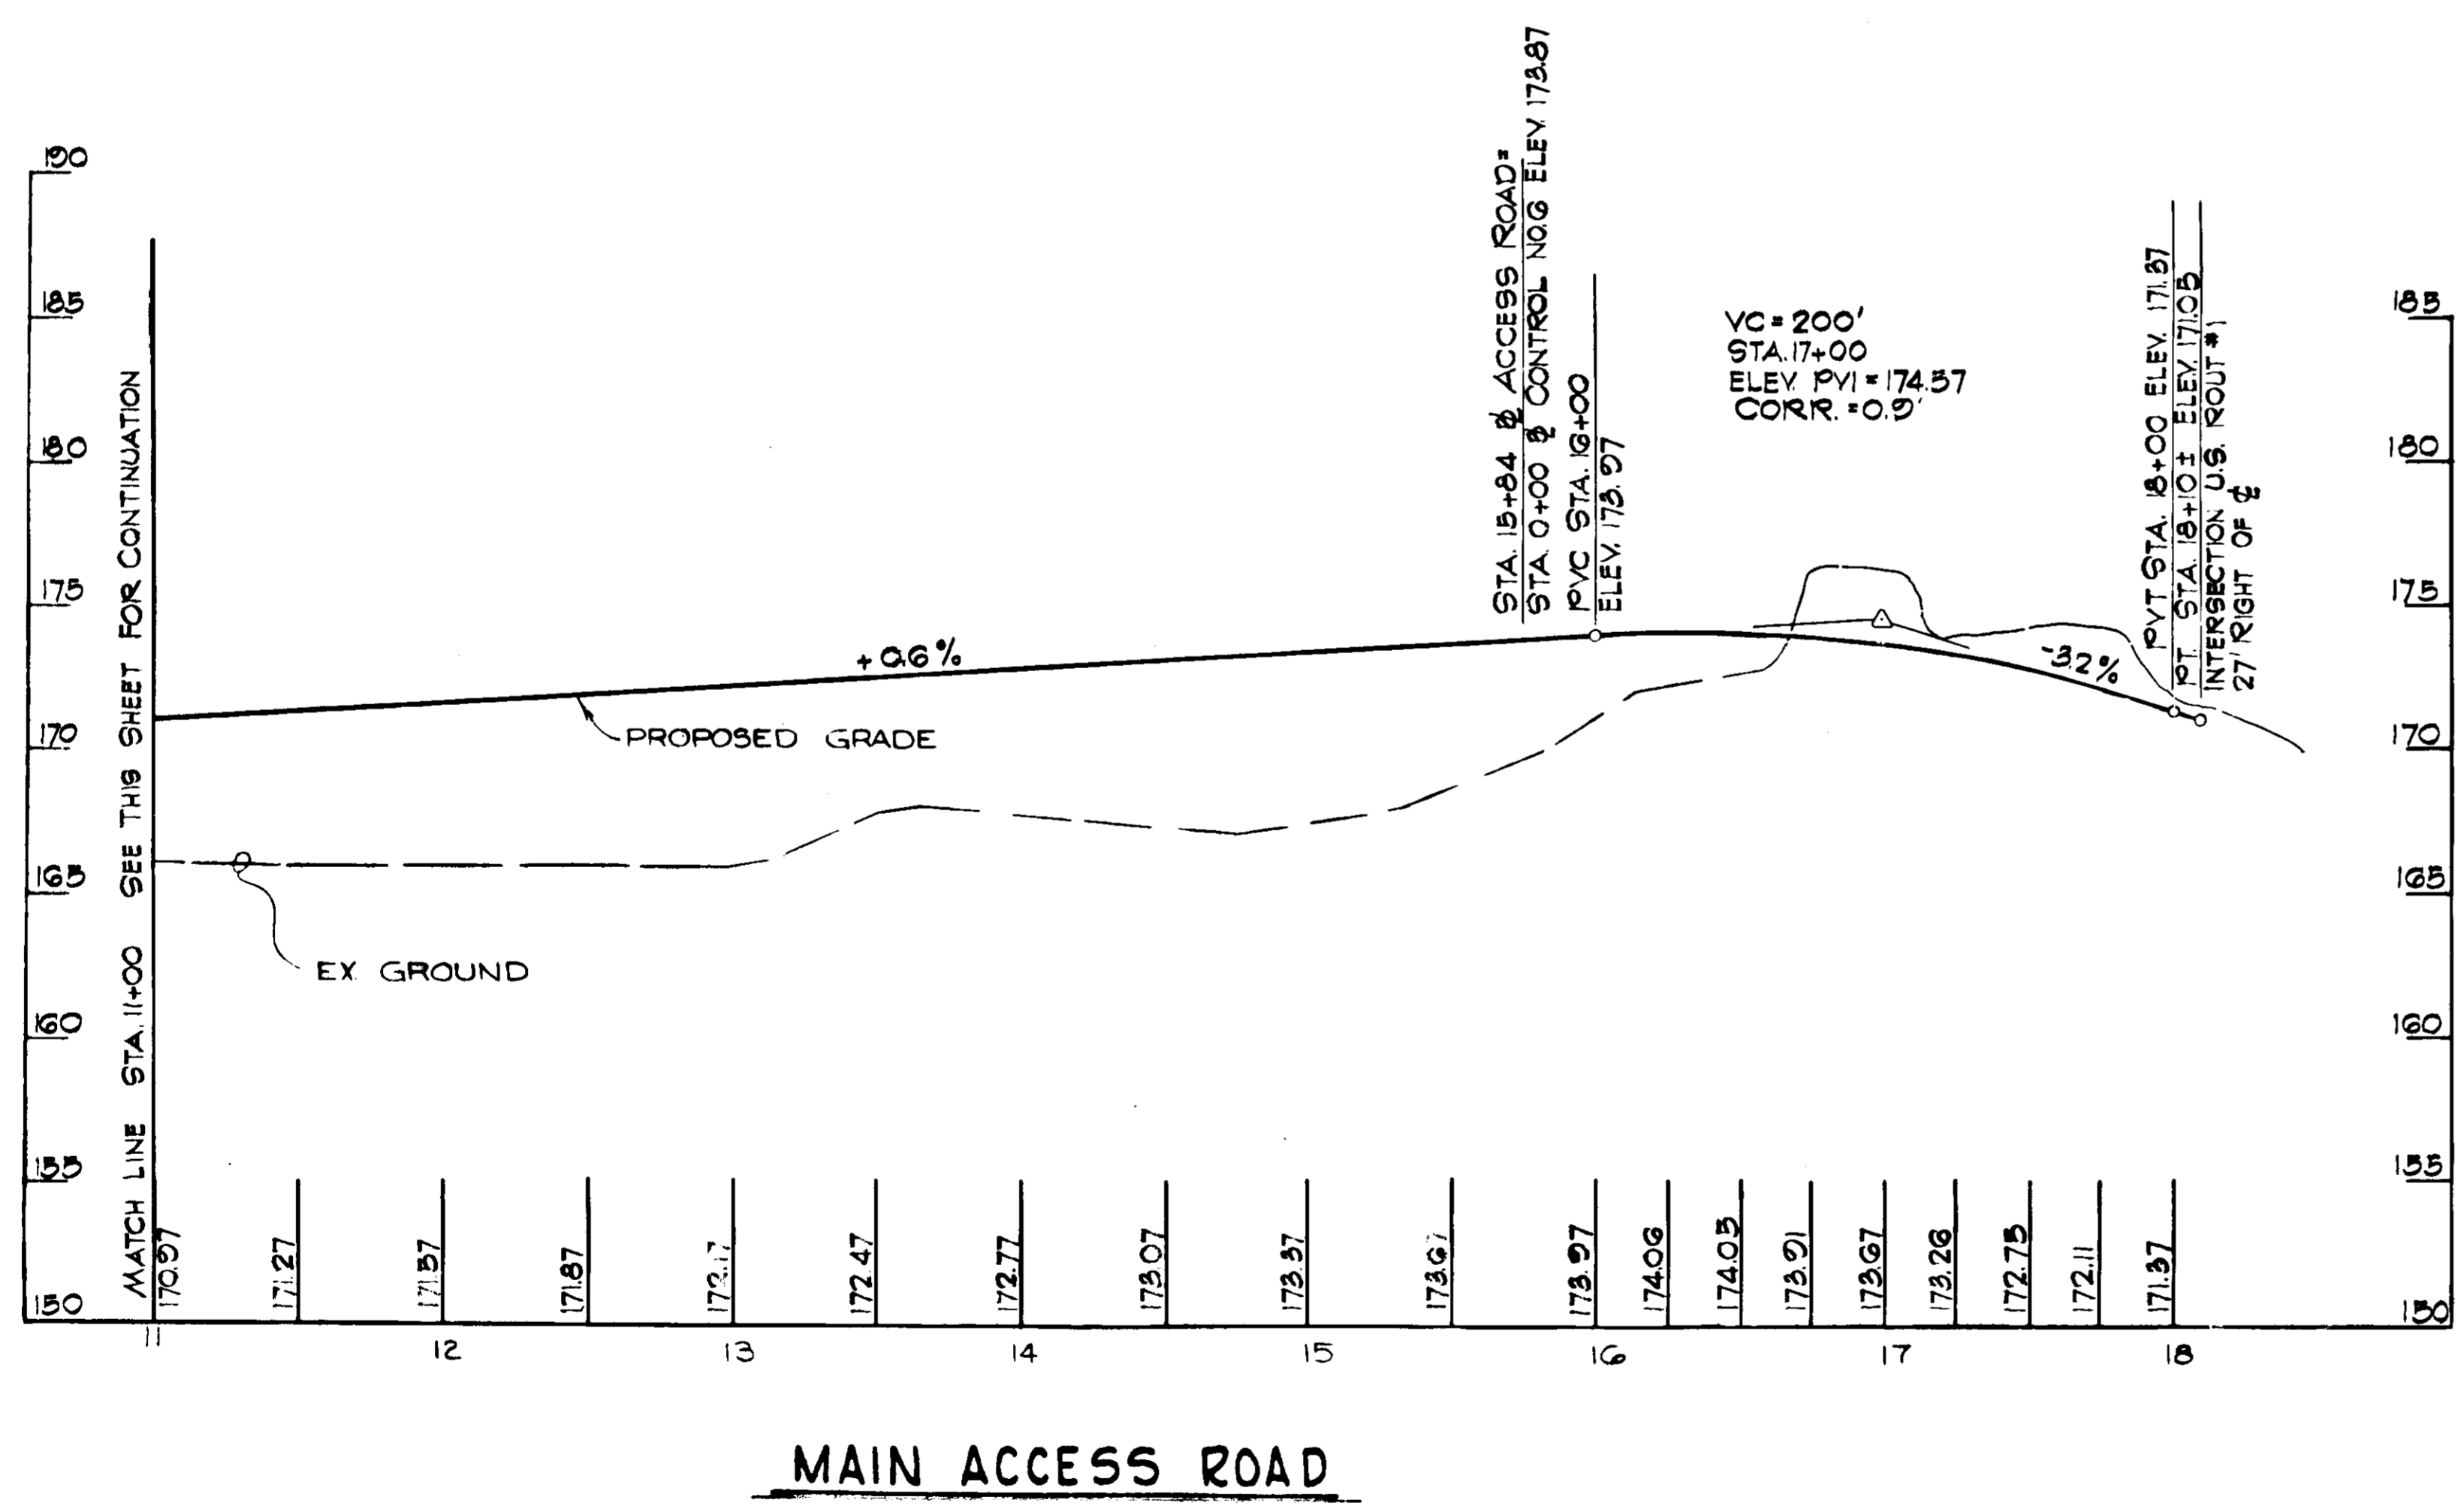

MAIN ACCESS ROAD

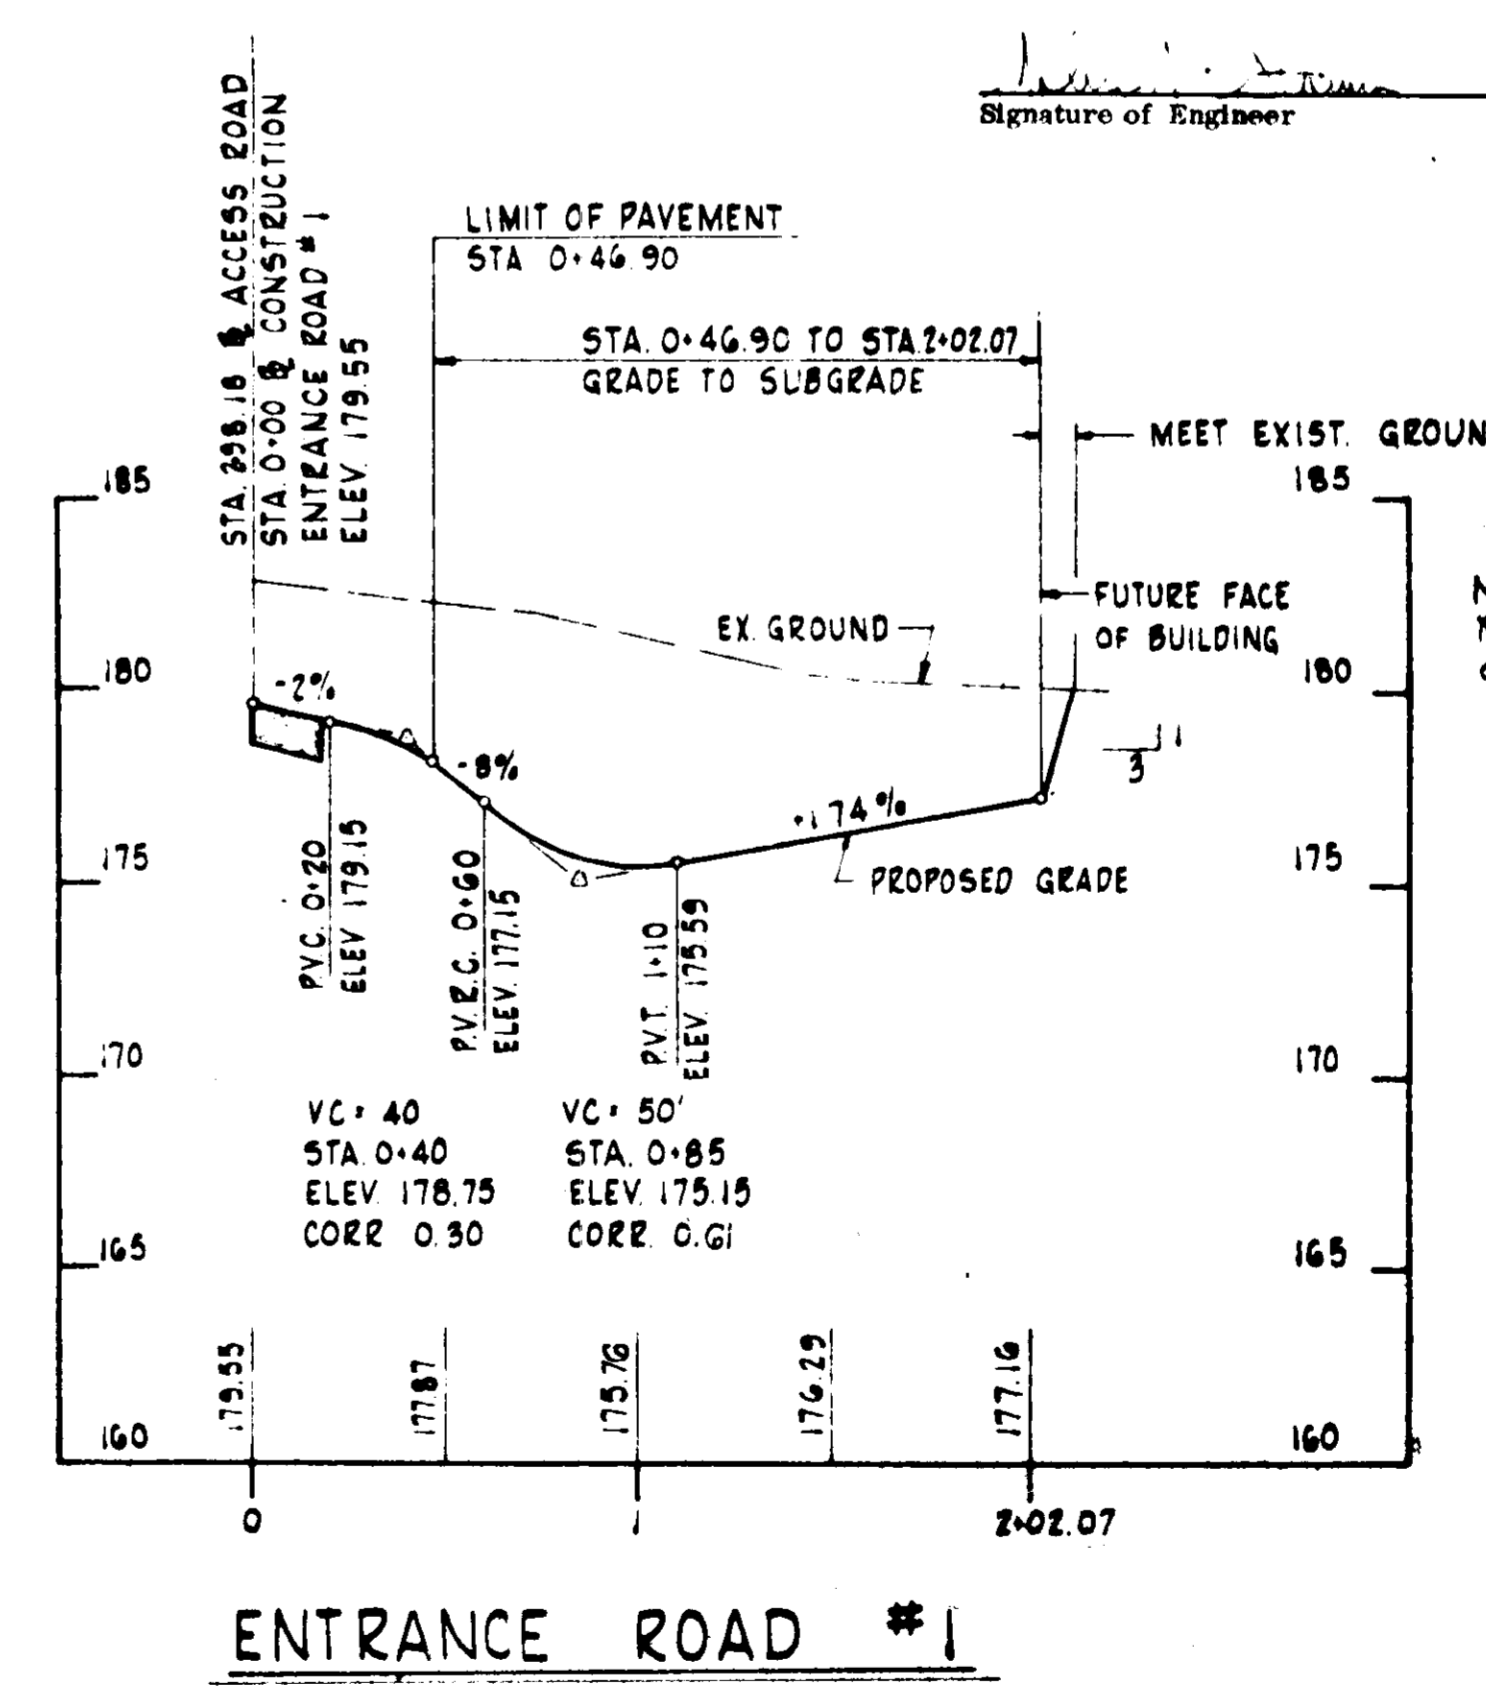

ENTRANCE ROAD #1

Note: For Plan of Entrance Road #1 See Sheet No. 3 of 16

SCALE: HORZ. 1"=50'
 VERT. 1"=5'

AS BUILT DRAWING

9/17/74
[Signature]


AMERICAN INSTRUMENT CO.
 DIVISION OF
 TRAVENOL LABORATORIES INC.
 HOWARD COUNTY, MD.
 ELECTION DISTRICT NO. 6
 TAX MAP 47, PARCEL NO. 145

INSPECTION SYMBOL


DRAWN F.W.G. DATE 4-12-74
 CHECKED L.C.P. JOB No. 736640

PROFILES


ADDITION & ALTERATIONS
 PLANT & OFFICE BUILDING
 AMINCO
 SAVAGE MARYLAND

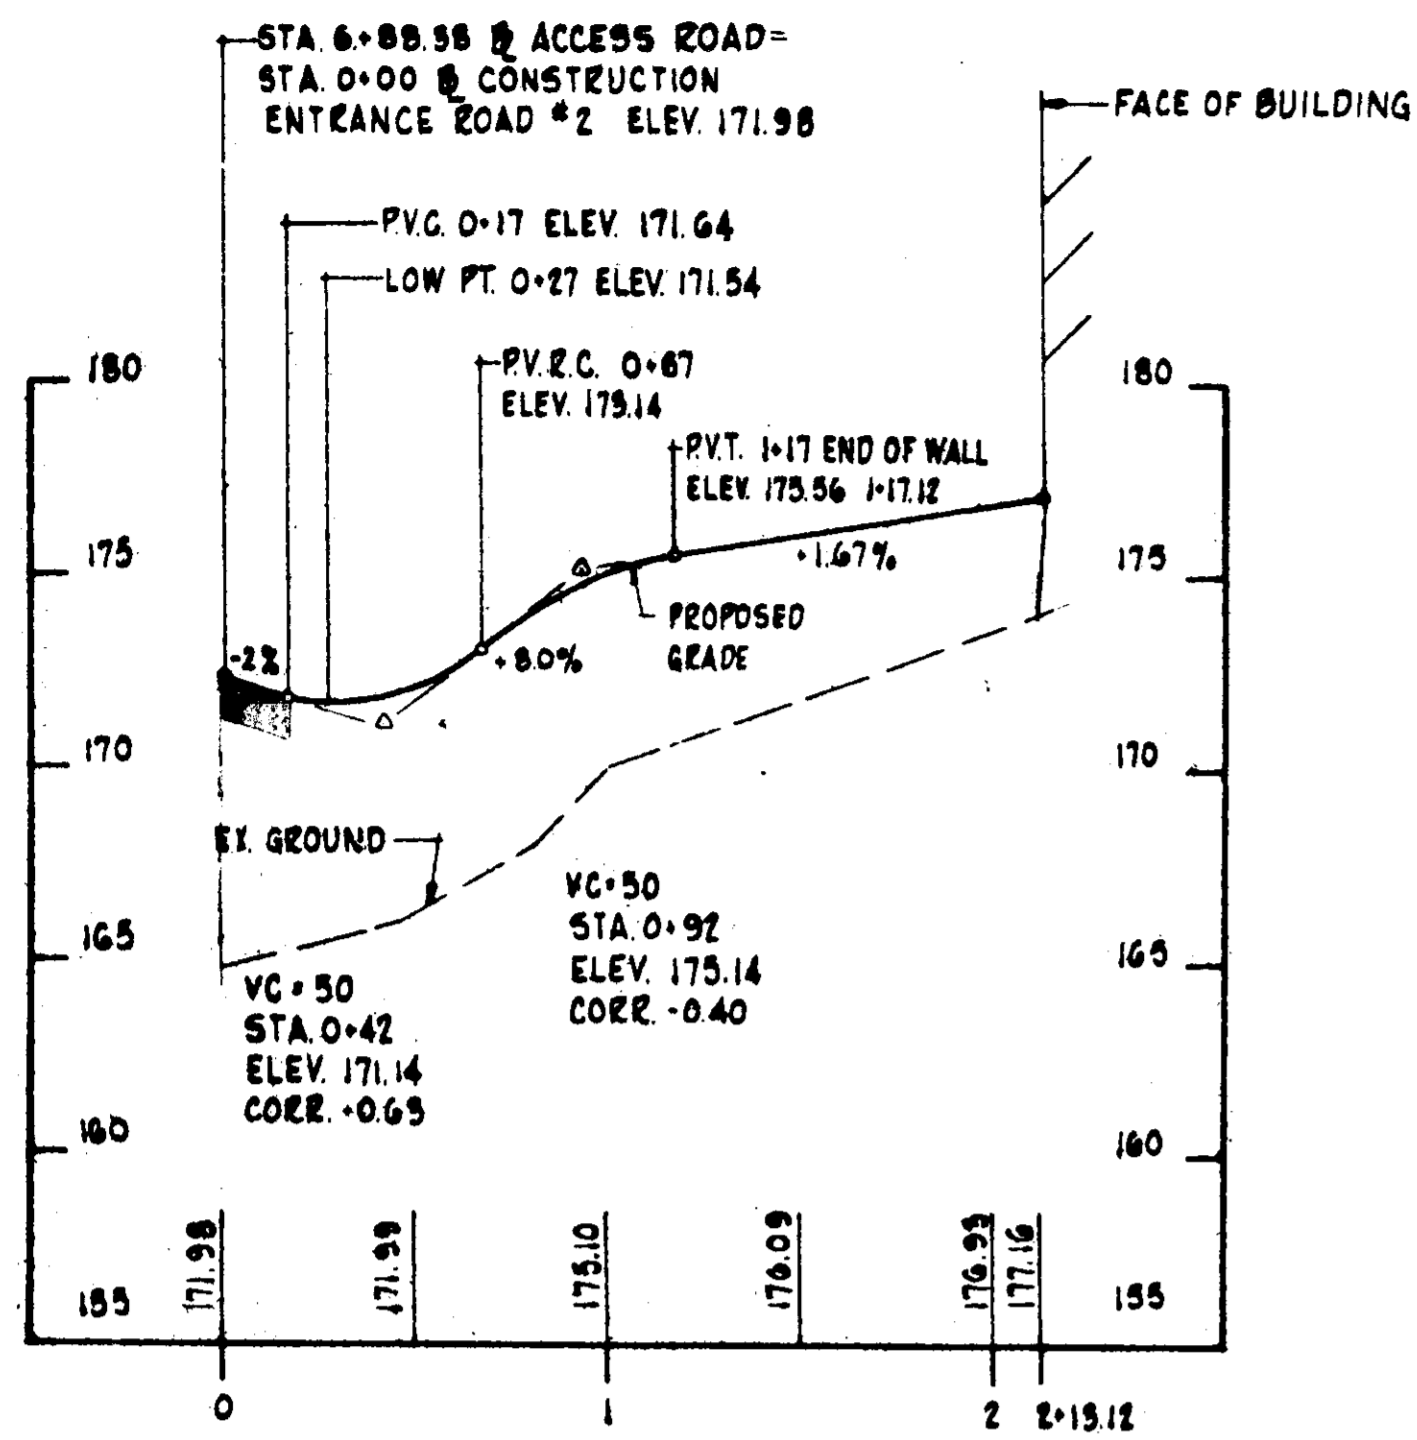

ENTRANCE ROAD # 2

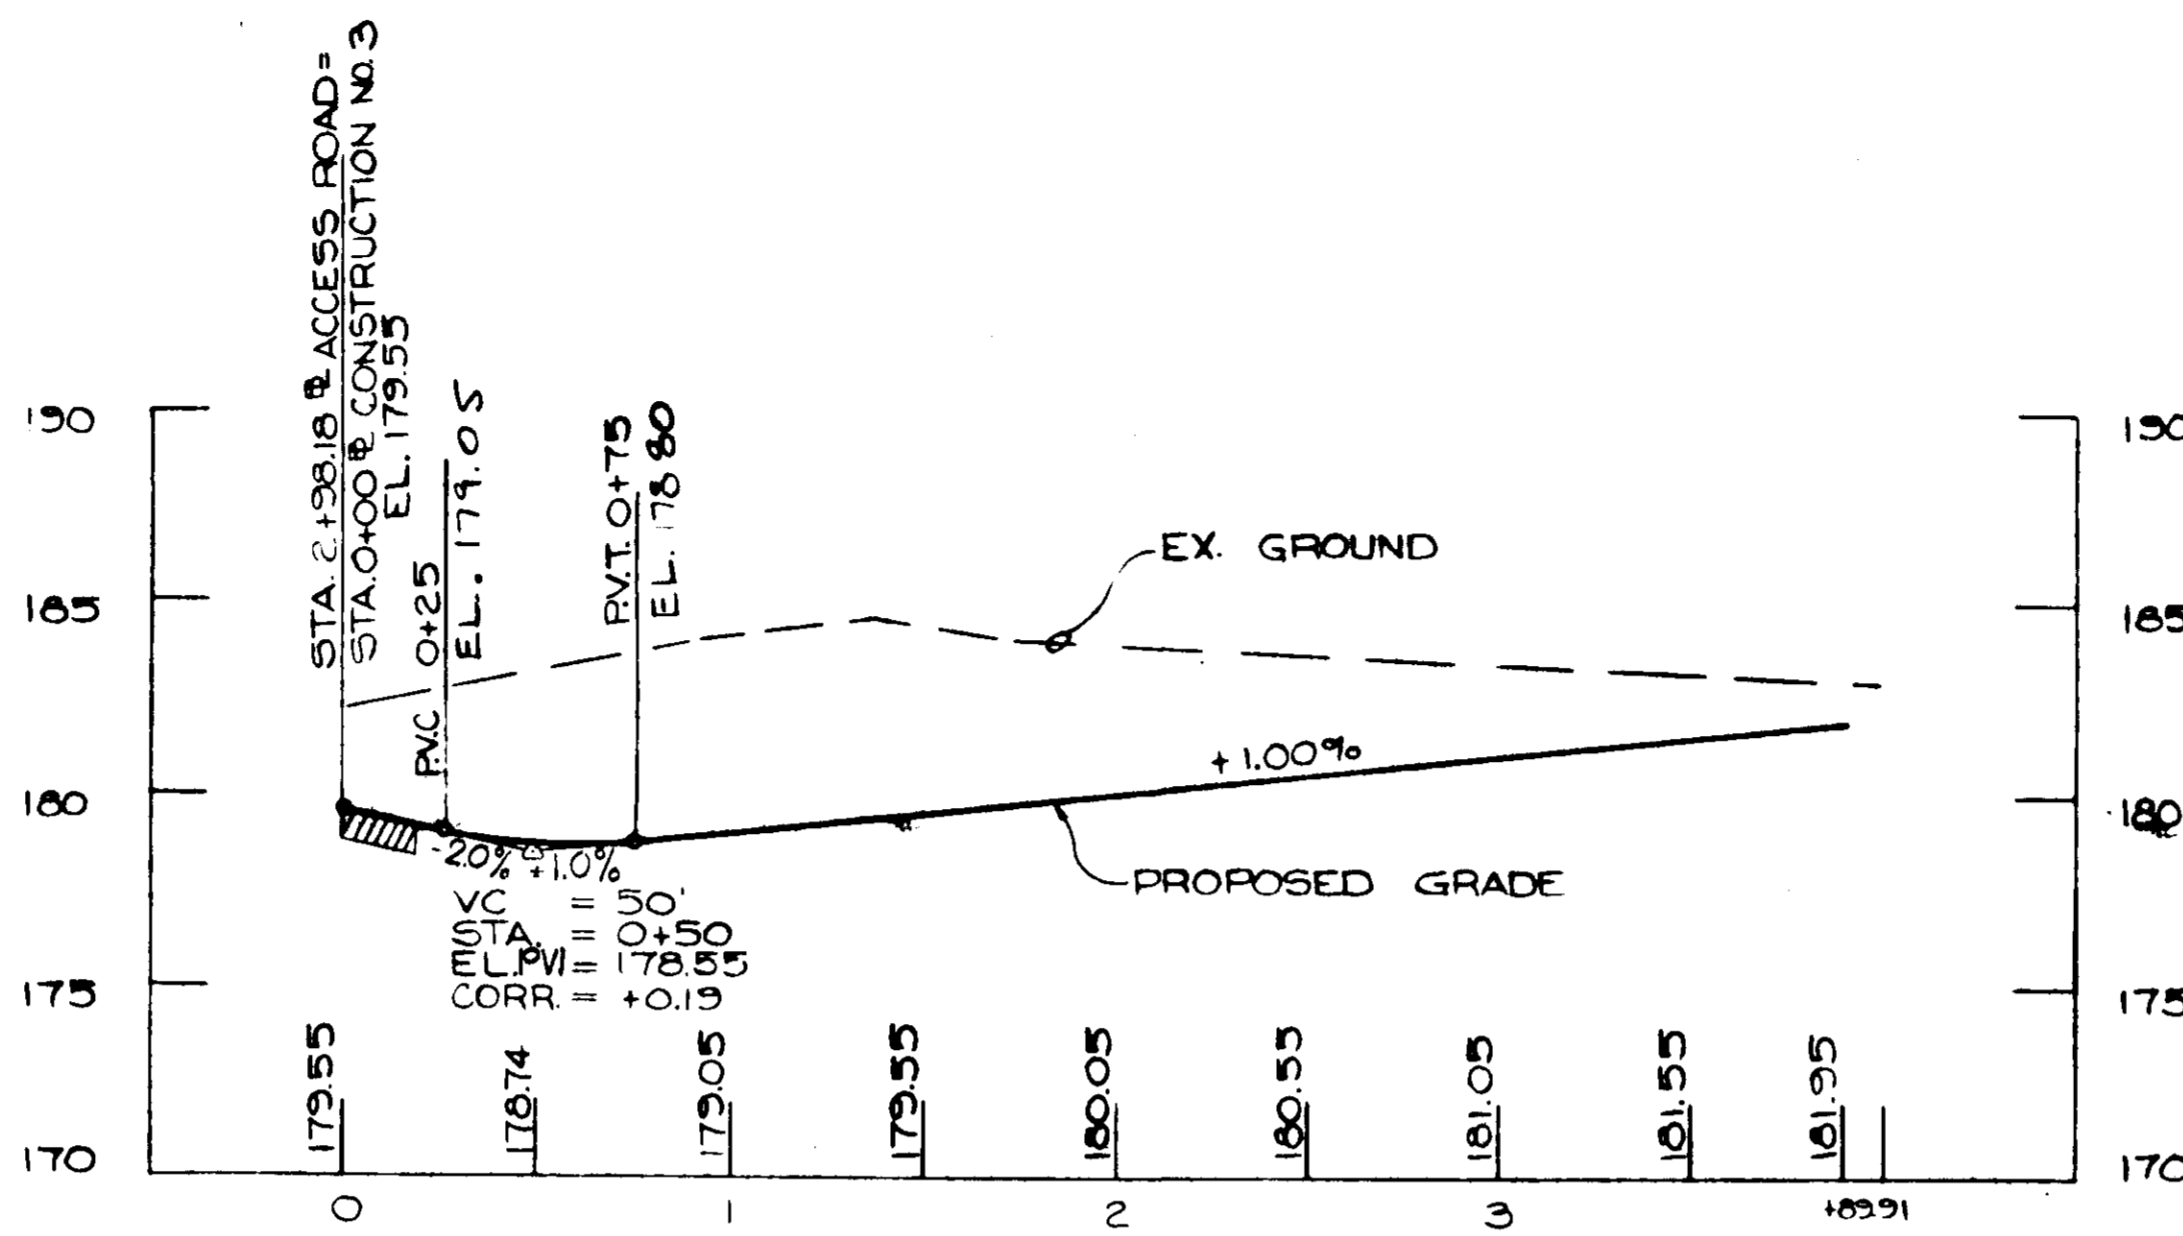

CONSTRUCTION NO. 3

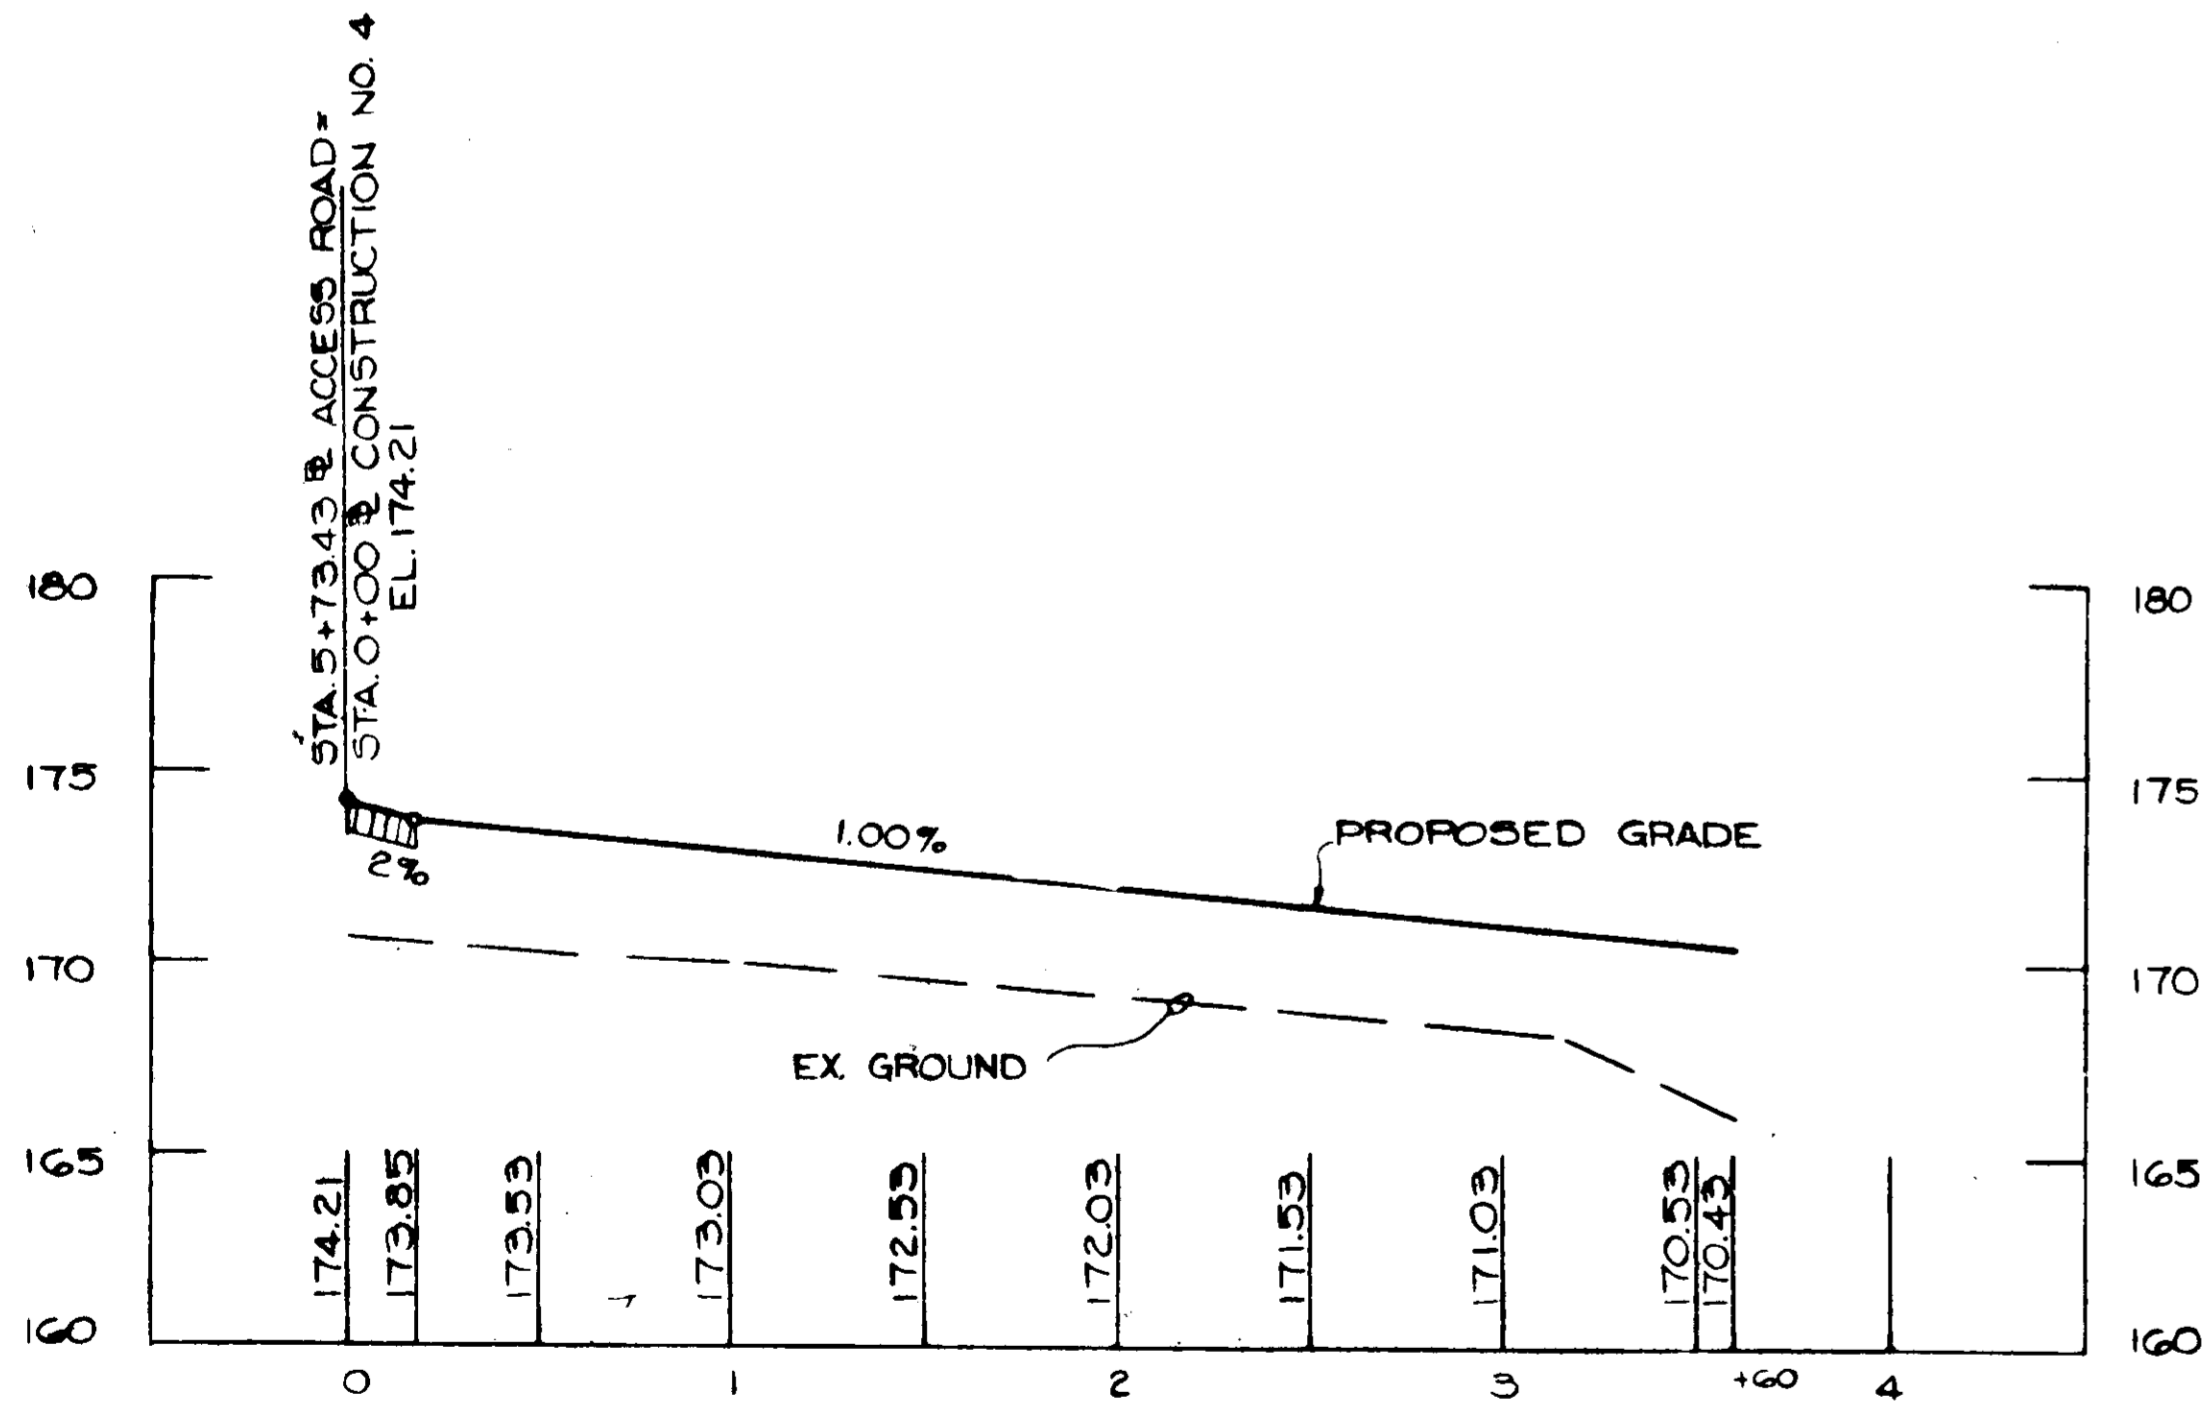

CONSTRUCTION NO. 4

SOIL STABILIZATION NOTES

- Provide 24 hour notice to HSCD and Bureau of Inspection and Permits prior to beginning grading.
- As soon as roughgrading is completed, areas to be paved will be stabilized with base course material.
- Sediment control structures are to be constructed and stabilized according to Note 6 prior to any other grading on this site.
- Sediment control measures are not to be removed without the approval of the Sediment Control Inspector and not until all areas upgrade have been stabilized.
- Following the removal of Sediment Control measures, the disturbed area will be stabilized immediately in accordance with Note 6.
- Final Stabilization:
 - Sodding
 - Pulverized dolomitic limestone shall be applied at a minimum rate of 46 lbs. per 1,000 sq. ft.
 - Fertilizer - (10-10-10) or its equivalent shall be distributed evenly over the area to be sodded at a rate of 23 lbs. per 1,000 sq. ft.
 - Lime and fertilizer shall be harrowed or disced into the soil to a depth of 2-3 inches until a uniform bed has been prepared.
 - Sod shall be not less than 50% Kentucky Blue Grass, free from weeds and shall be State "Approved Sod" not less than three (3) years old, machine cut uniform thickness of 3/4 inches (1.4 inch) excluding top growth and thatch and shall be installed within 36 hours of harvesting.
 - Sod shall be watered immediately after placement and kept watered for a period of two weeks until growth is assured or until accepted.
 - As sodding is completed in any section the entire area shall be rolled and all cracks between blocks of sod shall be closed with additional sod.
 - Seeding
 - Pulverized dolomitic limestone shall be applied at a rate of 46 lbs. per 1,000 sq. ft.
 - Fertilizer (10-10-10) or its equivalent shall be distributed evenly over the area to be seeded at a rate of 23 lbs. per 1,000 sq. ft.
 - Lime and fertilizer shall be harrowed or disced into the soil to a depth of 2-3 inches until a uniform bed has been prepared.
 - Slopes 3:1 or flatter shall be seeded with a mixture of 1.13 lbs. of Kentucky 31 tall fescue and 0.34 lbs. of Korean lespedeza, inoculated per 1,000 sq. ft. or other approved mixture applied uniformly over the prepared seed bed.
 - Slopes steeper than 3:1 (but not steeper than 2:1) shall be seeded with 0.34 lbs. of Crownvetch and .92 lbs. of Kentucky 31 tall fescue per 1,000 sq. ft. applied uniformly over the prepared seed bed.
 - Seed may be applied with a cyclone seeder, drill or multipacker on a firm moist seed bed. Use of a hydroseeder may be approved in which case the seed and fertilizer shall be included in the slurry.
 - Immediately after seeding, all areas shall be mulched with unweathered small grain straw at the rate of 69 to 92 lbs. per 1,000 sq. ft.
 - All mulched areas shall be anchored using either:
 - Mulch anchoring tool - a series of flat notched discs which punch the mulch material into the soil.
 - Asphalt mulch tie-down using liquid asphalt - rapid curing (PC-70, PC-250, or RC-800) or medium-curing (MC-250 or MC 800) at a rate of 0.1 gal. per sq. yd.
 - Swale areas seeded and mulched shall be stabilized using plastic net over the mulch and stapled into the ground at all joints in the net and at intervals between joints to prevent erosion of the seed bed mulch cover.

PROFILE	PLAN SHT.
Entr. Rd. #2	2
Constr. No. 3	3
Constr. No. 4	2 & 3

SCALE: HORIZ. 1"=50'
VERT. 1"=5'

APPROVED: FOR PUBLIC WATER AND PUBLIC SEWERAGE SYSTEMS, HOWARD COUNTY HEALTH DEPARTMENT
 COUNTY HEALTH OFFICER
 DATE 10/8/74

APPROVED: HOWARD COUNTY OFFICE OF PLANNING AND ZONING
 PLANNING DIRECTOR
 CHIEF, DIVISION OF LAND DEVELOPMENT AND TRANSPORTATION PLANNING
 DATE 10-8-74
 DATE 12/21/74

APPROVED: FOR PUBLIC WATER, PUBLIC SEWERAGE AND STORM DRAINAGE SYSTEMS AND ROADS
 HOWARD COUNTY DEPARTMENT OF PUBLIC WORKS

Director
 Chief, Bureau of Highways
 DATE 10/4/74
 DATE 10/4/74

Reviewed for: Howard - S.C.D.

and meets Technical Requirements
 Signature
 U.S. Soil Conservation Service

THIS DEVELOPMENT PLAN IS APPROVED FOR SOIL EROSION AND SEDIMENT CONTROL BY THE HOWARD SOIL CONSERVATION DISTRICT

Approved: Robert W. Ziehm Date 9-30-74
 Howard S.C.D.

By the Developer:

"I certify that all development and/or construction will be done according to this plan of development and plan for Erosion and Sediment Control, and I also authorize periodic on-site inspection by the Howard Soil Conservation District or their authorized agents, as are deemed necessary." Deviation from this plan will not be made unless authorized by the Howard Soil Conservation District.

Signature of Developer
 Date 8-16-74

By the Engineer:

"I certify that this plan for Erosion and Sediment Control represents a practical and workable plan based on my personal knowledge of the site conditions and that it was prepared in accordance with the requirements of the Howard Soil Conservation District."
 Signature of Engineer
 Date 4-11-74

ISSUED FOR BIDDING

ADDENDA REVISIONS

ISSUED FOR CONSTRUCTION

REVISIONS

NO.	DESCRIPTION	DATE	BY
1	REMOVE SPECIAL STRUCTURE DETAIL AND REVISE END PIECE DETAIL	5/13/74	W.B.
2	REVISED IN ACCORDANCE WITH HOWARD COUNTY COMMENTS	7/15/74	M.W.
3	REVISED IN ACCORDANCE WITH HOWARD COUNTY COMMENTS	9/3/74	M.W.

AS BUILT DRAWINGS

9/17/74
 J.H. Clauson

AMERICAN INSTRUMENT CO. DIVISION OF TRAVENOL LABORATORIES INC. HOWARD COUNTY, MD. ELECTION DISTRICT NO. 6 TAX MAP 47, PARCEL NO. 145

SECTION SYMBOL


DRAWN F.W.G. DATE 4-12-74
 CHECKED L.C.P. JOB NO. 796640

SOIL STABILIZATION NOTES & PROFILES

ADDITION & ALTERATIONS PLANT & OFFICE BUILDING AMINCO SAVAGE MARYLAND


SHEET 6 OF 10

SPP-74-100

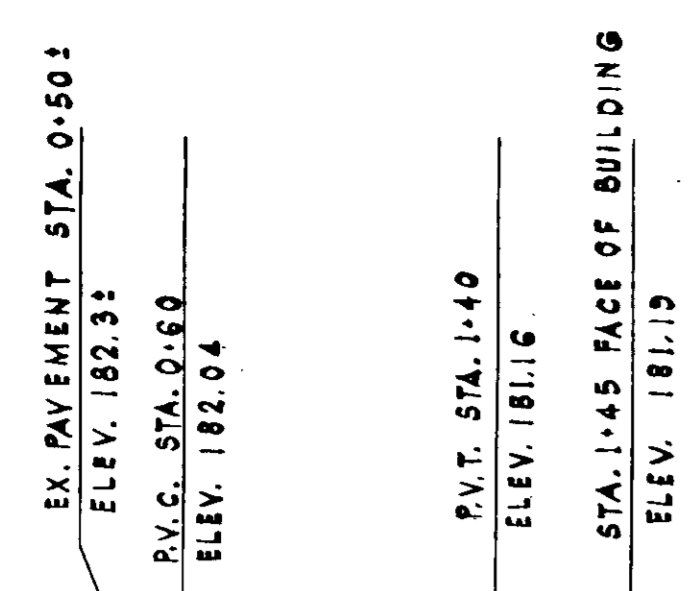


SCALE: HORZ. 1" = 50'
VERT. 1" = 5'

NOTE: FOR PLAN OF CONSTRUCTION NO. 9 & 10 SEE SHEET NO. 3 OF 10

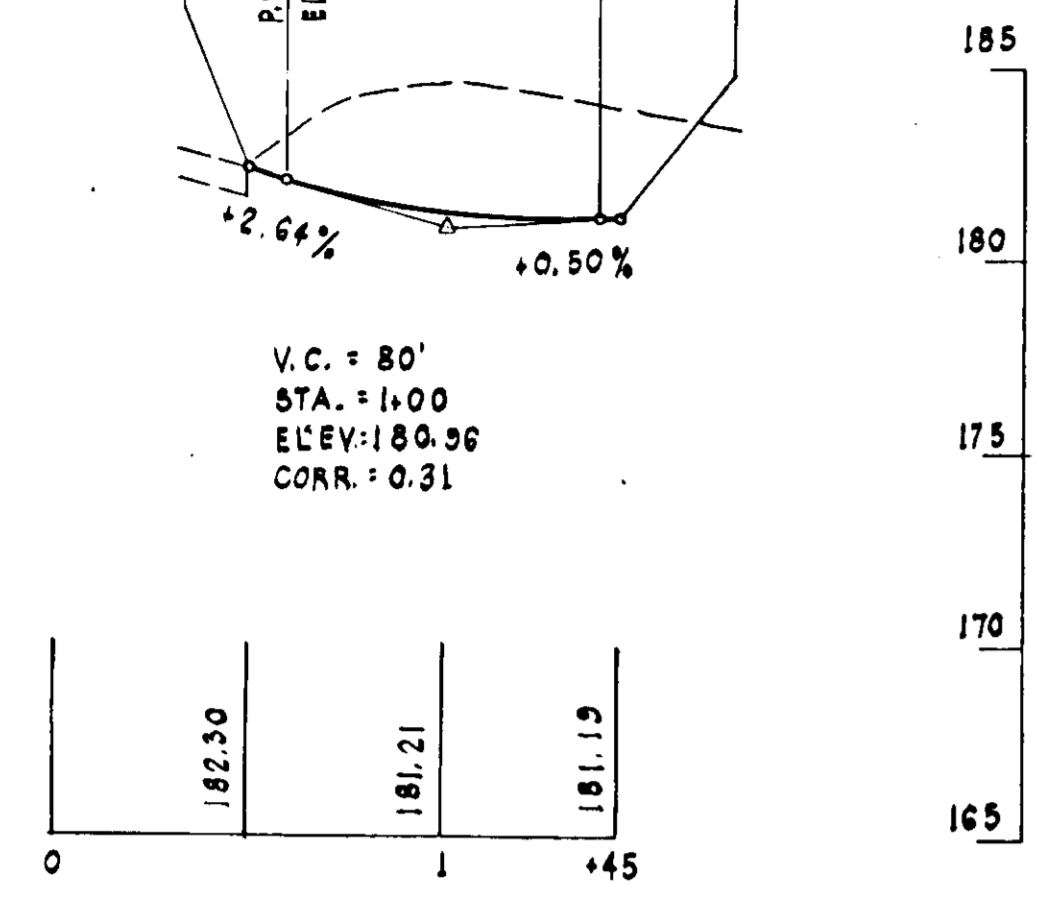


CONSTRUCTION NO. 9


CONSTRUCTION NO. 10

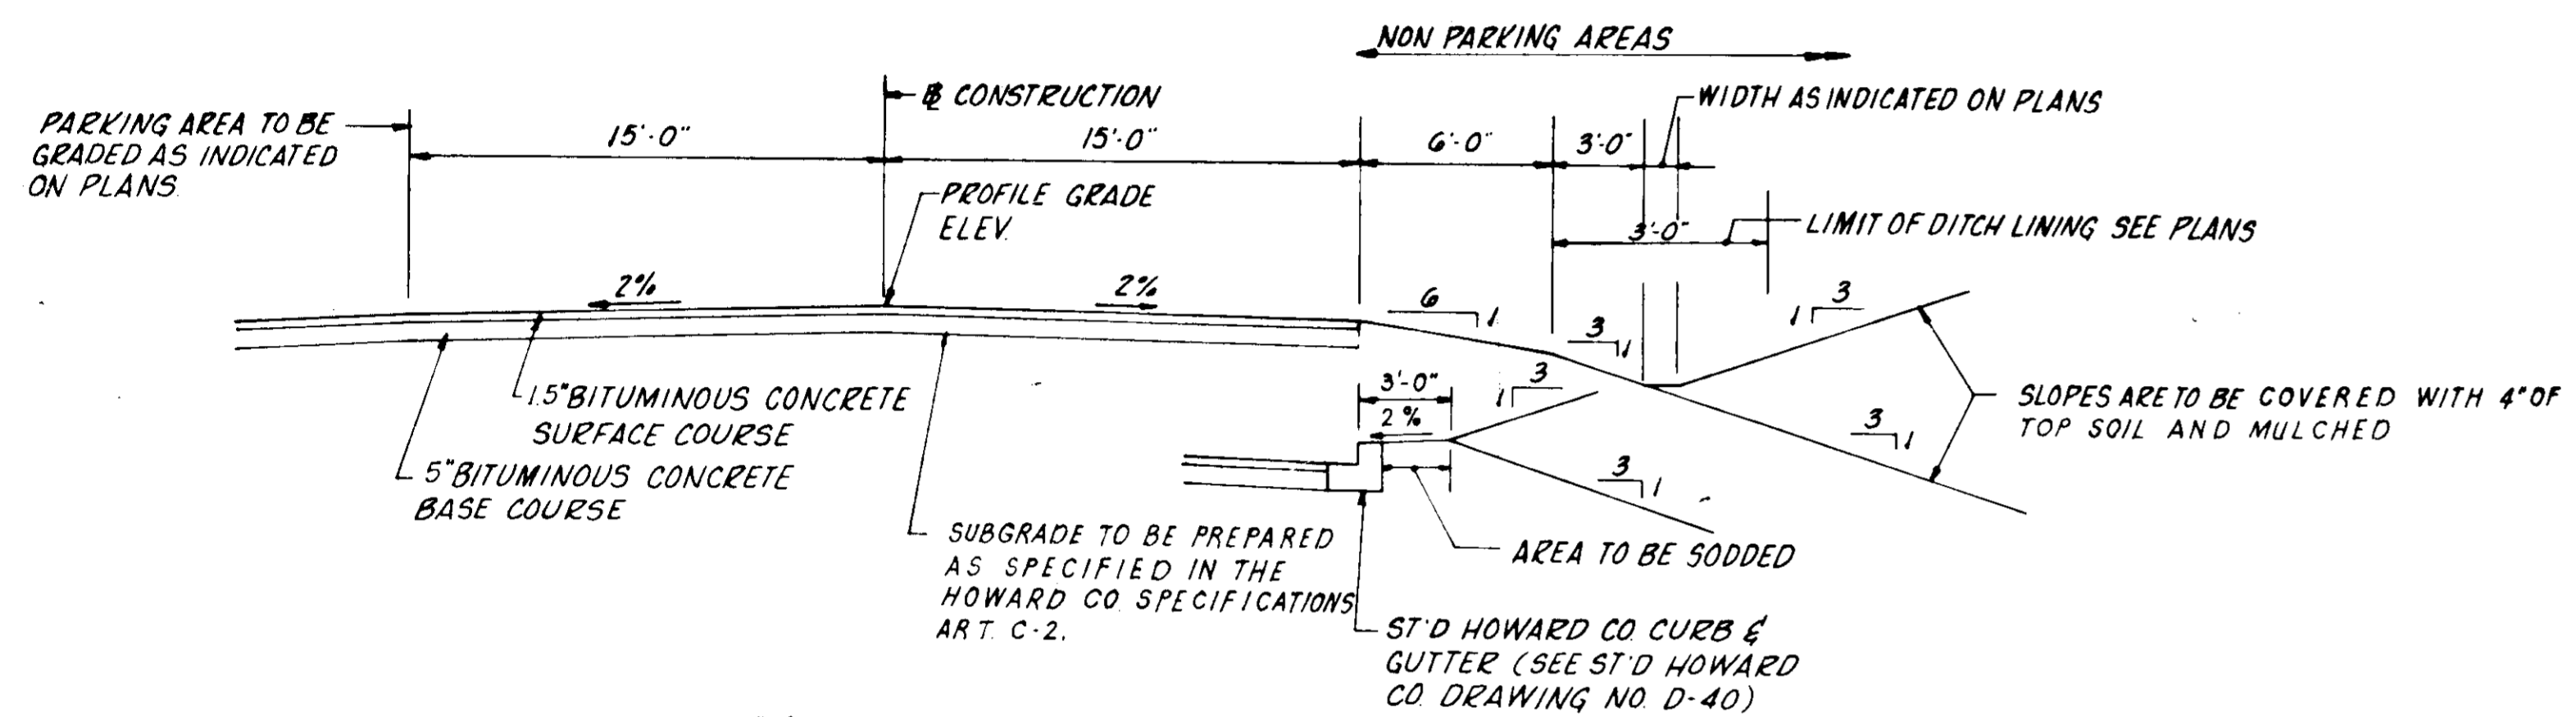


TYPICAL SECTION OF CONSTRUCTION NO. 3, 4, 5 & 6
SCALE 1" = 5'

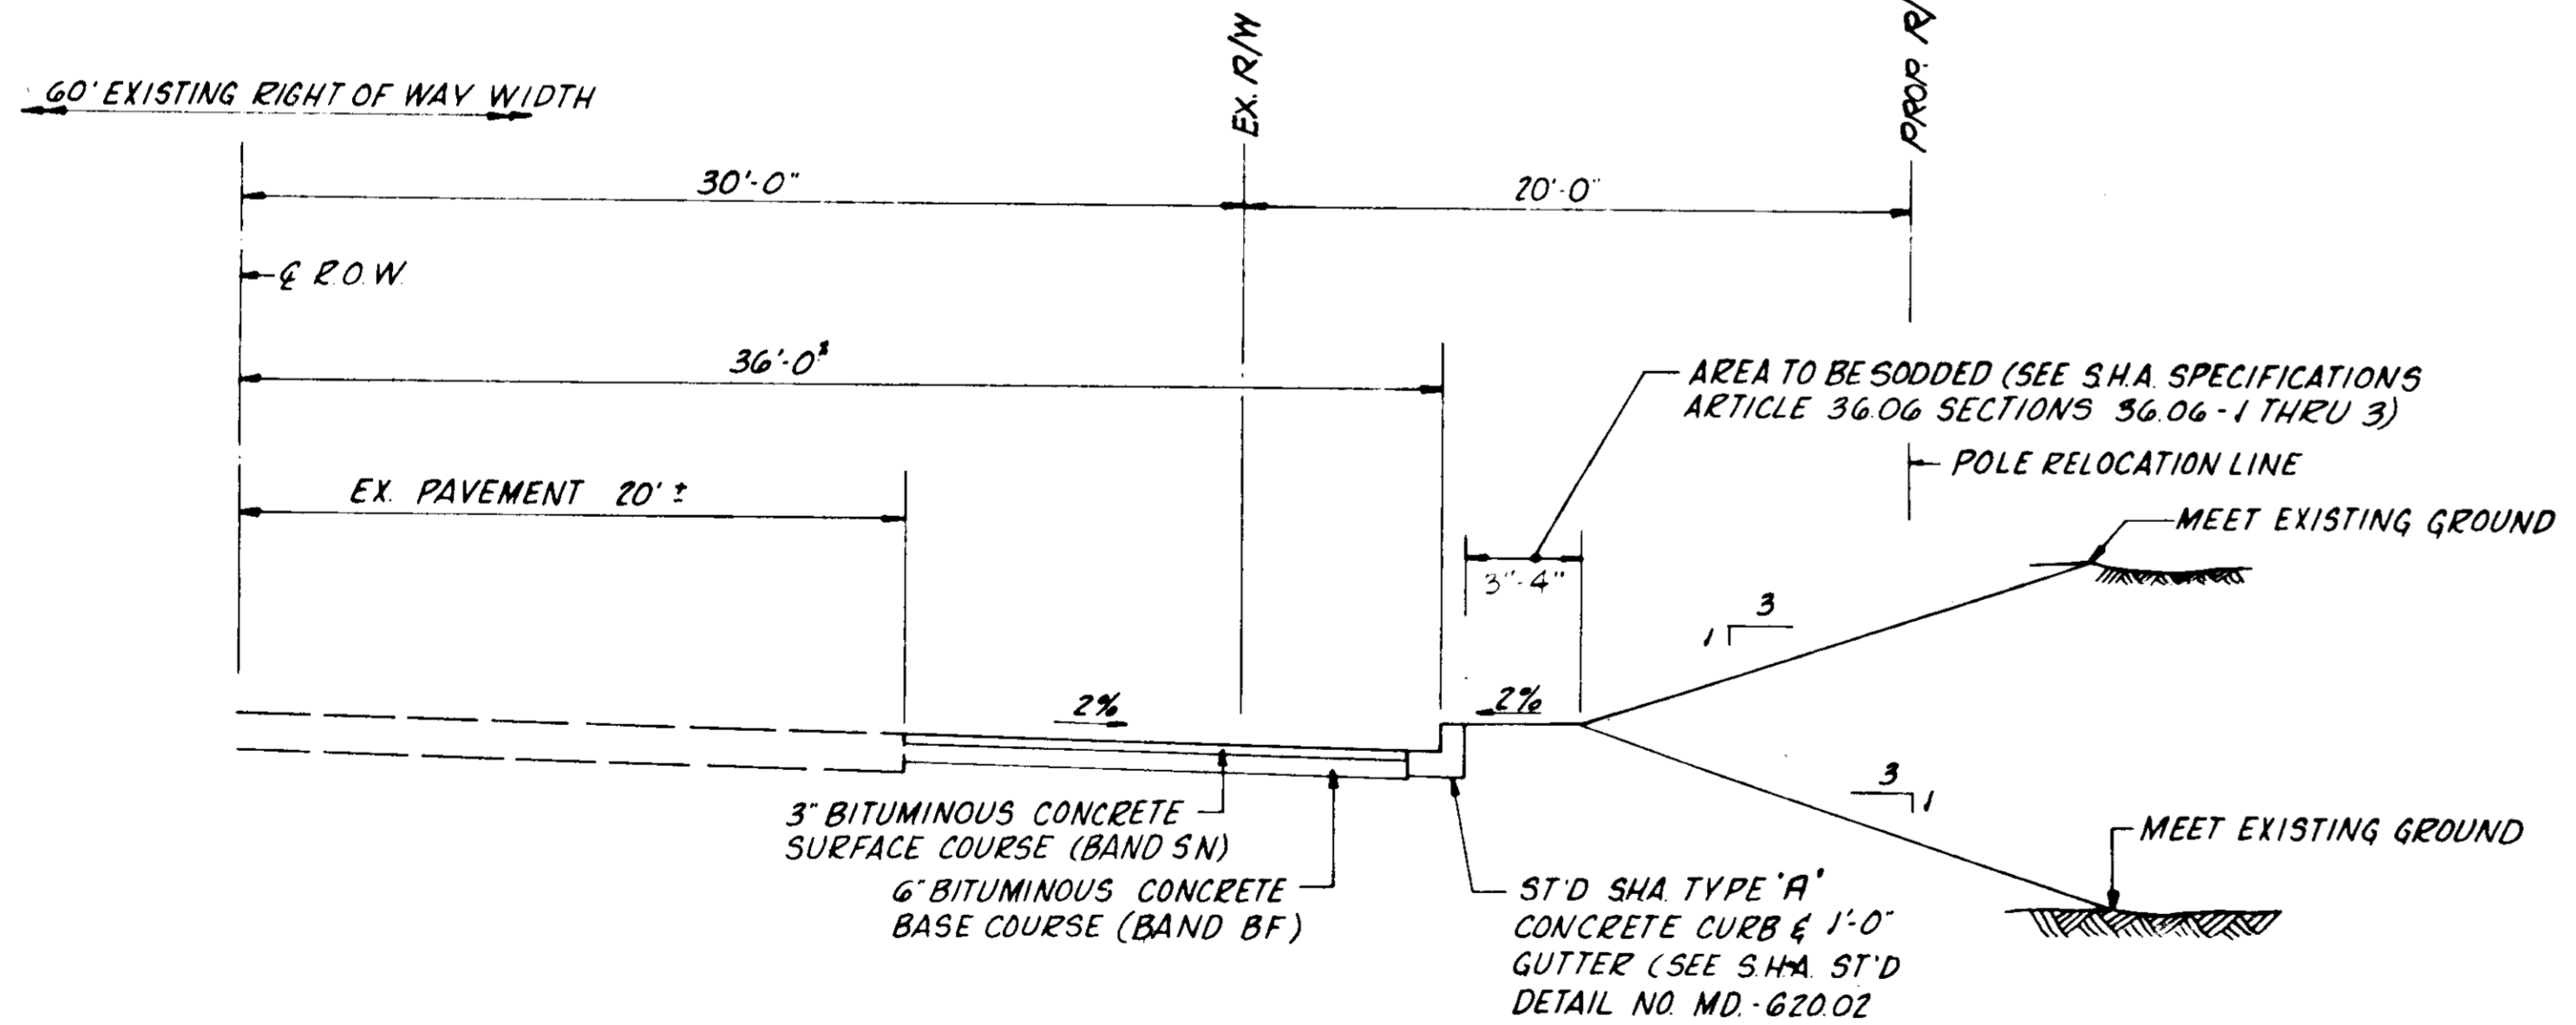

TYPICAL SECTION ALONG US RTE ONE
SCALE 1" = 5'

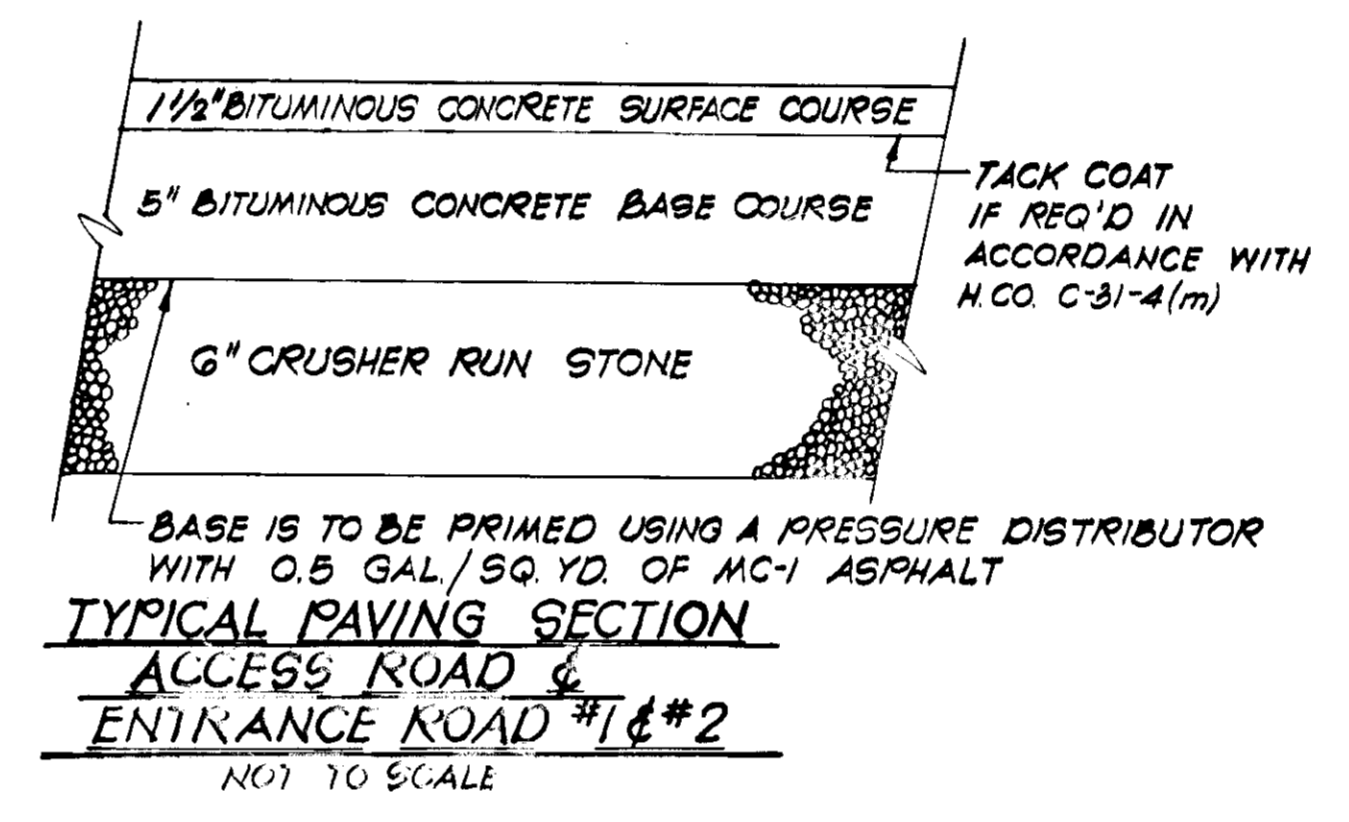

TYPICAL PAVING SECTION ACCESS ROAD & ENTRANCE ROAD #1 & #2
NOT TO SCALE

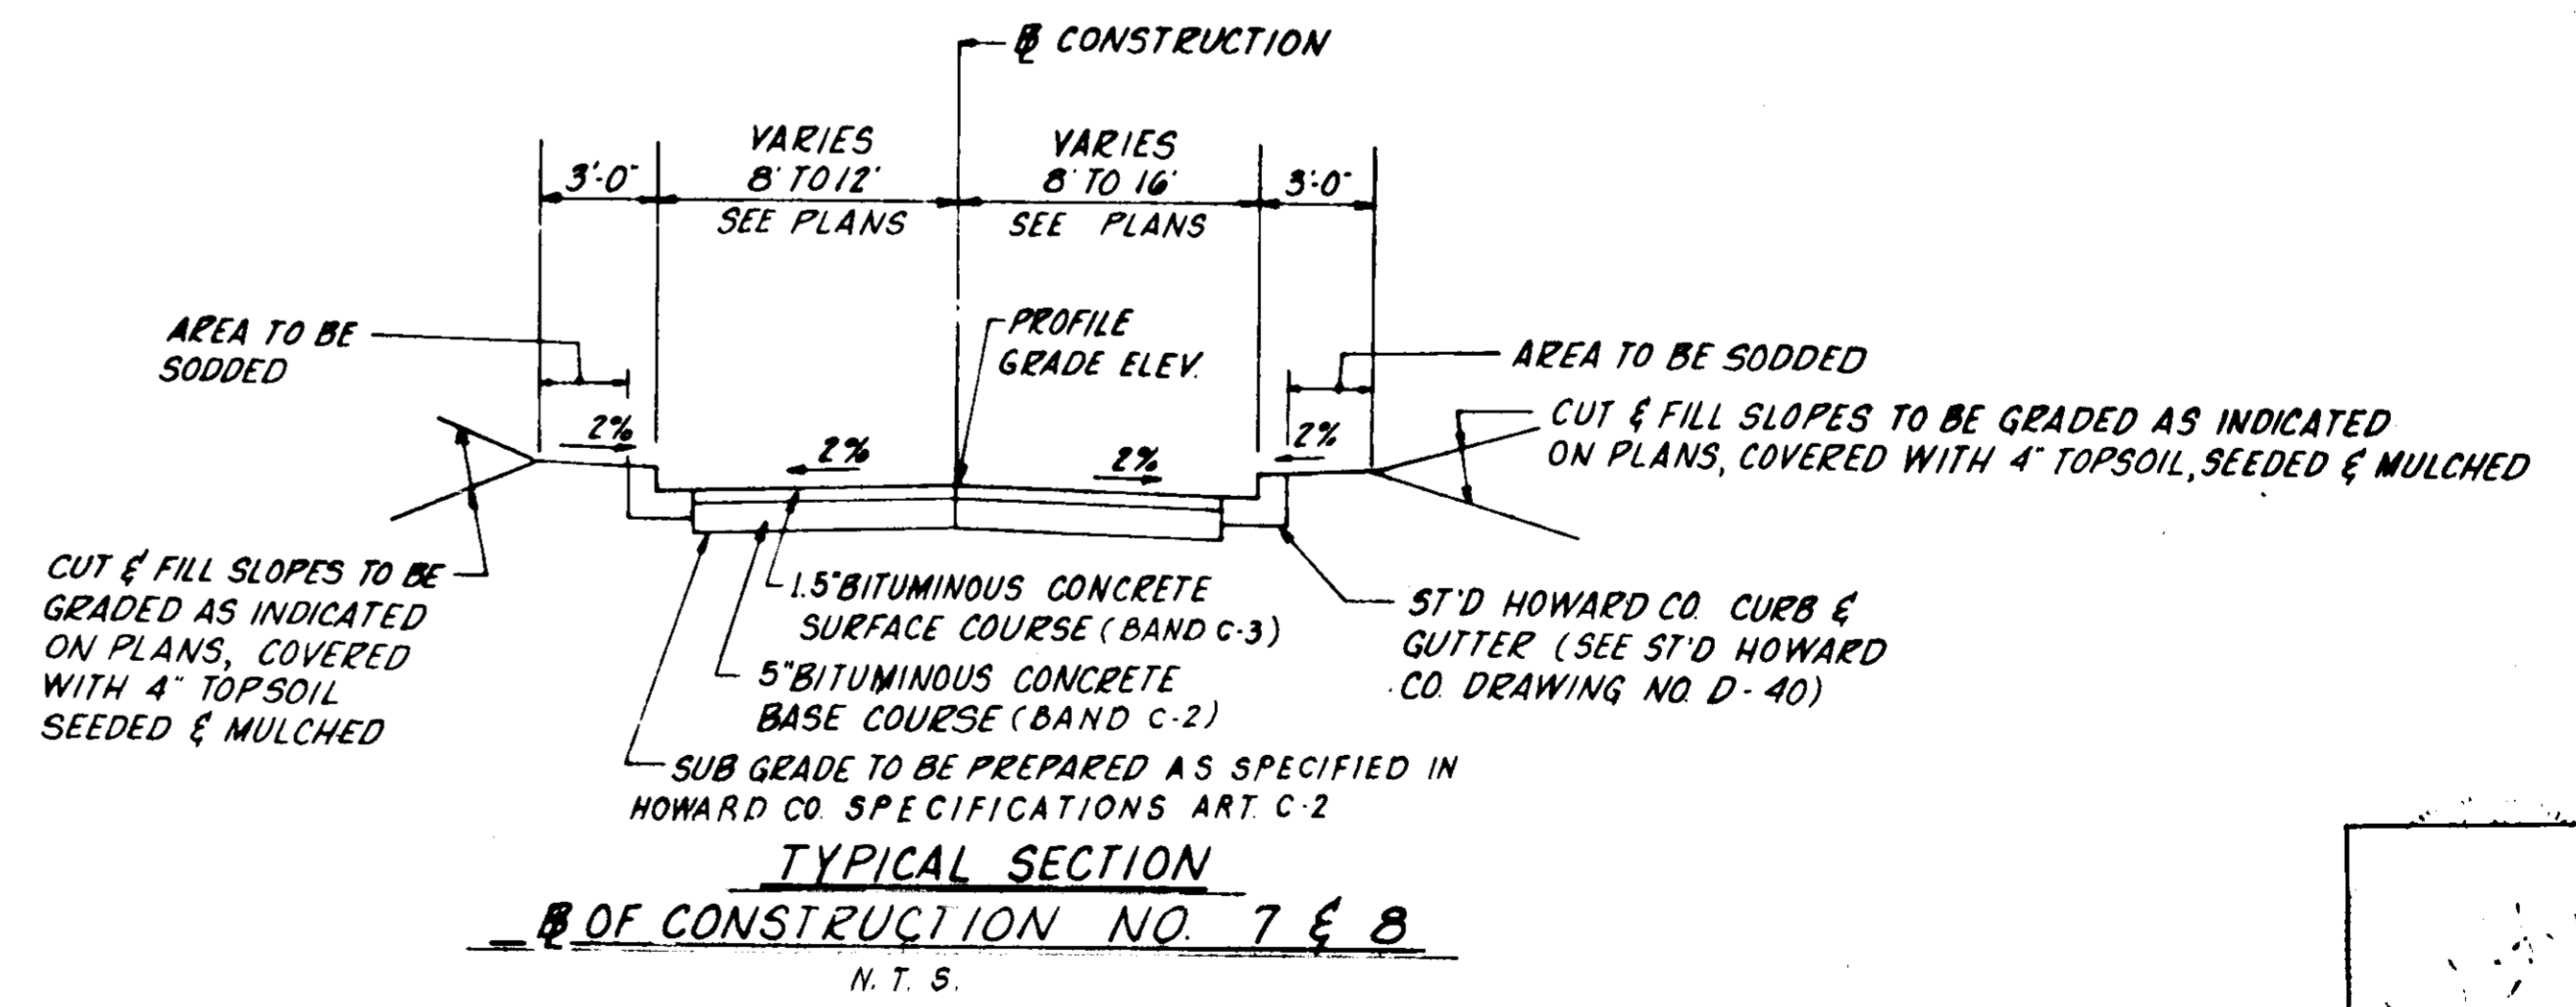

TYPICAL SECTION OF CONSTRUCTION NO. 7 & 8
N.T.S.

- NOTES:
- GRADED SLOPE AREAS ARE TO HAVE 4" OF TOP SOIL, SEEDED & MULCHED (SEE SHA ST'D SPECIFICATIONS ARTICLE 36.05 SECTIONS 36.05-1 THRU 3.)
 - EXISTING UTILITY POLES ARE TO BE RELOCATED ALONG PROPOSED DEDICATION LINE

APPROVED: FOR PUBLIC WATER AND PUBLIC SEWERAGE SYSTEMS, HOWARD COUNTY HEALTH DEPARTMENT
[Signature] 10/8/74
COUNTY HEALTH OFFICER DATE

APPROVED: HOWARD COUNTY OFFICE OF PLANNING AND ZONING
[Signature] 10-8-74
PLANNING DIRECTOR DATE
[Signature] 10/8/74
CHIEF, DIVISION OF LAND DEVELOPMENT AND TRANSPORTATION PLANNING DATE

APPROVED: FOR PUBLIC WATER, PUBLIC SEWERAGE AND STORM DRAINAGE SYSTEMS AND ROADS
HOWARD COUNTY DEPARTMENT OF PUBLIC WORKS
[Signature] 10/4/74
DIRECTOR DATE
[Signature] 10/4/74
CHIEF, BUREAU OF HIGHWAYS DATE





Reviewed for: Howard S. C. D. NAME
and meets Technical Requirements
[Signature] Date 9-30-74
Signature
S. Soil Conservation Service

THIS DEVELOPMENT PLAN IS APPROVED FOR SOIL EROSION AND SEDIMENT CONTROL BY THE HOWARD SOIL CONSERVATION DISTRICT
Approved: *[Signature]* Date 9-30-74
Howard S. C.

By the Developer:
"I certify that all development and/or construction will be done according to this plan of development and plan for Erosion and Sediment Control, and I also authorize periodic on-site inspection by the Howard Soil Conservation District or their authorized agents, as are deemed necessary. Deviation from this plan will not be made unless authorized by the Howard Soil Conservation District."
[Signature] 9-11-74
Date

By the Engineer:
"I certify that this plan for Erosion and Sediment Control represents a practical and workable plan based on my personal knowledge of the site conditions and that it was prepared in accordance with the requirements of the Howard Soil Conservation District."
[Signature] Date

ISSUED FOR BIDDING		DATE	BY
ADDENDA REVISIONS			
ADDENDA NO.	ADDENDA DATE	BY	
ISSUED FOR CONSTRUCTION			
DATE			
REVISIONS			
NO.	DESCRIPTION	DATE	BY
1	REVISED IN ACCORDANCE WITH HOWARD COUNTY COMMENTS	7/15/74	MW
2	REVISED IN ACCORDANCE WITH HOWARD COUNTY COMMENTS	9/13/74	MW
AS BUILT DRAWINGS			
DATE			
BY			
AMERICAN INSTRUMENT CO. DIVISION OF TRAVENOL LABORATORIES INC. HOWARD COUNTY MD. ELECTION DISTRICT NO. 6 TAX MAP 47, PARCEL NO. 145			
SECTION SYMBOL			
DRAWN F.W.G. DATE 4-12-74 CHECKED L.C.P. JOB No. 736640			
PROFILES & SECTIONS			
ADDITION & ALTERATIONS PLANT & OFFICE BUILDING AMINCO SAVAGE MARYLAND			
SHEET 7 OF 16			

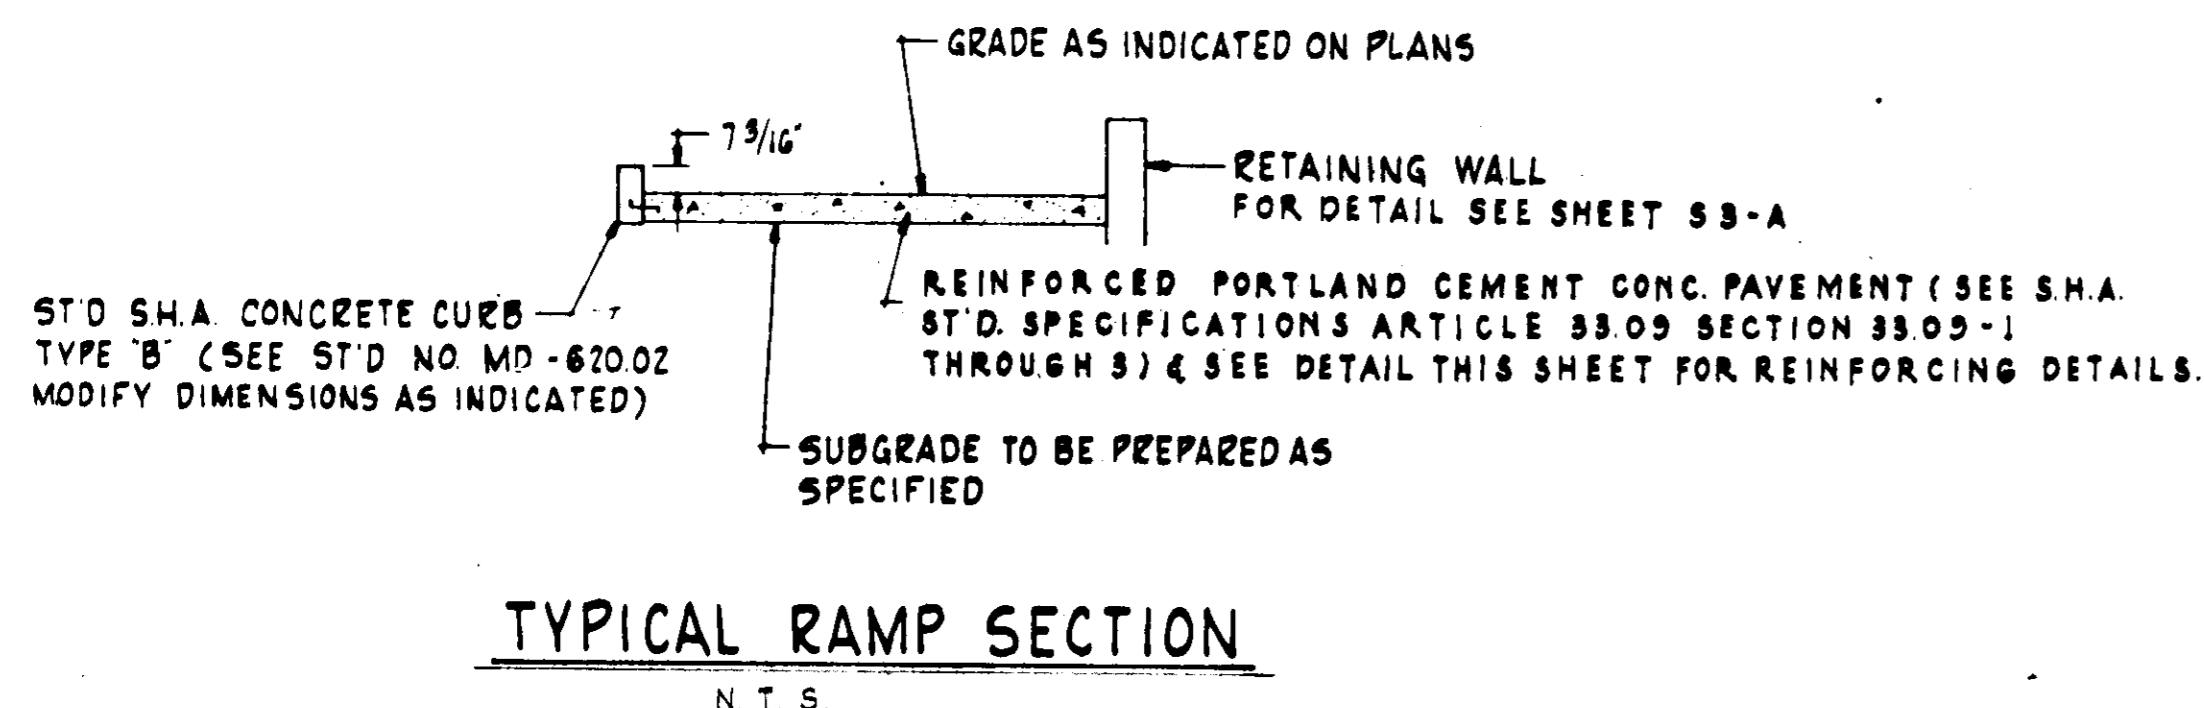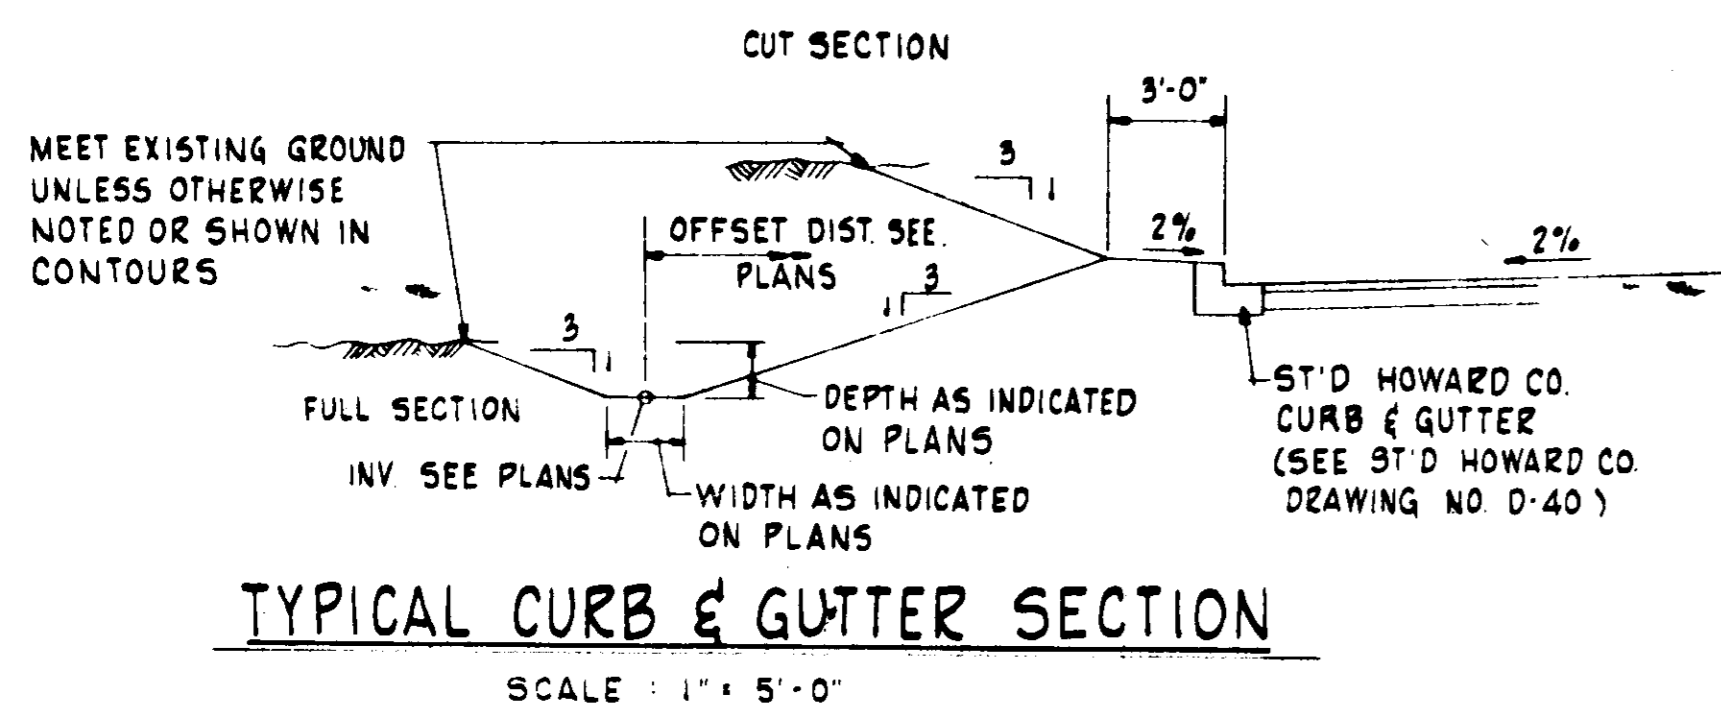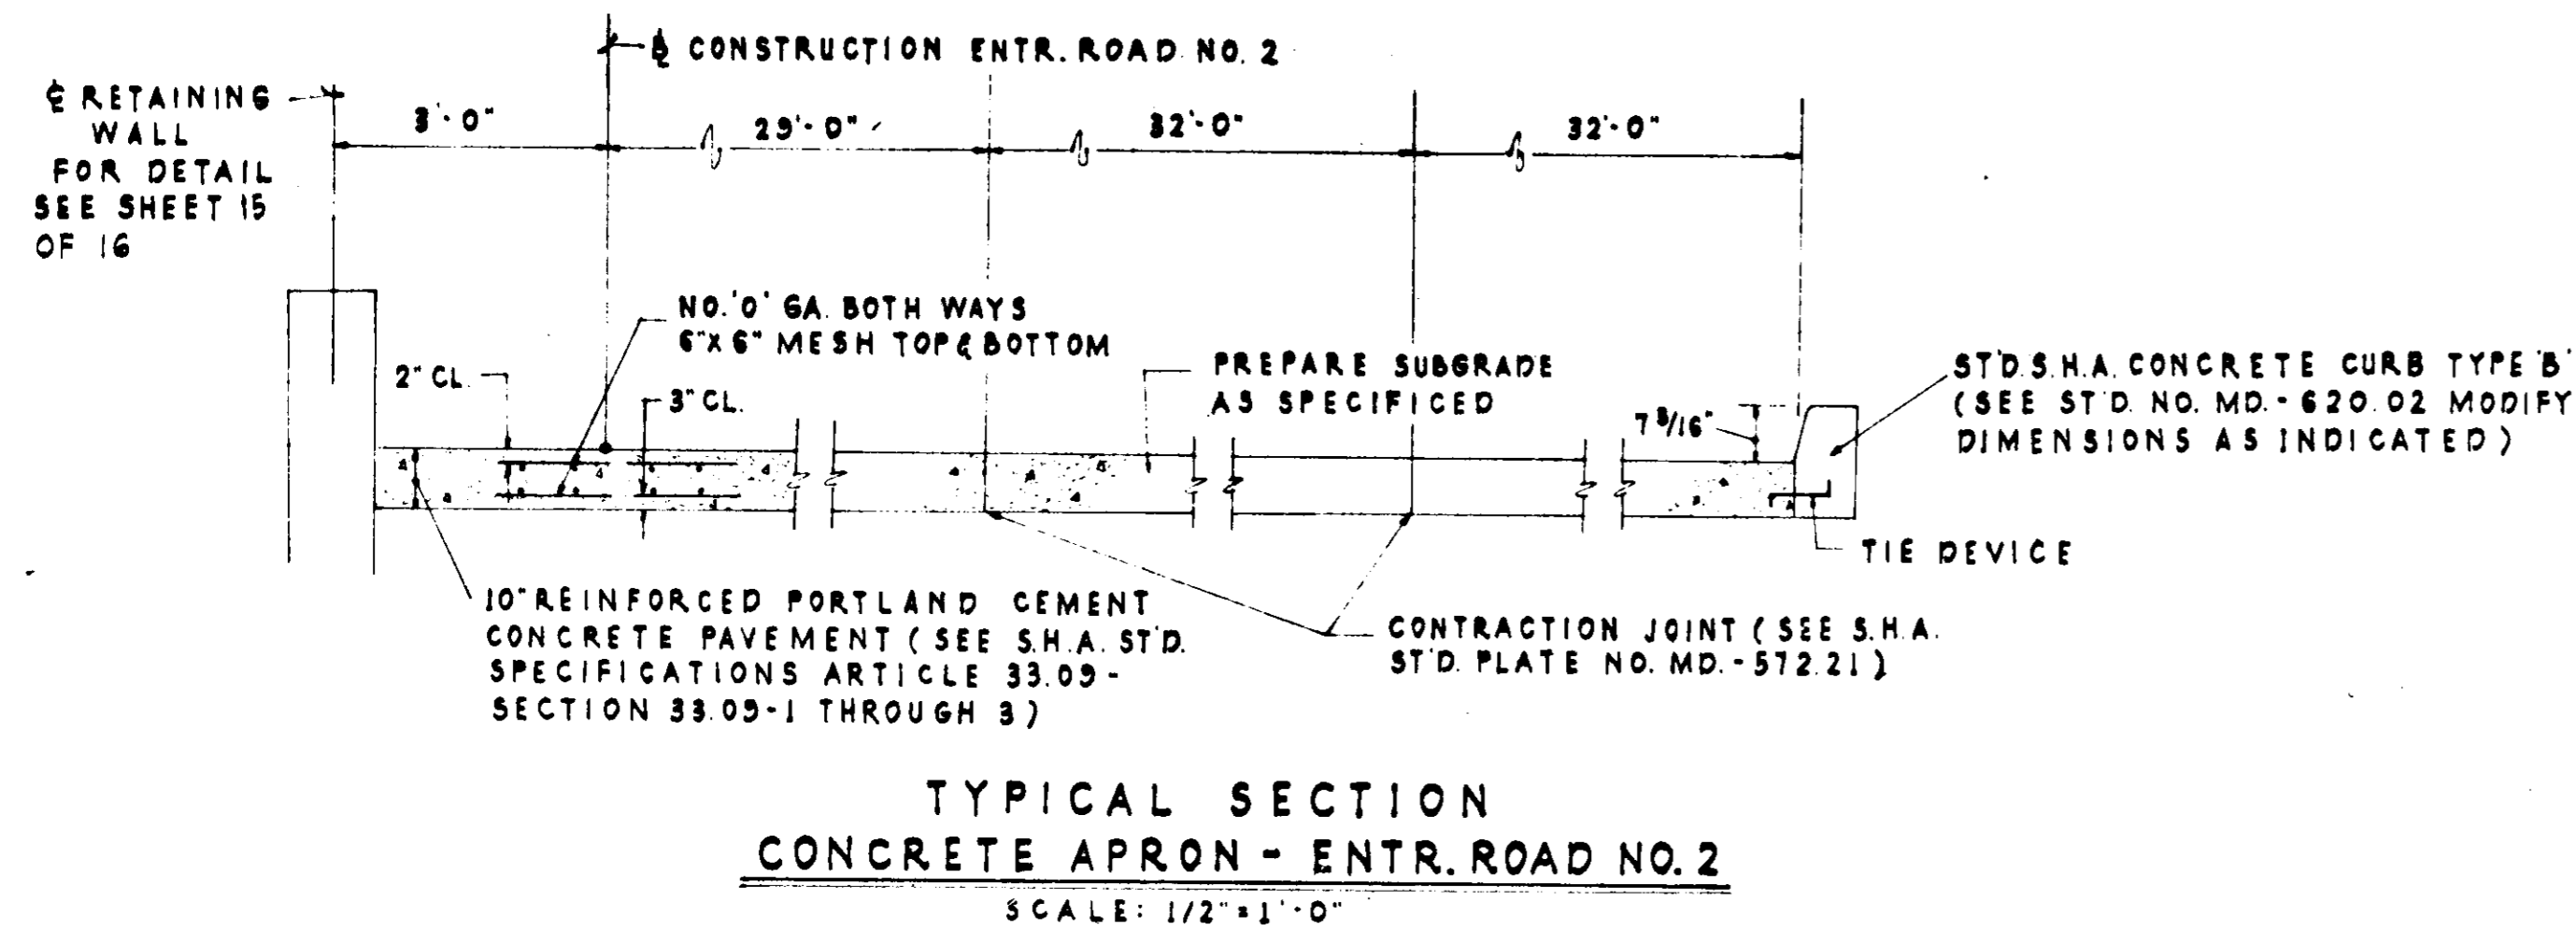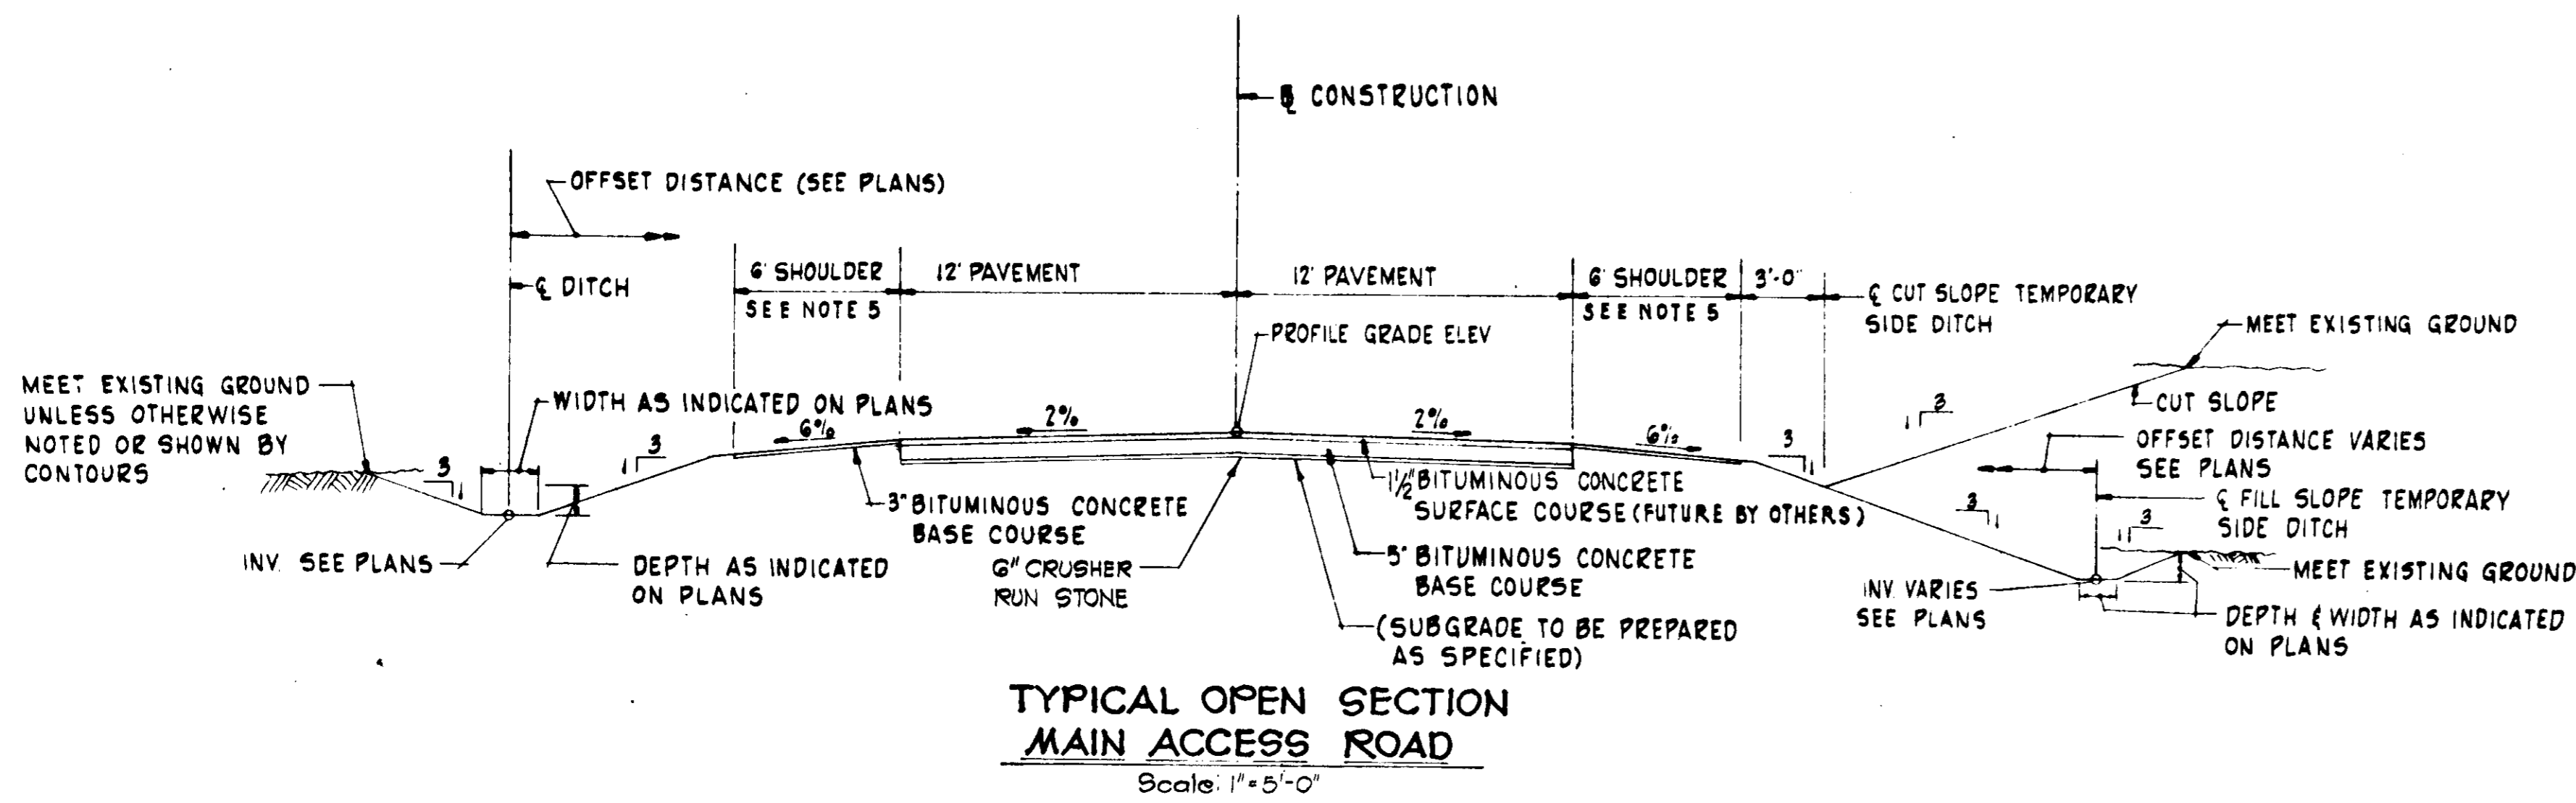

1. SITE PREPARATION

Areas under the embankment and any structural works shall be cleared, grubbed and the topsoil stripped to remove all trees, vegetation, roots or other objectionable material. In order to facilitate clean out and restoration, the permanent pool area shall be cleared of all brush and trees.

2. EARTH FILL

a. **Material**- The fill material shall be taken from approved designated borrow area or areas. It shall be free from roots, stumps, wood, rubbish, oversize stones, frozen or other objectionable materials. The embankment shall be constructed to an elevation which provides for anticipated settlement to the design elevation. The fill height all along the length of the embankment shall be increased 1'-0" as shown on the plans.

b. **Placement**- Areas on which fill is to be placed shall be scarified prior to placement of fill. Fill materials shall be placed in 8" maximum thickness (before compaction) layers which are to be continuous over the entire length of the fill. The most porous borrow material shall be placed in the downstream portions of the embankment.

c. **Compaction**- The movement of the hauling and spreading equipment over the fill shall be controlled so that the entire surface of each lift shall be traversed by not less than one tread track of the equipment or compaction shall be achieved by a minimum of four complete passes of a sheepfoot, rubber tired or vibratory roller. Fill material shall contain sufficient moisture so that it can be formed into a ball without crumbling. If water can be squeezed out of the ball, it is too wet to compact properly.

3. STRUCTURAL BACKFILL

Backfill material shall be of the type and quality conforming to that specified for the adjoining fill material. The fill shall be placed in horizontal layers not to exceed four (4) inches in thickness and compacted by hand tampers or other compaction equipment. At no time during the backfilling operation shall driven equipment be allowed to operate closer than four (4) feet, measured horizontally, to any part of a structure. Under no circumstances shall the contractor drive equipment over any part of a concrete structure or pipe unless there is a compacted fill of twenty-four (24) inches or greater over the structure or pipe.

4. PIPE CONDUITS

a. CORRUGATED METAL PIPE

1. **Materials**- (Steel Pipe)- This pipe and its appurtenances shall be galvanized and fully bituminous coated and shall conform to the requirements of AASHTO Specification M-190 Type A with watertight coupling bands. Any bituminous coating damaged or otherwise removed shall be replaced with cold applied bituminous coating compound.
2. **Connections**- All connections with pipes must be completely watertight. The drain pipe or barrel connection to the riser shall be welded all around. Watertight coupling bands shall be used at all joints. Anti-seep collars shall be connected to the pipe in a manner as to be completely watertight by a continuous watertight weld.
3. **Bedding**- The pipe shall be firmly and uniformly bedded throughout its entire length. Where rock or soft, spongy or other unstable soil is encountered, all such material shall be removed and replaced with suitable earth compacted to provide adequate support.
4. **Laying pipe**- The pipe shall be placed with inside circumferential laps pointing downstream and with the longitudinal laps at the sides.
5. **Backfilling** shall conform to structural backfill as shown above.
6. **Other details**- (anti-seep collars, valves, etc.) shall be as shown on the drawings.

b. REINFORCED CONCRETE PIPE

1. **Materials**- Reinforced concrete pipe shall have a rubber gasket joint and shall equal or exceed ASTM Specification C-361.
2. **Laying pipe**- Bell and spigot pipe shall be placed with the bell end upstream. Joints shall be made in accordance with recommendations of the manufacturer of the material. After the joints are sealed on the entire line, the bedding shall be placed so that all spaces under the pipe are filled. Care shall be exercised to prevent any deviation from the original line and grade of the pipe.
3. **Backfilling** shall conform to structural backfill as shown above.

APPROVED: FOR PUBLIC WATER AND PUBLIC SEWERAGE SYSTEMS, HOWARD COUNTY HEALTH DEPARTMENT
[Signature] 12/1/74
 COUNTY HEALTH OFFICER DATE

APPROVED: HOWARD COUNTY OFFICE OF PLANNING AND ZONING
[Signature] 10-8-74
 PLANNING DIRECTOR DATE
[Signature] 10/8/74
 CHIEF, DIVISION OF LAND DEVELOPMENT AND TRANSPORTATION PLANNING DATE

APPROVED: FOR PUBLIC WATER, PUBLIC SEWERAGE AND STORM DRAINAGE SYSTEMS AND ROADS HOWARD COUNTY DEPARTMENT OF PUBLIC WORKS
[Signature] 10/4/74
 DIRECTOR DATE
[Signature] 10/4/74
 CHIEF, BUREAU OF HIGHWAYS DATE

Reviewed for: Howard S. C. D. NAME

and meets Technical Requirements

[Signature] Date: 9-30-74
 Signature
 U. S. Soil Conservation Service

THIS DEVELOPMENT PLAN IS APPROVED FOR SOIL EROSION AND SEDIMENT CONTROL BY THE HOWARD SOIL CONSERVATION DISTRICT

Approved: *[Signature]* Date 9-30-74
 Howard S. C. D.

By the Developer:

"I certify that all development and/or construction will be done according to this plan of development and plan for Erosion and Sediment Control, and I also authorize periodic on-site inspection by the Howard Soil Conservation District or their authorized agents, as are deemed necessary." Deviation from this plan will not be made unless authorized by the Howard Soil Conservation District.

[Signature] Date: 9-17-74
 Signature of Developer Date

By the Engineer:

"I certify that this plan for Erosion and Sediment Control represents a practical and workable plan based on my personal knowledge of the site conditions and that it was prepared in accordance with the requirements of the Howard Soil Conservation District."

[Signature] Date: 9-30-74
 Signature of Engineer Date

STORM WATER RETENTION BASIN AND SITE CONSTRUCTION SPECIFICATIONS

ISSUED FOR BIDDING	DATE	BY
ADDENDA REVISIONS		
ADDITIONAL REVISIONS		
ISSUED FOR CONSTRUCTION	DATE	BY

REVISIONS			
NO.	DESCRIPTION	DATE	BY
1	SEDIMENT CONTROL DATA REVISED	5/13/74	W.B.
2	REVISED IN ACCORDANCE WITH HOWARD COUNTY COMMENTS	7/15/74	M.W.
3	REVISED IN ACCORDANCE WITH HOWARD COUNTY COMMENTS	9/2/74	M.J.W.
4	REVISED IN ACCORDANCE WITH HOWARD COUNTY COMMENTS	9/13/74	M.W.

APPROVED
[Signature] 9/17/74
 J. H. Dawson

AS BUILT DRAWINGS
 DATE BY

AMERICAN INSTRUMENT CO.
 DIVISION OF
 TRAVENOL LABORATORIES INC.
 HOWARD COUNTY MD.
 ELECTION DISTRICT NO. 6
 TAX MAP 47, PARCEL NO. 145

SECTION SYMBOL


DRAWN F.W.G. DATE 4-12-74
 CHECKED L.C.P. JOB No. 736640

SECTIONS
 ADDITION & ALTERATIONS
 PLANT & OFFICE BUILDING
 AMINCO
 SAVAGE MARYLAND

SHEET 8 OF 16


CONTRACTOR SHALL GRADE GROUND AROUND METER VAULT TO PERMIT ACCESS & MAINTAIN POSITIVE DRAINAGE AWAY FROM TOP HATCH.

CONTRACTOR SHALL CONNECT TO EX. 8" & 10" W OUTSIDE OF EX. VAULT USING FITTINGS OR SLEEVE SPACER

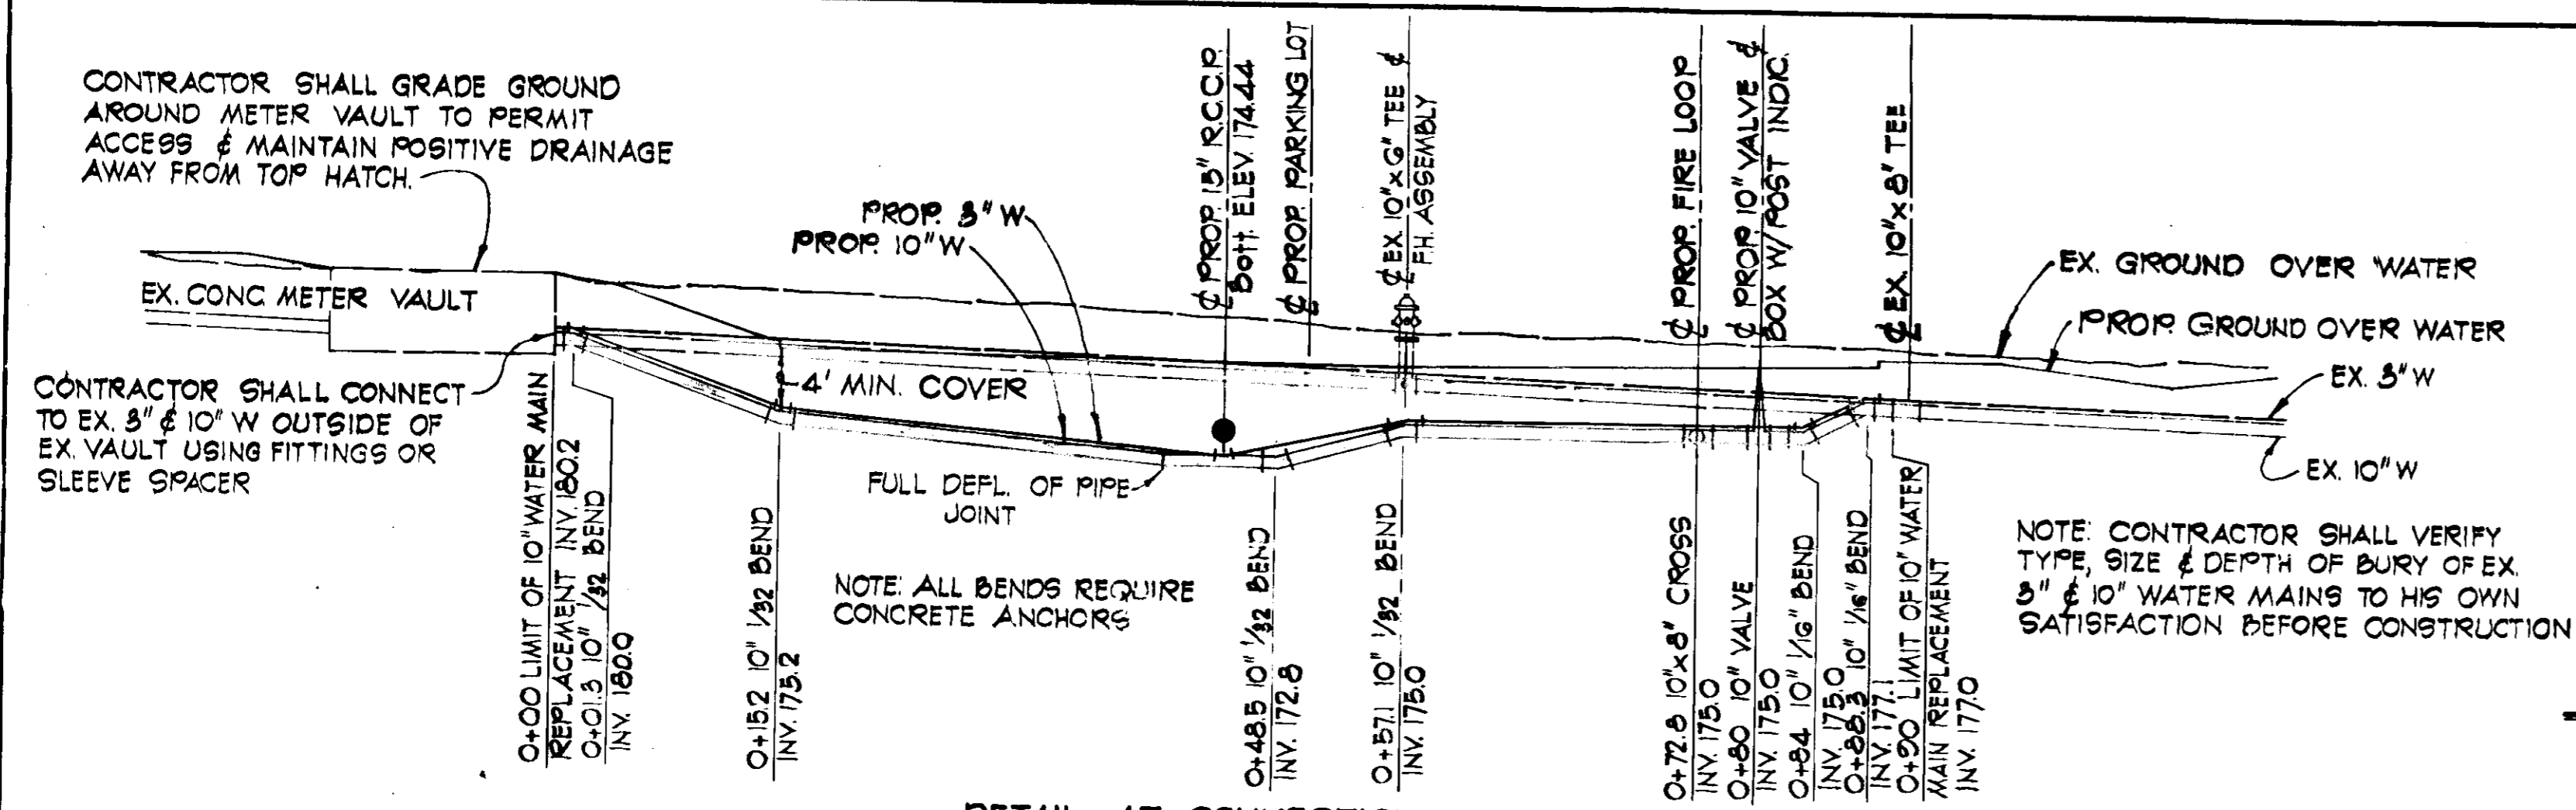


DETAIL AT CONNECTION TO EXISTING WATER

SCALE: HORIZ. 1" = 10'
VERT. 1" = 10'

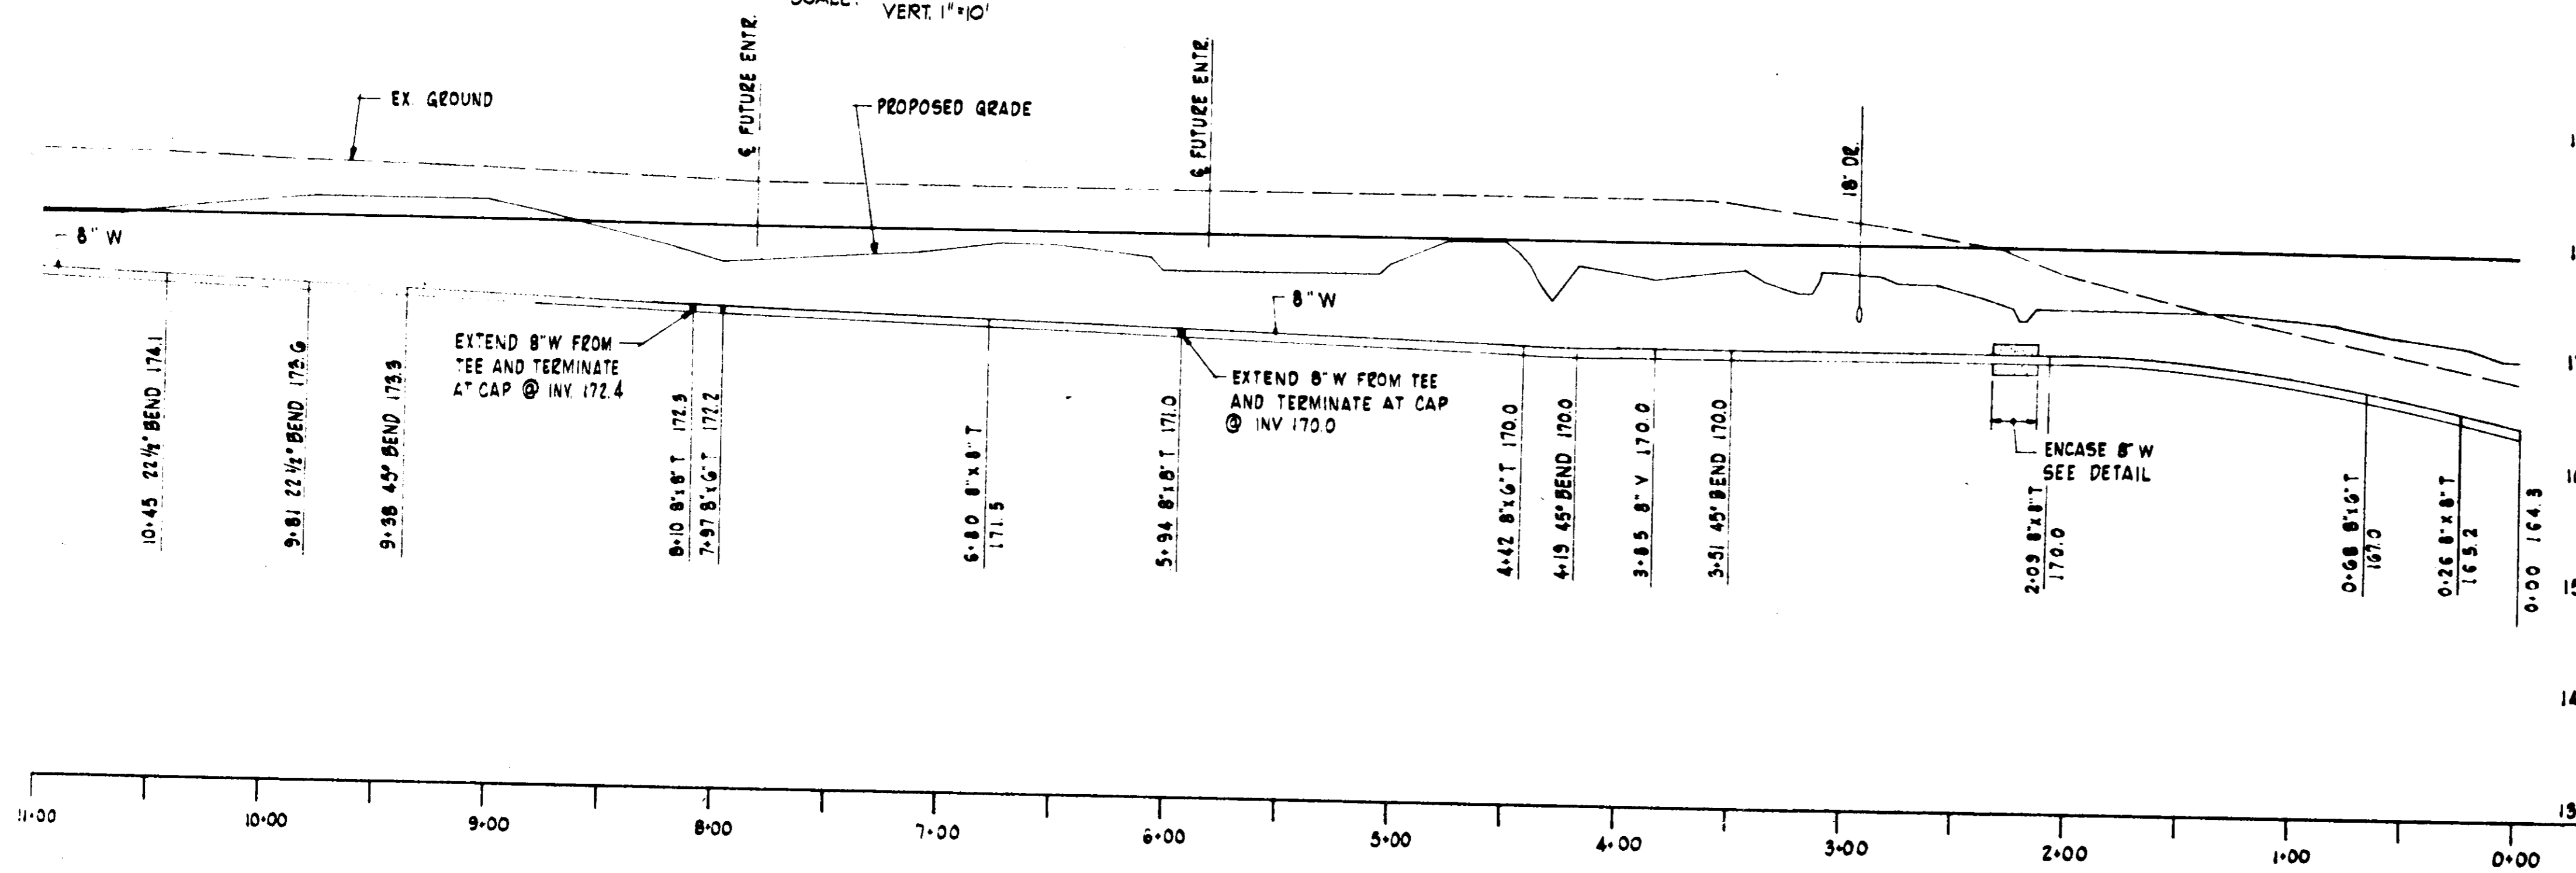

DETAIL - CONCRETE ENCASEMENT
NOT TO SCALE

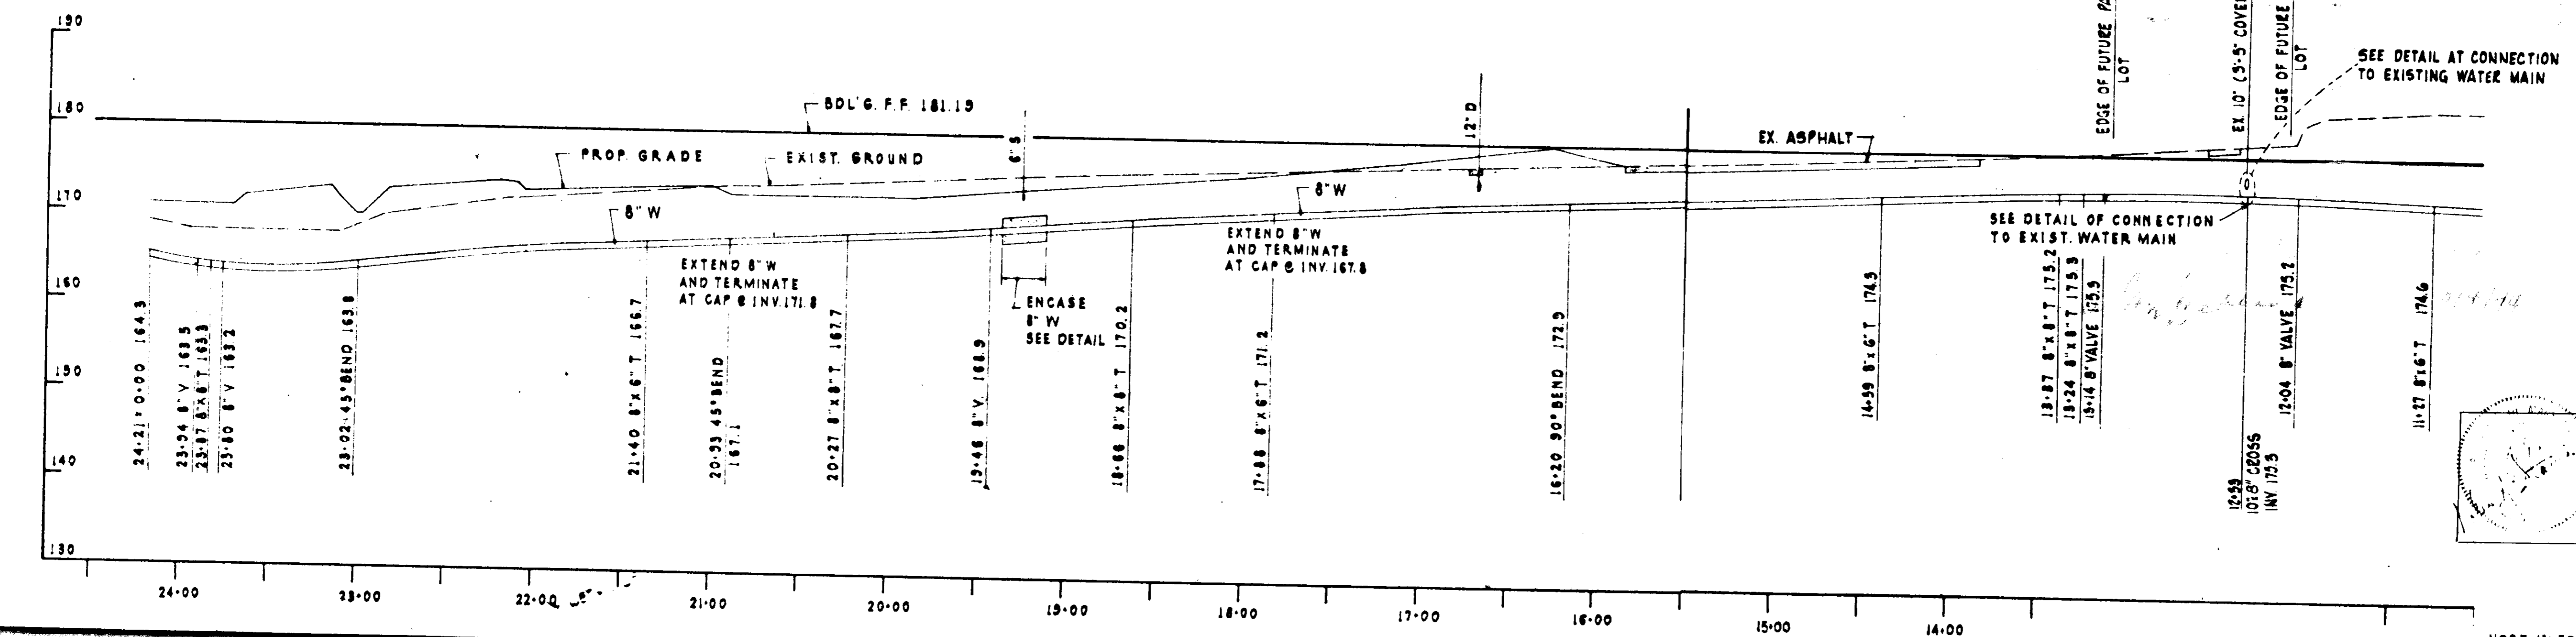

SCALE: HORIZ. 1" = 50'
VERT. 1" = 10'

APPROVED FOR PUBLIC WATER AND PUBLIC SEWERAGE SYSTEMS, HOWARD COUNTY HEALTH DEPARTMENT
[Signature]
COUNTY HEALTH OFFICER
DATE: 10/21/74

APPROVED: HOWARD COUNTY OFFICE OF PLANNING AND ZONING
[Signature]
PLANNING DIRECTOR
[Signature]
CHIEF, DIVISION OF LAND DEVELOPMENT AND TRANSPORTATION PLANNING
DATE: 10-8-74
DATE: 10/6/74

APPROVED: FOR PUBLIC WATER, PUBLIC SEWERAGE AND STORM DRAINAGE SYSTEMS AND ROADS
HOWARD COUNTY DEPARTMENT OF PUBLIC WORKS
[Signature]
DIRECTOR
[Signature]
CHIEF, BUREAU OF HIGHWAYS
DATE: 10/4/74
DATE: 10/4/74

Reviewed for: Howard - S. C. D.
NAME
and meets Technical Requirements
[Signature] Date: 9-30-74
Signature
S. Soil Conservation Service
THIS DEVELOPMENT PLAN IS APPROVED FOR SOIL EROSION AND SEDIMENT CONTROL BY THE HOWARD SOIL CONSERVATION DISTRICT
Approved: *[Signature]* Date: 9-30-74
Howard S. C. D.

By the Developer:
"I certify that all development and/or construction will be done according to this plan of development and plan for Erosion and Sediment Control, and I also authorize periodic on-site inspection by the Howard Soil Conservation District or their authorized agents, as are deemed necessary. Deviation from this plan will not be made unless authorized by the Howard Soil Conservation District."
[Signature] Date: 8-16-74
Signature of Developer

By the Engineer:
"I certify that this plan for Erosion and Sediment Control represents a practical and workable plan based on my personal knowledge of the site conditions and that it was prepared in accordance with the requirements of the Howard Soil Conservation District."
[Signature] Date: 1-1-74
Signature of Engineer


ISSUED FOR BIDDING	DATE	BY
ADDENDUM BIDDING		

ISSUED FOR CONSTRUCTION	DATE	BY

NO.	DESCRIPTION	DATE	BY
1	REVISED IN ACCORDANCE WITH HOWARD COUNTY COMMENTS	7/15/74	M.W.
2	REVISED IN ACCORDANCE WITH HOWARD COUNTY COMMENTS	9/3/74	M.W.







AS BUILT DRAWINGS
DATE:

AMERICAN INSTRUMENT CO.
DIVISION OF
TRAVENOL LABORATORIES INC.
HOWARD COUNTY, MD.
ELECTION DISTRICT NO. 6
TAX MAP 47, PARCEL NO. 145

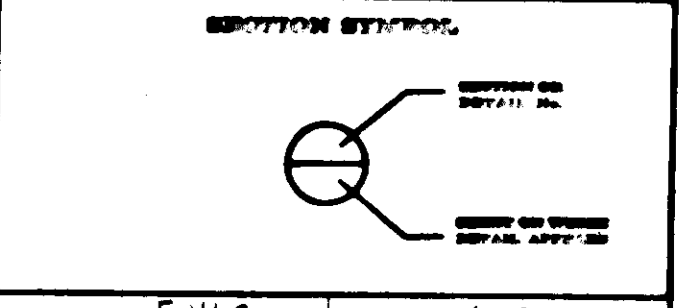

DRAWN F.W.G. DATE 4-12-74
CHECKED L.C.P. JOB No. 736640

FIRE LOOP PROFILES & DETAILS
ADDITION & ALTERATIONS
PLANT & OFFICE BUILDING
AMINCO
SAVAGE MARYLAND

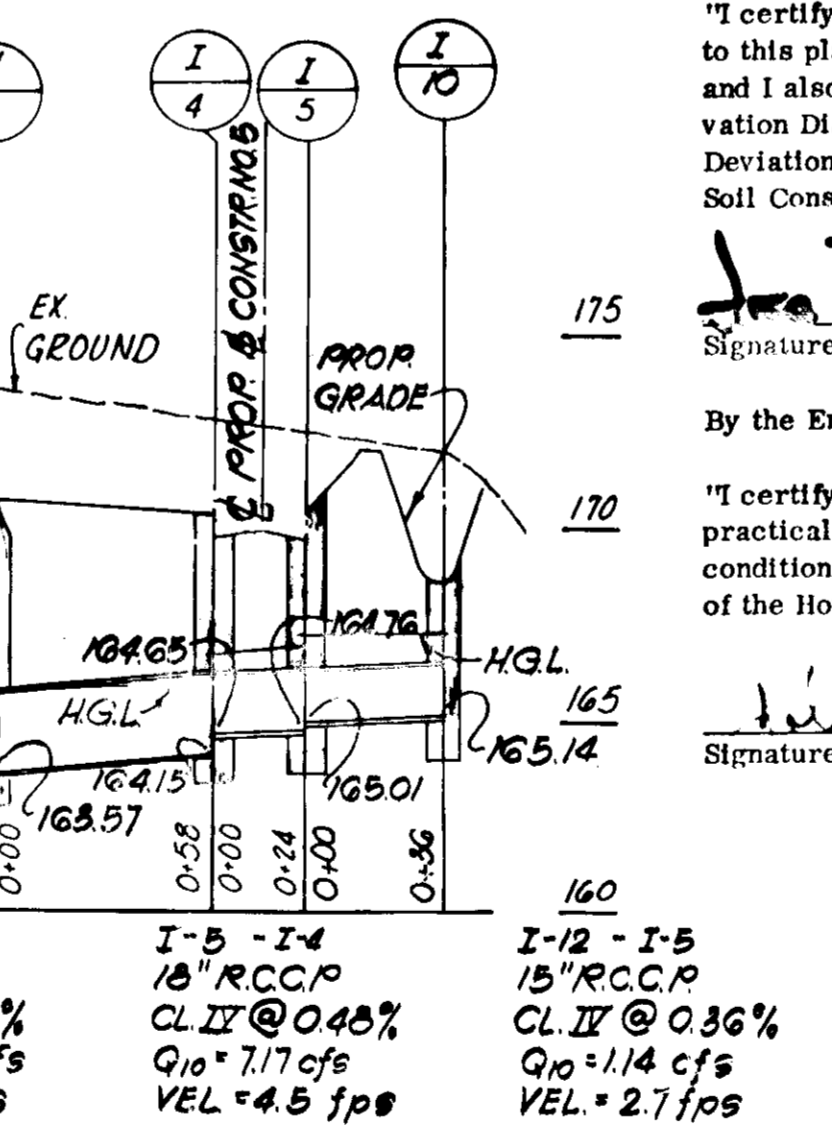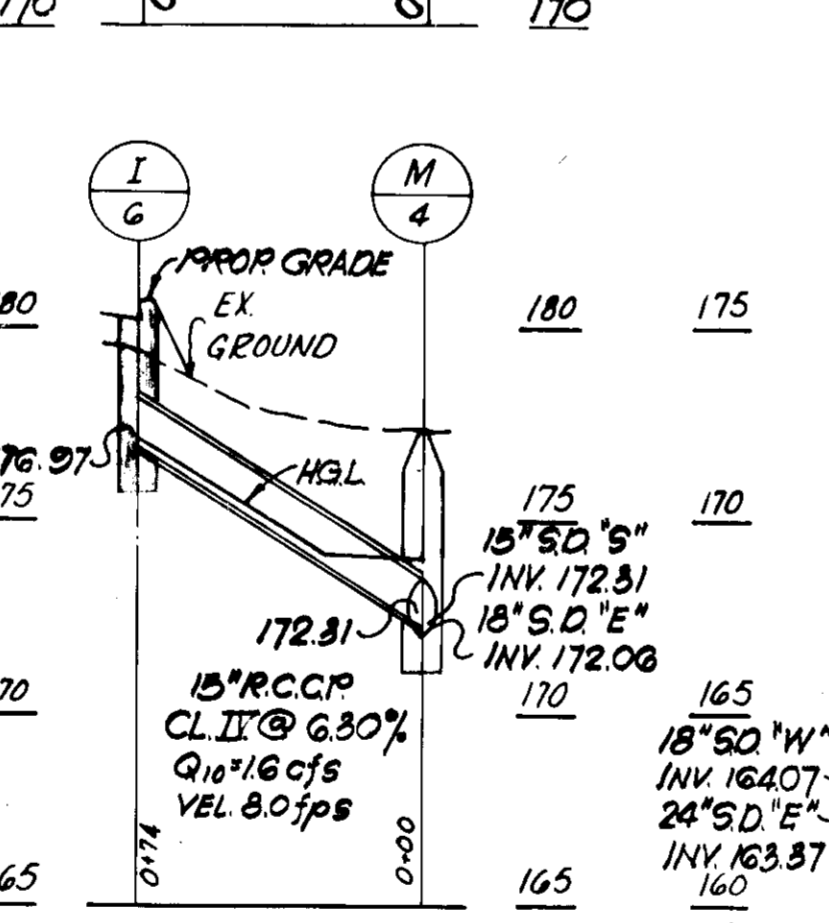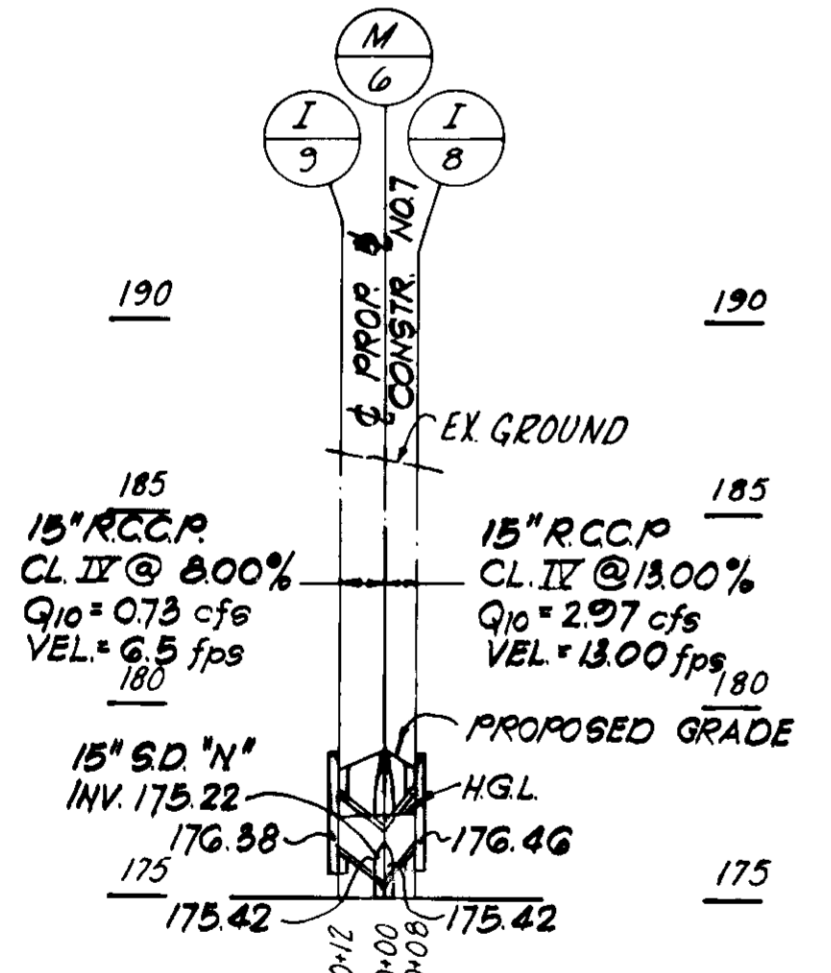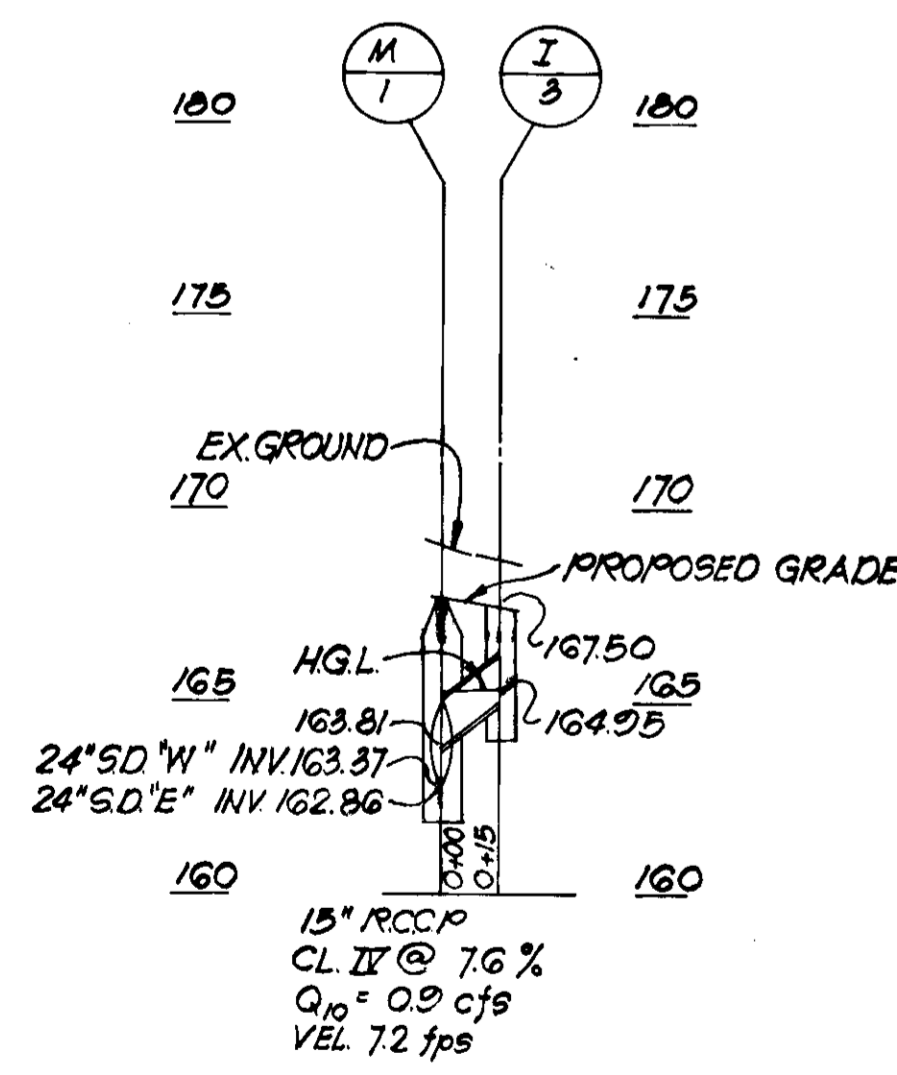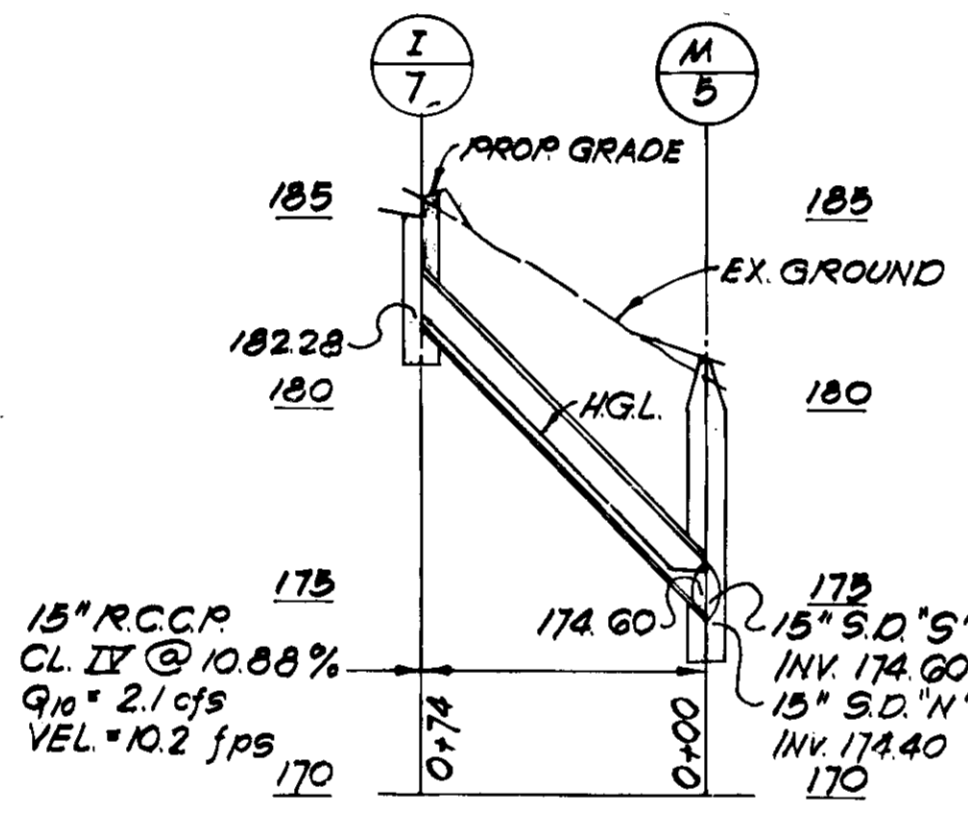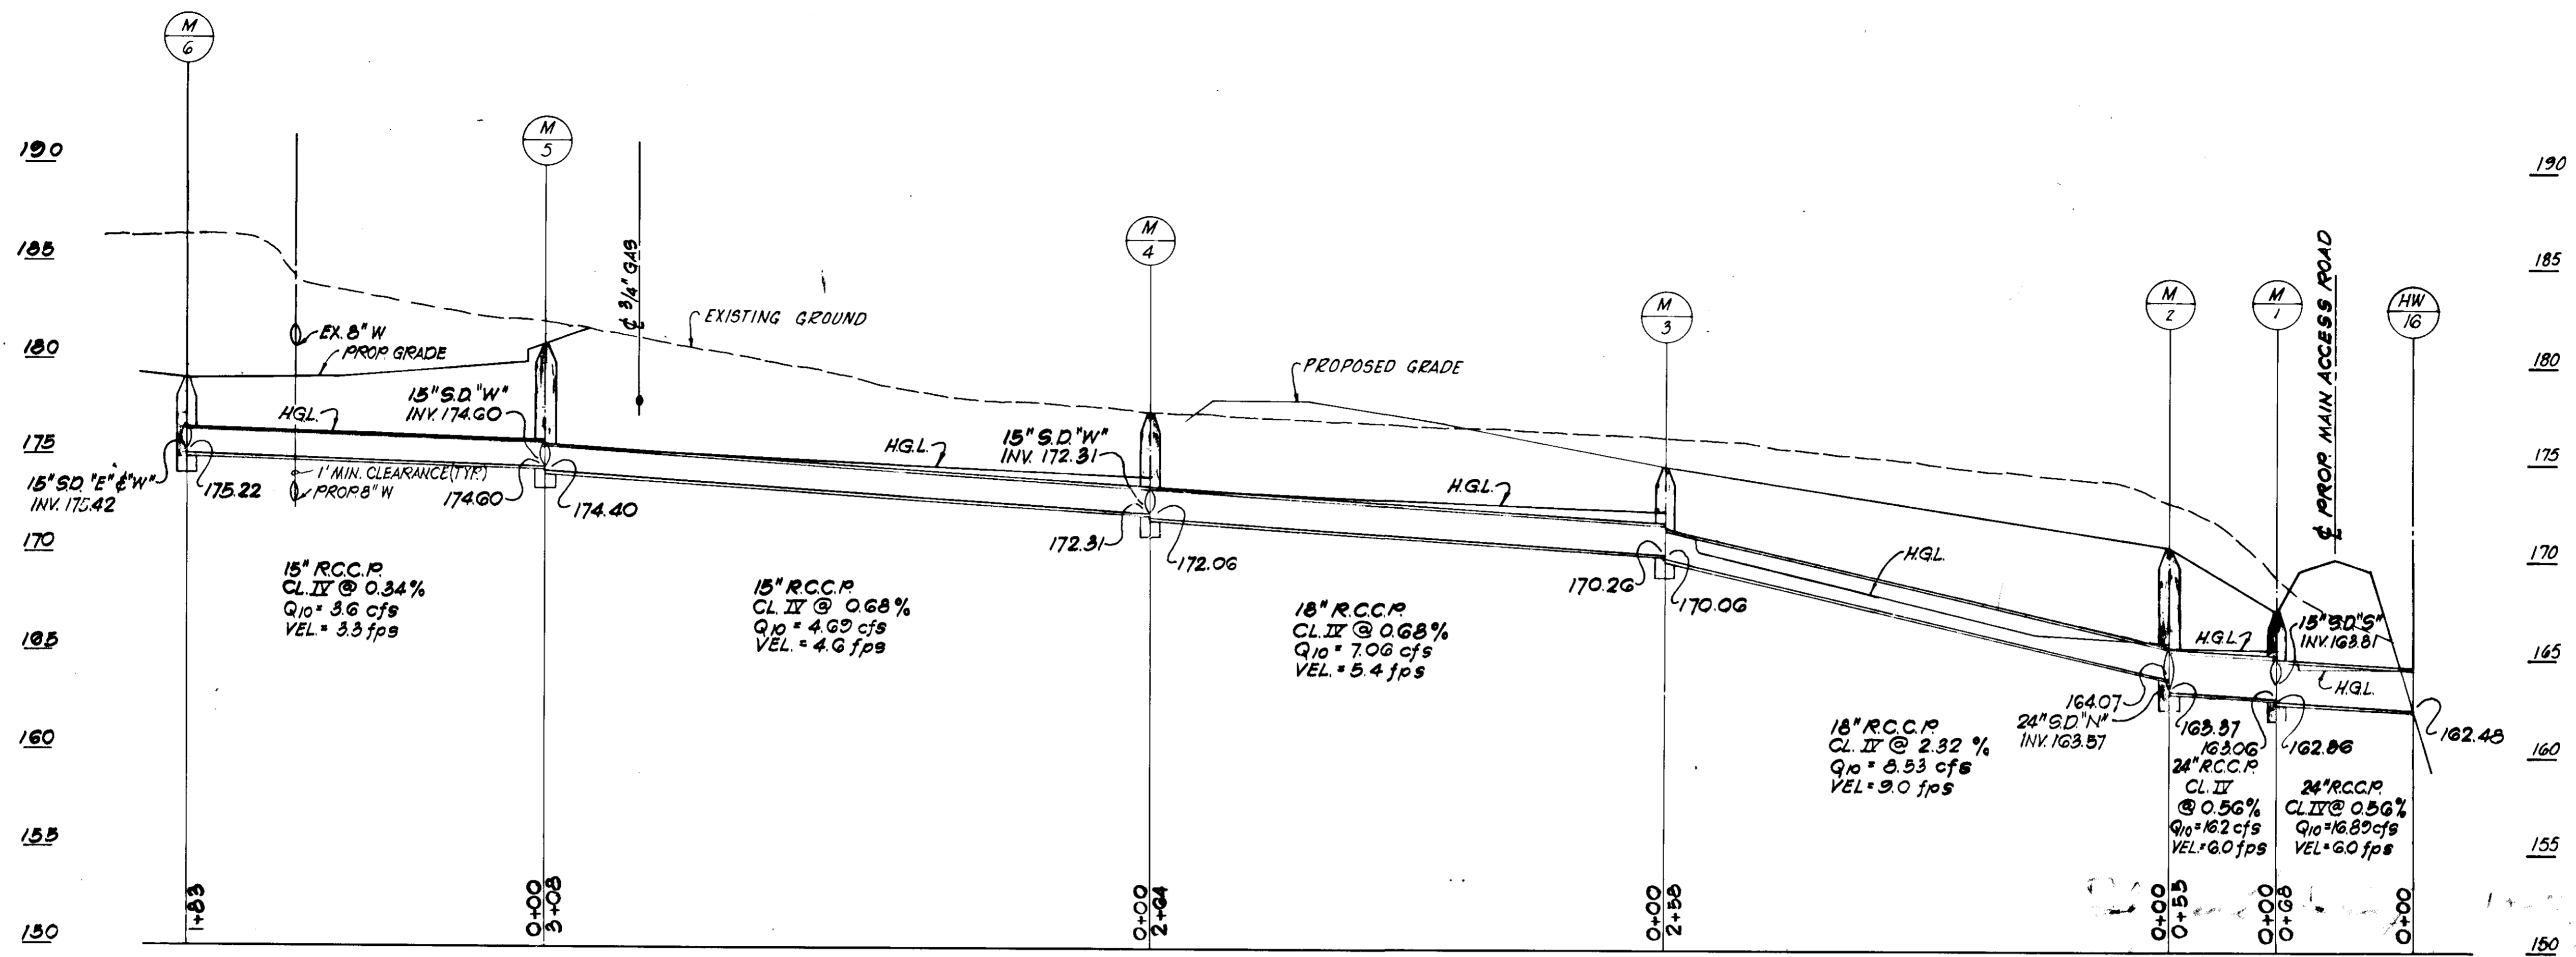

THIS DEVELOPMENT PLAN IS APPROVED FOR SOIL EROSION AND SEDIMENT CONTROL BY THE HOWARD SOIL CONSERVATION DISTRICT

Approved: Robert W. Zichner Date 9-30-74
Howard S. C. D.

By the Developer:
"I certify that all development and/or construction will be done according to this plan of development and plan for Erosion and Sediment Control, and I also authorize periodic on-site inspection by the Howard Soil Conservation District or their authorized agents, as are deemed necessary. Deviation from this plan will not be made unless authorized by the Howard Soil Conservation District."

Signature of Developer: *Paul P. J. J.* Date: 9-16-74

By the Engineer:
"I certify that this plan for Erosion and Sediment Control represents a practical and workable plan based on my personal knowledge of the site conditions and that it was prepared in accordance with the requirements of the Howard Soil Conservation District."

Signature of Engineer: *William J. Adams* Date: 9-30-74

APPROVED: FOR PUBLIC WATER AND PUBLIC SEWERAGE SYSTEMS, HOWARD COUNTY HEALTH DEPARTMENT
Signature: *Robert W. Zichner* Date: 9-30-74

APPROVED: HOWARD COUNTY OFFICE OF PLANNING AND ZONING
Signature: *James J. Harris* Date: 10-8-74
Signature: *J. H. Lawson* Date: 10/8/74

APPROVED: FOR PUBLIC WATER, PUBLIC SEWERAGE AND STORM DRAINAGE SYSTEMS AND ROADS, HOWARD COUNTY DEPARTMENT OF PUBLIC WORKS
Signature: *William J. Adams* Date: 10/4/74
Signature: *G. B. Adams* Date: 10/4/74

Reviewed for: *Howard* S. C. D. NAME and meets Technical Requirements
Signature: *James J. Harris* Date: 9-30-74

ISSUED FOR BIDDING		
NO.	DESCRIPTION	DATE

ADDENDA REVISIONS		
NO.	DESCRIPTION	DATE

ISSUED FOR CONSTRUCTION		
NO.	DESCRIPTION	DATE

REVISIONS		
NO.	DESCRIPTION	DATE
1	REVISED IN ACCORDANCE WITH HOWARD COUNTY COMMENTS	7/15/74 M.W.

AS BUILT DRAWINGS

9/17/74
J. H. Lawson

AMERICAN INSTRUMENT CO. DIVISION OF TRAVENOL LABORATORIES INC. HOWARD COUNTY, MD. ELECTION DISTRICT NO. 6 TAX MAP 47, PARCEL NO. 145

SECTION 577.0101
SECTION OR DETAIL NO.


DRAWN F.W.G. DATE 4-12-74
CHECKED L.C.P. JOB NO. 736640

STORM DRAIN PROFILES

ADDITION & ALTERATIONS PLANT & OFFICE BUILDING
AMINCO
SAVAGE MARYLAND

SCALE: HORZ. 1" = 50'
VERT. 1" = 5'



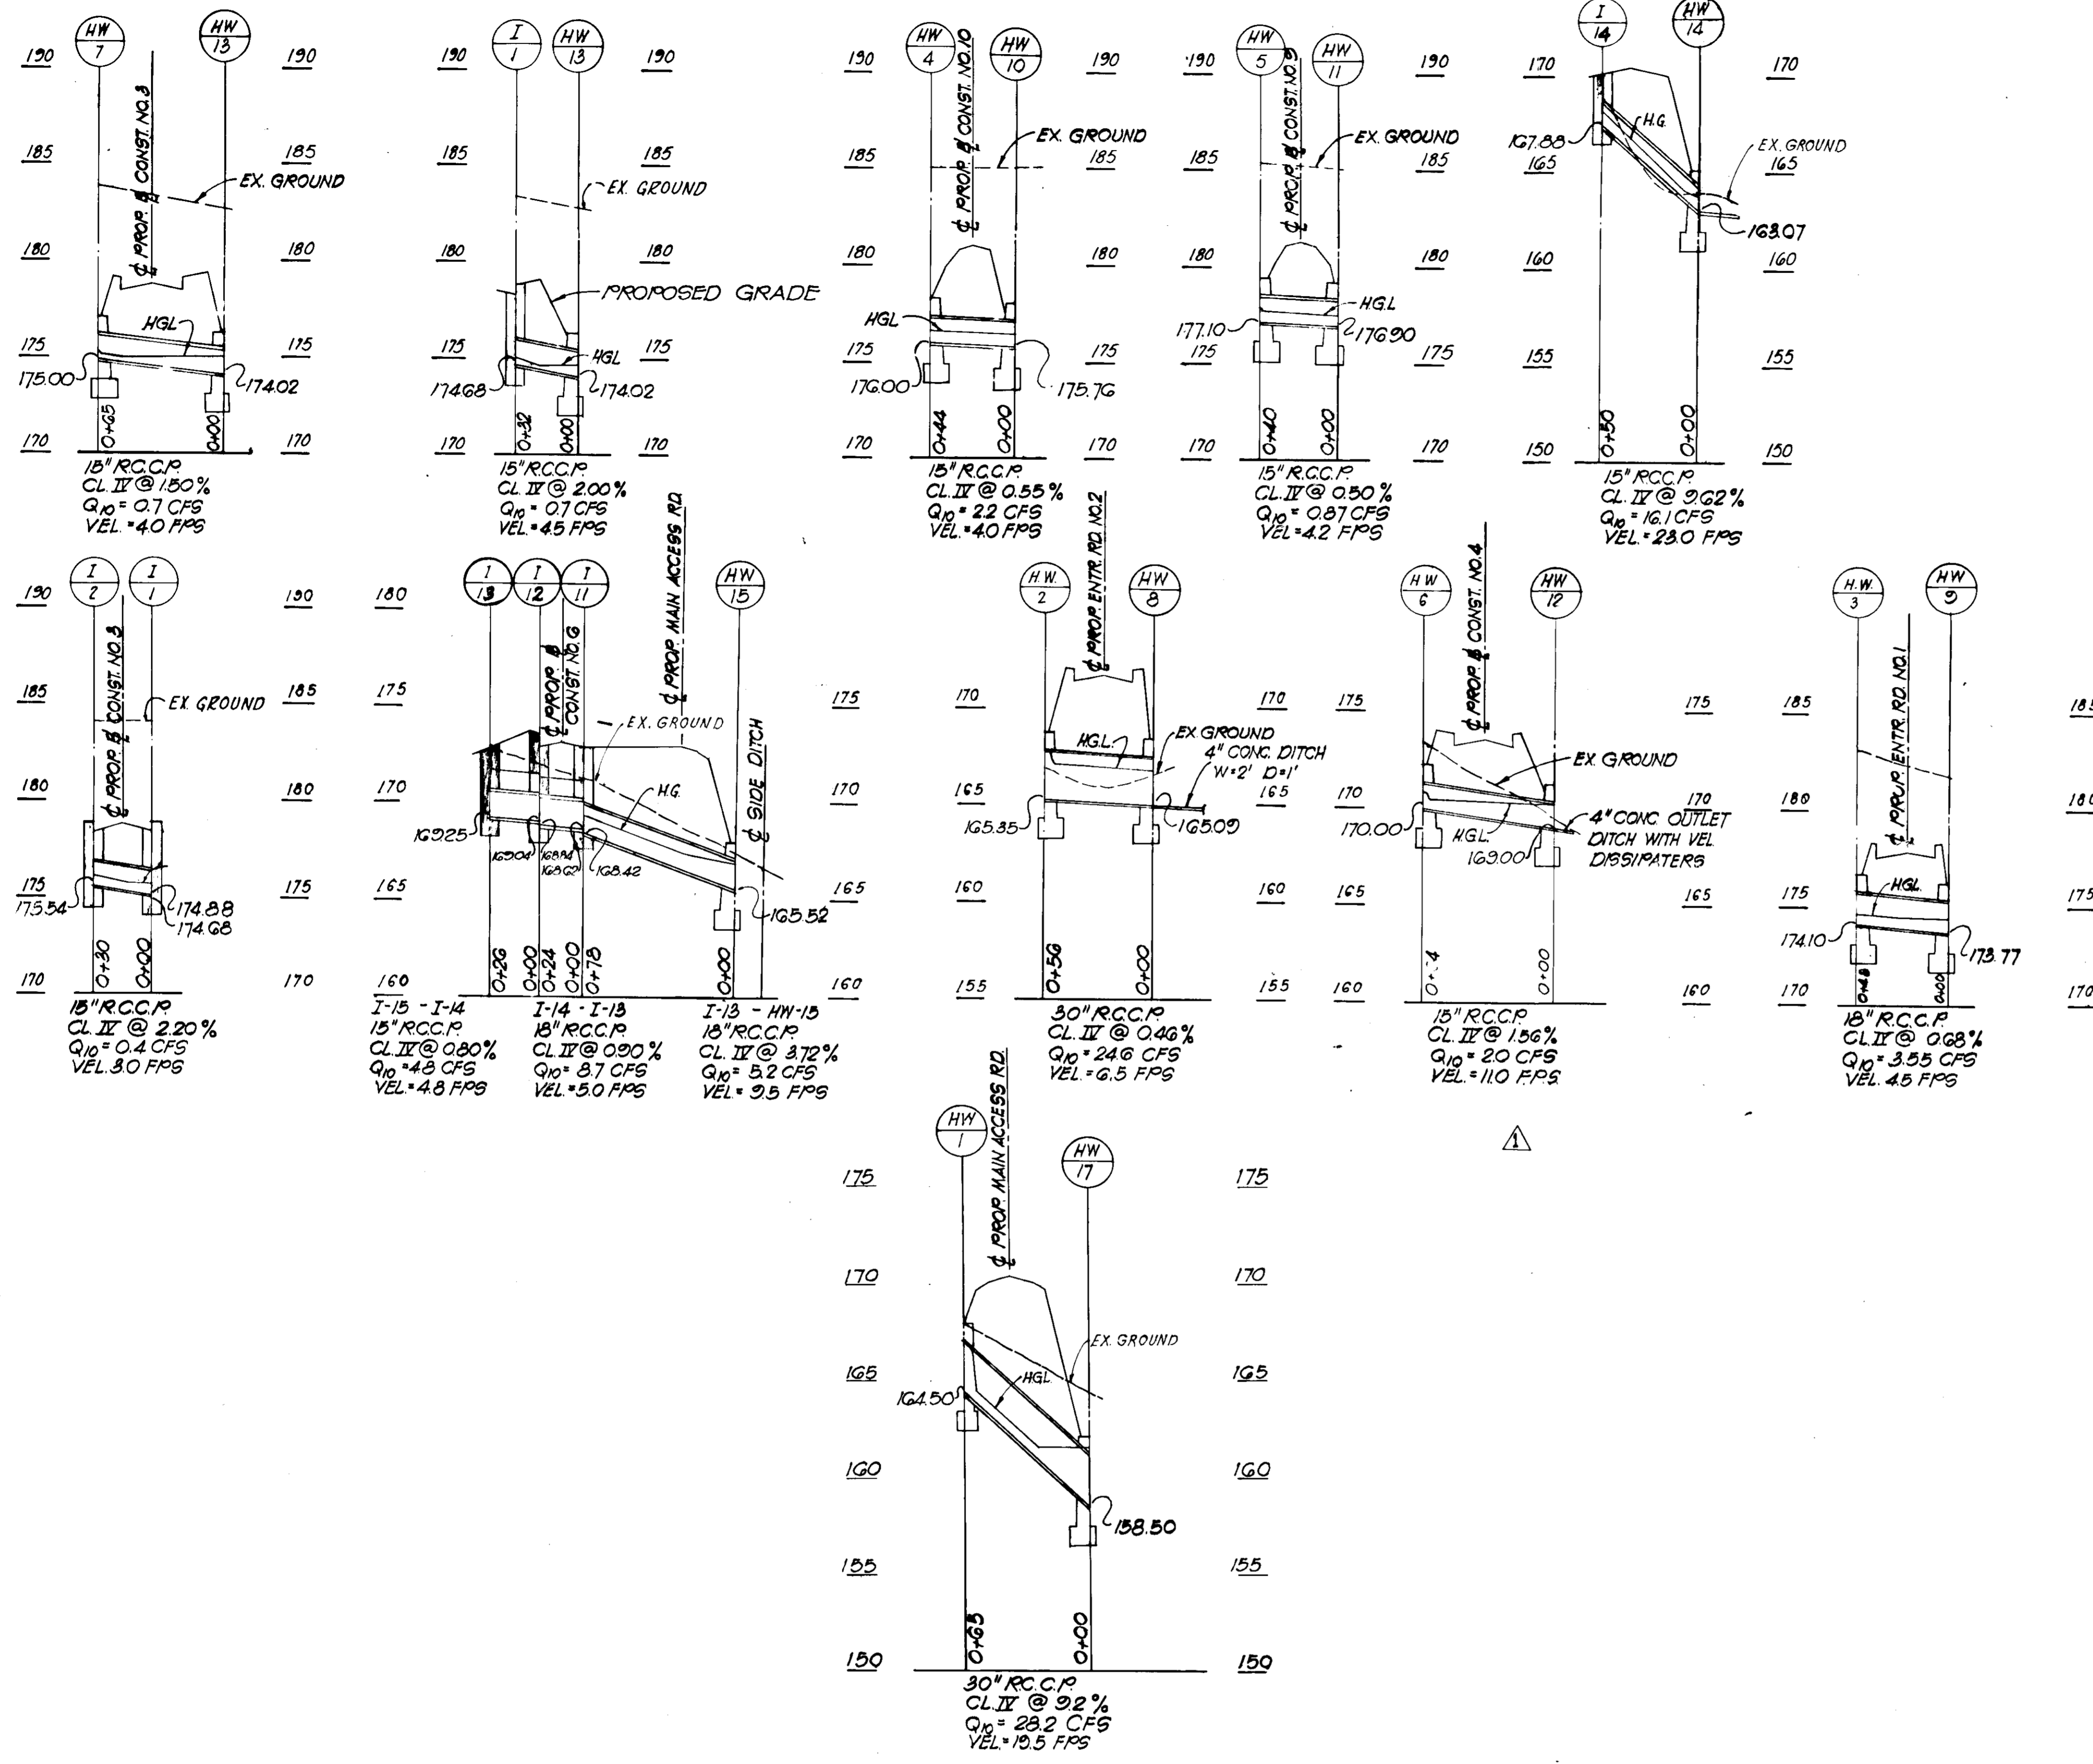

APPROVED: FOR PUBLIC WATER AND PUBLIC SEWERAGE SYSTEMS, HOWARD COUNTY HEALTH DEPARTMENT
 [Signature] 10/8/74
 COUNTY HEALTH OFFICER DATE

APPROVED: HOWARD COUNTY OFFICE OF PLANNING AND ZONING
 [Signature] 10-8-74
 PLANNING DIRECTOR DATE

[Signature] 10/8/74
 CHIEF, DIVISION OF LAND DEVELOPMENT AND TRANSPORTATION PLANNING DATE

APPROVED: FOR PUBLIC WATER, PUBLIC SEWERAGE AND STORM DRAINAGE SYSTEMS AND ROADS
 HOWARD COUNTY DEPARTMENT OF PUBLIC WORKS

[Signature] 10/4/74
 DIRECTOR DATE

[Signature] 10/4/74
 CHIEF, BUREAU OF HIGHWAYS DATE

Reviewed for: Howard S. C. D.
 NAME
 and meets Technical Requirements
 [Signature] Date 9-30-74
 Signature
 S. Soil Conservation Service

THIS DEVELOPMENT PLAN IS APPROVED FOR SOIL EROSION AND SEDIMENT CONTROL BY THE HOWARD SOIL CONSERVATION DISTRICT

Approved: [Signature] Date 9-30-74
 Howard S. Q.D.

By the Developer:
 "I certify that all development and/or construction will be done according to this plan of development and plan for Erosion and Sediment Control, and I also authorize periodic on-site inspection by the Howard Soil Conservation District or their authorized agents, as are deemed necessary." Deviation from this plan will not be made unless authorized by the Howard Soil Conservation District.

[Signature] 4-16-74
 Signature of Developer Date

By the Engineer:
 "I certify that this plan for Erosion and Sediment Control represents a practical and workable plan based on my personal knowledge of the site conditions and that it was prepared in accordance with the requirements of the Howard Soil Conservation District."

[Signature] 4/16/74
 Signature of Engineer Date

SCALE: HORZ. 1" = 50'
 VERT. 1" = 5'

ISSUED FOR BIDDING		
DATE	BY	
ADDENDA REVISIONS		
ADDENDA NO.	ADDENDA DATE	BY
ISSUED FOR CONSTRUCTION		
DATE	BY	


REVISIONS			
NO.	DESCRIPTION	DATE	BY
1	REVISED PIPE PROFILE	5/13/74	W.B.
2	REVISED IN ACCORDANCE WITH HOWARD COUNTY COMMENTS	7/15/74	M.W.
3	REVISED IN ACCORDANCE WITH HOWARD COUNTY COMMENTS	9/3/74	M.W.

AS BUILT DRAWINGS

DATE BY

9/17/74
 J.H. Lawson JR

AMERICAN INSTRUMENT CO.
 DIVISION OF
 TRAVENOL LABORATORIES INC.
 HOWARD COUNTY, MD.
 ELECTION DISTRICT NO. 6
 TAX MAP 47, PARCEL NO. 145

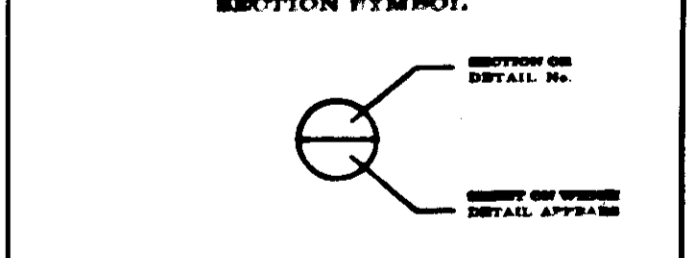

DRAWN F.W.G.	DATE 4-12-74
CHECKED L.C.P.	JOB No. 736640

STORM DRAIN PROFILES

ADDITION & ALTERATIONS
 PLANT & OFFICE BUILDING
 AMINCO
 SAVAGE MARYLAND

STORM DRAINAGE DESIGN COMPUTATION - DESIGN STORM FREQUENCY 10 YEARS

LOCATION FROM TO	AREA	ACRES		COEFF. "C"	CA	ΣCA	TIME CONC. MIN.			Q=CIA C.F.S.	PIPE D. = 0.013				REMARKS		
		SUB.	TOTAL				INLET	DRAIN	TOT.		INTE.	Q=CIA	SIZE	SLOPE		VEL.	LENGTH
I-9	M-6	2	0.4	.35	—	0.14	10.6	—	10.6	5.2	0.73	15"	3.0	6.5	12		
I-8	M-6	1	1.50	.44	—	0.66	22.44	—	22.44	4.5	2.97	15"	13.0	13	8		
M-6	M-5	1.2	1.59	.5	—	0.80	22.44	.02	22.46	4.5	3.6	15"	.34	3.3	183		
I-7	M-5	5	.31	.31	.29	0.29	5.0	—	5.0	7.0	2.1	15"	10.38	10.2	74		
M-5	M-4	1.2, 5	1.90	.57	—	1.09	22.44	.34	23.38	4.3	4.69	15"	4.8	4.6	303		
I-6	M-4	6	.2	.25	.19	0.19	5.0	—	5.0	7.0	1.3	15"	6.3	8.0	74		
Roof	M-4	4	4.23	.95	.40	0.40	1.8	—	1.8	10	4.0	—	—	—	—		
M-4	M-3	12.4, 5.6	—	.67	—	1.68	22.44	2.06	24.5	4.2	7.06	18"	.63	5.4	264		
Roof	M-3	3	4.23	.95	.40	0.40	1.8	—	1.8	10	4.0	—	—	—	—		
M-3	M-2	12.3, 4.5, 6.1, 1.9	—	.71	—	2.08	22.44	2.88	25.32	4.1	8.53	18"	2.32	9.0	258		
I-10	I-5	13	.44	.44	.20	—	12.4	—	12.4	5.7	1.14	15"	.36	2.7	40		
—	I-5	7	1.14	.95	1.03	—	5.4	—	5.4	6.9	7.45	—	—	—	—		
I-5	I-4	13.7	—	1.58	0.81	—	12.4	.25	12.65	5.6	7.17	18"	.48	4.5	24		
I-4	M-2	13.7, 8	—	3.08	.61	—	12.4	.34	12.74	5.6	10.47	24"	1.0	7.0	53		
M-2	M-1	12.3, 4.5, 6.1, 1.9	—	5.93	.66	—	22.44	3.34	25.78	4.1	16.20	24"	.56	6.0	55		
I-3	M-1	9	.66	.66	.17	.17	16.3	—	16.3	5.2	0.9	15"	1.2	7.2	15		
M-1	HW-16	12.3, 4.5, 6.1, 1.9	—	6.64	.62	—	22.44	3.49	25.93	4.1	16.89	24"	.56	6.0	68		
I-13	I-12	10	—	2.14	.19	—	0.40	23.4	—	23.4	4.5	1.8	15"	0.80	4.8	26	
I-12	I-11	10, 11	—	2.34	.25	—	.59	23.4	.1	23.5	4.5	2.7	15"	0.90	5.0	24	
I-11	HW-15	10, 11, 12	—	2.95	.39	—	1.16	23.5	.1	23.6	4.5	5.2	18"	3.72	9.5	78	
I-2	I-1	14	.10	—	.04	.06	—	10.9	—	10.9	5.9	0.4	—	—	—		
—	I-1	15	.06	—	.06	.06	—	5.0	—	5.0	7.0	0.4	—	—	—		
I-1	HW-13	14, 15	.16	—	.75	.12	0.12	10.9	.01	11.0	5.9	0.7	—	—	—		
I-14	HW-14	16	2.57	—	.92	2.36	—	6.2	—	6.2	6.8	16.0	15"	9.62	23.0	56	

HEADWALL DESIGN

LOCATION FROM TO	AREA NO.	ACRES		COEFF. "C"	CA	ΣCA	TIME CONC. MIN.			Q=CIA C.F.S.	ENTRANCE CONTROL				REMARKS					
		SUB.	TOT.				INLET	DRAIN	TOT.		INTE.	Q=CIA	HW/D	HW ELEV.		SIZE	SLOPE	VEL.	LENGTH	
HW1	HW17	17-21	—	8.04	.69	—	5.53	17.3	.03	17.33	5.1	28.2	0.82	164.50	(2)	30"	3.2%	19.5	65'	
HW2	HW8	17-20	—	7.24	.67	—	4.84	15.1	2.2	17.3	5.1	24.6	1.05	165.35	(2)	30"	0.46%	6.5	56'	
HW3	HW9	17-19	—	1.62	.41	—	0.67	13.1	2.0	15.1	5.3	3.55	0.68	174.10	(2)	18"	0.28%	4.5	48'	
HW4	HW10	17-18	—	1.03	.38	—	0.39	11.5	1.6	13.1	5.6	2.2	0.68	176.00	(2)	15"	0.55%	4.0	44'	
HW5	HW11	17	—	.45	—	—	0.15	11.5	—	11.5	5.8	0.87	0.50	177.10	(2)	15"	0.5%	4.2	40'	
HW6	HW12	14, 15, 22, 23	—	.49	.71	—	0.35	12.1	1.3	13.4	5.7	2.0	0.63	170.00	(2)	15"	1.47%	11.0	68'	
HW7	HW13	22	—	.21	.58	—	0.12	12.1	—	12.1	5.8	0.7	0.50	175.00	(2)	15"	1.5%	4.0	65'	
EX 36"	PIPE	1-23	—	25.37	—	—	14.87	—	—	30.3	3.7	5.5	1.30	155.00	(3)	36"	5.56%	19.5	18	EXISTING n = 0.15

HEADWALL SCHEDULE

NO.	TYPE	INV. ELEV.	LOCATION		
			STATION	OFFSET	# OF CONSTRUCTION
HW1	B	164.50	7+75	25' LT.	ACCESS RD.
HW2	B	165.35	0+50	26' LT.	ENT. RD. #2
HW3	B	174.10	0+52	21' LT.	ENT. RD. #1
HW4	B	176.00	0+30	22' LT.	# NO.10
HW5	B	177.10	0+33	22' LT.	# NO.9
HW6	B	170.00	0+33	40' RT.	# NO.4
HW7	B	175.00	0+33	25' RT.	# NO.3
HW8	B	165.00	0+50	30' RT.	ENT. RD. #2
HW9	B	173.77	0+52	26' RT.	ENT. RD. #1
HW10	B	175.76	0+30	23' RT.	# NO.10
HW11	B	176.30	0+33	17' RT.	# NO.9
HW12	B	169.00	0+52	25' LT.	# NO.4
HW13	DOUBLE	174.02	0+30	37' LT.	# NO.3
HW14	B	163.07	3+57	33' LT.	# NO.4
HW15	B	165.52	15+74	30' RT.	ACCESS RD.
HW16	B	162.73	9+60	38' RT.	ACCESS RD.
HW17	B	163.50	7+75	42' RT.	ACCESS RD.

NOTE: FOR TYPE "B" HEADWALL SEE HOWARD COUNTY STANDARD DETAIL NO. SDD 21

MANHOLE SCHEDULE

NO.	TYPE	INV. ELEV.	TOP ELEV.	LOCATION		
				STATION	OFFSET	# OF CONSTRUCTION
M-1	TYPE A-3	162.86	167.70	9+55	25' LT.	ACCESS RD.
M-2	TYPE A-2 PRECAST	163.37	170.80	9+02	62' LT.	ACCESS RD.
M-3	TYPE A-3 PRECAST	170.06	174.00	2+80	37' LT.	NO. 5
M-4	TYPE A-3 PRECAST	172.06	176.70	—	—	—
M-5	TYPE A-2 PRECAST	174.40	180.30	—	—	—
M-6	TYPE A-3 PRECAST	175.22	179.17	3+15	0'	NO.7

NOTE: FOR TYPE A-2 & A-3 PRECAST MANHOLE SEE HOWARD COUNTY STANDARD DETAIL NO. SDD 2

INLET SCHEDULE

NO.	TYPE	INV. ELEV.	TOP ELEV. GRATE	LOCATION			CONSTRUCTION	HOWARD CO. STD. DETAIL
				STATION	OFFSET	# OF CONSTRUCTION		
I-1	SINGLE "S" COMB.	174.68	178.50	0+67	15' LT.	NO. 3	UNDEPRESSED	SDD 44
I-2	SINGLE "S" COMB.	175.54	178.50	0+67	15' RT.	NO. 3	UNDEPRESSED	SDD 44
I-3	YARD	164.95	167.50	9+45	24.1 LT.	ACCESS RD.	—	SDD 49
I-4	SINGLE "S" COMB.	164.45	169.61	0+48	12' LT.	NO. 5	DEPRESSED	SDD 44
I-5	SINGLE "S"	165.01	169.61	0+48	12' RT.	NO. 5	DEPRESSED	SDD 44
I-6	SINGLE "S"	176.27	180.23	—	—	—	UNDEPRESSED	SDD 44
I-7	DOUBLE "S" COMB.	182.28	184.83	—	—	—	UNDEPRESSED	SDD 47
I-8	DOUBLE "S" COMB.	176.46	178.79	3+15	8' RT.	NO. 7	UNDEPRESSED	SDD 47
I-9	SINGLE "S"	176.38	178.71	3+15	12' LT.	NO. 7	UNDEPRESSED	SDD 44
I-10	YARD	165.14	168.50	11+00	24' LT.	ACCESS RD.	—	SDD 49
I-11	DOUBLE "S" COMB.	168.42	172.88	0+48	12' LT.	NO. 6	UNDEPRESSED	SDD 47
I-12	SINGLE "S" COMB.	163.24	172.88	0+48	12' RT.	NO. 6	UNDEPRESSED	SDD 44
I-13	YARD	169.25	172.80	0+48	40' RT.	NO. 6	—	SDD 49
I-14	DOUBLE "S" COMB.	167.88	170.13	3+60	15' RT.	NO. 4	DEPRESSED	SDD 47

APPROVED: FOR PUBLIC WATER AND PUBLIC SEWERAGE SYSTEMS, HOWARD COUNTY HEALTH DEPARTMENT

[Signature]
COUNTY HEALTH OFFICER

APPROVED: HOWARD COUNTY OFFICE OF PLANNING AND ZONING

[Signature] 10-8-74
PLANNING DIRECTOR
[Signature] 10/4/74
CHIEF, DIVISION OF LAND DEVELOPMENT AND TRANSPORTATION PLANNING

APPROVED: FOR PUBLIC WATER, PUBLIC SEWERAGE AND STORM DRAINAGE SYSTEMS AND ROADS, HOWARD COUNTY DEPARTMENT OF PUBLIC WORKS

[Signature] 10/4/74
DIRECTOR
[Signature] 10/4/74
CHIEF, BUREAU OF HIGHWAYS

Reviewed for: Howard S. C. D.

and meets Technical Requirements
[Signature] Date 9-30-74
Signature
U. S. Soil Conservation Service

THIS DEVELOPMENT PLAN IS APPROVED FOR SOIL EROSION AND SEDIMENT CONTROL BY THE HOWARD SOIL CONSERVATION DISTRICT

Approved: *[Signature]* Date 9-30-74
Howard S. C. D.

By the Developer:
"I certify that all development and/or construction will be done according to this plan of development and plan for Erosion and Sediment Control, and I also authorize periodic on-site inspection by the Howard Soil Conservation District or their authorized agents, as are deemed necessary." Deviation from this plan will not be made unless authorized by the Howard Soil Conservation District.

[Signature] 4-16-74
Signature of Developer

By the Engineer:
"I certify that this plan for Erosion and Sediment Control represents a practical and workable plan based on my personal knowledge of the site conditions and that it was prepared in accordance with the requirements of the Howard Soil Conservation District."

[Signature] 4-16-74
Signature of Engineer

ISSUED FOR BIDDING		
NO.	DATE	BY


ADDENDA REVISIONS		
NO.	DATE	BY

ISSUED FOR CONSTRUCTION		
NO.	DATE	BY

REVISIONS			
NO.	DATE	BY	
1	7/15/74	M.W.	REVISED IN ACCORDANCE WITH HOWARD COUNTY COMMENTS
2	9/3/74	M.W.	REVISED IN ACCORDANCE WITH HOWARD COUNTY COMMENTS





AS BUILT DRAWINGS
[Signature] 9/17/74
J.H. Lawson

AMERICAN INSTRUMENT CO.
DIVISION OF TRAVENOL LABORATORIES INC.
HOWARD COUNTY, MD.
ELECTION DISTRICT NO. 6
TAX MAP 47, PARCEL NO. 145

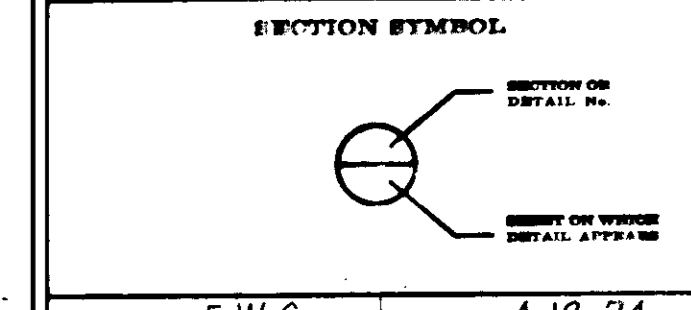

DRAWN F.W.G. DATE 4-12-74
CHECKED L.C.P. JOB No. 736640

DRAINAGE INFORMATION
ADDITION & ALTERATIONS
PLANT & OFFICE BUILDING
AMINCO
SAVAGE, MARYLAND

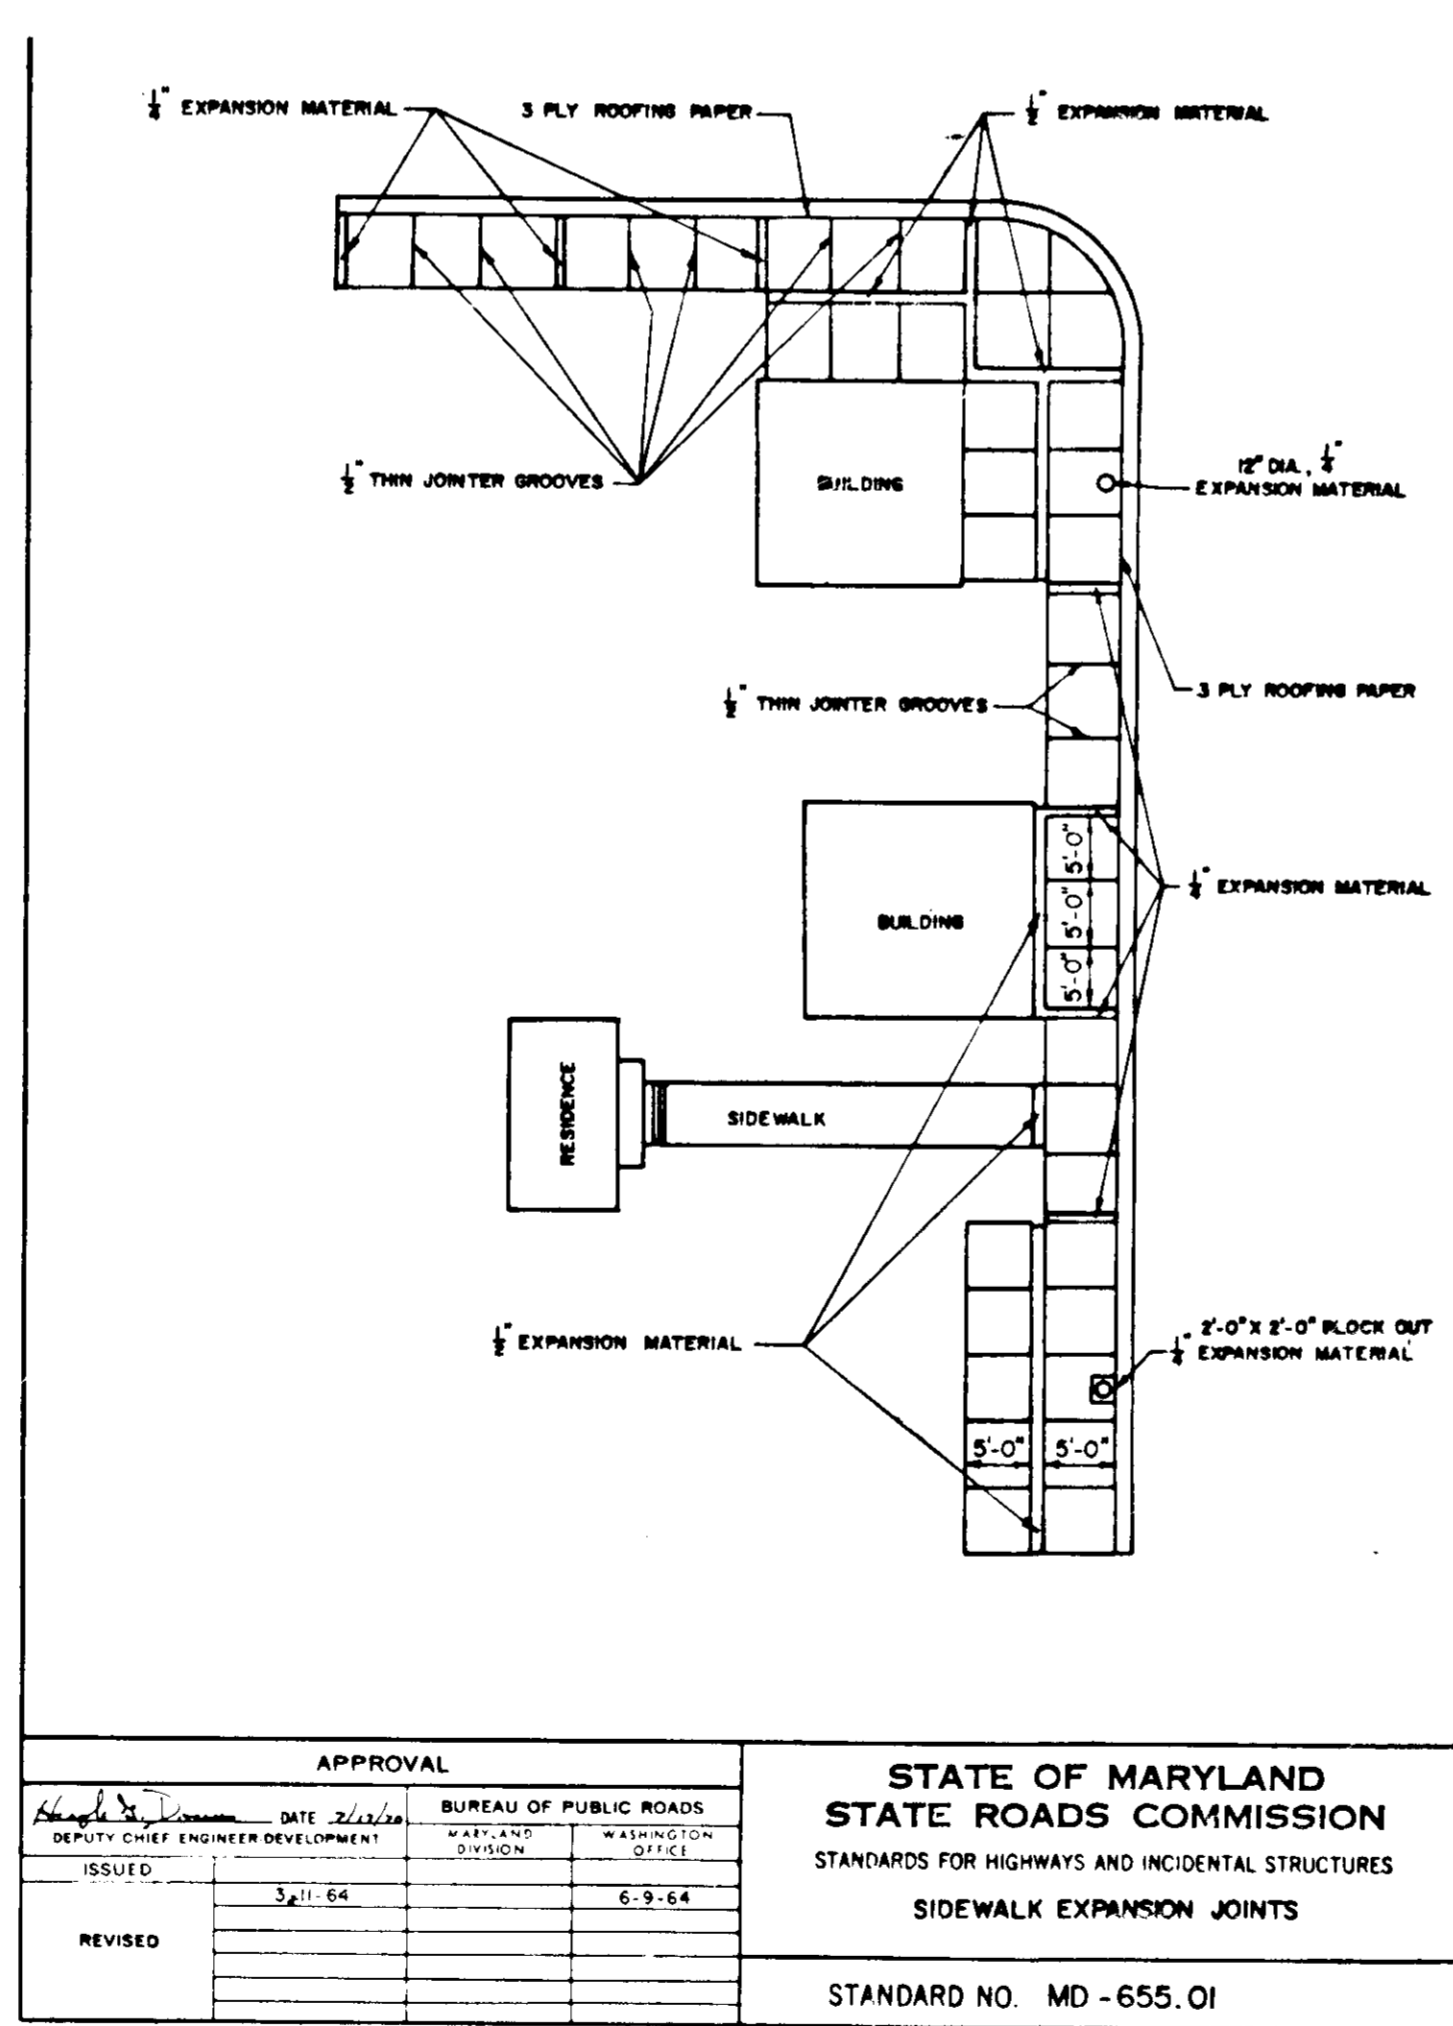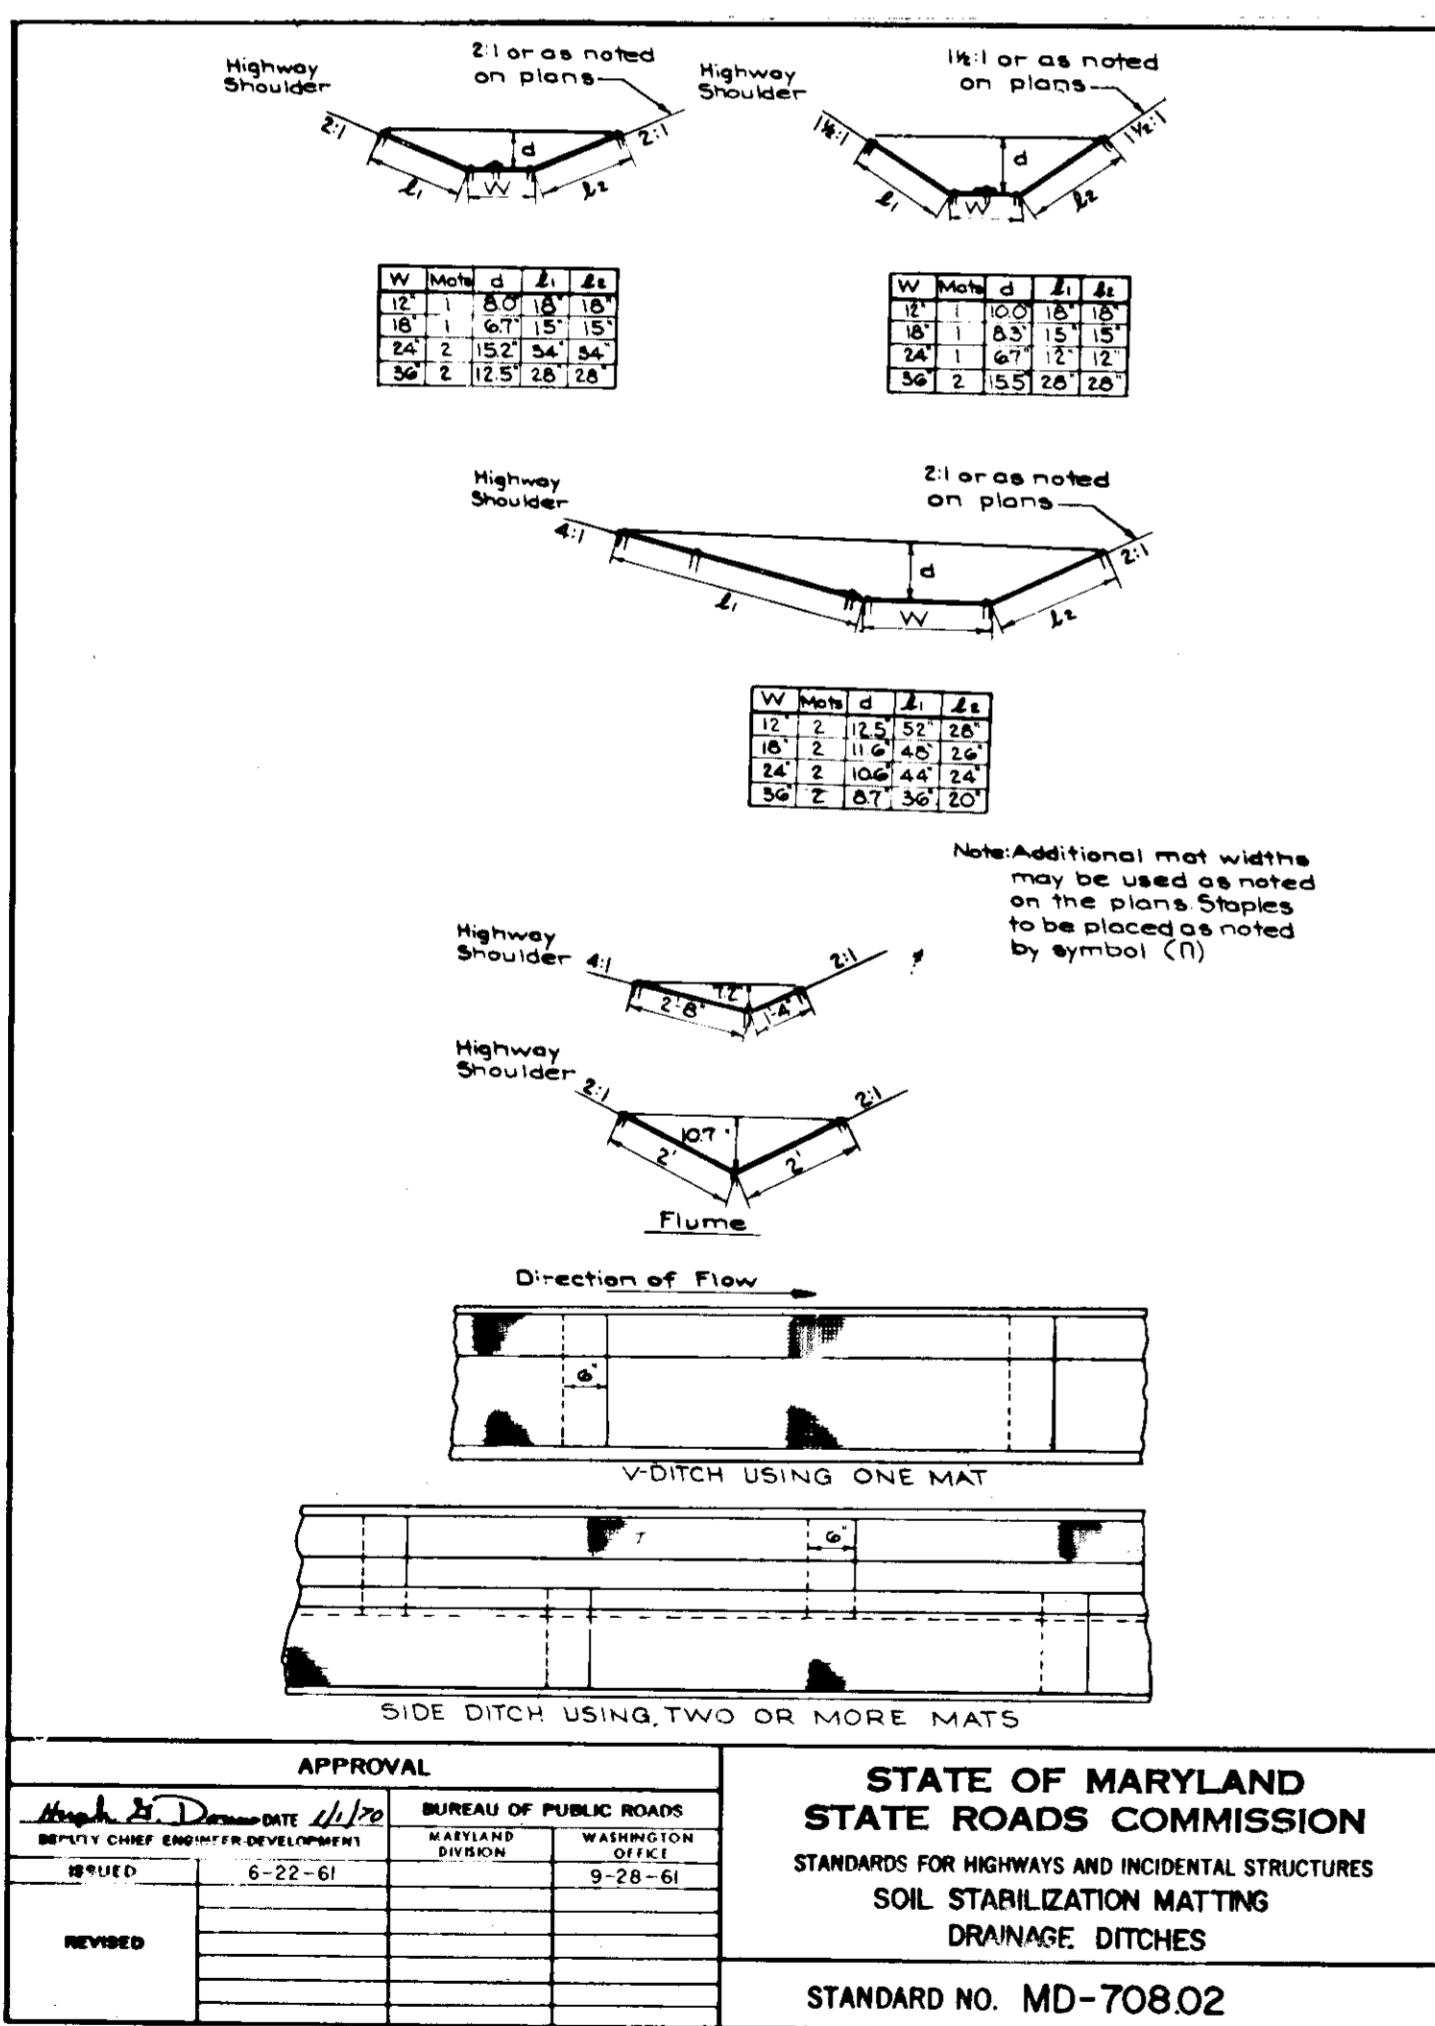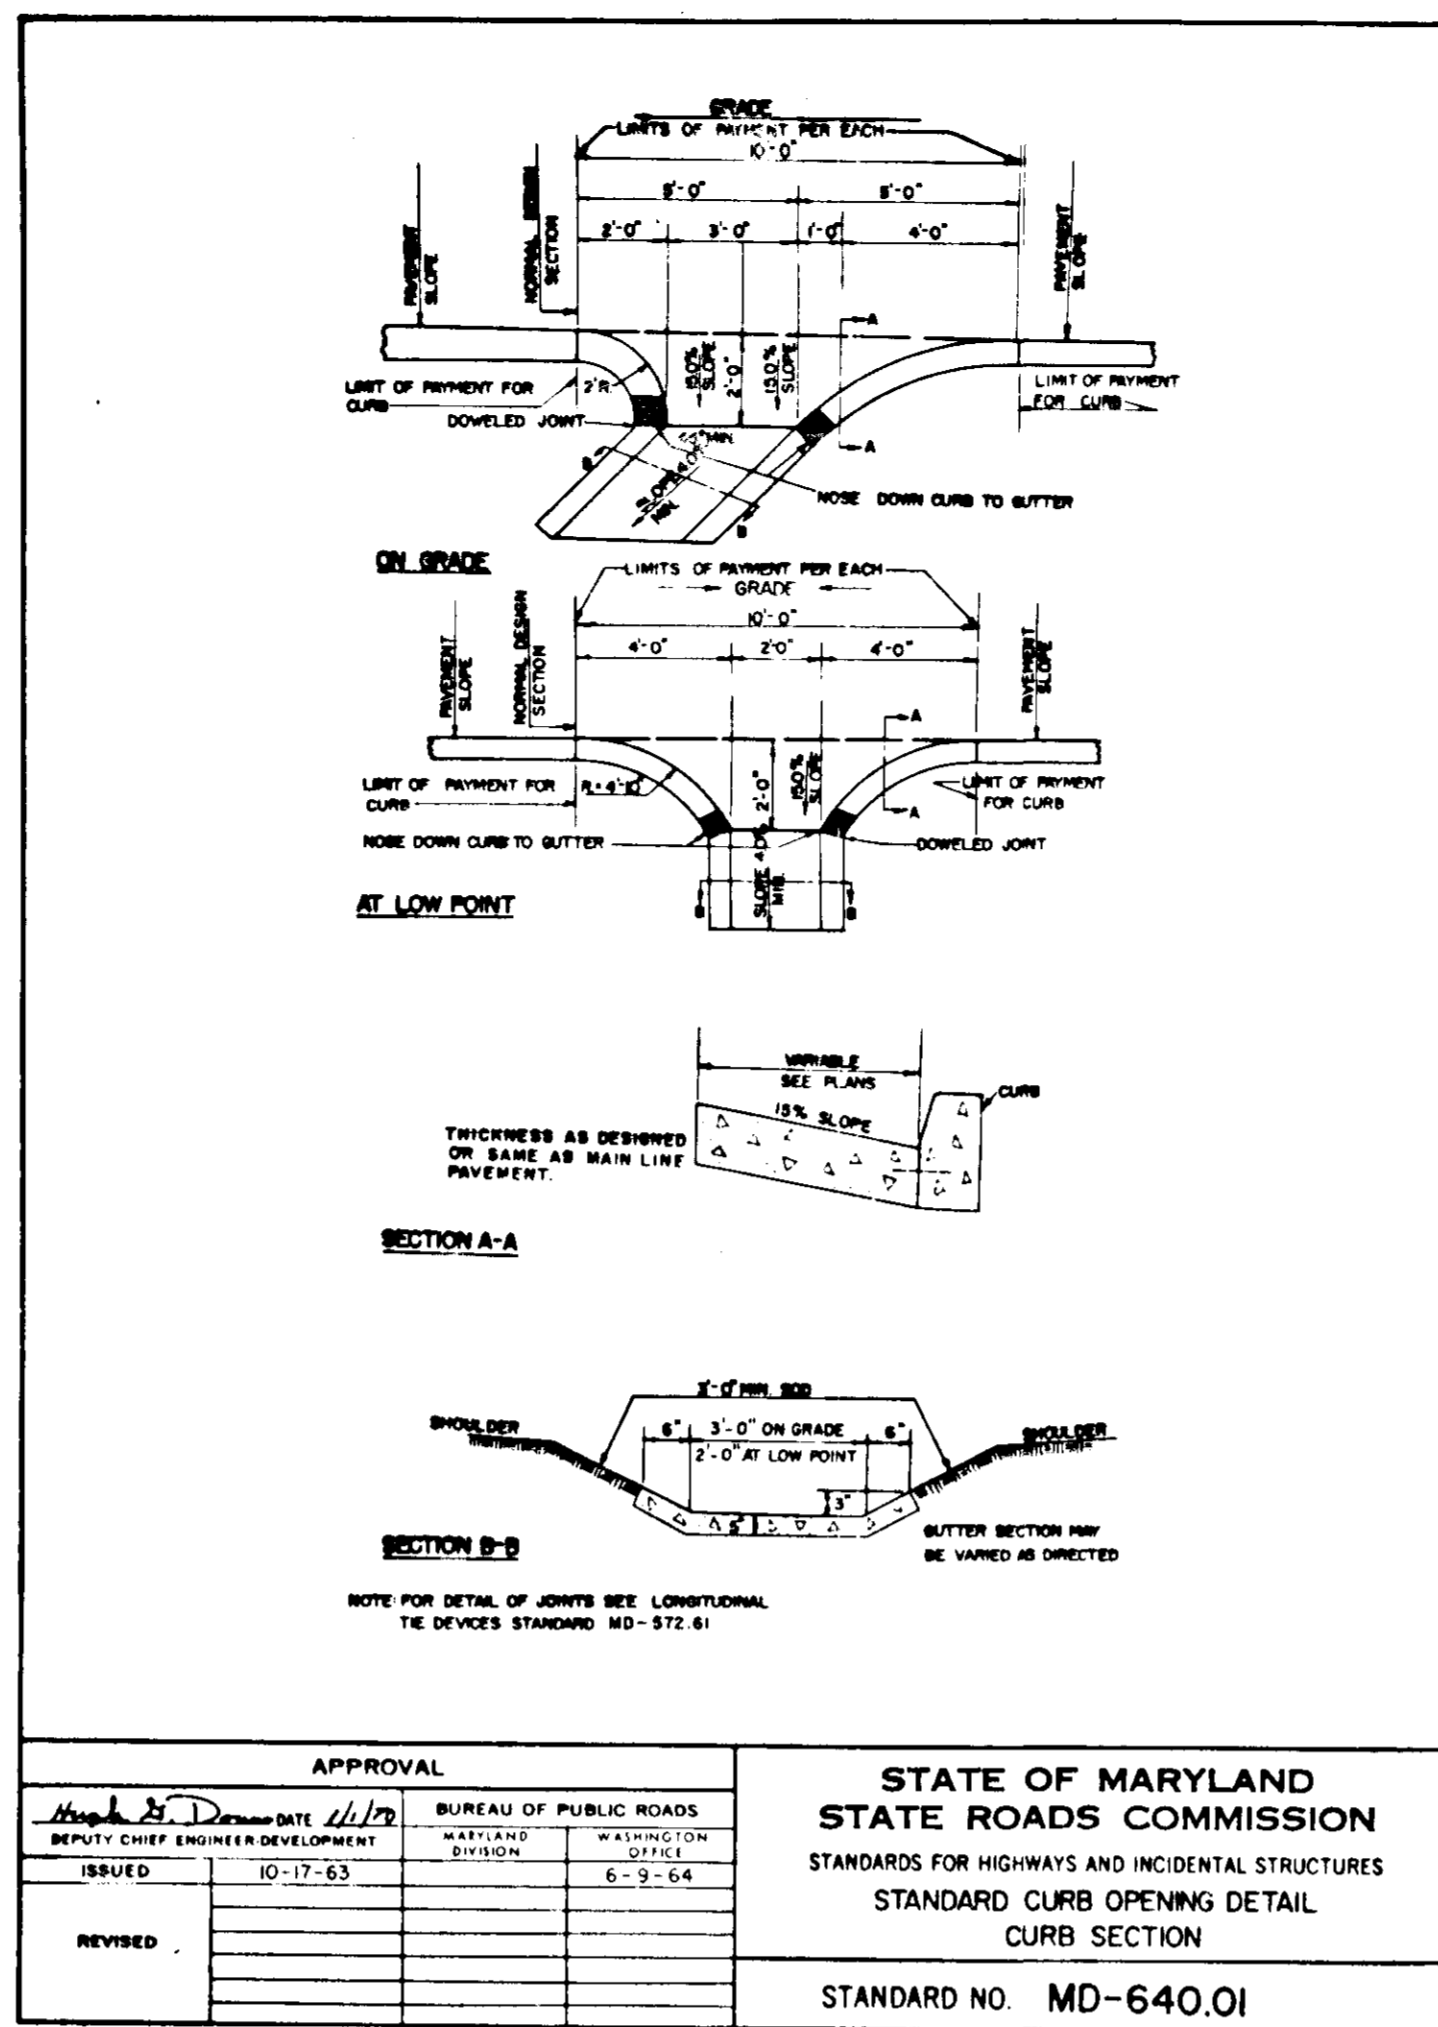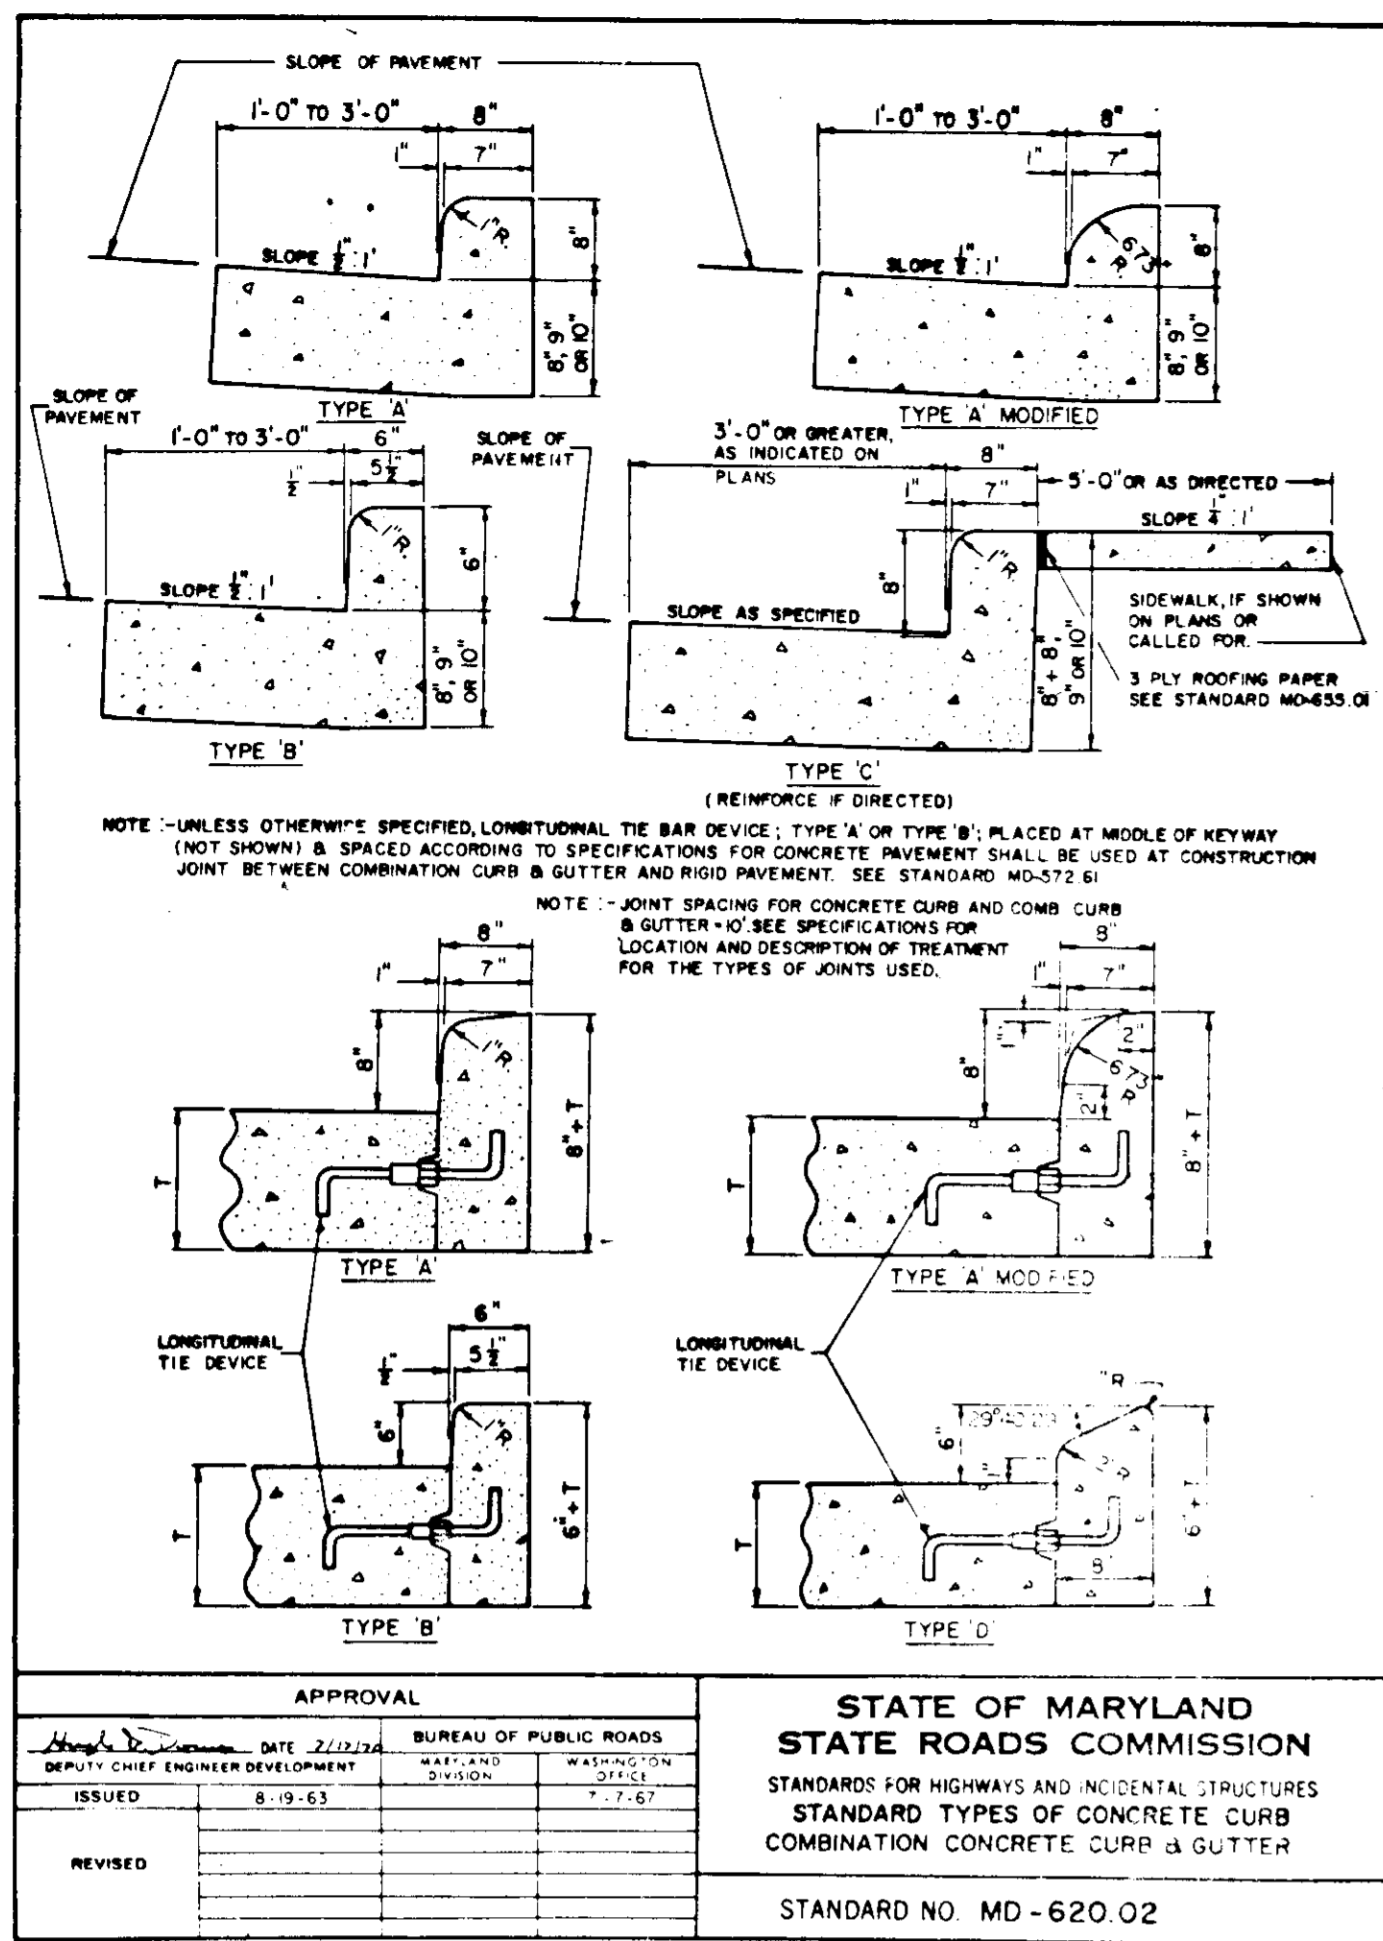

APPROVED: FOR PUBLIC WATER AND PUBLIC SEWERAGE SYSTEMS, HOWARD COUNTY HEALTH DEPARTMENT
[Signature] COUNTY HEALTH OFFICER DATE 10/8/74

APPROVED: HOWARD COUNTY OFFICE OF PLANNING AND ZONING
[Signature] PLANNING DIRECTOR DATE 10-8-74

[Signature] CHIEF, DIVISION OF LAND DEVELOPMENT AND TRANSPORTATION PLANNING DATE 10/8/74

APPROVED: FOR PUBLIC WATER, PUBLIC SEWERAGE AND STORM DRAINAGE SYSTEMS AND ROADS
HOWARD COUNTY DEPARTMENT OF PUBLIC WORKS

[Signature] DIRECTOR DATE 10/4/74

[Signature] CHIEF, BUREAU OF HIGHWAYS DATE 10/4/74


Reviewed for: Howard S. C. D.
NAME
and meets Technical Requirements
[Signature] Date 9-30-74
Signature
U. S. Soil Conservation Service

THIS DEVELOPMENT PLAN IS APPROVED FOR SOIL EROSION AND SEDIMENT CONTROL BY THE HOWARD SOIL CONSERVATION DISTRICT

Approved: *[Signature]* Date 9-30-74
Howard S. C. D.

By the Developer:
[Signature] Date 4-16-74

By the Engineer:
[Signature] Date 4-16-74

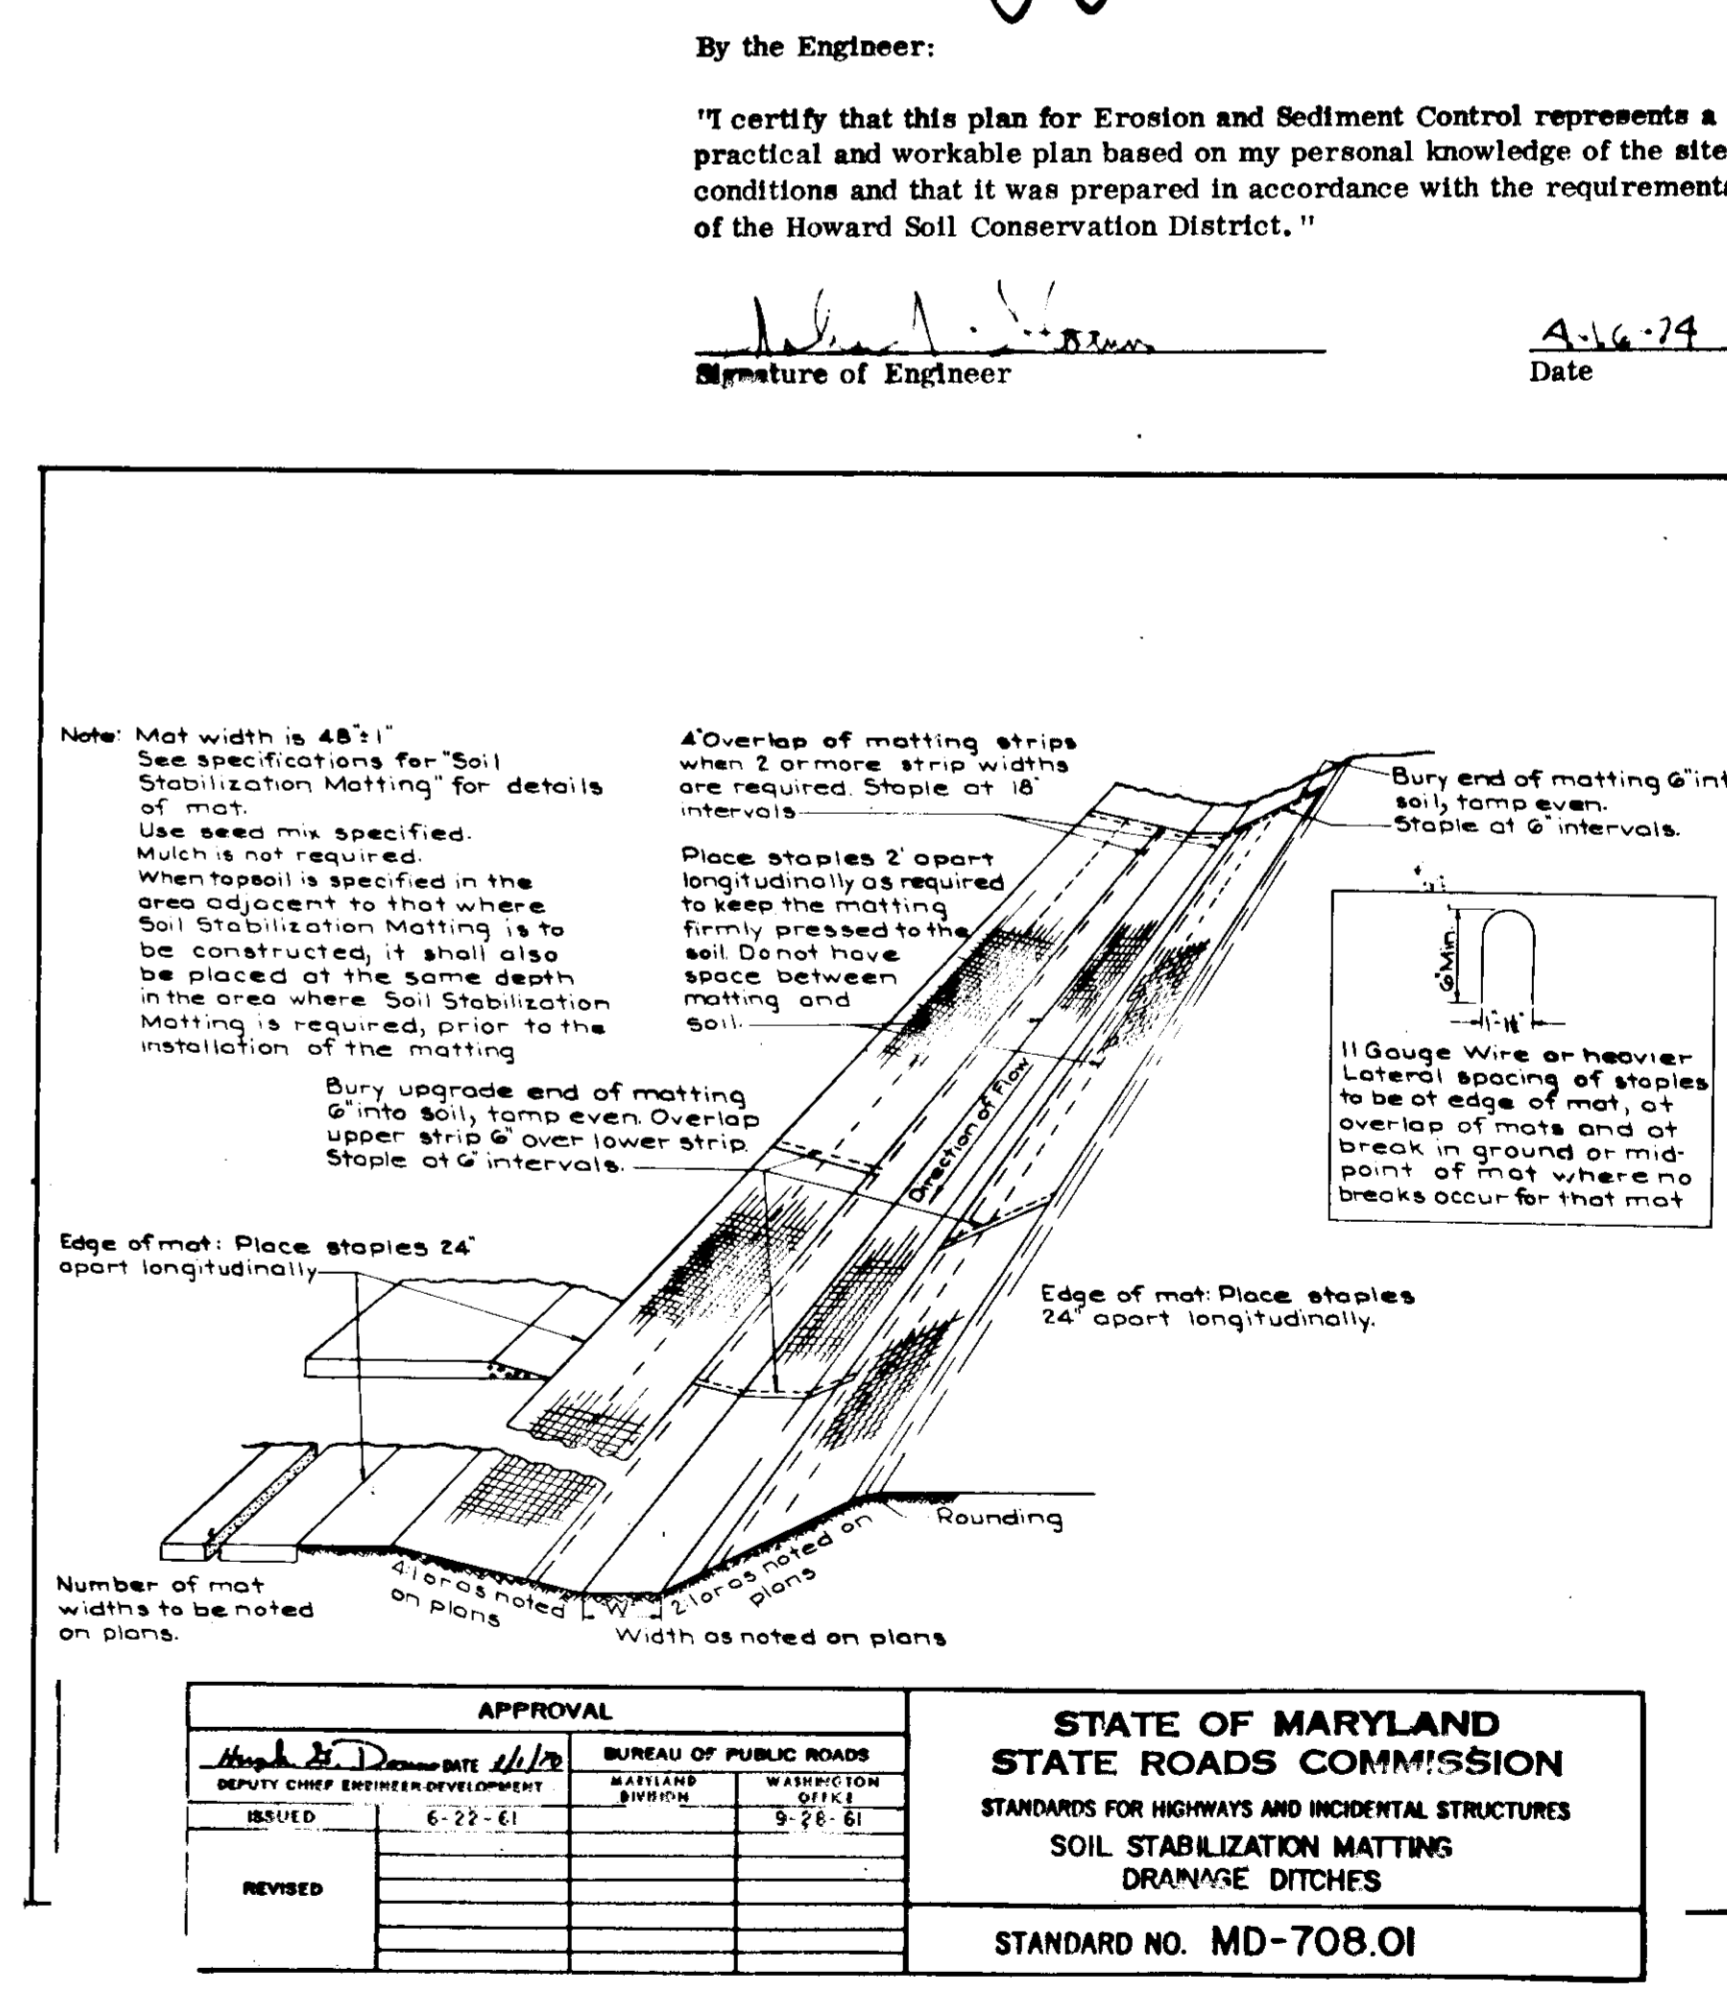

ISSUED FOR BIDDING

APPROVAL

NO.	DESCRIPTION	DATE	BY
1	REVISED IN ACCORDANCE WITH HOWARD COUNTY COMMENTS	7/15/74	M.W.

ISSUED FOR CONSTRUCTION

REVISIONS

AS BUILT DRAWING

AMERICAN INSTRUMENT CO
DIVISION OF TRAVENOL LABORATORIES INC.
HOWARD COUNTY, MD.
ELECTION DISTRICT NO. 6
TAX MAP 47, PARCEL NO. 145

DRAWN F.W.G. DATE 4-12-74
CHECKED L.C.P. JOB No. 736640


DETAILS

ADDITION & ALTERATIONS
PLANT & OFFICE BUILDING
AMINCO
SAVAGE MARYLAND


SHEET 13 OF 16

1. Dowels shall be assembled in a rigid framework of a length equal to a lane width. The expansion joint framework shall provide adequate support to maintain the premolded joint filler in proper horizontal and vertical alignment.
2. The framework shall be strong enough to support a 200 pound concentrated load without deformation or failure.
3. Anchor pins shall be used to secure the framework against any movement along the subgrade.
4. The dowels and supporting framework shall be stable against overturning. Independent of any anchor pins, and upon application of the 200 pound concentrated load they shall not be displaced below their normal position in the pavement slab.
5. The free moving or unanchored end of all dowel bars in both contraction and expansion joints shall be coated, after installation of the device upon the subgrade and immediately prior to the pouring of the concrete, with granite grease applied with a gloved hand. This same end of all expansion joint dowel bars shall be capped with a snap fitting, closed end metal expansion sleeve temporarily secured to the bar so as to provide a 1" long open socket beyond the bar end and to lap back 2" on the bar at the time of installation.


EXPANSION JOINT ONLY:
Dowel bar to minimum length of 20". If bar is not centered, the long side shall be the free end.

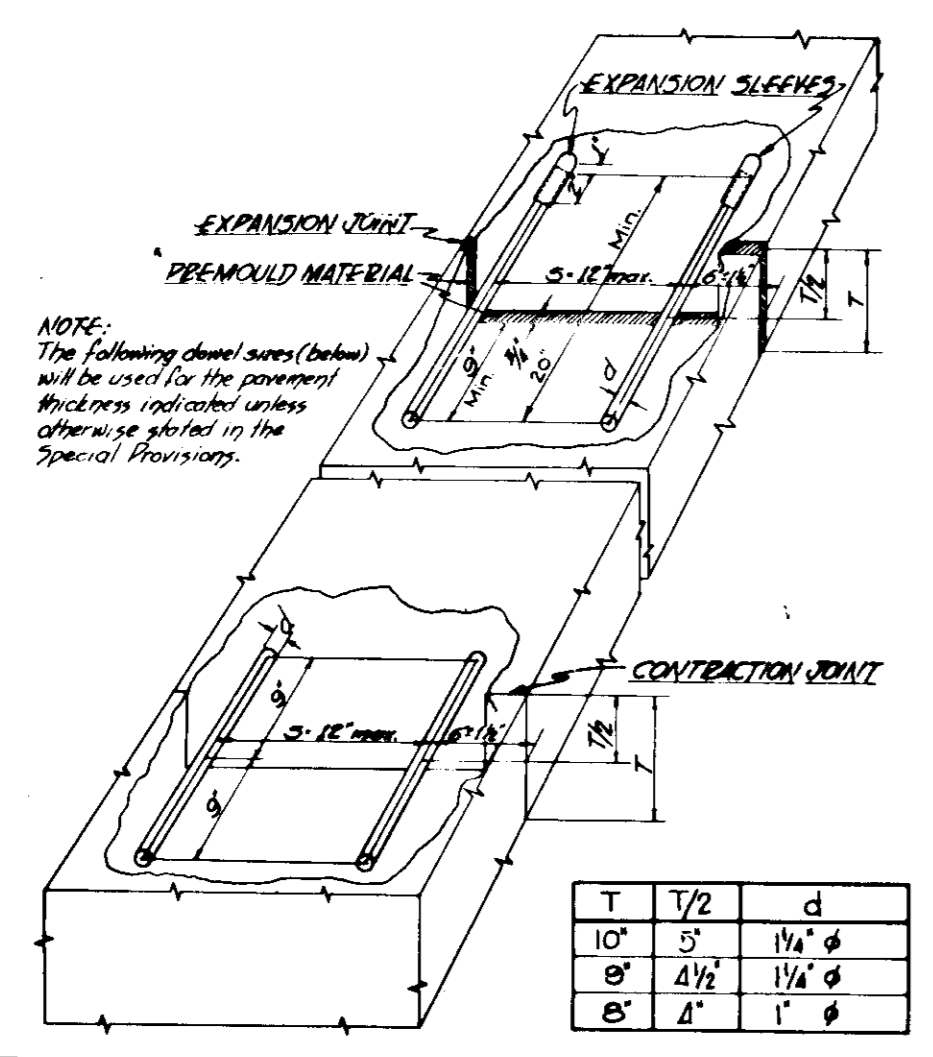

APPROVAL
 HUGH D. DENNIS, DATE 11/17/74, DEPUTY CHIEF ENGINEER DEVELOPMENT
 BUREAU OF PUBLIC ROADS, WASHINGTON OFFICE, 1-10-62
 STATE OF MARYLAND STATE ROADS COMMISSION
 STANDARDS FOR HIGHWAYS AND INCIDENTAL STRUCTURES
 REINFORCED CONCRETE PAVEMENT REQUIREMENTS FOR LOAD TRANSFER DEVICES
 STANDARD NO. MD-572.21

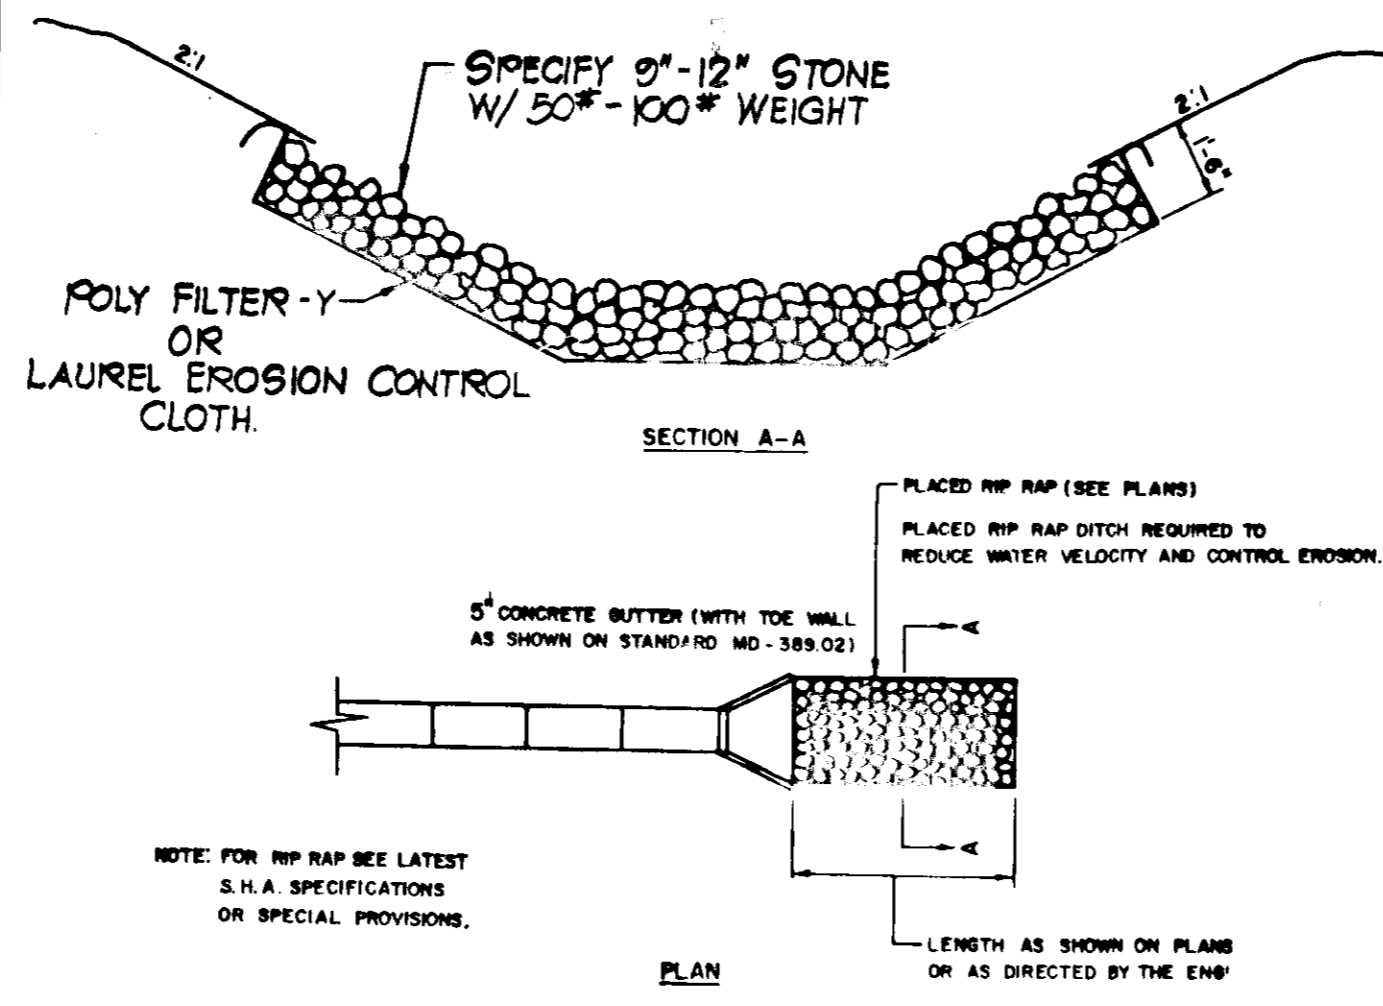

APPROVAL
 HUGH D. DENNIS, DATE 11/16/74, DEPUTY CHIEF ENGINEER DEVELOPMENT
 FEDERAL HIGHWAY ADMINISTRATION, WASHINGTON OFFICE, 11-5-71
 STATE OF MARYLAND DEPARTMENT OF TRANSPORTATION STATE HIGHWAY ADMINISTRATION
 STANDARDS FOR HIGHWAYS AND INCIDENTAL STRUCTURES
 SEDIMENT AND EROSION CONTROL PLACED RIP-RAP DITCH
 STANDARD NO. MD-389.21

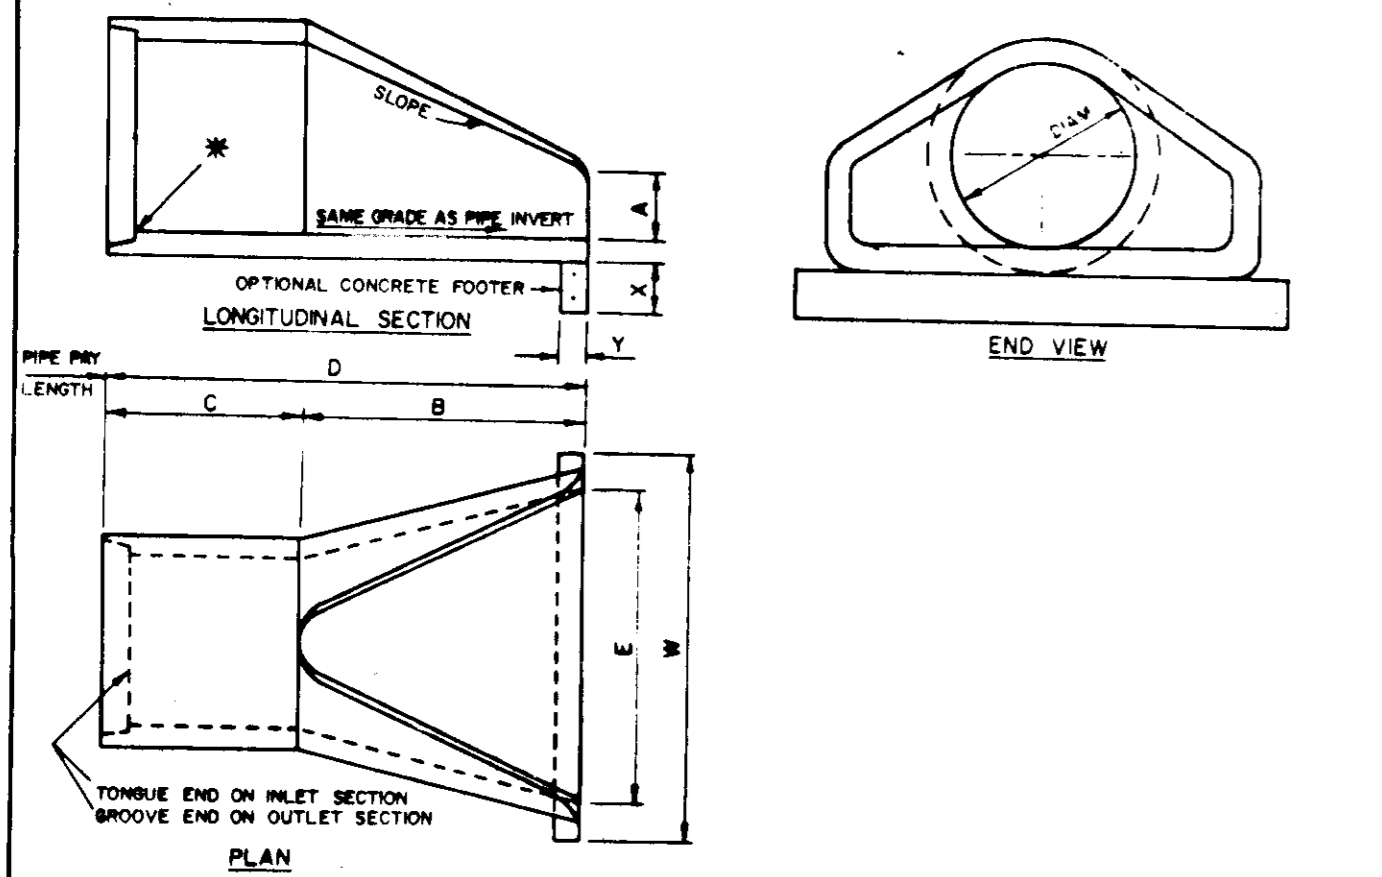


NOTES:
 1. END SECTIONS MUST BE REINFORCED TO CONFORM WITH CLASS OF PIPE.
 2. CONCRETE FOOTER SHALL BE USED WHEN SPECIFIED ON THE PLANS. COST OF CONCRETE FOOTER TO BE PAID PER CUBIC YARD OF CLASS P-1 CONCRETE FOR MISCELLANEOUS STRUCTURES. REINFORCEMENT TO BE NO. 3 BARS.
 3. INVERT ELEVATION TO BE AT THE PIPE END OF THE STANDING END SECTION. ELEVATIONS TO BE NOTED ON CONSTRUCTION PLANS.


NOTE: CONTRACTOR HAS OPTION OF FURNISHING END SECTIONS CONFORMING TO DETAILS ON THIS SHEET OR END SECTIONS CONFORMING TO DETAILS ON STANDARD MD-368.0.

DRAIN	CONCRETE END SECTION					CONCRETE FOOTER				
	DIAM	SLOPE	A	B	C	D	E	W	X	Y
12"	3:1	4"	2'-0"	4'-0"	5'-0"	2'-0"	3'-0"	12"	5"	
15"	3:1	6"	2'-3"	3'-0"	6'-1"	2'-6"	3'-6"	12"	9"	
18"	3:1	9"	2'-3"	3'-0"	6'-1"	3'-0"	4'-0"	12"	9"	
24"	3:1	9"	3'-0"	3'-1 1/2"	6'-1 1/2"	3'-6"	4'-6"	12"	9"	
27"	3:1	10 1/2"	3'-1 1/2"	2'-6"	6'-1 1/2"	4'-0"	5'-0"	15"	9"	
30"	3:1	10 1/2"	4'-0"	2'-6"	6'-1 1/2"	4'-6"	5'-6"	15"	9"	
36"	3:1	11-3"	5'-3"	2'-6"	6'-1 1/2"	6'-0"	6'-0"	15"	9"	
42"	3:1	11-3"	5'-3"	2'-6"	6'-1 1/2"	6'-0"	7'-3"	15"	9"	
48"	3:1	2'-0"	6'-0"	2'-3"	6'-2 1/2"	7'-0"	8'-6"	18"	12"	
54"	2-1/2:1	2'-3"	5'-5"	2'-3"	6'-2 1/2"	7'-6"	9'-0"	18"	12"	

APPROVAL
 HUGH D. DENNIS, DATE 8/11/74, DEPUTY CHIEF ENGINEER DEVELOPMENT
 BUREAU OF PUBLIC ROADS, WASHINGTON OFFICE, 7-7-67
 STATE OF MARYLAND STATE ROADS COMMISSION
 STANDARDS FOR HIGHWAYS AND INCIDENTAL STRUCTURES
 STANDARD CONCRETE END SECTION ROUND CONCRETE PIPE
 STANDARD NO. MD-368.02

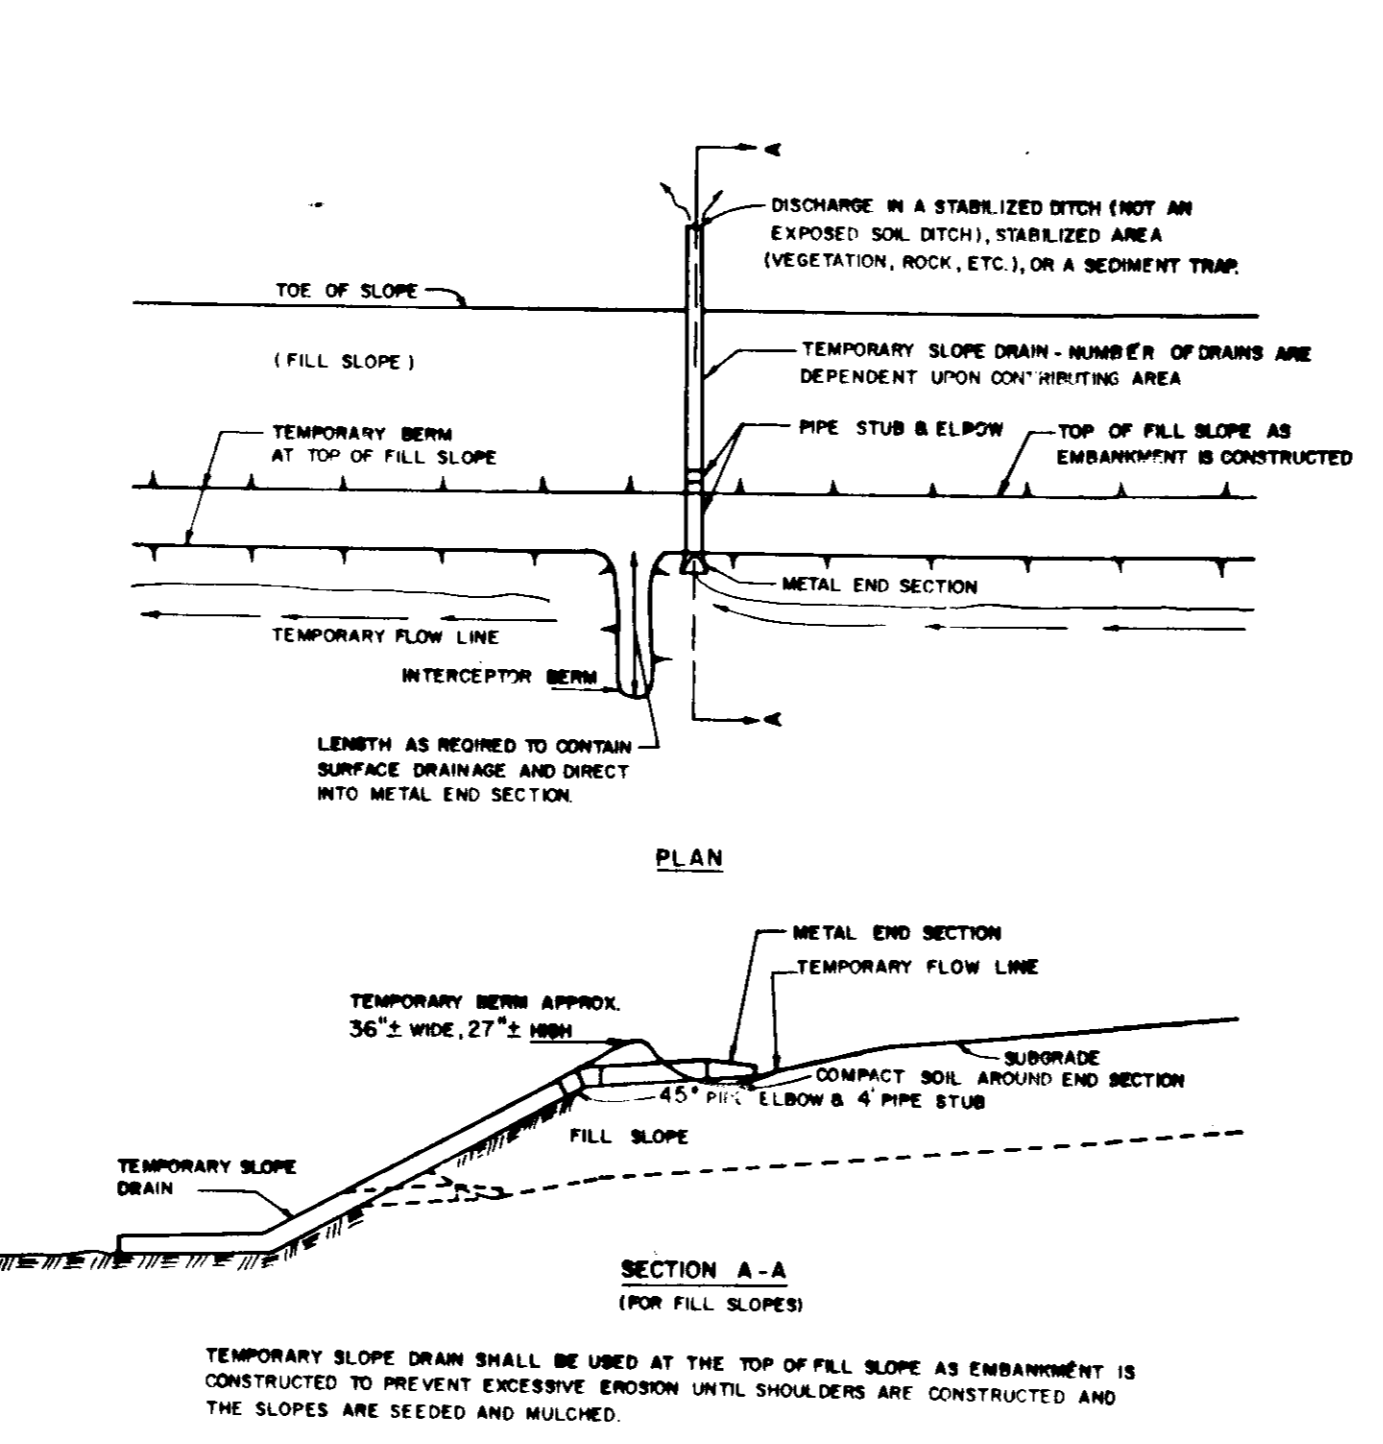

APPROVAL
 HUGH D. DENNIS, DATE 11/16/74, DEPUTY CHIEF ENGINEER DEVELOPMENT
 FEDERAL HIGHWAY ADMINISTRATION, WASHINGTON OFFICE, 11-5-71
 STATE OF MARYLAND DEPARTMENT OF TRANSPORTATION STATE HIGHWAY ADMINISTRATION
 STANDARDS FOR HIGHWAYS AND INCIDENTAL STRUCTURES
 SEDIMENT AND EROSION CONTROL TEMPORARY SLOPE DRAIN
 STANDARD NO. MD-388.02

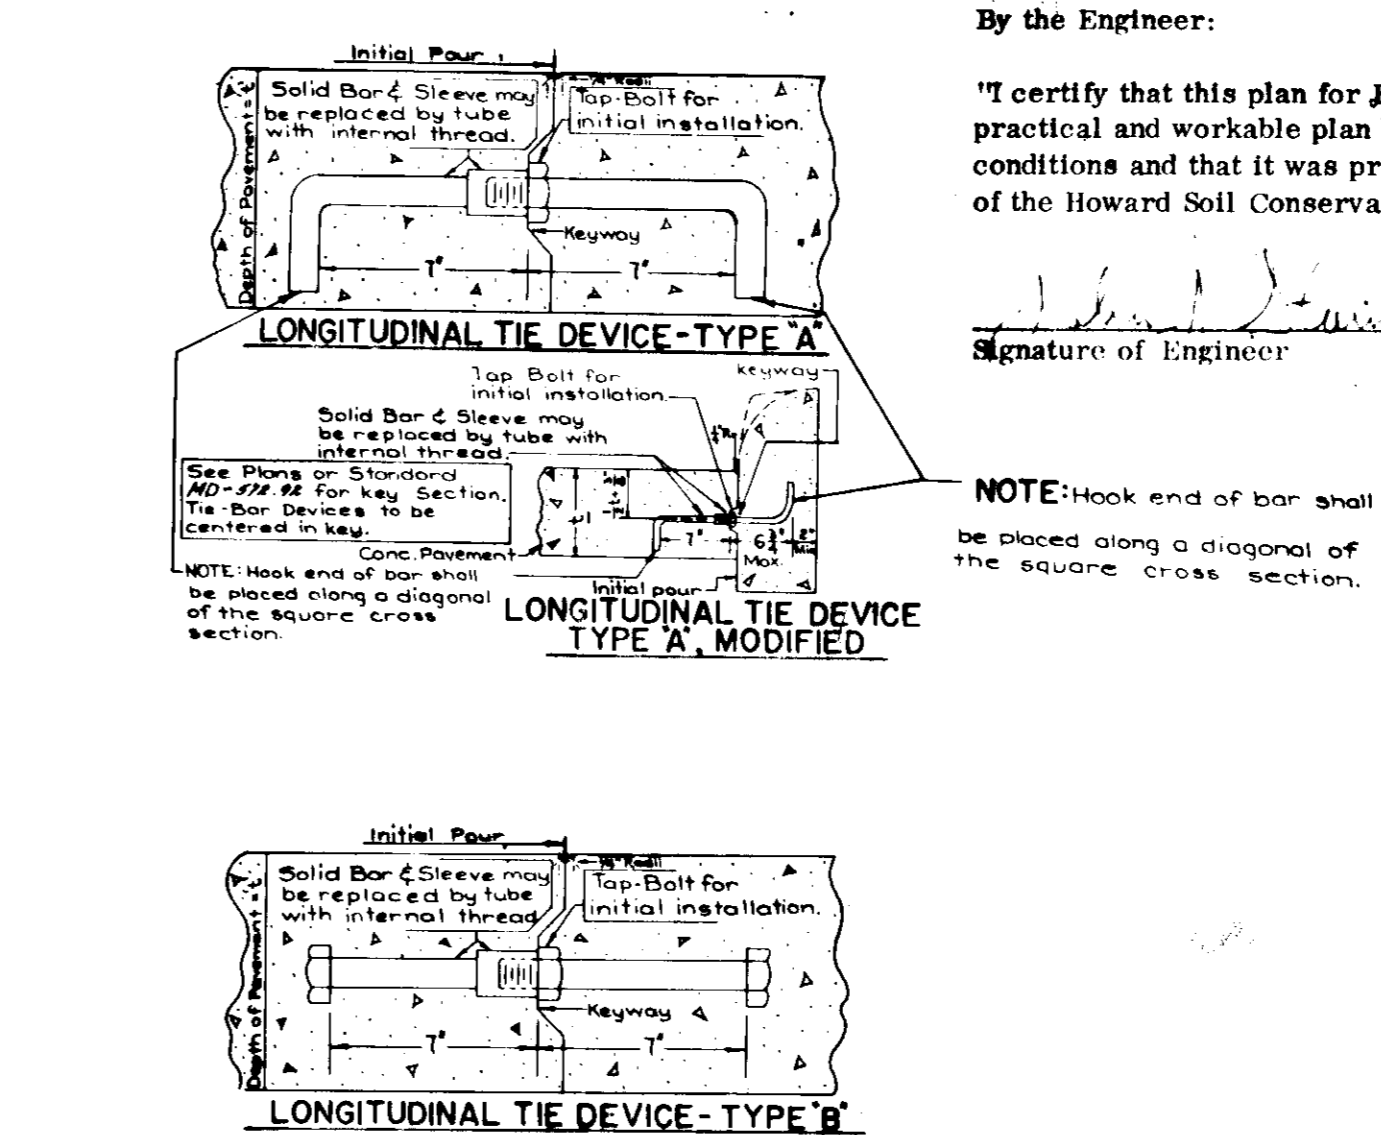

APPROVAL
 HUGH D. DENNIS, DATE 11/17, DEPUTY CHIEF ENGINEER DEVELOPMENT
 BUREAU OF PUBLIC ROADS, WASHINGTON OFFICE, 7-21-65
 STATE OF MARYLAND STATE ROADS COMMISSION
 STANDARDS FOR HIGHWAYS AND INCIDENTAL STRUCTURES
 REINFORCED CONCRETE PAVEMENT LONGITUDINAL TIE DEVICES
 STANDARD NO. MD-572.61

APPROVED FOR PUBLIC WATER AND PUBLIC SEWERAGE SYSTEMS, HOWARD COUNTY HEALTH DEPARTMENT
 COUNTY HEALTH OFFICER
 DATE 10/8/74

APPROVED: HOWARD COUNTY OFFICE OF PLANNING AND ZONING
 PLANNING DIRECTOR
 THOMAS G. HAMM, JR., DATE 10-8-74
 CHIEF, DIVISION OF LAND DEVELOPMENT AND TRANSPORTATION PLANNING
 DATE 10/8/74

APPROVED: FOR PUBLIC WATER, PUBLIC SEWERAGE AND STORM DRAINAGE SYSTEMS AND ROADS
 HOWARD COUNTY DEPARTMENT OF PUBLIC WORKS
 DIRECTOR
 WILSON A. UTTIN, DATE 10/4/74
 CHIEF, BUREAU OF HIGHWAYS
 G. W. MEHLAND, DATE 10/4/74

Reviewed for: Howard S. C. D. NAME and meets Technical Requirements
 Signature: Howard S. C. D. Date: 9-30-74
 S. Soil Conservation Service

THIS DEVELOPMENT PLAN IS APPROVED FOR SOIL EROSION AND SEDIMENT CONTROL BY THE HOWARD SOIL CONSERVATION DISTRICT
 Approved: Robert W. Zielman, Date 9-30-74
 Howard S. C. D.

By the Developer:
 "I certify that all development and/or construction will be done according to this plan of development and plan for Erosion and Sediment Control, and I also authorize periodic on-site inspection by the Howard Soil Conservation District or their authorized agents, as are deemed necessary. Deviation from this plan will not be made unless authorized by the Howard Soil Conservation District."
 Signature of Developer: Jan Paul Godylak, Date 9-16-74

By the Engineer:
 "I certify that this plan for Erosion and Sediment Control represents a practical and workable plan based on my personal knowledge of the site conditions and that it was prepared in accordance with the requirements of the Howard Soil Conservation District."
 Signature of Engineer: J. H. Lawson, Date 1-16-74

ISSUED FOR BIDDING
 ADDENDA REVISIONS
 ISSUED FOR CONSTRUCTION
 REVISIONS

NO.	DESCRIPTION	DATE	BY
1	REVISED IN ACCORDANCE WITH HOWARD COUNTY COMMENTS	7/15/74	MW
2	REVISED IN ACCORDANCE WITH HOWARD COUNTY COMMENTS	9/5/74	MW


AS BUILT DRAWINGS

9/17/74
 J. H. Lawson / PR

AMERICAN INSTRUMENT CO. DIVISION OF TRAVENOL LABORATORIES INC. HOWARD COUNTY MD. ELECTION DISTRICT NO. 6 TAX MAP 47, PARCEL NO. 145

DRAWN F.W.G. DATE 4-12-74
 CHECKED L.C.P. JOB No. 736640


DETAILS
 ADDITION & ALTERATIONS PLANT & OFFICE BUILDING
 AMINCO
 SAVAGE MARYLAND

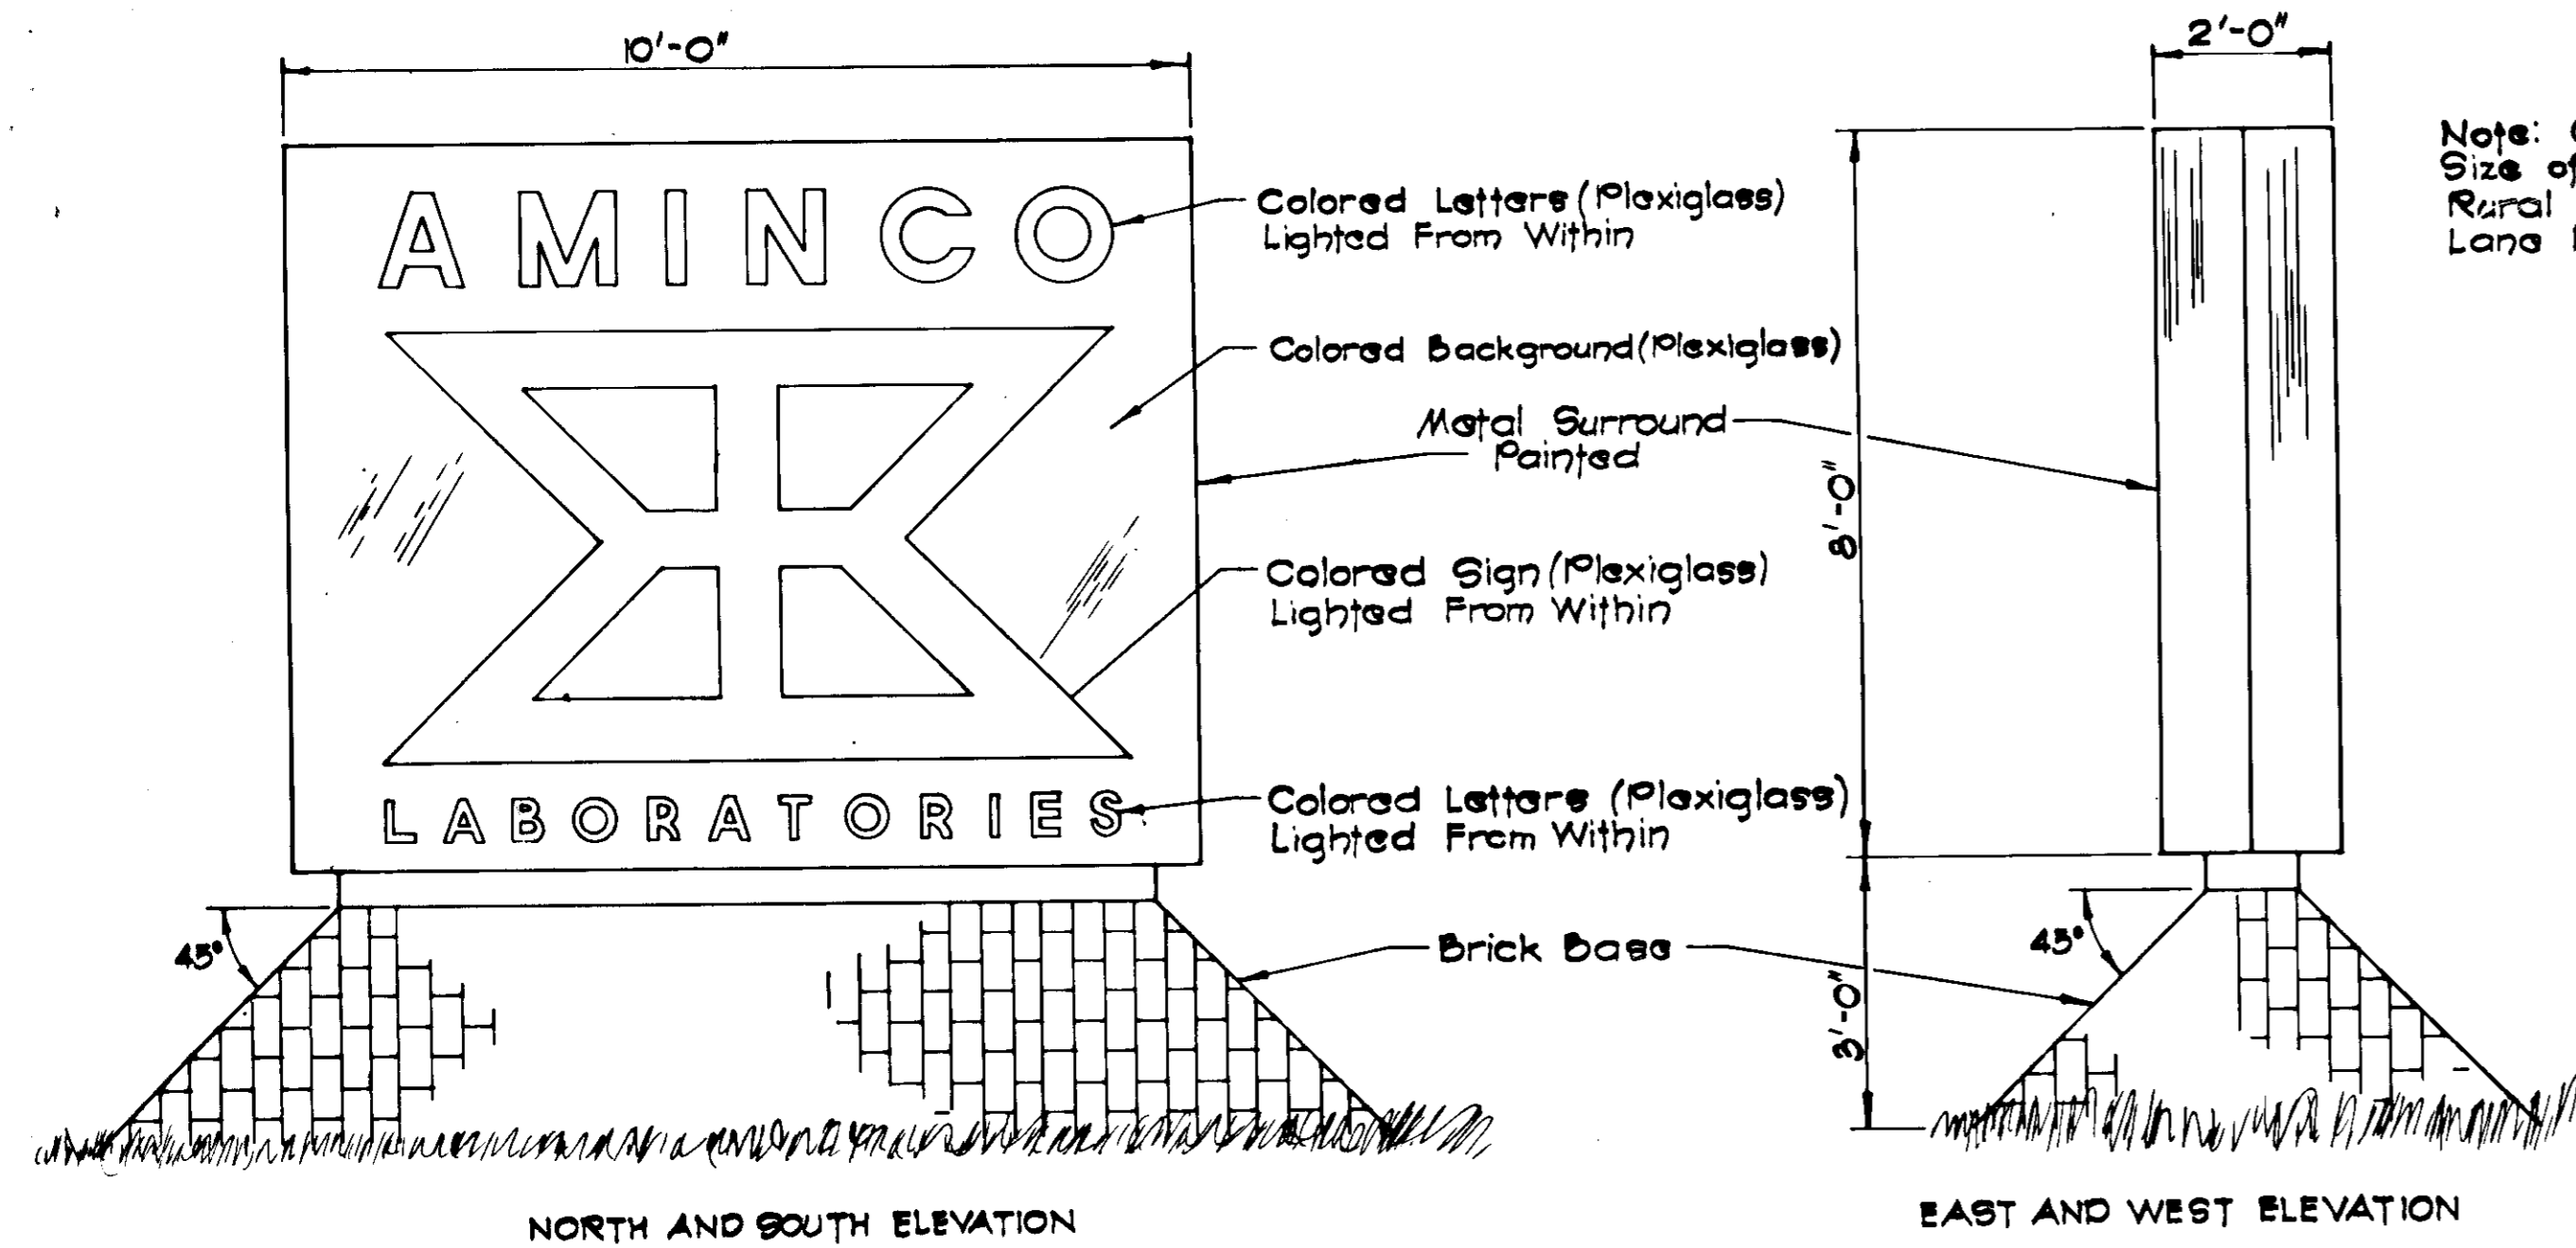

Note: 65 Sq. Ft. Best Recommended Size of Sign on Basis of Industrial, Rural Surroundings, Seen from a 4' Lane Highway at 45 M.P.H.

SIGN DETAIL
Scale: 1/2" = 1'-0"

RETAINING WALL SCHEDULE												
h	a	b	c	d	e	f	g	k	l	m	n	p
2'-6" TO 3'-11"	1'-0"	0'-6"	1'-0"	2'-6"	#4@18"	#4@12"	#3@18"	#3@12"	#4@18"	#3@12"	#4@18"	#3@12"
4'-0" TO 5'-11"	1'-0"	1'-0"	1'-8"	3'-8"	#4@18"	#4@12"	#3@18"	#4@12"	#4@18"	#4@12"	#4@18"	#4@12"
6'-0" TO 7'-11"	1'-0"	1'-3"	2'-3"	4'-6"	#4@12"	#4@12"	#4@18"	#4@12"	#4@12"	#4@12"	#4@12"	#4@12"

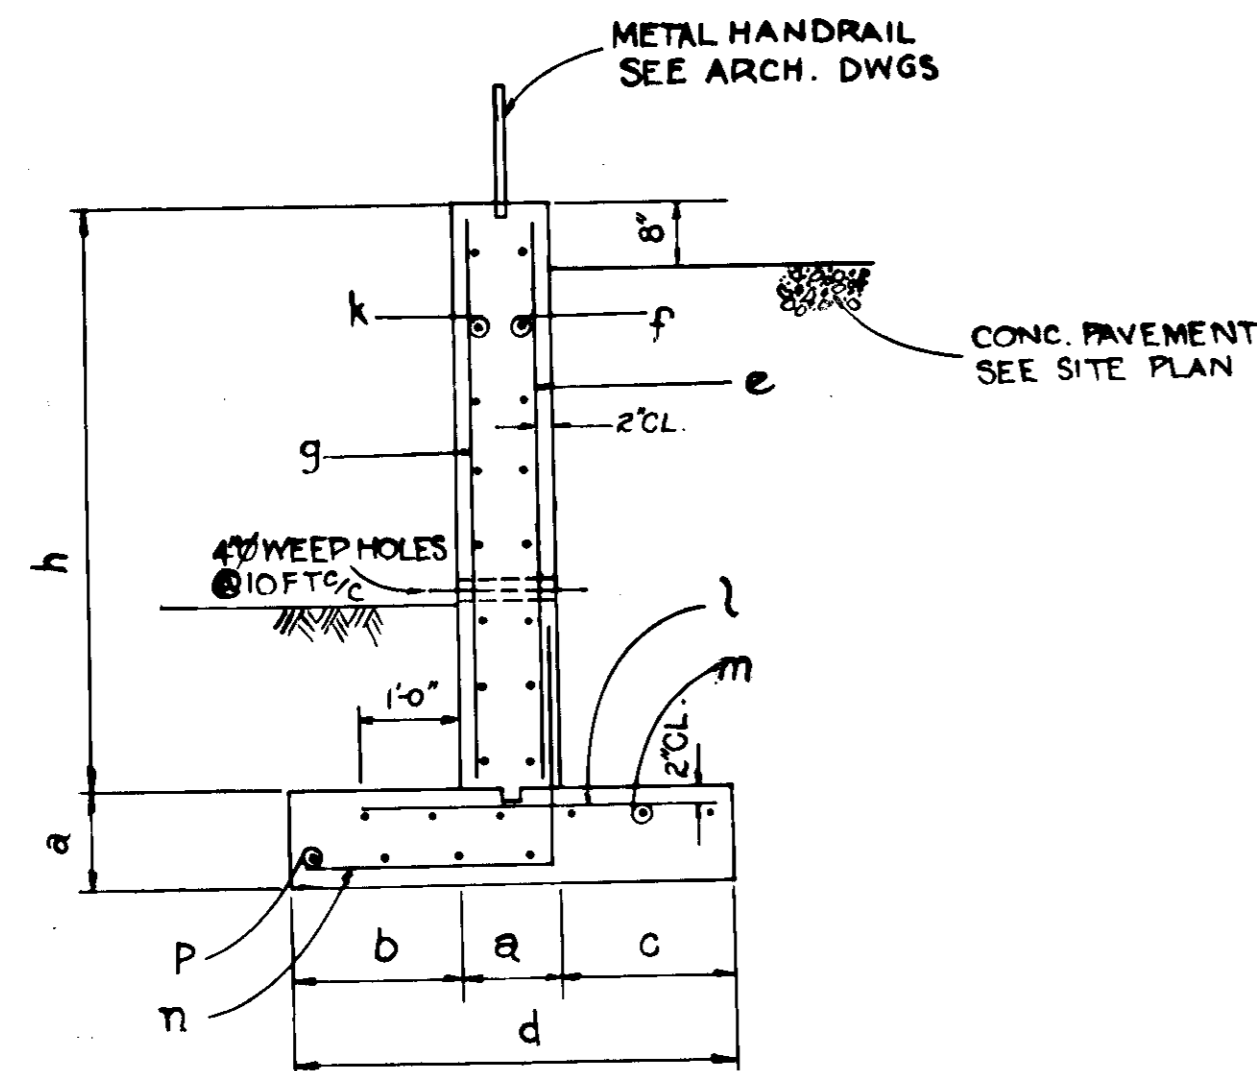


SECTION TYPICAL RETAINING WALL
NOT TO SCALE

- PROVIDE CONTRACTION JOINTS EVERY 20' MAX.
- PROVIDE CONSTRUCTION JOINTS EVERY 60' MAX.

SEDIMENT CONTROL & STORM WATER DETENTION BASIN NOTES

- Contractor shall construct and maintain storm water detention basin as a first order of work. The basin shall serve as a sediment control structure during construction.
- Sediment shall be removed when in excess of 2 ft. depth and placed at a suitable site.
- Offsite borrow and spoil areas shall be approved by the Howard Soil Conservation District.
- Compaction shall be achieved by placing fill in 8" lifts and compacted to 95 percent standard proctor.
- Construction shall conform to S.C.S. Maryland Standards and Specifications Code 378, revised June 27, 1972.
- Detention Basin shall be stabilized according to notes on Shi. 6.
- Riser shall be 30" dia. BCCMP with 1/2" dia. holes spaced 4" vert. & 4" horz.
- Anti-Vortex Device- This device shall be a thin vertical plate BCCMP normal to the centerline of the embankment and bolted or welded to the top of the riser. The plate dimensions are length-42" height-21".
- Contractor shall convert sediment basin into a storm water retention basin after completion of construction and all soil stabilization by:
 - Cleaning out sediment from all culvert pipes, basin bottom, and 21" dia. pipe spillway.
 - Removing 30" riser pipe and anti-vortex plate.
 - Resurfacing or replacing 4' x 4' concrete inlet pad.
 - Restabilizing any disturbed areas of storm water retention basin.
- Owner will submit one set of as built plans to the Howard S.C.D. upon completion of work.

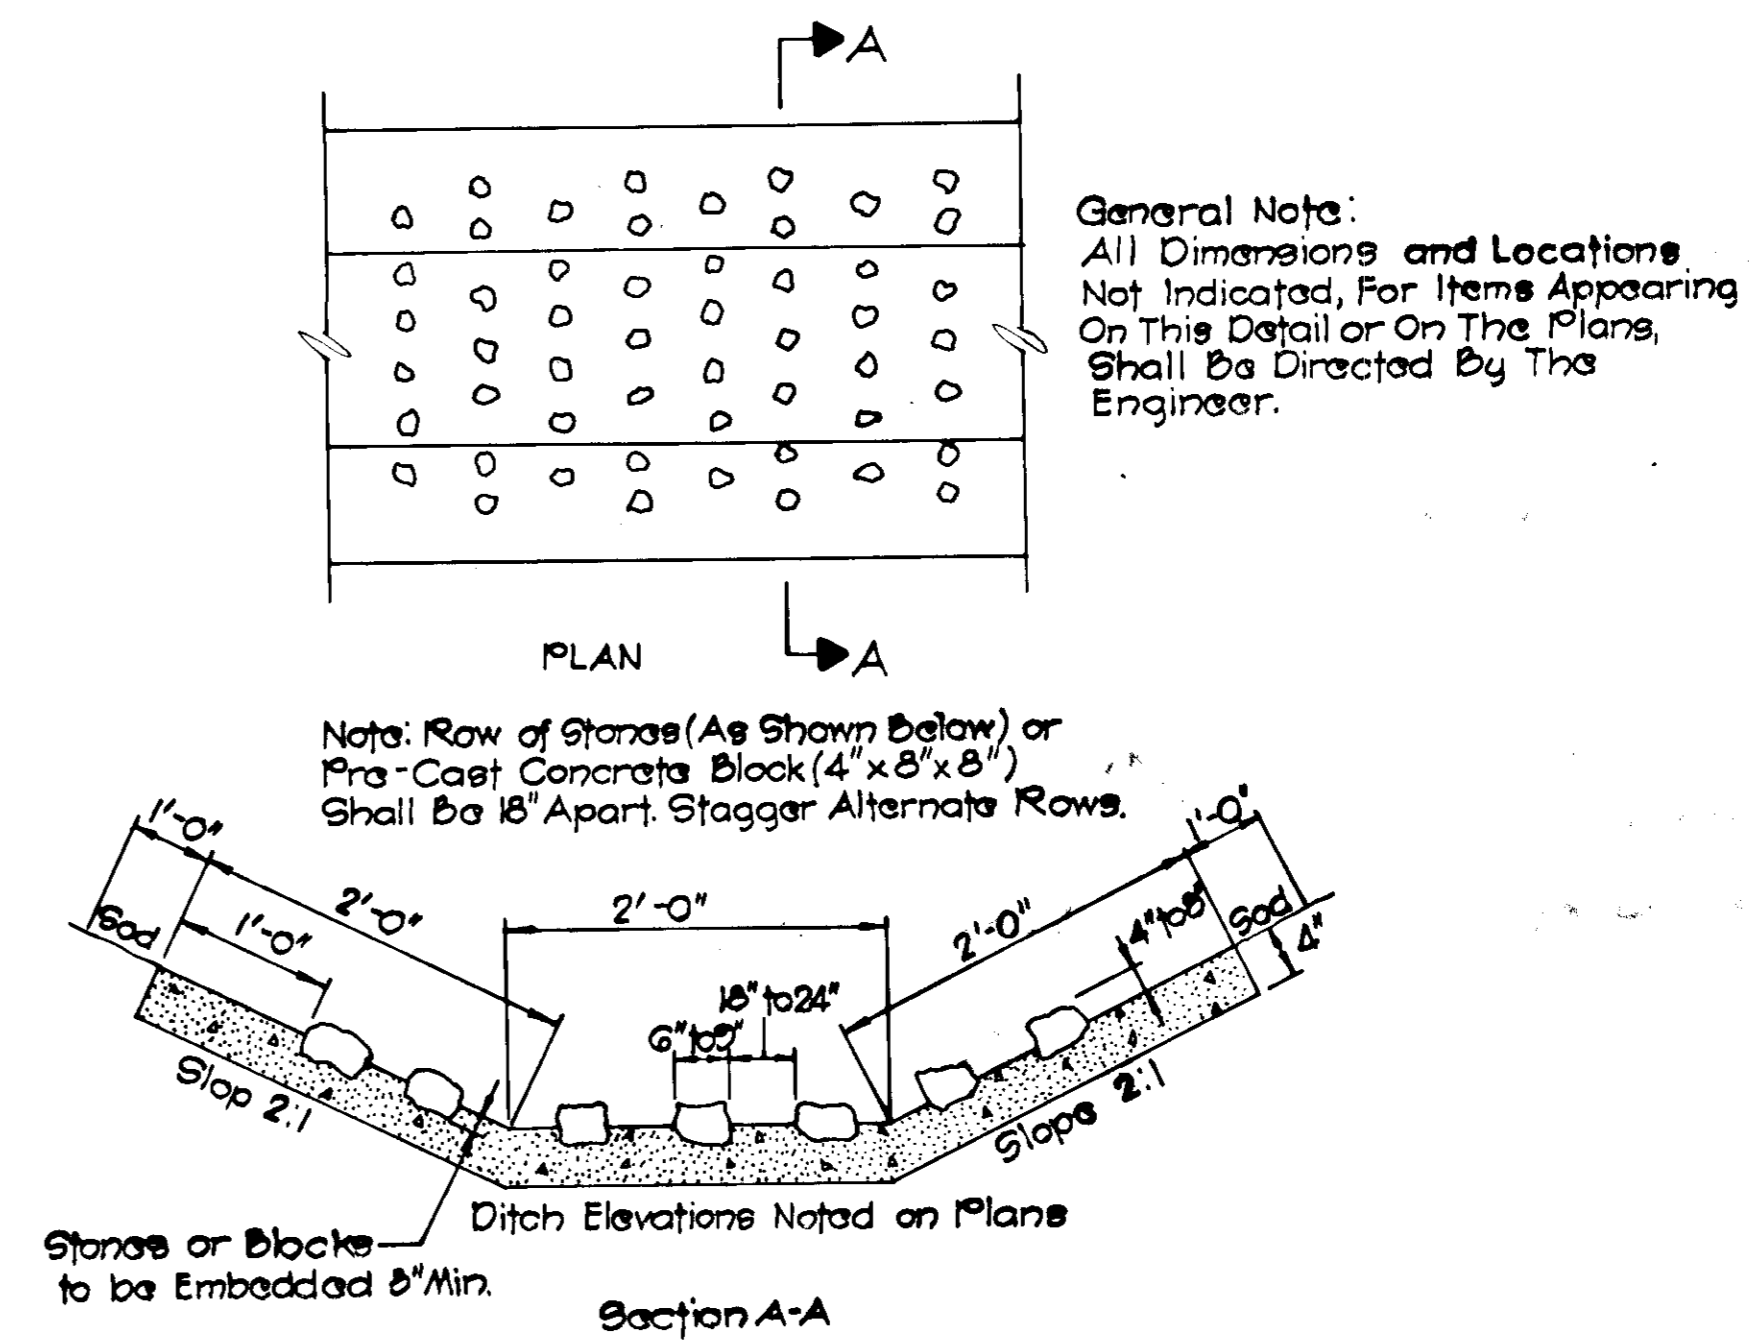

TYPICAL DETAIL 4' CONCRETE ENERGY DISSIPATING GUTTER
Not To Scale

APPROVED: FOR PUBLIC WATER AND PUBLIC SEWERAGE SYSTEMS, HOWARD COUNTY HEALTH DEPARTMENT
 COUNTY HEALTH OFFICER
 DATE 10/8/74

APPROVED: HOWARD COUNTY OFFICE OF PLANNING AND ZONING
 PLANNING DIRECTOR
 DATE 10-8-74

CHIEF, DIVISION OF LAND DEVELOPMENT AND TRANSPORTATION PLANNING
 DATE 10/8/74

APPROVED: FOR PUBLIC WATER, PUBLIC SEWERAGE AND STORM DRAINAGE SYSTEMS AND ROADS
 HOWARD COUNTY DEPARTMENT OF PUBLIC WORKS
 DIRECTOR
 DATE 10/8/74

CHIEF, BUREAU OF HIGHWAYS
 DATE 10/8/74

Reviewed for Howard S.C.D.
 NAME
 and meets Technical Requirements
 Signature
 U. S. Soil Conservation Service
 Date 9-30-74

THIS PLAN FOR SMALL POND CONSTRUCTION MEETS THE REQUIREMENTS OF THE HOWARD SOIL CONSERVATION DISTRICT
 Approved: Robert Ziehm Howard S.C.D. Date 9-30-74
 Plan Number SDP-24-100

THIS PLAN HAS BEEN REVIEWED FOR THE HOWARD SOIL CONSERVATION DISTRICT AND MEETS THE TECHNICAL REQUIREMENTS FOR SMALL POND CONSTRUCTION.

Approved: James M. Nolan U. S. Soil Conservation Service Date 9-30-74

OWNER'S CERTIFICATION FOR POND CONSTRUCTION

I certify that the development and construction of this pond will be done according to this plan. I also authorize periodic on-site evaluation by the Howard Soil Conservation District or its authorized agents as deemed necessary. Deviation from this plan will not be made unless authorized in writing by the Howard Soil Conservation District.

Signature: James Badisiek Date: 10/17/74

THIS DEVELOPMENT PLAN IS APPROVED FOR SOIL EROSION AND SEDIMENT CONTROL BY THE HOWARD SOIL CONSERVATION DISTRICT
 Approved: Robert Ziehm Howard S.C.D. Date 9-30-74

By the Developer:

"I certify that all development and/or construction will be done according to this plan of development and plan for Erosion and Sediment Control, and I also authorize periodic on-site inspection by the Howard Soil Conservation District or their authorized agents, as are deemed necessary." Deviation from this plan will not be made unless authorized by the Howard Soil Conservation District.



Signature of Developer: James M. Nolan Date: 9-30-74

By the Engineer:

"I certify that this plan for Erosion and Sediment Control represents a practical and workable plan based on my personal knowledge of the site conditions and that it was prepared in accordance with the requirements of the Howard Soil Conservation District."

Signature of Engineer: James M. Nolan Date: 7-16-74


ISSUED FOR BIDDING		DATE	BY
ADDENDA REVISIONS			
ADDENDA NO.	ADDENDA DATE	BY	
ISSUED FOR CONSTRUCTION			
REVISIONS			
NO.	DESCRIPTION	DATE	BY
1	REVISED IN ACCORDANCE WITH HOWARD COUNTY COMMENTS	9/15/74	M.J.W.
AS BUILT DRAWINGS			
AMERICAN INSTRUMENT CO. DIVISION OF TRAVENOL LABORATORIES INC. HOWARD COUNTY, MD. ELECTION DISTRICT NO. 6 TAX MAP 47, PARCEL NO 145			
SECTION SYMBOL			
DRAWN M.J.W. DATE 7-15-74			
CHECKED J.J.S. JOB NO. 732640			
DETAILS			
ADDITION & ALTERATIONS PLANT & OFFICE BUILDING AMINCO SAVAGE, MARYLAND			
SHEET 15 OF 16			

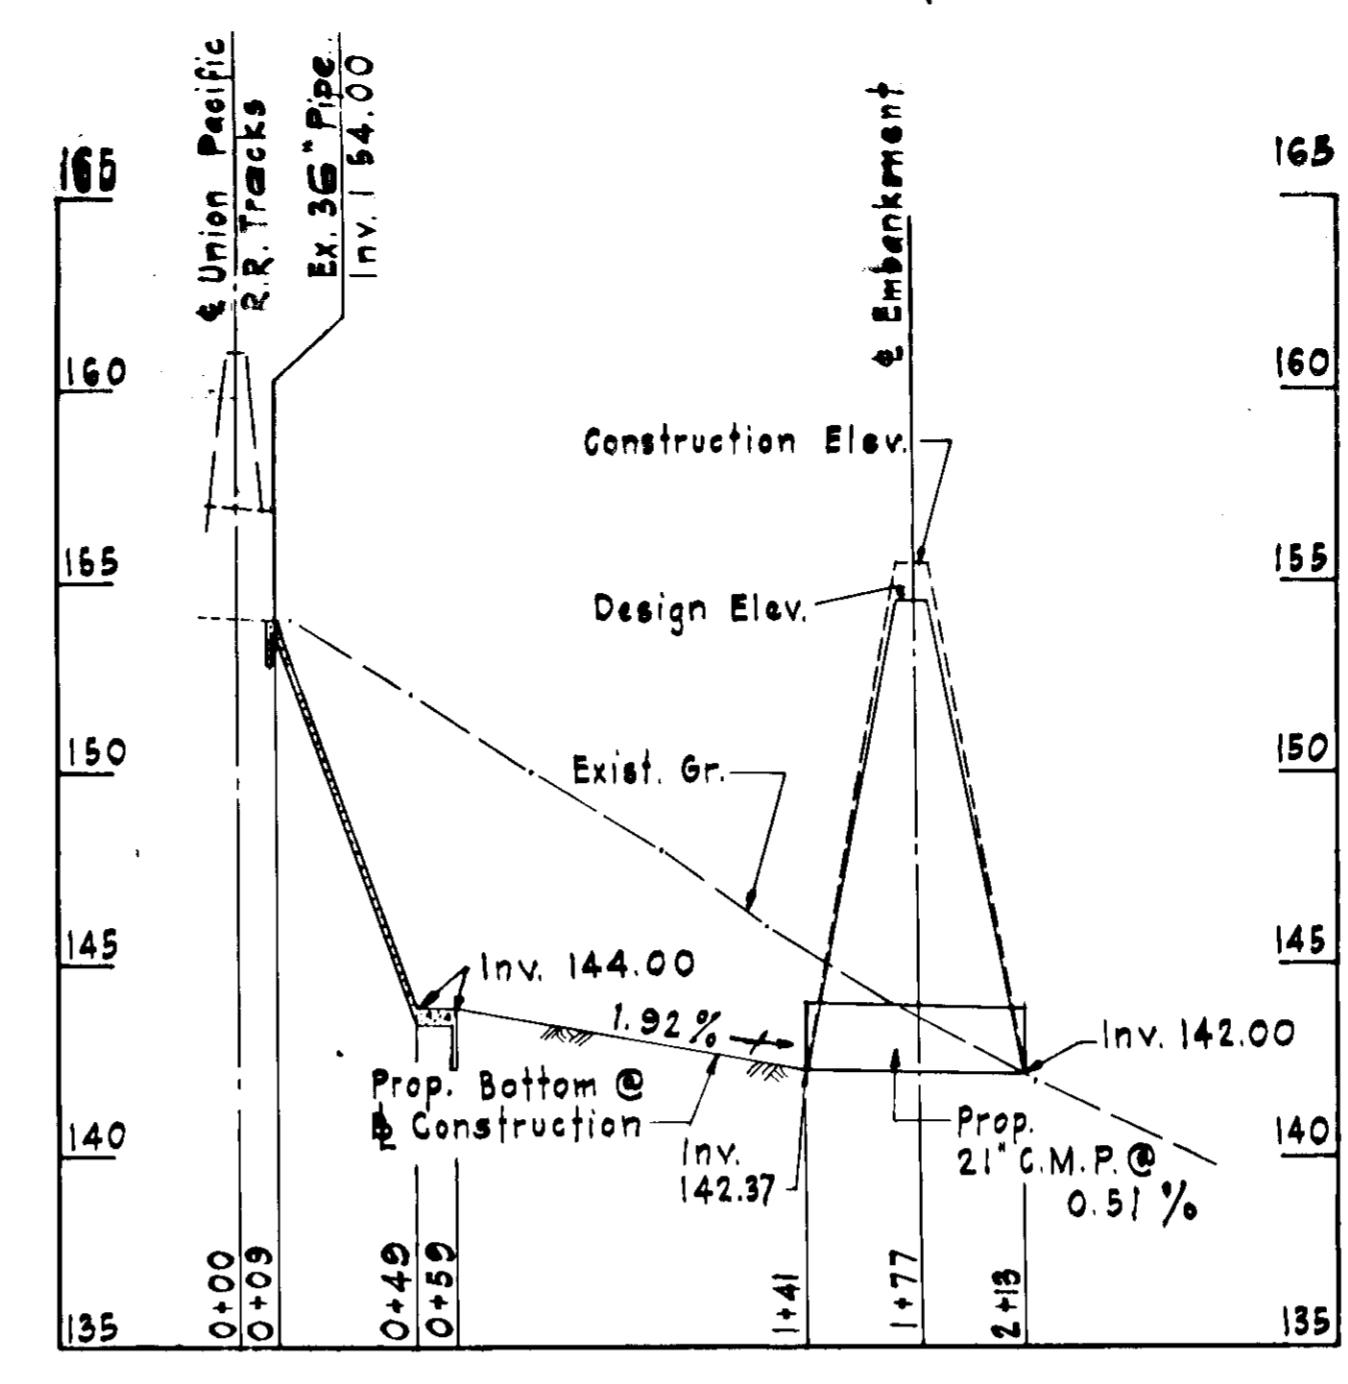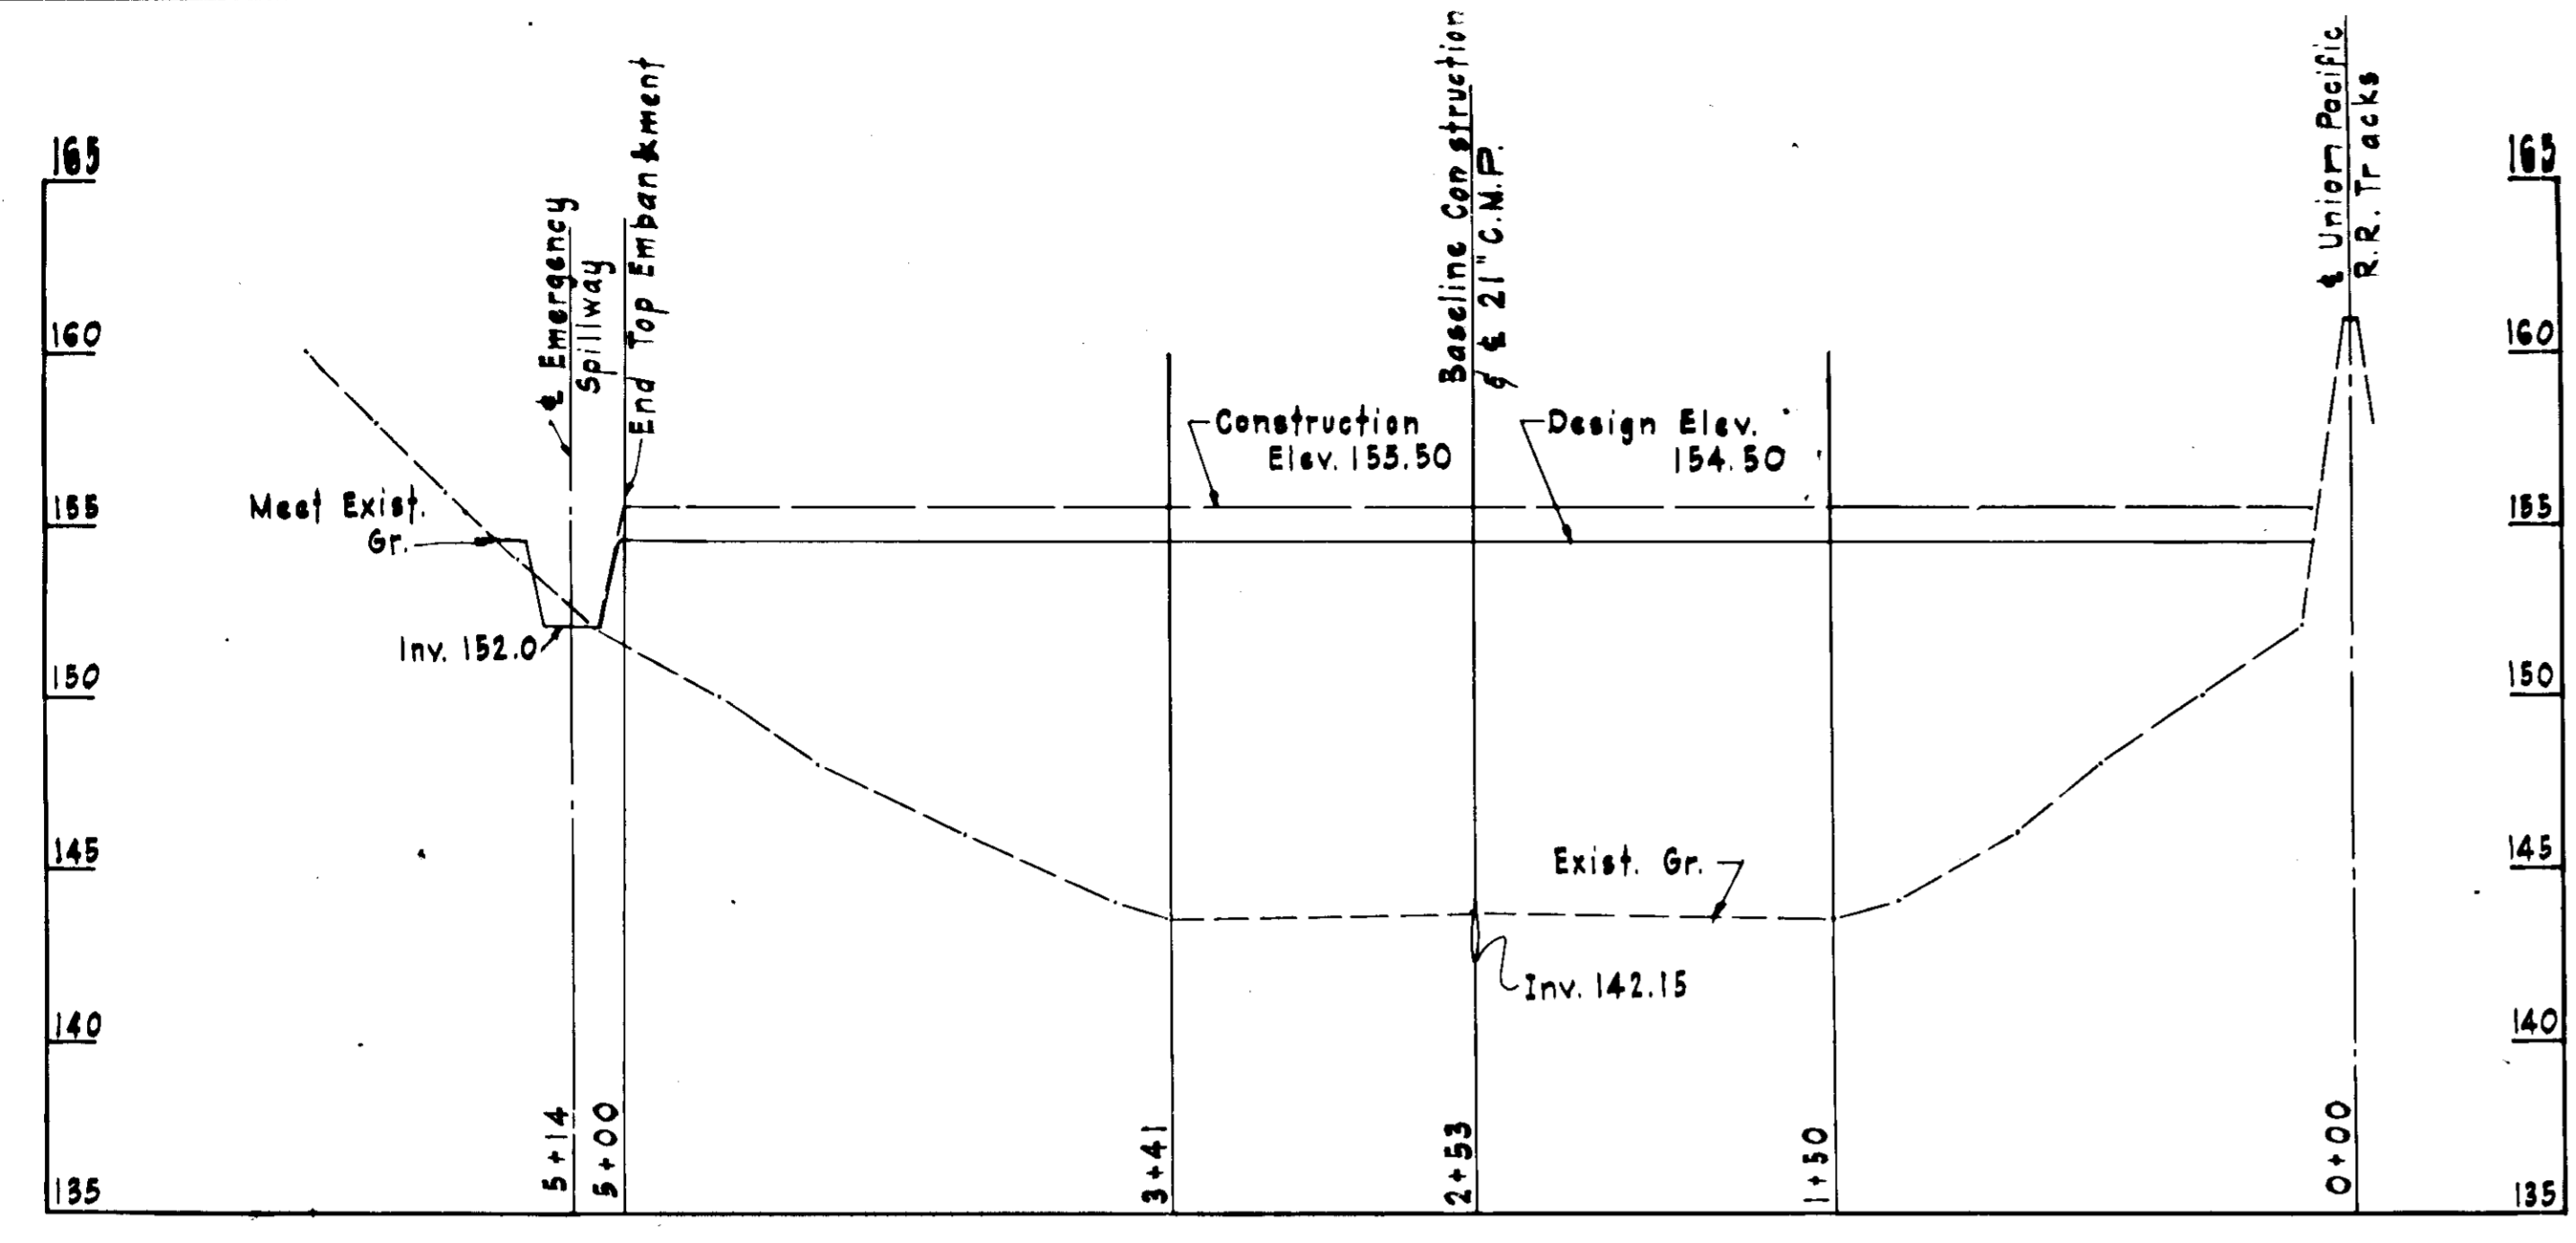


PROFILE - TOP EMBANKMENT
SCALE: HORIZ. 1" = 50' VERT. 1" = 5'

PROFILE - BASELINE CONSTRUCTION
SCALE: HORIZ. 1" = 50' VERT. 1" = 5'


NOTE: Riser shall be attached with a watertight connection. Riser shall be removed upon completion of construction & stabilization of site. Compacted earth to be stabilized by seeding & mulching & anchored with a plastic net.

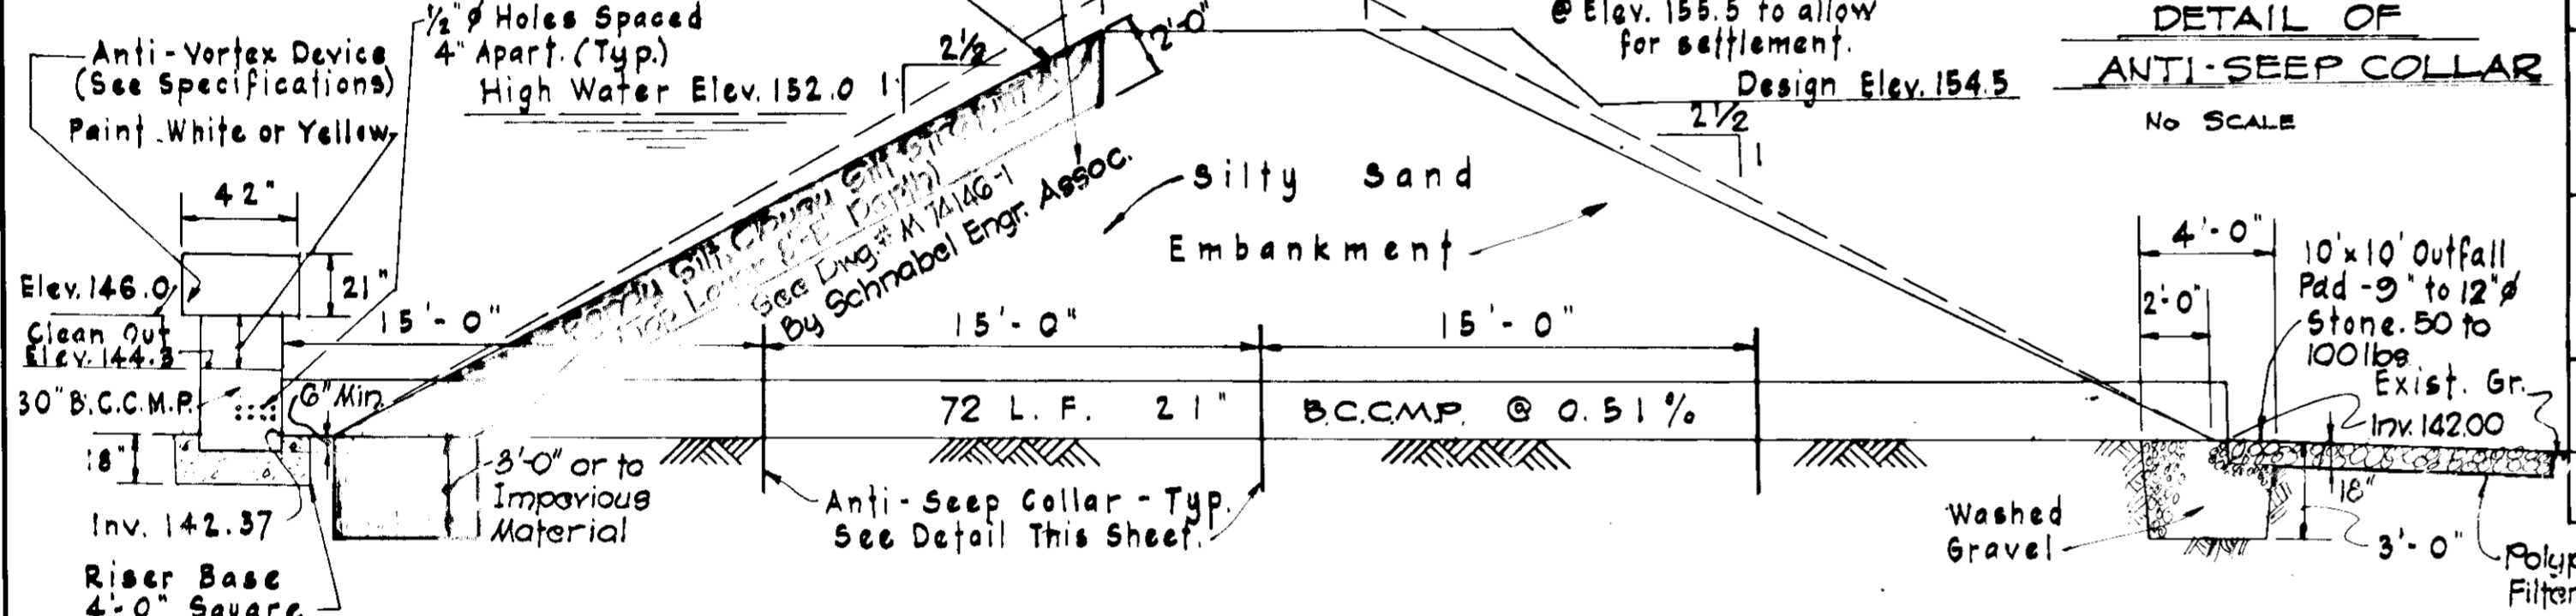


TYPICAL SECTION - EMBANKMENT
SCALE: 1" = 5'-0"

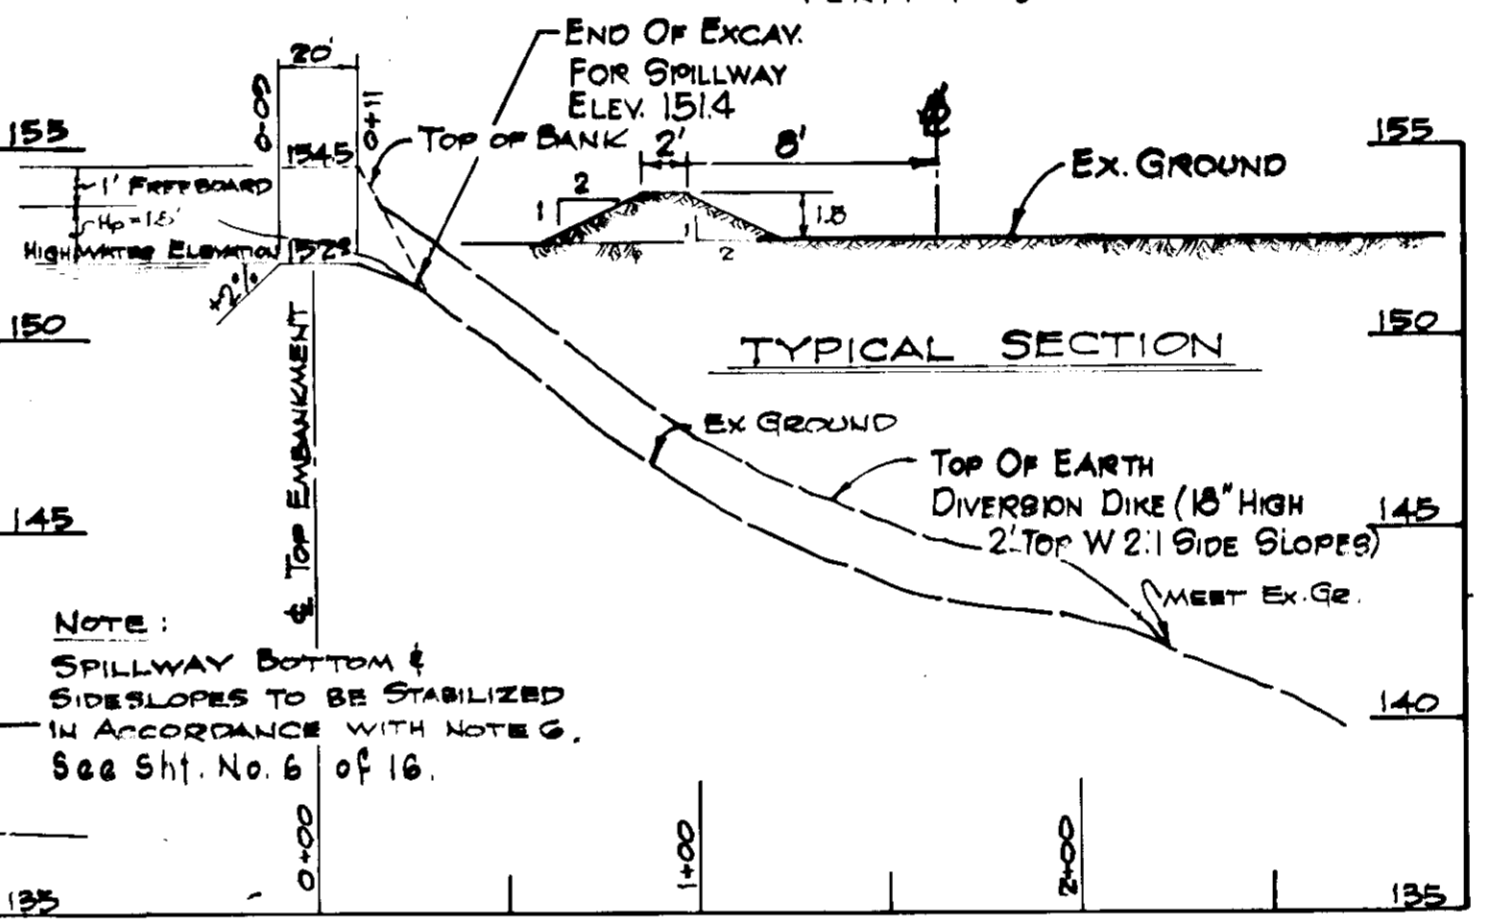


PROFILE - EMERGENCY SPILLWAY
SCALE: HORIZ. 1" = 50' VERT. 1" = 5'

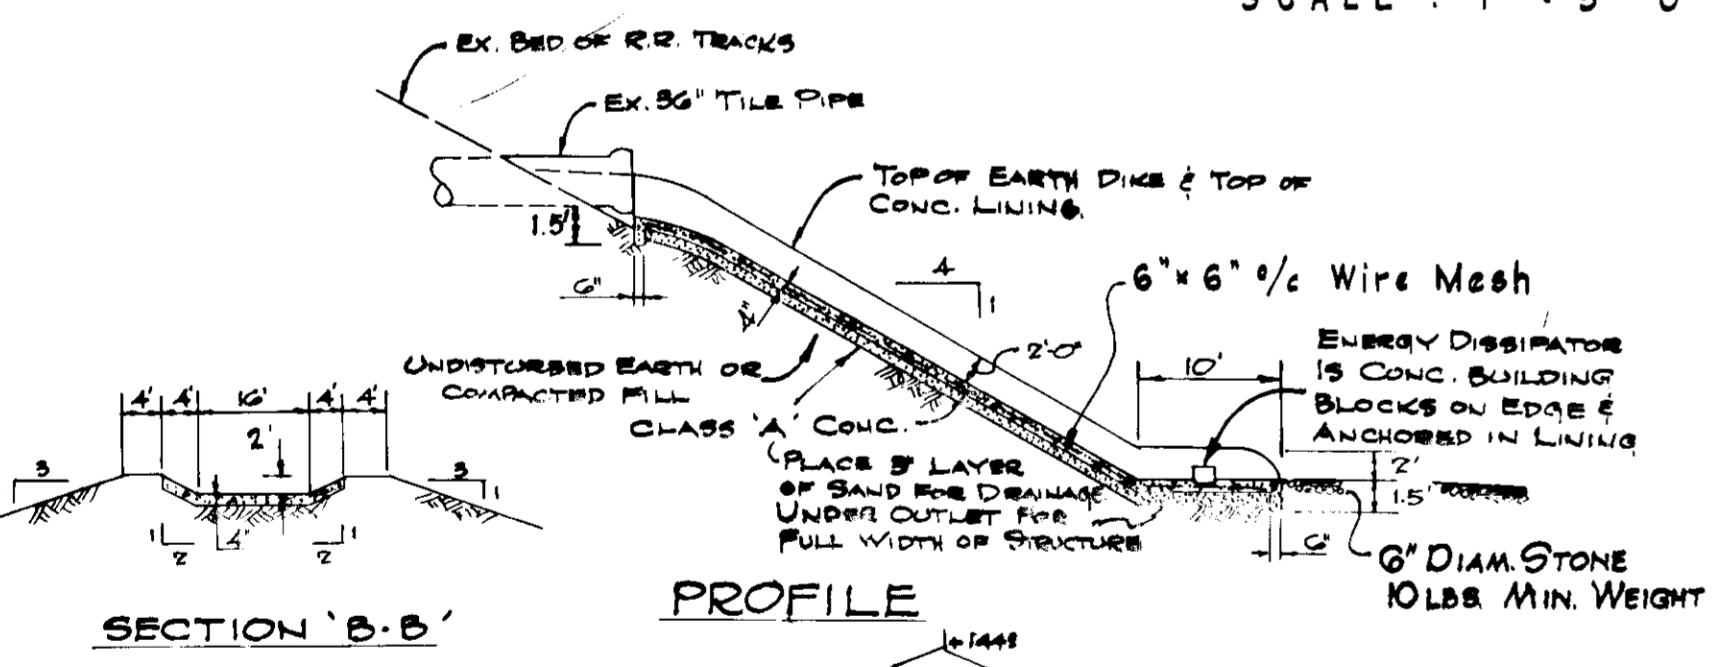

SECTION B-B

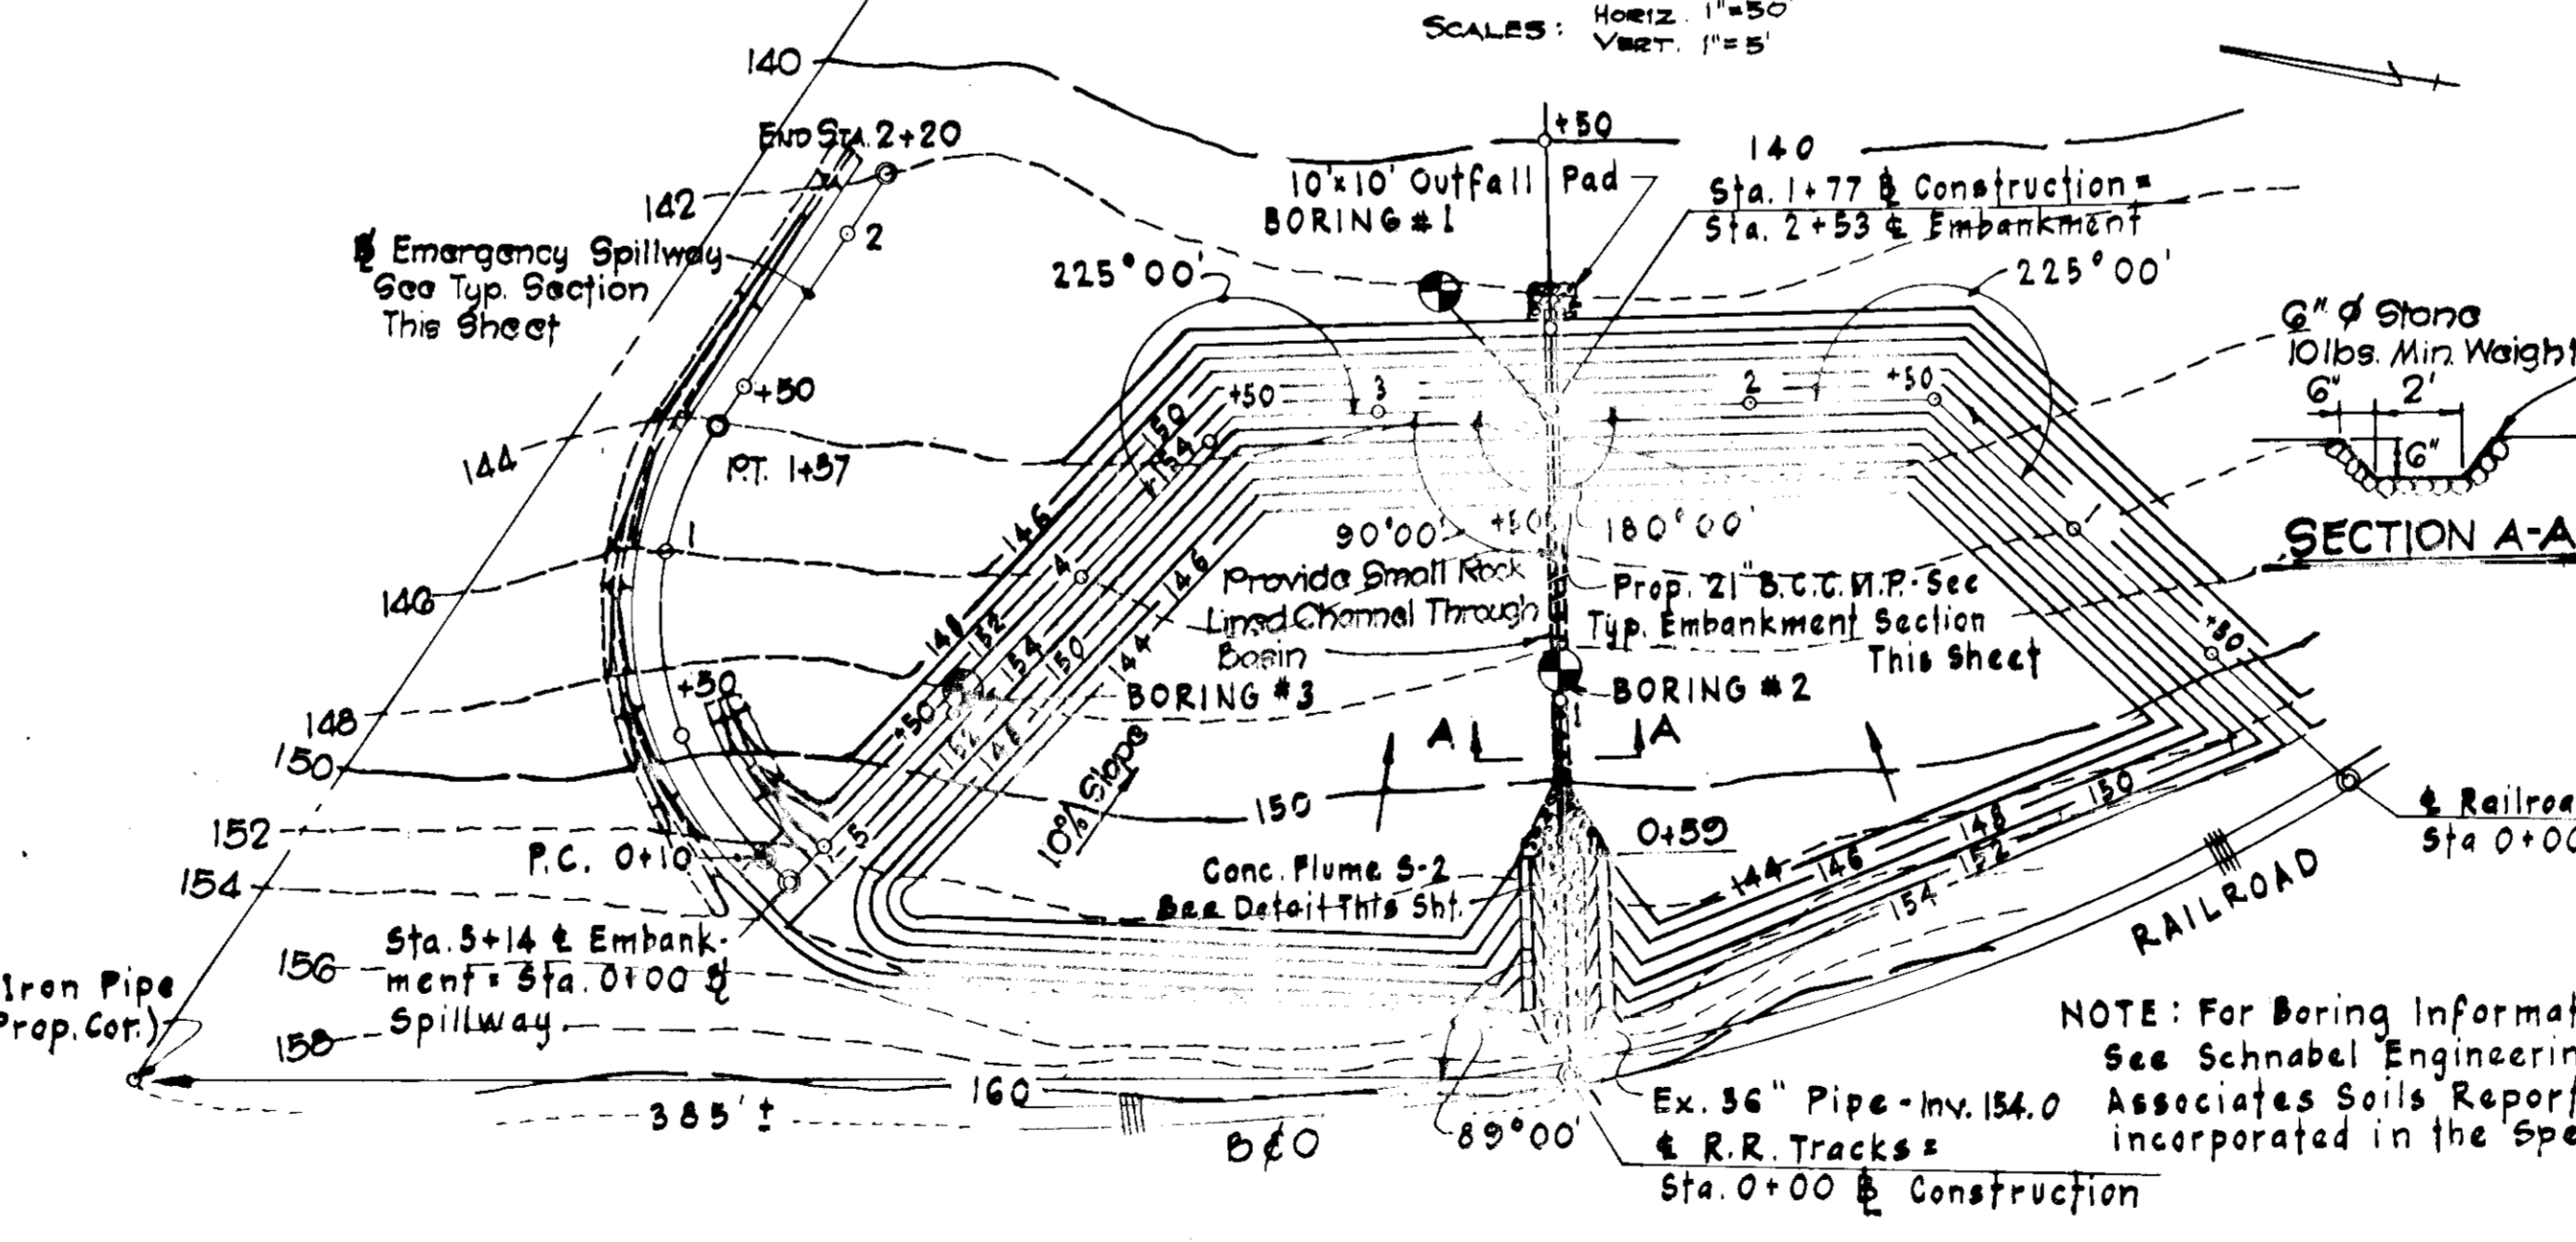

PLAN
SCALE: 1" = 50'

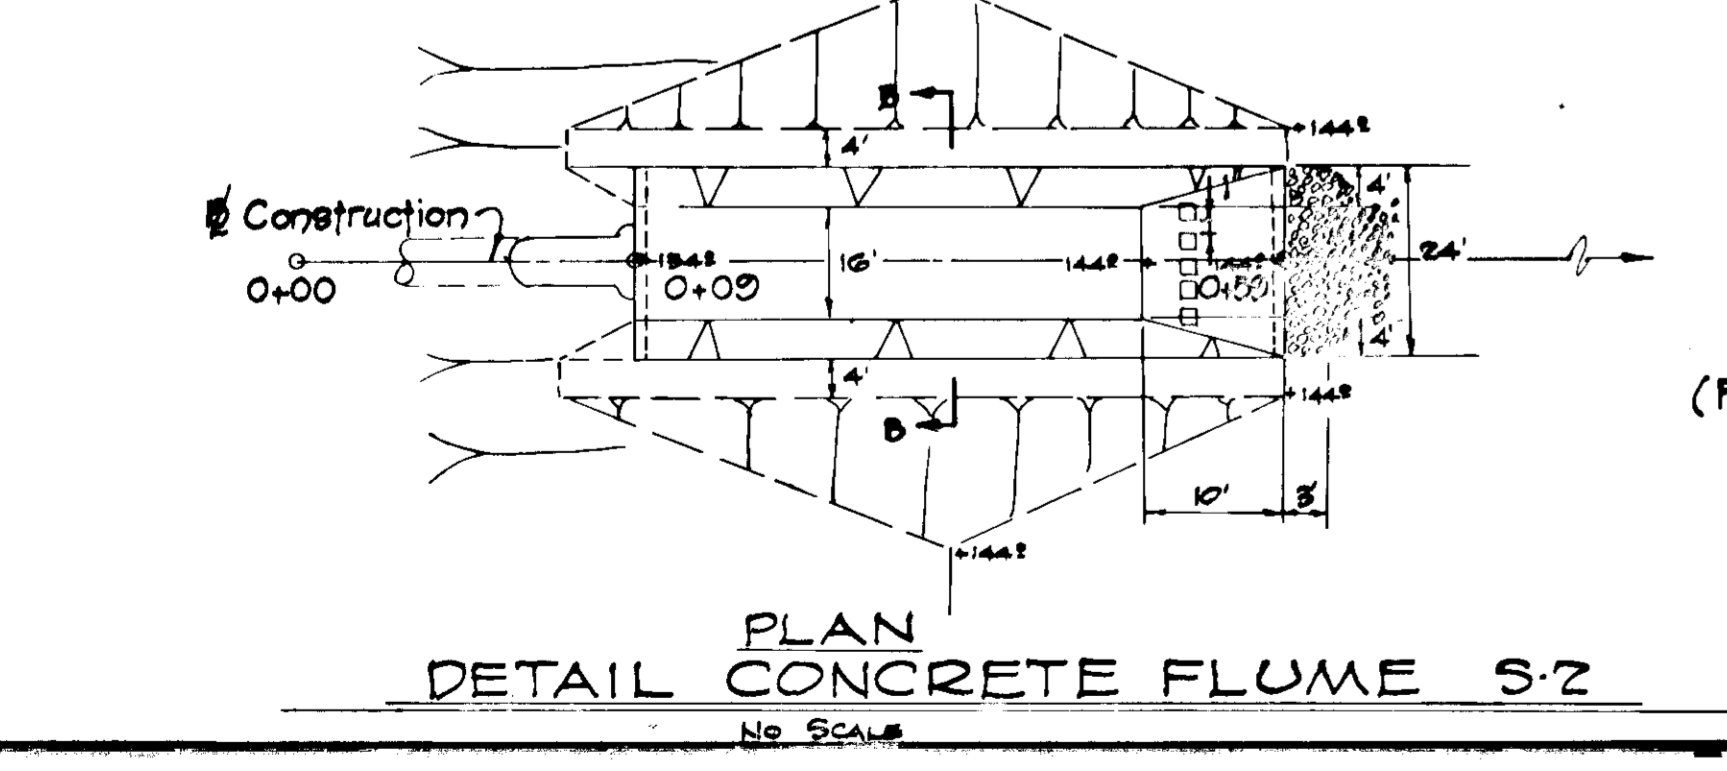

PLAN - DETAIL CONCRETE FLUME S-2
NO SCALE

APPROVED: FOR PUBLIC WATER AND PUBLIC SEWERAGE SYSTEMS, HOWARD COUNTY HEALTH DEPARTMENT
 COUNTY HEALTH OFFICER
 DATE 10-8-74

APPROVED: HOWARD COUNTY OFFICE OF PLANNING AND ZONING
 PLANNING DIRECTOR
 DATE 10/10/74

APPROVED: FOR PUBLIC WATER, PUBLIC SEWERAGE AND STORM DRAINAGE SYSTEMS AND ROADS
 HOWARD COUNTY DEPARTMENT OF PUBLIC WORKS
 DIRECTOR
 DATE 10/4/74

Reviewed for: Howard - S.C.D.
 and meets Technical Requirements
 Signature: [Signature]
 U. S. Soil Conservation Service
 Date: 9-30-74

THIS DEVELOPMENT PLAN IS APPROVED FOR SOIL EROSION AND SEDIMENT CONTROL BY THE HOWARD SOIL CONSERVATION DISTRICT
 Approved: [Signature] Date: 9-30-74
 Howard S.C.D.

By the Developer: [Signature] Date: 9-16-74

By the Engineer: [Signature] Date: 9-16-74

APPROVED: [Signature] Date: 9-30-74
 HOWARD S.C.D.

SDP-24-100
 Plan Number

THIS PLAN HAS BEEN REVIEWED FOR THE HOWARD SOIL CONSERVATION DISTRICT AND MEETS THE TECHNICAL REQUIREMENTS FOR SMALL POND CONSTRUCTION.

OWNER'S CERTIFICATION FOR POND CONSTRUCTION
 I certify that the development and construction of this pond will be done according to this plan. I also authorize periodic on-site evaluation by the Howard Soil Conservation District or its authorized agents as deemed necessary. Deviation from this plan will not be made unless authorized in writing by the Howard Soil Conservation District.
 Signature: [Signature] Date: 9/16/74

NOTES:
 1. FOR SEDIMENT CONTROL & STORM WATER DETENTION NOTES SEE SHT. #15 OF 16.
 2. FOR CONSTRUCTION SPECIFICATIONS SEE SHT. #8 OF 16.

NOTE: For Boring Information See Schnabel Engineering Associates Soils Report incorporated in the Specifications.

ISSUED FOR BIDDING		DATE	BY
ADDENDUM REVISIONS			
NO.	DESCRIPTION	DATE	BY
1	REVISED IN ACCORDANCE WITH HOWARD COUNTY COMMENTS	9/13/74	MJM
2	REVISED IN ACCORDANCE WITH HOWARD SOIL CONSERVATION DISTRICT COMMENTS	9/13/74	MJM
ISSUED FOR CONSTRUCTION			
REVISIONS			
NO.	DESCRIPTION	DATE	BY
1	REVISED IN ACCORDANCE WITH HOWARD COUNTY COMMENTS	9/13/74	MJM
2	REVISED IN ACCORDANCE WITH HOWARD SOIL CONSERVATION DISTRICT COMMENTS	9/13/74	MJM
AS BUILT DRAWING			
DATE			
BY			
DRAWN W.R.B. DATE 7-15-74			
CHECKED J.J.G. JOB NO. 786640			
STORM WATER DETENTION BASIN AND SEDIMENT CONTROL BASIN			
ADDITION & ALTERATIONS PLANT & OFFICE BUILDING			
AMINCO			
SAVAGE, MARYLAND			
SHEET 16 OF 16			

DALTON • DALTON • BUTLER • NEWPORT

ARCOLLETT • BINGHAM • BIRCH • PLACENTIA