

HARPER'S CHOICE MIDDLE SCHOOL
EXIST. FIN. FLR. 479.00

SHEET INDEX	
NO.	DESCRIPTION
SD-1	SITE DEVELOPMENT PLAN
SD-2	SITE DEVELOPMENT PLAN
SD-3	DRAINAGE AREA PLAN
SD-4	DRAINAGE AREA PLAN
SD-5	UTILITY PLAN
SD-6	UTILITY PROFILES
SD-7	SWM DETAILS AND PROFILES
SD-8	SEDIMENT CONTROL PLAN
SD-9	SEDIMENT CONTROL PLAN
SD-10	SEDIMENT CONTROL DETAILS
SD-11	PLANTING PLAN
SD-12	PLANTING PLAN
SD-13	SITE DETAILS
14	NOTES AND LOCATION SHEET
15	DEMOLITION PLAN AND SITE PLAN
16	SEDIMENT AND EROSION CONTROL PLAN & DRAINAGE AREA MAP
17	GEOMETRY PLAN
18	SITE DETAILS, BORING LOGS AND SEDIMENT CONTROL DETAILS
19	SEDIMENT CONTROL NOTES
20	PROFILES
21	PROFILES

NOTE: CONTRACTOR SHALL CALL MISS UTILITY BEFORE GRADING & HAVE THESE UTILITIES LOWERED AS REQUIRED TO ALLOW FOR GRADING & STORM DRAINS

NOTE: THE PURPOSE OF THIS RED LINE IS TO SHOW THE INSTALLATION OF A MODULAR CLASSROOM, EMERGENCY ACCESS ROADWAY AND THEIR UTILITIES ON SHEETS 14-21.

1-18-24 ADDED SHEET INDEX AND REVISED SHEET NUMBER

APPROVED: For Public Water, Public Sewerage and Storm Drainage Systems and Roads
HOWARD COUNTY DEPARTMENT OF PUBLIC WORKS
DIRECTOR: *George F. Nemejny* DATE: 12-3-79
CHIEF, BUREAU OF ENGINEERING: *W. O. [Signature]* DATE: 12-3-79

APPROVED: For Public Water and Public Sewerage Systems
HOWARD COUNTY HEALTH DEPARTMENT
COUNTY HEALTH OFFICER: *John W. [Signature]* DATE: 12-5-79

APPROVED: Howard County Office of Planning and Zoning
PLANNING DIRECTOR: *James [Signature]* DATE: 12-7-79
CHIEF, DIV. OF LAND DEVELOPMENT: *[Signature]* DATE: 12-7-79

SITE DEVELOPMENT PLAN
HOWARD COUNTY SPECIAL EDUCATION CENTER


VILLAGE OF HARPER'S CHOICE COLUMBIA, MD.
SECTION G, AREA 2
PLAT BOOK 23 FOLIO 64

TAX MAP NO. 29 PARCEL NO. 69
ELECTION DISTRICT NO. 5 HOWARD COUNTY, MARYLAND
SCALE 1" = 50' APRIL 11, 1979


HOWARD COUNTY SPECIAL EDUCATION CENTER
Village of Harper's Choice
Columbia, Maryland

Browne, Worrall & Johnson / Architects
Baltimore, Maryland 21218
George Evans Associates, Structural
130 West Harmon St. Baltimore, Maryland
Moore Lewis, Inc., Mechanical & Electrical
2435 N. Calvert St. Baltimore, Maryland

SD-1
OP 21

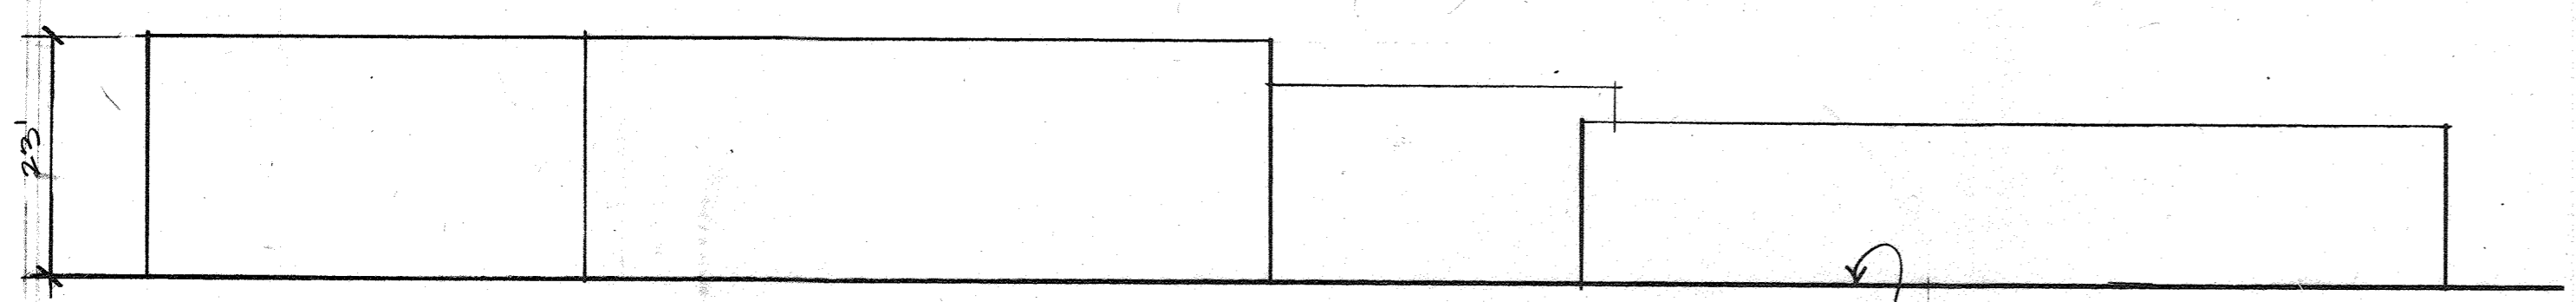


SOUTH ELEVATION
SCALE: 1/8" = 1'-0"
SCHEMATIC BUILDING PROFILE

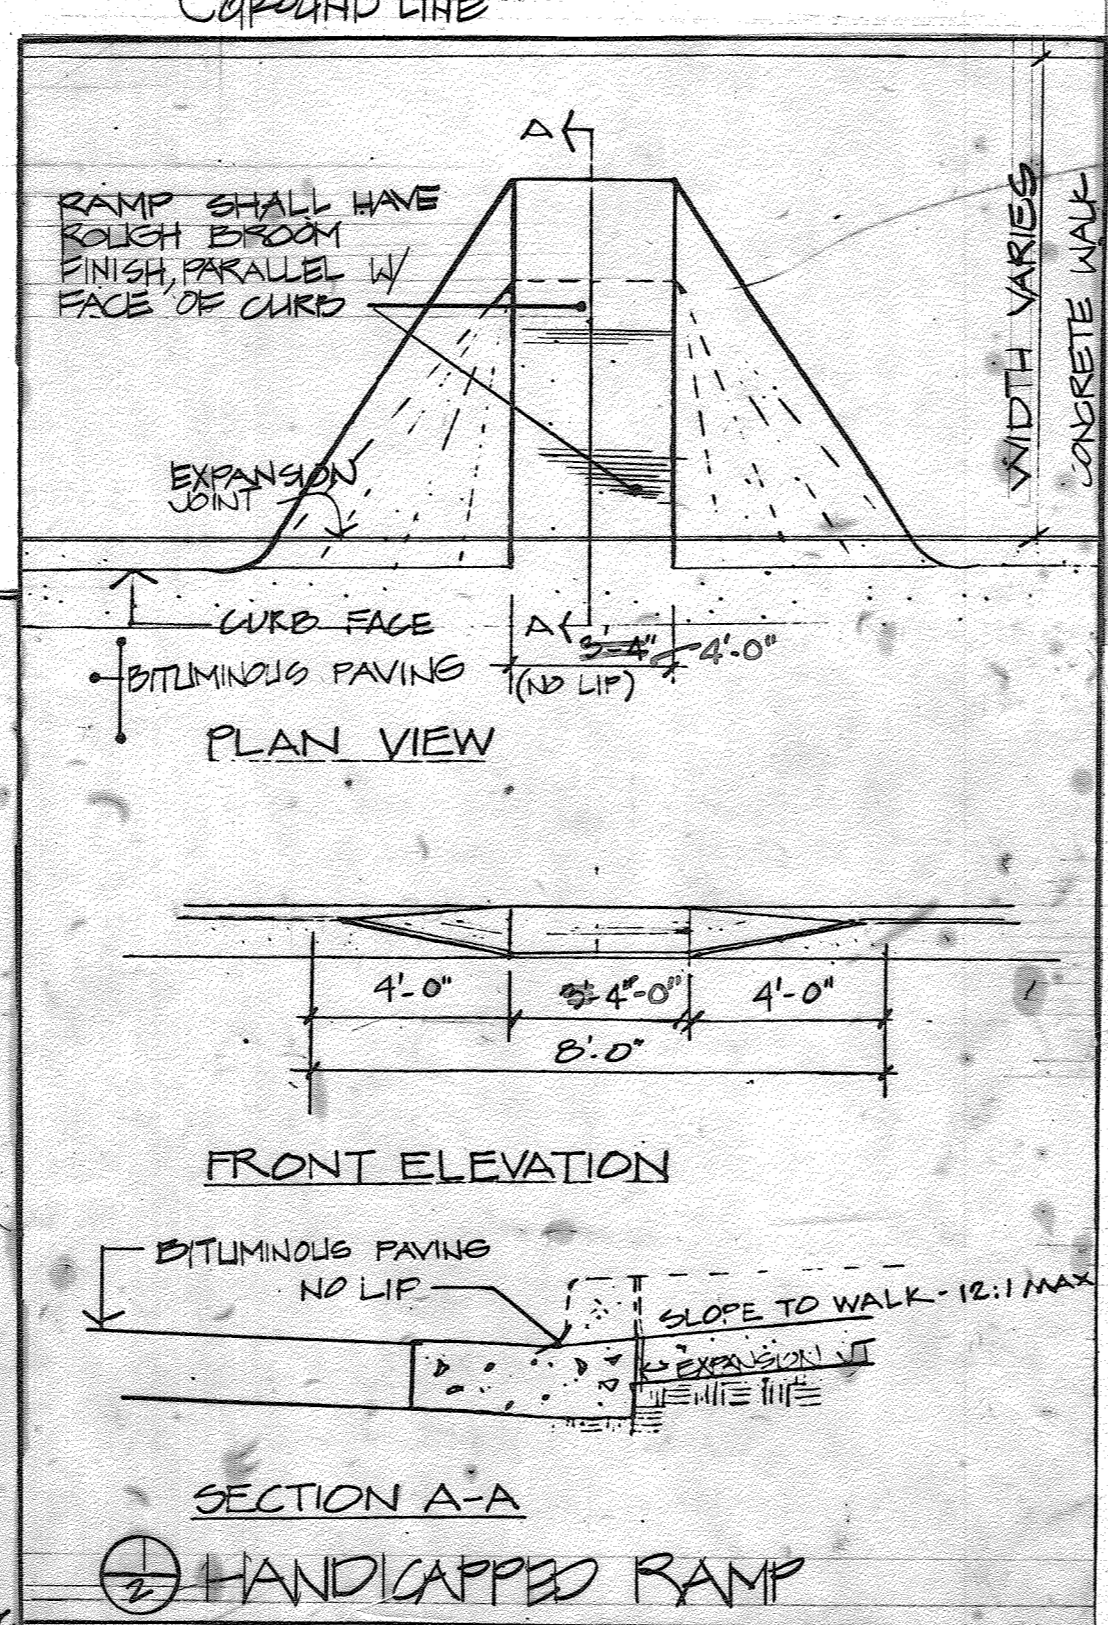

GENERAL NOTES


- All construction shall be done in accordance with the latest edition of the Howard County Road Construction Code and Standard Specifications.
- Contractor shall verify all existing information to his own satisfaction. The information shown is for the convenience of those concerned only. The correctness or completeness of the information given is not warranted or guaranteed.
- All existing utility companies are to be notified at least 48 hours before starting work. Contact Miss Utility at (301) 559-0100.
- Contractor is responsible for protection of all existing features not designated to be removed.
- All disturbed areas not designated to be paved or sodded shall be seeded.
- All curb and gutter shall be Howard County standard 7" combination curb and gutter drawing D-40.
- Road, service drive and parking area bituminous paving section shall be Howard County Bus Ways and Parking Areas Paving Section Drawing D-117. All other bituminous paving (track, tot lots, etc.) shall be Howard County Sidewalks, Paving Section Drawing D-117.
- CONTRACTOR WILL NOT BE ALLOWED ACCESS TO THE SITE FROM BEAVERKILL ROAD. ACCESS WILL BE PERMITTED ONLY FROM CEDAR LAKE.
- CONTRACTOR SHALL GRADE & SOD THE PROPOSED BALLFIELD NORTH OF THE EXISTING PAVED PLAY AREA BEFORE FINISH ANY OTHER CONSTRUCTION.
- ALL INLET GRATES & MANHOLE FRAMES & COVERS TO BE ABANDONED AND THE PROPERTY OF HOWARD COUNTY.
- CONTRACTOR SHALL ADJUST ALL EXISTING & PROPOSED UTILITIES TO FINISHED GRADE.
- CONTRACTOR SHALL INSTALL AN EXPANSION JOINT AT ALL VERTICALS & BETWEEN PROPOSED & EXISTING WORK.
- MAXIMUM SLOPE SHALL BE 3:1
- CONTRACTOR SHALL INSTALL AN SNOW FENCE ALONG LIMITS OF GRADING ALONG ENTIRE 35' LINE SIDES OF THE SITE. CONTRACTOR SHALL CONTAIN CONSTRUCTION DEBRIS ON SITE.
- SEE UTILITY PLAN & PROFILES (SHEET SD-5 & 6) FOR INVERT ELEVATIONS FOR WATER & SEWER HOUSE CONNECTIONS.
- ALL DRIVEWAYS AND PARKING AREAS ARE PRIVATE.

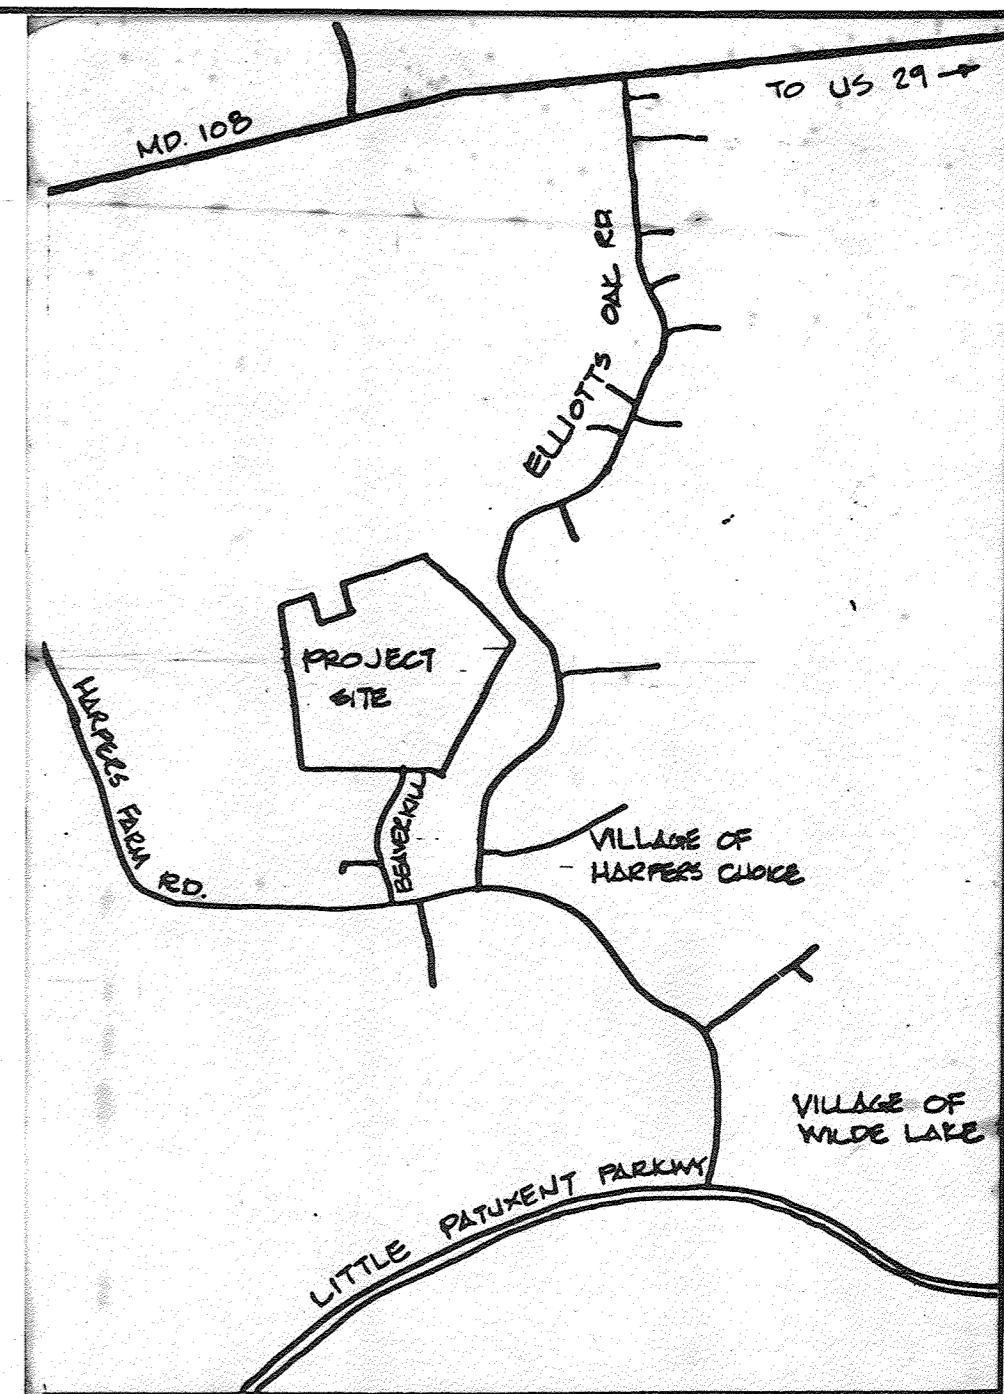


Vicinity Sketch

SITE ANALYSIS:


TOTAL AREA VILLAGE OF HARPER'S CHOICE, SECTION 6 AREA 2 LOT 3 = 30.87 ACRES ±
 PARKING REQUIRED: 163 CARS
 PARKING PROVIDED: 103 CARS
 PARKING SPACES = 10'x20' W/24' LANES
 ZONING = V.H.C. 0/2 - NEW TOWN/OPEN SPACE PDP 123 A
 COVERAGE = 30.87 ACRES TOTAL
 EXIST. BLDG. 15,000 S.F. = 5.55%
 PROPOSED BLDG. 50,000 S.F. = 2.72%
 TOTAL = 125,000 S.F. = 9.30%

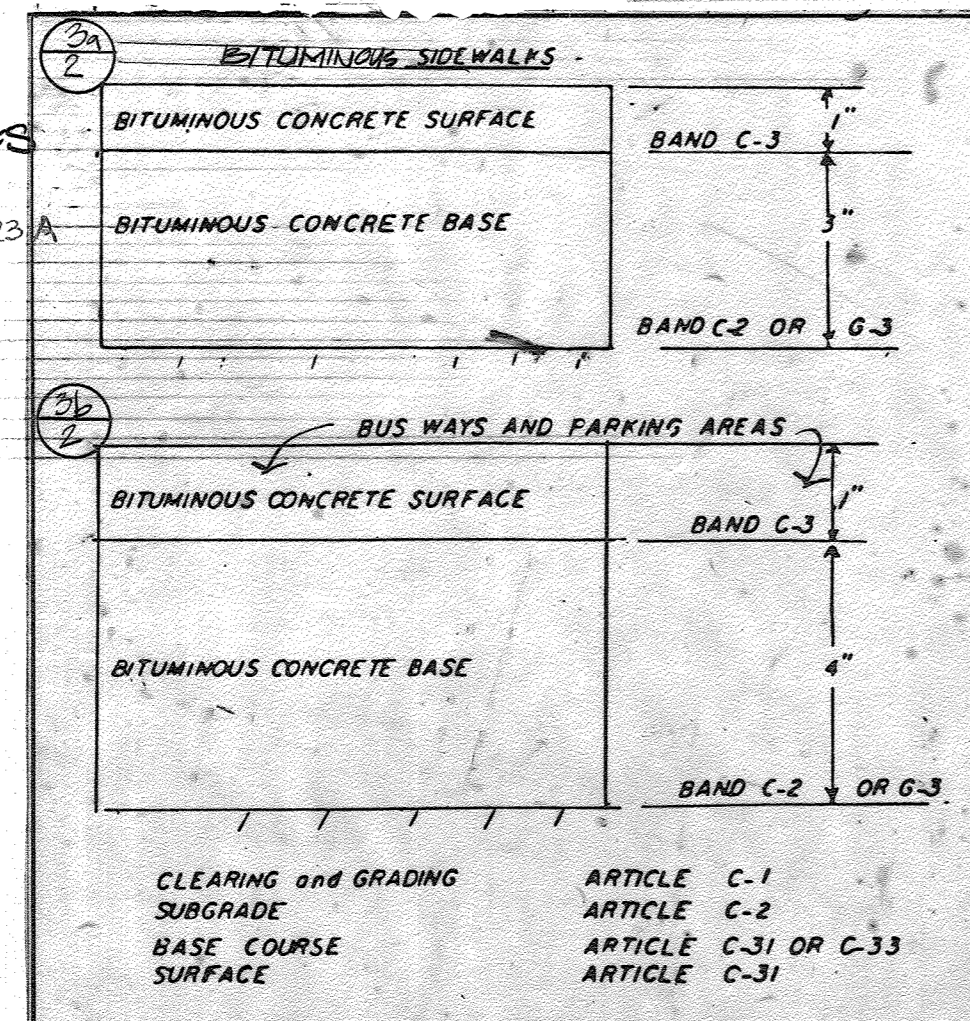


CLEARING AND GRADING ARTICLE C-1
 SUBGRADE ARTICLE C-2
 BASE COURSE SURFACE ARTICLE C-31 OR C-33
 ARTICLE C-31
 1. TO BE CONSTRUCTED IN ACCORDANCE WITH THE HOWARD COUNTY ROAD CONSTRUCTION CODE AND SPECIFICATIONS
 2. THE BASE SHALL BE PRIMED IN ACCORDANCE WITH SECTION C-30-3 AS PROVIDED IN THE HOWARD COUNTY ROAD CONSTRUCTION CODE STANDARD SPECIFICATIONS
 3. A TACK COAT WILL BE REQUIRED, IN ACCORDANCE WITH SECTION C-31-4 OF THE HOWARD COUNTY ROAD CONSTRUCTION CODE & STANDARD SPECIFICATIONS
 EXISTING GRAVEL DRIVEWAY ROAD TO REMAIN

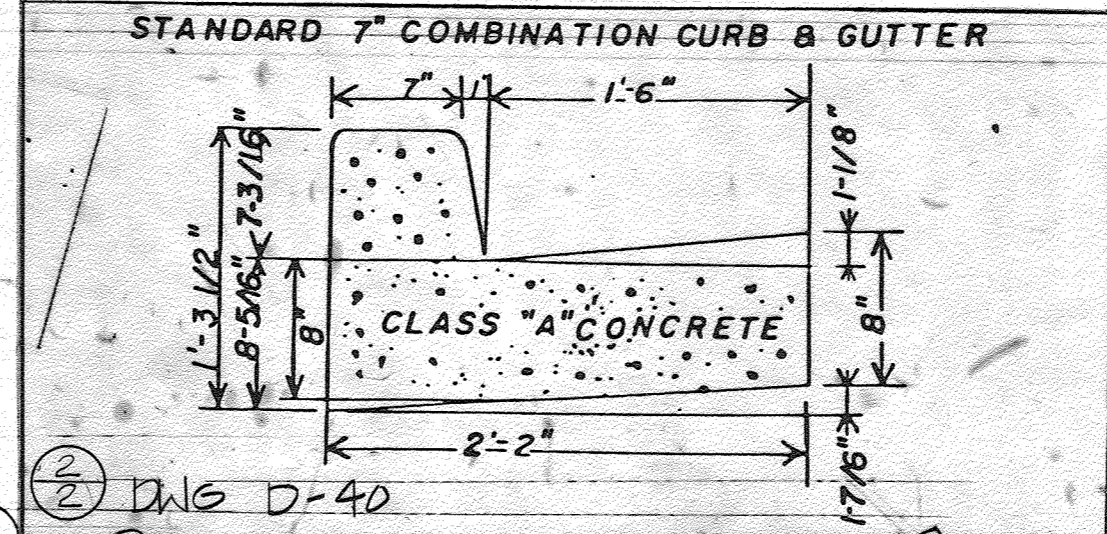

APPROVED: For Public Water, Public Sewerage and Storm Drainage Systems and Roads
 HOWARD COUNTY DEPARTMENT OF PUBLIC WORKS
 DIRECTOR: *[Signature]* DATE: 12-3-79
 CHIEF, BUREAU OF ENGINEERING: *[Signature]* DATE: 12-3-79
 APPROVED: For Public Water and Public Sewerage Systems
 HOWARD COUNTY HEALTH DEPARTMENT
 COUNTY HEALTH OFFICER: *[Signature]* DATE: 12-3-79
 APPROVED: Howard County Office of Planning and Zoning
 PLANNING DIRECTOR: *[Signature]* DATE: 12-7-79
 CHIEF, DIV. OF LAND DEVELOPMENT: *[Signature]* DATE: 12-7-79

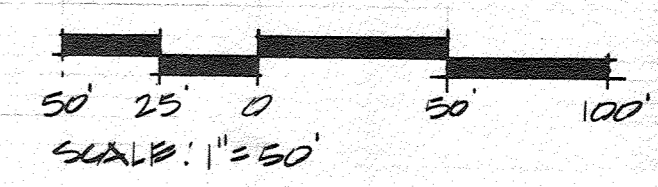

CONSTRUCTION ACCESS

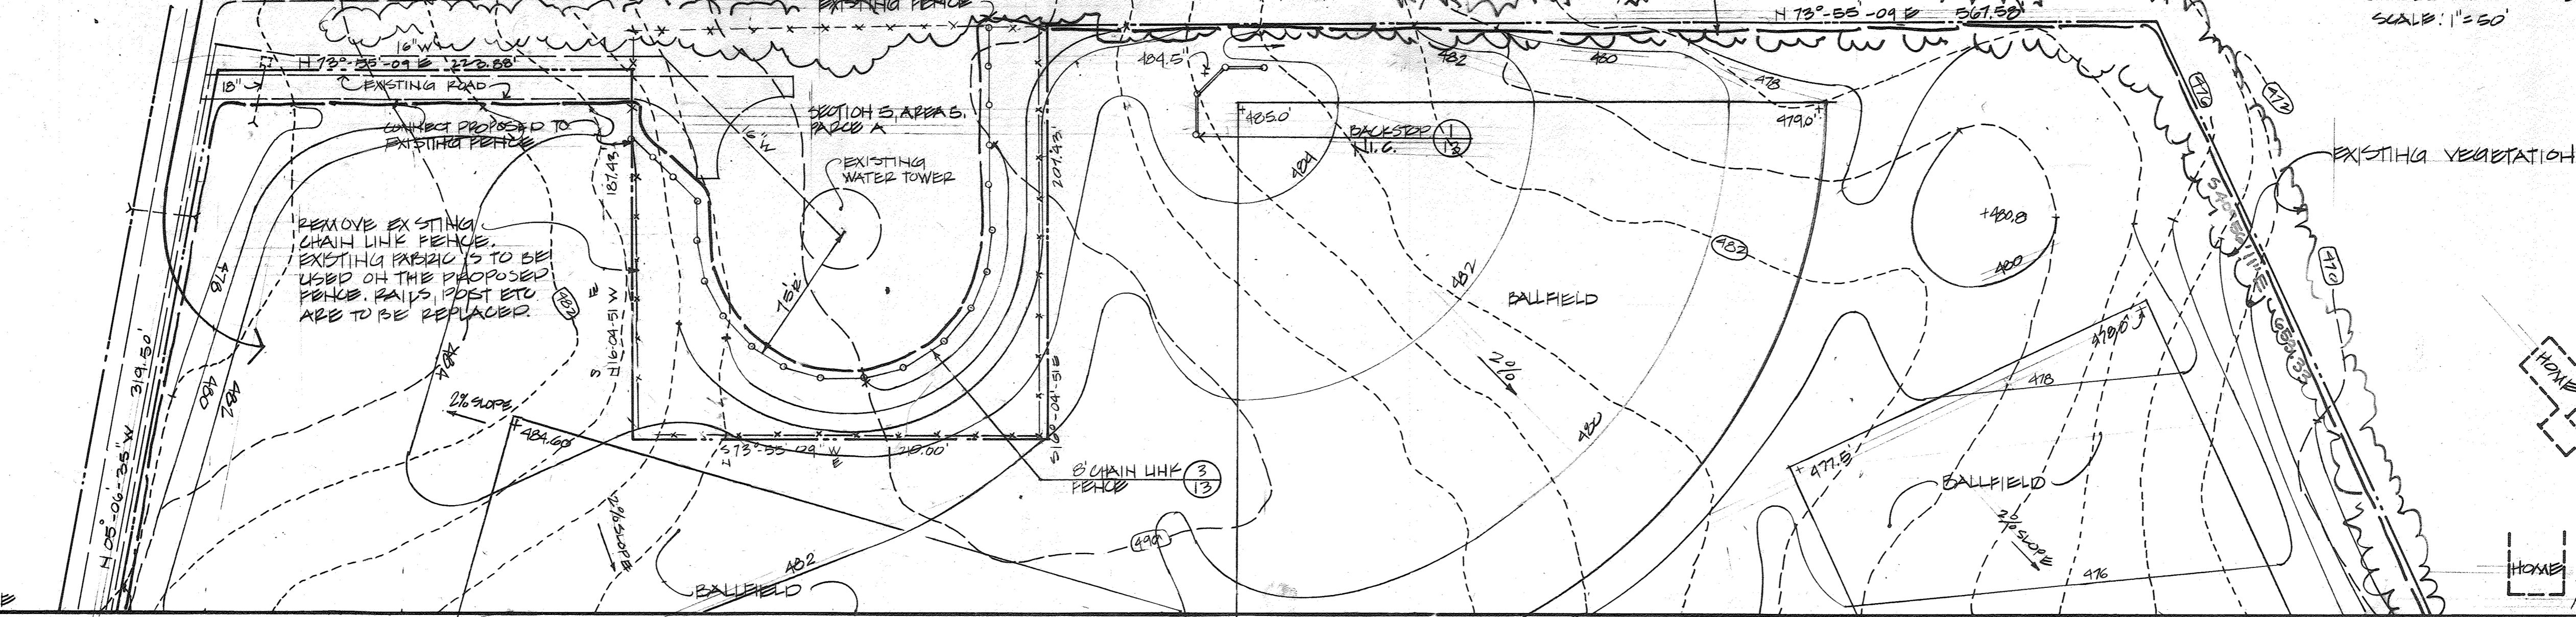

APPROVED
 PLANNING BOARD OF HOWARD COUNTY
 DATE: 5-23-79
[Signature]

REVISED 6/6/79 DMW/JJA



SITE DEVELOPMENT PLAN
 HOWARD COUNTY
 SPECIAL EDUCATION CENTER
 VILLAGE OF HARPER'S CHOICE COLUMBIA, MD.
 SECTION 6 AREA 2
 PLAT BOOK 23 FOLIO 64

TAX MAP NO. 25 PARCEL NO. 60
 ELECTION DISTRICT NO. 5 HOWARD COUNTY, MARYLAND
 SCALE: 1" = 50' APRIL 11, 1979

Browne, Worrall & Johnson / Architects
 Baltimore, Maryland 21218
 George Evans Associates, Structural
 130 West Hamilton St. Baltimore, Maryland
 Moore Lewis, Inc., Mechanical & Electrical
 2435 N. Calvert St. Baltimore, Maryland

HOWARD COUNTY SPECIAL EDUCATION CENTER
 Village of Harper's Choice
 Columbia, Maryland

SD-2
 09 21

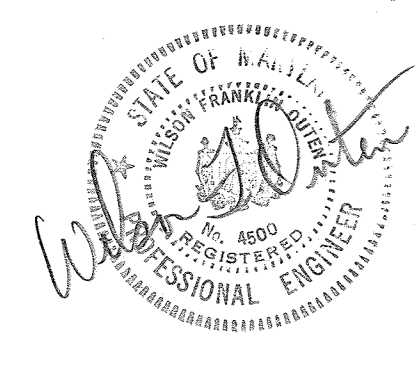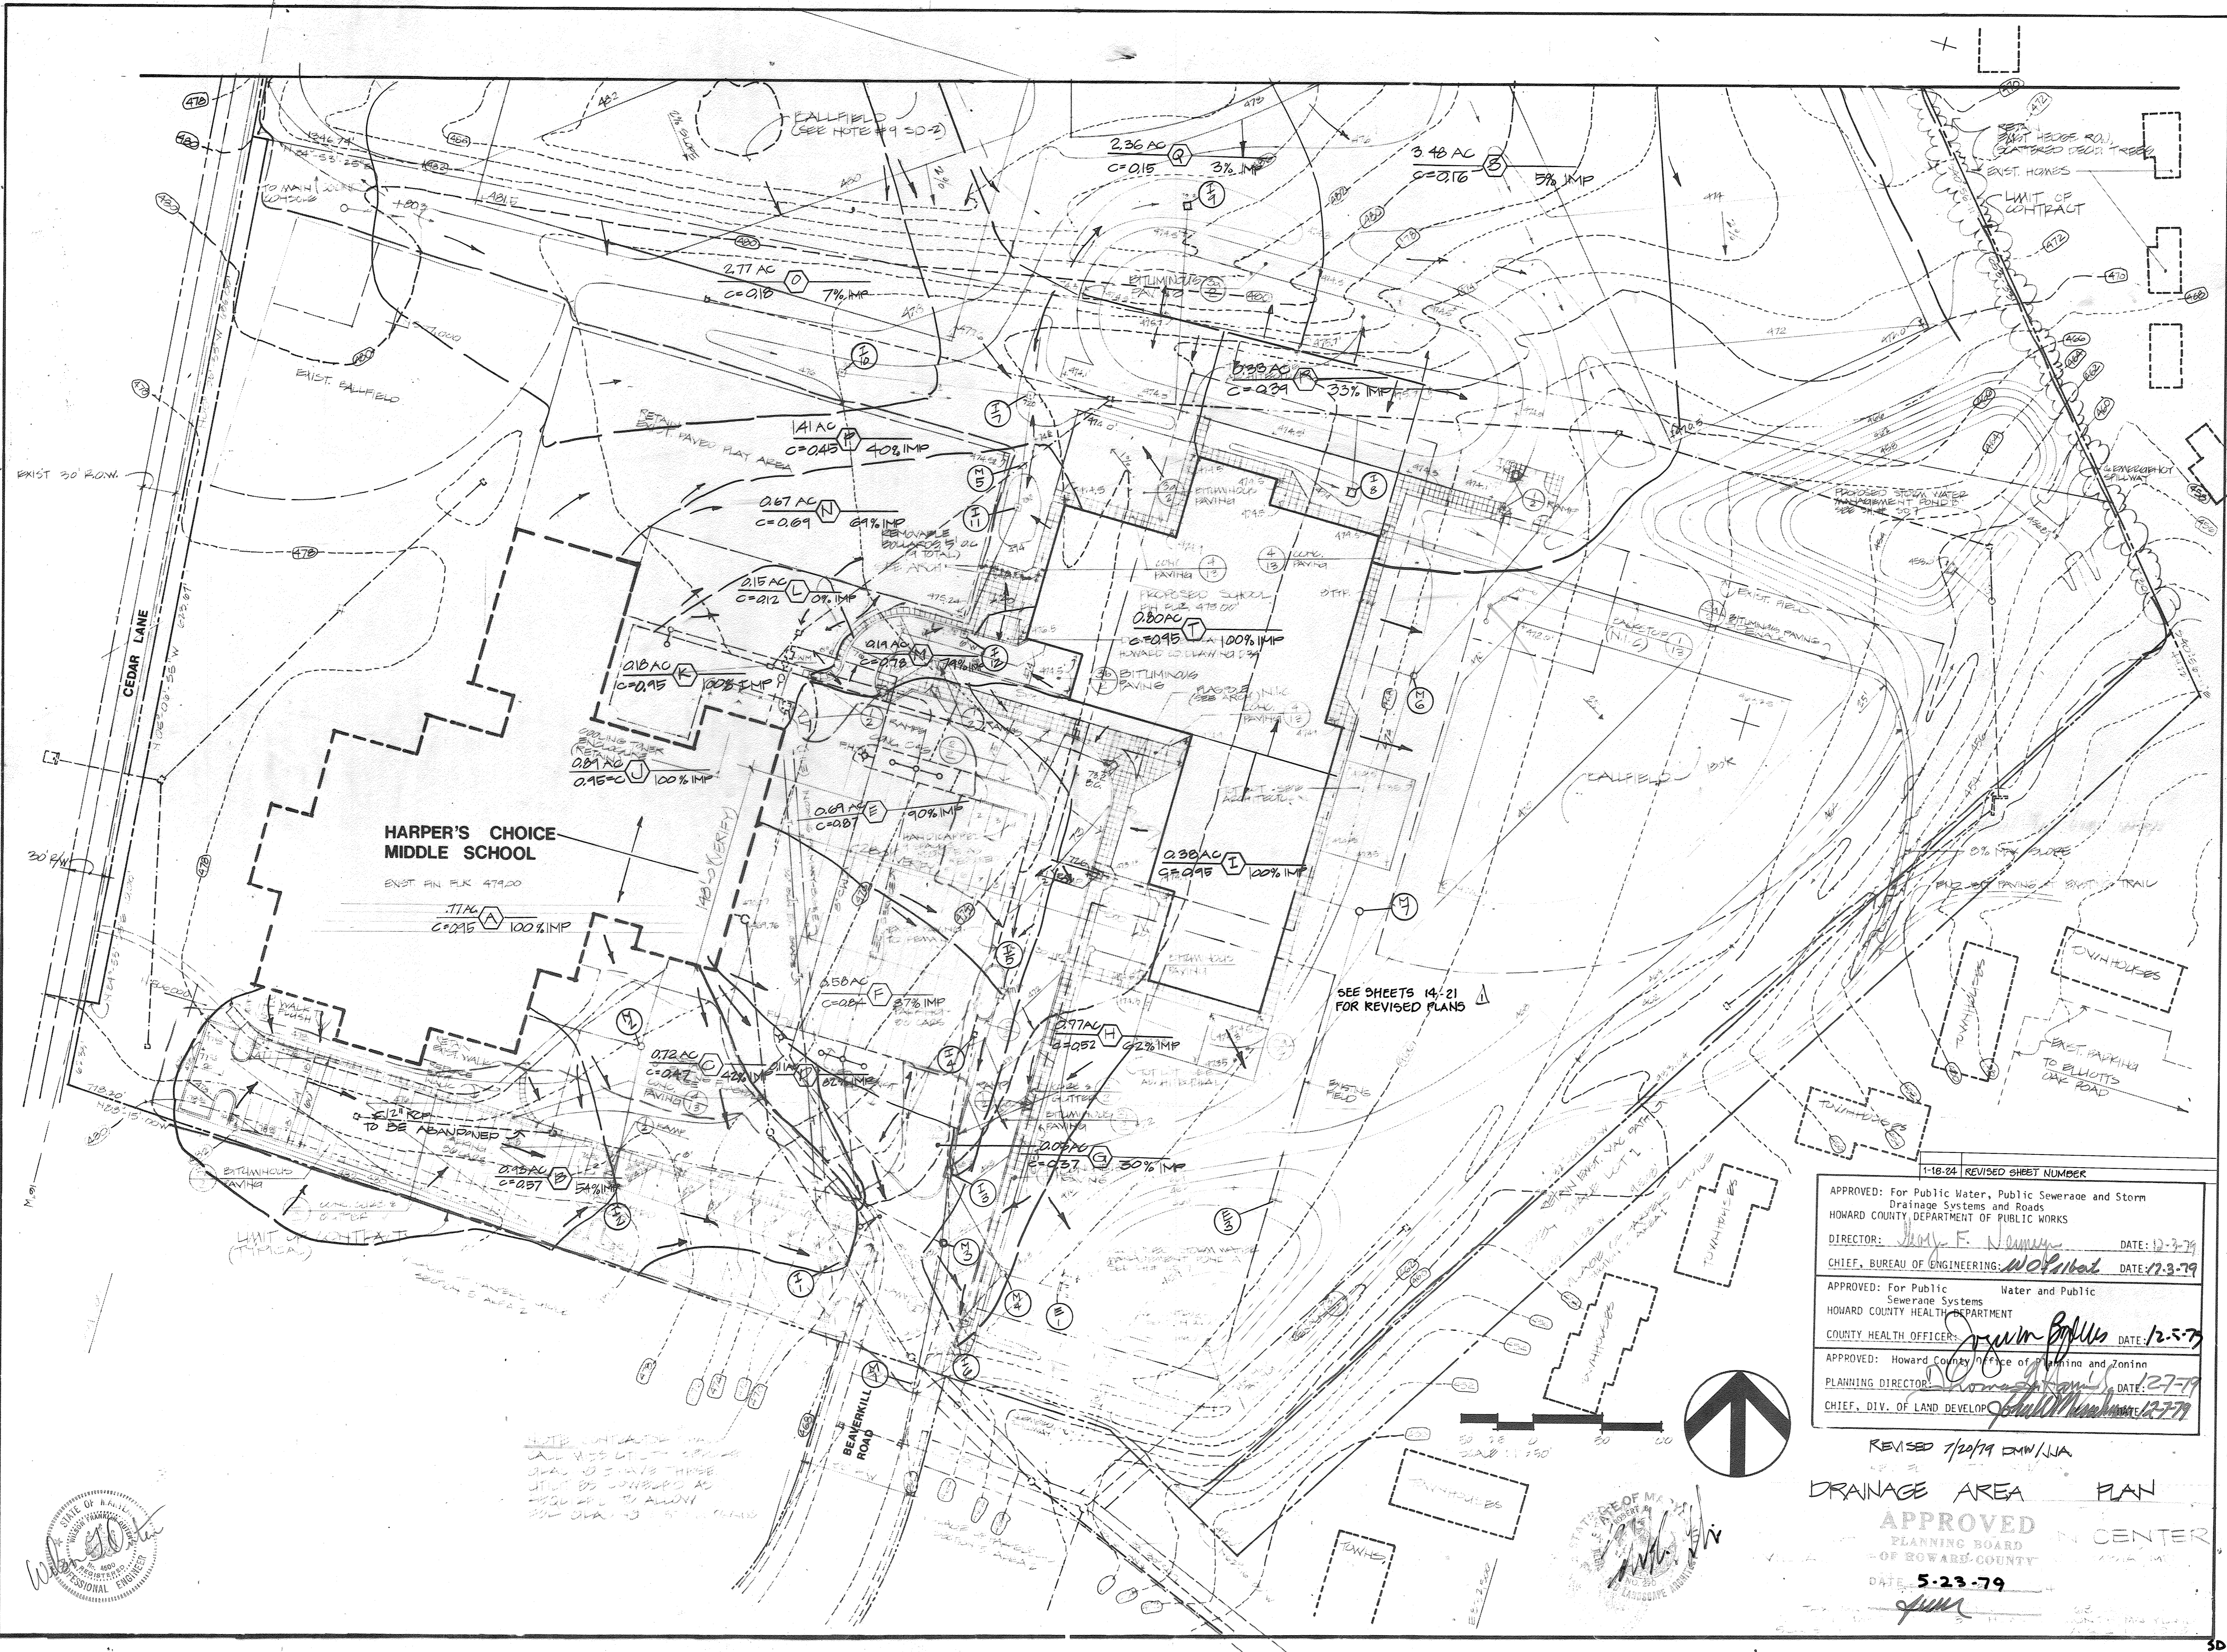

1-18-24 REVISED SHEET NUMBER

APPROVED: For Public Water, Public Sewerage and Storm Drainage Systems and Roads
 HOWARD COUNTY DEPARTMENT OF PUBLIC WORKS
 DIRECTOR: *W. F. Nalley* DATE: 12-3-79
 CHIEF, BUREAU OF ENGINEERING: *W. F. Nalley* DATE: 12-3-79

APPROVED: For Public Water and Public Sewerage Systems
 HOWARD COUNTY HEALTH DEPARTMENT
 COUNTY HEALTH OFFICER: *James P. Kelly* DATE: 12-5-79

APPROVED: Howard County Office of Planning and Zoning
 PLANNING DIRECTOR: *John W. ...* DATE: 12-7-79
 CHIEF, DIV. OF LAND DEVELOPMENT: *John W. ...* DATE: 12-7-79

REVISED 7/20/79 DMW/LJA


DRAINAGE AREA PLAN

APPROVED
 PLANNING BOARD
 OF HOWARD COUNTY
 DATE: 5-23-79
John W. ...


HOWARD COUNTY
SPECIAL EDUCATION CENTER
 Village of Harper's Choice
 Columbia, Maryland

Browne, Worrall & Johnson / Architects
 Baltimore, Maryland 21218
 George Evers Associates, Structural
 130 West Hamilton St. Baltimore, Maryland
 Moore Lewis, Inc., Mechanical & Electrical
 2435 N. Calvert St. Baltimore, Maryland

SD-3
 OF 21

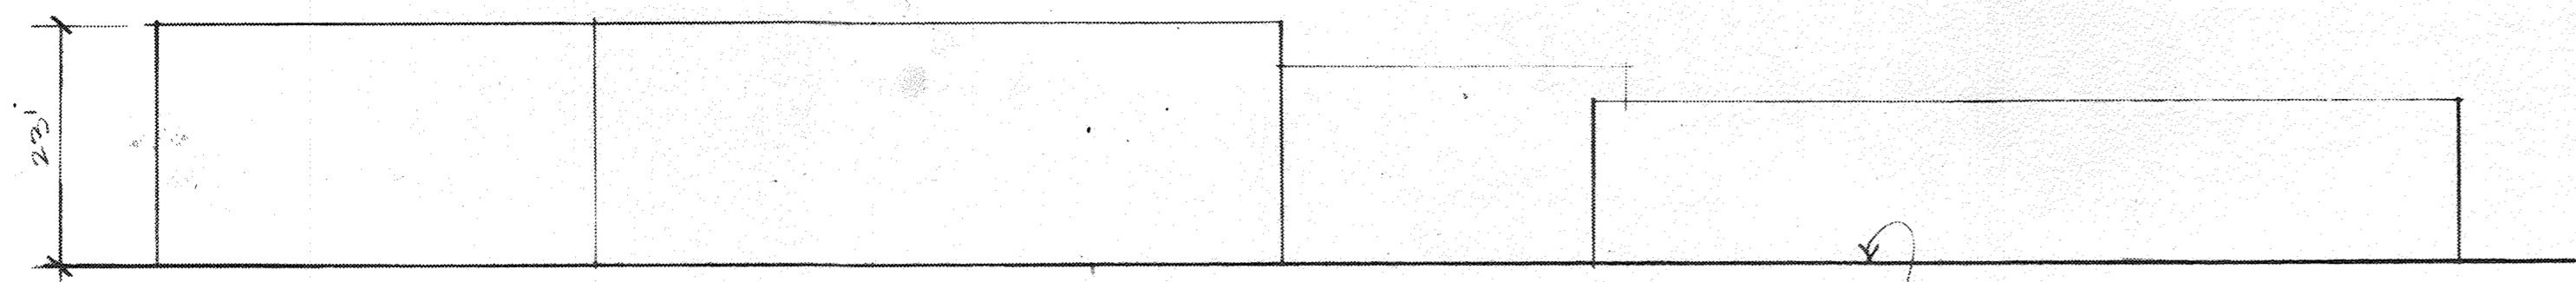


SOUTH ELEVATION
SCALE: 1/8" = 1'-0"
SCHEMATIC BUILDING PROFILE

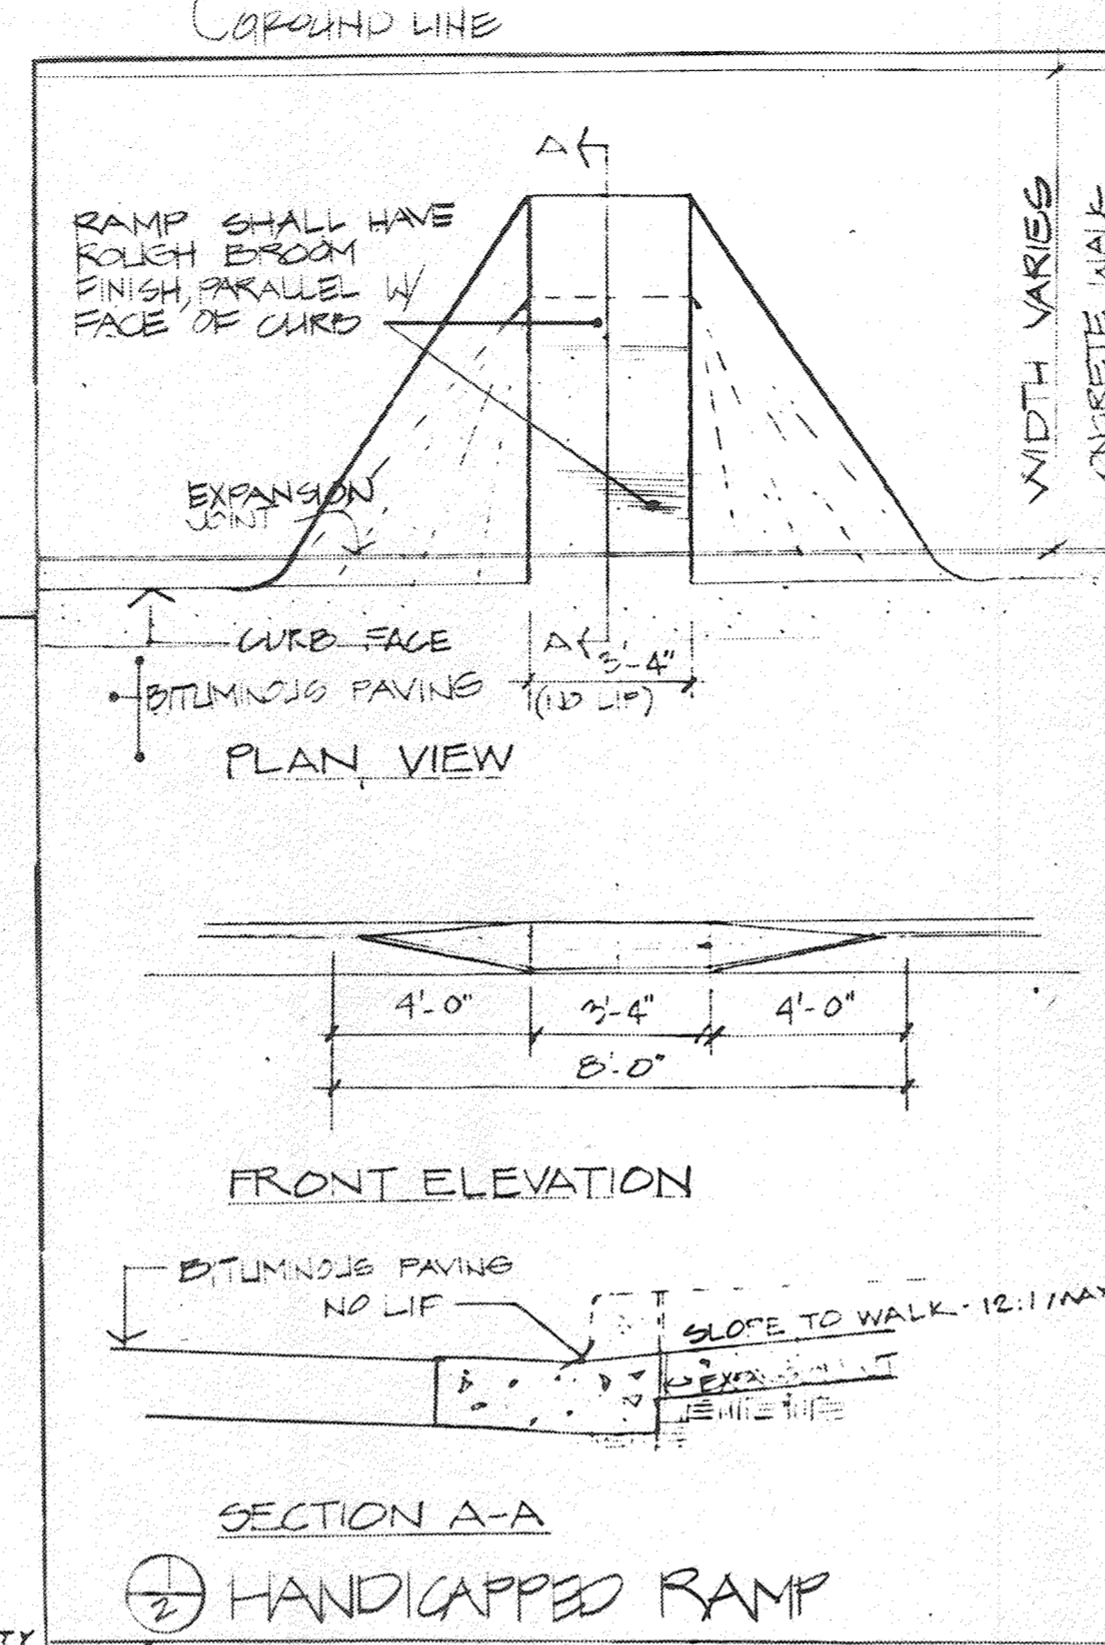

SECTION A-A
HANDICAPPED RAMP


SITE ANALYSIS: (SEE SHEET SD-2)

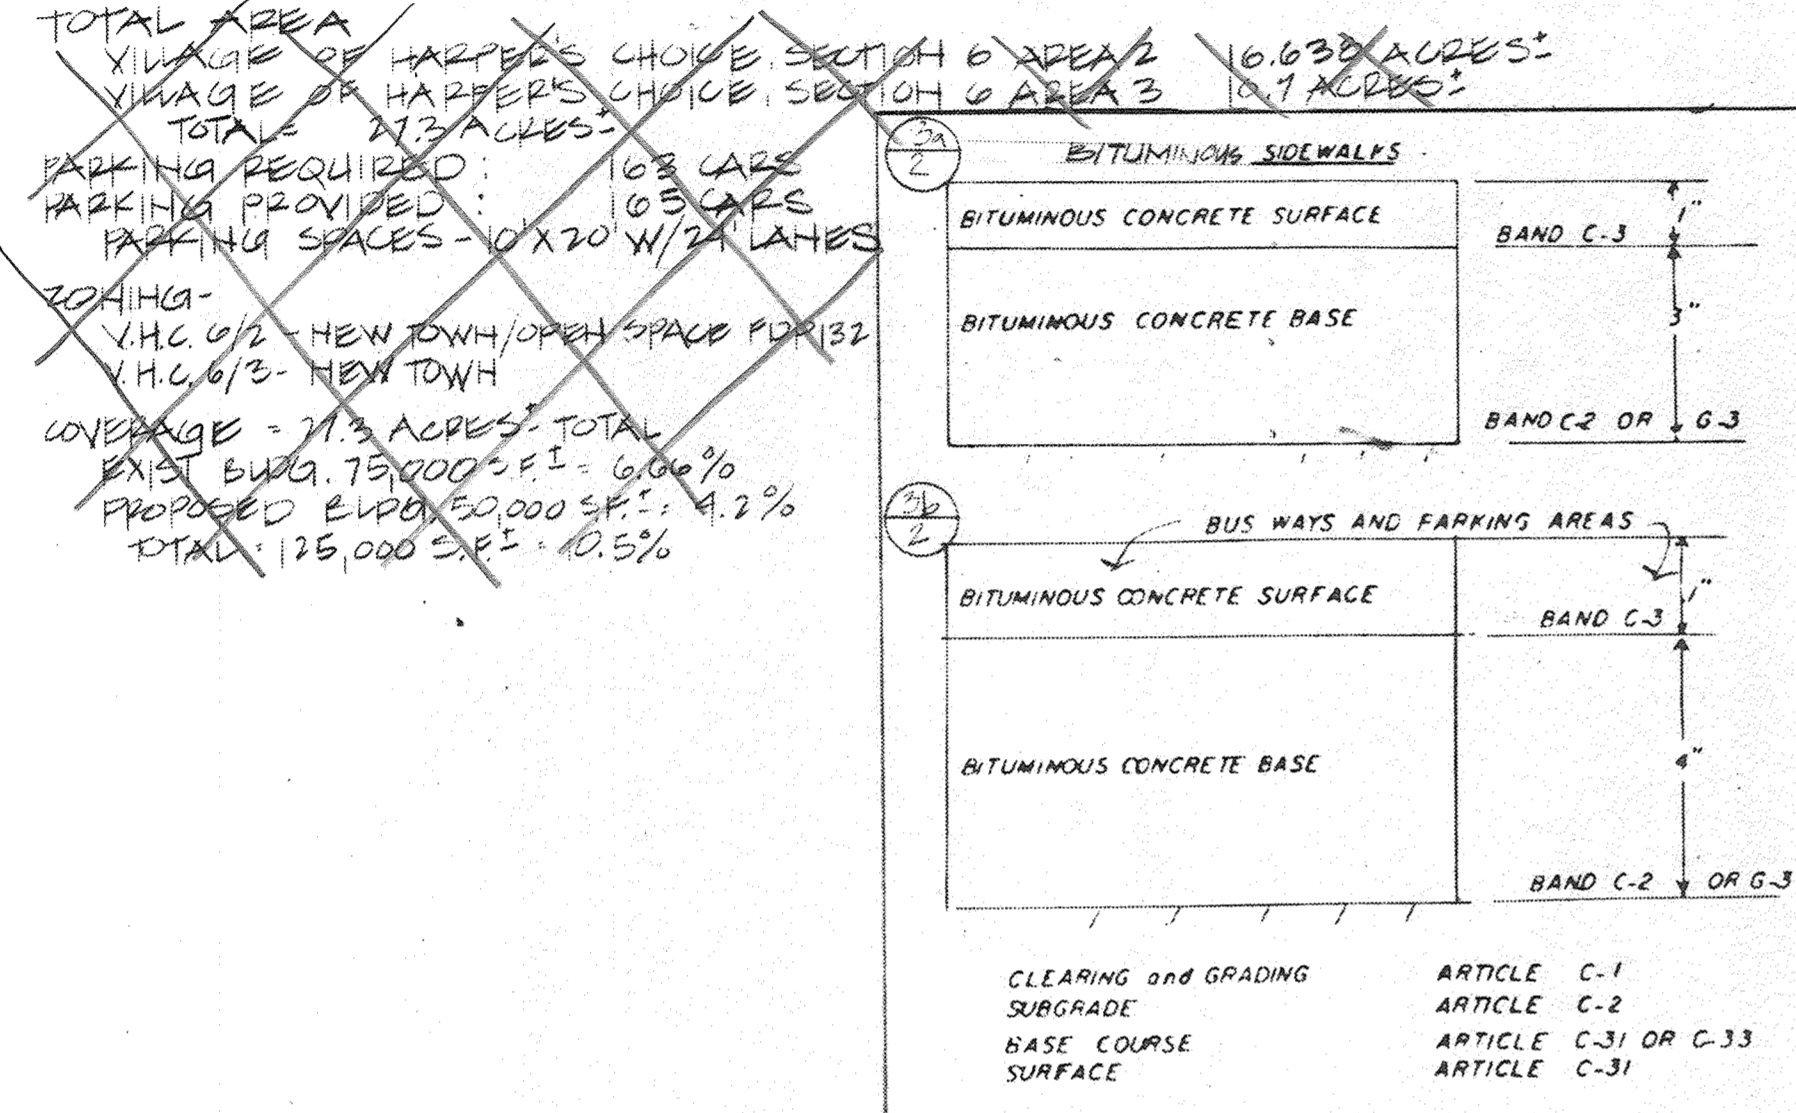

- TO BE CONSTRUCTED IN ACCORDANCE WITH THE HOWARD COUNTY ROAD CONSTRUCTION CODE AND SPECIFICATIONS
- THE BASE SHALL BE PRIMED IN ACCORDANCE WITH SECTION C-30.3 AS PROVIDED IN THE HOWARD COUNTY ROAD CONSTRUCTION CODE & STANDARD SPECIFICATIONS
- A TACK COAT WILL BE REQUIRED IN ACCORDANCE WITH SECTION C-31.4 OF THE HOWARD COUNTY ROAD CONSTRUCTION CODE & STANDARD SPECIFICATIONS

GENERAL NOTES

- All construction shall be done in accordance with the latest edition of the Howard County Road Construction Code and Standard Specifications.
- Contractor shall verify all existing information to his own satisfaction. The information shown is for the convenience of those concerned only. The correctness or completeness of the information given is not warranted or guaranteed.
- All existing utility companies are to be notified at least 48 hours before starting work. Contact Miss Utility at (301) 559-0100.
- Contractor is responsible for protection of all existing features not designated to be removed.
- All disturbed areas not designated to be paved or sodded shall be seeded.
- All curb and gutter shall be Howard County standard 7" combination curb and gutter drawing D-40.
- Road, service drive and parking area bituminous paving section shall be Howard County Bus Ways and Parking Areas Paving Section Drawing D-117. All other bituminous paving (track, tot lots, etc.) shall be Howard County Sidewalks, Paving Section Drawing D-117.
- CONTRACTOR WILL NOT BE ALLOWED ACCESS TO THE SITE FROM BEAVERKILL ROAD. ACCESS WILL BE PERMITTED ONLY FROM CEDAR LAKE.
- CONTRACTOR SHALL GRADE & SOD THE PROPOSED BALLFIELD NORTH OF THE EXISTING PAVED PLAY AREA BEFORE DOING ANY OTHER CONSTRUCTION.
- ALL INLET GRATES & MANHOLE FRAMES & COVERS TO BE AS SHOWN AND BE THE PROPERTY OF HOWARD COUNTY.
- CONTRACTOR SHALL ADJUST ALL EXISTING & PROPOSED UTILITIES TO FINISHED GRADE.
- CONTRACTOR SHALL INSTALL AN EXPANSION JOINT AT ALL VERTICALS & BETWEEN PROPOSED & EXISTING WORK.
- MAXIMUM SLOPE SHALL BE 5%.
- CONTRACTOR SHALL INSTALL SNOW FENCE ALONG LIMITS OF GRADING ALONG ENTIRE SIDE OF THE SITE. CONTRACTOR SHALL CONTAIN CONSTRUCTION DEBRIS ON SITE.
- SEE UTILITY PLAN & PROFILES (SHEET SD-5 & 6) FOR HUBST ELEVATIONS FOR WATER & SEWER HOUSE CONNECTIONS.



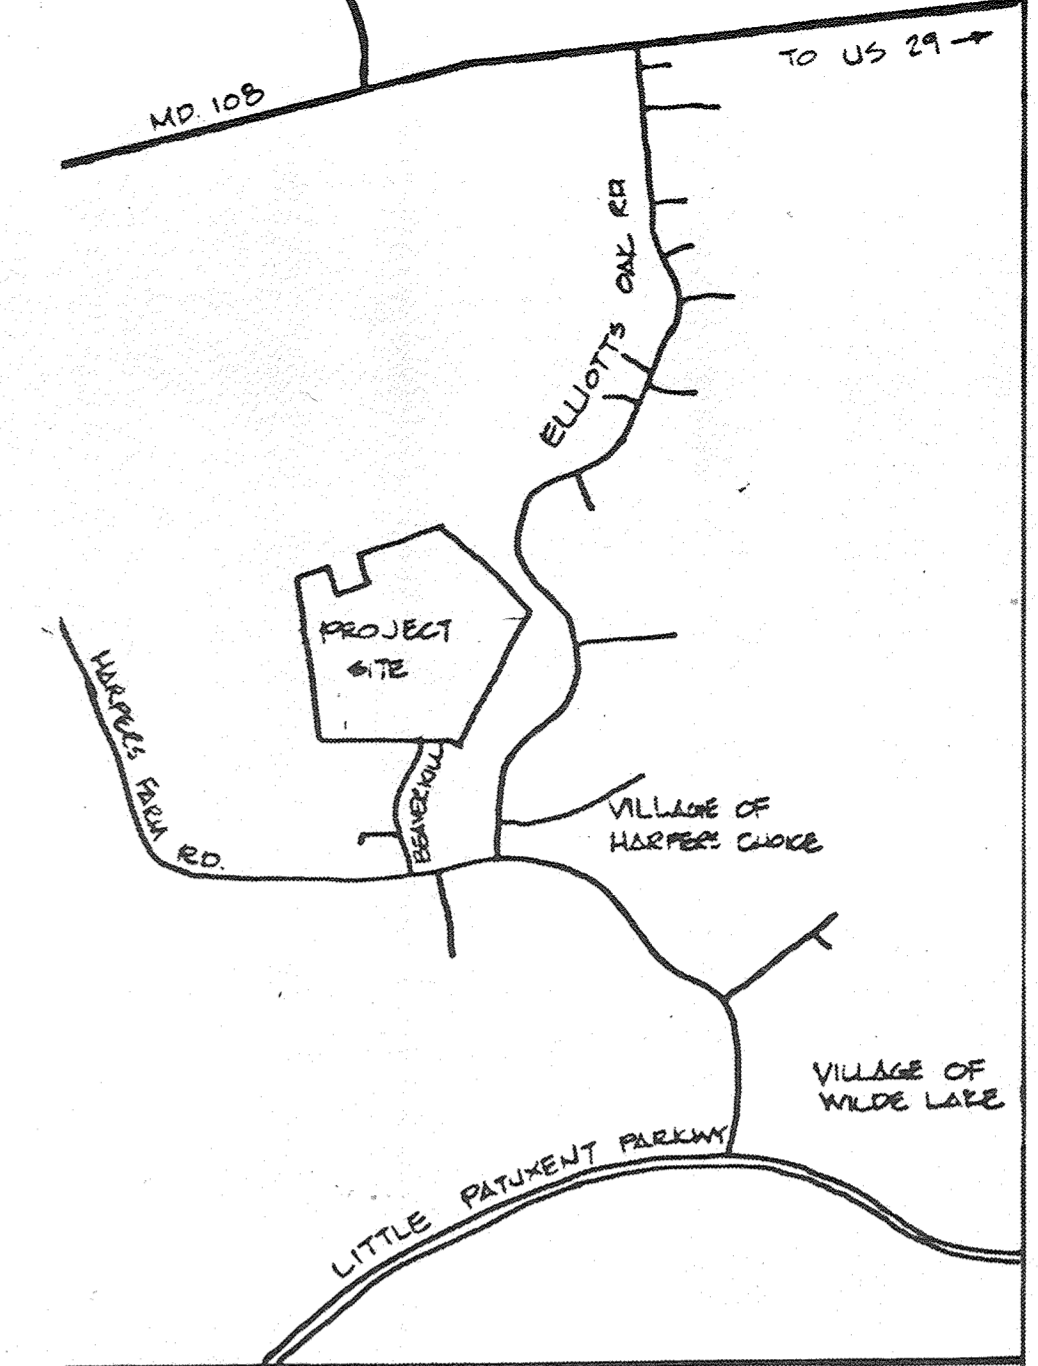


Vicinity Sketch

APPROVED: For Public Water, Public Sewerage and Storm Drainage Systems and Roads
HOWARD COUNTY DEPARTMENT OF PUBLIC WORKS
DIRECTOR: *W. F. Nimmer* DATE: 12-27-79
CHIEF, BUREAU OF ENGINEERING: *W. O. Hild* DATE: 12-27-79

APPROVED: For Public Water and Public Sewerage Systems
HOWARD COUNTY HEALTH DEPARTMENT
COUNTY HEALTH OFFICER: *John G. ...* DATE: 12-27-79

APPROVED: Howard County Office of Planning and Zoning
PLANNING DIRECTOR: *Thomas J. ...* DATE: 12-7-79
CHIEF, DIV. OF LAND DEVELOPMENT: *...* DATE: 12-7-79

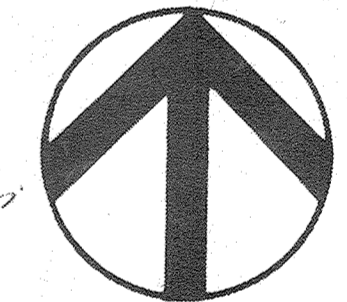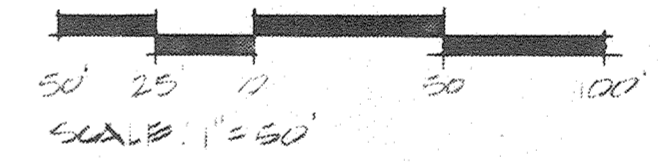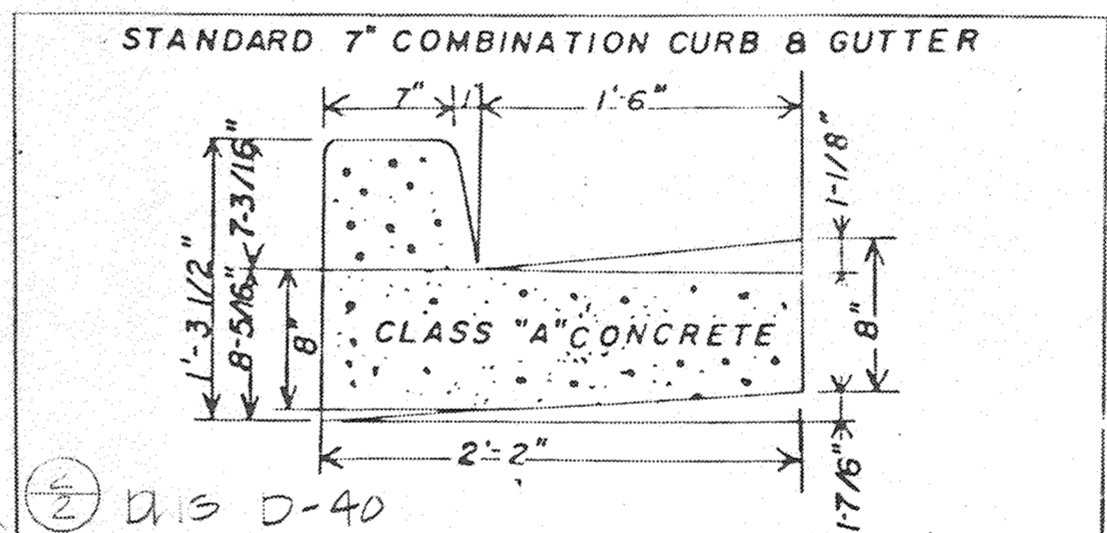

APPROVED
PLANNING BOARD
OF HOWARD COUNTY
DATE: 5-23-79
[Signature]

REVISED 7/19/79 DMK/JJA
REVISED 6/19/79 DMK/JJA

DRAINAGE AREA PLAN
HOWARD COUNTY
SPECIAL EDUCATION CENTER
VILLAGE OF HARPERS CHOICE COLUMBIA, MD.
SECTION G AREA 2
PLAT BOOK 23 FOLIO 64

TAX MAP NO. 25 PARCEL NO. 60
ELECTION DISTRICT NO. 5 HOWARD COUNTY, MARYLAND
SCALE: 1" = 50'
APRIL 11, 1979



HOWARD COUNTY
SPECIAL EDUCATION CENTER
Village of Harpers Choice
Columbia, Maryland

Browne, Worrall & Johnson / Architects
2435 North Calvert Street
Baltimore, Maryland 21218

George Evans Associates, Structural
130 West Hamilton St.
Baltimore, Maryland

Moore Lewis, Inc., Mechanical & Electrical
2435 N. Calvert St.
Baltimore, Maryland

W. Boulton Kelly, Architectural Consultant
6229 N. Charles St.
Baltimore, Maryland

Draft McCune Walker, Landscape & Civil
530 E. Joppa Rd.
Towson, Maryland

SD-4
OP 21

APPROVED: For public Water, Public Sewerage and Storm Drainage Systems and Roads

HOWARD COUNTY DEPARTMENT OF PUBLIC WORKS

W. F. J. J. J.
DIRECTOR
W. O. L. L.
CHIEF, BUREAU OF ENGINEERING

12-3-79
DATE
12-3-79
DATE

APPROVED: For public Water and Public Sewerage Systems

HOWARD COUNTY HEALTH DEPARTMENT

R. J. J. J.
COUNTY HEALTH OFFICER

11-5-79
DATE

APPROVED: Howard County Office of Planning and Zoning



P. J. J. J.
PLANNING DIRECTOR

12-7-79
DATE
12-7-79
DATE

CHIEF, DIVISION OF LAND DEVELOPMENT

STRUCTURE SCHEDULE

NO.	TYPE	INV. IN.	INV. OUT.	TOP ELEV.	REMARKS
M-1	STD. M.H.	401.16	400.96	417.00	DWG. P. 103, PG. 153
M-2	"	-	478.00	477.00	"
M-3	"	404.48	403.16	408.00	"
M-4	"	401.78	401.22	407.80	"
M-5	"	409.57	408.07	474.10	"
M-6	"	408.15	407.90	474.00	"
M-7	"	465.50	465.30	473.00	"
M-8	"	434.01	433.96	465.50	"
M-9	"	452.00	451.80	459.00	"

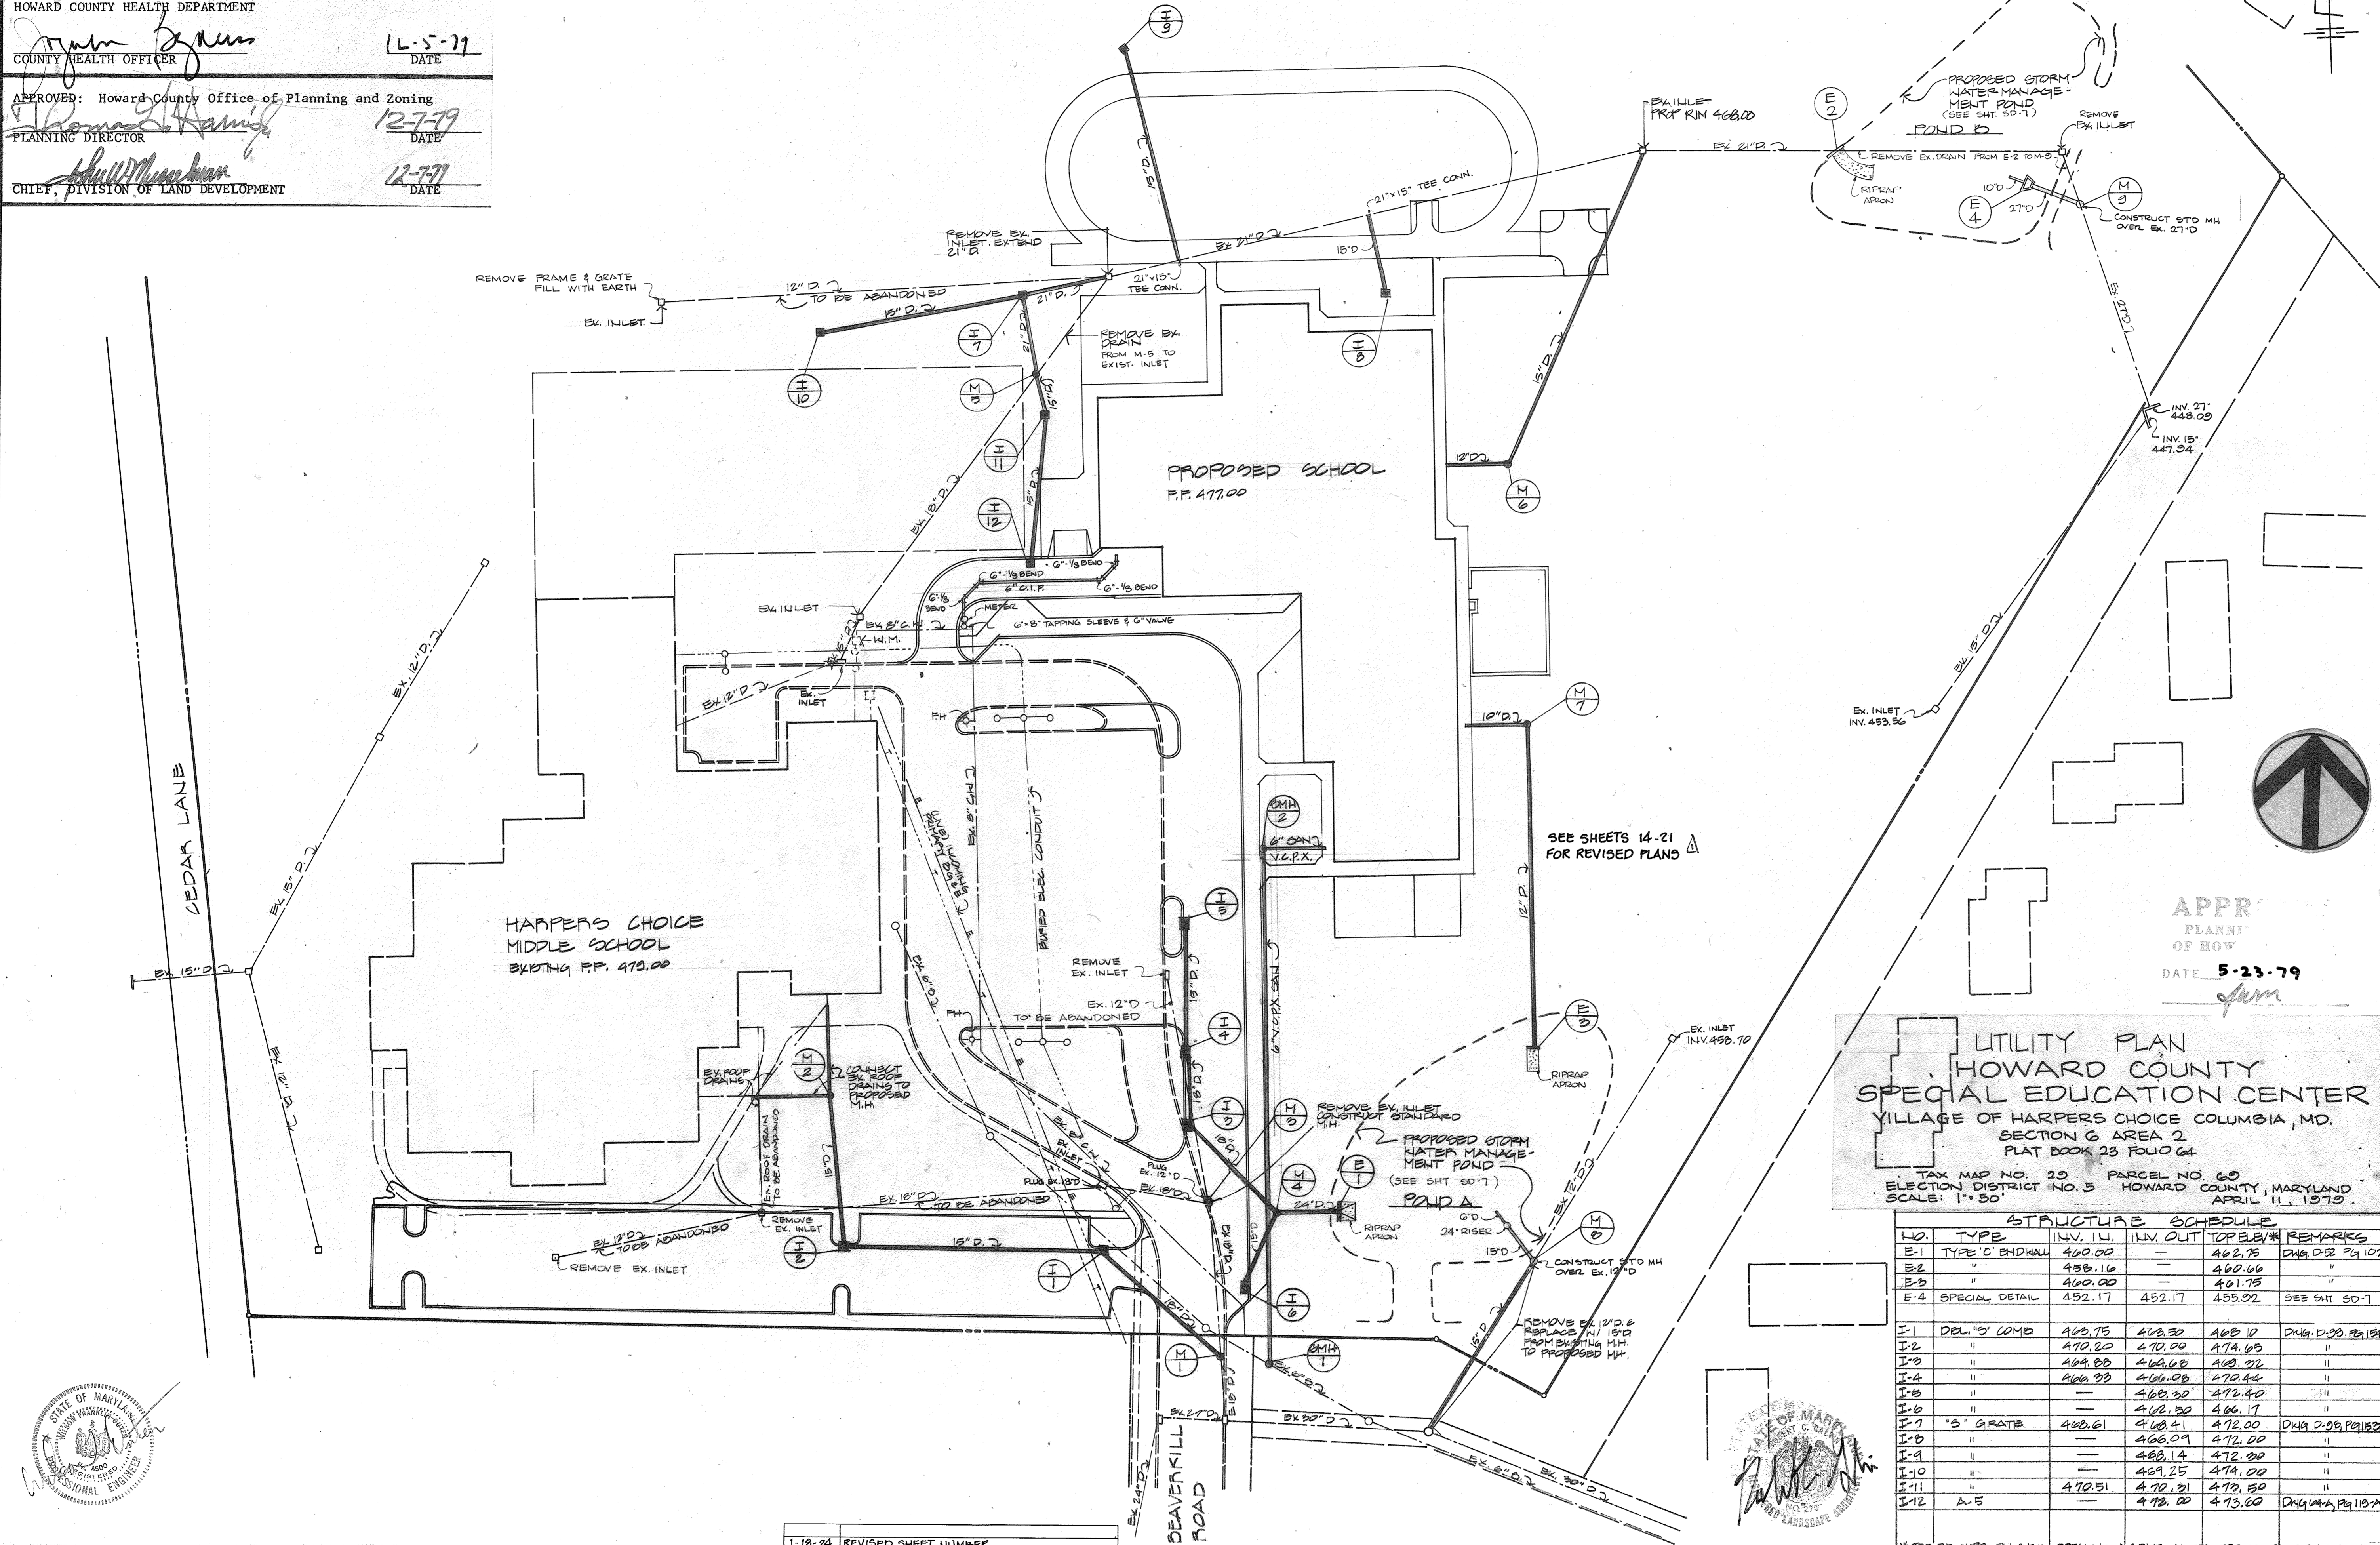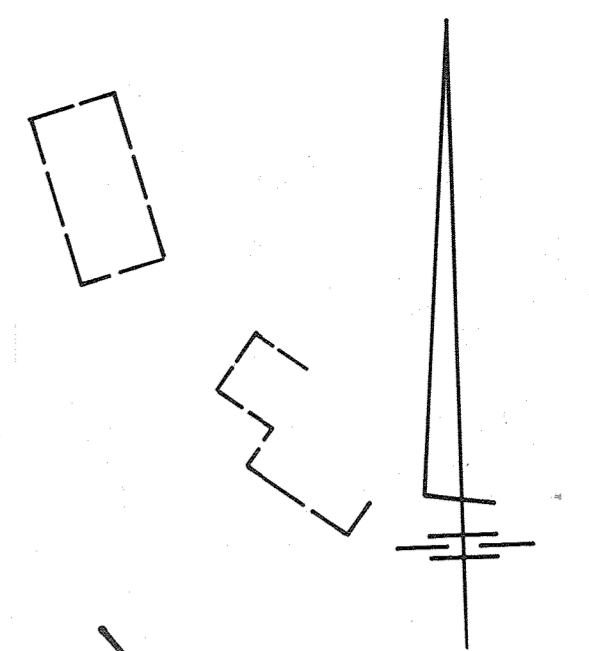



UTILITY PLAN
HOWARD COUNTY
SPECIAL EDUCATION CENTER
VILLAGE OF HARPERS CHOICE COLUMBIA, MD.
SECTION G AREA 2
PLAT BOOK 23 FOLIO 64

TAX MAP NO. 20 PARCEL NO. 60
ELECTION DISTRICT NO. 5 HOWARD COUNTY, MARYLAND
SCALE: 1" = 50'

STRUCTURE SCHEDULE

NO.	TYPE	INV. IN.	INV. OUT.	TOP ELEV.	REMARKS
E-1	TYPE 'C' BNDWLL	400.00	-	402.75	DWG. DET. PG. 107
E-2	"	458.16	-	460.00	"
E-3	"	460.00	-	461.75	"
E-4	SPECIAL DETAIL	452.17	452.17	455.00	SEE SHT. SD-7
I-1	DEL. '5' COMB	403.75	403.50	408.10	DWG. D. 09, PG. 153
I-2	"	470.20	470.00	474.05	"
I-3	"	464.00	464.00	468.00	"
I-4	"	464.00	464.00	470.44	"
I-5	"	-	468.30	472.40	"
I-6	"	-	462.50	466.17	"
I-7	'5' GRATE	468.01	468.41	472.00	DWG. D. 09, PG. 153
I-8	"	-	466.09	472.00	"
I-9	"	-	468.14	472.00	"
I-10	"	-	469.25	474.00	"
I-11	"	470.51	470.51	473.50	"
I-12	A-5	-	472.00	473.00	DWG. D. 09, PG. 153

* DP OF CURB ON CURB OPENING, * COMB. INLETS, TOP OF GRATE ON GRATE INLET

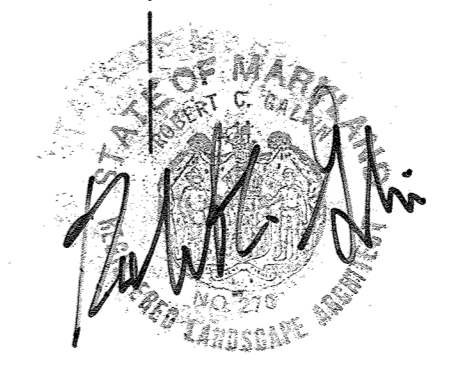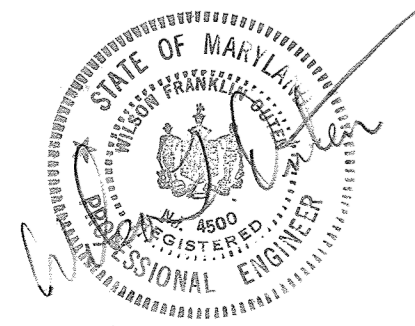

HOWARD COUNTY
SPECIAL EDUCATION CENTER
Village of Harper's Choice
Columbia, Maryland


Browne, Worrall & Johnson / Architects
2435 North Calvert Street
Baltimore, Maryland 21218

George Evans Associates, Structural
130 West Hamilton St.
Baltimore, Maryland

Moore Lewis, Inc., Mechanical & Electrical
2435 N. Calvert St.
Baltimore, Maryland

Dart McCune Walker, Landscape & Civil
530 E. Joppa Rd.
Towson, Maryland

SD-5
OF 21

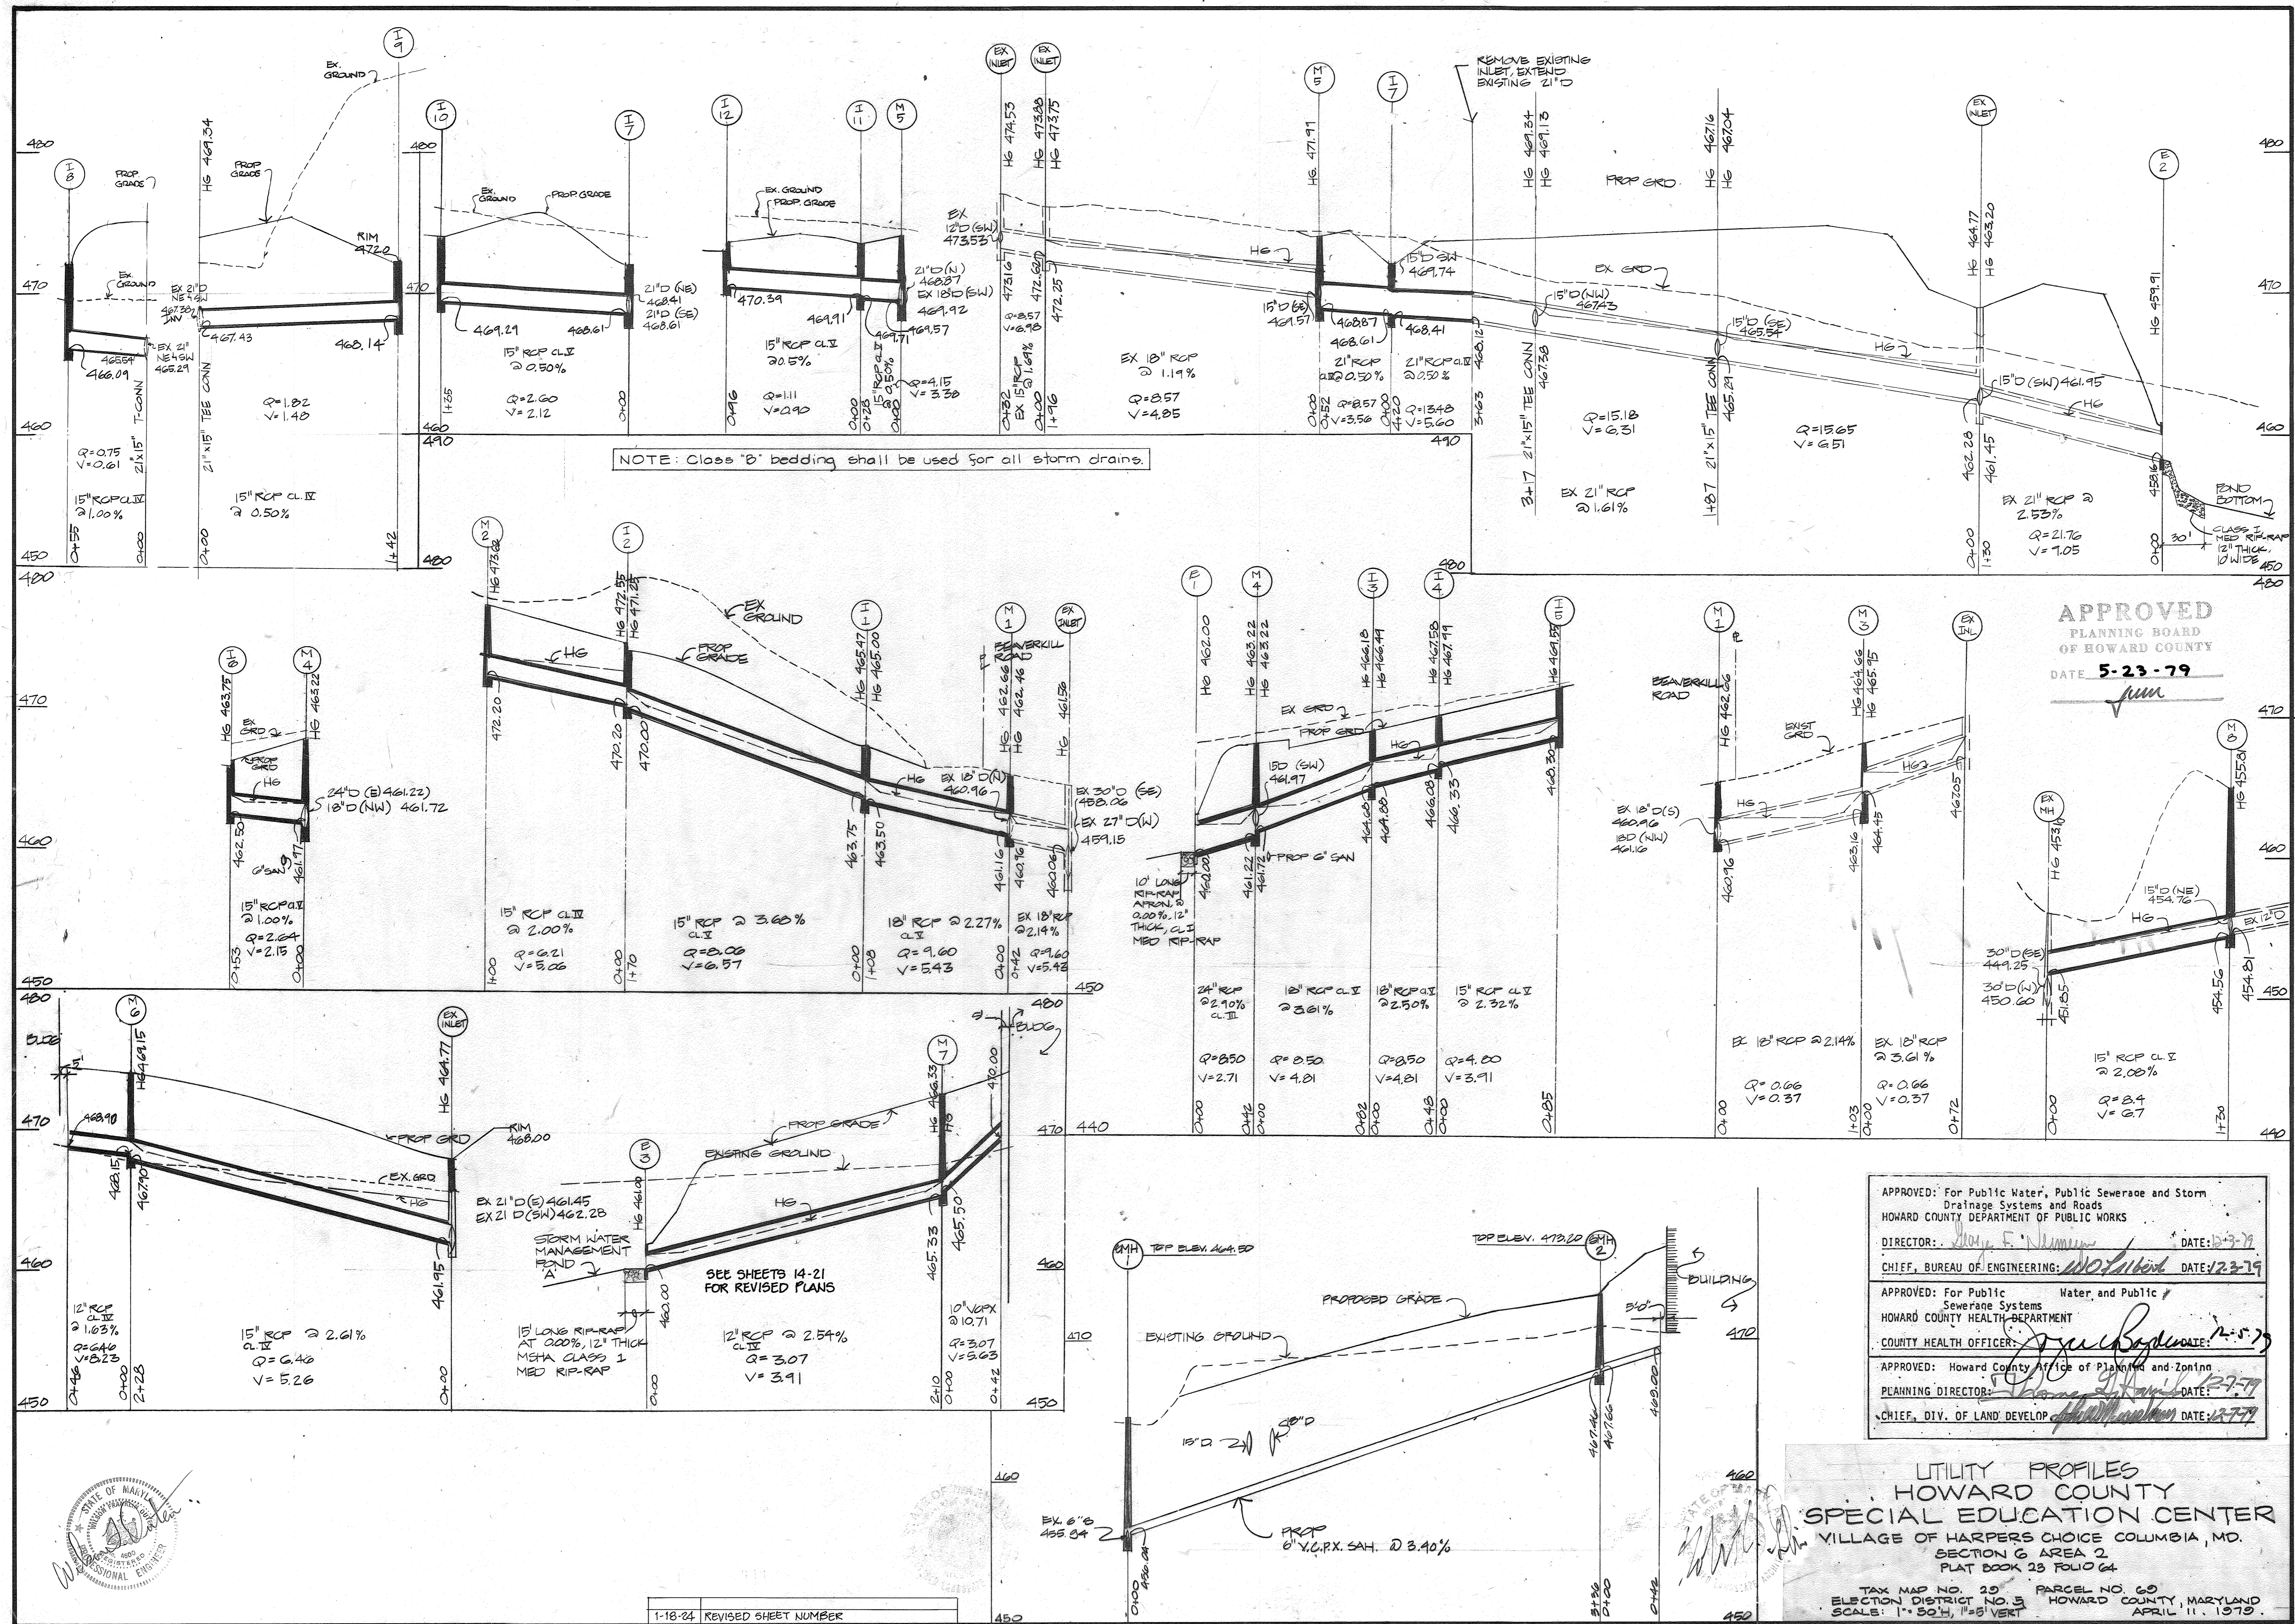

1-18-24 REVISED SHEET NUMBER

BUILDING ADDITION TO SDP-72-672
MAY 17, 1979
PLAT BOOK 23 FOLIO 64

HOWARD COUNTY
SPECIAL EDUCATION CENTER
Village of Harper's Choice
Columbia, Maryland

Browne, Worrall & Johnson / Architects
Baltimore, Maryland 21218

George Evans Associates, Structural
150 West Hamilton St. Baltimore, Maryland

Moore Lewis, Inc., Mechanical & Electrical
2435 N. Calvert St. Baltimore, Maryland

APPROVED: For Public Water, Public Sewerage and Storm Drainage Systems and Roads
HOWARD COUNTY DEPARTMENT OF PUBLIC WORKS

DIRECTOR: *Ray F. Williams* DATE: 5-23-79

CHIEF, BUREAU OF ENGINEERING: *W. J. Williams* DATE: 5-23-79

APPROVED: For Public Water and Public Sewerage Systems
HOWARD COUNTY HEALTH DEPARTMENT

COUNTY HEALTH OFFICER: *James R. Williams* DATE: 5-23-79

APPROVED: Howard County Office of Planning and Zoning
PLANNING DIRECTOR: *James R. Williams* DATE: 5-23-79




















CHIEF, DIV. OF LAND DEVELOPMENT: *James R. Williams* DATE: 5-23-79

SD-6
97-21
SDP-74-125C

STORM WATER MANAGEMENT DETAILS
 HOWARD COUNTY
 SPECIAL EDUCATION CENTER
 VILLAGE OF HARPERS CHOICE COLUMBIA, MD.

SECTION 2 AREA 2
 PLAT BOOK 23 FOLIO 64
 TAX MAP NO. 25 PARCEL NO. 60
 ELECTION DISTRICT NO. 5 HOWARD COUNTY, MARYLAND
 SCALE: AS SHOWN

Site Development Plan approved for Soil Erosion and Sediment Control by the Howard County Soil Conservation District.
 William V. Howe Date: 11/21/79
 Reviewed for Howard County Soil Conservation District and meets technical requirements.
 James M. Helmick Date: 1/21/79

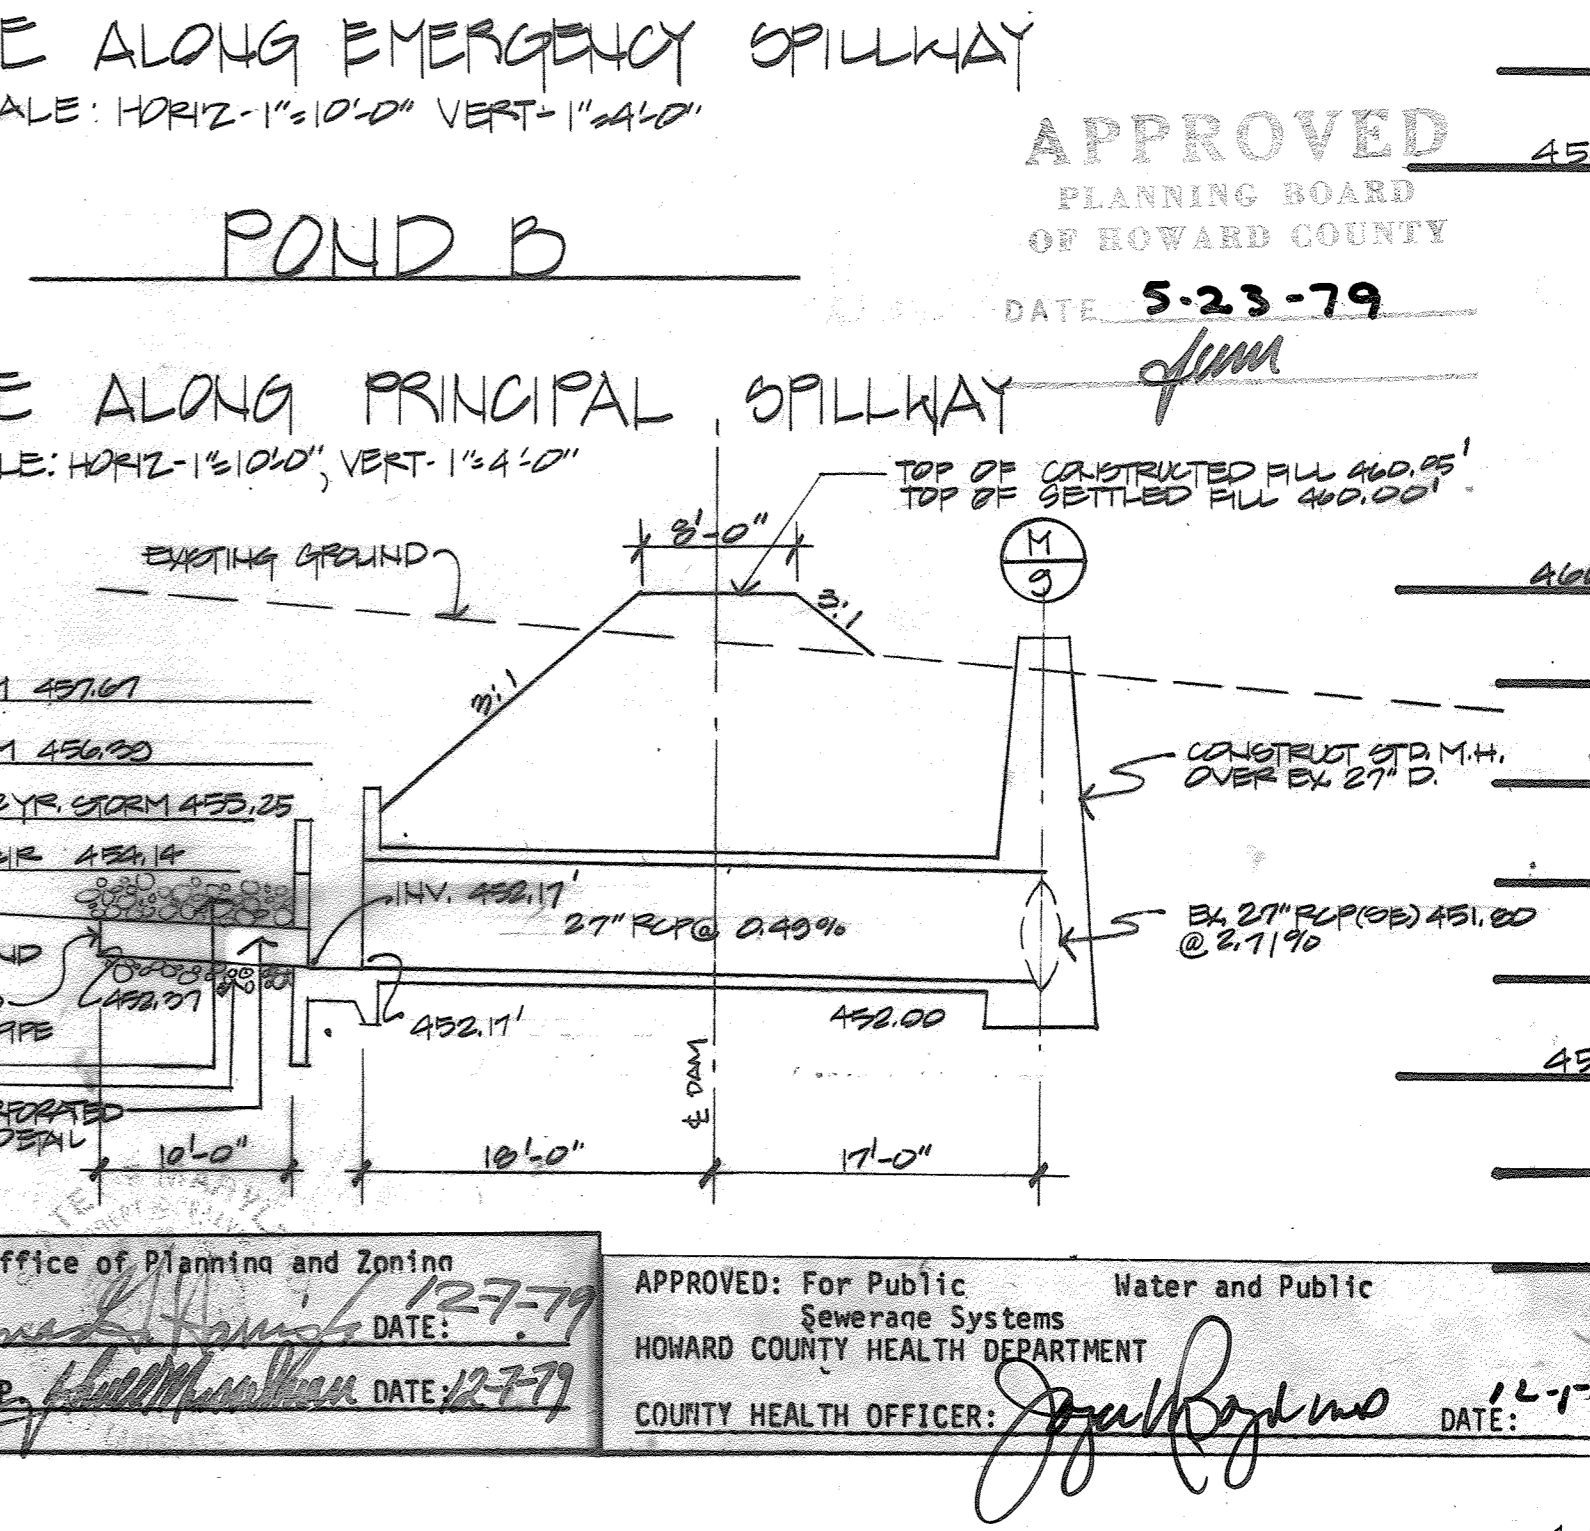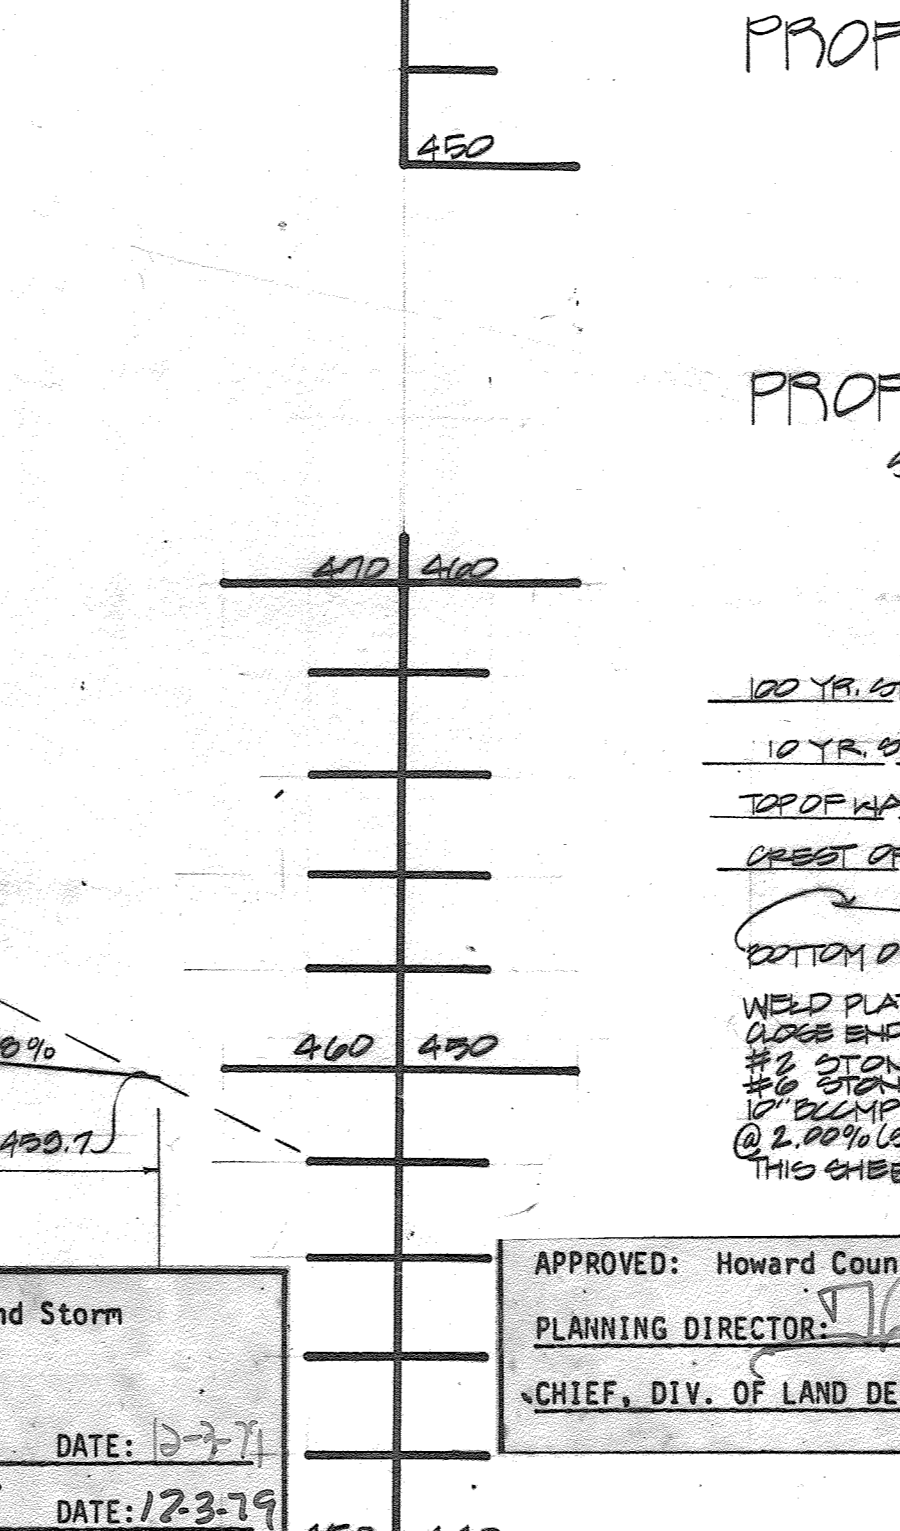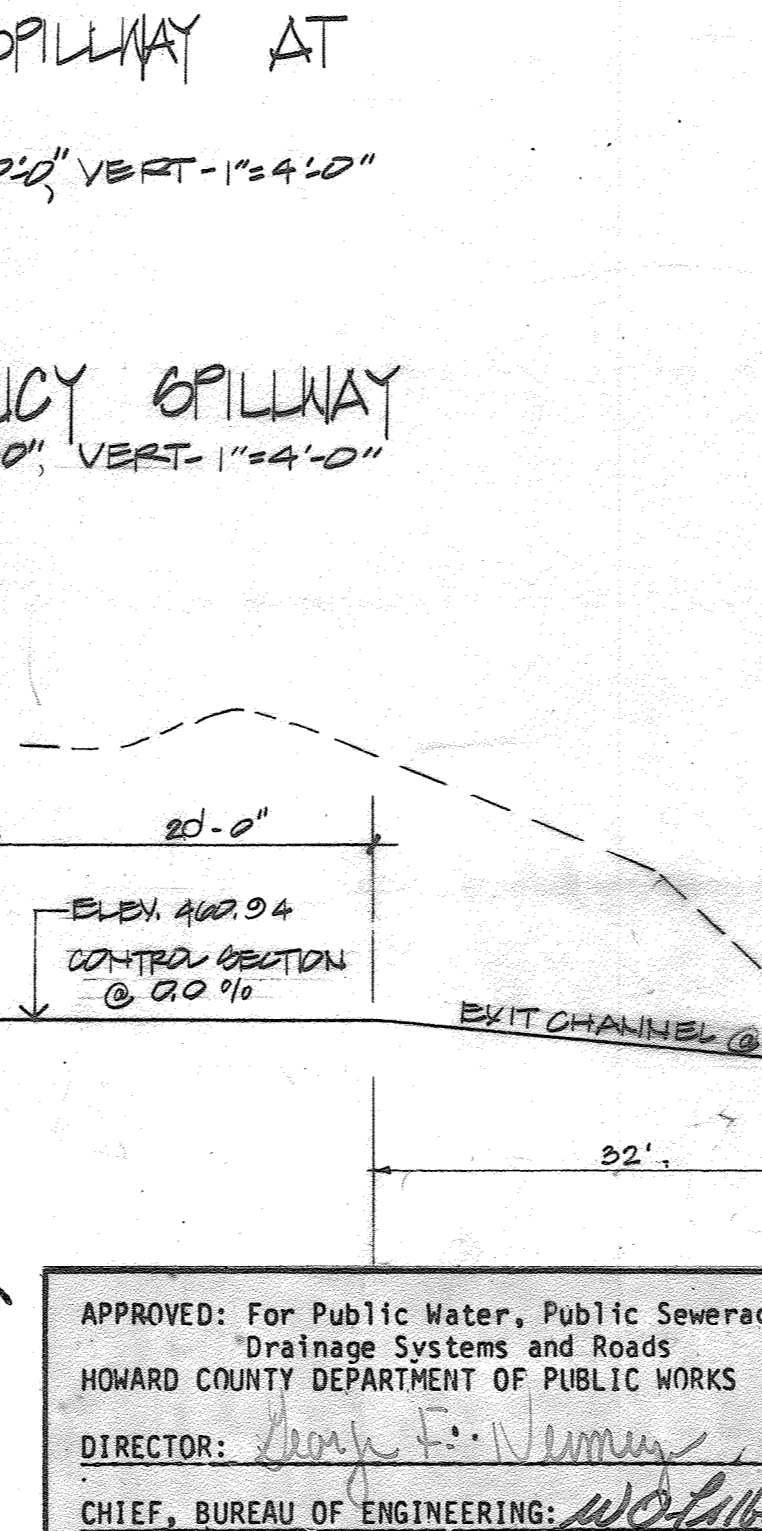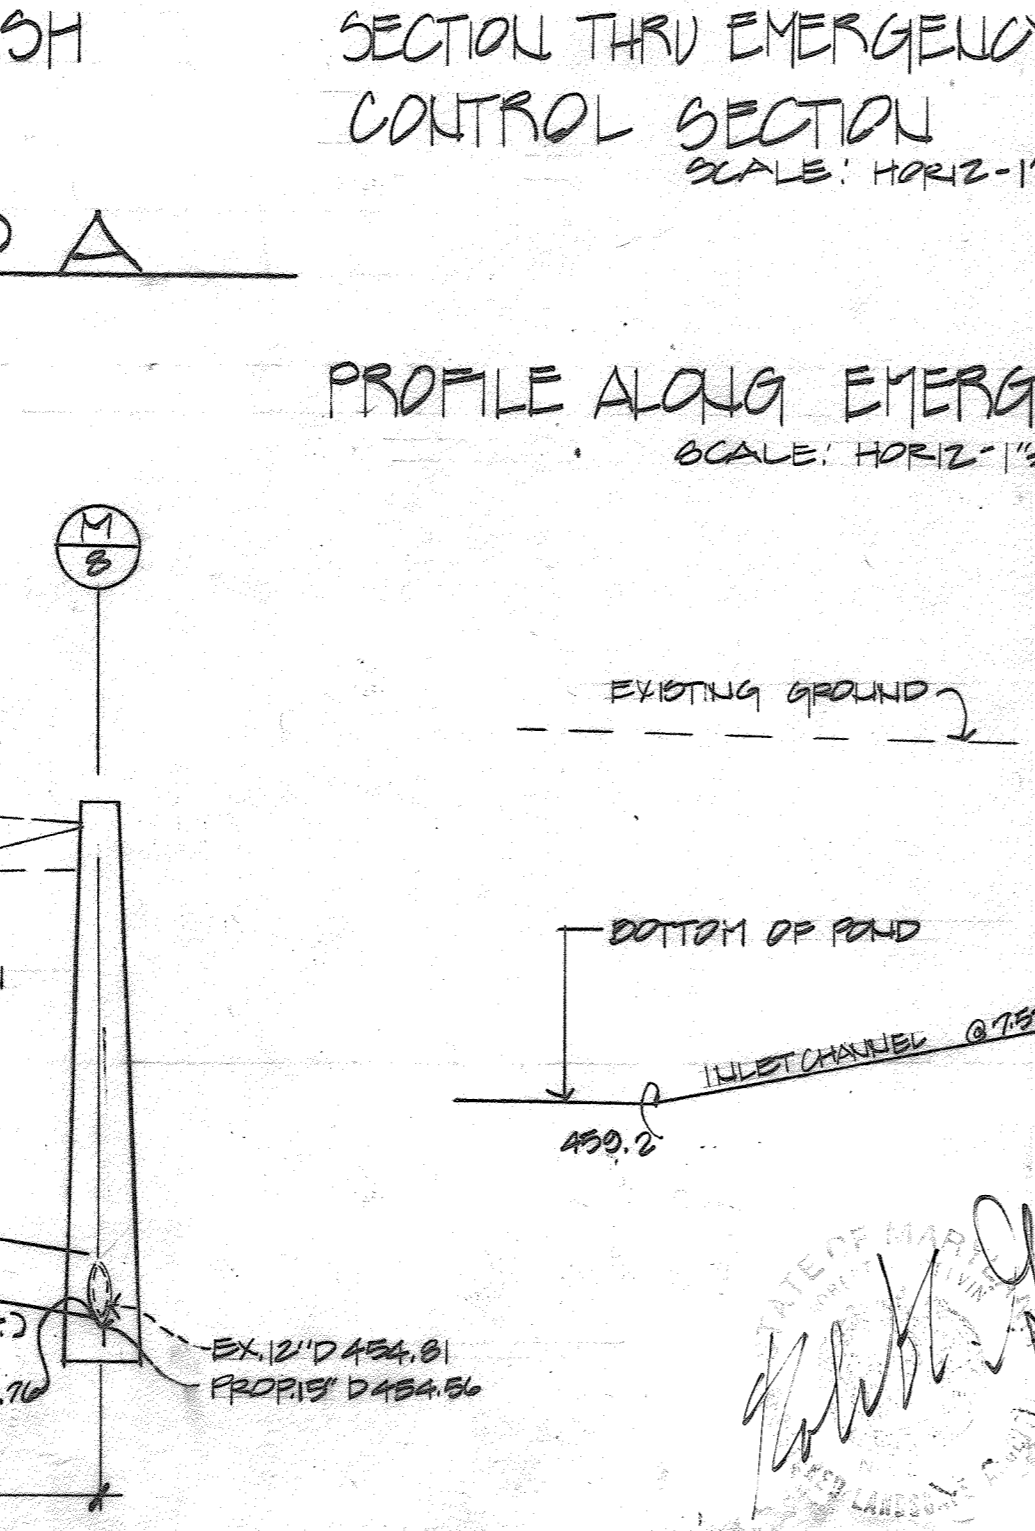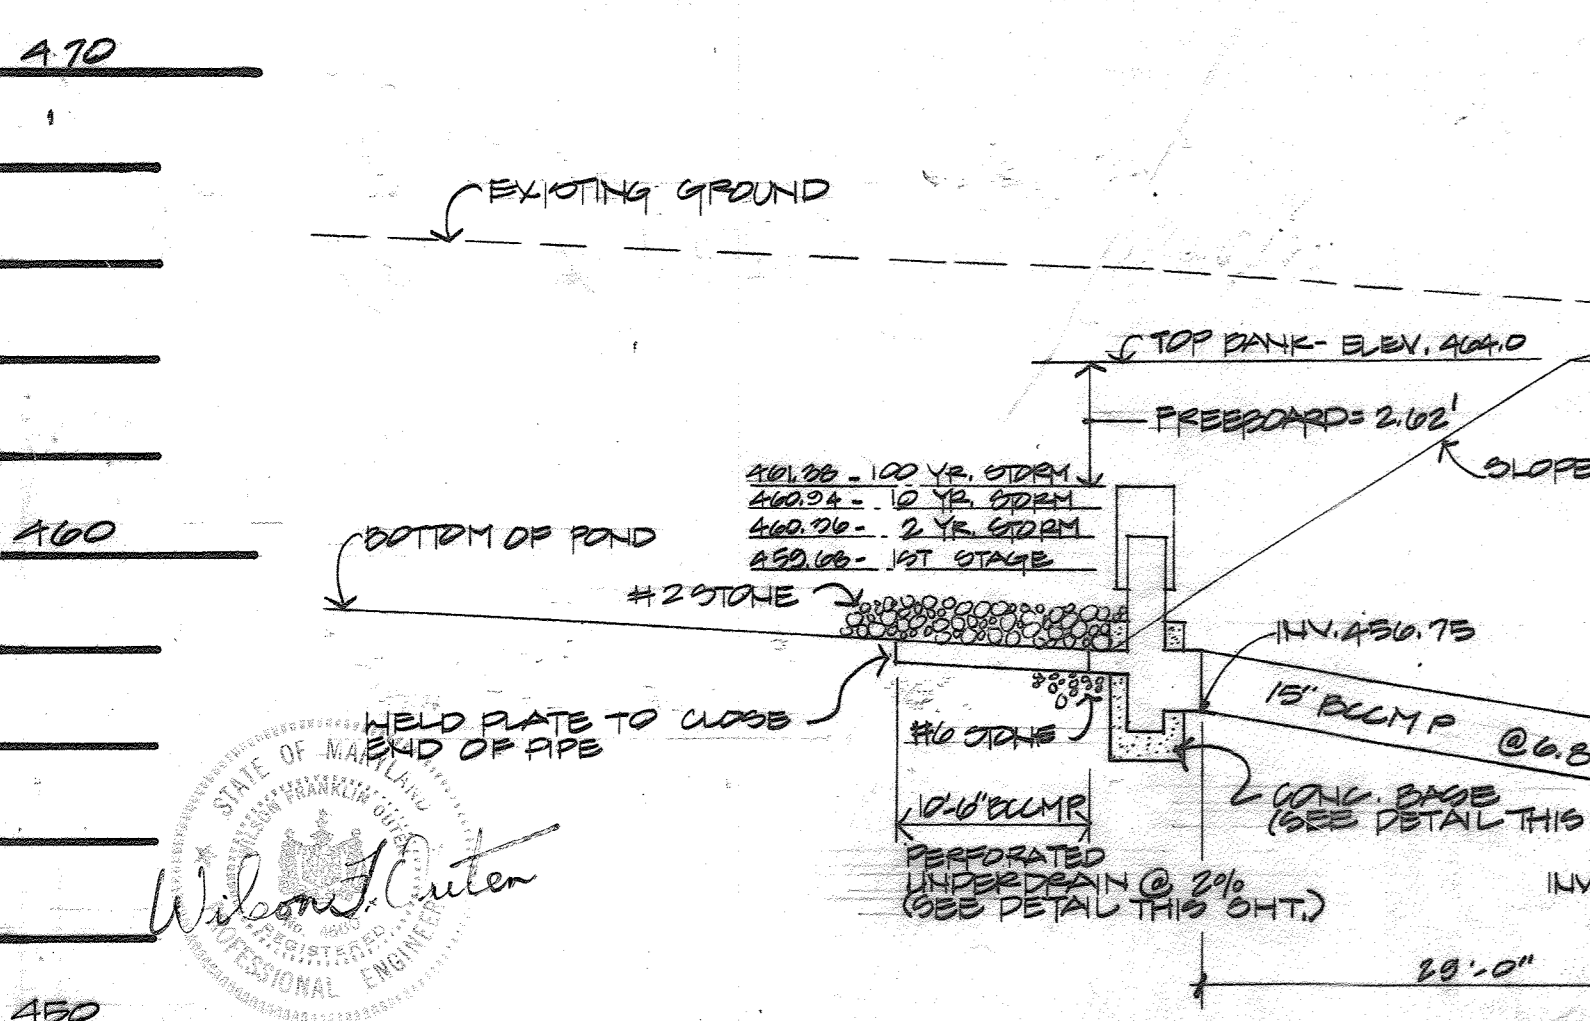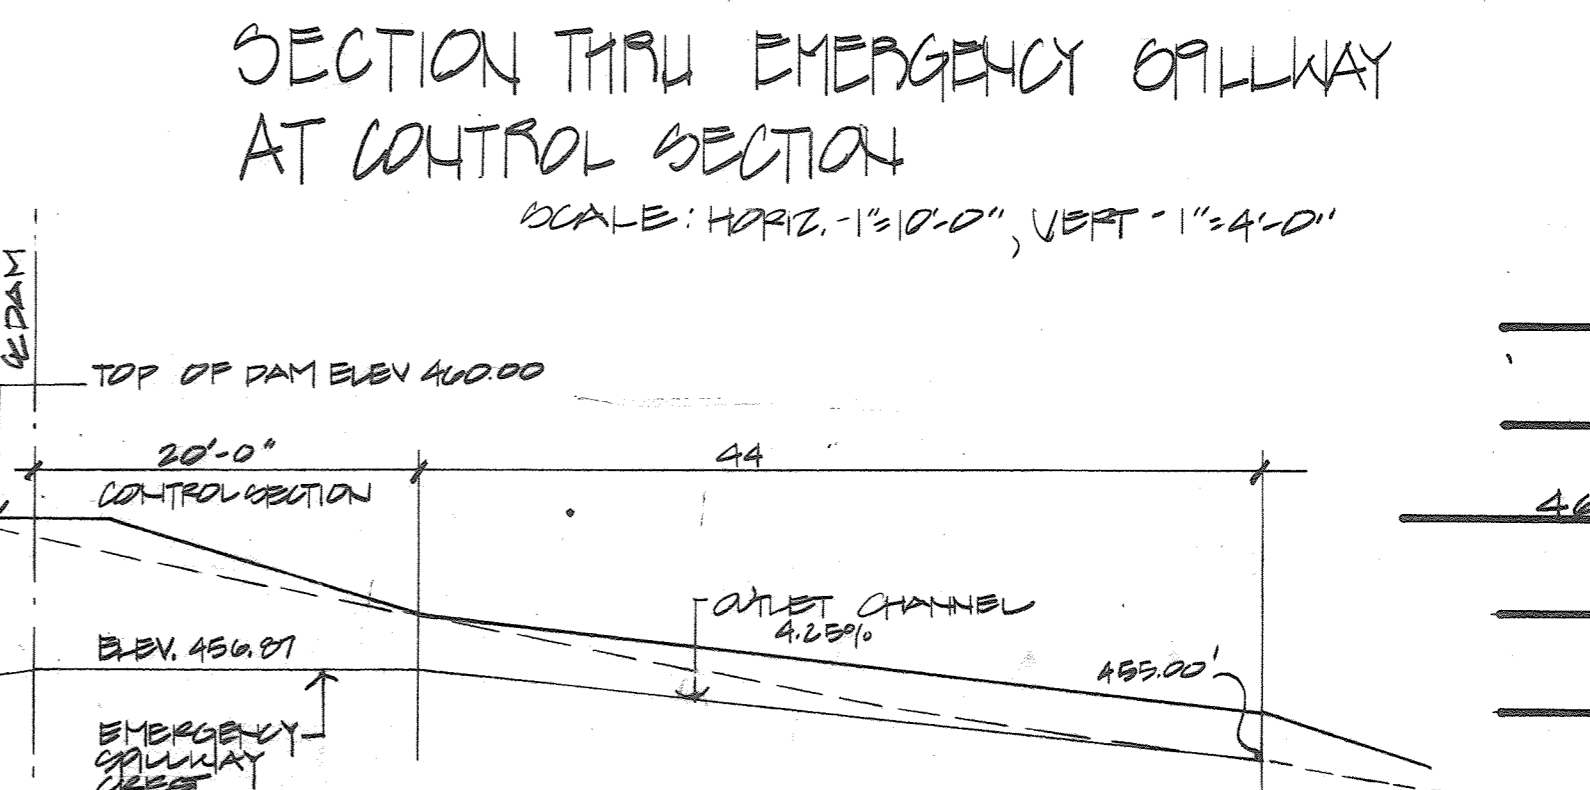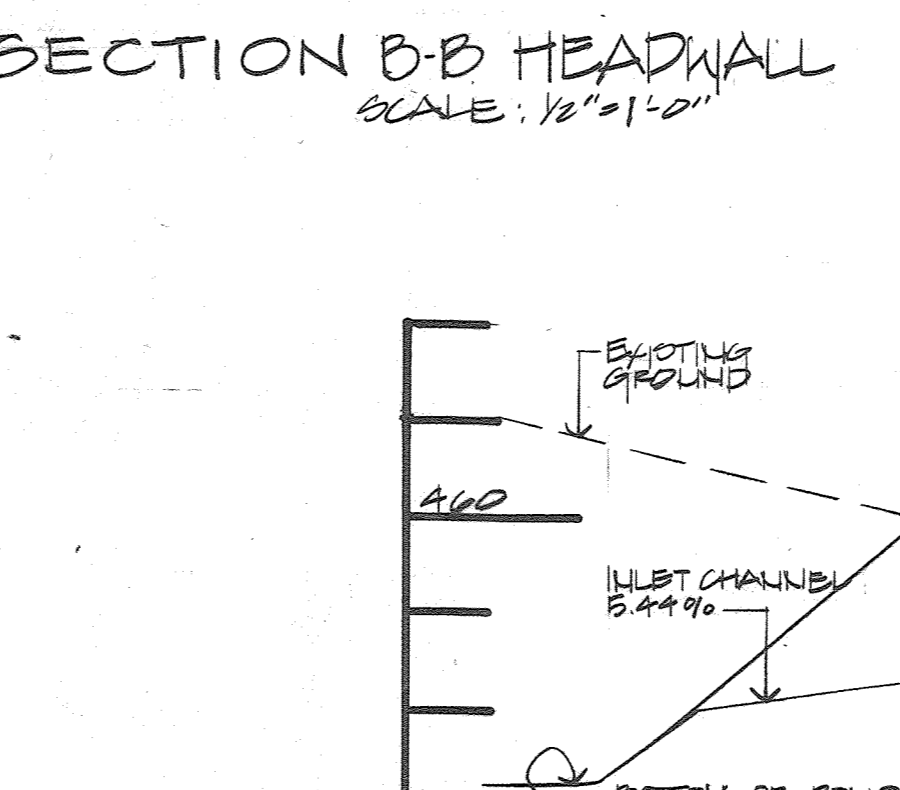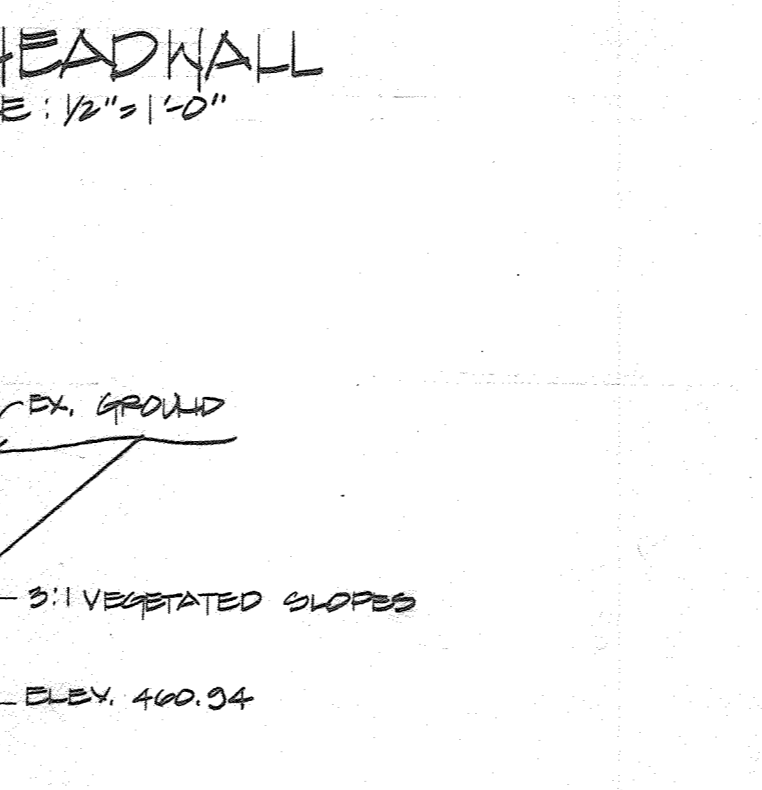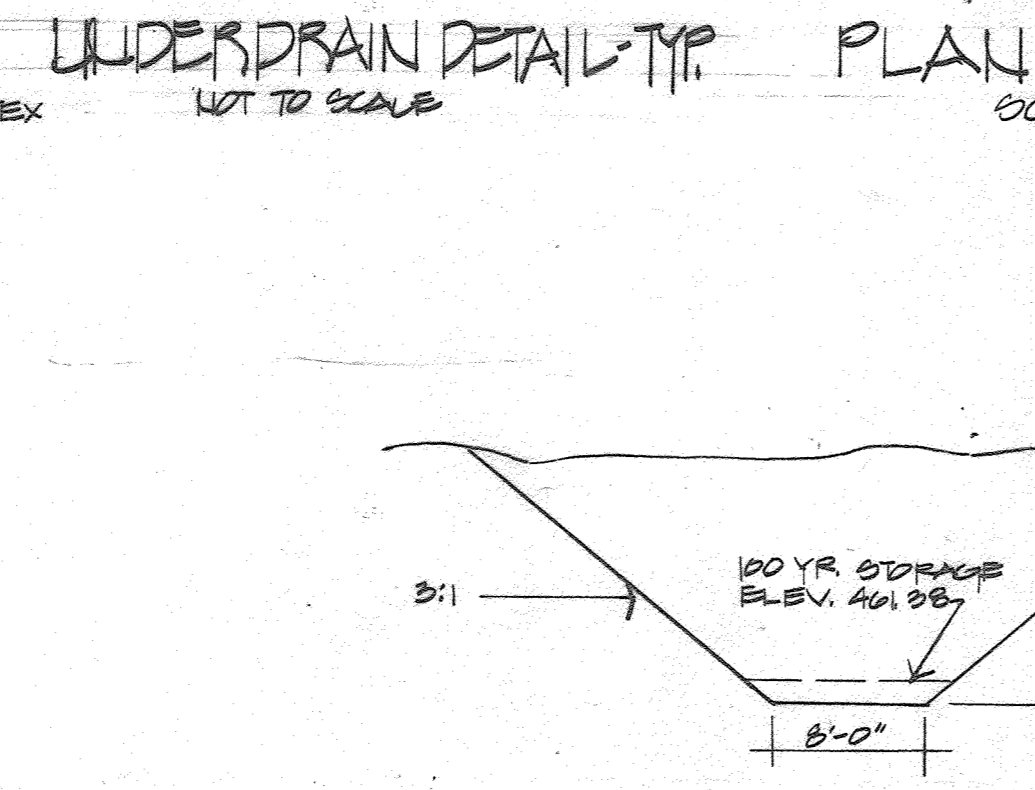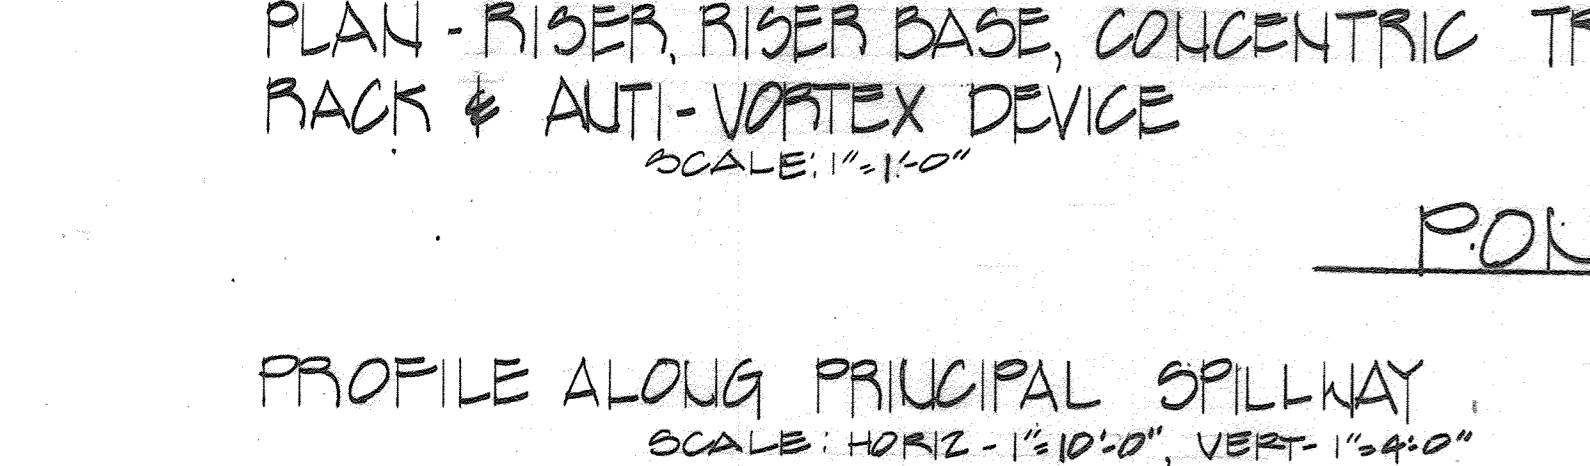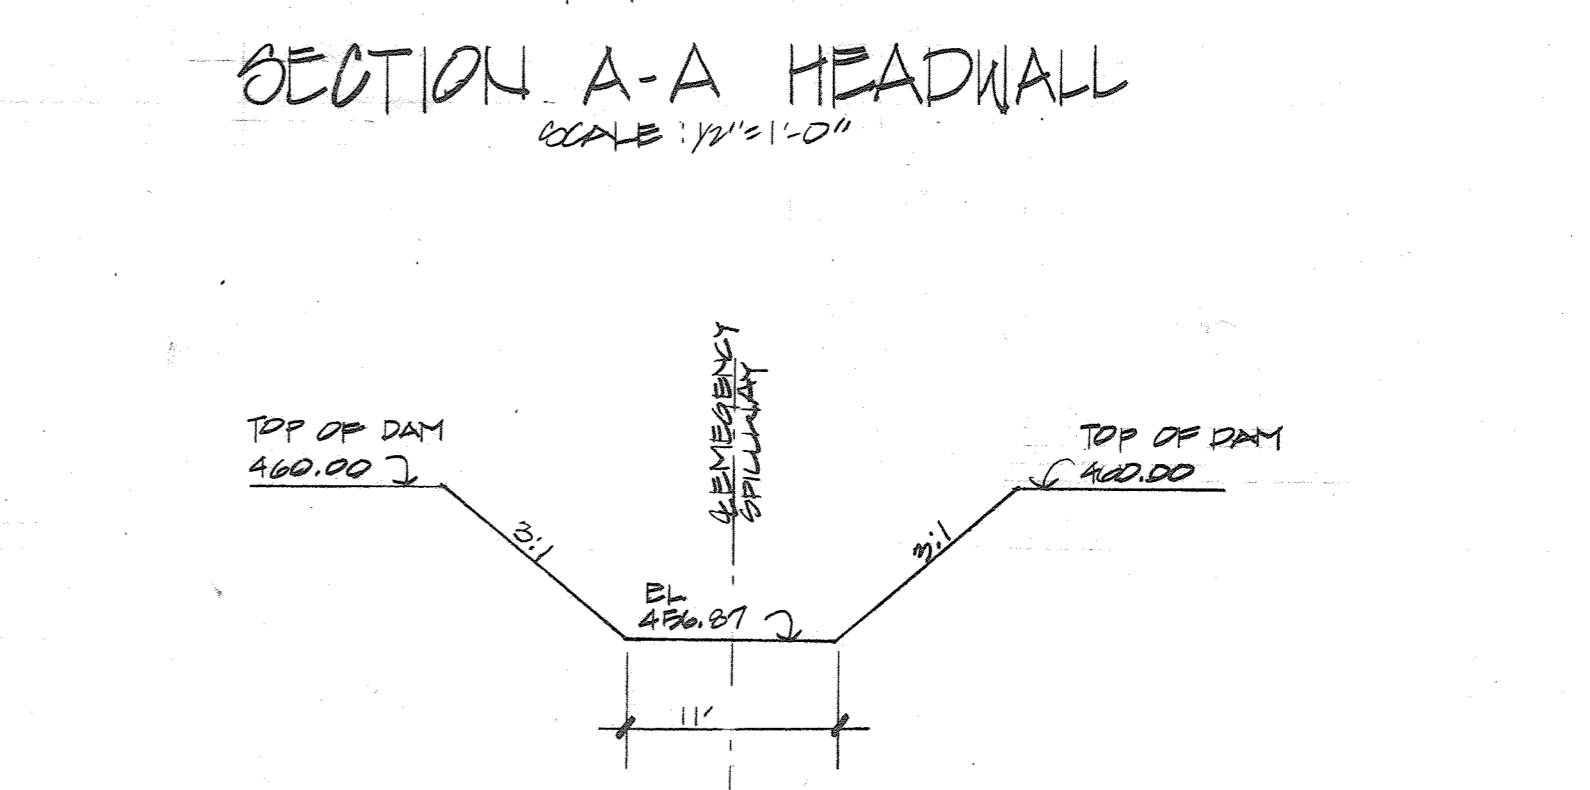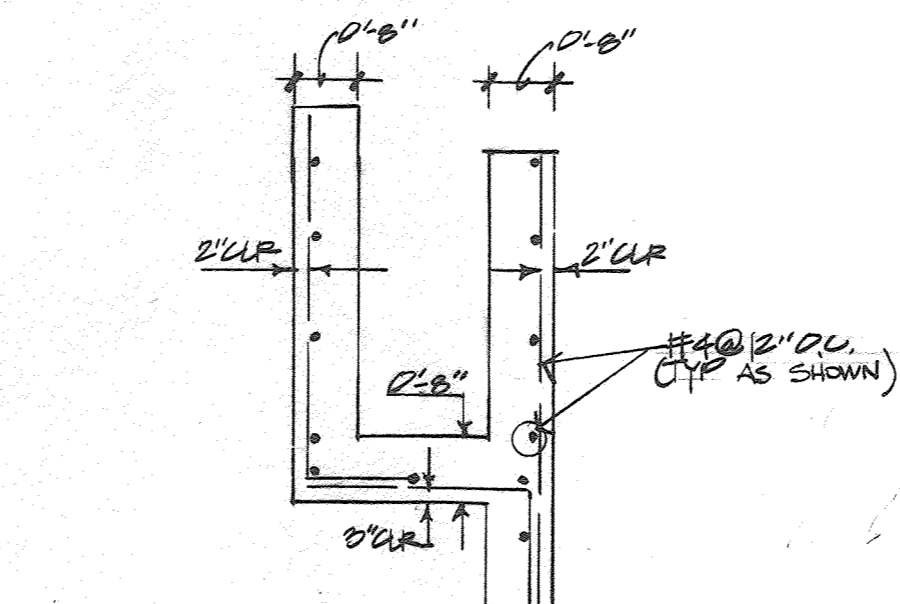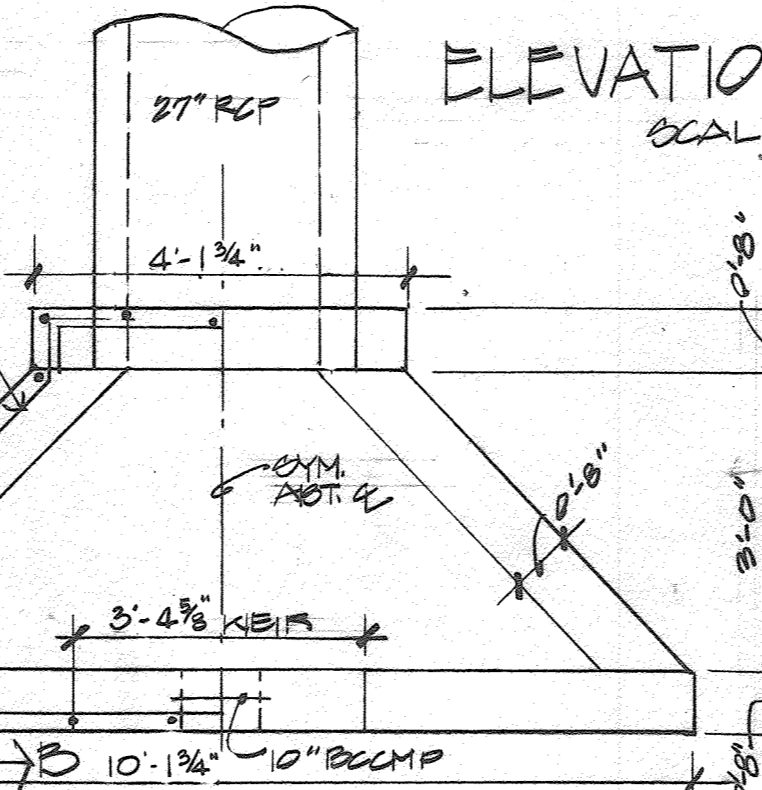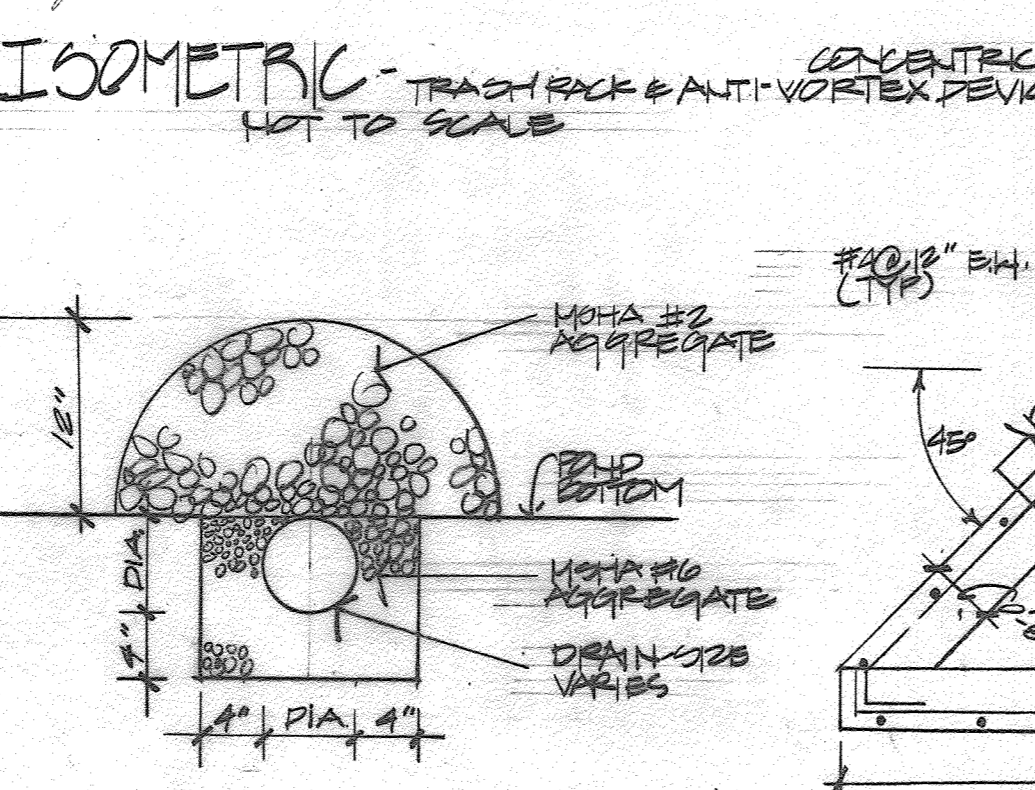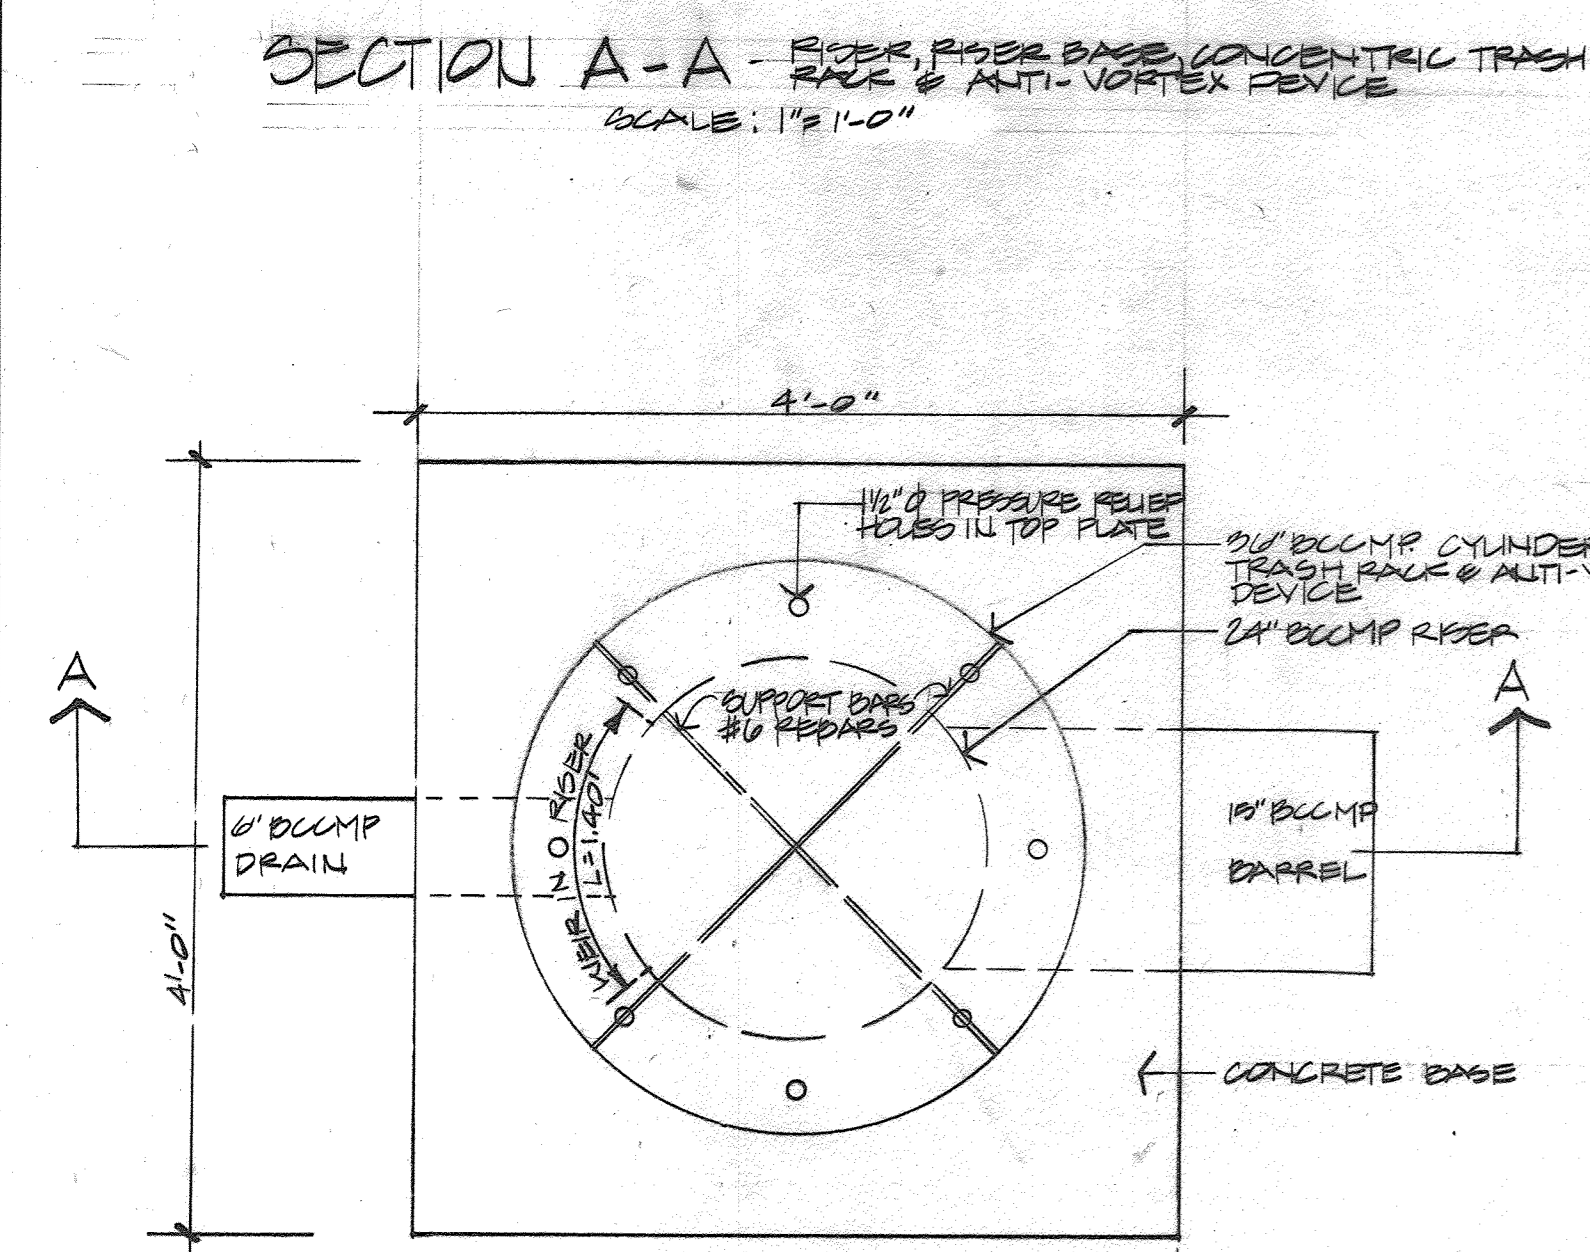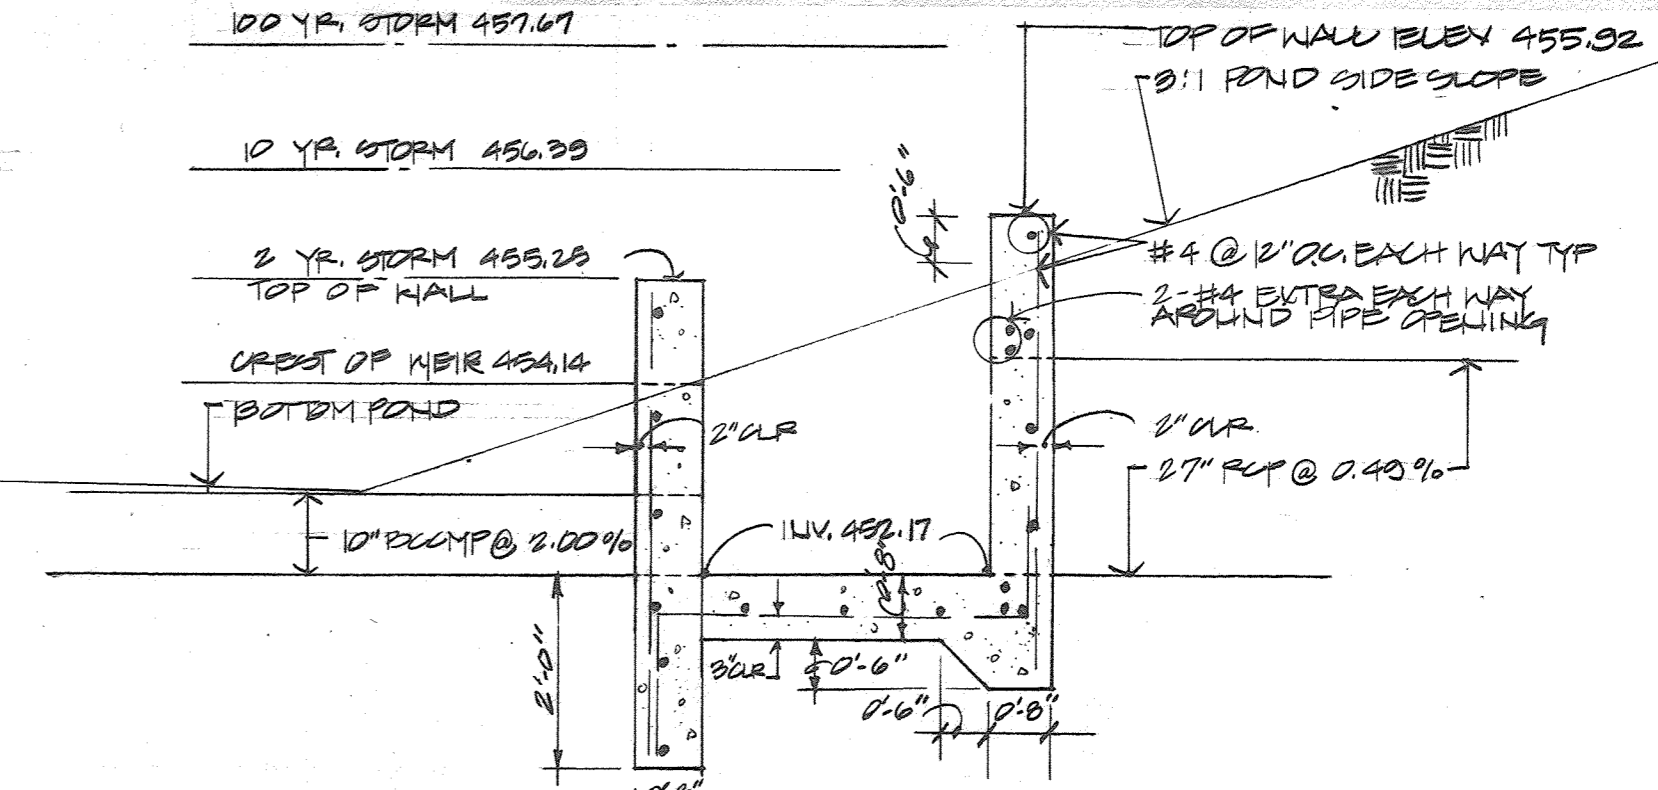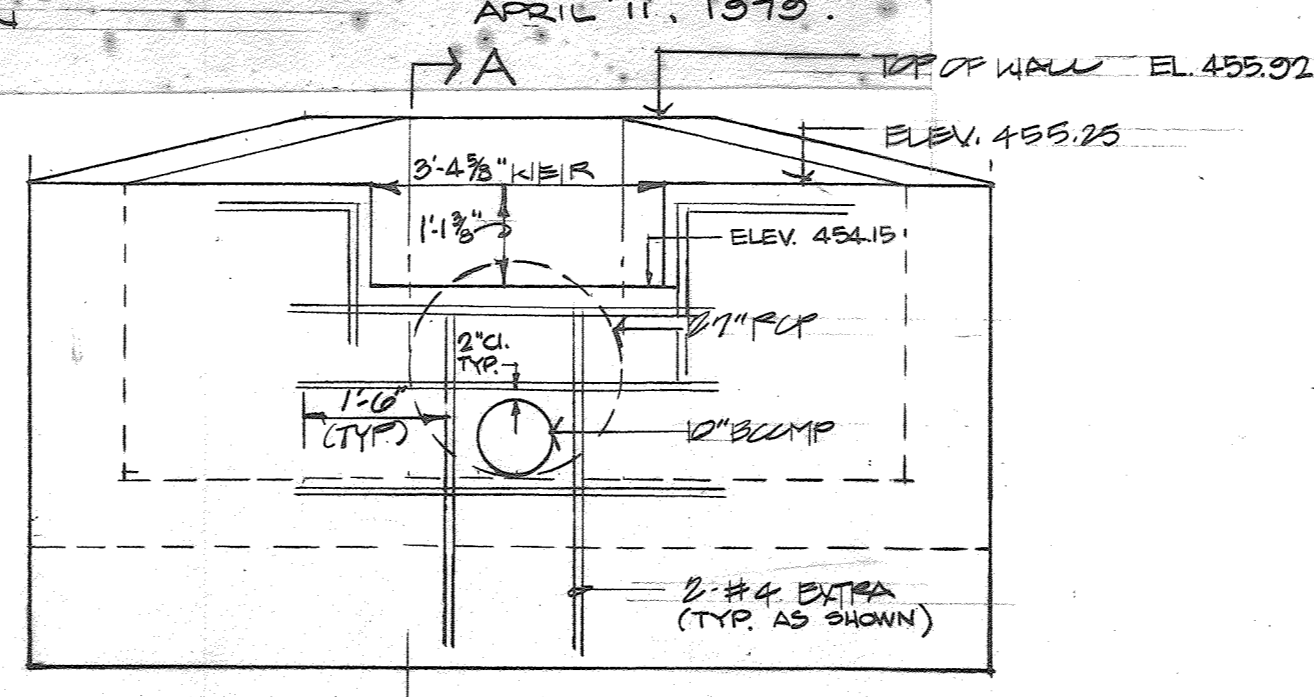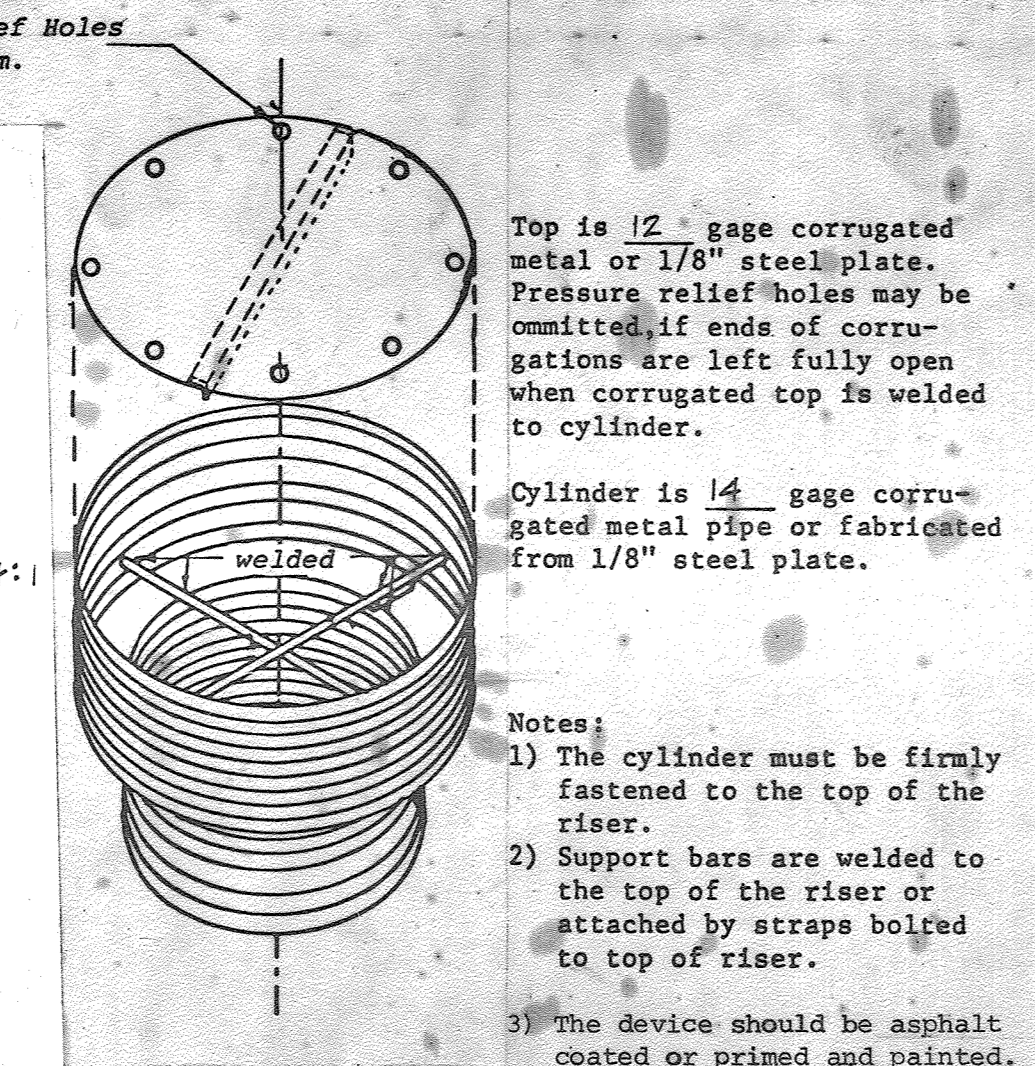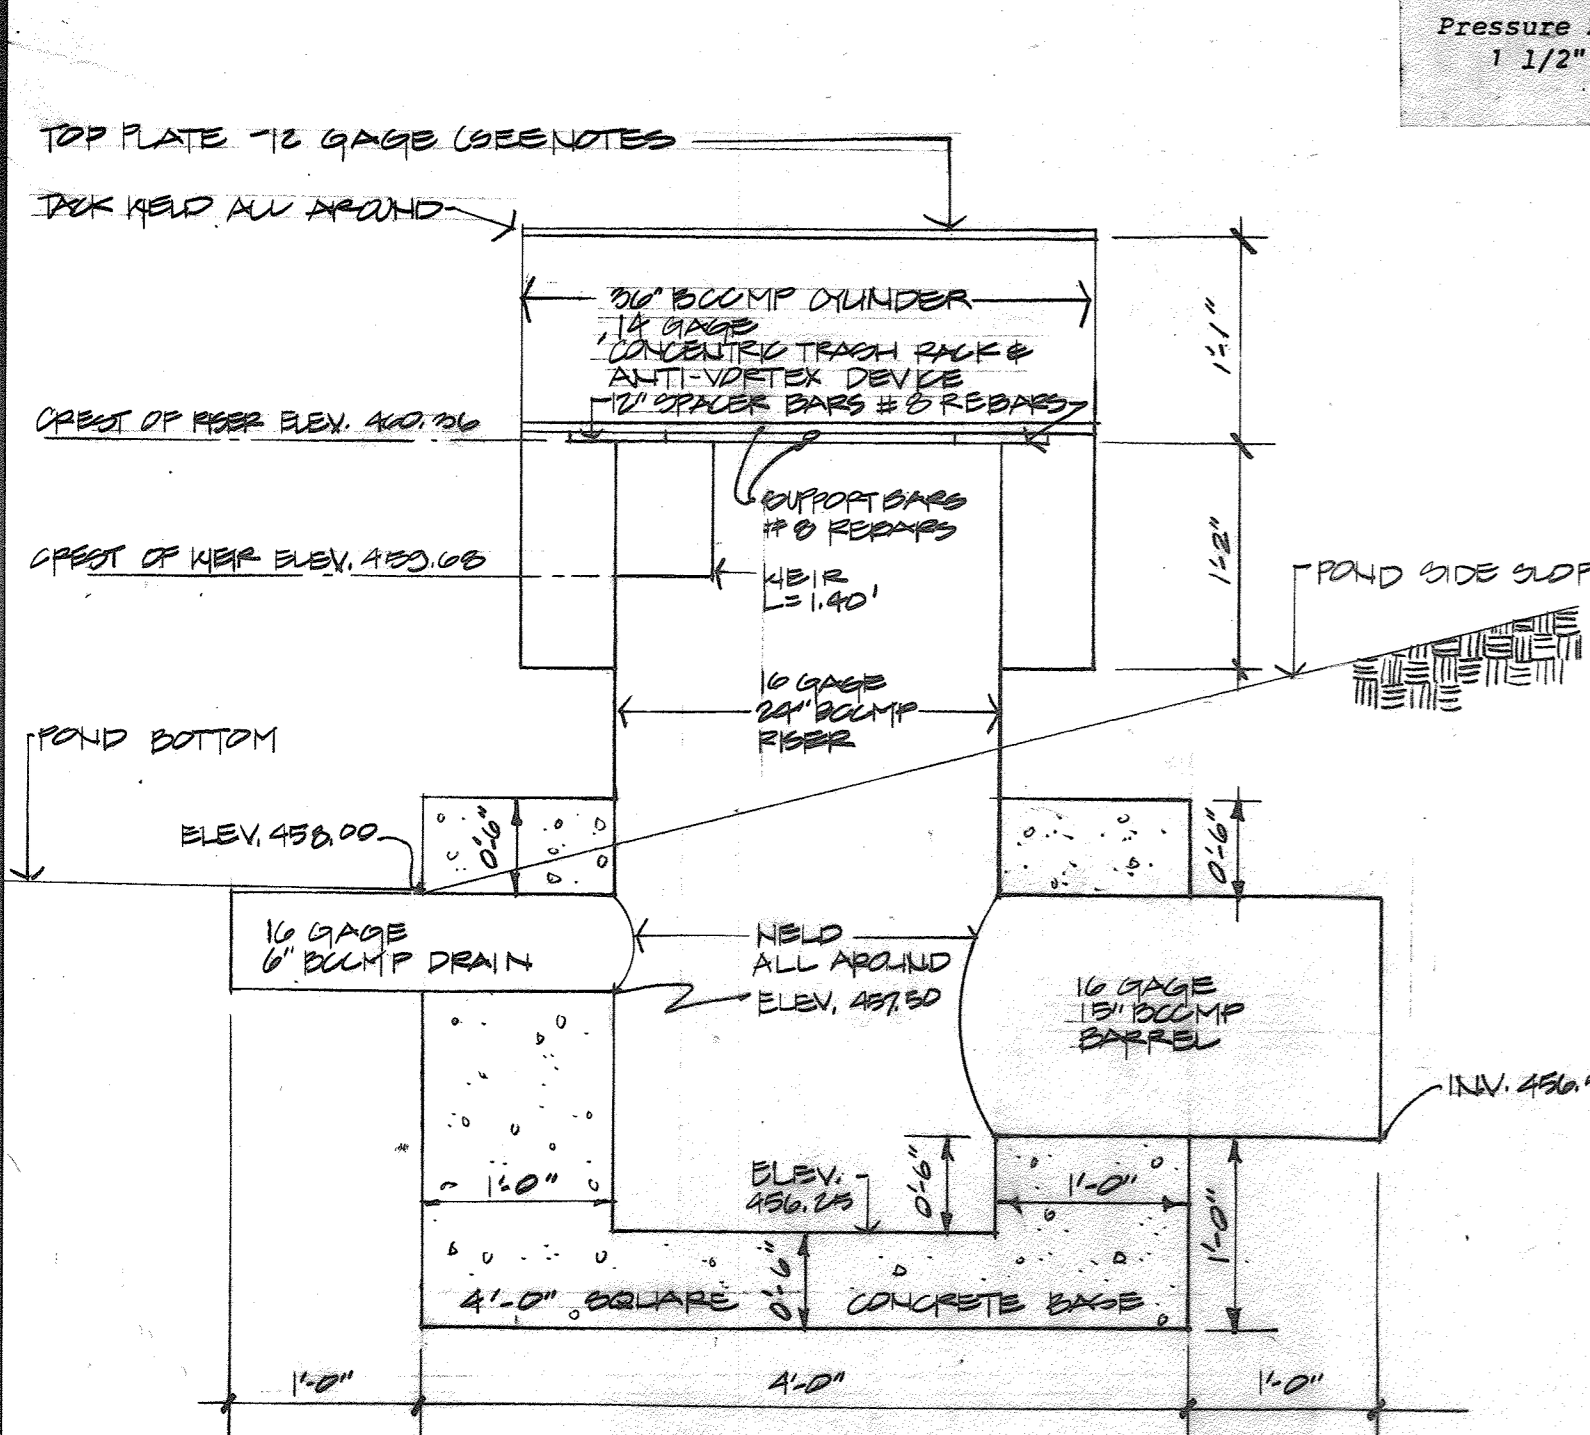

APPROVED: For Public Water, Public Sewerage and Storm Drainage Systems and Roads
 HOWARD COUNTY DEPARTMENT OF PUBLIC WORKS
 DIRECTOR: Joseph F. Nemmer DATE: 12-7-79
 CHIEF, BUREAU OF ENGINEERING: W. J. L. DATE: 12-3-79


APPROVED: Howard County Office of Planning and Zoning
 PLANNING DIRECTOR: J. R. DATE: 12-7-79
 CHIEF, DIV. OF LAND DEVELOPMENT: DATE: 12-7-79

APPROVED: For Public Water and Public Sewerage Systems
 HOWARD COUNTY HEALTH DEPARTMENT
 COUNTY HEALTH OFFICER: DATE: 12-7-79

HOWARD COUNTY
 SPECIAL EDUCATION CENTER
 Village of Harper's Choice
 Columbia, Maryland

Browne, Worrall & Johnson / Architects
 Baltimore, Maryland 21218
 George Evans Associates, Structural
 130 West Hamilton St. Baltimore, Maryland
 Moore Lewis, Inc., Mechanical & Electrical
 2435 N. Calvert St. Baltimore, Maryland

SD-7
 OF 21
 SDP-79-125C

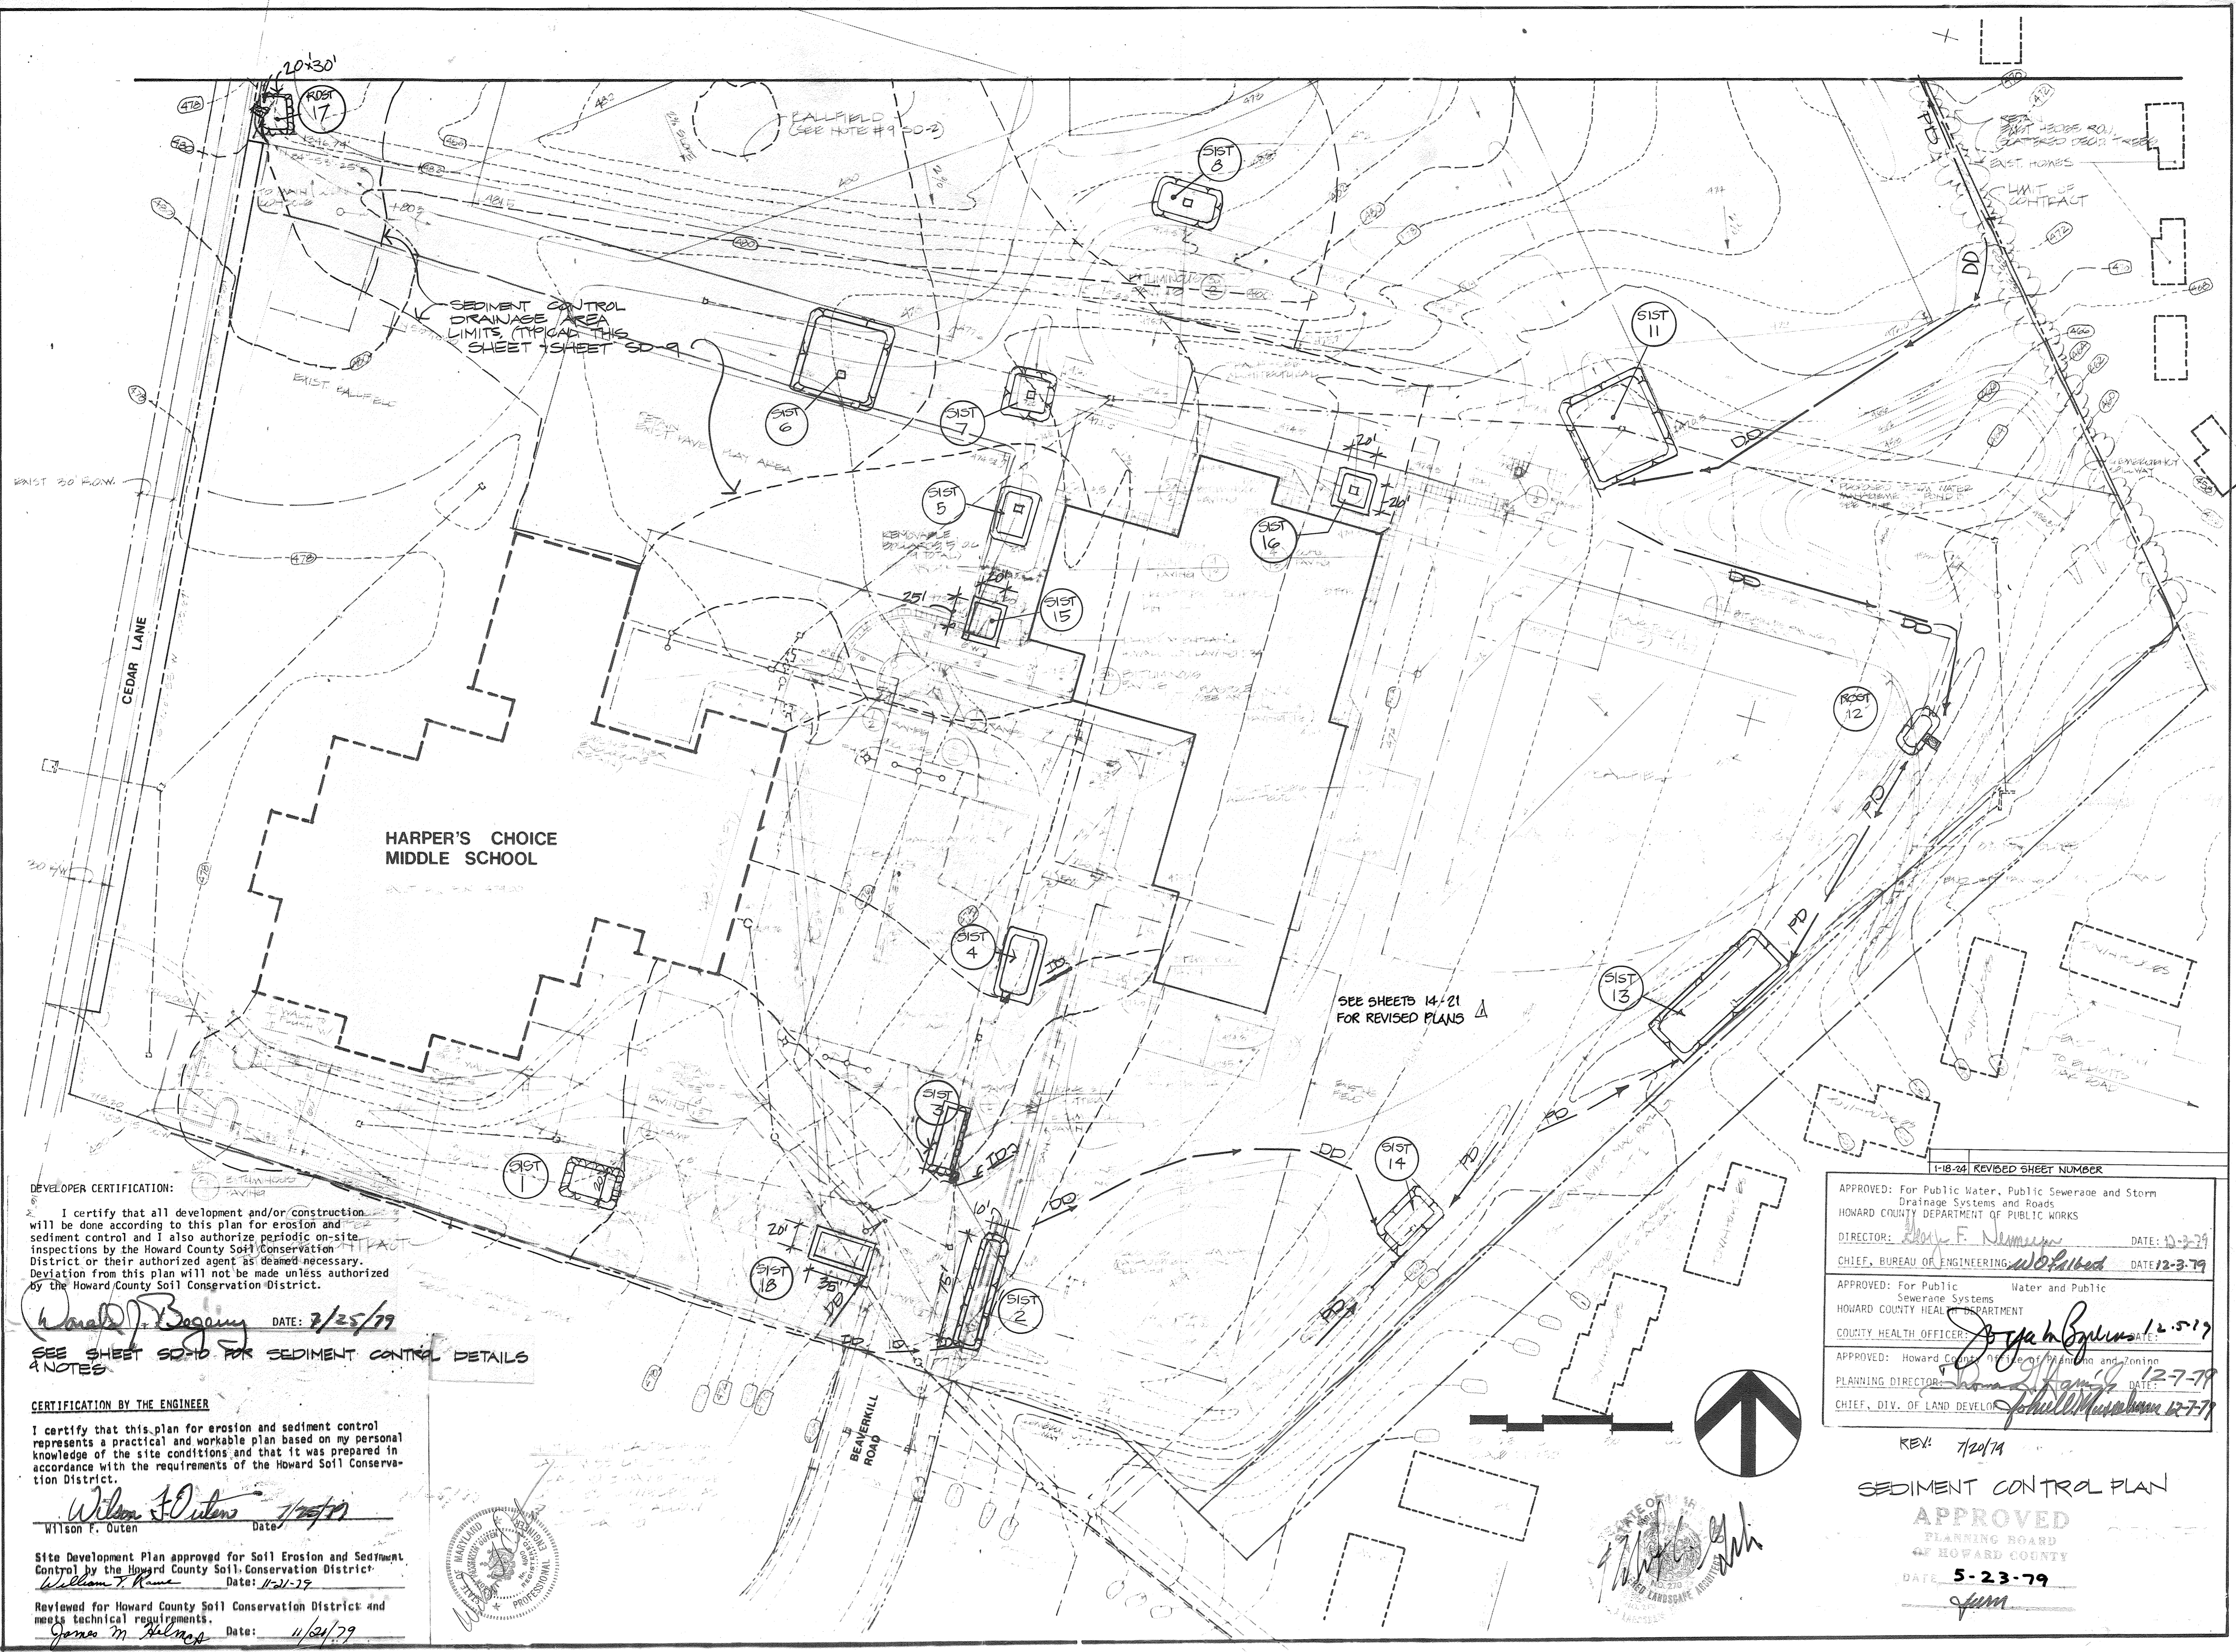

HARPER'S CHOICE
MIDDLE SCHOOL

DEVELOPER CERTIFICATION:

I certify that all development and/or construction will be done according to this plan for erosion and sediment control and I also authorize periodic on-site inspections by the Howard County Soil Conservation District or their authorized agent as deemed necessary. Deviation from this plan will not be made unless authorized by the Howard County Soil Conservation District.

Donald J. Begany DATE: 2/25/79

SEE SHEET SD-10 FOR SEDIMENT CONTROL DETAILS & NOTES


CERTIFICATION BY THE ENGINEER

I certify that this plan for erosion and sediment control represents a practical and workable plan based on my personal knowledge of the site conditions and that it was prepared in accordance with the requirements of the Howard Soil Conservation District.

Wilson F. Outen DATE: 1/24/79
Wilson F. Outen

Site Development Plan approved for Soil Erosion and Sediment Control by the Howard County Soil Conservation District.
William T. Rame Date: 11-21-79

Reviewed for Howard County Soil Conservation District and meets technical requirements.
James M. Salinas Date: 11/24/79

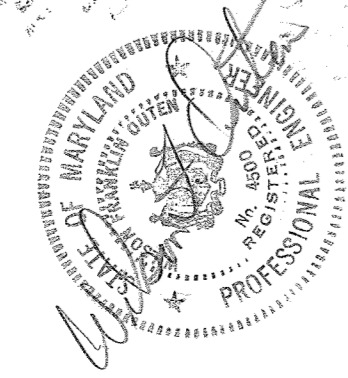

SEE SHEETS 14-21 FOR REVISED PLANS

1-18-24 REVISED SHEET NUMBER	
APPROVED: For Public Water, Public Sewerage and Storm Drainage Systems and Roads HOWARD COUNTY DEPARTMENT OF PUBLIC WORKS	
DIRECTOR: <i>Walter F. Nimmer</i> DATE: 10-2-79	
CHIEF, BUREAU OF ENGINEERING: <i>W. J. ...</i> DATE: 12-3-79	
APPROVED: For Public Water and Public Sewerage Systems HOWARD COUNTY HEALTH DEPARTMENT	
COUNTY HEALTH OFFICER: <i>John H. ...</i> DATE: 12-5-79	
APPROVED: Howard County Office of Planning and Zoning	
PLANNING DIRECTOR: <i>James ...</i> DATE: 12-7-79	
CHIEF, DIV. OF LAND DEVELOPMENT: <i>John ...</i> DATE: 12-7-79	

REV: 7/20/79

SEDIMENT CONTROL PLAN

APPROVED

PLANNING BOARD OF HOWARD COUNTY

DATE: 5-23-79

HOWARD COUNTY
SPECIAL EDUCATION CENTER
Columbia, Maryland
Village of Harper's Choice
OWNER & DEVELOPER: HOWARD COUNTY PUBLIC SCHOOL SYSTEM

Browne, Worrall & Johnson / Architects
Baltimore, Maryland 21218
George Evans Associates, Structural
180 West Hamilton St. Baltimore, Maryland
Moore Lewis, Inc., Mechanical & Electrical
2435 N. Calvert St. Baltimore, Maryland

SD-8
OF 21

TRAP NO	TYPE	DRAINAGE AREA (AC)	STORAGE REQUIRED (CU FT)	STORAGE PROVIDED (CU FT)	BOTTOM OF TRAP DIMENSIONS (FT)	DEPTH (FT)
1	STORM INLET (SIST)	0.94	1692	1760	20 x 32	2
2	"	1.24	2232	2244	10 x 75	"
3	"	0.81	1458	1504	12 x 42	"
4	"	1.06	1908	2144	20 x 40	"
5	"	0.90	1620	1664	20 x 30	"
6	"	3.33	5994	6304	52 x 52	"
7	"	0.98	1764	1832	26 x 26	"
8	"	1.10	1980	2144	20 x 40	"
9	RIPRAP OUTLET (ROST)	2.61	4698	5024	35 x 60 OUTLET LENGTH=10'	"
10	RIPRAP OUTLET (ROST)	2.02	3636	3744	25 x 60 OUTLET LENGTH=13'	"
11	STORM INLET (SIST)	4.14	7452	7584	55 x 60	"
12	RIPRAP OUTLET (ROST)	0.41	738	844	25 x 10 OUTLET LENGTH=6'	"
13	STORM INLET (SIST)	3.64	6552	6764	30 x 95	"
14	"	1.05	1890	1904	20 x 35	"
15	"	.50	900	1000	20 x 25	"
16	"	.42	756	800	20 x 20	"
17	RIPRAP OUTLET (ROST)	.61	1098	1200	20 x 30	"
18	STORM INLET (SIST)	.71	1278	1400	20 x 35	"
19	RIPRAP OUTLET (ROST)	.67	1206	1250	25 x 25	"

Sequence of Operations

1. Notify Howard County Department of Inspections and Permits at least 72 hours before any work begins (Ph. 992-2436).
2. Construct Storm Water Management Ponds, install new storm drain systems and modifications to existing drains, install all sediment control devices such as traps, dikes, etc.
3. Rough grade site.
4. Fine grade and place sub-base on parking and drive areas.
5. Begin construction of building.
6. Stabilize all disturbed soil outside of building area.
7. Remove sediment control measures and stabilize area. (After approval by Howard Soil Conservation District.)
8. Pave parking areas.
9. Seeding, fertilizing and mulching shall be as follows:


Seed - 30% Adelphi Kentucky Bluegrass
 30% Marion Kentucky Bluegrass
 37% South Dakota Bluegrass
 10% Birka Kentucky Bluegrass
 At 50 to 60 lbs. per acre.
 Fertilizer - 500 lbs. of 10-10-10 per acre
 Lime - 2,500 lbs. per acre
 Mulch - Straw to a depth of 1-2 inches
 Anchoring - Asphalt Binder

(Note: Where 2:1 slopes are necessary, sod with same mix as above.)

GENERAL NOTES

1. Refer to the "Standards and Specifications for Soil Erosion and Sediment Control in Developing Areas" for detailed specifications for each practice.
2. During the layout of the sediment control practices required on this plan, minor field adjustments can and will be made to assure the arrest and control of any sediment before it leaves the construction site. Sediment control practice changes require prior approval of the Sediment Control Inspector and the Howard Soil Conservation District.
3. At the end of each working day, all sediment control practices will be inspected and left in an operational condition.

Site
 Con

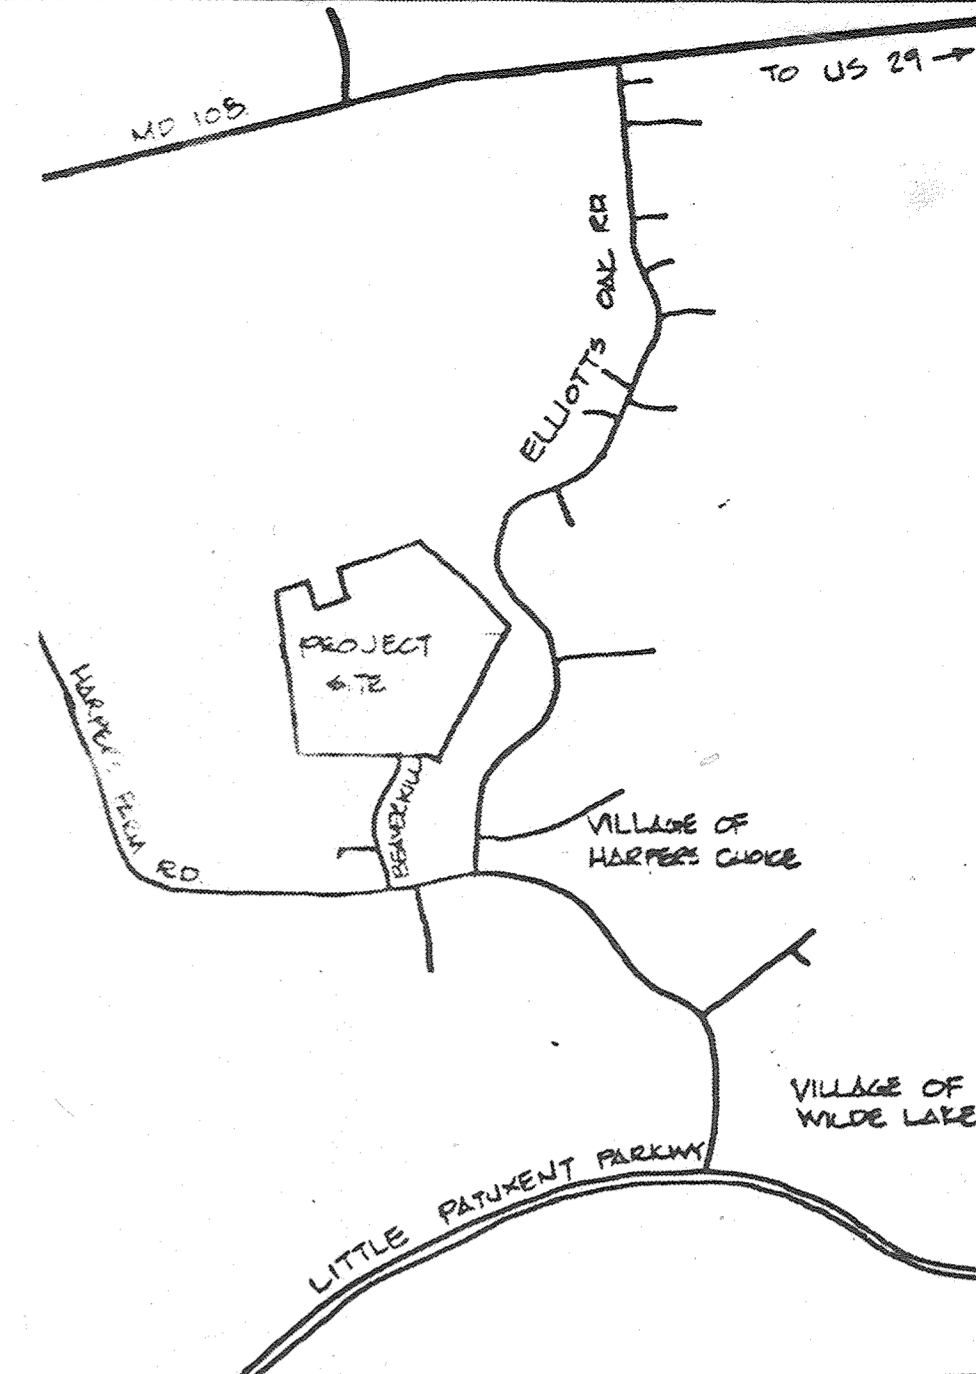

Vicinity Sketch

CERTIFICATION BY THE ENGINEER

I certify that this plan for erosion and sediment control represents a practical and workable plan based on my personal knowledge of the site conditions and that it was prepared in accordance with the requirements of the Howard Soil Conservation District.

Wilson F. Outen 7/25/79
 Wilson F. Outen Date

Site Development Plan approved for Soil Erosion and Sediment Control by the Howard County Soil Conservation District.
William T. Reese Date: 11-21-79


Reviewed for Howard County Soil Conservation District and meets technical requirements.
James M. Williams Date: 4/24/79

DEVELOPER CERTIFICATION:

I certify that all development and/or construction will be done according to this plan for erosion and sediment control and I also authorize periodic on-site inspections by the Howard County Soil Conservation District or their authorized agent as deemed necessary. Deviation from this plan will not be made unless authorized by the Howard County Soil Conservation District.


Donald J. Roggeny DATE: 7/25/79

APPROVED: For Public Water, Public Sewerage and Storm Drainage Systems and Roads HOWARD COUNTY DEPARTMENT OF PUBLIC WORKS	DATE: 10-3-79
DIRECTOR: <i>George E. Williams</i>	DATE: 12-3-79
CHIEF, BUREAU OF ENGINEERING: <i>W.D. Wood</i>	DATE: 12-3-79
APPROVED: For Public Water and Public Sewerage Systems HOWARD COUNTY HEALTH DEPARTMENT	DATE: 12-7-79
COUNTY HEALTH OFFICER: <i>Joyce M. Byrd</i>	DATE: 12-7-79
APPROVED: Howard County Office of Planning and Zoning	DATE: 12-7-79
PLANNING DIRECTOR: <i>Thomas H. Harney</i>	DATE: 12-7-79
CHIEF, DIV. LAND DEV. <i>John W. Washburn</i>	DATE: 12-7-79

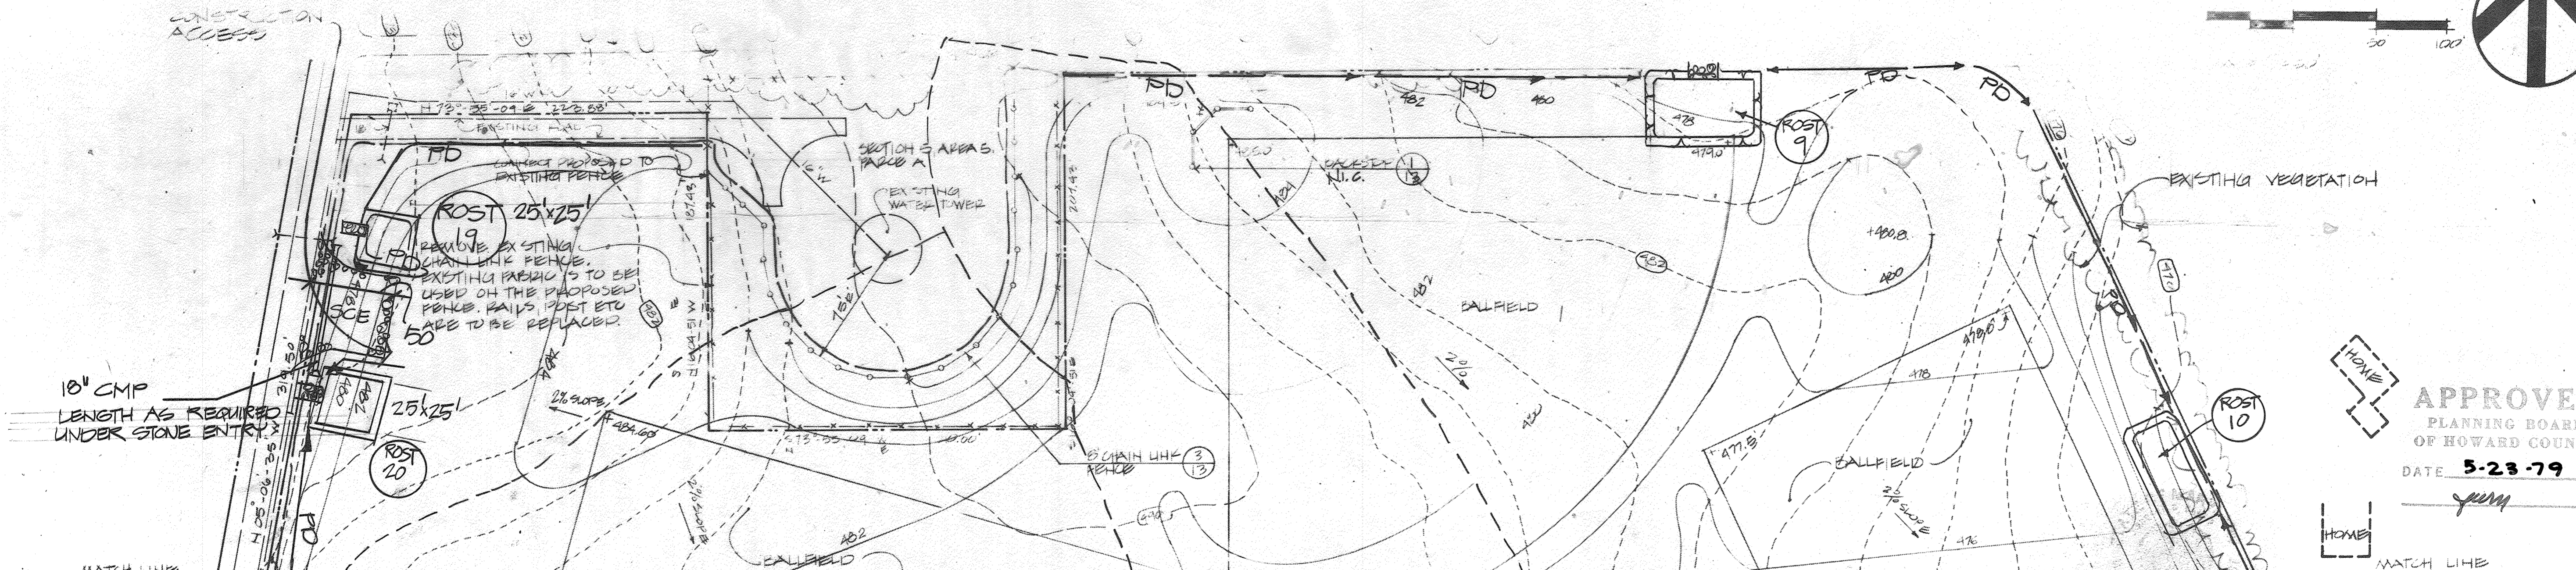

REVISED: 7/19/79
 REVISED: 6/6/79 DMW/KJA


SEDIMENT CONTROL PLAN
 HOWARD COUNTY
 SPECIAL EDUCATION CENTER
 VILLAGE OF HARPERS CHOICE COLUMBIA, MD.
 SECTION 6 AREA 2
 PLAT BOOK 23 FOLIO 64
 TAX MAP NO. 29 PARCEL NO. 60
 ELECTION DISTRICT NO. 5 HOWARD COUNTY, MARYLAND
 SCALE: 1"=50' APRIL 11, 1979

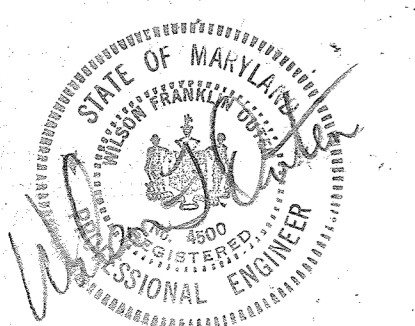


HOWARD COUNTY
 SPECIAL EDUCATION CENTER
 VILLAGE OF HARPERS CHOICE
 HOWARD COUNTY PUBLIC SCHOOL SYSTEM
 Columbia, Maryland

Browne, Worrall & Johnson / Architects
 Baltimore, Maryland 21218
 George Evans Associates, Structural
 Baltimore, Maryland
 Moore Lewis, Inc., Mechanical & Electrical
 Baltimore, Maryland
 Daft McCune Walker, Landscape & Civil
 Towson, Maryland


SD-9
 07 21
 SDP-79-125c

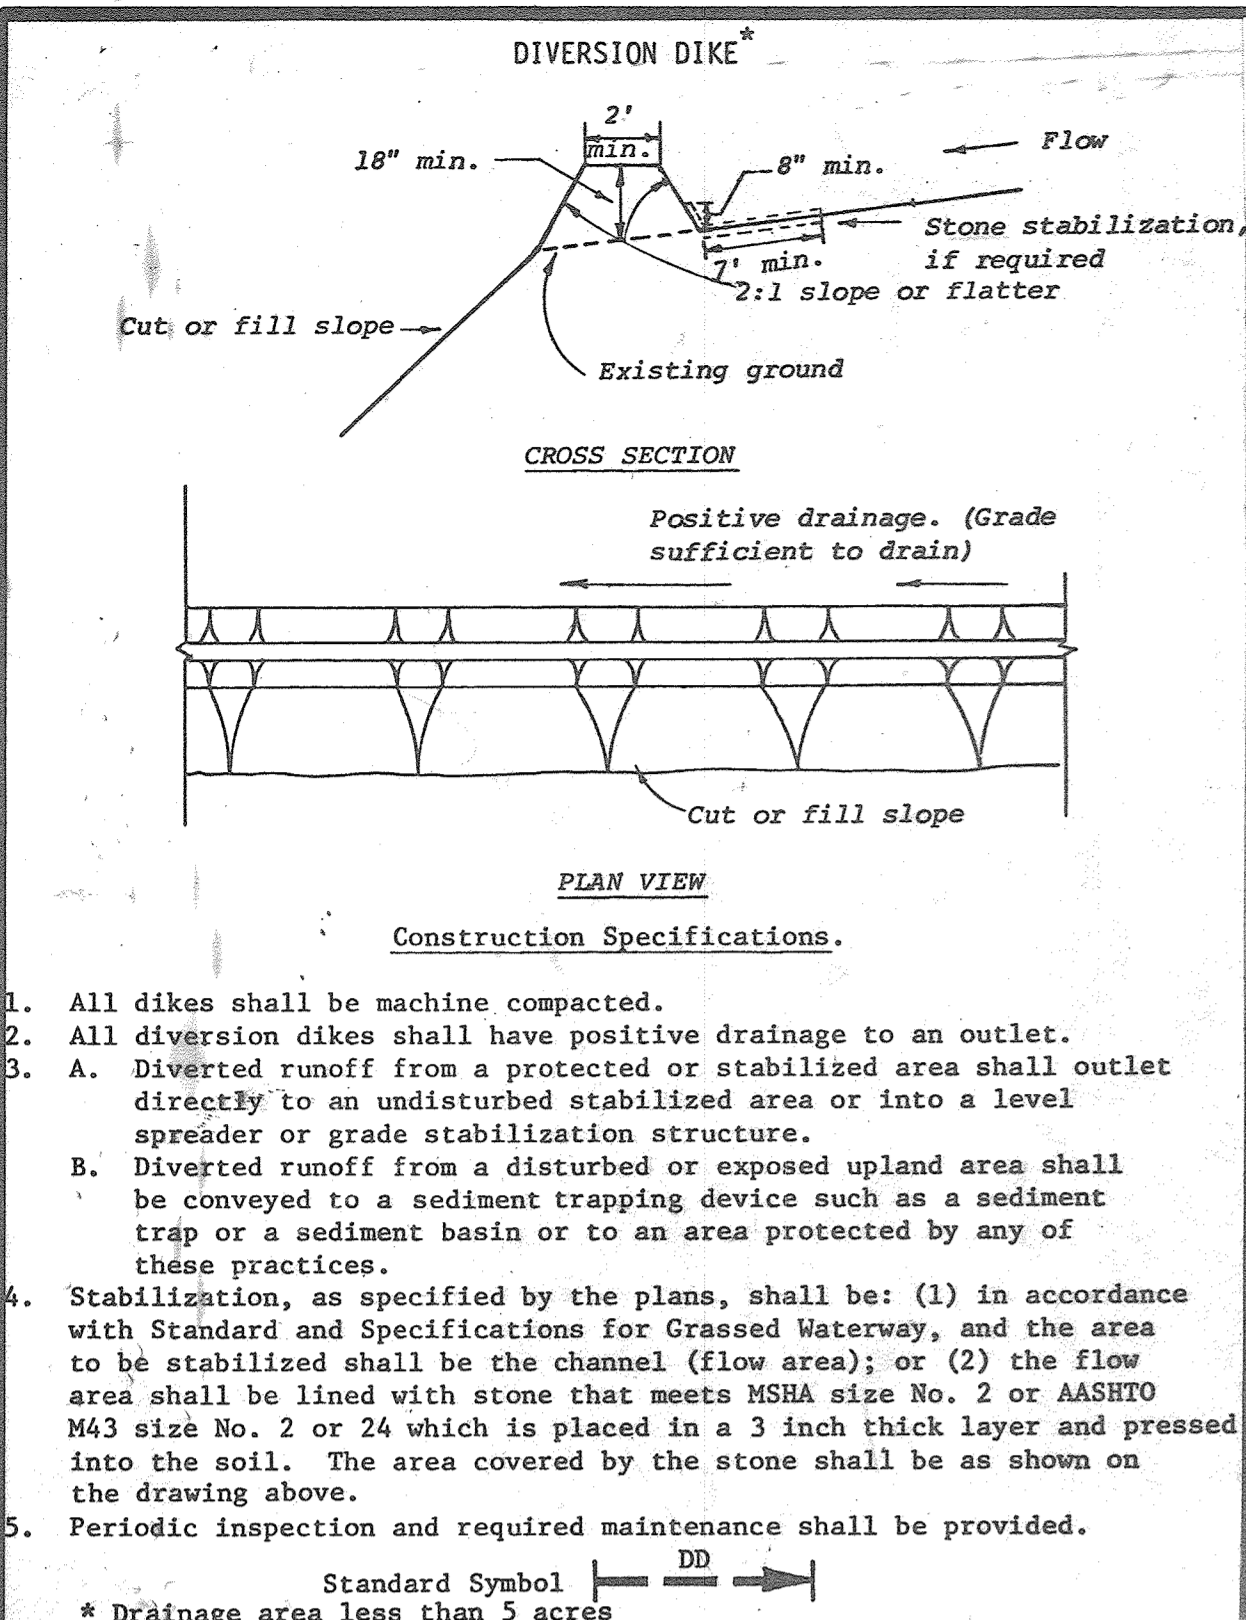


U. S. DEPARTMENT OF AGRICULTURE SOIL CONSERVATION SERVICE College Park, Md.	DIVERSION DIKE	Standard Drawing DD-1
---	----------------	--------------------------

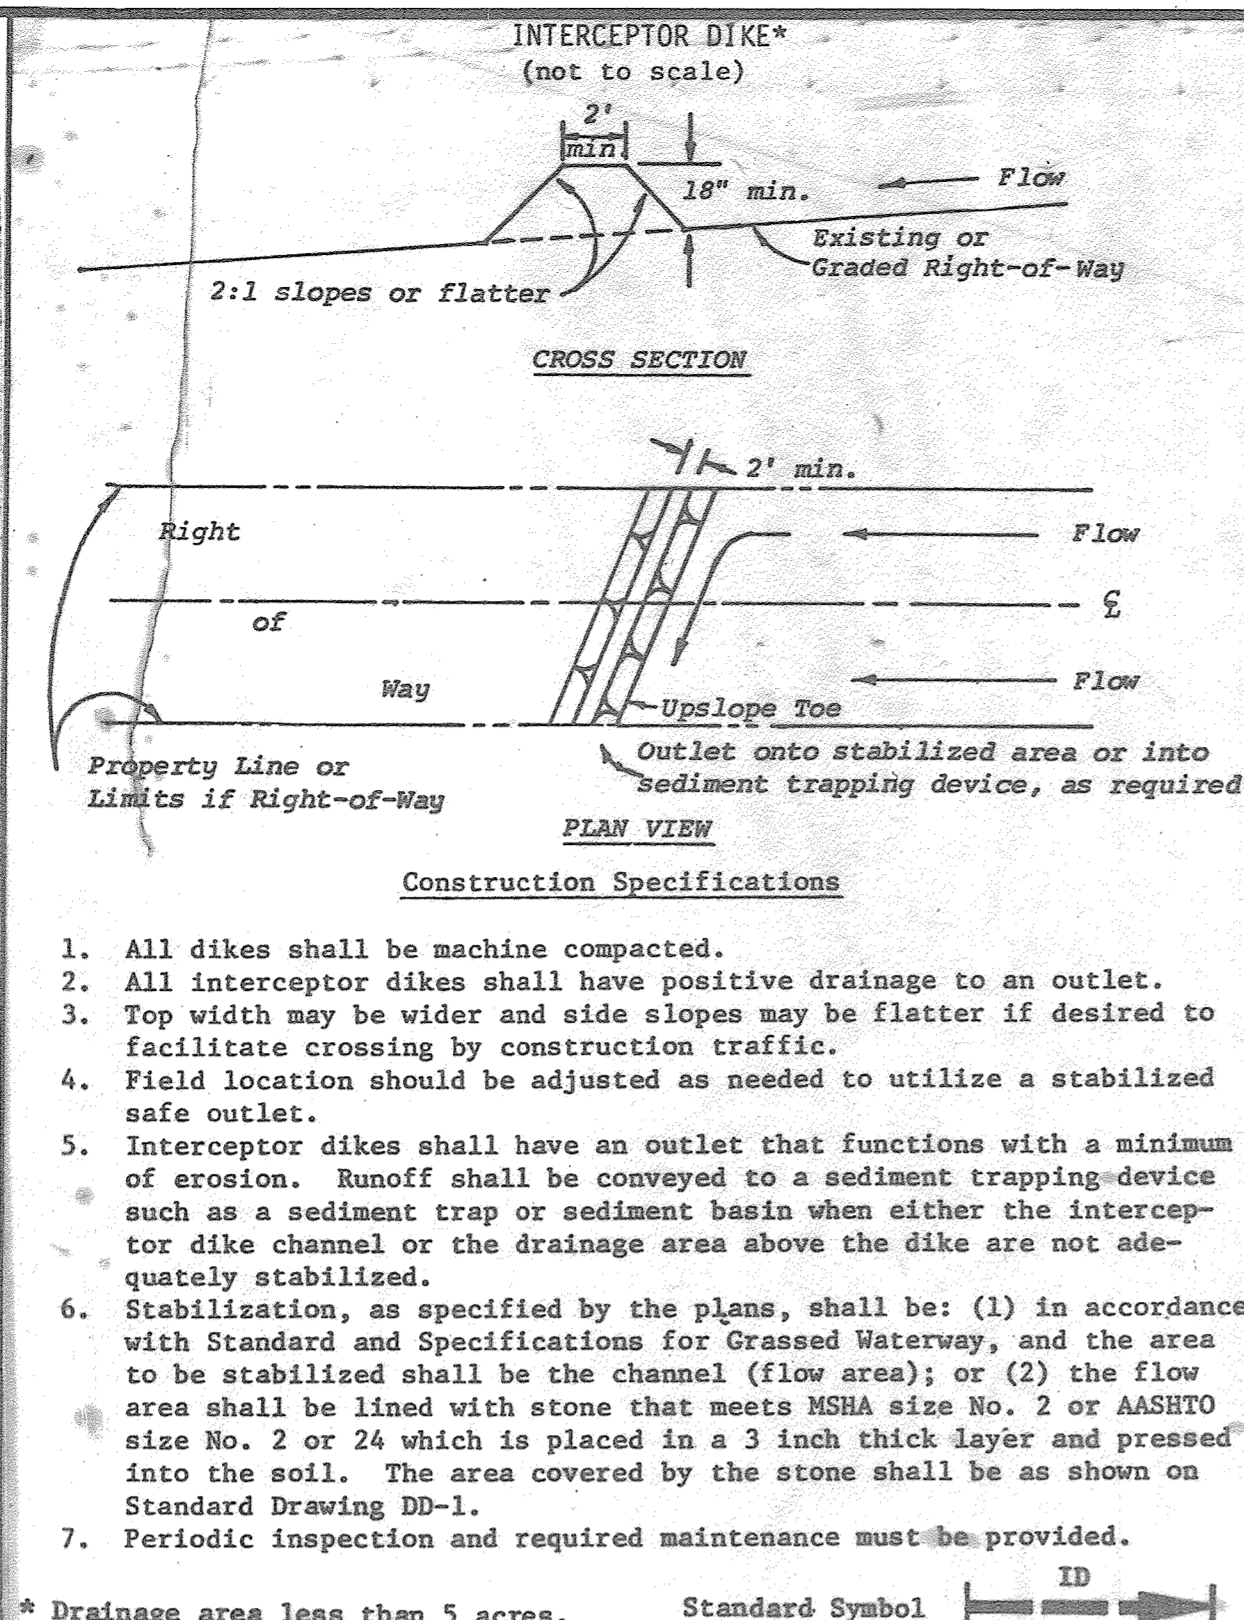


U. S. DEPARTMENT OF AGRICULTURE SOIL CONSERVATION SERVICE College Park, Md.	INTERCEPTOR DIKE	Standard Drawing ID-1
---	------------------	--------------------------

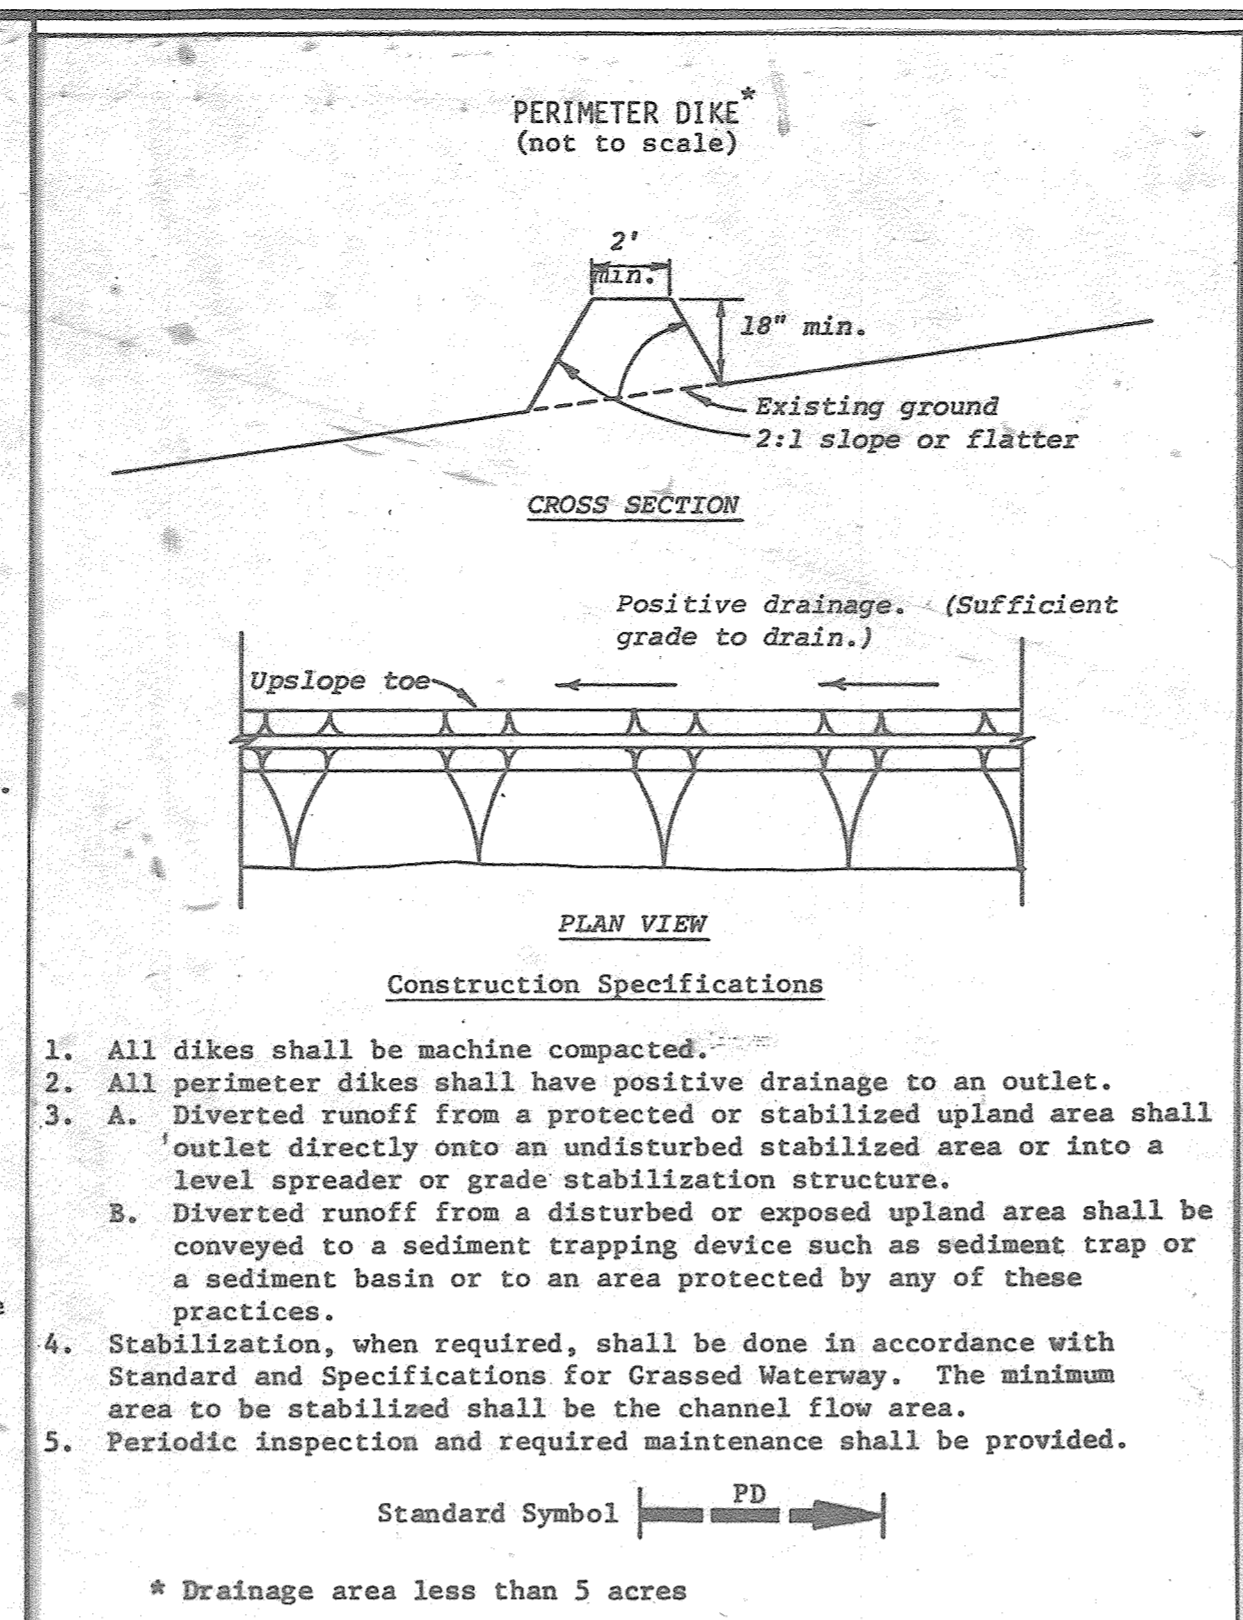



U. S. DEPARTMENT OF AGRICULTURE SOIL CONSERVATION SERVICE College Park, Md.	PERIMETER DIKE	Standard Drawing PD-1
---	----------------	--------------------------

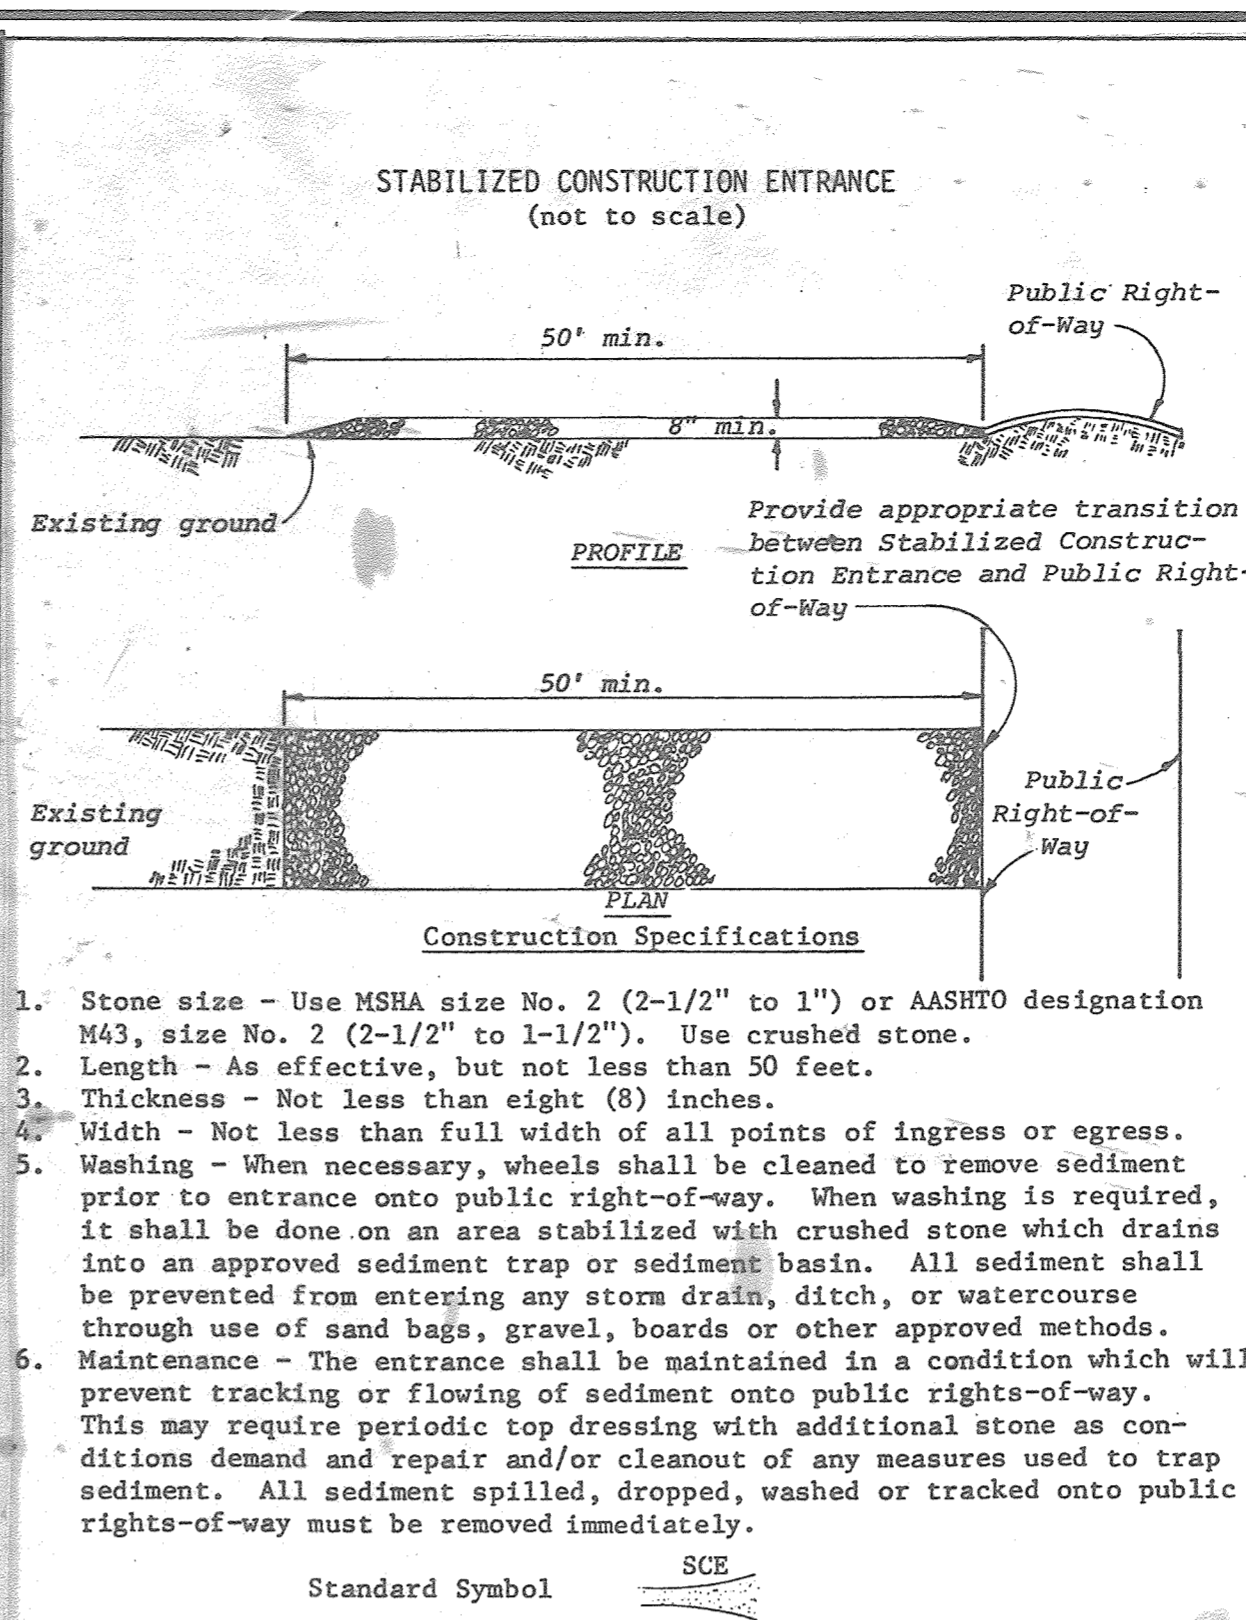

U. S. DEPARTMENT OF AGRICULTURE SOIL CONSERVATION SERVICE College Park, Md.	STABILIZED CONSTRUCTION ENTRANCE	Standard Drawing SCE-1
---	----------------------------------	---------------------------

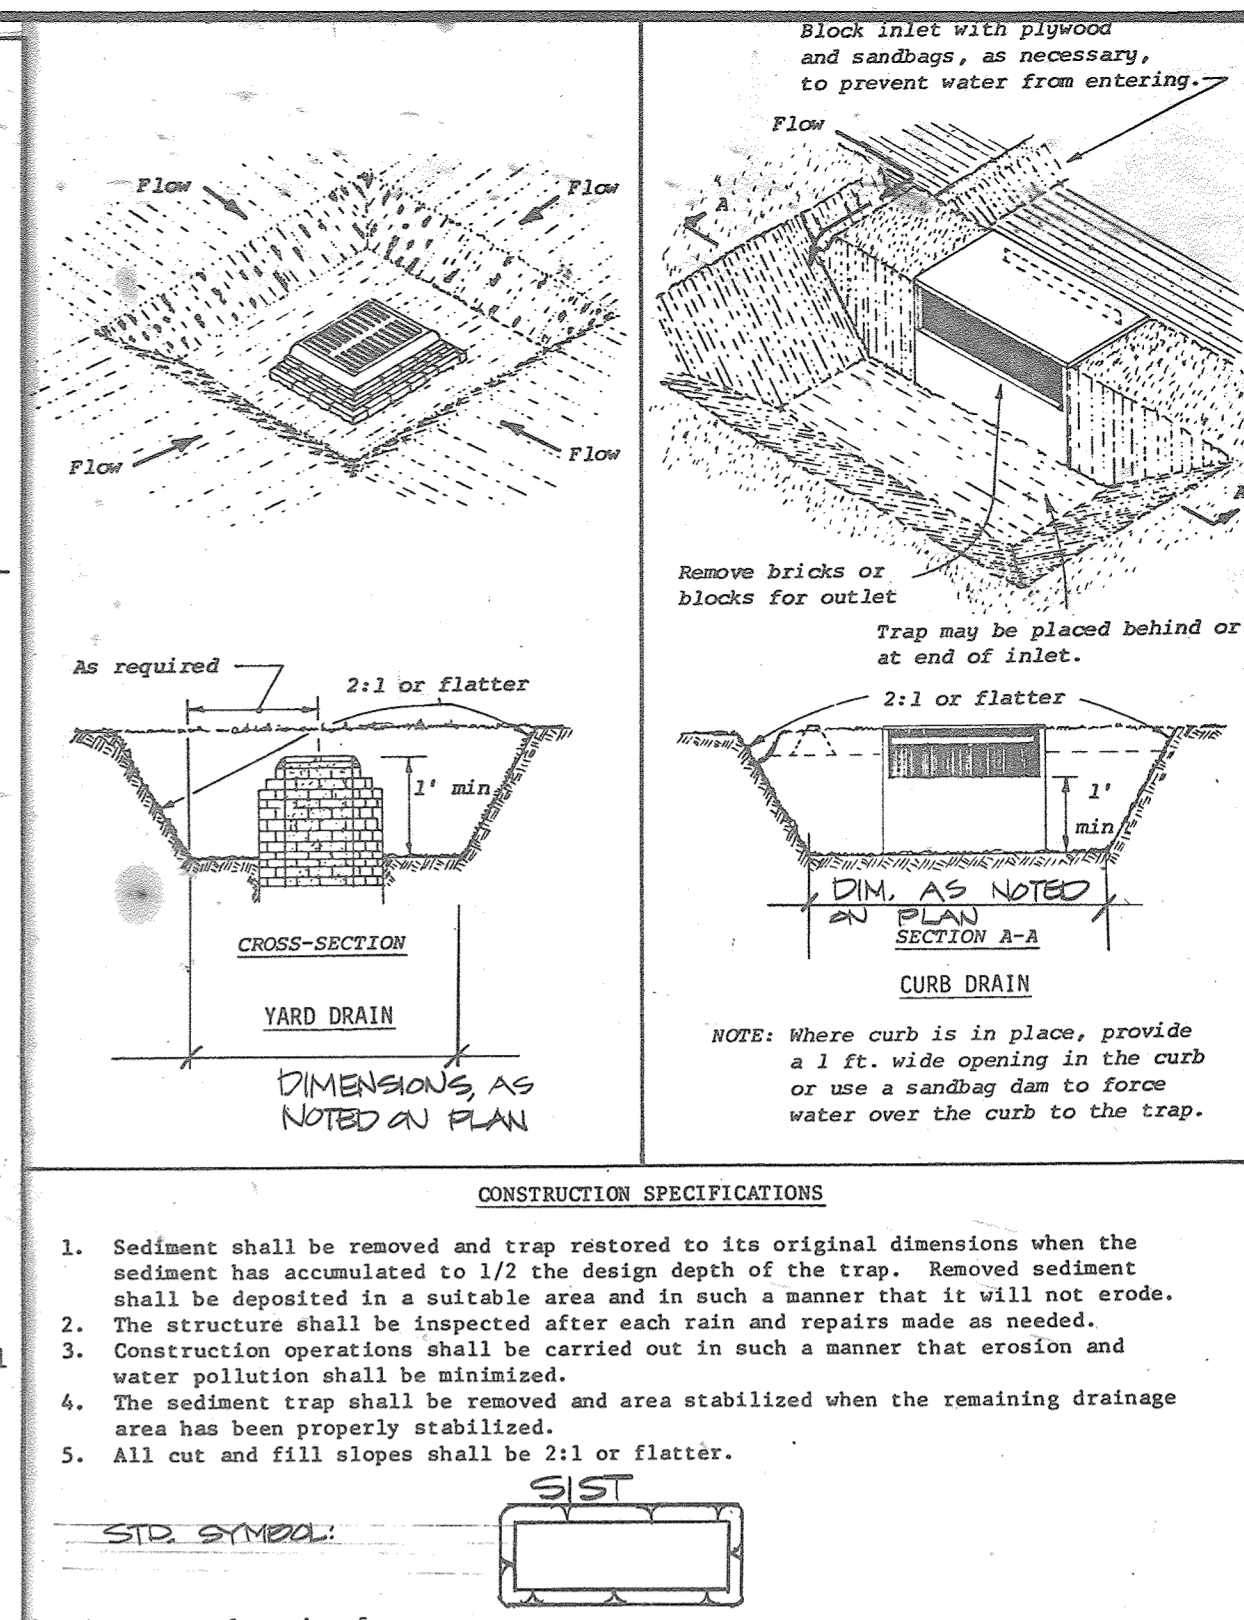

U. S. DEPARTMENT OF AGRICULTURE SOIL CONSERVATION SERVICE College Park, Md.	STORM INLET SEDIMENT TRAP	Standard Drawing ST-4
---	---------------------------	--------------------------

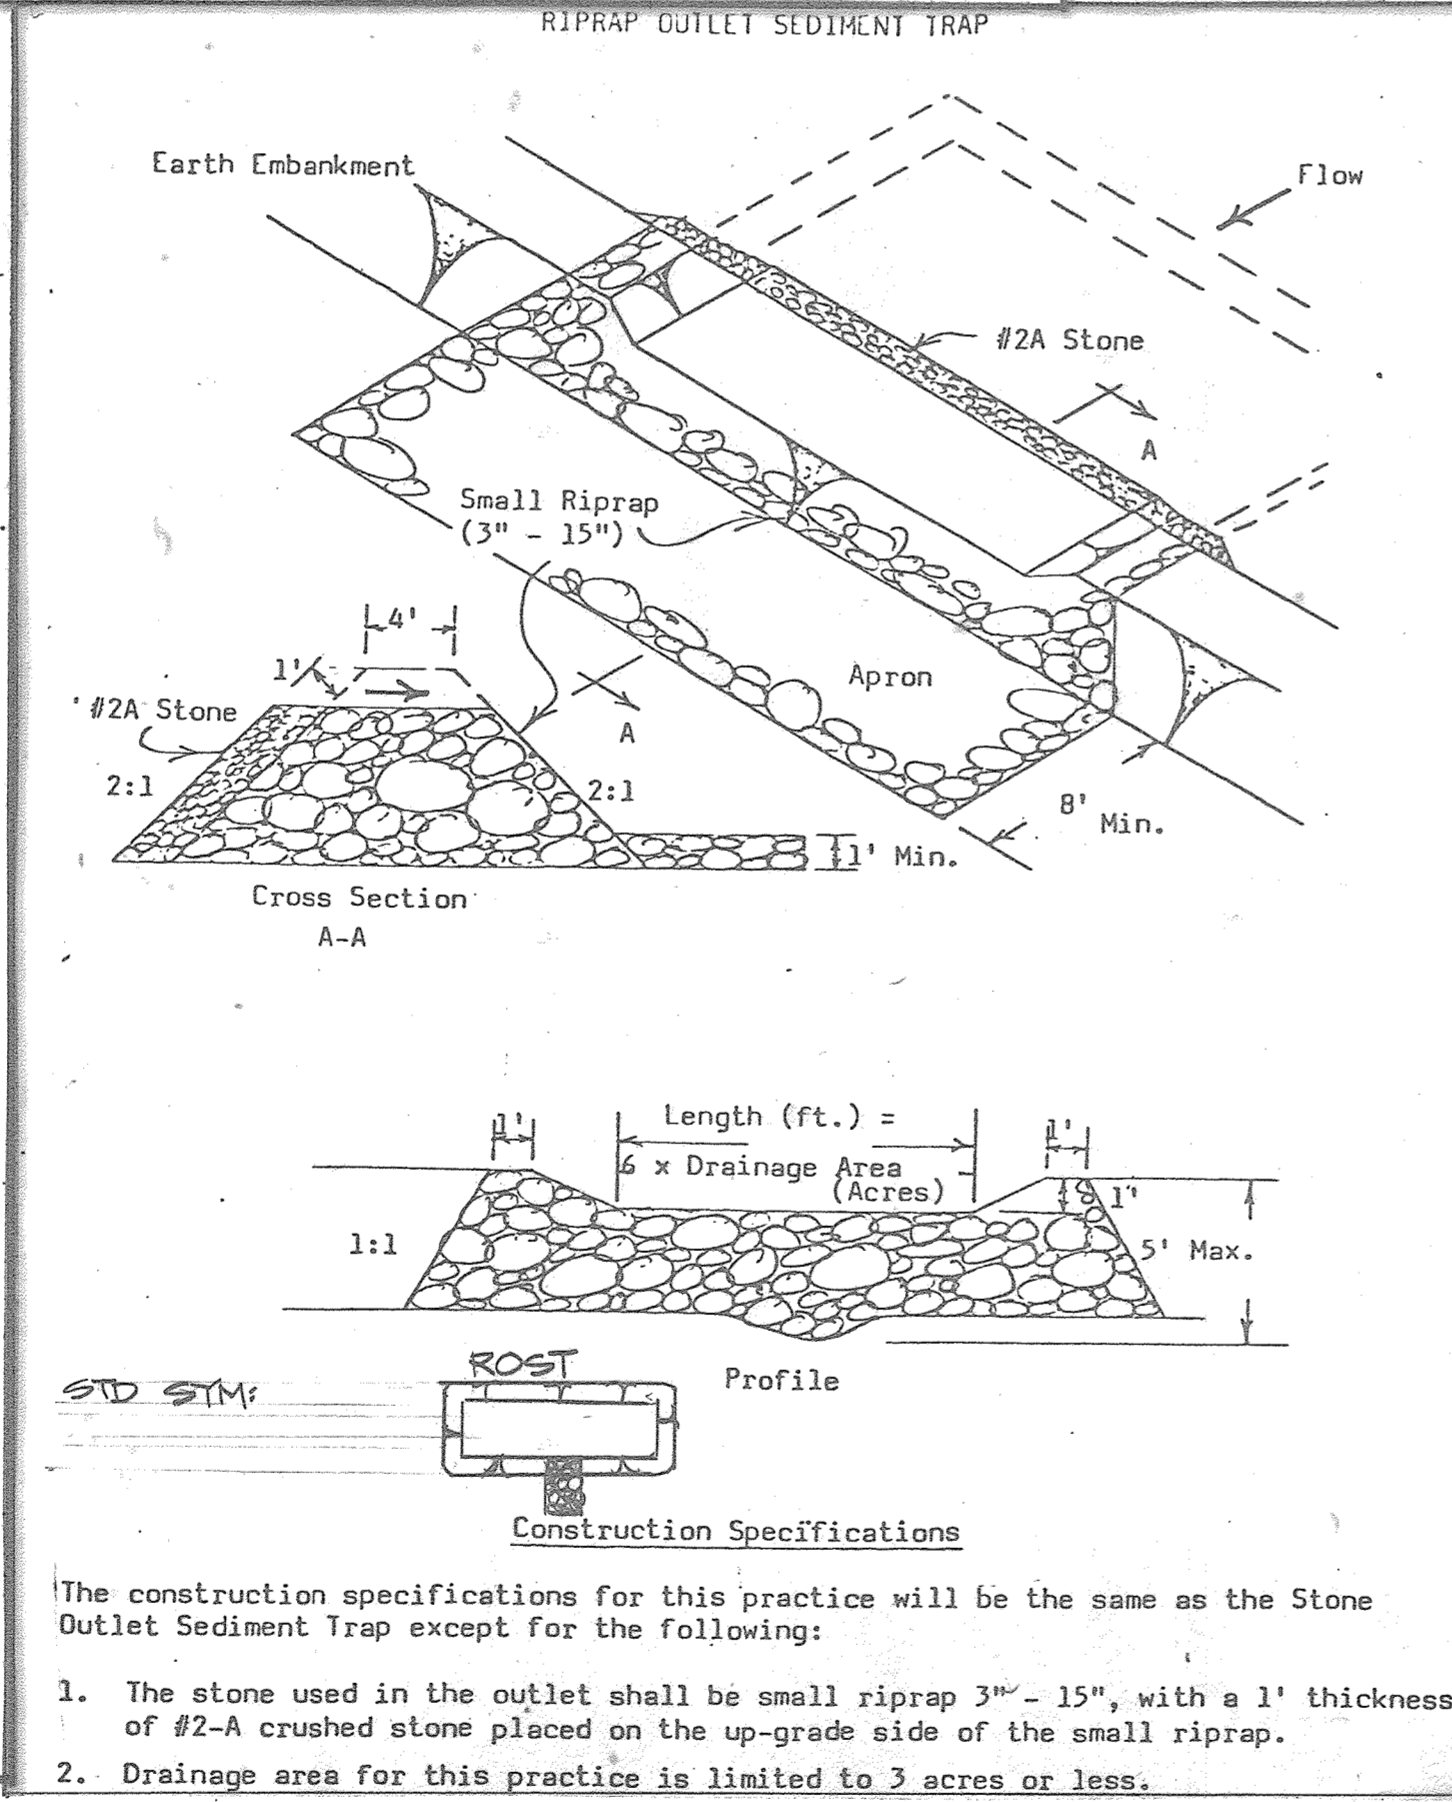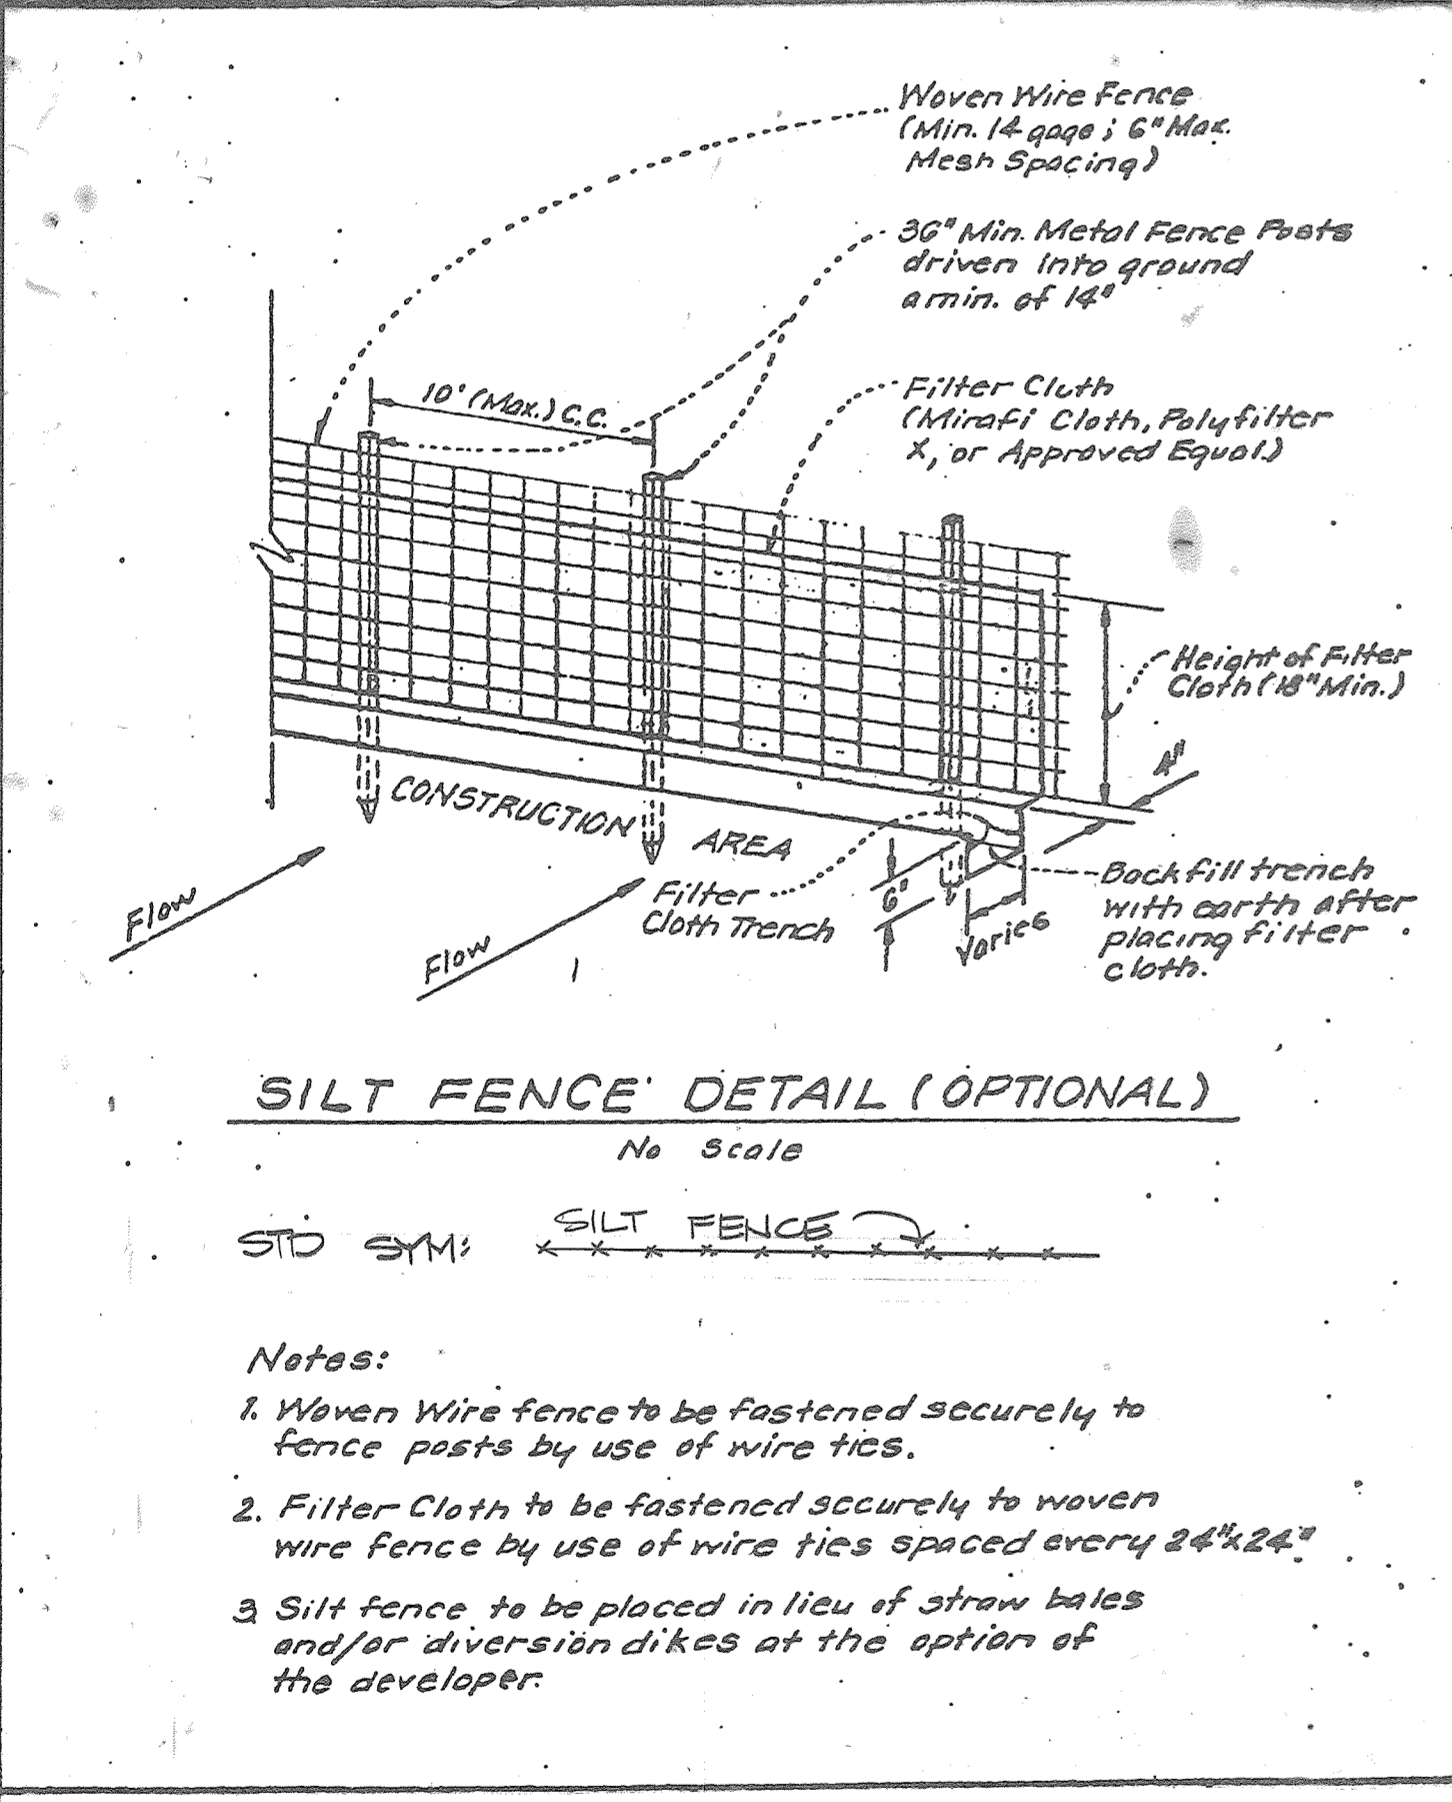

U. S. DEPARTMENT OF AGRICULTURE SOIL CONSERVATION SERVICE College Park, Md.	RIPRAP OUTLET SEDIMENT TRAP	Standard Drawing RST
---	-----------------------------	-------------------------

APPROVED: For Public Water, Public Sewerage and Storm Drainage Systems and Roads
HOWARD COUNTY DEPARTMENT OF PUBLIC WORKS
DIRECTOR: *Shay F. Neumann* DATE: 12-3-79
CHIEF, BUREAU OF ENGINEERING: *W.D. [illegible]* DATE: 12-3-79

APPROVED: For Public Water and Public Sewerage Systems
HOWARD COUNTY HEALTH DEPARTMENT
COUNTY HEALTH OFFICER: *Jacqueline [illegible]* DATE: 12-5-79

APPROVED: Howard County Office of Planning and Zoning
PLANNING DIRECTOR: *[illegible]* DATE: 12-7-79
CHIEF, DIV. OF LAND DEVELOPMENT: *[illegible]* DATE: 12-7-79


SEDIMENT CONTROL DETAILS
HOWARD COUNTY
SPECIAL EDUCATION CENTER
VILLAGE OF HARPERS CHOICE COLUMBIA, MD.
SECTION 6 AREA 2
PLAT BOOK 23 FOLIO 64

TAX MAP NO. 25 PARCEL NO. 60
ELECTION DISTRICT NO. 5 HOWARD COUNTY, MARYLAND
SCALE: NONE
APRIL 11, 1979

HOWARD COUNTY
SPECIAL EDUCATION CENTER
Village of Harper's Choice
Columbia, Maryland

Browne, Worrall & Johnson / Architects
Baltimore, Maryland 21218
George Evans Associates, Structural
130 West Hamilton St. Baltimore, Maryland
Moore Lewis, Inc., Mechanical & Electrical
2435 N. Calvert St. Baltimore, Maryland

SD-10
OF 21

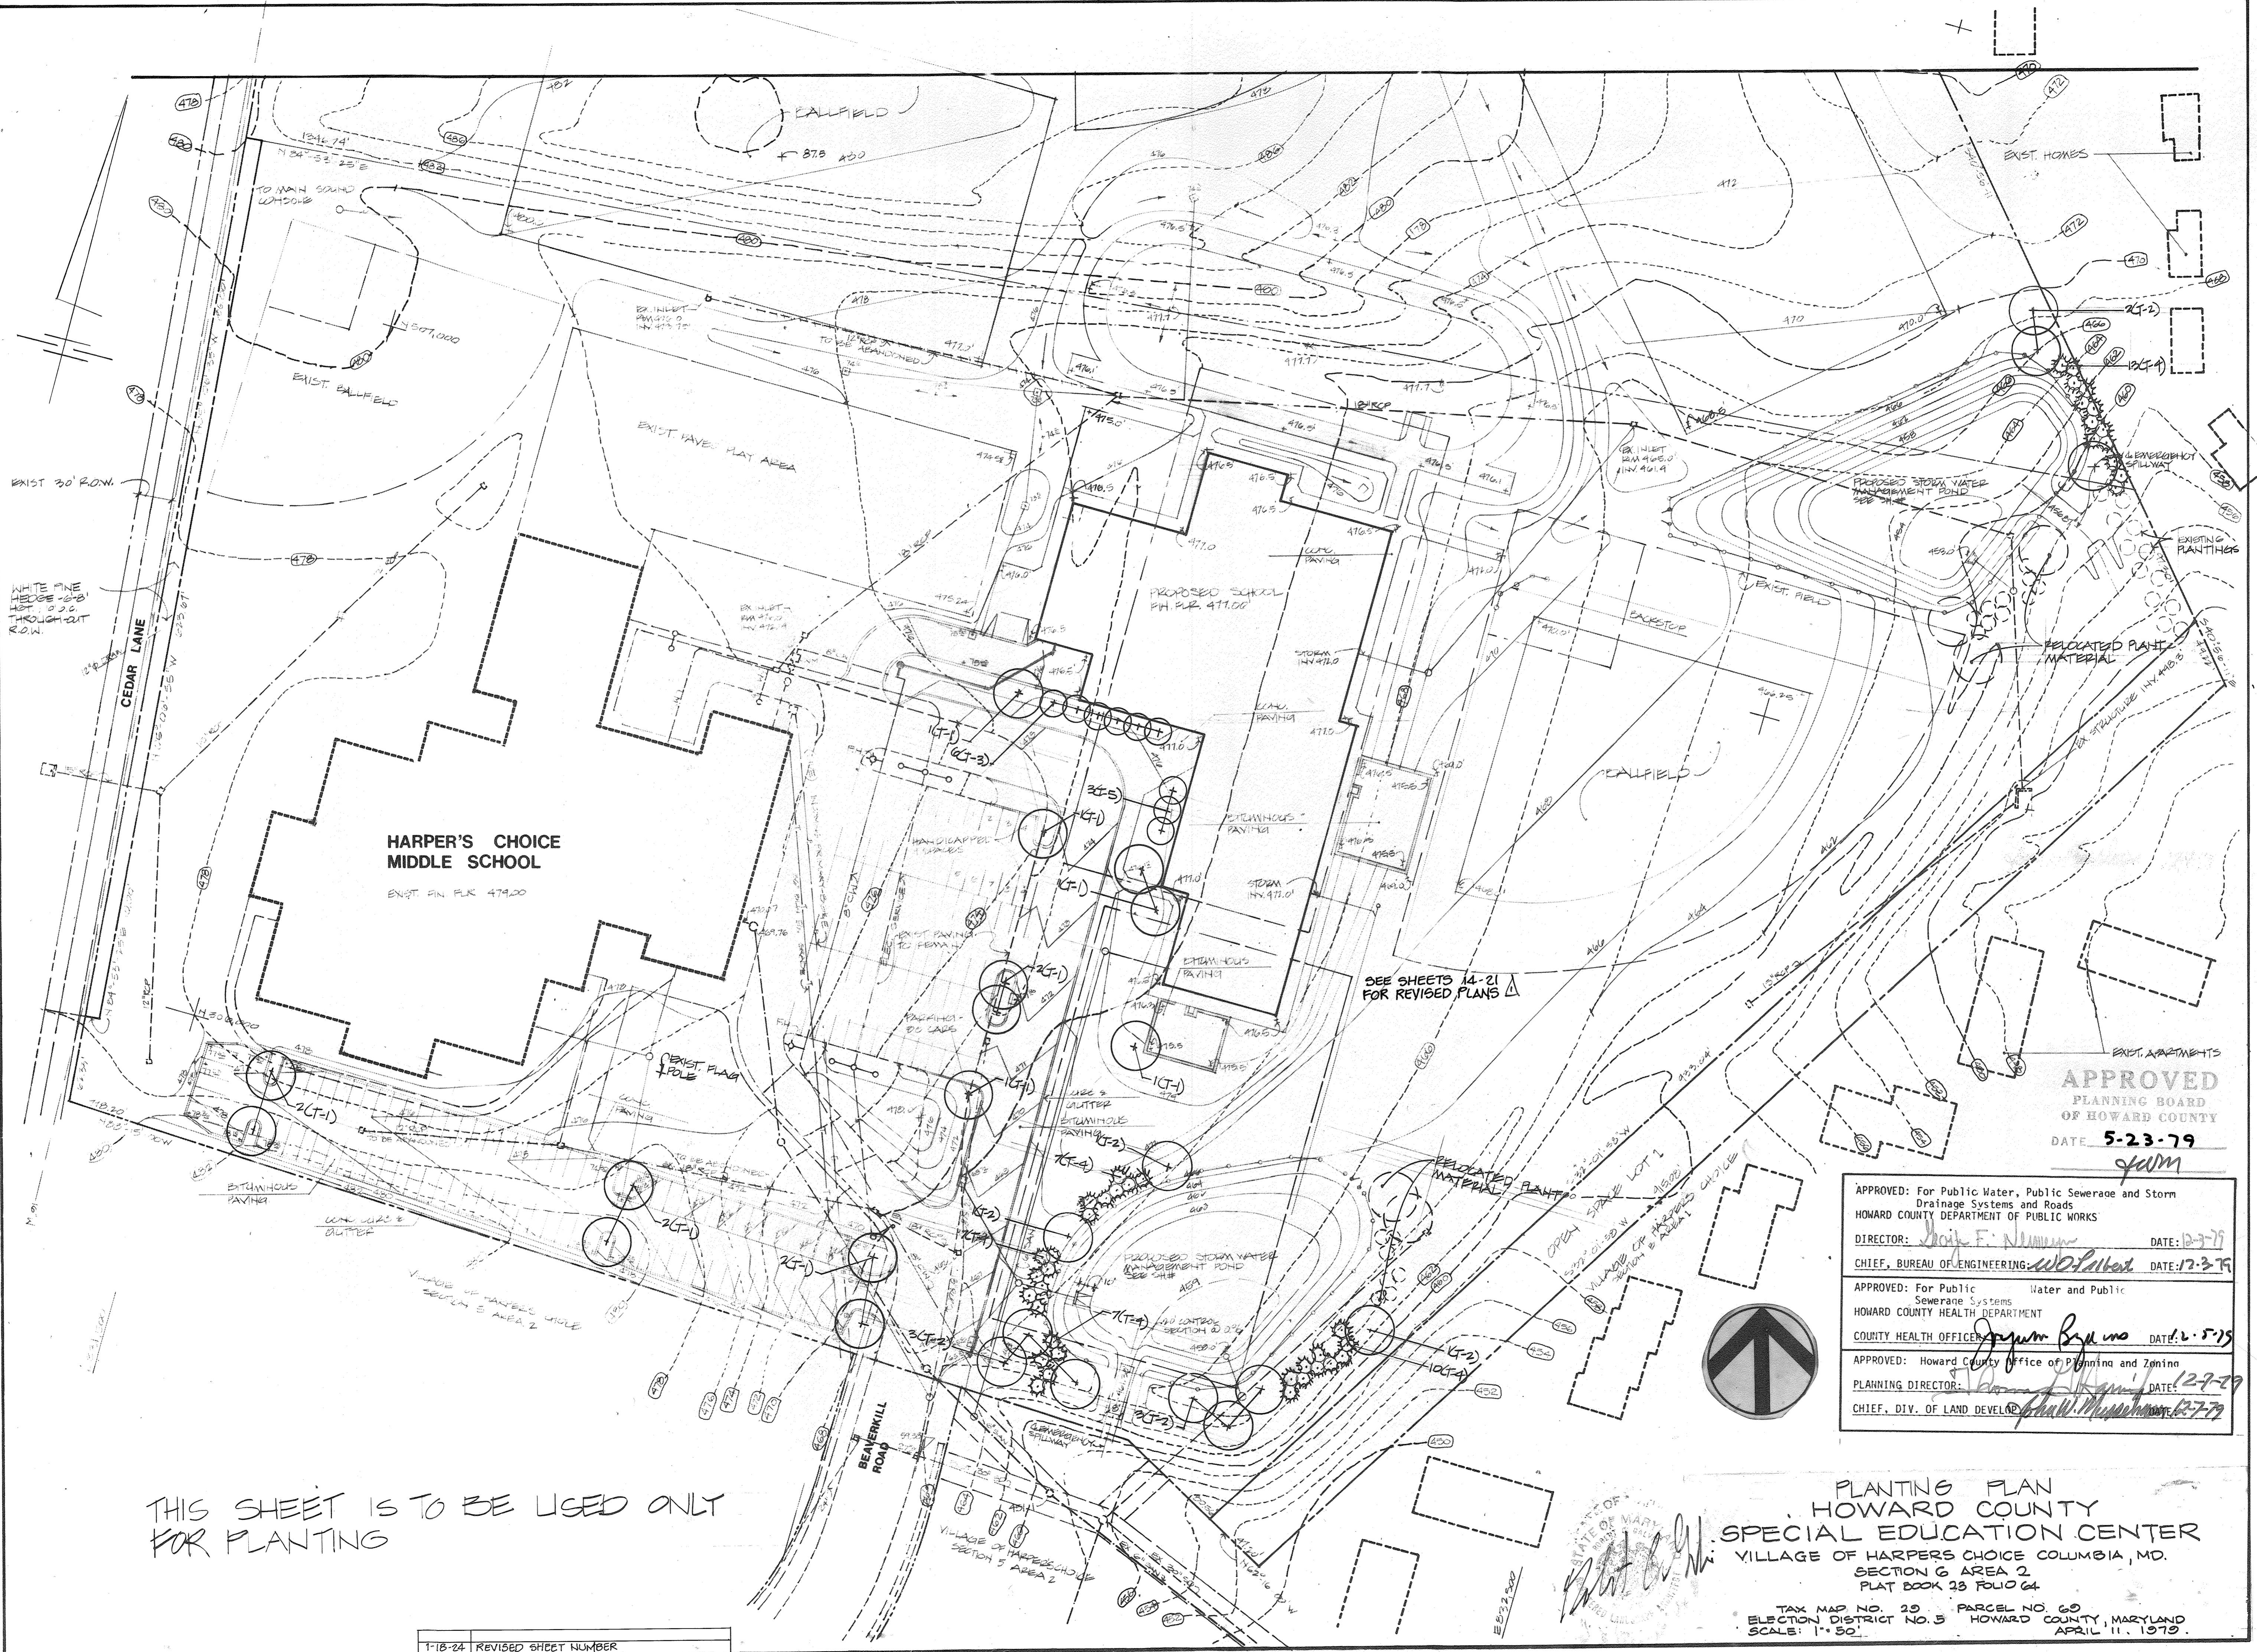

HARPER'S CHOICE MIDDLE SCHOOL
EXIST. FIN. PLR. 479.20


SEE SHEETS 14-21 FOR REVISED PLANS

APPROVED
PLANNING BOARD OF HOWARD COUNTY
DATE: 5-23-79
JDM

APPROVED: For Public Water, Public Sewerage and Storm Drainage Systems and Roads
HOWARD COUNTY DEPARTMENT OF PUBLIC WORKS
DIRECTOR: *Joel F. Nunn* DATE: 12-7-79
CHIEF, BUREAU OF ENGINEERING: *W. J. L. ...* DATE: 12-3-79

APPROVED: For Public Water and Public Sewerage Systems
HOWARD COUNTY HEALTH DEPARTMENT
COUNTY HEALTH OFFICER: *James Byrne* DATE: 12-5-79

APPROVED: Howard County Office of Planning and Zoning
PLANNING DIRECTOR: *...* DATE: 12-7-79
CHIEF, DIV. OF LAND DEVELOPMENT: *...* DATE: 12-7-79

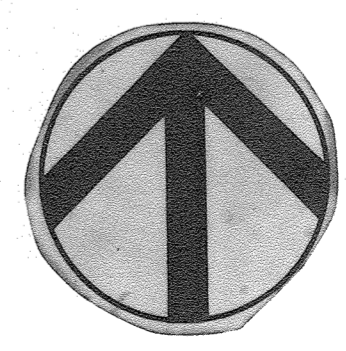

PLANTING PLAN
HOWARD COUNTY
SPECIAL EDUCATION CENTER
VILLAGE OF HARPER'S CHOICE COLUMBIA, MD.
SECTION 6 AREA 2
PLAT BOOK 23 FOLIO 64

TAX MAP NO. 29 PARCEL NO. 60
ELECTION DISTRICT NO. 5 HOWARD COUNTY, MARYLAND
SCALE: 1" = 50'
APRIL 11, 1979

THIS SHEET IS TO BE USED ONLY FOR PLANTING

T-18-24 REVISED SHEET NUMBER

HOWARD COUNTY
SPECIAL EDUCATION CENTER
Columbia, Maryland
Village of Harper's Choice


Browne, Worrall & Johnson / Architects
Baltimore, Maryland 21218
George Evans Associates, Structural
130 West Hamilton St. Baltimore, Maryland
Morgan Lewis, Inc., Mechanical & Electrical
2408 W. Calvert St. Baltimore, Maryland

SD-11
SDP-79-125C


PLANT LIST

KEY	QUAN.	BOTANICAL NAME COMMON NAME	SIZE	COND.	REMARKS
T-1	14	ZELKOVA SERRATA JAPANESE ZELKOVA	2-2 1/2" CAL.	B & B	
T-2	12	ACER RUBRUM RED MAPLE	2-2 1/2" CAL.	B & B	
T-3	6	CRATAEGUS PHENOPYRUM WASHINGTON HAWTHORN	2-10" HGT.	B & B	
T-4	42	PINUS STROBUS WHITE PINE	4-5 HGT.	B & B	
T-5	3	PYRUS CALLERTANA BRADFORD PEAR	1 1/2-2" CAL.	B & B	


NOTE:
1. CONTRACTOR SHALL VERIFY PLANT QUANTITIES TO HIS OWN SATISFACTION.
2. EXISTING PLANT MATERIAL IN THE AREA TO BE DISTURBED SHALL BE RELOCATED TO SCREEN THE STORM WATER MANAGEMENT PONDS. ALL PLANT RELOCATIONS ARE TO BE DONE WITH THE USE OF A TREE MOVING MACHINE. ALL RELOCATIONS ARE TO BE DONE BETWEEN MARCH 15 - MAY 15 & SEPTEMBER 1 & NOVEMBER 15.

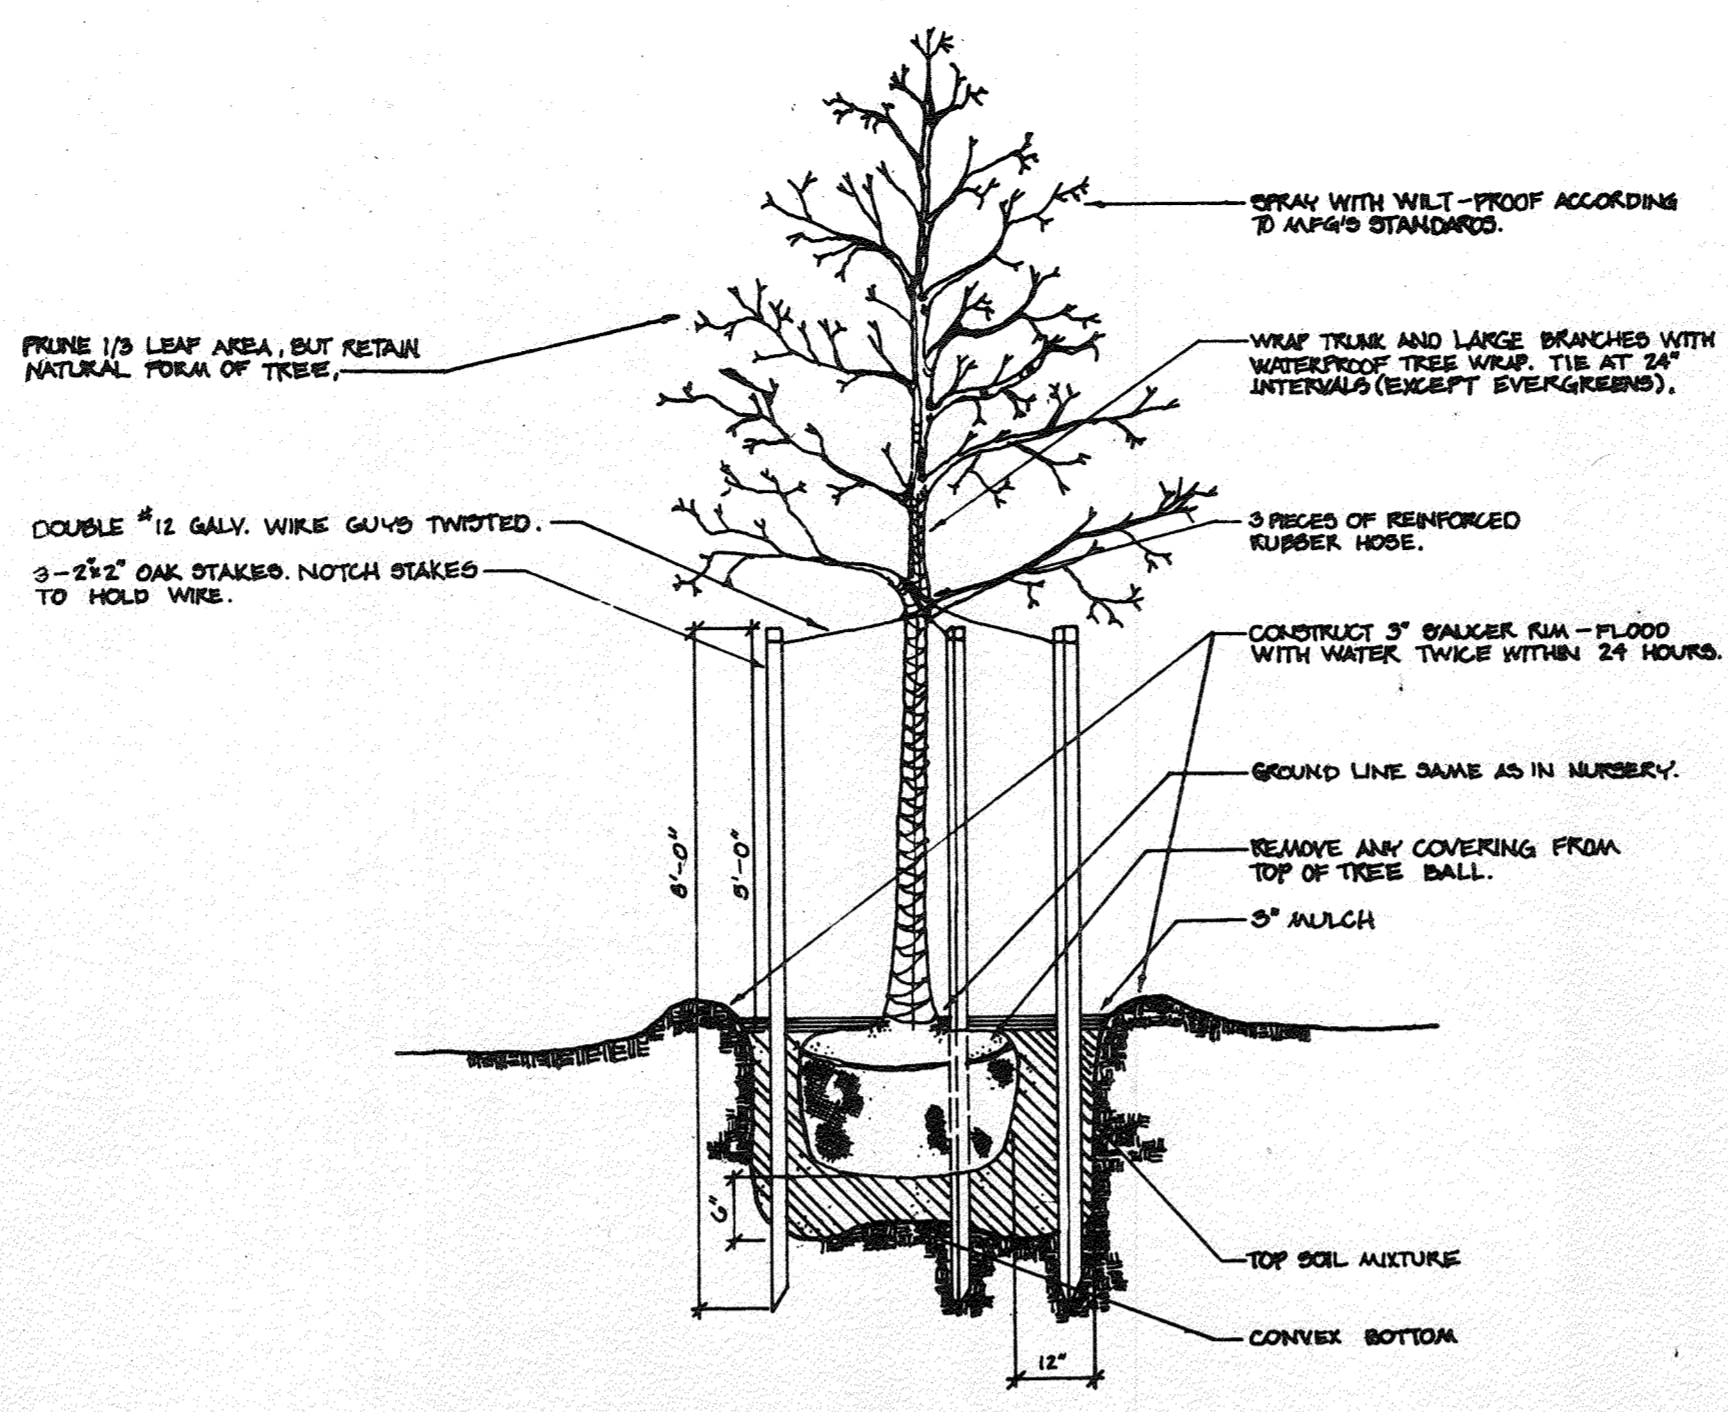

PLANTING DETAIL FOR TREES 1 1/4 - 4" CAL
NO SCALE

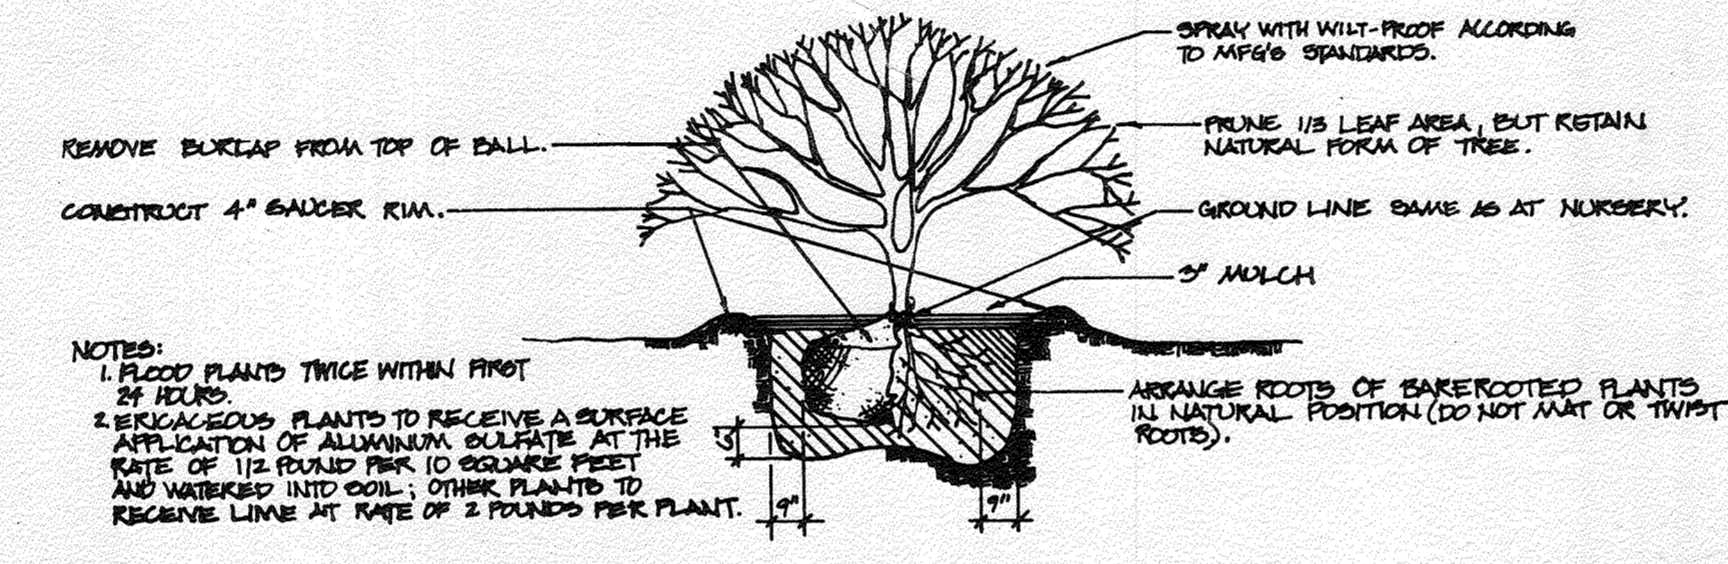


PLANTING DETAIL FOR EVERGREEN AND DECIDUOUS SHRUBS
NO SCALE

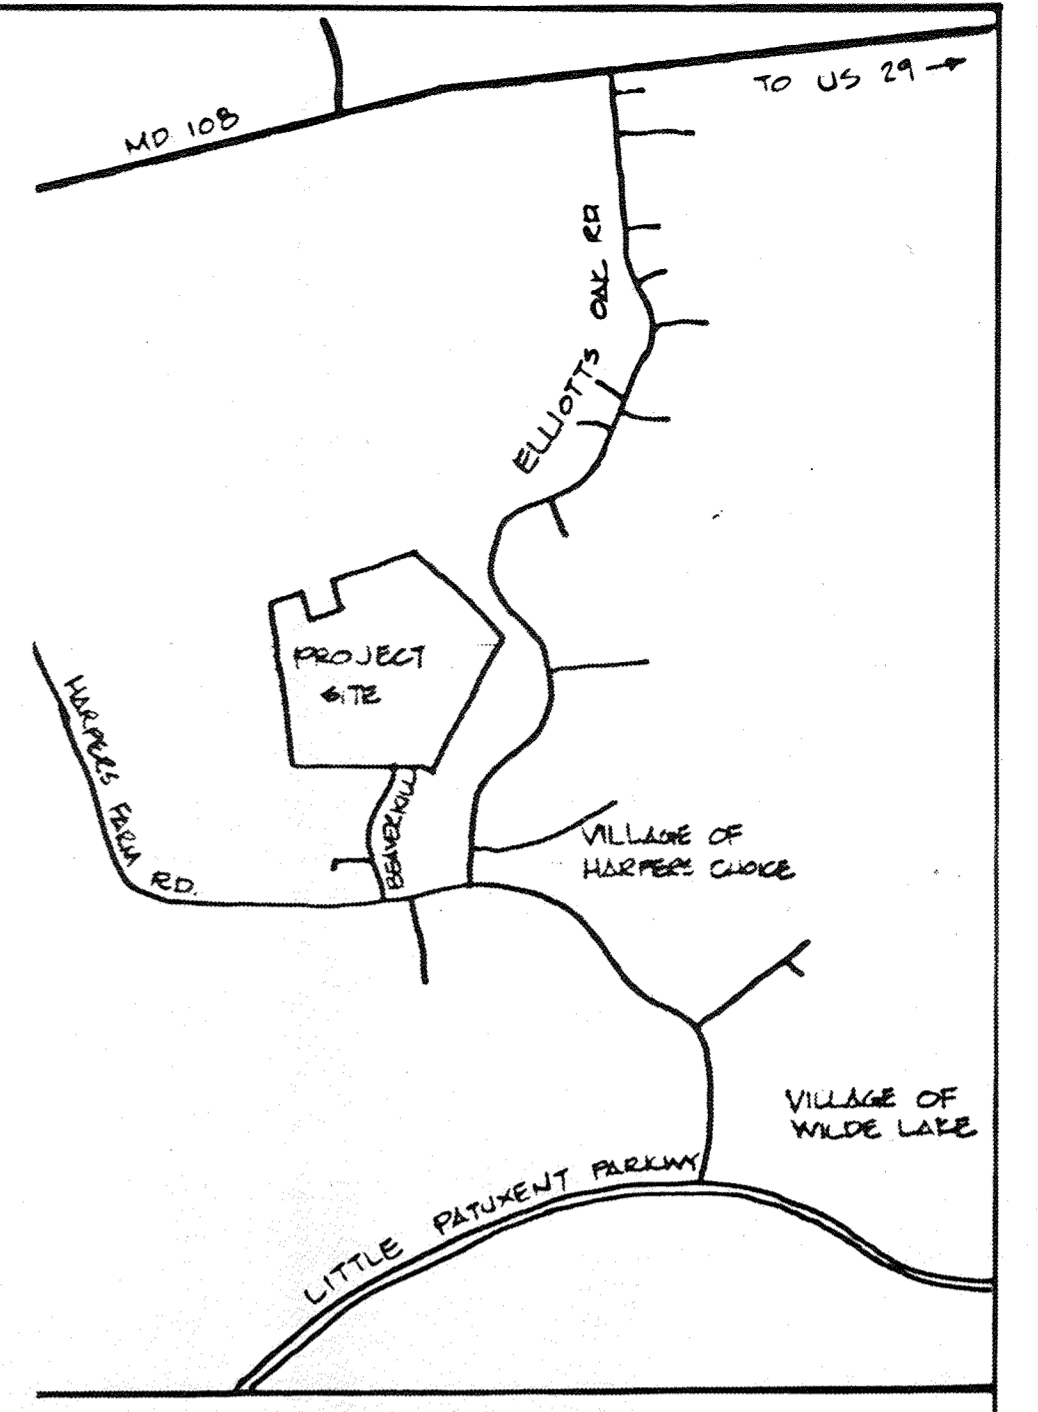

Vicinity Sketch

APPROVED: For Public Water, Public Sewerage and Storm Drainage Systems and Roads
HOWARD COUNTY DEPARTMENT OF PUBLIC WORKS
DIRECTOR: *John F. Neman* DATE: 12-2-79
CHIEF, BUREAU OF ENGINEERING: *W. O. Sabel* DATE: 12-3-79
APPROVED: For Planning, Zoning and Public Works
HOWARD COUNTY DEPARTMENT OF PUBLIC WORKS
COUNTY HEALTH OFFICER: *John E. Gurn* DATE: 1-5-79
APPROVED: Howard County Office of Planning and Zoning
PLANNING DIRECTOR: *Thomas J. Hume* DATE: 12-7-79
CHIEF, DIV. OF LAND DEVELOPMENT: *John W. Hume* DATE: 12-7-79

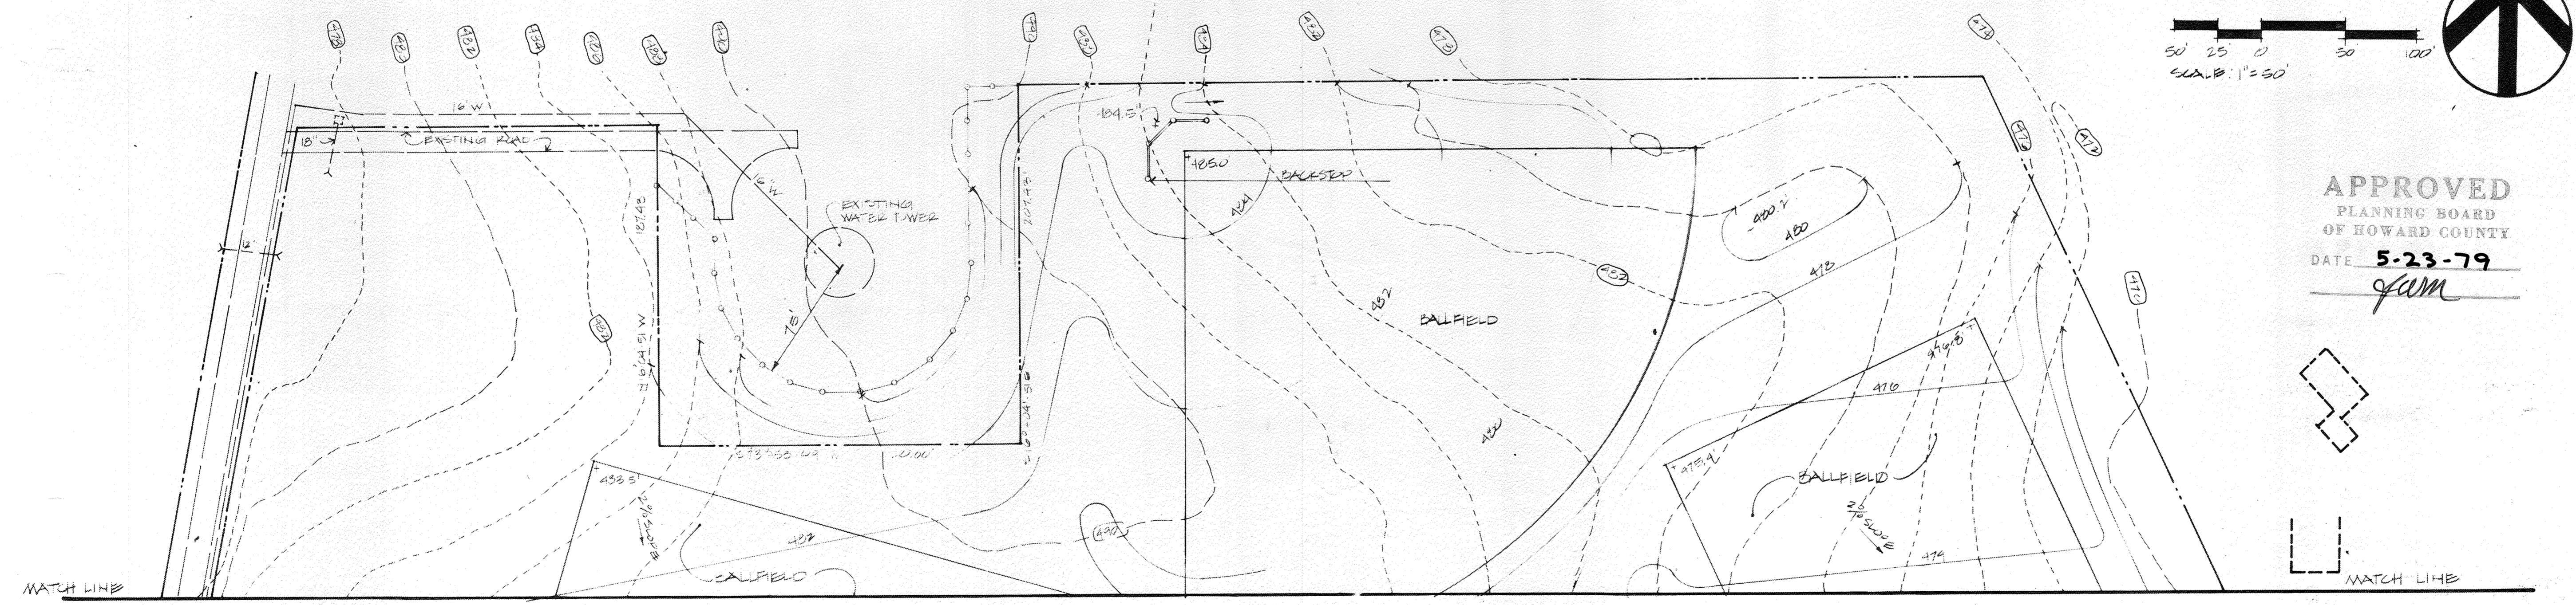

THIS SHEET IS TO BE USED ONLY FOR PLANTING


PLANTING PLAN
HOWARD COUNTY
SPECIAL EDUCATION CENTER
VILLAGE OF HARPERS CHOICE COLUMBIA, MD.
SECTION 6 AREA 2
PLAT BOOK 28 FOLD 64

TAX MAP NO. 20 PARCEL NO. 60
ELECTION DISTRICT NO. 5 HOWARD COUNTY, MARYLAND
SCALE: 1" = 50' APRIL 11, 1979


HOWARD COUNTY SPECIAL EDUCATION CENTER
Village of Harper's Choice
Columbia, Maryland

Browne, Worrall & Johnson / Architects
2435 North Calvert Street
Baltimore, Maryland 21218
George Evars Associates, Structural
130 West Harmon St. Baltimore, Maryland
Moore Lewis, Inc., Mechanical & Electrical
2435 N. Calvert St. Baltimore, Maryland

SD-12
OP 21
SDP-79-125C

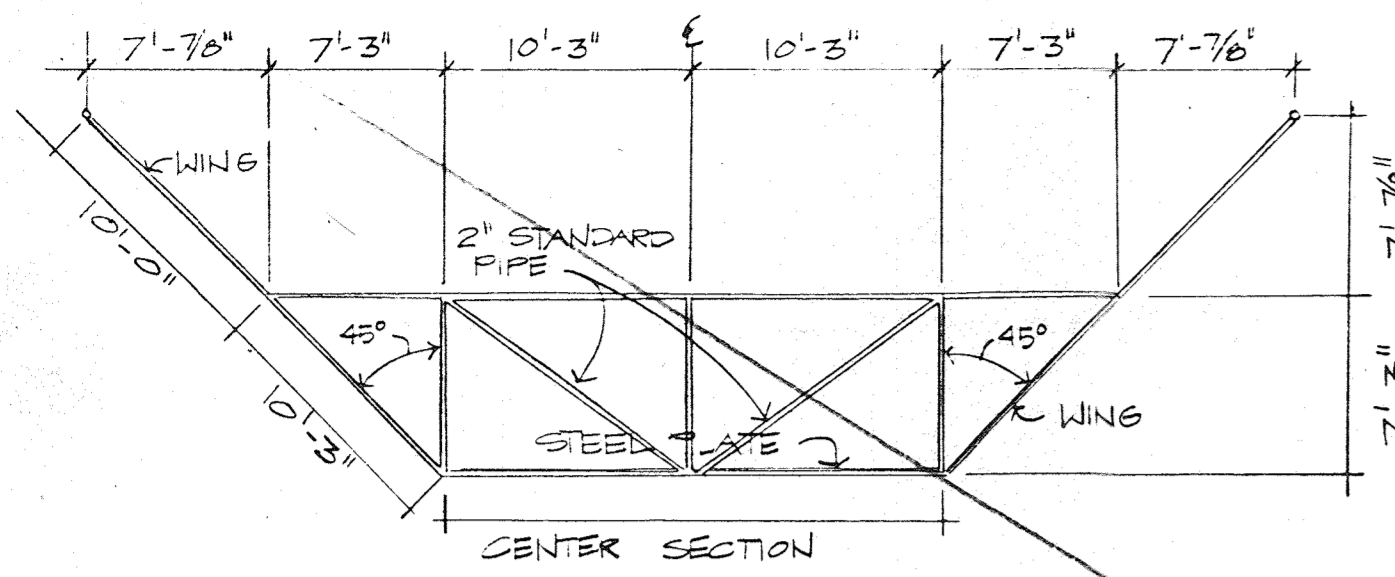


PLAN VIEW
SCALE 1/8"=1'-0"

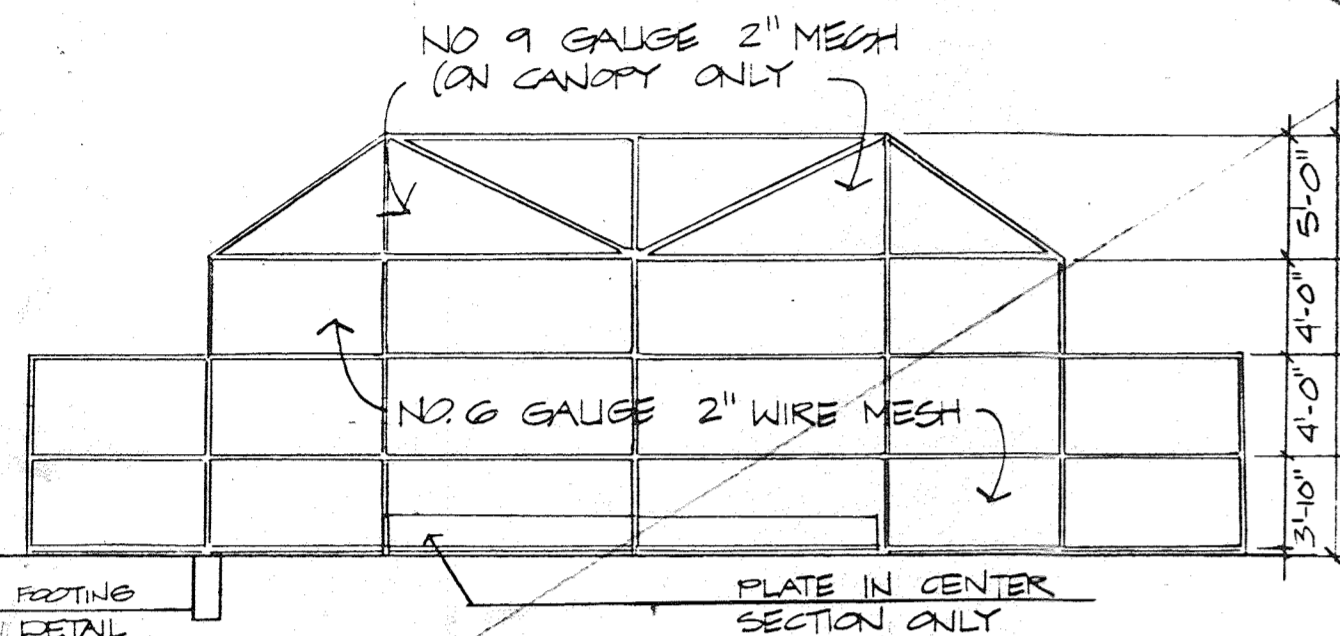


ELEVATION
SCALE 1/8"=1'-0"

THIS DETAIL IS NOT IN CONTRACT


① HOODED BACKSTOP
⑬ SCALE: SEE DETAIL

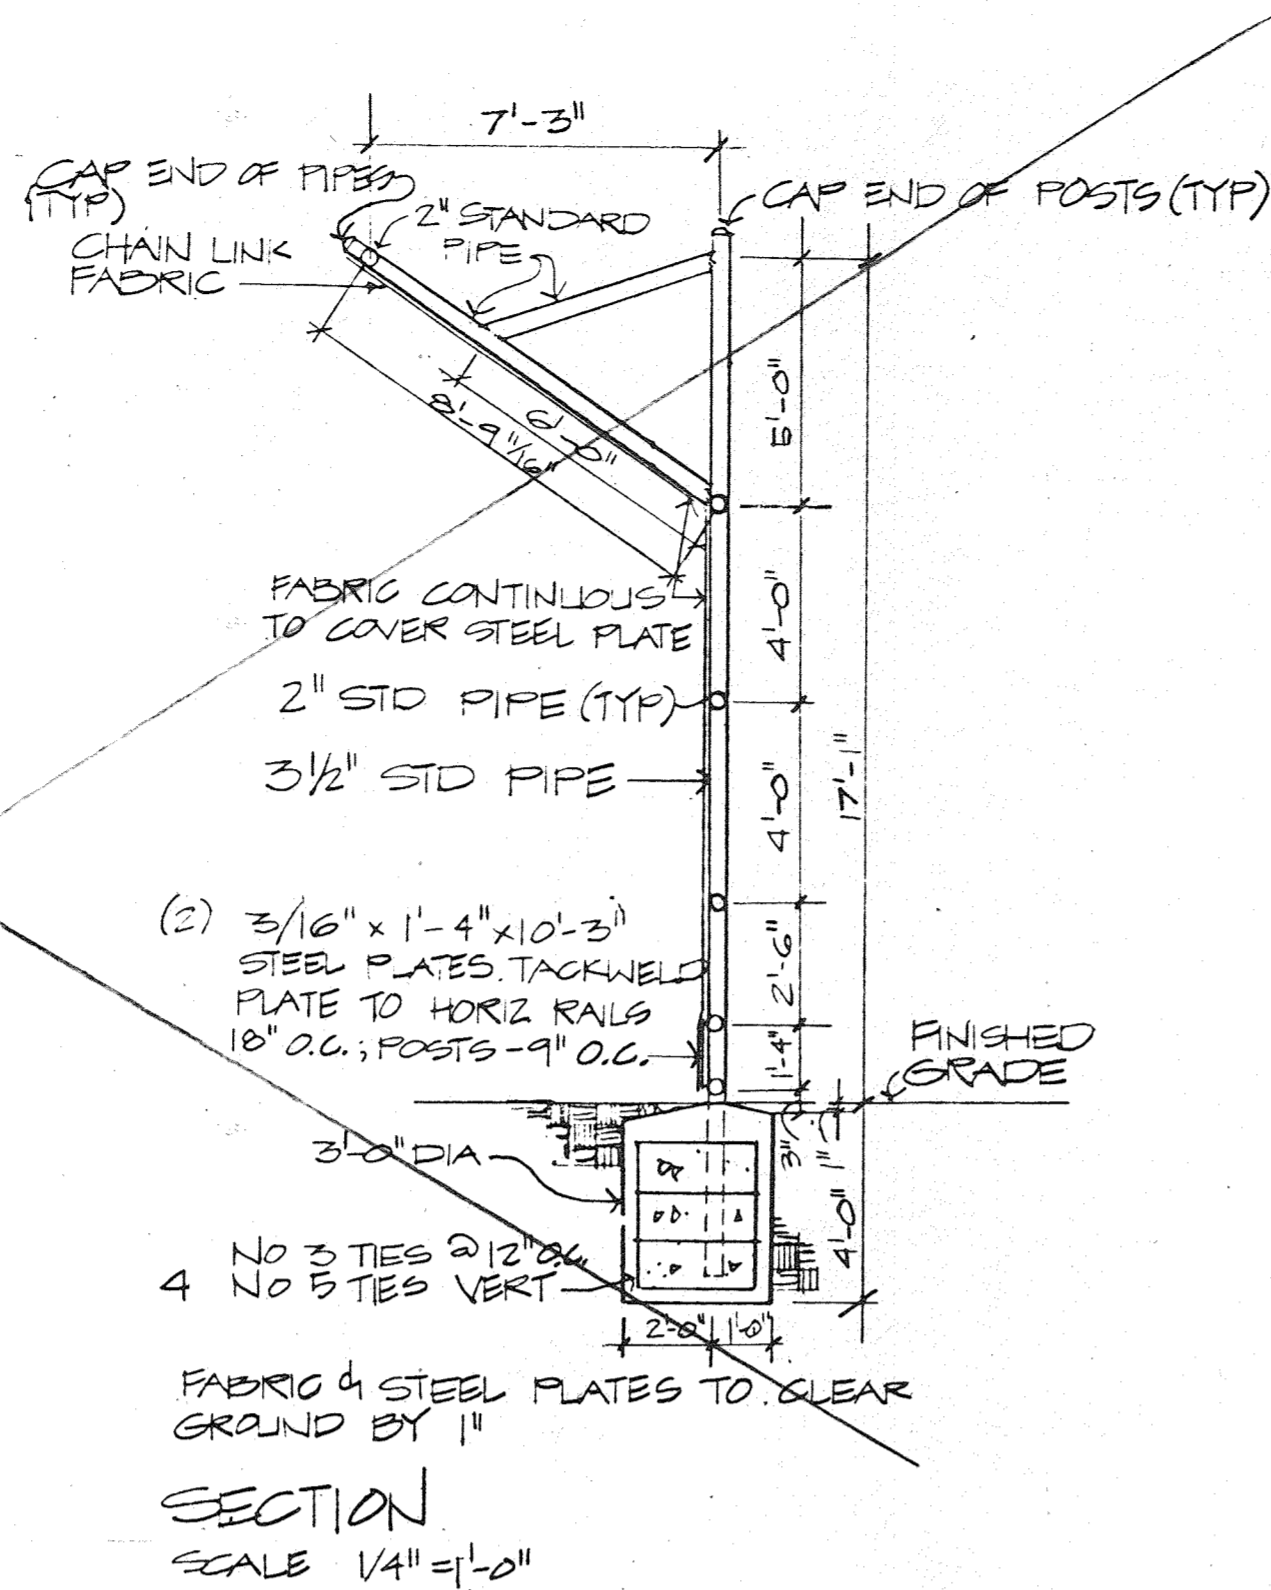


SECTION
SCALE 1/4"=1'-0"

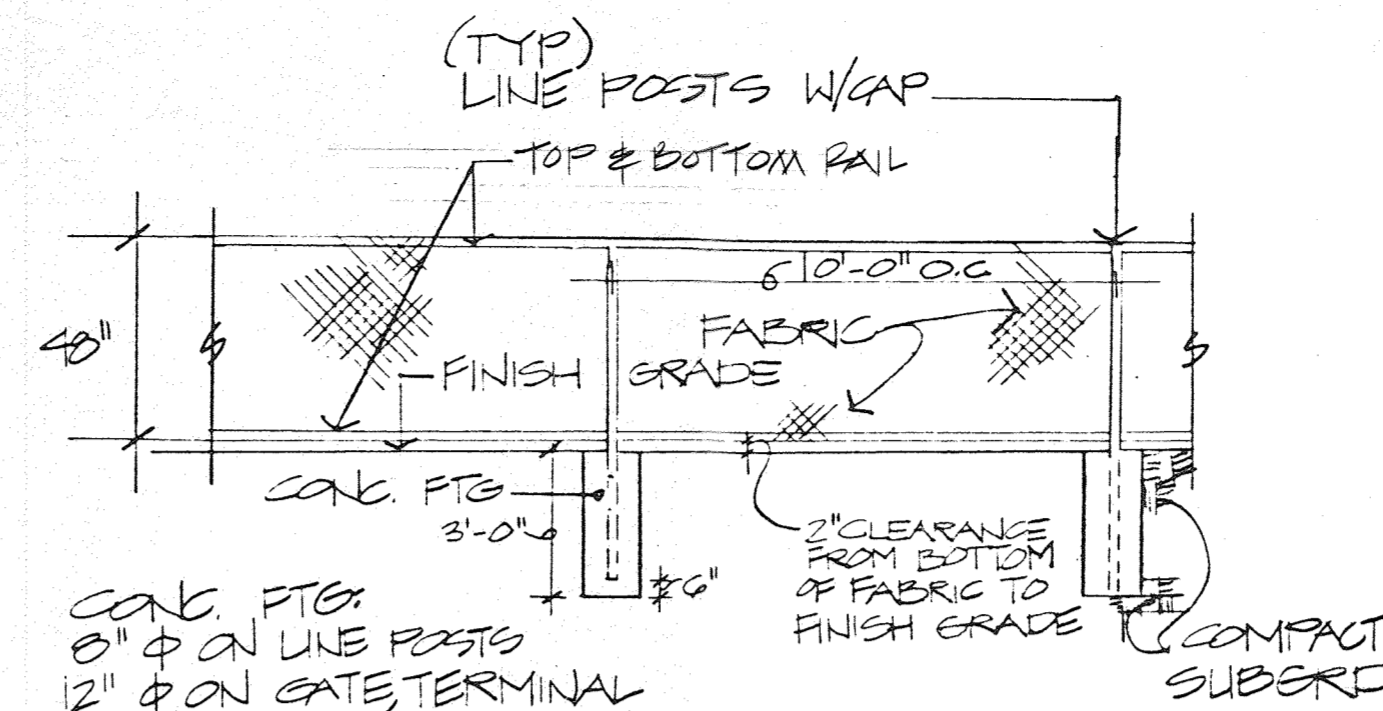


PROFILE TYPICAL RUN
SCALE 1/4"=1'-0"

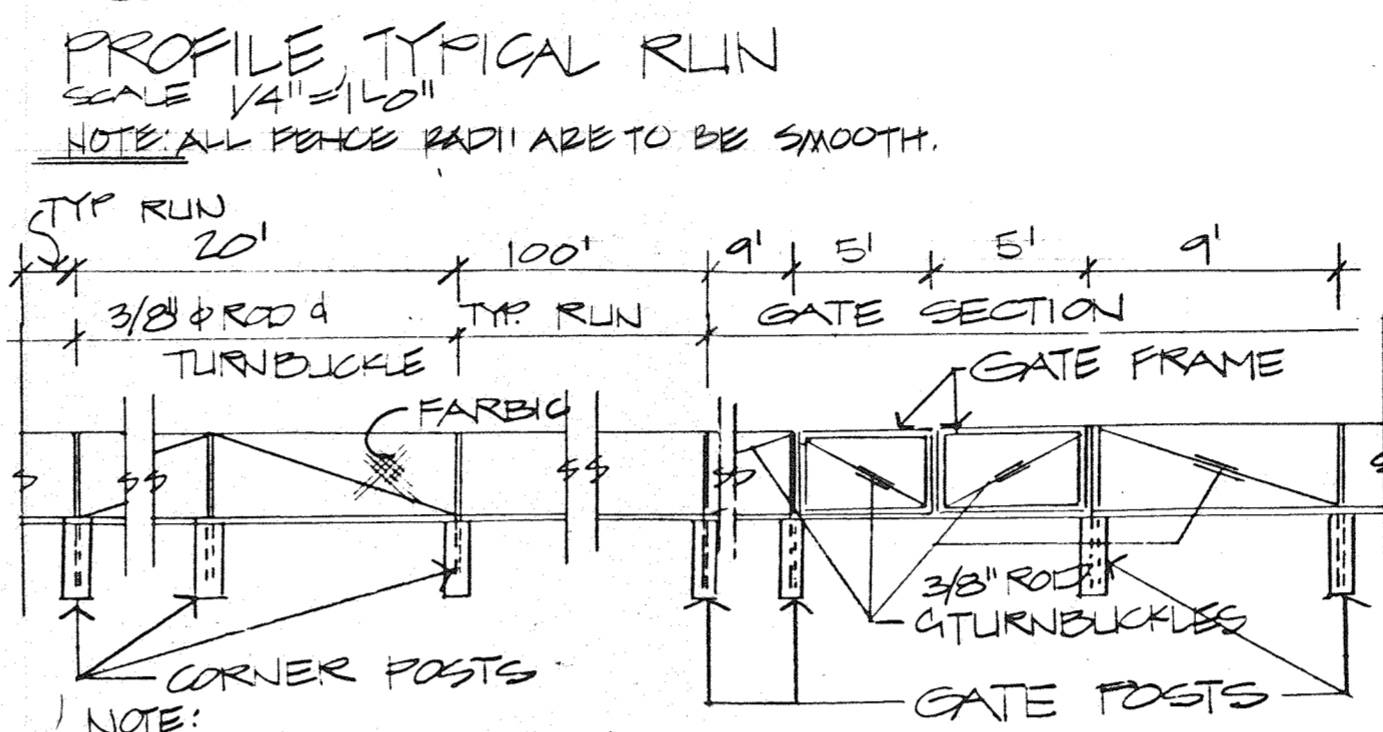


PROFILE: GATE SECTION
NO SCALE

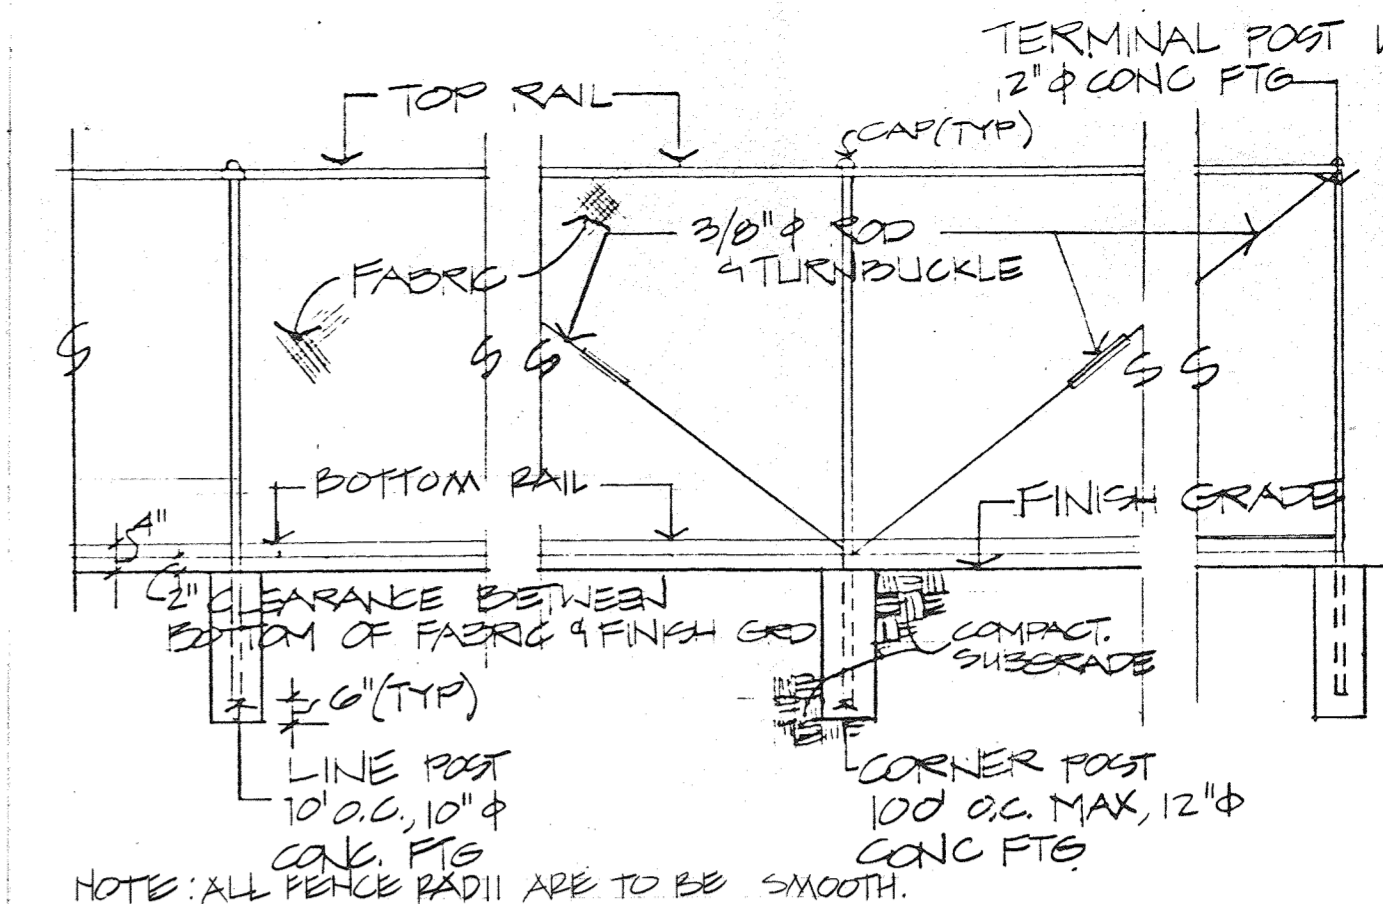

② 8' FENCE
⑬ SCALE: 1/4"

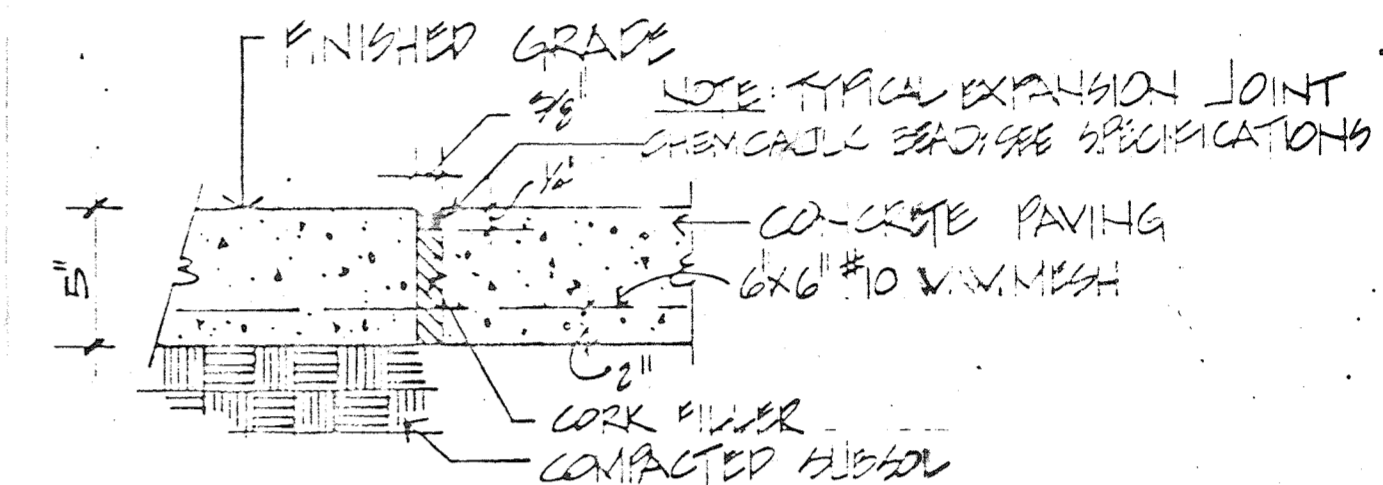


④ CONCRETE PAVING SECTION (NO SCALE)
NOTE: THESE DETAILS ARE TYPICAL FOR ALL CONCRETE PAVING SHOWN ON SITE PLANS.

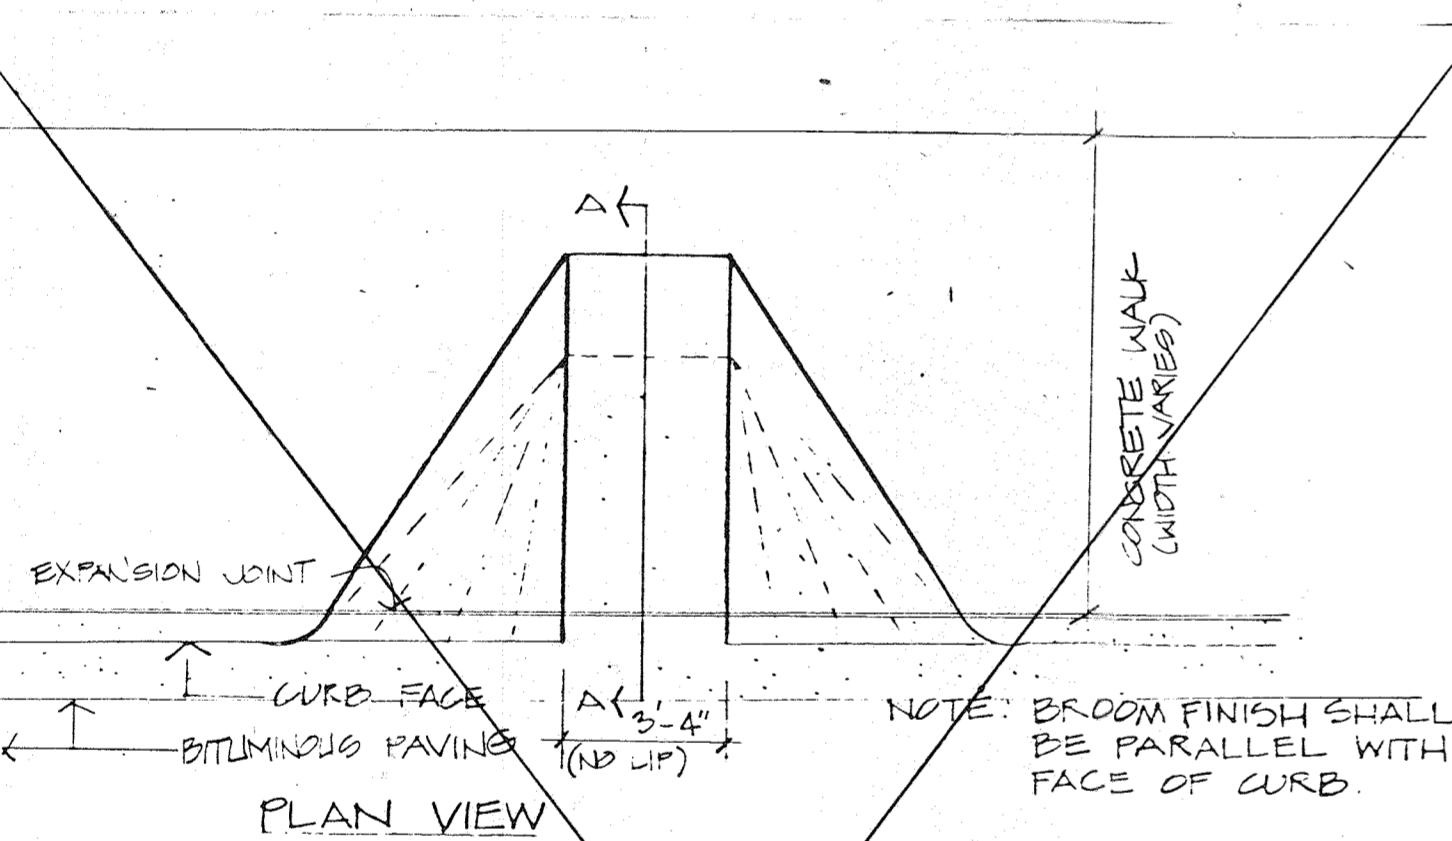


PLAN VIEW

NOTE: BROOM FINISH SHALL BE PARALLEL WITH FACE OF CURB.

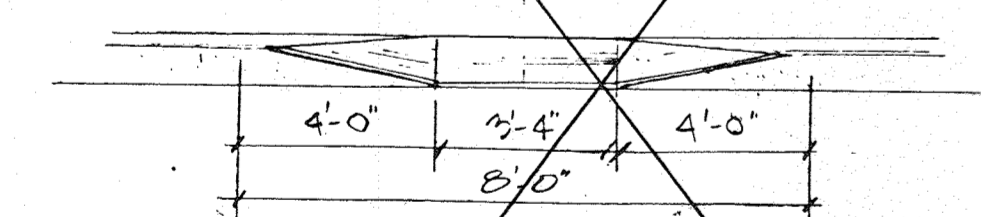


FRONT ELEVATION

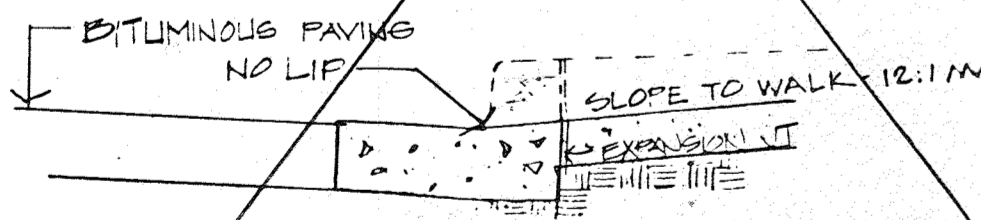


SECTION A-A

SEE DETAIL ②

⑤ HANDICAPPED RAMP
⑬ SCALE NONE

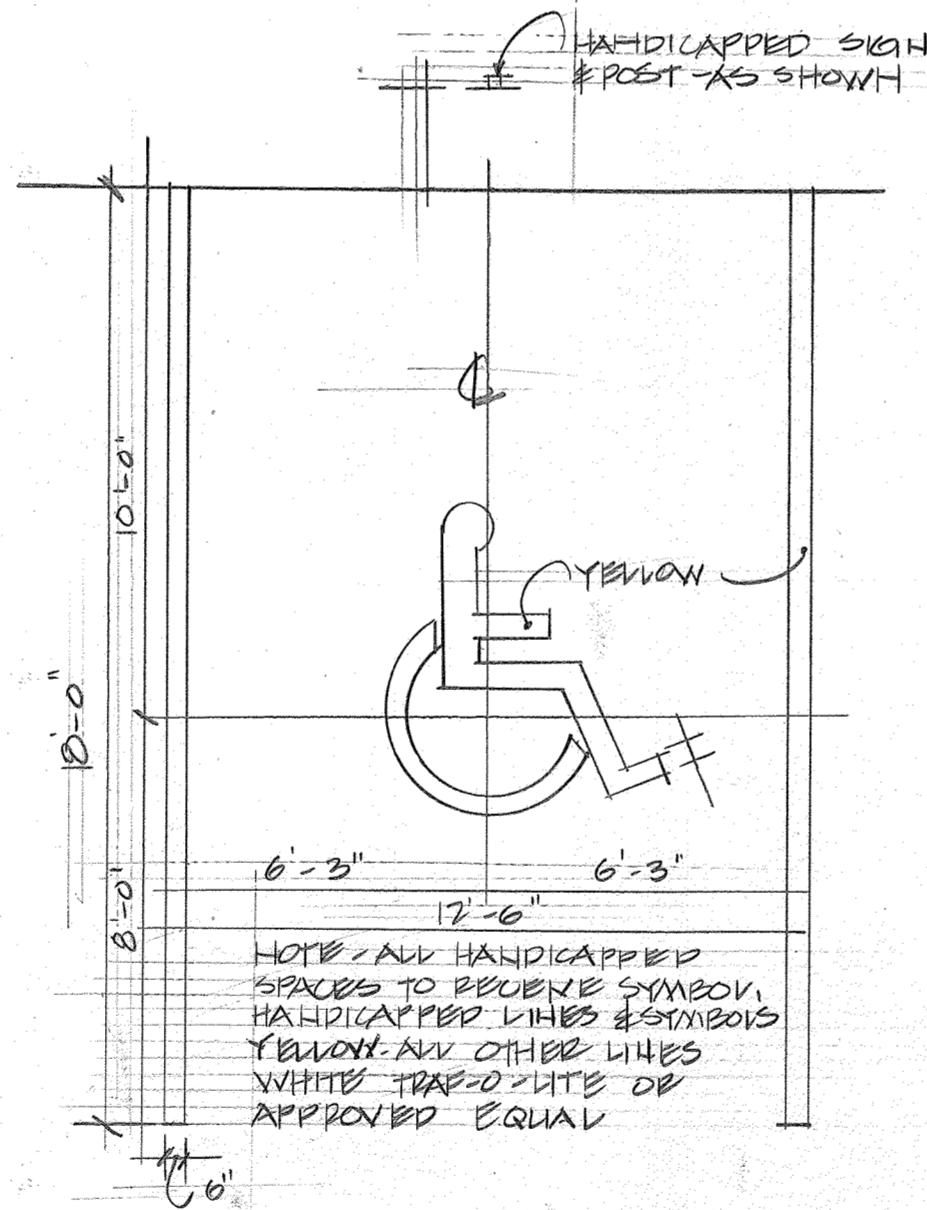

⑥ PARKING SPACE PLAN
⑬ SCALE 1/4"=1'-0"

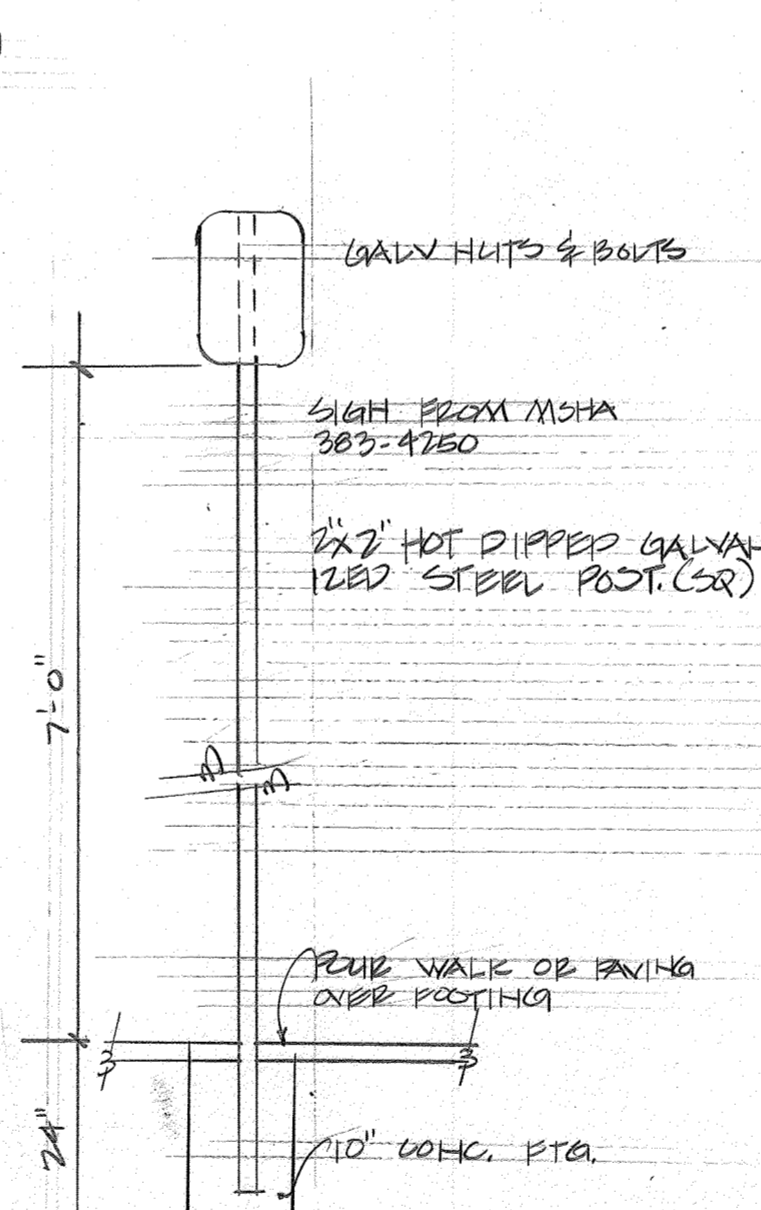

⑦ SIGN SECTION
SCALE 1/2"=1'-0"

APPROVED
PLANNING BOARD
OF HOWARD COUNTY
DATE: 5-23-79
Jum

APPROVED: For Public Water, Public Sewerage and Storm Drainage Systems and Roads HOWARD COUNTY DEPARTMENT OF PUBLIC WORKS DIRECTOR: <i>J. F. Naiman</i> DATE: 12-79
CHIEF, BUREAU OF ENGINEERING: <i>W. O. Palmer</i> DATE: 12-79
APPROVED: For Public Water and Public Sewerage Systems HOWARD COUNTY HEALTH DEPARTMENT COUNTY HEALTH OFFICER: <i>James B. ...</i> DATE: 12-79
APPROVED: Howard County Office of Planning and Zoning PLANNING DIRECTOR: <i>...</i> DATE: 12-79
CHIEF, DIV. OF LAND DEVELOPMENT: <i>...</i> DATE: 12-79



SITE DETAILS
HOWARD COUNTY
SPECIAL EDUCATION CENTER
VILLAGE OF HARPERS CHOICE COLUMBIA, MD.
SECTION G AREA 2
PLAT BOOK 23 FOLIO 64

TAX MAP NO. 29 PARCEL NO. 60
ELECTION DISTRICT NO. 5 HOWARD COUNTY, MARYLAND
SCALE: 1"=1'-0" APRIL 11, 1979


B.L.S. 6/12/05 LOT 3

Browne, Worrall & Johnson / Architects
Baltimore, Maryland 21218
George Evers Associates, Structural
150 West Hamilton St. Baltimore, Maryland
Moore Lewis, Inc., Mechanical & Electrical
2435 N. Calvert St. Baltimore, Maryland

SD-13
OF 21
SDP-79-125C


HOWARD COUNTY SPECIAL EDUCATION CENTER
Columbia, Maryland
Village of Harper's Choice
OWNER & DEVELOPER: HOWARD COUNTY PUBLIC SCHOOL SYSTEM

SITE DEVELOPMENT PLAN OLD CEDAR LANE SPECIAL EDUCATION CENTER VILLAGE OF HARPER'S CHOICE SECTION 6 AREA 2

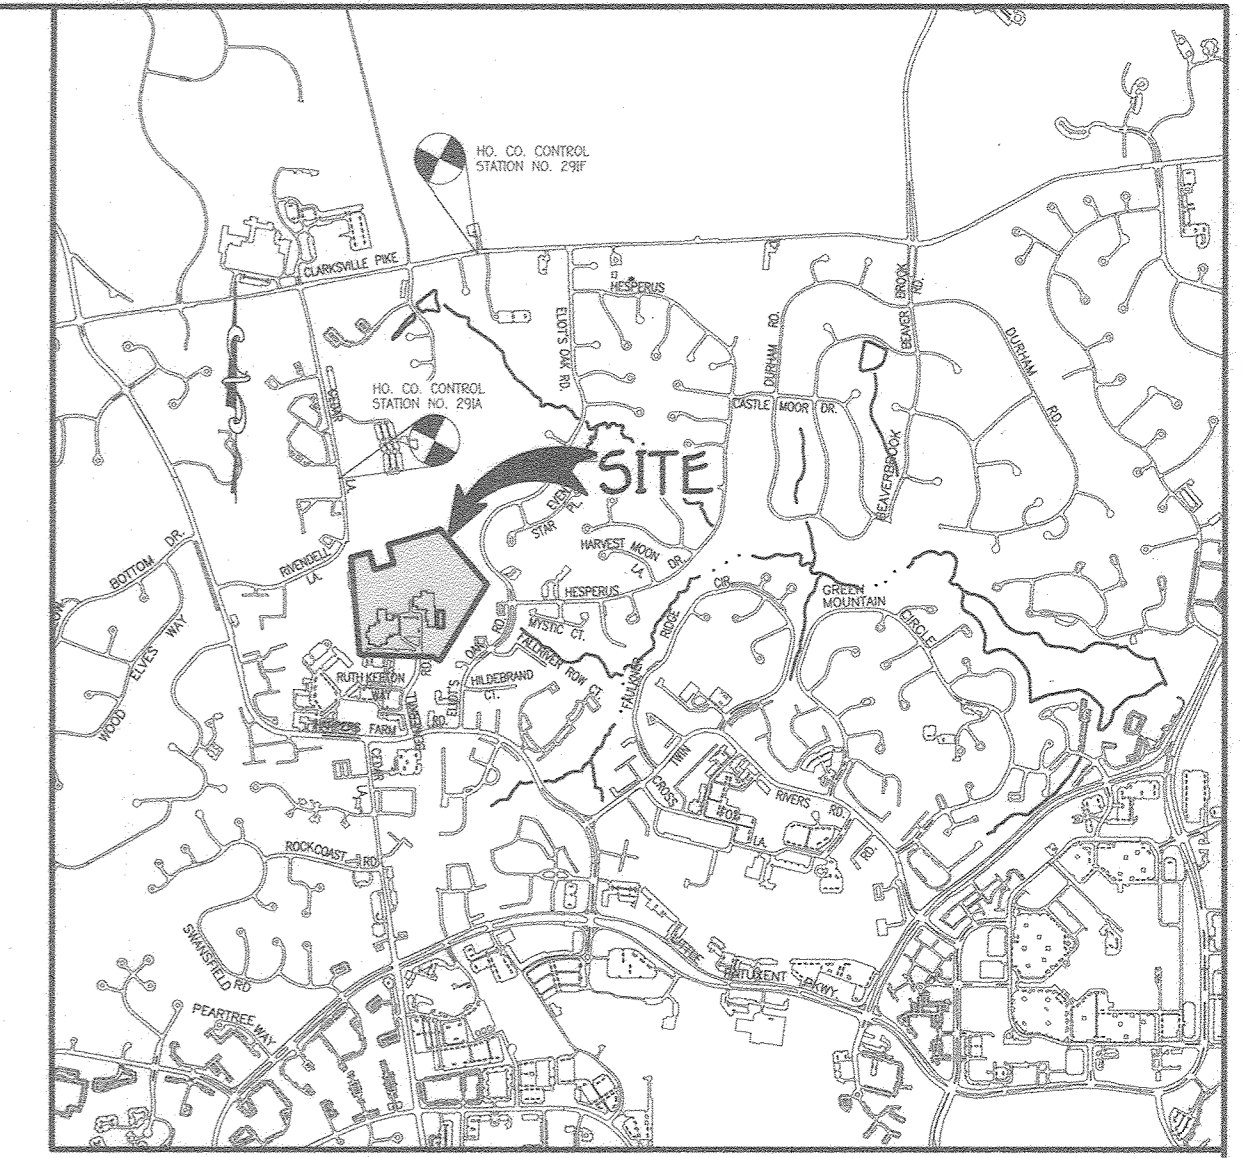

VICINITY MAP
SCALE: 1" = 2000'
2000' 4000' 6000'
ADC STREET MAP 26, GRID C7

LEGEND - EX. CONDITIONS		LEGEND - PROP. CONDITIONS	
SYMBOL	DESCRIPTION	SYMBOL	DESCRIPTION
---	EXISTING CONTOUR 2' INTERVAL	---	PROPOSED CONTOUR 2' INTERVAL
---	EXISTING CONTOUR 10' INTERVAL	---	PROPOSED CONTOUR 10' INTERVAL
S	EXISTING SAN SEWER LINE	+ 470.50	PROPOSED SPOT ELEVATION
D	EXISTING STORM DRAIN LINE	---	PROPOSED CONCRETE WALK
W	EXISTING WATER LINE	---	PROPOSED GRASS PAVERS
E	EXISTING UNDERGROUND ELECTRIC LINE	---	PROPOSED TREE LINE
FO	EXISTING FIBER OPTICS LINE	---	PROPOSED WATER
GAS	EXISTING GAS LINE	---	PROPOSED STORMDRAIN
---	EXISTING TREE	---	PROPOSED SEWER
---	EXISTING TREE LINE	---	
---	EXISTING CONCRETE	---	
---	EXISTING PAVING	---	

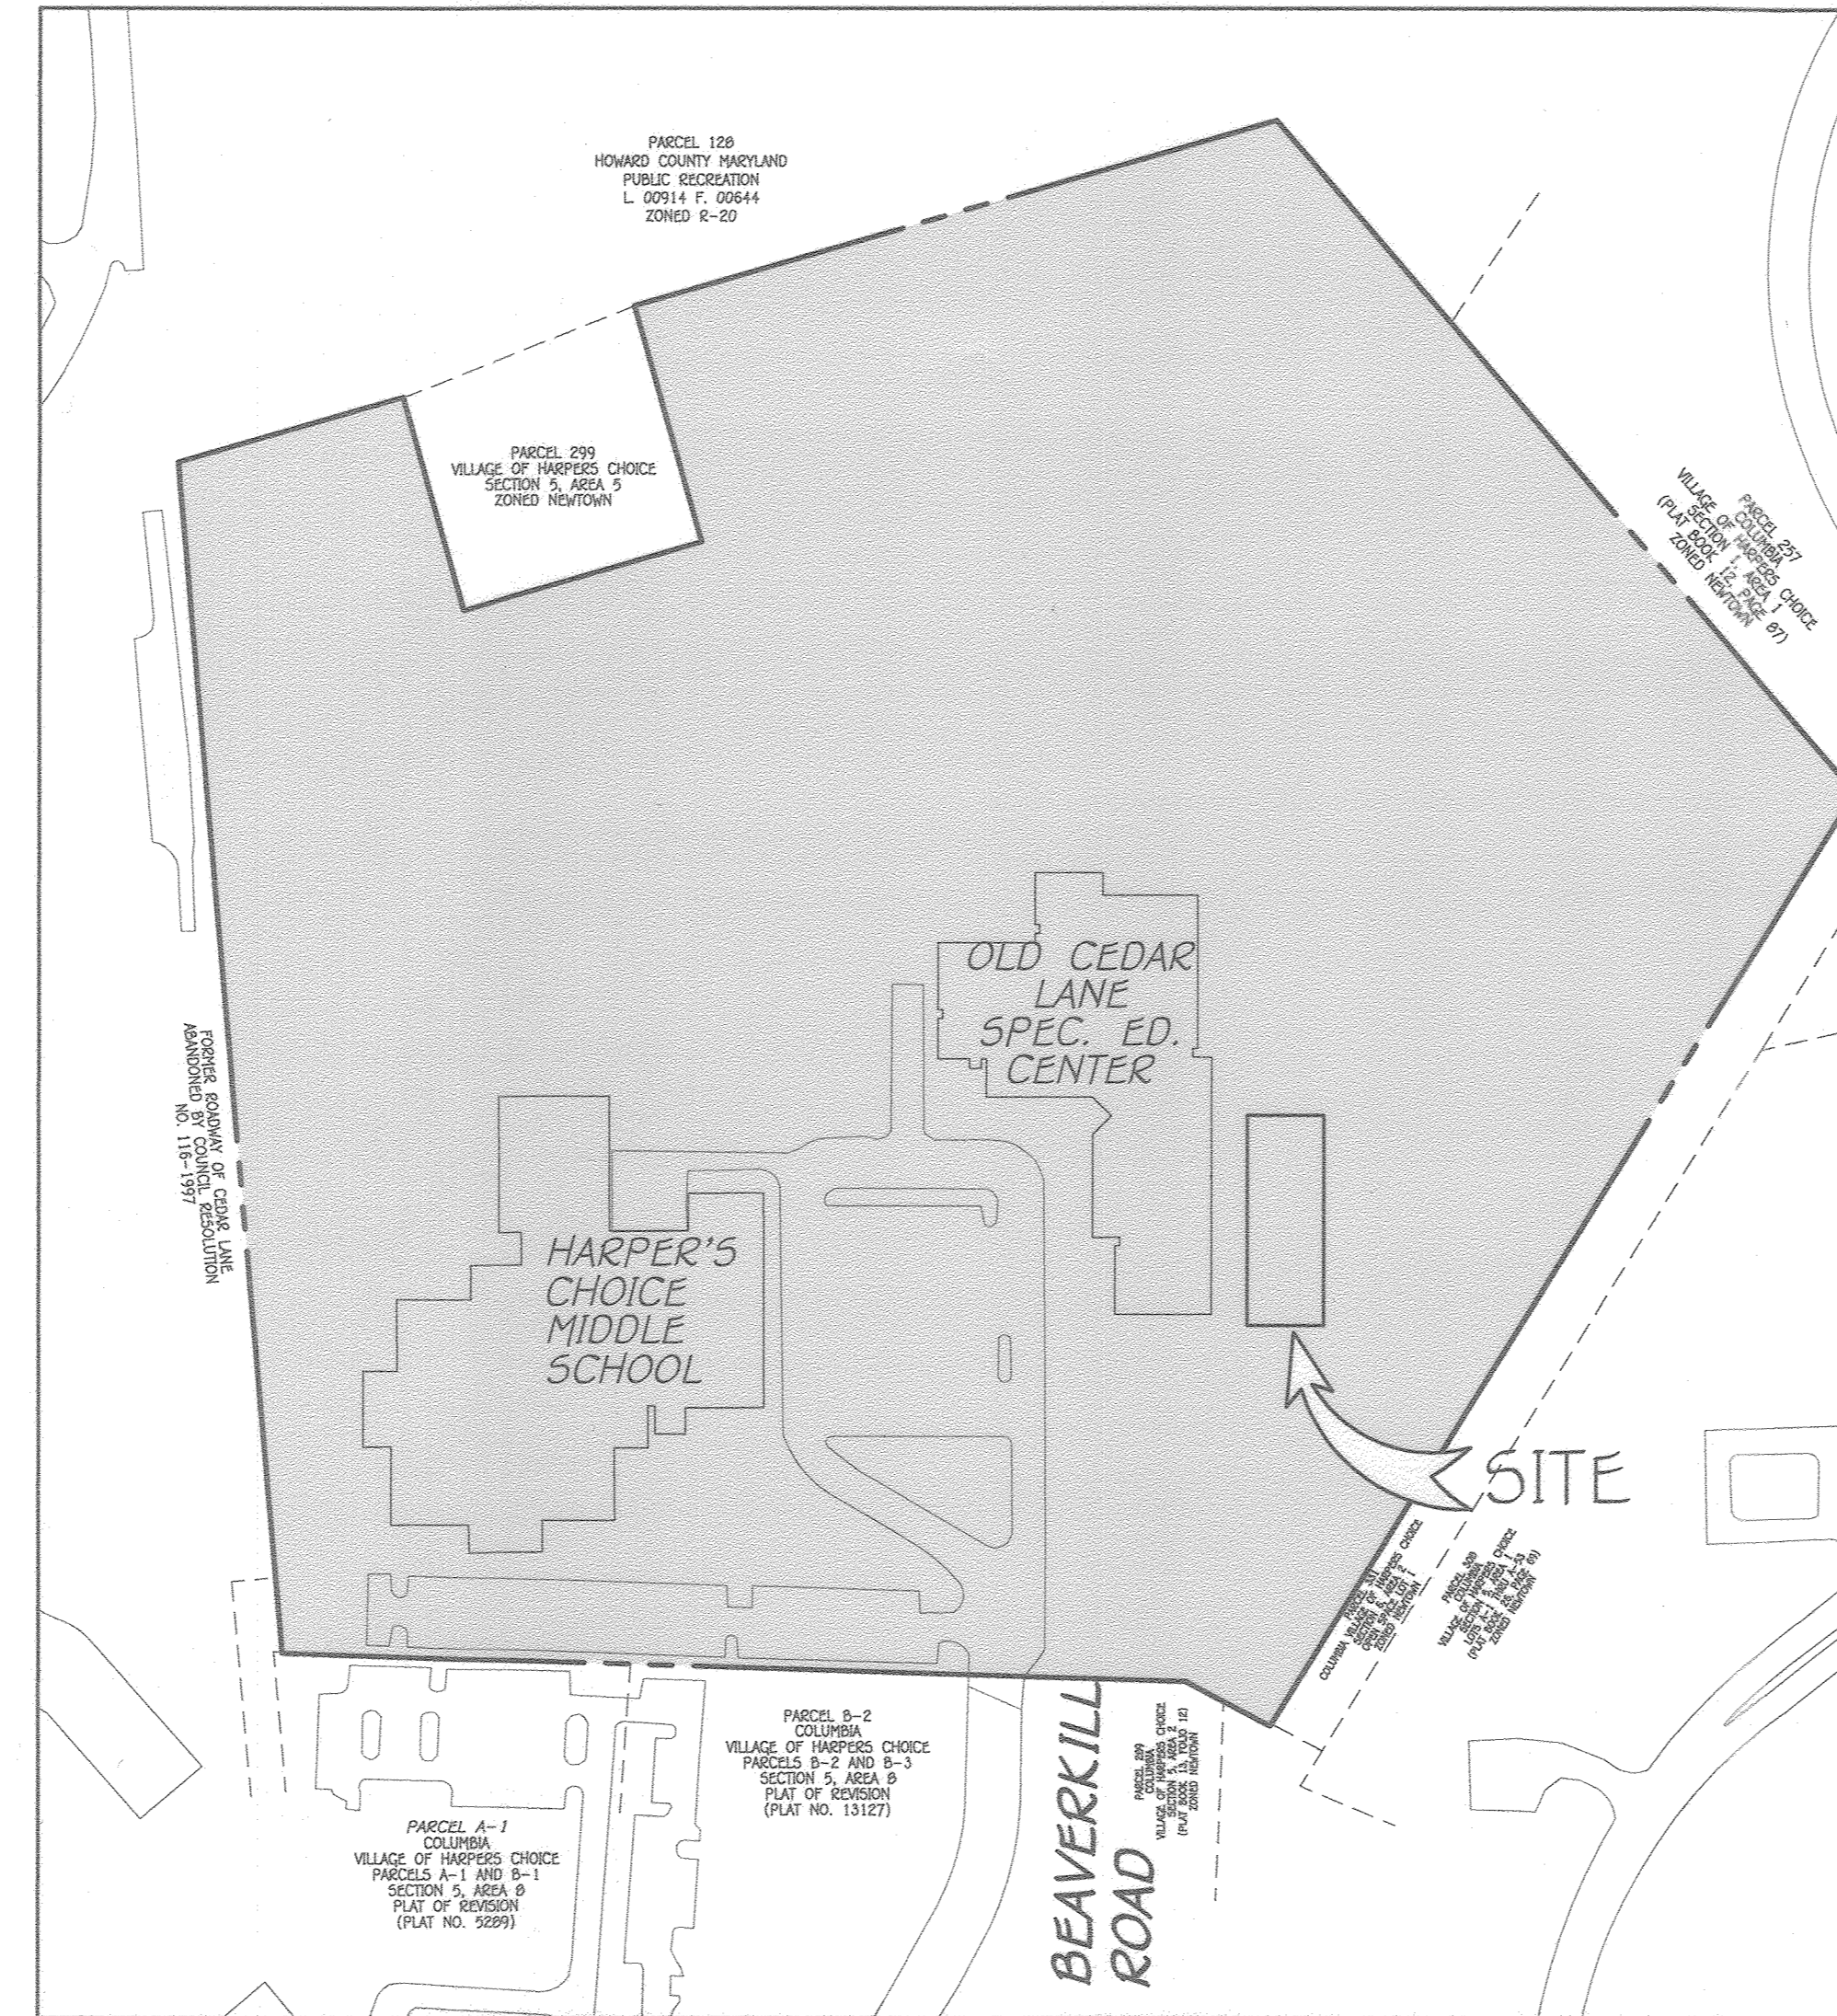

LOCATION MAP
SCALE: 1" = 150'
0' 150' 300' 450'

- GENERAL NOTES:**
- ALL CONSTRUCTION SHALL BE IN ACCORDANCE WITH THE LATEST STANDARDS AND SPECIFICATIONS OF HOWARD COUNTY PLUS MSHA STANDARDS AND SPECIFICATIONS IF APPLICABLE.
 - THE CONTRACTOR SHALL NOTIFY THE DEPARTMENT OF PUBLIC WORKS, BUREAU OF ENGINEERING, CONSTRUCTION INSPECTION DIVISION AT (410) 313-1000 AT LEAST (5) WORKING DAYS PRIOR TO THE START OF WORK.
 - THE CONTRACTOR SHALL NOTIFY "MISS UTILITY" AT 1-800-257-7777 AT LEAST 48 HOURS PRIOR TO ANY EXCAVATION WORK BEING DONE.
 - TRAFFIC CONTROL DEVICES:
 - THE TRAFFIC CONTROL DEVICE LOCATIONS SHOWN ON THE PLANS ARE APPROXIMATE AND MUST BE FIELD APPROVED BY HOWARD COUNTY TRAFFIC DIVISION (410-313-2430) PRIOR TO THE INSTALLATION OF ANY OF THE TRAFFIC CONTROL DEVICES.
 - ALL TRAFFIC CONTROL DEVICES AND THEIR LOCATIONS SHALL BE IN ACCORDANCE WITH THE LATEST EDITION OF THE "MARYLAND MANUAL ON UNIFORM TRAFFIC CONTROL DEVICES" (MUMUTCD).
 - ALL SIGN POSTS USED FOR TRAFFIC CONTROL SIGNS INSTALLED IN THE COUNTY RIGHT-OF-WAY SHALL BE MOUNTED ON A 2" GALVANIZED STEEL PERFORATED ("QUICK PUNCH") SQUARE TUBE POST (14 GAUGE) INSERTED INTO A 2-1/2" GALVANIZED STEEL PERFORATED SQUARE TUBE SLEEVE (12 GAUGE) - 3' LONG. THE ANCHOR SHALL NOT EXTEND MORE THAN TWO "QUICK PUNCH" HOLES ABOVE LEVEL. A GALVANIZED STEEL POLE CAP SHALL BE MOUNTED ON TOP OF EACH POST.
 - COORDINATES ARE BASED ON NAD 83 MARYLAND COORDINATES SYSTEM AS PROJECTED BY HOWARD COUNTY GEODETIC CONTROL STATIONS.

291F N 571,309.766 E 1,345,093.245 ELEV. 444.451
291A N 568,985.057 E 1,345,640.177 ELEV. 482.195
 - BACKGROUND INFORMATION:
 - SUBDIVISION NAME: OLD CEDAR LANE SPECIAL ED CENTER
 - TAX MAP NO.: 29
 - PARCEL NOS.: 69
 - ZONING: NT PER 10/6/13 COMPREHENSIVE ZONING PLAN.
 - ELECTION DISTRICT: FIFTH
 - TOTAL TRACT AREA: 1,336,026 SF (30.67 AC.)
 - AREA OF STEEP SLOPES 25% AND GREATER = 0 AC.
 - NO. OF BUILDABLE PARCELS: 1
 - AREA OF BUILDABLE PARCELS: 30.67 AC.
 - TOTAL AREA OF ROADWAY TO BE DEDICATED: 0 AC.
 - AREA OF FLOODPLAIN: 0 AC.
 - PREVIOUS FILE NOS.: SDP-72-076, SDP-79-125, ECP-23-041
 - ALL FILL AREAS WITHIN ROADWAYS AND UNDER STRUCTURES SHALL BE COMPACTED TO A MINIMUM OF 95% COMPACTION OF AASHTO T-180.
 - SOILS INFORMATION TAKEN FROM NRCS WEB SOIL SURVEY.
 - THERE ARE NO WETLAND AREAS ON THIS PROJECT.
 - THERE ARE NO STEEP SLOPES OF 25% OR GREATER ON THIS SITE.
 - THERE IS NO FLOODPLAIN ON SITE.
 - PER SECTION 16.1202(B)(1)(ii), PROPERTY OWNED BY HCPSS AND IS EXEMPT FROM THE REQUIREMENTS OF SECTION 16.1200 OF THE HOWARD COUNTY CODE FOR FOREST CONSERVATION BECAUSE THE SITE IS PART OF A PLANNED UNIT DEVELOPMENT, NEW TOWN COLUMBIA.
 - THE PROJECT IS IN CONFORMANCE WITH THE LATEST HOWARD COUNTY STANDARDS.
 - THE EXISTING TOPOGRAPHY INFORMATION SHOWN IS FROM A FIELD RUN SURVEY BY FISHER COLLINS AND CARTER INC. DATED JANUARY 2023 AND OFFSITE TOPOGRAPHY IS FROM HOWARD COUNTY GIS DATA.
 - BOUNDARY INFORMATION IS BASED ON A SURVEY PERFORMED BY FISHER, COLLINS & CARTER, INC. DATED AUGUST 2018.
 - THIS PROPERTY IS LOCATED WITHIN THE METROPOLITAN DISTRICT.
 - STORM WATER MANAGEMENT WILL BE PROVIDED WITH TWELVE DRYWELLS ALONG WITH TWO NON-ROOFTOP DISCONNECT AREAS TO MEET AND EXCEED THE REQUIRED E50 VOLUME IN ACCORDANCE WITH THE M.D.E. STORM WATER DESIGN MANUAL, VOLUMES I & II, REVISED 2009.
 - A NOISE STUDY IS NOT REQUIRED FOR THIS PROJECT.
 - ALL PROPOSED UTILITY CONSTRUCTION SHALL BE IN ACCORDANCE WITH COUNTY STANDARDS AND SPECIFICATIONS.
 - ANY DAMAGE TO COUNTY AND OR STATE OWNED RIGHT-OF-WAY TO BE CORRECTED AT THE CONTRACTOR'S EXPENSE.
 - GUTTER PAN OF CURBS SHALL BE PITCHED TO CONFORM TO THE ADJACENT DRAINAGE PATTERNS OF THE ADJOINING PAVING FOR VEHICULAR USE.
 - ALL PROPOSED RAMPS SHALL BE IN ACCORDANCE WITH CURRENT A.D.A. STANDARDS ACCESSIBILITY GUIDELINES. MAXIMUM SIDEWALK CROSS SLOPE SHALL BE TWO PERCENT. PROVIDE A (5'X5') FIVE FOOT BY FIVE FOOT LEVEL LANDING (MAX. SLOPE 2%) AT THE TOP AND BOTTOM OF ALL RAMPS AND BUILDING ENTRANCES AND EXITS. HANDRAILS SHALL BE PROVIDED ON ALL RAMPS IN ACCORDANCE WITH SECTION 505 OF THE A.D.A. STANDARDS ACCESSIBILITY GUIDELINES.
 - ALL PLAN DIMENSIONS ARE TO THE FACE OF CURB OR FACE OF BUILDING UNLESS OTHERWISE NOTED. DIMENSIONS ARE MEASURED PERPENDICULAR OR RADIAL BETWEEN ITEMS UNLESS OTHERWISE NOTED.
 - ON-SITE WATER IS PRIVATE. SEWER IS PRIVATE. PUBLIC WATER CONTRACT (44-1324-D) AND PUBLIC SEWER CONTRACT (364 W&S) SERVE THE SITE.
 - EXISTING UTILITIES ARE BASED ON FIELD LOCATION BY FISHER, COLLINS & CARTER, INC. ON JANUARY 2023 AND SUPPLEMENTED WITH COUNTY AVAILABLE INFORMATION.
 - THERE IS NO HISTORIC STRUCTURES LOCATED ON THIS SITE.
 - THE SITE PLAN IS LIMITED TO THE MODULAR UNIT. THE FINAL DEVELOPMENT PLAN DOES NOT REQUIRE AMENDMENT FOR A MOVABLE FACILITY.
 - MINIMUM BUILDING SETBACK RESTRICTIONS FROM PROPERTY LINES AND THE PUBLIC RIGHT-OF-WAY LINES TO BE IN ACCORDANCE WITH FDP-123-A CRITERIA
 - REVIEW OF THIS PROJECT FOR COMPLIANCE WITH THE HOWARD COUNTY SUBDIVISION AND LAND DEVELOPMENT REGULATIONS AND THE HOWARD COUNTY ZONING REGULATIONS SHALL OCCUR AT THE SITE PLAN STAGES. THEREFORE, THE APPLICANT AND CONSULTANT SHOULD EXPECT ADDITIONAL AND MORE DETAILED COMMENTS (INCLUDING THOSE THAT MAY ALTER OVERALL SITE DESIGN) AS THIS PROJECT PROGRESSES.
 - NO GRADING, REMOVAL OF VEGETATIVE COVER OR TREES, PAVING AND NEW STRUCTURES SHALL BE PERMITTED WITHIN THE LIMITS OF WETLANDS, STREAMS, OR THEIR REQUIRED BUFFER, FLOODPLAIN AND FOREST CONSERVATION EASEMENT AREAS.
 - PER HOWARD COUNTY PUBLIC SCHOOL SYSTEMS PARKING REQUIREMENTS - 200 PARKING SPACES FOR STAFF AND VOLUNTEERS, 42 SPACES FOR VISITORS TOTALING 242 SPACES.

STORMWATER MANAGEMENT SUMMARY										
AREA ID OR LOCATION	FACILITY NAME & NUMBER	PUBLIC	PRIVATE	HOA MAINTAINED	OWNER MAINTAINED	DRAINAGE AREA (SF)	IMPERVIOUS AREA (SF)	ESDy PROVIDED (CF)	SURFACE AREA (SF)	ESDy PROVIDED
5451 BEAVERKILL RD	DW-1.6,7,12	N	Y	N	Y	692*	692*	994	1,140	ESDy REQUIRED = 1,911 CF
5451 BEAVERKILL RD	DW-2-5, 8-11	N	Y	N	Y	983*	983*	1,620	1,140	ESDy PROVIDED = 2,222 CF (DRYWELLS) RECHARGE
5451 BEAVERKILL RD	DNR# 1	N	Y	N	Y	1,190	1,190	94	N/A	ESDy TOTAL = 2,364 CF
5451 BEAVERKILL RD	DNR# 2	N	Y	N	Y	600	600	48	N/A	Pe REQUIRED = 1.50'
										Pe PROVIDED = 1.83'

* PER DRYWELL


STORMWATER MANAGEMENT INFORMATION AND PRACTICES							
AREA ID OR LOCATION	PERMEABLE PAVING (A-2)	DISCONNECT OR ROOFTOP RUNOFF (N-1)	DISCONNECT OR NON-ROOFTOP RUNOFF (N-2)	FILTERBAY INLETS (M-3)	MICRO BIO-RETENTION (M-6)	BIO-RETENTION (M-6)	DRYWELL (M-5)
PORT CLASSROOM & EMERGENCY ACCESS	N	N	Y (2)	N	N	N	Y (12)

FISHER, COLLINS & CARTER, INC.
CIVIL ENGINEERING CONSULTANTS & LAND SURVEYORS
CENTENNIAL SQUARE OFFICE PARK - 10772 BALTIMORE NATIONAL PIKE
ELICOTT CITY, MARYLAND 21042
(410) 461-3995

"PROFESSIONAL CERTIFICATION. I HEREBY CERTIFY THESE DOCUMENTS WERE PREPARED OR APPROVED BY ME, AND THAT I AM A DULY LICENSED PROFESSIONAL ENGINEER UNDER THE LAWS OF THE STATE OF MARYLAND, LICENSE NO. 27020, EXPIRATION DATE: 01/25/26."
Paul G. Cavannaugh
PAUL GEORGE CAVANNAUGH
DATE: Jan 18, 2024

DATE	DESCRIPTION	REVISION BLOCK
APPROVED: DEPARTMENT OF PLANNING AND ZONING		
<i>Maura Kinnell</i>	Director - Department of Planning and Zoning	2/6/24 Date
<i>[Signature]</i>	Chief, Division of Land Development	2/5/24 Date
<i>[Signature]</i>	Chief, Development Engineering Division	2/6/24 Date

OWNER/DEVELOPER
PREPARED FOR
HOWARD COUNTY PUBLIC SCHOOL SYSTEM
9020 MENDENHALL COURT
SUITE 'C'
COLUMBIA, MARYLAND 21045
Attention: DANIEL LUBELEY
410-313-8203

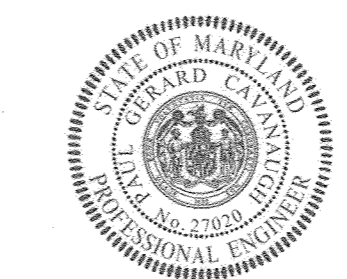



ADDRESS CHART			
PARCEL NO.	STREET ADDRESS		
69	OLD CEDAR LANE SPECIAL ED CENTER COLUMBIA, MARYLAND 21044		
PROJECT	SECTION/AREA	PARCEL	
OLD CEDAR LANE SPECIAL ED CENTER	6/2	69	
PLAT NOS.	BLOCK NO.	ZONE	TAX MAP
-	17,23	NT	29
		ELEC. DIST.	CENSUS TR.
		FIFTH	605502

NOTES AND LOCATION SHEET

**OLD CEDAR LANE SPECIAL
EDUCATION CENTER**

VILLAGE OF HARPER'S CHOICE
SECTION 6 AREA 2

ZONED: NEW TOWN
TAX MAP No.: 29 GRID No.: 17, 23 PARCEL No.: 69
FIFTH ELECTION DISTRICT HOWARD COUNTY, MARYLAND
SCALE: AS SHOWN DATE: JANUARY, 2024
SHEET 14 OF 21

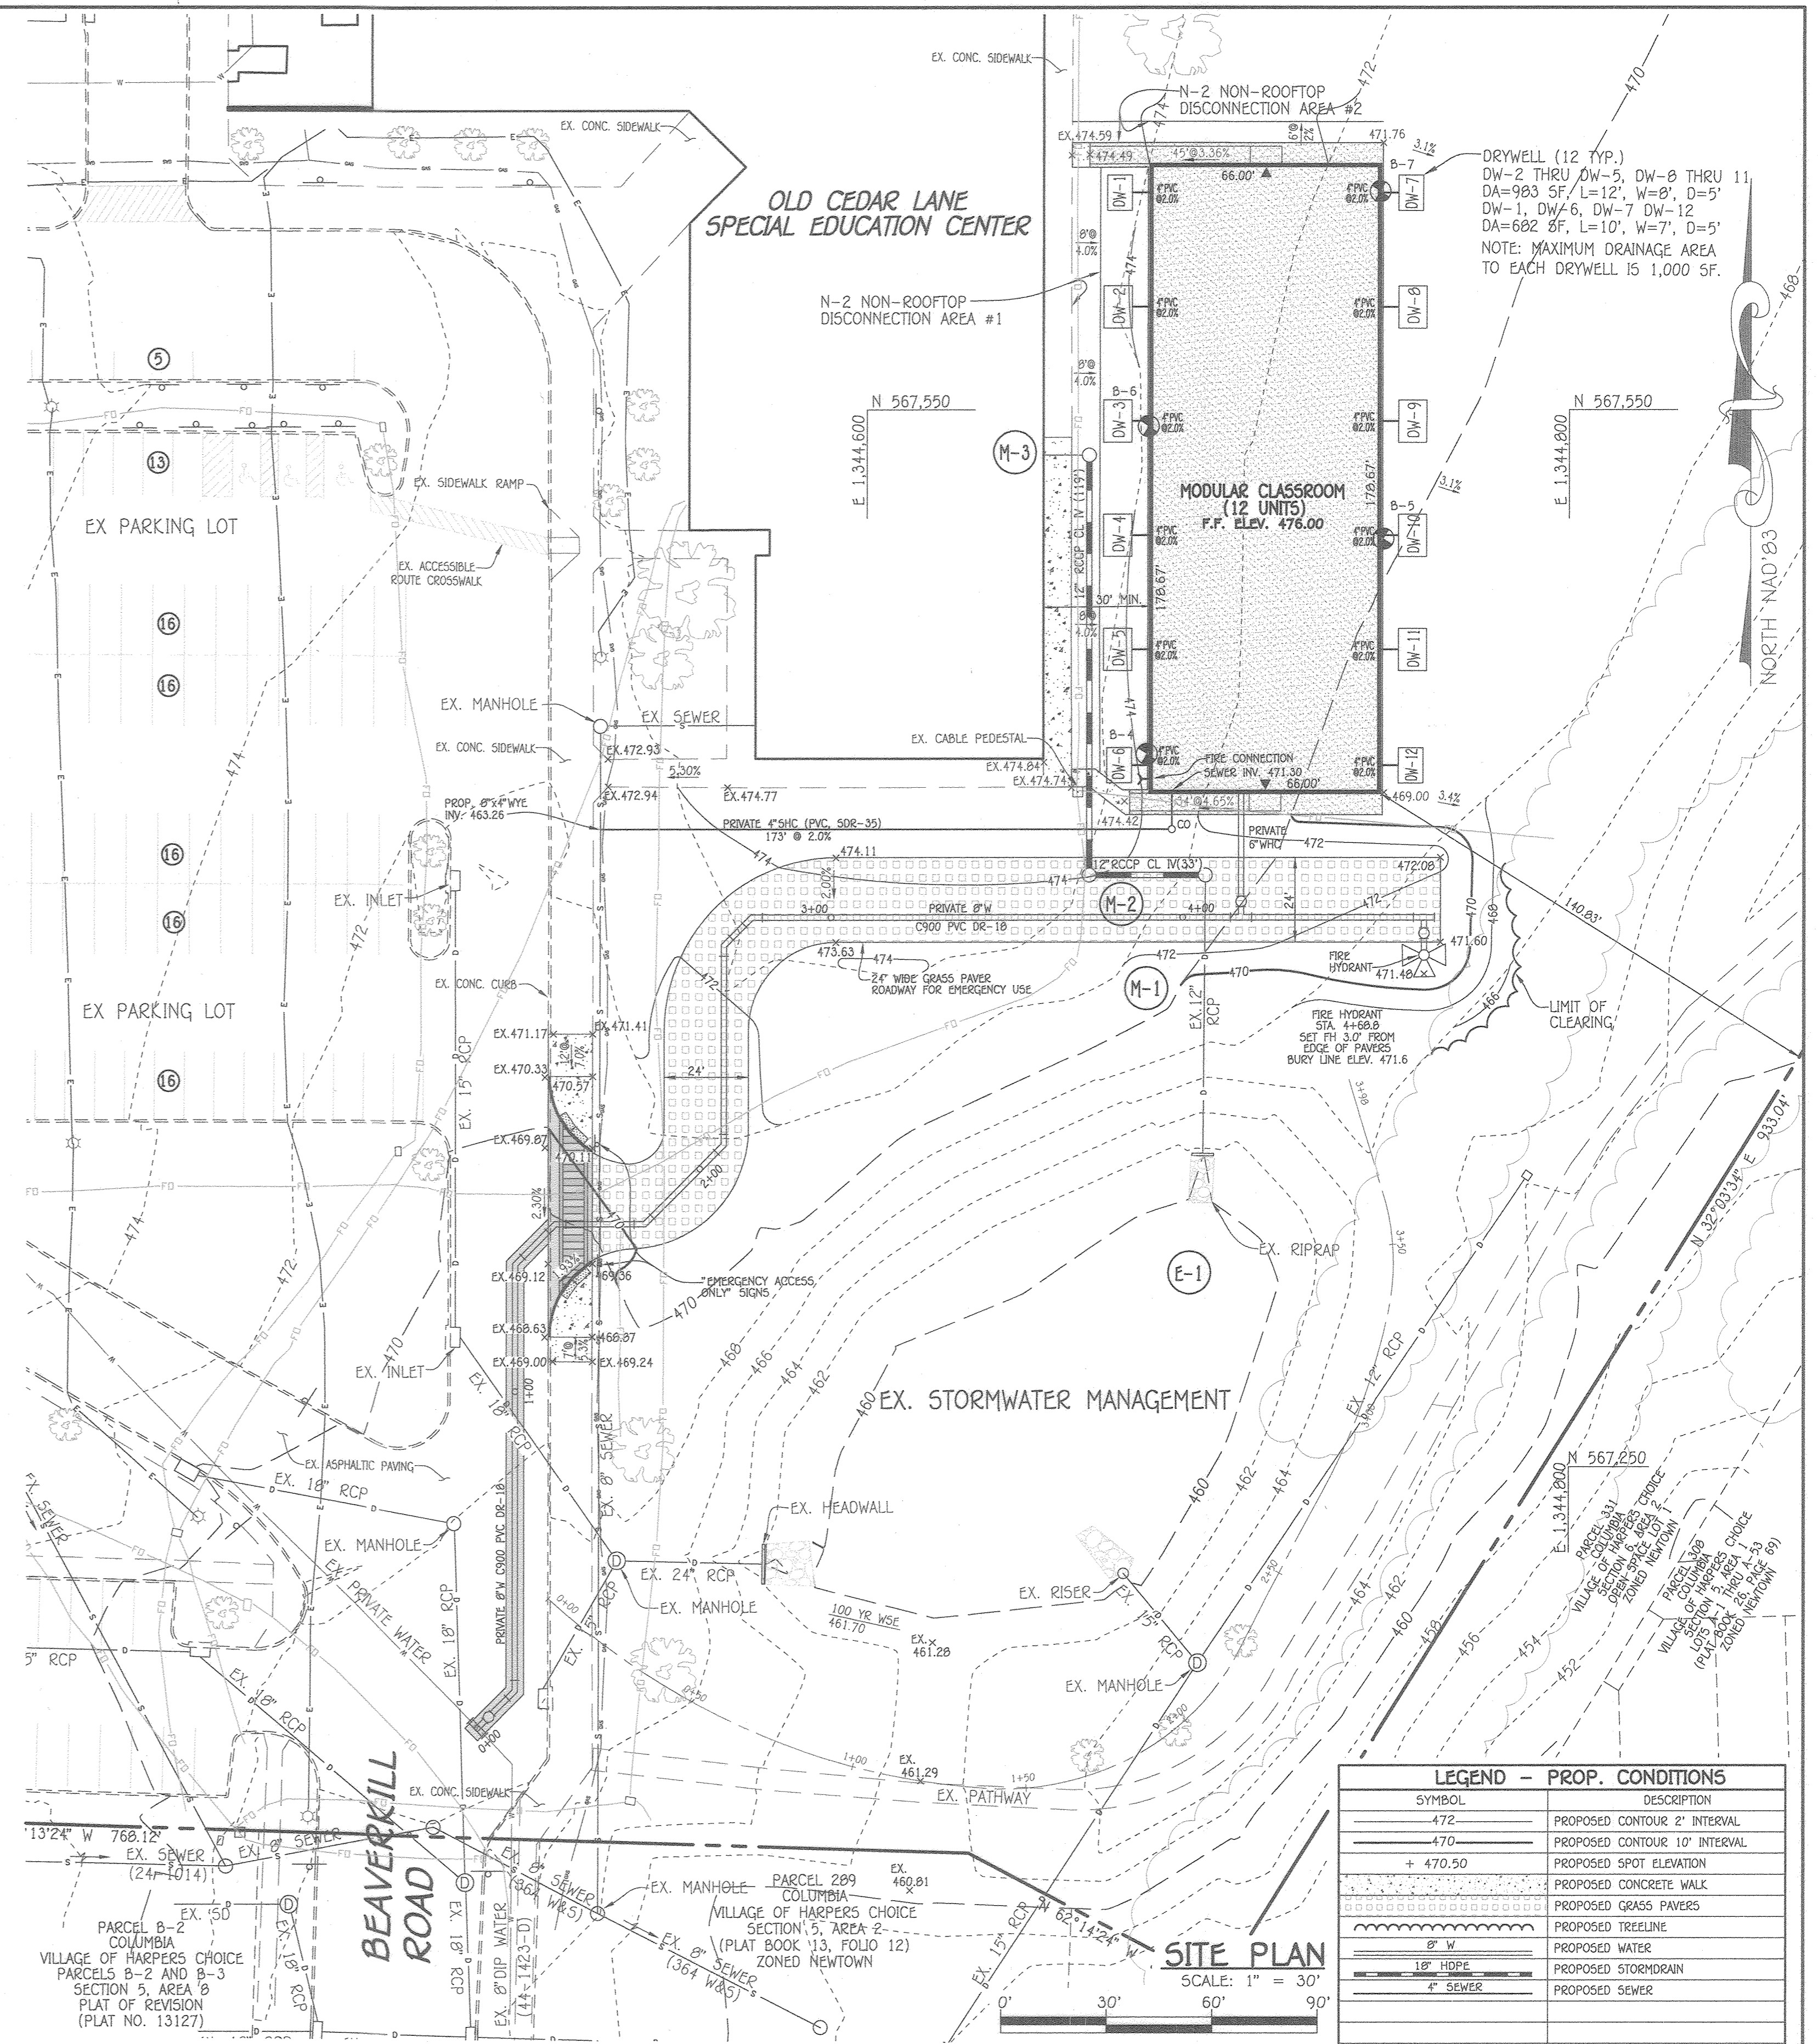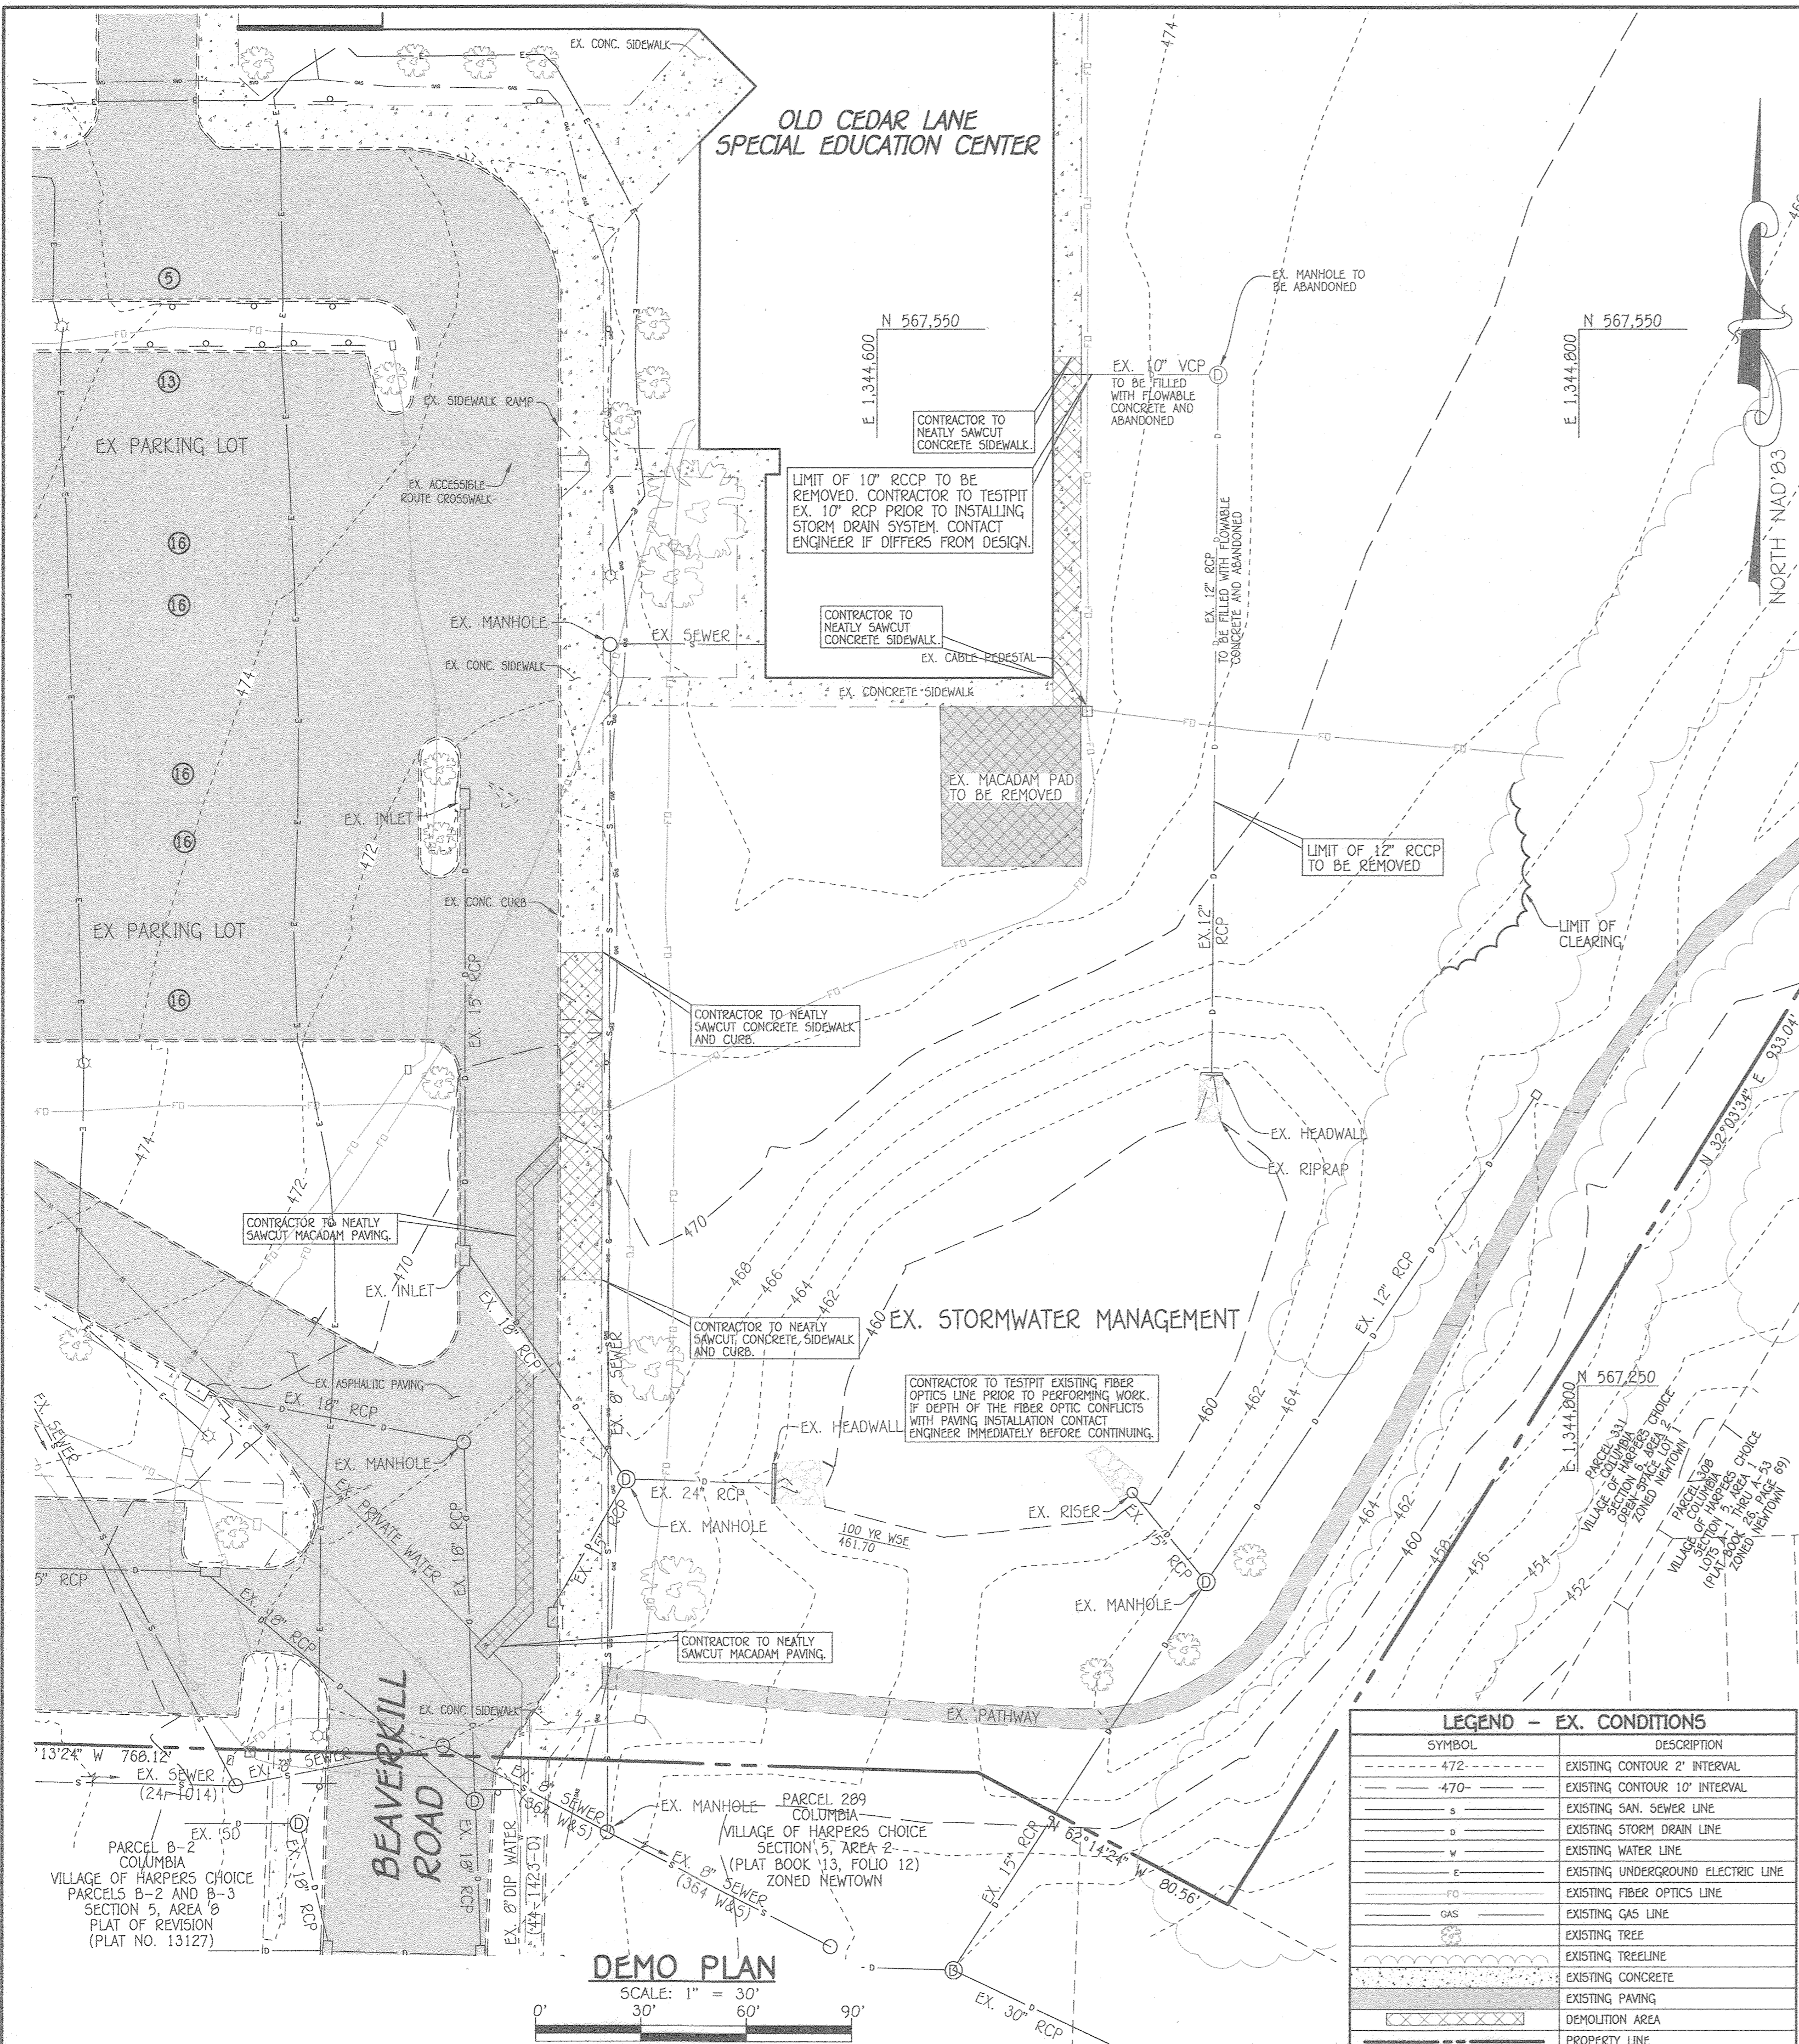

LEGEND - EX. CONDITIONS

SYMBOL	DESCRIPTION
472	EXISTING CONTOUR 2' INTERVAL
470	EXISTING CONTOUR 10' INTERVAL
—	EXISTING SAN SEWER LINE
—	EXISTING STORM DRAIN LINE
—	EXISTING WATER LINE
—	EXISTING UNDERGROUND ELECTRIC LINE
—	EXISTING FIBER OPTICS LINE
—	EXISTING GAS LINE
—	EXISTING TREE
—	EXISTING TREELINE
—	EXISTING CONCRETE
—	EXISTING PAVING
—	DEMOLITION AREA
—	PROPERTY LINE

LEGEND - PROP. CONDITIONS

SYMBOL	DESCRIPTION
472	PROPOSED CONTOUR 2' INTERVAL
470	PROPOSED CONTOUR 10' INTERVAL
+ 470.50	PROPOSED SPOT ELEVATION
—	PROPOSED CONCRETE WALK
—	PROPOSED GRASS PAVERS
—	PROPOSED TREELINE
—	PROPOSED WATER
—	PROPOSED STORMDRAIN
—	PROPOSED SEWER

FISHER, COLLINS & CARTER, INC.
 CIVIL ENGINEERING CONSULTANTS & LAND SURVEYORS
 CENTENNIAL SQUARE OFFICE PARK - 10275 BALTIMORE NATIONAL PIKE
 ELICOTT CITY, MARYLAND 21042
 (410) 461-2895

"PROFESSIONAL CERTIFICATION. I HEREBY CERTIFY THESE DOCUMENTS WERE PREPARED OR APPROVED BY ME, AND THAT I AM A DULY LICENSED PROFESSIONAL ENGINEER UNDER THE LAWS OF THE STATE OF MARYLAND, LICENSE NO. 27020, EXPIRATION DATE: 01/25/26."

Paul Gerard Cavanaugh
 PAUL GERARD CAVANAUGH
 DATE: *Jan 18, 2024*

DATE	DESCRIPTION
	REVISION BLOCK
	APPROVED: DEPARTMENT OF PLANNING AND ZONING
<i>Maura Knorr</i>	Director, Department of Planning and Zoning
<i>2/16/24</i>	Date
<i>1/15/24</i>	Date
<i>2/11/24</i>	Date

OWNER/DEVELOPER
 PREPARED FOR:
 HOWARD COUNTY PUBLIC SCHOOL SYSTEM
 9020 MENDENHALL COURT
 SUITE 'C'
 COLUMBIA, MARYLAND 21045
 Attention: DANIEL LUBELEY
 410-313-8203

ADDRESS CHART

PARCEL NO.	STREET ADDRESS
69	OLD CEDAR LANE SPECIAL ED CENTER COLUMBIA, MARYLAND 21044

PROJECT	SECTION/AREA	PARCEL
OLD CEDAR LANE SPECIAL ED CENTER	6/2	69



PLAT NOS.	BLOCK NO.	ZONE	TAX MAP	ELEC. DIST.	CENSUS TR.
-	17,23	NT	29	FIFTH	605502

DEMOLITION PLAN AND SITE PLAN
OLD CEDAR LANE SPECIAL EDUCATION CENTER
 VILLAGE OF HARPER'S CHOICE
 SECTION 6 AREA 2

ZONED: NEW TOWN
 TAX MAP No.: 29 GRID No.: 17, 23 PARCEL No.: 69
 FIFTH ELECTION DISTRICT HOWARD COUNTY, MARYLAND
 SCALE: AS SHOWN DATE: JANUARY, 2024
 SHEET 15 OF 21

SOIL	NAME	GROUP
GhB	Glenns-urban land complex, 0 to 8 percent slopes, K VALUE = 0.43	B
UuB	Urban land-Udothents complex, 0 to 8 percent slopes	D

DRAINAGE AREA DATA				
STRUCTURE NO.	DRAINAGE AREA	AREA	'C' FACTOR	% IMP.
1-1	A	9,576 SF	0.83	95%
1-2	B	6,875 SF	0.80	90%
1-3	C	21,697 SF	0.67	70%

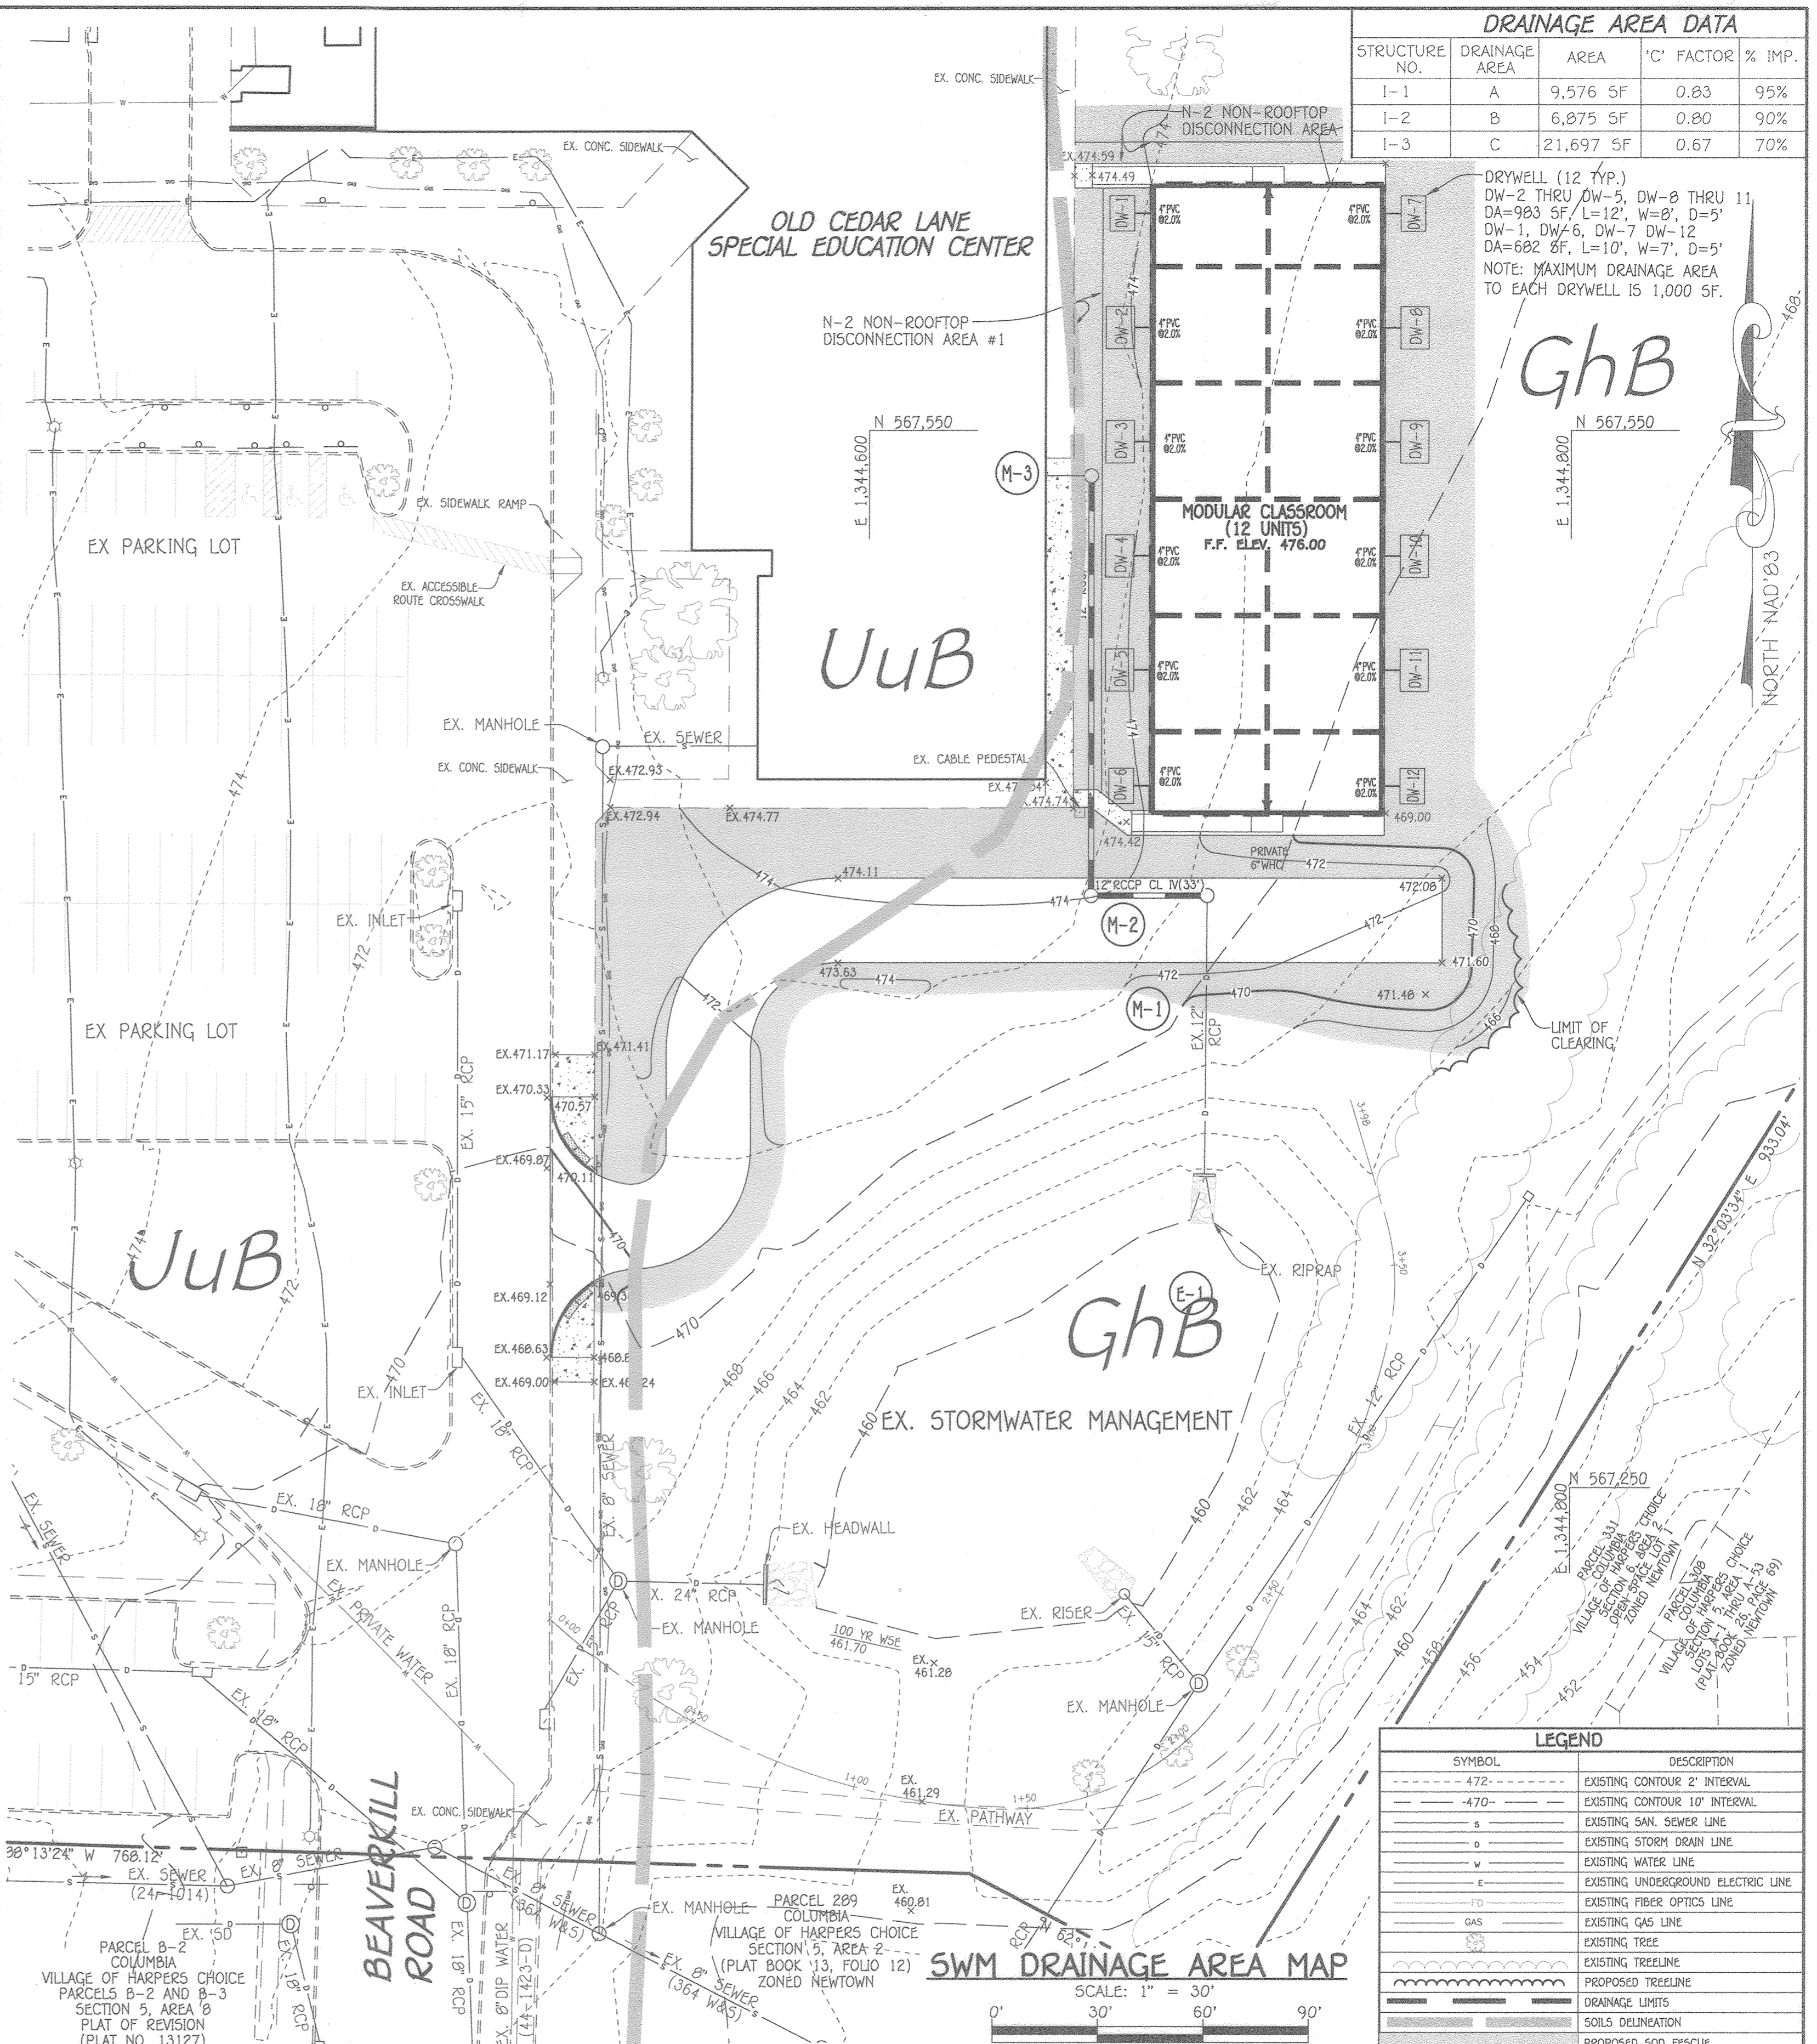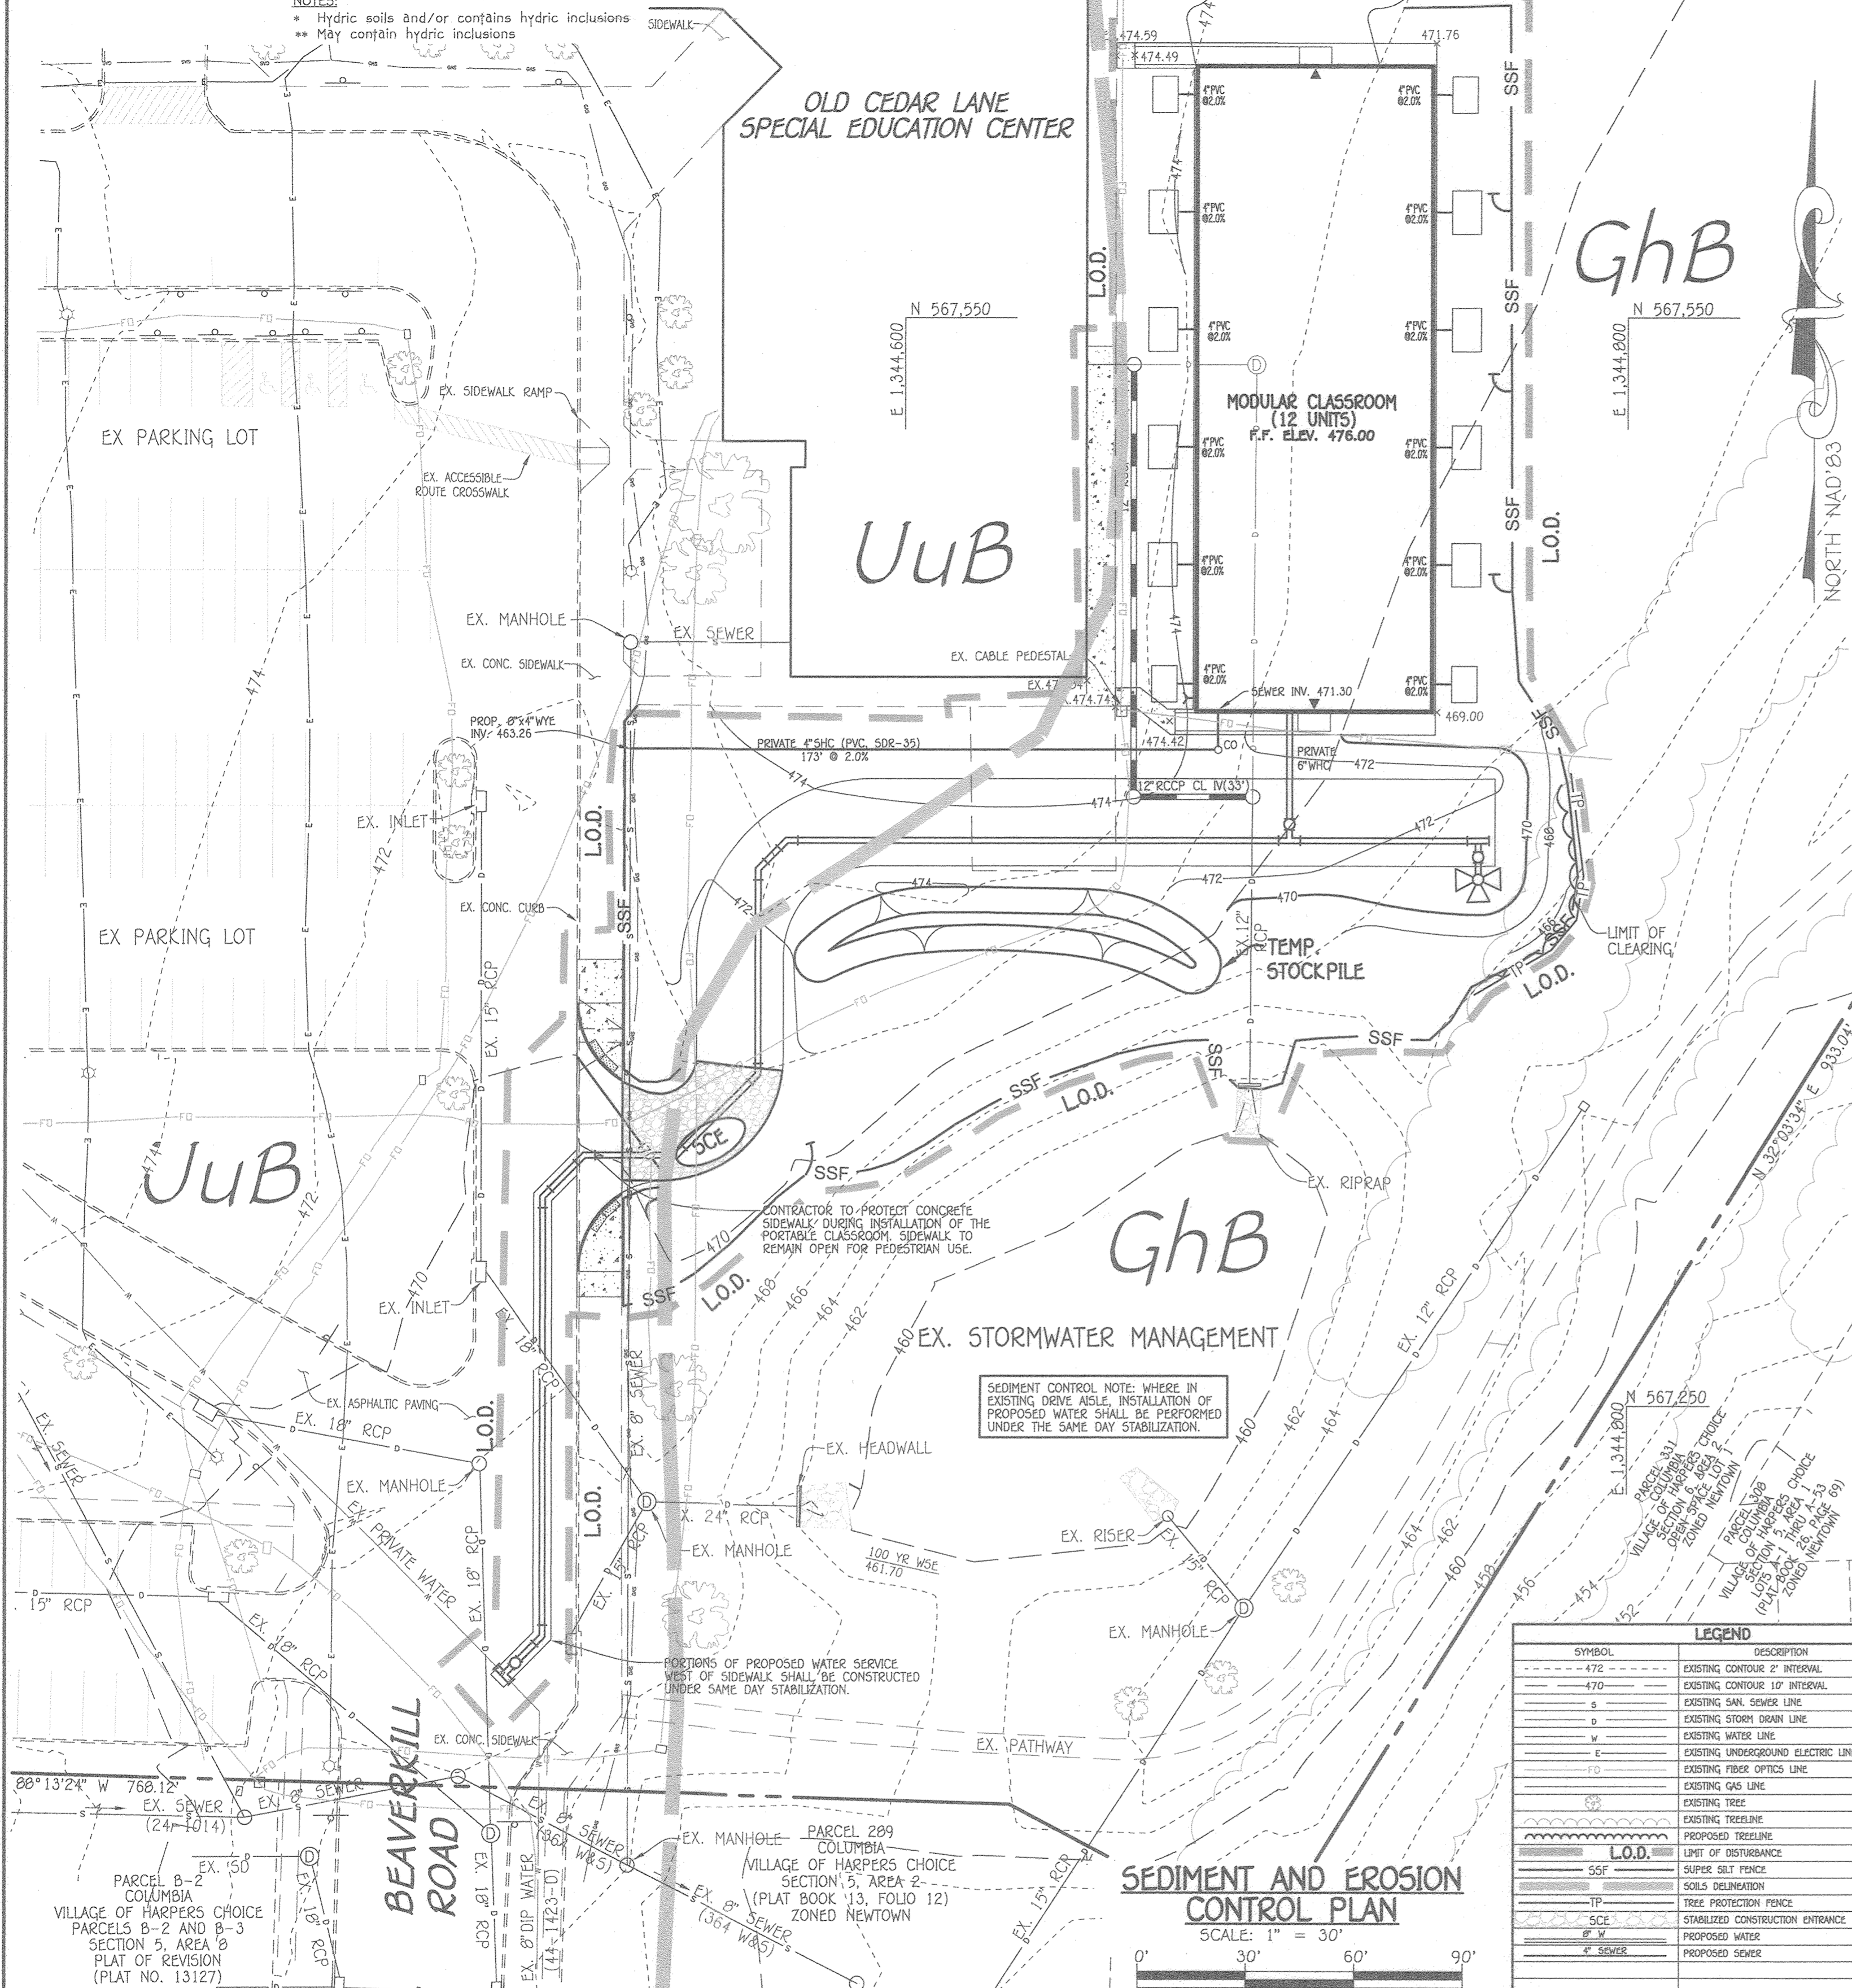

FISHER, COLLINS & CARTER, INC.
 CIVIL ENGINEERING CONSULTANTS & LAND SURVEYORS
 1100 BALTIMORE NATIONAL PIKE
 ELICOTT CITY, MARYLAND 21042
 (410) 461-2895

ENGINEER'S CERTIFICATE
 I HEREBY CERTIFY THAT THIS PLAN HAS BEEN DESIGNED IN ACCORDANCE WITH THE CURRENT MARYLAND EROSION AND SEDIMENT CONTROL LAWS, REGULATIONS, AND STANDARDS. I REPRESENTED THE PROJECT AND WORKABLE PLAN BASED ON MY PERSONAL KNOWLEDGE OF THE SITE, AND THAT I WAS PREPARED IN ACCORDANCE WITH THE REQUIREMENTS OF THE HOWARD SOIL CONSERVATION DISTRICT.
 Signature: *Paul G. Cavanaugh* DATE: *Jan 18, 2024*

DEVELOPER'S CERTIFICATE
 I/WE HEREBY CERTIFY THAT ANY CLEARING, GRADING, CONSTRUCTION, OR DEVELOPMENT WILL BE DONE PURSUANT TO THIS APPROVED EROSION AND SEDIMENT CONTROL PLAN, INCLUDING INSPECTING AND MAINTAINING CONTROLS, AND THAT THE RESPONSIBLE PERSONNEL INVOLVED IN THE CONSTRUCTION PROJECT WILL HAVE A CERTIFICATE OF TRAINING AT A MARYLAND DEPARTMENT OF THE ENVIRONMENT (TDES) APPROVED TRAINING PROGRAM FOR THE CONTROL ON EROSION AND SEDIMENT PRIOR TO BEGINNING THE PROJECT. I CERTIFY RIGHT OF ENTRY FOR PERIODIC ON-SITE EVALUATION BY HOWARD COUNTY, THE HOWARD SOIL CONSERVATION DISTRICT AND/OR MDOT.
 Signature: *Andrew P. Quib* DATE: *Jan 19, 2024*


PROFESSIONAL CERTIFICATION: I HEREBY CERTIFY THESE DOCUMENTS WERE PREPARED OR APPROVED BY ME, AND THAT I AM A DULY LICENSED PROFESSIONAL ENGINEER UNDER THE LAWS OF THE STATE OF MARYLAND, LICENSE NO. 27020, EXPIRATION DATE: 01/25/26.
 Signature: *Paul G. Cavanaugh* DATE: *Jan 18, 2024*

THESE PLANS FOR SMALL POND CONSTRUCTION, SOIL EROSION AND SEDIMENT CONTROL MEET THE REQUIREMENTS OF THE HOWARD SOIL CONSERVATION DISTRICT.
 Signature: *Alexander Bratich* DATE: *02/20/24*

OWNER/DEVELOPER
 PREPARED FOR:
 HOWARD COUNTY PUBLIC SCHOOL SYSTEM
 9020 MENDENHALL COURT
 SUITE 'C'
 COLUMBIA, MARYLAND 21045
 Attention: DANIEL LUBELEY
 410-313-8203

APPROVED: DEPARTMENT OF PLANNING AND ZONING
 Signature: *Mary A. Kendall Fox* DATE: *2/16/24*
 Director, Department of Planning and Zoning

Signature: *Chief, Division of Land Development* DATE: *2/15/24*
 Chief, Development Engineering Division

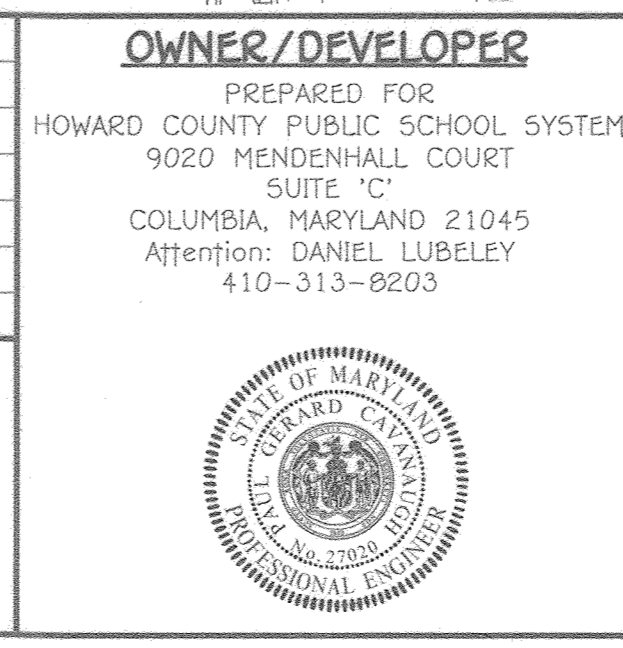

ADDRESS CHART		
PARCEL NO.	STREET ADDRESS	
69	OLD CEDAR LANE SPECIAL ED CENTER COLUMBIA, MARYLAND 21044	

PROJECT	SECTION/AREA	PARCEL
OLD CEDAR LANE SPECIAL ED CENTER	6/2	69


PLAT NOS.	BLOCK NO.	ZONE	TAX MAP	ELEC. DIST.	CENSUS TR.
-	17.23	NT	29	FIFTH	605502

SEDIMENT AND EROSION CONTROL PLAN AND DRAINAGE AREA MAP


OLD CEDAR LANE SPECIAL EDUCATION CENTER

VILLAGE OF HARPER'S CHOICE
 SECTION 5, AREA 2


ZONED: NEW TOWN
 TAX MAP No.: 29 GRID No.: 17, 23 PARCEL No.: 69
 FIFTH ELECTION DISTRICT HOWARD COUNTY, MARYLAND
 SCALE: AS SHOWN DATE: JANUARY, 2024
 SHEET 16 OF 21

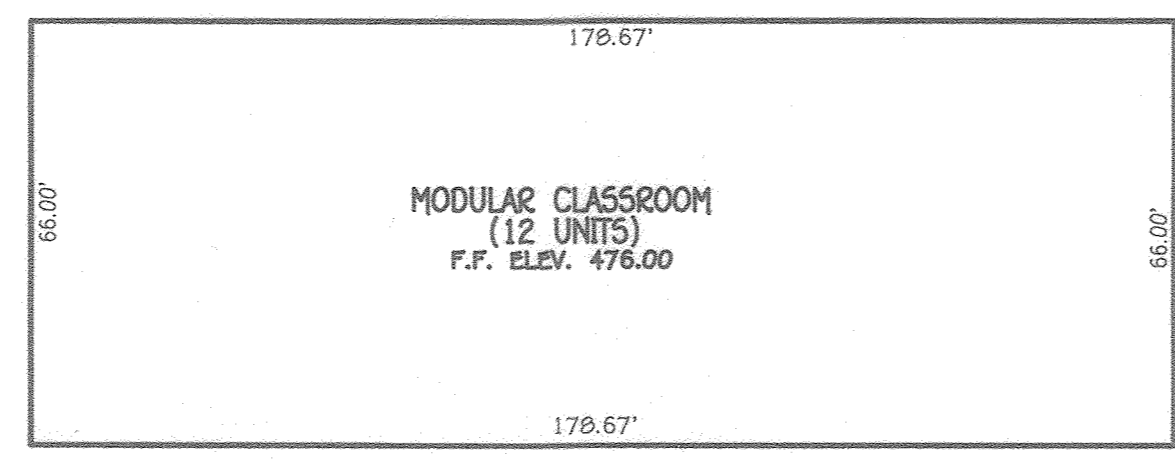


BUILDING OUTLINE
SCALE: 1" = 30'
0' 30' 60' 90'

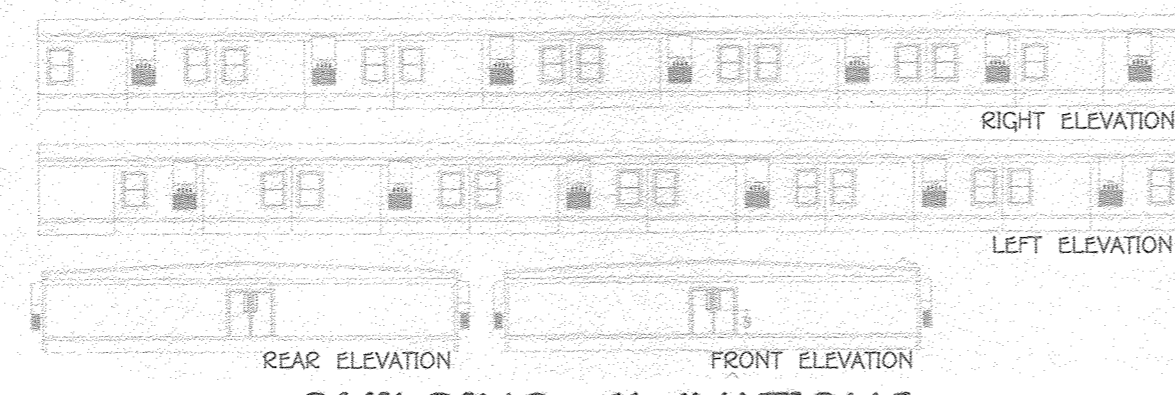

BUILDING ELEVATIONS
SCALE: 1" = 30'
0' 30' 60' 90'

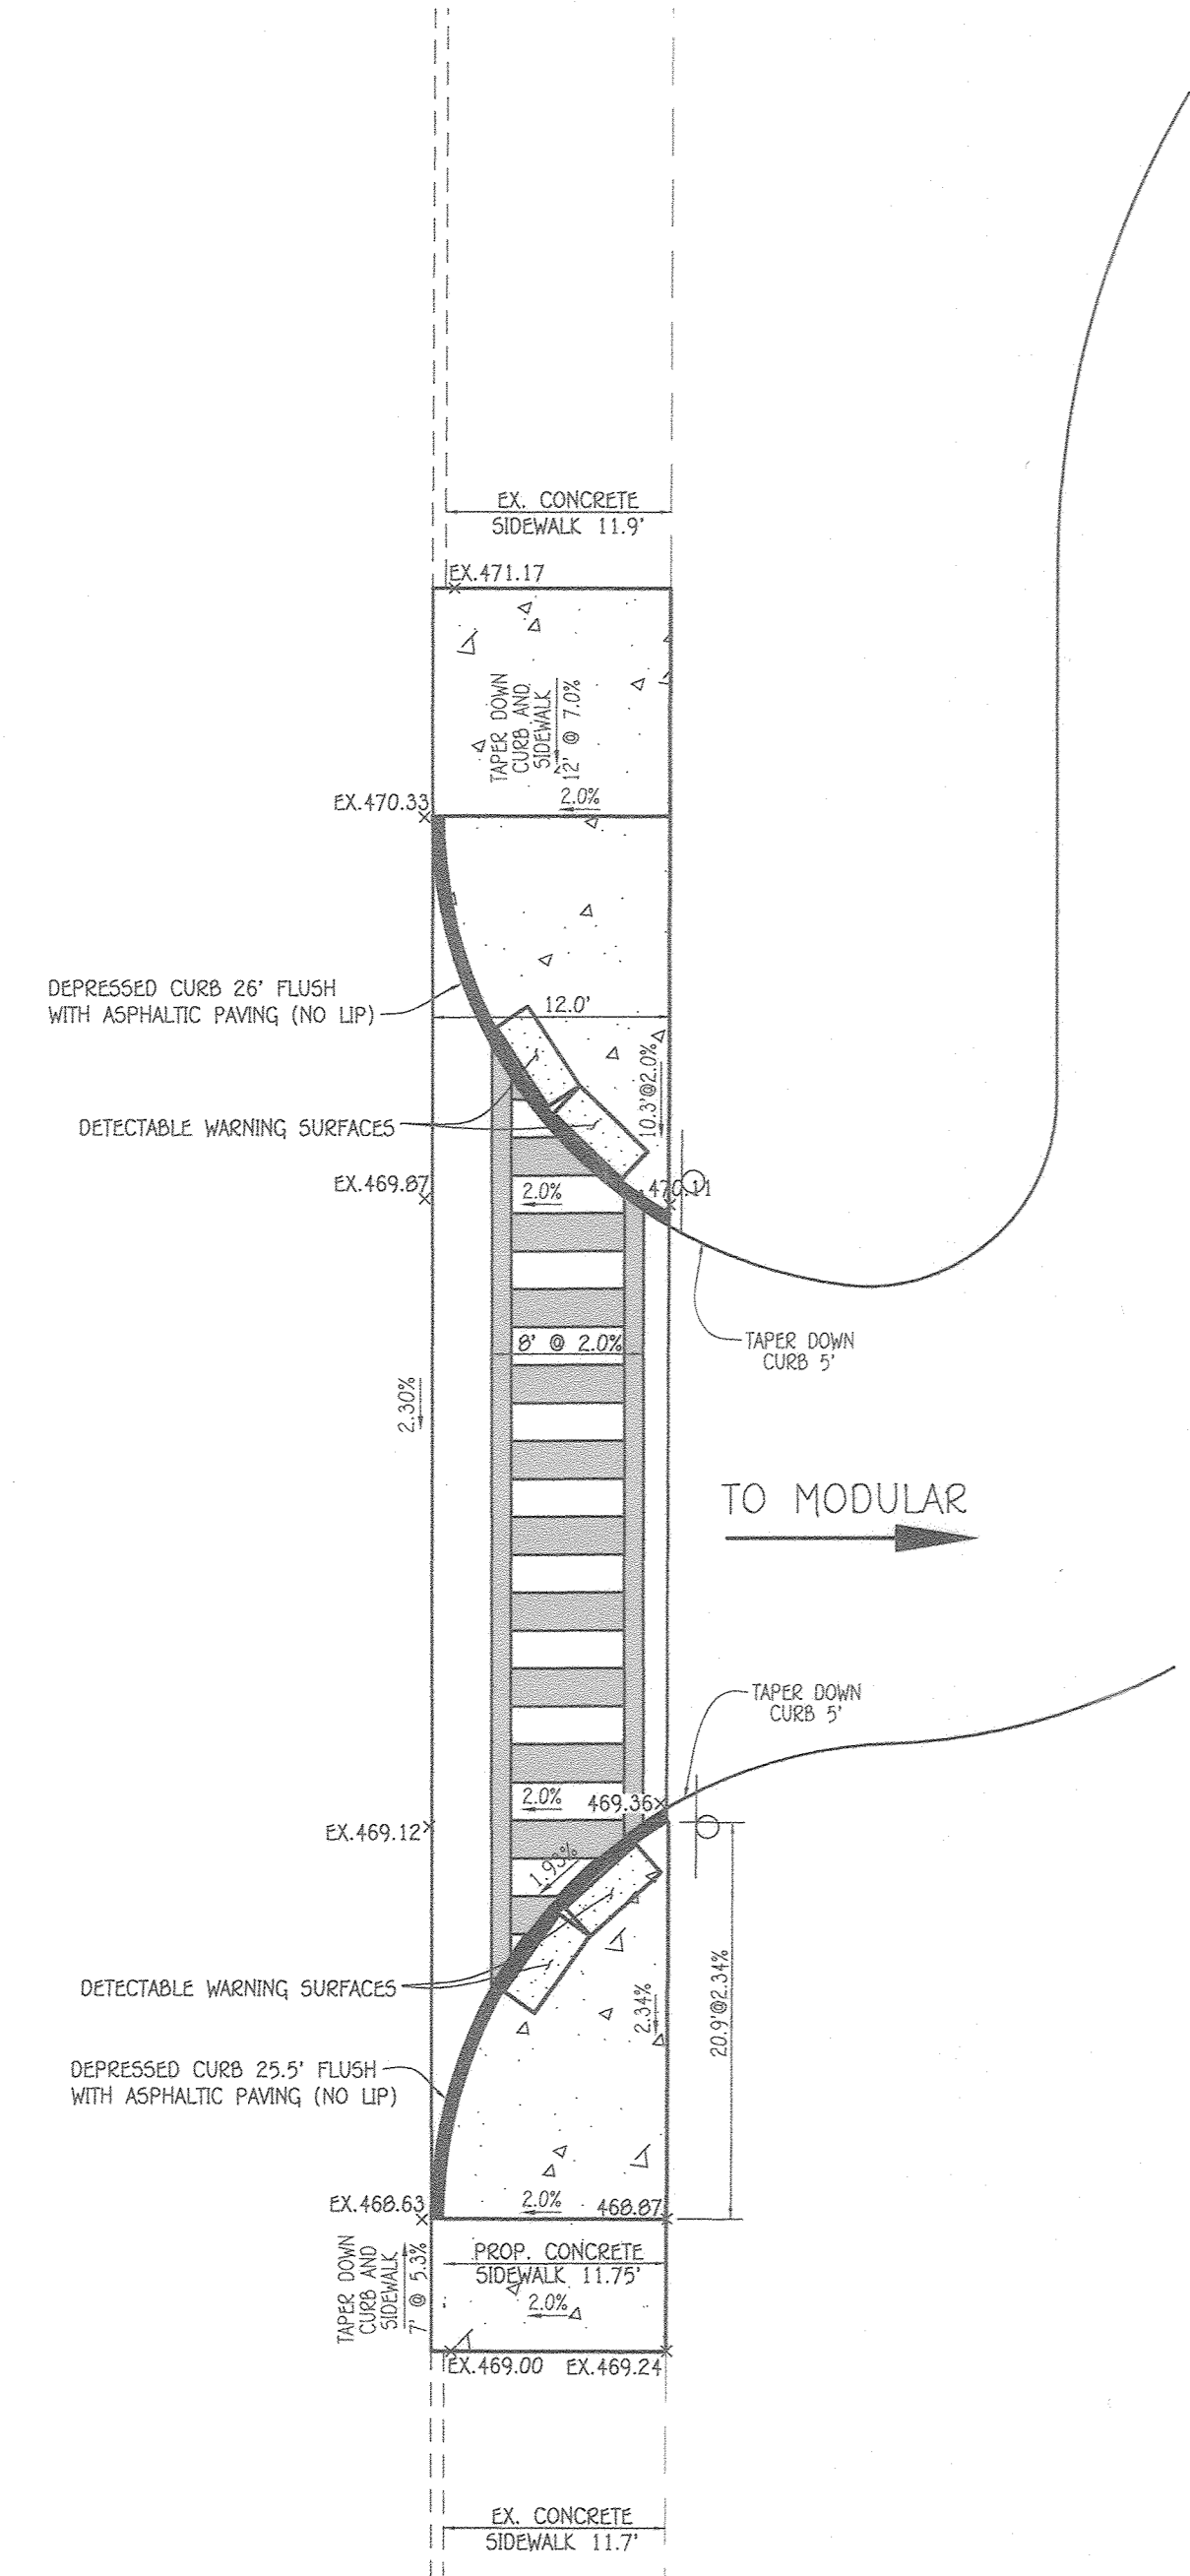

HC ACCESS PLAN
SCALE: 1" = 10'
0' 10' 20' 30'

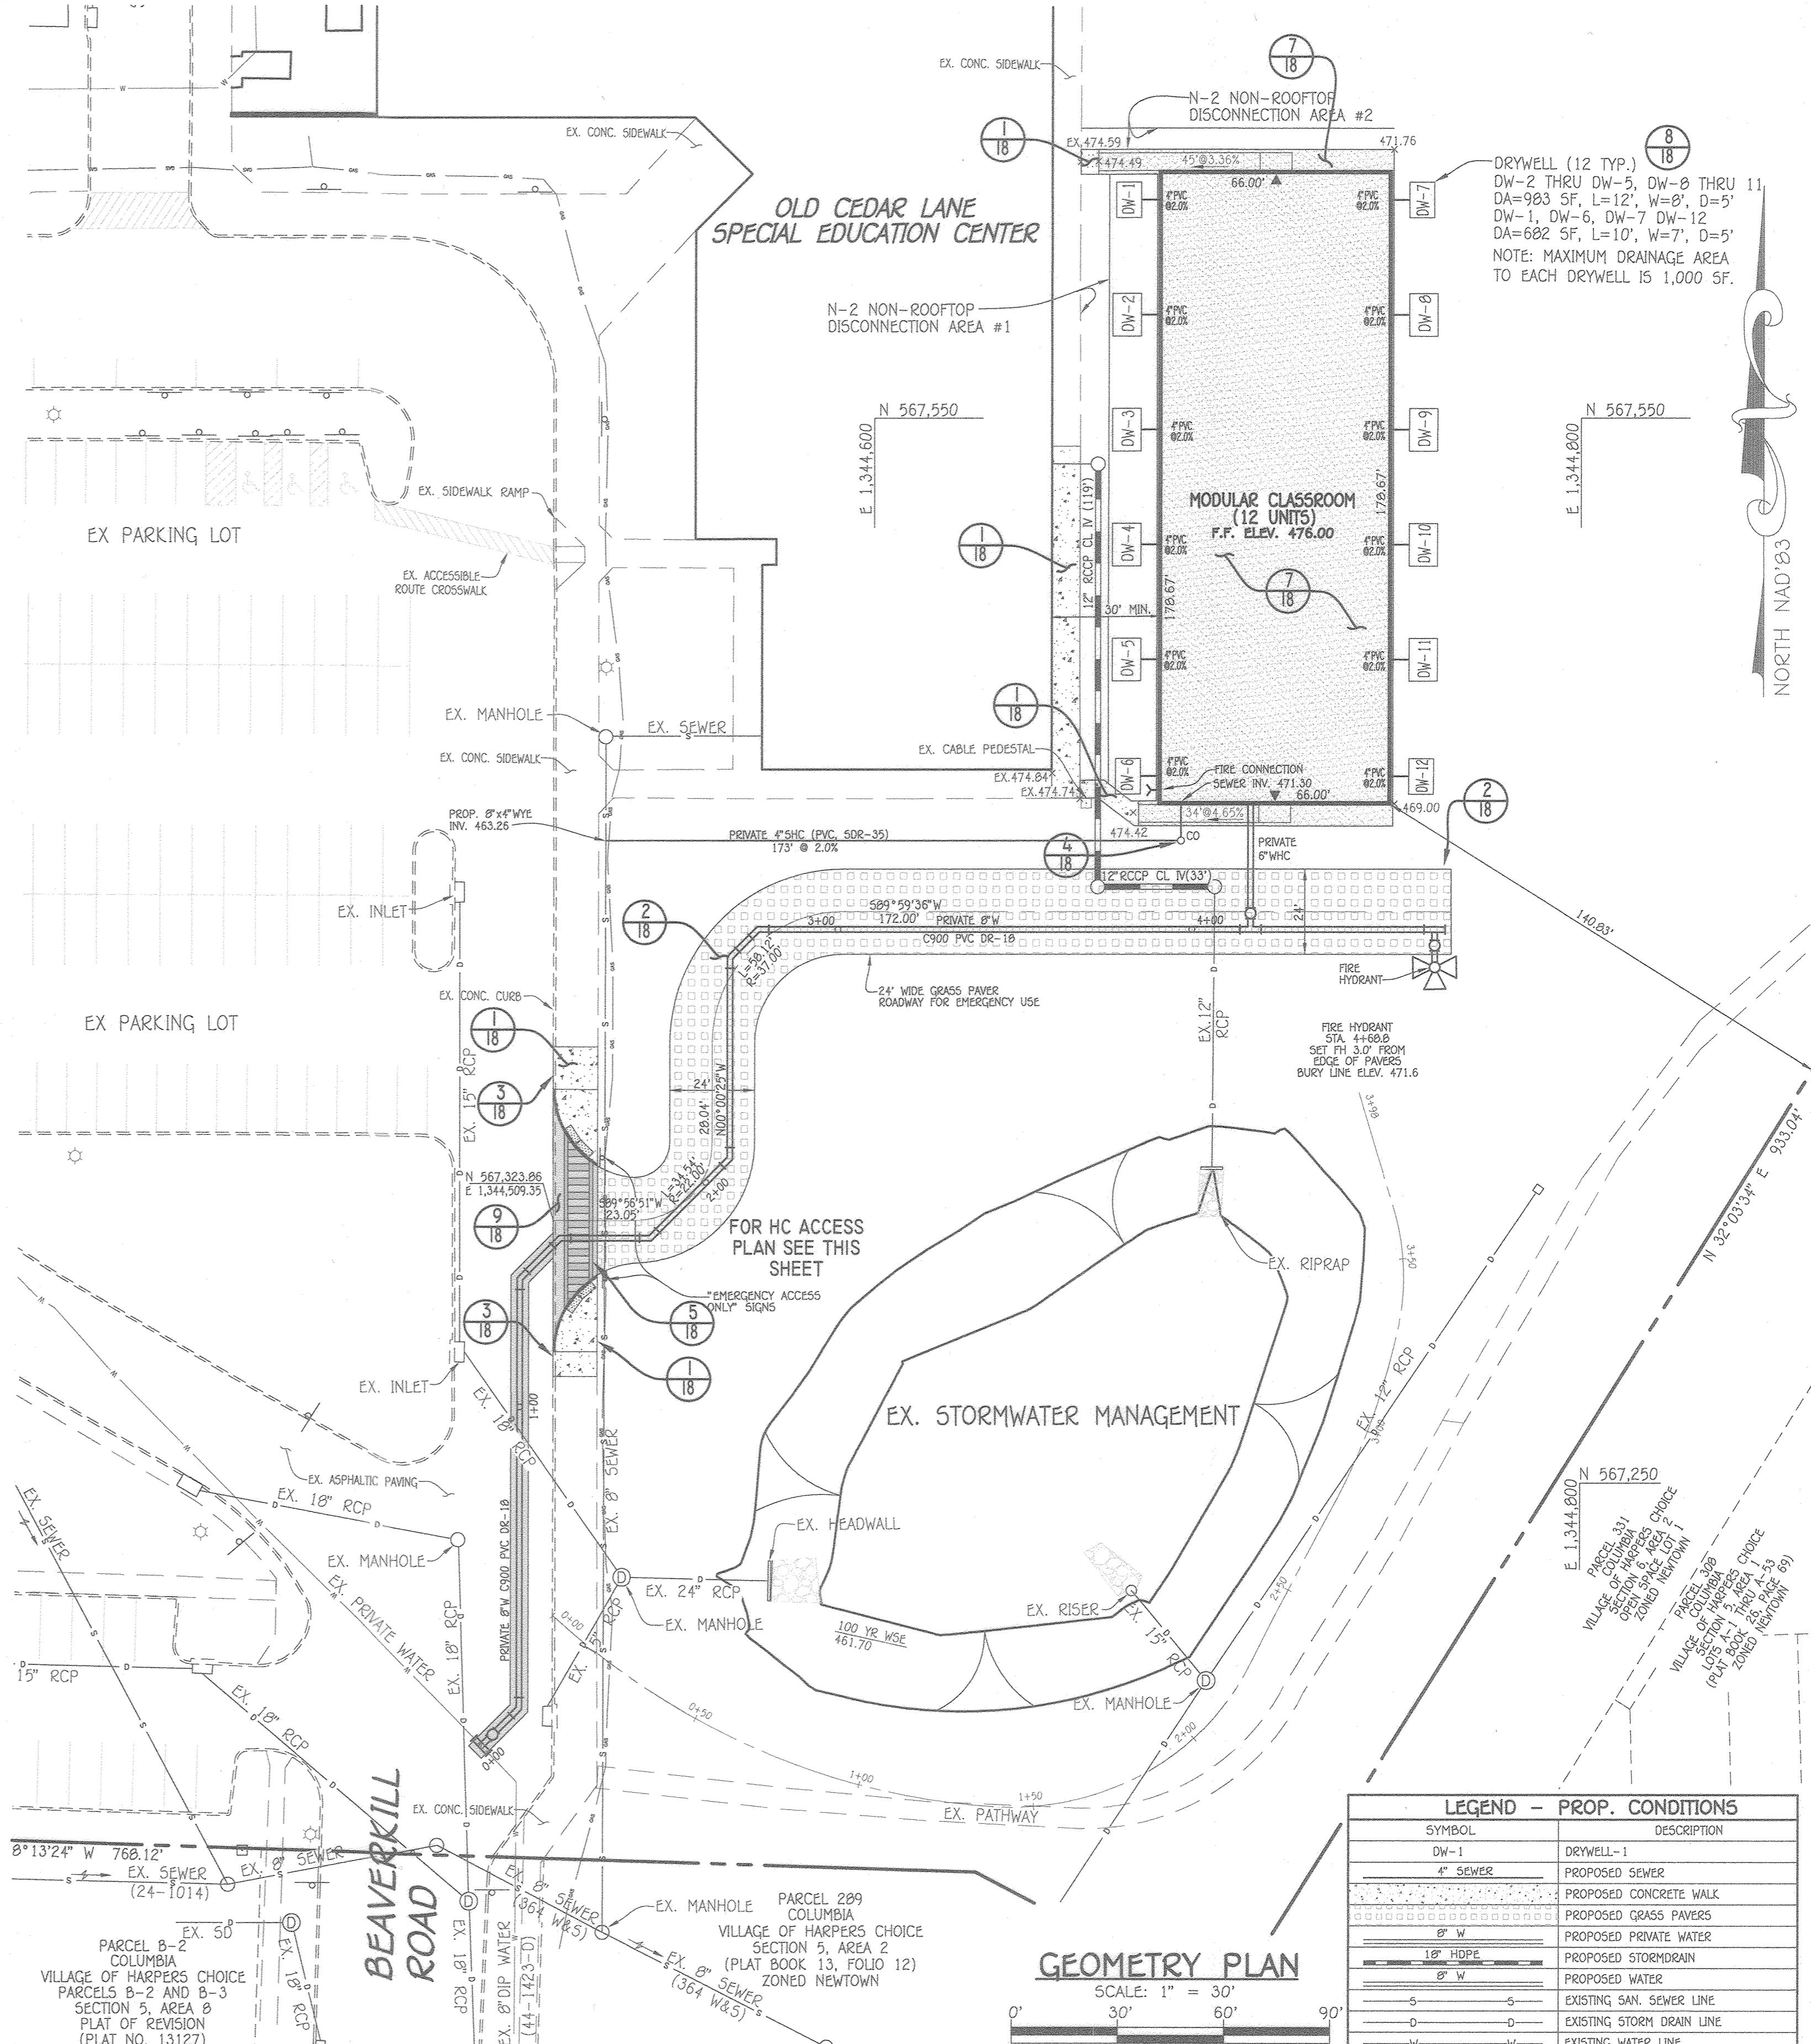

GEOMETRY PLAN
SCALE: 1" = 30'
0' 30' 60' 90'

LEGEND - PROP. CONDITIONS	
SYMBOL	DESCRIPTION
DW-1	DRYWELL-1
8" SEWER	PROPOSED SEWER
Proposed Concrete Walk	PROPOSED CONCRETE WALK
Proposed Grass Pavers	PROPOSED GRASS PAVERS
Proposed Private Water	PROPOSED PRIVATE WATER
Proposed Stormdrain	PROPOSED STORMDRAIN
Proposed Water	PROPOSED WATER
Existing San. Sewer Line	EXISTING SAN. SEWER LINE
Existing Storm Drain Line	EXISTING STORM DRAIN LINE
Existing Water Line	EXISTING WATER LINE

FISHER, COLLINS & CARTER, INC.
CIVIL ENGINEERING CONSULTANTS & LAND SURVEYORS
CENTENNIAL SQUARE OFFICE PARK - 18270 BALTIMORE NATIONAL PIKE
ELICOTT CITY, MARYLAND 21042
(410) 461-2895


"PROFESSIONAL CERTIFICATION. I HEREBY CERTIFY THESE DOCUMENTS WERE PREPARED OR APPROVED BY ME, AND THAT I AM A DULY LICENSED PROFESSIONAL ENGINEER UNDER THE LAWS OF THE STATE OF MARYLAND, LICENSE NO. 27020, EXPIRATION DATE: 01/25/26."
Paul Gerard Cavanaugh
PAUL GERARD CAVANAUGH
DATE: *Jan 18 2024*

DATE	DESCRIPTION
	REVISION BLOCK
	APPROVED: DEPARTMENT OF PLANNING AND ZONING
<i>2/16/24</i>	DATE
<i>2/5/24</i>	DATE
<i>2/3/24</i>	DATE

OWNER/DEVELOPER
PREPARED FOR:
HOWARD COUNTY PUBLIC SCHOOL SYSTEM
9020 MENDENHALL COURT
SUITE 'C'
COLUMBIA, MARYLAND 21045
Attention: DANIEL LUBELEY
410-313-8203

ADDRESS CHART			
PARCEL NO.	STREET ADDRESS		
69	OLD CEDAR LANE SPECIAL ED CENTER COLUMBIA, MARYLAND 21044		
PROJECT	SECTION/AREA	PARCEL	
OLD CEDAR LANE SPECIAL ED CENTER	6/2	69	
PLAT NOS.	BLOCK NO.	ZONE	TAX MAP
-	17.23	NT	29
ELEC. DIST.	CENSUS TR.		
FIFTH	605502		


GEOMETRY PLAN
OLD CEDAR LANE SPECIAL EDUCATION CENTER
VILLAGE OF HARPER'S CHOICE
SECTION 6 AREA 2
ZONED: NEW TOWN
TAX MAP No.: 29 GRID No.: 17, 23 PARCEL No.: 69
FIFTH ELECTION DISTRICT HOWARD COUNTY, MARYLAND
SCALE: AS SHOWN DATE: JANUARY, 2024
SHEET 17 OF 21

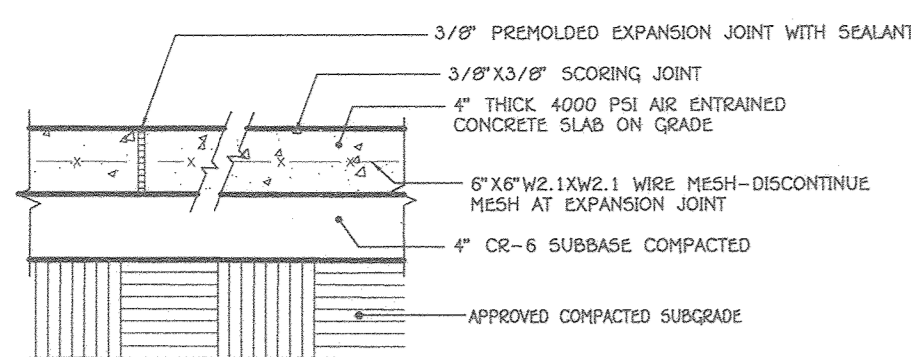

CONCRETE WALK DETAIL


NO SCALE

*THE SUBBASE IS A HOMOGENEOUS MIXTURE CONSISTING OF 1) A CLEAR-STONE/CRUSHED ROCK HAVING AN ASHTO#5 OR SIMILAR DESIGNATION BLENDED WITH 2) PULVERIZED TOPSOIL AND 3) A VOID COMPONENT GENERALLY CONTAINING AIR AND/OR WATER. THE AGGREGATE PORTION SHALL HAVE A PARTICLE RANGE FROM 0.5 MM TO 25 MM (0.375 TO 1.0 IN) WITH A D50 OF 13 MM (0.5 IN). THE PERCENTAGE VOID-SPACE OF THE AGGREGATE PORTION WHEN COMPACTED SHALL BE AT LEAST 30%. THE PULVERIZED TOPSOIL PORTION SHALL EQUAL 25% OF THE TOTAL VOLUME AND BE ADDED AND BLENDED TO PRODUCE A HOMOGENEOUS MIXTURE PRIOR TO PLACEMENT OR WASHED INTO THE IN-PLACE COMPACTED AGGREGATE. ONCE PLACED, THE MIXTURE SHALL BE COMPACTED TO 95% STANDARD PROCTOR DENSITY.

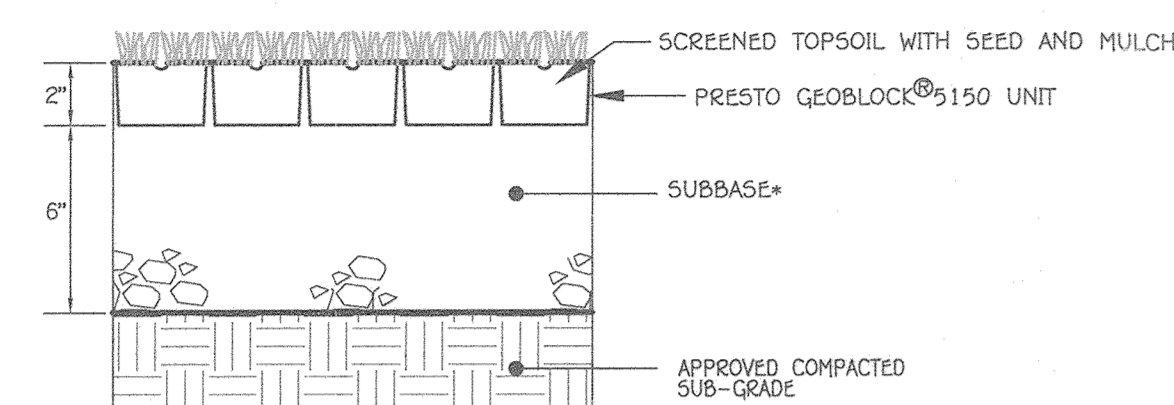


GRASS PAVER SYSTEM PRESTO GEOSYSTEMS - GEOBLOCK® 5150

NO SCALE

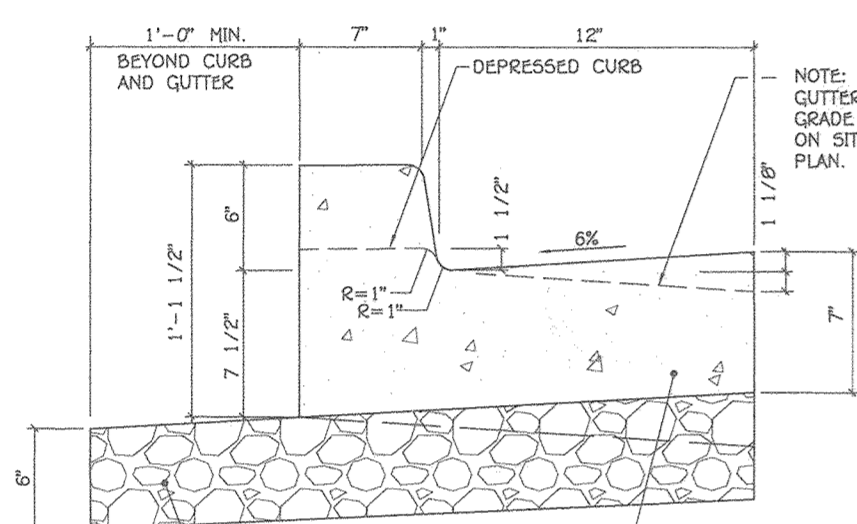


STANDARD 6" COMB. CONC. CURB AND GUTTER

NO SCALE

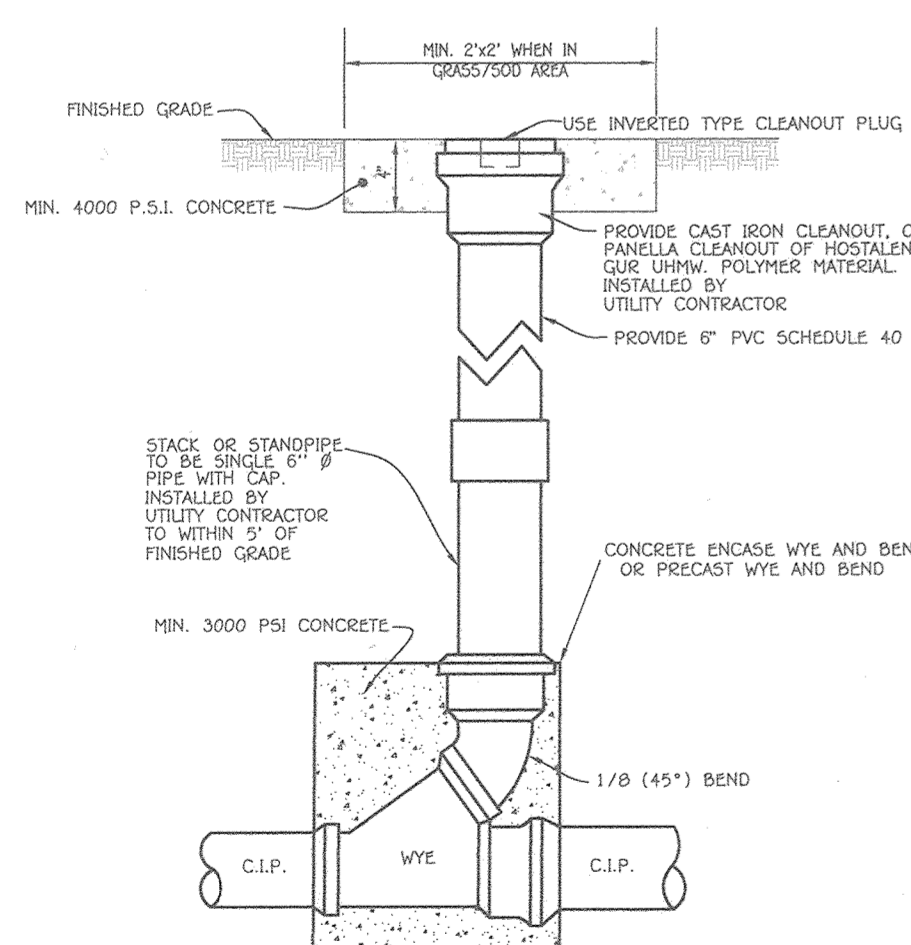


TYPICAL CLEAN-OUT

NO SCALE

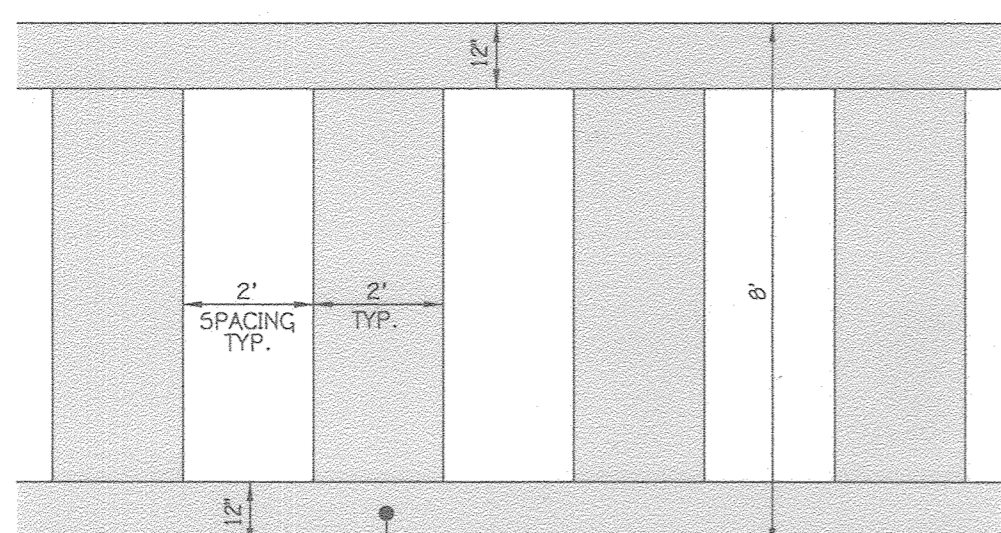


PEDESTRIAN CROSSWALK DETAIL

NO SCALE

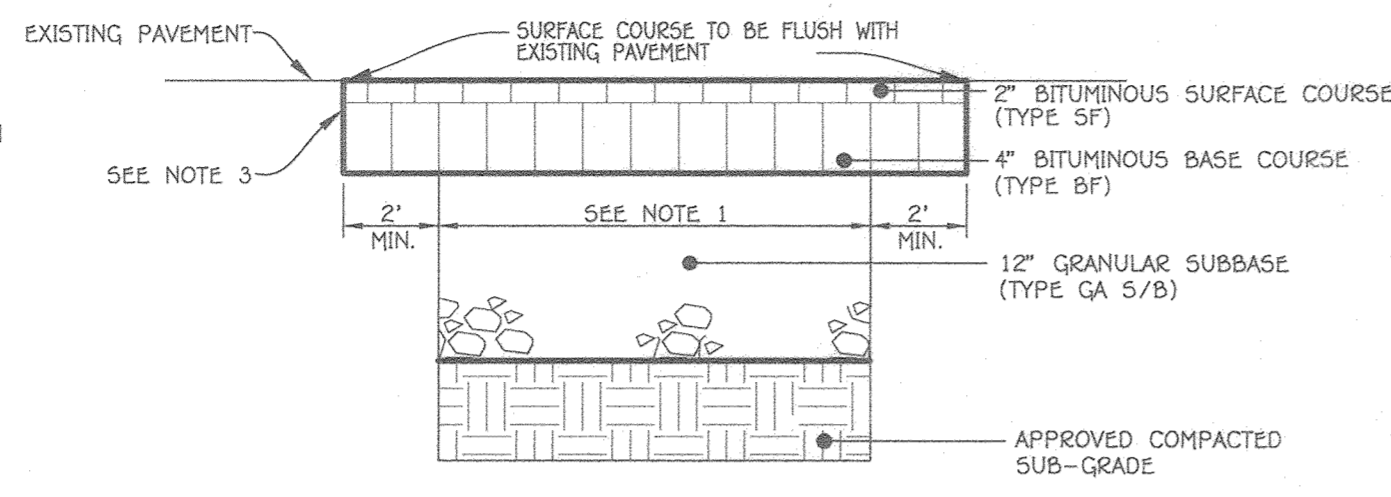


ASPHALTIC PATCH DETAIL

NO SCALE

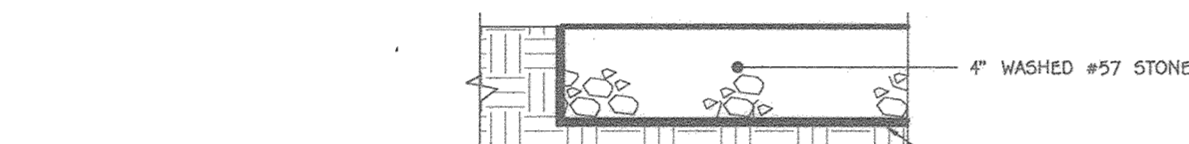

STONE UNDERLAY

NO SCALE

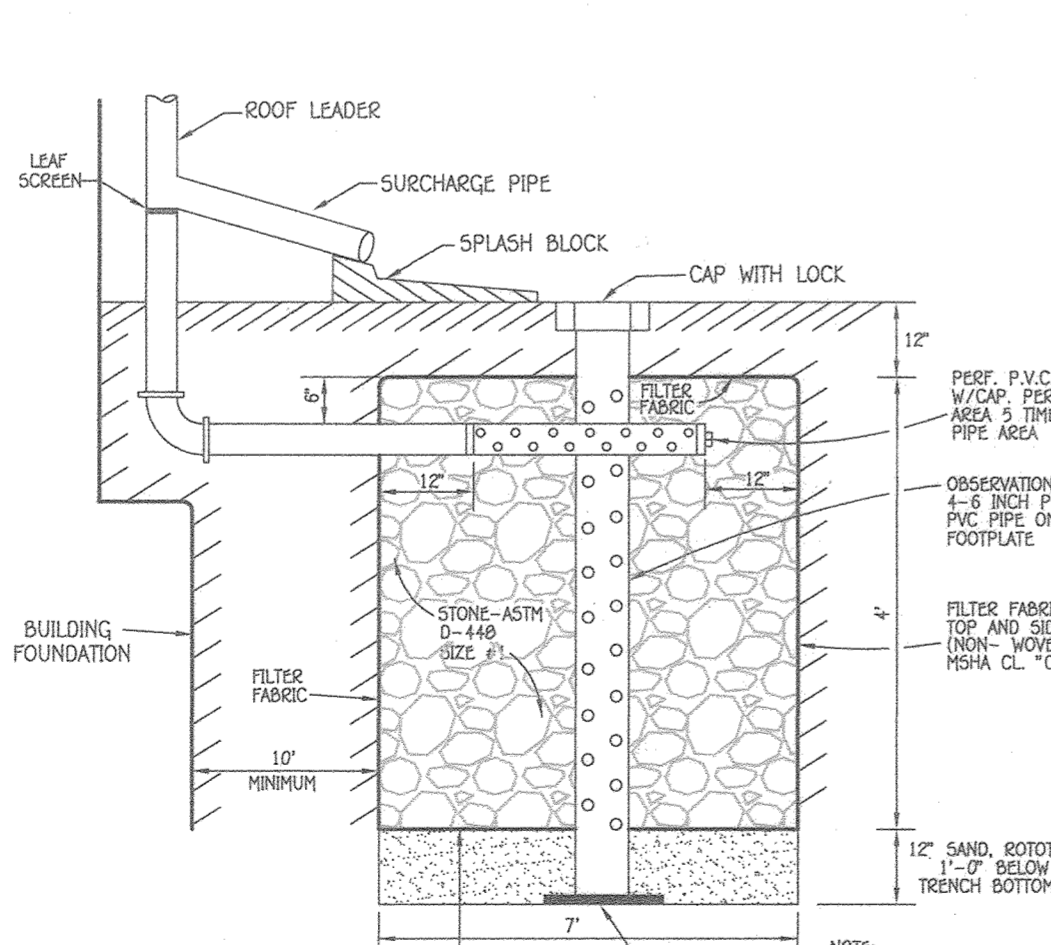

DRYWELL (M-5)

NO SCALE

DRYWELL No.	AREA OF ROOF PER DRYWELL	VOLUME REQUIRED	VOLUME PROVIDED	AREA OF TREATMENT	L x W x D
DW-1	682 SQ. FT.	141 C.F.	141 C.F.	100%	10' x 7' x 5'
DW-2	983 SQ. FT.	203 C.F.	203 C.F.	100%	12' x 8' x 5'
DW-3	983 SQ. FT.	203 C.F.	203 C.F.	100%	12' x 8' x 5'
DW-4	983 SQ. FT.	203 C.F.	203 C.F.	100%	12' x 8' x 5'
DW-5	983 SQ. FT.	203 C.F.	203 C.F.	100%	12' x 8' x 5'
DW-6	682 SQ. FT.	141 C.F.	141 C.F.	100%	10' x 7' x 5'
DW-7	682 SQ. FT.	141 C.F.	141 C.F.	100%	10' x 7' x 5'
DW-8	983 SQ. FT.	203 C.F.	203 C.F.	100%	12' x 8' x 5'
DW-9	983 SQ. FT.	203 C.F.	203 C.F.	100%	12' x 8' x 5'
DW-10	983 SQ. FT.	203 C.F.	203 C.F.	100%	12' x 8' x 5'
DW-11	983 SQ. FT.	203 C.F.	203 C.F.	100%	12' x 8' x 5'
DW-12	682 SQ. FT.	141 C.F.	141 C.F.	100%	10' x 7' x 5'

* AREA OF TREATMENT EXCEEDS THAT REQUIRED.

HILLIS - CARNES ENGINEERING ASSOCIATES, INC. RECORD OF SOIL EXPLORATION

Project Name: Old Cedar Lane, Location: Columbia, MD, Boring No: B-4, Job #: 23380A

Date: 6/19/2023, Date Completed: 6/19/2023

Elevation (ft)	SOIL TYPE (per ASTM D-1586)	Description	Boring and Sampling Notes	Sample No.	SPT Blows	SPT N (blows/ft)			
						10	30	50	60
470.0	D	Red brown, moist, medium stiff, micaceous silty SAND with trace gravel and organics (SM)		1	6	4-3	7		
471.0	D	Red brown, moist, very soft to medium stiff, silty SILT with some gravel (ML)		2	8	5-4	7		
472.0	D	Brown, trace organics	Groundwater was not encountered while drilling	3	2	18	1-1	2	
473.0	D	Brown, moist, stiff to very stiff, micaceous SILT with some sand (ML)		4	12	5-6	10		
474.0	D	Dark grey, trace gravel		5	12	7-7	20		
475.0		Bottom of boring at 15 feet							

HILLIS - CARNES ENGINEERING ASSOCIATES, INC. RECORD OF SOIL EXPLORATION

Project Name: Old Cedar Lane, Location: Columbia, MD, Boring No: B-5, Job #: 23380A

Date: 6/19/2023, Date Completed: 6/19/2023

Elevation (ft)	SOIL TYPE (per ASTM D-1586)	Description	Boring and Sampling Notes	Sample No.	SPT Blows	SPT N (blows/ft)			
						10	30	50	60
470.0	D	Red brown, moist, medium stiff to very stiff, micaceous SILT with some sand and trace organics (ML)	Topsoil - 0'	1	8	2-3	4		
471.0	D	Red brown		2	10	3-7	6		
472.0	D	Brown, trace sand and gravel, and organics	Groundwater was not encountered while drilling	3	14	4-4	12		
473.0	D	Brown, trace sand		4	14	10-16	17		
474.0	D	Red brown		4	12	6-5	10		
475.0		Bottom of boring at 15 feet							


HILLIS - CARNES ENGINEERING ASSOCIATES, INC. RECORD OF SOIL EXPLORATION

Project Name: Old Cedar Lane, Location: Columbia, MD, Boring No: B-6, Job #: 23380A

Date: 6/19/2023, Date Completed: 6/19/2023

Elevation (ft)	SOIL TYPE (per ASTM D-1586)	Description	Boring and Sampling Notes	Sample No.	SPT Blows	SPT N (blows/ft)			
						10	30	50	60
470.0	D	Red brown, moist, medium stiff to very stiff, micaceous SILT with some sand and trace organics (ML)		1	4	6-6	10		
471.0	D	Red brown		2	4	3-7	9		
472.0	D	Brown, trace sand, gravel, and organics	Groundwater was not encountered while drilling	3	3	2-3	8		
473.0	D	Red brown		4	12	8-7	17		
474.0	D	Dark grey, moist, no longer micaceous		5	10	6-6	10		
475.0		Bottom of boring at 15 feet							


DETAIL E-3 SUPER SILT FENCE

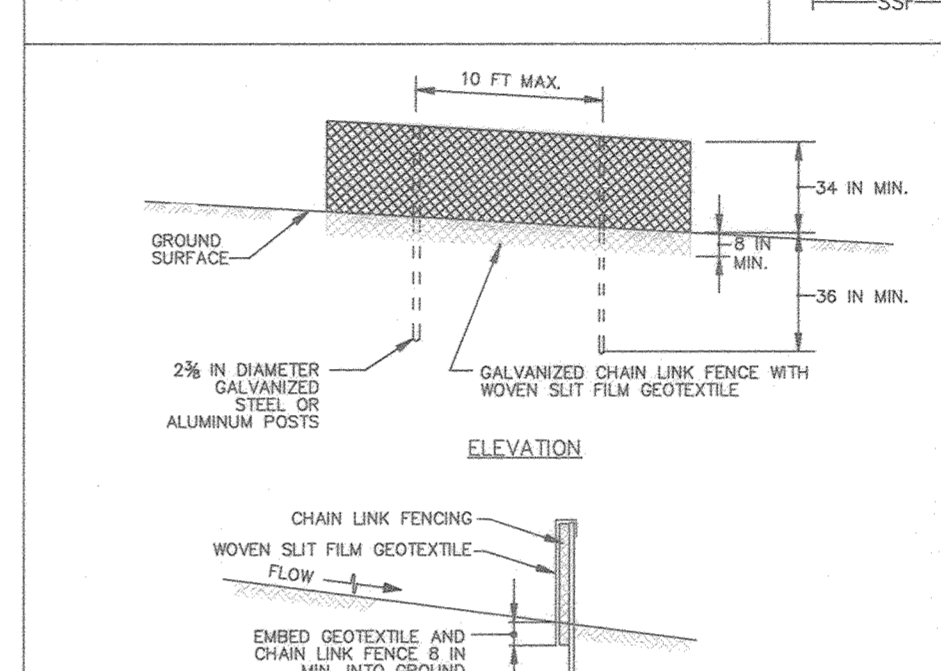

CONSTRUCTION SPECIFICATIONS

- INSTALL 2 1/2 INCH DIAMETER GALVANIZED STEEL POSTS AT 6.095 INCH WALL THICKNESS AND SIX FOOT LENGTH SPACED NO FURTHER THAN 10 FEET APART. DRIVE THE POSTS A MINIMUM OF 36 INCHES INTO THE GROUND.
- FASTEN 9 GAUGE OR HEAVIER GALVANIZED CHAIN LINK FENCE (2% MINIMUM OPENING) 42 INCHES IN HEIGHT SECURELY TO THE FENCE POSTS WITH WIRE TIES OR HUG RINGS.
- FASTEN WOVEN SILT FILM GEOTEXTILE AS SPECIFIED IN SECTION H-1 MATERIALS, SECURELY TO THE UPSLOPE SIDE OF CHAIN LINK FENCE WITH TIES SPACED EVERY 24 INCHES AT THE TOP AND MID SECTION. EMBED GEOTEXTILE AND CHAIN LINK FENCE A MINIMUM OF 6 INCHES INTO THE GROUND.
- WHERE ENDS OF THE GEOTEXTILE COME TOGETHER, THE ENDS SHALL BE OVERLAPPED BY 6 INCHES, FOLDED, AND STAPLED TO PREVENT SEDIMENT BY PASS.
- EXTEND BOTH ENDS OF THE SUPER SILT FENCE A MINIMUM OF FIVE HORIZONTAL FEET UPSLOPE AT 45 DEGREES TO THE MAIN FENCE ALIGNMENT TO PREVENT RUNOFF FROM GOING AROUND THE ENDS OF THE SUPER SILT FENCE.
- PROVIDE MANUFACTURER CERTIFICATION TO THE INSPECTION/ENFORCEMENT AUTHORITY SHOWING THAT GEOTEXTILE USED MEETS THE REQUIREMENTS IN SECTION H-1 MATERIALS.
- REMOVE ACCUMULATED SEDIMENT AND DEBRIS WHEN BULGES DEVELOP IN FENCE OR WHEN SEDIMENT REACHES 25% OF FENCE HEIGHT. REPLACE GEOTEXTILE IF TORN, IF UNDERMINING OCCURS, REINSTALL CHAIN LINK FENCING AND GEOTEXTILE.

DETAIL B-1 STABILIZED CONSTRUCTION ENTRANCE

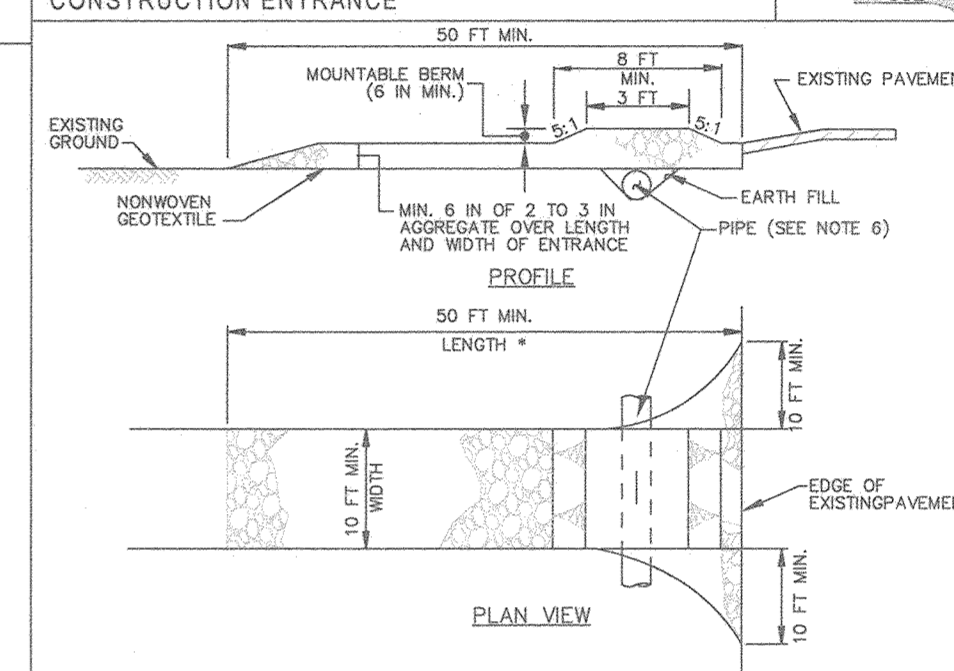

CONSTRUCTION SPECIFICATIONS

- PLACE STABILIZED CONSTRUCTION ENTRANCE IN ACCORDANCE WITH THE APPROVED PLAN. VEHICLES MUST TRAVEL OVER THE ENTIRE LENGTH OF THE SCE. USE MINIMUM LENGTH OF 50 FEET (40 FEET FOR SINGLE RESIDENCE LOTS). USE MINIMUM WIDTH OF 10 FEET. FLARE SCE TO FEET MINIMUM AT THE EXISTING ROAD TO PROVIDE A TURNING RADIUS.
- PIPE ALL SURFACE WATER FLOWING TO OR DIVERTED TOWARD THE SCE UNDER THE ENTRANCE. MAINTAIN POSITIVE DRAINAGE. PROTECT PIPE INSTALLED THROUGH THE SCE WITH A MOUNTABLE BERM WITH 5:1 SLOPES AND A MINIMUM OF 12 INCHES OF STONE OVER THE PIPE. PROVIDE PIPE AS SPECIFIED ON APPROVED PLAN. WHEN THE SCE IS LOCATED AT A HIGH SPOT AND HAS NO DRAINAGE TO CONVEY, A PIPE IS NOT NECESSARY. A MOUNTABLE BERM IS REQUIRED WHEN SCE IS NOT LOCATED AT A HIGH SPOT.
- PREPARE SUBGRADE AND PLACE NONWOVEN GEOTEXTILE, AS SPECIFIED IN SECTION H-1 MATERIALS.
- PLACE CRUSHED AGGREGATE (2 TO 3 INCHES IN SIZE) OR EQUIVALENT RECYCLED CONCRETE (WITHOUT REBAR) AT LEAST 6 INCHES DEEP OVER THE LENGTH AND WIDTH OF THE SCE.
- MAINTAIN ENTRANCE IN A CONDITION THAT MINIMIZES TRACKING OF SEDIMENT AND STONE OR MAKE OTHER REPAIRS AS CONDITIONS DEMAND TO MAINTAIN CLEAN SURFACE. MOUNTABLE BERM, AND SPECIFIED DIMENSIONS. IMMEDIATELY REMOVE STONE AND/OR SEDIMENT SPILLED, DROPPED, OR TRACKED ON ADJACENT ROADWAY BY VACUUMING, SCRAPING, AND/OR SWEEPING. WASHING ROADWAY TO REMOVE MUD TRACKED ONTO PAVEMENT IS NOT ACCEPTABLE UNLESS WASH WATER IS DIRECTED TO AN APPROVED SEDIMENT CONTROL PRACTICE.

MARYLAND STANDARDS AND SPECIFICATIONS FOR SOIL EROSION AND SEDIMENT CONTROL

HILLIS - CARNES ENGINEERING ASSOCIATES, INC. RECORD OF SOIL EXPLORATION


Project Name: Old Cedar Lane, Location: Columbia, MD, Boring No: B-7, Job #: 23380A

Date: 6/19/2023, Date Completed: 6/19/2023

Elevation (ft)	SOIL TYPE (per ASTM D-1586)	Description	Boring and Sampling Notes	Sample No.	SPT Blows	SPT N (blows/ft)			
						10	30	50	60
470.0	D	Brown, moist, medium stiff, silty SILT with trace organics and gravel (ML)		1	8	5-4	9		
471.0	D	Brown and red brown, moist, silty, micaceous SILT with trace sand, gravel, and organics (ML)		2	8	6-8	13		
472.0	D	Red brown, some gravel, no longer micaceous	Groundwater was not encountered while drilling	3	10	6-6	11		
473.0	D	Red brown		4	12	6-8	14		
474.0	D	Bottom of boring at 15 feet		5	13	5-6	10		

HEAVY DUTY ASPHALTIC PAVING DETAIL

NO SCALE

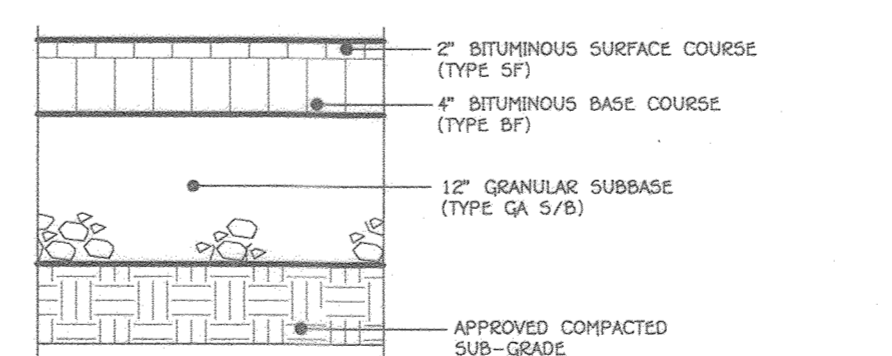

FISHER, COLLINS & CARTER, INC. CIVIL ENGINEERING CONSULTANTS & LAND SURVEYORS

ENGINEER'S CERTIFICATE

I HEREBY CERTIFY THAT THIS PLAN HAS BEEN DESIGNED IN ACCORDANCE WITH THE CURRENT MARYLAND EROSION AND SEDIMENT CONTROL LAWS, REGULATIONS, AND STANDARDS REPRESENTS A PRACTICAL AND WORKABLE PLAN BASED ON MY PERSONAL KNOWLEDGE OF THE SITE AND THAT IT WAS PREPARED IN ACCORDANCE WITH THE REQUIREMENTS OF THE HOWARD SOIL CONSERVATION DISTRICT.

Signature of Engineer: Paul Gerard Cavanaugh, Date: Jan 18, 2024

*PROFESSIONAL CERTIFICATION: I HEREBY CERTIFY THESE DOCUMENTS WERE PREPARED OR APPROVED BY ME AND THAT I AM A DULY LICENSED PROFESSIONAL ENGINEER UNDER THE LAWS OF THE STATE OF MARYLAND, LICENSE NO. 27020, EXPIRATION DATE: 01/25/26.

Signature of Professional Engineer: Paul Gerard Cavanaugh, Date: Jan 18, 2024

DEVELOPER'S CERTIFICATE

I/WE HEREBY CERTIFY THAT ANY CLEARING, GRADING, CONSTRUCTION, OR DEVELOPMENT WILL BE DONE PURSUANT TO THIS APPROVED EROSION AND SEDIMENT CONTROL PLAN, INCLUDING INSPECTING AND MAINTAINING CONTROLS, AND THAT THE RESPONSIBLE PERSONNEL INVOLVED IN THE CONSTRUCTION PROJECT WILL HAVE A CERTIFICATE OF TRAINING AT A MARYLAND DEPARTMENT OF THE ENVIRONMENT (MDE) APPROVED TRAINING PROGRAM FOR THE CONTROL OF EROSION AND SEDIMENT PRIOR TO BEGINNING THE PROJECT. I CERTIFY RIGHT OF ENTRY FOR PERIODIC ON-SITE EVALUATION BY HOWARD COUNTY, THE HOWARD SOIL CONSERVATION DISTRICT AND/OR MDE.

Signature of Developer: Alexander Bratcher, Date: Jan 19, 2024

THESE PLANS FOR SMALL POND CONSTRUCTION, SOIL EROSION AND SEDIMENT CONTROL, MEET THE REQUIREMENTS OF THE HOWARD SOIL CONSERVATION DISTRICT.

Signature of Howard Soil Conservation District: Alexander Bratcher, Date: 02/16/24

OWNER/DEVELOPER

PREPARED FOR HOWARD COUNTY PUBLIC SCHOOL SYSTEM 9020 MENDENHALL COURT SUITE 'C' COLUMBIA, MARYLAND 21045 Attention: DANIEL LUBELEY 410-313-8203

ADDRESS CHART

PARCEL NO.	STREET ADDRESS
69	OLD CEDAR LANE SPECIAL ED CENTER COLUMBIA, MARYLAND 21044


PROJECT	SECTION/AREA	PARCEL			
OLD CEDAR LANE SPECIAL ED CENTER	6/2	69			
PLAT NOS.	BLOCK NO.	ZONE	TAX MAP	ELEC. DIST.	CENSUS TR.
-	17.23	NT	29	FIFTH	605902

SITE DETAILS, BORING LOGS AND SEDIMENT CONTROL DETAILS

OLD CEDAR LANE SPECIAL EDUCATION CENTER


VILLAGE OF HARPER'S CHOICE SECTION 6 AREA 2

ZONED: NEW TOWN TAX MAP No.: 29 GRID No.: 17, 23 PARCEL No.: 69 FIFTH ELECTION DISTRICT HOWARD COUNTY, MARYLAND SCALE: AS SHOWN DATE: JANUARY, 2024 SHEET 19 OF 21

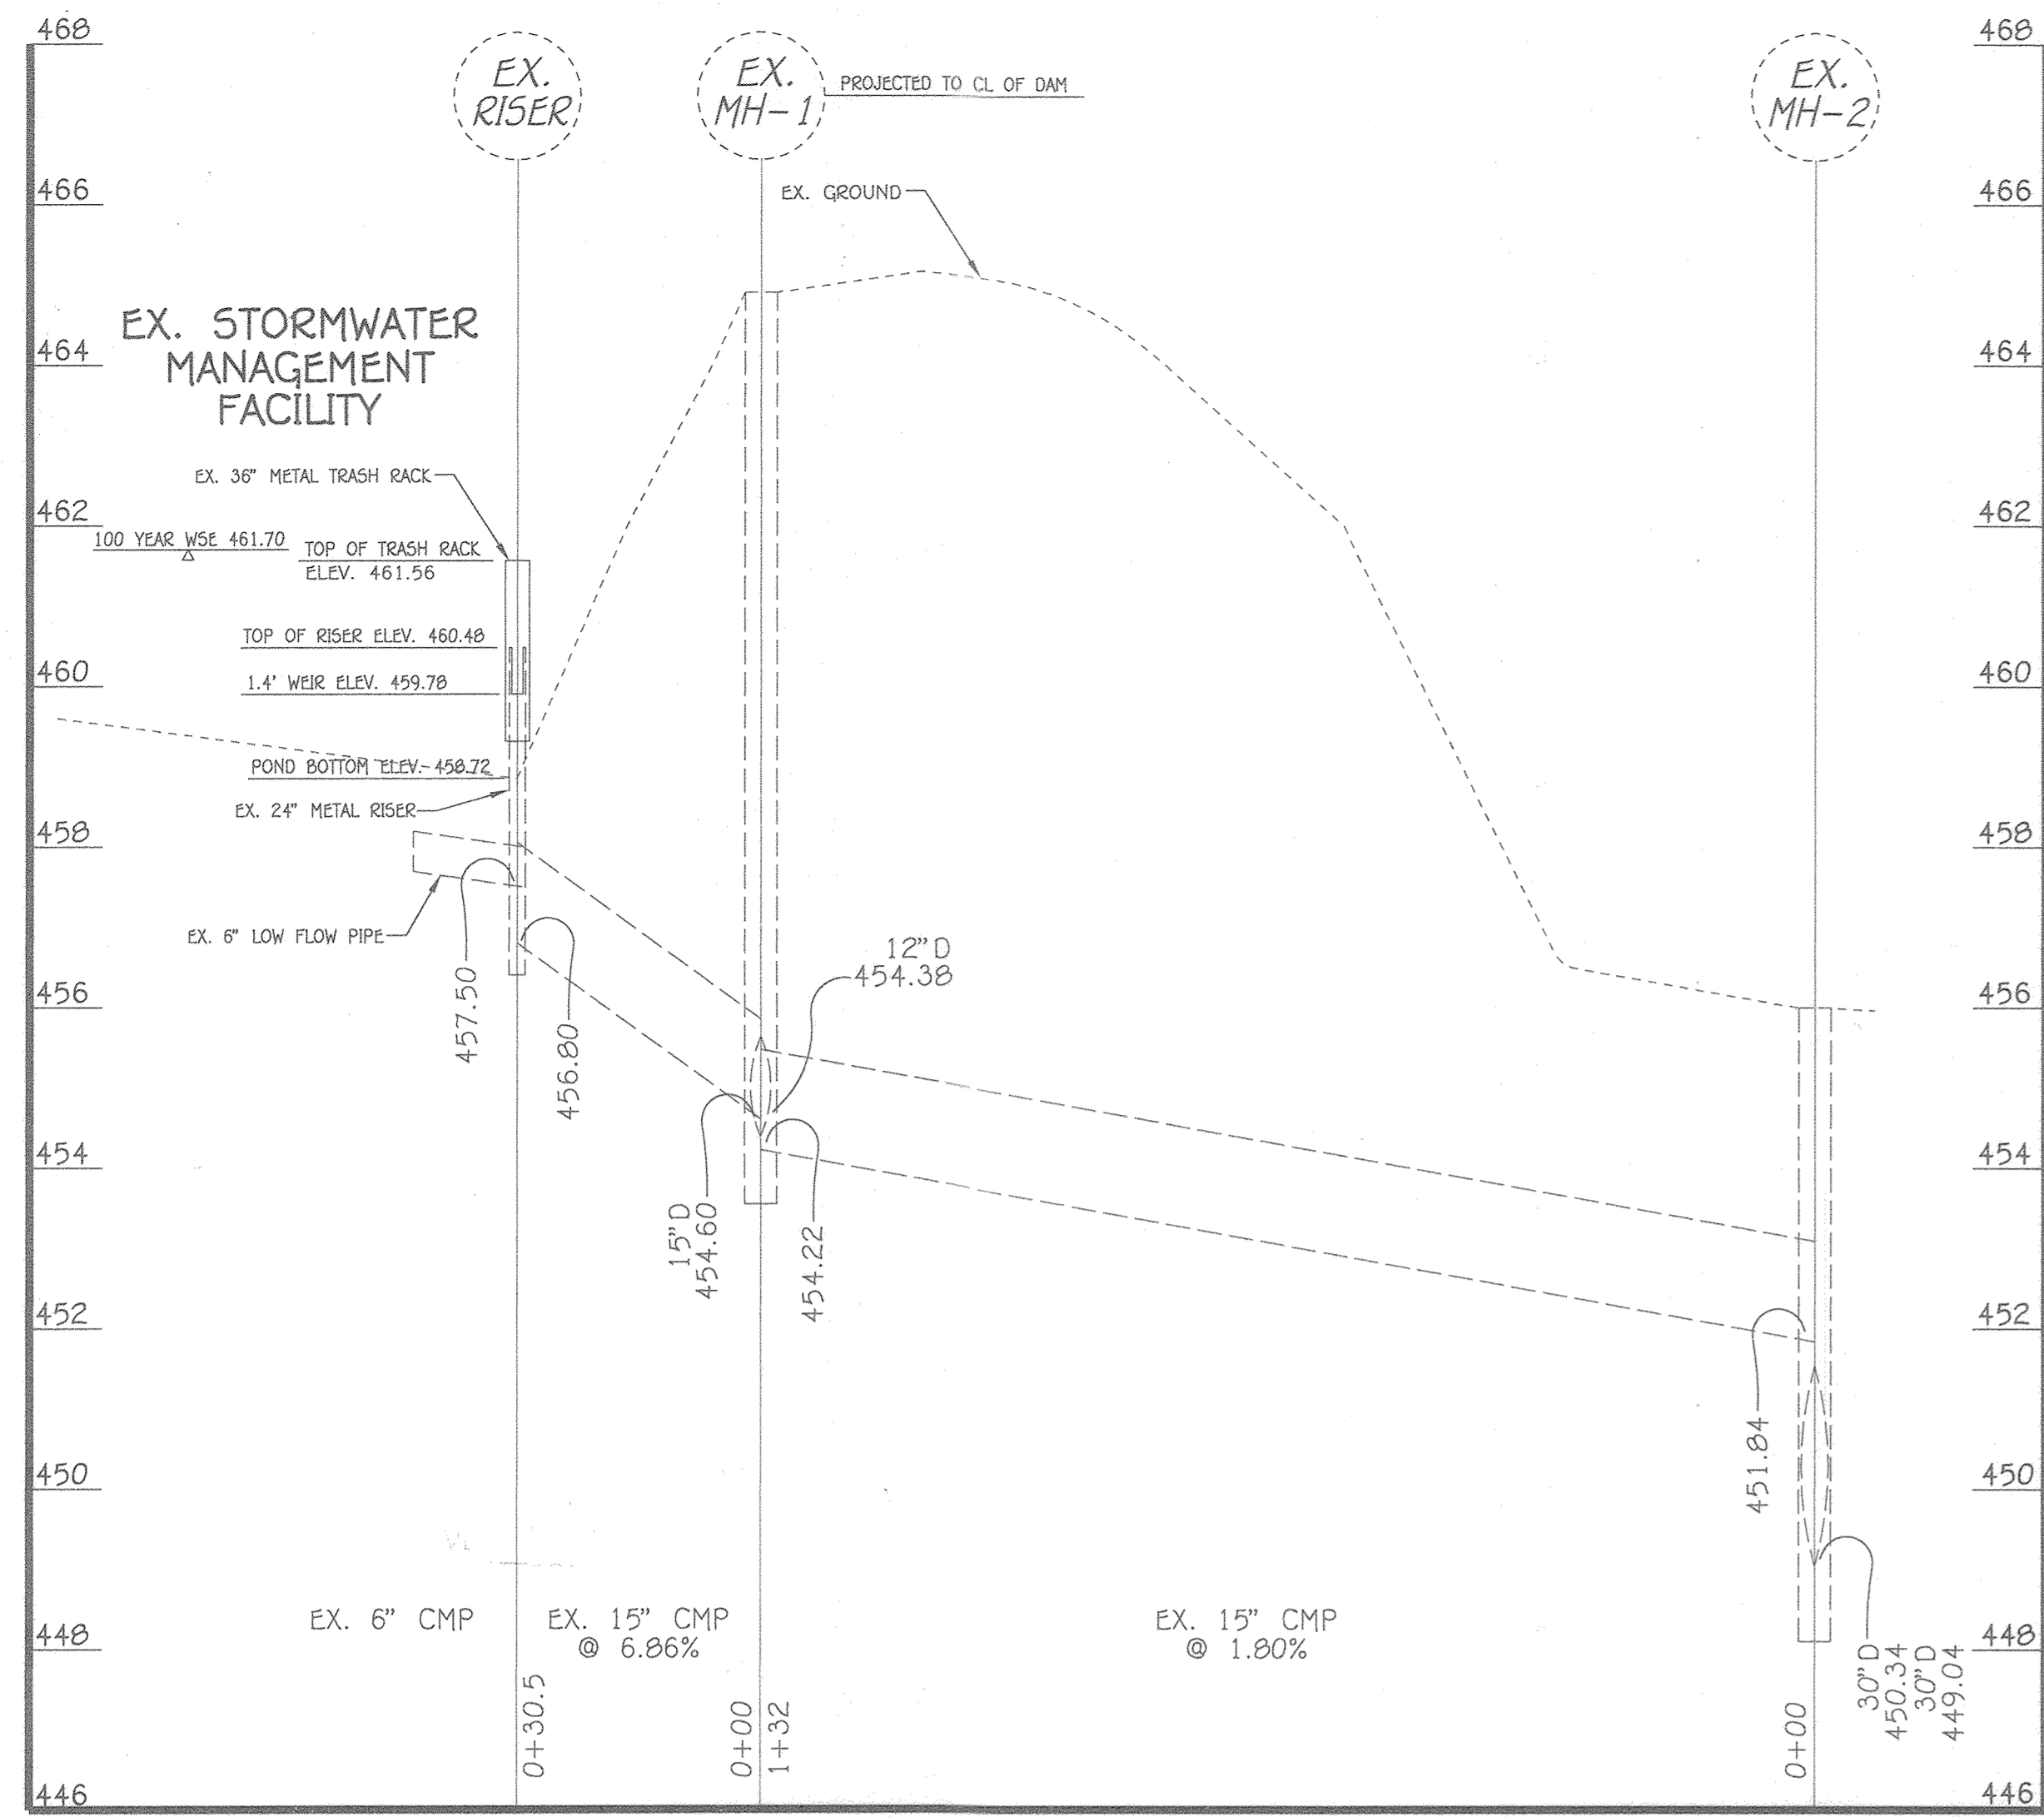

PROFILE THRU EXISTING EMBANKMENT

SCALE: HORIZ. : 1" = 20'
VERT. : 1" = 2'

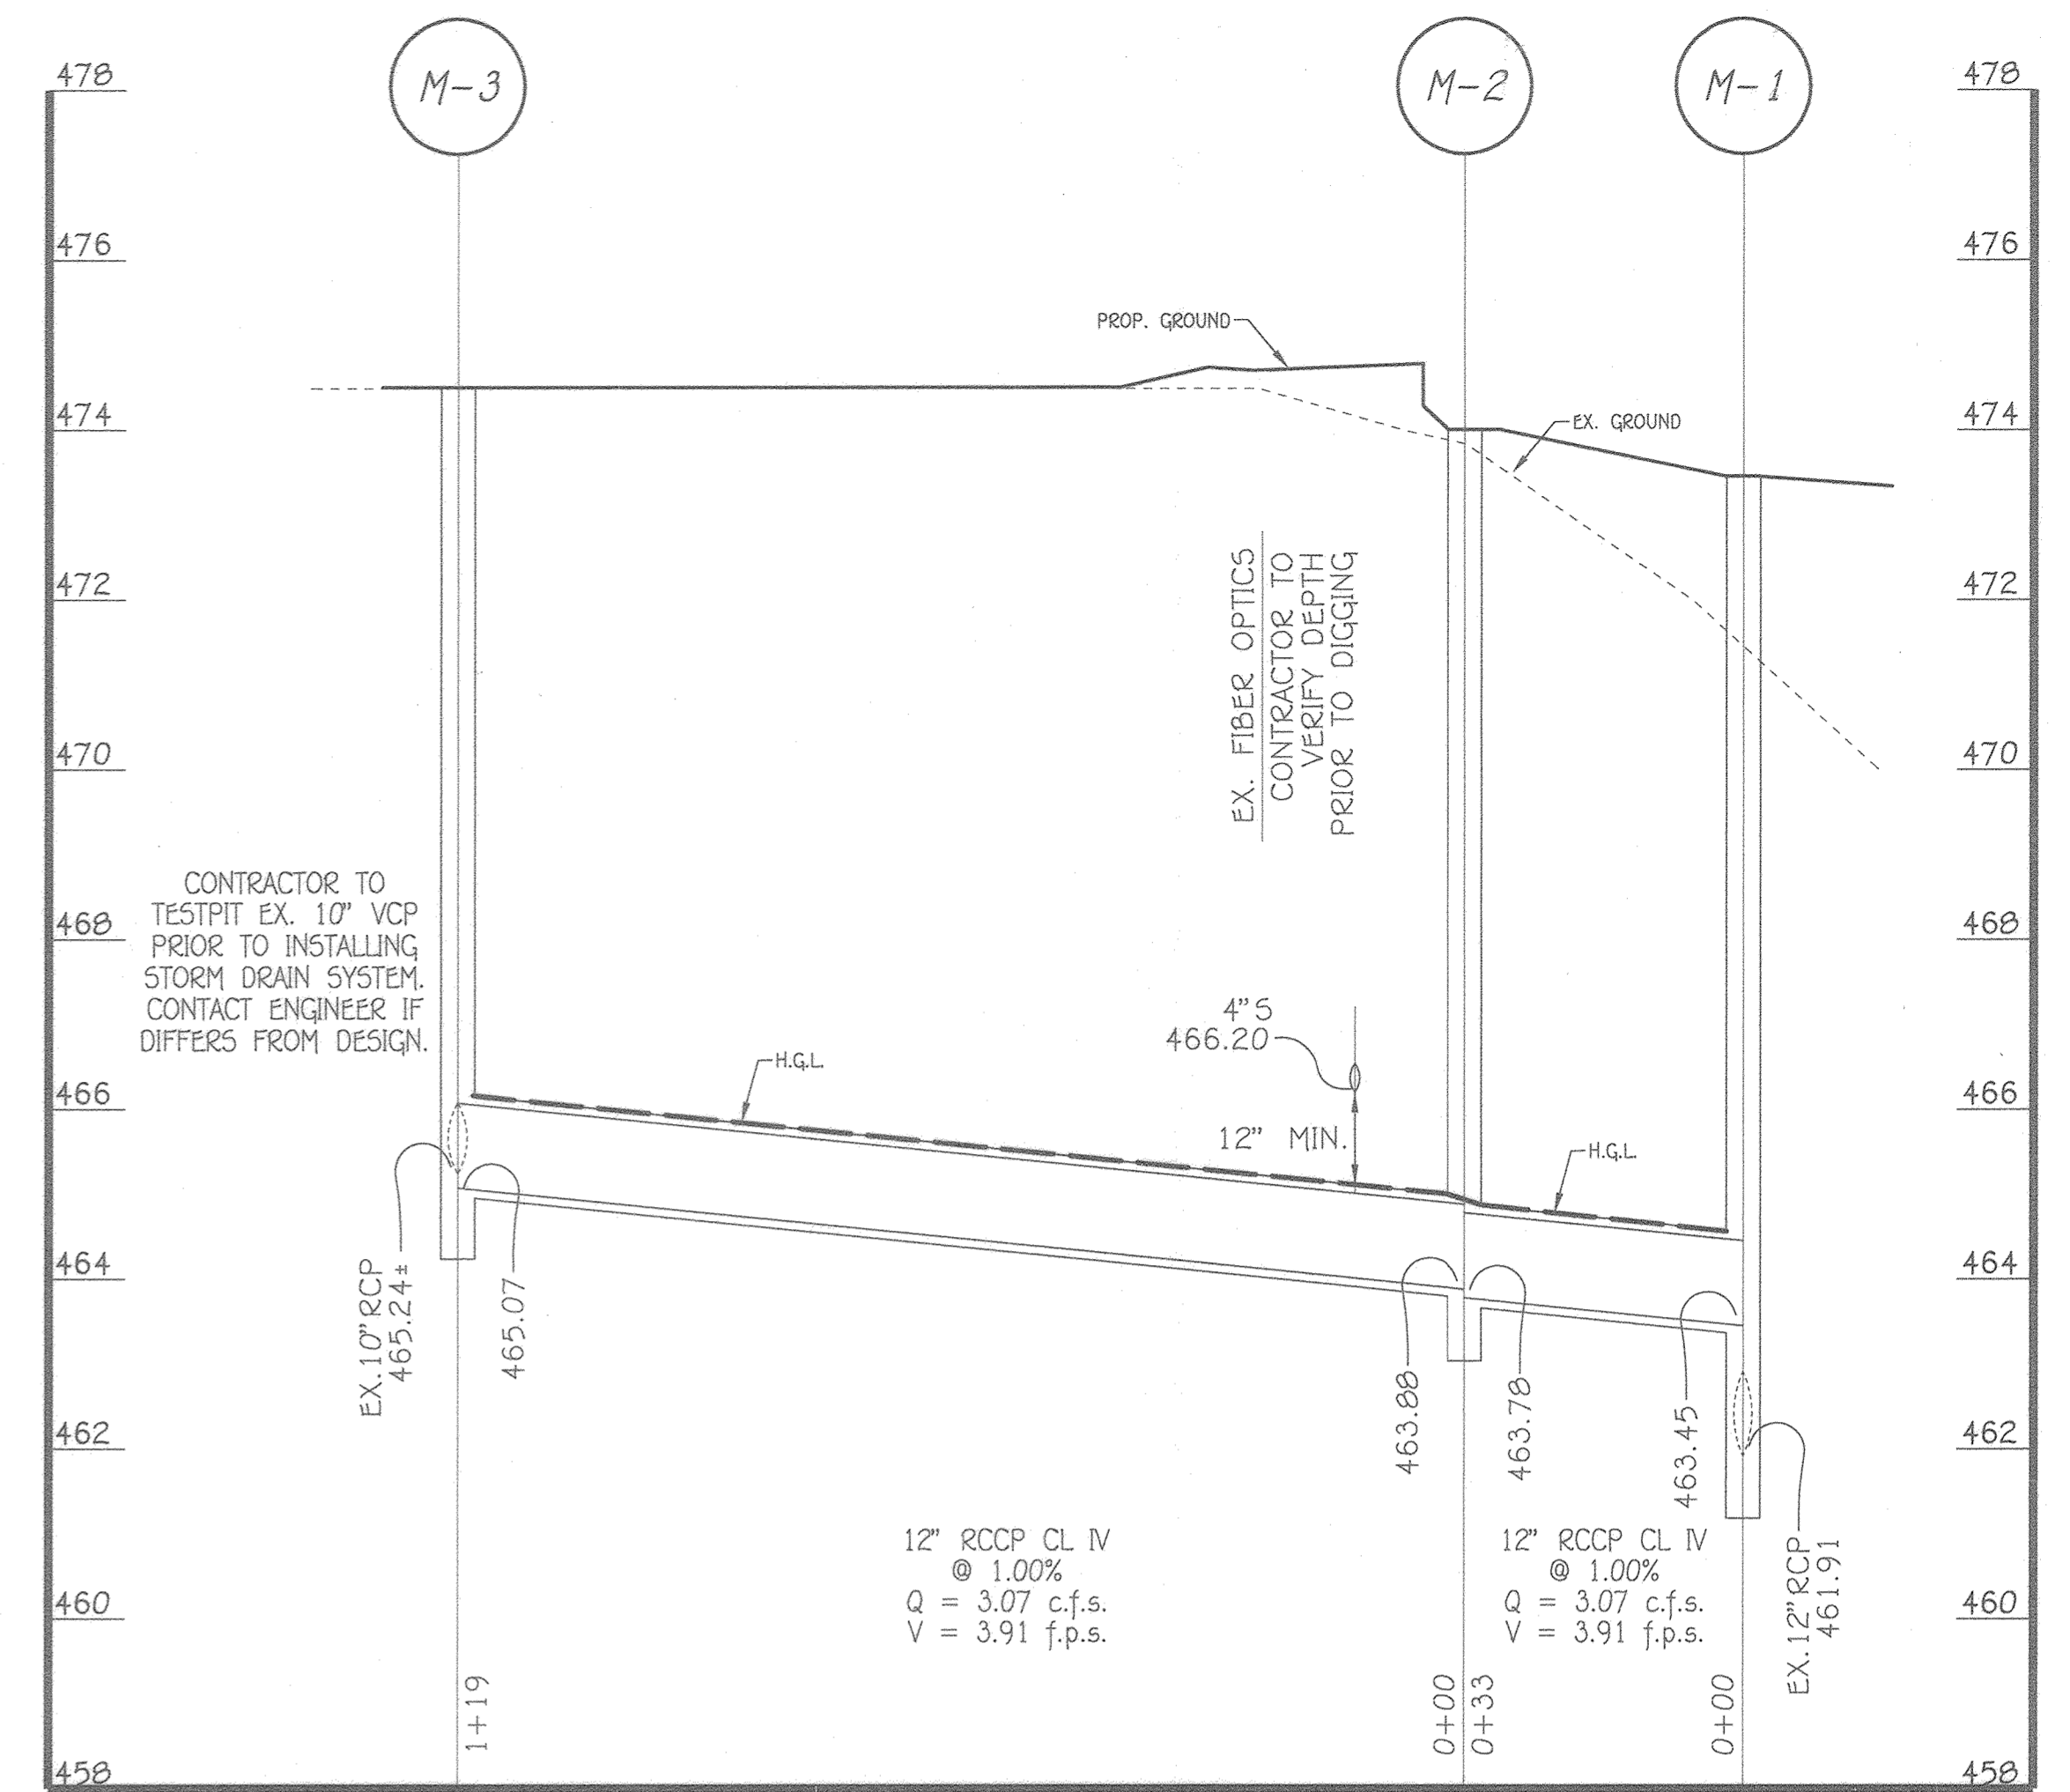

STORM DRAIN PROFILE

SCALE: HORIZ. : 1" = 20'
VERT. : 1" = 2'

SIZE	CLASS	LENGTH
4"	PVC	60 L.F.
12"	RCCP	152 L.F.

STRUCTURE NO.	OWNERSHIP AND MAINTENANCE	TOP ELEVATION	INV. IN	INV. OUT	COORDINATES	INTERIOR WIDTH	TYPE	REMARKS
M-1	PRIVATE	473.45	463.45 (12")	461.91 (12")	N 567,417.94 E 1,344,696.31	4.0'	STD MANHOLE	Q=5.12
M-2	PRIVATE	474.00	463.88 (12")	463.78 (12")	N 567,370.83 E 1,344,663.38	4.0'	STD MANHOLE	Q=5.12
M-3	PRIVATE	474.50	465.24 (10")	465.07 (12")	N 567,537.13 E 1,344,663.28	4.0'	STD MANHOLE	Q=5.12

FISHER, COLLINS & CARTER, INC.
CIVIL ENGINEERING CONSULTANTS & LAND SURVEYORS
CENTENNIAL SQUARE OFFICE PARK - 10272 BALTIMORE NATIONAL PIKE
ELLSWORTH CITY, MARYLAND 21044
(410) 461-2895


*PROFESSIONAL CERTIFICATION. I HEREBY CERTIFY THESE DOCUMENTS WERE PREPARED OR APPROVED BY ME, AND THAT I AM A DULY LICENSED PROFESSIONAL ENGINEER UNDER THE LAWS OF THE STATE OF MARYLAND, LICENSE NO. 27020, EXPIRATION DATE: 01/25/26.
Paul Gerard Cavanaugh
PAUL GERARD CAVANAUGH
DATE: *Jan 13, 2024*

APPROVED: DEPARTMENT OF PLANNING AND ZONING
Mary A. Kendall FOR
Director, Department of Planning and Zoning
DATE: *2/16/24*
CHIEF, Division of Land Development
[Signature]
DATE: *2/3/24*
Chief, Development Engineering Division

OWNER/DEVELOPER
PREPARED FOR
HOWARD COUNTY PUBLIC SCHOOL SYSTEM
9020 MENDENHALL COURT
SUITE 'C'
COLUMBIA, MARYLAND 21045
Attention: DANIEL LUBELEY
410-313-8203


ADDRESS CHART					
PARCEL NO.	STREET ADDRESS				
69	OLD CEDAR LANE SPECIAL ED CENTER COLUMBIA, MARYLAND 21044				
PROJECT	SECTION/AREA	PARCEL			
OLD CEDAR LANE SPECIAL ED CENTER	6/2	69			
PLAT NOS.	BLOCK NO.	ZONE	TAX MAP	ELEC. DIST.	CENSUS TR.
-	17.23	NT	29	FIFTH	605502

PROFILES
OLD CEDAR LANE SPECIAL EDUCATION CENTER
VILLAGE OF HARPER'S CHOICE
SECTION 6 AREA 2
ZONED: NEW TOWN
TAX MAP No.: 29 GRID No.: 17, 23 PARCEL No.: 69
FIFTH ELECTION DISTRICT HOWARD COUNTY, MARYLAND
SCALE: AS SHOWN DATE: JANUARY, 2024
SHEET 20 OF 21

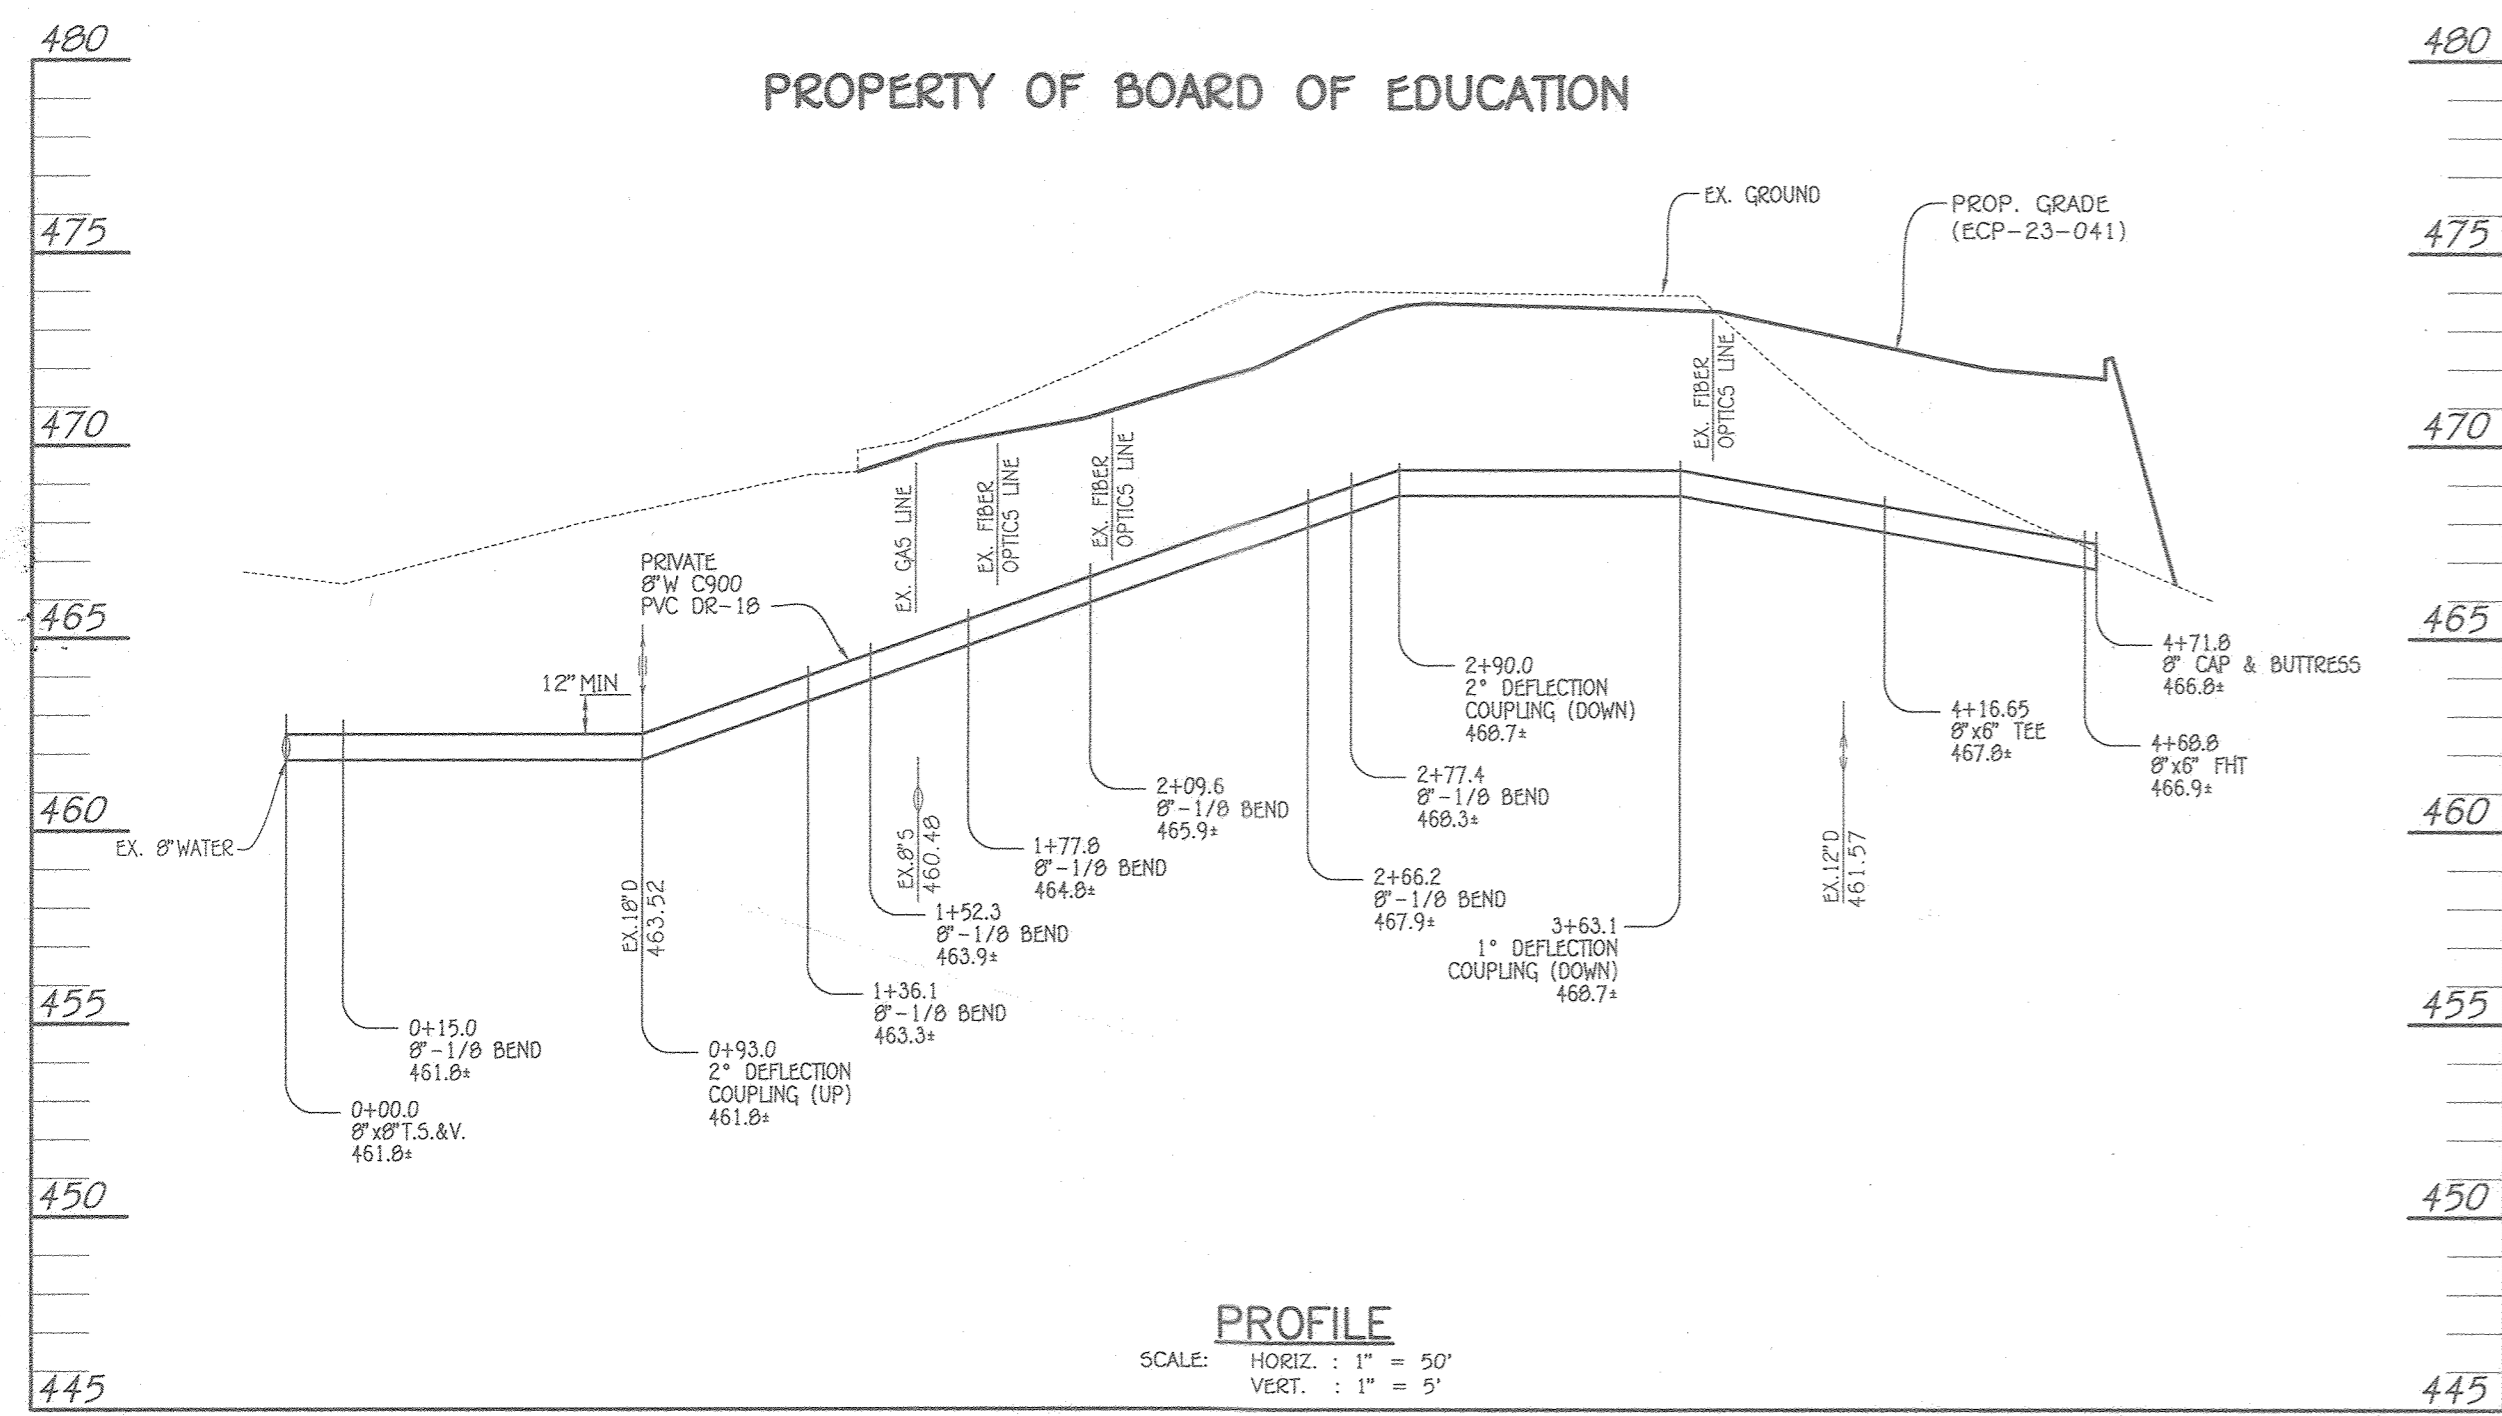


PRIVATE 8" WATER MAIN: PORTABLE CLASSROOM

PRIVATE WATER MAIN TABULATION CHART			
W.M. STA.	APPURTENANCE	NORTHING	EASTING
8" WATER MAIN			
0+00.0	8"x8" T, S & V	567,175.74	1,344,489.30
0+15.0	8"-1/8" BEND	567,186.36	1,344,499.91
0+93.0	2" DEFLECTION COUPLING	567,264.35	1,344,499.91
1+36.1	8"-1/8" BEND	567,307.44	1,344,499.91
1+52.3	8"-1/8" BEND	567,318.88	1,344,511.34
1+77.8	8"-1/8" BEND	567,318.88	1,344,536.86
2+09.8	8"-1/8" BEND	567,341.40	1,344,559.30
2+66.2	8"-1/8" BEND	567,397.98	1,344,559.30
2+77.4	8"-1/8" BEND	567,405.92	1,344,567.32
2+90.0	2" DEFLECTION COUPLING	567,405.92	1,344,579.87
3+63.1	1" DEFLECTION COUPLING	567,405.93	1,344,652.97
4+16.65	8"x8" TEE	567,405.94	1,344,708.52
4+68.8	8"x8" FHT	567,405.95	1,344,758.70
4+71.8	8" CAP & BUTTRESS	567,405.95	1,344,761.70

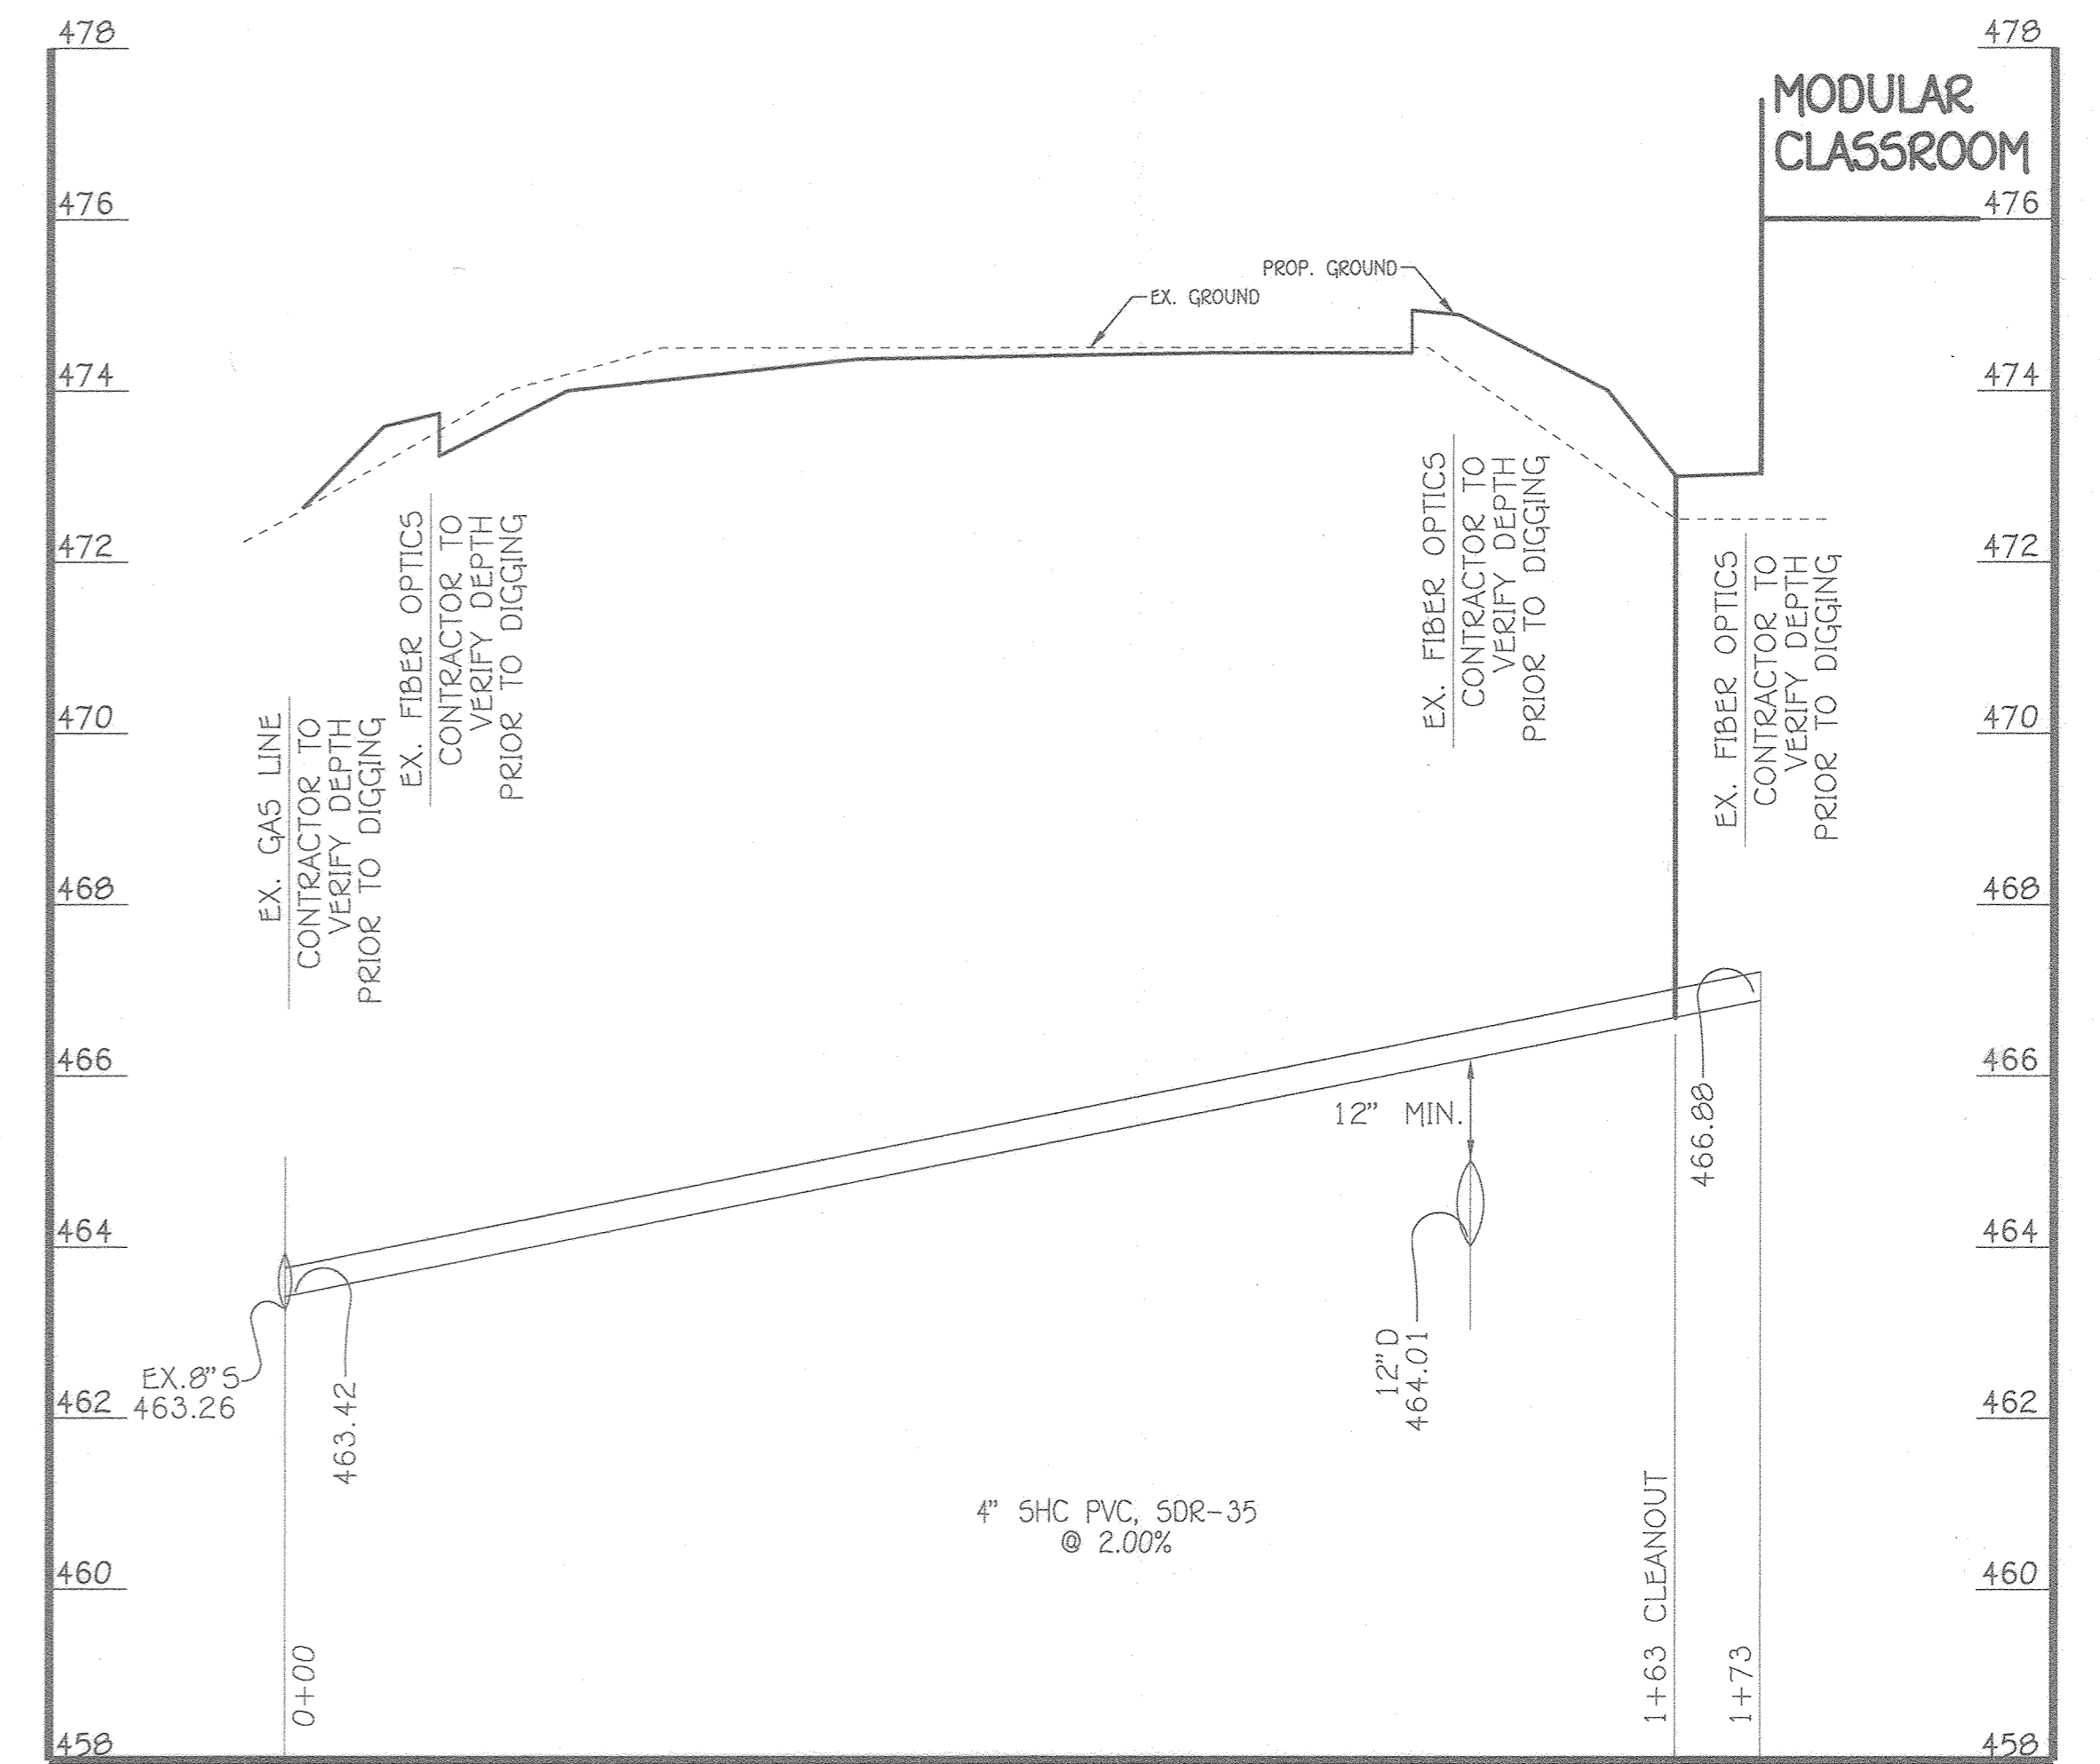

SEWER PROFILE

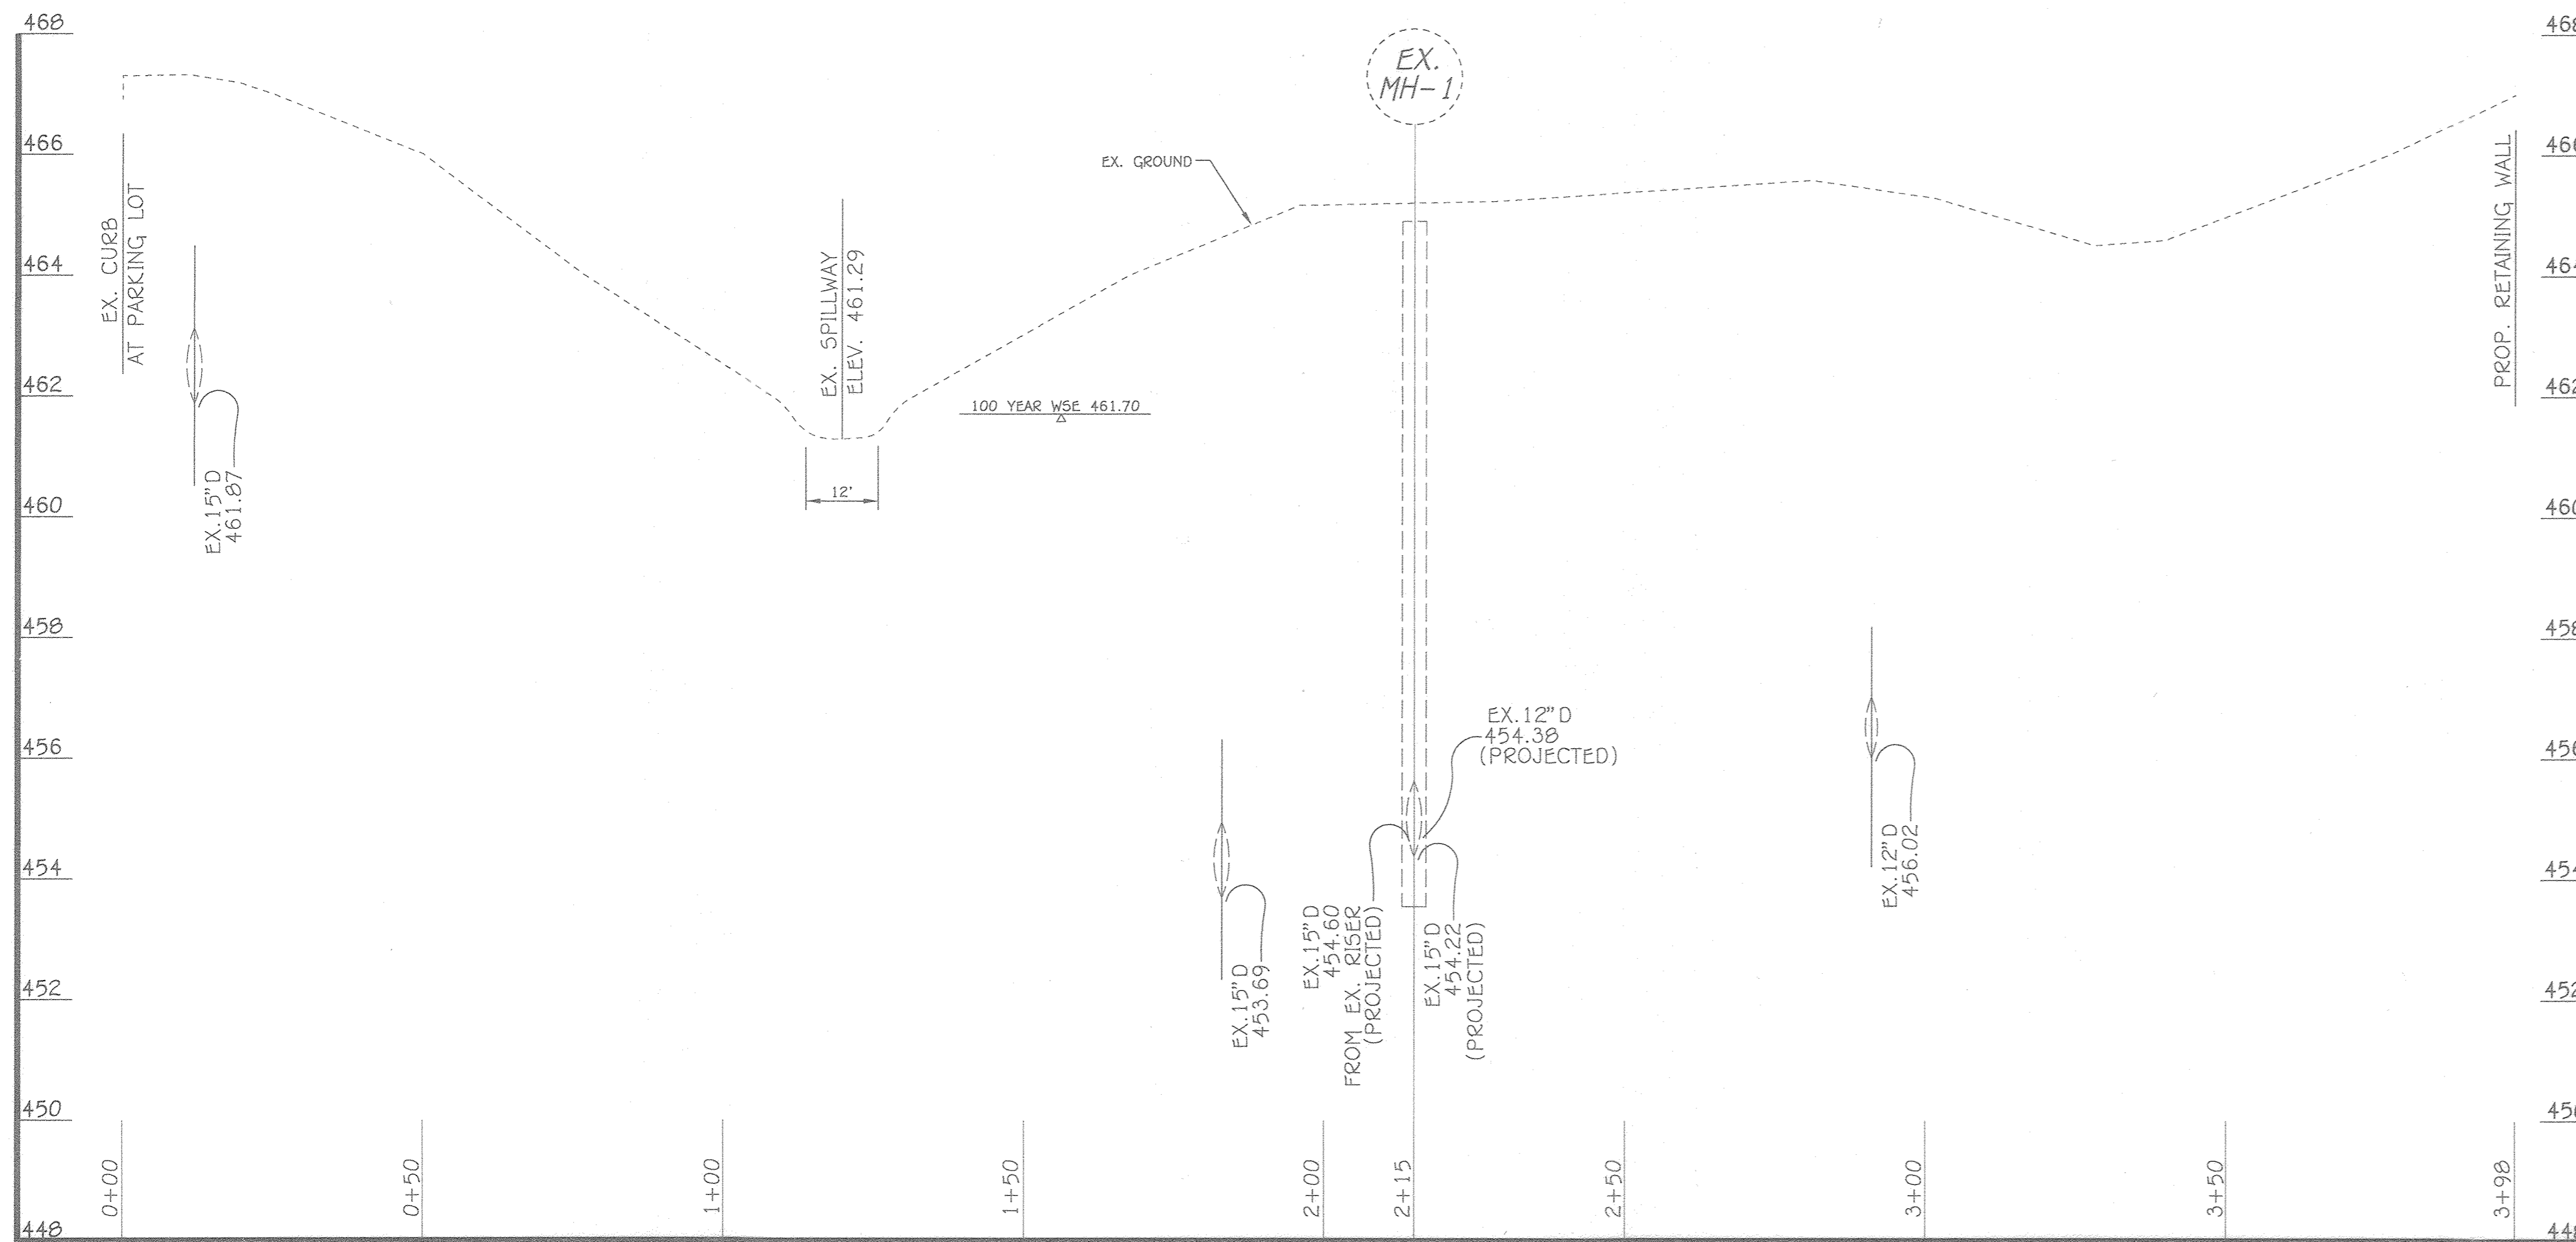

PROFILE ALONG CL EXISTING EMBANKMENT

FISHER, COLLINS & CARTER, INC.
 CIVIL ENGINEERING CONSULTANTS & LAND SURVEYORS
 CENTRAL SQUARE OFFICE PARK - 10772 BALTIMORE NATIONAL PIKE
 ELLETTTS CITY, MARYLAND 21046
 (410) 461-2295

*PROFESSIONAL CERTIFICATION. I HEREBY CERTIFY THESE DOCUMENTS WERE PREPARED OR APPROVED BY ME, AND THAT I AM A DULY LICENSED PROFESSIONAL ENGINEER UNDER THE LAWS OF THE STATE OF MARYLAND, LICENSE NO. 27020, EXPIRATION DATE: 01/25/26.
Paul Gerard Cavanaugh
 PAUL GERARD CAVANAUGH
 DATE: Jan 15, 2024

DATE: _____ DESCRIPTION: _____ REVISION BLOCK: _____
 APPROVED: DEPARTMENT OF PLANNING AND ZONING
Maura Kendall Fox 2/16/24
 Director, Department of Planning and Zoning
 Chief, Division of Land Development
 Chief, Development Engineering Division

OWNER/DEVELOPER
 PREPARED FOR
 HOWARD COUNTY PUBLIC SCHOOL SYSTEM
 9020 MENDENHALL COURT
 SUITE 'C'
 COLUMBIA, MARYLAND 21045
 Attention: DANIEL LUBBELEY
 410-313-8203



ADDRESS CHART					
PARCEL NO.	STREET ADDRESS				
69	OLD CEDAR LANE SPECIAL ED CENTER SUITE 'C' COLUMBIA, MARYLAND 21044				
PROJECT	SECTION/AREA				
OLD CEDAR LANE SPECIAL ED CENTER	6/2				
TAX MAP NO.	BLOCK NO.	ZONE	TAX MAP	ELEC. DIST.	CENSUS TR.
-	17.23	NT	29	FIFTH	605502

PROFILES
OLD CEDAR LANE SPECIAL EDUCATION CENTER
 VILLAGE OF HARPER'S CHOICE
 SECTION 6 AREA 2
 ZONED: NEW TOWN
 TAX MAP No.: 29 GRID No.: 17.23 PARCEL No.: 69
 FIFTH ELECTION DISTRICT HOWARD COUNTY, MARYLAND
 SCALE: AS SHOWN DATE: JANUARY, 2024
 SHEET 21 OF 21