


HOWARD COUNTY DESIGN MANUAL VOLUME IV  
STANDARD SPECIFICATIONS AND DETAILS FOR  
CONSTRUCTION (DRAWING R-201)

**P-3 PAVING**  
NOT TO SCALE

- GENERAL NOTES**
1. Topography taken from field run topo prepared by Hudkins Associates.
  2. Recording references: Plats 13535 & 13536 (F99-18)
  3. Public Water and Sewer facilities are being utilized.
  4. Existing zoning - New Town - open space
  5. Final Development Plan Phase FDP 4-A-IV
  6. Total area = 10.198 AC.

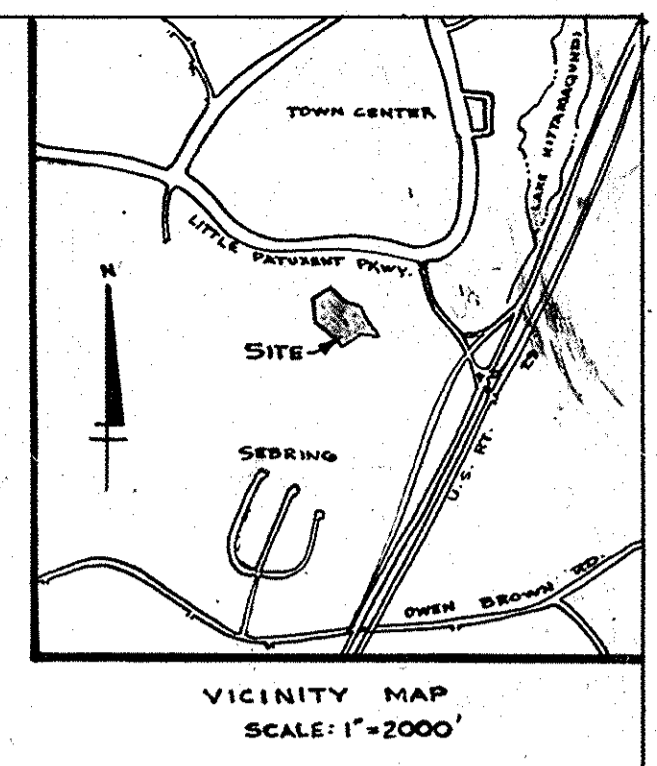

**REVISIONS 25 MARCH 1982**


1. ADD 10' X 20' WALK-IN REFRIG ADJ. TO BLDG 1
  2. ADD 10' X 15' WALK-IN REFRIG ADJ. TO BLDG 4
  3. ADD NEW 19' X 22' BLDG 5
  4. ADD NEW 15' X 35' BLDG 6
  5. BLDG 1 BECOMES BLDG 3
  6. BLDG 3 BECOMES BLDG 1
  7. REPLACE STAIRS W/ RAMP BLDG 3
- NEW BLDG. INDICATION  
LIMIT OF SUBMISSION & CONSTRUCTION  
ADD. S.E. OR 0.032 ACRES

ARCHITECTURAL REGISTRATION BOARD  
2507-R  
STATE OF MARYLAND

LYNWOOD E. BROWN, AIA  
AND ASSOC., INC.  
1220 PRINCE STREET  
ALEXANDRIA, VA 22314

For Revision 1  
*J. Brown* 4-20-82

**APPROVED**  
PLANNING BOARD  
OF HOWARD COUNTY  
DATE 4-21-82  
*JMM*

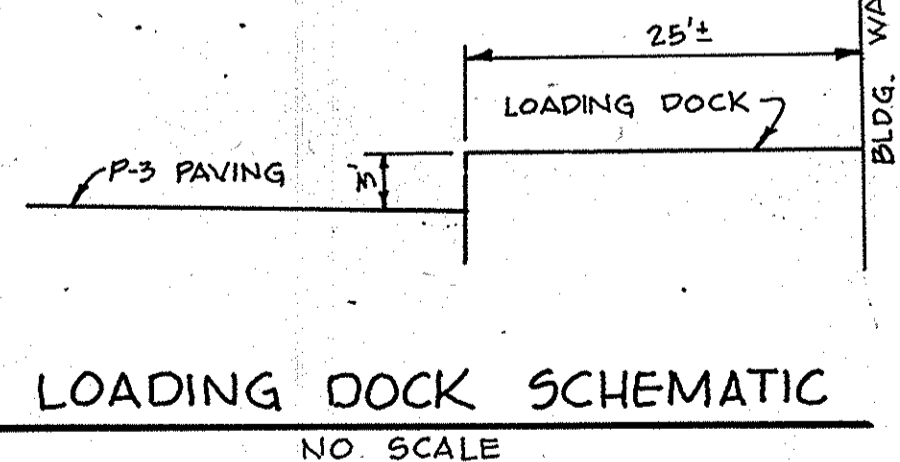

NOTE:  
CONTOURS SHOWN ARE EXISTING. NO GRADING TO BE DONE.

NOTE:  
ADDITIONS BEING POINT OR STRUCTURES BEING REBUILT. NO ADDITIONAL STRUCTURES BEING CONSTRUCTED. BLDG. ADDITS. TO SDP-70-58 & SDP-81-178.

APPROVED FOR PUBLIC WATER AND PUBLIC SEWERAGE SYSTEMS HOWARD COUNTY HEALTH DEPARTMENT.  
*James J. ...* 5-2-82  
COUNTY HEALTH OFFICER DATE

APPROVED: HOWARD COUNTY OFFICE OF PLANNING AND ZONING  
*John W. ...* 5-1-82  
PLANNING DIRECTOR, ACTING DATE

CHIEF, DIVISION OF LAND DEVELOPMENT AND ZONING ADMINISTRATION  
*John W. ...* 5-1-82  
DATE

APPROVED FOR PUBLIC WATER PUBLIC SEWER AND STORM DRAINAGE SYSTEMS AND ROADS, HOWARD COUNTY DEPARTMENT OF PUBLIC WORKS.  
*John F. ...* 4-30-82  
DIRECTOR DATE

*John F. ...* 4-29-82  
CHIEF, BUREAU OF ENGINEERING DATE

**OWNER**  
THE HOWARD RESEARCH & DEVELOPMENT CORP.  
THE ROUSE BUILDING  
10275 LITTLE PATUXENT PARKWAY  
COLUMBIA, MD. 21044

No.	TYPE	LOCATION	INV. IN	INV. OUT	TOP ELEV.	REMARKS
I-1	DBL 'S'	SEE PLAN	317.38	322.20	HC STD. 9D 4-23	

No.	DATE	REVISION
7-19-99		ADDED DECK #4 BEHIND PAVILION
4-1-97		REVISED LOADING DOCK AREA

**COLUMBIA SITE PLAN**  
**TOWN CENTER**  
SECTION 1 LOT 13  
MERRIWEATHER POST PAVILION  
AS-BUILTS (PART)

5TH ELECTION DISTRICT OF HOWARD COUNTY  
SCALE: 1" = 50' DATE:  
TAX MAP 36 SHEET 1 of 1

SDP-82-106c