

NOTES:

- All materials and construction to be in accordance with Howard County Road Construction Code and Specs.
- This plan is covered by Final Development Plan Phase 192-A.
- Any damage to County owned rights of way shall be corrected at the Developer's expense.
- Installation of Traffic Control Devices shall be in accordance with the latest edition of the "Manual of Uniform Traffic Control."
- Topography was compiled by actual field survey.
- All driveways are to be privately owned and maintained.
- All coordinates are based on Howard County Geodetic Control Traverse which is based on the Maryland State Plane Coordinate System.
- Class "C" trench bedding shall be used under all storm drainage, unless shown otherwise.
- Information concerning underground utilities was obtained from available records, but the contractor must determine the exact location and elev. of mains by digging test pits, by hand, at all crossings well in advance of construction.
- All downspout drains shall be handled by one of the following methods:
 - Downspout to splash blocks and discharge to ground having good percolation.
 - Downspout in front of unit, piped to curb.
 - Downspout connected to storm drain.
- The developer agrees to work with The Dept. of Licenses and Inspections to resolve any problems caused by roof water discharge.
- The contractor of developer shall contact the Construction Inspection/Survey Division 24 hrs. in advance of commencement of work at 992.2417, of 792.7272.
- Handicap parking signs shall be provided for each handicap space, in accordance with the Maryland Building Code for the Handicapped "Section 5.01 to 7.05." See details Sht. 2.

LEGEND:

- Contour Interval 2 FT
- Existing Contour 370
- Proposed Contour 370
- Spot Elevation +705
- Direction of Drainage
- Existing Trees to be Saved
- Proposed Storm Drainage 15" RCP

Gravel Infiltration Ditch #3
6' Deep
Bottom Elev. = 358.5
92' x 23.17'


New A-5 Inlet, bottom elev. = 364.00
5 LF 15" RCP CI III

Gravel Infiltration Ditch #4
6' Deep - Bottom Elev. = 360.5
150' x 33.06'



Build Curb Straight Thru for Drainage

SITE ANALYSIS:




- Zoning: New Town (Employment Center Commercial)
- Area: 3.340 Acres
- Parking Requirements:
 - 4.73 Spots @ 1 space / 3 seats = 158
 - 50 Employees @ 1 space / 5 employees = 10 (as per regulation 9d of F.D.P.)
 - TOTAL: 168
- Parking Provided: 191
- Building Coverage: 13.5% sq. ft. 9%
- Total Floor Area of Bldg.: 13.5% sq. ft. 9%
- Open Space to Remain: 5% = 24 sq. ft. and 2%

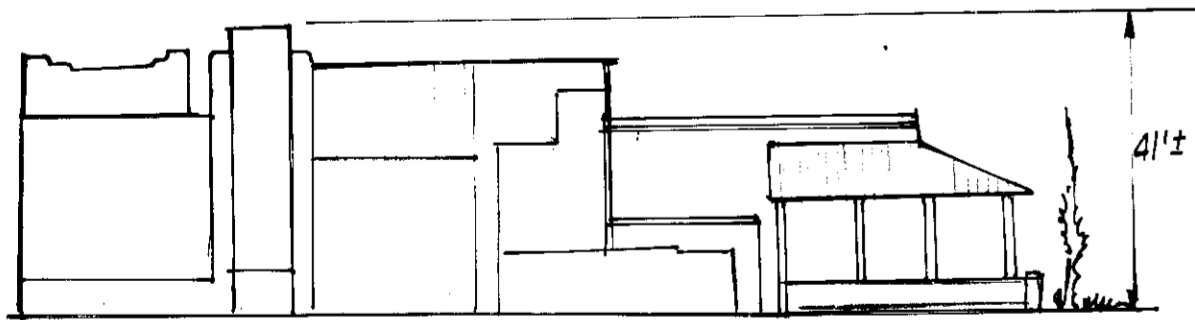

BUILDING ELEVATION
NO SCALE

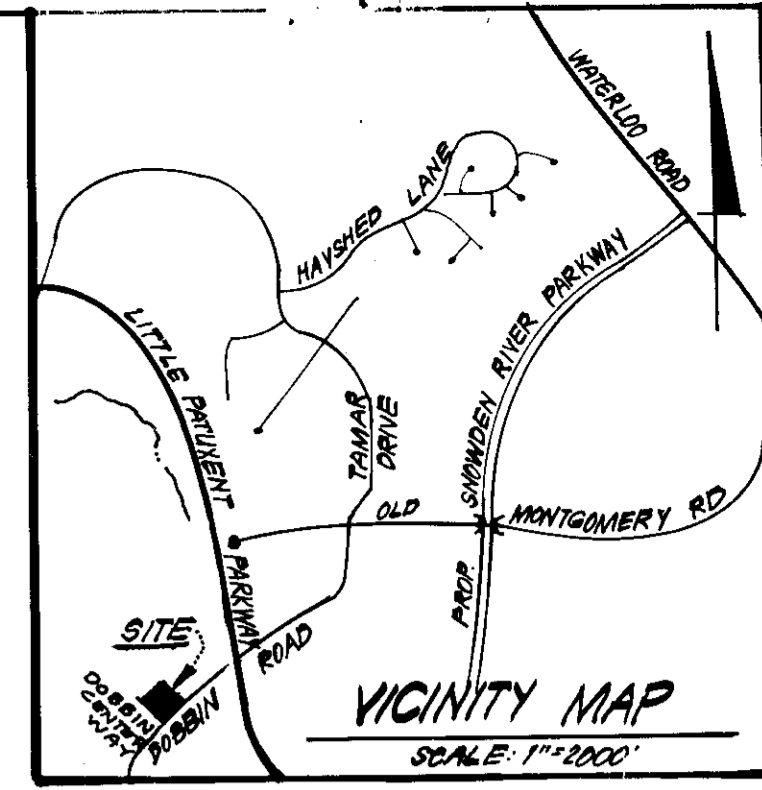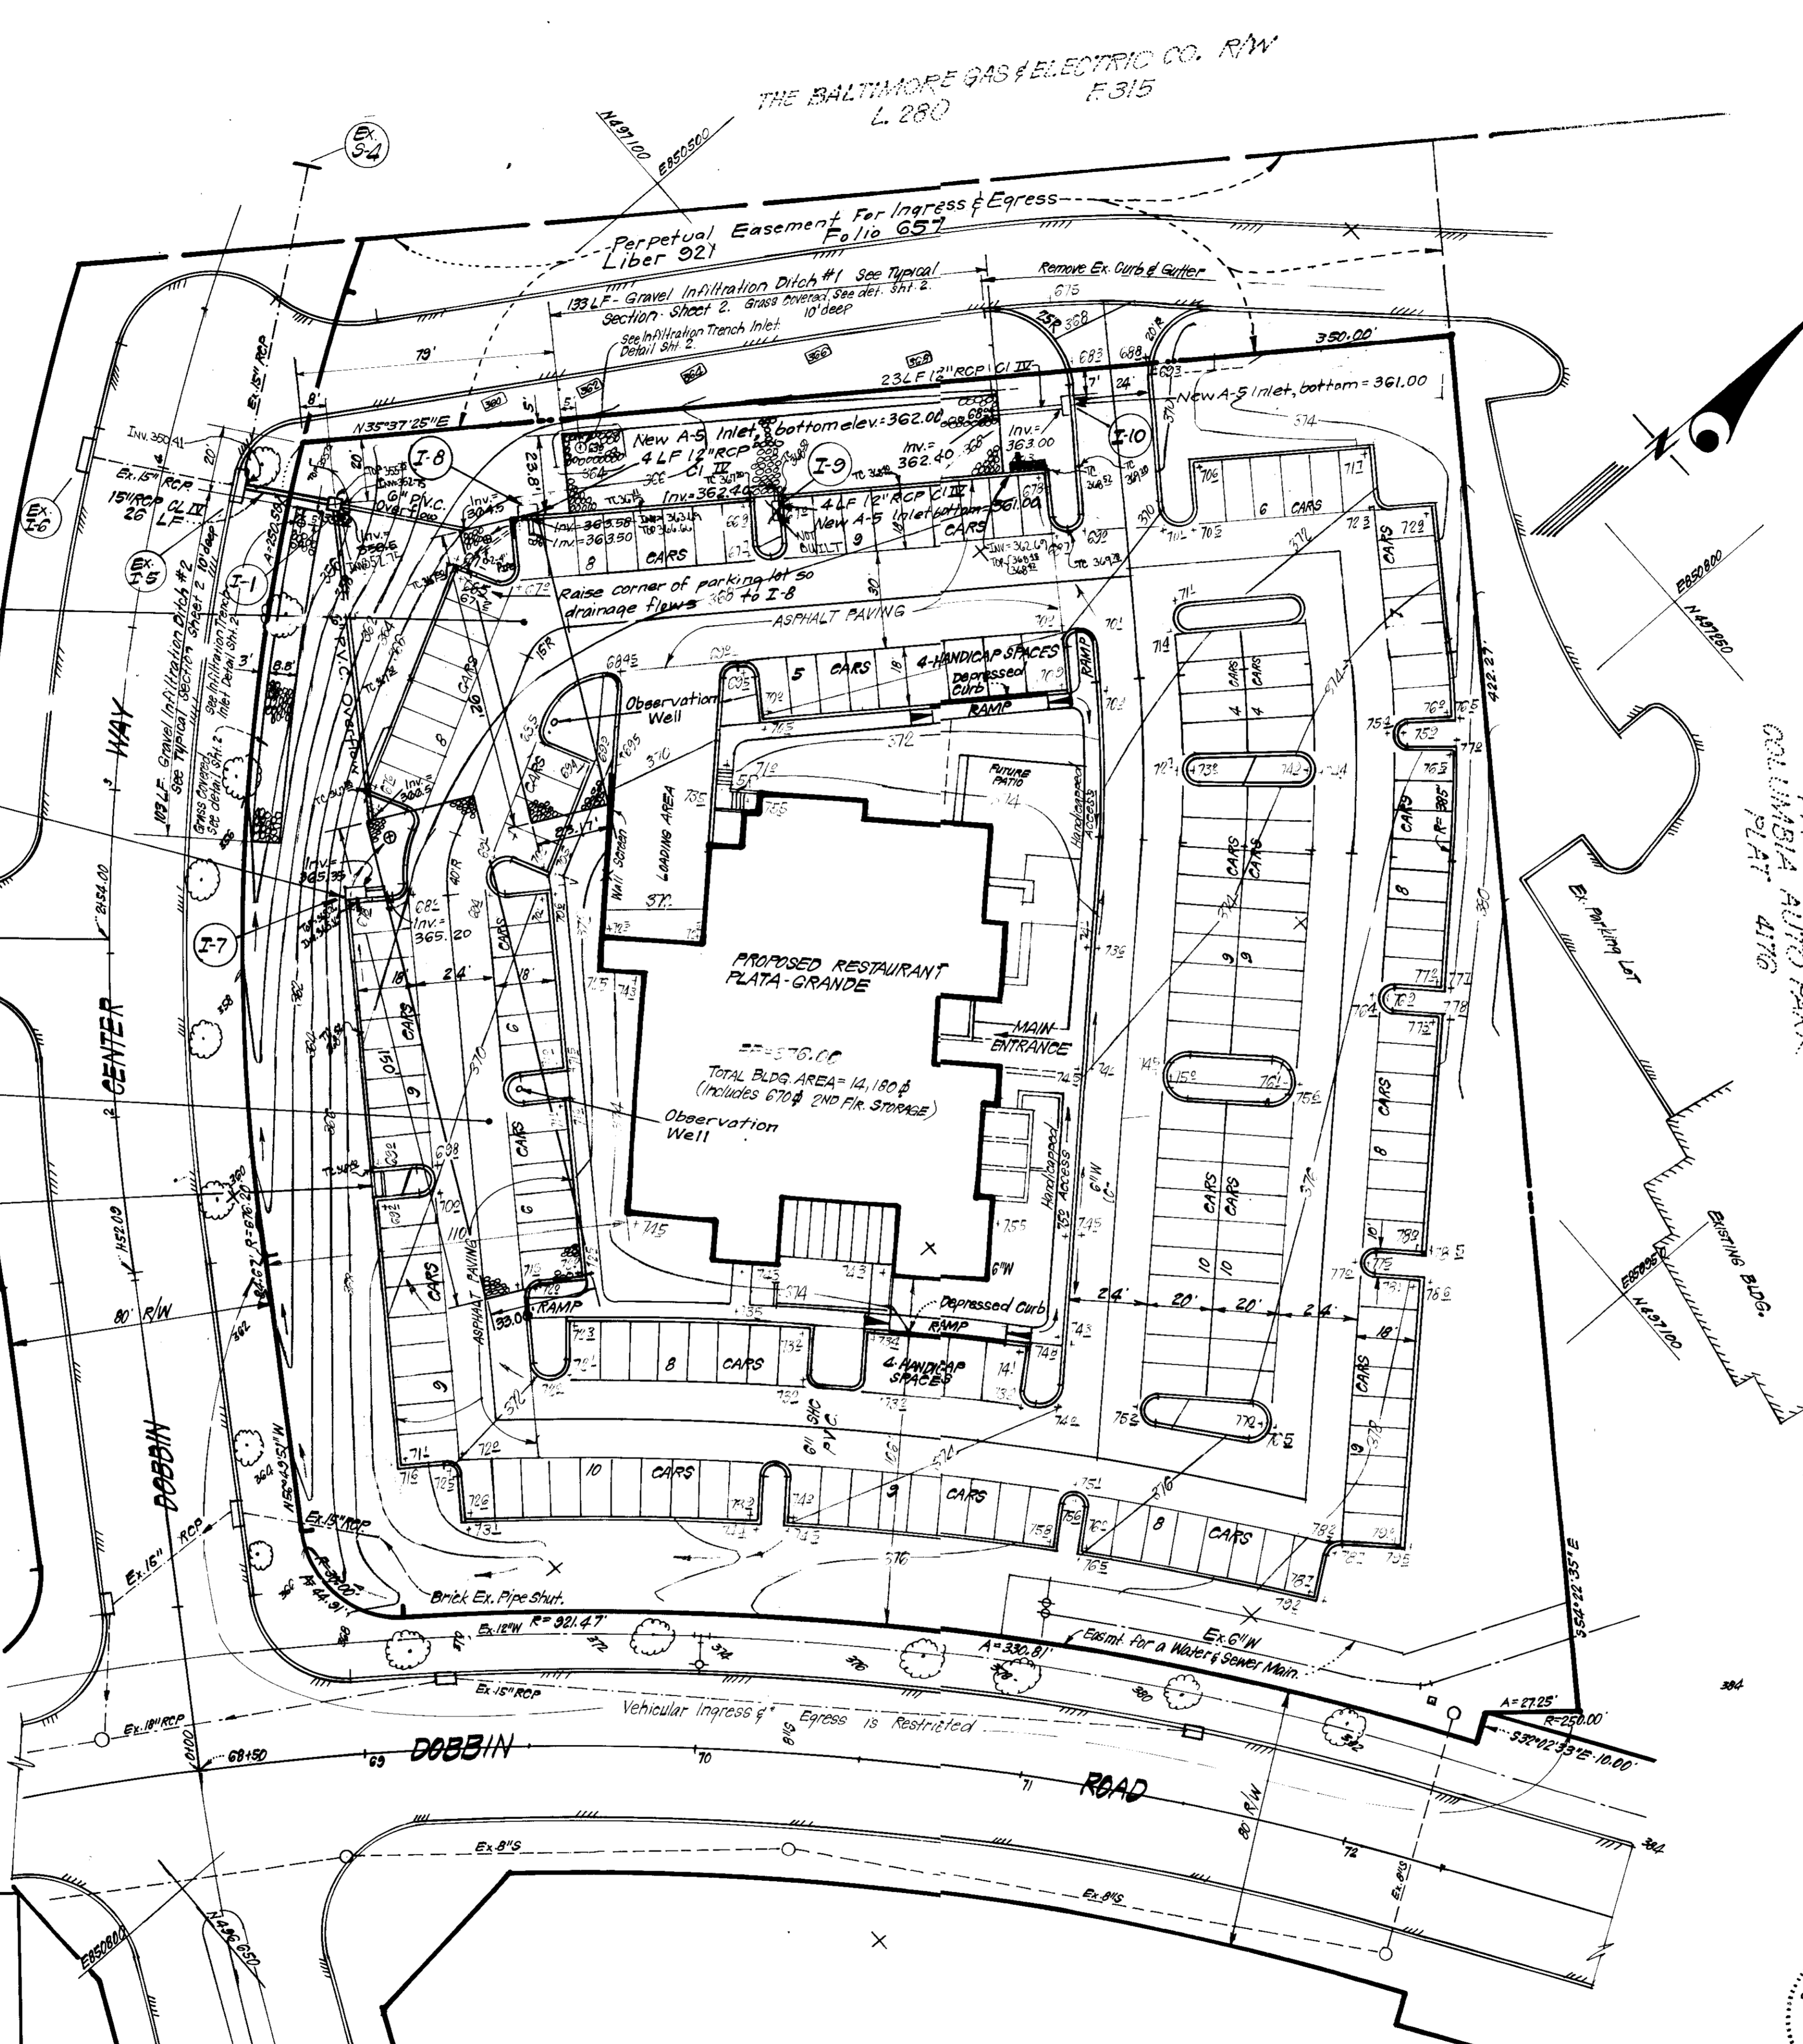

VICINITY MAP
SCALE: 1" = 200'

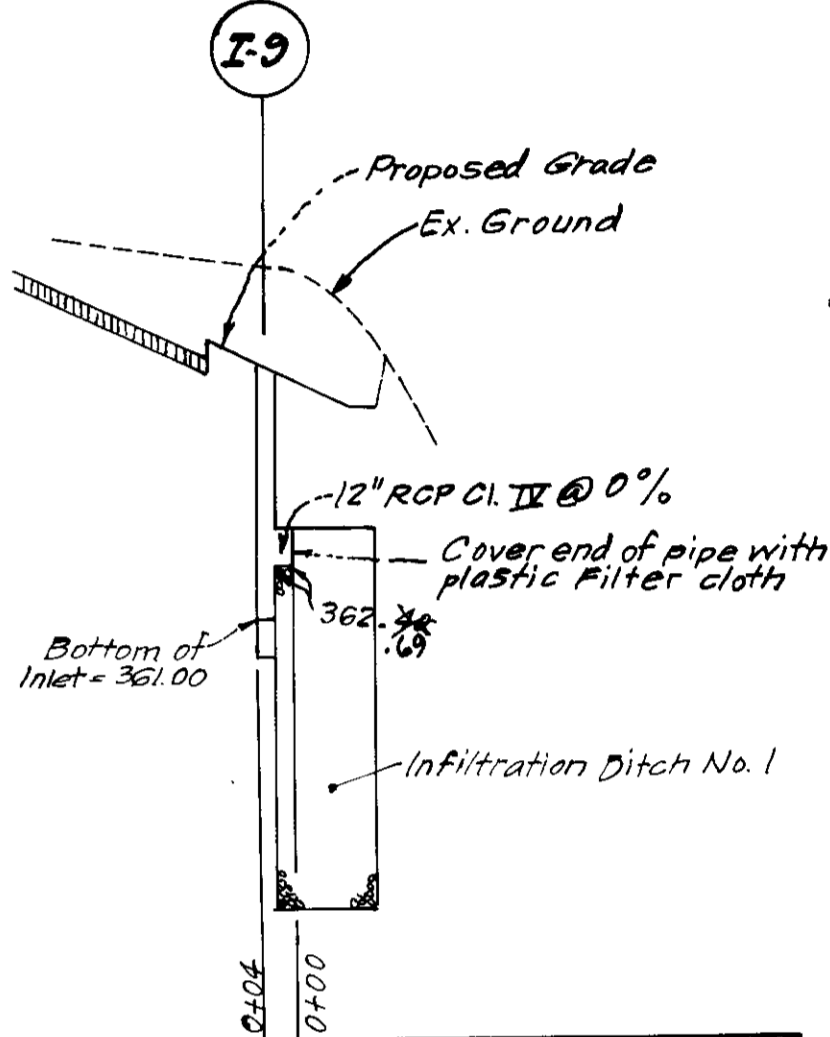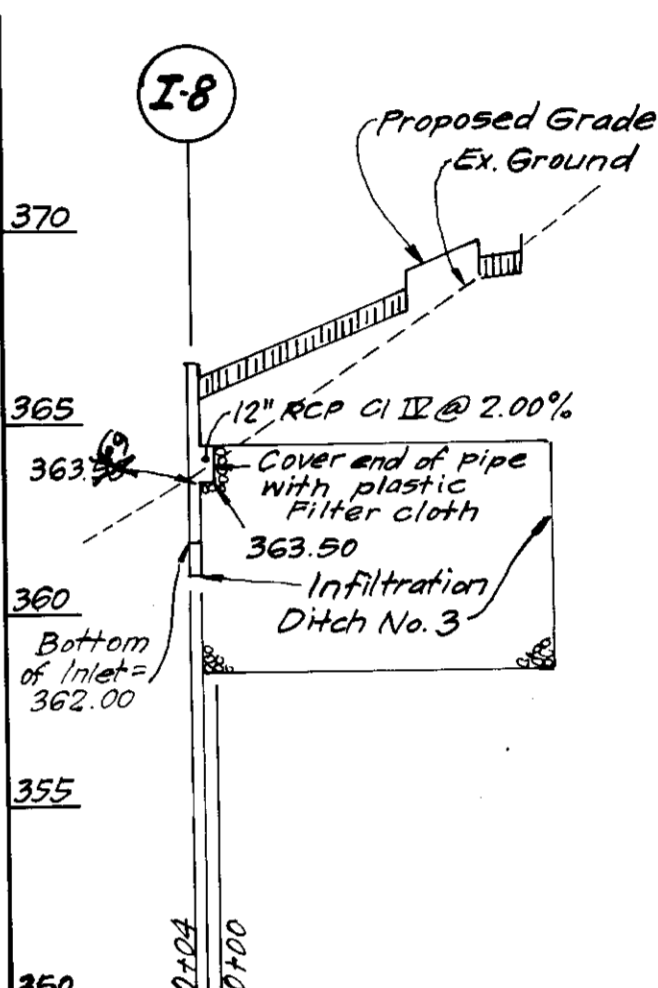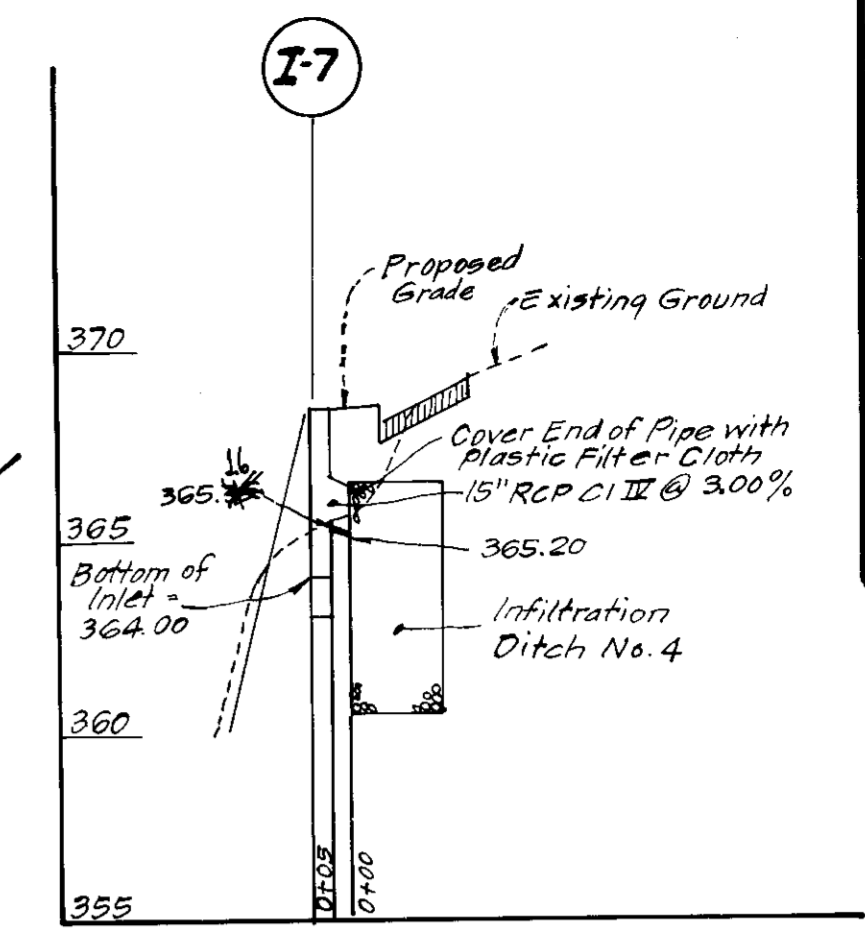

PROFILES

SCALES: HORIZ. 1" = 50'
VERT. 1" = 5'

Rev. Date	Rev. No.	Revision Description
12-10-85	1	Added Infiltration Ditches and Eliminated Porous Paving.
5-7-86	2	Inlets Added & Profiles

AS-BUILT SURVEY CERTIFIED BY
DONALD B. SACKETT, MD. L.S.
NO. 6059 ON 2-20-87.

ADDRESS CHART	
LOT NO.	STREET ADDRESS
PARCEL L-3	6490 DOBBIN CENTER WAY
SUBDIVISION NAME	"COLUMBIA" SEC. 1 AREA LOT/PARCEL L-3
DOBBIN ROAD COMMERCIAL CENTER	1/1 L-3
PLAT FOR L/P PROJECT	DATE: 17/11/84
WATER CODE	SEWER CODE
500	5333-400

APPROVED: FOR PUBLIC WATER AND PUBLIC SEWERAGE SYSTEMS,
HOWARD COUNTY HEALTH DEPARTMENT
COUNTY HEALTH OFFICER: *[Signature]* DATE: 3-4-85

APPROVED: HOWARD COUNTY OFFICE OF PLANNING & ZONING
PLANNING DIRECTOR: *[Signature]* DATE: 3-5-85

CHIEF DIVISION OF LAND DEVELOPMENT (ZONING ADMIN) DATE: 3-5-85

APPROVED: FOR PUBLIC WATER AND PUBLIC SEWERAGE,
STORM DRAINAGE SYSTEMS AND PUBLIC ROADS
HOWARD COUNTY DEPARTMENT OF PUBLIC WORKS
DATE: 4-27-85

ENGINEERING: *[Signature]* DATE: 4-27-85

APPROVED
PLANNING BOARD
OF HOWARD COUNTY
DATE: 11-14-84



[Signature]
10-24-84


OWNER: CARROLLTON ENTERPRISES LTD. PTN.
1700 Beltsville Drive
Beltsville Md. 20705

CLARK · FINEFROCK & SACKETT
ENGINEERS · PLANNERS · SURVEYORS
11315 LOCKWOOD DRIVE SILVER SPRING, MARYLAND 20904 (301) 593-3400

DESIGNED: R.G.B. EP
DRAWN: EP
CHECKED: K.W.
DATE: 10-24-84

SITE DEVELOPMENT PLAN
PARCEL L-3
COLUMBIA
DOBBIN ROAD COMMERCIAL CENTER
SECTION 1 AREA 1
GTHELECTION DISTRICT
HOWARD COUNTY, MD.


SCALE: 1" = 30'
DRAWING: 10F 5
JOB NO.: 84-054
DATE: 10-24-84

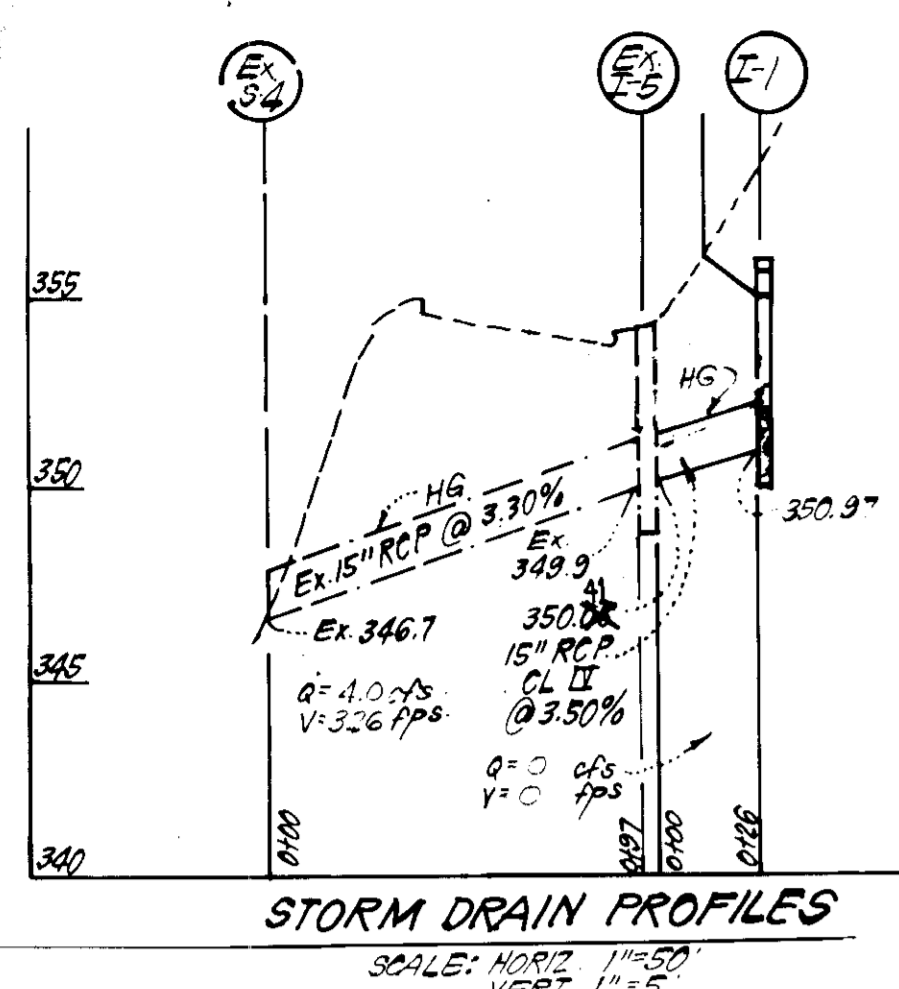



PIPE SCHEDULE			
SIZE	TYPE	LENGTH	
18"	RCP	CL II	26 LF

STRUCTURE SCHEDULE						
No.	TYPE	INV. IN	INV. OUT	TOP ELEVATION UPPER LOWER	REMARKS	LOCATION
E-1	D 12" Top	355.75	355.37	355.37	No. Co. Std. SD 4.11	See Plan
E-7	A-5 Inlet	362.76	362.35	362.35	No. Co. Std. SD 4.01	See Plan
E-8	A-5 Inlet	362.76	362.35	362.35	No. Co. Std. SD 4.01	See Plan
E-9	A-5 Inlet	362.76	362.35	362.35	No. Co. Std. SD 4.01	See Plan
E-10	A-5 Inlet	362.76	362.35	362.35	No. Co. Std. SD 4.01	See Plan

* Openings in all 4 sides
All inverts to be fully developed
(or Parking Lot Paving)

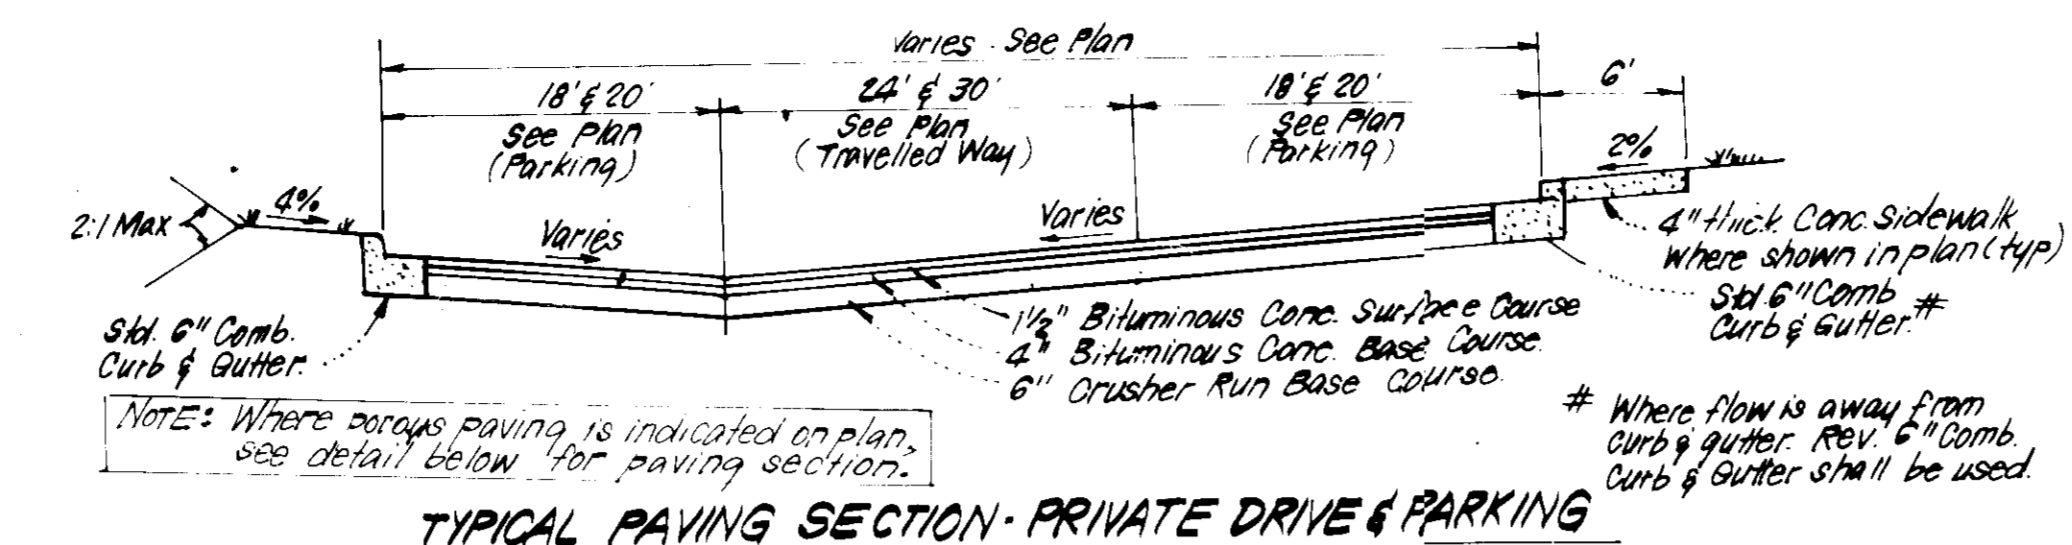





Notes:
1. Longitudinal joint between sidewalk & curb shall be continuous and to a depth of 1/4 the thickness of the sidewalk or 1" Latitudinal Joints shall run from back edge of sidewalk continuous to the bottom face of curb to a depth of 1/4 the sidewalk thickness or 1" and spaced 5' apart.
2. Provide 1/2" expansion joints at 15' intervals. In latitudinal joints to full cross-section.

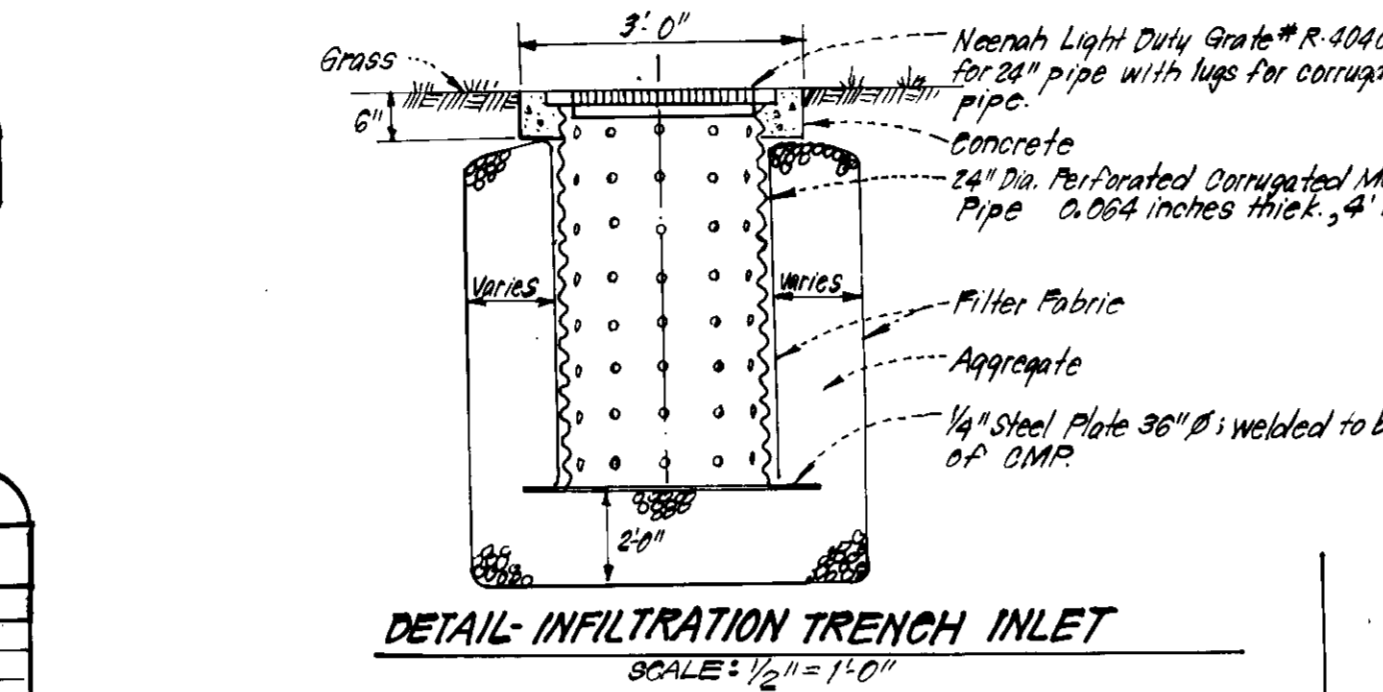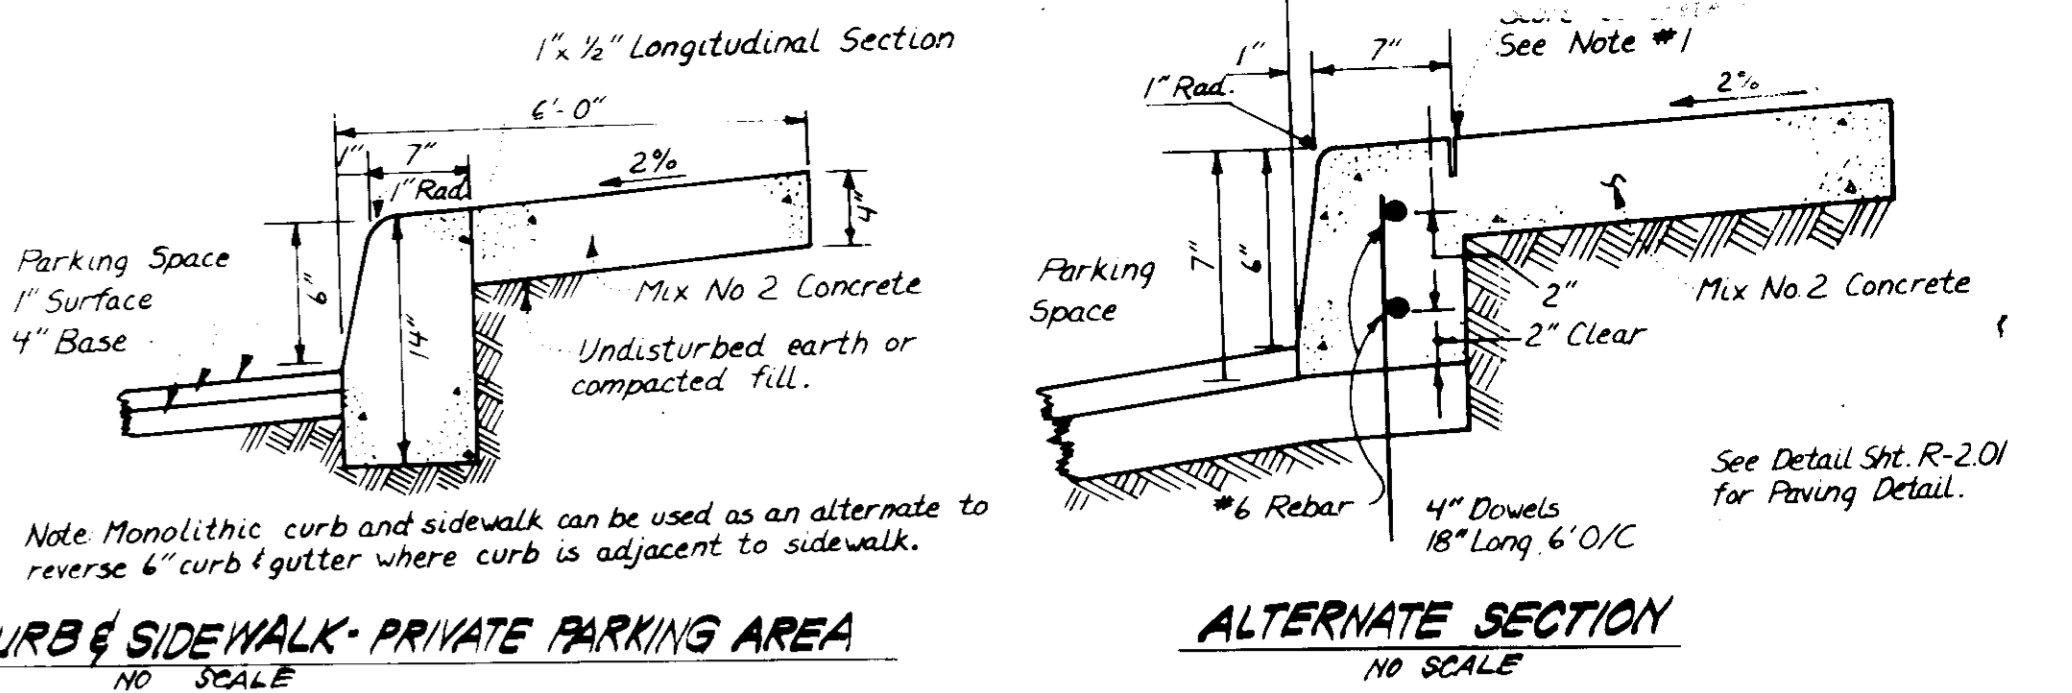

Rev. Date	Rev. No.	Revision Description
12-19-85	1	Added Infiltration Ditches and Eliminated Porous Paving.
5-8-86	2	Profile Added for Inlet I-10.

CONSTRUCTION METHODS & SPECIFICATIONS FOR POROUS ASPHALT PAVING






- STABILIZATION**
To preclude premature clogging and/or failure of this practice, porous asphalt paving structures shall not be placed into service until all of the surface drainage areas contributing to the pavement have been effectively stabilized in accordance with Maryland Standards and Specifications for Soil Erosion and Sediment Control.
- SUBGRADE PREPARATION**
A. Alter and refine the grades as necessary to bring subgrade to required grades & sections as shown on drawings.
B. The type of equipment used in subgrade preparation construction shall not cause undue subgrade compaction. (Use tracked equipment or oversized rubber tire equipment - DO NOT use standard rubber-tired equipment)
Traffic on subgrade shall be kept at a minimum. Where fill is required, it shall be compacted to a density equal to the undisturbed subgrade, and inherent soft spots corrected.
- AGGREGATE BASE COURSE**
A. All stone used shall be cleaned, washed, crushed stone, meeting Howard County Specifications.
B. Aggregate shall be of two sizes: the reservoir base course shall be to depth as noted on drawings of aggregate (max. of 1" min. of 1/2") and a 2" deep top course of 1/2" aggregate (max. of 5/8" min. 3/8").
C. Aggregate base course shall be laid over a dry subgrade covered with engineering filter fabric to a depth shown on drawings. No lifts to lay naturally compacted. The stone base course shall be compacted lightly. Keep the base course clean from debris, and sediment.
- POROUS ASPHALT SURFACE COURSE**
A. The surface course shall be laid directly over the 1/2" aggregate base course and shall be laid in one lift.
B. The laying temperature shall be between 230° and 260°, with min. air temp. of 50° to make sure that the surface does not cool prior to compaction.
C. Compaction of surface course shall be done while the surface is cool enough to resist a 10-ton roller. One or two passes by the roller is all that is required for proper compaction. More rolling could cause a reduction in the surface course porosity.
D. Mixing plant shall certify the aggregate mix and absorption loss factor and the asphalt content in the mix. The asphaltic mix shall be tested for its resistance to stripping by water using ASTM D 1664. If the estimated coating area is not above 75%, anti-stripping agents shall be added to the asphalt.
E. Transporting of mix to site shall be in clean vehicles with smooth dump beds that have been sprayed with a non-petroleum release agent. The mix shall be covered during transportation to control cooling.
F. Mix of asphalt shall be 5.5 to 6 percent of weight of dry aggregate.
G. Aggregate grading shall be a specified on Table 3.3.
- PROTECTION**
After final rolling, no vehicular traffic of any kind shall be permitted on the pavement until cooling and hardening has taken place, and in no case less than 6 hours (preferably a day or two).
- WORKMANSHIP**
A. Work shall be done expeditiously throughout and without staining or damage to other permanent work.
B. Make transition between existing and new paving work neat and flush.
C. Finished paving shall be even, without pockets, and graded to elevations shown.
D. Iron smoothly to grade, all minor surface projections and edges adjoining other materials.
- CERTIFICATION**
An appropriate professional registered in the state of Maryland, shall certify that these specifications were complied with.

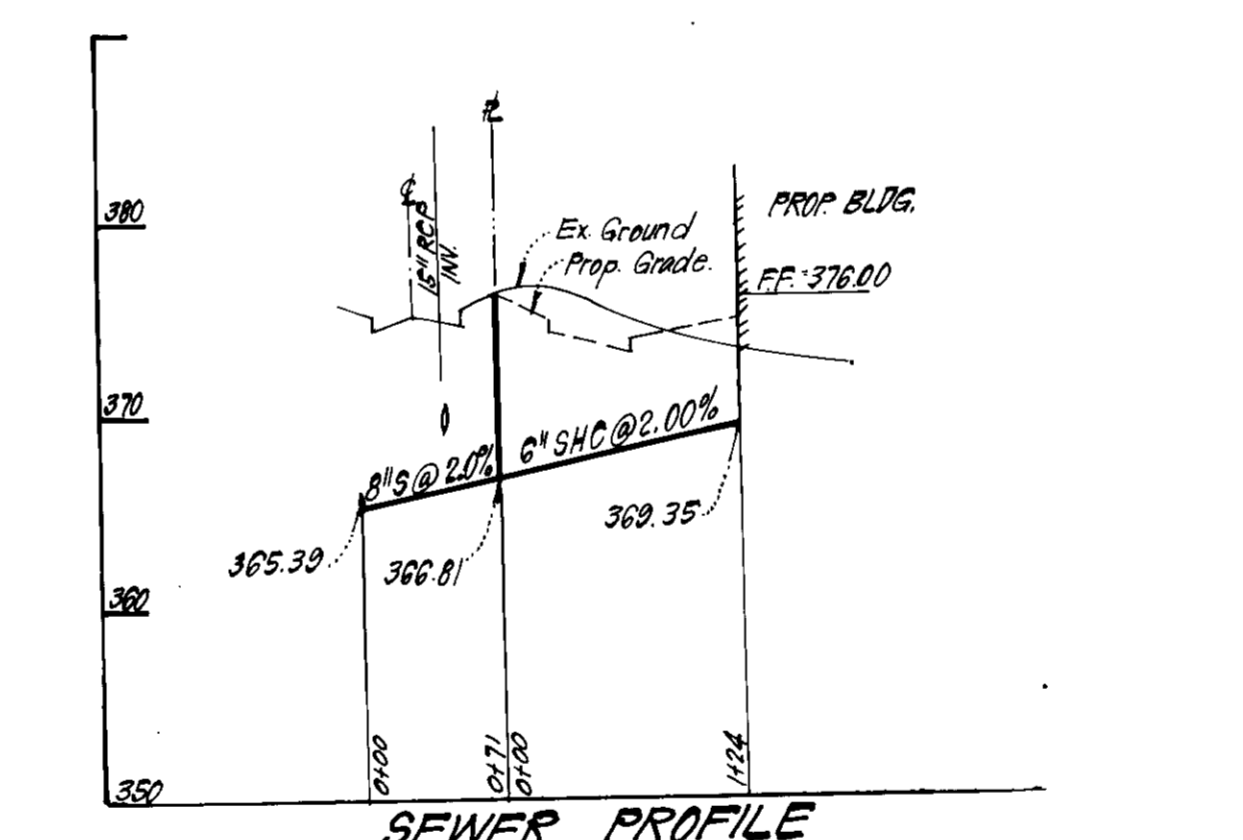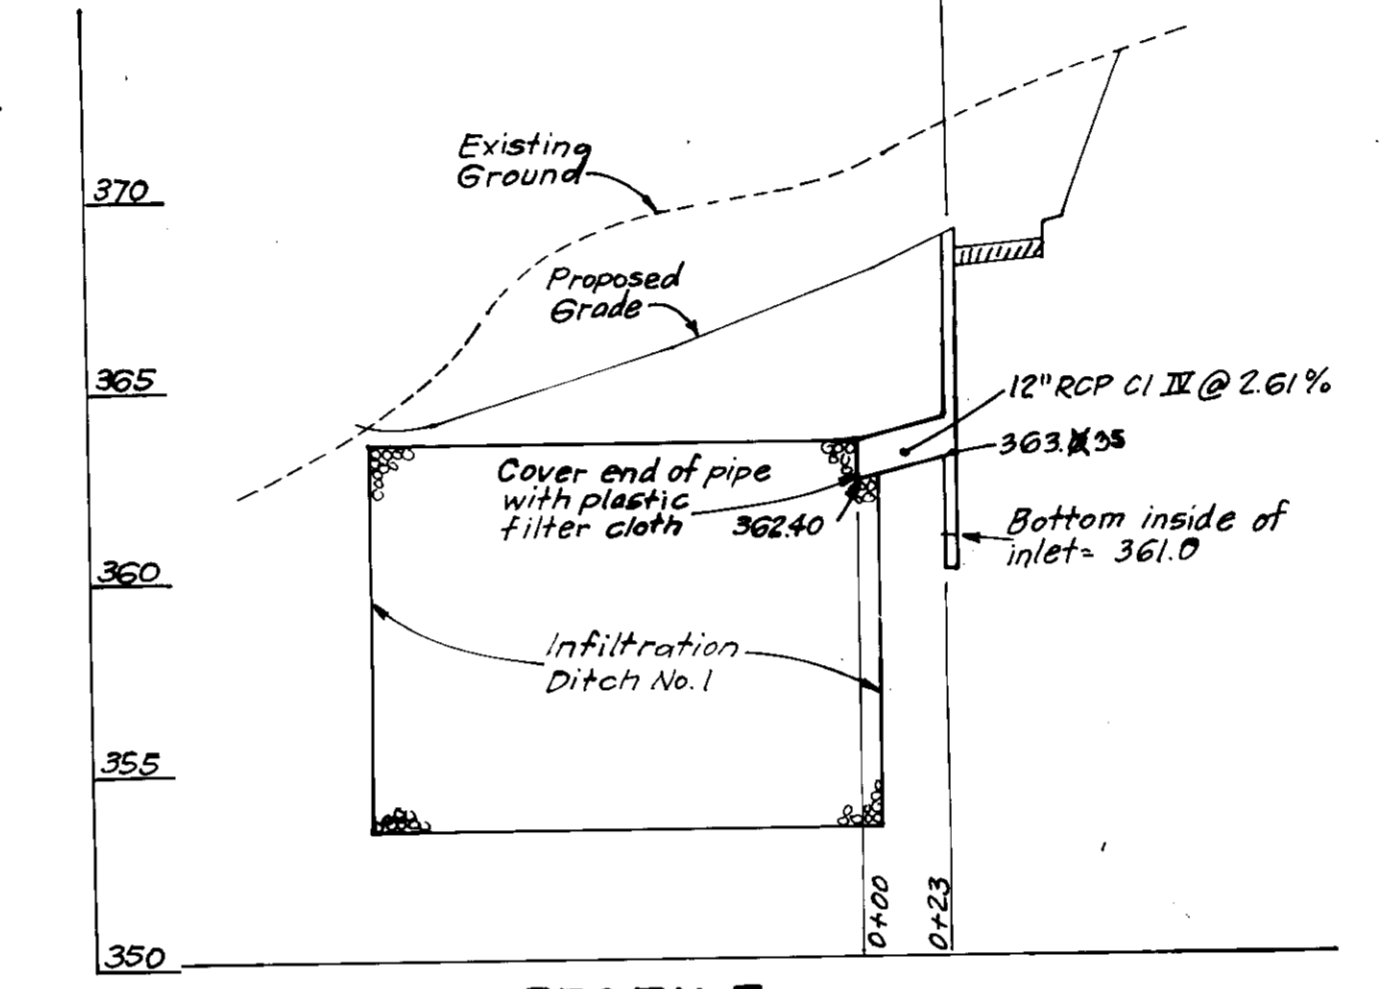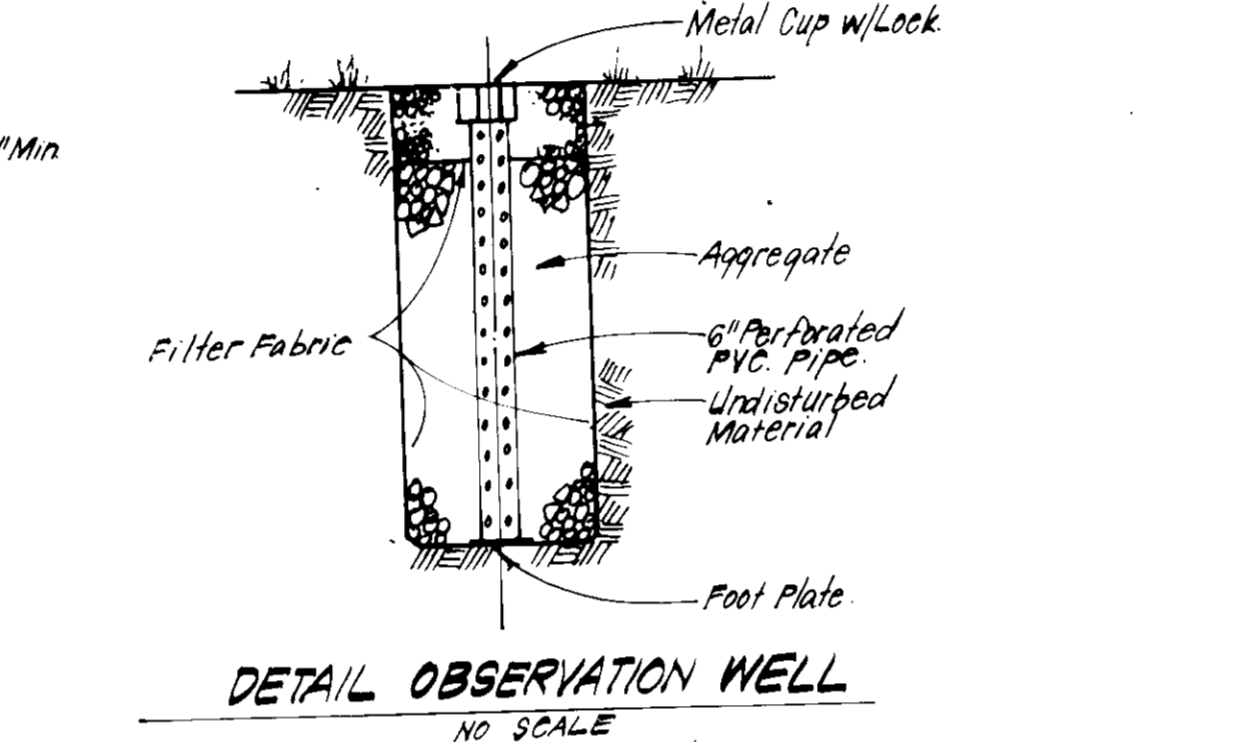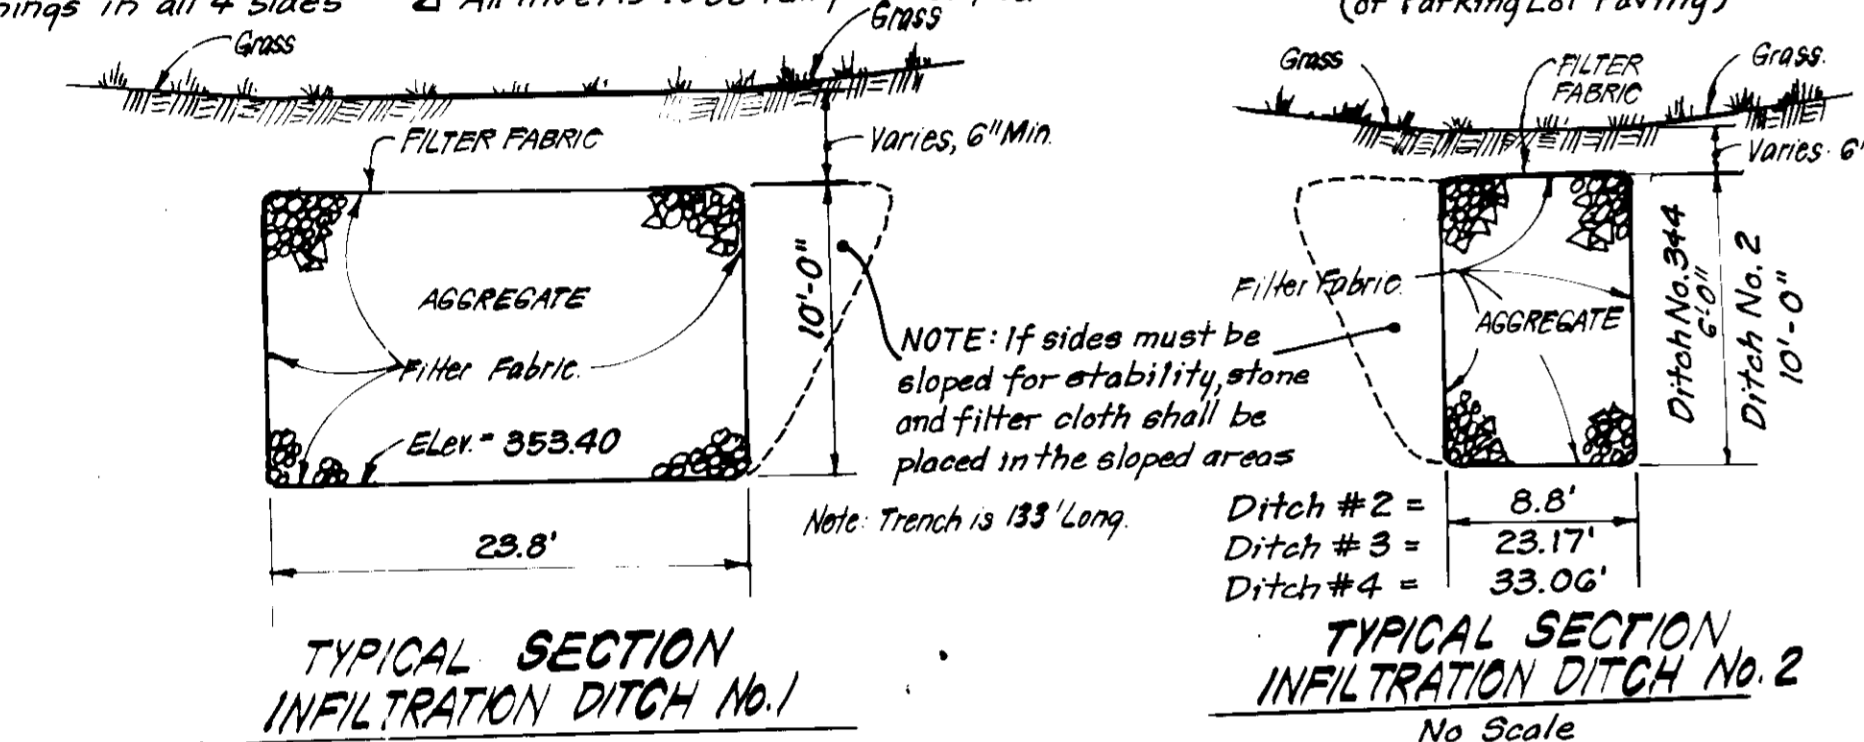

POROUS (OPEN-GRADED) ASPHALT CONCRETE FORMULATION

MATERIAL	SCREEN	WEIGHT %	VOLUME %	PROBABLE PARTICLE DATA		
				WIDTH, mm	WEIGHT, %	No. IN 100g. of ASPHALT CONC.
AGGREGATE	Through 1/2"	2.8	2.2	10.7	1.667	1.7
	Through 3/8"	59.6	46.3	8.0	6.97	85.5
	Through #4	17.0	13.3	4.0	.087	135.4
SUB-TOTAL---		79.4	61.8			282.6
ASPHALT	Through #8	2.8	2.2	2.0	0.0109	25.6
	Through #16	10.4	8.0	1.0	0.0036	7647.0
	Through 200	1.9	1.5	0.06	0.000294	6462.0
TOTAL		93.7	71.3			

AS-BUILT SURVEY CERTIFIED BY
DONALD B. SACKETT MD. L.S.
NO. 60379 ON 7-20-87

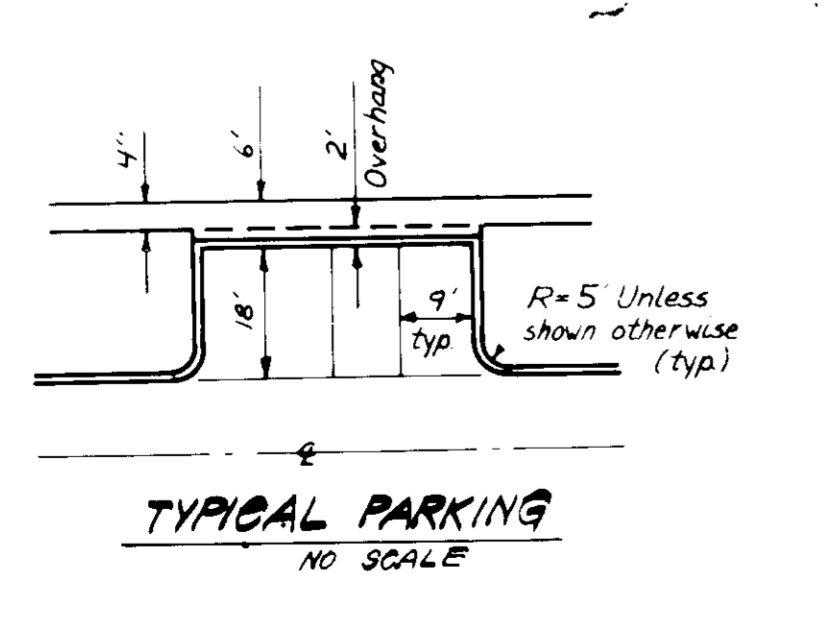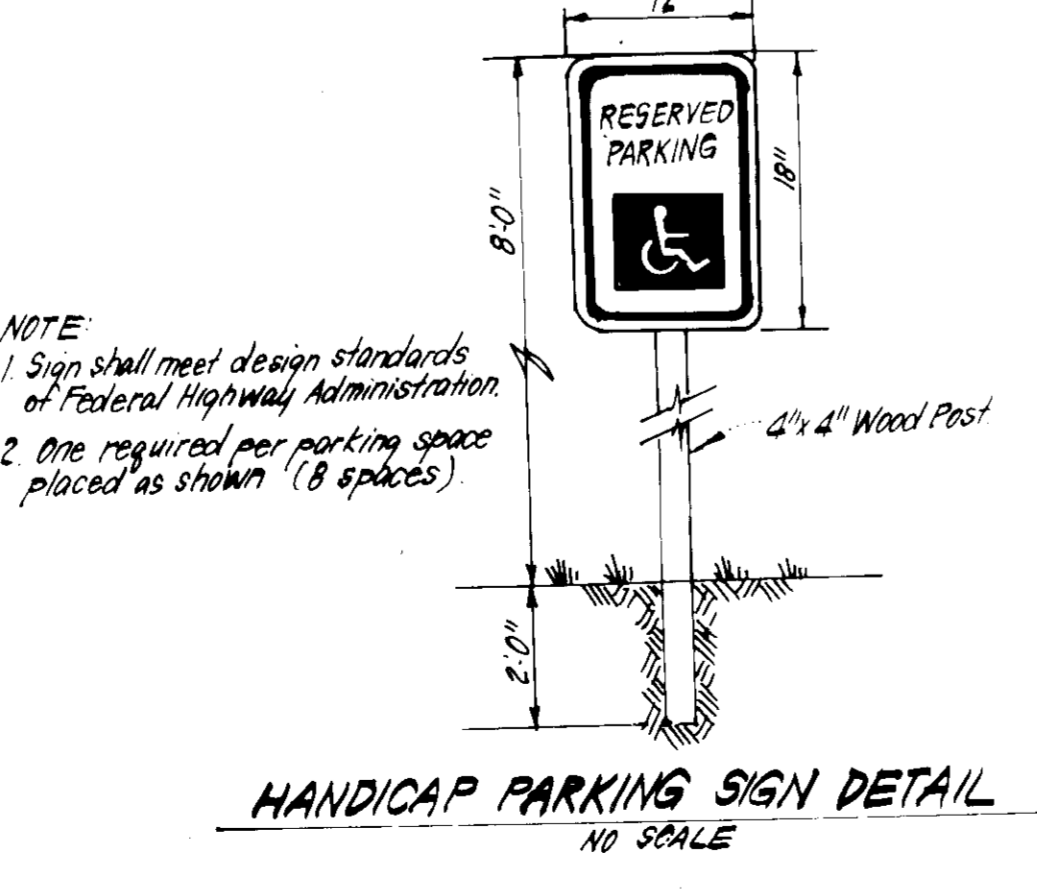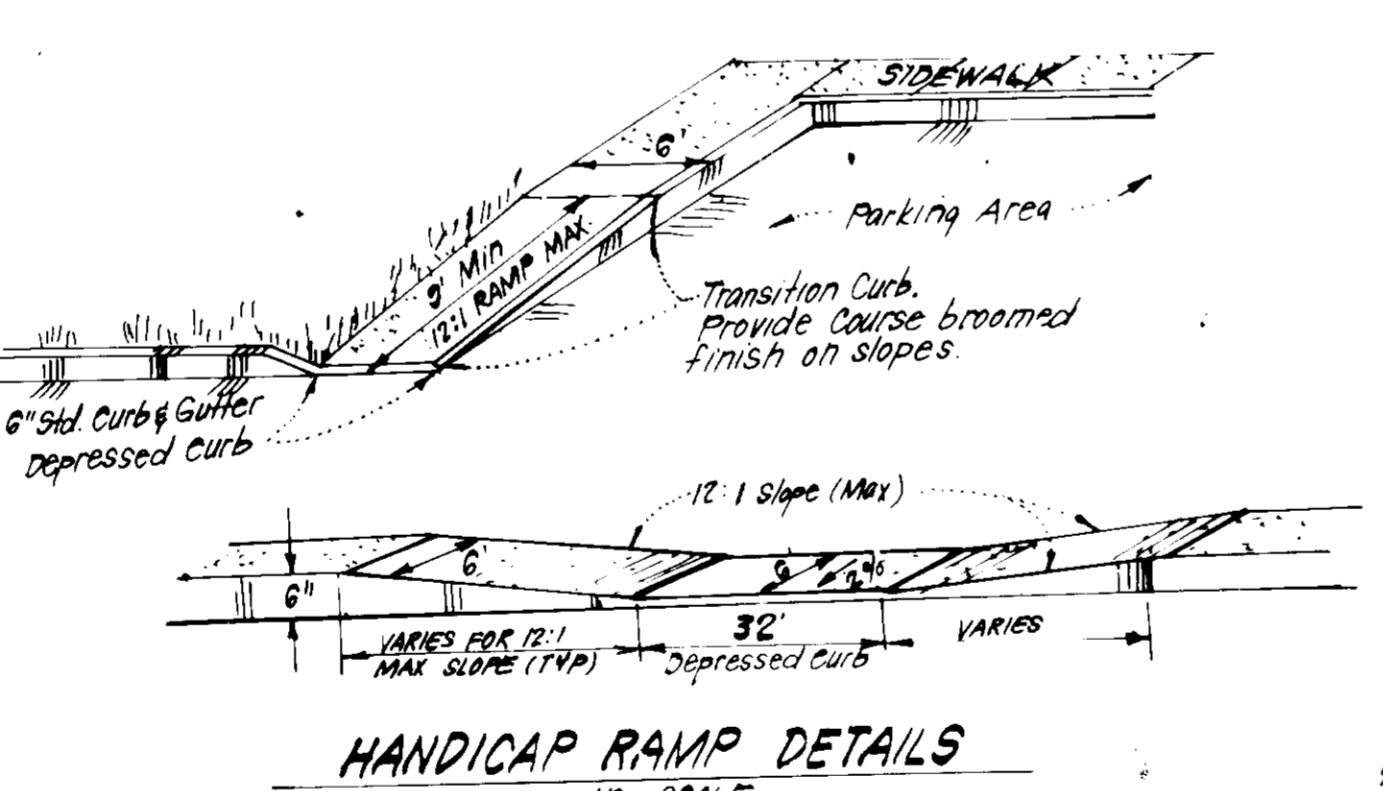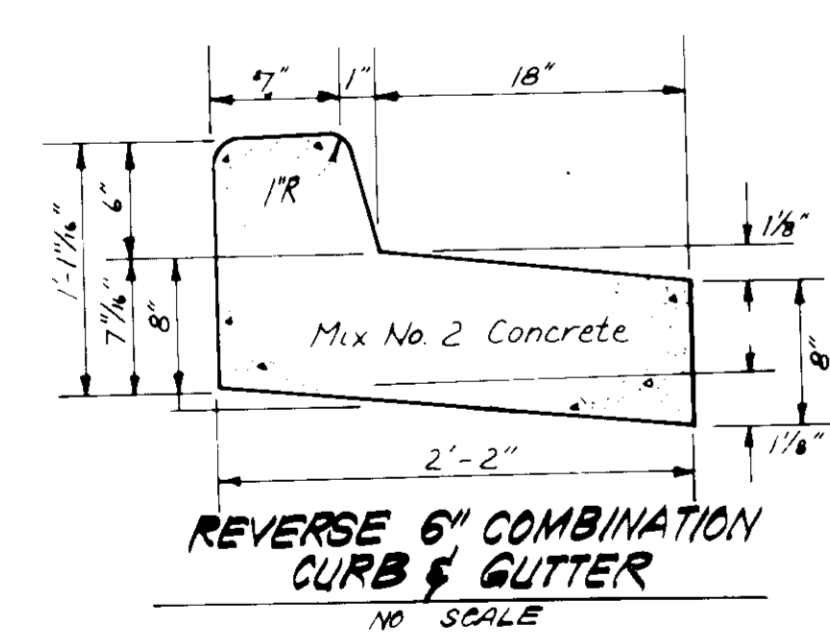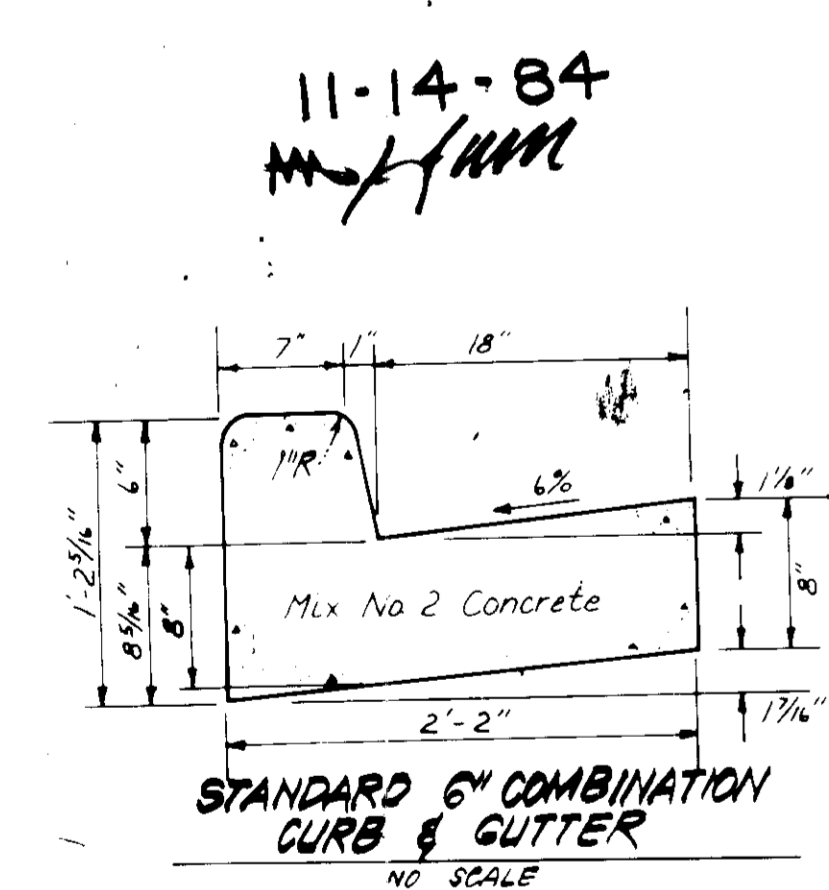

APPROVED: FOR PUBLIC WATER AND PUBLIC SEWERAGE SYSTEMS, HOWARD COUNTY HEALTH DEPARTMENT
DATE: 3-4-85

APPROVED: HOWARD COUNTY OFFICE OF PLANNING & ZONING
DATE: 3-5-85

APPROVED: FOR PUBLIC WATER AND PUBLIC SEWERAGE, STORM DRAINAGE SYSTEMS AND PUBLIC ROADS, HOWARD COUNTY DEPARTMENT OF PUBLIC WORKS
DATE: 2-27-85

WATER AND SEWER NOTES:
1. All sewer mains shall be PVC, CSPX, VCPX or ACP, Class 2000 except where indicated.
2. All construction methods and materials for on-site private water & sewer systems shall follow the current edition of the Howard County Plumbing Code, supplemented by the Howard County Std. Details & Specs. where necessary.
3. All water mains shall be ductile iron pipe.
4. All water mains shall have a min. of 3.5' of cover.
5. Block all fittings with concrete.
6. Sewer house connections shall be built to within 5' of buildings, at a slope of 2.0%.
7. Areas where water house connections are to be built shall be at final grade and connections shall be laid with a min. of 3.5' of cover.

STATE OF MARYLAND
DONALD B. SACKETT
REGISTERED PROFESSIONAL ENGINEER
No. 7136

CLARK · FINEFROCK & SACKETT
ENGINEERS · PLANNERS · SURVEYORS

11317 LOCKWOOD DRIVE • SILVER SPRING, MARYLAND 20904 • (301) 593-3400

DESIGNED: EP
DRAWN: EP
CHECKED: KIN
DATE: 10-24-84

SCALE: AS SHOWN
DRAWING: 2 OF 5
JOB NO.: 84-054
FILE NO.: 84-054

OWNER: CARROLLTON ENTERPRISES LTD. P.M.
11700 BELTSVILLE DRIVE
BELTSVILLE MD. 20705

FOR: CARROLLTON ENTERPRISES
11700 BELTSVILLE DRIVE
BELTSVILLE MD. 20705


SDP-85-56c

AS-BUILT 2-20-87

CONSTRUCTION SEQUENCE

1. Obtain Permit.
2. Install Sediment Control Devices.
3. Clear Rough Grade Site, excluding Trap #1.
4. Install base course of asphalt paving, excluding areas of porous paving.
5. Stabilize all disturbed areas outside of building area and sediment controls.
6. Construct Building.
7. Install Storm Drainage.
8. Convert Trap #1 from G.O.S.T. to S.I.S.T.
9. Install Water & Sewer Connections.
10. Stabilize all disturbed areas.
11. Remove sediment control devices with approval of SCS inspector.
12. Grade area occupied by trap #1.
13. Install Storm Infiltration devices and stone base for porous paving.
14. Place porous asphalt paving and final pavement course.

LEGEND:

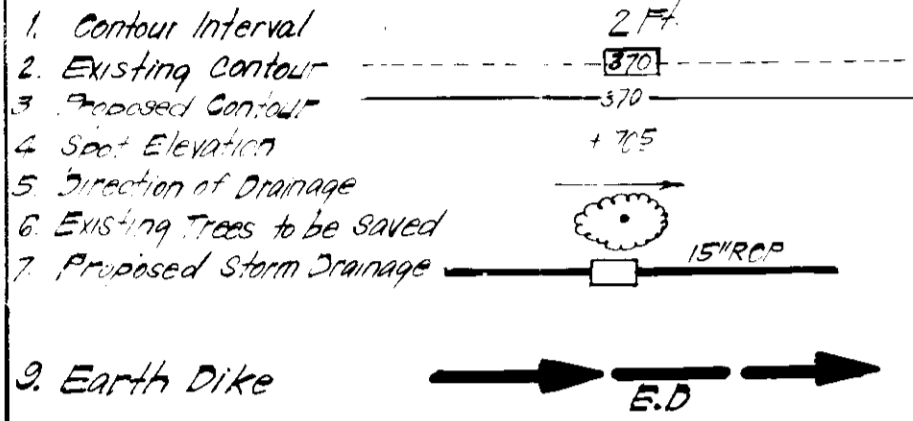



TRAP #1 G.O.S.T. (S.F.D.)
 Drainage Area: 3.80 Acres
 Storage Required: 6848 CF
 Storage Provided: 9637 CF
 Outlet Length: 16 LF
 Storage Depth Below Clean out elevation: 2.5'
 Bottom Elevation: 351.0
 Outlet Crest Elevation: 356.0
 Convert trap to storm drain / Inlet Trap after construction of storm drains.

Drainage Area: 3.80 Acres
 Storage Required: 6848 CF
 Storage Provided: 6849 CF
 Outlet Length: 16 LF
 (4 openings in inlet, each 2.5 wide)
 Storage Depth below Clean out elevation: 2.0'
 Bottom Elevation: 351.0
 Outlet Crest Elevation: 356.0

A=1.07AC COMM 28% RFP
 C=.35

A=0.35AC COMM 60% RFP
 C=.63

A=0.42AC COMM 60% RFP
 C=.63

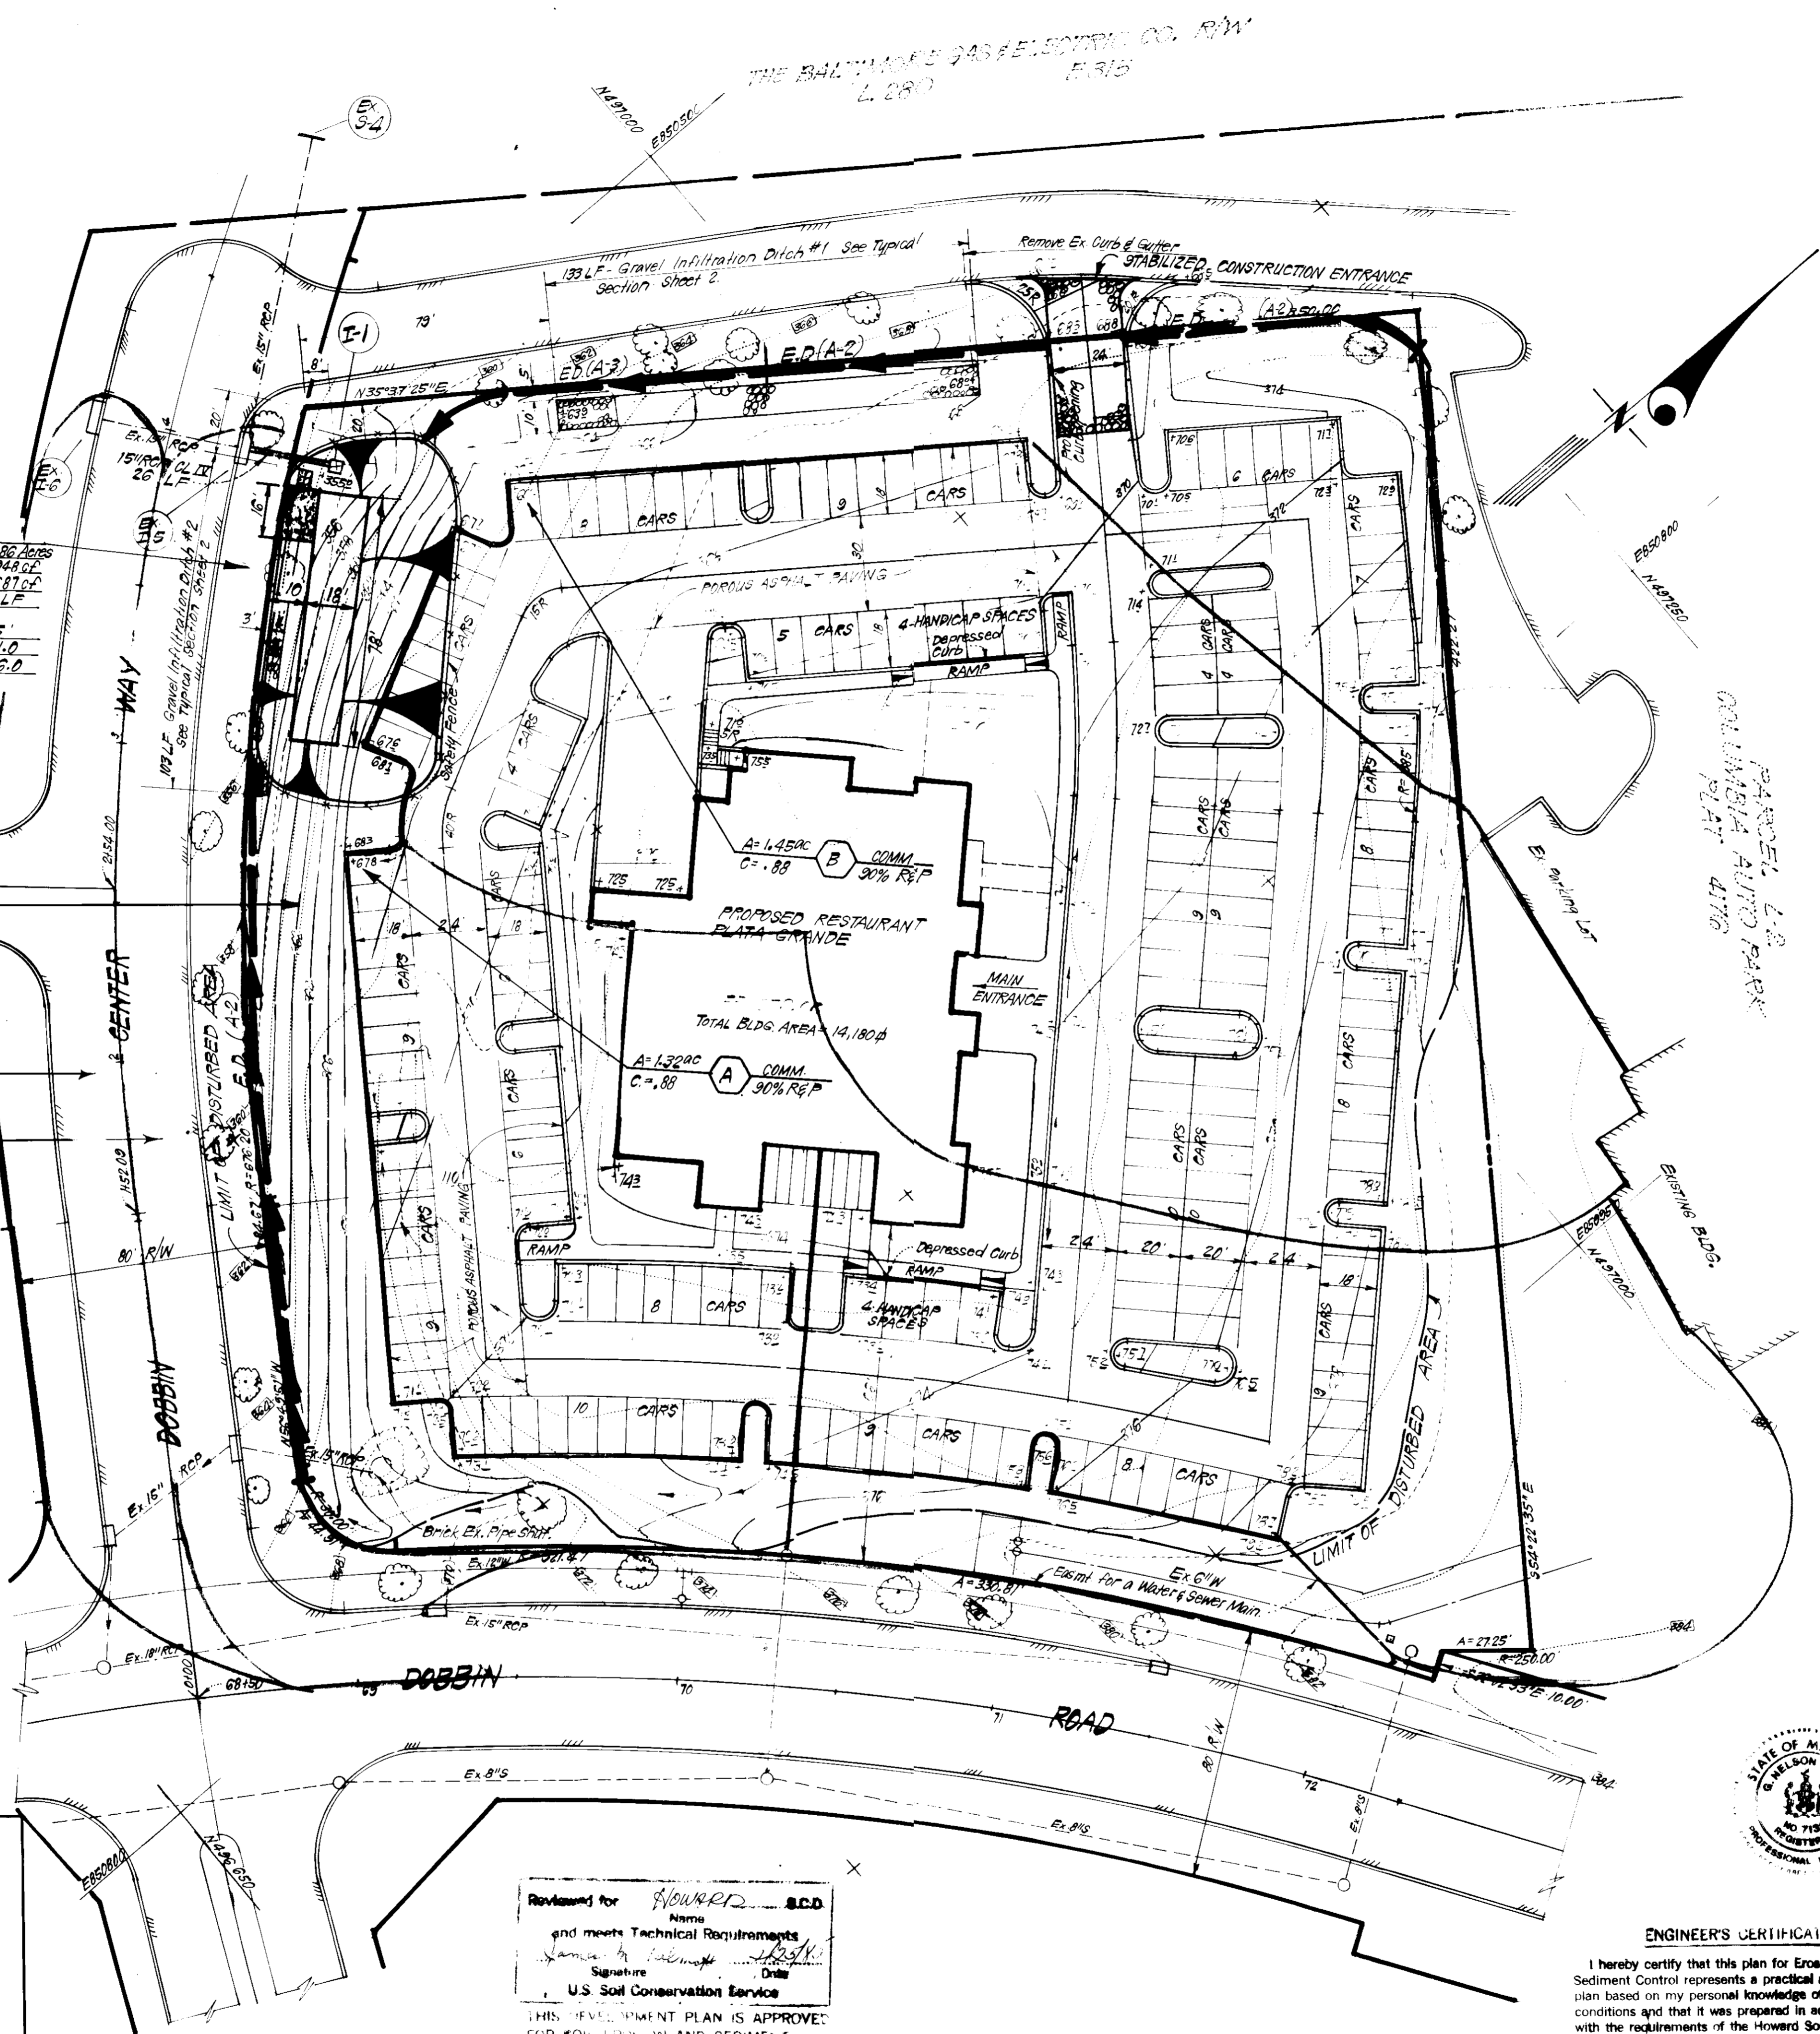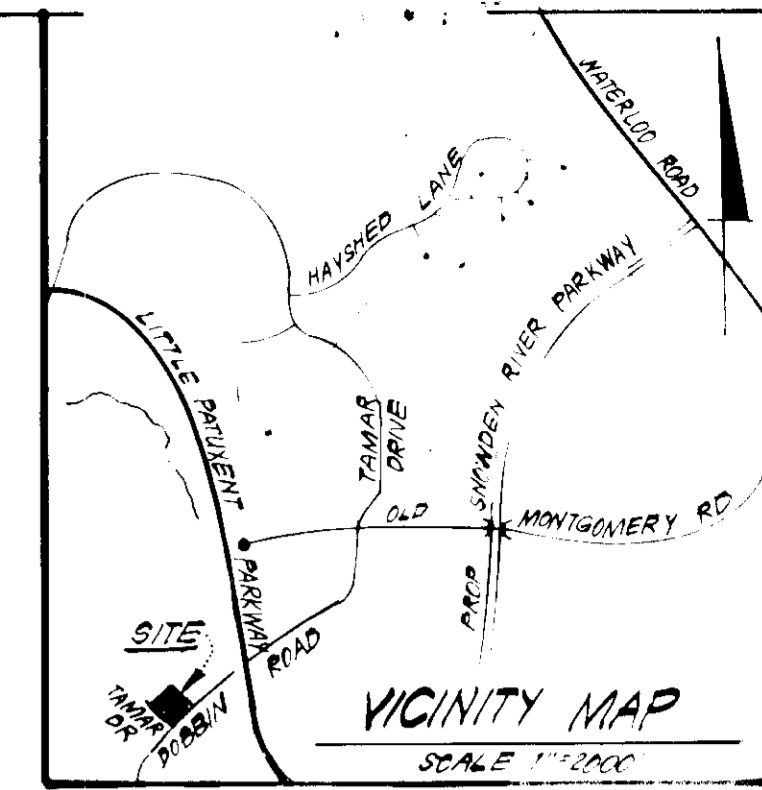

DEVELOPER'S/BUILDER'S CERTIFICATE

"I/we certify that all development and construction will be done according to this plan of development and plan for erosion and sediment control and that all responsible personnel involved in the construction project will have a Certificate of Attendance at a Dept. of Natural Resources Approved Training Program for the Control of Sediment and Erosion before beginning the project. I also authorize periodic on-site inspection by the Howard Soil Conservation District or their authorized agents, as are deemed necessary."

Signature of Developer/Builder: *[Signature]* Date: _____
 COLLEGE PARK CONTRACTORS INC
 IRVING L. KIDWELL



ENGINEER'S CERTIFICATE

I hereby certify that this plan for Erosion and Sediment Control represents a practical and workable plan based on my personal knowledge of the site conditions and that it was prepared in accordance with the requirements of the Howard Soil Conservation District.

Signature: *[Signature]* Date: 10-24-84
 G. Nelson Clark

APPROVED: FOR PUBLIC WATER AND PUBLIC SEWERAGE SYSTEMS
 HOWARD COUNTY HEALTH DEPARTMENT
 County Health Officer: *[Signature]* DATE: 3-4-85

APPROVED: HOWARD COUNTY OFFICE OF PLANNING & ZONING
 Planning Director: *[Signature]* DATE: 3-5-85

CHIEF DIVISION OF LAND DEVELOPMENT & ZONING ADMIN.
 DATE: 3-5-85

APPROVED: FOR PUBLIC WATER AND PUBLIC SEWERAGE,
 STORM DRAINAGE SYSTEMS AND PUBLIC ROADS
 HOWARD COUNTY DEPARTMENT OF PUBLIC WORKS
 Director: *[Signature]* DATE: 2-27-85

CHIEF BUREAU OF ENGINEERING
 DATE: 2-27-85

11-14-84
 AM/AMM

Reviewed for *[Signature]* S.C.D.
 Name: _____
 and meets Technical Requirements
 Signature: *[Signature]* Date: _____
 U.S. Soil Conservation Service

THIS DEVELOPMENT PLAN IS APPROVED FOR SOIL EROSION AND SEDIMENT CONTROL BY THE HOWARD SOIL CONSERVATION DISTRICT.

Signature: *[Signature]* Date: 2/12/85
 Approved

OWNER: CARROLLTON ENTERPRISES LTD. PTN.
 11700 Beltsville Drive
 Beltsville Md. 20705

CLARK · FINEFROCK & SACKETT ENGINEERS · PLANNERS · SURVEYORS		11315 LOCKWOOD DRIVE SILVER SPRING, MARYLAND 20904
DESIGNED R.G.B. EP	SEDIMENT & EROSION CONTROL PLAN & DRAINAGE AREA MAP PARCEL L-3 COLUMBIA DOBBIN ROAD COMMERCIAL CENTER SECTION 1 AREA 1 6 TH ELECTION DISTRICT HOWARD COUNTY, MARYLAND FOR: CARROLLTON ENTERPRISES 11700 Beltsville Drive Beltsville, Md. 20705	DATE 10-24-84
DRAWN K.W.		SCALE 1"=30'
CHECKED EP		DRAWN NO. 3075
DATE		FILE NO. 84-54
		FILE NO. 84-545E


AS-BUILT 2-20-87

SDP-85-56c

GENERAL NOTES

- Grading Permits shall be obtained prior to installation of sediment control.
- All Sediment Control Measures will be installed and stabilized according to this plan prior to any other grading, clearing or disturbance of existing surface of site.
- Notify the Bureau of Inspections and Permits at least 24 hours before starting any work.
- All Sediment Control Practices to conform to the 1983 Maryland Standards and Specifications for Soil Erosion and Sediment Control, and shall be adjusted to meet actual field conditions.
- All structural Sediment Control Measures are to remain in place until permission for their removal has been obtained from the Bureau of Inspections and Permits.
- On Site Inspection and maintenance of all sediment control measures including clean-out of Sediment Traps and Dikes, and proper establishment of all planned vegetative measures will be the responsibility of the developer or his representative on the site, on a continuing day to day basis.
- It will be the developer's responsibility to provide additional sediment & Erosion Control Devices to protect stabilized areas during construction.
- The contractor shall keep all public roads free of sediment deposits left from traffic leaving construction.
- Approval of this plan is conditional upon the approval of Sediment Control Plan for the off-site waste or borrow area prior to the impact of any borrow or export of waste to or from this site.
- See Pages 51.01 - 51.08 of the Maryland State & Specs for Soil Erosion and Sediment Control for Permanent Seeding and Pages 50.01 - 50.05 for Temporary Seeding.
- As per COMAR 08.05.01.06 -- "Following initial soil disturbance or redistribution, permanent or temporary stabilization shall be completed within: (a) seven calendar days as to the surface of all perimeter contours, dikes, swales, ditches, perimeter slopes, and all slopes greater than 3:1 horizontal to one vertical (3:1) and (b) fourteen days as to all other disturbed or graded areas on the project site."
- All Pipes to be blocked at the end of each day (See detail below). (Not Req'd.)

- The total amount of Straw Bale Dikes/ Silt Fence shown = None LF
- SITE ANALYSIS:**
 - A Total Area: 3340 Acres
 - B Area to be Reroiled: 0.300 Acres
 - C Area to be Paved: 1.630 Acres
 - D Area to be Seeded: 1.120 Acres
 - E Area Undisturbed: 0.290 Acres
- All sediment traps shown must be fenced and warning signs posted around their perimeter in accordance with Vol. 1, Chap. 12, of The Howard Co. Design Manual for Storm Drainage.

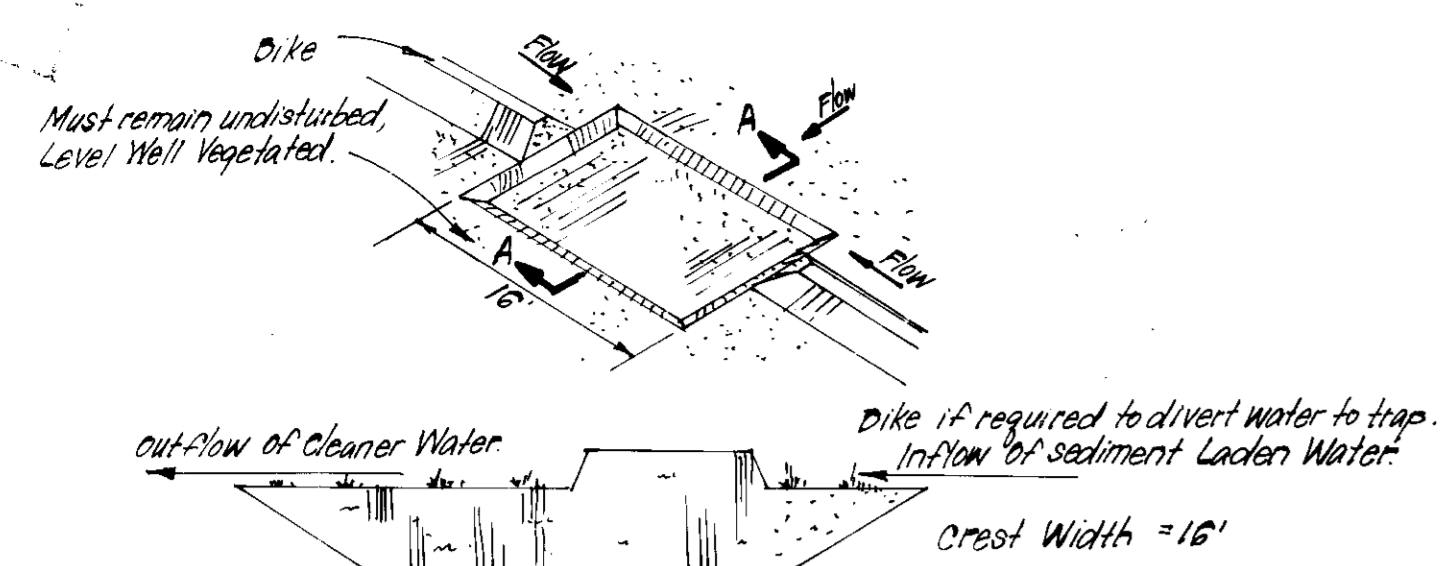


CONSTRUCTION SEQUENCE:

- Volume of sediment storage shall be 1800 cu ft/acre of contributory drainage area.
- Min Crest width shall be 4 x D.A.
- Sediment shall be removed and trap restored to its original dimensions when the sediment has accumulated to 1/2 the design depth of the trap. Removed sediment shall be deposited in a suitable area and in such a manner that it will not erode.
- The structure shall be inspected after each rain and repairs made as needed.
- Construction operations shall be carried out in such a manner that erosion and water pollution shall be minimized.
- The sediment trap shall be removed and area stabilized when the remaining drainage area has been properly stabilized.
- All cut slopes shall be 1:1 or flatter.

GRASS OUTLET SEDIMENT TRAP (G.O.S.T.)

NO SCALE

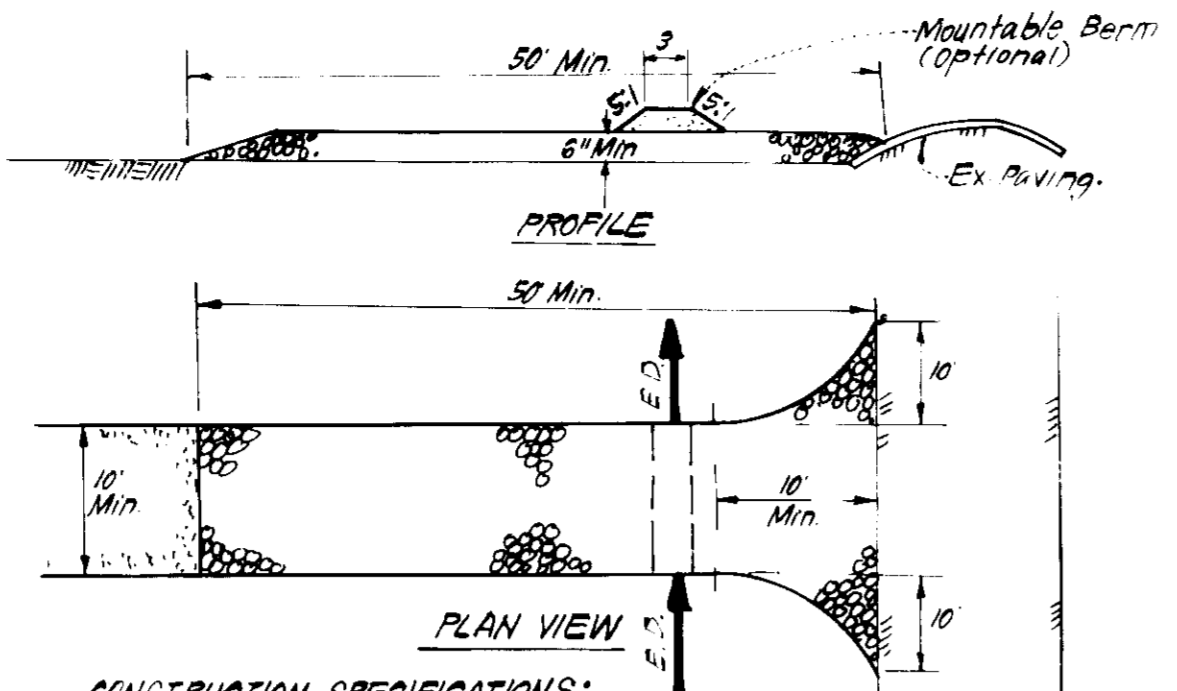


CONSTRUCTION SPECIFICATIONS:

- Stone Size - Use 2" stone, or reclaimed or recycled concrete equivalent.
- Length - As required, but not less than 50 feet (except on a single residence lot where a 100 min length would apply).
- Thickness - Not less than 6".
- Width - Ten foot min, but not less than the full width at point where ingress occurs.
- Filter Cloth - Will be placed over the entire area prior to placing of stone. Filter will not be required on a single family residence lot.
- Surface Water - All surface water flowing or diverted toward construction entrances shall be piped across the entrance. If piping is impractical, a mountable berm with 5:1 slopes will be permitted.
- Maintenance - The entrance shall be maintained in a condition which will prevent tracking or flowing of sediment onto public rights of way. This may require periodic top dressing with additional stone as conditions demand. Sediment spilled, dropped, washed or tracked onto public rights of way must be removed immediately.
- Washing - Wheels shall be cleaned to remove sediment prior to entrance onto public rights of way. When washing is required, it shall be done on an area stabilized with stone and which drains into an approved sediment trapping device.
- Periodic inspection and needed maintenance shall be provided after each rain.

STABILIZED CONSTRUCTION ENTRANCE (S.C.E.)

NO SCALE

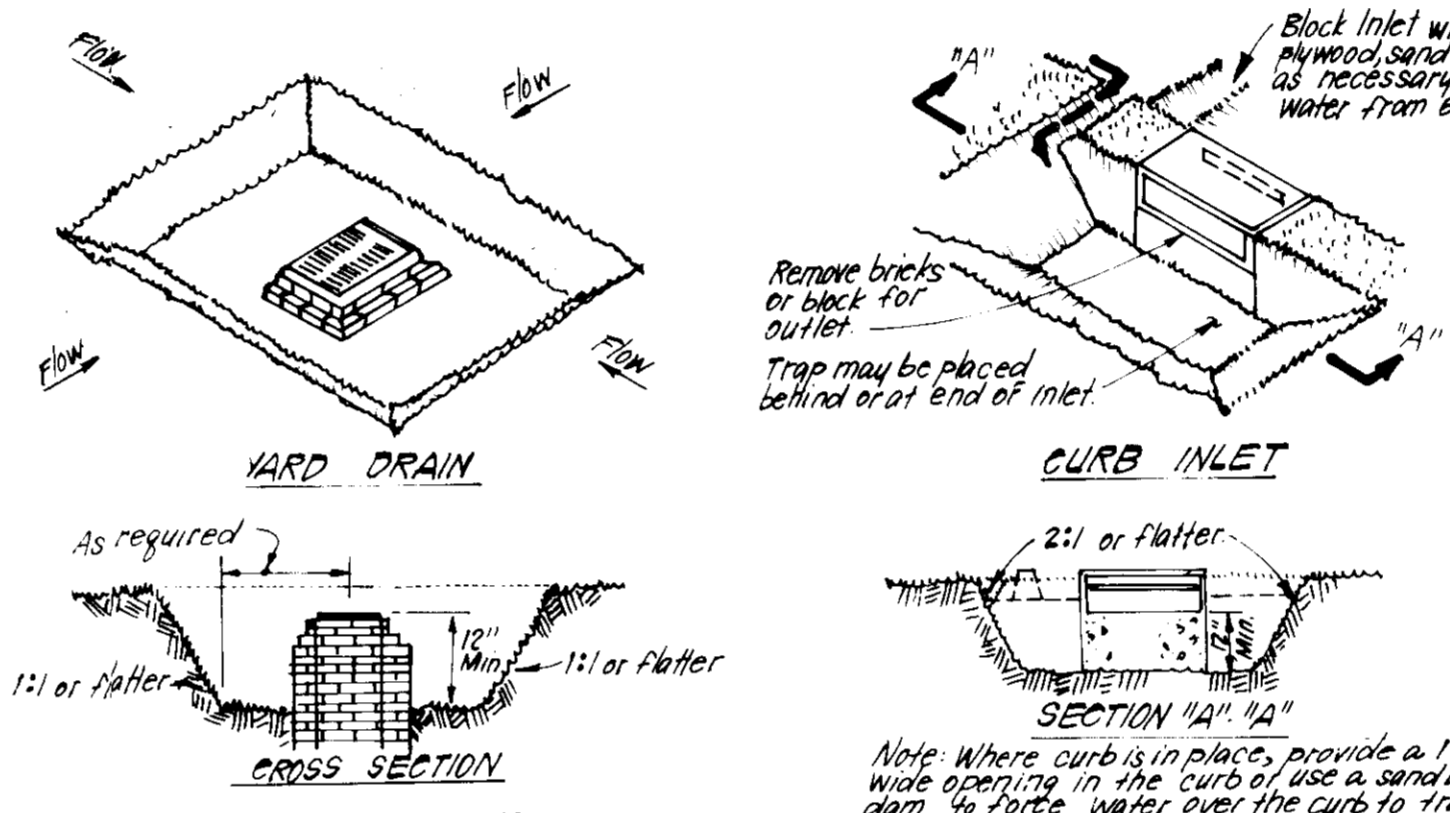

CONSTRUCTION SPECIFICATIONS:

- Sediment shall be removed and the trap restored to its original dimensions when sediment has accumulated to 1/2 the design depth of the trap. Removed sediment shall be deposited in a suitable area and in such a manner that it will not erode.
- The volume of sediment storage shall be 1800 cu ft/acre of contributory drainage.
- The structure shall be inspected after each rain and repairs made as needed.
- Construction operations shall be carried out in such a manner that erosion and water pollution shall be minimized.
- The sediment trap shall be removed and the area stabilized when the constructed drainage area has been properly stabilized.
- All cut slopes shall be 1:1 or flatter.

STORM INLET SEDIMENT TRAP (S.I.S.T.) ST III

NO SCALE

APPROVED

11-14-84

APPROVED FOR PUBLIC WATER AND PUBLIC SEWERAGE SYSTEMS, HOWARD COUNTY HEALTH DEPARTMENT

Chief Health Officer: *[Signature]* DATE: 3-4-85

APPROVED FOR HOWARD COUNTY OFFICE OF PLANNING & ZONING


Planning Director: *[Signature]* DATE: 3-5-85

CHIEF DIVISION OF LAND DEVELOPMENT AND ZONING ADMINISTRATION

APPROVED FOR PUBLIC WATER AND PUBLIC SEWERAGE, STORM DRAINAGE SYSTEMS AND PUBLIC ROADS, HOWARD COUNTY DEPARTMENT OF PUBLIC WORKS

Director: *[Signature]* DATE: 2-27-85

CHIEF BUREAU OF ENGINEERING: *[Signature]* DATE: 2-27-85

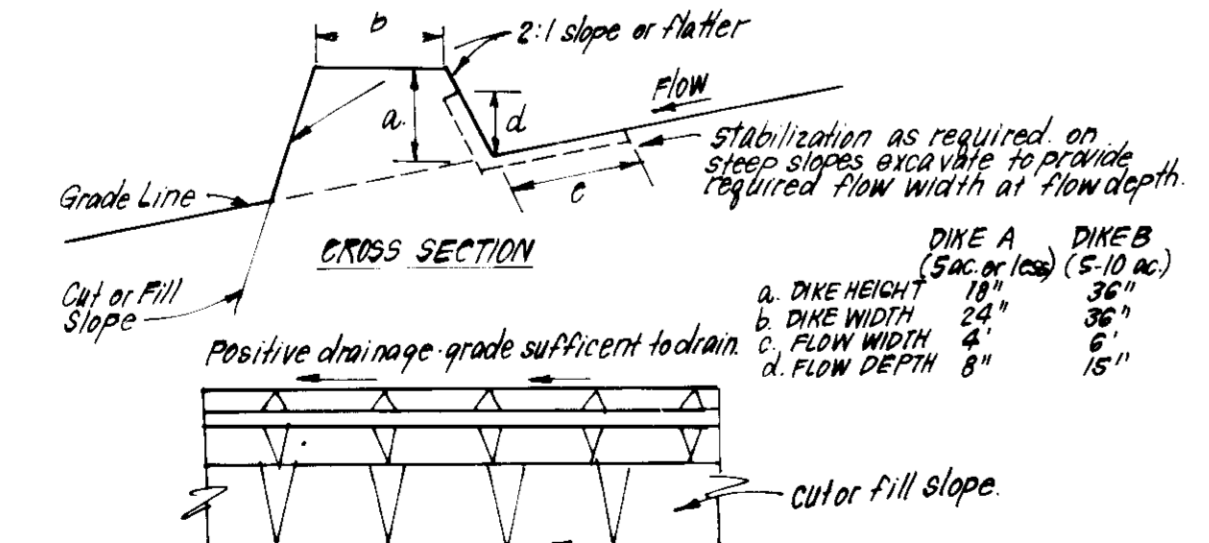

CONSTRUCTION SPECIFICATIONS:

- All dikes shall be compacted by earth-moving equipment.
- All dikes shall have positive drainage to an outlet.
- Top width may be wider and side slopes may be flatter if desired to facilitate crossing by construction traffic.
- Field location should be adjusted as needed to utilize a stabilized safe outlet.
- Earth dikes shall have an outlet that functions with a min of erosion runoff basin where either the dike or the drainage area above the dike are not adequately stabilized.
- Stabilization shall be: (A) in accordance with the State & Specs for Seed and Straw Mulch if not in seeding season (B) flow channel as per Std Detail ED-1, pg 10.03 of the State & Specs.

EARTH DIKE DETAIL (E.D.)

NO SCALE

Reviewed for: *[Signature]* S.O.D.

and meets Technical Requirements

Signature: *[Signature]* Date: *[Date]*

U.S. Soil Conservation Service

THIS DEVELOPMENT PLAN IS APPROVED FOR SOIL EROSION AND SEDIMENT CONTROL BY THE HOWARD SOIL CONSERVATION DISTRICT.

[Signature] Approved: *[Signature]* Date: *[Date]*

DEVELOPER'S/BUILDER'S CERTIFICATE

"I/We certify that all development and construction will be done according to this plan of development and plan for erosion and sediment control and that all responsible personnel involved in the construction project will have a Certificate of Attendance at a Dept. of Natural Resources Approved Training Program for the Control of Sediment and Erosion before beginning the project. I also authorize periodic on-site inspection by the Howard Soil Conservation District or their authorized agents, as are deemed necessary."

Signature of Developer/Builder: *[Signature]* Date: 10-23-84

COLLEGE PARK CONTRACTORS INC. IRVING L. KIPWELL

ENGINEER'S CERTIFICATE

"I hereby certify that this plan for Erosion and Sediment Control represents a practical and workable plan based on my personal knowledge of the site conditions and that it was prepared in accordance with the requirements of the Howard Soil Conservation District."

Signature: *[Signature]* Date: 10-24-84

G. Nelson Clark



OWNER: CARROLLTON ENTERPRISES LTD. PTN. 11700 BELTSVILLE DRIVE BELTSVILLE, MD. 20705


CLARK · FINEFROCK & SACKETT
ENGINEERS · PLANNERS · SURVEYORS

11315 LOCKWOOD DRIVE SILVER SPRING, MARYLAND 20904 (301) 593-3400

DESIGNED	EP	SEDIMENT EROSION CONTROL PLAN DETAILS PARCEL L-3 COLUMBIA DOBBIN ROAD COMMERCIAL CENTER SECTION 1, AREA 1 6TH ELECTION DISTRICT HOWARD COUNTY, MARYLAND FOR: CARROLLTON ENTERPRISES 11700 BELTSVILLE DRIVE BELTSVILLE, MD. 20705	SCALE	AS SHOWN
DRAWN	K/W		DRAWING	40F5
CHECKED	EP		JOB NO.	84-054
DATE	10-24-84		FILE NO.	84-054-3E

AS-BUILT 2-20-87

SDP-85-56

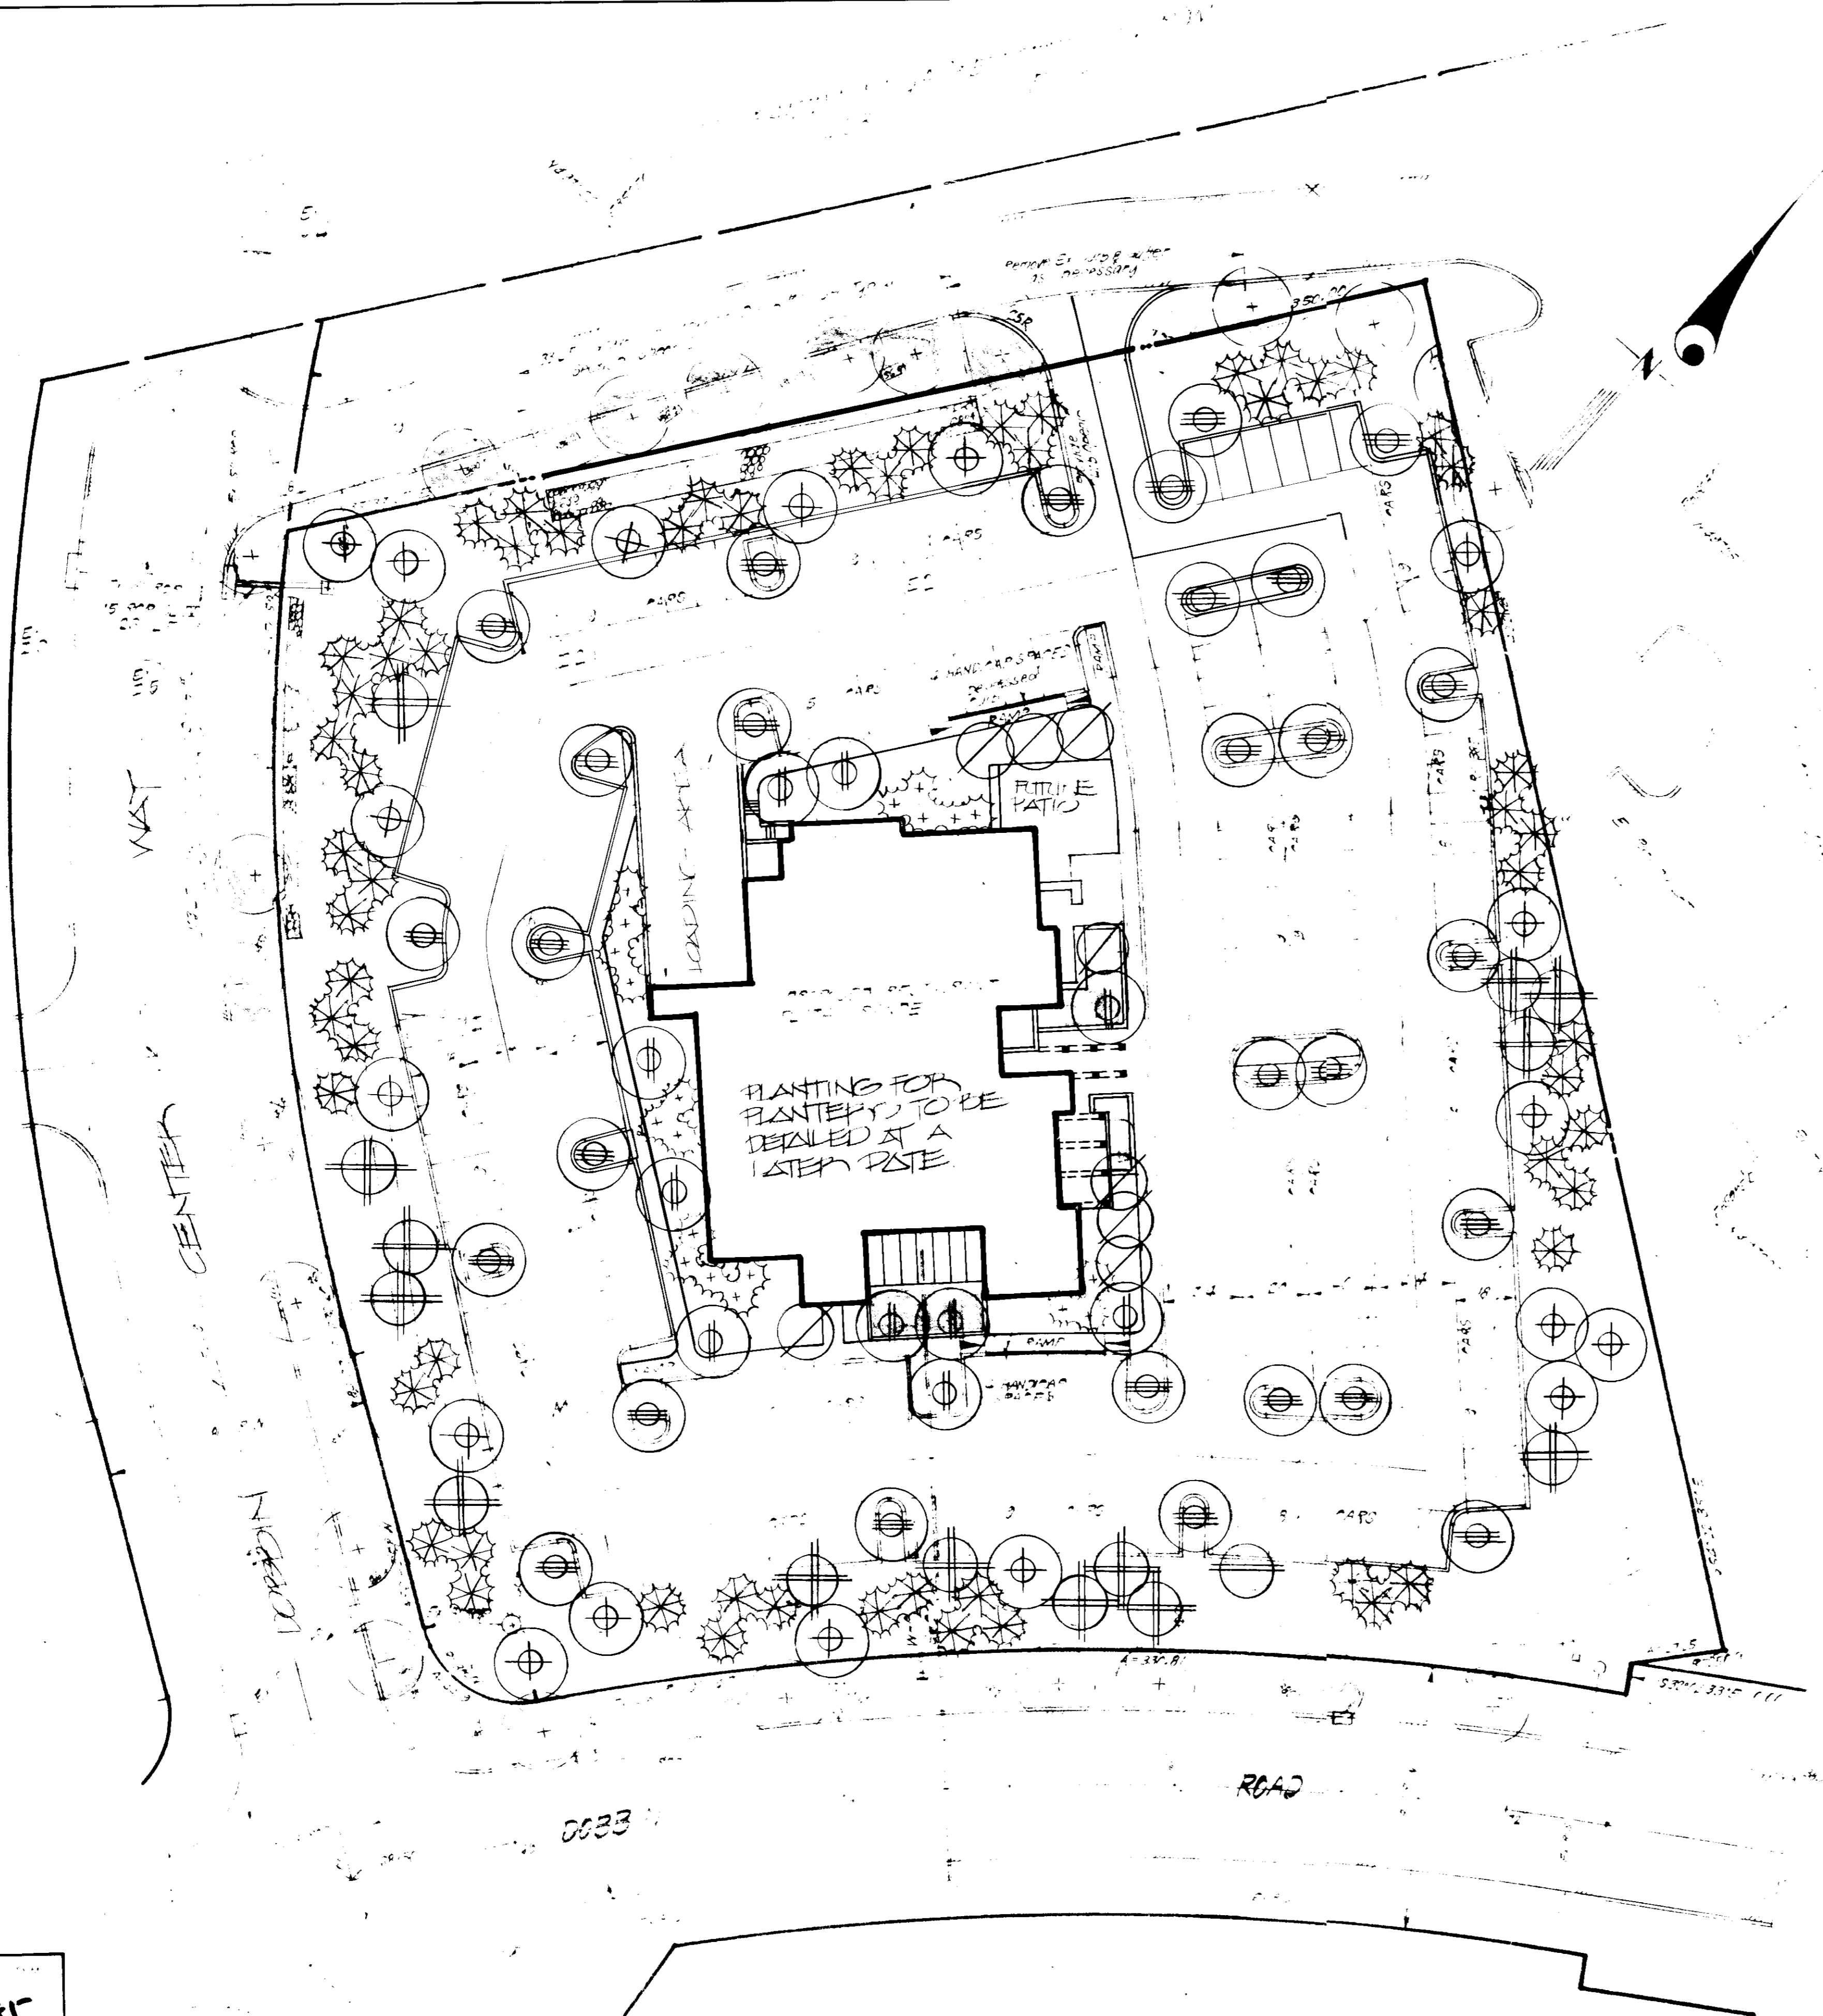

PLANT SCHEDULE

KEY	PLANT NAME	SIZE	QUANT	REMARKS
⊕	ZELKOVA CEPP. VILL. GR. / VILLAGE GREEN ZELKOVA	2 1/2' DIA. / 12' HGT.	20	P.P.P. HEAVY FEEL
⊕	ACER PLURIM. OCT. GL. / OCTOBER GLORY MAPLE		18	
⊕	COFFEA JAP. 'PRESENT' / PRESENT CHOLAR TREE		10	
⊕	FRANKO CEPP. KWANZAN / KWANZAN CHEEFT	2 1/2' DIA. / 8-10' HGT.	15	
⊕	CHATAEGUS PLUR. OPT. LUM. / WASHINGTON HAWTHORN		8	
⊗	FRIND. OP. P. B. / EASTERN WHITE PINE	6-8' HGT.	62	B&D HEAVY
⊗	PIEA CANADENSIS / CANADIAN HEMLOCK	6-8' HGT.	20	B&D HEAVY

DATE	REVISION
10-18-84	REVISED RING TO REFLECT SDP REVISION
11-10-84	REVISED PLUGS TO REFLECT SPCH. REVISION
1-15-85	REVISED PLANT LIST AS PER HPD COMMENTS

NOTE:
 * CONTRACTOR SHALL VERIFY LOCATION OF ALL UNDERGROUND UTILITIES PRIOR TO DIGGING.
 * ALL PLANTING SHALL BE DONE IN COMPLIANCE WITH ATTACHED SPECIFICATIONS.
 * SUBSTITUTIONS MAY BE PERMITTED WITH THE APPROVAL OF THE LANDSCAPE ARCHITECT (525-3400).

APPROVED
 PLANNING BOARD
 OF HOWARD COUNTY

11-14-84

Jorge P. Boyer 3-4-81
 Thomas L. Amis 3-5-85
 William W. ... 3-5-85
 ... 2-27-85
 ... 2-27-85

OWNER: CARROLLTON ENTERPRISES LTD. PTN.
 11700 Beltsville Drive
 Beltsville, Md. 20705

CLARK • FINEFROCK & SACKETT
 ENGINEERS • PLANNERS • SURVEYORS
 11315 LOCKWOOD DRIVE • SUITE 200 • BELTSVILLE, MARYLAND 20704

LANDSCAPE PLANTING PLAN
 PARCEL L-3
 COLUMBIA-CORPUS COMM. CENTER
 DESIGN: AREA - CIVIL ENGINEER LARRY
 HOWARD COUNTY, MARYLAND

DATE: 7-04
 FOR: CARROLLTON ENTERPRISES
 11700 BELTSVILLE DRIVE
 BELTSVILLE, MD 20705

FILE NO. 84-024

SDP-85-56c AS-BUILT 2-20-87