


| PLANT LIST | | | | | |
|-------------------------------|---------|-----------|---------|----------|--------|
| BOTANICAL NAME COMMON NAME | SIZE | CALIPER | ROOT | QUANTITY | SYMBOL |
| ACER RUBRUM RED MAPLE | 18"-12" | 2"-2 1/2" | 3' BALL | 10 | ⊙ |
| LEYLAND CYPRUS | 5'-6" | 1 1/2"-2" | 2'-6" | 33 | ★ |

- CONSTRUCTION NOTES**
- C-1 PROPOSED RELOCATED GRAVEL DRIVE AREAS TIE INTO EXISTING PAVING AS NEEDED
 - C-2 PROPOSED BUILDING ADDITION FIRST FLOOR & BASEMENT ELEV. TO MATCH EXISTING BUILDING SEE ARCHITECTURAL DRAWINGS FOR DETAILS
 - C-3 PROPOSED PORCH TO MATCH EXISTING SEE ARCHITECTURAL DRAWINGS FOR DETAILS
 - C-4 PROPOSED RIP RAP CHANNEL SEE TYPICAL SECTION THIS SHEET PROVIDE 15'X10' WIDE APRON AT BOTTOM OF SLOPE
 - C-5 PROPOSED GRAVEL PARKING SPACES (14 TOTAL) 2'X18' TYPICAL
 - C-6 PROPOSED GRAVEL PARKING SPACES (9 TOTAL) 2'X18' TYPICAL
 - C-7 PROPOSED SILT FENCE PLACED AT PROPOSED TOE OF DISTURBANCE PER 1994 MARYLAND STANDARDS SPECIFICATIONS FOR SOIL EROSION & SEDIMENT CONTROL
 - C-8 SPREAD TOPSOIL ON SLOPES; SEED WITH CROWN VETCH OR OTHER LOW MAINTENANCE SEED MIXTURE
 - C-9 INSTALL ONEWAY SIGN

- RESTRICTIONS PER BA CASE NO 87-10E**
- That all outdoor water needs for the special exception be obtained from the pond;
 - That the pond be constructed with a bi-flow capacity in order to maintain the historical flow rate of the stream to downstream riparian property owners;
 - That all tools and equipment, including vehicles used in the landscaping business, be stored inside of structures;
 - That any outdoor lighting be directed downward and inward away from adjoining properties;
 - That nursery stock delivery vehicles not be loaded or unloaded before 7:30 A.M. or after 7:30 P.M.;
 - That the landscape contractor business not be operated from the subject property on Sundays;
 - That all scrub brush along Md. Route 27 which will obstruct the vision of motorists entering or leaving the subject property be removed prior to commencing business operations;
 - That the merchandise, items and planting stock offered for sale on the subject property substantially comply with the testimony at the hearing;
 - That all improvements and landscaping substantially comply with the testimony at the hearing; and
 - That Petitioner comply with all applicable federal, state and local regulations.

| LOT NO | STREET ADDRESS |
|--------|-----------------|
| P. 193 | 1025 RIDGE ROAD |

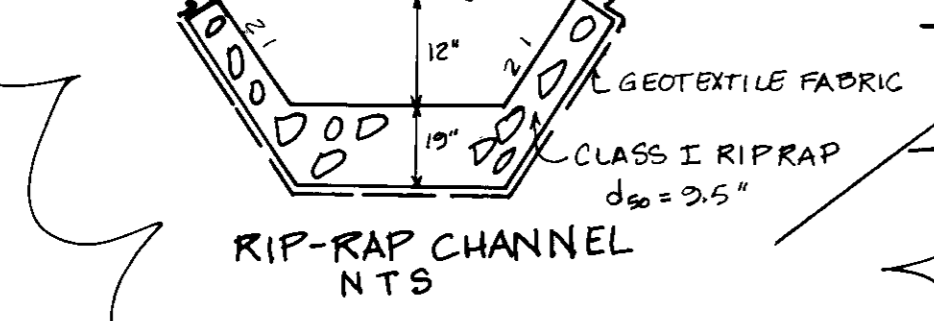


LANDSCAPE REQUIREMENTS
 TYPE II HEAVY BUFFER SOUTHERN DISTURBED LOT LINE
 1 SHADE TREE/40 LF
 1 EVERGREEN/20 LF
 DISTURBED AREA = 230LF
 115 EVERGREENS
 515 SHADE TREES
 NOTE: SEE SHEET 2 FOR SEPTIC SYSTEM DETAILS

| PLANT LIST | | | |
|------------|--------|------------------|----------------|
| QUANTITY | SYMBOL | SPECIES | SIZE |
| 6 | AR | RED SUNSET MAPLE | 2 1/2" CALIPER |
| 13 | CL | LEYLAND CYPRUS | 5'-6 FT |

HYDROLOGICAL COMPONENTS
 LOCATION OF HYDROLOGICAL COMPONENTS
 BU BAILE WHOLE MAP UNIT
 GIBCO GLENVILLE BAILE INCLUDING IN DRAINAGE WITH REFERENCE TO THESE AREAS


| SMAL NAME | ZONING | SOIL LIMITATIONS | | |
|---------------|--------|------------------|------------------|-------------|
| | | PLUS W/ BASEMENT | SEPTIC FIELD | SEPTIC TANK |
| U10 LANGRICE | Y1 | MODERATE | SLIGHT | SEVERE |
| M10 MT AIRY | Y3 | MODERATE | SEVERE | SEVERE |
| M100 | Y3 | SEVERE | SEVERE | SEVERE |
| M102 | P4 | SEVERE | SEVERE | SEVERE |
| M104 | Y3 | MODERATE | MODERATE | SEVERE |
| M106 | P4 | SEVERE | SEVERE | SEVERE |
| B0 BAILE | P2 | SEVERE | HIGH WATER TABLE | SEVERE |
| G10 GLENVILLE | F2 | SEVERE | HIGH WATER TABLE | SEVERE |
| G10 GLENVILLE | B1 | SLIGHT | SLIGHT | SLIGHT |

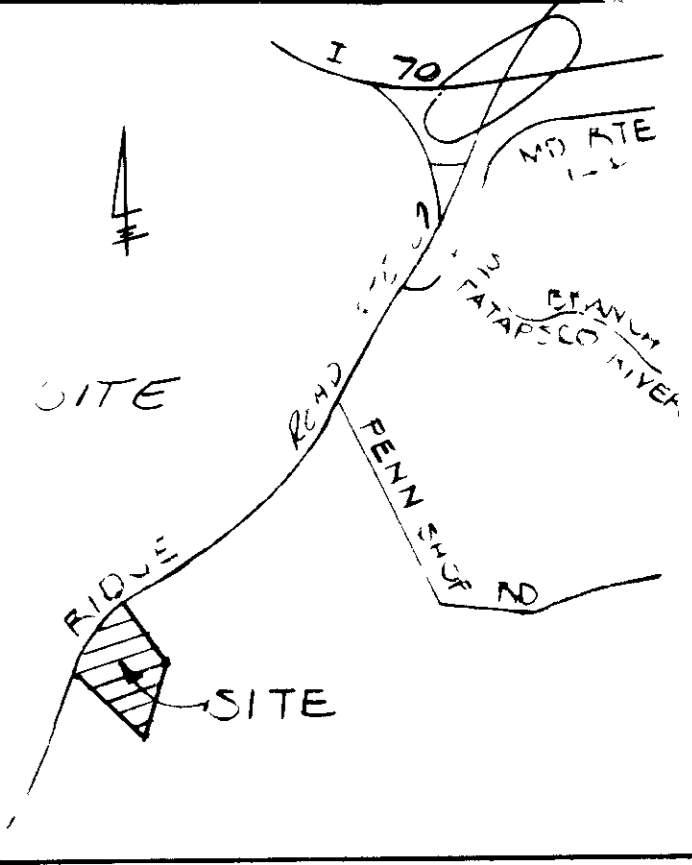

SITE ANALYSIS

- Area of parcel - 1.25 acres
- Zoning - "R" with a special exception for Farm and Garden Supply Store, Retail Nursery and Landscape Contractor Business See BA Case No 87-10E
- Floor Area and Parking Data (BA CASE NO 95-06E4V)
 Basement Storage 1920 S F NO SPACES REQUIRED
 First Floor Retail 2120 S F 2-1 6P/100-6 F 22-6 spaces
 Second Floor Mezz Office 816 S F (1/2 OFFICE, 1/2 RETAIL)
 No. of employees - 4
 Total No. Spaces Required - 24 spaces
 Total No. Spaces Provided - 26 spaces
- Building Coverage 2400
 Main Building - 2000 S F GREENHOUSE 4000 SF
 Storage Shed - 2,400 S F TOTAL 4700 SF 100% COVERAGE
 Green Area - 40.6 acres 96.5% 3700 SF = 2.1%
 9.67 ACRES = 78.9%
- PROPOSED GREENHOUSE
 1ST FLOOR - 4000 SF RETAIL 204 SPACES
 BASEMENT - 4000 SF STORAGE 0 SPACES
 PARKING RATIOS: RETAIL 6 SPACES/1000 SF
 OFFICE 3.3 SPACES/1000 SF
 TOTAL PARKING REQUIRED 40 SPACES
 46 STANDARD SPACES
 2 HANDICAP SPACES
 TOTAL PARKING PROVIDED: 50 SPACES
 46 STANDARD SPACES
 2 HANDICAP SPACES

NOTE: THE FOLLOWING ENGINEER'S CERTIFICATION CERTIFIES ONLY RED LINE REVISIONS TO THIS SHEET DATED 2-6-96

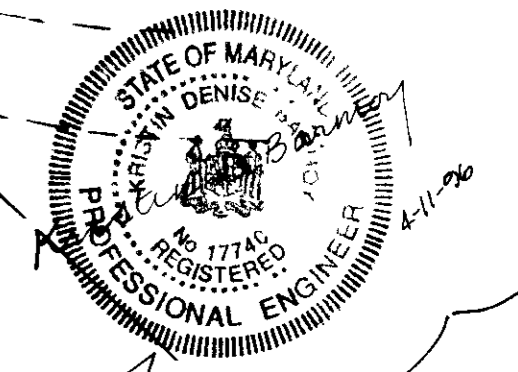

CERTIFICATION OF DAM RETRO-FIT ONLY

I hereby certify that the facility shown on this plan was constructed as shown on the "as-built" plans and meets the approved plans and specifications.

Date: _____
 Carl P. Thomas
 Property Line Surveyor
 MD Reg #411

HARFORD DRAFTING & DESIGN, INC.
 601 CHARWOOD COURT
 EDGEWOOD, MD. 21040
 301-679-8719

ENGINEER'S CERTIFICATE

"I certify that this plan for pond construction, erosion and sediment control represents a practical and workable plan based on my personal knowledge of the site conditions. This plan was prepared in accordance with the requirements of the Howard Soil Conservation District. I have notified the developer that he must provide the Howard Soil Conservation District with an "as-built" plan of the pond within 30 days of completion. I also authorize periodic on-site inspections by the Howard Soil Conservation District."

Signature of Engineer: *Carl P. Thomas*, P.E. 12/2/90
 DATE: 12/2/90

DEVELOPER'S CERTIFICATE

"I/We certify that all development and/or construction will be done according to these plans, and that any responsible personnel involved in the construction project will have a Certificate of Attendance at a Department of Natural Resources Approved Training Program for the Control of Sediment and Erosion before beginning the project. I will provide the Howard Soil Conservation District with an "as-built" plan of the pond within 30 days of completion. I also authorize periodic on-site inspections by the Howard Soil Conservation District."

Signature of Developer: *David A. Snell*
 DATE: 10-24-88

These plans have been reviewed for the Howard Soil Conservation District and meet the technical requirements for small pond construction, soil erosion and sediment control.

Signature: *John M. Snell*, 12/2/90
 Date: 12/2/90

These plans for small pond construction, soil erosion and sediment control meet the requirements of the Howard Soil Conservation District.

Signature: *John M. Snell*, 12/2/90
 Date: 12/2/90

APPROVED DEPT OF PLANNING AND ZONING

Signature: *James H. Smith*, 4/12/91
 DATE: 4/12/91

Signature: *James H. Smith*, 7/2/91
 DATE: 7/2/91

CHIEF DIVISION OF COMMUNITY PLANNING & LAND DEVELOPMENT

Signature: *James H. Smith*, 1-21-90
 DATE: 1-21-90

APPROVED DEPARTMENT OF PUBLIC WORKS FOR PUBLIC ROAD AND STORM DRAINAGE SYSTEM

Signature: *James H. Smith*, 4/12/91
 DATE: 4/12/91

Signature: *James H. Smith*, 1-29-91
 DATE: 1-29-91








PROPERTY/SUBDIVISION
 D.R. SNELL NURSERY SECTION/AREA - PARCEL/LOT NO 193

PLAT NO / LF 1630-325 BLOCK NO ZONE TAX / ZONE ELEC DIST CENSUS TR 6040

WATER CODE SEWER CODE

SITE DEVELOPMENT PLAN

D.R. SNELL NURSERY
 RIDGE ROAD, MD. RTE. 27
 FOURTH ELECT. DISTRICT
 HOWARD CO., MARYLAND
 AUGUST 11, 1988
 SCALE 1" = 50'
 T.M. P. 193 SHEET 1 OF 5

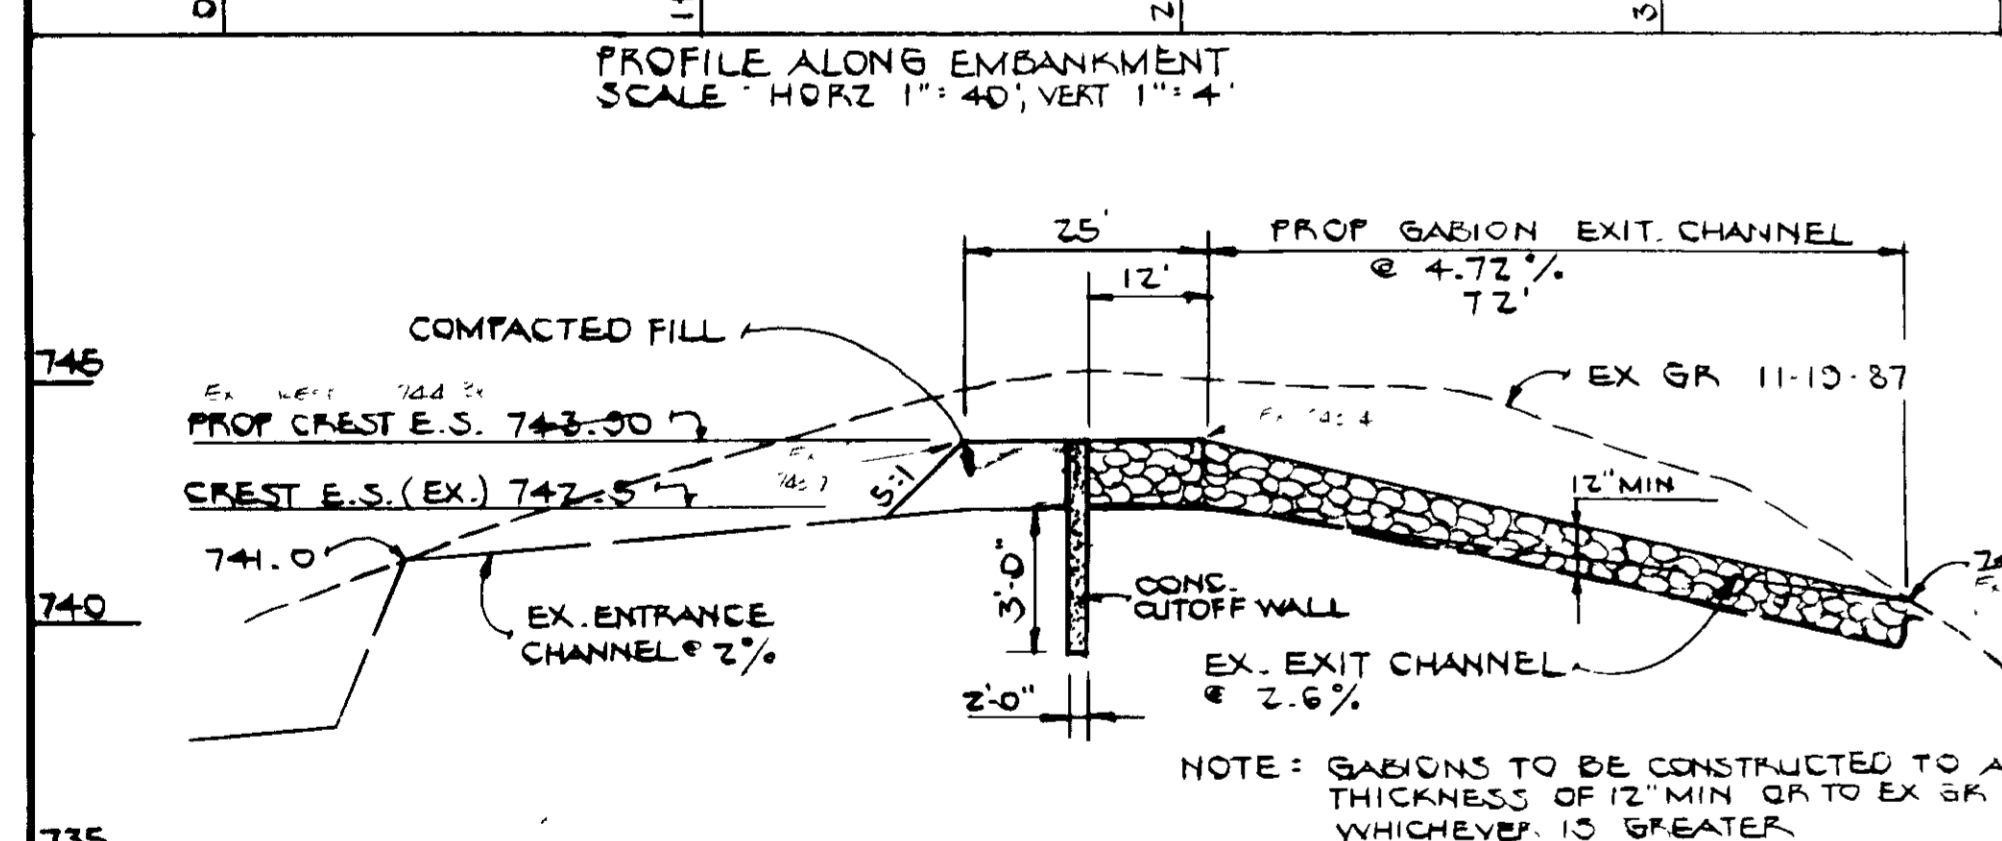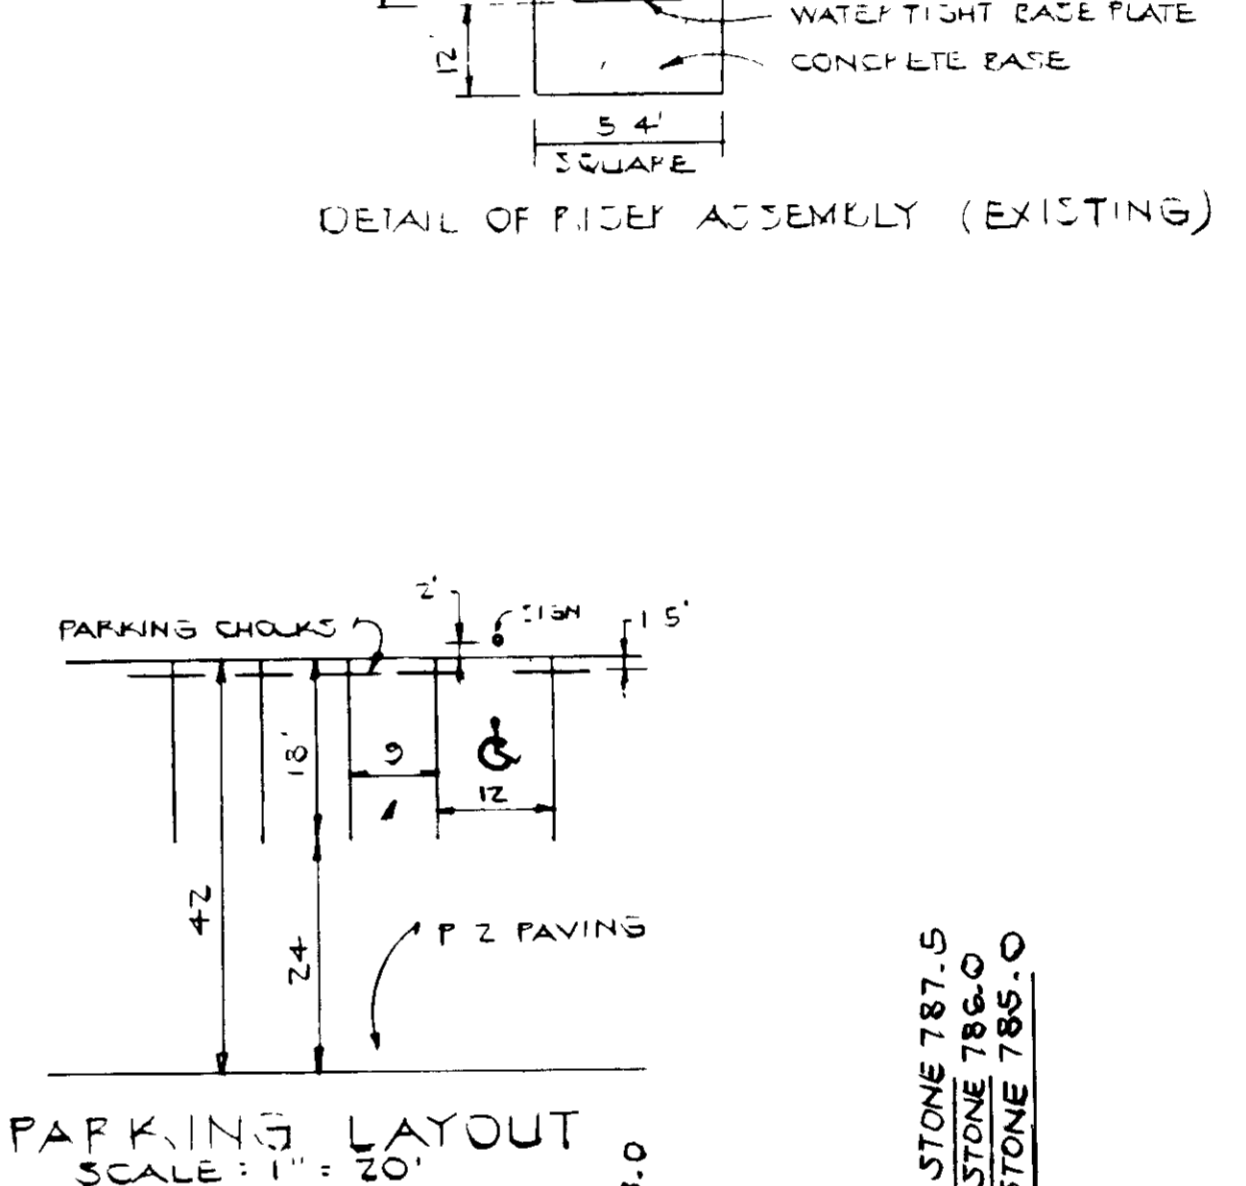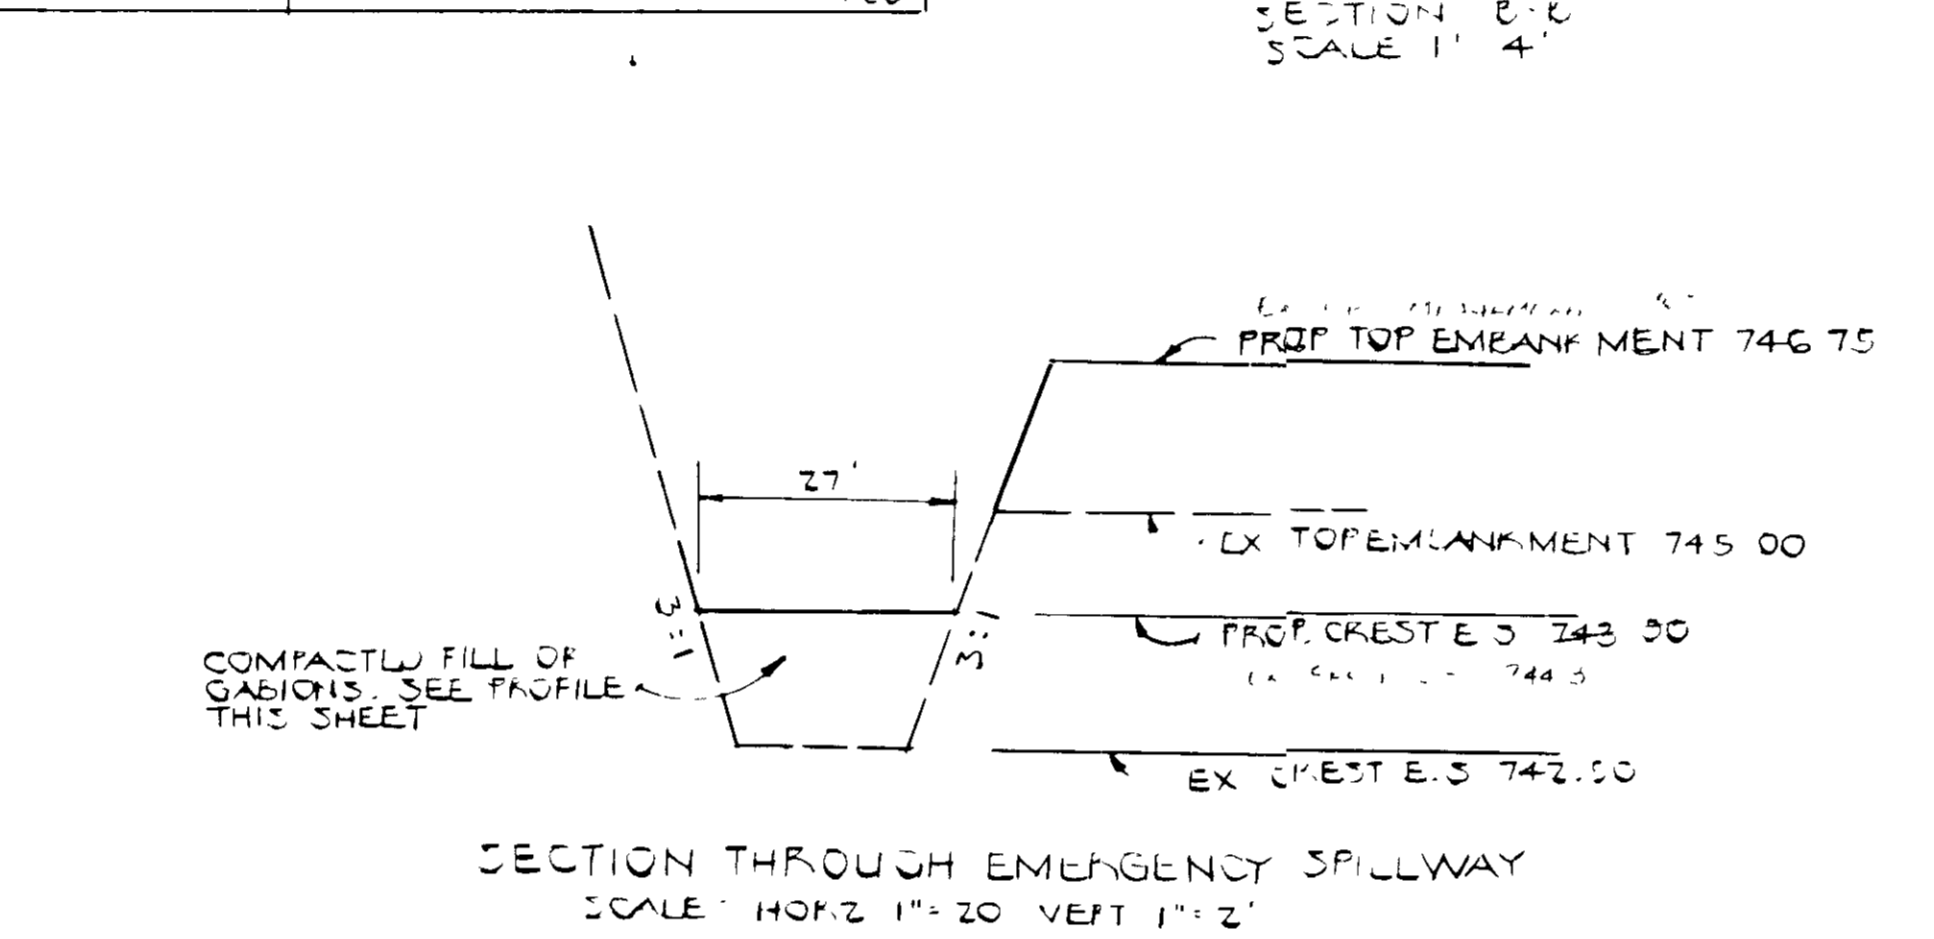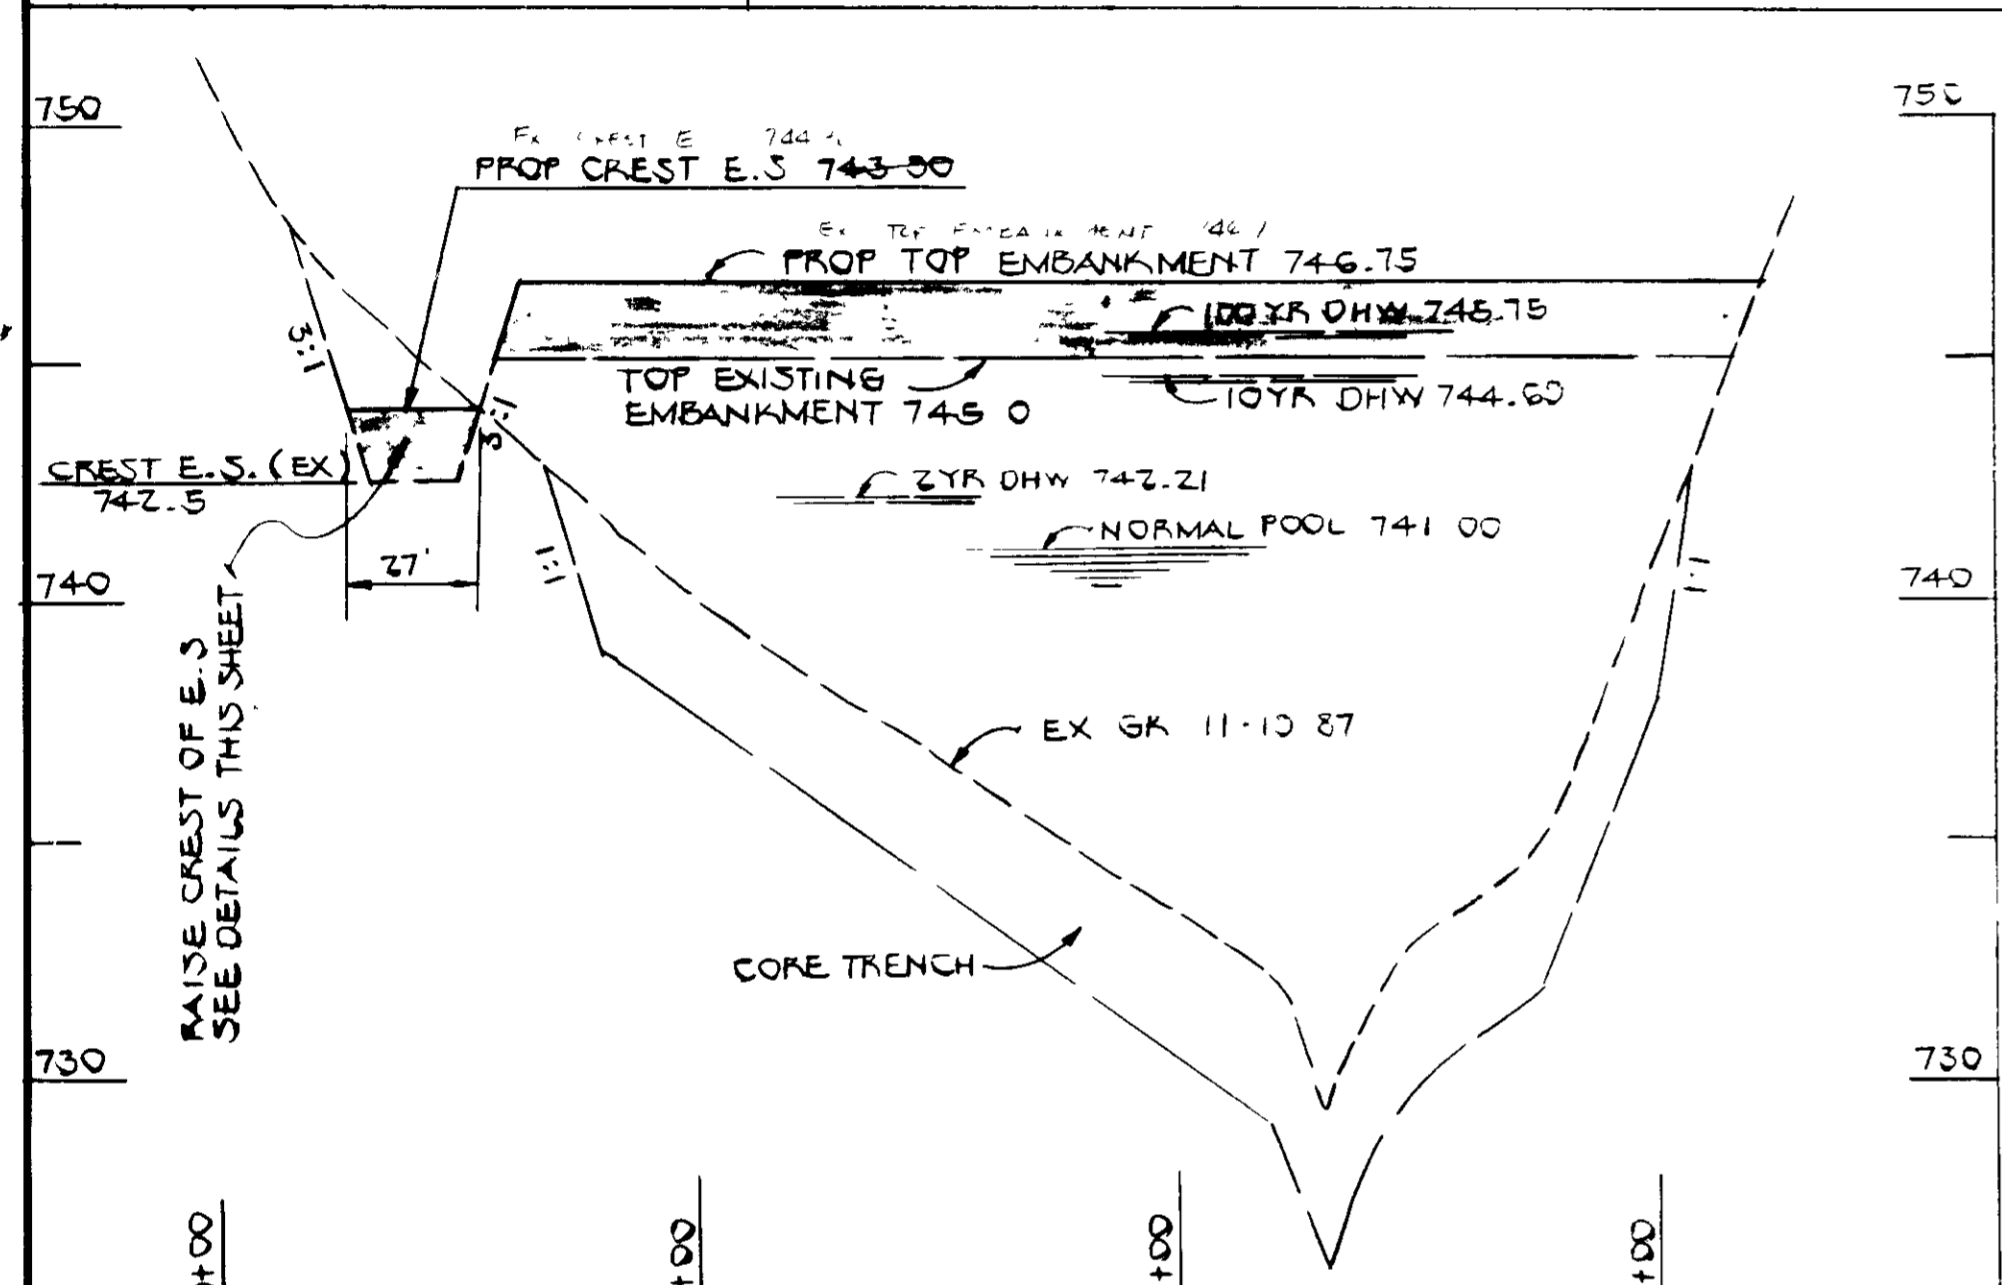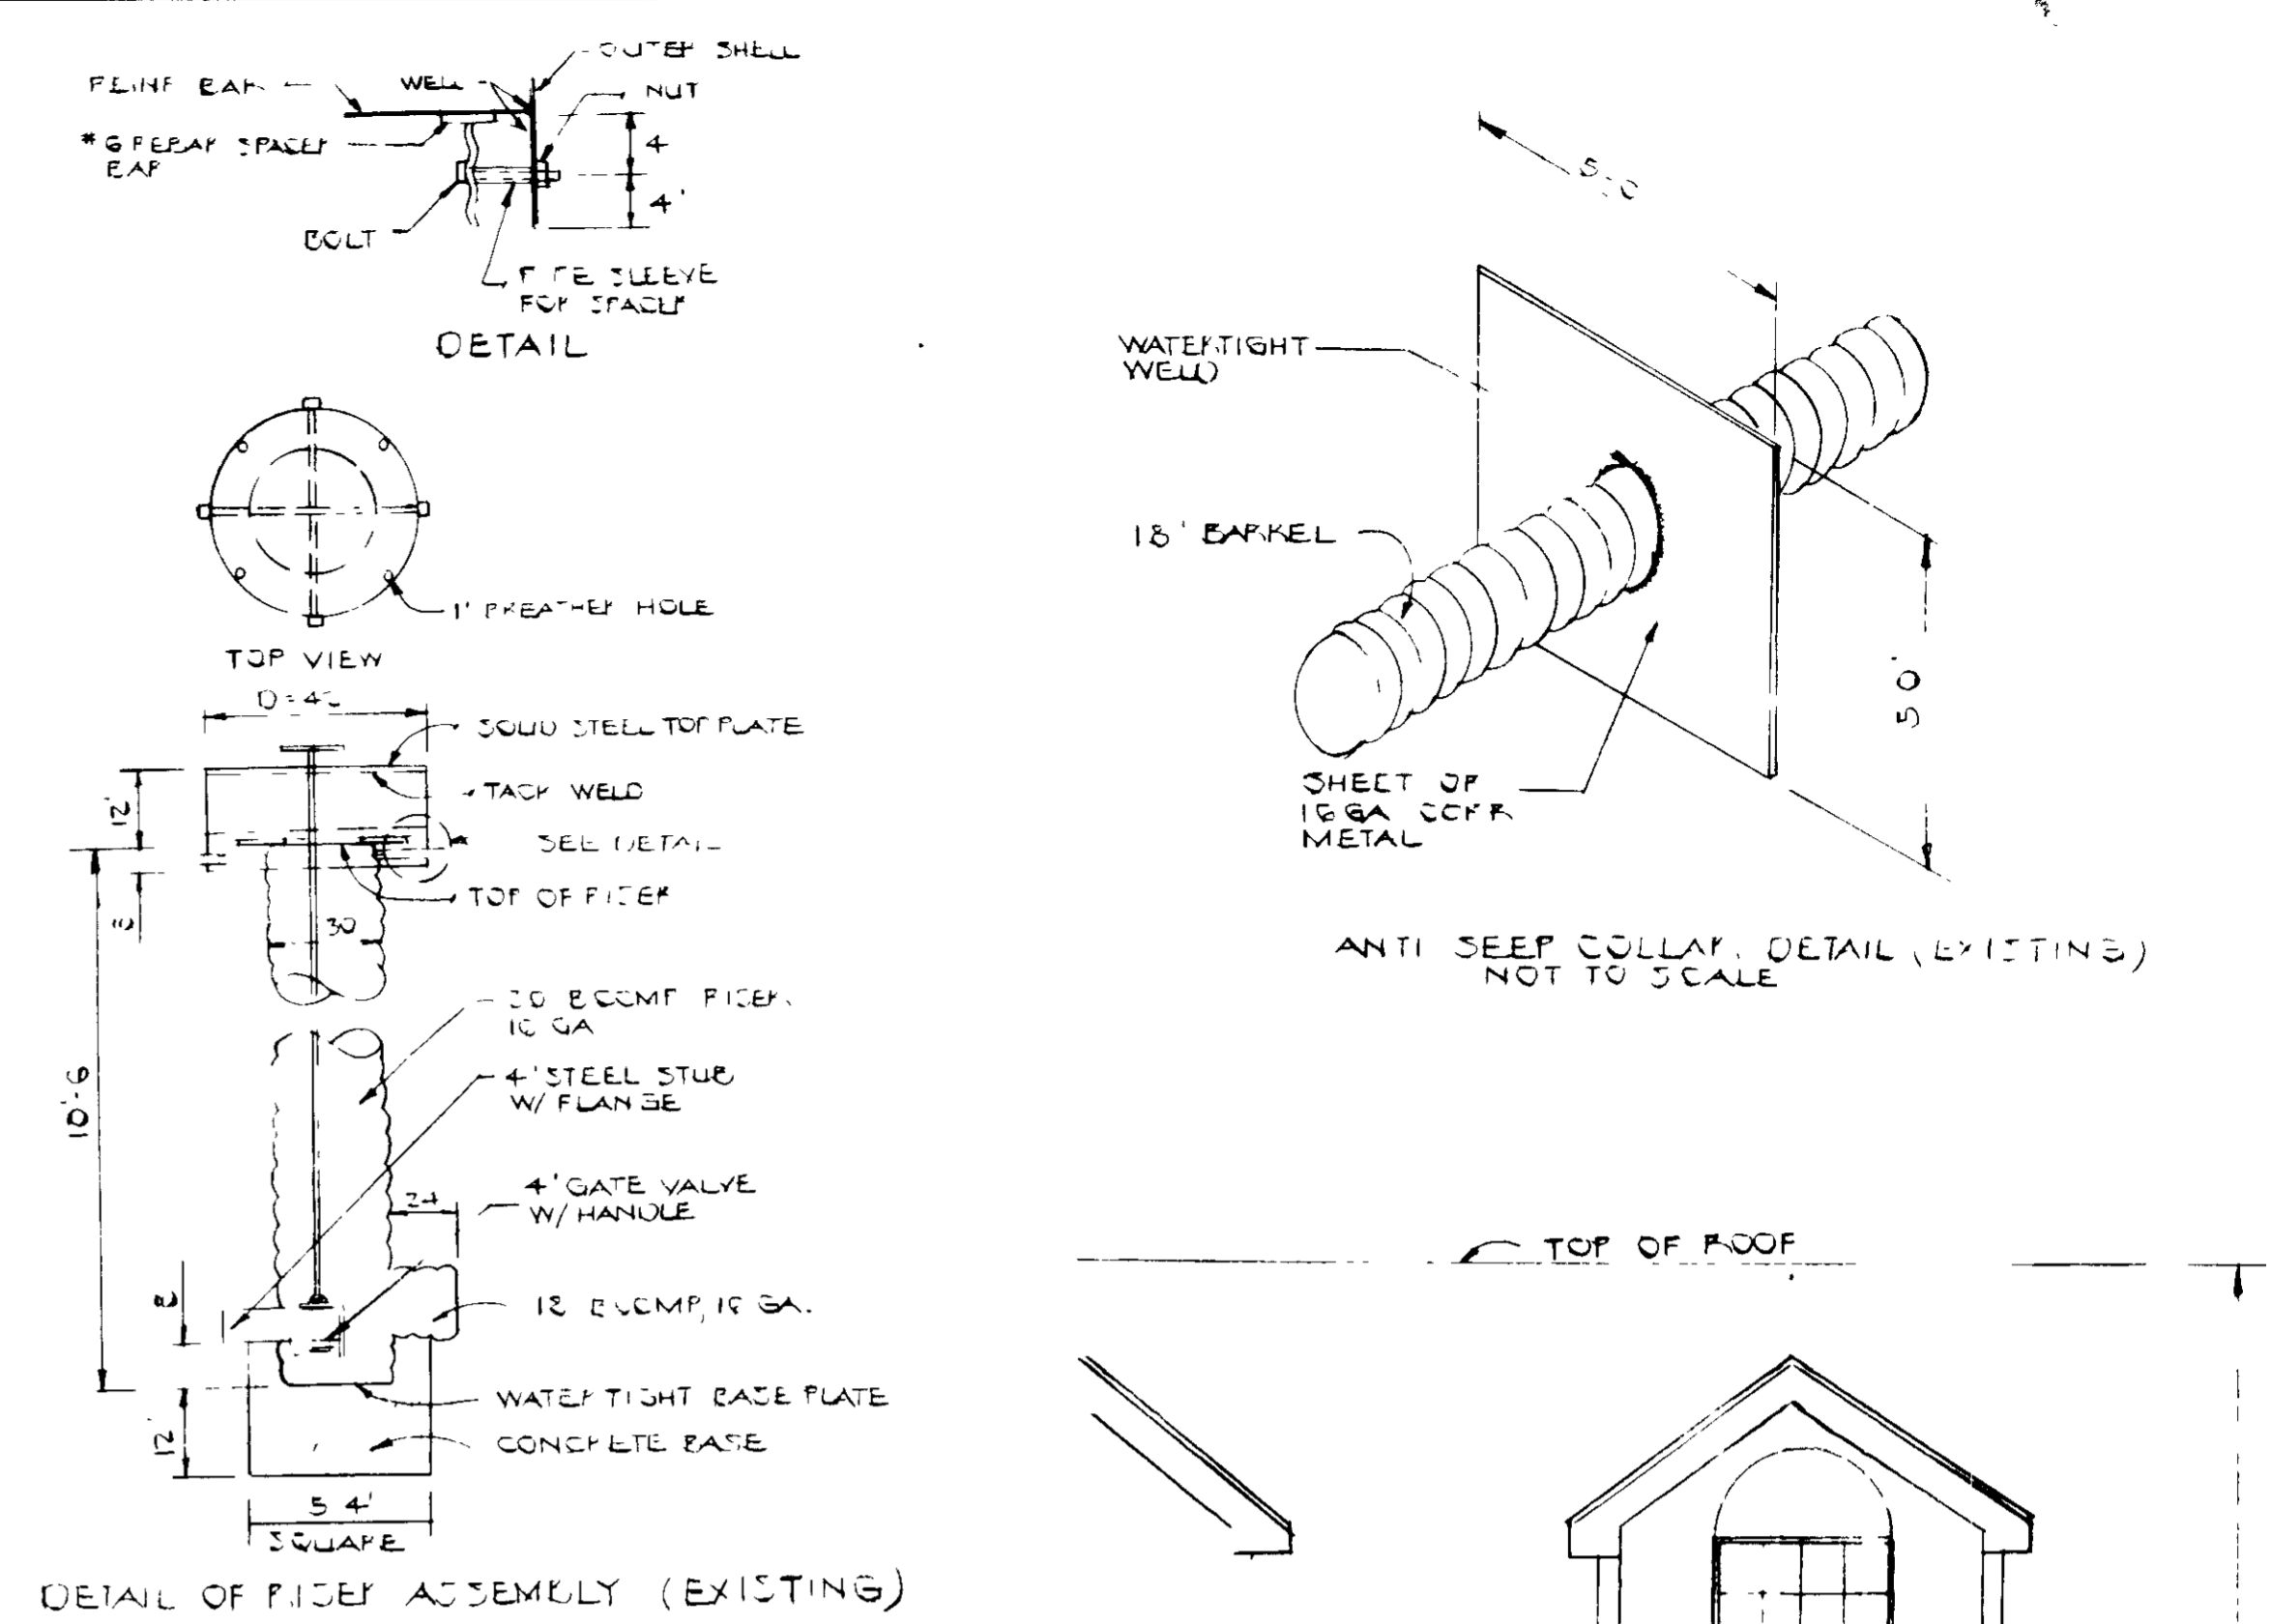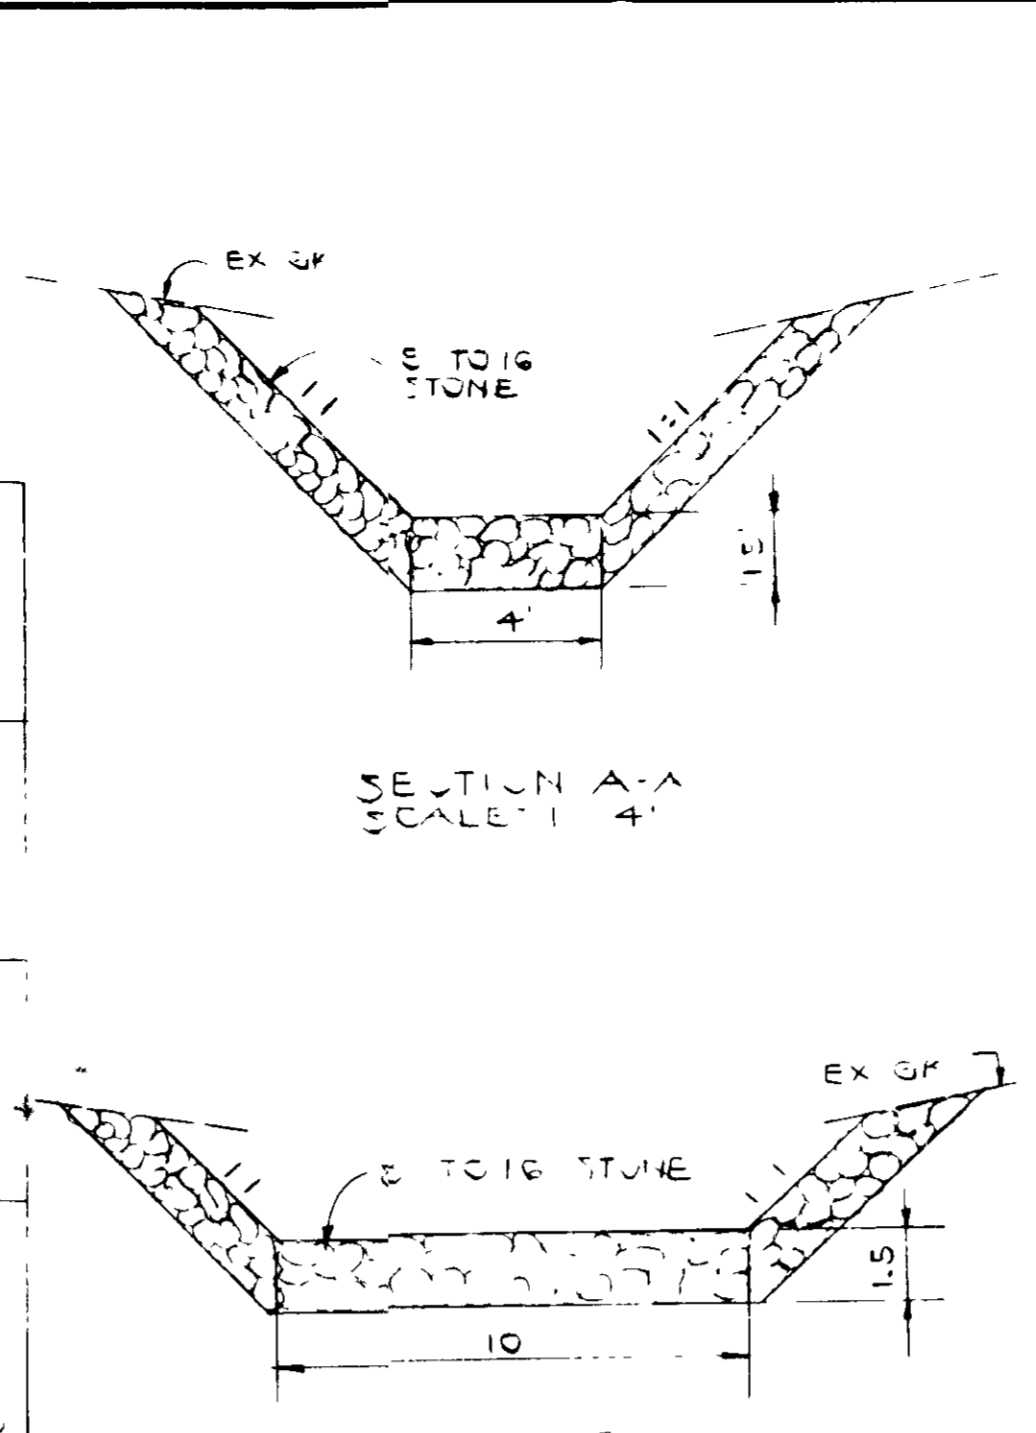
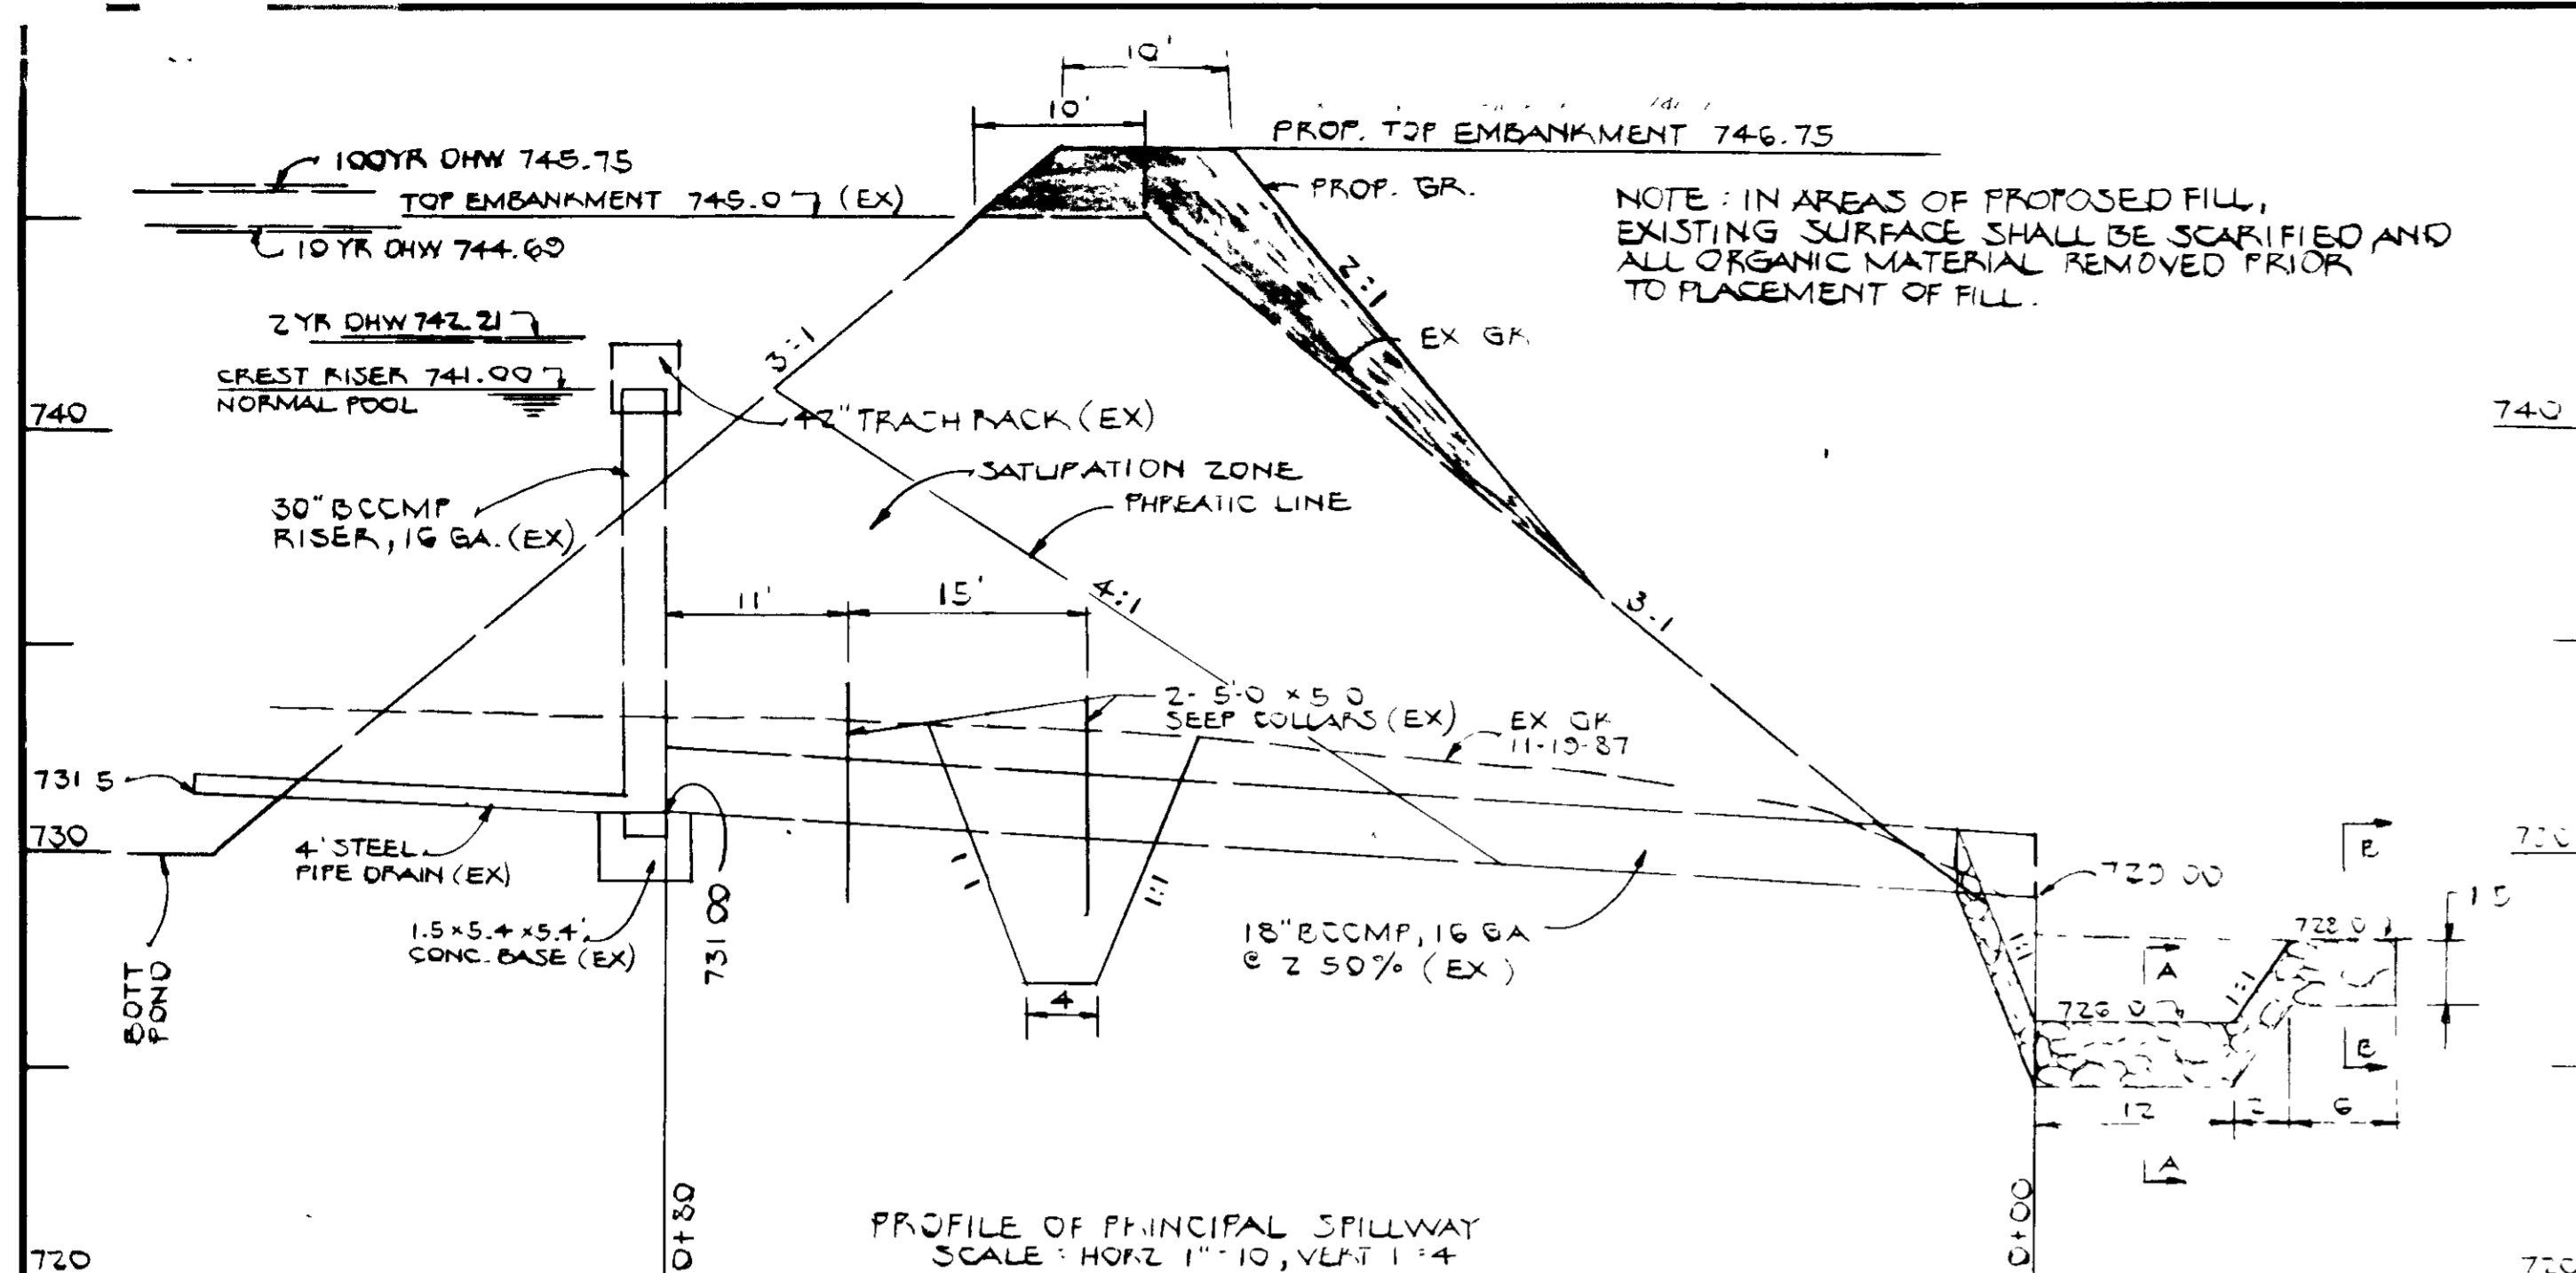


CERTIFICATION OF DAM RETRO-FIT ONLY

I hereby certify that the facility shown on this plan was constructed as shown on the "as-built" plans and meets the approved plans and specifications.

Date: *11/10/88*
Carl P. Thomas
Property Line Surveyor
MD Reg #411

STATE OF MARYLAND
DEPARTMENT OF LAND AND NATURAL RESOURCES
PROPERTY LINE SURVEYOR

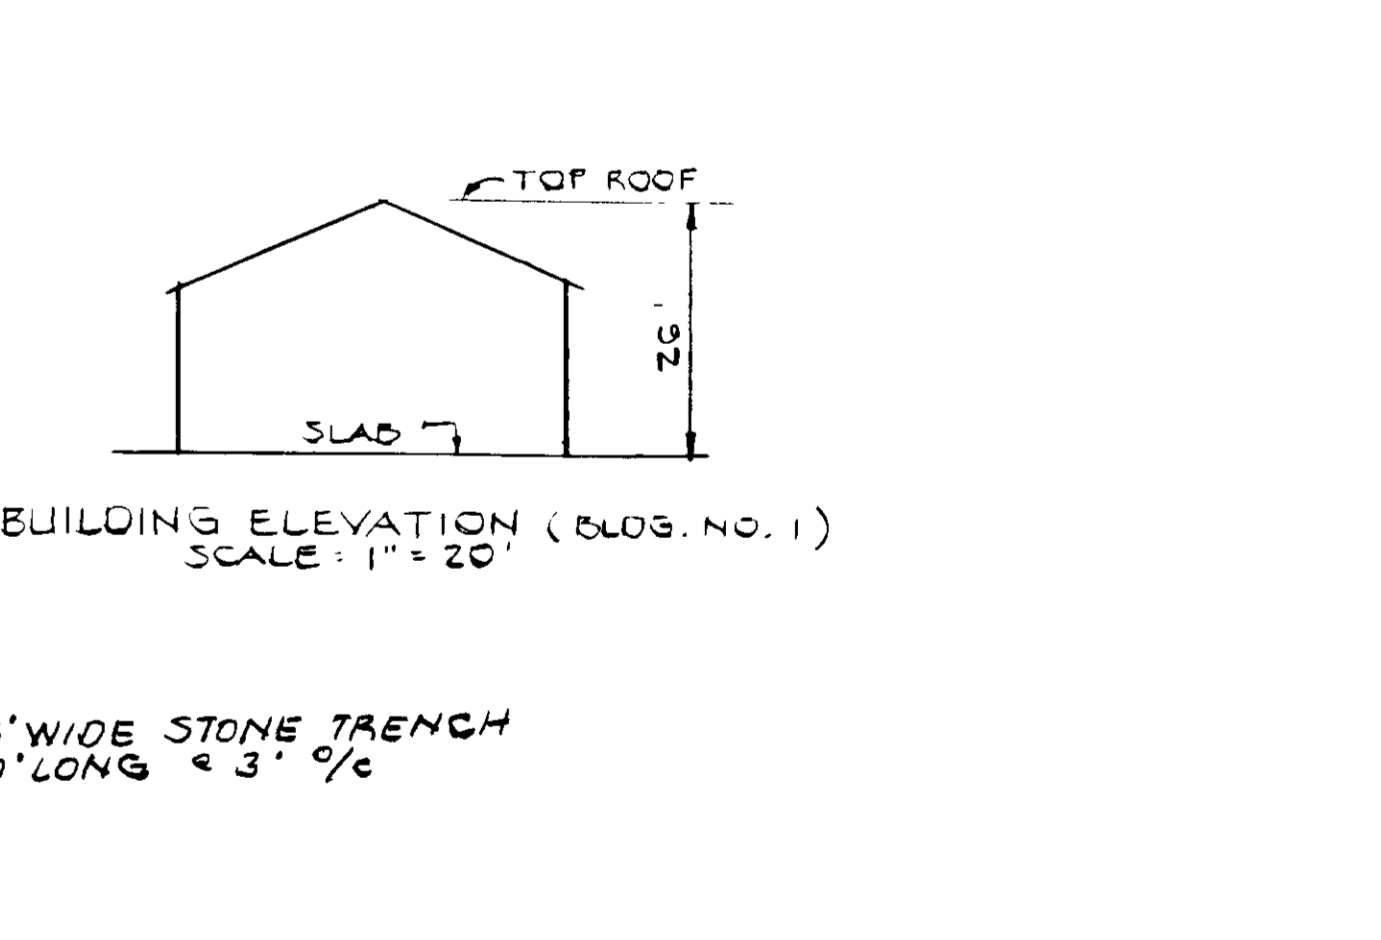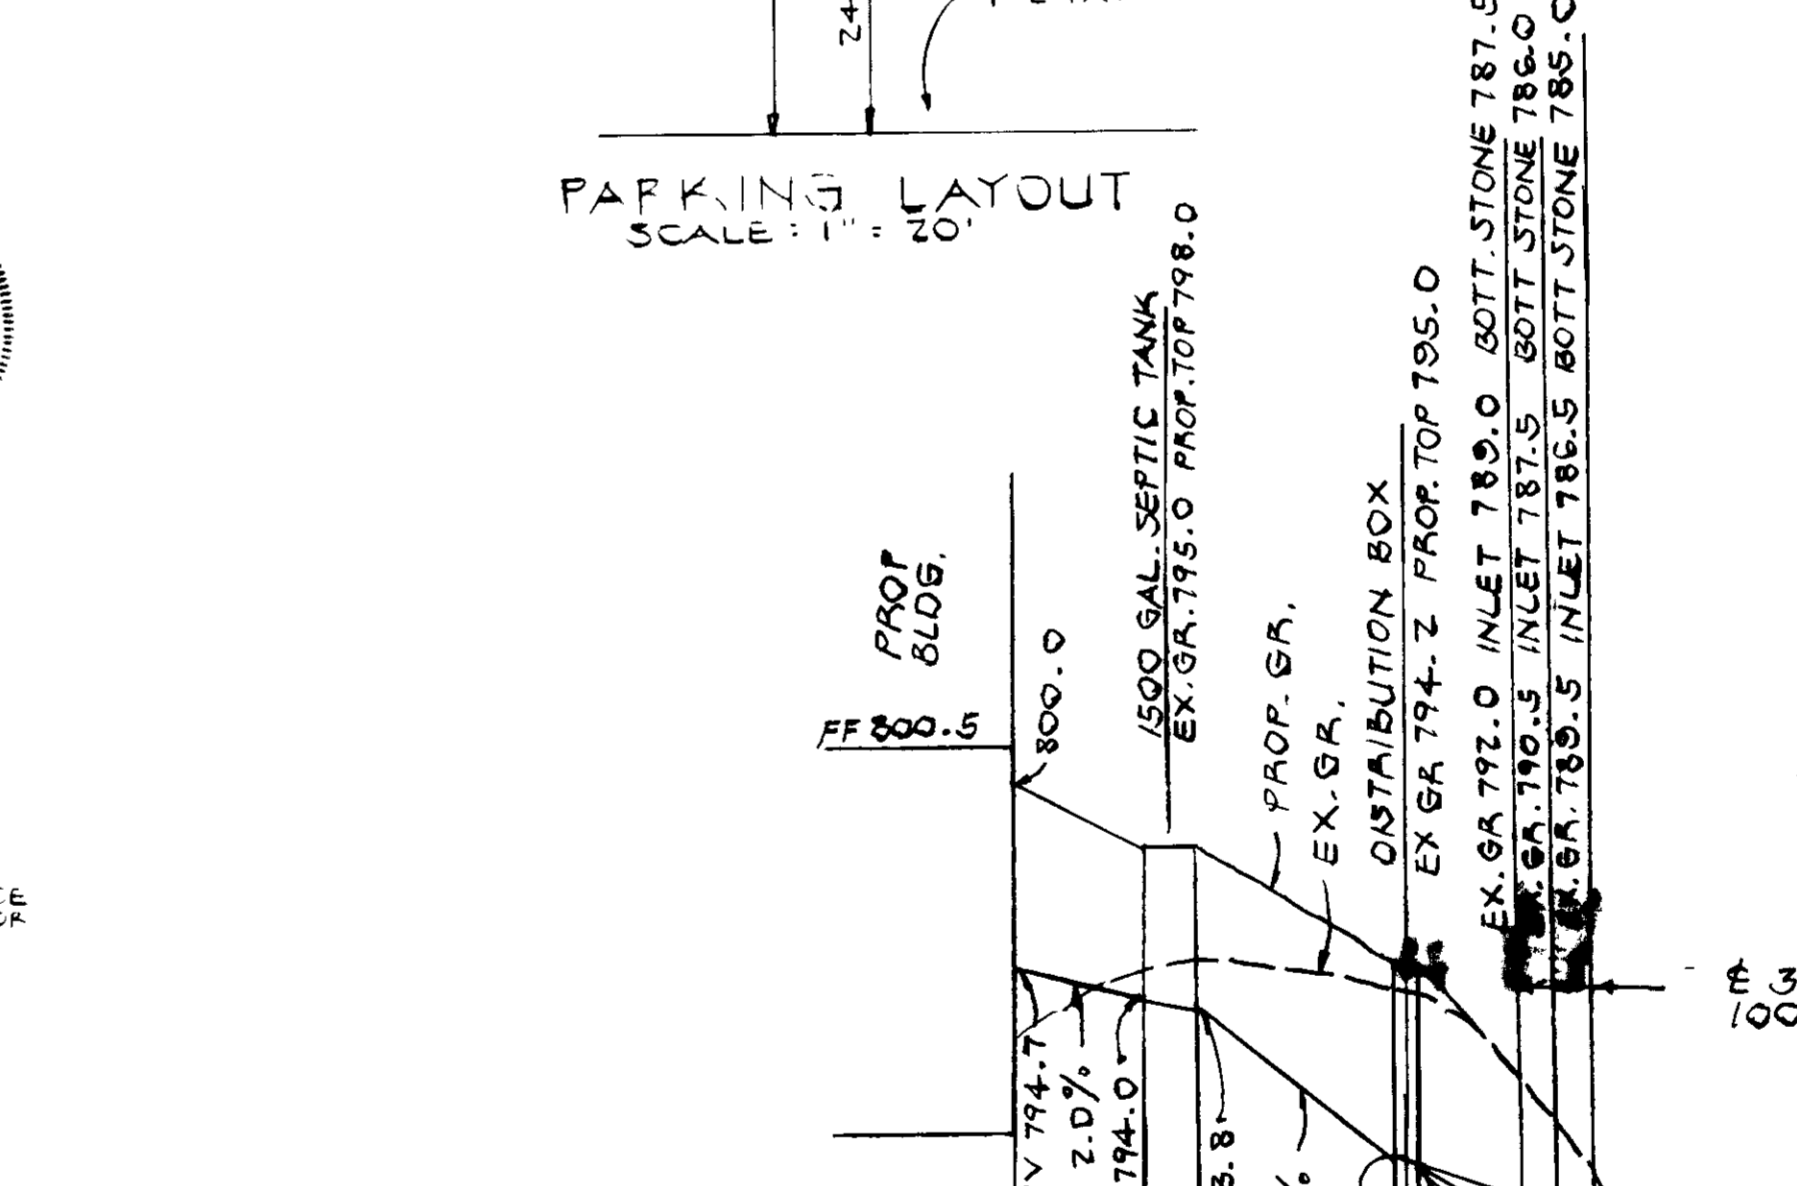

HARFORD DRAFTING & DESIGN, INC.
601 CHARWOOD COURT
EDGEWOOD, MD. 21040
301-679-8719

ENGINEER'S CERTIFICATE
"I certify that this plan for pond construction, erosion and sediment control represents a practical and workable plan based on my personal knowledge of the site conditions. This plan was prepared in accordance with the requirements of the Howard Soil Conservation District. I have notified the developer that he must provide the Howard Soil Conservation District with an "as-built" plan of the pond within 30 days of completion."

Paul E. Wicko, P.E.
SIGNATURE OF ENGINEER
DATE: *10-24-88*

DEVELOPER'S CERTIFICATE
"I/We certify that all development and/or construction will be done according to these plans, and that any responsible personnel involved in the construction project will have a Certificate of Attendance at a Department of Natural Resources Approved Training Program for the Control of Sediment and Erosion before beginning the project. I will provide the Howard Soil Conservation District with an "as-built" plan of the pond within 30 days of completion. I also authorize periodic on-site inspections by the Howard Soil Conservation District."

Daniel Snell
SIGNATURE OF DEVELOPER
DATE: *10-24-88*

APPROVAL: DEPT. OF PLANNING & ZONING
James P. Smith
PLANNING DIRECTOR
DATE: *11/12/88*

APPROVAL: DEPARTMENT OF PUBLIC WORKS FOR PUBLIC GUTS AND STORM DRAINAGE SYSTEMS
James P. Smith
DIRECTOR, PUBLIC WORKS
DATE: *11/14/88*

APPROVAL: HOWARD COUNTY HEALTH DEPARTMENT FOR PRIVATE WATER AND SEWERAGE SYSTEMS
Josephine B. M...
HEALTH OFFICER
DATE: *1-21-90*

APPROVAL: DEPARTMENT OF PUBLIC WORKS FOR PUBLIC GUTS AND STORM DRAINAGE SYSTEMS
William B. R...
CHIEF, BUREAU OF ENGINEERING
DATE: *1-25-91*

PROPERTY / SUBDIVISION: D.R. SNELL NURSERY
SECTION / AREA: -
PANEL / LOT NO: 100

PLAT NO. / L.F. BLOCK NO. ZONE / TAX / ZONE ELECT. DIST. CENSUS TR. 1630-375 1 R G 4 6040

WATER CODE: SEWER CODE:

SITE DEVELOPMENT PLAN
D.R. SNELL NURSERY
RIDGE ROAD, MD. RTE. 57
FOURTH ELECT. DISTRICT
HOWARD CO., MARYLAND
AUGUST 11, 1988
SCALE: AS SHOWN
SHEET 2 OF 5

| BOTANICAL NAME | COMMON NAME | SIZE | CALIPER | ROOT | QUANTITY | SYMBOL |
|-----------------|-------------|---------|-----------|---------|----------|--------|
| ACER RUBRUM | RED MAPLE | 10'-12' | 2"-2 1/2" | 3" BALL | 19 | ⊙ |
| LEYLANDO CYPRUS | | 5'-6' | 1 1/2"-2" | 2'-6" | 33 | ★ |



PERMANENT SEEDING NOTES:
 APPLY TO GRADED OR CLEARED AREA NOT SUBJECT TO IMMEDIATE FURTHER DISTURBANCE WHEN A PERMANENT LONG-LIVED VEGETATIVE COVER IS NEEDED.

SEEDBED PREPARATION: LOOSEN UPPER THREE-INCHES OF SOIL BY RAKING, DISCING OR OTHER ACCEPTABLE MEANS BEFORE SEEDING. IF NOT PREVIOUSLY LOOSENED, SOIL ANCHORMENTS IN LIEU OF SOIL TEST RECOMMENDATIONS, USE ONE OF THE FOLLOWING SCHEDULES:

- 1) PREFERRED - APPLY 2 TONS PER ACRE DOLOMITIC LIMESTONE (92 LBS/1000 SQ. FT.) AND 600 LBS PER ACRE 10-10-10 FERTILIZER (14 LBS/1000 SQ. FT.) BEFORE SEEDING. HARRON OR DISC INTO UPPER THREE-INCHES OF SOIL. AT TIME OF SEEDING, APPLY 400 LBS. PER ACRE 30-0-0 UREAFORM FERTILIZER (9 LBS/1000 SQ. FT.)
- 2) ACCEPTABLE - APPLY 2 TONS PER ACRE DOLOMITIC LIMESTONE (92 LBS/1000 SQ. FT.) AND 1000 LBS. PER ACRE 10-10-10 FERTILIZER (23 LBS/1000 SQ. FT.) BEFORE SEEDING. HARRON OR DISC INTO UPPER THREE-INCHES OF SOIL.

SEEDING: FOR THE PERIODS MARCH 1 THRU APRIL 30, AND AUGUST 1 THRU OCTOBER 15, SEED WITH 60 LBS. PER ACRE (1.4 LBS/1000 SQ. FT.) OF KENTUCKY 31 TALL FESCUE. FOR THE PERIOD MAY 1 THRU JULY 31, SEED WITH 60 LBS. KENTUCKY 31 TALL FESCUE PER ACRE AND 2 LBS. PER ACRE (.05 LBS/1000 SQ. FT.) OF WEEPING LOVERGRASS. DURING THE PERIOD OF OCTOBER 16 THRU FEBRUARY 28, PROTECT SITE BY OPTION (1) 2 TONS PER ACRE OF WELL ANCHORED STRAW MULCH AND SEED AS SOON AS POSSIBLE IN THE SPRING. OPTION (2) USE SOO. OPTION (3) SEED WITH 60 LBS/ACRE KENTUCKY 31 TALL FESCUE AND MULCH WITH 2 TONS/ACRE WELL ANCHORED STRAW.

MULCHING: APPLY 1 1/2 TO 2 TONS PER ACRE (70 TO 90 LBS/1000 SQ. FT.) OF UNROTTED SMALL DRAIN STRAW IMMEDIATELY AFTER SEEDING. ANCHOR MULCH IMMEDIATELY AFTER APPLICATION USING MULCH ANCHORING TOOL OR 218 GALLONS PER ACRE (8 GAL/1000 SQ. FT.) OF EMULSIFIED ASPHALT ON FLAT AREAS. ON SLOPES 8 FEET OR HIGHER, USE 348 GALLONS PER ACRE (8 GAL/1000 SQ. FT.) OR HIGHER. MAINTENANCE: INSPECT ALL SEEDING AREAS AND MAKE NEEDED REPAIRS, REPLACEMENTS AND RESEEDINGS.

TEMPORARY SEEDING NOTES:
 APPLY TO GRADED OR CLEARED AREAS LIKELY TO BE REDISTURBED WHERE A SHORT-TERM VEGETATIVE COVER IS NEEDED.

SEEDBED PREPARATION: LOOSEN UPPER THREE-INCHES OF SOIL BY RAKING, DISCING OR OTHER ACCEPTABLE MEANS BEFORE SEEDING. IF NOT PREVIOUSLY LOOSENED, SOIL ANCHORMENTS: APPLY 600 LBS PER ACRE 10-10-10 FERTILIZER (14 LBS/1000 SQ. FT.)



SEEDING: FOR PERIODS MARCH 1 THRU APRIL 30 AND FROM AUGUST 15 THRU NOVEMBER 15, SEED WITH 2 1/2 TONS PER ACRE OF ANNUAL RYE (3.2 LBS/1000 SQ. FT.). FOR THE PERIOD MAY 1 THRU AUGUST 14, SEED WITH 3 LBS PER ACRE OF WEEPING LOVERGRASS (.07 LBS/1000 SQ. FT.). FOR THE PERIOD NOVEMBER 16 THRU FEBRUARY 28, PROTECT SITE BY APPLYING 2 TONS PER ACRE OF WELL ANCHORED STRAW MULCH AND SEED AS SOON AS POSSIBLE IN THE SPRING. OR USE SOO.

MULCHING: APPLY 1 1/2 TO 2 TONS PER ACRE (70 TO 90 LBS/1000 SQ. FT.) OF UNROTTED SMALL DRAIN STRAW IMMEDIATELY AFTER SEEDING. ANCHOR MULCH IMMEDIATELY AFTER APPLICATION USING MULCH ANCHORING TOOL OR 218 GAL PER ACRE (8 GAL/1000 SQ. FT.) OF EMULSIFIED ASPHALT ON FLAT AREAS. ON SLOPES 8 FT. OR HIGHER, USE 348 GAL PER ACRE (8 GAL/1000 SQ. FT.) FOR ANCHORING.

REFER TO THE 1983 MARYLAND STANDARDS AND SPECIFICATIONS FOR SOIL EROSION AND SEDIMENT CONTROL FOR RATE AND METHODS NOT COVERED.

OWNER & DEVELOPER
 O. R. SNELL
 1025 RIDGE ROAD
 MT. AIRY, MD. 21771
 831-1777

- SEQUENCE OF CONSTRUCTION**
- 1 OBTAIN GRADING PERMIT
 - 2 NOTIFY THE HOWARD COUNTY OFFICE OF INSPECTION AND PERMITS 24 HOURS BEFORE STARTING WORK
 - 3 INSTALL ALL EROSION AND SEDIMENT CONTROL DEVICES
 - 4 FINISH GRADE SITE
 - 5 BEGIN BUILDING CONSTRUCTION
 - 6 FINE GRADE SITE
 - 7 PLACE SUB-BASE MATERIAL ON PARKING LOT *
 - 8 STABILIZE REMAINING AREAS PER SEEDING LOT *
 - 9 PAVE PARKING LOT
 - 10 MODIFY EXISTING POND PER PLANS
 - 11 STABILIZE DISTURBED AREAS PER SEEDING PROCEDURES
 - 12 REMOVE EROSION AND SEDIMENT CONTROL DEVICES AND STABILIZE THOSE AREAS
- * INSTALL SEPTIC SYSTEM

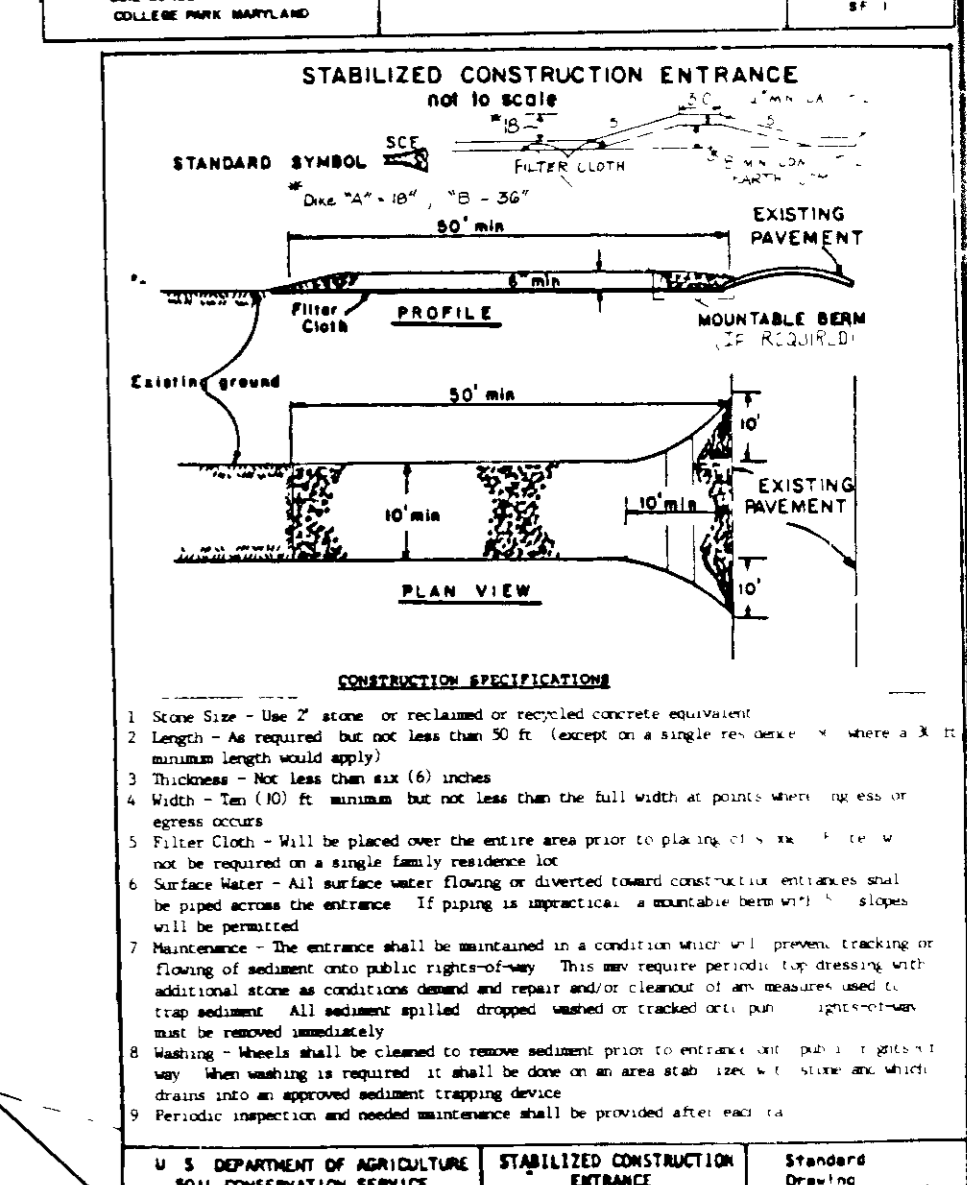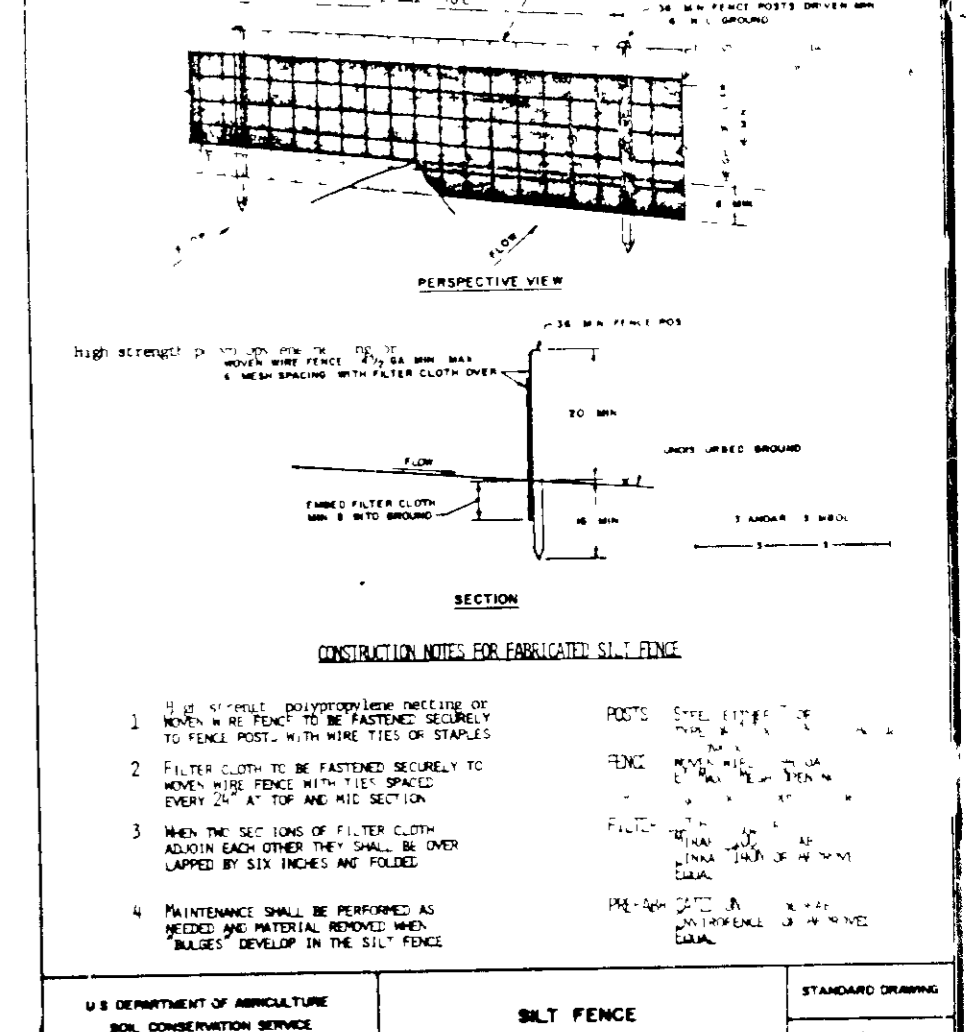

- SEEDING CONTROL NOTES**
- 1) A minimum of 24 hours notice must be given to the Howard County Office of Inspection and Permits prior to the start of any construction (892-2437)
 - 2) All vegetative and structural practices are to be installed according to the provisions of this plan and are to be in conformance with the 1983 MARYLAND STANDARDS AND SPECIFICATIONS FOR SOIL EROSION AND SEDIMENT CONTROL.
 - 3) Following initial soil disturbance or disturbance permanent or temporary stabilization shall be completed within a) 7 calendar days for all permanent sediment control structures, ditches, perimeter ditches and all slopes greater than 3:1, b) 14 days as to all other disturbed or graded areas on the project site.
 - 4) All sediment traps/basins shown must be sized and sited in accordance with the 1983 MARYLAND STANDARDS AND SPECIFICATIONS for Chapter 12 of the HOWARD COUNTY DESIGN MANUAL, Storm Drainage.
 - 5) All graded areas must be stabilized within the time period specified above in accordance with the 1983 MARYLAND STANDARDS AND SPECIFICATIONS FOR SOIL EROSION AND SEDIMENT CONTROL for permanent seed mix (See 51) and (See 52). Temporary stabilization with mulch shall not be used unless recommended seed mix does not allow for proper germination and establishment of grass.
 - 6) All sediment control structures are to remain in place and are to be maintained in operative condition until permission for their removal has been obtained from the Howard County Sediment Control Inspector.
 - 7) Site Analysis:
 Total Area of Site: 17.25 Acres
 Area Disturbed: 2.00 Acres
 Area to be seeded or graded: 15.25 Acres
 Area to be vegetatively stabilized: 15.25 Acres
 Total Cut: 1500 Cu Yds
 Total Fill: 1500 Cu Yds
 Off-site waste/borrow area location: N/A
 - 8) Any sediment control practice which is disturbed by grading activity for placement of utilities must be restored on the same day of disturbance.
 - 9) Additional sediment controls must be provided if deemed necessary by the Howard County DPW sediment control inspector.
 - 10) On all areas which disturbed areas in excess of 2 acres approval of the inspection agency shall be required upon completion of installation of sediment controls and before proceeding with any other earth disturbance or grading. Other building or construction approvals may not be authorized until this initial approval by the inspection agency is made.

ENGINEER'S CERTIFICATE

HARFORD DRAFTING & DESIGN, INC.
 601 CHARWOOD COURT
 EDGEWOOD, MD. 21040
 301-679-8719

I certify that this plan for pond construction, erosion and sediment control represents a practical and workable plan based on my personal knowledge of the site conditions. This plan was prepared in accordance with the requirements of the Howard Soil Conservation District. I have notified the developer that he must provide the Howard Soil Conservation District with an "as-built" plan of the pond within 30 days of completion.

Donald E. Hildebrand, P.E.
 SIGNATURE OF ENGINEER
 DATE: 10-24-88

DEVELOPER'S CERTIFICATE

I/We certify that all development and/or construction will be done according to these plans, and that any responsible personnel involved in the construction project will have a Certificate of Attendance at a Department of Natural Resources Approved Training Program for the Control of Sediment and Erosion before beginning the project. I will provide the Howard Soil Conservation District with an "as-built" plan of the pond within 30 days of completion. I also authorize periodic on-site inspections by the Howard Soil Conservation District.

O. R. Snell
 SIGNATURE OF DEVELOPER
 DATE: 10-24-88

APPROVED DEPT OF PLANNING AND ZONING

James Smith 4/12/91
 PLANNING DIRECTOR DATE

Mark J. DeCamp 4/12/91
 CHIEF, DIVISION OF COMMUNITY PLANNING & LAND DEVELOPMENT DATE

APPROVED HOWARD COUNTY HEALTH DEPARTMENT FOR PRIVATE WATER AND SEWERAGE SYSTEMS

James Boyd 1-21-90
 HEALTH OFFICER DATE

APPROVED DEPARTMENT OF PUBLIC WORKS FOR PUBLIC ROADS AND STORM DRAINAGE SYSTEMS

James A. Shaw 4/14/91
 DIRECTOR, PUBLIC WORKS DATE

McCaskey & Riley 1-28-91
 CHIEF, BUREAU OF ENGINEERING DATE

PROPERTY/SUBDIVISION: DR SNELL NURSERY
 SECTION/AREA: -
 PARCEL/LOT NO: 100
 PLAT NO./LF: 1630-325
 BLOCK NO: 1
 ZONE: R
 TAX/ZONE: 6
 ELEC. DIST: 4
 CENSUS TR: 6040
 WATER CODE: -
 SEWER CODE: -

LEGEND

- LIMIT OF DISTURBANCE: - - - - -
- SILT FENCE: 5 --- 5 --- 5
- STABILIZED CONSTRUCTION ENTRANCE WITH MOUNTABLE BEAM: [Symbol]
- EX. CONTOURS: [Symbol]
- PROP. CONTOURS: [Symbol]

OWNER'S CERTIFICATE



O. R. SNELL NURSERY
 RIDGE ROAD, MOUNT AIRY, MD.
 FOURTH ELECT. DISTRICT
 HOWARD COUNTY, MARYLAND
 AUGUST 11, 1988
 SCALE: 1"=50'
 SHEET 3 OF 5
 SDP 89-77

PLAN

ENCL. CLEMENTS
323-243
P 106

OFFSITE TO POND
84.8 AC.

| BOTANICAL NAME COMMON NAME | SIZE | CALIPER | ROOT | QUANTITY | SYMBOL |
|-------------------------------|---------|-----------|--------|----------|--------|
| ACER RUBRUM RED MAPLE | 10'-12' | 2"-2 1/2" | 3 BALL | 19 | ⊙ |
| LEYLAND CYPRUS | 5'-6' | 1 1/2"-2" | 2-6' | 33 | ✱ |

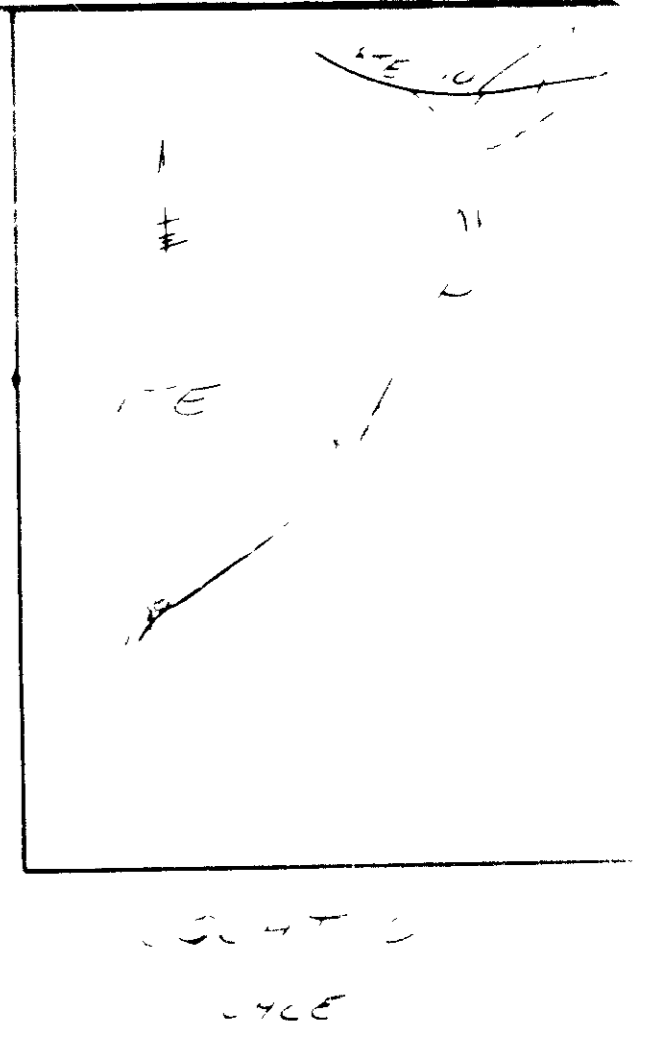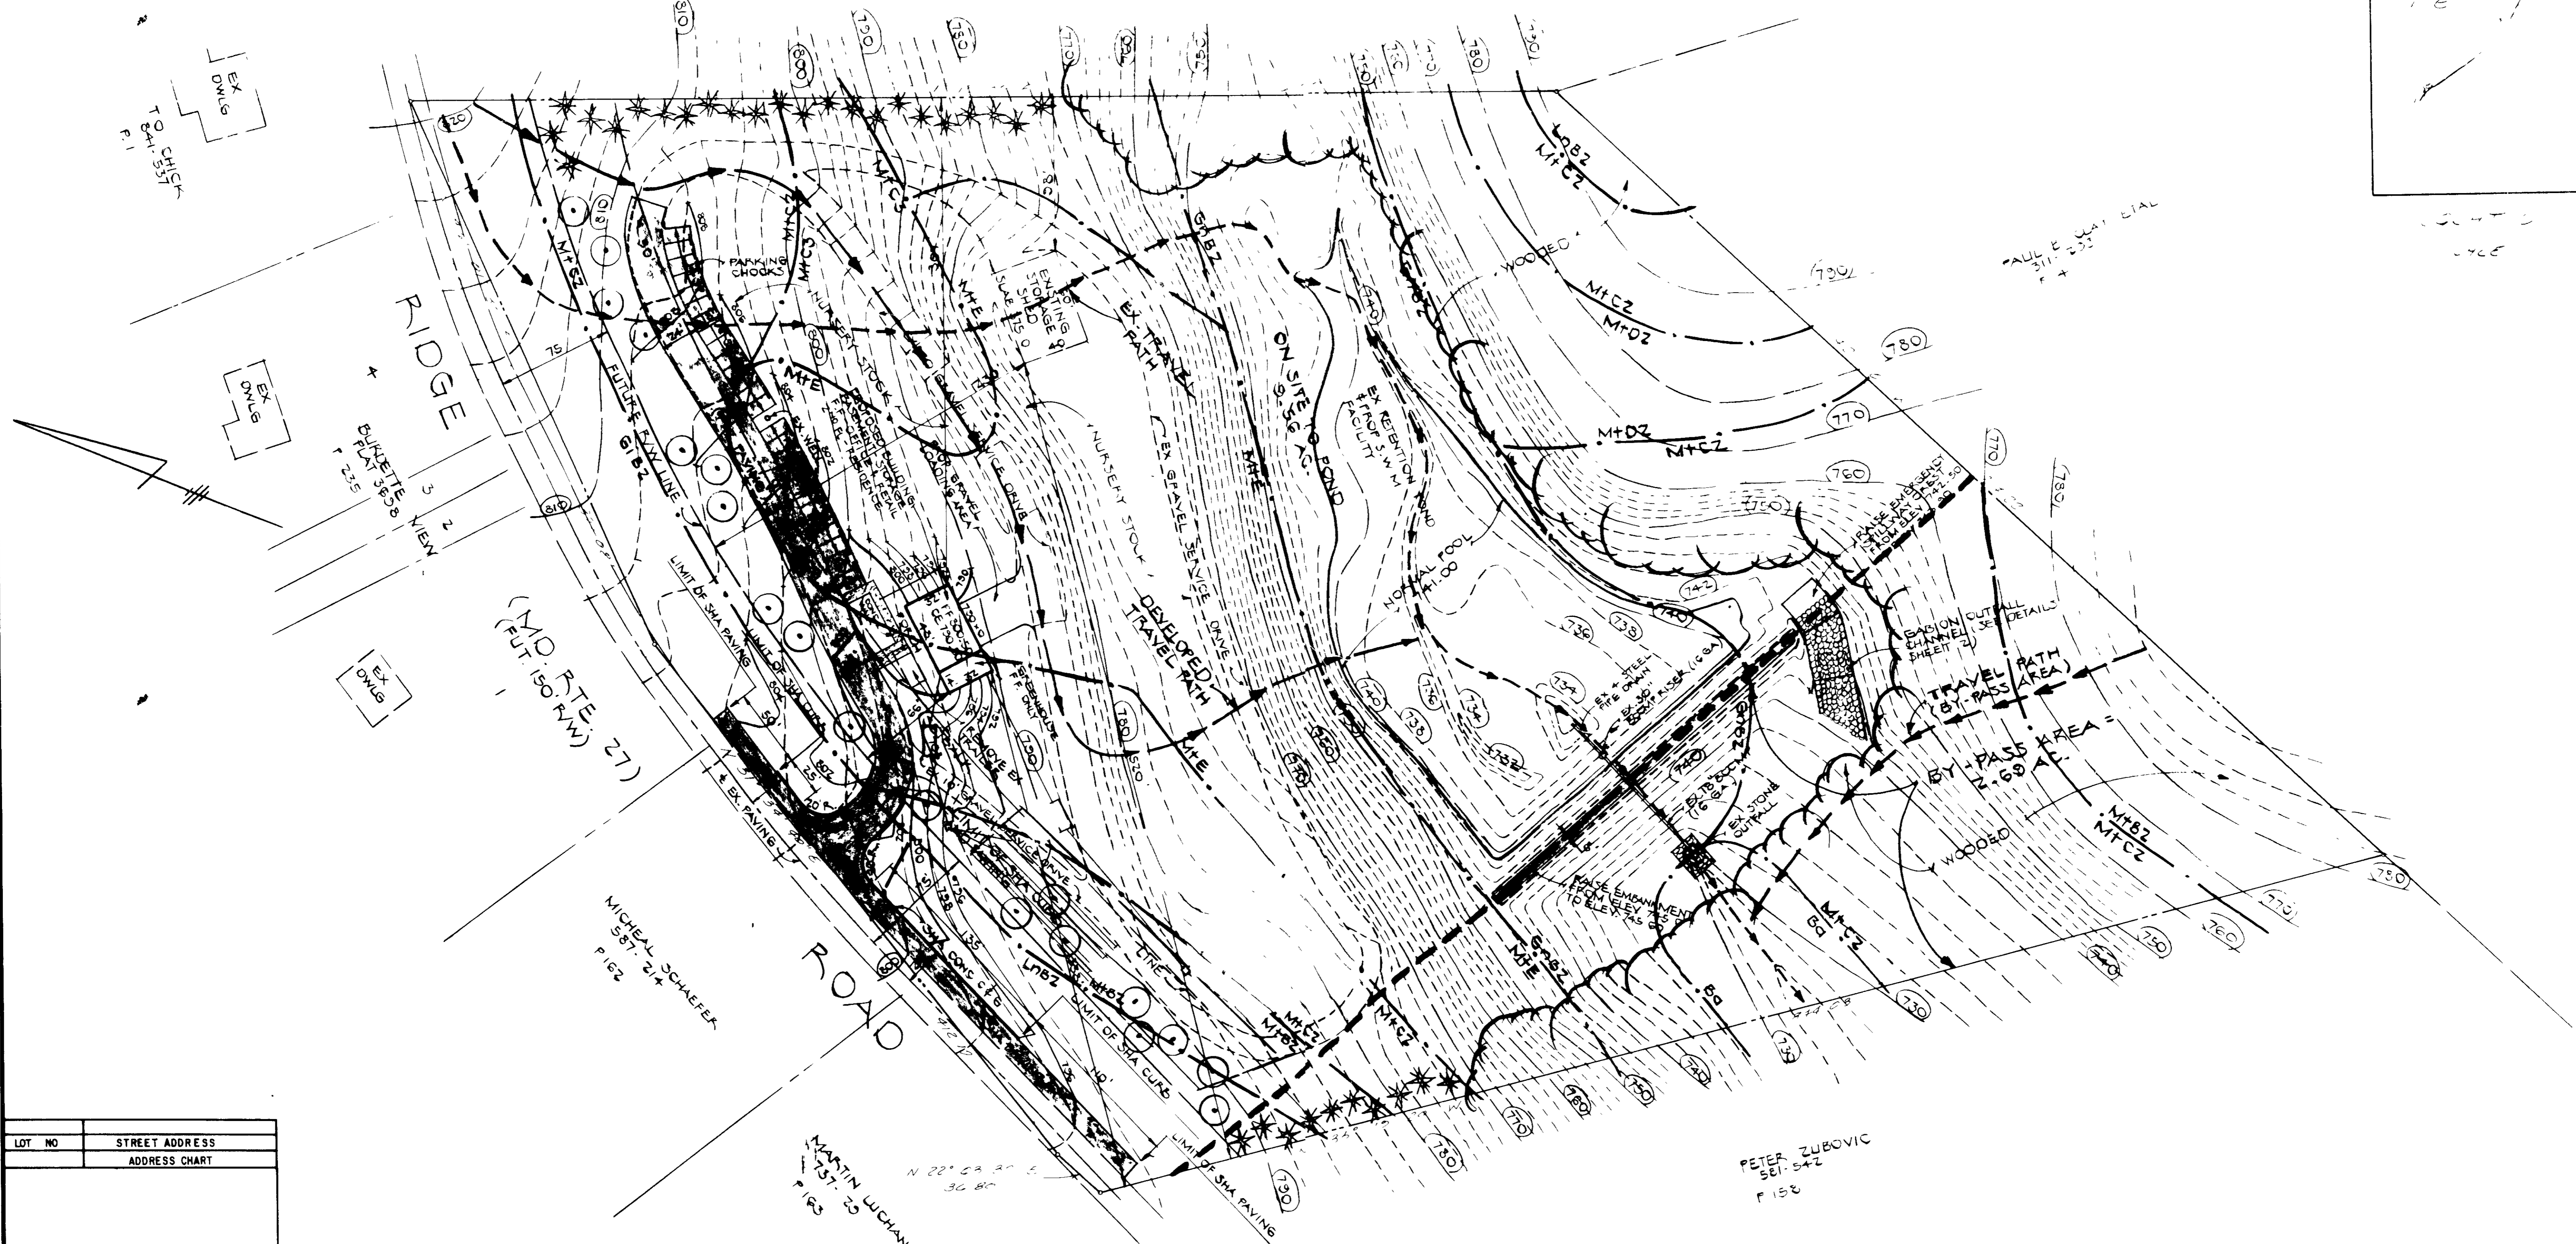

| LOT NO | STREET ADDRESS |
|--------|----------------|
| | ADDRESS CHART |

OWNER & DEVELOPER
D. R. SNELL
1025 RIDGE ROAD
MT. AIRY, MD 21771
831-7777



Donald E. Wilks, P.E.

HARFORD DRAFTING & DESIGN, INC.
601 CHARWOOD COURT
EDGEWOOD, MD. 21040
301-679-8719

ENGINEER'S CERTIFICATE
"I certify that this plan for pond construction, erosion and sediment control represents a practical and workable plan based on my personal knowledge of the site conditions. This plan was prepared in accordance with the requirements of the Howard Soil Conservation District. I have notified the developer that he must provide the Howard Soil Conservation District with an "as-built" plan of the pond within 30 days of completion."

Donald E. Wilks, P.E.
SIGNATURE OF ENGINEER
DATE: 12/27/90

DEVELOPER'S CERTIFICATE
"I/we certify that all development and/or construction will be done according to these plans, and that any responsible personnel involved in the construction project will have a Certificate of Attendance at a Department of Natural Resources Approved Training Program for the Control of Sediment and Erosion before beginning the project. I will provide the Howard Soil Conservation District with an "as-built" plan of the pond within 30 days of completion. I also authorize periodic on-site inspections by the Howard Soil Conservation District."

D. R. Snell
SIGNATURE OF DEVELOPER
DATE: 12/27/90

These plans have been reviewed for the Howard Soil Conservation District and meet the technical requirements for small pond construction, soil erosion and sediment control.
James W. Johnson 12/27/90
Howard Soil Conservation District
DATE: 12/27/90

These plans for small pond construction, soil erosion and sediment control meet the requirements of the Howard Soil Conservation District.
Robert W. Johnson 12/27/90
Howard Soil Conservation District
DATE: 12/27/90

APPROVED LEFT OF PLANNING AND ZONING
James W. Johnson 4/12/91
PLANNING DIRECTOR DATE
Robert W. Johnson 4/12/91
CHIEF, DIVISION OF COMMUNITY PLANNING & LAND DEVELOPMENT DATE
APPROVED HOWARD COUNTY HEALTH DEPARTMENT FOR PRIVATE WATER AND SEWERAGE SYSTEMS
Joseph M. Boyle 1-21-90
HEALTH OFFICER DATE

APPROVED DEPARTMENT OF PUBLIC WORKS FOR PUBLIC ROAD AND STORM DRAINAGE SYSTEMS.
James W. Johnson 4/14/91
DIRECTOR, PUBLIC WORKS DATE
Robert W. Johnson 1-29-91
CHIEF, BUREAU OF ENGINEERING DATE

| | | |
|----------------------|--------------|---------------|
| PROPERTY/SUBDIVISION | SECTION/AREA | PARCEL/LOT NO |
| O.R. SNELL NURSERY | | 109 |
| PLAT NO / L.F. | BLOCK NO | ZONE |
| 1630-325 | 1 | R |
| TAX / ZONE | ELEC DIST | CENSUS TR |
| 6 | 4 | 6040 |
| WATER CODE | SEWER CODE | |

O.R. SNELL NURSERY
RIDGE ROAD, MD. RTE. 27
FOURTH ELECT DISTRICT
HOWARD CO, MARYLAND
AUGUST 11, 1988
SHEET 4 OF 5
SDP 89-77

