


EX OF SHEETS

SHEET NO.	TITLE
1	KEY SHEET
2	SITE DEVELOPMENT PLAN - LOTS 62 THROUGH AND LOTS 70 THRU 76
3	SITE DEVELOPMENT PLAN - LOTS 77 THRU 81 AND LOTS 100 THRU 111
4	SITE DEVELOPMENT PLAN - LOTS 82 THRU 98
5	SITE DEVELOPMENT PLAN - LOTS 112 THRU 117 AND LOTS 119 THRU 125
6	SITE DEVELOPMENT PLAN - LOTS 124 THRU 135
7	SEDIMENT CONTROL PLAN - LOTS 62 THRU 68 AND LOTS 70 THRU 76
8	SEDIMENT CONTROL PLAN - LOTS 77 THRU 81 AND LOTS 100 THRU 111
9	SEDIMENT CONTROL PLAN - LOTS 82 THRU 98
10	SEDIMENT CONTROL PLAN - LOTS 112 THRU 117 AND LOTS 119 THRU 125
11	SEDIMENT CONTROL PLAN - LOTS 124 THRU 135
12	NOTES AND DETAILS

WATER AND SEWER CODE FOR COUNTY
 USE ONLY
 WATER NO. 901
 SEWER NO. 2900000

ADDRESS CHART

LOT NO.	STREET	ADDRESS
62	5201	KING SUN LANE
63	5205	"
64	5209	"
65	5203	SPURK TERRACE
66	5209	"
67	5213	"
68	5217	"
70	5208	"
71	5204	"
72	5212	KING SUN LANE
73	5221	"
74	5225	"
75	5229	"
76	5233	"
77	5237	"
78	5241	"
79	5245	"
80	5249	"
81	5253	"
82	5257	"
83	5201	"
84	5205	"
85	5209	"
86	5213	"
87	5217	"
88	5221	"
89	O.S.	"
90	5280	"
91	5276	"
92	5272	"
93	5268	"
94	5264	KING SUN LANE
95	5229	GLENNMAR ROAD
96	8233	"
97	8237	"
98	8222	"
100	5252	KING SUN LANE
101	5248	"
102	5244	"
103	5240	"
104	5207	FOREST MEADOW COURT
105	5211	"
106	5215	"
107	5214	"
108	5210	"
109	5206	"
110	5232	KING SUN LANE
111	5228	"
112	5205	HILLMONT COURT
113	5209	"
114	5213	"
115	5217	"
116	5221	"
117	5225	"
118	5229	"
119	5233	"
120	5237	"
121	5241	"
122	5245	"
123	5249	"
124	5204	"
125	5212	KING SUN LANE
126	5208	"
127	5204	NEW PROSPECT COURT
128	5211	"
129	5215	"
130	5219	"
131	5223	"
132	5218	"
133	5214	"
134	5210	"
135	5206	"
136	5202	NEW PROSPECT COURT

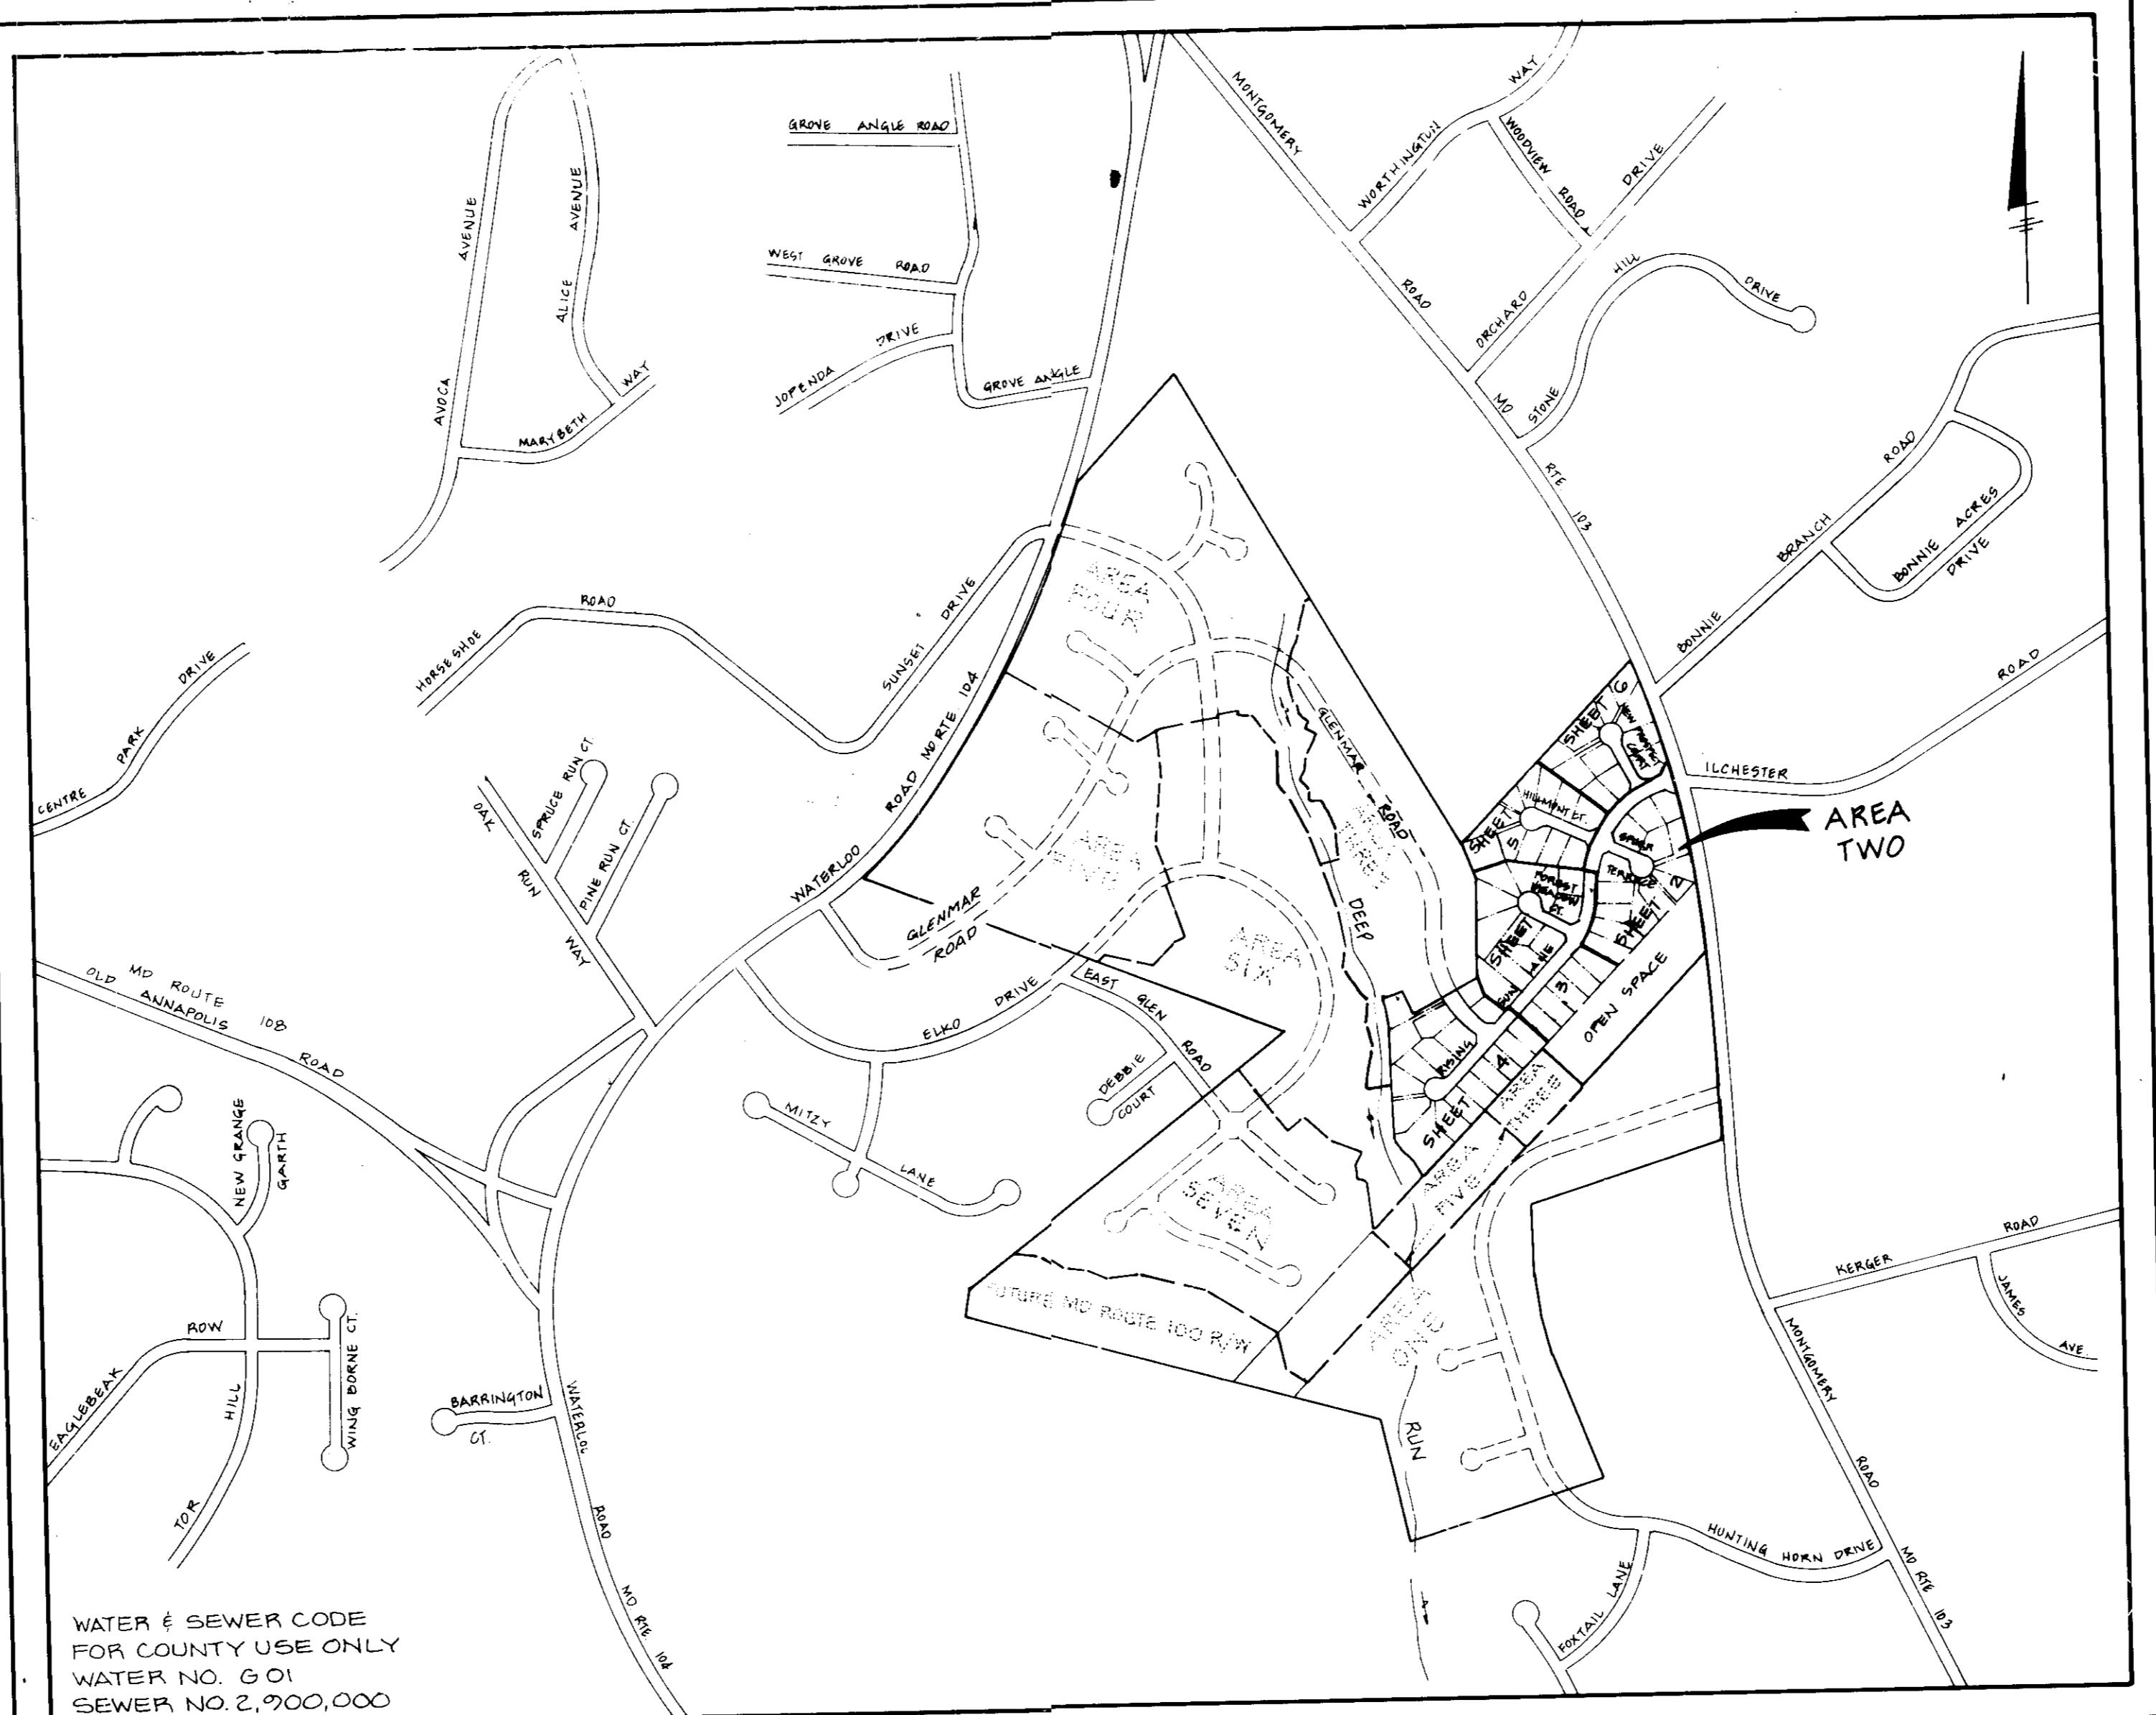

WATER & SEWER CODE
 FOR COUNTY USE ONLY
 WATER NO. 901
 SEWER NO. 2,900,000

LOCATION MAP

SCALE 1"=500'

VICINITY MAP

GENERAL NOTES

- Site Analysis:
 - Total Area of Lots: 31.65 AC±
 - Total Number of Lots: 71
 - Present Zoning: R-20 (Single Family/Detached)
 - Tax Map 31 Part of Parcel 423
 - Plat Reference:
- Typical Minimum Building Set Backs
 - Front:
 - Lots 20,000 s.f. and greater: 50'
 - Lots less than 20,000 s.f.: 40'
 - Rear: 30'
 - Side: 10'
 - Corner Lot: 30'
- For typical house dimensions, house profiles, construction details, sediment control notes and specifications see sheet 12 of 12.
- All work shown on these plans shall be done in accordance with Howard County Standards, Specifications and Details for Construction, Volume IV.
- The contractor and/or the developer shall notify all utility companies 24 hours (minimum) prior to commencement of any work shown on these plans.
- The contractor and/or the developer shall notify the Howard County Inspection/Surveys Division at least 3 days (72 hours) minimum prior to commencement of any work shown on these plans.
- Any damage to existing public right-of-ways, existing paving, existing curb and gutter, existing utilities, etc. shall be corrected at the contractor's expense.
- The approximate location of existing utilities are shown for the contractor's information and convenience. The contractor shall locate existing utilities to his own satisfaction and well advance of any construction activities. Additionally, the contractor shall take all necessary precautions to protect all existing utilities and maintain uninterrupted service.
- The street trees shown on these plans are provided under F-88-244.
- Storm water management for this site is provided under F-89-44.
- Water and sewer systems shown on these plans are constructed under contract 14-1864-D.
- REFER TO S-87-61, P-87-71 AND F-88-244 FOR OTHER PLAN APPROVALS
- DECLARATION OF MAINTENANCE AGREEMENTS FOR USE IN COMMON ACCESS AREAS HAVE BEEN SUBMITTED FOR RECORD AND HAVE BEEN ISSUED THE FOLLOWING RECEIPT NUMBERS.

LOTS	RECEIPT #
96+97	856760
126+128	856740

MONTGOMERY MEADOWS

SECTION ONE AREA TWO

SITE DEVELOPMENT PLAN

1ST ELECTION DISTRICT

HOWARD COUNTY, MARYLAND

Dewberry & Davis
 ARCHITECTS ENGINEERS PLANNERS SURVEYORS

3300 Ridge Road
 Suite 100
 Ellicott City, Maryland
 21043

(301) 461-7478 BALTIMORE
 (301) 621-4973 WASHINGTON

ENGINEER'S CERTIFICATE
 I HEREBY CERTIFY THAT THIS PLAN FOR EROSION AND SEDIMENT CONTROL REPRESENTS A PRACTICAL AND WORKABLE PLAN BASED ON MY PERSONAL KNOWLEDGE OF THE SITE CONDITIONS AND THAT IT HAS BEEN PREPARED IN ACCORDANCE WITH REQUIREMENTS OF THE HOWARD SOIL CONSERVATION DISTRICT.

Thomas L. Wiley
 THOMAS L. WILEY, M.E. REG. NO. 9273
 DATE 1-10-90

DEVELOPER'S CERTIFICATE
 I HEREBY CERTIFY THAT ALL DEVELOPMENT AND CONSTRUCTION WILL BE DONE ACCORDING TO THIS PLAN OF DEVELOPMENT AND PLAN FOR EROSION AND SEDIMENT CONTROL AND THAT ALL RESPONSIBLE PERSONNEL INVOLVED IN THE CONSTRUCTION PROJECT WILL HAVE A CERTIFICATE OF ATTENDANCE AT A DEPARTMENT OF NATURAL RESOURCES APPROVED TRAINING PROGRAM FOR THE CONTROL OF SEDIMENT AND EROSION BEFORE BEGINNING THE PROJECT. I ALSO AUTHORIZE PERIODIC ON-SITE INSPECTION BY THE HOWARD SOIL CONSERVATION DISTRICT OR THEIR AUTHORIZED AGENTS, AS ARE DEEMED NECESSARY.

Michael G. Clay
 MICHAEL G. CLAY, CAPITAL HOMES INC.
 DATE 1/10/90

REVIEWED FOR HOWARD SOIL CONSERVATION DISTRICT AND MET'S TECHNICAL REQUIREMENTS.

John M. Atkin
 U.S. SOIL CONSERVATION SERVICE
 DATE 8-13-90

THIS DEVELOPMENT IS APPROVED FOR EROSION AND SEDIMENT CONTROL BY THE HOWARD SOIL CONSERVATION DISTRICT.

John M. Atkin
 HOWARD SOIL CONSERVATION DISTRICT
 DATE 2/12/90

APPROVED: HOWARD COUNTY DEPARTMENT OF PLANNING AND ZONING

Walt
 PLANNING DIRECTOR
 DATE 1-30-90

Mark
 CHIEF, DIVISION OF COMMUNITY PLANNING AND LAND DEVELOPMENT

APPROVED: HOWARD COUNTY HEALTH DEPARTMENT FOR PUBLIC WATER AND SEWERAGE SYSTEMS.

Joan
 HEALTH OFFICER
 DATE 4-23-90

APPROVED: DEPARTMENT OF PUBLIC WORKS FOR PUBLIC WATER AND SEWER AND STORM DRAINAGE SYSTEMS AND ROADS.

James
 DIRECTOR, PUBLIC WORKS
 DATE 4/17/90

James
 CHIEF, BUREAU OF ENGINEERING

DATE 4-16-90

WATER CODE 901 SEWER CODE 2,900,000

DEVELOPER

OWNER

NVLand
 6820 ELM STREET McLEAN, VIRGINIA 22101
 (703) 734-9730

Capital Homes
 A Commitment to Quality
 10200 GORMAN ROAD BALT. (301) 792-2467
 LAUREL, MARYLAND 20707 WASH. (309) 853-0671

KEY SHEET

MONTGOMERY MEADOWS
 SECTION ONE AREA TWO
 LOTS 62 THRU 137

TAX MAP 31 P/O PARCEL 423
 1ST ELECTION DISTRICT HOWARD COUNTY, MARYLAND
 SCALE: AS SHOWN DATE: APRIL 4, 1990

SHEET 1 OF 12

DRAWN: J.A.U. DESIGNED: E.D.B. CHECKED: E.D.B. APPROVED: T.L.W.



S.D.P.-89-196

REVISION	DATE	BY
RESITE LOT 64 (BY G.L.W.)	4-25-01	FDM
RESITE LOT 71 (BY G.L.W.)	6-4-01	FDM
RESITE LOT 72 (BY G.L.W.)	8-12-01	HK
RESITE LOT 63 (BY G.L.W.)	11-1-91	HK
RESITE LOT 68 (BY G.L.W.)	2-25-02	HK
RESITE LOT 70 (BY G.L.W.)	2-25-02	HK
RESITE LOT 73 (BY G.L.W.)	2-25-02	HK
RESITE LOT 75 (BY G.L.W.)	2-25-02	HK
RESITE LOT 67 (BY G.L.W.)	3-20-02	HK
RESITE LOT 74 (BY G.L.W.)	5-20-02	HK
LOT 65	2-29-02	CH
RESITE LOT 76 (BY G.L.W.) PAVED HOUSE TYPE	7-28-02	HK
RESITE LOT 69 (BY G.L.W.)	8-11-02	HK
RESITE LOT 66 (BY G.L.W.)	3-1-03	HK
revised grading lots 75, 76 (by G.L.W.)	9/20/03	HK
RESITED LOT 62 (BY G.L.W.)	1/25/03	HKU

GLW Seal Signature applies only to revisions by Gutschick, Little & Weber.

K. H. H. H.

Elevations shown in parenthesis indicate existing conditions after mass grading. Topographic survey performed by Gutschick, Little & Weber, P.A. on 4/23/93

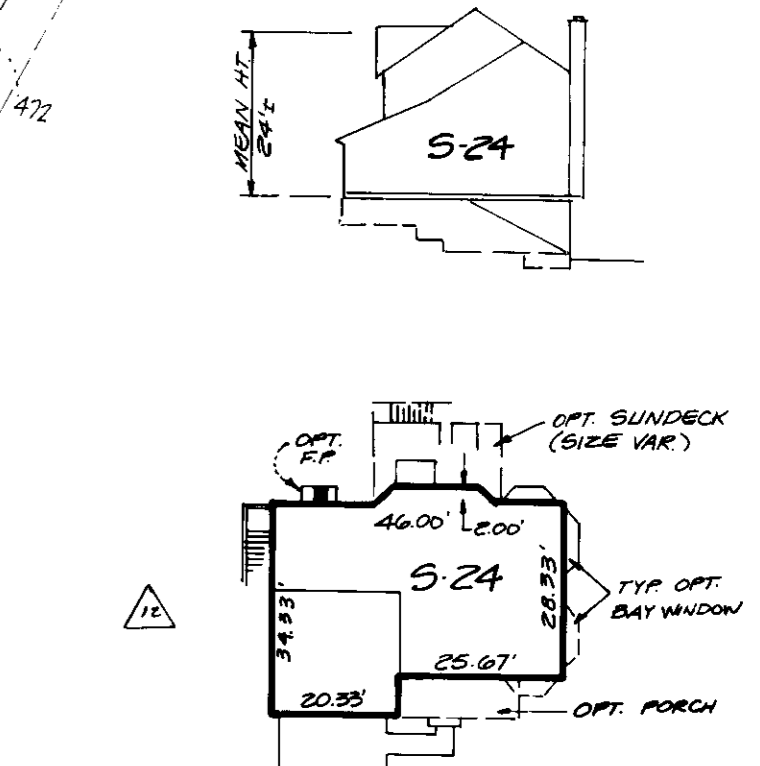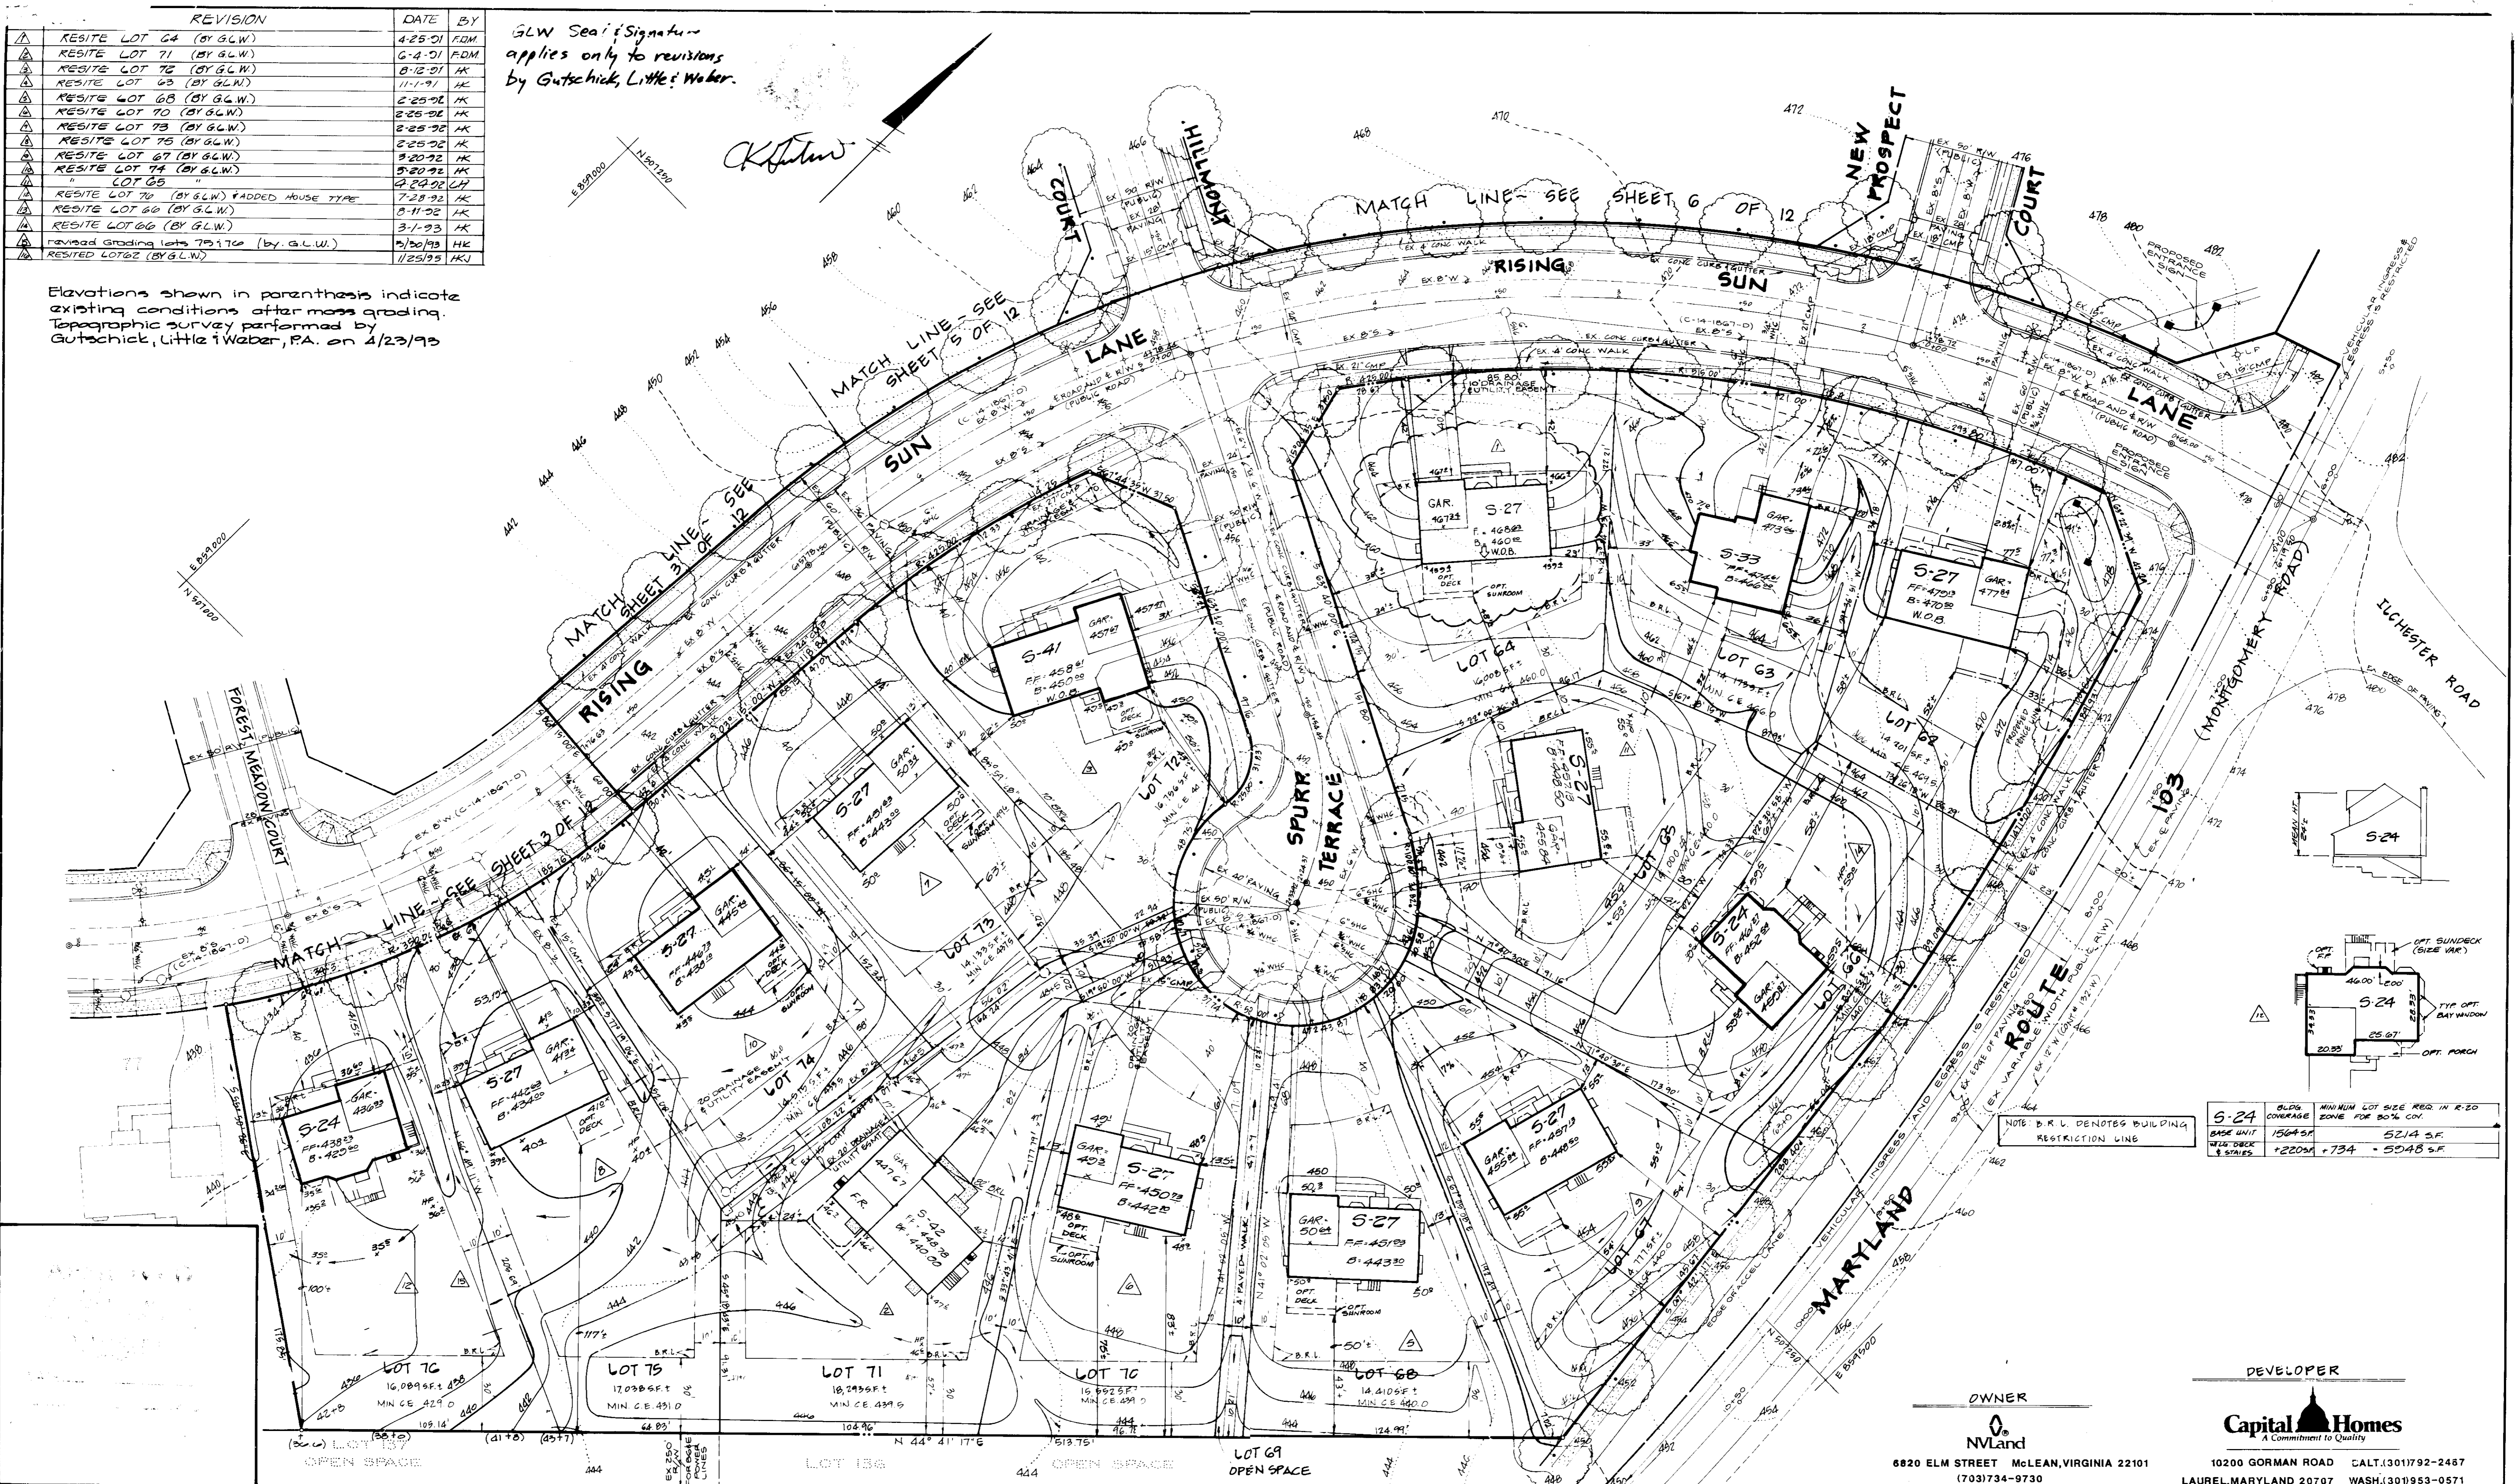

S-24	BLDG COVERAGE	MINIMUM LOT SIDE REQ IN R-20 ZONE FOR 80% COV.
	1564 SF	5214 SF
	+2204 +734	= 5948 SF

DEVELOPER: **Capital Homes**
 A Commitment to Quality
 10200 GORMAN ROAD LAUREL, MARYLAND 20707
 410.301.1792-2487 WASH. 301.953-0571

OWNER: **NVland**
 6820 ELM STREET McLEAN, VIRGINIA 22101
 (703) 734-9730

Dewberry & Davis
 ARCHITECTS ENGINEERS PLANNERS SURVEYORS
 3300 Ridge Road
 Suite 100
 Ellicott City, Maryland
 21043
 (301) 461-7478 BALTIMORE
 (301) 621-4970 WASHINGTON

ENGINEER'S CERTIFICATE
 I HEREBY CERTIFY THAT THIS PLAN FOR EROSION AND SEDIMENT CONTROL REPRESENTS A PRACTICAL AND WORKABLE PLAN BASED ON MY PERSONAL KNOWLEDGE OF THE SITE CONDITIONS AND THAT IT WAS PREPARED IN ACCORDANCE WITH REQUIREMENTS OF THE HOWARD SOIL CONSERVATION DISTRICT.
Alan P. Kelly 1-12-90
 DATE

DEVELOPER'S CERTIFICATE
 I/WE CERTIFY THAT ALL DEVELOPMENT AND CONSTRUCTION WILL BE DONE ACCORDING TO THIS PLAN OF DEVELOPMENT AND PLAN FOR EROSION AND SEDIMENT CONTROL AND THAT ALL RESPONSIBLE PERSONNEL INVOLVED IN THE CONSTRUCTION PROJECT WILL HAVE A CERTIFICATE OF ATTENDANCE AT A DEPARTMENT OF NATURAL RESOURCES APPROVED TRAINING PROGRAM FOR THE CONTROL OF SEDIMENT AND EROSION BEFORE BEGINNING THE PROJECT. I ALSO AUTHORIZE PERIODIC ON-SITE INSPECTION BY THE HOWARD SOIL CONSERVATION DISTRICT OR THEIR AUTHORIZED AGENTS, AS ARE DEEMED NECESSARY.
Michael G. Clay 1/10/90
 DATE


REVIEWED FOR HOWARD SOIL CONSERVATION DISTRICT AND MEETS TECHNICAL REQUIREMENTS.
John M. Allen 2-13-90
 U.S. SOIL CONSERVATION SERVICE DATE
 THIS DEVELOPMENT IS APPROVED FOR EROSION AND SEDIMENT CONTROL BY THE HOWARD SOIL CONSERVATION DISTRICT.
John K. Roberts 1/10/90
 HOWARD SOIL CONSERVATION DISTRICT DATE

APPROVED: HOWARD COUNTY DEPARTMENT OF PLANNING AND ZONING
Christina 4-30-90
 PLANNING DIRECTOR DATE
 APPROVED: HOWARD COUNTY HEALTH DEPARTMENT FOR PUBLIC WATER AND SEWERAGE SYSTEMS.
John A. Roberts 4-23-90
 HEALTH OFFICER DATE

APPROVED: DEPARTMENT OF PUBLIC WORKS FOR PUBLIC WATER AND SEWER AND STORM DRAINAGE SYSTEMS AND ROADS.
James P. ... 4-16-90
 DIRECTOR, PUBLIC WORKS DATE
 SUBDIVISION NAME: MONTGOMERY MEADOWS SECTION/AREA: 1/2 LOT NUMBERS: 62 THRU 131
 PLAT NO.: 14-20 ZONE: R-2C TAX/ELEC. DIST.: 31/101 CENSUS TR.: 1047-5067
 WATER CODE: C-04 SEWER CODE: 2,900,000

SITE DEVELOPMENT PLAN
 MONTGOMERY MEADOWS
 SECTION ONE AREA TWO
 LOTS 62 THRU 131
 TAX MAP 31 P/O PARCEL 123
 1ST ELECTION DISTRICT HOWARD COUNTY, MARYLAND
 SCALE: 1" = 30' DATE: APRIL 4, 1991
 SHEET 2 OF 12
 DRAWN: J.A.U. DESIGNED: B.D.B. CHECKED: B.D.B. APPROVED: T.L.W.

CRYSTAL SPRING ESTATES
SECTION TWO
ZONED R-20
F-89-22

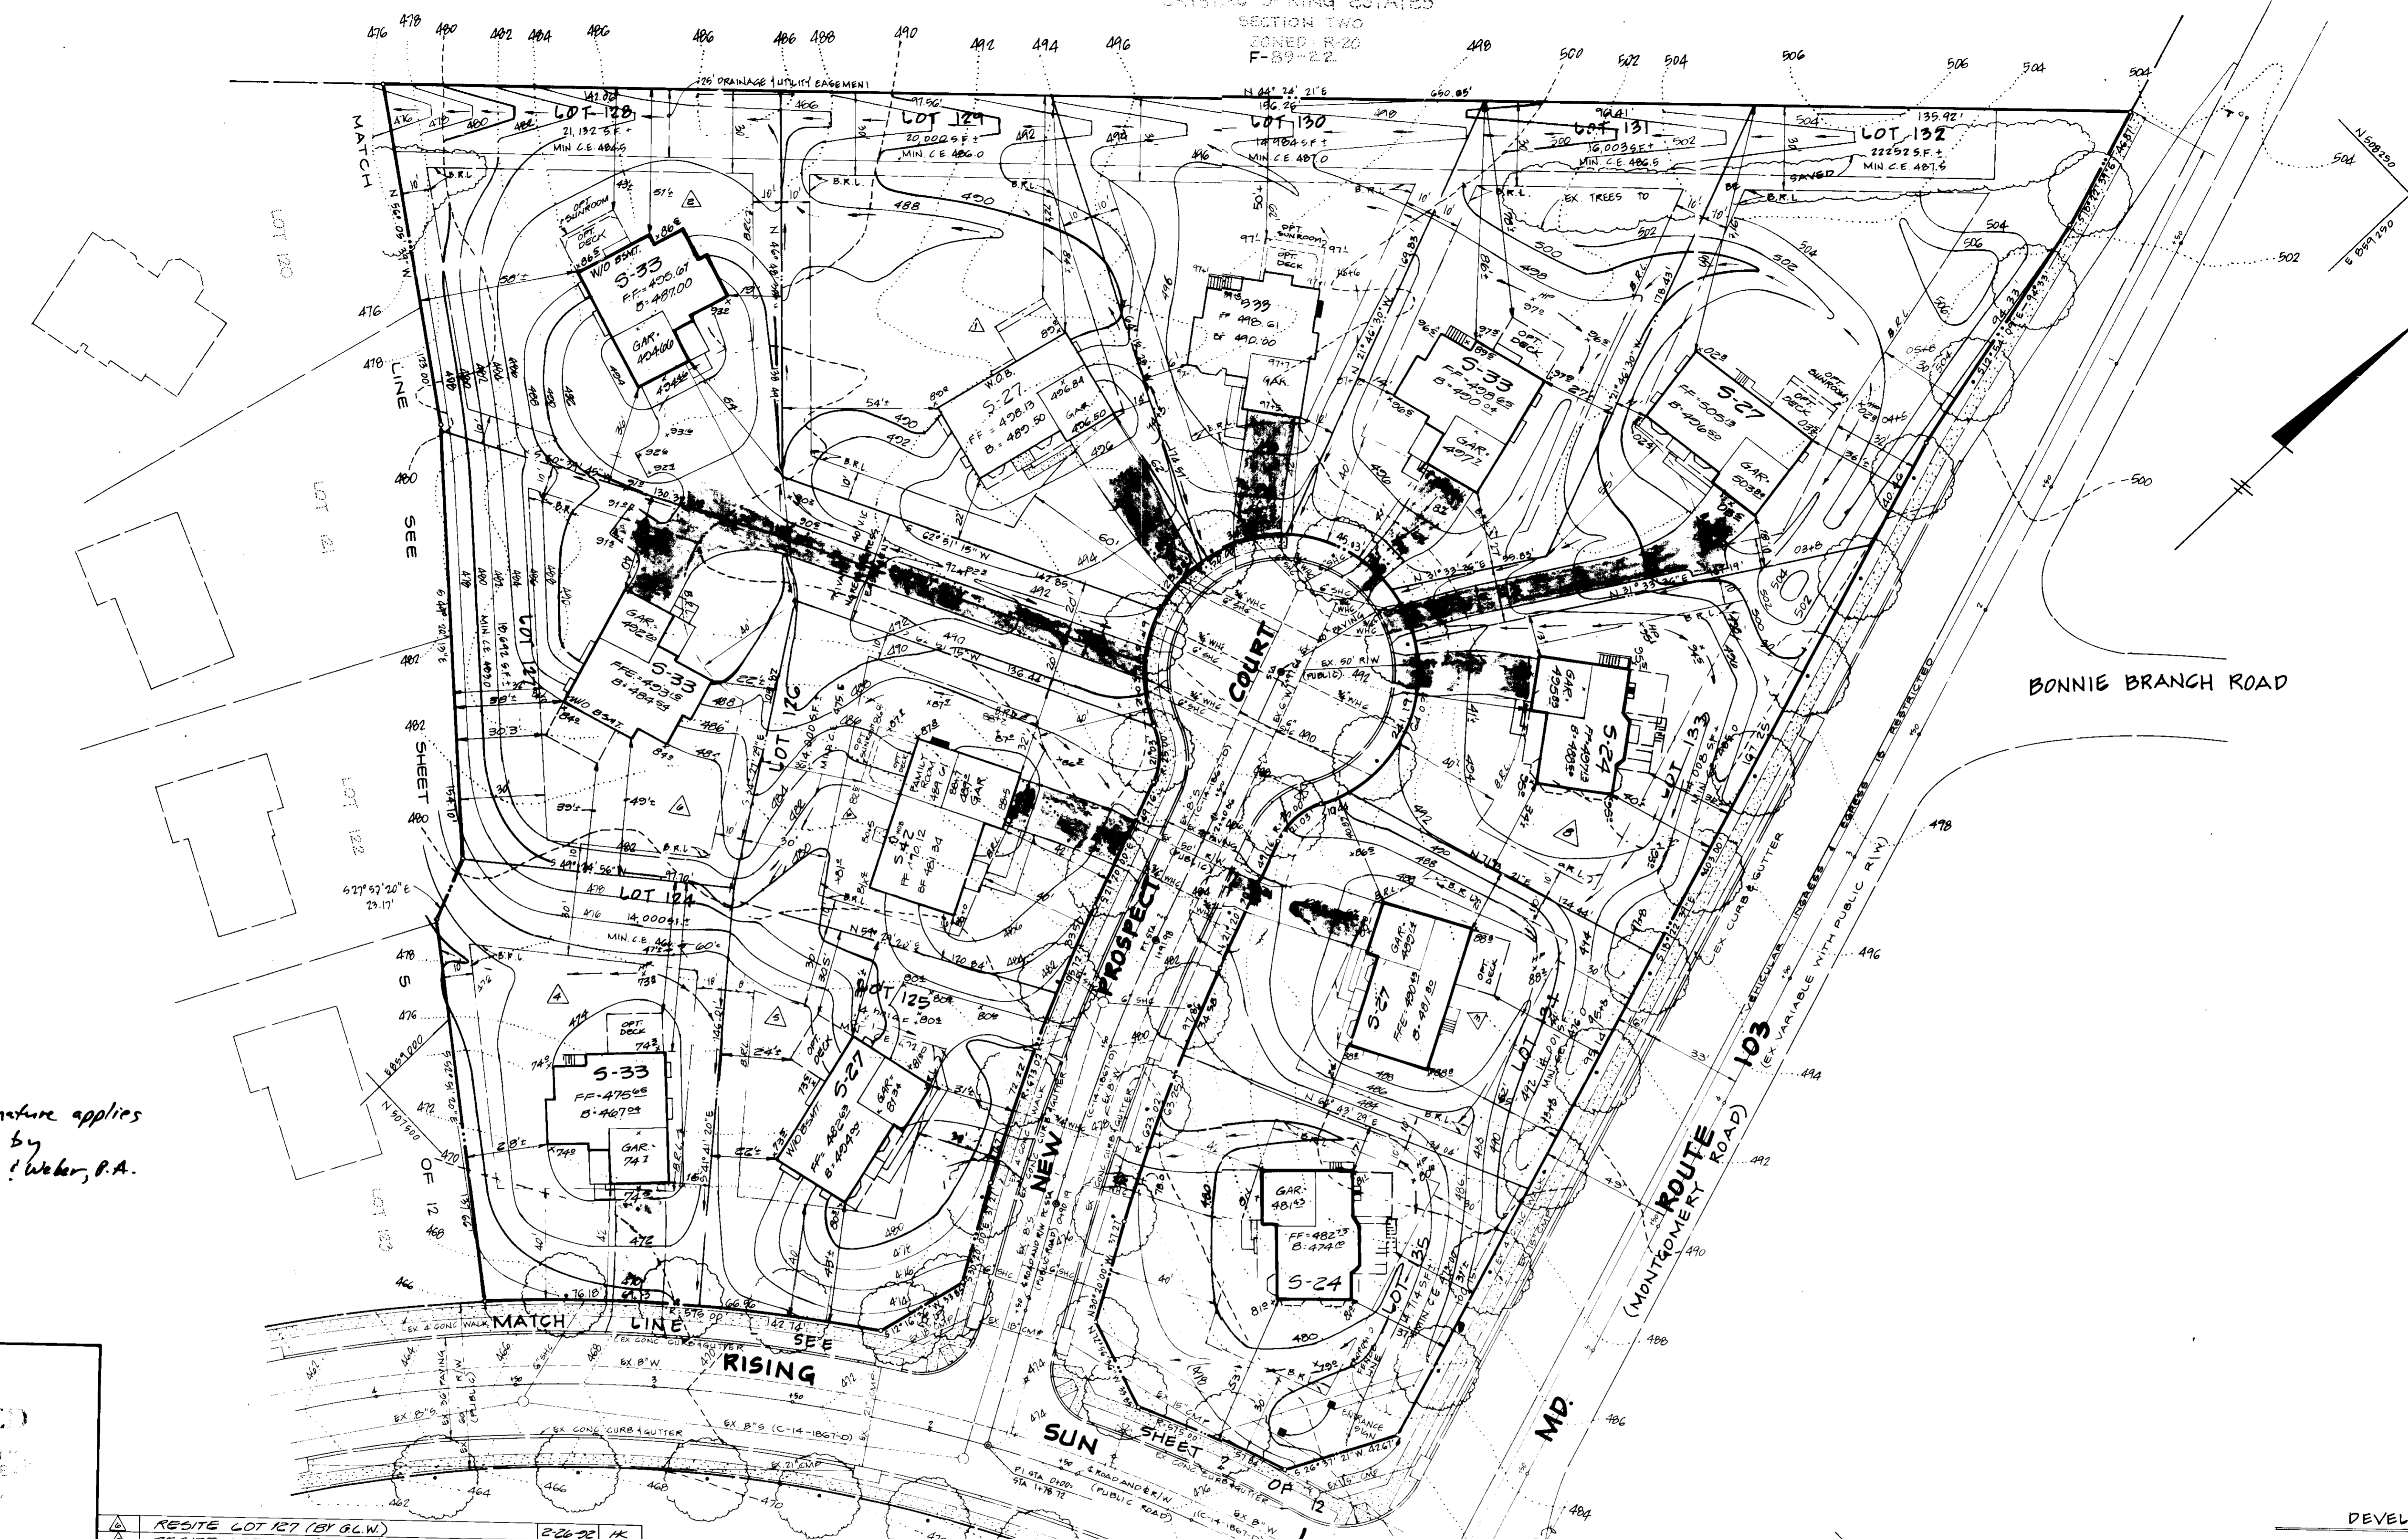

GLW seal & Signature applies only to revisions by Gutschick, Little & Weber, P.A.

NO.	REVISION	DATE	BY
1	RESITE LOT 127 (BY GLW)	2-26-92	JK
2	RESITE LOT 125 (BY GLW)	2-26-92	JK
3	RESITE LOT 124 (BY GLW)	2-26-92	JK
4	RESITE LOT 124 (BY GLW)	11-1-91	JK
5	RESITE LOT 123 (BY GLW)	10-18-91	JK
6	RESITE LOT 120 (BY GLW)	6-4-91	FDH

NO.	REVISION	DATE	BY
7	Revised grading lot 124, 125, 126, 127, 129 (by GLW)	5-30-92	HE
8	RESITED LOT 135 TO S-24 (BY GLW)	5-17-92	JK
9	RESITED LOT 133 TO S-24 (BY GLW)	12-17-92	HE
10	RESITED LOT 133	5-5-92	JK

Dewberry & Davis
ARCHITECTS ENGINEERS PLANNERS SURVEYORS
3300 Ridge Road
Suite 100
Ellicott City, Maryland
21043
(301) 461-7478 BALTIMORE
(301) 621-4970 WASHINGTON

ENGINEER'S CERTIFICATE
I HEREBY CERTIFY THAT THIS PLAN FOR EROSION AND SEDIMENT CONTROL REPRESENTS A PRACTICAL AND WORKABLE PLAN BASED ON MY PERSONAL KNOWLEDGE OF THE SITE CONDITIONS AND THAT IT WAS PREPARED IN ACCORDANCE WITH REQUIREMENTS OF THE HOWARD SOIL CONSERVATION DISTRICT.

Shirley L. Kelly 1-18-90
DATE

DEVELOPER'S CERTIFICATE
I HEREBY CERTIFY THAT ALL DEVELOPMENT AND CONSTRUCTION WILL BE DONE ACCORDING TO THIS PLAN OF DEVELOPMENT AND PLAN FOR EROSION AND SEDIMENT CONTROL AND THAT ALL RESPONSIBLE PERSONNEL INVOLVED IN THE CONSTRUCTION PROJECT WILL HAVE A CERTIFICATE OF ATTENDANCE AT A DEPARTMENT OF NATURAL RESOURCES APPROVED TRAINING PROGRAM FOR THE CONTROL OF SEDIMENT AND EROSION BEFORE BEGINNING THE PROJECT. I ALSO AUTHORIZE PERIODIC ON-SITE INSPECTION BY THE HOWARD SOIL CONSERVATION DISTRICT OR THEIR AUTHORIZED AGENTS, AS ARE DEEMED NECESSARY.

Mark G. Kelly 1/18/90
DATE

REVIEWED FOR HOWARD SOIL CONSERVATION DISTRICT AND MEETS TECHNICAL REQUIREMENTS.

John P. Blanton 2/12/90
DATE

APPROVED: HOWARD COUNTY DEPARTMENT OF PLANNING AND ZONING

William J. ... 4-30-90
PLANNING DIRECTOR DATE

APPROVED: DEPARTMENT OF PUBLIC WORKS FOR PUBLIC WATER AND SEWER AND STORM DRAINAGE SYSTEMS AND ROADS.

James G. ... 4-16-90
DIRECTOR, PUBLIC WORKS DATE

APPROVED: CHIEF, BUREAU OF ENGINEERING

James G. ... 4-14-90
DATE

APPROVED: HOWARD COUNTY HEALTH DEPARTMENT FOR PUBLIC WATER AND SEWERAGE SYSTEMS.


John Bodew 4-23-90
HEALTH OFFICER DATE

SUBDIVISION NAME	SECTION/AREA	LOT NUMBERS
MONTGOMERY MEADOWS	1/2	LOTS 62 THRU 137
PLAT NO. BLOCK NO.	ZONE	TAX/ZONE
7067-2069 1d 4 80	R-20	31
WATER CODE	SEWER CODE	
Q01	2900,000	

OWNER
NVLand
6820 ELM STREET McLEAN, VIRGINIA 22101
(703) 734-9730

DEVELOPER
Capital Homes
A Commitment to Quality
10200 GORMAN ROAD BALT. (301) 792-2467
LAUREL, MARYLAND 20707 WASH. (301) 953-0571

SITE DEVELOPMENT PLAN
MONTGOMERY MEADOWS
SECTION ONE AREA TWO
LOTS 62 THRU 137
TAX MAP 31 P/O PARCEL 423
1ST ELECTION DISTRICT HOWARD COUNTY, MARYLAND
SCALE: 1" = 30'
DATE: APRIL 4, 1993
SHEET 6 OF 12

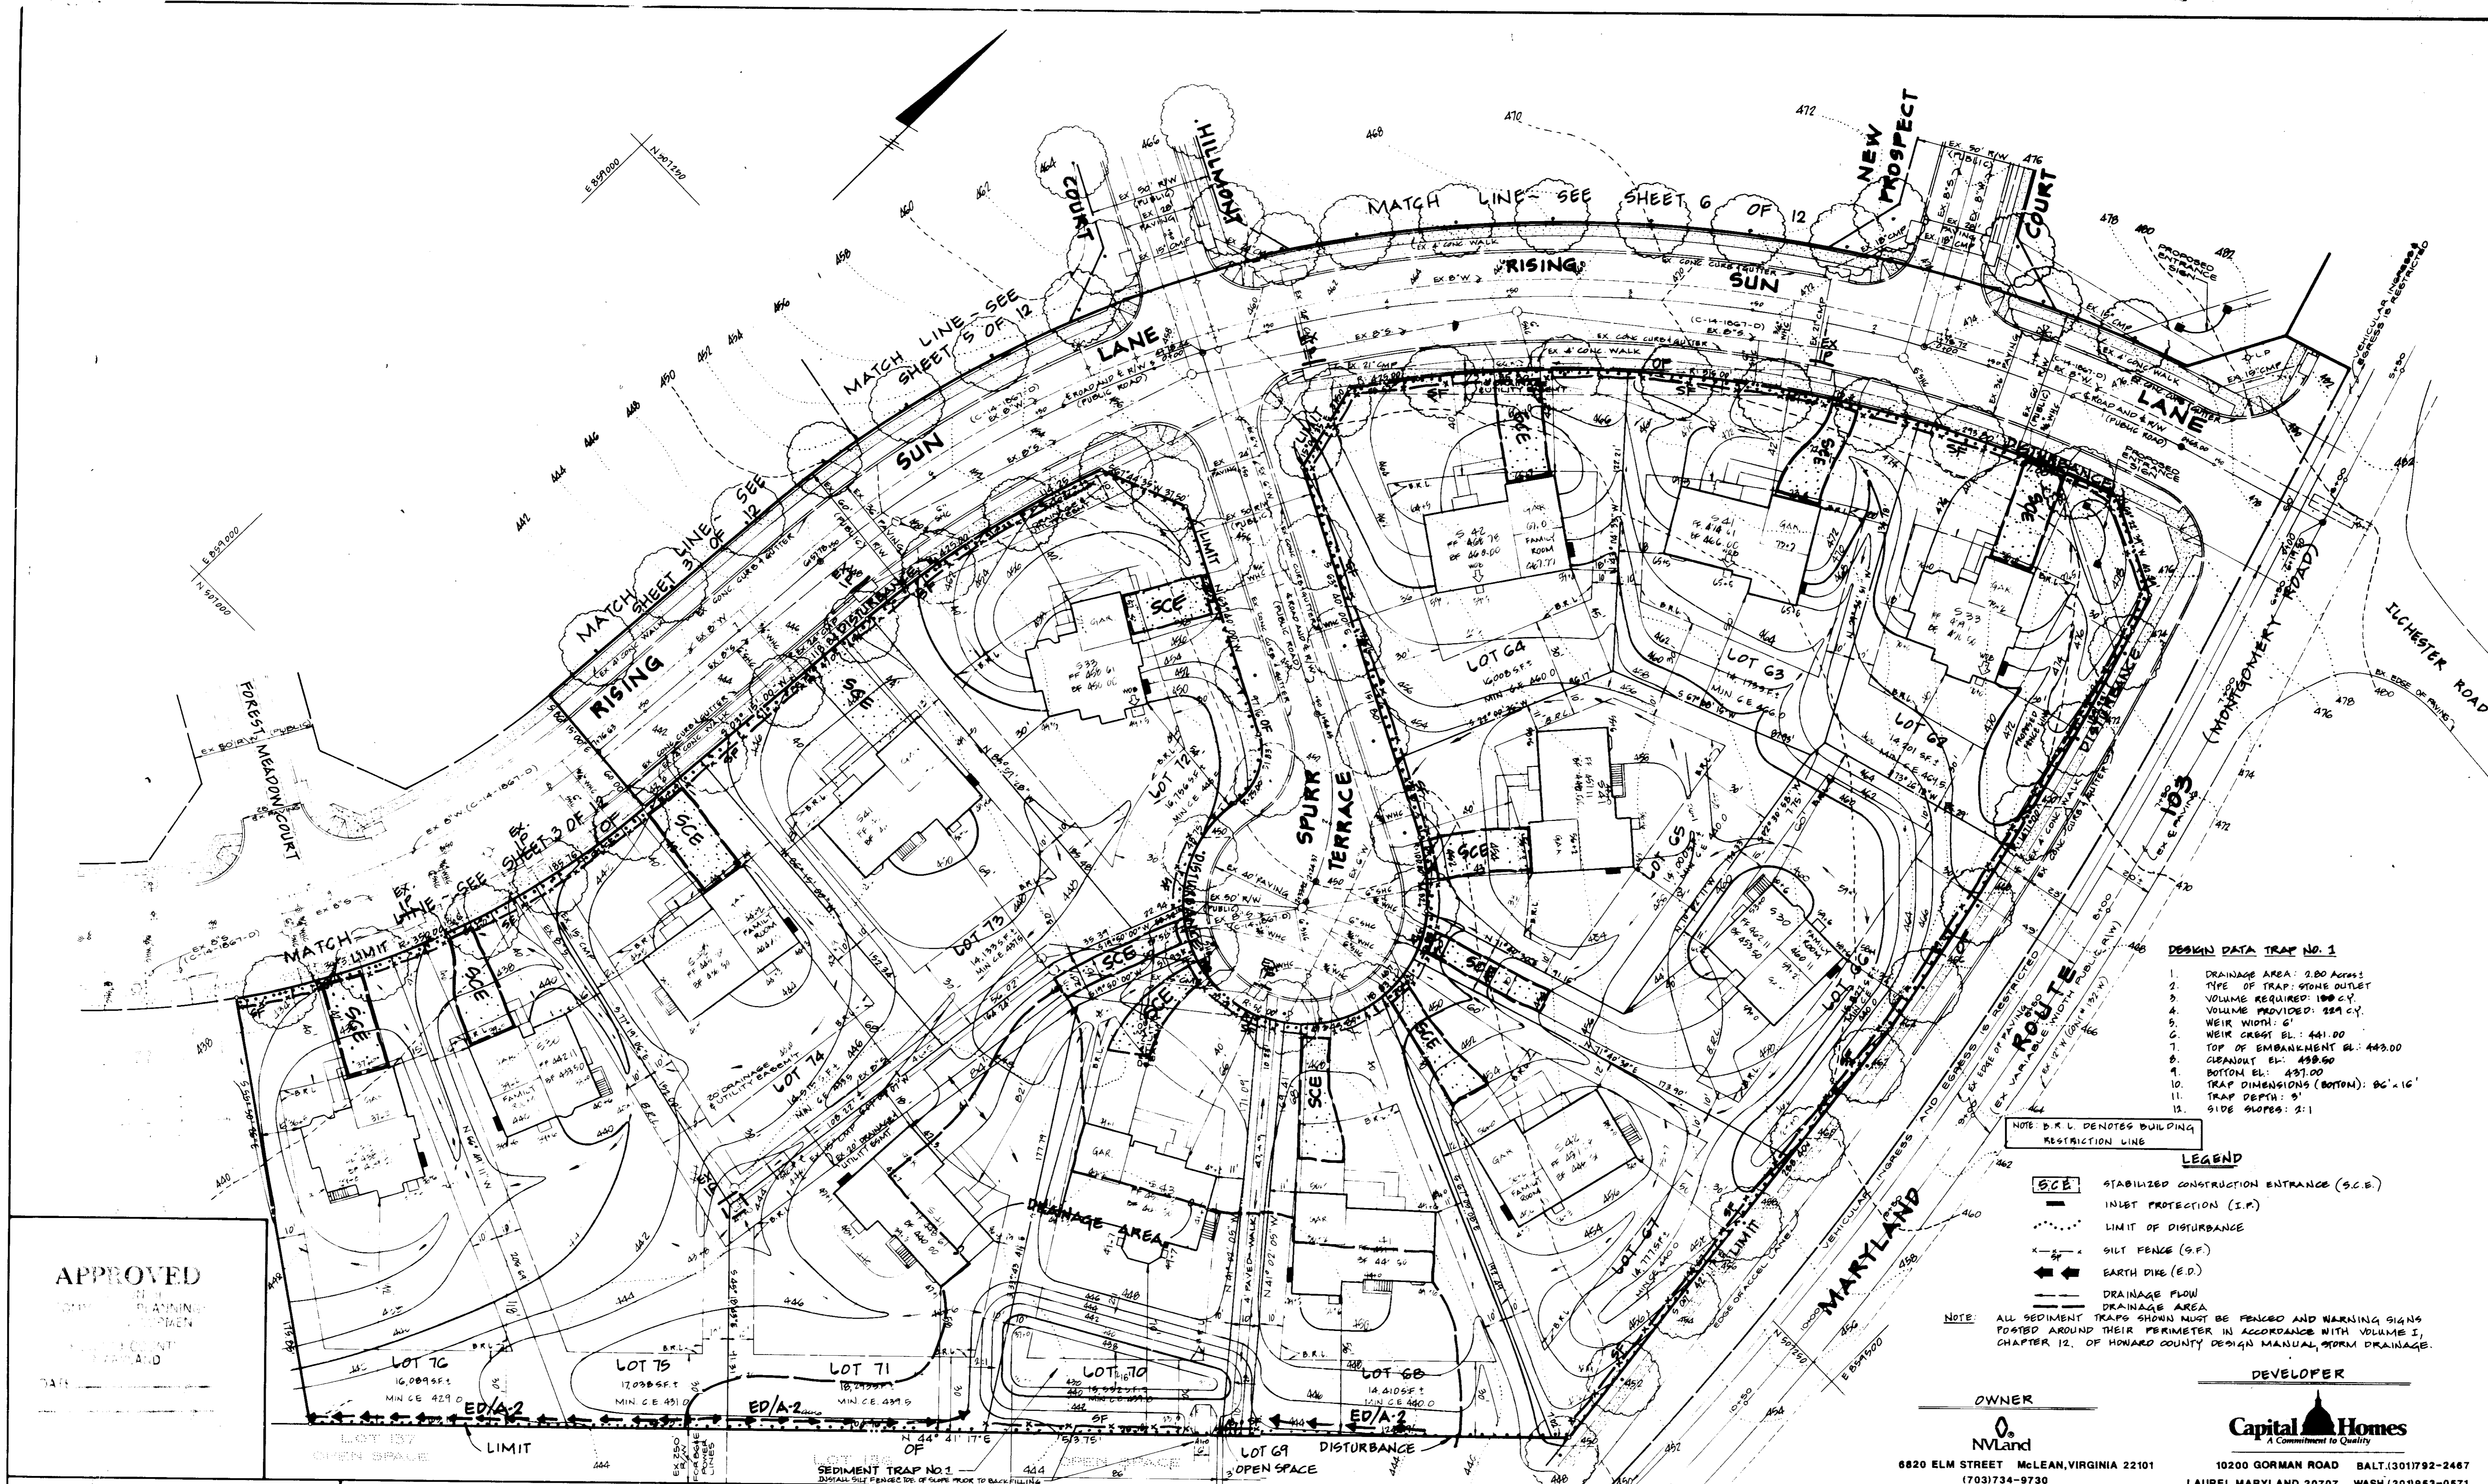

- DESIGN DATA TRAP NO. 1**
1. DRAINAGE AREA: 2.00 ACROSS
 2. TYPE OF TRAP: STONE OUTLET
 3. VOLUME REQUIRED: 100 C.Y.
 4. VOLUME PROVIDED: 589 C.Y.
 5. WEIR WIDTH: 6'
 6. WEIR CREST EL.: 441.00
 7. TOP OF EMBANKMENT EL.: 443.00
 8. CLEANOUT EL.: 439.00
 9. BOTTOM EL.: 437.00
 10. TRAP DIMENSIONS (BOTTOM): 96" x 16"
 11. TRAP DEPTH: 9'
 12. SIDE SLOPES: 2:1

- LEGEND**
- SCE STABILIZED CONSTRUCTION ENTRANCE (S.C.E.)
 - INLET PROTECTION (I.P.)
 - LIMIT OF DISTURBANCE
 - SILT FENCE (S.F.)
 - EARTH DIKE (E.D.)
 - DRAINAGE FLOW
 - DRAINAGE AREA
- NOTE:** ALL SEDIMENT TRAPS SHOWN MUST BE FENCED AND WARNING SIGNS POSTED AROUND THEIR PERIMETER IN ACCORDANCE WITH VOLUME I, CHAPTER 12, OF HOWARD COUNTY DESIGN MANUAL, NORM DRAINAGE.

DEVELOPER
Capital Homes
 A Commitment to Quality
 10200 GORMAN ROAD BALTIMORE, MARYLAND 21286
 WASH. (301) 953-0571

OWNER
 NVland
 6820 ELM STREET McLEAN, VIRGINIA 22101
 (703) 734-9730

APPROVED
 HOWARD COUNTY DEPARTMENT OF PLANNING AND ZONING
 4-30-90

Dewberry & Davis
 ARCHITECTS ENGINEERS PLANNERS SURVEYORS
 450 N. Ridge Road
 Suite 100
 Ellicott City, Maryland
 21043
 (301) 481-7478
 (301) 621-4976

ENGINEER'S CERTIFICATE
 I HEREBY CERTIFY THAT THIS PLAN, SPECIFICATION AND SECTION WAS PREPARED BY ME OR UNDER MY CLOSE PERSONAL SUPERVISION AND THAT I AM A LICENSED PROFESSIONAL ENGINEER IN THE STATE OF MARYLAND AND THAT I AM NOT PROVIDING ANY SERVICES IN ACCORDANCE WITH REQUIREMENTS OF THE MARYLAND PROFESSIONAL ENGINEERING ACT.

Richard W. Kelly 1-18-90
 DATE

DEVELOPER'S CERTIFICATE
 I HEREBY CERTIFY THAT ALL DEVELOPMENT AND CONSTRUCTION WILL BE DONE ACCORDING TO THIS PLAN OF DEVELOPMENT AND PLAN FOR EROSION AND SEDIMENT CONTROL AND THAT ALL RESPONSIBLE PERSONNEL INVOLVED IN THE CONSTRUCTION PROJECT WILL HAVE A CERTIFICATE OF ATTENDANCE AT A DEPARTMENT OF NATURAL RESOURCES APPROVED TRAINING PROGRAM FOR THE CONTROL OF SEDIMENT AND EROSION BEFORE BEGINNING THE PROJECT. I ALSO AUTHORIZE PERIODIC ON-SITE INSPECTION BY THE HOWARD SOIL CONSERVATION DISTRICT OR THEIR AUTHORIZED AGENTS, AS ARE DEEMED NECESSARY.

Michael G. Kelly 4/10/90
 DATE

REVIEWED FOR HOWARD SOIL CONSERVATION DISTRICT AND MEETS TECHNICAL REQUIREMENTS.

John M. Hester 2/13/90
 DATE

SOIL CONSERVATION SERVICE

THIS DEVELOPMENT IS APPROVED FOR EROSION AND SEDIMENT CONTROL BY THE HOWARD SOIL CONSERVATION DISTRICT.

John M. Hester 2/13/90
 DATE

APPROVED: HOWARD COUNTY DEPARTMENT OF PLANNING AND ZONING

Frank J. Hayes 4-30-90
 DATE

PLANNING DIRECTOR

CHIEF, DIVISION OF COMMUNITY PLANNING AND LAND DEVELOPMENT

APPROVED: HOWARD COUNTY HEALTH DEPARTMENT FOR PUBLIC WATER AND SEWERAGE SYSTEMS.

James Boylen 4-23-90
 DATE

HEALTH OFFICER

APPROVED: DEPARTMENT OF PUBLIC WORKS FOR PUBLIC WATER AND SEWER DRAINAGE SYSTEMS AND ROADS.

James J. ... 4-11-90
 DATE

DIRECTOR, PUBLIC WORKS

CHIEF, BUREAU OF ENGINEERING

SUBDIVISION NAME	SECTION/AREA	LOT NUMBERS
MONTGOMERY MEADOWS	1/2	LOTS 62 THRU 197
PLAT NO.	BLOCK NO.	ZONE
90GT-2069	14:20	R-20
TAX/ZONE	ELEC. DIST.	CENSUS TR.
51	197	
WATER CODE	SEWER CODE	
Q01	2900000	

SEDIMENT CONTROL PLAN

MONTGOMERY MEADOWS

SECTION ONE AREA TWO

LOTS 62 THRU 197

TAX MAP 51 P/O PARCEL 423


18TH ELECTION DISTRICT HOWARD COUNTY, MARYLAND

SCALE: 1"=30'

DATE: APRIL 4, 1991

SHEET 7 OF 12

DRAWN: J.A.U. CHECKED: B.D.B. APPROVED: T.L.W.

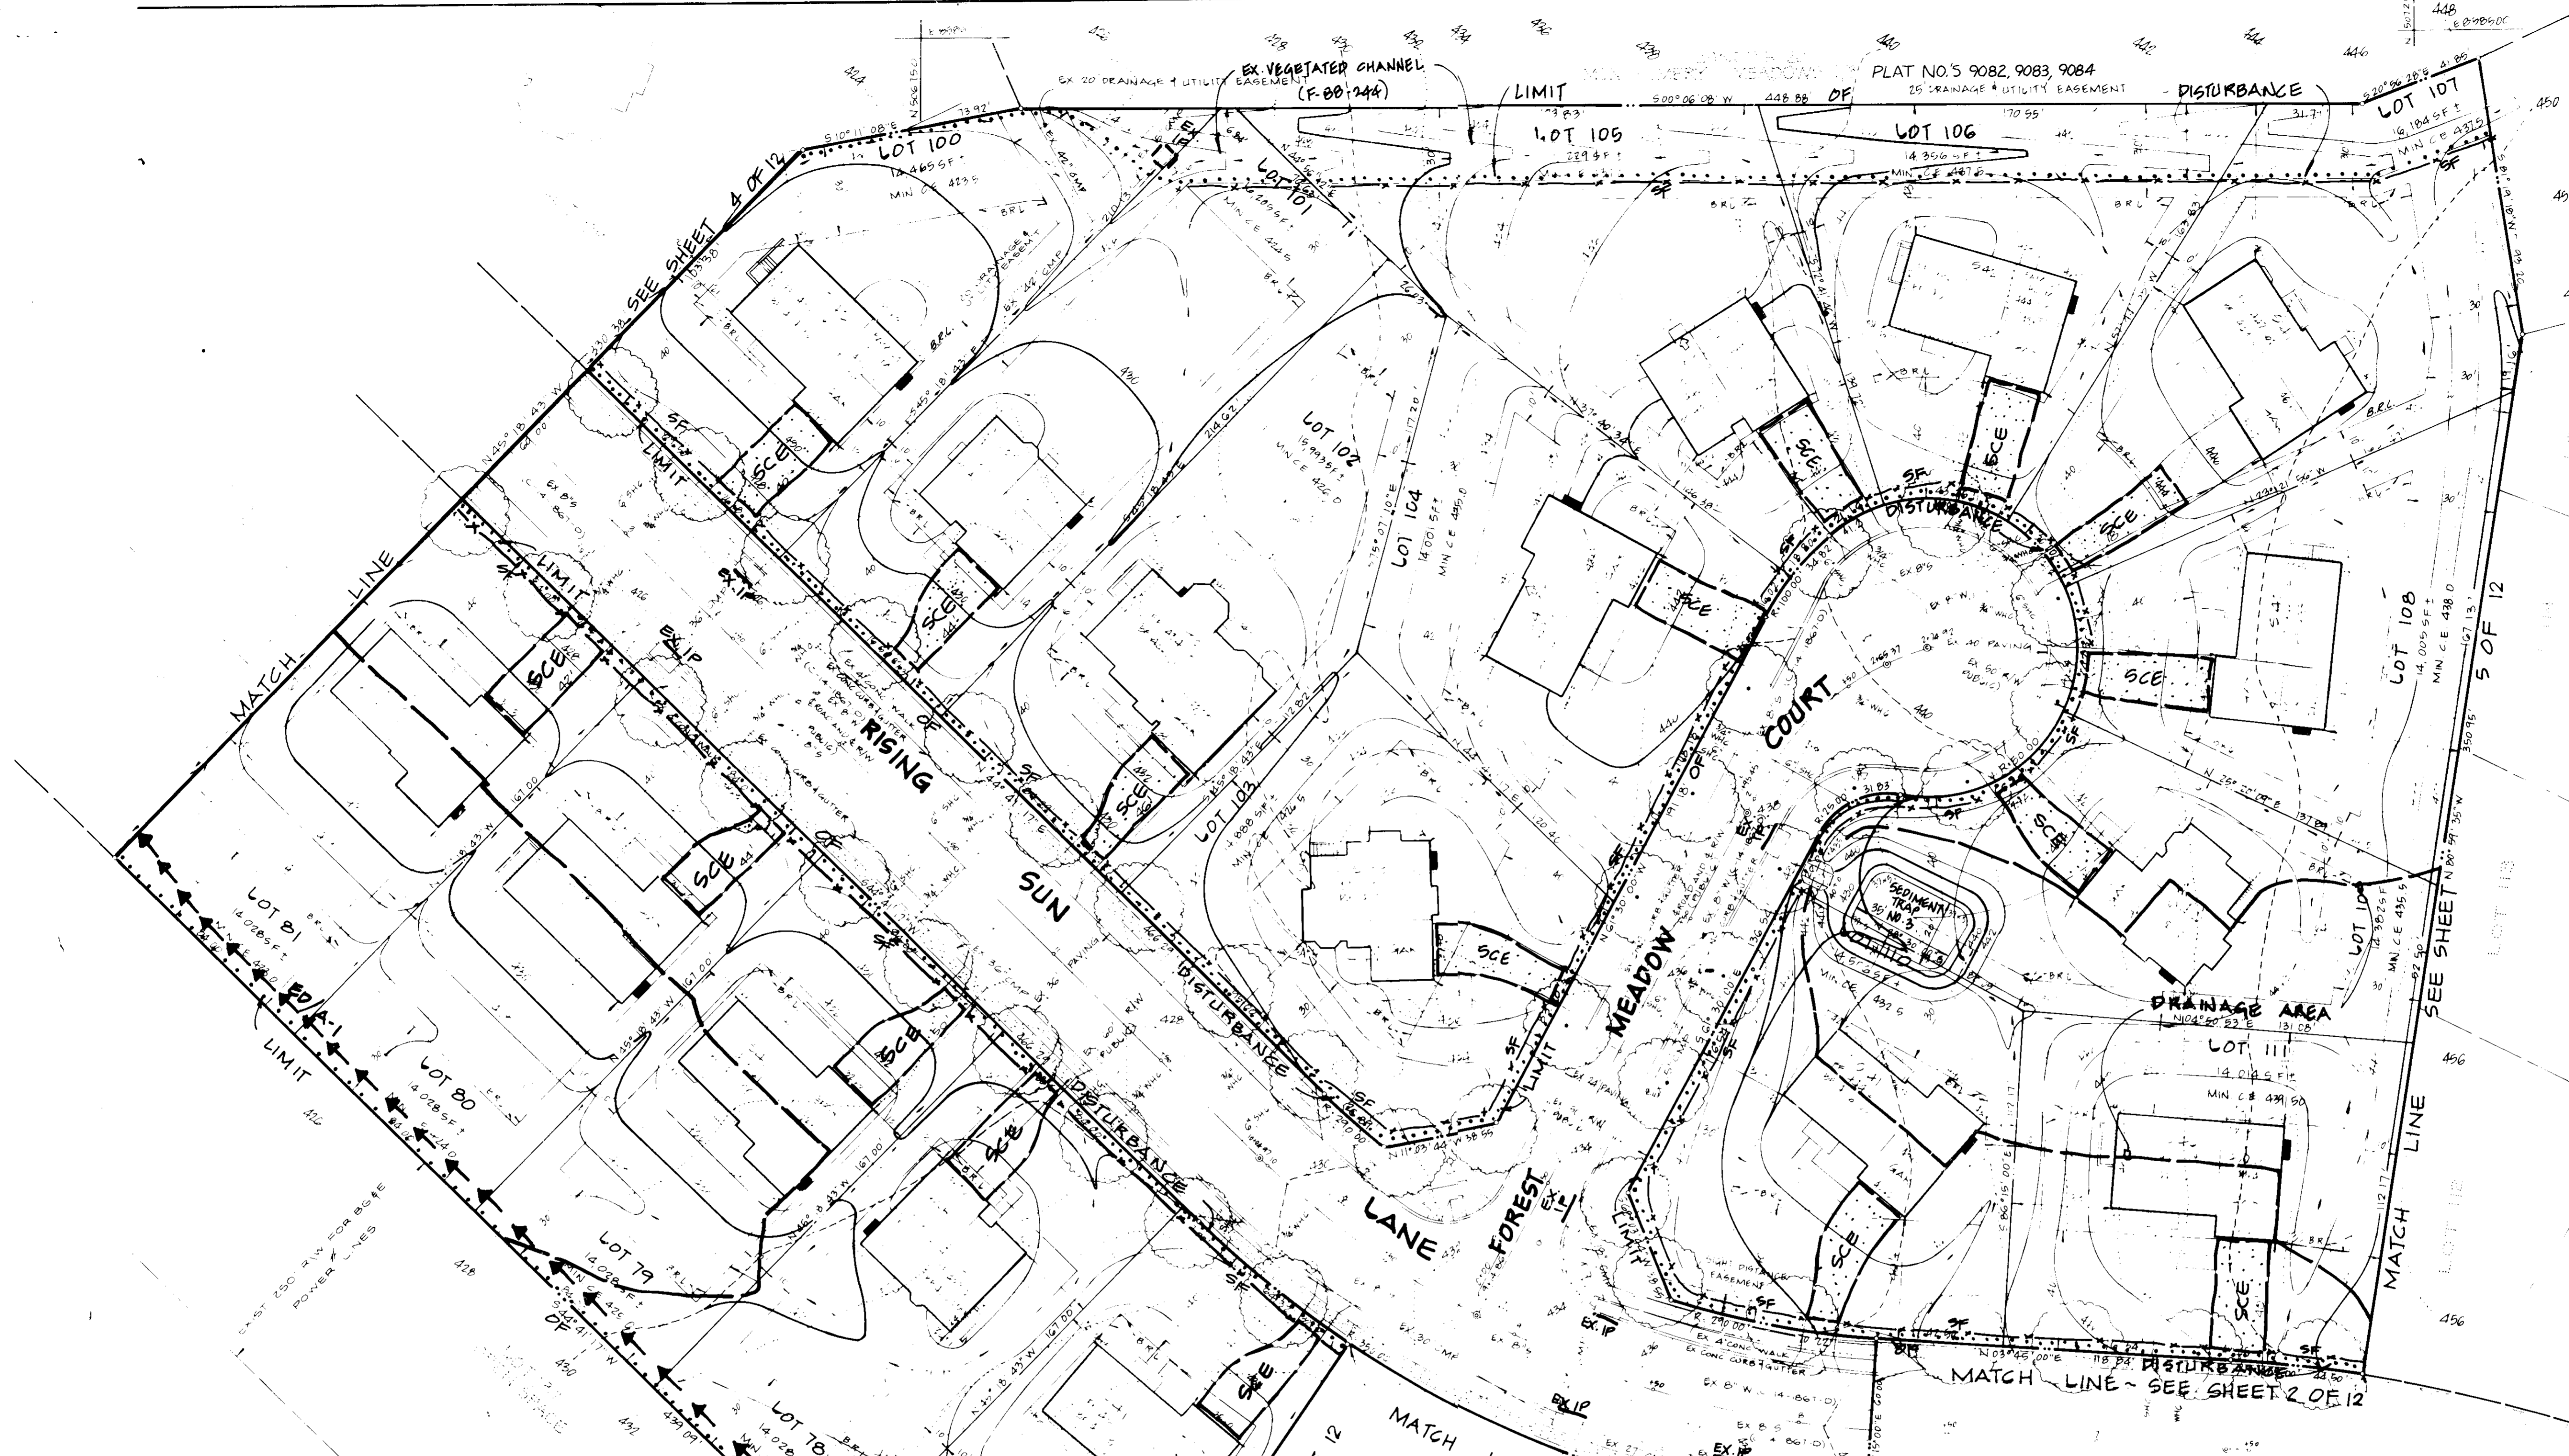

DESIGN DATA TRAP No. 2

1. DRAINAGE AREA: 2.00 ACRES ±
2. TYPE OF TRAP: STONE OUTLET
3. VOLUME REQUIRED: 134 C.F.
4. VOLUME PROVIDED: 134 C.F.
5. WEIR WIDTH: 4'
6. WEIR CREST EL.: 422.00
7. TOP OF EMBANKMENT EL.: 424.00
8. CLEANOUT EL.: 420.00
9. BOTTOM EL.: 419.00
10. TRAP DIMENSIONS (BOTTOM): 60" x 24"
11. TRAP DEPTH: 2'
12. SIDE SLOPES: 2:1

NOTE: ALL SEDIMENT TRAPS SHOWN MUST BE FENCED AND WARNING SIGNS POSTED AROUND THEIR PERIMETER IN ACCORDANCE WITH VOLUME I, CHAPTER 12, OF HOWARD COUNTY DESIGN MANUAL, SDRM DRAINAGE.

DESIGN DATA TRAP No. 3

1. DRAINAGE AREA: 0.52 ACRES ±
2. TYPE OF TRAP: STONE OUTLET
3. VOLUME REQUIRED: 34.61 CU YDS
4. VOLUME PROVIDED: 38.89 CU YDS
5. WEIR WIDTH: 4'
6. WEIR CREST EL.: 439.00
7. TOP OF EMBANKMENT EL.: 443.00
8. CLEANOUT EL.: 438.25
9. BOTTOM EL.: 437.15
10. TRAP DIMENSIONS (BOTTOM): 20' x 35'
11. TRAP DEPTH: 1.5'
12. SIDE SLOPES: 2:1

APPROVED

FOR THE COMMISSION ON PLANNING & LAND DEVELOPMENT
HOWARD COUNTY, MARYLAND

DATE _____

- LEGEND**
- SEE: STABILIZED CONSTRUCTION ENTRANCE (S.C.E.)
 - : INLET PROTECTION (I.P.)
 -: LIMIT OF DISTURBANCE
 - X-X-X: SILT FENCE (S.F.)
 - ←←←: EARTH DIKE (E.D.)
 - : DRAINAGE FLOW
 - - - - : DRAINAGE AREA

OWNER
NVland
6820 ELM STREET McLEAN, VIRGINIA 22101
(703)734-9730

DEVELOPER
Capital Homes
A Commitment to Quality
10200 GORMAN ROAD BALT. 301792-2467
LAUREL, MARYLAND 20707 WASH. (301)953-0571

Dewberry & Davis
ARCHITECTS ENGINEERS PLANNERS SERVITORS

400 R. R. Road
Suite 100
Farmingdale, Maryland
21044
410-461-7475
410-421-4070

David G. ... 1-18-90
DATE

Michael G. ... 1/10/90
DATE

REVIEWED FOR HOWARD SOIL CONSERVATION DISTRICT AND MEETS TECHNICAL REQUIREMENTS.

[Signature] 2/13/90
DATE

SOIL CONSERVATION SERVICE

THIS DEVELOPMENT IS APPROVED FOR EROSION AND SEDIMENT CONTROL BY THE HOWARD SOIL CONSERVATION DISTRICT.

[Signature] 2/12/90
DATE

HOWARD COUNTY DEPARTMENT OF PLANNING AND ZONING

[Signature] 4-30-90
DATE

PLANNING DIRECTOR

CHIEF, DIVISION OF COMMUNITY PLANNING AND LAND DEVELOPMENT

[Signature] 4-23-90
DATE

HOWARD COUNTY DEPARTMENT OF PUBLIC WORKS

[Signature] 4-11-90
DATE

CHIEF, BUREAU OF ENGINEERING

HOWARD COUNTY HEALTH DEPARTMENT FOR PUBLIC WATER AND SEWERAGE SYSTEMS.

[Signature] 4-23-90
DATE

SEDIMENT CONTROL PLAN


MONTGOMERY MEADOWS
SECTION ONE AREA TWO
LOTS 62 THRU 137

TAX MAP 31 P/O PARCEL 423
1st ELECTION DISTRICT HOWARD COUNTY, MARYLAND
SCALE 1" = 30' DATE APRIL 4, 1991

SHEET 8 OF 12
DRAWN J.A.U. DESIGNED P.O.B. CHECKED S.O.B. APPROVED T.W.W.

WATER CODE G01 SEWER CODE 2,900,000

S.D.P.-89-196

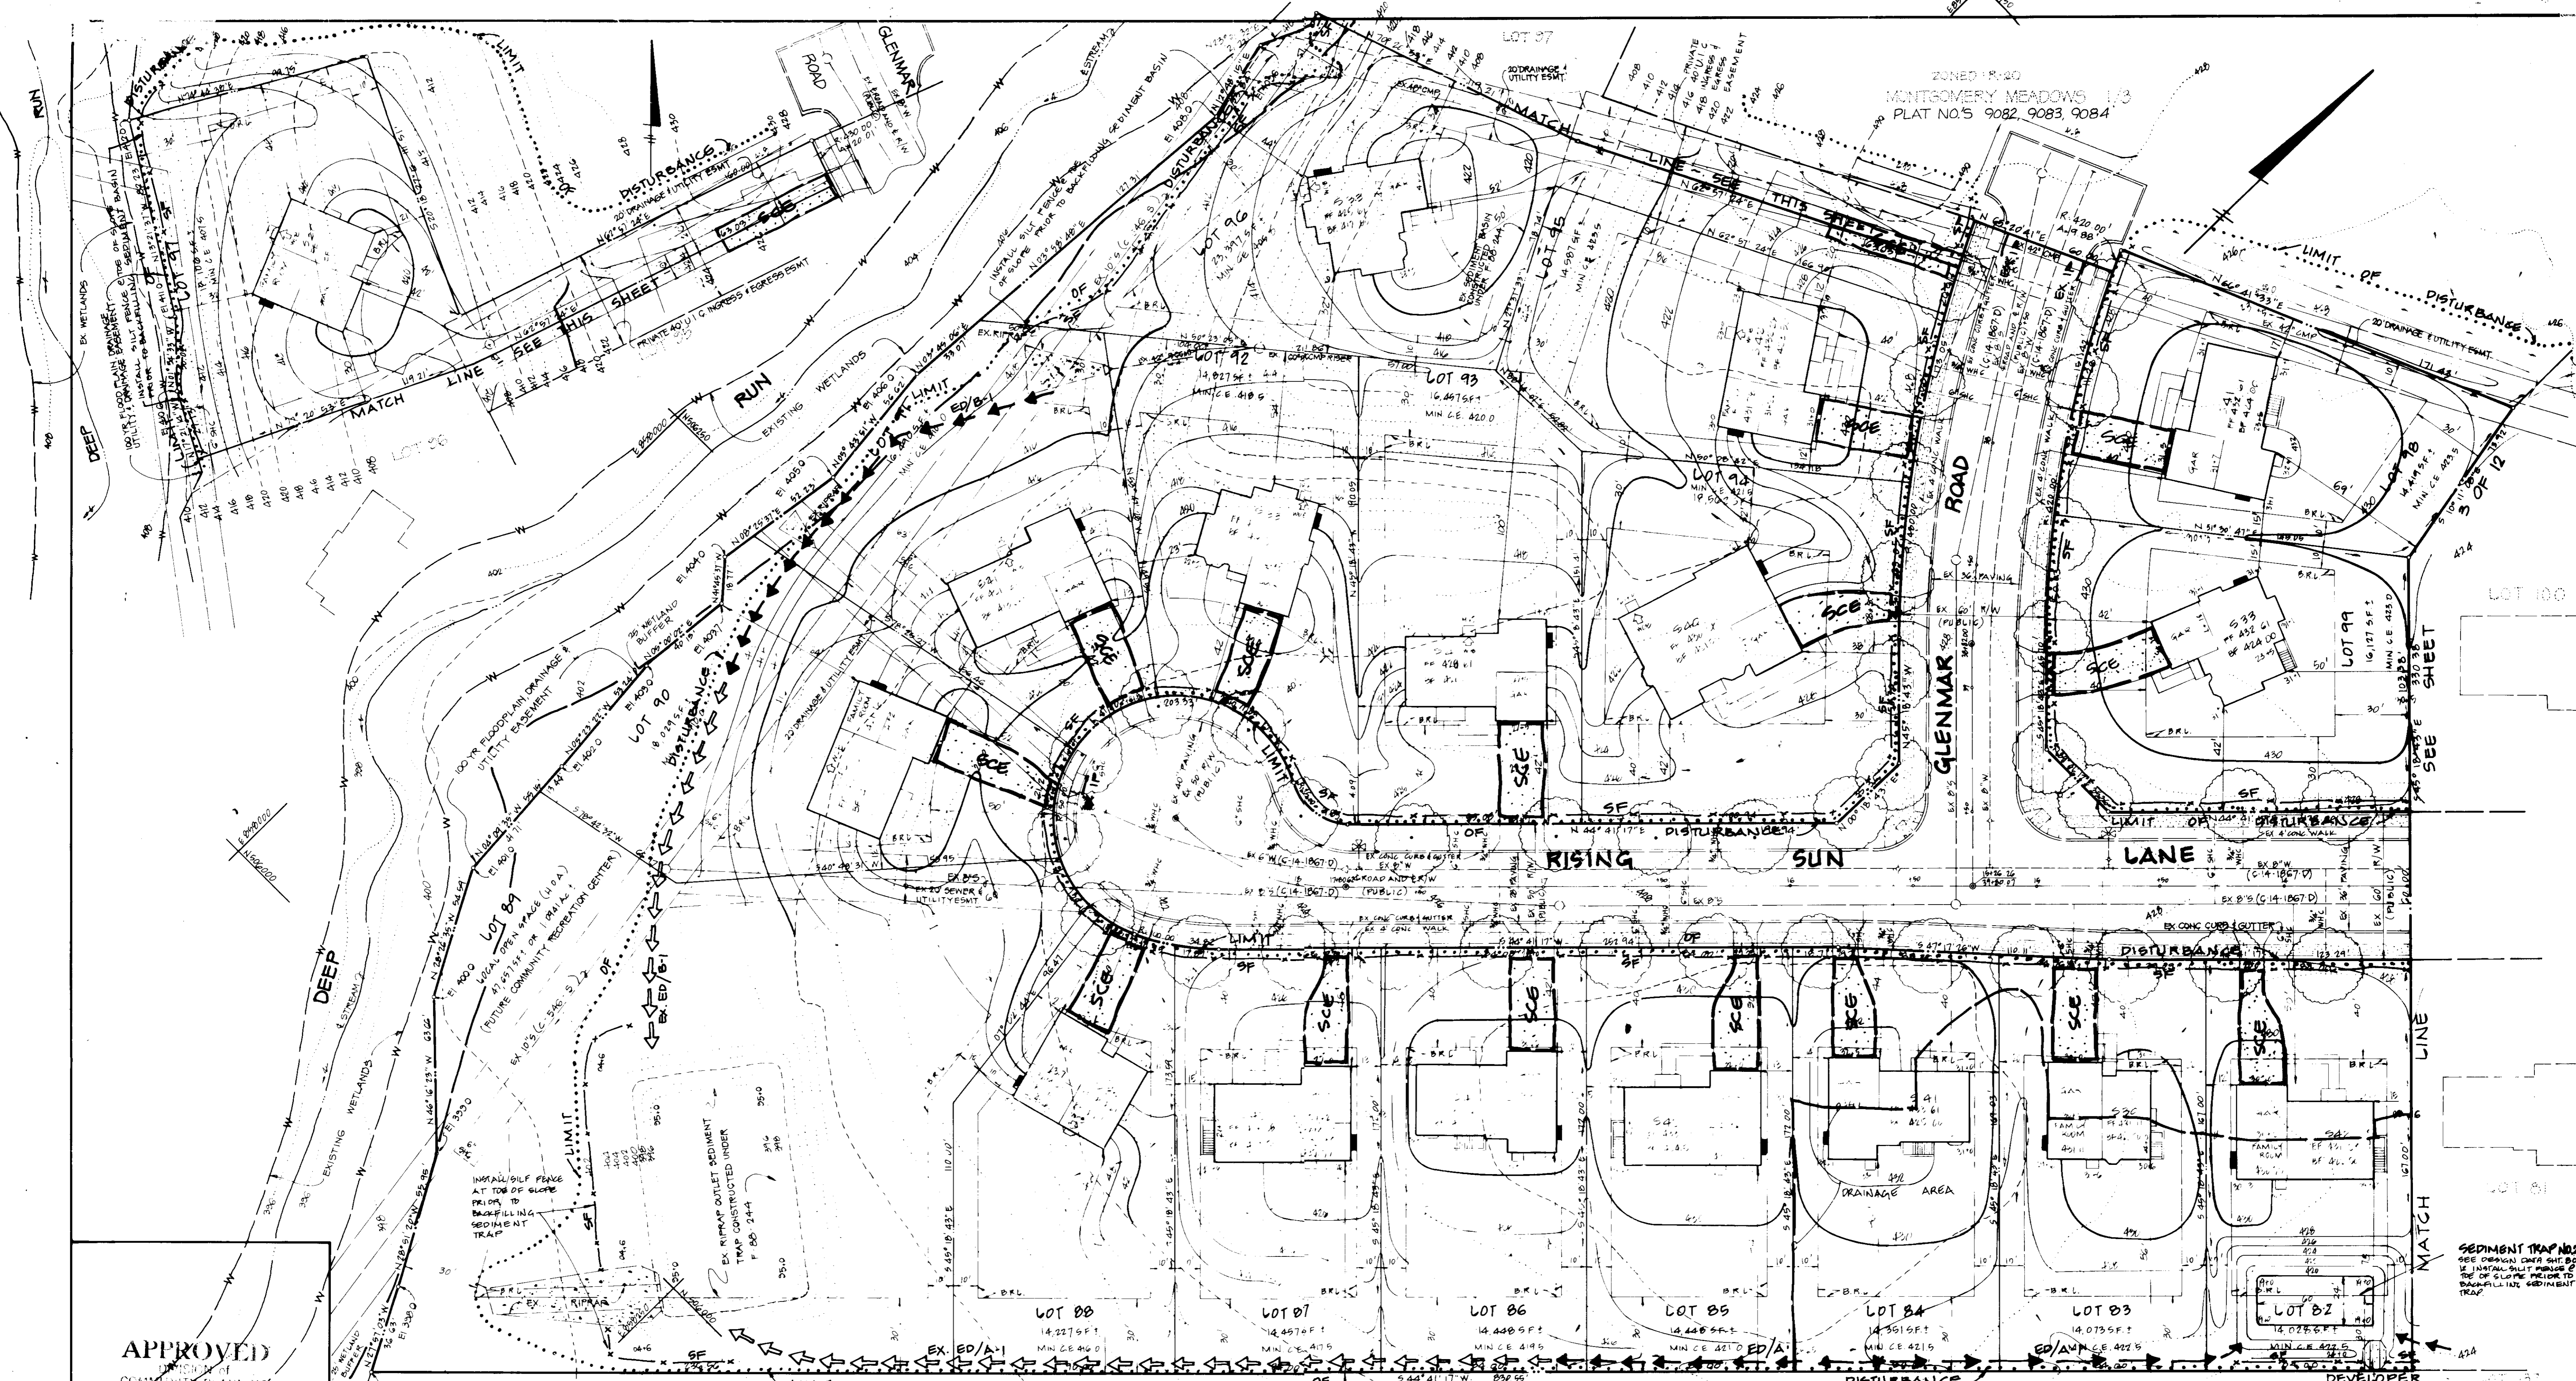

APPROVED
 DIVISION OF
 COMMUNITY PLANNING
 & LAND DEVELOPMENT
 MONTGOMERY, MARYLAND

NOTE: ALL SEDIMENT TRAPS SHOWN MUST BE FENCED AND WARNING SIGNS POSTED AROUND THEIR PERIMETER IN ACCORDANCE WITH VOLUME 1, CHAPTER 12, OF HOWARD COUNTY DESIGN MANUAL, STORM DRAINAGE.

LEGEND
 SCE STABILIZED CONSTRUCTION ENTRANCE (S.C.E.)
 S.F. INLET PROTECTION (C.E.P.)
 --- LIMIT OF DISTURBANCE
 X SILT FENCE (S.F.)
 + BARTH DIKE (B.D.)
 --- DRAINAGE FLOW
 --- DRAINAGE AREA

OWNER
 NVLand
 6820 ELM STREET MCLEAN, VIRGINIA 22101
 (703) 734-9730

Capital Homes
 A Commitment to Quality

10200 GORMAN ROAD BALT. (301) 792-2467
 LAUREL, MARYLAND 20707 WASH. (301) 953-0571

Dewberry & Davis
 ARCHITECTS ENGINEERS PLANNERS SURVEYORS
 3300 Ridge Road
 Suite 100
 Elkport City, Maryland
 21043
 (301) 461-7478 BALTIMORE
 (301) 621-4970 WASHINGTON

ENGINEER'S CERTIFICATE
 I HEREBY CERTIFY THAT THE PLAN FOR EROSION AND SEDIMENT CONTROL REPRESENTS A FEASIBLE AND WORKABLE PLAN AS A NECESSARY PART OF THE SITE PLAN SUBMITTED AND THAT IT IS AS PREPARED IN ACCORDANCE WITH REQUIREMENTS OF THE ASBESTOS CONTROL ACT.

Frank Kelly 1-18-90
 DATE

DEVELOPER'S CERTIFICATE
 I HEREBY CERTIFY THAT ALL DEVELOPMENT AND CONSTRUCTION WILL BE IN ACCORDANCE WITH THIS PLAN OF DEVELOPMENT AND PLAN FOR EROSION AND SEDIMENT CONTROL AND THAT ALL RESPONSIBLE PERSONS INVOLVED IN THE CONSTRUCTION PROJECT WILL HAVE A CERTIFICATE OF ATTENDANCE AT A DEPARTMENT OF NATURAL RESOURCES APPROVED TRAINING PROGRAM FOR THE CONTROL OF SEDIMENT AND EROSION BEFORE BEGINNING THE PROJECT. I ALSO AUTHORIZE PERIODIC ON-SITE INSPECTIONS BY THE HOWARD SOIL CONSERVATION DISTRICT OR THEIR AUTHORIZED AGENTS, AS ARE DEEMED NECESSARY.

Michael G. Clay 1/18/90
 DATE

REVIEWED FOR HOWARD SOIL CONSERVATION DISTRICT AND MEETS TECHNICAL REQUIREMENTS.

James M. Miller 2/13/90
 SOIL CONSERVATION SERVICE DATE

THIS DEVELOPMENT IS APPROVED FOR EROSION AND SEDIMENT CONTROL BY THE HOWARD SOIL CONSERVATION DISTRICT.

Paul Roberto 2/12/90
 HOWARD SOIL CONSERVATION DISTRICT DATE

APPROVED: HOWARD COUNTY DEPARTMENT OF PLANNING AND ZONING

Chad 4-30-90
 PLANNING DIRECTOR DATE

Janice V. Wright 4/21/90
 CHIEF, DIVISION OF COMMUNITY PLANNING AND LAND DEVELOPMENT DATE

APPROVED: HOWARD COUNTY HEALTH DEPARTMENT FOR PUBLIC WATER AND SEWERAGE SYSTEMS.

Joyce W. Zolner 4-23-90
 HEALTH OFFICER DATE

APPROVED: DEPARTMENT OF PUBLIC WORKS FOR PUBLIC WATER AND SEWER AND STORM DRAINAGE SYSTEMS AND ROADS.

James J. Shaw 4/17/90
 DIRECTOR, PUBLIC WORKS DATE

Richard B. Pagan 4-16-90
 CHIEF, BUREAU OF ENGINEERING DATE

SUBDIVISION NAME	SECTION/AREA	LOT NUMBERS
MONTGOMERY MEADOWS	1/2	LOTS 62 THRU 137
PLAT NO.	BLOCK NO.	TAX/ZONE
2067-2069	14120	R-20
WATER CODE	SEWER CODE	
Q01	2,900,000	

SEDIMENT CONTROL PLAN
MONTGOMERY MEADOWS
 SECTION ONE AREA TWO
 LOTS 62 THRU 137



TAX MAP 31 P/O PARCEL 423
 1st ELECTION DISTRICT HOWARD COUNTY, MARYLAND
 SCALE: 1" = 30' DATE: APRIL 4, 1989
 SHEET 9 OF 12

DRAWN: S.A.U. DESIGNED: B.B.B. CHECKED: B.B.B. APPROVED: T.L.W.



- LEGEND**
- STABILIZED CONSTRUCTION ENTRANCE (S.C.E.)
 - INLET PROTECTION (I.P.)
 - LIMIT OF DISTURBANCE
 - SILT FENCE (S.F.)
 - EARTH DIKE (E.D.)
 - DRAINAGE FLOW

- Construction Specifications**
- I. Materials
 1. Wooden frame is to be constructed of 2" x 4" construction grade lumber.
 2. Wire mesh must be of sufficient strength to support filter fabric, and stems for each stake, with water being impounded against it.
 3. Filter cloth must be of a type approved for this purpose, resistant to sunlight with a minimum of 50% UV protection. It must allow sufficient passage of water and removal of sediment.
 4. Stone is to be 2" in size and clean, stone filter cloth must be placed on top of the stone.
 5. The assembly shall be placed so that the ends and spacers are a minimum 1' beyond both ends of the throat opening.
 6. Form the wire mesh and filter cloth to the concrete gutter and against the face of curb on both sides of the inlet. Place clean 1/2" stone over the wire mesh and filter fabric in such a manner as to prevent water from entering the inlet under or around the filter cloth.
 7. This type of protection must be inspected frequently and the filter cloth and stone replaced when clogged with sediment.
 8. Areas that erode from down slope bypass inlet by installing temporary earth or silt fence diverting flow into inlet.
 - II. Preparation
 1. Excavate completely around inlet to a depth of 18" below notch elevation.
 2. Drive 2 x 4 post 1' into ground at four corners of inlet. Place nail strips between posts on ends of inlet. Assemble top portion of 2 x 4 frame using overlap joints shown. Top of frame (weir) must be 6" below edge of roadway adjacent to inlet.
 3. Stretch wire mesh tightly around frame and fasten securely. Ends must meet at post.
 4. Stretch filter cloth tightly over wire mesh, the cloth must extend from top of frame to 18" below inlet notch also. Fasten securely to frame. Ends must meet at post, be overlapped and fastened, then fastened down.
 5. Backfill around inlet in compacted 6" layers until layer of earth is even with notch elevation on ends and top elevation as shown.
 6. If the inlet is set in a low water, construct a compacted earth dike in the ditchline below it. The top of this dike is to be at least 6" higher than the top of frame (weir).
 7. This structure must be inspected frequently and the filter fabric replaced when clogged.
 - III. Curb Inlet Protection
 1. Attach a continuous piece of wire mesh (20" min. width by throat length plus 4") to the 2" x 4" weir (ensuring throat length plus 4") as shown on the standard drawing.
 2. Place a piece of approved filter cloth (48-60 inches) of the same dimensions as the wire mesh over the wire mesh and securely attach to the 2" x 4" weir.
 3. Securely nail the 2" x 4" weir to 3" long vertical spacers to be located between the weir and inlet face (one 4" spacer 2' lengths of 2" x 4" to the top of the weir at spacer locations). These 2" x 4" spacers shall extend across the inlet top and be held in place by sandbags or alternate weight.

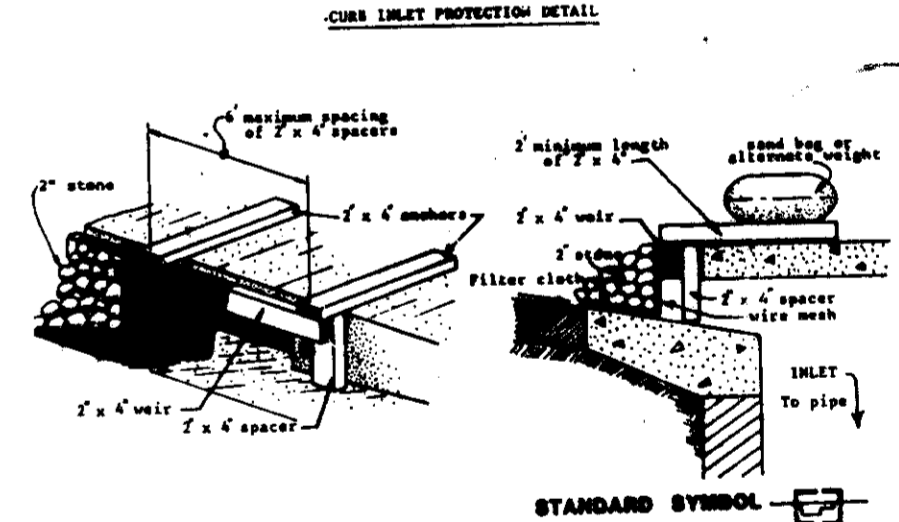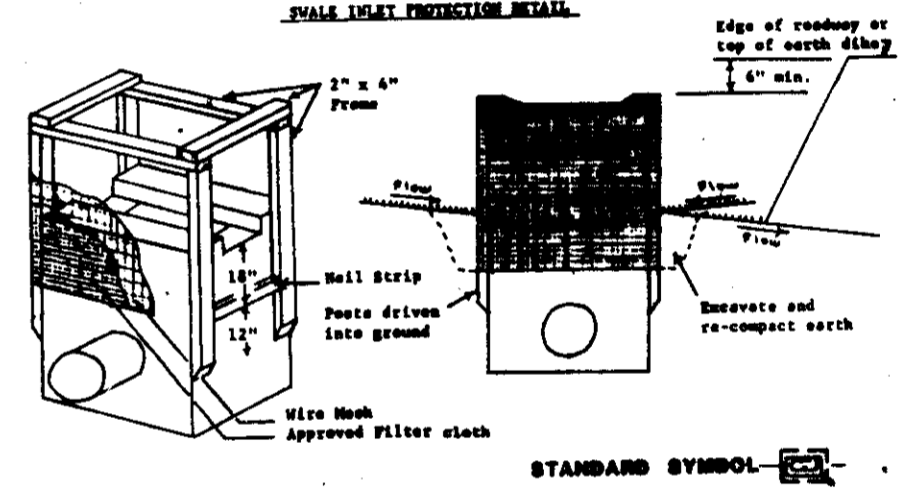

APPROVED
DIVISION OF
COMMUNITY PLANNING
& LAND DEVELOPMENT
HOWARD COUNTY
MARYLAND
DATE _____

Dewberry & Davis
ARCHITECTS ENGINEERS PLANNERS SURVEYORS
3300 N. Ridge Road
Suite 100
Ellicott City, Maryland
21043
(301) 461-7478 BALTIMORE
(301) 621-4970 WASHINGTON

ENGINEER'S CERTIFICATE
I HEREBY CERTIFY THAT THIS PLAN FOR EROSION AND SEDIMENT CONTROL REPRESENTS A PRACTICAL AND WORKABLE PLAN BASED ON MY PERSONAL KNOWLEDGE OF THE SITE CONDITIONS AND THAT IT WAS PREPARED IN ACCORDANCE WITH REQUIREMENTS OF THE HOWARD SOIL CONSERVATION DISTRICT.
Dewberry & Davis 1-18-90
DATE

DEVELOPER'S CERTIFICATE
I DO HEREBY CERTIFY THAT ALL DEVELOPMENT AND CONSTRUCTION WILL BE DONE ACCORDING TO THIS PLAN OF DEVELOPMENT AND PLAN FOR EROSION AND SEDIMENT CONTROL AND THAT ALL RESPONSIBLE PERSONNEL INVOLVED IN THE CONSTRUCTION PROJECT WILL HAVE A CERTIFICATE OF ATTENDANCE AT A DEPARTMENT OF NATURAL RESOURCES APPROVED TRAINING PROGRAM FOR THE CONTROL OF SEDIMENT AND EROSION BEFORE BEGINNING THE PROJECT. I ALSO AUTHORIZE PERIODIC ON-SITE INSPECTION BY THE HOWARD SOIL CONSERVATION DISTRICT OR THEIR AUTHORIZED AGENTS, AS ARE DEEMED NECESSARY.
Michael G. Clay 1/18/90
DATE

REVIEWED FOR HOWARD COUNTY SOIL CONSERVATION DISTRICT AND MEETS TECHNICAL REQUIREMENTS.
John P. Blanton 2/13/90
DATE
SOIL CONSERVATION SERVICE
THIS DEVELOPMENT IS APPROVED FOR EROSION AND SEDIMENT CONTROL BY THE HOWARD SOIL CONSERVATION DISTRICT.
John P. Blanton 2/13/90
DATE
HOWARD SOIL CONSERVATION DISTRICT


APPROVED: HOWARD COUNTY DEPARTMENT OF PLANNING AND ZONING
Ullrich 4-30-90
DATE
PLANNING DIRECTOR
James J. D'Angelo 4/28/90
DATE
CHIEF, DIVISION OF COMMUNITY PLANNING AND LAND DEVELOPMENT
APPROVED: HOWARD COUNTY HEALTH DEPARTMENT FOR PUBLIC WATER AND SEWERAGE SYSTEMS.
John Brodeur 4-23-90
DATE
HEALTH OFFICER

APPROVED: DEPARTMENT OF PUBLIC WORKS FOR PUBLIC WATER AND SEWER AND STORM DRAINAGE SYSTEMS AND ROADS.
James P. Shaw 4/17/90
DATE
DIRECTOR, PUBLIC WORKS
Michael G. Clay 4-16-90
DATE
CHIEF, BUREAU OF ENGINEERING
SUBDIVISION NAME: MONTGOMERY MEADOWS
SECTION/AREA: 1/2
LOT NUMBERS: LOT 62 THRU 137
PLM NO. 9067-9069
BLOCK NO. 14-20
ZONE R-20
TAX/ZONE 31
ELEC. DIST. 1st
CENSUS TR. 2,900,000
WATER CODE Q01
SEWER CODE 2,900,000

DEVELOPER
Capital Homes
A Commitment to Quality
10200 GORMAN ROAD BALT.(301)792-2467
6820 ELM STREET McLEAN,VIRGINIA 22101
LAUREL, MARYLAND 20707 WASH.(301)953-0571
SEDIMENT CONTROL PLAN
MONTGOMERY MEADOWS
SECTION ONE AREA TWO
LOTS 62 THRU 137
TAX MAP 31 P/O PARCEL 463
1ST ELECTION DISTRICT HOWARD COUNTY, MARYLAND
SCALE: 1" = 30'
DATE: APRIL 4, 1990
SHEET 10 OF 12
DRAWN: J.A.U. DESIGNED: B.D.S. CHECKED: B.D.S. APPROVED: T.L.W.
S.D.P. - 89-176

REVISION	DATE	BY
1. 12B (BY G.L.W.)	8-20-91	K

CRYSTAL SPRING STATES
SECTION TWO F-89-22
ZONED R-20

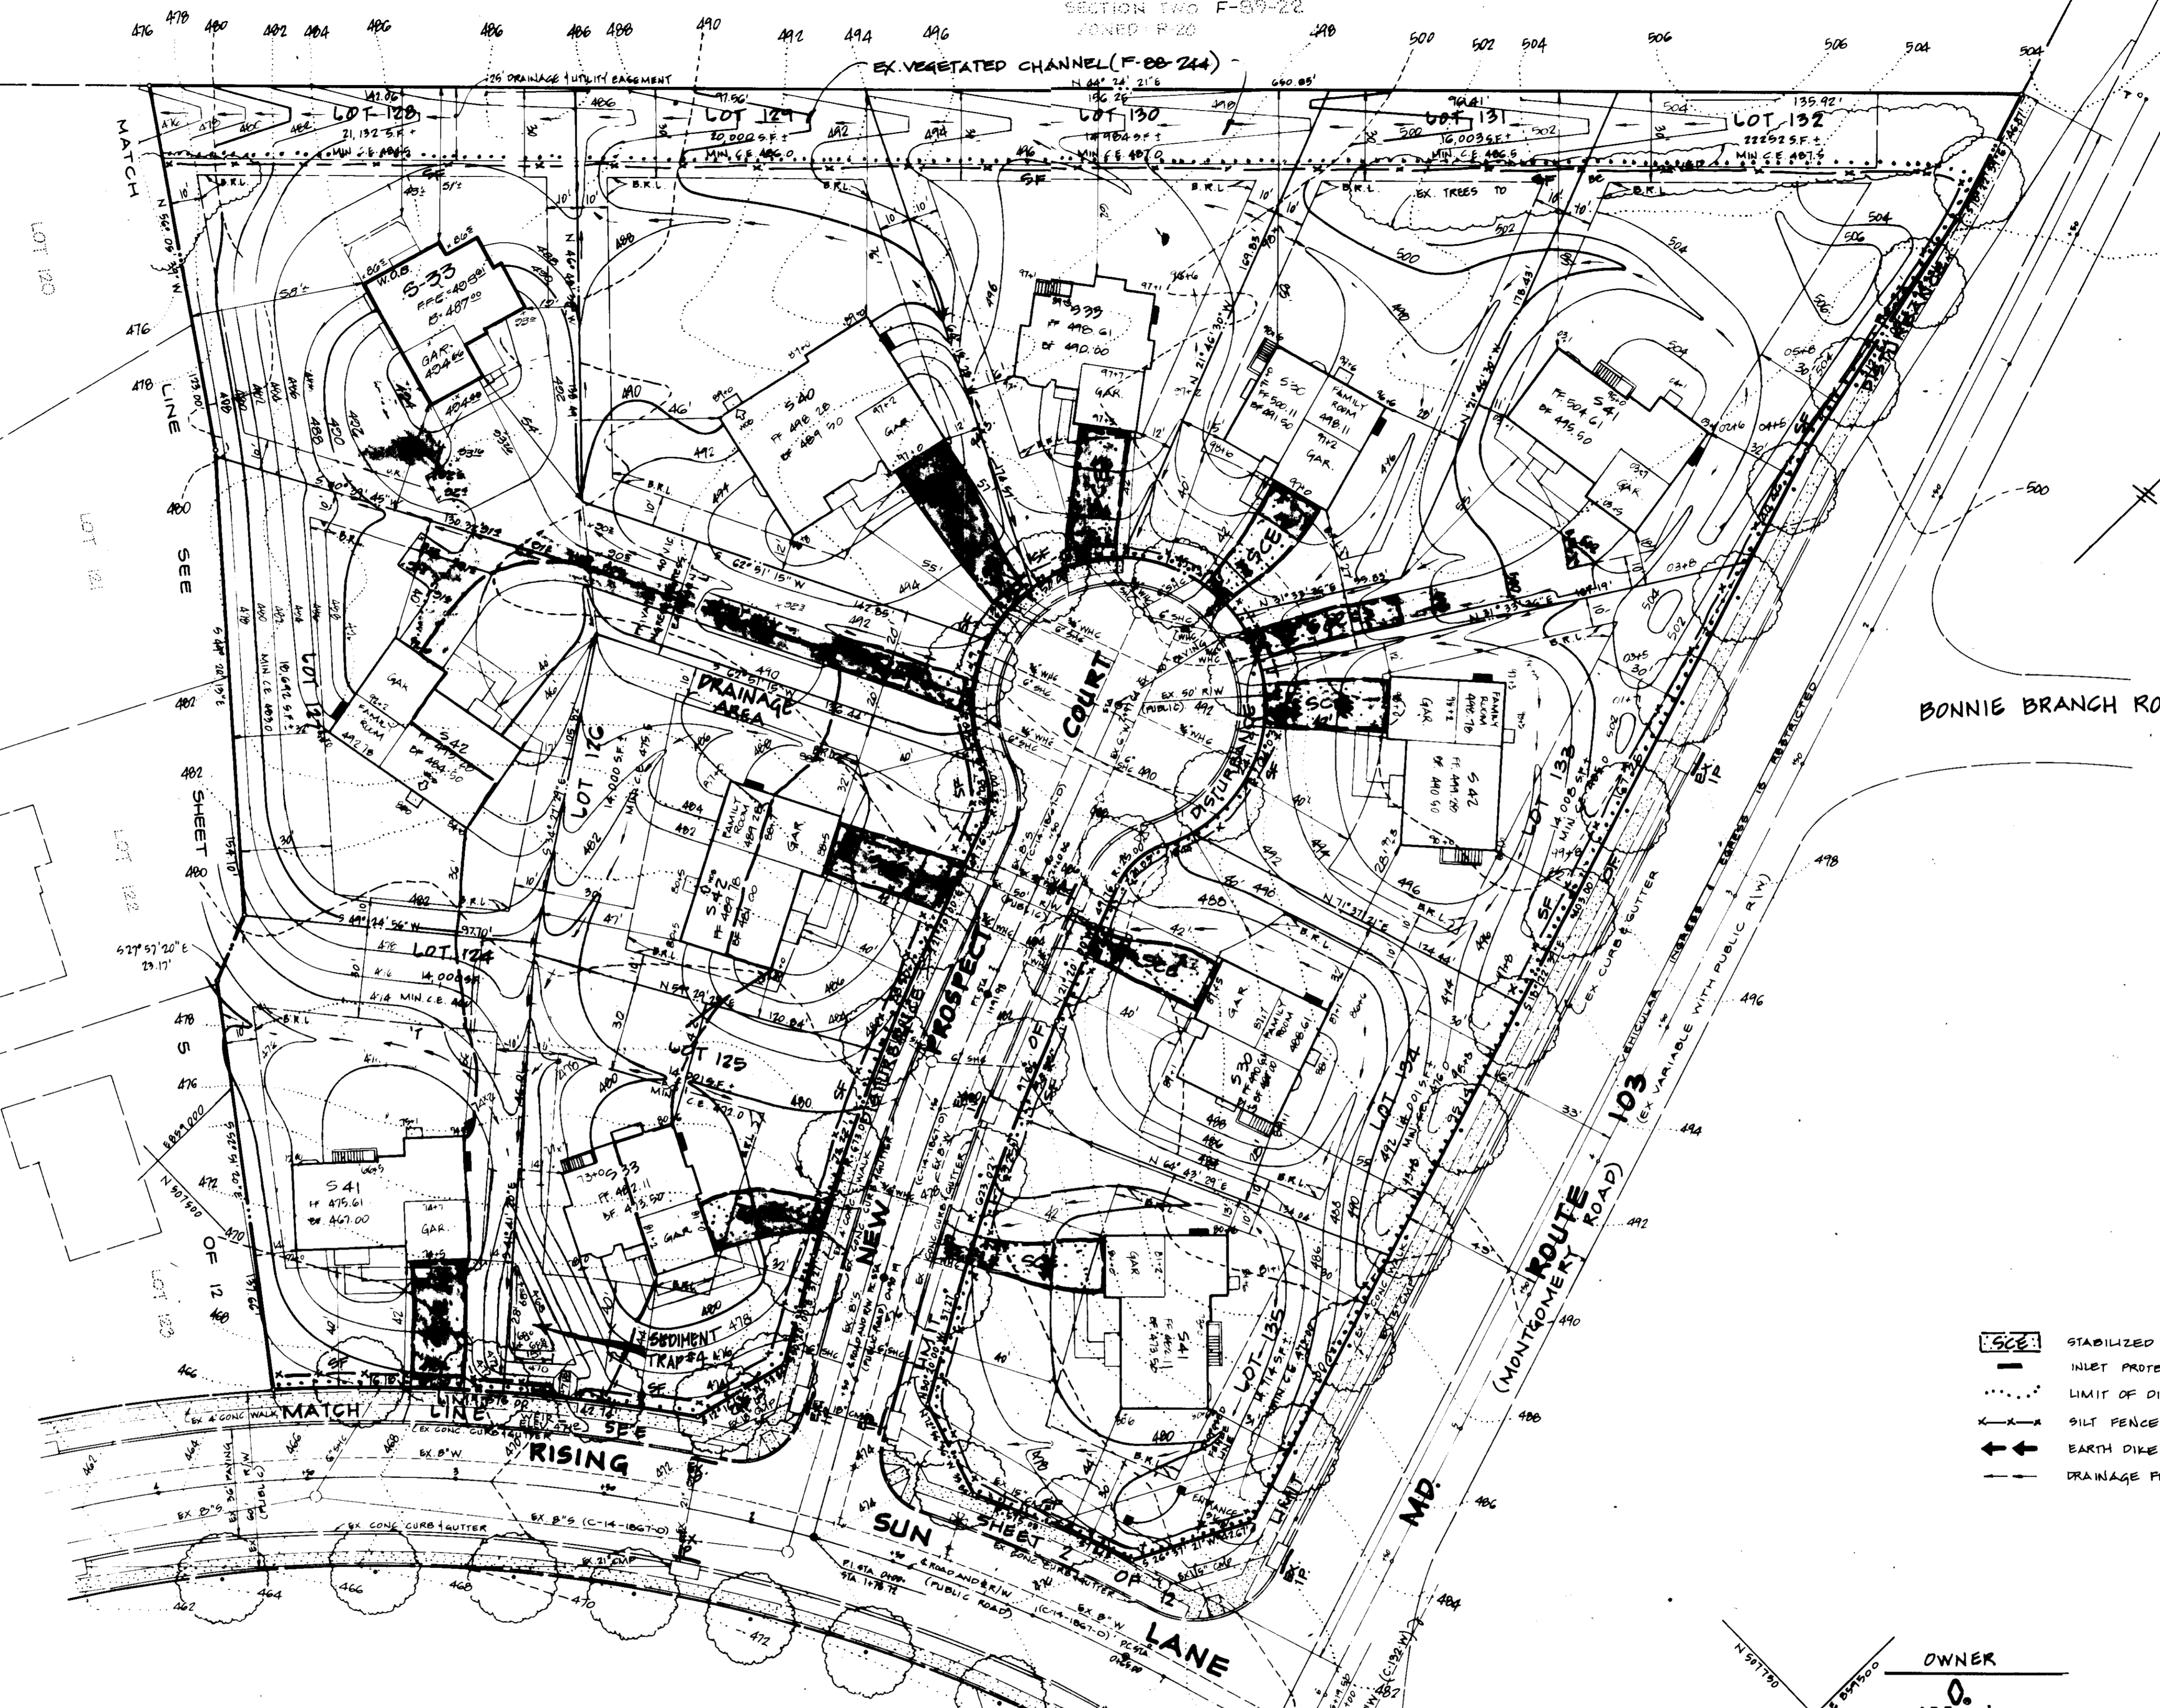

DESIGN DATA TRAP NO. 4
 1. DRAINAGE AREA - 0.54 AC.
 2. TYPE OF TRAP - STORM OUTLET
 3. VOLUME REQUIRED: 25.69 CU. YDS.
 4. VOLUME PROVIDED: 54.90 CU. YDS.
 5. WEIR WIDTH: 4'
 6. WEIR CREST EL: 477.00
 7. TOP OF EMBANKMENT: 472.00
 8. CLEARANCE EL: 470.00
 9. BOTTOM EL: 468.00
 10. TRAP DIMENSIONS (BOTTOM) 15' x 28'
 11. TRAP DEPTH: 3.0'
 12. SIDE SLOPES: 2:1

- LEGEND**
- SCE — STABILIZED CONSTRUCTION ENTRANCE (S.C.E.)
 - INLET PROTECTION (I.P.)
 - LIMIT OF DISTURBANCE
 - X-X- SILT FENCE (S.F.)
 - ←←← EARTH DIKE (E.D.)
 - - - DRAINAGE FLOW

APPROVED
 DIVISION of
 COMMUNITY PLANNING
 & LAND DEVELOPMENT
 HOWARD COUNTY,
 MARYLAND
 DATE _____

DEVELOPER
Capital Homes
 A Commitment to Quality
 10200 GORMAN ROAD BALTIMORE, MARYLAND 21286-2487
 LAUREL, MARYLAND 20707 WASH. 309888-0071

OWNER
 O.
 NVLand
 6820 ELM STREET McLEAN, VIRGINIA 22101
 (703) 734-9730

Dewberry & Davis
 ARCHITECTS ENGINEERS PLANNERS SURVEYORS
 3300 Ridge Road
 Suite 100
 Ellicott City, Maryland
 21043
 (301) 461-7478 BALTIMORE
 (301) 621-4970 WASHINGTON

ENGINEER'S CERTIFICATE
 I HEREBY CERTIFY THAT THIS PLAN FOR EROSION AND SEDIMENT CONTROL REPRESENTS A PRACTICAL AND WORKABLE PLAN BASED ON MY PERSONAL KNOWLEDGE OF THE SITE CONDITIONS AND THAT IT WAS PREPARED IN ACCORDANCE WITH REQUIREMENTS OF THE HOWARD SOIL CONSERVATION DISTRICT.
Shirley L. Kelly 1-18-90
 DATE

DEVELOPER'S CERTIFICATE
 I/WE CERTIFY THAT ALL DEVELOPMENT AND CONSTRUCTION WILL BE DONE ACCORDING TO THIS PLAN OF DEVELOPMENT AND PLAN FOR EROSION AND SEDIMENT CONTROL AND THAT ALL RESPONSIBLE PERSONNEL INVOLVED IN THE CONSTRUCTION PROJECT WILL HAVE A CERTIFICATE OF ATTENDANCE AT A DEPARTMENT OF NATURAL RESOURCES APPROVED TRAINING PROGRAM FOR THE CONTROL OF SEDIMENT AND EROSION BEFORE BEGINNING THE PROJECT. I ALSO AUTHORIZE PERIODIC ON-SITE INSPECTION BY THE HOWARD SOIL CONSERVATION DISTRICT OR THEIR AUTHORIZED AGENTS, AS ARE DEEMED NECESSARY.
Michael G. Kelly 1/10/90
 DATE


REVIEWED FOR HOWARD SOIL CONSERVATION DISTRICT AND MEETS TECHNICAL REQUIREMENTS.
John D. Hester 2/13/90
 DATE
 SOIL CONSERVATION SERVICE
 THIS DEVELOPMENT IS APPROVED FOR EROSION AND SEDIMENT CONTROL BY THE HOWARD SOIL CONSERVATION DISTRICT.
 APPROVED:
John D. Hester 2/13/90
 HOWARD SOIL CONSERVATION DISTRICT DATE

APPROVED: HOWARD COUNTY DEPARTMENT OF PLANNING AND ZONING
William J. ... 4-30-90
 PLANNING DIRECTOR DATE
David J. ... 4/2/90
 CHIEF, DIVISION OF COMMUNITY PLANNING AND LAND DEVELOPMENT DATE
 APPROVED: HOWARD COUNTY HEALTH DEPARTMENT FOR PUBLIC WATER AND SEWERAGE SYSTEMS.
John ... 4-23-90
 HEALTH OFFICER DATE

APPROVED: DEPARTMENT OF PUBLIC WORKS FOR PUBLIC WATER AND SEWER AND STORM DRAINAGE SYSTEMS AND ROADS.
James ... 4/17/90
 DIRECTOR, PUBLIC WORKS DATE
Richard ... 4-16-90
 CHIEF, BUREAU OF ENGINEERING DATE
 SUBDIVISION NAME: MONTGOMERY MEADOWS
 SECTION/AREA: 1/5
 LOT NUMBERS: LOTS 62 THRU 107
 PLAT NO.: 2004-5069
 BLOCK NO.: 16 1/2
 ZONE: R-20
 TAX/ZONE: 31
 ELEC. DIST.: 1st
 CENSUS TR.:
 WATER CODE: C01
 SEWER CODE: 2900,000


SEDIMENT CONTROL PLAN
MONTGOMERY MEADOWS
 SECTION ONE AREA TWO
 LOTS 62 THRU 107
 TAX MAP 31 P/O PARCEL 465
 1ST ELECTION DISTRICT HOWARD COUNTY, MARYLAND
 SCALE: 1" = 30'
 DATE: APRIL 4, 1991
 SHEET 11 OF 12
 DRAWN: J.A.U. CHECKED: S.E.S. APPROVED: T.L.W.

S.D.P. - 89-176

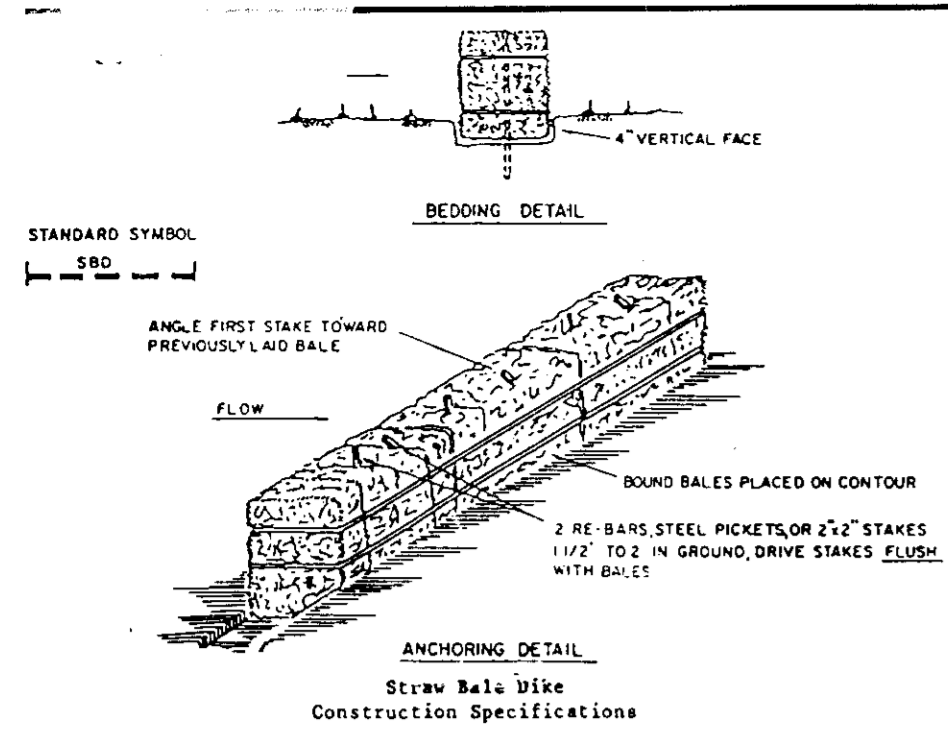

1. Straw bale dikes must be embedded, or keyed in, at least 4 inches into the ground. The key-in trench can be excavated by hand or by machine.
2. Bales shall be placed in the key-in trench so that adjacent bales are tightly abutting and the bindings on the bales are horizontal and above ground level.
3. Two wooden stakes or re-bars per bale shall be used to anchor the dike in place. The stakes or re-bars must be at least 36 inches long and driven through the bales to a depth of 1 1/2 to 2 feet into the ground, and flush with the top of the bale. The first stake shall be driven at an angle toward the previously laid bale, so that the bales are forced together. There should be no gaps between or under the bales.
4. Straw bale dikes must be inspected periodically and after each rain event and maintenance performed as necessary.

STRAW BALE DIKE
NOT TO SCALE

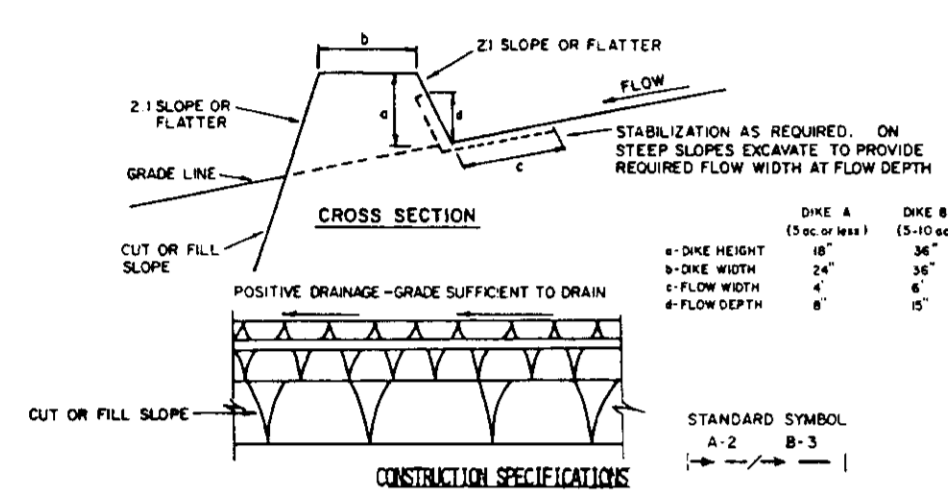


1. All dikes shall be compacted by earthmoving equipment.
2. All dikes shall have positive drainage to an outlet.
3. Top width may be wider and side slopes may be flatter if desired to facilitate crossing by construction traffic.
4. Field location shall be adjusted as needed to utilize a stabilized safe outlet. Earth dikes shall have an outlet that functions with a minimum of erosion. Rip-rap shall be compacted to a sediment trapping device such as a sediment trap or sediment basin where either the dike channel or the drainage area above the dike are not adequately stabilized.
5. Stabilization shall be in accordance with standard specifications for seed and straw mulch or straw mulch if not in seeding season. (C) Flow channel, as per the chart below.

TYPE OF TRAP	CHANNEL	DIKE A	DIKE B
1	5'-3" SEED AND STRAW MULCH	SEED AND STRAW MULCH	SEED AND STRAW MULCH
2	5'-3" SEED AND STRAW MULCH	SEED USING JUTE, OR EXCELGARD, SOIL, 2" STONE	SEED USING JUTE, OR EXCELGARD, SOIL, 2" STONE
3	5'-3" SEED WITH JUTE, OR SOIL	LINED RIP-RAP 4" X 8"	LINED RIP-RAP 4" X 8"
4	8'-2" LINED RIP-RAP 4" X 8"	ENGINEERING DESIGN	ENGINEERING DESIGN

- A. Stone to be 2" thick, or recycled concrete equivalent, in a layer at least 3 inches in thickness and be pressed into the soil with construction equipment.
- B. Rip-rap to be 4" thick in a layer at least 3 inches in thickness and pressed into the soil.
- C. Periodic maintenance shall be provided for any of the above materials.
- D. Periodic inspection and required maintenance shall be provided after each rain.


EARTH DIKE
NOT TO SCALE

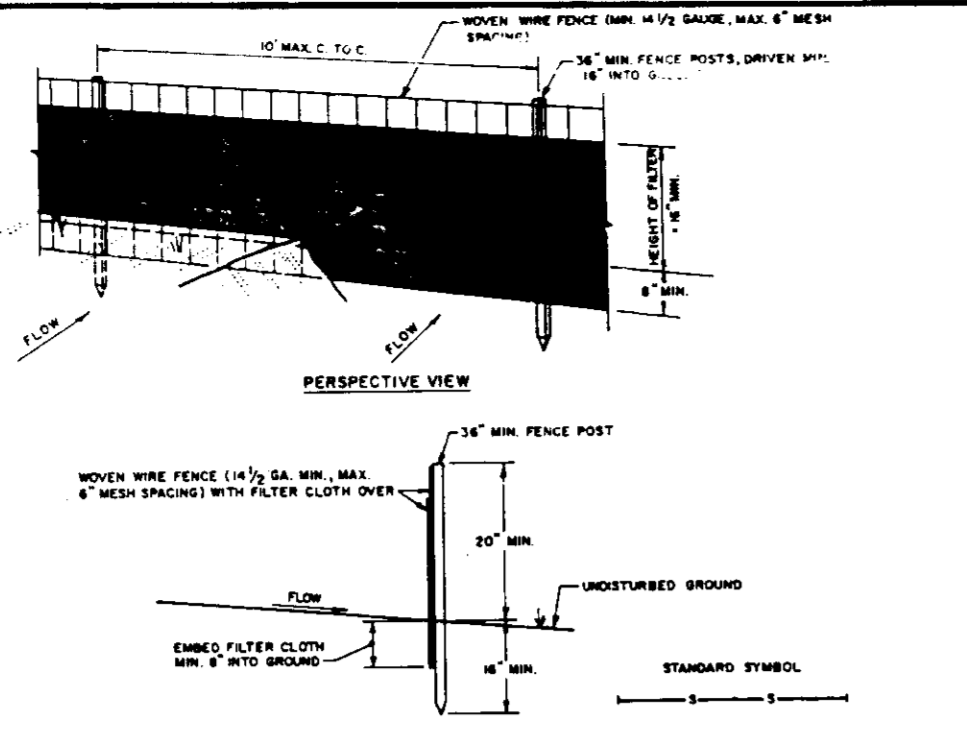

1. The area under embankment shall be cleared, grubbed and stripped of any vegetation and root mat. The pool area shall be cleared.
2. The fill material for the embankment shall be free of roots or other woody vegetation as well as over-sized stones, rocks, organic material or other objectionable material. The embankment shall be compacted by traversing with equipment while it is being constructed. Maximum height of embankment shall be five (5) feet, measured at centerline of embankment.
3. All fill slopes shall be 2:1 or flatter; cut slopes 1:1 or flatter.
4. Elevation of the top of any dike directing water into trap must equal or exceed the height of the embankment.
5. Storage area provided shall be figured by computing the volume available behind the outlet channel up to an elevation of one (1) foot below the level weir crest.
6. Filter cloth shall be placed over the bottom and sides of the outlet channel prior to placement of stone. Sections of fabric must overlap at least one (1) foot with section nearest the entrance placed on top. Fabric shall be embedded at least six (6) inches into existing ground at entrance of outlet channel.
7. Stone used in the outlet channel shall be four (4) to eight (8) inches (riprap). To provide a filtering effect, a layer of filter cloth shall be embedded one (1) foot back into the upstream face of the outlet stone or a one (1) foot thick layer of 1/2 inch filter aggregate shall be placed on the upstream face of the outlet.
8. Sediment shall be removed and trap restored to its original dimensions when the sediment has accumulated to 1/2 the design depth of the trap. Removed sediment shall be deposited in a suitable area and in such a manner that it will not erode.
9. The structure shall be inspected after each rain and repaired as needed.
10. Construction operations shall be carried out in such a manner that erosion and water pollution are minimized.
11. The structure shall be removed and the area stabilized when the drainage area has been properly stabilized.
12. Drainage area for this practice is limited to 15 acres or less.


RIP-RAP SEDIMENT TRAP
NOT TO SCALE

1. A minimum of 24 hours notice must be given to the HOWARD COUNTY OFFICE OF INSPECTION AND PERMITS PRIOR TO THE START OF ANY CONSTRUCTION. (1992-2437)
2. ALL VEGETATIVE AND STRUCTURAL PRACTICES ARE TO BE INSTALLED ACCORDING TO THE PROVISIONS OF THIS PLAN AND ARE TO BE IN CONFORMANCE WITH THE 1983 MARYLAND STANDARDS AND SPECIFICATIONS FOR SOIL EROSION AND SEDIMENT CONTROL.
3. FOLLOWING INITIAL SOIL DISTURBANCE OR REDISTURBANCE, PERMANENT OR TEMPORARY STABILIZATION SHALL BE COMPLETED WITHIN: A) 7 CALENDAR DAYS FOR ALL PERIMETER SEDIMENT CONTROL STRUCTURES, DIKES, PERIMETER SLOPES AND ALL SLOPES GREATER THAN 3:1; B) 14 DAYS AS TO ALL OTHER DISTURBED OR GRADED AREAS ON THE PROJECT SITE.
4. ALL SEDIMENT TRAPS/BASINS SHOWN MUST BE FENCED AND WARNING SIGNS POSTED AROUND THEIR PERIMETER IN ACCORDANCE WITH VOL. 1, CHAPTER 12, OF THE HOWARD COUNTY DESIGN MANUAL, STORM DRAINAGE.
5. ALL DISTURBED AREAS MUST BE STABILIZED WITHIN THE TIME PERIOD SPECIFIED ABOVE IN ACCORDANCE WITH THE 1983 MARYLAND STANDARDS AND SPECIFICATIONS FOR SOIL EROSION AND SEDIMENT CONTROL FOR PERMANENT SEEDINGS (SEC. 51) AND (SEC. 54), TEMPORARY SEEDING (SEC. 50) AND MULCHING (SEC. 52), TEMPORARY STABILIZATION WITH MULCH ALONE CAN ONLY BE DONE WHEN RECOMMENDED SEEDING DATES DO NOT ALLOW FOR PROPER GERMINATION AND ESTABLISHMENT OF GRASSES.
6. ALL SEDIMENT CONTROL STRUCTURES ARE TO REMAIN IN PLACE AND ARE TO BE MAINTAINED IN OPERATIVE CONDITION UNTIL PERMITS FOR THEIR REMOVAL HAS BEEN OBTAINED FROM THE HOWARD COUNTY SEDIMENT CONTROL INSPECTOR.
7. SITE ANALYSIS:
TOTAL AREA OF SITE: 21.05 ACRES
AREA TO BE ROOFED OR PAVED: 7.55 ACRES
AREA TO BE VEGETATIVELY STABILIZED: 13.50 ACRES
TOTAL CUT: 87,000 CU. YDS.
TOTAL FILL: 87,000 CU. YDS.
8. ANY SEDIMENT CONTROL PRACTICE WHICH IS DISTURBED BY GRADING ACTIVITY FOR PLACEMENT OF UTILITIES MUST BE REPAIRED ON THE SAME DAY OF DISTURBANCE.

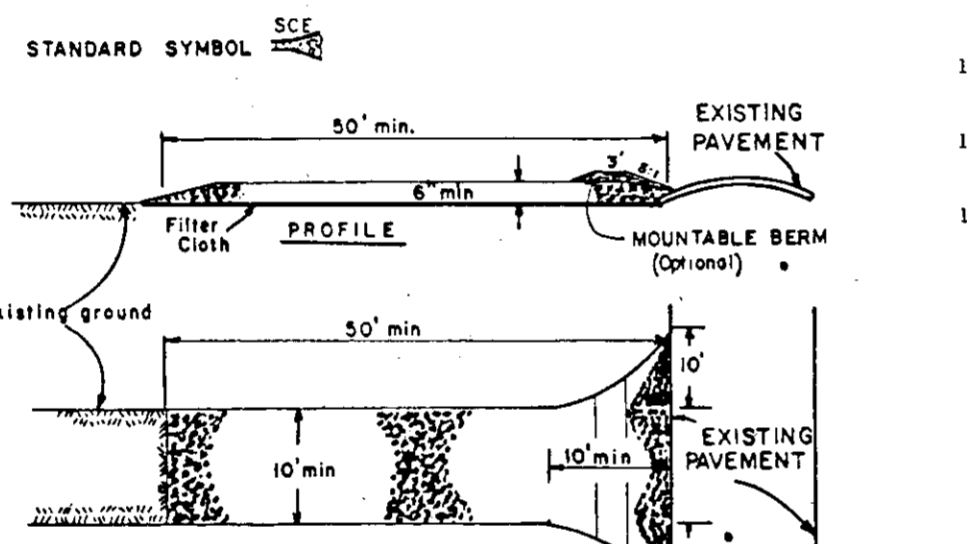

1. Stone Size - Use 2" stone, or recycled or recycled concrete equivalent.
2. Length - As required, but not less than 30 feet (except on a single residence lot where a 30 foot minimum length would apply).
3. Thickness - Not less than six (6) inches.
4. Width - Ten (10) foot minimum, but not less than the full width at points where ingress or egress occurs.
5. Filter Cloth - Will be placed over the entire area prior to placing of stone. Filter will not be required on a single family residence lot.
6. Surface Water - All surface water flowing or diverted toward construction entrances shall be piped across the entrance. If piping is impractical, a mounded beam with 3:1 slope will be permitted.
7. Maintenance - The entrance shall be maintained in a condition which will prevent tracking of flowing sediment onto public rights-of-way. This may require periodic top dressing with additional stone as conditions demand and repair and/or cleanup of any measures used to trap sediment. All sediment spilled, dropped, washed or tracked onto public rights-of-way must be removed immediately.
8. Washing - Wheels shall be cleaned to remove sediment prior to entrance onto public rights-of-way. When washing is required, it shall be done on an area stabilized with stone and which drains into an approved sediment trapping device.
9. Periodic inspection and needed maintenance shall be provided after each rain.

STABILIZED CONSTRUCTION ENTRANCE
NOT TO SCALE

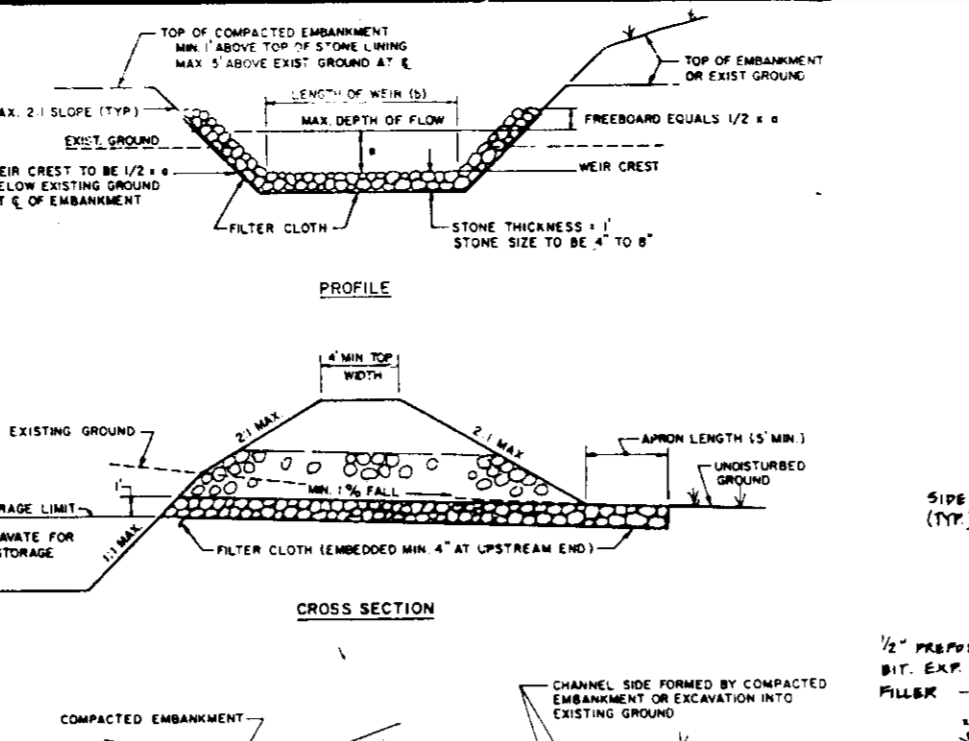

1. Obtain grading permit. Inspect the existing sediment basin and traps constructed under P-8-B-33 and make any necessary repairs or maintenance prior to beginning any work shown hereon.
2. Construct stabilized construction entrances for lots.
3. Construct earth dikes. Compact dike and stabilize with temporary seeding mixture and straw mulch.
4. Install silt fence at limit of disturbance as shown hereon.
5. Install inlet protection.
6. Clear and grub lots to subgrade.
7. Begin excavation for house foundations and begin house construction.
8. Sediment shall be removed from the sediment basin and traps when the cleanout elevation has been reached.
9. The contractor shall inspect and provide necessary maintenance on the sediment and erosion control structures shown hereon after each rainfall and on a daily basis.
10. The sediment basin and traps shall be dewatered by pumping. The accumulated sediment from the basin and traps shall be placed up-grade from the basin and traps in such a manner as not to interfere with construction operations or cause erosion downgrade from the traps.
11. Fine grade lots and stabilize with permanent seeding mixture and straw mulch. Install driveways and sidewalks.
12. Remove silt fence and stabilize disturbed area with permanent seeding mixture and straw mulch.
13. Install silt fence at toe of slopes of the basins and all traps.
14. After permission has been given by the sediment control inspector, backfill the sediment basin and the sediment traps. Bring lots 92 through 97 to subgrade. Pour foundations and begin house construction.
15. Fine grade lots and stabilize with permanent seeding mixture and straw mulch. Install driveways and sidewalks.
16. Remove silt fence and stabilize disturbed area with permanent seeding mixture and straw mulch.

TYPICAL DRIVEWAY ENTRANCE W/ SIDEWALK
NOT TO SCALE

1. Area under embankment shall be cleared, grubbed and stripped of any vegetation and root mat. The pool area shall be cleared.
2. The embankment shall be constructed of fill material that is free of roots and other woody vegetation, as well as over-sized stones, rocks, organic material or other objectionable material. The embankment shall be compacted by traversing with equipment while it is being constructed.
3. All inside cut and fill slopes shall be 2:1 or flatter; outside slopes shall be 3:1 or flatter.
4. Sediment traps must be stabilized within seven calendar days of disturbance or redisturbance.
5. The outlet shall be constructed of small riprap (4" to 8" aggregate) along with a 1" thickness of clean #6 stone (3/4" to 1 1/2" aggregate) stone placed on the upgrade side of the small riprap. The weir section of the outlet shall be 1" lower than the embankment height, and shall be level. The outlet shall discharge onto an undisturbed or stabilized area.
6. Construction operations shall be carried out in such a manner that erosion and water pollution are minimized.
7. The structure shall be inspected periodically and after each rain and maintenance performed as necessary.
8. Sediment shall be removed and trap restored to its original dimensions when the sediment has accumulated to 1/2 the design depth of the trap.
9. The structure shall be removed and the area stabilized when the drainage area has been properly stabilized.

TYPICAL DRIVEWAY ENTRANCE W/O SIDEWALK
NOT TO SCALE


1. Obtain grading permit. Inspect the existing sediment basin and traps constructed under P-8-B-33 and make any necessary repairs or maintenance prior to beginning any work shown hereon.
2. Construct stabilized construction entrances for lots.
3. Construct earth dikes. Compact dike and stabilize with temporary seeding mixture and straw mulch.
4. Install silt fence at limit of disturbance as shown hereon.
5. Install inlet protection.
6. Clear and grub lots to subgrade.
7. Begin excavation for house foundations and begin house construction.
8. Sediment shall be removed from the sediment basin and traps when the cleanout elevation has been reached.
9. The contractor shall inspect and provide necessary maintenance on the sediment and erosion control structures shown hereon after each rainfall and on a daily basis.
10. The sediment basin and traps shall be dewatered by pumping. The accumulated sediment from the basin and traps shall be placed up-grade from the basin and traps in such a manner as not to interfere with construction operations or cause erosion downgrade from the traps.
11. Fine grade lots and stabilize with permanent seeding mixture and straw mulch. Install driveways and sidewalks.
12. Remove silt fence and stabilize disturbed area with permanent seeding mixture and straw mulch.
13. Install silt fence at toe of slopes of the basins and all traps.
14. After permission has been given by the sediment control inspector, backfill the sediment basin and the sediment traps. Bring lots 92 through 97 to subgrade. Pour foundations and begin house construction.
15. Fine grade lots and stabilize with permanent seeding mixture and straw mulch. Install driveways and sidewalks.
16. Remove silt fence and stabilize disturbed area with permanent seeding mixture and straw mulch.

TYPICAL DRIVEWAY ENTRANCE W/ SIDEWALK
NOT TO SCALE

1. Obtain grading permit. Inspect the existing sediment basin and traps constructed under P-8-B-33 and make any necessary repairs or maintenance prior to beginning any work shown hereon.
2. Construct stabilized construction entrances for lots.
3. Construct earth dikes. Compact dike and stabilize with temporary seeding mixture and straw mulch.
4. Install silt fence at limit of disturbance as shown hereon.
5. Install inlet protection.
6. Clear and grub lots to subgrade.
7. Begin excavation for house foundations and begin house construction.
8. Sediment shall be removed from the sediment basin and traps when the cleanout elevation has been reached.
9. The contractor shall inspect and provide necessary maintenance on the sediment and erosion control structures shown hereon after each rainfall and on a daily basis.
10. The sediment basin and traps shall be dewatered by pumping. The accumulated sediment from the basin and traps shall be placed up-grade from the basin and traps in such a manner as not to interfere with construction operations or cause erosion downgrade from the traps.
11. Fine grade lots and stabilize with permanent seeding mixture and straw mulch. Install driveways and sidewalks.
12. Remove silt fence and stabilize disturbed area with permanent seeding mixture and straw mulch.
13. Install silt fence at toe of slopes of the basins and all traps.
14. After permission has been given by the sediment control inspector, backfill the sediment basin and the sediment traps. Bring lots 92 through 97 to subgrade. Pour foundations and begin house construction.
15. Fine grade lots and stabilize with permanent seeding mixture and straw mulch. Install driveways and sidewalks.
16. Remove silt fence and stabilize disturbed area with permanent seeding mixture and straw mulch.

TYPICAL DRIVEWAY ENTRANCE W/O SIDEWALK
NOT TO SCALE

1. Obtain grading permit. Inspect the existing sediment basin and traps constructed under P-8-B-33 and make any necessary repairs or maintenance prior to beginning any work shown hereon.
2. Construct stabilized construction entrances for lots.
3. Construct earth dikes. Compact dike and stabilize with temporary seeding mixture and straw mulch.
4. Install silt fence at limit of disturbance as shown hereon.
5. Install inlet protection.
6. Clear and grub lots to subgrade.
7. Begin excavation for house foundations and begin house construction.
8. Sediment shall be removed from the sediment basin and traps when the cleanout elevation has been reached.
9. The contractor shall inspect and provide necessary maintenance on the sediment and erosion control structures shown hereon after each rainfall and on a daily basis.
10. The sediment basin and traps shall be dewatered by pumping. The accumulated sediment from the basin and traps shall be placed up-grade from the basin and traps in such a manner as not to interfere with construction operations or cause erosion downgrade from the traps.
11. Fine grade lots and stabilize with permanent seeding mixture and straw mulch. Install driveways and sidewalks.
12. Remove silt fence and stabilize disturbed area with permanent seeding mixture and straw mulch.
13. Install silt fence at toe of slopes of the basins and all traps.
14. After permission has been given by the sediment control inspector, backfill the sediment basin and the sediment traps. Bring lots 92 through 97 to subgrade. Pour foundations and begin house construction.
15. Fine grade lots and stabilize with permanent seeding mixture and straw mulch. Install driveways and sidewalks.
16. Remove silt fence and stabilize disturbed area with permanent seeding mixture and straw mulch.

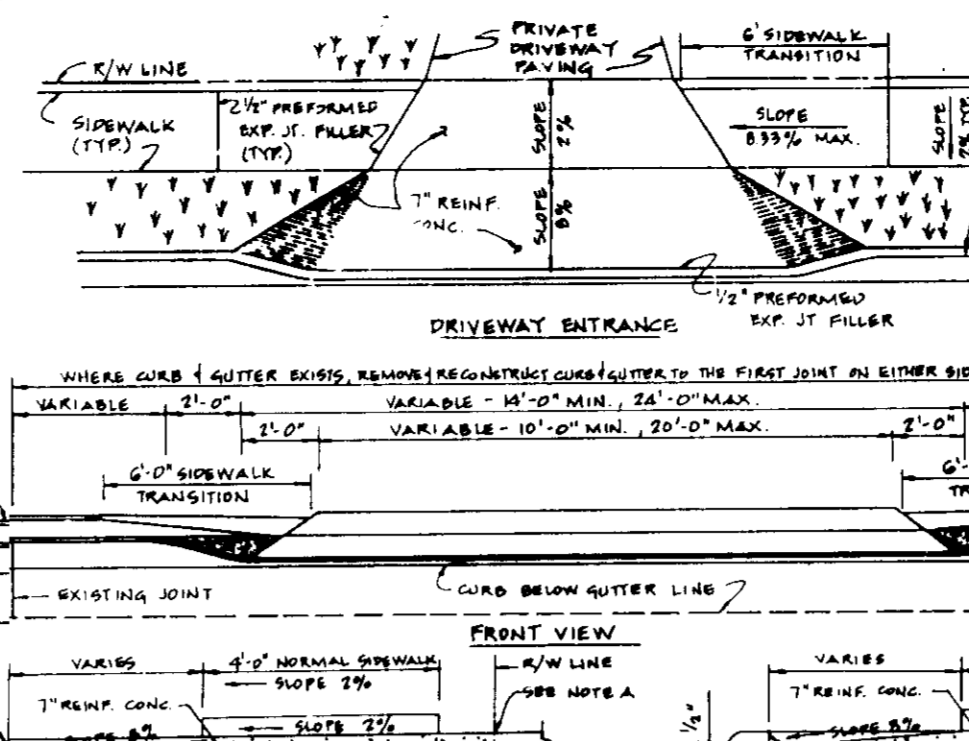

1. Area under embankment shall be cleared, grubbed and stripped of any vegetation and root mat. The pool area shall be cleared.
2. The embankment shall be constructed of fill material that is free of roots and other woody vegetation, as well as over-sized stones, rocks, organic material or other objectionable material. The embankment shall be compacted by traversing with equipment while it is being constructed.
3. All inside cut and fill slopes shall be 2:1 or flatter; outside slopes shall be 3:1 or flatter.
4. Sediment traps must be stabilized within seven calendar days of disturbance or redisturbance.
5. The outlet shall be constructed of small riprap (4" to 8" aggregate) along with a 1" thickness of clean #6 stone (3/4" to 1 1/2" aggregate) stone placed on the upgrade side of the small riprap. The weir section of the outlet shall be 1" lower than the embankment height, and shall be level. The outlet shall discharge onto an undisturbed or stabilized area.
6. Construction operations shall be carried out in such a manner that erosion and water pollution are minimized.
7. The structure shall be inspected periodically and after each rain and maintenance performed as necessary.
8. Sediment shall be removed and trap restored to its original dimensions when the sediment has accumulated to 1/2 the design depth of the trap.
9. The structure shall be removed and the area stabilized when the drainage area has been properly stabilized.

TYPICAL HOUSE PLANS
NOT TO SCALE

1. Obtain grading permit. Inspect the existing sediment basin and traps constructed under P-8-B-33 and make any necessary repairs or maintenance prior to beginning any work shown hereon.
2. Construct stabilized construction entrances for lots.
3. Construct earth dikes. Compact dike and stabilize with temporary seeding mixture and straw mulch.
4. Install silt fence at limit of disturbance as shown hereon.
5. Install inlet protection.
6. Clear and grub lots to subgrade.
7. Begin excavation for house foundations and begin house construction.
8. Sediment shall be removed from the sediment basin and traps when the cleanout elevation has been reached.
9. The contractor shall inspect and provide necessary maintenance on the sediment and erosion control structures shown hereon after each rainfall and on a daily basis.
10. The sediment basin and traps shall be dewatered by pumping. The accumulated sediment from the basin and traps shall be placed up-grade from the basin and traps in such a manner as not to interfere with construction operations or cause erosion downgrade from the traps.
11. Fine grade lots and stabilize with permanent seeding mixture and straw mulch. Install driveways and sidewalks.
12. Remove silt fence and stabilize disturbed area with permanent seeding mixture and straw mulch.
13. Install silt fence at toe of slopes of the basins and all traps.
14. After permission has been given by the sediment control inspector, backfill the sediment basin and the sediment traps. Bring lots 92 through 97 to subgrade. Pour foundations and begin house construction.
15. Fine grade lots and stabilize with permanent seeding mixture and straw mulch. Install driveways and sidewalks.
16. Remove silt fence and stabilize disturbed area with permanent seeding mixture and straw mulch.

TYPICAL HOUSE PLANS
NOT TO SCALE


1. Obtain grading permit. Inspect the existing sediment basin and traps constructed under P-8-B-33 and make any necessary repairs or maintenance prior to beginning any work shown hereon.
2. Construct stabilized construction entrances for lots.
3. Construct earth dikes. Compact dike and stabilize with temporary seeding mixture and straw mulch.
4. Install silt fence at limit of disturbance as shown hereon.
5. Install inlet protection.
6. Clear and grub lots to subgrade.
7. Begin excavation for house foundations and begin house construction.
8. Sediment shall be removed from the sediment basin and traps when the cleanout elevation has been reached.
9. The contractor shall inspect and provide necessary maintenance on the sediment and erosion control structures shown hereon after each rainfall and on a daily basis.
10. The sediment basin and traps shall be dewatered by pumping. The accumulated sediment from the basin and traps shall be placed up-grade from the basin and traps in such a manner as not to interfere with construction operations or cause erosion downgrade from the traps.
11. Fine grade lots and stabilize with permanent seeding mixture and straw mulch. Install driveways and sidewalks.
12. Remove silt fence and stabilize disturbed area with permanent seeding mixture and straw mulch.
13. Install silt fence at toe of slopes of the basins and all traps.
14. After permission has been given by the sediment control inspector, backfill the sediment basin and the sediment traps. Bring lots 92 through 97 to subgrade. Pour foundations and begin house construction.
15. Fine grade lots and stabilize with permanent seeding mixture and straw mulch. Install driveways and sidewalks.
16. Remove silt fence and stabilize disturbed area with permanent seeding mixture and straw mulch.

TYPICAL HOUSE PLANS
NOT TO SCALE

1. Obtain grading permit. Inspect the existing sediment basin and traps constructed under P-8-B-33 and make any necessary repairs or maintenance prior to beginning any work shown hereon.
2. Construct stabilized construction entrances for lots.
3. Construct earth dikes. Compact dike and stabilize with temporary seeding mixture and straw mulch.
4. Install silt fence at limit of disturbance as shown hereon.
5. Install inlet protection.
6. Clear and grub lots to subgrade.
7. Begin excavation for house foundations and begin house construction.
8. Sediment shall be removed from the sediment basin and traps when the cleanout elevation has been reached.
9. The contractor shall inspect and provide necessary maintenance on the sediment and erosion control structures shown hereon after each rainfall and on a daily basis.
10. The sediment basin and traps shall be dewatered by pumping. The accumulated sediment from the basin and traps shall be placed up-grade from the basin and traps in such a manner as not to interfere with construction operations or cause erosion downgrade from the traps.
11. Fine grade lots and stabilize with permanent seeding mixture and straw mulch. Install driveways and sidewalks.
12. Remove silt fence and stabilize disturbed area with permanent seeding mixture and straw mulch.
13. Install silt fence at toe of slopes of the basins and all traps.
14. After permission has been given by the sediment control inspector, backfill the sediment basin and the sediment traps. Bring lots 92 through 97 to subgrade. Pour foundations and begin house construction.
15. Fine grade lots and stabilize with permanent seeding mixture and straw mulch. Install driveways and sidewalks.
16. Remove silt fence and stabilize disturbed area with permanent seeding mixture and straw mulch.

TYPICAL HOUSE PLANS
NOT TO SCALE

1. Obtain grading permit. Inspect the existing sediment basin and traps constructed under P-8-B-33 and make any necessary repairs or maintenance prior to beginning any work shown hereon.
2. Construct stabilized construction entrances for lots.
3. Construct earth dikes. Compact dike and stabilize with temporary seeding mixture and straw mulch.
4. Install silt fence at limit of disturbance as shown hereon.
5. Install inlet protection.
6. Clear and grub lots to subgrade.
7. Begin excavation for house foundations and begin house construction.
8. Sediment shall be removed from the sediment basin and traps when the cleanout elevation has been reached.
9. The contractor shall inspect and provide necessary maintenance on the sediment and erosion control structures shown hereon after each rainfall and on a daily basis.
10. The sediment basin and traps shall be dewatered by pumping. The accumulated sediment from the basin and traps shall be placed up-grade from the basin and traps in such a manner as not to interfere with construction operations or cause erosion downgrade from the traps.
11. Fine grade lots and stabilize with permanent seeding mixture and straw mulch. Install driveways and sidewalks.
12. Remove silt fence and stabilize disturbed area with permanent seeding mixture and straw mulch.
13. Install silt fence at toe of slopes of the basins and all traps.
14. After permission has been given by the sediment control inspector, backfill the sediment basin and the sediment traps. Bring lots 92 through 97 to subgrade. Pour foundations and begin house construction.
15. Fine grade lots and stabilize with permanent seeding mixture and straw mulch. Install driveways and sidewalks.
16. Remove silt fence and stabilize disturbed area with permanent seeding mixture and straw mulch.

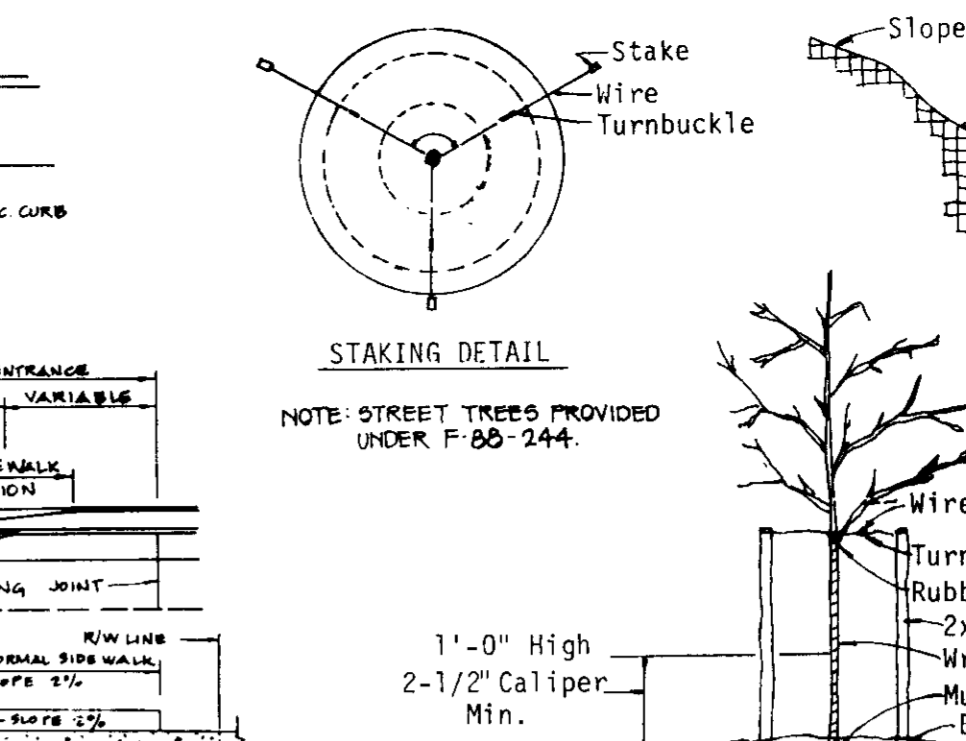

1. Area under embankment shall be cleared, grubbed and stripped of any vegetation and root mat. The pool area shall be cleared.
2. The embankment shall be constructed of fill material that is free of roots and other woody vegetation, as well as over-sized stones, rocks, organic material or other objectionable material. The embankment shall be compacted by traversing with equipment while it is being constructed.
3. All inside cut and fill slopes shall be 2:1 or flatter; outside slopes shall be 3:1 or flatter.
4. Sediment traps must be stabilized within seven calendar days of disturbance or redisturbance.
5. The outlet shall be constructed of small riprap (4" to 8" aggregate) along with a 1" thickness of clean #6 stone (3/4" to 1 1/2" aggregate) stone placed on the upgrade side of the small riprap. The weir section of the outlet shall be 1" lower than the embankment height, and shall be level. The outlet shall discharge onto an undisturbed or stabilized area.
6. Construction operations shall be carried out in such a manner that erosion and water pollution are minimized.
7. The structure shall be inspected periodically and after each rain and maintenance performed as necessary.
8. Sediment shall be removed and trap restored to its original dimensions when the sediment has accumulated to 1/2 the design depth of the trap.
9. The structure shall be removed and the area stabilized when the drainage area has been properly stabilized.

TREE PLANTING
NOT TO SCALE

1. Obtain grading permit. Inspect the existing sediment basin and traps constructed under P-8-B-33 and make any necessary repairs or maintenance prior to beginning any work shown hereon.
2. Construct stabilized construction entrances for lots.
3. Construct earth dikes. Compact dike and stabilize with temporary seeding mixture and straw mulch.
4. Install silt fence at limit of disturbance as shown hereon.
5. Install inlet protection.
6. Clear and grub lots to subgrade.
7. Begin excavation for house foundations and begin house construction.
8. Sediment shall be removed from the sediment basin and traps when the cleanout elevation has been reached.
9. The contractor shall inspect and provide necessary maintenance on the sediment and erosion control structures shown hereon after each rainfall and on a daily basis.
10. The sediment basin and traps shall be dewatered by pumping. The accumulated sediment from the basin and traps shall be placed up-grade from the basin and traps in such a manner as not to interfere with construction operations or cause erosion downgrade from the traps.
11. Fine grade lots and stabilize with permanent seeding mixture and straw mulch. Install driveways and sidewalks.
12. Remove silt fence and stabilize disturbed area with permanent seeding mixture and straw mulch.
13. Install silt fence at toe of slopes of the basins and all traps.
14. After permission has been given by the sediment control inspector, backfill the sediment basin and the sediment traps. Bring lots 92 through 97 to subgrade. Pour foundations and begin house construction.
15. Fine grade lots and stabilize with permanent seeding mixture and straw mulch. Install driveways and sidewalks.
16. Remove silt fence and stabilize disturbed area with permanent seeding mixture and straw mulch.

TREE PLANTING
NOT TO SCALE


1. Obtain grading permit. Inspect the existing sediment basin and traps constructed under P-8-B-33 and make any necessary repairs or maintenance prior to beginning any work shown hereon.
2. Construct stabilized construction entrances for lots.
3. Construct earth dikes. Compact dike and stabilize with temporary seeding mixture and straw mulch.
4. Install silt fence at limit of disturbance as shown hereon.
5. Install inlet protection.
6. Clear and grub lots to subgrade.
7. Begin excavation for house foundations and begin house construction.
8. Sediment shall be removed from the sediment basin and traps when the cleanout elevation has been reached.
9. The contractor shall inspect and provide necessary maintenance on the sediment and erosion control structures shown hereon after each rainfall and on a daily basis.
10. The sediment basin and traps shall be dewatered by pumping. The accumulated sediment from the basin and traps shall be placed up-grade from the basin and traps in such a manner as not to interfere with construction operations or cause erosion downgrade from the traps.
11. Fine grade lots and stabilize with permanent seeding mixture and straw mulch. Install driveways and sidewalks.
12. Remove silt fence and stabilize disturbed area with permanent seeding mixture and straw mulch.
13. Install silt fence at toe of slopes of the basins and all traps.
14. After permission has been given by the sediment control inspector, backfill the sediment basin and the sediment traps. Bring lots 92 through 97 to subgrade. Pour foundations and begin house construction.
15. Fine grade lots and stabilize with permanent seeding mixture and straw mulch. Install driveways and sidewalks.
16. Remove silt fence and stabilize disturbed area with permanent seeding mixture and straw mulch.

TREE PLANTING
NOT TO SCALE

1. Obtain grading permit. Inspect the existing sediment basin and traps constructed under P-8-B-33 and make any necessary repairs or maintenance prior to beginning any work shown hereon.
2. Construct stabilized construction entrances for lots.
3. Construct earth dikes. Compact dike and stabilize with temporary seeding mixture and straw mulch.
4. Install silt fence at limit of disturbance as shown hereon.
5. Install inlet protection.
6. Clear and grub lots to subgrade.
7. Begin excavation for house foundations and begin house construction.
8. Sediment shall be removed from the sediment basin and traps when the cleanout elevation has been reached.
9. The contractor shall inspect and provide necessary maintenance on the sediment and erosion control structures shown hereon after each rainfall and on a daily basis.
10. The sediment basin and traps shall be dewatered by pumping. The accumulated sediment from the basin and traps shall be placed up-grade from the basin and traps in such a manner as not to interfere with construction operations or cause erosion downgrade from the traps.
11. Fine grade lots and stabilize with permanent seeding mixture and straw mulch. Install driveways and sidewalks.
12. Remove silt fence and stabilize disturbed area with permanent seeding mixture and straw mulch.
13. Install silt fence at toe of slopes of the basins and all traps.
14. After permission has been given by the sediment control inspector, backfill the sediment basin and the sediment traps. Bring lots 92 through 97 to subgrade. Pour foundations and begin house construction.
15. Fine grade lots and stabilize with permanent seeding mixture and straw mulch. Install driveways and sidewalks.
16. Remove silt fence and stabilize disturbed area with permanent seeding mixture and straw mulch.

TREE PLANTING
NOT TO SCALE

1. Obtain grading permit. Inspect the existing sediment basin and traps constructed under P-8-B-33 and make any necessary repairs or maintenance prior to beginning any work shown hereon.
2. Construct stabilized construction entrances for lots.
3. Construct earth dikes. Compact dike and stabilize with temporary seeding mixture and straw mulch.
4. Install silt fence at limit of disturbance as shown hereon.
5. Install inlet protection.
6. Clear and grub lots to subgrade.
7. Begin excavation for house foundations and begin house construction.
8. Sediment shall be removed from the sediment basin and traps when the cleanout elevation has been reached.
9. The contractor shall inspect and provide necessary maintenance on the sediment and erosion control structures shown hereon after each rainfall and on a daily basis.
10. The sediment basin and traps shall be dewatered by pumping. The accumulated sediment from the basin and traps shall be placed up-grade from the basin and traps in such a manner as not to interfere with construction operations or cause erosion downgrade from the traps.
11. Fine grade lots and stabilize with permanent seeding mixture and straw mulch. Install driveways and sidewalks.
12. Remove silt fence and stabilize disturbed area with permanent seeding mixture and straw mulch.
13. Install silt fence at toe of slopes of the basins and all traps.
14. After permission has been given by the sediment control inspector, backfill the sediment basin and the sediment traps. Bring lots 92 through 97 to subgrade. Pour foundations and begin house construction.
15. Fine grade lots and stabilize with permanent seeding mixture and straw mulch. Install driveways and sidewalks.
16. Remove silt fence and stabilize disturbed area with permanent seeding mixture and straw mulch.

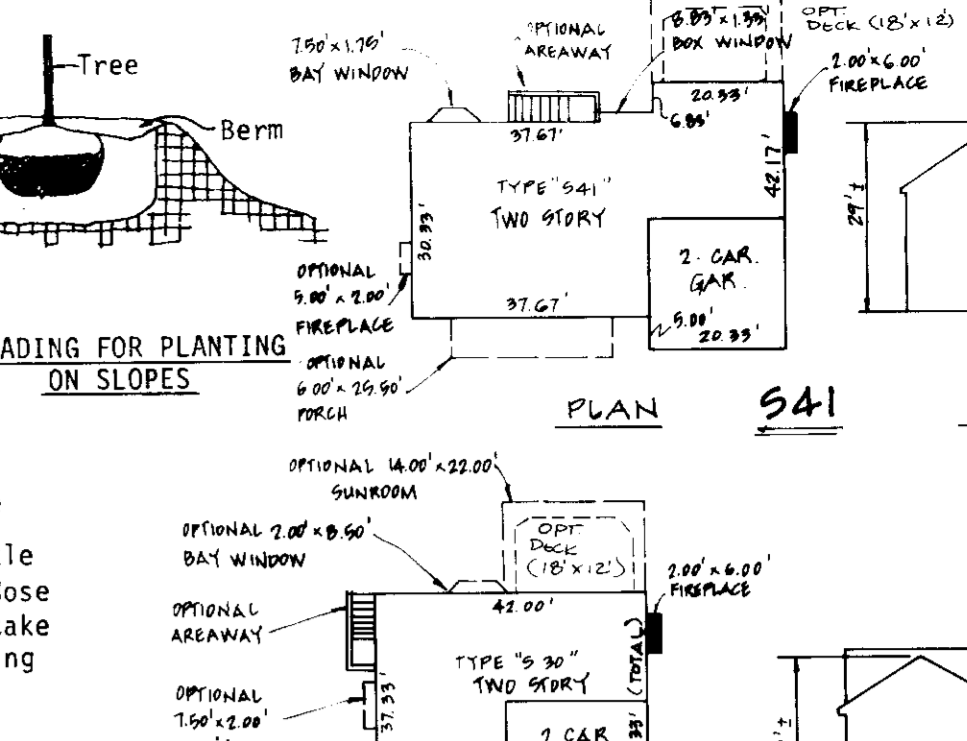

1. Obtain grading permit. Inspect the existing sediment basin and traps constructed under P-8-B-33 and make any necessary repairs or maintenance prior to beginning any work shown hereon.
2. Construct stabilized construction entrances for lots.
3. Construct earth dikes. Compact dike and stabilize with temporary seeding mixture and straw mulch.
4. Install silt fence at limit of disturbance as shown hereon.
5. Install inlet protection.
6. Clear and grub lots to subgrade.
7. Begin excavation for house foundations and begin house construction.
8. Sediment shall be removed from the sediment basin and traps when the cleanout elevation has been reached.
9. The contractor shall inspect and provide necessary maintenance on the sediment and erosion control structures shown hereon after each rainfall and on a daily basis.
10. The sediment basin and traps shall be dewatered by pumping. The accumulated sediment from the basin and traps shall be placed up-grade from the basin and traps in such a manner as not to interfere with construction operations or cause erosion downgrade from the traps.
11. Fine grade lots and stabilize with permanent seeding mixture and straw mulch. Install driveways and sidewalks.
12. Remove silt fence and stabilize disturbed area with permanent seeding mixture and straw mulch.
13. Install silt fence at toe of slopes of the basins and all traps.
14. After permission has been given by the sediment control inspector, backfill the sediment basin and the sediment traps. Bring lots 92 through 97 to subgrade. Pour foundations and begin house construction.
15. Fine grade lots and stabilize with permanent seeding mixture and straw mulch. Install driveways and sidewalks.
16. Remove silt fence and stabilize disturbed area with permanent seeding mixture and straw mulch.

STONE OUTLET SEDIMENT TRAP
NOT TO SCALE

1. Obtain grading permit. Inspect the existing sediment basin and traps constructed under P-8-B-33 and make any necessary repairs or maintenance prior to beginning any work shown hereon.
2. Construct stabilized construction entrances for lots.
3. Construct earth dikes. Compact dike and stabilize with temporary seeding mixture and straw mulch.
4. Install silt fence at limit of disturbance as shown hereon.
5. Install inlet protection.
6. Clear and grub lots to subgrade.
7. Begin excavation for house foundations and begin house construction.
8. Sediment shall be removed from the sediment basin and traps when the cleanout elevation has been reached.
9. The contractor shall inspect and provide necessary maintenance on the sediment and erosion control structures shown hereon after each rainfall and on a daily basis.
10. The sediment basin and traps shall be dewatered by pumping. The accumulated sediment from the basin and traps shall be placed up-grade from the basin and traps in such a manner as not to interfere with construction operations or cause erosion downgrade from the traps.
11. Fine grade lots and stabilize with permanent seeding mixture and straw mulch. Install driveways and sidewalks.
12. Remove silt fence and stabilize disturbed area with permanent seeding mixture and straw mulch.
13. Install silt fence at toe of slopes of the basins and all traps.
14. After permission has been given by the sediment control inspector, backfill the sediment basin and the sediment traps. Bring lots 92 through 97 to subgrade. Pour foundations and begin house construction.
15. Fine grade lots and stabilize with permanent seeding mixture and straw mulch. Install driveways and sidewalks.
16. Remove silt fence and stabilize disturbed area with permanent seeding mixture and straw mulch.

STONE OUTLET SEDIMENT TRAP
NOT TO SCALE

1. Obtain grading permit. Inspect the existing sediment basin and traps constructed under P-8-B-33 and make any necessary repairs or maintenance prior to beginning any work shown hereon.
2. Construct stabilized construction entrances for lots.
3. Construct earth dikes. Compact dike and stabilize with temporary seeding mixture and straw mulch.
4. Install silt fence at limit of disturbance as shown hereon.
5. Install inlet protection.
6. Clear and grub lots to subgrade.
7. Begin excavation for house foundations and begin house construction.
8. Sediment shall be removed from the sediment basin and traps when the cleanout elevation