

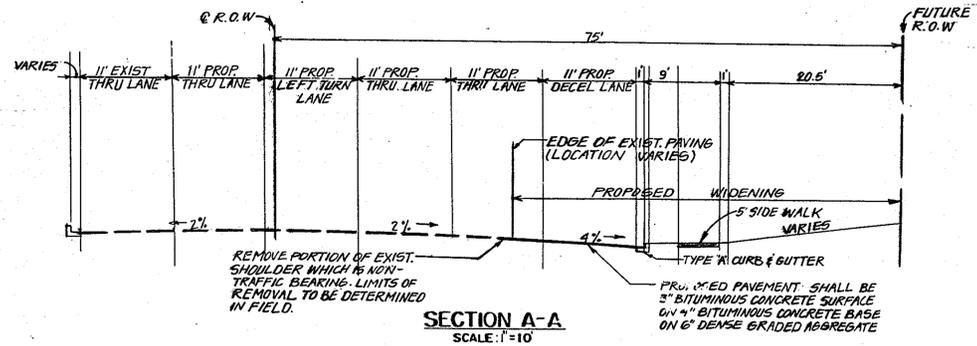
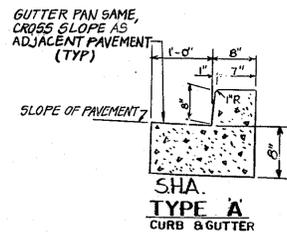
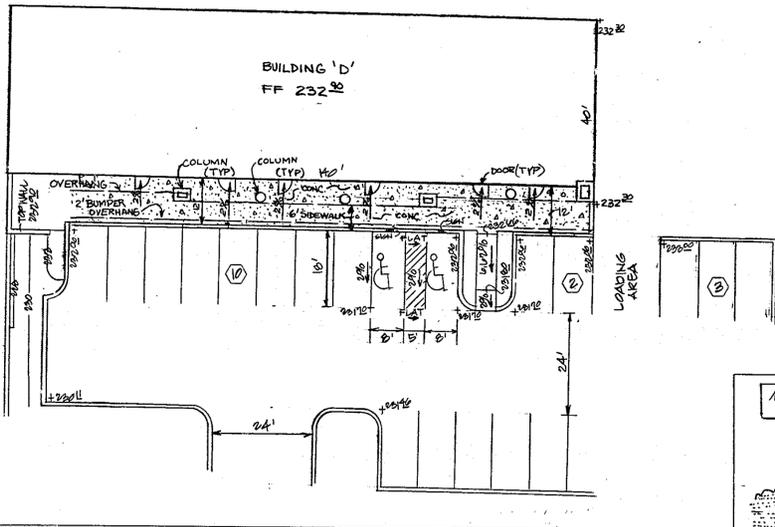
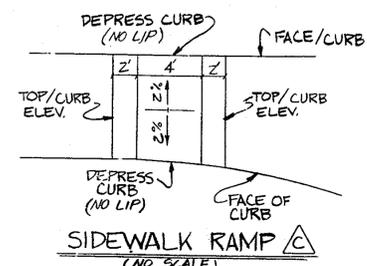





HANDICAP DETAIL
SCALE: 1" = 20'

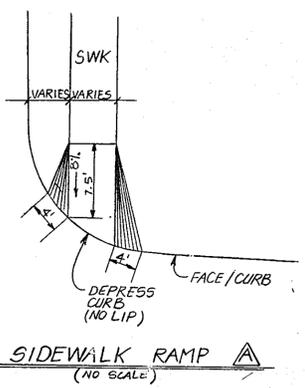

HILLSIDE MOTEL ELK RIDGE CORNERS

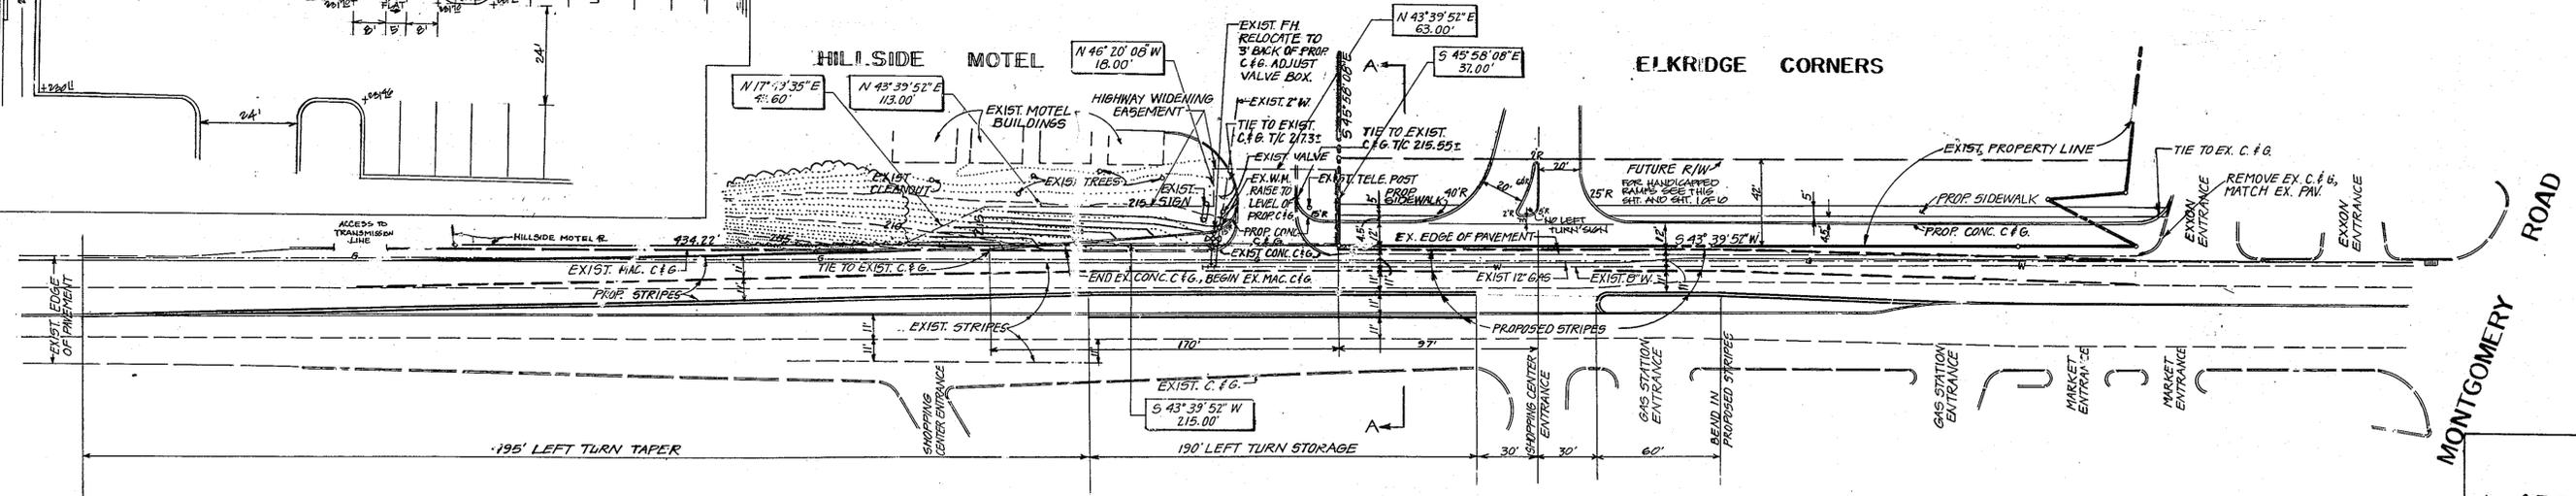


U. S. ROUTE 1 WIDENING
SCALE: 1" = 40'

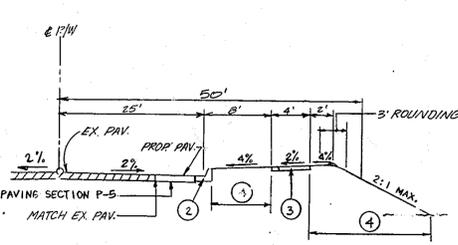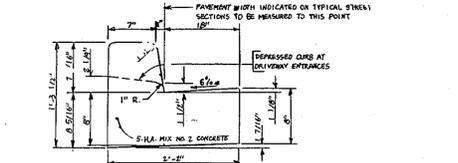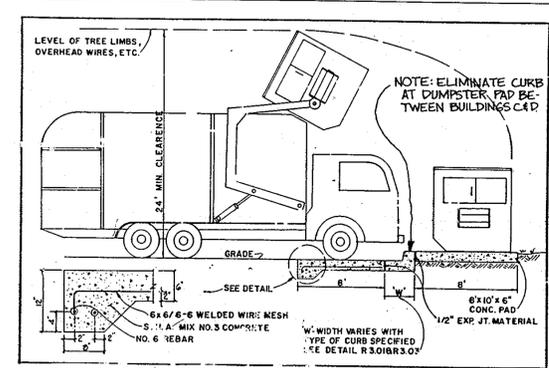

TYPICAL SECTION MONTGOMERY ROAD WIDENING
NOT TO SCALE

- ② 3" D. CON. CURB & GUTTER
- ③ 4" CONCRETE SIDEWALK AS REQUIRED BY SUB-DIVISION REGULATIONS
- ④ INDICATES 2" TOPSOIL, SEED AND MULCH

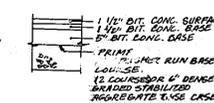

APPROVED
DIVISION OF
COMMUNITY PLANNING
& LAND DEVELOPMENT
HOWARD COUNTY,
MARYLAND
DATE: 8-16-89
J.B.

THIS PLAN IS APPROVED FOR SOIL EROSION AND SEDIMENT CONTROL BY THE HOWARD SOIL CONSERVATION DISTRICT.
APPROVED: *[Signature]* DATE: 7/20/89
HOWARD SOIL CONSERVATION DISTRICT
REVIEWED FOR THE HOWARD SOIL CONSERVATION DISTRICT AND MEETS TECHNICAL REQUIREMENTS.
SIGNATURE: *[Signature]* DATE: 9/20/89
HOWARD SOIL CONSERVATION SERVICE
APPROVED FOR PUBLIC WATER AND PUBLIC SEWERAGE SYSTEMS
HOWARD COUNTY HEALTH DEPARTMENT.
APPROVED: *[Signature]* DATE: 9-27-89
COUNTY HEALTH OFFICER
APPROVED: *[Signature]* DATE: 12-16-89
DIRECTOR
APPROVED: *[Signature]* DATE: 7/20/89
CHIEF DIVISION OF COMMUNITY PLANNING & LAND DEVELOPMENT
APPROVED FOR PUBLIC WATER AND PUBLIC SEWERAGE SYSTEMS AND PUBLIC ROADS HOWARD COUNTY DEPARTMENT OF PUBLIC WORKS.
APPROVED: *[Signature]* DATE: 9/25/89
DIRECTOR
APPROVED: *[Signature]* DATE: 9-25-89
CHIEF BUREAU OF ENGINEERING

GEORGE WILLIAM STEPHENS, JR. AND ASSOCIATES, INC.
CIVIL ENGINEERS & LAND SURVEYORS
303 ALLEGHENY AVENUE
TOWSON, MARYLAND 21284
(301) 825-8120


ENGINEER'S CERTIFICATE:
I CERTIFY THAT THIS PLAN FOR S.W.M. FACILITY CONSTRUCTION, FROSION AND SEDIMENT CONTROL REPRESENTS A PRACTICAL AND WORKABLE PLAN BASED ON MY PERSONAL KNOWLEDGE OF THE SITE CONDITIONS. THIS PLAN WAS PREPARED IN ACCORDANCE WITH THE REQUIREMENTS OF THE HOWARD SOIL CONSERVATION DISTRICT. I HAVE NOTIFIED THE DEVELOPER THAT HE MUST PROVIDE THE HOWARD SOIL CONSERVATION DISTRICT WITH A RED-LINED "AS-BUILT" OF THE S.W.M. FACILITY WITHIN 30 DAYS OF COMPLETION.
ENGINEER: *[Signature]*
REG. NO. 8738 DATE: 6/15/89

OWNERS / DEVELOPERS
PARCEL A-1 ELK RIDGE NATIONAL BANK
7250 MONTGOMERY RD.
ELK RIDGE, MD. 21227
301-798-1200
PARCEL B-1 B & M DEVELOPMENT CO. LIMITED PARTNERSHIP
ONE NORTH CHARLES STREET SUITE 1100
BALTIMORE, MD. 21201
301-327-8500

DEVELOPER'S CERTIFICATE:
I CERTIFY THAT ALL DEVELOPMENT FOR CONSTRUCTION WILL BE DONE ACCORDING TO THE CONDITIONS AND THAT ALL RESPONSIBLE PERSONNEL INVOLVED IN THE CONSTRUCTION PROJECT WILL HAVE A CERTIFICATE OF ATTENDANCE AT A MEETING OF NATURAL RESOURCES APPROVED PROGRAM FOR THE CONSERVATION DISTRICT BEFORE BEGINNING THE PROJECT. I ALSO CERTIFY THAT THE CONSTRUCTION OF THE HOWARD SOIL CONSERVATION DISTRICT OR THEIR AUTHORIZED AGENTS AS ARE DEEMED NECESSARY, DEVIATION FROM THIS PLAN WILL NOT BE MADE UNLESS AUTHORIZED BY THE HOWARD SOIL CONSERVATION DISTRICT. I WILL PROVIDE THE HOWARD SOIL CONSERVATION DISTRICT WITH A RED-LINED "AS-BUILT" OF THE S.W.M. FACILITY WITHIN 30 DAYS OF COMPLETION.
DEVELOPER: *[Signature]* DATE: 9/20/89


DESIGNED: D.P.J.K.
DRAWN: M.K.
CHECKED: D.P.
T.M. 05690
REVISIONS

ROAD WIDENING AND SITE DETAILS FOR ELK RIDGE CORNERS
TAX MAP 38 FILE NO. 5-89-08 PARCELS 826, 805, 799
HOWARD CO., MD. WP-89-52 ELECTION DISTRICT 1
SCALE: AS SHOWN DATE: 4/10/89 SHEET 5 OF 10

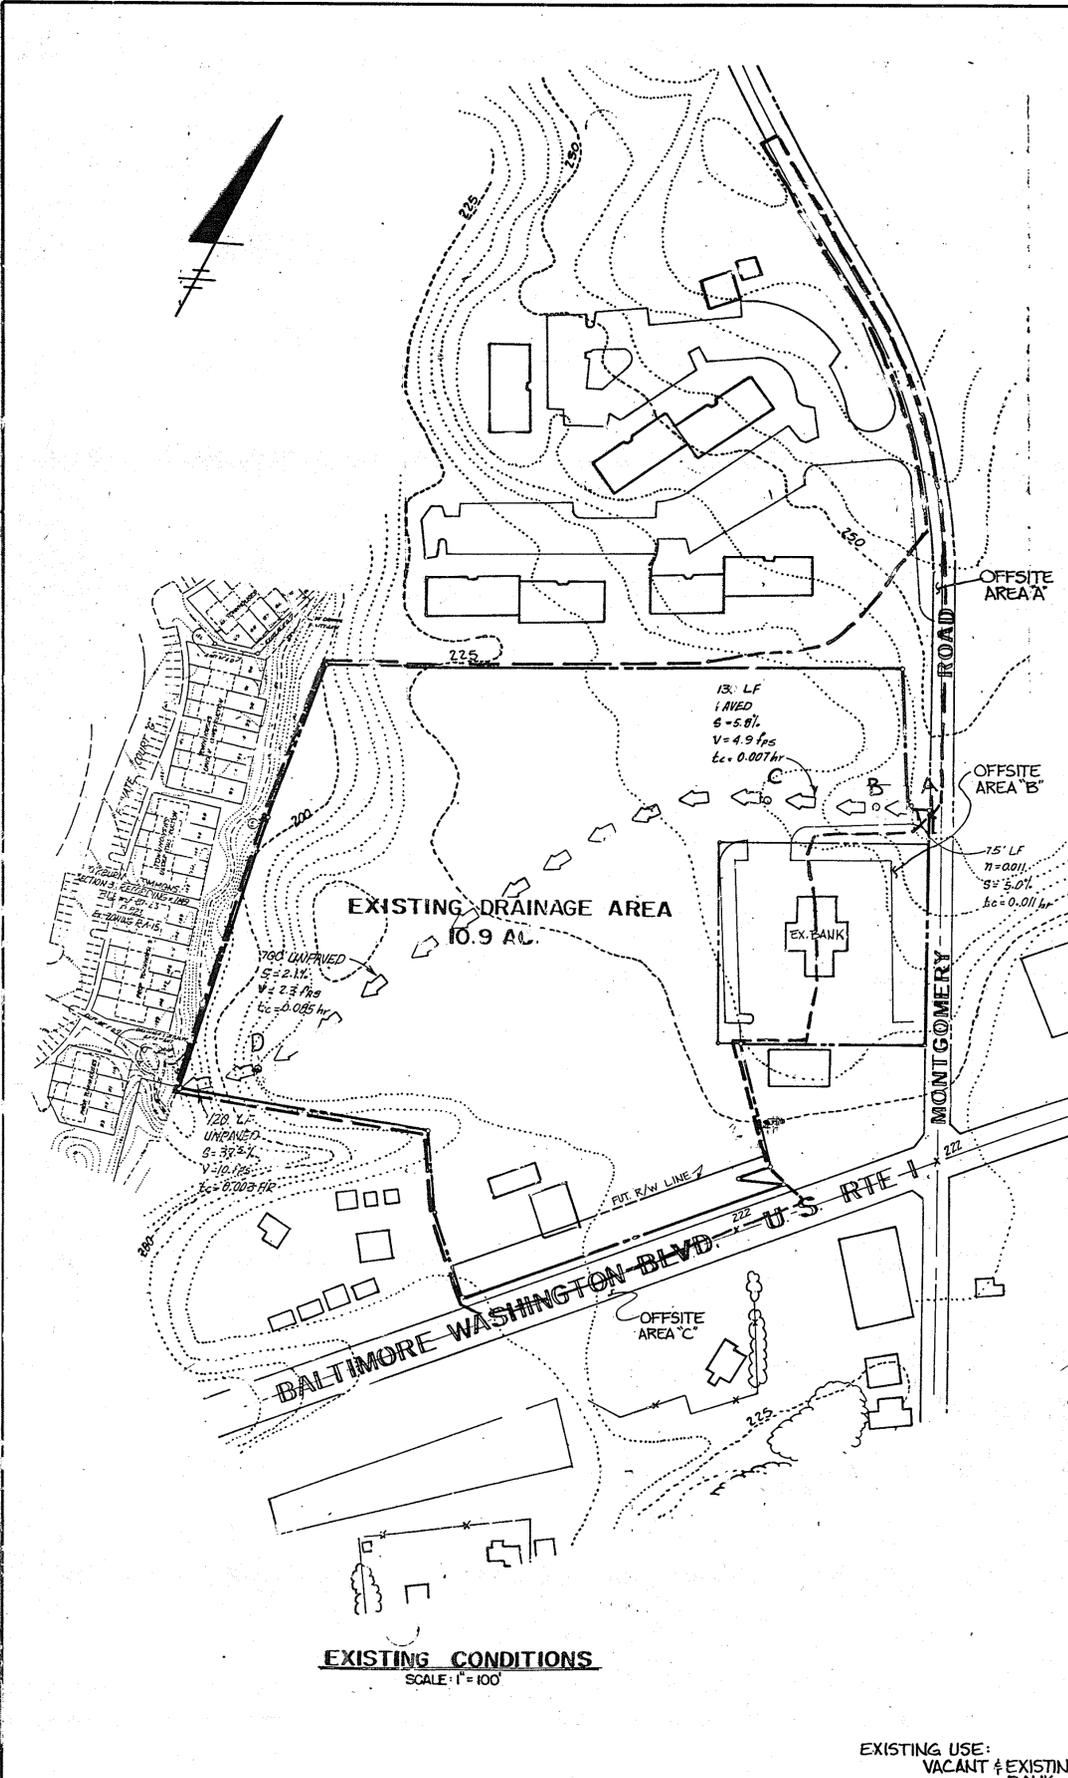


EXISTING CONDITIONS
SCALE: 1" = 100'

EXISTING USE:
VACANT & EXISTING BANK

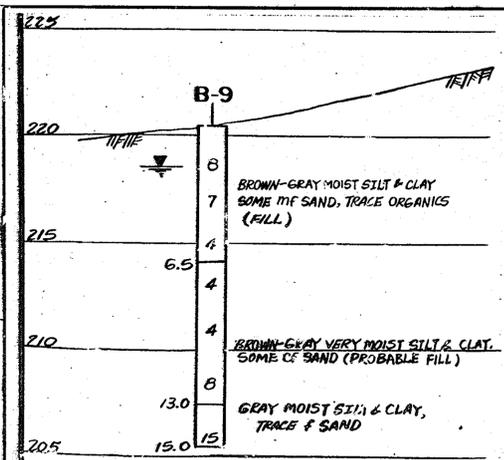

SOIL BORING B-9
BORING PERFORMED BY HERBST & ASSOCIATES
IN MARCH, 1987.

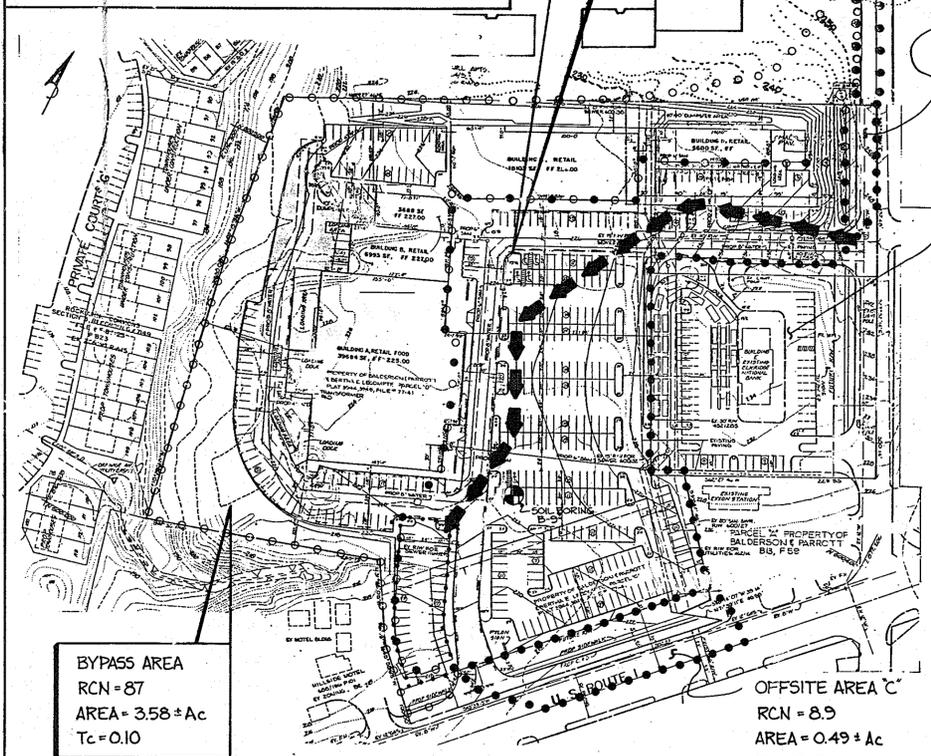

PROPOSED CONDITIONS

SCALE: 1" = 100'

PROPOSED USE:
COMMERCIAL

STORM WATER MANAGEMENT DATA		ELKRIDGE CORNERS	
EXISTING CONDITIONS:			
a) MONTGOMERY ROAD D.A. = 0.44 AC RCN = 98.0 2 YEAR FLOW = 1.58 cfs 10 YEAR FLOW = 2.54 cfs	b) ELKRIDGE BANK D.A. = 0.69 AC RCN = 97.0 2 YEAR FLOW = 2.45 cfs 10 YEAR FLOW = 3.95 cfs	c) TOTAL FLOW TO BE ROUTED (OFFSITE & ONSITE) BEFORE MANAGEMENT (TO THE S.W.M. FACILITY) 2 YEAR FLOW = 20.88 cfs 10 YEAR FLOW = 34.44 cfs	
AFTER MANAGEMENT (FROM THE S.W.M. FACILITY) 2 YEAR FLOW = 10.66 cfs 10 YEAR FLOW = 24.16 cfs			
c) BALTO. WASH. BLVD. D.A. = 0.49 AC RCN = 89.0 2 YEAR FLOW = 1.42 cfs 10 YEAR FLOW = 2.54 cfs	d) ELKRIDGE CORNERS D.A. = 8.41 AC RCN = 75.0 2 YEAR FLOW = 13.50 cfs 10 YEAR FLOW = 30.85 cfs	TWO YEAR STORAGE 26,052 CF (AT ELEV. 215.41) TEN YEAR STORAGE 59,800 CF (AT ELEV. 217.01)	
d) TOTAL FLOW COMPARISON (RELEASE FROM SITE, EXISTING FLOW VERSUS PROPOSED FLOW - NOTE: TOTAL FLOW INC. ADDED HYDROGRAPHS)			
PROPOSED CONDITIONS:		TOTAL EX. FLOW	TOTAL PROP. FLOW
a) ELKRIDGE CORNERS; BY PASS D.A. = 3.58 AC RCN = 87.0 2 YEAR FLOW = 9.71 cfs 10 YEAR FLOW = 17.85 cfs	b) ELKRIDGE CORNERS; TO BE ROUTED D.A. = 4.51 AC RCN = 95.0 2 YEAR FLOW = 15.43 cfs 10 YEAR FLOW = 25.42 cfs	2 YEAR FLOW = 18.91 cfs 10 YEAR FLOW = 39.85 cfs	2 YEAR FLOW = 19.85 cfs 10 YEAR FLOW = 39.40 cfs
REQUIRED STORM WATER MANAGEMENT - TWO & TEN YEAR STORM FREQUENCY PROVIDED STORM WATER MANAGEMENT - TWO & TEN YEAR STORM FREQUENCY			

UNDERGROUND STORAGE
CONSTRUCTION SPECIFICATIONS

I. SITE PREPARATION
AREAS DESIGNATED FOR STORAGE AREAS AND STRUCTURAL WORKS SHALL BE CLEARED, GRUBBED AND REMOVED OF TOPSOIL. ALL TREES, VEGETATION, ROOTS AND OTHER OBJECTIONABLE MATERIAL SHALL BE REMOVED. CHANNEL MARKS AND STRAP MARKS SHALL BE SLOPED TO NO STEEPER THAN 2:1.

AREAS TO BE COVERED BY STORM WATER MANAGEMENT DEVICES SHALL BE CONTROLLED SO THAT THE SURFACE OF EACH LIFT SHALL BE CONTIGUOUS TO THAT OF ADJACENT LIFTS WHICH ARE TO BE CONTIGUOUS OVER THE ENTIRE LENGTH OF THE LIFT. THE ROUGH FINISH OF MATERIAL SHALL BE PLACED PARTIALLY FROM THE STORAGE DEVICE.

CONSTRUCTION:
THE MOVEMENT OF THE SLOPING AND SPREADING EQUIPMENT OVER THE LIFT SHALL BE CONTROLLED SO THAT THE SURFACE OF EACH LIFT SHALL BE CONTIGUOUS TO THAT OF ADJACENT LIFTS WHICH ARE TO BE CONTIGUOUS OVER THE ENTIRE LENGTH OF THE LIFT. THE ROUGH FINISH OF MATERIAL SHALL BE PLACED PARTIALLY FROM THE STORAGE DEVICE.

WHERE A MINIMUM COVERED DENSITY IS SPECIFIED, EACH LAYER AND IS TO BE CERTIFIED BY THE ENGINEER.

III. STRUCTURAL MATERIAL
CONCRETE SHALL MEET MINIMUM REQUIREMENTS SET FORTH IN HANDBOOK OF THE MARYLAND STATE BOARD OF PROFESSIONAL ENGINEERS AND ARCHITECTS (M.S.B.E.A.) SECTION 20.07 (PORTLAND CEMENT CONCRETE MIXTURES), 21.10 (REINFORCING STEEL), 21.11 (STEEL ANCHORS), 21.12 (STEEL ANCHORS), 21.13 (STEEL ANCHORS), 21.99 (STEEL ANCHORS), 22.00 (STEEL ANCHORS).

OFFSITE AREA 'A'
RCN = 98
AREA = 0.44 ± Ac
Tc = 0.10

OFFSITE AREA 'B'
RCN = 97
AREA = 0.69 ± Ac
Tc = 0.10

OFFSITE AREA 'C'
RCN = 89
AREA = 0.49 ± Ac
Tc = 0.10

LEGEND

- ○ ○ ○ ○ ○ ○ ○ AREA TO BY PASS STORM WATER MANAGEMENT FACILITY
- ● ● ● ● ● ● ● AREA TO BE MANAGED VIA THE STORM WATER MANAGEMENT FACILITY
- → → → → → EX. TC PATH
- → → → → → PROP. TC PATH
- LIMIT OF STORM WATER MANAGEMENT FACILITY

APPROVED
DIVISION OF
COMMUNITY PLANNING
& LAND DEVELOPMENT
HOWARD COUNTY,
MARYLAND
DATE: 8-16-89

THESE PLANS HAVE BEEN REVIEWED FOR THE HOWARD SOIL CONSERVATION DISTRICT & MEET THE TECHNICAL REQUIREMENTS FOR SOIL EROSION AND SEDIMENT CONTROL.

John H. Helm 9/20/89
U.S. SOIL CONSERVATION SERVICE

THESE PLANS FOR SMALL POND CONSTRUCTION, SOIL EROSION AND SEDIMENT CONTROL MEET THE REQUIREMENTS OF HOWARD SOIL CONSERVATION DISTRICT.

APPROVED: *Stephen J. Gales* 9-20-89
HOWARD SOIL CONSERVATION DISTRICT

PLAN NUMBER

APPROVED: FOR PUBLIC WATER AND PUBLIC SEWERAGE SYSTEMS
HOWARD COUNTY HEALTH DEPARTMENT.

Jeanne Boyd 9-27-89
COUNTY HEALTH OFFICER

APPROVED: HOWARD COUNTY DEPT. OF PLANNING & ZONING.

W.P.S. 10.16.89
DIRECTOR

David S. M. Taylor 9/20/89
CHIEF DIVISION OF COMMUNITY PLANNING & LAND DEVELOPMENT

APPROVED: FOR PUBLIC WATER AND PUBLIC SEWERAGE SYSTEMS AND PUBLIC ROADS HOWARD COUNTY DEPARTMENT OF PUBLIC WORKS.

James P. Lane 9/25/89
DIRECTOR

James P. Lane 9-25-89
CHIEF BUREAU OF ENGINEERING

GEORGE WILLIAM STEPHENS, JR. AND ASSOCIATES, INC.
CIVIL ENGINEERS & LAND SURVEYORS
303 ALLEGHENY AVENUE
TOWSON, MARYLAND 21204
13011825-8120



ENGINEER'S CERTIFICATE:
I CERTIFY THAT THIS PLAN FOR S.W.M. FACILITY CONSTRUCTION, EROSION AND SEDIMENT CONTROL REPRESENT A PRACTICAL AND WORKABLE PLAN BASED ON MY PERSONAL KNOWLEDGE OF THE SITE CONDITIONS THIS PLAN WAS PREPARED IN ACCORDANCE WITH THE REQUIREMENTS OF THE SITE CONDITIONS THIS PLAN WAS PREPARED IN ACCORDANCE WITH THE REQUIREMENTS OF THE HOWARD SOIL CONSERVATION DISTRICT. I HAVE NOTIFIED THE DEVELOPER THAT HE MUST PROVIDE THE HOWARD SOIL CONSERVATION DISTRICT WITH A RED-LINED "AS-BUILT" OF THE S.W.M. FACILITY WITHIN 30 DAYS OF COMPLETION.

ENGINEER: *George William Stephens, Jr.*
REG. NO. 13011825-8120 DATE: 6/15/89

OWNERS / DEVELOPERS
PARCEL A - ELKRIDGE NATIONAL BANK
7290 MONTGOMERY ROAD
ELKRIDGE, MD. 21227
301-796-1200

PARCEL B - L & M DEVELOPMENT CO. LIMITED PARTNERSHIP
ONE NORTH CHARLES STREET SUITE 1100
BALTIMORE, MD. 21201
301-7-7-8300


DEVELOPER'S CERTIFICATE:
I CERTIFY THAT ALL DEVELOPMENT AND CONSTRUCTION WILL BE DONE ACCORDING TO THESE PLANS AND THAT I AM RESPONSIBLE PERSONNEL INVOLVED IN THE PROJECT. THIS PROJECT WILL HAVE A CERTIFICATE OF ATTENDANCE AT A MEETING OF NATURAL RESOURCES APPROVED PROGRAM FOR THE CONTROL OF SEDIMENT AND EROSION BEFORE BEGINNING THE PROJECT. I AM SO INFORMED PERIODIC ON-SITE INSPECTION BY THE HOWARD SOIL CONSERVATION DISTRICT OR THEIR AUTHORIZED AGENTS AS ARE DETERMINED NECESSARY. NO PORTION FROM THIS PLAN WILL NOT BE MADE UNLESS AUTHORIZED BY THE HOWARD SOIL CONSERVATION DISTRICT. I WILL PROVIDE THE HOWARD SOIL CONSERVATION DISTRICT WITH A RED-LINED "AS-BUILT" OF THE S.W.M. FACILITY WITHIN 30 DAYS OF COMPLETION.

PARCEL A - DEVELOPER: *George William Stephens, Jr.* DATE: 6/15/89
PARCEL B - DEVELOPER: *L & M Development Co.* DATE: 6/15/89


DESIGNED BY: CJB
DRAWN BY: RCB
CHECKED BY: DLP

REVISIONS:


STORM WATER MANAGEMENT DRAINAGE AREA MAP
FOR
ELKRIDGE CORNERS
TAX MAP 38 FILE NO. 5-89-08 PARCELS 826, 885, 799
HOWARD CO., MD. WP-89-52 ELECTION DISTRICT 1
SCALE: 1" = 100' NP-89-104 DATE: 4/18/89
SHEET 5 OF 10

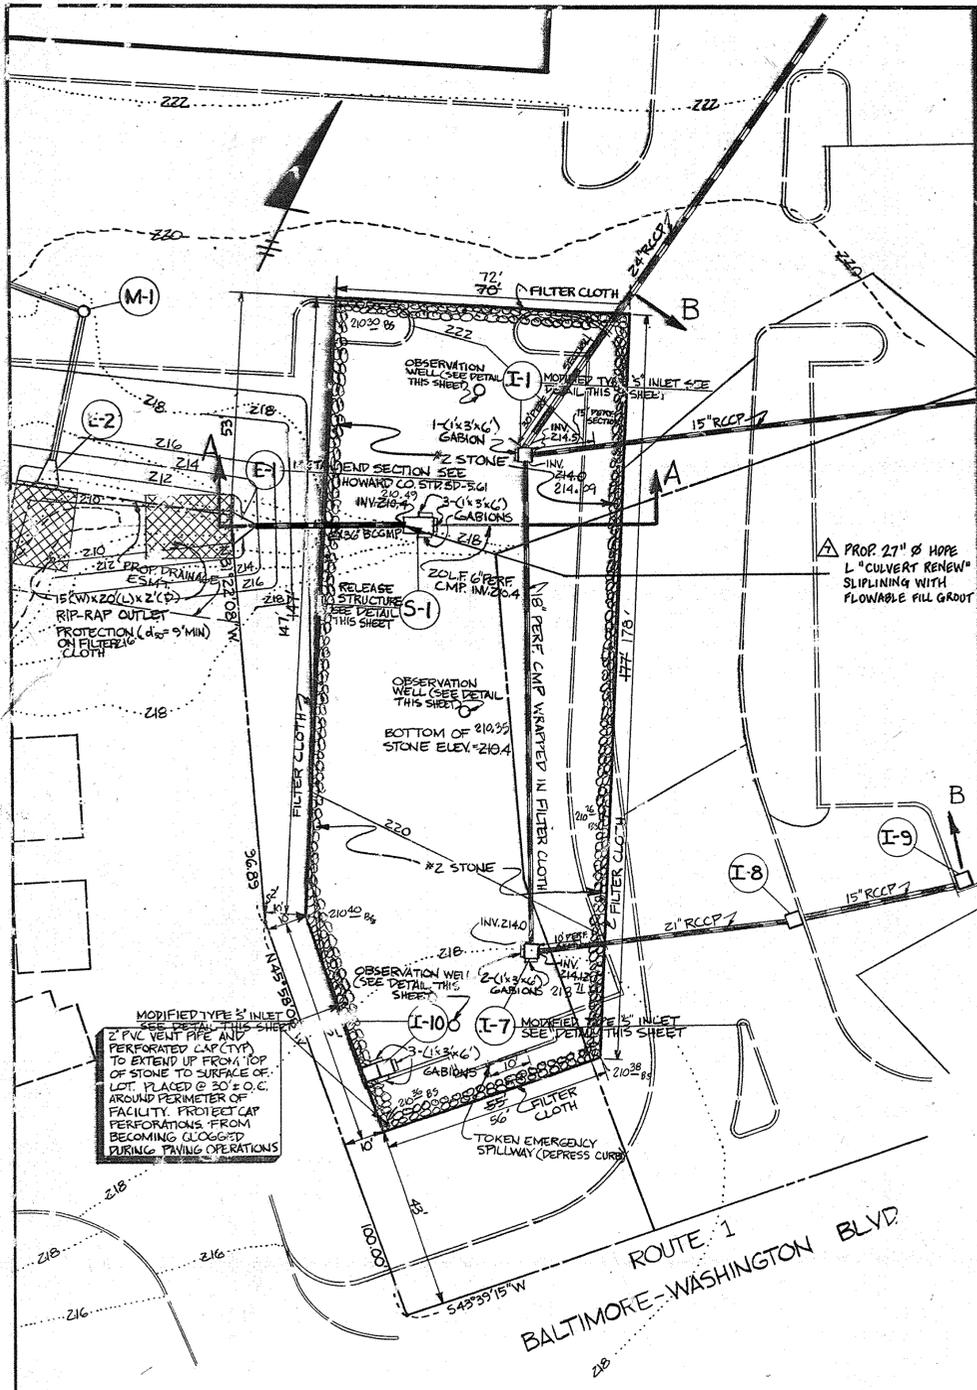


DETAIL OF UNDERGROUND STORMWATER MANAGEMENT FACILITY
SCALE: 1"=20'

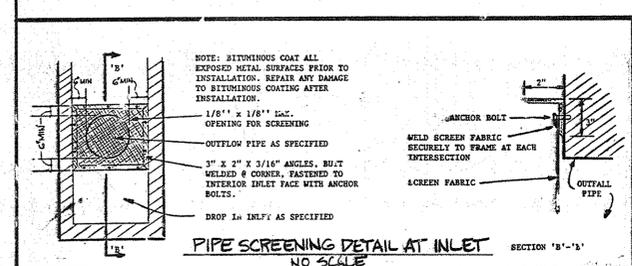


PIPE SCREENING DETAIL AT INLET
NO SCALE

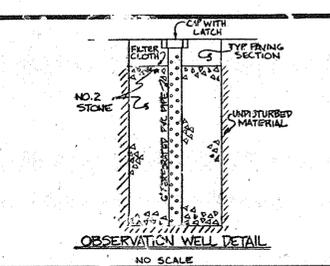


OBSERVATION WELL DETAIL
NO SCALE

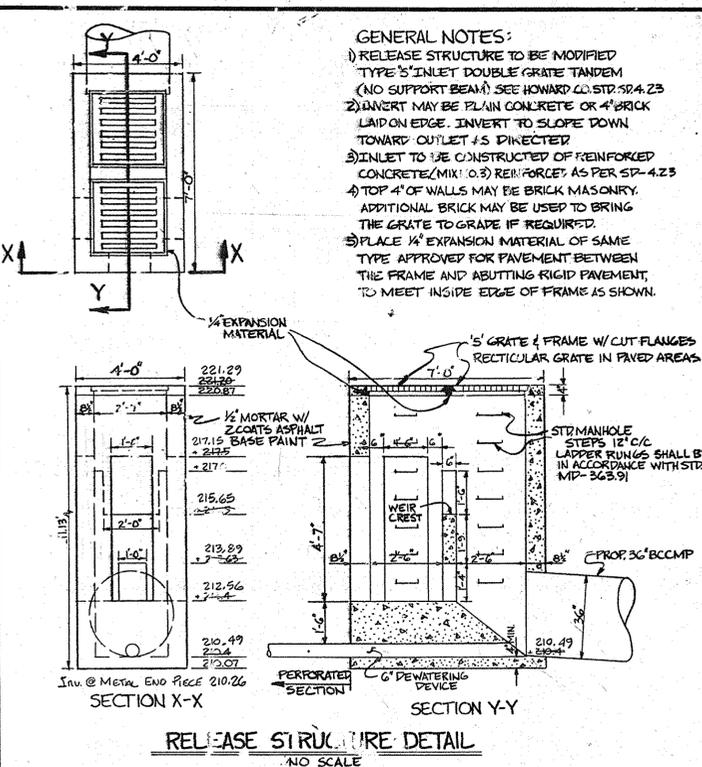

RELEASE STRUCTURE DETAIL
NO SCALE

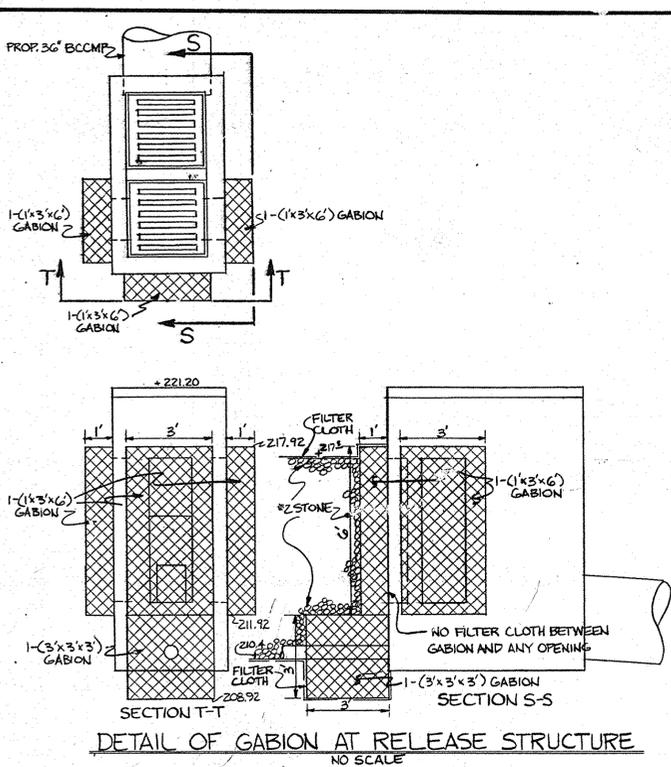


DETAIL OF GABION AT RELEASE STRUCTURE
NO SCALE

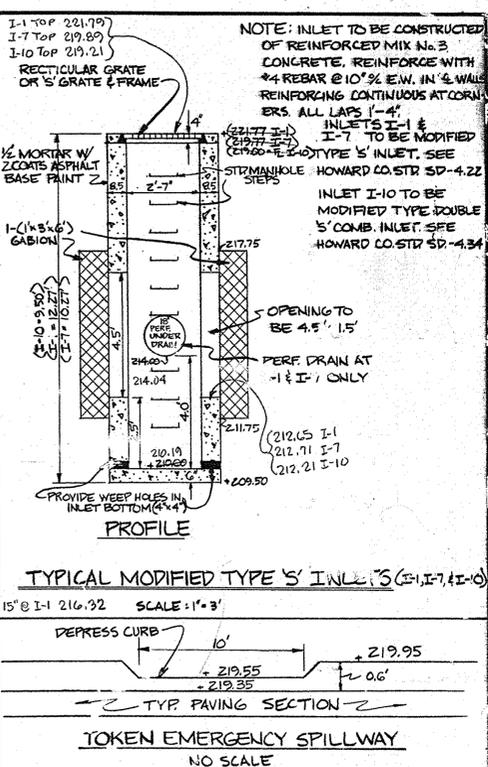


TYPICAL MODIFIED TYPE 'S' INLET PROFILE
SCALE: 1\"/>


TOKEN EMERGENCY SPILLWAY
NO SCALE

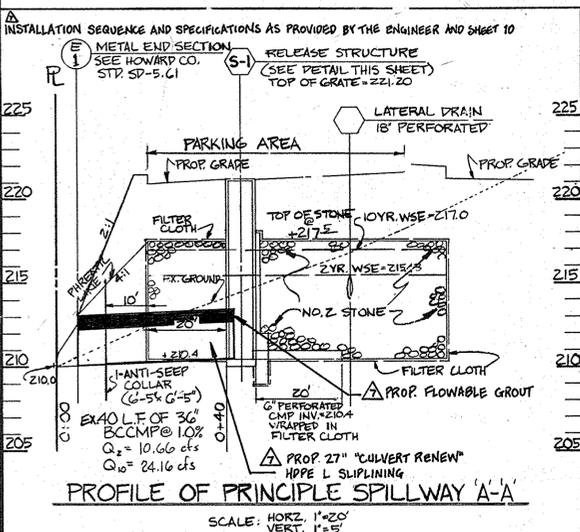

PROFILE OF PRINCIPLE SPILLWAY 'A-A'
SCALE: HORIZ. 1\"/>

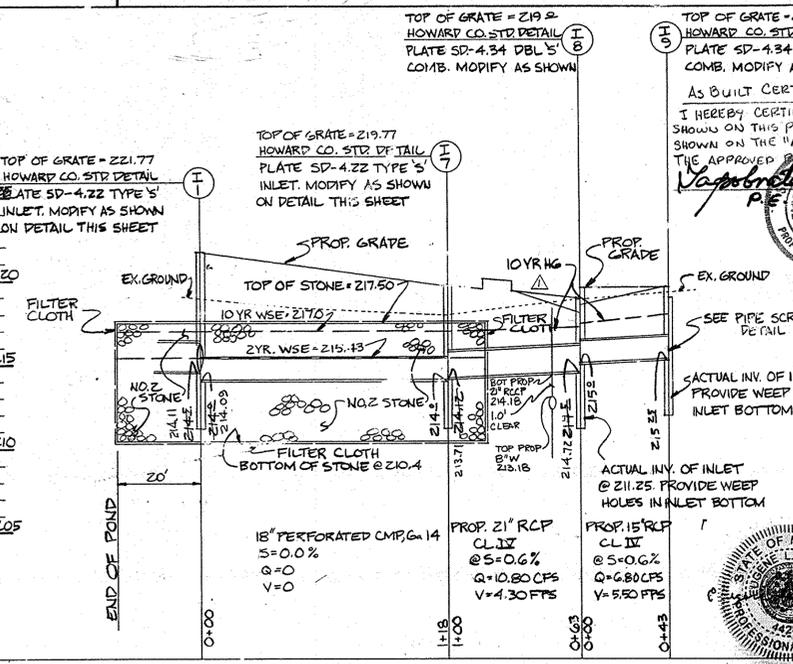

STORM DRAIN PROFILE AND PROFILE OF POND 'B-B'
UNDERGROUND STORMWATER MANAGEMENT
SCALE: HORIZ. 1\"/>

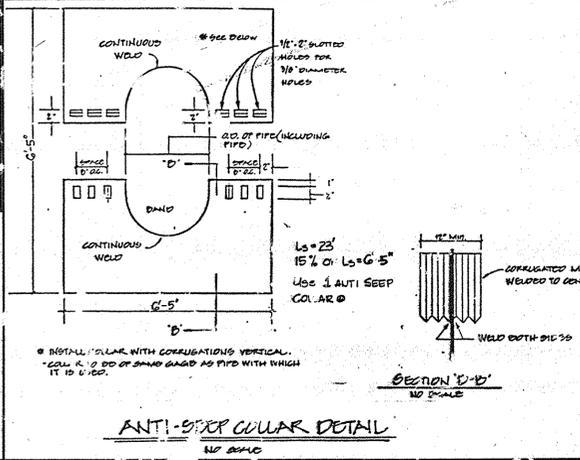

ANTI-SEEP COLLAR DETAIL
NO SCALE

APPROVED
DIVISION OF COMMUNITY PLANNING & LAND DEVELOPMENT
HOWARD COUNTY, MARYLAND
DATE: 8-15-89

THIS PLAN IS APPROVED FOR SOIL EROSION AND SEDIMENT CONTROL BY THE HOWARD SOIL CONSERVATION DISTRICT.

APPROVED: *[Signature]* DATE: 7-20-87
HOWARD SOIL CONSERVATION DISTRICT

REVIEWED FOR THE HOWARD SOIL CONSERVATION DISTRICT AND MEETS TECHNICAL REQUIREMENTS.

SIGNATURE: *[Signature]* DATE: 9/20/89
UNITED STATES SOIL CONSERVATION SERVICE

APPROVED FOR PUBLIC WATER AND PUBLIC SEWERAGE SYSTEMS
HOWARD COUNTY HEALTH DEPARTMENT.

[Signature] 9-27-89
COUNTY HEALTH OFFICER

APPROVED: HOWARD COUNTY DEPT. OF PLANNING & ZONING.

[Signature] 10.16.89
DIRECTOR

[Signature] 7/25/89
CHIEF DIVISION OF COMMUNITY PLANNING & LAND DEVELOPMENT

APPROVED FOR PUBLIC WATER AND PUBLIC SEWERAGE STORM DRAINAGE SYSTEMS AND PUBLIC ROADS HOWARD COUNTY DEPARTMENT OF PUBLIC WORKS.

[Signature] 9/25/89
DIRECTOR

[Signature] 9-25-89
CHIEF BUREAU OF ENGINEERING

GEORGE WILLIAM STEPHENS, JR. AND ASSOCIATES, INC.
CIVIL ENGINEERS & LAND SURVEYORS
303 ALLEGHENY AVENUE
TOWSON, MARYLAND 21204
(301)825-6120

ENGINEER'S CERTIFICATE:
I CERTIFY THAT THIS PLAN FOR S.W.M. FACILITY CONSTRUCTION, TROSON AND SEDIMENT CONTROL REPRESENT A PRACTICAL AND WORKABLE "AS-BUILT" ON MY PERSONAL KNOWLEDGE OF THE SITE CONDITIONS THIS PLAN WAS PREPARED IN ACCORDANCE WITH THE REQUIREMENTS OF THE SITE CONDITIONS THIS PLAN WAS PREPARED IN ACCORDANCE WITH THE REQUIREMENTS OF THE HOWARD SOIL CONSERVATION DISTRICT. I HAVE NOTIFIED THE DEVELOPER THAT HE MUST PROVIDE THE HOWARD SOIL CONSERVATION DISTRICT WITH A RED-LINED "AS-BUILT" OF THIS S.W.M. FACILITY WITHIN 30 DAYS OF COMPLETION.

ENGINEER: *[Signature]*
REG. NO. 8990 / APPROVED DATE: 6/15/89

OWNERS / DEVELOPERS
PARCEL A - ELK RIDGE NATIONAL BANK
7290 MONTGOMERY ROAD
ELK RIDGE, MD. 21227
301-795-1200

PARCEL B - I & M DEVELOPMENT CO. LIMITED PARTNERSHIP
ONE NORTH CHARLES STREET SUITE 1100
BALTIMORE, MD. 21201
301-722-5300

DESIGNED BY: C.I.B.
DRAWN BY: R.A.B.
CHECKED BY: R.A.B.


REVISIONS:
1. REVISED PROP. GRADE I-3
2. REVISED PROP. GRADE S-1-M

STORMWATER MANAGEMENT PROFILES AND DETAILS
- FOR -
ELK RIDGE CORNERS



TAX MAP 38
HOWARD CO., MD. WP-89-52
SCALE: AS SHOWN

FILE NO. S-89-08
WP-89-52
NP-89-109

PARCELS 826, 885, 799
ELECTION DISTRICT 1
DATE: 4/16/89
SHEET 6 OF 10

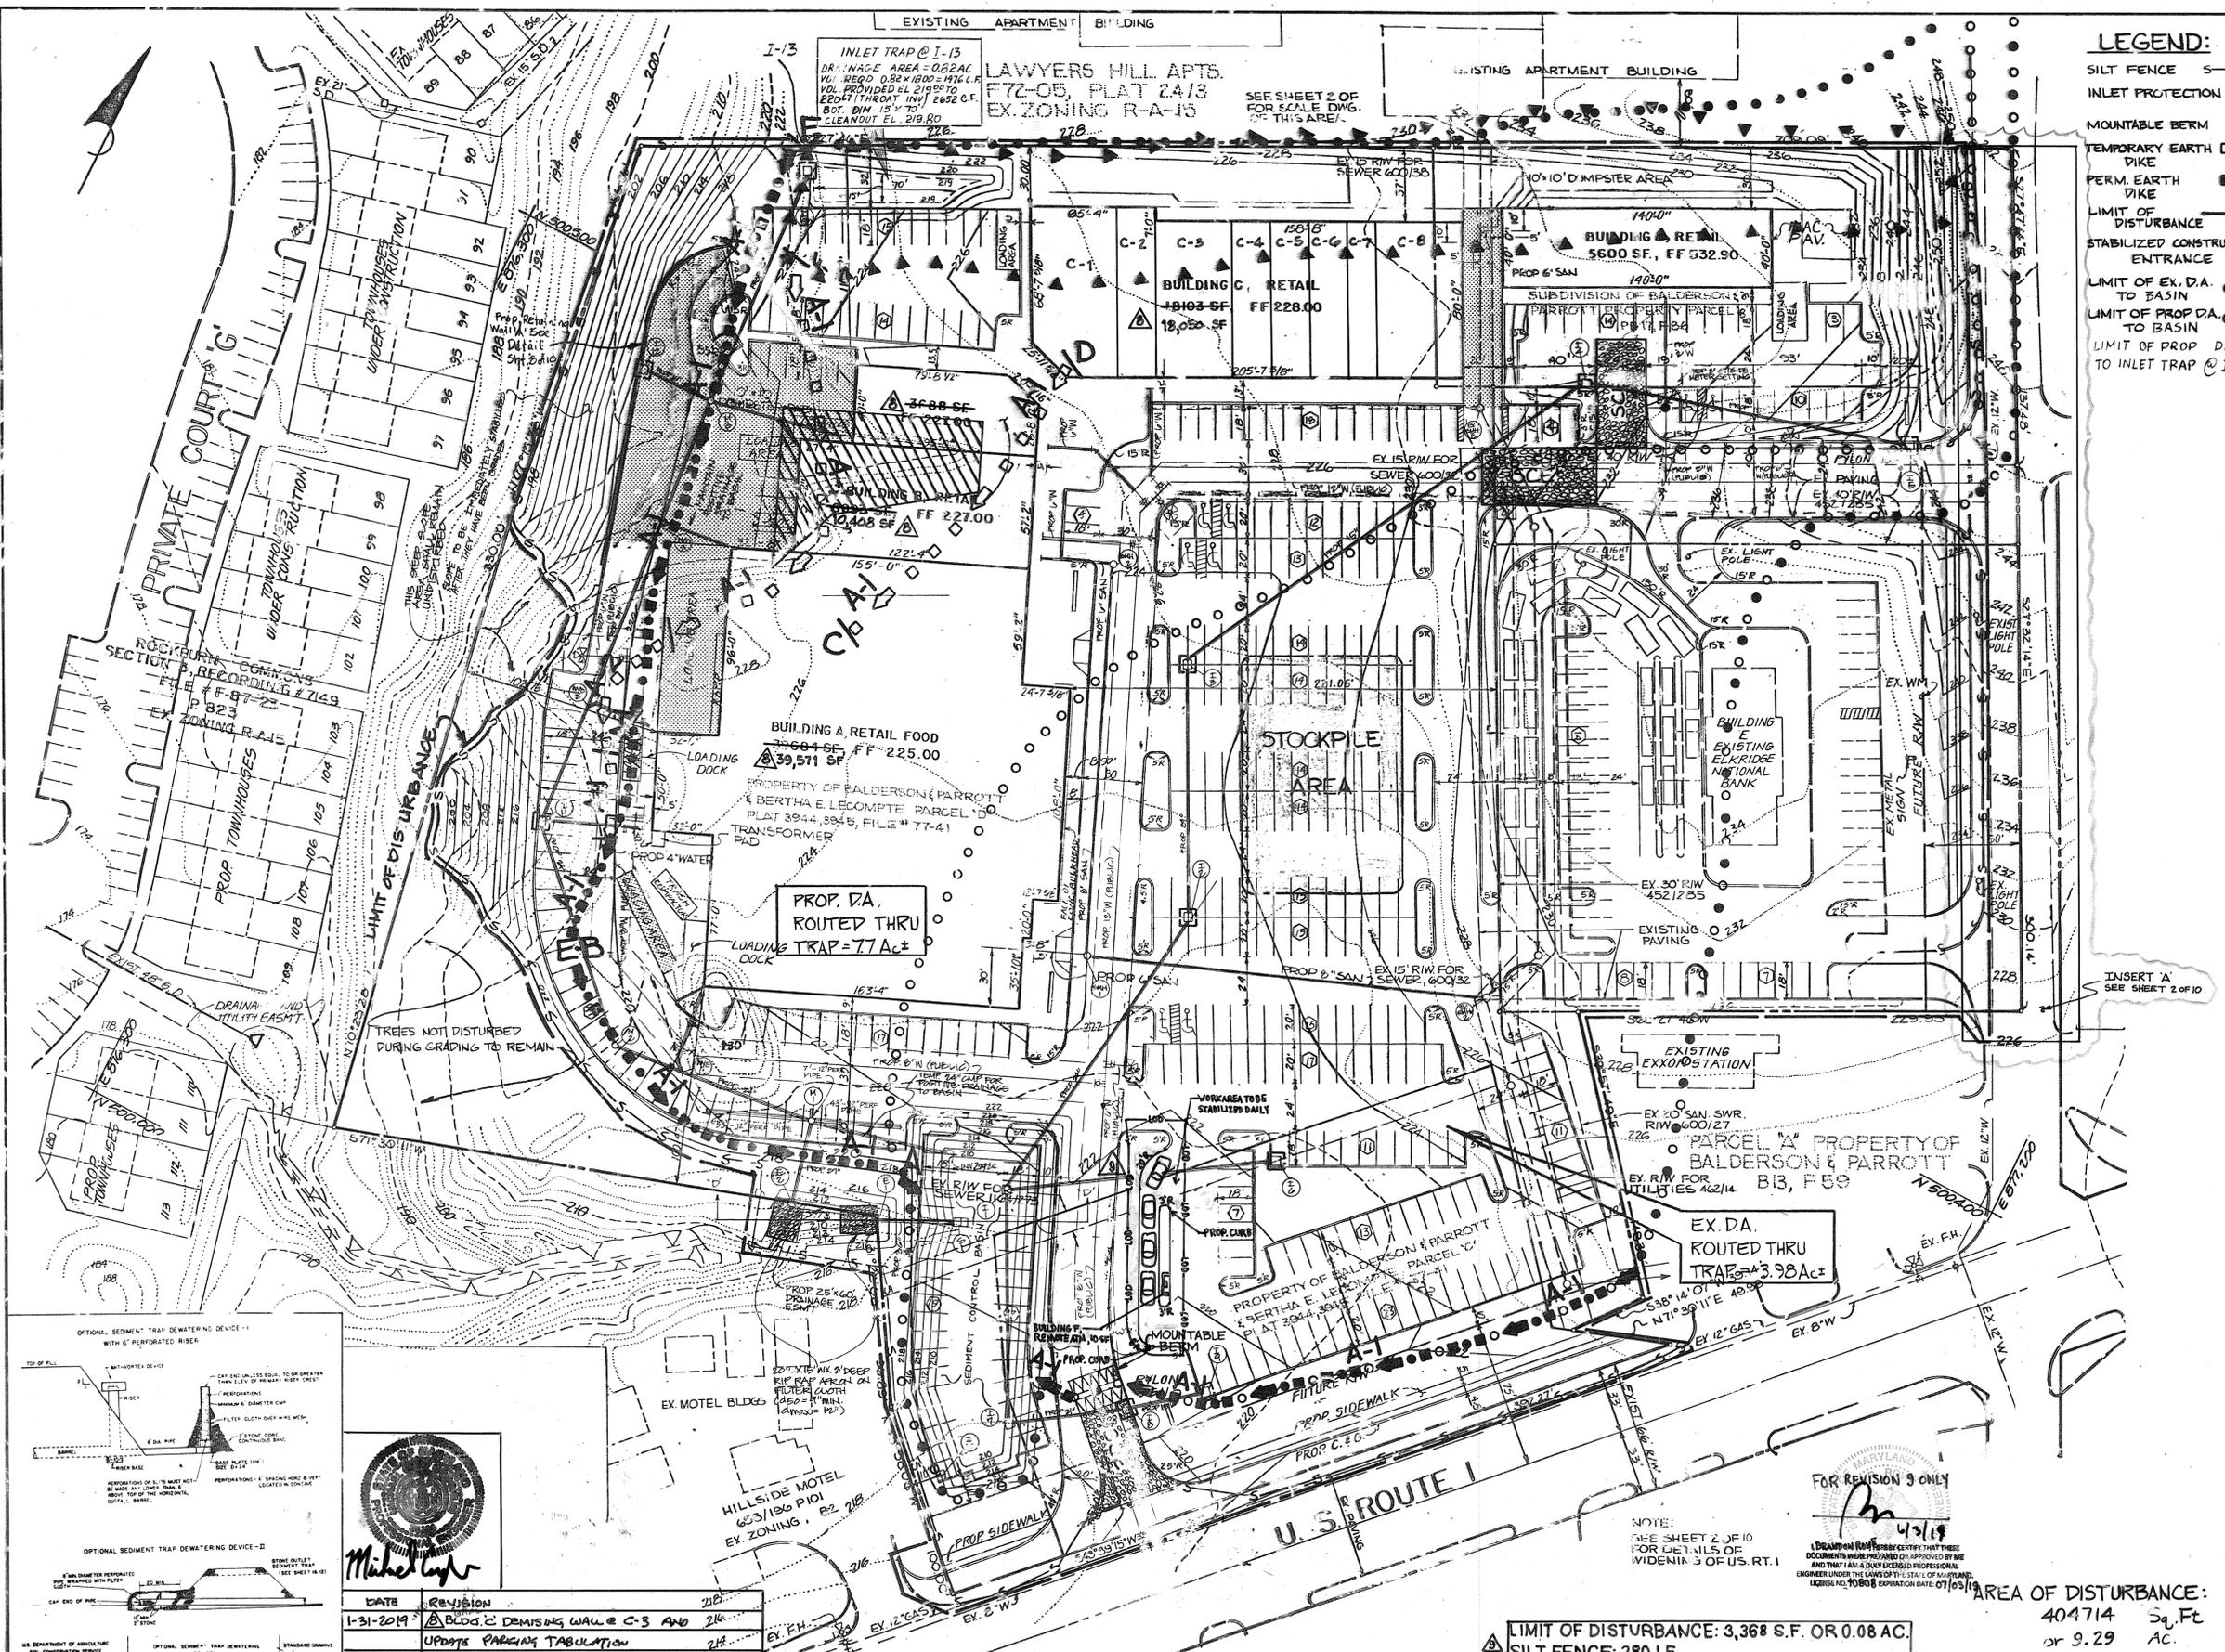

- LEGEND:**
- SILT FENCE
 - INLET PROTECTION
 - MOUNTABLE BERM
 - TEMPORARY EARTH DIKE
 - PERM. EARTH DIKE
 - LIMIT OF DISTURBANCE
 - STABILIZED CONSTRUCTION ENTRANCE
 - LIMIT OF EX. DA. TO BASIN
 - LIMIT OF PROP. DA. TO BASIN
 - LIMIT OF PROP. DA. TO INLET TRAP @ I-13

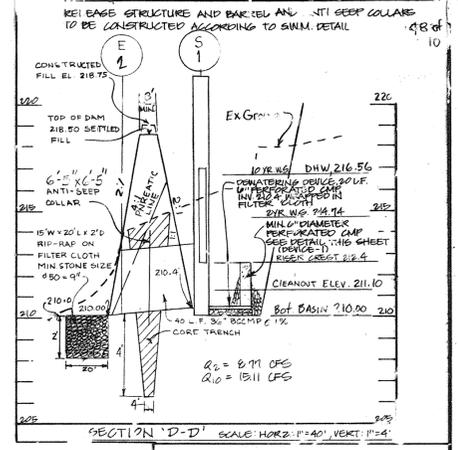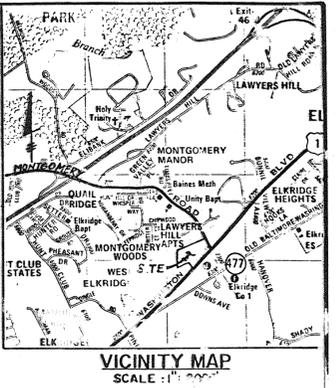

APPROVED
 DIVISION OF
 COMMUNITY PLANNING
 & LAND DEVELOPMENT
 HOWARD COUNTY,
 MARYLAND
 DATE **8-15-89**

THIS PLAN IS APPROVED FOR SOIL EROSION AND SEDIMENT CONTROL BY THE HOWARD SOIL CONSERVATION DISTRICT.

APPROVED: *[Signature]* DATE: 9-20-89
 HOWARD SOIL CONSERVATION DISTRICT

REVIEWED FOR THE HOWARD SOIL CONSERVATION DISTRICT AND MEETS TECHNICAL REQUIREMENTS.

SIGNATURE: *[Signature]* DATE: 9/20/89
 HOWARD SOIL CONSERVATION SERVICE

APPROVED FOR PUBLIC WATER AND PUBLIC SEWERAGE SYSTEMS
 HOWARD COUNTY HEALTH DEPARTMENT.

[Signature] 9-27-89
 COUNTY HEALTH OFFICER


APPROVED: HOWARD COUNTY DEPT. OF PLANNING & ZONING.
[Signature] 10.16.89
 DIRECTOR

[Signature] 9/20/89
 CHIEF DIVISION OF COMMUNITY PLANNING & LAND DEVELOPMENT

APPROVED FOR PUBLIC WATER AND PUBLIC SEWERAGE STORM DRAINAGE SYSTEMS AND PUBLIC ROADS HOWARD COUNTY DEPARTMENT OF PUBLIC WORKS.

[Signature] 9/26/89
 DIRECTOR

[Signature] 9-25-89
 CHIEF BUREAU OF ENGINEERING

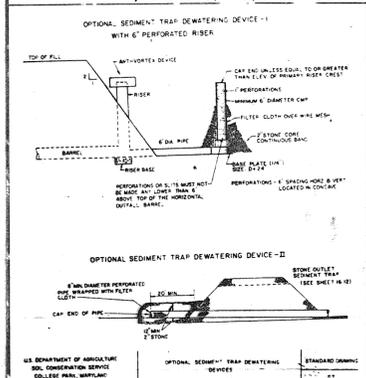

DATE	REVISION
1-31-2019	BLDG. & DEMISING WALL C-3 AND 216
	UPDATE PARKING TABULATION
4/2/19	ADD REMOTE ATM AND UPDATE PARKING TABULATION

ENGINEER'S CERTIFICATE:
 I CERTIFY THAT THIS PLAN FOR S.W.M. FACILITY CONSTRUCTION, EROSION AND SEDIMENT CONTROL, PRACTICAL AND WORKABLE PLAN BASED ON MY PERSONAL KNOWLEDGE OF THE SITE CONDITIONS THIS PLAN WAS PREPARED IN ACCORDANCE WITH THE REQUIREMENTS OF THE SITE CONDITIONS THIS PLAN WAS PREPARED IN ACCORDANCE WITH THE REQUIREMENTS OF THE HOWARD SOIL CONSERVATION DISTRICT. I HAVE NOTIFIED THE DEVELOPER THAT HE MUST PROVIDE THE HOWARD SOIL CONSERVATION DISTRICT WITH A RED-LINED "AS-BUILT" OF THE S.W.M. FACILITY WITHIN 30 DAYS OF COMPLETION.

ENGINEER: *[Signature]*
 REG. NO. 8730 TAPOBATA CHAKRABARTI DATE: 6/15/89

OWNERS / DEVELOPERS
 PARCEL A - ELKRIDGE NATIONAL BANK
 7290 MONTGOMERY ROAD
 ELKRIDGE MD. 21227

PARCEL B I & M DEVELOPMENT CO.
 801-796-1200
 05 NORTH CHARLES STREET SUITE 1100
 BALTIMORE, MD. 21201
 301-777-8500

DEVELOPER'S CERTIFICATE:
 I CERTIFY THAT ALL DEVELOPMENT AND/OR CONSTRUCTION WILL BE DONE ACCORDING TO THESE PLANS AND THAT AN ADEQUATE PERSONNEL INVOLVED IN THE CONSTRUCTION PROJECT WILL HAVE A CERTIFICATE OF ATTENTION AT ALL TIMES OF NATURAL RESOURCES APPROVED PROGRAM FOR THE CONTROL OF SEDIMENT AND EROSION BEFORE BEGINNING THE PROJECT. I ALSO AUTHORIZE THE HOWARD SOIL CONSERVATION DISTRICT TO TAKE ANY NECESSARY ACTION BY THE HOWARD SOIL CONSERVATION DISTRICT OR THE AUTHORIZED AGENTS AS ARE DEEMED NECESSARY. DEVIATION FROM THIS PLAN WILL NOT BE MADE UNLESS AUTHORIZED BY THE HOWARD SOIL CONSERVATION DISTRICT. I WILL PROVIDE THE HOWARD SOIL CONSERVATION DISTRICT WITH A RED-LINED "AS-BUILT" OF THE S.W.M. FACILITY WITHIN 30 DAYS OF COMPLETION.

PARCEL A-1 DEVELOPER: *[Signature]* DATE: 11/11/88
 PARCEL B-1 DEVELOPER: *[Signature]* DATE: 11/11/88

DESIGNED BY: CIB
 DRAWN BY: RGB
 CHECKED BY: DJP
 REVISIONS:
 1. 1/28/89 ADDED INSERT 'A'

EROSION AND SEDIMENT CONTROL
 -FOR-
ELKRIDGE CORNERS

TAX MAP 88 FILE NO. 5-89-08
 HOWARD CO., MD. WP-89-52
 SCALE: 1" = 40' WP-89-164

PARCELS 826, 885, 799
 ELECTION DISTRICT: 1
 DATE: 4/16/89
 SHEET 7 OF 10

GEORGE WILLIAM STEPHENS, JR. AND ASSOCIATES, INC.
 CIVIL ENGINEERS & LAND SURVEYORS
 303 ALLEGHENY AVENUE
 TOWSON, MARYLAND 21204
 (301)875-8120



CONSTRUCTION SPECIFICATIONS

Site Preparation

Areas under the embankment shall be cleared, grubbed, and stripped of topsoil to remove trees, vegetation, roots or other objectionable material. In order to facilitate cleanout and restoration, the pool area (measured at the top of the rim wall) shall be cleared of all brush, trees, and other objectionable materials.

Cut-off Trench

A cut-off trench shall be excavated along the centerline of each fill embankment. The minimum depth shall be two feet. The cut-off trench shall extend up both abutments to the river crest elevation. The minimum bottom width shall be four feet, but wide enough to permit operation of excavation and compaction equipment. The side slopes shall be no steeper than 1:1. Compaction requirements shall be the same as those for embankment. The trench shall be dewatered during the backfilling-compaction operations.

Embankment

The fill material shall be taken from approved areas shown on the plans. It shall be clean mineral soil free of roots, woody vegetation, oversized stones, roots, or other objectionable material. Temporary stabilization materials such as sand or gravel (Unified Soil Classes GW, GP, US & SP) shall not be placed in the embankment. Areas on which fill is to be placed shall be scarified prior to placement of fill. The fill material shall contain sufficient moisture so that it can be formed by hand into a ball without crumbling. If water can be squeezed out of the ball, it is too wet for proper compaction. Fill material shall be placed six-inch to eight-inch thick continuous layers over the entire length of the fill. Compaction shall be obtained by routing and hauling the construction equipment over the fill so that the entire surface of each layer of the fill is traversed by at least one wheel or tread track of the equipment or by the use of a compactor. The embankment shall be constructed to an elevation 10 percent higher than the design height to allow for settlement.

Pipe Spillways

The riser shall be securely attached to the barrel or braced stub by welding the full circumference making a watertight structural connection. The barrel stub must be attached to the riser at the same percent (angle) of least one wheel or tread track of the equipment or by the use of a compactor. All connections between barrel sections must be achieved by approved watertight gaskets. (See page 18-22 for details.) The barrel and riser shall be placed on a firm smooth foundation of impervious soil. Riser materials such as sand, gravel, or crushed stone shall not be used as backfill around the riser or against the riser. The fill material around the pipe spillway shall be placed in four inch layers and compacted under and around the pipe to at least the same density as the adjacent embankment.

A minimum depth of two feet of hand compacted backfill shall be placed over the pipe spillway before capping it with compacted earth. Base plates on risers shall have at least 2-1/2 feet of compacted earth, stone or gravel placed over it to prevent flotation.

Emergency Spillway

The emergency spillway shall be installed in undisturbed ground. The achievement of planned elevations, grades, design width, entrance and exit channel slopes are critical to the successful operation of the emergency spillway and must be constructed within a tolerance of ± 0.2 feet.

Vegetative Treatment

Stabilize the embankment and emergency spillway in accordance with the appropriate vegetative Standard and Specifications immediately following construction. In no case shall the embankment remain unstabilized for more than six months.

Erosion and Pollution Control

Construction operations shall be carried out in such a manner that erosion and soil pollution will be minimized. Great care and local laws shall be complied with concerning pollution abatement.

Safety

State and local requirements shall be met concerning fencing and signs, warning the public of hazards of soft accident and flooding and signs.

Maintenance





- Repair all damages caused by soil erosion and construction equipment at the end of each working day.
- Sediment shall be removed from the basin when it reaches the specified distance below the top of the riser. This sediment shall be placed in such a manner that it will not erode from the site. The sediment shall not be deposited downstream from the embankment, adjacent to a stream or flood plain.

Final Disposal

When temporary structures have served their intended purpose and the contributing drainage area has been properly stabilized, the embankment and resulting sediment deposits are to be leveled or otherwise disposed of in accordance with the approved sediment control plan. The proposed use of a sediment basin site is to be dictated by final disposition of the basin and any sediment contained therein. If the site is scheduled for future construction, then the sediment and trapped sediments must be removed, safely disposed of, and backfilled with a structural fill. When the basin area is to remain open space the pond may be pumped dry, graded and back filled.

SEDIMENT CONTROL NOTES

- A minimum of 24 hours notice must be given to the Howard County Office of Inspection and Permits prior to the start of any construction. (90-2037)
- All vegetative and structural practices are to be installed according to the provisions of this plan and are to be in conformance with the 1983 HANGLAND STANDARDS AND SPECIFICATIONS FOR SOIL EROSION AND SEDIMENT CONTROL.
- Following initial soil disturbance or redistribution, permanent or temporary stabilization shall be completed within: a) 7 calendar days for all perimeter sediment control structures, dikes, perimeter slopes and all slopes greater than 3:1; b) 14 days for all other disturbed or graded areas on the project site.
- All sediment traps/basins shown must be fenced and warning signs posted around their perimeter in accordance with Vol. 1, Chapter 12, of the HOWARD COUNTY DESIGN MANUAL, Storm Drainage.
- All disturbed areas must be stabilized within the time period specified above in accordance with the 1983 HANGLAND STANDARDS AND SPECIFICATIONS FOR SOIL EROSION AND SEDIMENT CONTROL for permanent seedings (Sec. 31) and (Sec. 32), temporary seedings (Sec. 30) and mulching (Sec. 32.) Temporary stabilization with mulch alone can only be done when recommended seeding dates do not allow for proper germination and establishment of grasses.
- All sediment control structures are to remain in place and are to be maintained in operative condition until permission for their removal has been obtained from the Howard County Sediment Control Inspector.
- Site Analysis:
 - Total Area of Site: 10.472 Acres
 - Area Disturbed: 1.212 Acres
 - Area to be roofed or paved: 0.762 Acres
 - Area to be vegetatively stabilized: 8.500 Acres
 - Total Cut: 10.472 Cu. Yds.
 - Total Fill: 10.472 Cu. Yds.
 - Offsite waste/borrow area: Location
- Any sediment control practice which is disturbed by grading activity for placement of utilities must be repaired on the same day of disturbance.
- Additional sediment controls must be provided, if deemed necessary by the Howard County Sediment Control Inspector.
- On all sites with disturbed areas in excess of 2 acres, approval of the inspection agency shall be requested upon completion of installation of permanent sediment controls, but before proceeding with any other earth disturbance or grading. Other building or grading inspection approvals may not be authorized until this initial approval by the inspection agency is made.

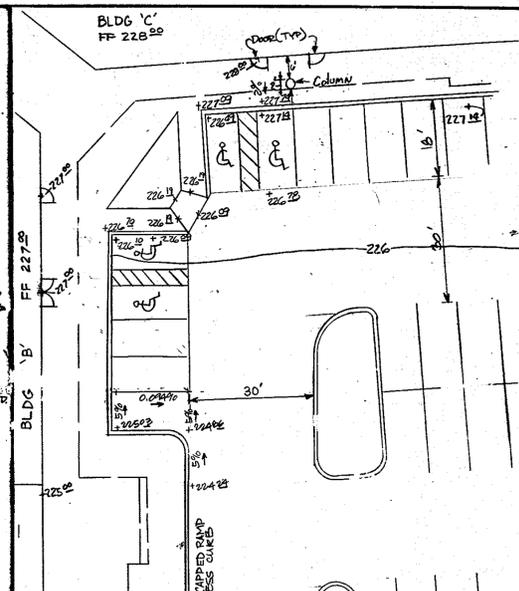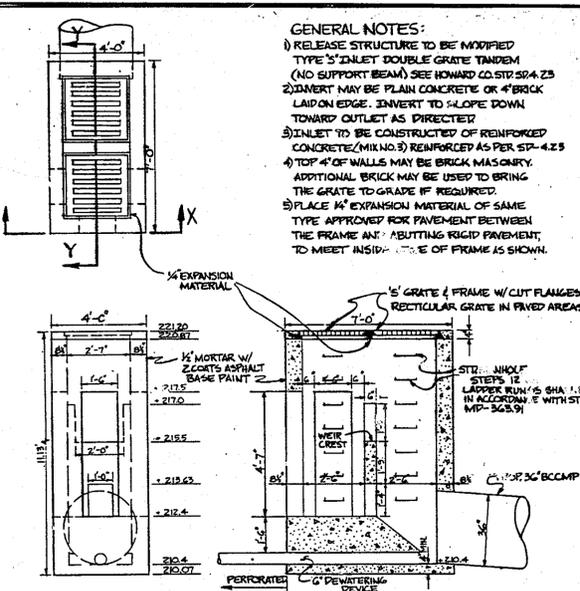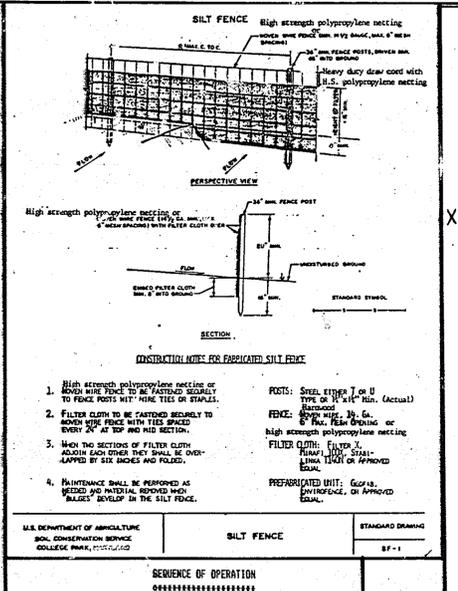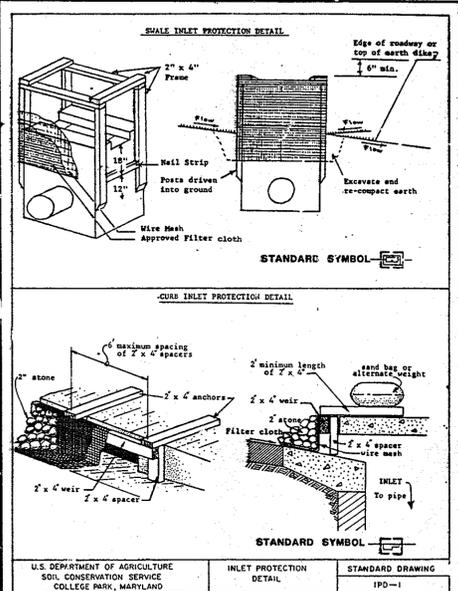

PERMANENT SEEDING NOTES

Apply to graded or cleared areas not subject to immediate further disturbance where permanent long-lived vegetative cover is needed.

Seedbed Preparation - Loosen upper three inches of soil by raking, disking or other acceptable means before seeding, if not previously loosened.

Soil Amendments - In lieu of soil test recommendations, use one of the following schedules:

- 1) Preferred - Apply 2 tons per acre dolomitic limestone (92 lb./1000 square ft) and 600 lb. per acre 10-10-10 fertilizer (14 lb./2000 sq ft) before seeding. Harrow or disk into upper three inches of soil. At time of seeding, apply 400 lb. per acre 10-0-10 ureaform fertilizer (9 lb./1000 sq. ft.).
- 2) Acceptable - Apply 2 tons per acre dolomitic limestone (92 lb./1000 sq ft) and 1000 lb. per acre 10-10-10 fertilizer (23 lb./2000 sq ft) before seeding. Harrow or disk into upper three inches of soil.

Seeding - For the period March 1 thru April 30, and August 1 thru October 15, seed with 60 lb. per acre (14 lb./2000 sq ft) of Kentucky 31 Tall Fescue. For the period May 1 thru July 31, seed with 60 lb. Kentucky 31 Tall Fescue per acre and 2 lb. per acre (.05 lb./2000 sq ft) of seeding lovage. During the period of October 1 thru February 28, project site by Option (1) 2 tons per acre of well mixed straw mulch and seed as soon as possible in the spring; Option (2) the seed; Option (3) Seed with 60 lb. Kentucky 31 Tall Fescue and mulch with 2 tons/acre well mixed straw.

Mulching - Apply 1-1/2 to 2 tons per acre (70 to 90 lb./2000 sq ft) of untreated small grain straw immediately after seeding. Anchor mulch immediately after application using mach mowing tool or 218 gallons per acre (9 gal/2000 sq ft) of emulsified asphalt on flat areas. On slopes 8 feet or higher use 348 gallons per acre (9 gal/2000 sq ft) for anchoring.

Maintenance - Inspect all seeded areas and make needed repairs, replacements and reseedings.

TEMPORARY SEEDING NOTES

Apply to graded or cleared areas likely to be restituted where a short-term vegetative cover is needed.


Seedbed Preparation - Loosen upper three inches of soil by raking, disking or other acceptable means before seeding, if not previously loosened.

Soil Amendments - Apply 60 lb. per acre 10-10-10 fertilizer (14 lb./2000 sq ft).

Seeding - For the period March 1 thru April 30 and August 1 thru October 15, seed with 2-1/2 times the rate of the permanent seeding. For the period May 1 thru July 31, seed with 3 lb. per acre of seeding lovage. (.07 lb./1000 sq ft). For the period November 1 thru February 28, project site by applying 2 tons per acre of well mixed straw mulch and seed as soon as possible in the spring, or the seed.

Mulching - Apply 1-1/2 to 2 tons per acre (70 to 90 lb./2000 sq ft) of untreated small grain straw immediately after seeding. Anchor mulch immediately after application using mach mowing tool or 218 gal per acre (9 gal/2000 sq ft) of emulsified asphalt on flat areas. On slopes 8 ft or higher use 348 gal per acre (9 gal/2000 sq ft) for anchoring.

Refer to the 1983 HANGLAND STANDARDS AND SPECIFICATIONS FOR SOIL EROSION AND SEDIMENT CONTROL for rate and methods not covered.

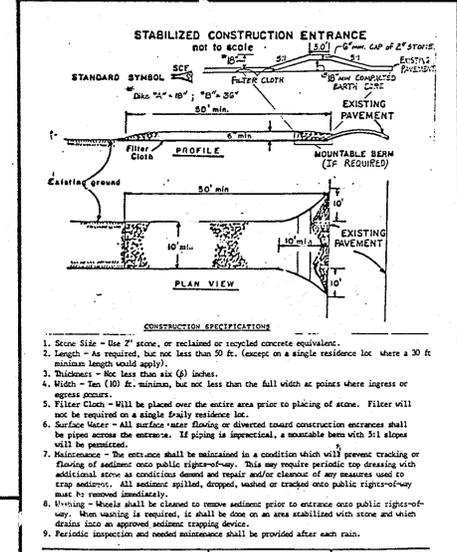

Construction Specifications

I. Materials

1. Wooden frame is to be constructed of 2" x 4" construction grade lumber.
2. Wire mesh must be of sufficient strength to support filter fabric and stone for curb inlets, with water fully impounded against it.
3. Filter cloth must be of a type approved for this purpose; resistant to sunlight with sieve size, 80S, 40-85, to allow sufficient passage of water and removal of sediment.
4. Stone to be 2" in size and clean, since fines would clog the cloth.

II. Procedure



1. Excavate completely around inlet to a depth of 18" below notch elevation.
2. Drive 2 x 4 post 1' into ground at four corners of inlet. Place nail strips between posts on ends of inlet. Assemble top members of 2 x 4 frame using overlap joint shown. Top of frame (weir) must be 6" below edge of roadway adjacent to inlet.
3. Stretch wire mesh tightly around frame and fasten securely. Ends must meet at post.
4. Stretch filter cloth tightly over wire mesh, the cloth must extend from top of frame to 18" below inlet notch level. Fasten securely to frame. Ends must meet at post, be overlapped and folded, then fastened down.
5. Backfill around inlet in compacted 6" layers until layer of earth is level with notch elevation on ends and top elevation on sides.
6. If the inlet is not in a low point, construct a compacted earth dike in the ditchline below it. The top of this dike is to be at least 6" higher than the top of frame (weir).
7. This structure must be inspected frequently and the filter fabric replaced when clogged.

B. Curb Inlet Protection.

1. Attach a continuous piece of wire mesh (30" min. width by throat length plus 4") to the 2" x 4" weir (measuring throat length plus 4") as shown on the standard drawing.
2. Place a piece of approved filter cloth (40-85 sieve) of the same dimensions as the wire mesh over the wire mesh and securely attach to the 2" x 4" weir.
3. Securely nail the 2" x 4" weir to 9" long vertical spacers to be located between the weir and inlet face (max. 6" apart).
4. Place the assembly against the inlet throat and nail (minimum 2" lengths of 2" x 4" to the top of the weir at spacer locations. These 2" x 4" anchors shall extend across the inlet top and be held in place by sandbags or alternate weight.
5. The assembly shall be placed so that the end spacers are a minimum 1" beyond both ends of the throat opening.
6. Form the wire mesh and filter cloth to the concrete gutter and against the face of curb on both sides of the inlet. Place clean 2" stone over the wire mesh and filter fabric in such a manner as to prevent water from entering the inlet under or around the filter cloth.
7. This type of protection must be inspected frequently and the filter cloth and stone replaced when clogged with sediment.
8. Assure that storm flow does not bypass inlet by installing temporary earth or asphalt dike directing flow into inlet.

SEQUENCE OF OPERATION


1. OBTAIN GRADING PERMIT
2. NOTIFY HOWARD COUNTY DEPARTMENT OF INSPECTIONS, PERMIT INSPECTOR 48 HOURS PRIOR TO BEGINNING ANY WORK.
3. CLEAR AND GRUB FOR SEDIMENT AND EROSION CONTROL MEASURES AND DEVICES ONLY.
4. INSTALL STABILIZED CONSTRUCTION ENTRANCE.
5. INSTALL THE SEDIMENT BASIN:
6. EXCAVATE SEDIMENT BASIN AREA ACCORDING TO APPROVED SEDIMENT & EROSION CONTROL PLAN.
7. INSTALL RISER, 36" OUTFALL PIPE WITH ANTI-SEEP COLLAR, METAL END SECTION, AND BATIONS.
8. INSTALL EARTH DIKES "4" TO "8", "10" TO "18", AND FILL THE AREA THAT IS CROSS HATCHED ON THE APPROVED SEDIMENT CONTROL PLANS. MAINTAIN POSITIVE DRAINAGE TO SEDIMENT BASIN AT ALL TIMES. WHEN ROADS ARE GRADED, PLACE MOUNTABLE BERMS WHERE SHOWN, AS TO DIRECT FLOW TO THE SEDIMENT TRAPPING DEVICES.
9. INSTALL FOUNDATIONS AND OTHER UTILITIES. PROTECT ALL INLETS WITH INLET PROTECTION DEVICES ON THIS SHEET. CONSTRUCT BUILDINGS, INSTALL INLET DRAINAGE TRAP AND 4" x 8" x 5" GREASE INTERCEPTOR.
10. FINE GRADE AND INSTALL CURB/OUTLET AND STONE BASE ON THE ROADS AND PARKING AREAS.
11. STABILIZE ALL DISTURBED AREAS OUTSIDE OF BUILDING AREAS WITH PERMANENT SEEDINGS.
12. WITH THE PERMISSION OF THE SEDIMENT CONTROL INSPECTOR REMOVE INLET PROTECTION IN THE ROADS AND THEIR PAVE ROADS.
13. WITH THE PERMISSION OF THE SEDIMENT CONTROL INSPECTOR, REMOVE ALL REMAINING SEDIMENT CONTROL MEASURES AND STABILIZE ANY DISTURBED AREAS WITH PERMANENT SEEDING. (SEE SPECIFICATIONS THIS SHEET)

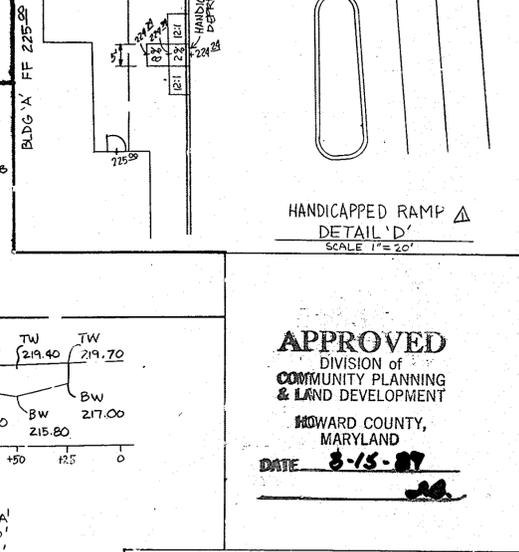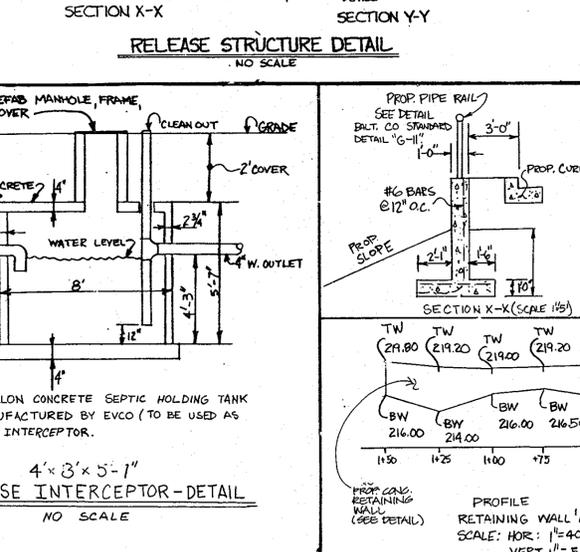

GEORGE WILLIAM STEPHENS, JR. AND ASSOCIATES, INC.

CIVIL ENGINEERS & LAND SURVEYORS



303 ALLEGHENY AVENUE
TOWSON, MARYLAND 21204
(301)825-8120

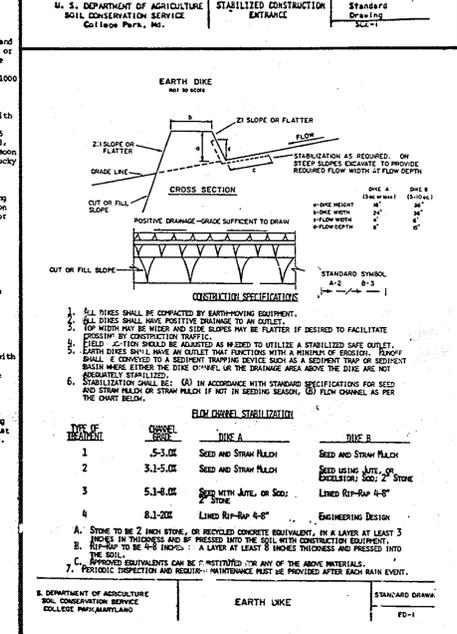

ENGINEER'S CERTIFICATE:

I CERTIFY THAT THIS PLAN FOR S.W.M. FACILITY CONSTRUCTION, EROSION AND SEDIMENT CONTROL REPRESENT A PRACTICAL AND WORKABLE PLAN BASED ON MY PERSONAL KNOWLEDGE OF THE SITE CONDITIONS. THIS PLAN WAS PREPARED IN ACCORDANCE WITH THE REQUIREMENTS OF THE SITE CONDITIONS. THIS PLAN WAS PREPARED IN ACCORDANCE WITH THE REQUIREMENTS OF THE HOWARD SOIL CONSERVATION DISTRICT. I HAVE NOTIFIED THE DEVELOPER THAT HE MUST PROVIDE THE HOWARD SOIL CONSERVATION DISTRICT WITH A RED-LINE "AS-BUILT" OF THE S.W.M. FACILITY WITHIN 30 DAYS OF COMPLETION.

ENGINEER: *George William Stephens, Jr.*
REG. NO. 12826 TAPSCOTT CHARLES W. DATE: 6/15/89

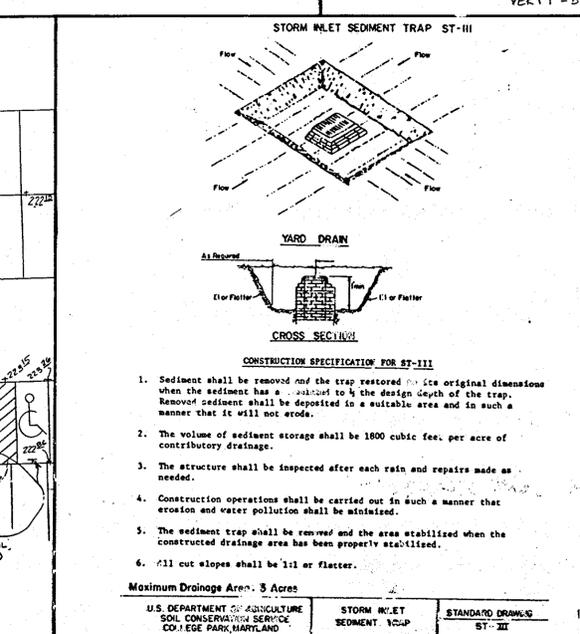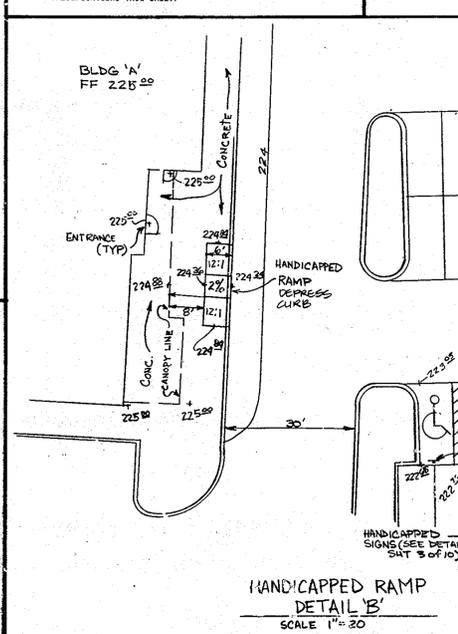

APPROVED

DIVISION OF COMMUNITY PLANNING & LAND DEVELOPMENT

HOWARD COUNTY, MARYLAND

DATE: 8-15-87

THIS PLAN IS APPROVED FOR SOIL EROSION AND SEDIMENT CONTROL BY THE HOWARD SOIL CONSERVATION DISTRICT.

APPROVED: *John R. ...* DATE: 9-20-87
HOWARD SOIL CONSERVATION DISTRICT

REVIEWED FOR THE HOWARD SOIL CONSERVATION DISTRICT AND MEETS TECHNICAL REQUIREMENTS.

SIGNATURE: *George William Stephens, Jr.* DATE: 6/15/89
REGISTERED PROFESSIONAL ENGINEER

APPROVED FOR PUBLIC WATER AND PUBLIC SEWERAGE SYSTEMS
HOWARD COUNTY HEALTH DEPARTMENT.

SIGNATURE: *John R. ...* DATE: 9-27-87
COUNTY HEALTH OFFICER

APPROVED: HOWARD COUNTY DEPT. OF PLANNING & ZONING.

SIGNATURE: *George William Stephens, Jr.* DATE: 6/15/89
DIRECTOR

SIGNATURE: *John R. ...* DATE: 9/28/87
CHIEF DIVISION OF COMMUNITY PLANNING & LAND DEVELOPMENT

APPROVED FOR PUBLIC WATER AND PUBLIC SEWERAGE STORM DRAINAGE SYSTEMS AND PUBLIC ROADS HOWARD COUNTY DEPARTMENT OF PUBLIC WORKS.

SIGNATURE: *John R. ...* DATE: 9/28/87
DIRECTOR

SIGNATURE: *John R. ...* DATE: 9-25-89
CHIEF BUREAU OF ENGINEERING

GEORGE WILLIAM STEPHENS, JR. AND ASSOCIATES, INC.

CIVIL ENGINEERS & LAND SURVEYORS

303 ALLEGHENY AVENUE
TOWSON, MARYLAND 21204
(301)825-8120

ENGINEER'S CERTIFICATE:

I CERTIFY THAT THIS PLAN FOR S.W.M. FACILITY CONSTRUCTION, EROSION AND SEDIMENT CONTROL REPRESENT A PRACTICAL AND WORKABLE PLAN BASED ON MY PERSONAL KNOWLEDGE OF THE SITE CONDITIONS. THIS PLAN WAS PREPARED IN ACCORDANCE WITH THE REQUIREMENTS OF THE SITE CONDITIONS. THIS PLAN WAS PREPARED IN ACCORDANCE WITH THE REQUIREMENTS OF THE HOWARD SOIL CONSERVATION DISTRICT. I HAVE NOTIFIED THE DEVELOPER THAT HE MUST PROVIDE THE HOWARD SOIL CONSERVATION DISTRICT WITH A RED-LINE "AS-BUILT" OF THE S.W.M. FACILITY WITHIN 30 DAYS OF COMPLETION.

ENGINEER: *George William Stephens, Jr.*
REG. NO. 12826 TAPSCOTT CHARLES W. DATE: 6/15/89

OWNERS / DEVELOPERS

PARCEL A - ELK RIDGE NATIONAL BANK

7290 MONTGOMERY ROAD
ELK RIDGE, MD. 21227

PARCEL B - I & M DEVELOPMENT CO. LIMITED PARTNERSHIP

100 CHARLES STREET SUITE 1100
BALTIMORE, MD. 21201

301-795-1200
301-727-8300

DEVELOPER'S CERTIFICATE

I CERTIFY THAT ALL NECESSARY CONSTRUCTION WILL BE DONE IN ACCORDANCE WITH THE REQUIREMENTS OF THE HOWARD SOIL CONSERVATION DISTRICT. I HAVE NOTIFIED THE HOWARD SOIL CONSERVATION DISTRICT WITH A RED-LINE "AS-BUILT" OF THE S.W.M. FACILITY WITHIN 30 DAYS OF COMPLETION.

DEVELOPER: *George William Stephens, Jr.*
DATE: 6/15/89

DESIGNED BY: CIB

CHECKED BY: RGB

DRAWN BY: DJP

REVISIONS:

1. REVISION: HANDED RAMP, DETAIL 'D' 7/1/80

TAX MAP 38

FILE NO. S-89-08

PARCELS 826, 885, 799

HOWARD CO., MD. WP-89-52

ELECTION DISTRICT 1

SCALE: 1"=40'

DATE: 4/18/89

SHEET 8 OF 10

EROSION AND SEDIMENT CONTROL DETAILS

-FOR-

ELK RIDGE CORNERS

TAX MAP 38

FILE NO. S-89-08

PARCELS 826, 885, 799

HOWARD CO., MD. WP-89-52


ELECTION DISTRICT 1

SCALE: 1"=40'

DATE: 4/18/89

SHEET 8 OF 10

SDP 87-205

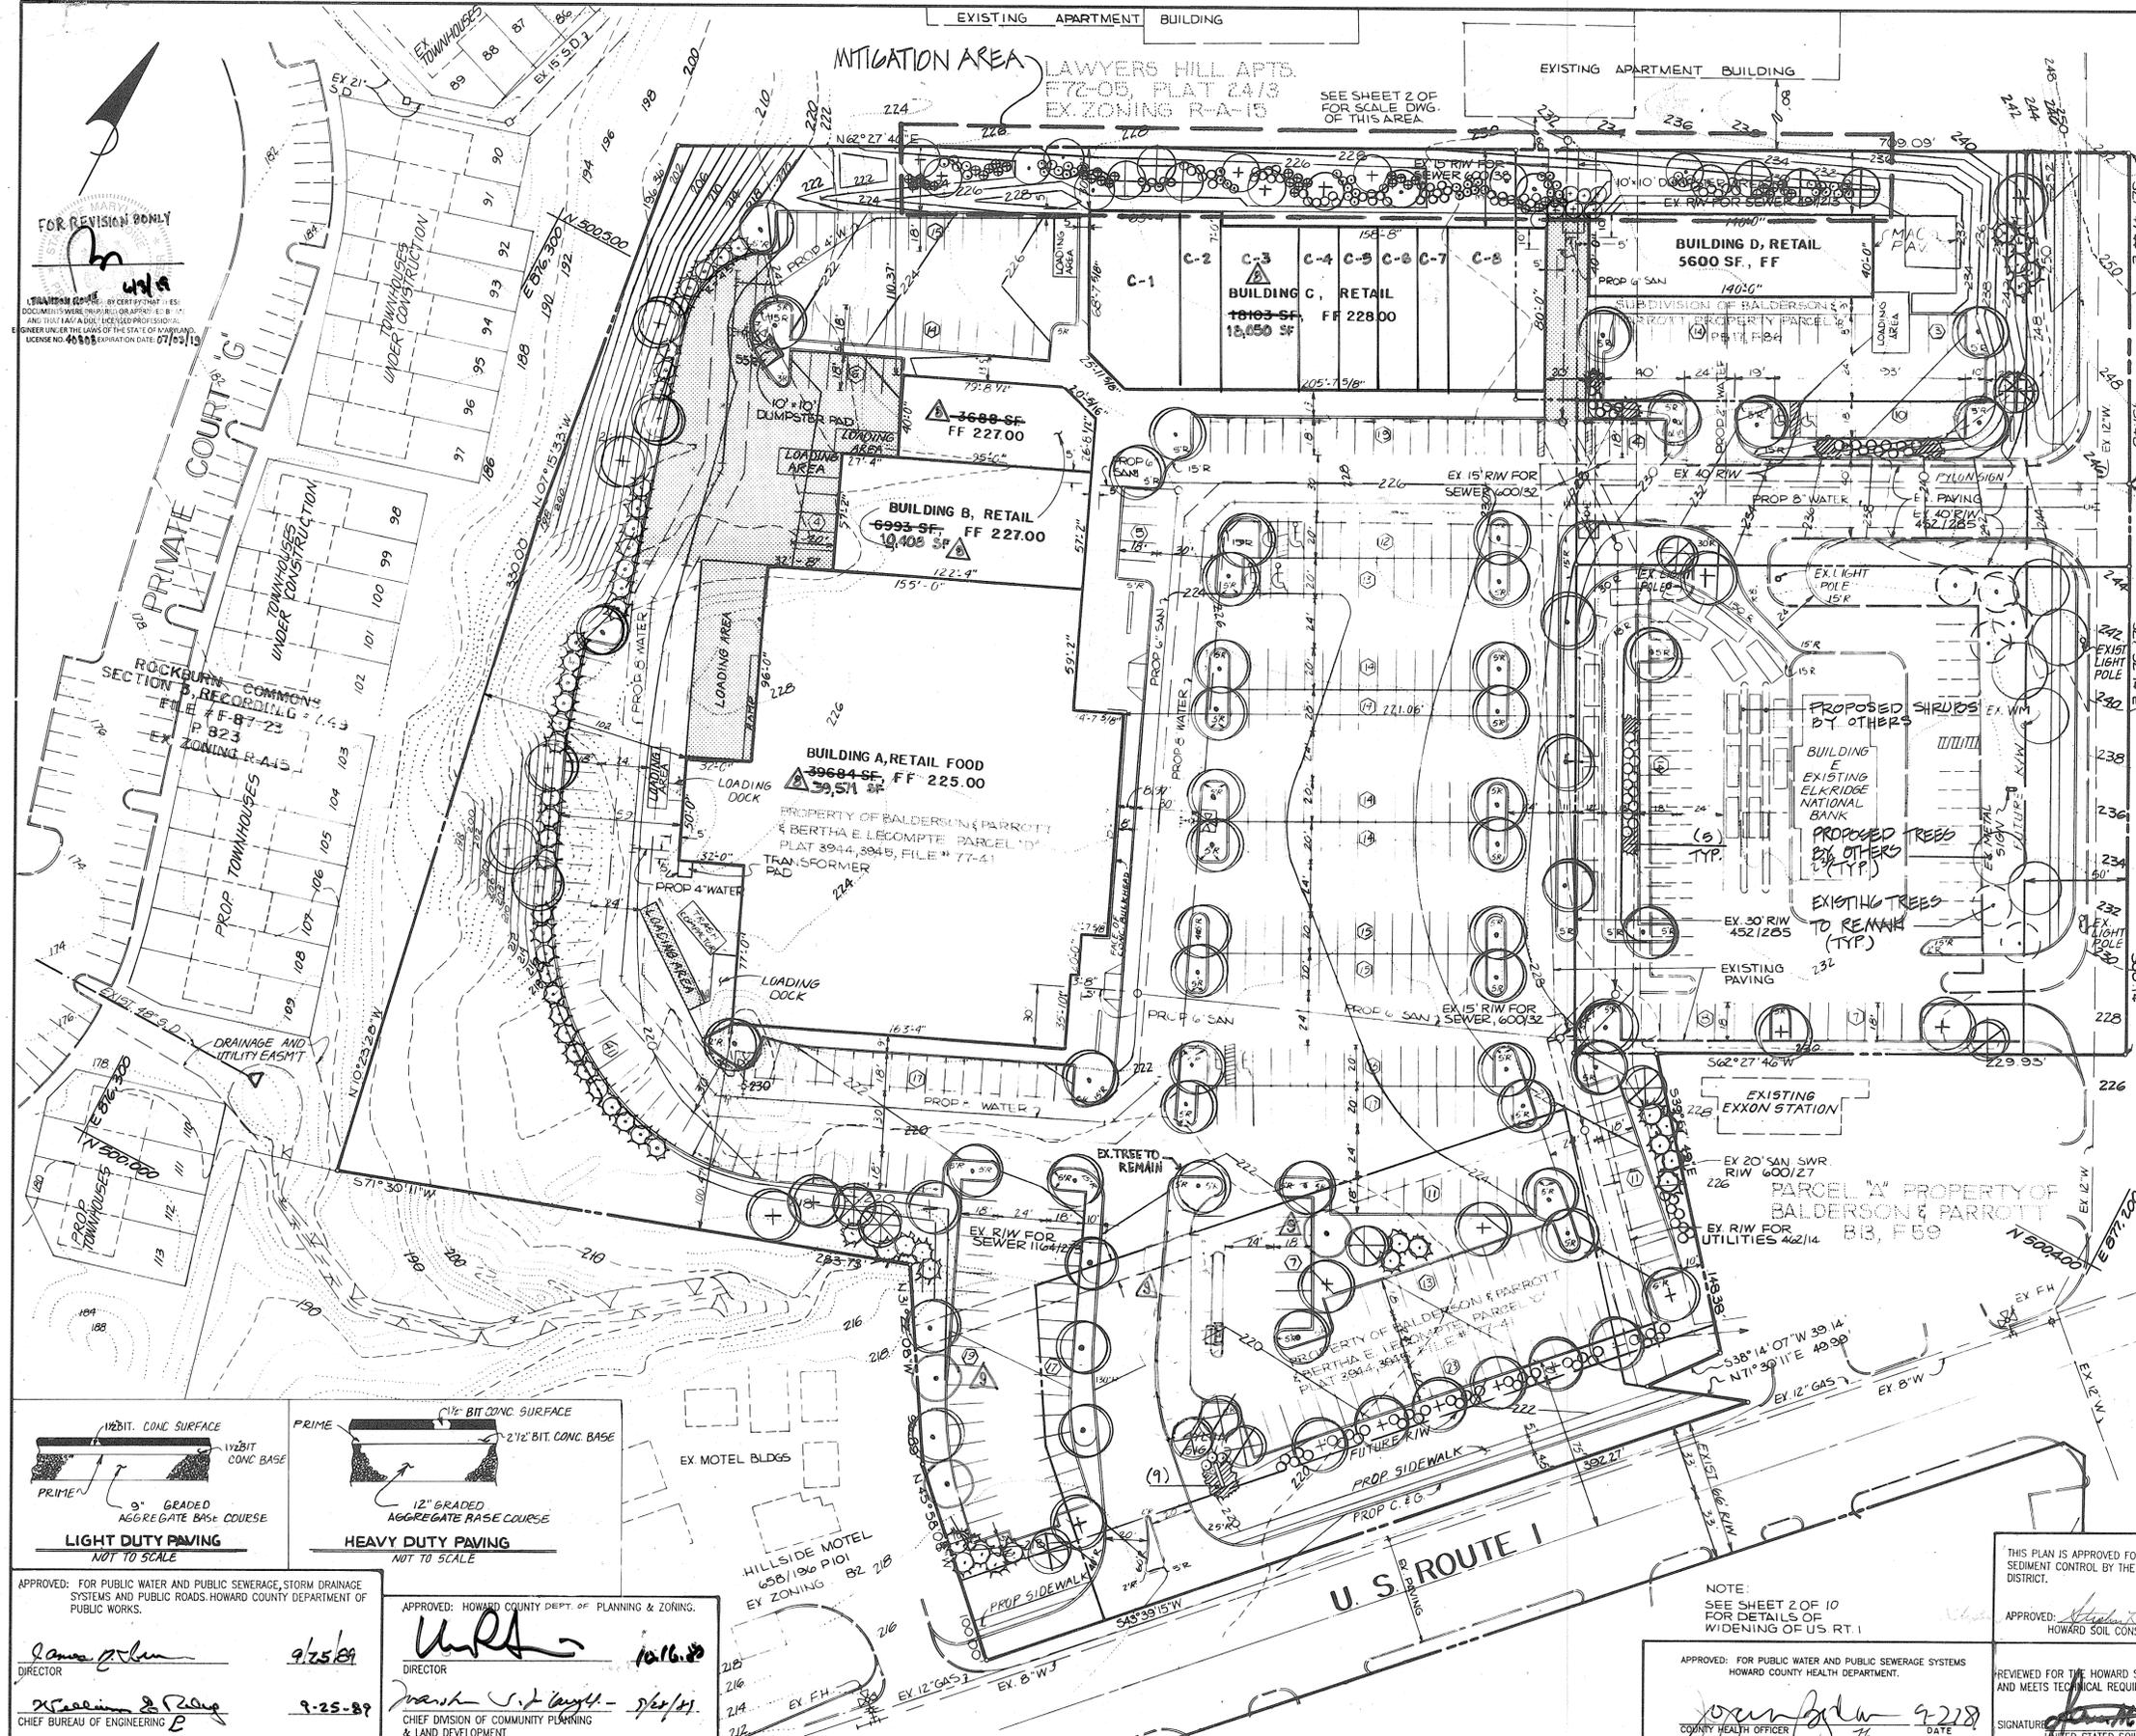

SITE DATA

TOTAL AREA OF SITE: []
 AREA OF HIGHWAY WIDENING: []
 NET AREA OF SITE: []
 EXISTING USE: []
 PROPOSED USE: []
 TOTAL FLOOR AREA: []
 FLOOR AREA RATIO (BLDG. COVERAGE W/O PAVING): []
 BUILDING COVERAGE WITH PAVING: []

AREA OF PARKING LOT: []
 AREA OF LANDSCAPED ISLANDS WITHIN PARKING LOT: []
 PERCENTAGE OF LANDSCAPING WITHIN PARKING LOT: []
 PERCENTAGE OF OPEN SPACE: []
 AREA TO BE DISTURBED: []
 AREA TO BE VEGETATIVELY STABILIZED: []
 EXISTING ZONING: B-2
 PROPERTY REFERENCE: []

VICINITY MAP
 SCALE: 1"=2000'

- GENERAL NOTES**
- MAXIMUM BUILDING HEIGHT
 - ALL AREAS NOT PAVED OR RECEIVING BUILDING COVERAGE SHALL BE STABILIZED IN ACCORDANCE WITH THE PLANS APPROVED BY THE HOWARD SOIL CONSERVATION DISTRICT.
 - ANY DAMAGE TO PUBLIC RIGHTS-OF-WAY AND/OR ADJACENT PROPERTIES SHALL BE REPAIRED IMMEDIATELY AT THE CONTRACTOR'S EXPENSE.
 - THE CONTRACTOR SHALL MAINTAIN AT LEAST A 2' LEVEL BENCH BEHIND ALL CURBS AND GUTTER IN FILL AREAS.
 - THE CONTRACTOR SHALL VERIFY ALL EXISTING UTILITIES TO HIS OWN SATISFACTION BEFORE STARTING CONSTRUCTION.
 - ALL SLOPES SHALL BE 2:1 OR FLATTER.
 - ALL WORK SHALL BE DONE IN ACCORDANCE WITH HOWARD COUNTY STANDARD SPECIFICATIONS AND DETAILS FOR CONSTRUCTION, OR AS SHOWN ON THESE PLANS.
 - THE CONTRACTOR SHALL NOTIFY THE CIP TELEPHONE CO AND THE GAS AND ELECTRIC COMPANY FIVE DAYS PRIOR TO STARTING WORK SHOWN ON THESE PLANS BY CALLING "MISS UTILITY" CALL COLLECT 1-559-0100.
 - FOR DETAILS OF RAMPS AND SIGNS FOR THE HANDICAPPED SEE THE MARYLAND BUILDING CODE FOR THE HANDICAPPED AND AGED AND DETAILS AS SHOWN HEREON.
 - THE CONTRACTOR SHALL MAINTAIN A MINIMUM OF 3' COVER OVER ALL PROPOSED WATER LINES.
 - THE CONTRACTOR OR DEVELOPER SHALL CONTACT THE CONSTRUCTION INSPECTION SURVEY DIVISION 24 HOURS IN ADVANCE OF COMMENCEMENT OF WORK AT 782-2630.
 - THE CONTRACTOR SHALL REMOVE ALL EXISTING PAVING, CURBS AND GUTTER, ETC. THAT MAY INTERFERE WITH PROPOSED CONSTRUCTION.
 - ALL UTILITIES INSTALLED SHALL RECEIVE FULL TRENCH COMPACTION.
 - ALL WATER MAIN TEES, BENDS, CAPS, ETC. SHALL BE BUTTRESSED IN ACCORDANCE WITH HOWARD COUNTY DESIGN REGULATIONS.
 - THE OWNER SHALL PROVIDE A SEPARATE AND INDEPENDENT SEWER CONNECTION FOR EACH TENANT OR OCCUPANT OF ANY BUILDING SHOWN ON THIS SITE DEVELOPMENT PLAN, WHO WILL DISCHARGE NON-DOMESTIC WASTE TO THE PUBLIC SEWER SYSTEM IF THIS WASTE IS REGULATED UNDER SECTION 18.122 OF THE HOWARD COUNTY CODE. EACH SEPARATE AND INDEPENDENT SEWER CONNECTION SHALL INCLUDE A STANDARD MANHOLE AND OTHER WASTE PRETREATMENT DEVICES AS REQUIRED AND APPROVED BY HOWARD COUNTY. WASTE LINES OF THE INTERIOR OF THE BUILDING SHALL BE DESIGNED, CONSTRUCTED OR MODIFIED SUCH THAT NON-DOMESTIC WASTE WILL BE DISCHARGED TO THE SEPARATE AND INDEPENDENT SEWER CONNECTION. NO TENANT OR OCCUPANT OF ANY BUILDING SHOWN ON THIS SITE DEVELOPMENT PLAN SHALL DISCHARGE REGULATED NON-DOMESTIC WASTE TO THE PUBLIC SEWER SYSTEM PRIOR TO THE INSTALLATION OF THE SEPARATE AND INDEPENDENT SEWER CONNECTION AND RELATED INTERIOR WASTE LINES.
 - THE ABOVE REQUIREMENTS SHALL APPLY TO ALL INITIAL AND FUTURE OCCUPANTS OR TENANTS.

PARKING TABULATION

PARKING REQUIRED:	
PARCEL A:	
EXIST. BANK AREA AVAILABLE TO PUBLIC:	2215 S.F. @ 1 SPC/100 S.F. = 22 SPC
REMAINDER OF EXIST. BANK AREA:	22 EMPLOYEES @ 0.7 SPC/EMR = 16 SPC
PARCEL B:	
RETAIL FOOD: (AREA AVAILABLE TO PUBLIC)	14029 S.F. @ 1 SPC/150 S.F. = 200 SPC
RETAIL FOOD: (AREA NOT AVAILABLE TO PUBLIC)	9755 S.F. @ 1 SPC/150 S.F. = 20 SPC
RETAIL:	34984 S.F. @ 1 SPC/120 S.F. = 175 SPC
TOTAL PARKING REQUIRED:	423 SPC
PARKING PROVIDED:	423 SPC (INCL. 0 H.L. SPC)


LEGEND

- TRACT OUTLINE
- R/W LINE
- EASEMENTS
- MINIMUM BUILDING RESTRICTION LINE
- EXISTING GROUND
- PROPOSED GRADE
- NUMBER PARKING SPACES
- HANDICAPPED PARKING
- LIGHT DUTY PAVING
- HEAVY DUTY PAVING
- CONCRETE PAVING
- M.S.H.A. TYPICAL PAVING
- HANDICAPPED DETAIL NO.

APPROVED
 DIVISION OF COMMUNITY PLANNING & LAND DEVELOPMENT
 HOWARD COUNTY, MARYLAND
 DATE: 8-15-89
 J.B.

FOR REVISION ONLY

PROFESSIONAL ENGINEER LICENSE NO. 46808 EXPIRATION DATE 07/31/13

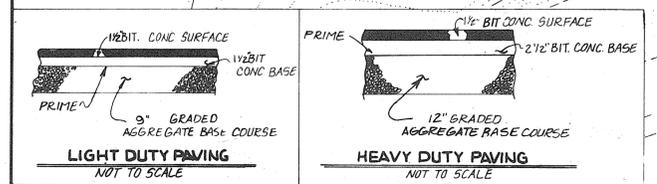

APPROVED: FOR PUBLIC WATER AND PUBLIC SEWERAGE, STORM DRAINAGE SYSTEMS AND PUBLIC ROADS. HOWARD COUNTY DEPARTMENT OF PUBLIC WORKS.

APPROVED: HOWARD COUNTY DEPT. OF PLANNING & ZONING.

Director: [Signature] 9/25/89

Chief Division of Community Planning & Land Development: [Signature] 9/25/89

DATE	REVISION
1-31-2019	BLDG. 'C' DEMISING WALL AND PARKING
5/22/19	TABULATION UPDATE
	ADD REMOTE ATM AND ADJUSTED TREE LOCATIONS

OWNERS / DEVELOPERS

PARCEL A: ELKRIDGE NATIONAL BANK
 7290 MONTGOMERY ROAD
 ELKRIDGE, MD 21227

PARCEL B: I & M DEVELOPMENT CO. LIMITED PARTNERSHIP
 301-795-1200
 ONE NORTH CHARLES STREET SUITE 1100
 BALTIMORE, MD 21201
 301-727-8300

DEVELOPER'S CERTIFICATE

I CERTIFY THAT ALL DEVELOPMENT AND/OR CONSTRUCTION WILL BE DONE ACCORDING TO THESE PLANS AND THAT ANY RESPONSIBLE PERSONNEL INVOLVED IN THE CONSTRUCTION PROJECT WILL HAVE A CERTIFICATE OF ATTENDANCE AT A DEPT. OF NATURAL RESOURCES APPROVED PROGRAM FOR THE CONTROL OF SEDIMENT AND EROSION BEFORE BEGINNING THE PROJECT. I ALSO AUTHORIZE PERIODIC ON-SITE INSPECTION BY THE HOWARD SOIL CONSERVATION DISTRICT OR THEIR AUTHORIZED AGENTS AS ARE DEEMED NECESSARY. DEVIATION FROM THIS PLAN WILL NOT BE MADE UNLESS AUTHORIZED BY THE HOWARD SOIL CONSERVATION DISTRICT. I WILL PROVIDE THE HOWARD SOIL CONSERVATION DISTRICT WITH A RED-LINE "AS-BUILT" OF THE S.W.M. FACILITY WITHIN 30 DAYS OF COMPLETION.

DEVELOPER: [Signature] DATE: 9/22/89

PLANTING PLAN
ELKRIDGE CORNERS

TAX MAP 38
 HOWARD CO. MD.
 SCALE: 1"=40'

FILE No. S-89-08
 WP-89-52
 WP 9A-10A

PARCELS 826, 885, 799
 ELECTION DISTRICT 1
 DATE: 4/18/89
 SHEET 9 OF 10

SDP 89-205

