



DRAINAGE AREA MAP Existing Conditions  
SCALE: 1" = 200'

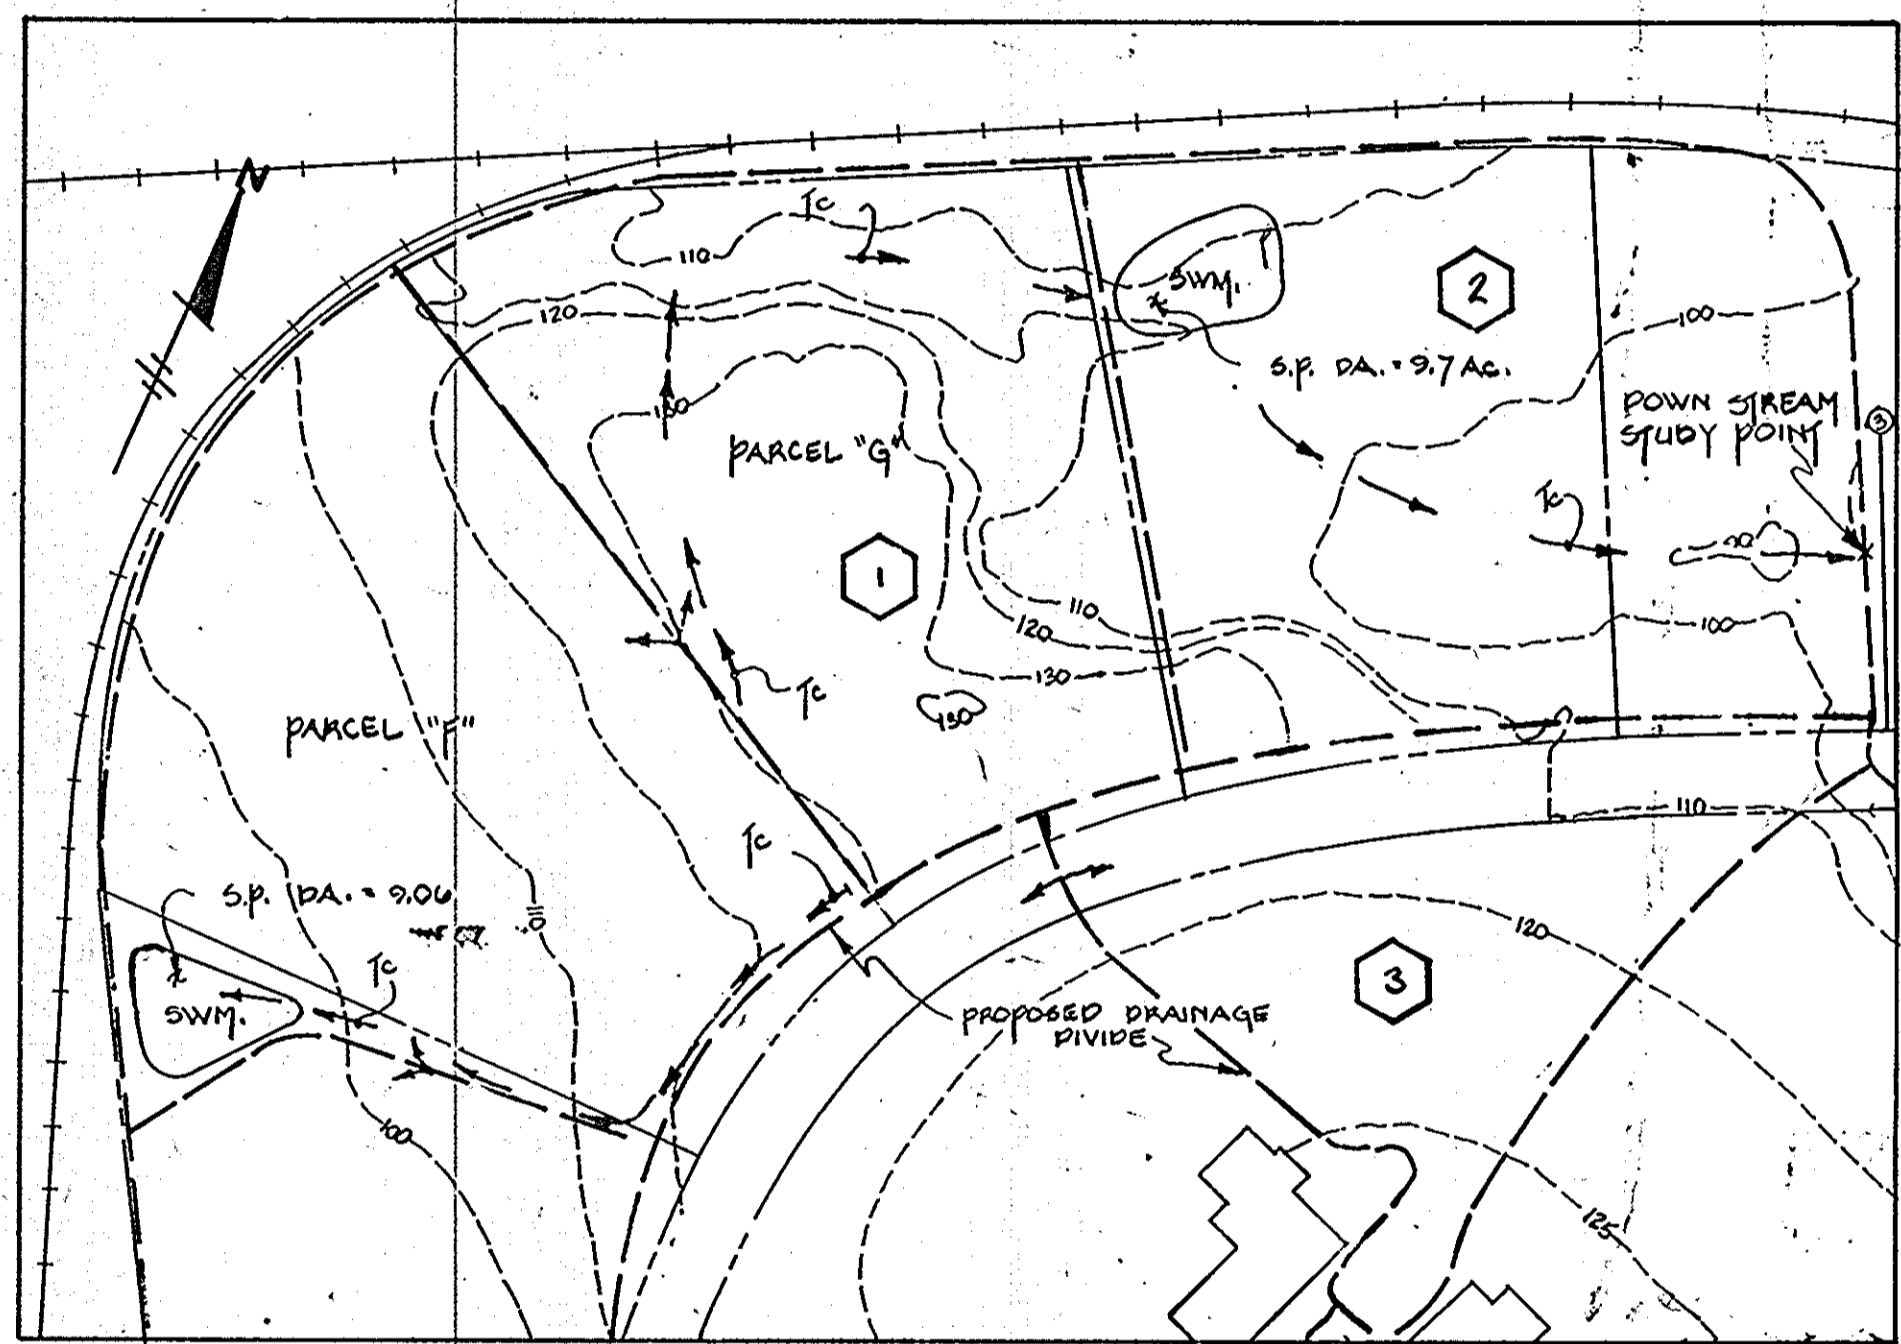

DRAINAGE AREA MAP Proposed Conditions  
SCALE: 1" = 200'


SITE ANALYSIS  
 AREA OF PARCELS - 17.662  
 PRESENT ZONING - M-2  
 FLOOR SPACE - 0  
 PARKING REQUIRED - 0  
 PARKING PROVIDED - 0  
 OPEN SPACE - N/A  
 BUILDING COVERAGE - 0

ADDRESS CHART	
LOT NUMBER	STREET ADDRESS
E	6755 PARK CIRCLE DRIVE
F	6755 A BLDG. PARK CIRCLE DRIVE 6765 B BLDG. PARK CIRCLE DRIVE
G	6705 PARK CIRCLE DRIVE

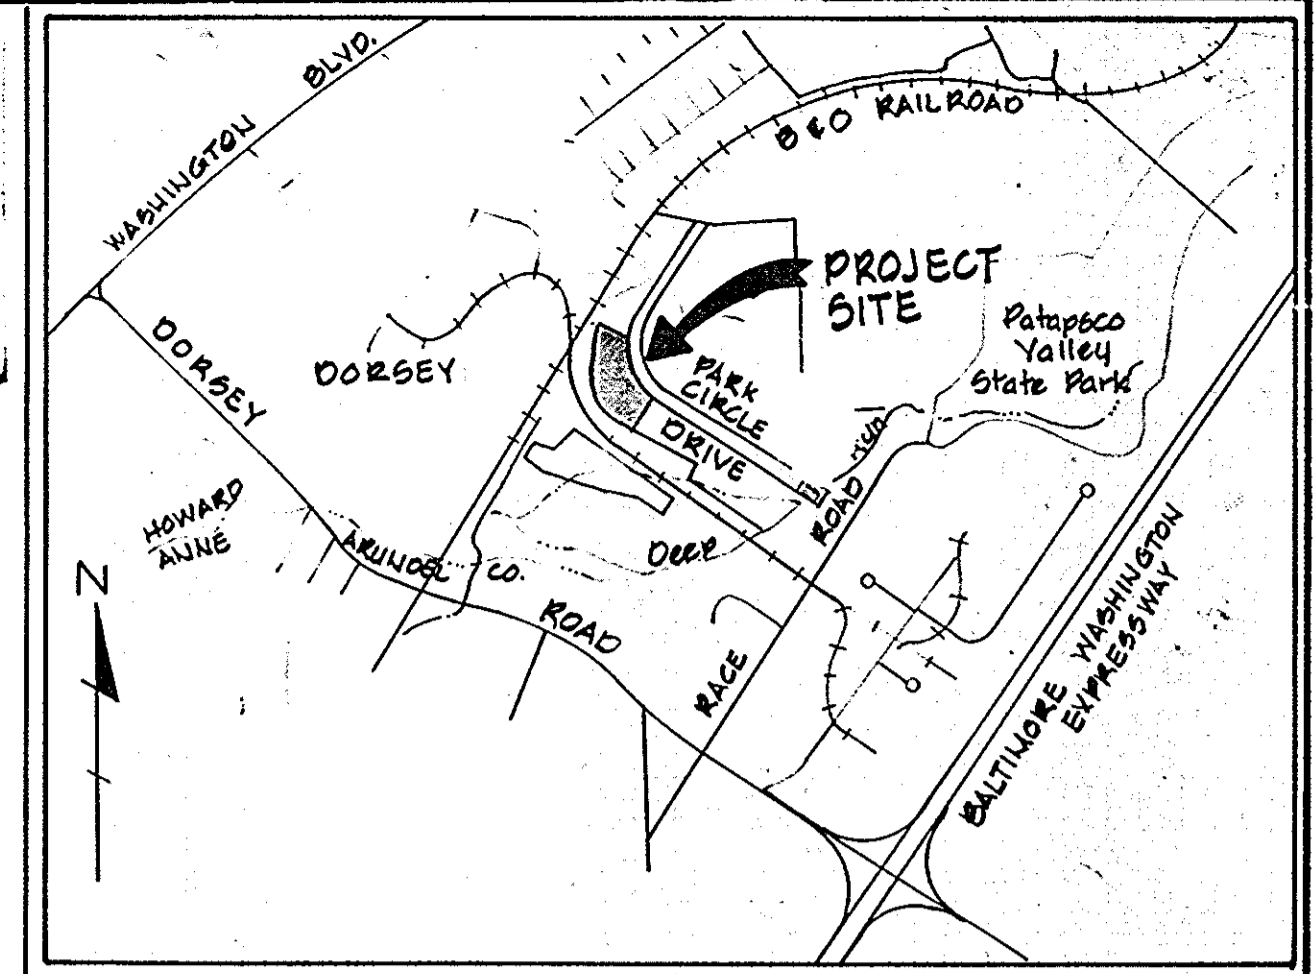

VICINITY MAP  
SCALE: 1" = 2000'

NOTE: THIS PLAN SUBJECT TO WAIVER FROM SECTION 14.116.2.4 AND 14.116.2.6 APPROVED DECEMBER 23, 1982 (WP-00-58) TO ALLOW GRADING AND CLEARING ON SLOPES 25% AND GREATER ADJACENT TO WETLANDS AND ELIMINATION OF 0.31 ACRES OF WETLAND ON PARCEL 'G'.

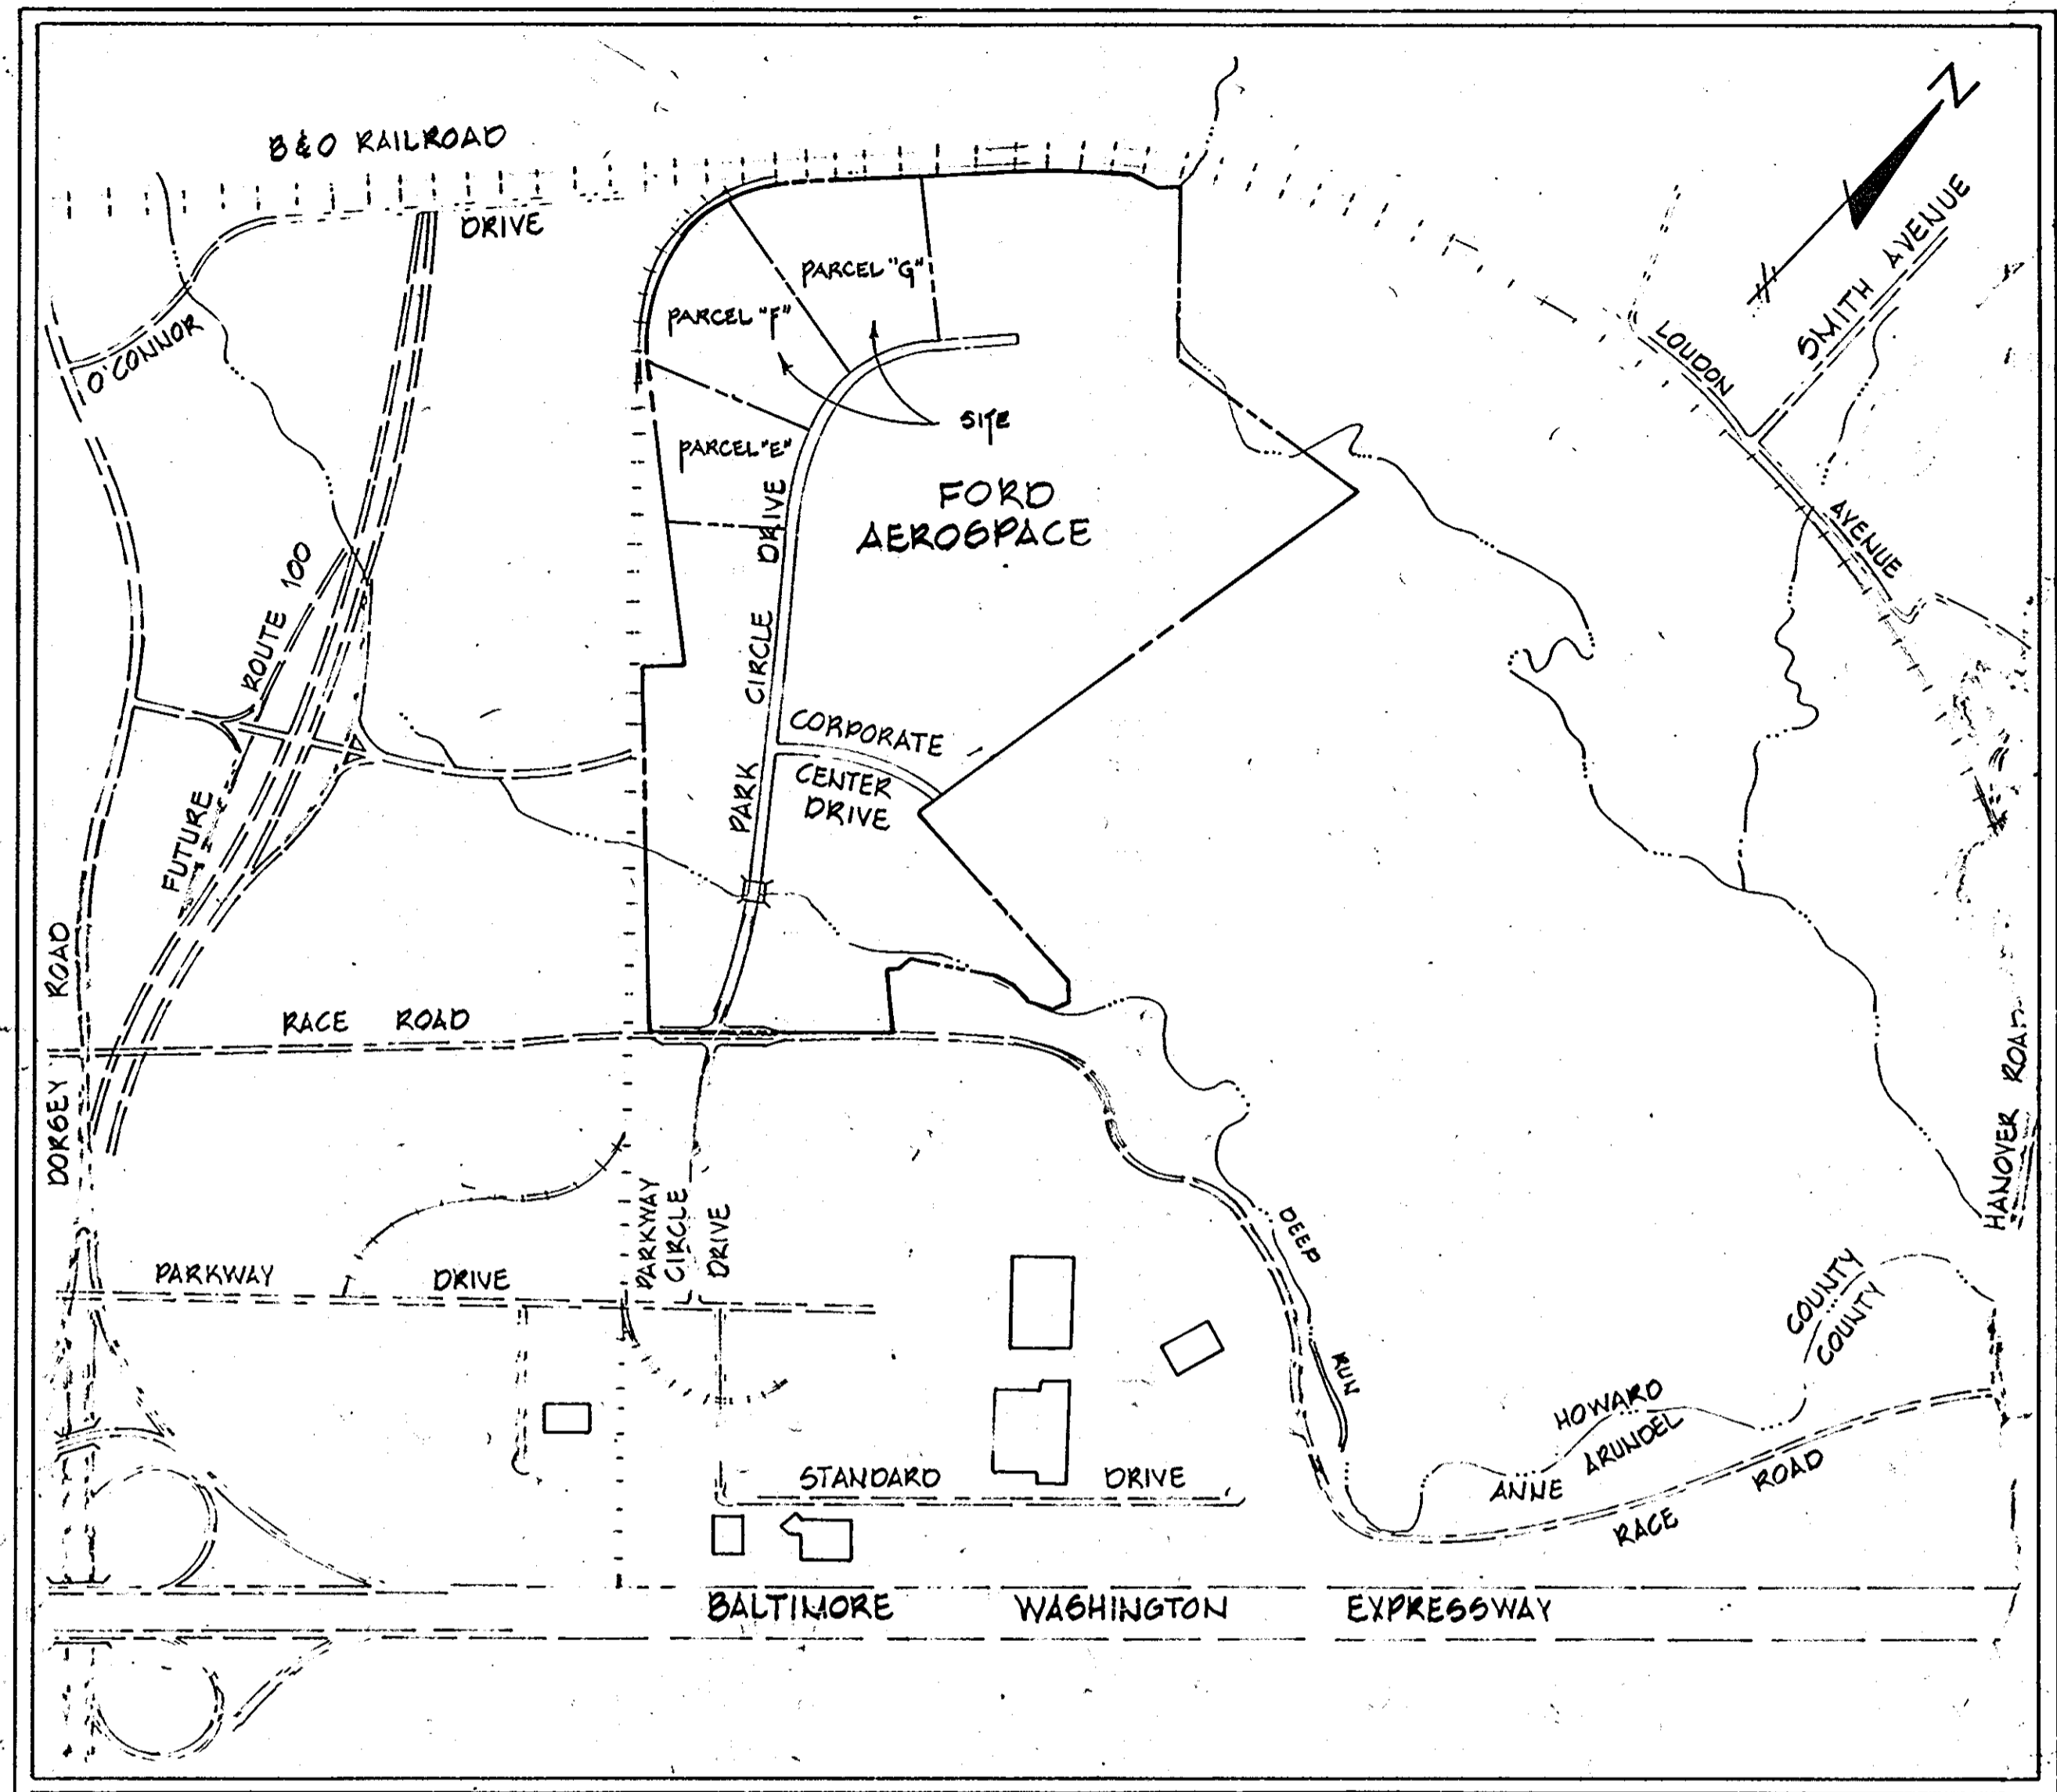

LOCATION MAP  
SCALE: 1" = 600'

DRAWING INDEX	
SHEET NO.	TITLE OF DRAWING
1	COVER SHEET
2	PARCEL 'F' GRADING PLAN
3	PARCEL 'G' GRADING PLAN
4	PARCEL 'F' INTERIM POND NO. 1 DETAILS
5	PARCEL 'G' INTERIM POND NO. 2 DETAILS
6	STANDARD NOTES AND DETAILS

Howard County Signature Block

**APPROVED**  
 DIVISION OF  
 COMMUNITY PLANNING  
 & LAND DEVELOPMENT  
 HOWARD COUNTY,  
 MARYLAND  
 DATE: \_\_\_\_\_

SEDIMENT CONTROL & POND CONSTRUCTION

( ) By the Developer:  
 "I/We certify that all development and/or construction will be done according to these plans, and that any responsible personnel involved in the construction project will have a Certificate of Attendance at a Department of Natural Resources Approved Training Program for the Control of Sediment and Erosion before beginning the project. I will provide the Howard Soil Conservation District with an "as-built" plan of the pond within 30 days of completion. I also authorize periodic on-site inspections by the Howard Soil Conservation District."  
 Signature of Developer: \_\_\_\_\_ Date: 2/13/90  
 Print name below signature: D. W. ZIEHL

( ) By the Engineer:  
 "I certify that this plan for pond construction, erosion and sediment control represents a practical and workable plan based on my personal knowledge of the site conditions. This plan was prepared in accordance with the requirements of the Howard Soil Conservation District. I have notified the developer that he must provide the Howard Soil Conservation District with an "as-built" plan of the pond within 30 days of completion."  
 Signature of Engineer: \_\_\_\_\_ Date: 2/13/90  
 Print name below signature: D. W. ZIEHL

( ) These plans have been reviewed for the Howard Soil Conservation District and meet the technical requirements for small pond construction, soil erosion and sediment control.  
 Signature of District: \_\_\_\_\_ Date: 2/13/90  
 Print name below signature: D. W. ZIEHL

( ) These plans for small pond construction, soil erosion and sediment control meet the requirements of the Howard Soil Conservation District.  
 Signature of District: \_\_\_\_\_ Date: 2/13/90  
 Print name below signature: D. W. ZIEHL

# PARKWAY ~~CORPORATE~~ CENTER

## PARCEL 'E', 'F', AND 'G' SITE DEVELOPMENT PLAN FOR GRADING AND STORMWATER MANAGEMENT

"PLAN SUBJECT TO"  
 0-8760, P-87-70 AND F-88-55, WP-00-58, F-90-125

ENGINEER'S CERTIFICATE  
 I HEREBY CERTIFY THAT THIS PLAN FOR EROSION AND SEDIMENT CONTROL REPRESENTS A PRACTICAL AND WORKABLE PLAN BASED ON MY PERSONAL KNOWLEDGE OF THE SITE CONDITIONS AND THAT IT HAS BEEN PREPARED IN ACCORDANCE WITH THE REQUIREMENTS OF THE HOWARD SOIL CONSERVATION DISTRICT.  
 Signature: D. W. ZIEHL  
 DATE: 2/13/90

DEVELOPER'S CERTIFICATE  
 "I/WE CERTIFY THAT ALL DEVELOPMENT AND CONSTRUCTION WILL BE DONE ACCORDING TO THIS PLAN OF DEVELOPMENT AND PLAN FOR EROSION AND SEDIMENT CONTROL AND THAT ALL RESPONSIBLE PERSONNEL INVOLVED IN THE CONSTRUCTION PROJECT WILL HAVE A CERTIFICATE OF ATTENDANCE AT A DEPARTMENT OF NATURAL RESOURCES APPROVED TRAINING PROGRAM FOR THE CONTROL OF SEDIMENT AND EROSION BEFORE BEGINNING THE PROJECT. I ALSO AUTHORIZE PERIODIC ON-SITE INSPECTIONS BY THE HOWARD SOIL CONSERVATION DISTRICT OR THEIR AUTHORIZED AGENTS, AS NECESSARY."  
 Signature: \_\_\_\_\_  
 DATE: 2/13/90

APPROVED: FOR PUBLIC WATER AND PUBLIC SEWERAGE SYSTEMS,  
 HOWARD COUNTY HEALTH DEPARTMENT  
 County Health Officer: \_\_\_\_\_ DATE: 3-21-90

APPROVED: HOWARD COUNTY DEPARTMENT OF PLANNING AND ZONING  
 Director: \_\_\_\_\_ DATE: 4-2-90  
 Chief Division of Community Planning and Land Development: \_\_\_\_\_ DATE: 2/16/90

APPROVED: FOR PUBLIC WATER AND PUBLIC SEWERAGE, STORM DRAINAGE SYSTEMS AND PUBLIC ROADS HOWARD COUNTY DEPARTMENT OF PUBLIC WORKS  
 Director: \_\_\_\_\_ DATE: 3/20/90  
 Chief Bureau of Engineering: \_\_\_\_\_ DATE: 3-2-90


REVIEWED FOR HOWARD COUNTY SOIL CONSERVATION DISTRICT AND MEETS TECHNICAL REQUIREMENTS.  
 Signature: J. Halpern  
 DATE: 2-13-90

THIS DEVELOPMENT IS APPROVED FOR EROSION AND SEDIMENT CONTROL BY THE HOWARD SOIL CONSERVATION DISTRICT  
 Signature: Robert W. Ziehl  
 DATE: 2/13/90

SUBDIVISION NAME	SECT./AREA	LOT/PARCEL #
PARKWAY Corporate Center	SECT. 1	E, F, G
BLK 1 OF 2E BLOCK 1	ZONE	PAR/ZONE MAP
PLAT 2281	1981	M-2
TM 30444	1	6012
WATER CODE	SEWER CODE	
A-04	2150000 & 2150000	

REVISIONS			
DESIGNED	DATE	BY	DESCRIPTION
JAB	5/82		
DRAWN	5/82		
CHECKED			
APPROVED			

**ENGINEERING TECHNOLOGIES ASSOCIATES, INC.**  
 ENGINEERS, PLANNERS, SURVEYORS  
 3458 ELLICOTT CENTER DRIVE SUITE 101  
 ELLICOTT CITY, MD. 21043  
 (301) 461-9920

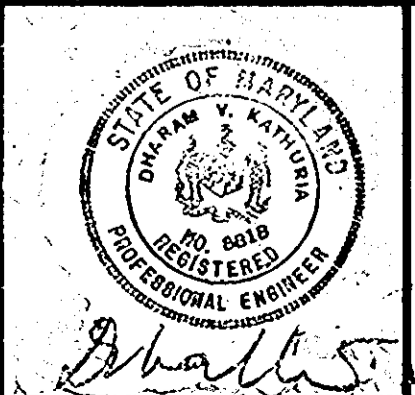



OWNER / DEVELOPER  
 HI-TECH VENTURE LIMITED PARTNERSHIP  
 7223 PARKWAY DRIVE  
 HANOVER, MARYLAND 21076  
 (301) 796-4446

COVER SHEET  
**PARKWAY CENTER SECTION I**  
 PARCELS 'E', 'F', and 'G'  
 AND OUT PARCEL (1565/469)  
 1st ELECTION DISTRICT TM-30444 HOWARD COUNTY, MARYLAND  
 SCALE AS SHOWN CONTRACT NO. 89100-40 DATE: 5/89 SHEET 1 OF 8  
 SDP-89-275

PARCEL "G"  
Parkway Center, Section 1  
PAT 7584  
ZONED M-2

INTERIM POND No. 1  
ELEVATIONS  
BOTTOM ELEV. = 92.75  
VOLUME REQUIRED = 607 CY  
VOLUME PROVIDED = 1390 CY  
CLEANOUT ELEV. = 95.00

MATCH LINE S 83° 31' 00" W 814.49' SHEET 3 OF 6

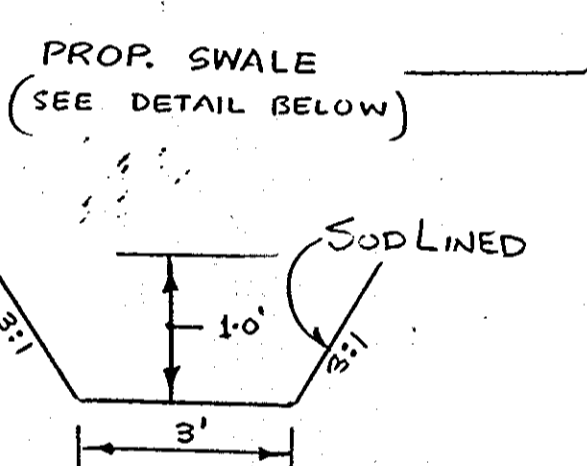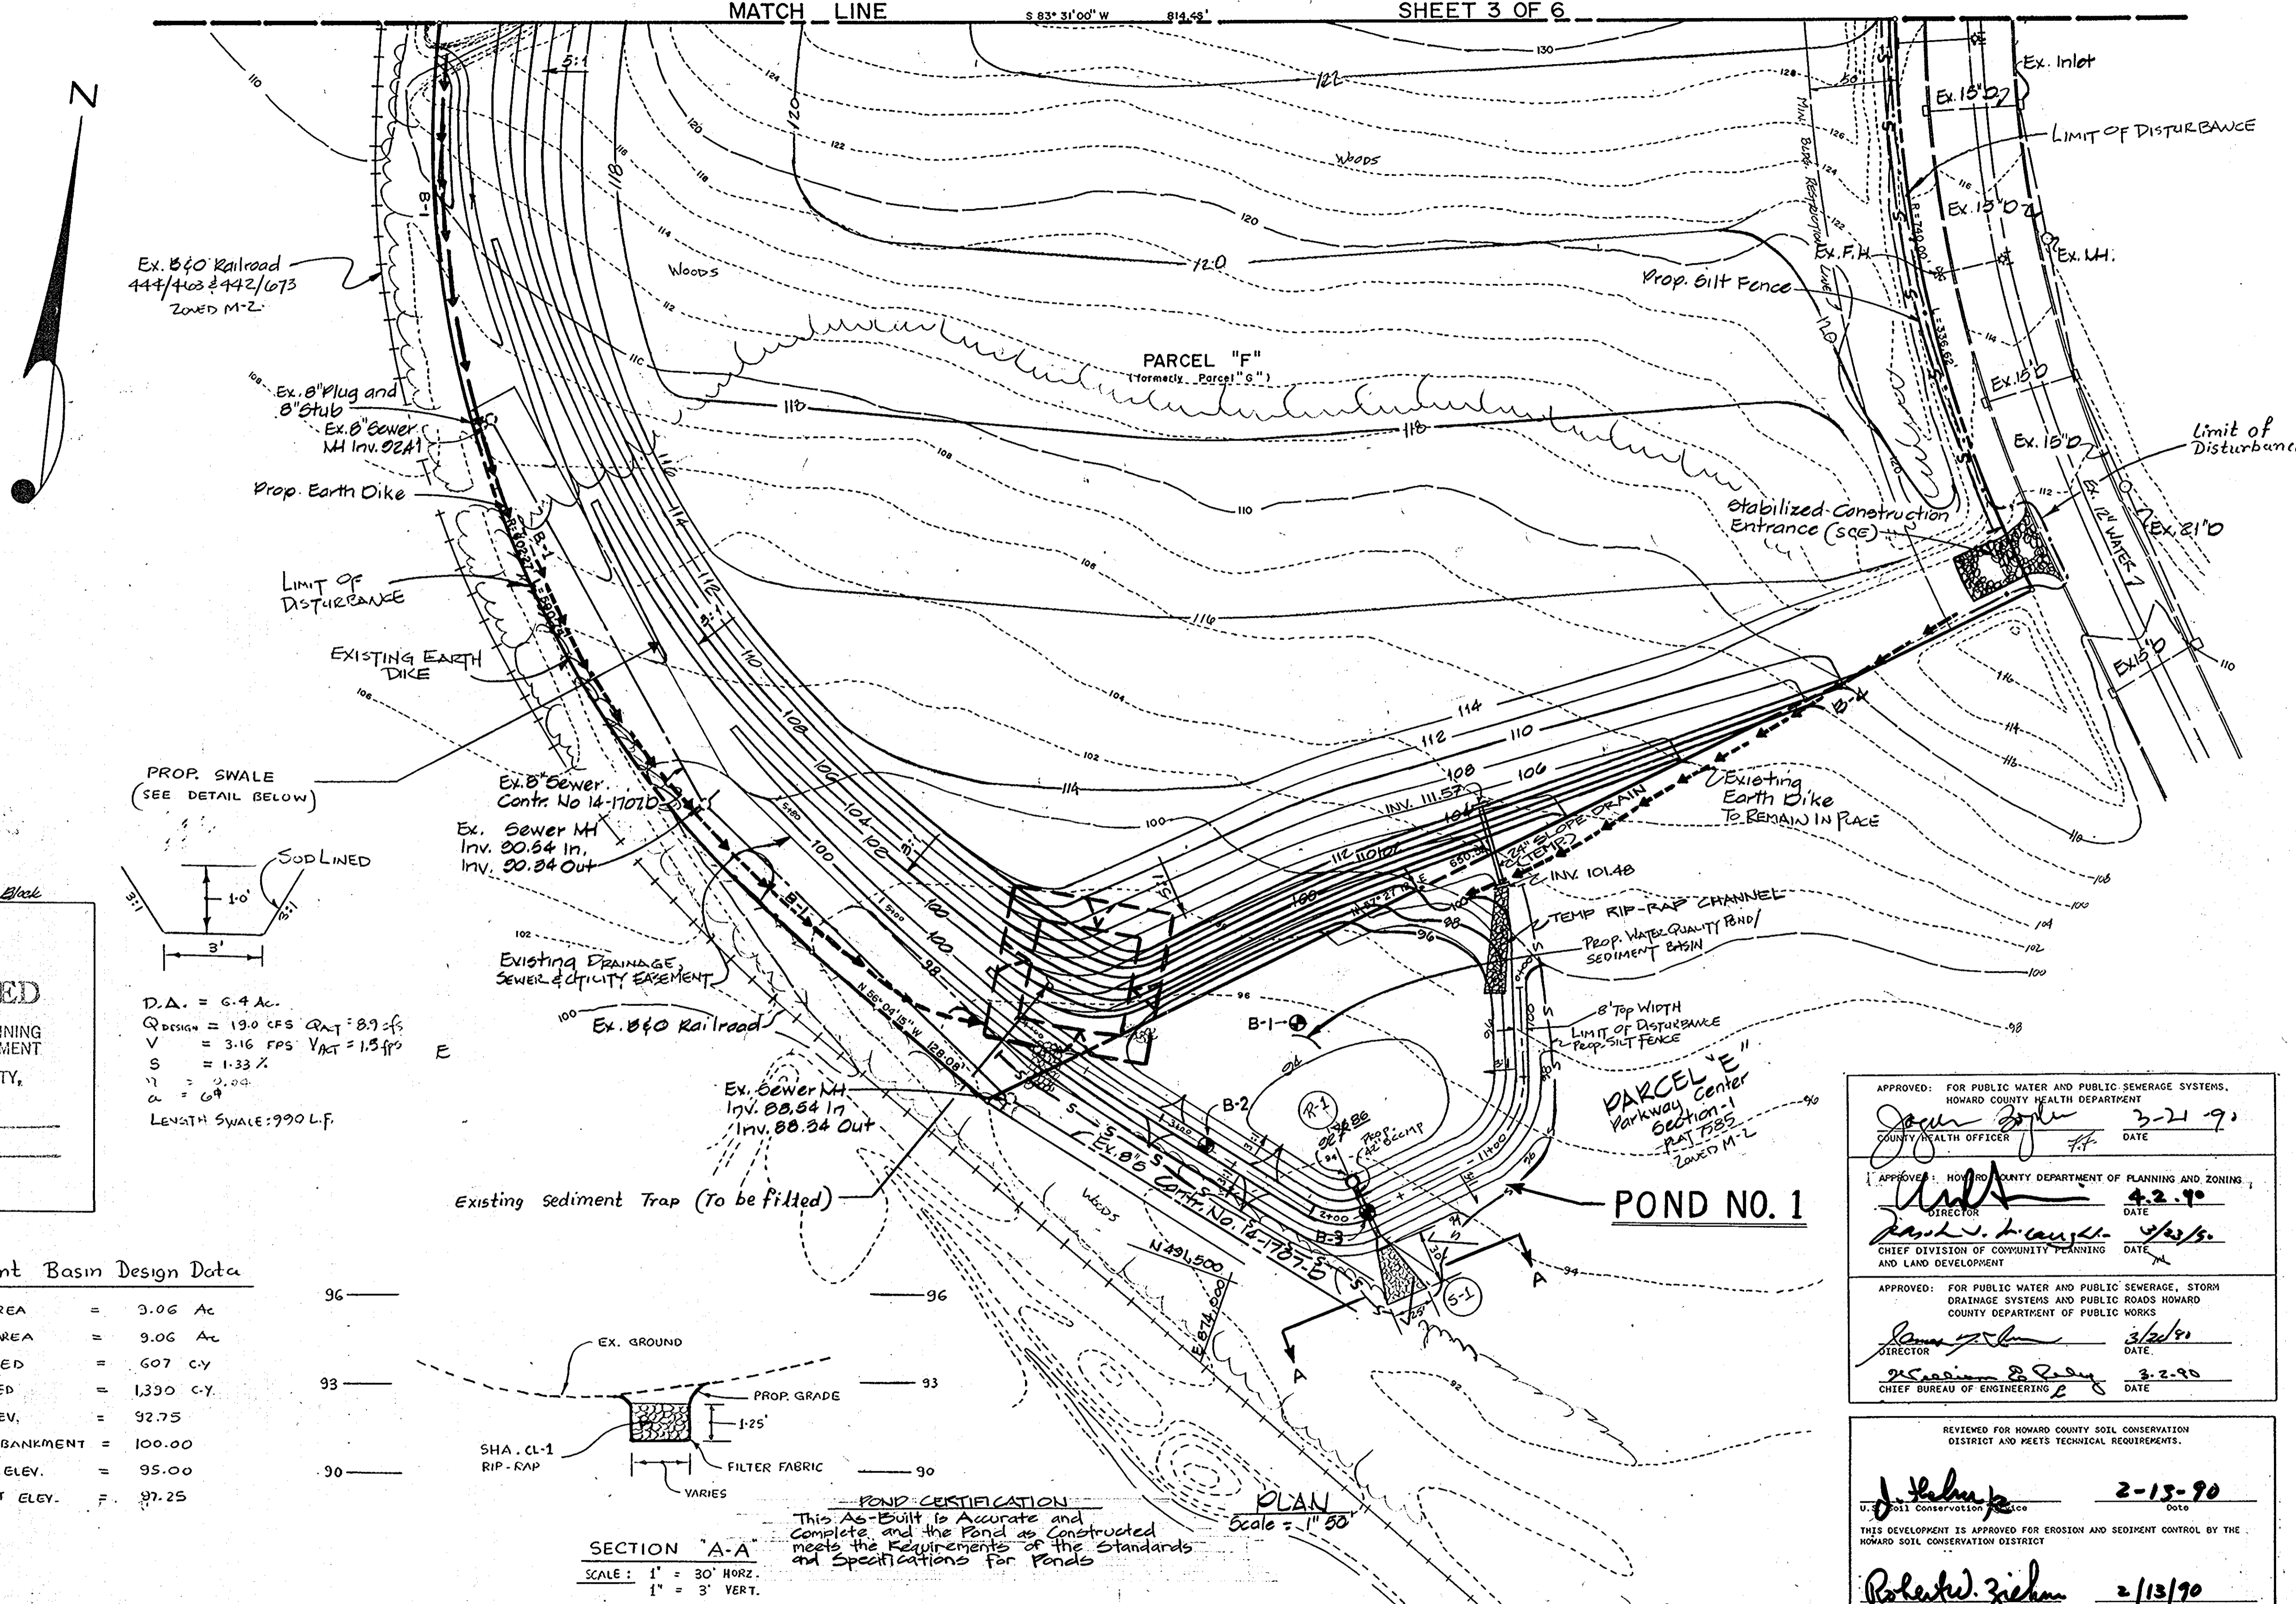

D.A. = 6.4 Ac  
Q<sub>Design</sub> = 19.0 CFS CRAT = 8.9 cfs  
V = 3.16 FPS V<sub>CRAT</sub> = 1.5 fps  
S = 1.33 %  
n = 2.04  
α = 69°  
LENGTH SWALE = 990 LF

PARCEL "K"  
Parkway Center, Section-1  
PAT 7584 & 7585  
ZONED M-2

ENGINEER'S CERTIFICATE  
I HEREBY CERTIFY THAT THIS PLAN FOR EROSION AND SEDIMENT CONTROL REPRESENTS A PRACTICAL AND WORKABLE PLAN BASED ON MY PERSONAL KNOWLEDGE OF THE SITE CONDITIONS AND THAT IT WAS PREPARED IN ACCORDANCE WITH THE REQUIREMENTS OF THE HOWARD SOIL CONSERVATION DISTRICT.  
*A. Khaturia* 2/13/90  
SIGNATURE OF ENGINEER DATE

DEVELOPER'S CERTIFICATE  
"I/WE CERTIFY THAT ALL DEVELOPMENT AND CONSTRUCTION WILL BE DONE ACCORDING TO THIS PLAN OF DEVELOPMENT AND PLAN FOR EROSION AND SEDIMENT CONTROL, AND THAT ALL RESPONSIBLE PERSONNEL INVOLVED IN THE CONSTRUCTION PROJECT WILL HAVE A CERTIFICATE OF ATTENDANCE AT A DEPARTMENT OF NATURAL RESOURCES APPROVED TRAINING PROGRAM FOR THE CONTROL OF SEDIMENT AND EROSION BEFORE BEGINNING THE PROJECT. I ALSO AUTHORIZE PERIODIC ON-SITE INSPECTIONS BY THE HOWARD SOIL CONSERVATION DISTRICT OR THEIR AUTHORIZED AGENTS, AS ARE DEEMED NECESSARY."  
*A. Khaturia* 2/13/90  
SIGNATURE OF DEVELOPER DATE

Howard County Signature Block  
**APPROVED**  
DIVISION OF  
COMMUNITY PLANNING  
& LAND DEVELOPMENT  
HOWARD COUNTY,  
MARYLAND  
DATE \_\_\_\_\_

SEDIMENT CONTROL & POND CONSTRUCTION

( ) By the Developer:  
"I/We certify that all development and/or construction will be done according to these plans, and that any responsible personnel involved in the construction project will have a Certificate of Attendance at a Department of Natural Resources Approved Training Program for the Control of Sediment and Erosion before beginning the project. I will provide the Howard Soil Conservation District with an "as-built" plan of the pond within 30 days of completion. I also authorize periodic on-site inspections by the Howard Soil Conservation District."  
*A. Khaturia* 2/13/90  
Signature of Developer Date  
Print name/Title/Signature

( ) By the Engineer:  
"I certify that this plan for pond construction, erosion and sediment control represents a practical and workable plan based on my personal knowledge of the site conditions. This plan was prepared in accordance with the requirements of the Howard Soil Conservation District. I have notified the developer that he must provide the Howard Soil Conservation District with an "as-built" plan of the pond within 30 days of completion."  
*A. Khaturia* 2/13/90  
Signature of Engineer Date  
Print name/Title/Signature

( ) These plans have been reviewed by the Howard Soil Conservation District and meet the technical requirements for small pond construction, soil erosion and sediment control.  
*A. Khaturia* 2/13/90  
Signature of Engineer Date  
Print name/Title/Signature

SITE DEVELOPMENT PLAN FOR GRADING AND STORMWATER MANAGEMENT

SITE, GRADING AND SEDIMENT CONTROL PLAN

PARKWAY CENTER SECTION 1

PARCELS "E", "F", and "G" AND OUT PARCEL (I565/469)

1st. ELECTION DISTRICT TM 30 & 44 HOWARD COUNTY, MARYLAND

SCALE: AS SHOWN CONTRACT NO. DATE: 5/89 SHEET: 2 OF 8

APPROVED: FOR PUBLIC WATER AND PUBLIC SEWERAGE SYSTEMS, HOWARD COUNTY HEALTH DEPARTMENT  
*James J. Zich* 3-21-90  
COUNTY HEALTH OFFICER DATE

APPROVED: HOWARD COUNTY DEPARTMENT OF PLANNING AND ZONING  
*Paul W. Langell* 4-2-90  
DIRECTOR DATE


APPROVED: FOR PUBLIC WATER AND PUBLIC SEWERAGE, STORM DRAINAGE SYSTEMS AND PUBLIC ROADS HOWARD COUNTY DEPARTMENT OF PUBLIC WORKS  
*James J. Zich* 3/26/90  
DIRECTOR DATE

REVIEWED FOR HOWARD COUNTY SOIL CONSERVATION DISTRICT AND MEETS TECHNICAL REQUIREMENTS.  
*A. Khaturia* 2-13-90  
U.S. Soil Conservation Service Date

THIS DEVELOPMENT IS APPROVED FOR EROSION AND SEDIMENT CONTROL BY THE HOWARD SOIL CONSERVATION DISTRICT  
*Robert W. Zich* 2/13/90  
HOWARD SOIL CONSERVATION DISTRICT DATE

Sediment Basin Design Data

- DRAINAGE AREA = 9.06 Ac
- DISTURBED AREA = 9.06 Ac
- VOL. REQUIRED = 607 C.Y.
- VOL. PROVIDED = 1390 C.Y.
- BOTTOM ELEV. = 92.75
- TOP OF EMBANKMENT = 100.00
- CLEANOUT ELEV. = 95.00
- RISER CREST ELEV. = 97.25

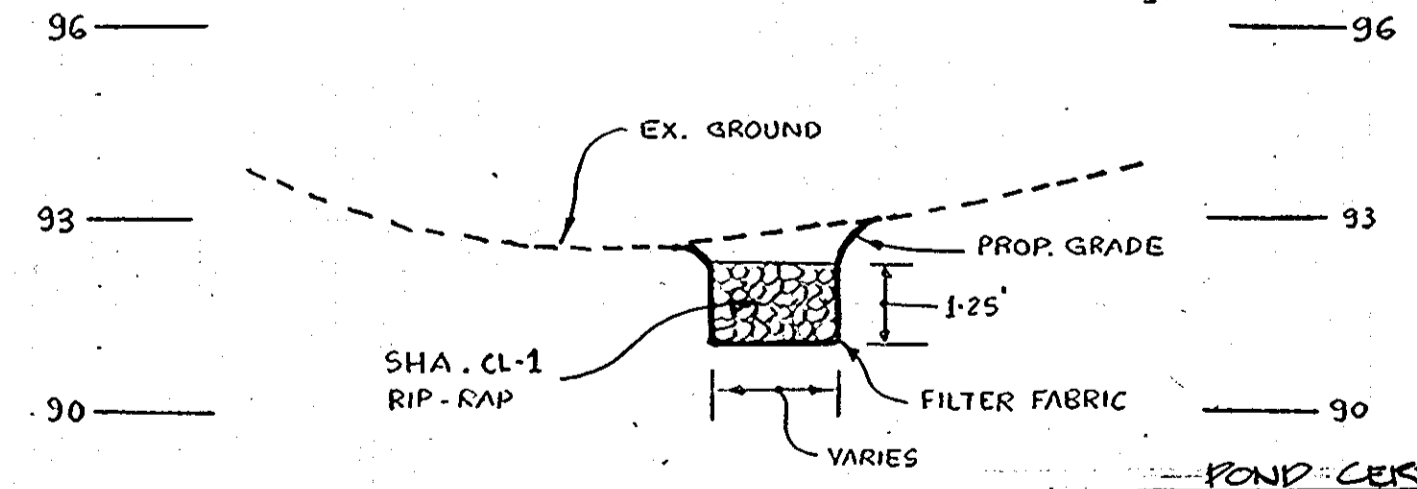


POND CERTIFICATION  
This As-Built is accurate and complete, and the Pond as constructed meets the requirements of the Standards and Specifications for Ponds

SECTION "A-A"  
SCALE: 1" = 30' HORIZ.  
1" = 3' VERT.

DESIGNED		DATE		REVISIONS	
DATE	BY	DATE	BY	DESCRIPTION	
5/24/91	MCR			AS-BUILT	

ENGINEERING TECHNOLOGIES ASSOCIATES, INC.

ENGINEERS, PLANNERS, SURVEYORS  
3458 ELLICOTT CENTER DRIVE SUITE 101  
ELLICOTT CITY, MD. 21043  
(301) 461-9920

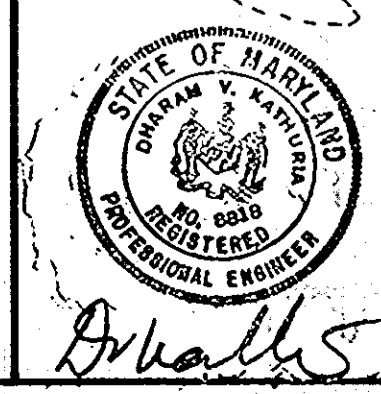

OWNER / DEVELOPER  
HI TECH VENTURE LIMITED PARTNERSHIP  
7223 PARKWAY DRIVE  
HANOVER, MARYLAND 21076  
(301) 796-4446

DATE: 5/89 SHEET: 2 OF 8  
SDP-89-275

SEDIMENT CONTROL & POND CONSTRUCTION

( ) By the Developer:

"I/We certify that all development and/or construction will be done according to these plans, and that any responsible personnel involved in the construction project will have a Certificate of Attendance at a Department of Natural Resources Approved Training Program for the Control of Sediment and Erosion before beginning the project. I will provide the Howard Soil Conservation District with an "as-built" plan of the pond within 30 days of completion. I also authorize periodic on-site inspections by the Howard Soil Conservation District."

Signature of Developer Date  
Print name below signature

( ) By the Engineer:

"I certify that this plan for pond construction, erosion and sediment control represents a practical and workable plan based on my personal knowledge of the site conditions. This plan was prepared in accordance with the requirements of the Howard Soil Conservation District. I have notified the developer that he must provide the Howard Soil Conservation District with an "as-built" plan of the pond within 30 days of completion."

Signature of Engineer Date  
Print name below signature

( ) These plans have been reviewed for the Howard Soil Conservation District and meet the technical requirements for small pond construction, soil erosion and sediment control.

Signature of Soil Conservation Service Date


( ) These plans for small pond construction, soil erosion and sediment control meet the requirements of the Howard Soil Conservation District.

Signature of Howard Soil Conservation District Date

Interim Pond No. 2 Elevations

Bottom Elev.-100.7 (Ultimate SWM)  
Volume Required-650 CY  
Volume Provided-1791 CY  
Cleanout Elev.-104.5

Note: Water encountered during construction of Core Trench will need to be removed by pumping

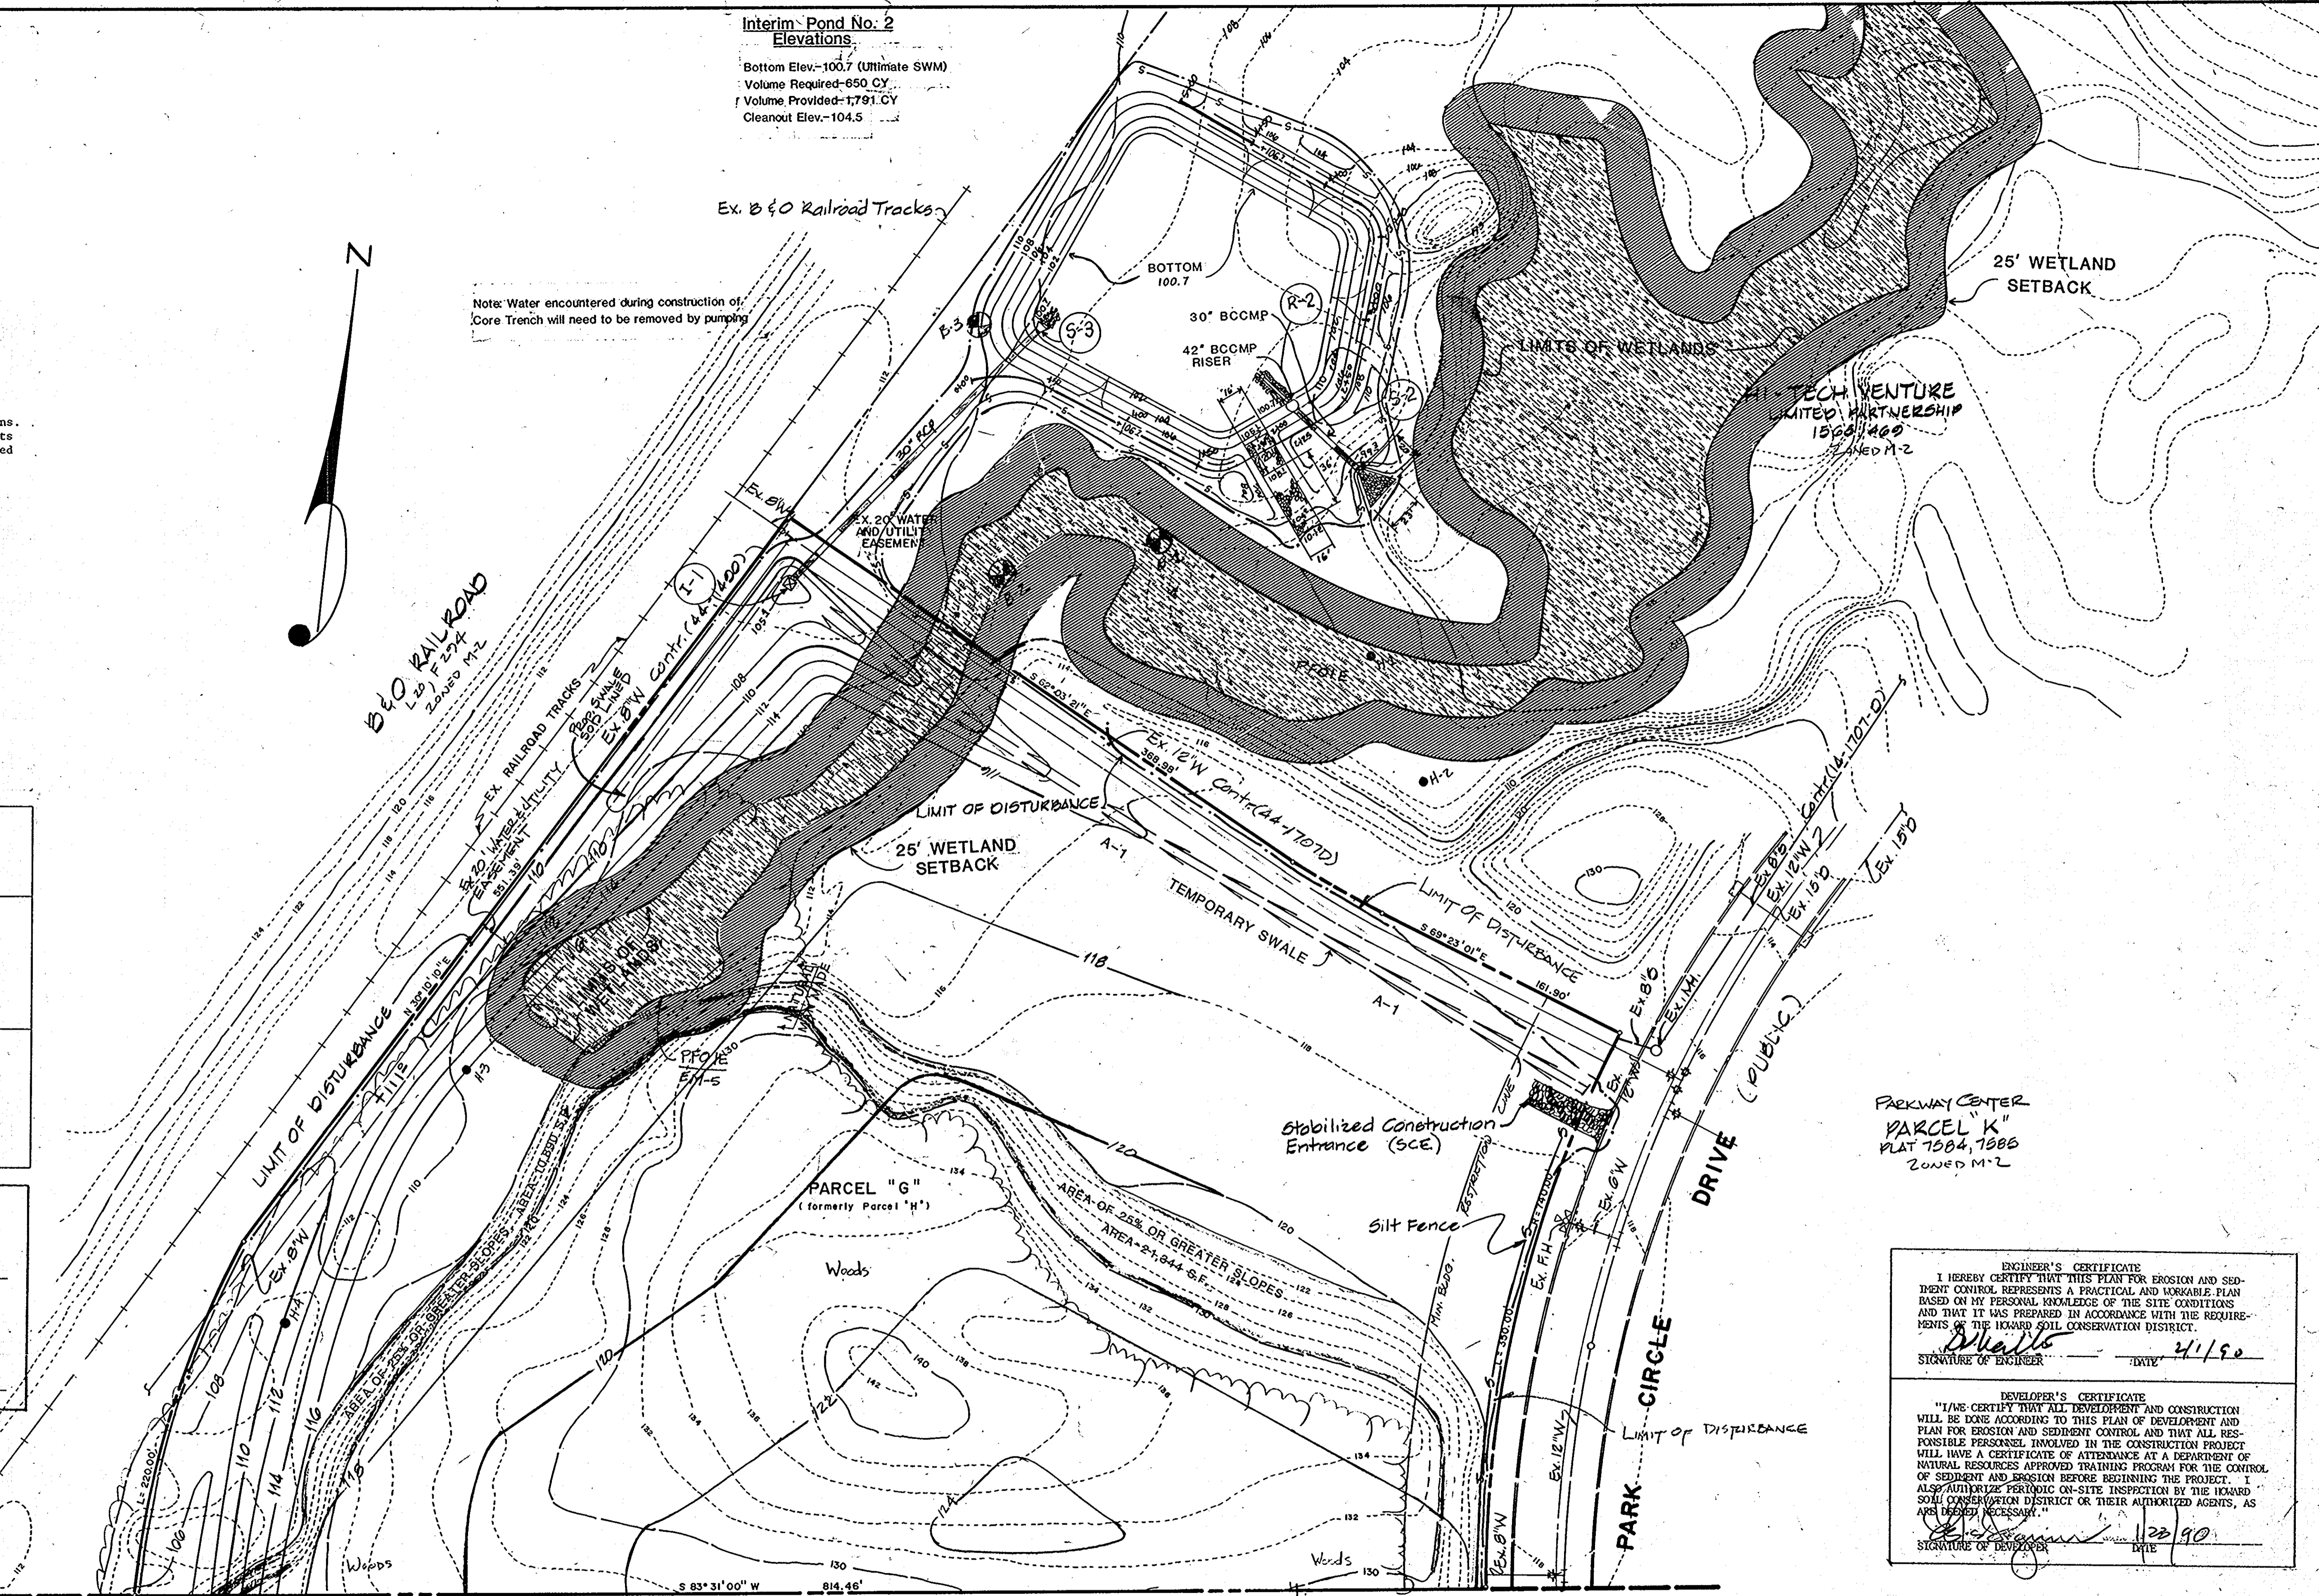

APPROVED: FOR PUBLIC WATER AND PUBLIC SEWERAGE SYSTEMS, HOWARD COUNTY HEALTH DEPARTMENT  
Signature of County Health Officer Date 3-21-90

APPROVED: HOWARD COUNTY DEPARTMENT OF PLANNING AND ZONING  
Signature of Director Date 4-2-90  
Signature of Chief of Community Planning Date 4/24/90

APPROVED: FOR PUBLIC WATER AND PUBLIC SEWERAGE, STORM DRAINAGE SYSTEMS AND PUBLIC ROADS HOWARD COUNTY DEPARTMENT OF PUBLIC WORKS  
Signature of Director Date 3-2-90  
Signature of Chief Bureau of Engineering Date 3-2-90

REVIEWED FOR HOWARD COUNTY SOIL CONSERVATION DISTRICT AND MEETS TECHNICAL REQUIREMENTS.  
Signature of Soil Conservation Service Date 2/13/90

THIS DEVELOPMENT IS APPROVED FOR EROSION AND SEDIMENT CONTROL BY THE HOWARD SOIL CONSERVATION DISTRICT.  
Signature of Howard Soil Conservation District Date 2/13/90

APPROVED DIVISION OF COMMUNITY PLANNING & LAND DEVELOPMENT HOWARD COUNTY, MARYLAND  
DATE

ENGINEER'S CERTIFICATE  
I HEREBY CERTIFY THAT THIS PLAN FOR EROSION AND SEDIMENT CONTROL REPRESENTS A PRACTICAL AND WORKABLE PLAN BASED ON MY PERSONAL KNOWLEDGE OF THE SITE CONDITIONS AND THAT IT WAS PREPARED IN ACCORDANCE WITH THE REQUIREMENTS OF THE HOWARD SOIL CONSERVATION DISTRICT.  
Signature of Engineer Date 4/1/90

DEVELOPER'S CERTIFICATE  
"I/WE CERTIFY THAT ALL DEVELOPMENT AND CONSTRUCTION WILL BE DONE ACCORDING TO THIS PLAN OF DEVELOPMENT AND PLAN FOR EROSION AND SEDIMENT CONTROL AND THAT ALL RESPONSIBLE PERSONNEL INVOLVED IN THE CONSTRUCTION PROJECT WILL HAVE A CERTIFICATE OF ATTENDANCE AT A DEPARTMENT OF NATURAL RESOURCES APPROVED TRAINING PROGRAM FOR THE CONTROL OF SEDIMENT AND EROSION BEFORE BEGINNING THE PROJECT. I ALSO AUTHORIZE PERIODIC ON-SITE INSPECTION BY THE HOWARD SOIL CONSERVATION DISTRICT OR THEIR AUTHORIZED AGENTS, AS ARE DEEMED NECESSARY."  
Signature of Developer Date 1/23/90


SITE DEVELOPMENT PLAN FOR GRADING AND STORMWATER MANAGEMENT

SITE, GRADING AND SEDIMENT CONTROL PLAN

PARKWAY CENTER SECTION I PARCELS 'E', 'F', and 'G' AND OUT PARCEL (1565/469)

1st ELECTION DISTRICT 7M-3344 HOWARD COUNTY, MARYLAND  
SCALE: AS SHOWN CONTRACT NO. DATE: 5/89 SHEET: 3 OF 8  
SDP-89-275

ENGINEERING TECHNOLOGIES ASSOCIATES, INC.  
ENGINEERS, PLANNERS, SURVEYORS  
3458 ELLICOTT CENTER DRIVE SUITE 101 ELLICOTT CITY, MD. 21043 (301) 461-9920

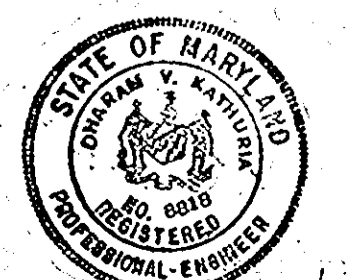

OWNER / DEVELOPER  
HI-TECH VENTURE LIMITED PARTNERSHIP  
7223 PARKWAY DRIVE HANOVER, MARYLAND 21076 (301) 796-4446


DESIGNED	DATE	REVISIONS		DESCRIPTION
		DATE	BY	
DRAWN	5/89			
CHECKED				
APPROVED				

**APPROVED**  
DIVISION of  
COMMUNITY PLANNING  
& LAND DEVELOPMENT  
HOWARD COUNTY,  
MARYLAND

DATE \_\_\_\_\_


**POND CERTIFICATION**  
This As-Built is Accurate and Complete  
and the Pond as constructed meets  
the Requirements of the Standards  
and Specifications for Ponds

D.V. KATHURIA DATE \_\_\_\_\_

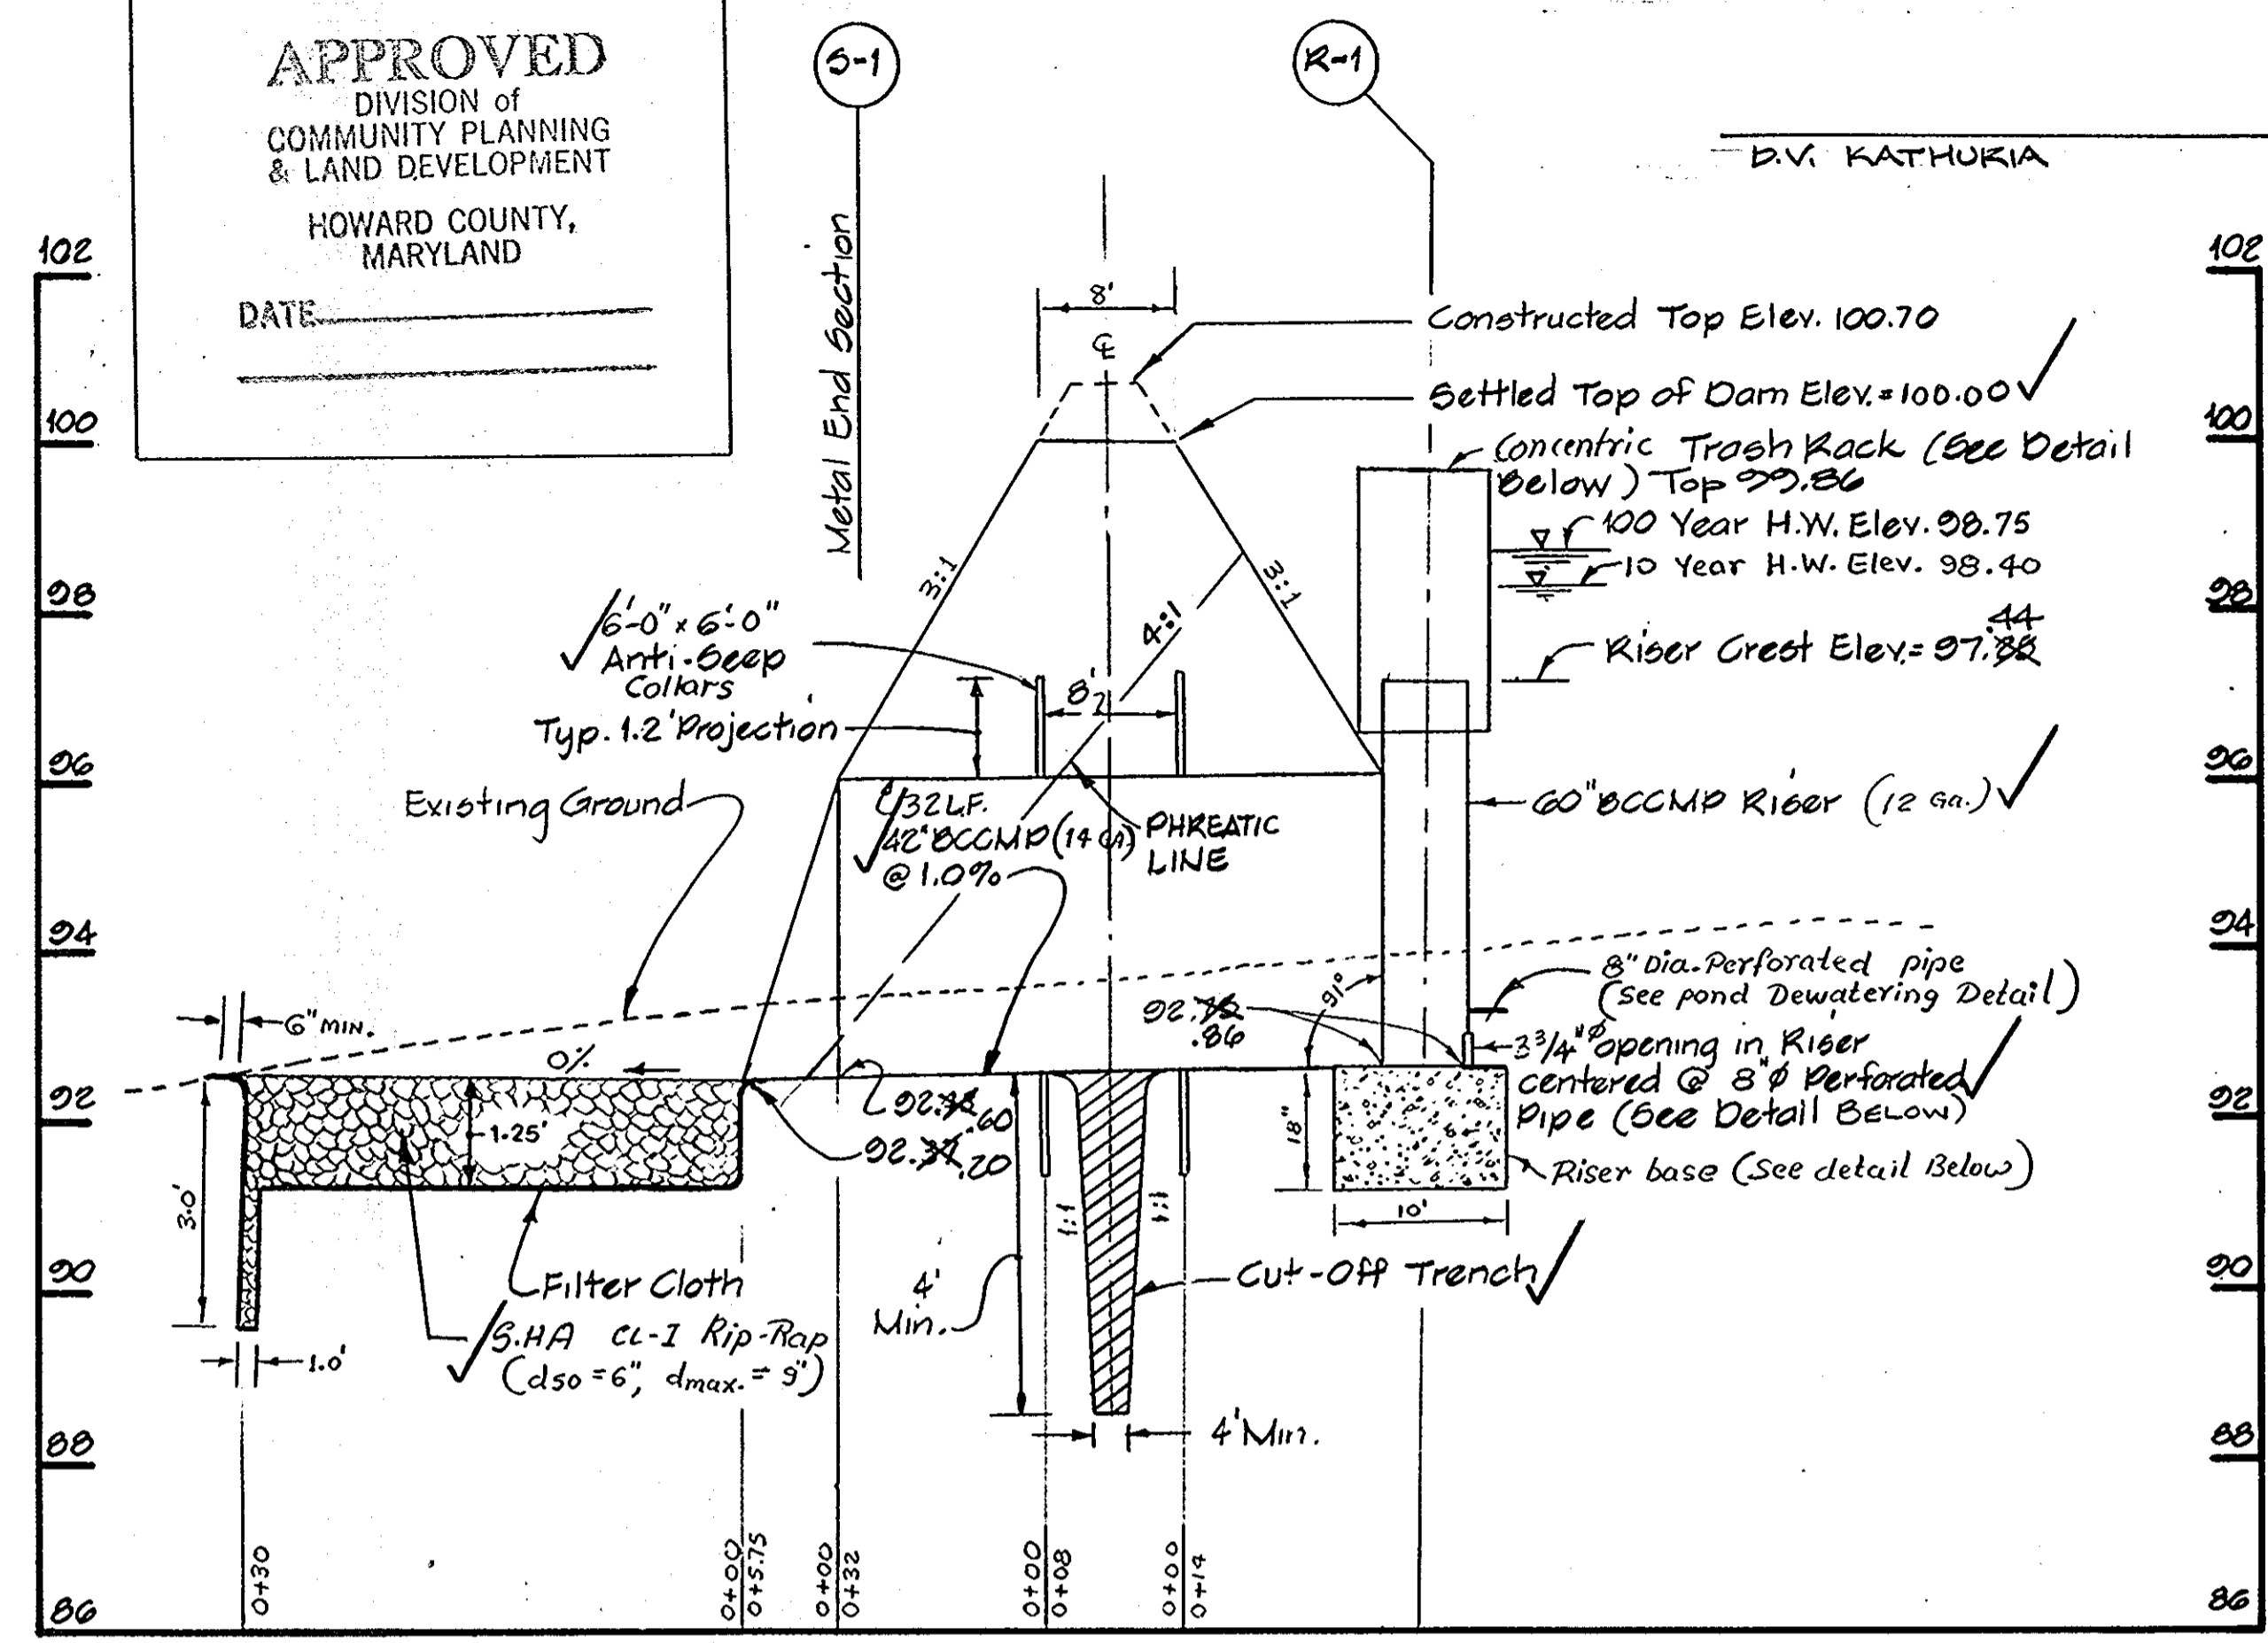


**CROSS-SECTION THRU DAM**

Scale: Horizontal = 1" = 10'  
Vertical = 1" = 2'

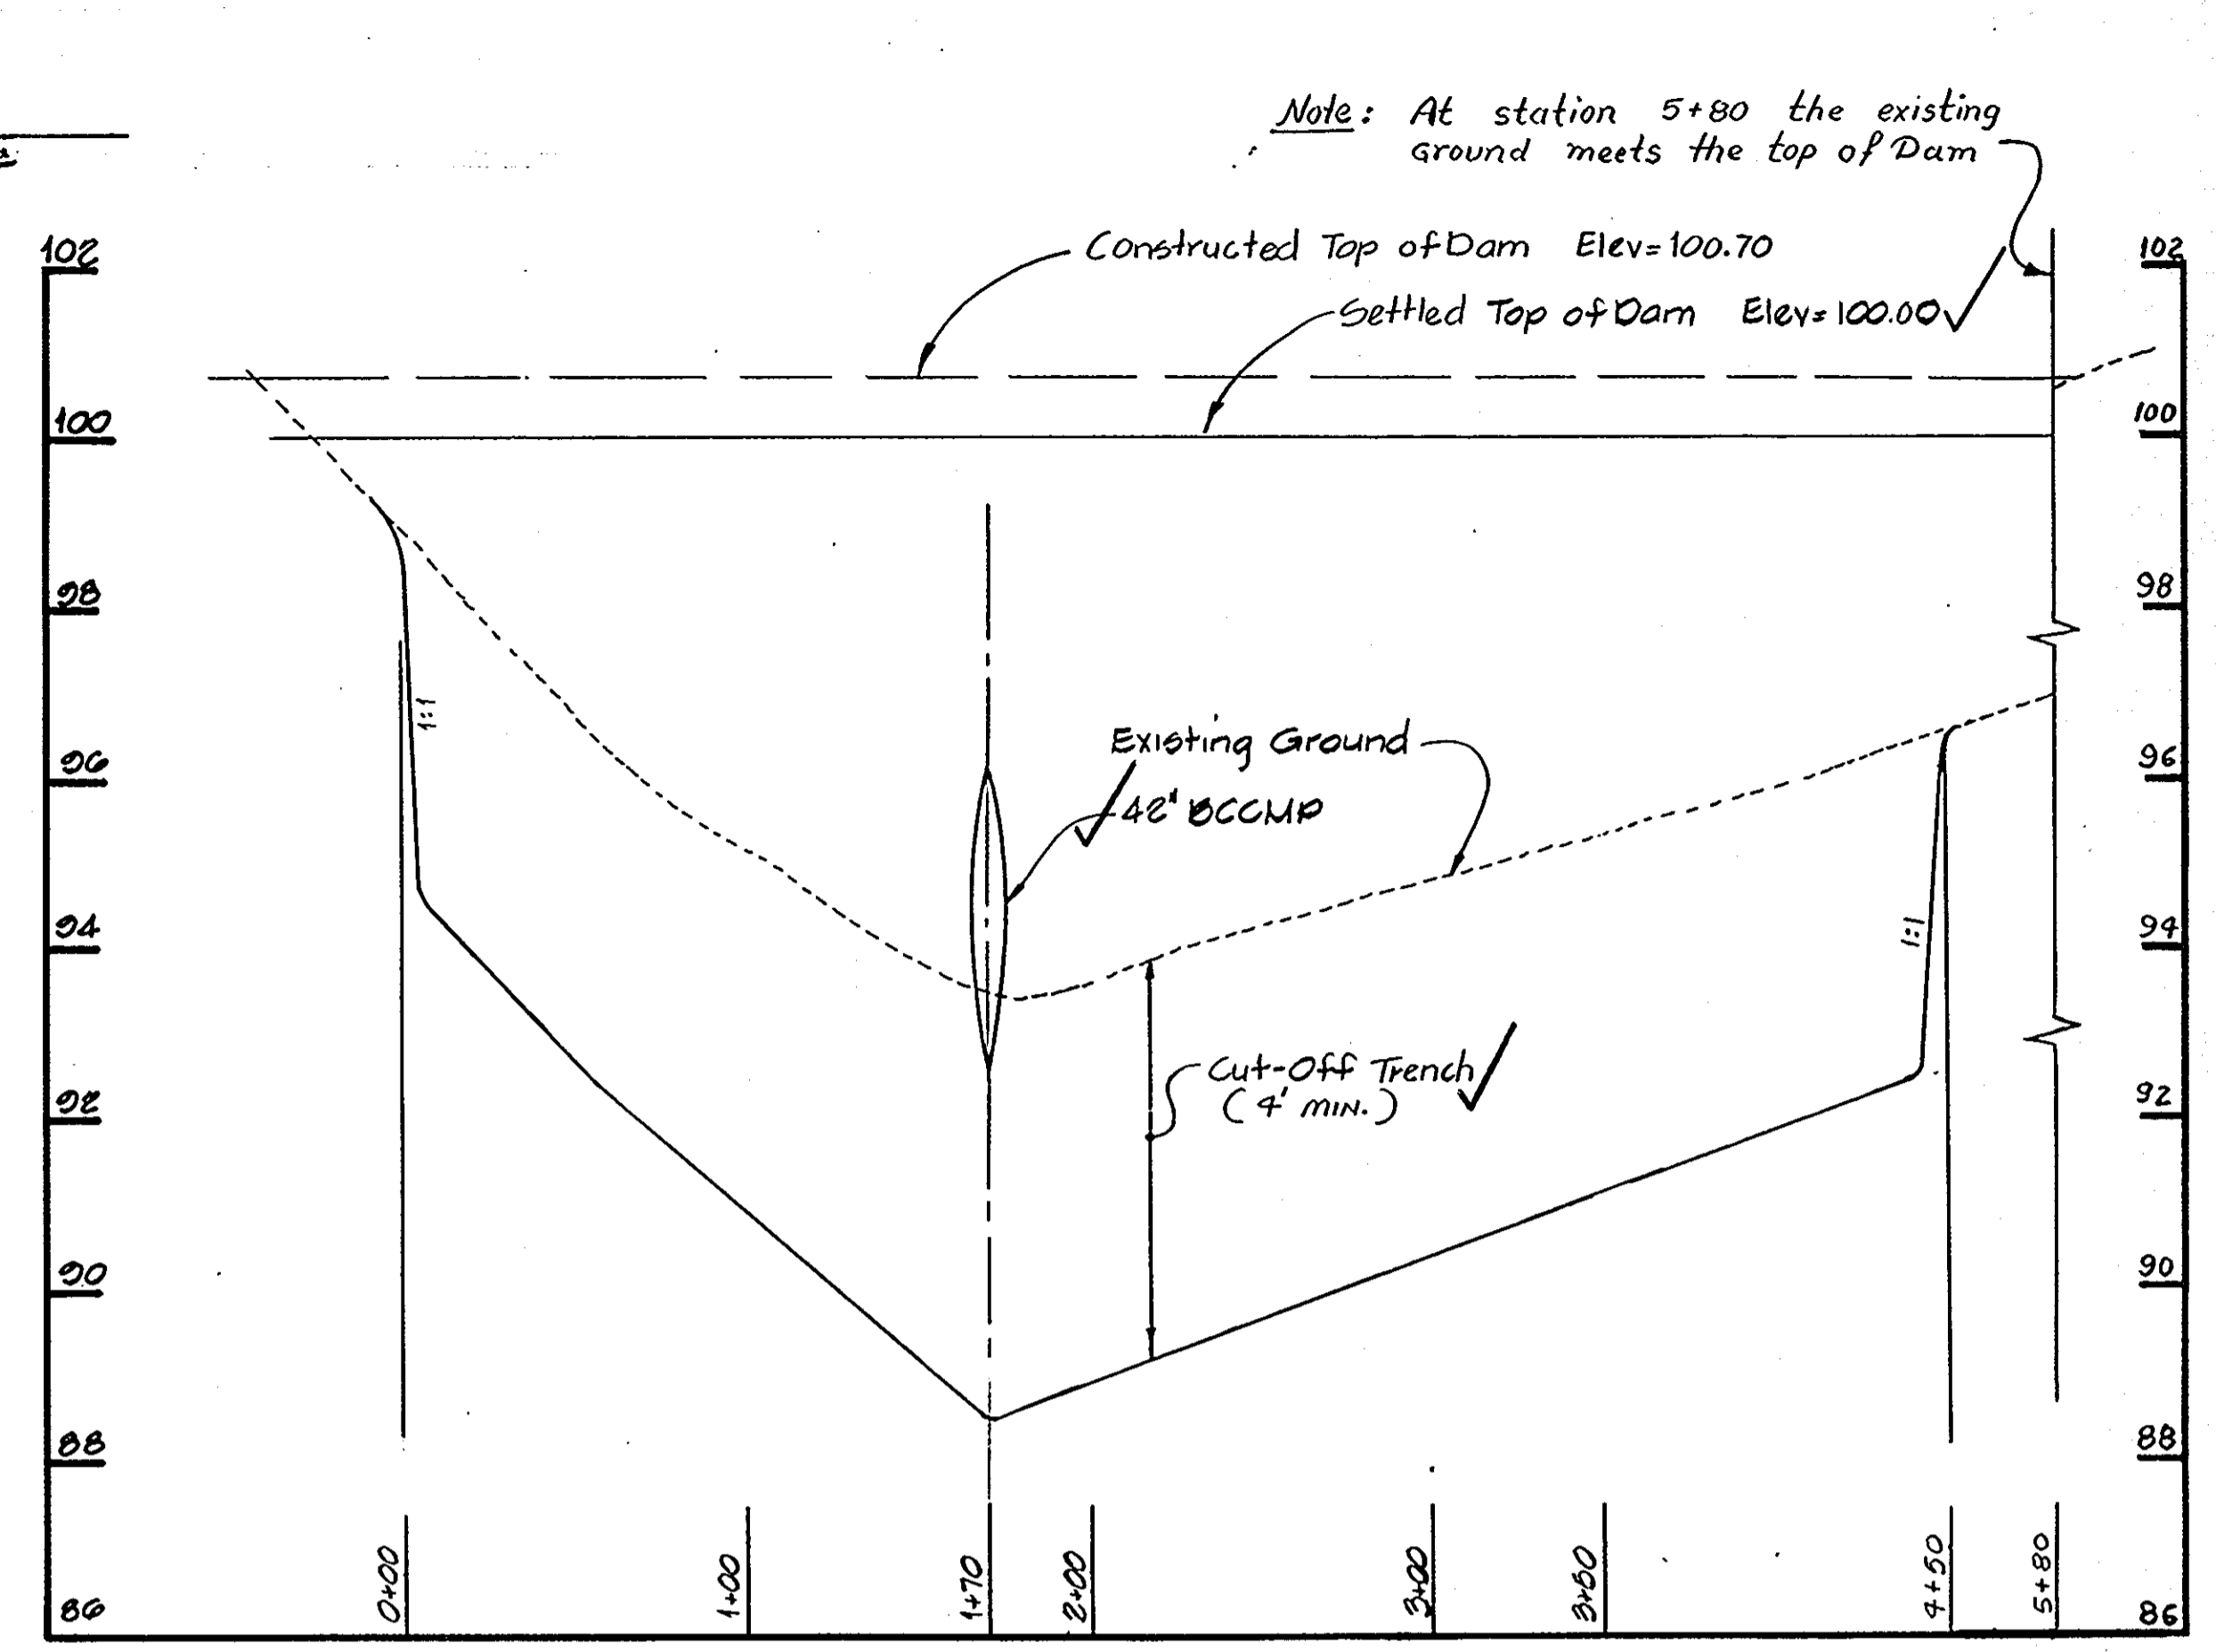


**PROFILE ALONG DAM**

Scale: Horizontal = 1" = 50'  
Vertical = 1" = 2'

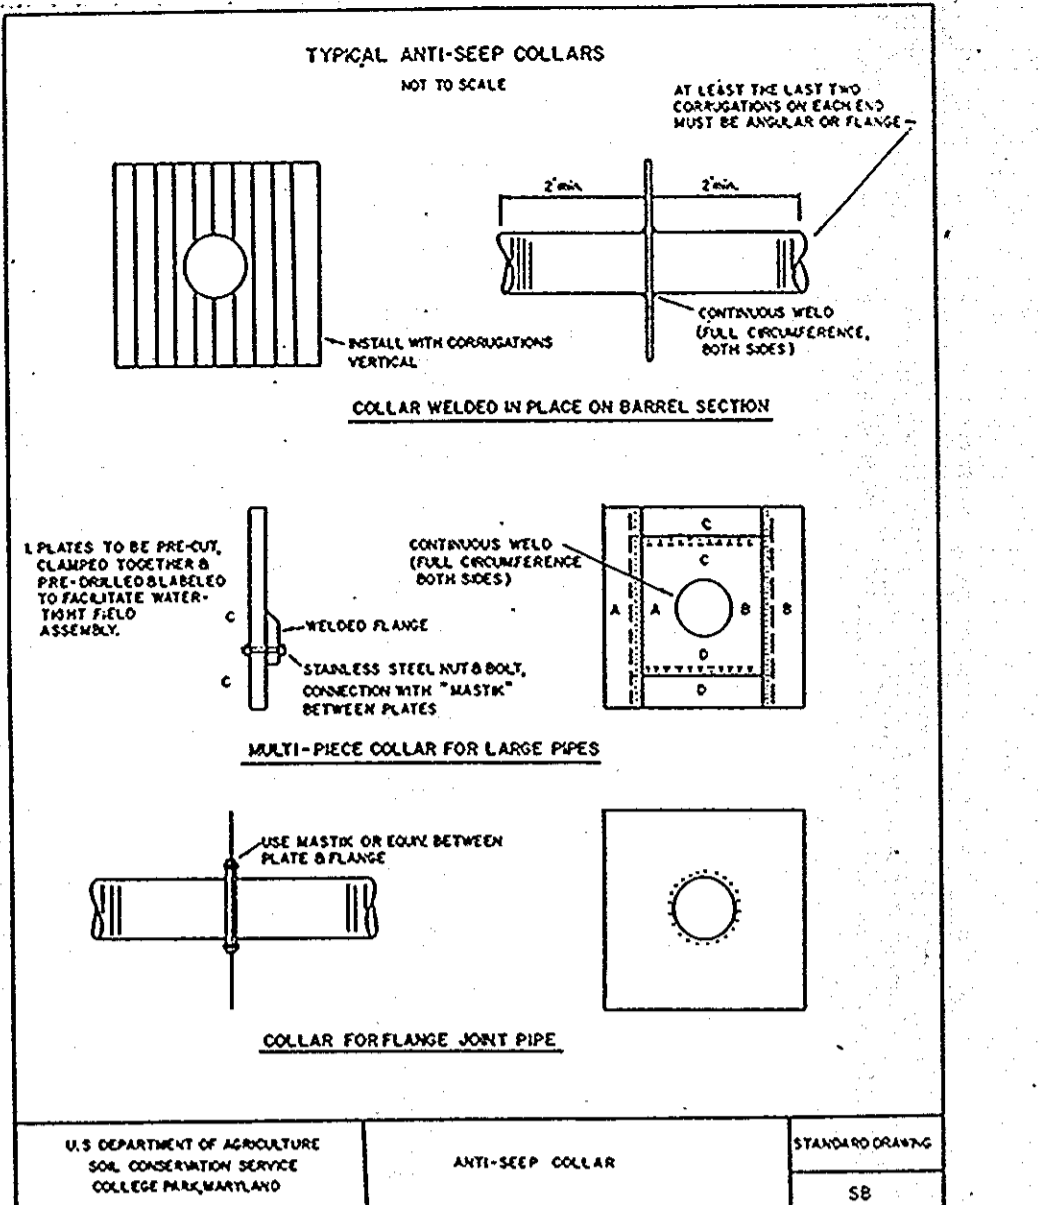


U.S. DEPARTMENT OF AGRICULTURE  
SOIL CONSERVATION SERVICE  
COLLEGE PARK, MARYLAND

ANTI-SEEP COLLAR STANDARD DRAWING  
SB

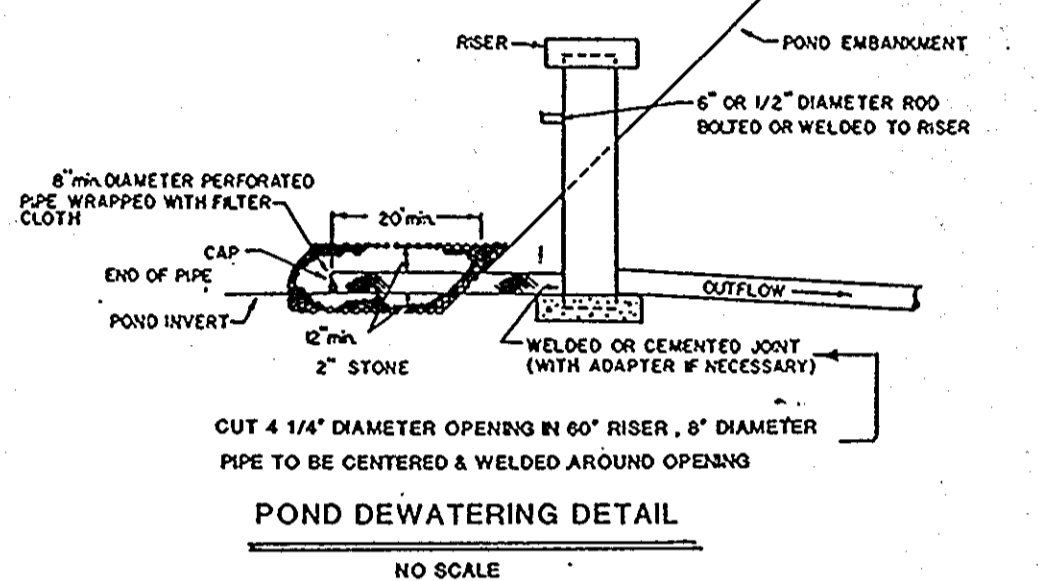

**POND DEWATERING DETAIL**



NO SCALE

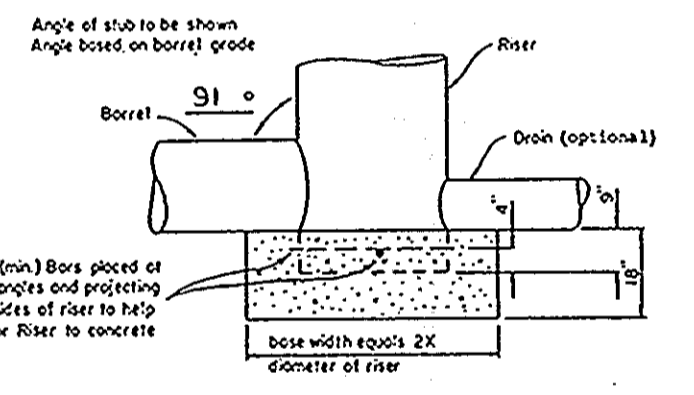

**RISER BASE DETAIL**

- NOTES:
- The concrete base shall be poured in such a manner to insure that the concrete fits the bottom of the riser to the level of the widest pipe to prevent the riser from breaking away from the base.
  - With aluminum or aluminum pipe, the embedded section must be painted with zinc chromate or equivalent.
  - Riser base may be sized as computed using flotation with a factor of safety of 1.2.


**TYPES OF COLLARS FOR CORRUGATED STEEL PIPE**  
(All collars have specific approval details)

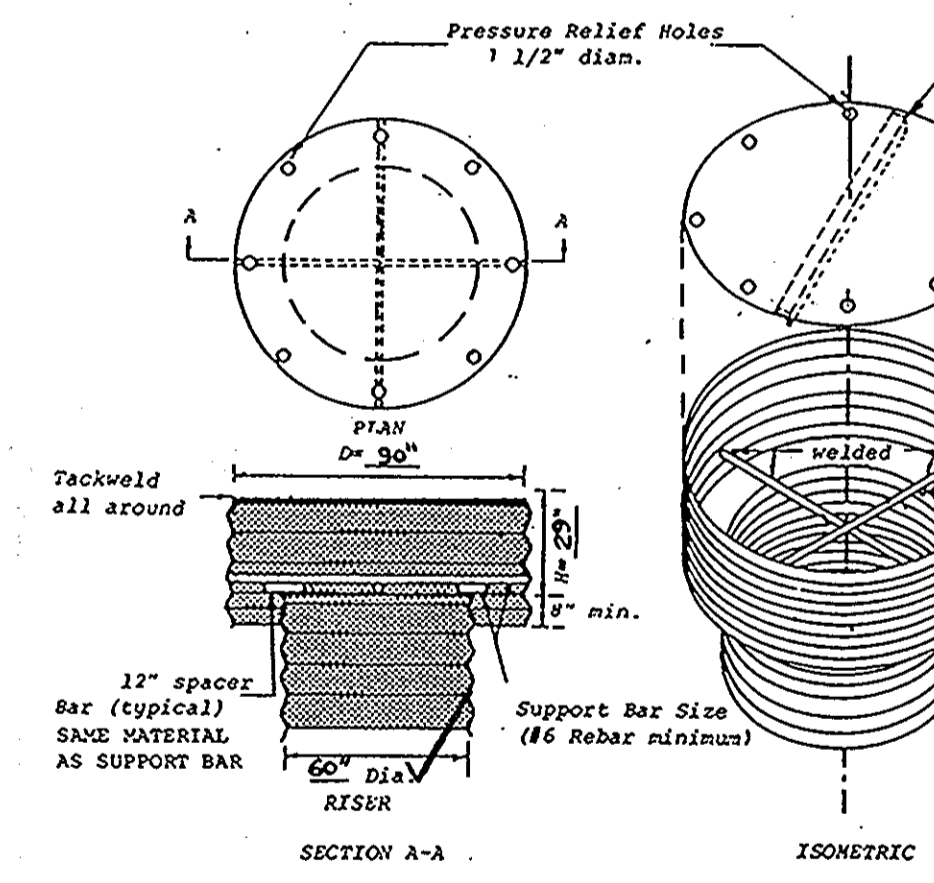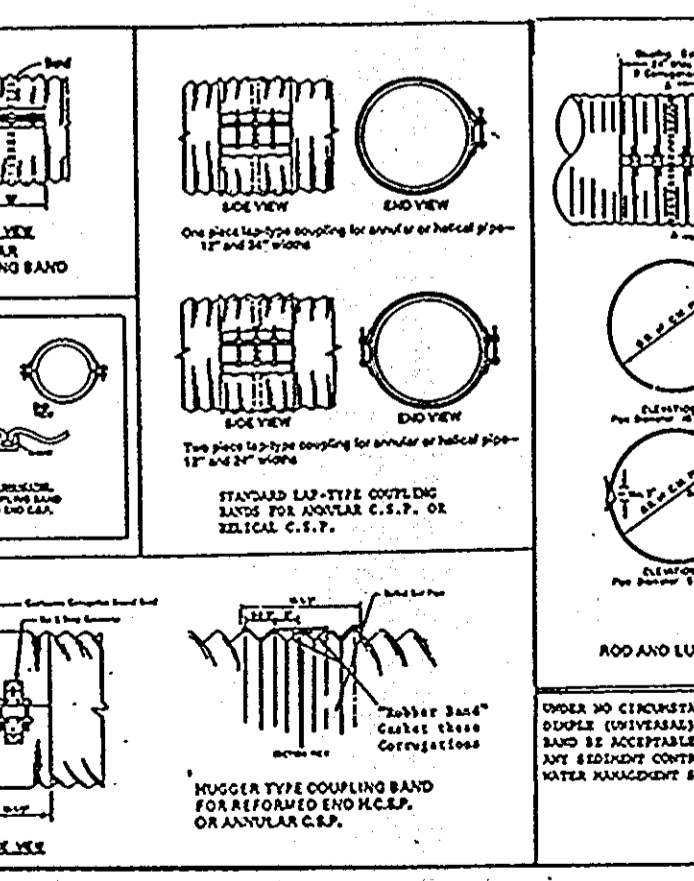

**CONCENTRIC TRASH RACK AND ANTI-VORTEX DEVICE**  
(not to scale)

**DEVELOPER'S CERTIFICATE**  
"I/We certify that all development and construction will be done according to this plan of development and plan for erosion and sediment control and that all responsible personnel involved in the construction project will have a certificate of attendance at a Department of Natural Resources Approved Training Program for the Control of Sediment and Erosion before beginning the project. I also advise periodic on-site inspection by the Howard Soil Conservation District or their authorized agents, as are required."   
Signature of Developer: [Signature] DATE: 4/2/90

**ENGINEER'S CERTIFICATE**  
I HEREBY CERTIFY THAT THIS PLAN FOR EROSION AND SEDIMENT CONTROL REPRESENTS A PRACTICAL AND WORKABLE PLAN BASED ON MY PERSONAL KNOWLEDGE OF THE SITE CONDITIONS AND THAT IT WAS PREPARED IN ACCORDANCE WITH THE REQUIREMENTS OF THE HOWARD SOIL CONSERVATION DISTRICT.   
Signature of Engineer: [Signature] DATE: 4/1/90

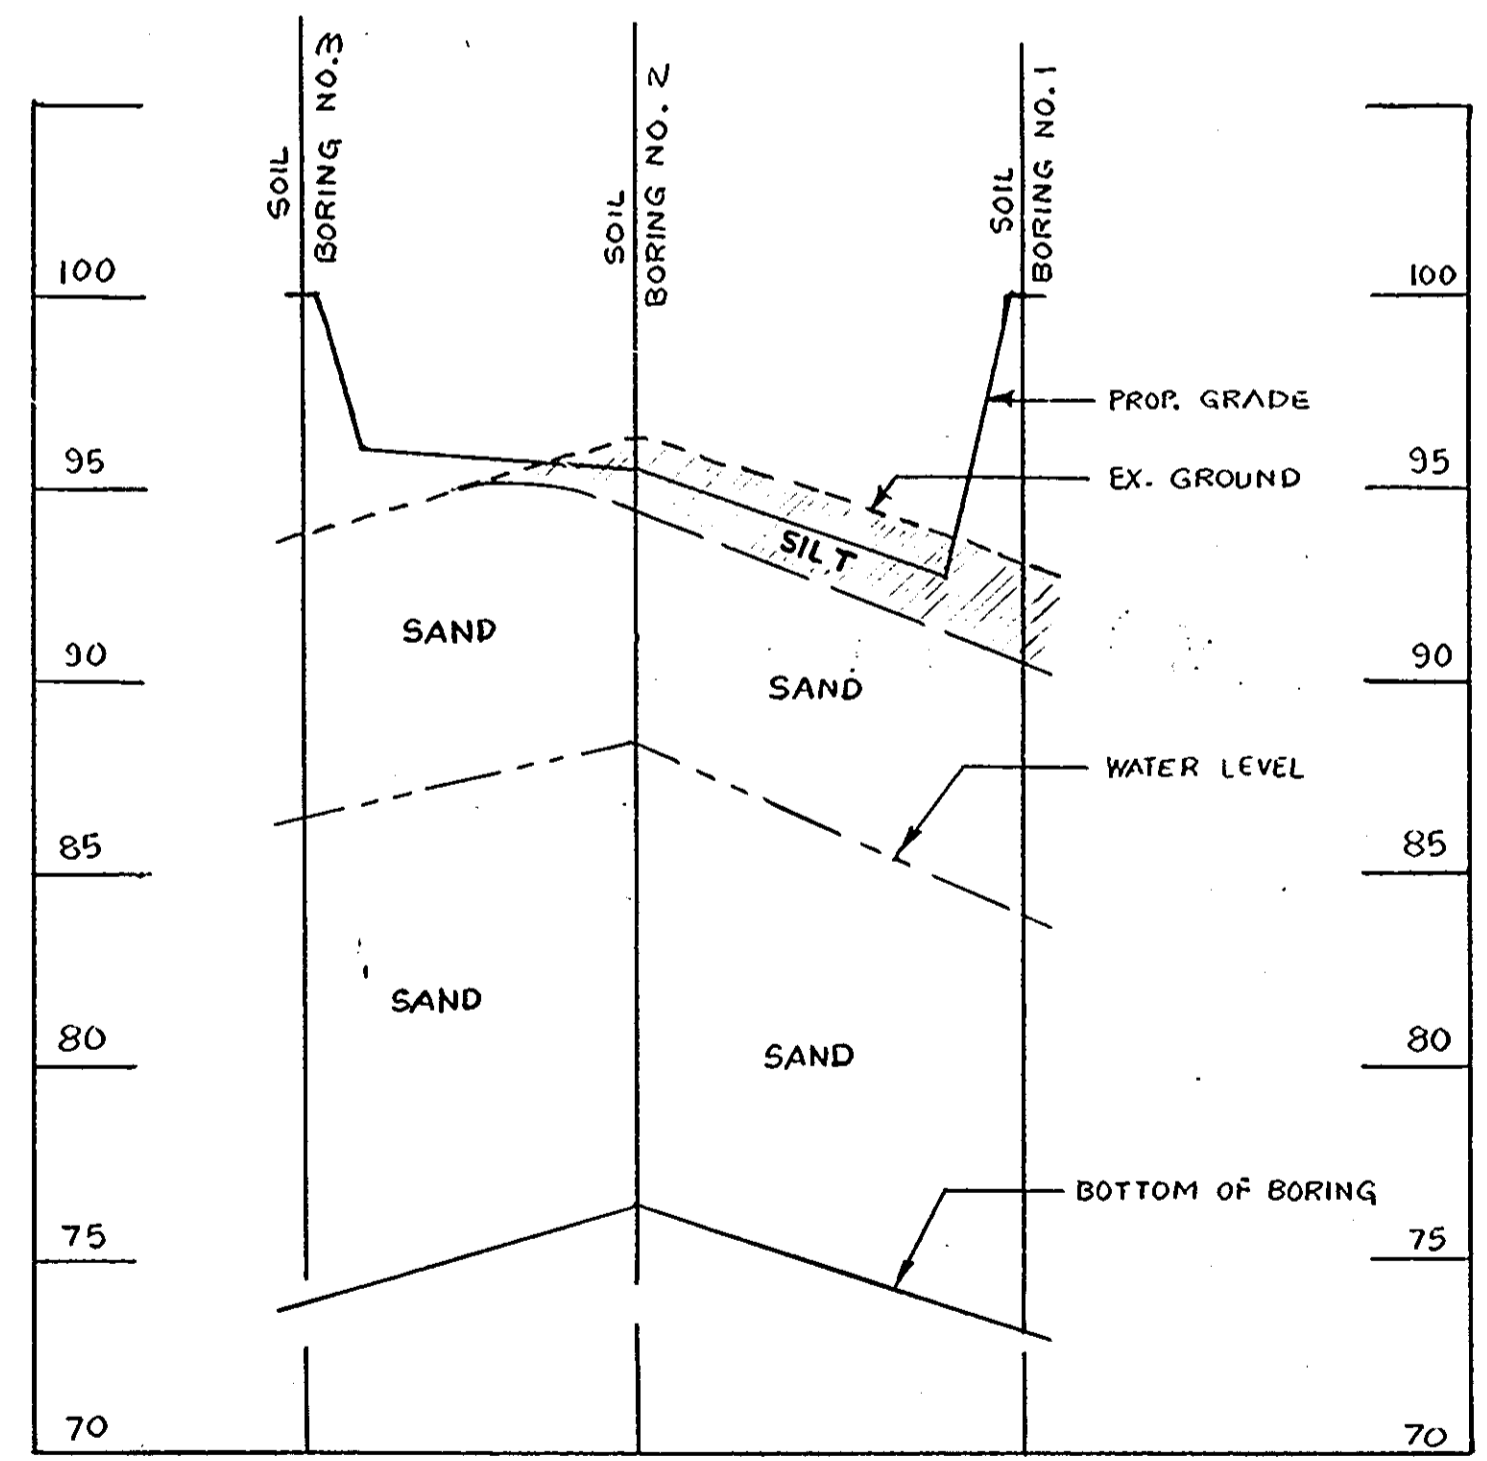

**SOIL BORING PROFILE**  
SCALE: HORIZONTAL = 1" = 50'  
VERT. 1" = 5'

APPROVED: FOR PUBLIC WATER AND PUBLIC SEWERAGE SYSTEMS,  
HOWARD COUNTY HEALTH DEPARTMENT  
Signature: [Signature] DATE: 3-21-90  
COUNTY HEALTH OFFICER

APPROVED: HOWARD COUNTY DEPARTMENT OF PLANNING AND ZONING  
Signature: [Signature] DATE: 4-2-90  
DIRECTOR

APPROVED: FOR PUBLIC WATER AND PUBLIC SEWERAGE, STORM  
DRAINAGE SYSTEMS AND PUBLIC ROADS HOWARD  
COUNTY DEPARTMENT OF PUBLIC WORKS  
Signature: [Signature] DATE: 3/20/90  
DIRECTOR

REVIEWED FOR HOWARD COUNTY SOIL CONSERVATION  
DISTRICT AND MEETS TECHNICAL REQUIREMENTS.  
Signature: [Signature] DATE: 2-13-90  
S. Soil Conservation Service

HIS DEVELOPMENT IS APPROVED FOR EROSION AND SEDIMENT CONTROL BY THE  
HOWARD SOIL CONSERVATION DISTRICT  
Signature: [Signature] DATE: 2-13-90  
Howard Soil Conservation District

**SEDIMENT CONTROL & POND CONSTRUCTION**

( ) By the Developer:  
"I/We certify that all development and/or construction will be done according to these plans, and that any responsible personnel involved in the construction project will have a Certificate of Attendance at a Department of Natural Resources Approved Training Program for the Control of Sediment and Erosion before beginning the project. I will provide the Howard Soil Conservation District with an "as-built" plan of the pond within 30 days of completion. I also advise periodic on-site inspections by the Howard Soil Conservation District."  
Signature of Developer: [Signature] DATE: 4/2/90  
Print name below signature

( ) By the Engineer:  
"I certify that this plan for pond construction, erosion and sediment control represents a practical and workable plan based on my personal knowledge of the site conditions. This plan was prepared in accordance with the requirements of the Howard Soil Conservation District. I have notified the developer that he must provide the Howard Soil Conservation District with an "as-built" plan of the pond within 30 days of completion."  
Signature of Engineer: [Signature] DATE: 2/13/90  
Print name below signature  
D. KATHURIA

( ) These plans for small pond construction, soil erosion and sediment control meet the requirements of the Howard Soil Conservation District.  
Signature: [Signature] DATE: 2-13-90  
Howard Soil Conservation District


**SITE DEVELOPMENT PLAN FOR GRADING AND STORMWATER MANAGEMENT**

REVISIONS			
DESIGNED	DATE	BY	DESCRIPTION
DRAWN	5/89	MCR	As-Built
CHECKED			
APPROVED			

**ENGINEERING TECHNOLOGIES ASSOCIATES, INC.**  
ENGINEERS, PLANNERS, SURVEYORS  
3458 ELLICOTT CENTER DRIVE SUITE 101  
ELLICOTT CITY, MD. 21043  
(301) 461-9920


**OWNER / DEVELOPER**  
HI-TECH VENTURE LIMITED PARTNERSHIP  
7223 PARKWAY DRIVE  
HANOVER, MARYLAND 21076  
(301) 796-4446

**PARCEL 'F' INTERIM POND NO.1 DETAILS**  
**PARKWAY CENTER SECTION I**  
PARCELS 'E', 'F', and 'G'  
AND OUT PARCEL (1565/469)  
1st ELECTION DISTRICT 7M 36444 HOWARD COUNTY, MARYLAND  
SCALE: AS SHOWN CONTRACT NO. DATE: 5/89 SHEET: 4 OF 8  
SDP-89-275

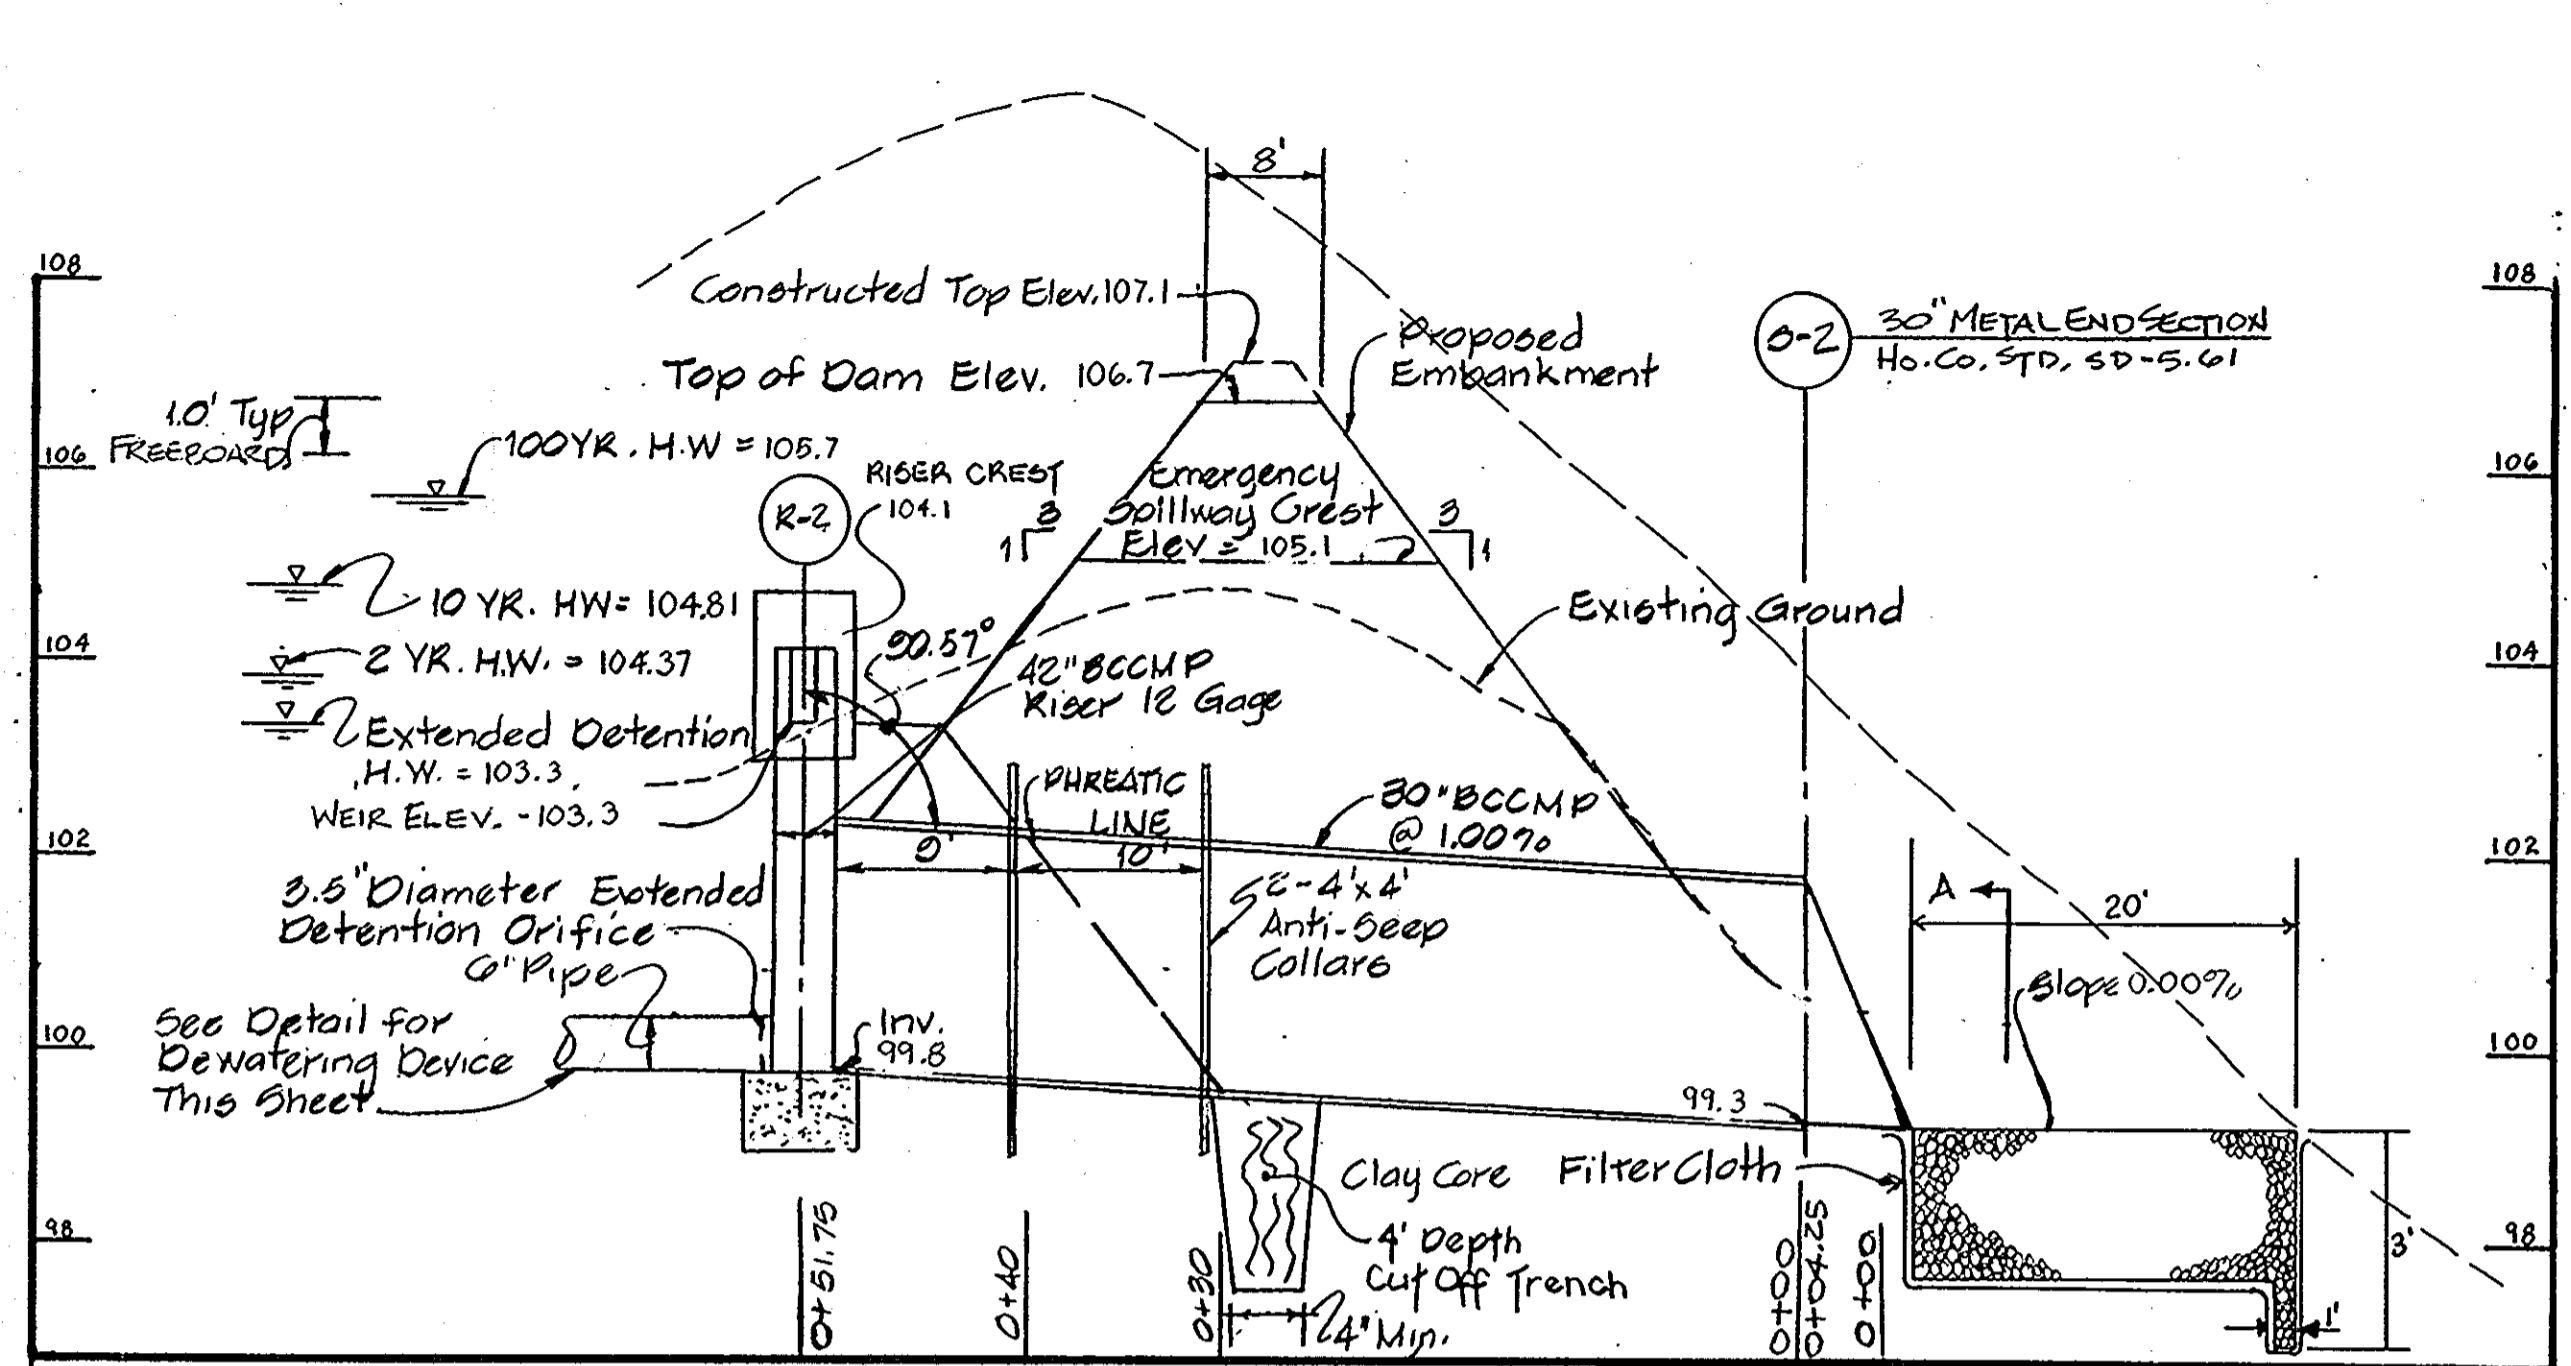


**CROSS-SECTION THRU DAM NO. 2**

Scale: Horizontal = 1" = 10'  
Vertical = 1" = 2'

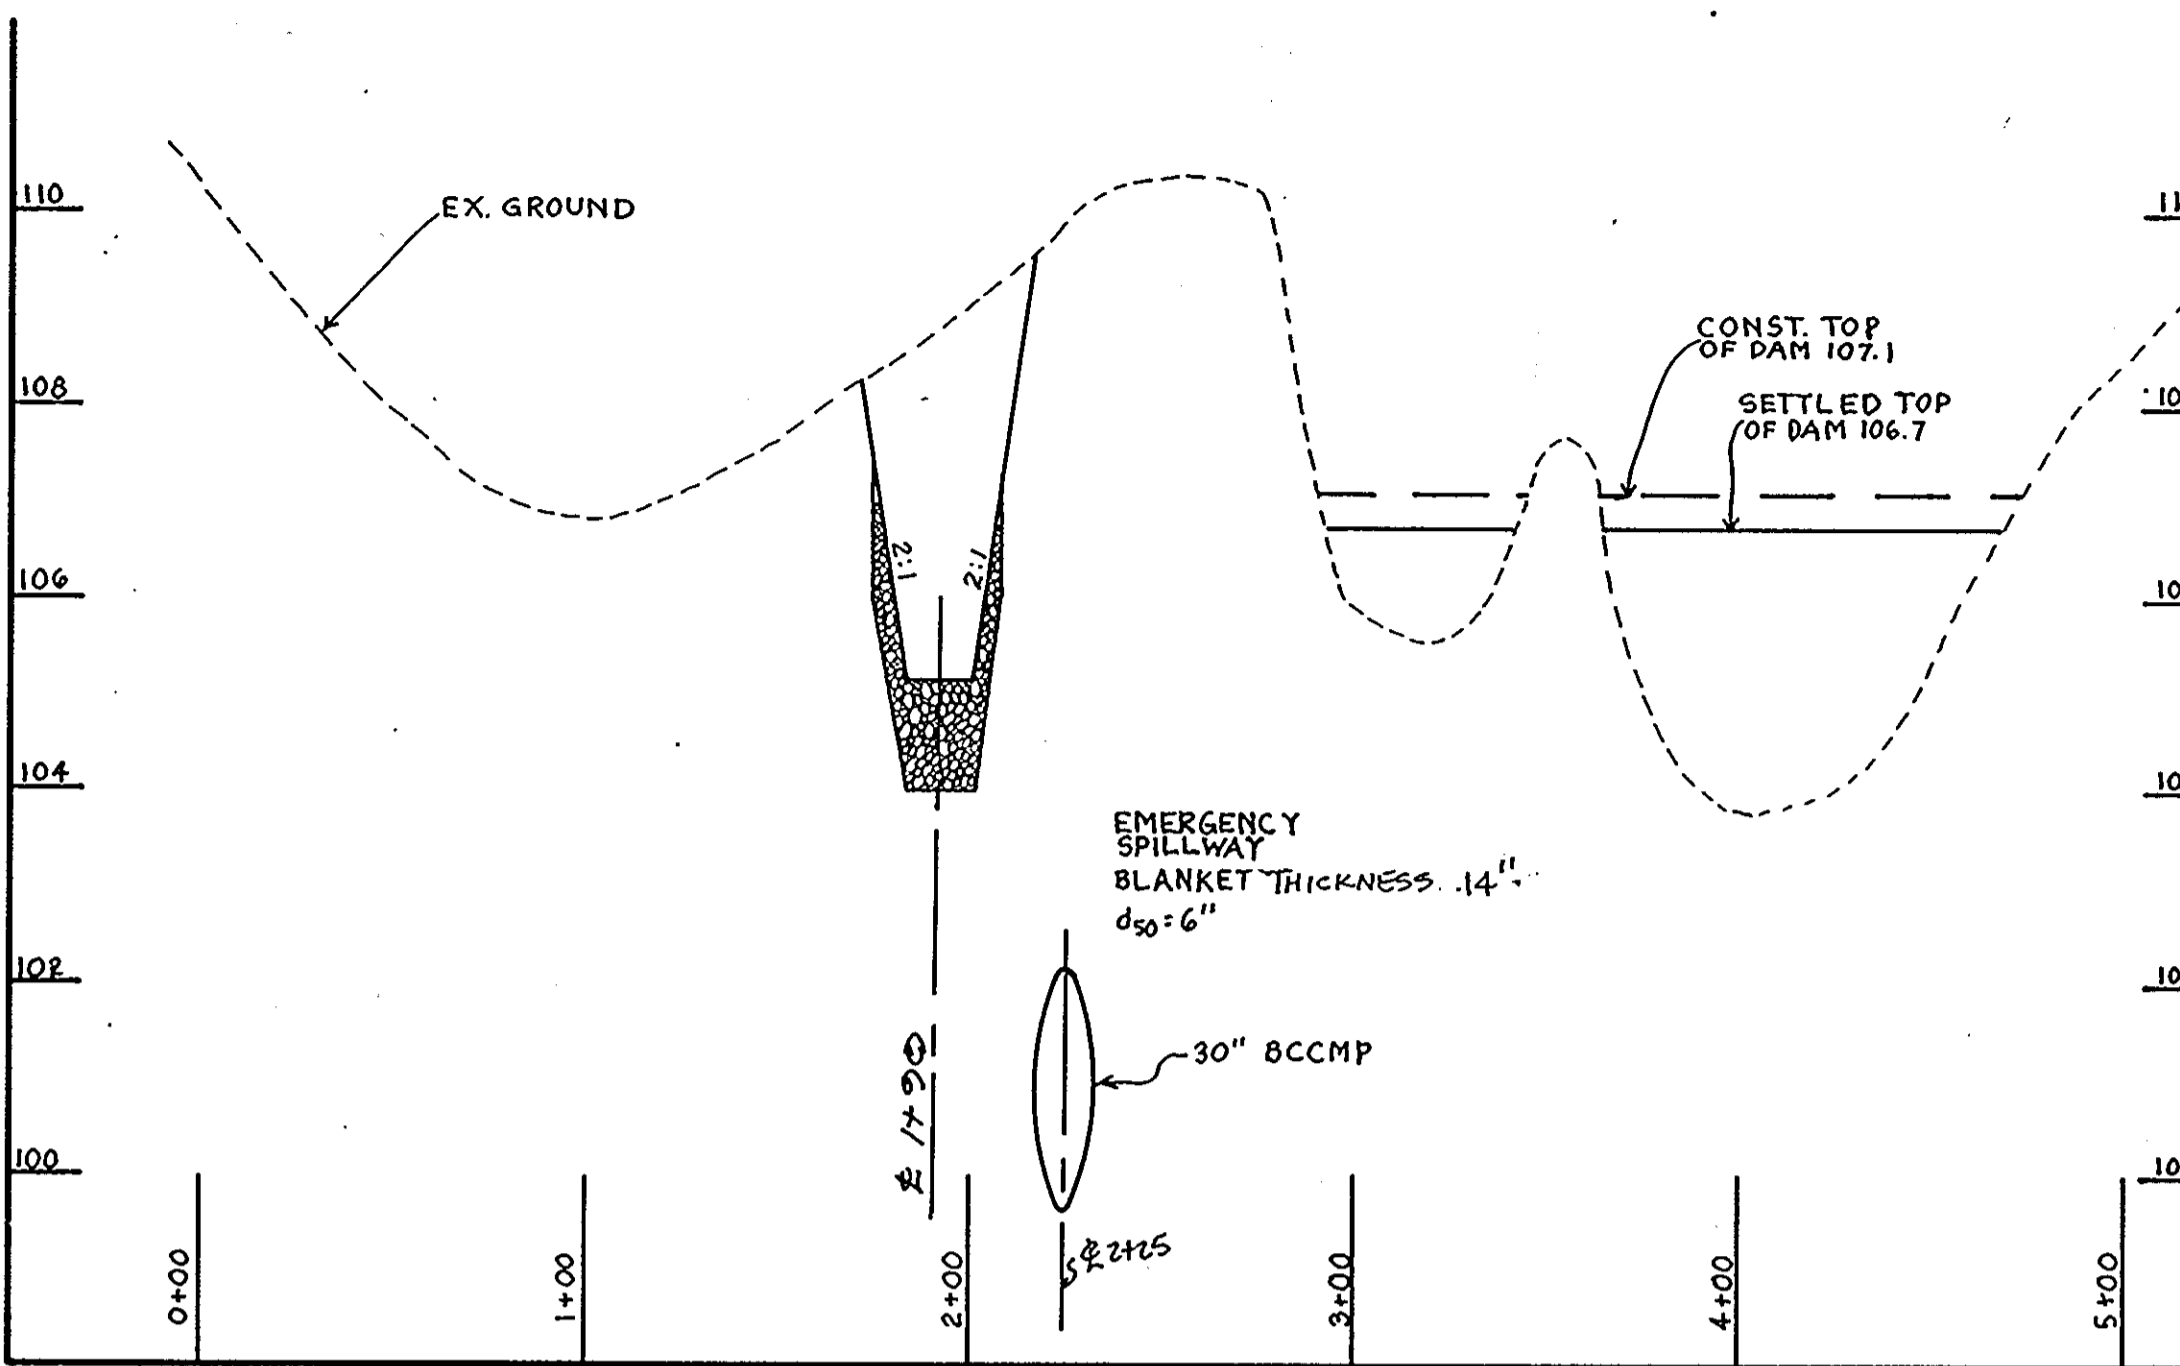


**PROFILE ALONG DAM NO. 2**


SCALE: HOR 1" = 50'  
VER 1" = 2'

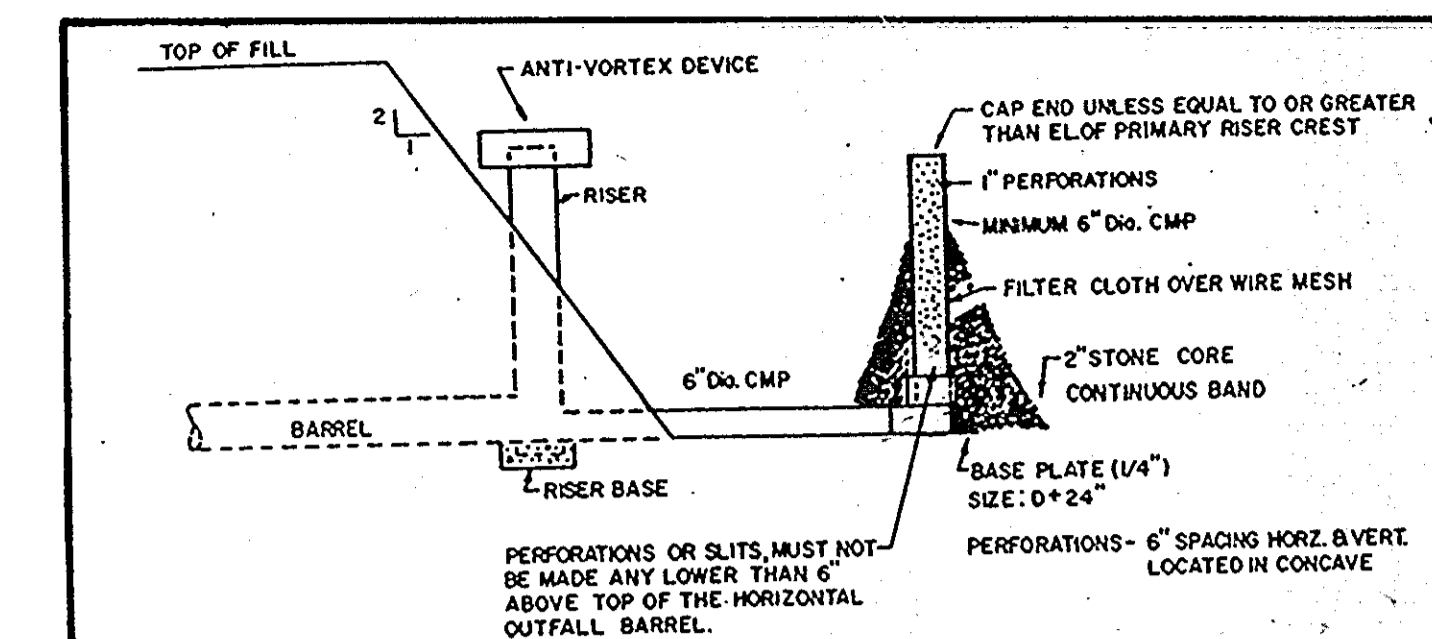

**SEDIMENT BASIN DENATURING DEVICE WITH 6\"/>**

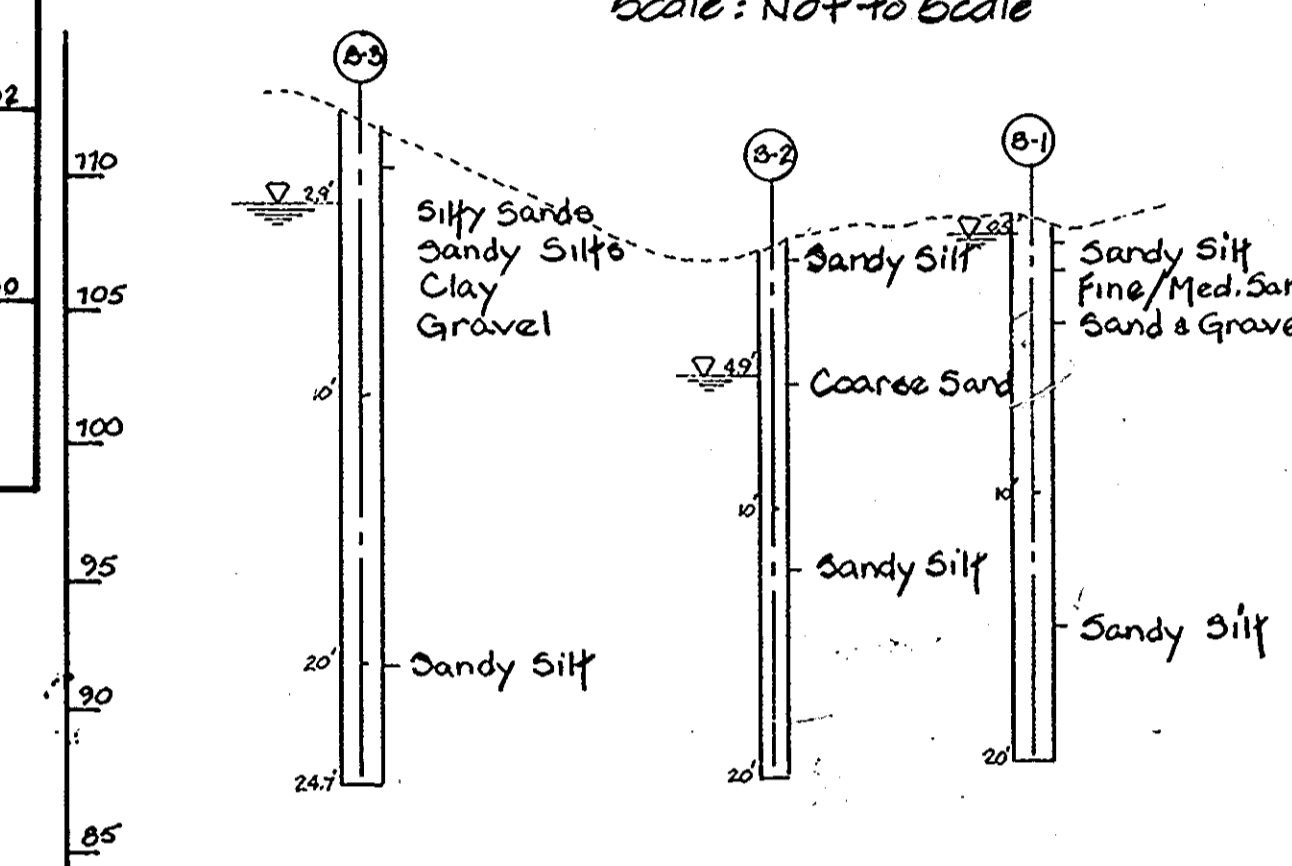


**BORING PROFILE POND NO. 2**  
NOT TO SCALE

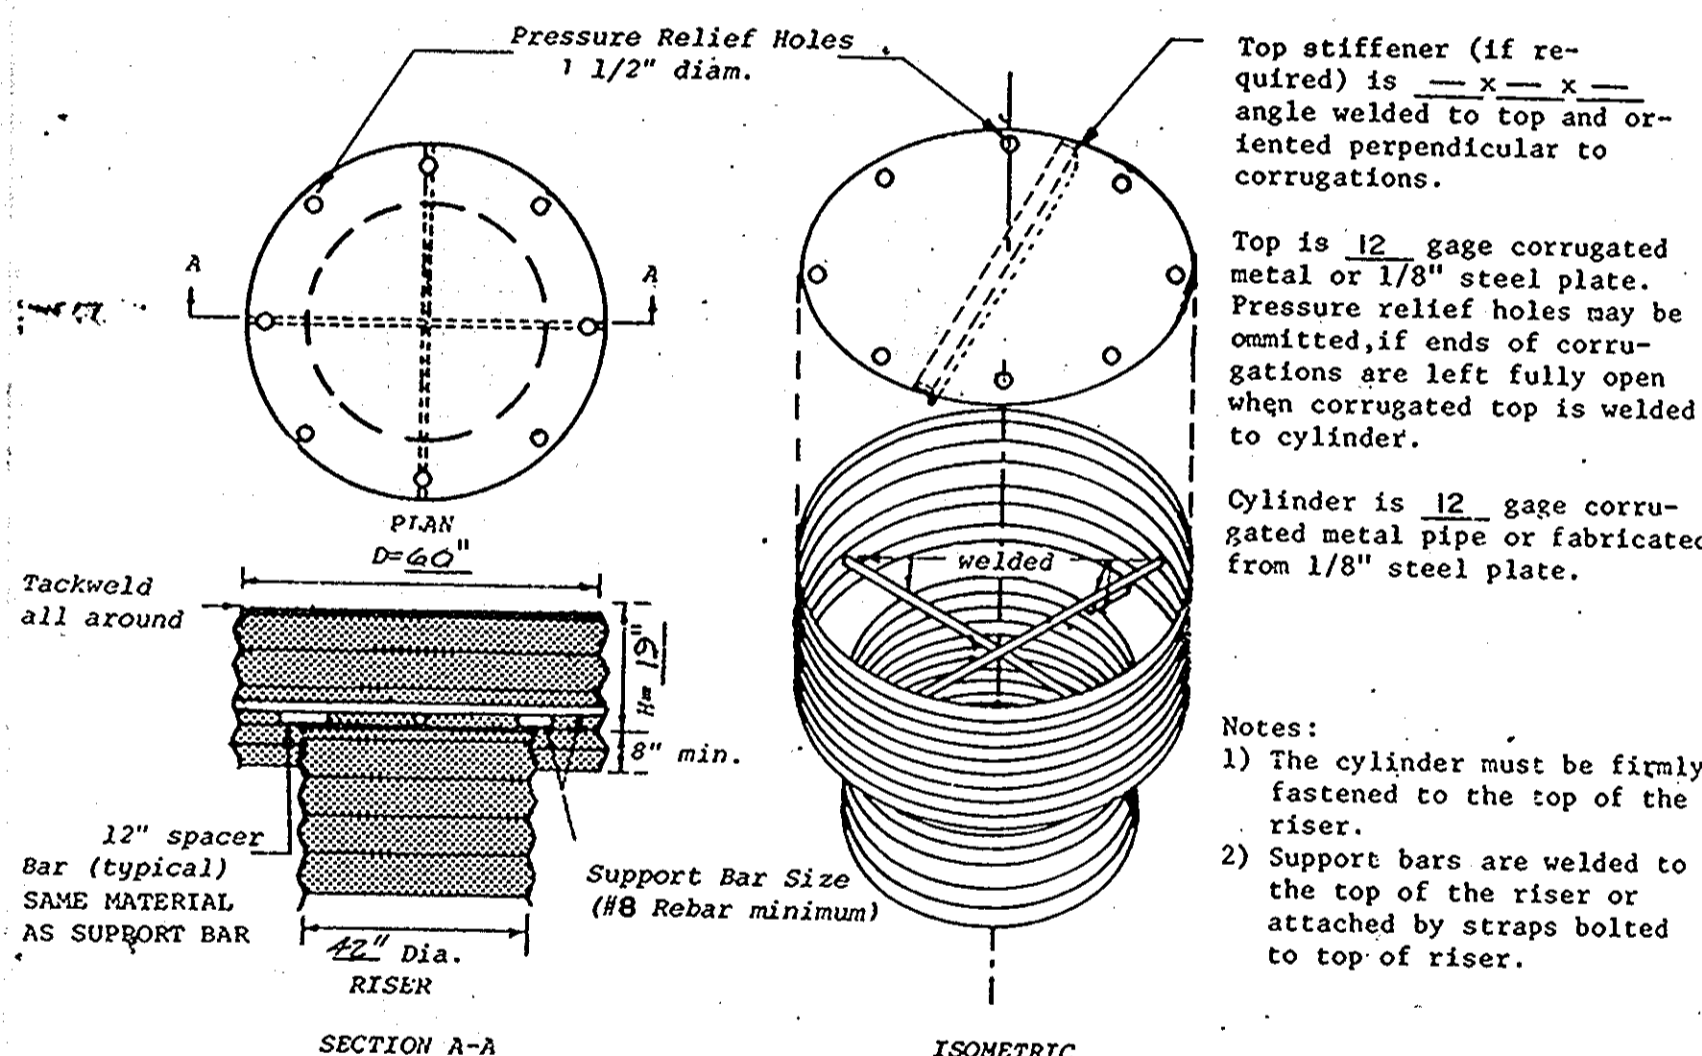


**CONCENTRIC TRASH RACK AND ANTI-VORTEX DEVICE POND NO. 2**

NOT TO SCALE

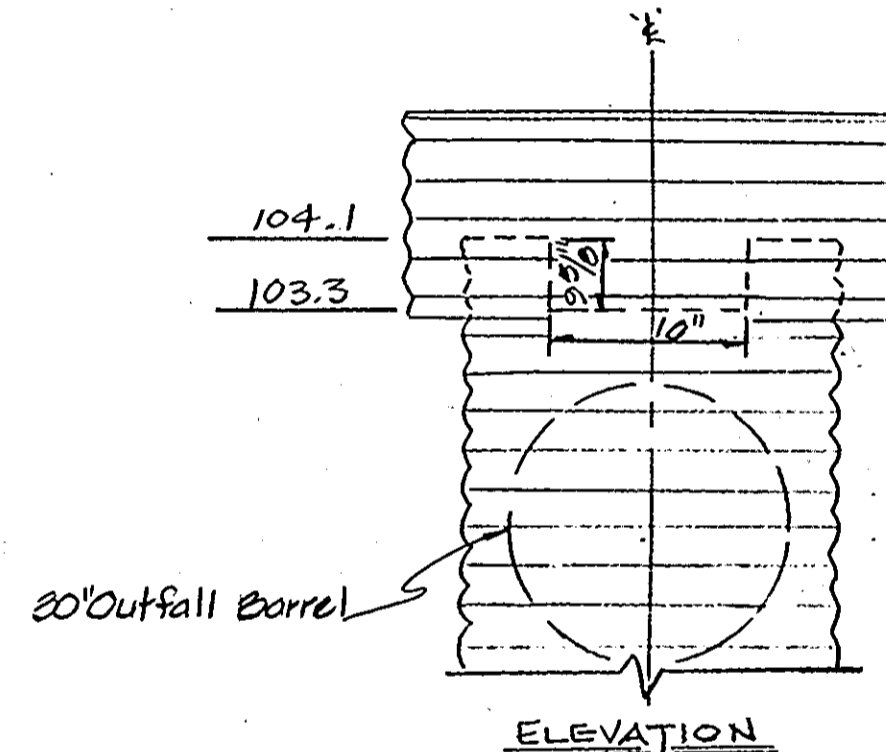


**ELEVATION**

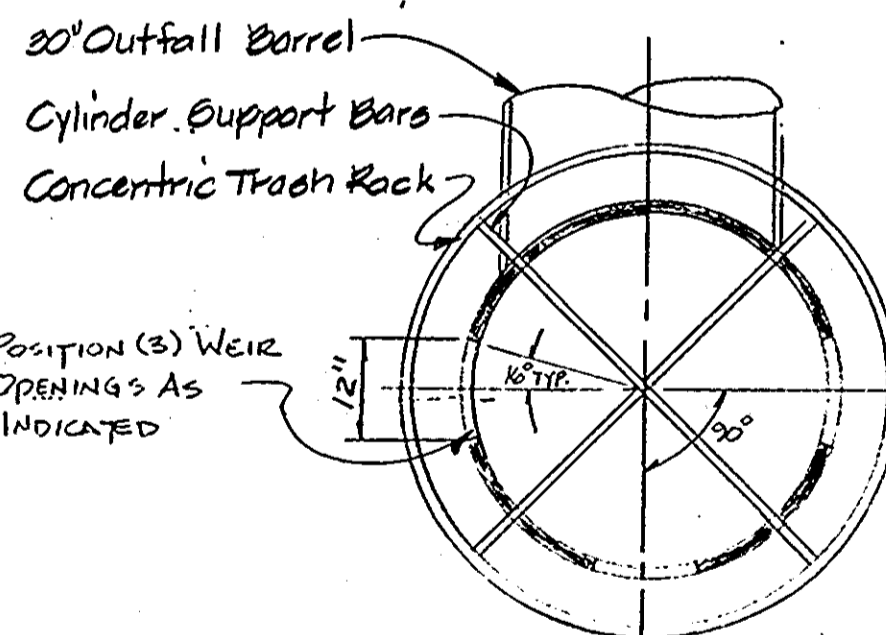

**TOP VIEW**

**MODIFIED RISER DETAIL POND NO. 2**

NTS

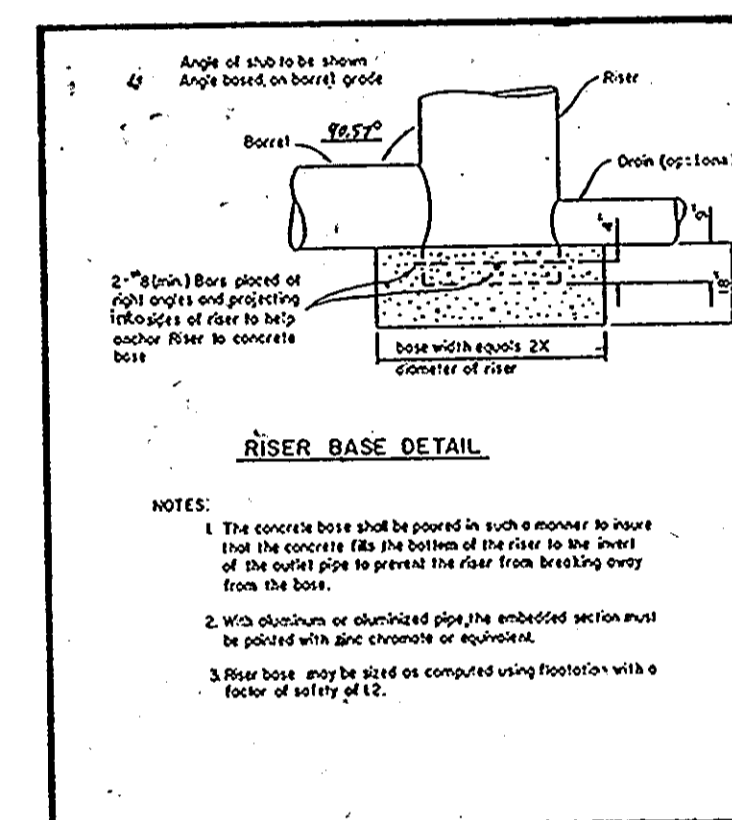

**RISER DETAIL**  
NOT TO SCALE

APPROVED FOR PUBLIC WATER AND PUBLIC SEWERAGE SYSTEMS, HOWARD COUNTY HEALTH DEPARTMENT  
 COUNTY HEALTH OFFICER *[Signature]* DATE 2-11-90

APPROVED HOWARD COUNTY DEPARTMENT OF PLANNING AND ZONING  
 CHIEF DIVISION OF COMMUNITY PLANNING AND LAND DEVELOPMENT  
 DATE 2-11-90

APPROVED FOR PUBLIC WATER AND PUBLIC SEWERAGE, STORM DRAINAGE SYSTEMS AND PUBLIC ROADS HOWARD COUNTY DEPARTMENT OF PUBLIC WORKS  
 DIRECTOR *[Signature]* DATE 2-22-90  
 CHIEF BUREAU OF ENGINEERING *[Signature]* DATE 2-22-90

Howard County Signature Block

**APPROVED**  
 DIVISION OF  
 COMMUNITY PLANNING  
 & LAND DEVELOPMENT  
 HOWARD COUNTY,  
 MARYLAND  
 DATE \_\_\_\_\_

**DEVELOPER'S CERTIFICATE**  
 I HEREBY CERTIFY THAT ALL DEVELOPMENT AND CONSTRUCTION WILL BE DONE ACCORDING TO THIS PLAN OF DEVELOPMENT AND PLAN FOR EROSION AND SEDIMENT CONTROL AND THAT ALL RESPONSIBLE PERSONNEL INVOLVED IN THE CONSTRUCTION PROJECT WILL HAVE A CERTIFICATE OF ATTENDANCE AT A DEPARTMENT OF NATURAL RESOURCES APPROVED TRAINING PROGRAM FOR THE CONTROL OF SEDIMENT AND EROSION BEFORE BEGINNING THE PROJECT. I ALSO AUTHORIZE PERIODIC ON-SITE INSPECTION BY THE HOWARD SOIL CONSERVATION DISTRICT OR THEIR AUTHORIZED AGENTS, AS AND WHERE NECESSARY.

*[Signature]* DATE 2/22/90

**ENGINEER'S CERTIFICATE**  
 I HEREBY CERTIFY THAT THIS PLAN FOR EROSION AND SEDIMENT CONTROL REPRESENTS A PRACTICAL AND WORKABLE PLAN BASED ON MY PERSONAL KNOWLEDGE OF THE SITE CONDITIONS AND THAT IT WAS PREPARED IN ACCORDANCE WITH THE REQUIREMENTS OF THE HOWARD SOIL CONSERVATION DISTRICT.

*[Signature]* DATE 2/11/90

REVIEWED FOR HOWARD COUNTY SOIL CONSERVATION DISTRICT AND MEETS TECHNICAL REQUIREMENTS.  
 Soil Conservation Service  
*[Signature]* DATE 2-13-90

THIS DEVELOPMENT IS APPROVED FOR EROSION AND SEDIMENT CONTROL BY THE HOWARD SOIL CONSERVATION DISTRICT  
*[Signature]* DATE 2-13-90

SEDIMENT CONTROL & POND CONSTRUCTION

( ) By the Developer:  
 "I/We certify that all development and/or construction will be done according to these plans, and that any responsible personnel involved in the construction project will have a Certificate of Attendance at a Department of Natural Resources Approved Training Program for the Control of Sediment and Erosion before beginning the project. I will provide the Howard Soil Conservation District with an "as-built" plan of the pond within 30 days of completion. I also authorize periodic on-site inspections by the Howard Soil Conservation District."  
*[Signature]* DATE 2/13/90


( ) By the Engineer:  
 "I certify that this plan for pond construction, erosion and sediment control represents a practical and workable plan based on my personal knowledge of the site conditions. This plan was prepared in accordance with the requirements of the Howard Soil Conservation District. I have notified the developer that he must provide the Howard Soil Conservation District with an "as-built" plan of the pond within 30 days of completion."  
*[Signature]* DATE 2/13/90

( ) These plans have been reviewed for the Howard Soil Conservation District and meet the technical requirements for small pond construction, soil erosion and sediment control.  
*[Signature]* DATE 2-13-90

DESIGNED		DATE		REVISIONS	
DATE	BY	DATE	BY	DESCRIPTION	
5/89	KNC/SGP				

**ENGINEERING TECHNOLOGIES ASSOCIATES, INC.**

ENGINEERS, PLANNERS, SURVEYORS  
 3458 ELLICOTT CENTER DRIVE SUITE 101  
 ELLICOTT CITY, MD. 21043  
 (301) 461-9920

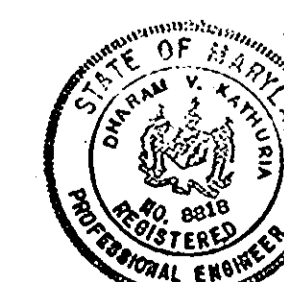

OWNER / DEVELOPER  
 HI-TECH VENTURE LIMITED PARTNERSHIP  
 7223 PARKWAY DRIVE  
 HANOVER, MARYLAND 21076  
 (301) 796-4446

**SITE DEVELOPMENT PLAN FOR GRADING AND STORMWATER MANAGEMENT**

PARCEL "G" INTERIM POND NO. 2 DETAILS








**PARKWAY CENTER SECTION I**

PARCELS 'E', 'F', and 'G' AND OUT PARCEL (1565/469)

1st ELECTION DISTRICT TM 30 & 44 HOWARD COUNTY, MARYLAND

SCALE: AS SHOWN CONTRACT NO. DATE: 2/89 SHEET 5 OF 8

SDP-89-275

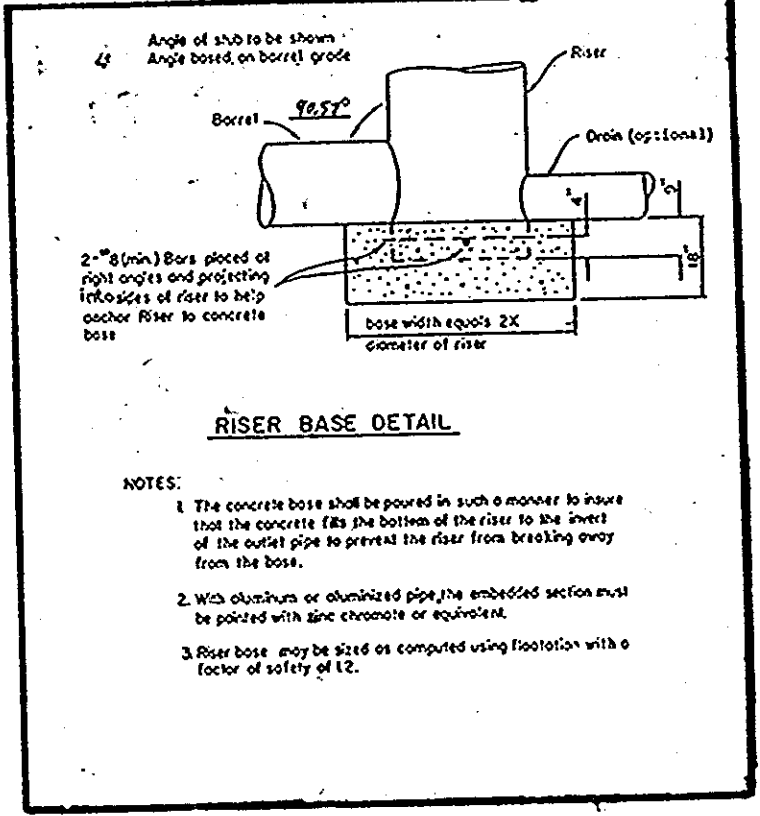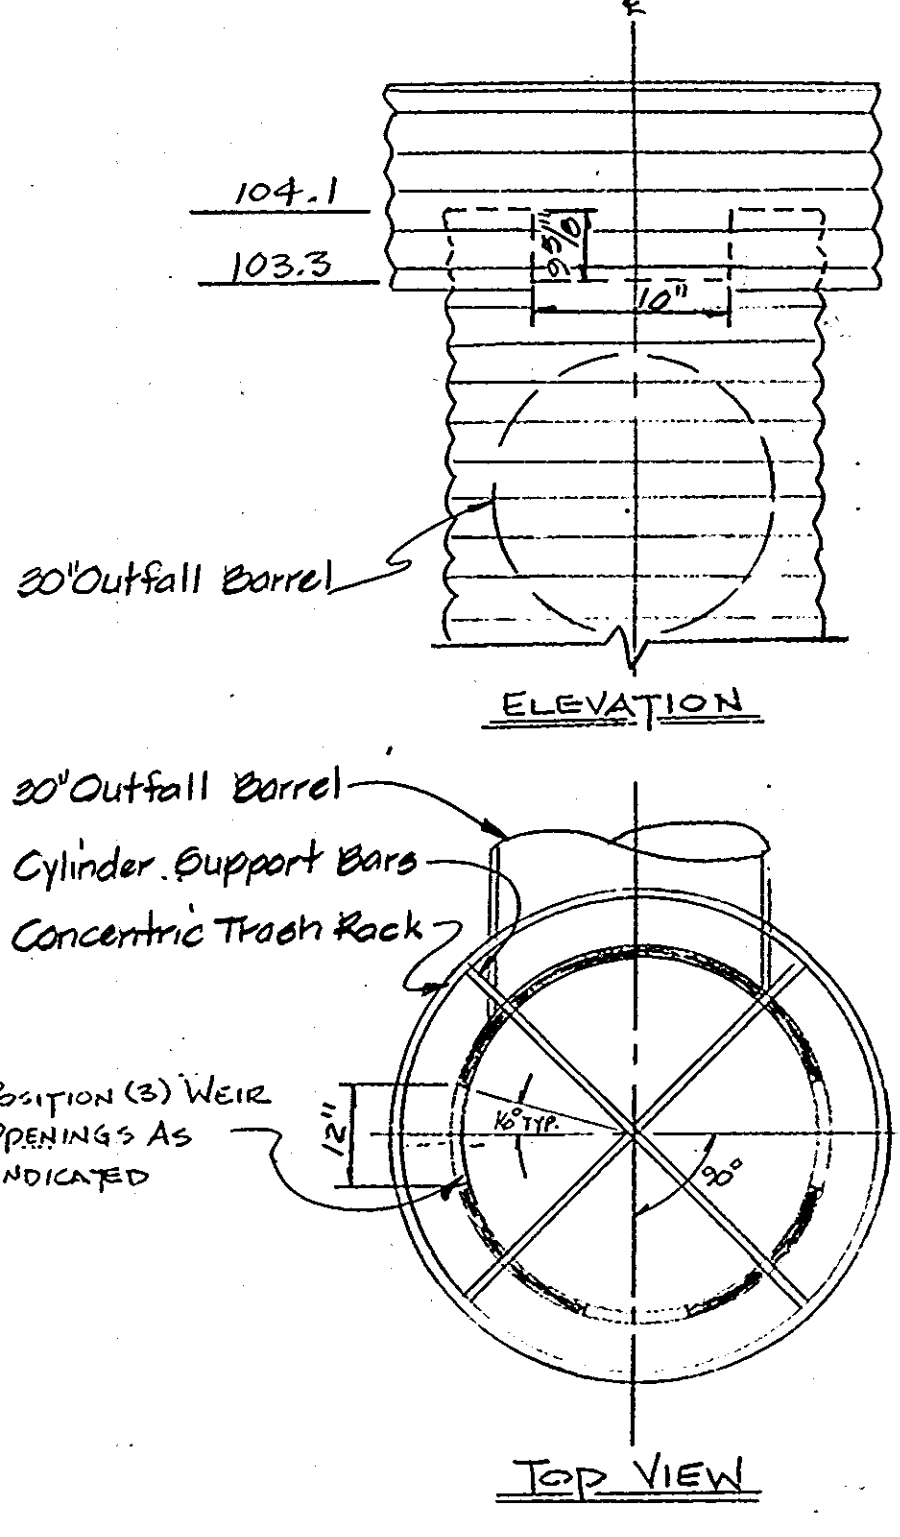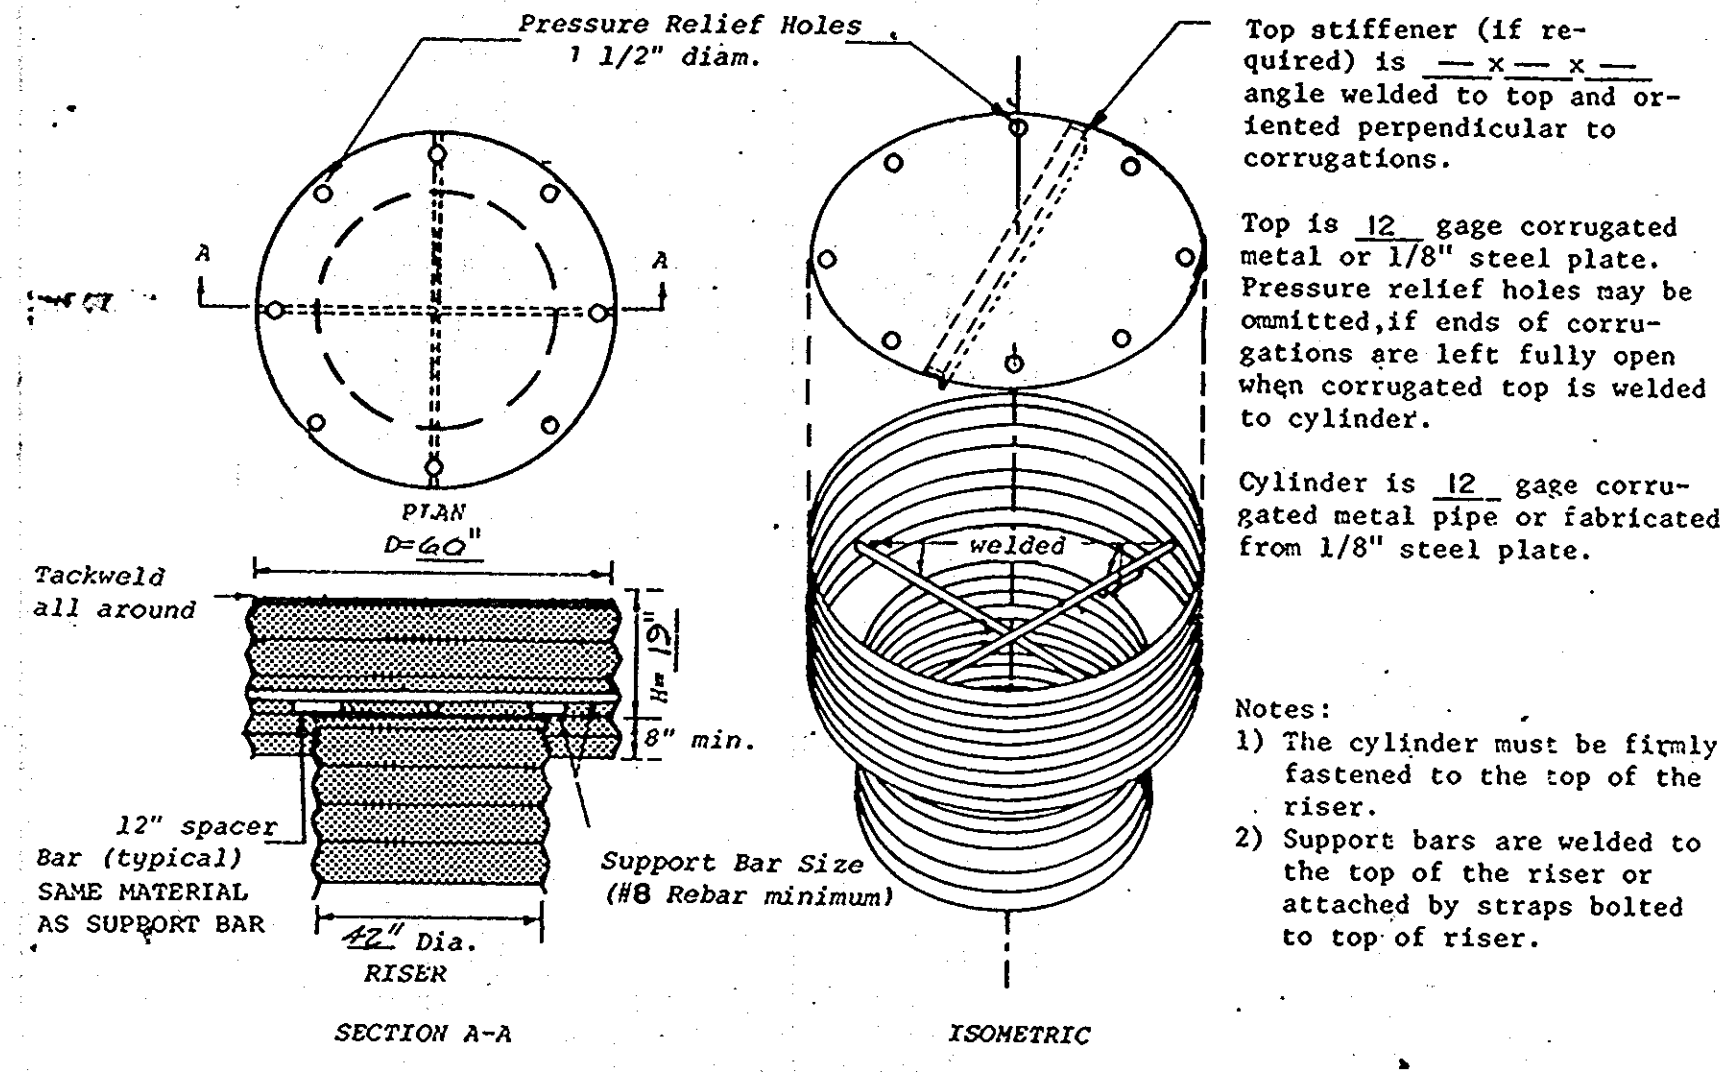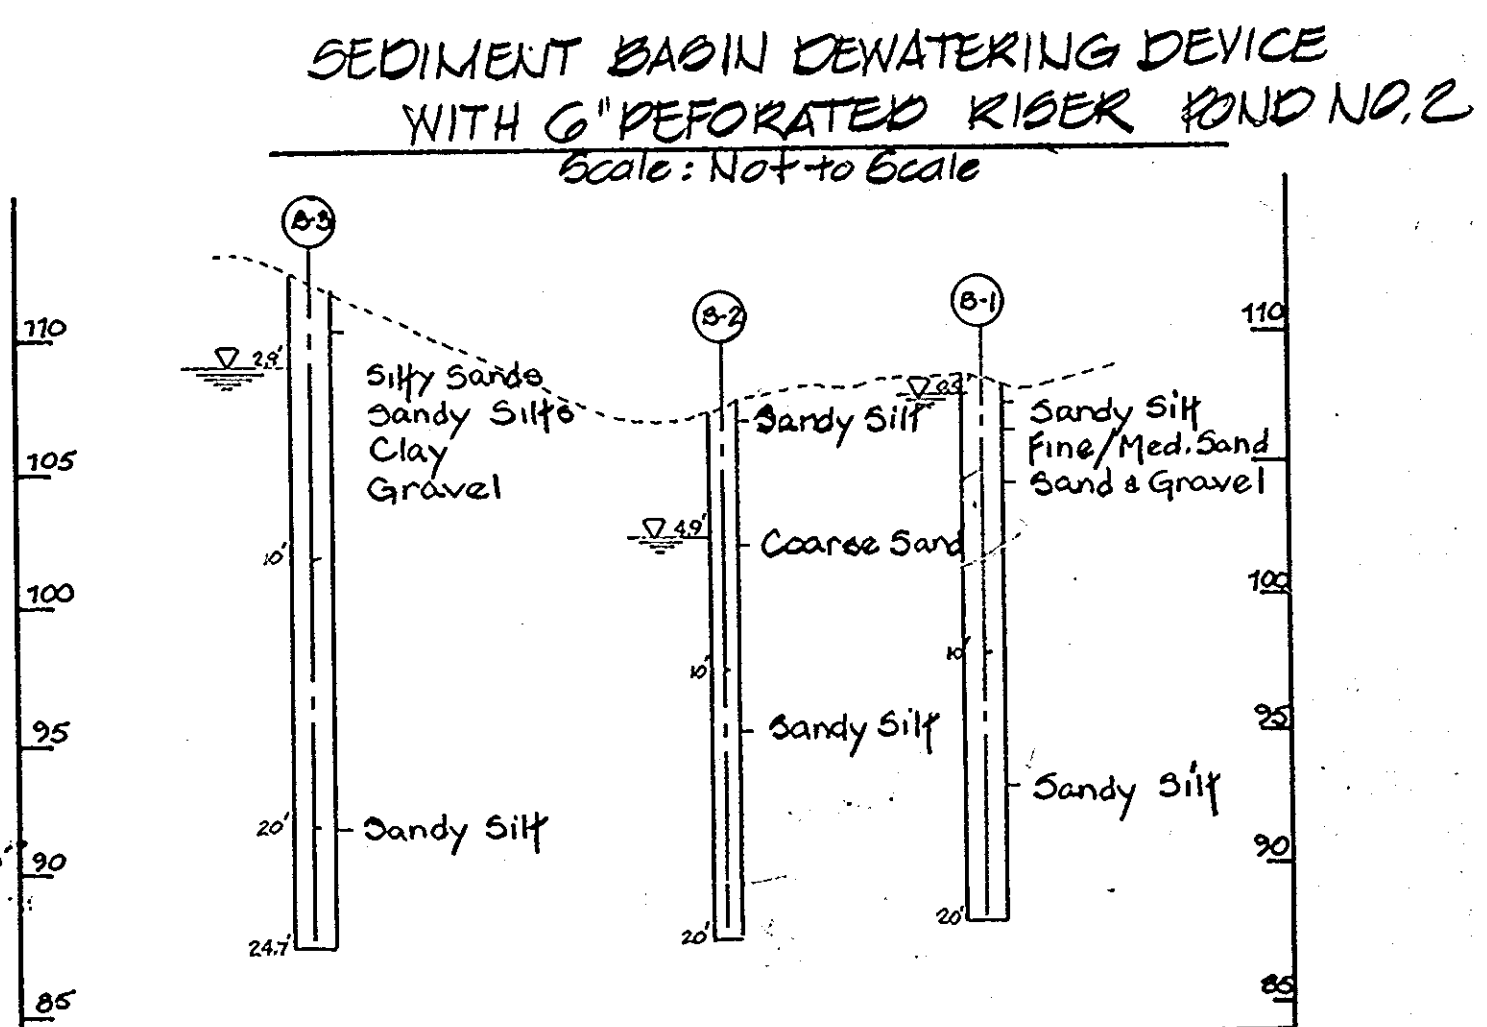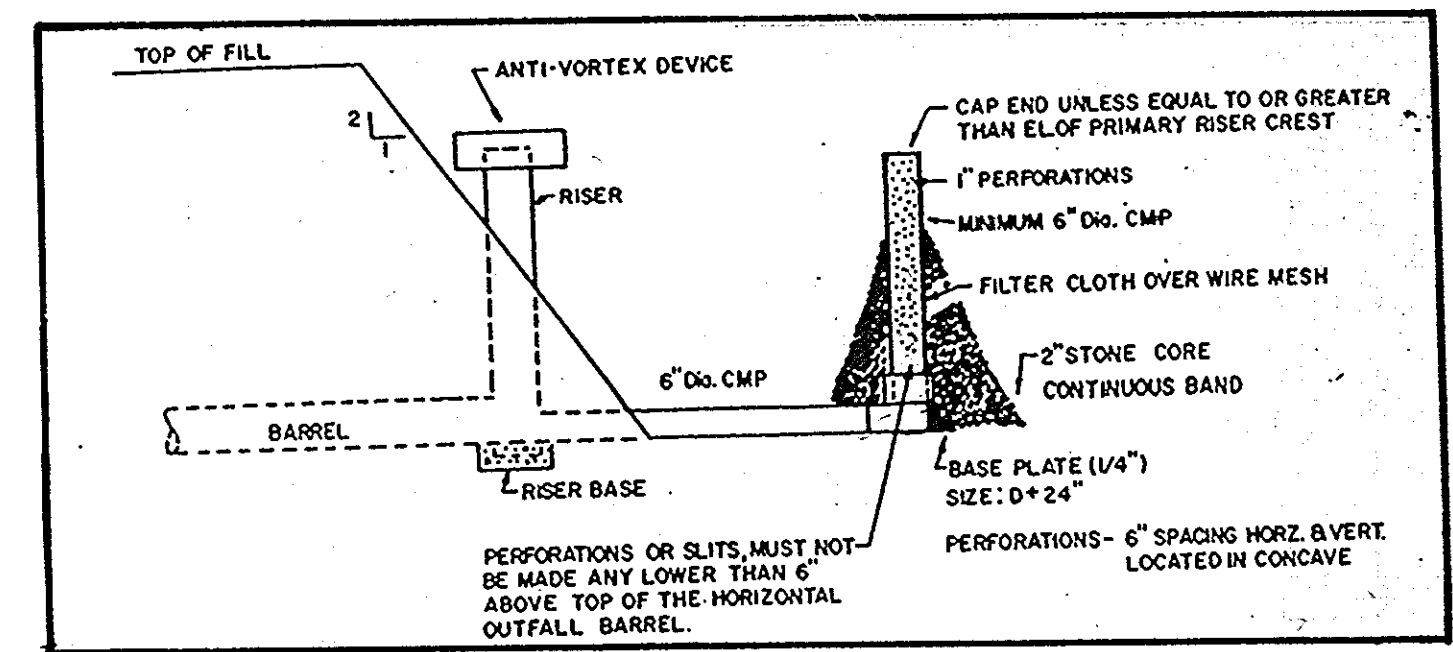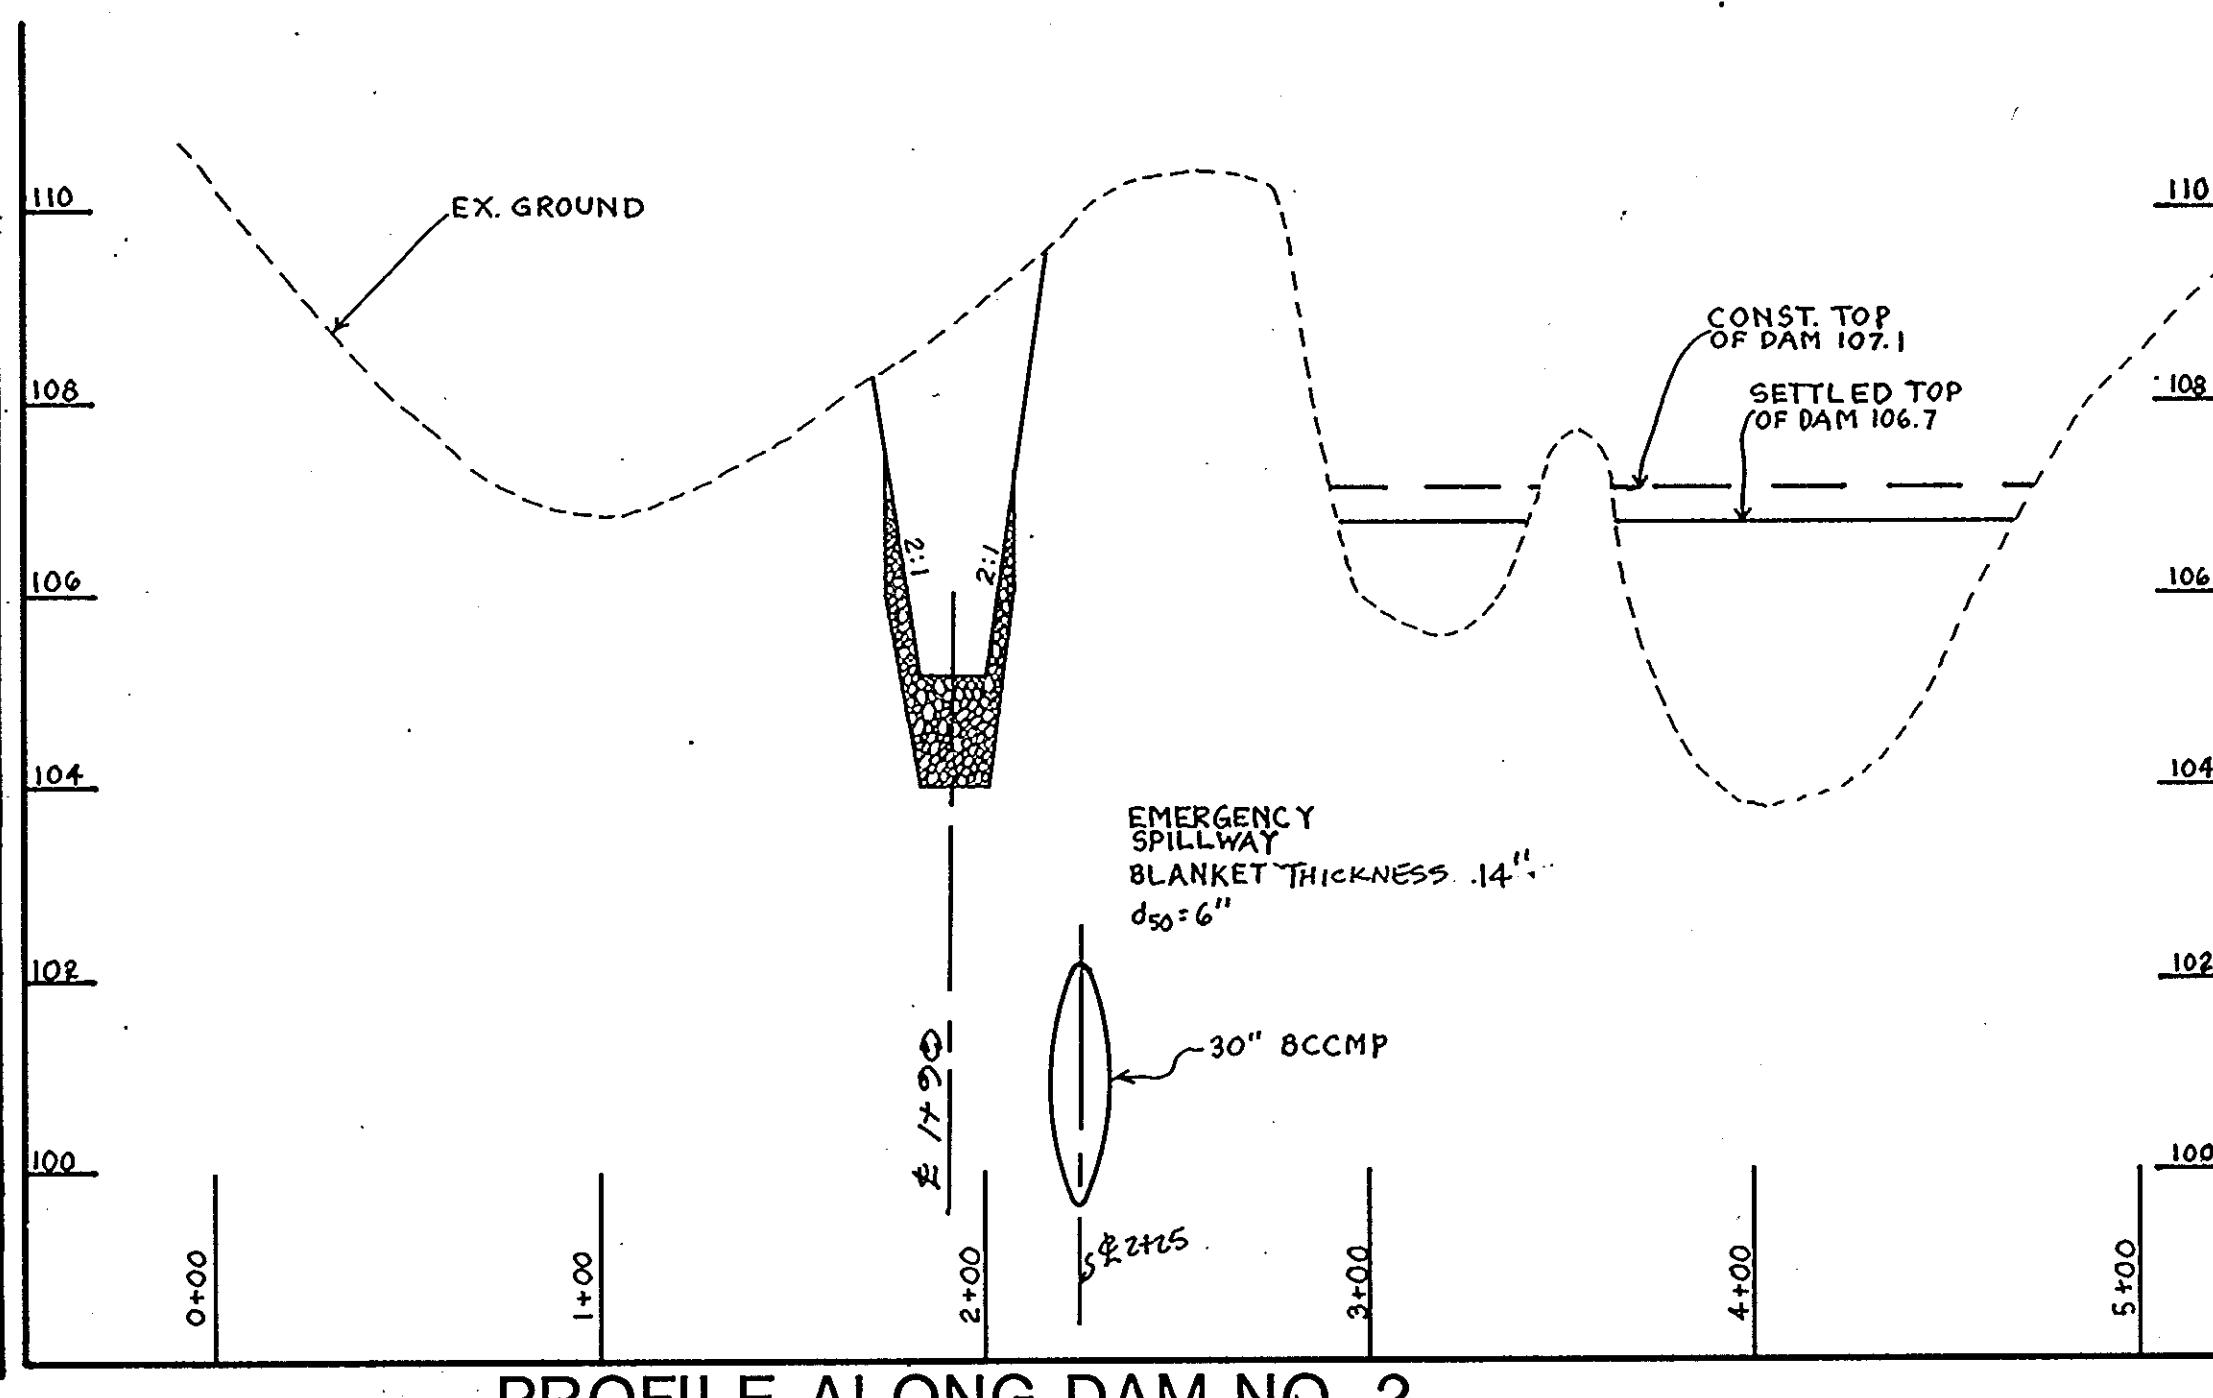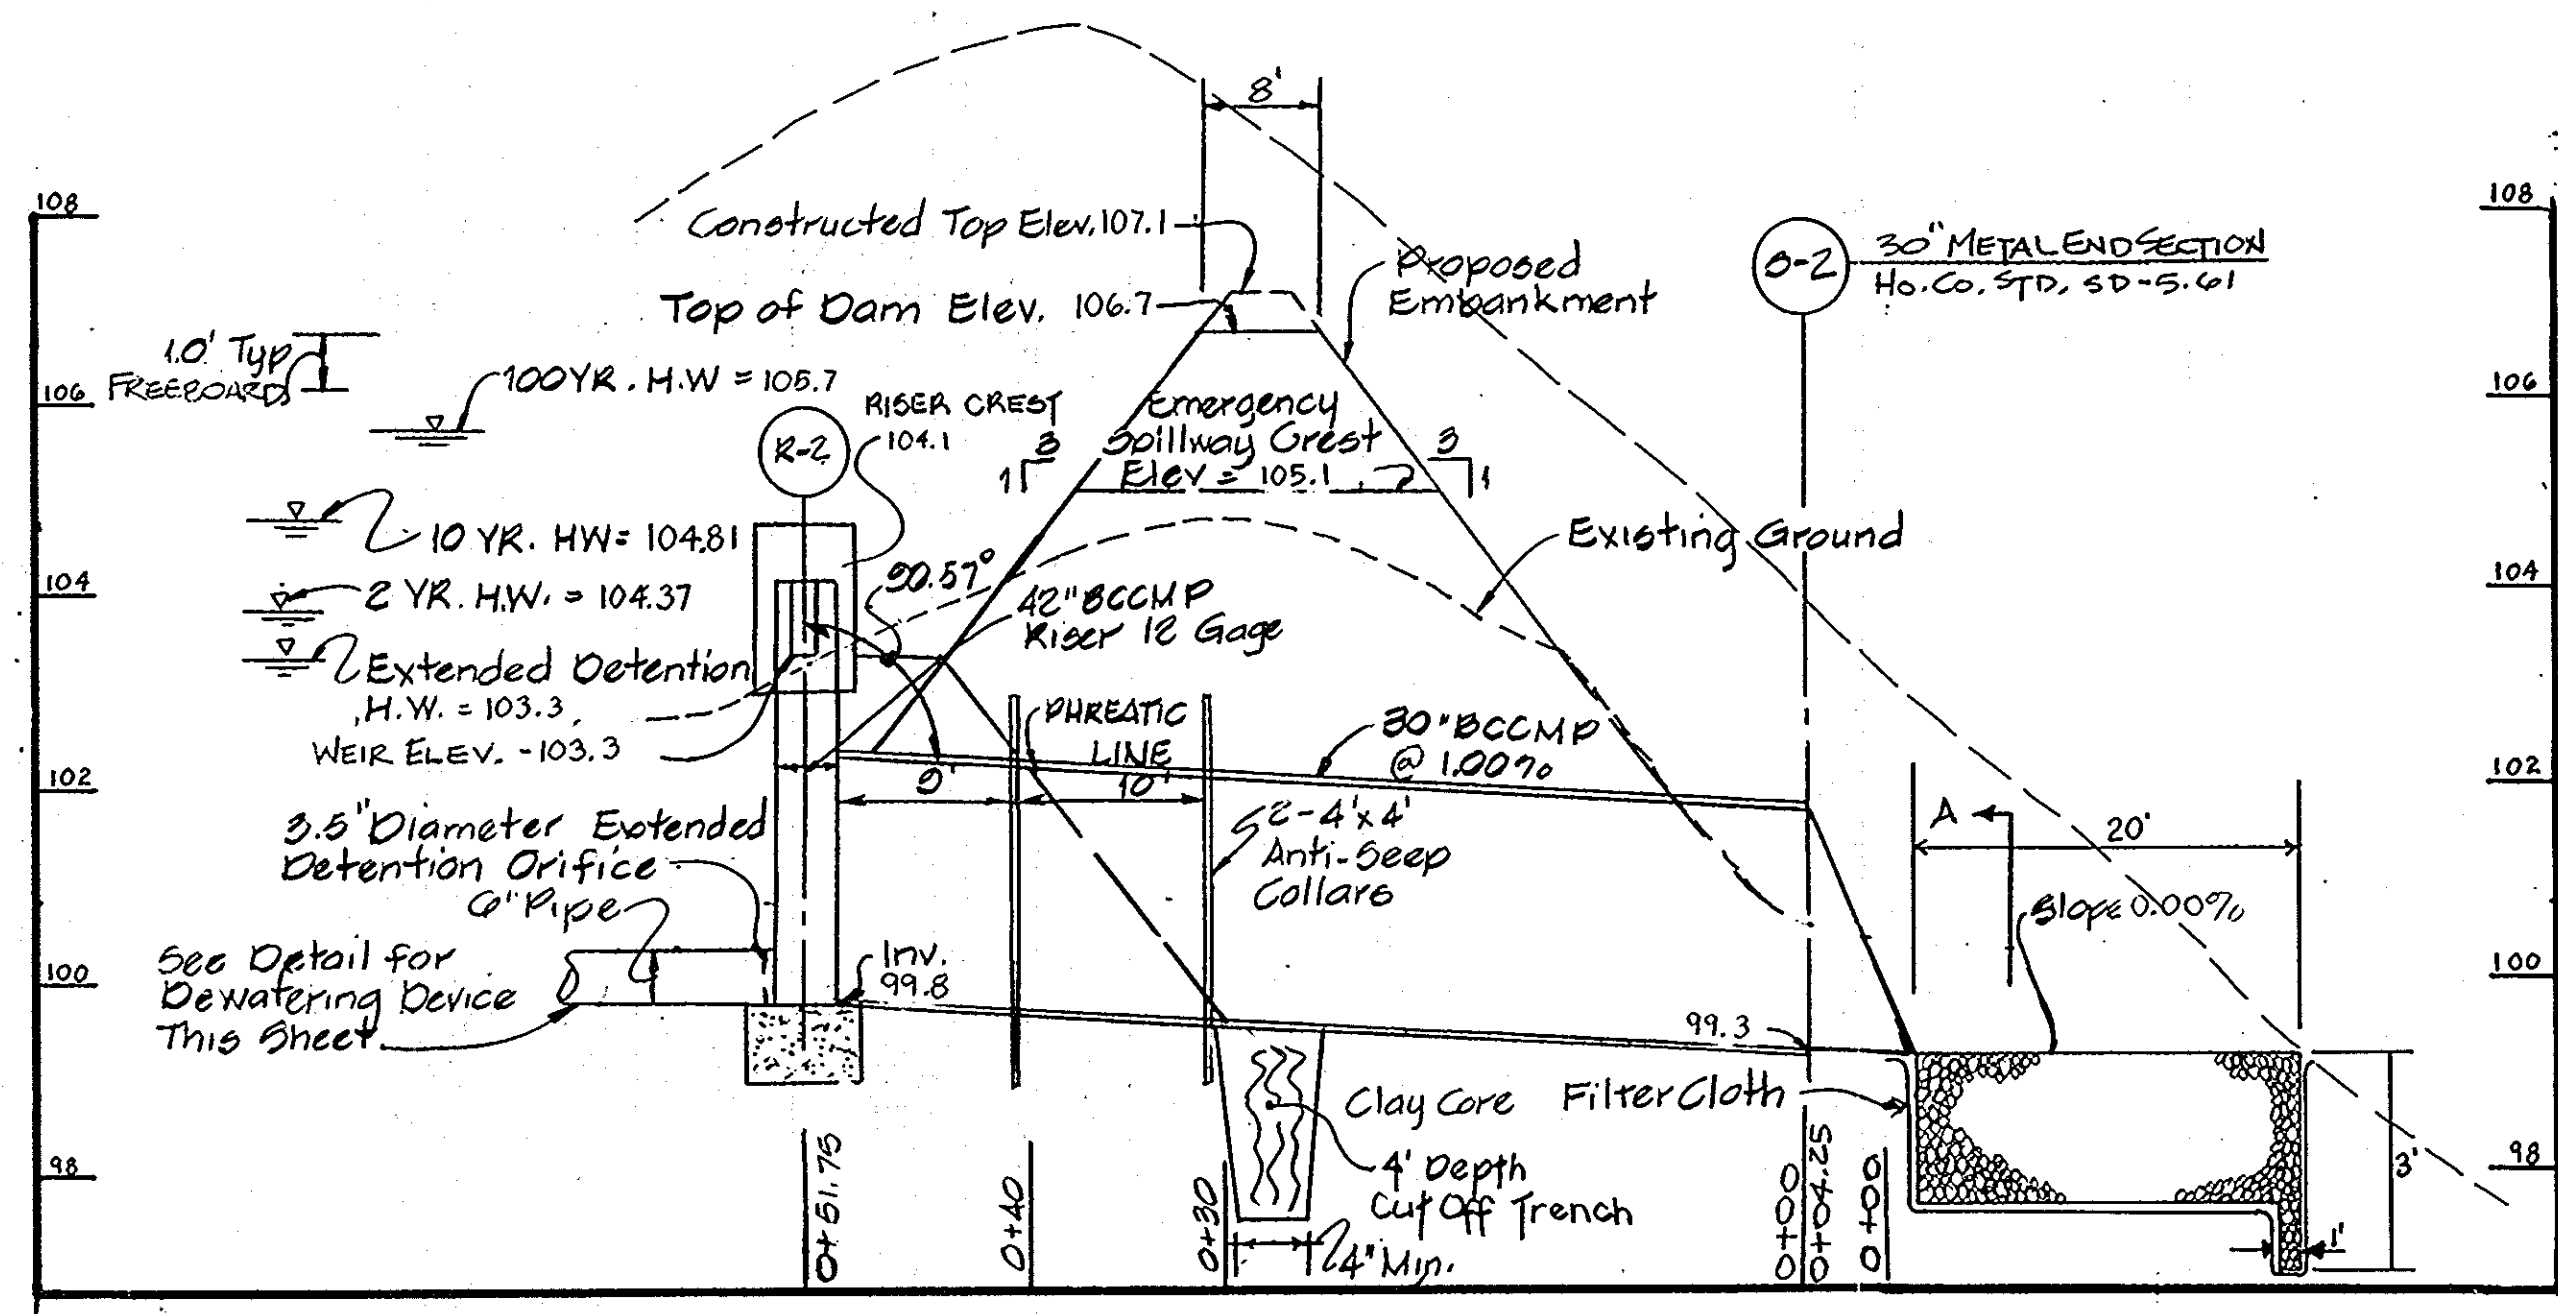


APPROVED  
DIVISION OF  
COMMUNITY PLANNING  
& LAND DEVELOPMENT  
HOWARD COUNTY,  
MARYLAND  
DATE: \_\_\_\_\_

REVIEWED FOR HOWARD COUNTY SOIL CONSERVATION DISTRICT AND MEETS TECHNICAL REQUIREMENTS.  
*John P. Hahn* 2-13-90  
*Robert J. Zelman* 2-13-90

By the Developer:  
"I/We certify that all development and/or construction will be done according to these plans, and that any responsible personnel involved in the construction project will have a Certificate of Attendance at a Department of Natural Resources Approved Training Program for the Control of Sediment and Erosion before beginning the project. I will provide the Howard Soil Conservation District with an 'as-built' plan of the pond within 30 days of completion. I also authorize the performance of site inspections by the Howard Soil Conservation District."  
*John P. Hahn* 2/13/90  
Signature of Developer  
Print name below signature

By the Engineer:  
"I certify that this plan for pond construction, erosion and sediment control represents a practical and workable plan based on my personal knowledge of the site conditions. This plan was prepared in accordance with the requirements of the Howard Soil Conservation District. I have notified the developer that he must provide the Howard Soil Conservation District with an 'as-built' plan of the pond within 30 days of completion."  
*Robert J. Zelman* 2/13/90  
Signature of Engineer  
Print name below signature

These plans have been reviewed for the Howard Soil Conservation District and meet the technical requirements for small pond construction, soil erosion and sediment control.  
*John P. Hahn* 2-13-90  
*Robert J. Zelman* 2-13-90  
Signature of District Director  
Howard Soil Conservation District

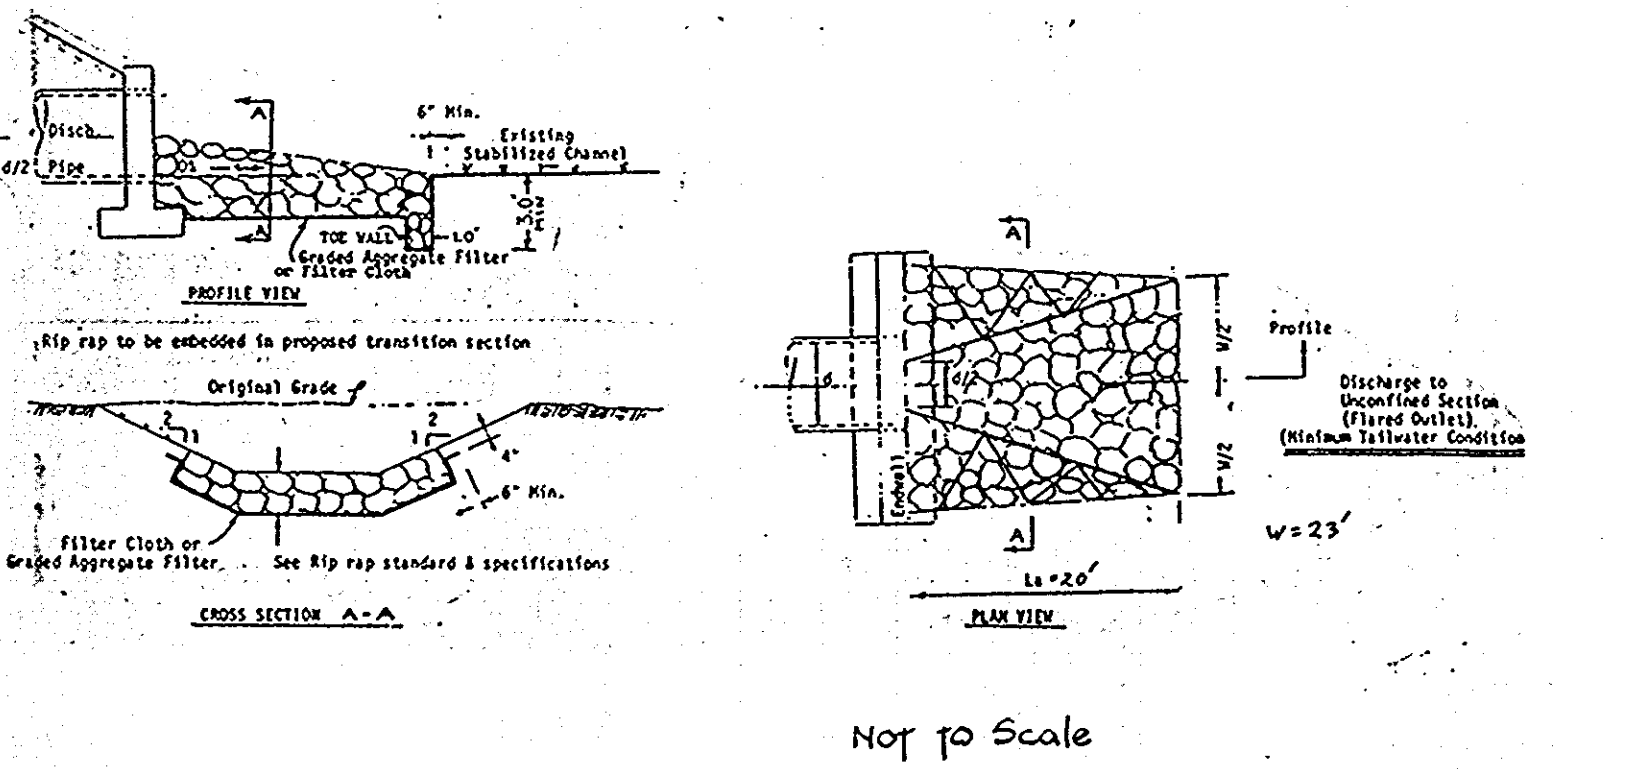

d<sub>50</sub> = 8"  
Blanket thickness = 20"  
V<sub>max</sub> = 5.0 fps  
Q<sub>1000</sub> = 27.7 cfs  
b = 3.5'  
n = 0.035  
Channel slope = 5.7%

DEVELOPER'S CERTIFICATE  
"I/WE CERTIFY THAT ALL DEVELOPMENT AND CONSTRUCTION WILL BE DONE ACCORDING TO THIS PLAN OF DEVELOPMENT AND PLAN FOR EROSION AND SEDIMENT CONTROL AND THAT ALL RESPONSIBLE PERSONNEL INVOLVED IN THE CONSTRUCTION PROJECT WILL HAVE A CERTIFICATE OF ATTENDANCE AT A DEPARTMENT OF NATURAL RESOURCES APPROVED TRAINING PROGRAM FOR THE CONTROL OF SEDIMENT AND EROSION BEFORE BEGINNING THE PROJECT. I ALSO AUTHORIZE PERIODIC ON-SITE INSPECTION BY THE HOWARD SOIL CONSERVATION DISTRICT OR THEIR AUTHORIZED AGENTS, AS ARE DEEMED NECESSARY."  
*John P. Hahn* 2/13/90  
SIGNATURE OF DEVELOPER DATE

ENGINEER'S CERTIFICATE  
I HEREBY CERTIFY THAT THIS PLAN FOR EROSION AND SEDIMENT CONTROL REPRESENTS A PRACTICAL AND WORKABLE PLAN BASED ON MY PERSONAL KNOWLEDGE OF THE SITE CONDITIONS AND THAT IT WAS PREPARED IN ACCORDANCE WITH THE REQUIREMENTS OF THE HOWARD SOIL CONSERVATION DISTRICT.  
*Robert J. Zelman* 2/13/90  
SIGNATURE OF ENGINEER DATE

DESIGNED		DATE	
DATE	BY	DATE	DESCRIPTION

**ENGINEERING TECHNOLOGIES ASSOCIATES, INC.**  
ENGINEERS, PLANNERS, SURVEYORS  
3458 ELLICOTT CENTER DRIVE, SUITE 101  
ELLICOTT CITY, MD. 21093  
(301) 461-9920

OWNER / DEVELOPER  
**HI-TECH VENTURE LIMITED PARTNERSHIP**  
7223 PARKWAY DRIVE  
HANOVER, MARYLAND 21076  
(301) 796-4446

**SITE DEVELOPMENT PLAN FOR GRADING AND STORMWATER MANAGEMENT**  
PARCEL "G" INTERIM POND NO. 2 DETAILS  
**PARKWAY CENTER SECTION I**  
PARCELS 'E', 'F', and 'G' AND OUT PARCEL (1565/469)  
1st ELECTION DISTRICT T1 32 & 44  
SCALE: AS SHOWN CONTRACT NO. \_\_\_\_\_ DATE: 2/89 SHEET 5 OF 8  
SDP-89-275






**SEQUENCE OF OPERATIONS**

1. Remove all concrete and bituminous spoil, timber, metal, wire and/or other miscellaneous debris over six (6) inches from within the areas designated for tree and shrub planting.
2. Areas requiring excavation in order to remove large masses of concrete or bituminous material shall be properly refilled with soil and smoothed to blend with the adjacent surface. No heavy equipment will be permitted within the areas designated for mitigation. All excavation shall be done using hand tools.
3. Lightly compact all disturbed areas and rake smoothly to blend with adjacent ground surface.
4. The Contractor shall provide the Landscape Architect with a list of plant material sources. All plant materials shall be subject to inspection by the landscape architect (Telephone # (301) 461-9920) prior to delivery to the site.
5. Plant trees and shrubs in accordance with the details and as directed by the Landscape Architect. Provide one (1) "UNIQUE" slow release fertilizer packet 16-8-16 (effective release time 8 years) at the side of each root ball when the pit is 1/2 backfilled. Do not place packet against root ball.
6. Plant all trees and shrubs between October 1 and May 15 only. Do not plant during periods of freezing temperatures.
7. After all trees and shrubs have been planted, rake smooth all areas disturbed by planting and fertilizer, seed, and mulch in accordance with Howard County, SCD requirements. Use a cyclone seeder.
8. When all planting, seeding and mulching has been completed, remove all excess plants or other debris resulting from planting and/or seeding operations from the site.

9. Notify the Landscape Architect at Engineering Technologies Associates, Inc. (Telephone # (301) 461-9920) regarding scheduling an inspection of the work within seven (7) days of completion of the work.

The Contractor is advised to contact sources of plant materials and fertilizers at least 6 to 8 months in advance of scheduling the actual work in order to assure proper quantities and sizes of specified items.

Potential sources of materials-plants:  
 Environs, Inc. Telephone # (301) 683-1015  
 Environmental Concern Telephone # (301) 745-9620  
 Environmental Consultants, Inc. Telephone # (804) 539-4833  
 Fertilizer Packets 16-8-16. Good Prod Sales Telephone # (201) 245-5055

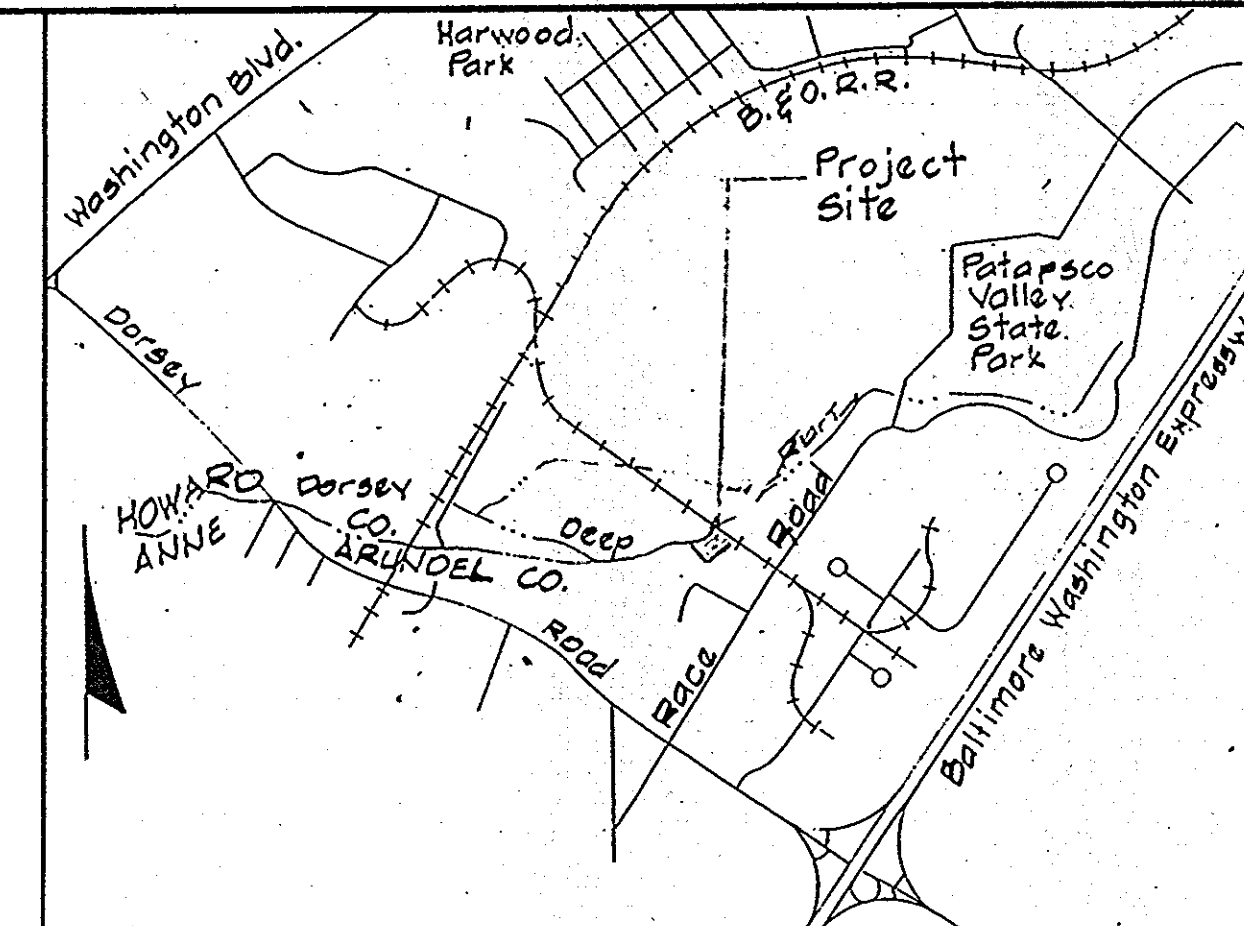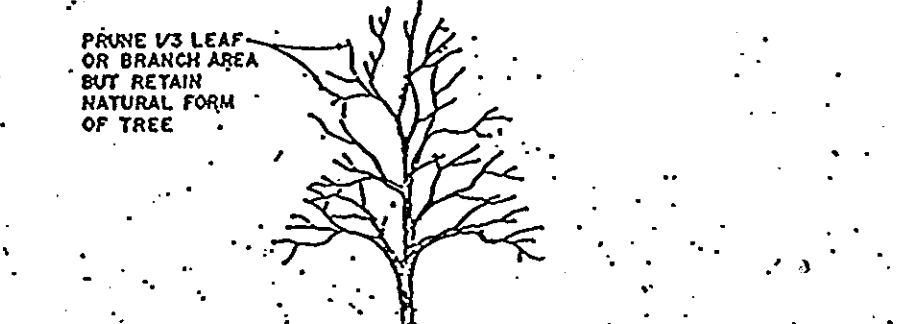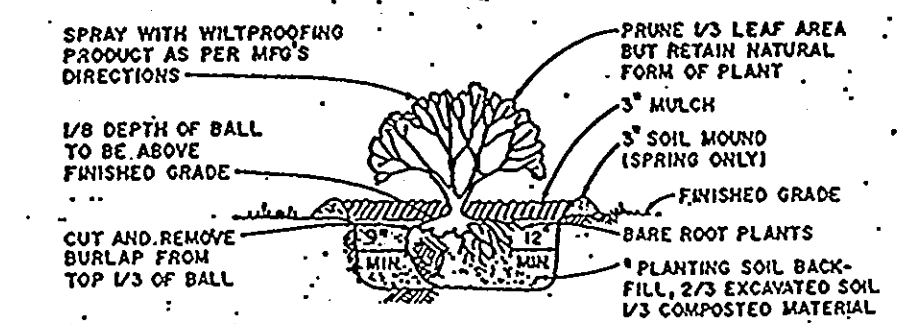


- NOTES:**
1. DOMINANT EXISTING DECIDUOUS TREES AND SHRUBS OBSERVED DURING SITE INSPECTION ON 11/8/89
  2. PROPOSED PLANTS FOR MITIGATION HAVE BEEN SELECTED BASED ON COMPATIBILITY WITH EXISTING SOIL MOISTURE CONDITIONS AS WELL AS EXISTING VEGETATION.
  3. ALL PROPOSED PLANT MATERIALS SHALL HAVE BEEN GROWN IN WET CULTURED CONDITIONS.
  4. PRIOR TO BEGINNING ANY PLANTING OPERATIONS, THE AREAS SHALL BE CLEARED OF ALL CONCRETE, TIMBER AND OTHER DEBRIS.
  5. PREDOMINANT SOIL TYPE IS Ha (HATBORO SILT/loam)
  6. NO GRADING SHALL BE DONE WITHIN THE AREAS DESIGNATED FOR MITIGATION OTHER THAN THE SMOOTHING OF DISTURBED AREAS BY THE USE OF HANDTOOLS.

**LEGEND**

	DECIDUOUS TREES (PLANTED RANDOMLY 10' O.C.)
	RED MAPLE 5'-6' HT. 35% (76 REQ'D B&B)
	RIVER BIRCH 5'-6' HT. 25% (54 REQ'D B&B)
	SWEETGUM 5'-6' HT. 20% (44 REQ'D B&B)
	SYCAMORE 5'-6' HT. 20% (43 REQ'D B&B)
	DECIDUOUS SHRUBS (PLANTED IN MIXED GROUPS OF 6-10)
	ARROW WOOD 3'-4' HT. 20% (48 REQ'D B&B)
	SILKY DOGWOOD 3'-4' HT. 25% (60 REQ'D B&B)
	HAZEL ALDER 3'-4' HT. 30% (72 REQ'D B&B)
	NANNYBERRY 3'-4' HT. 25% (60 REQ'D B&B)

±0.69 ACRES FOR MITIGATION

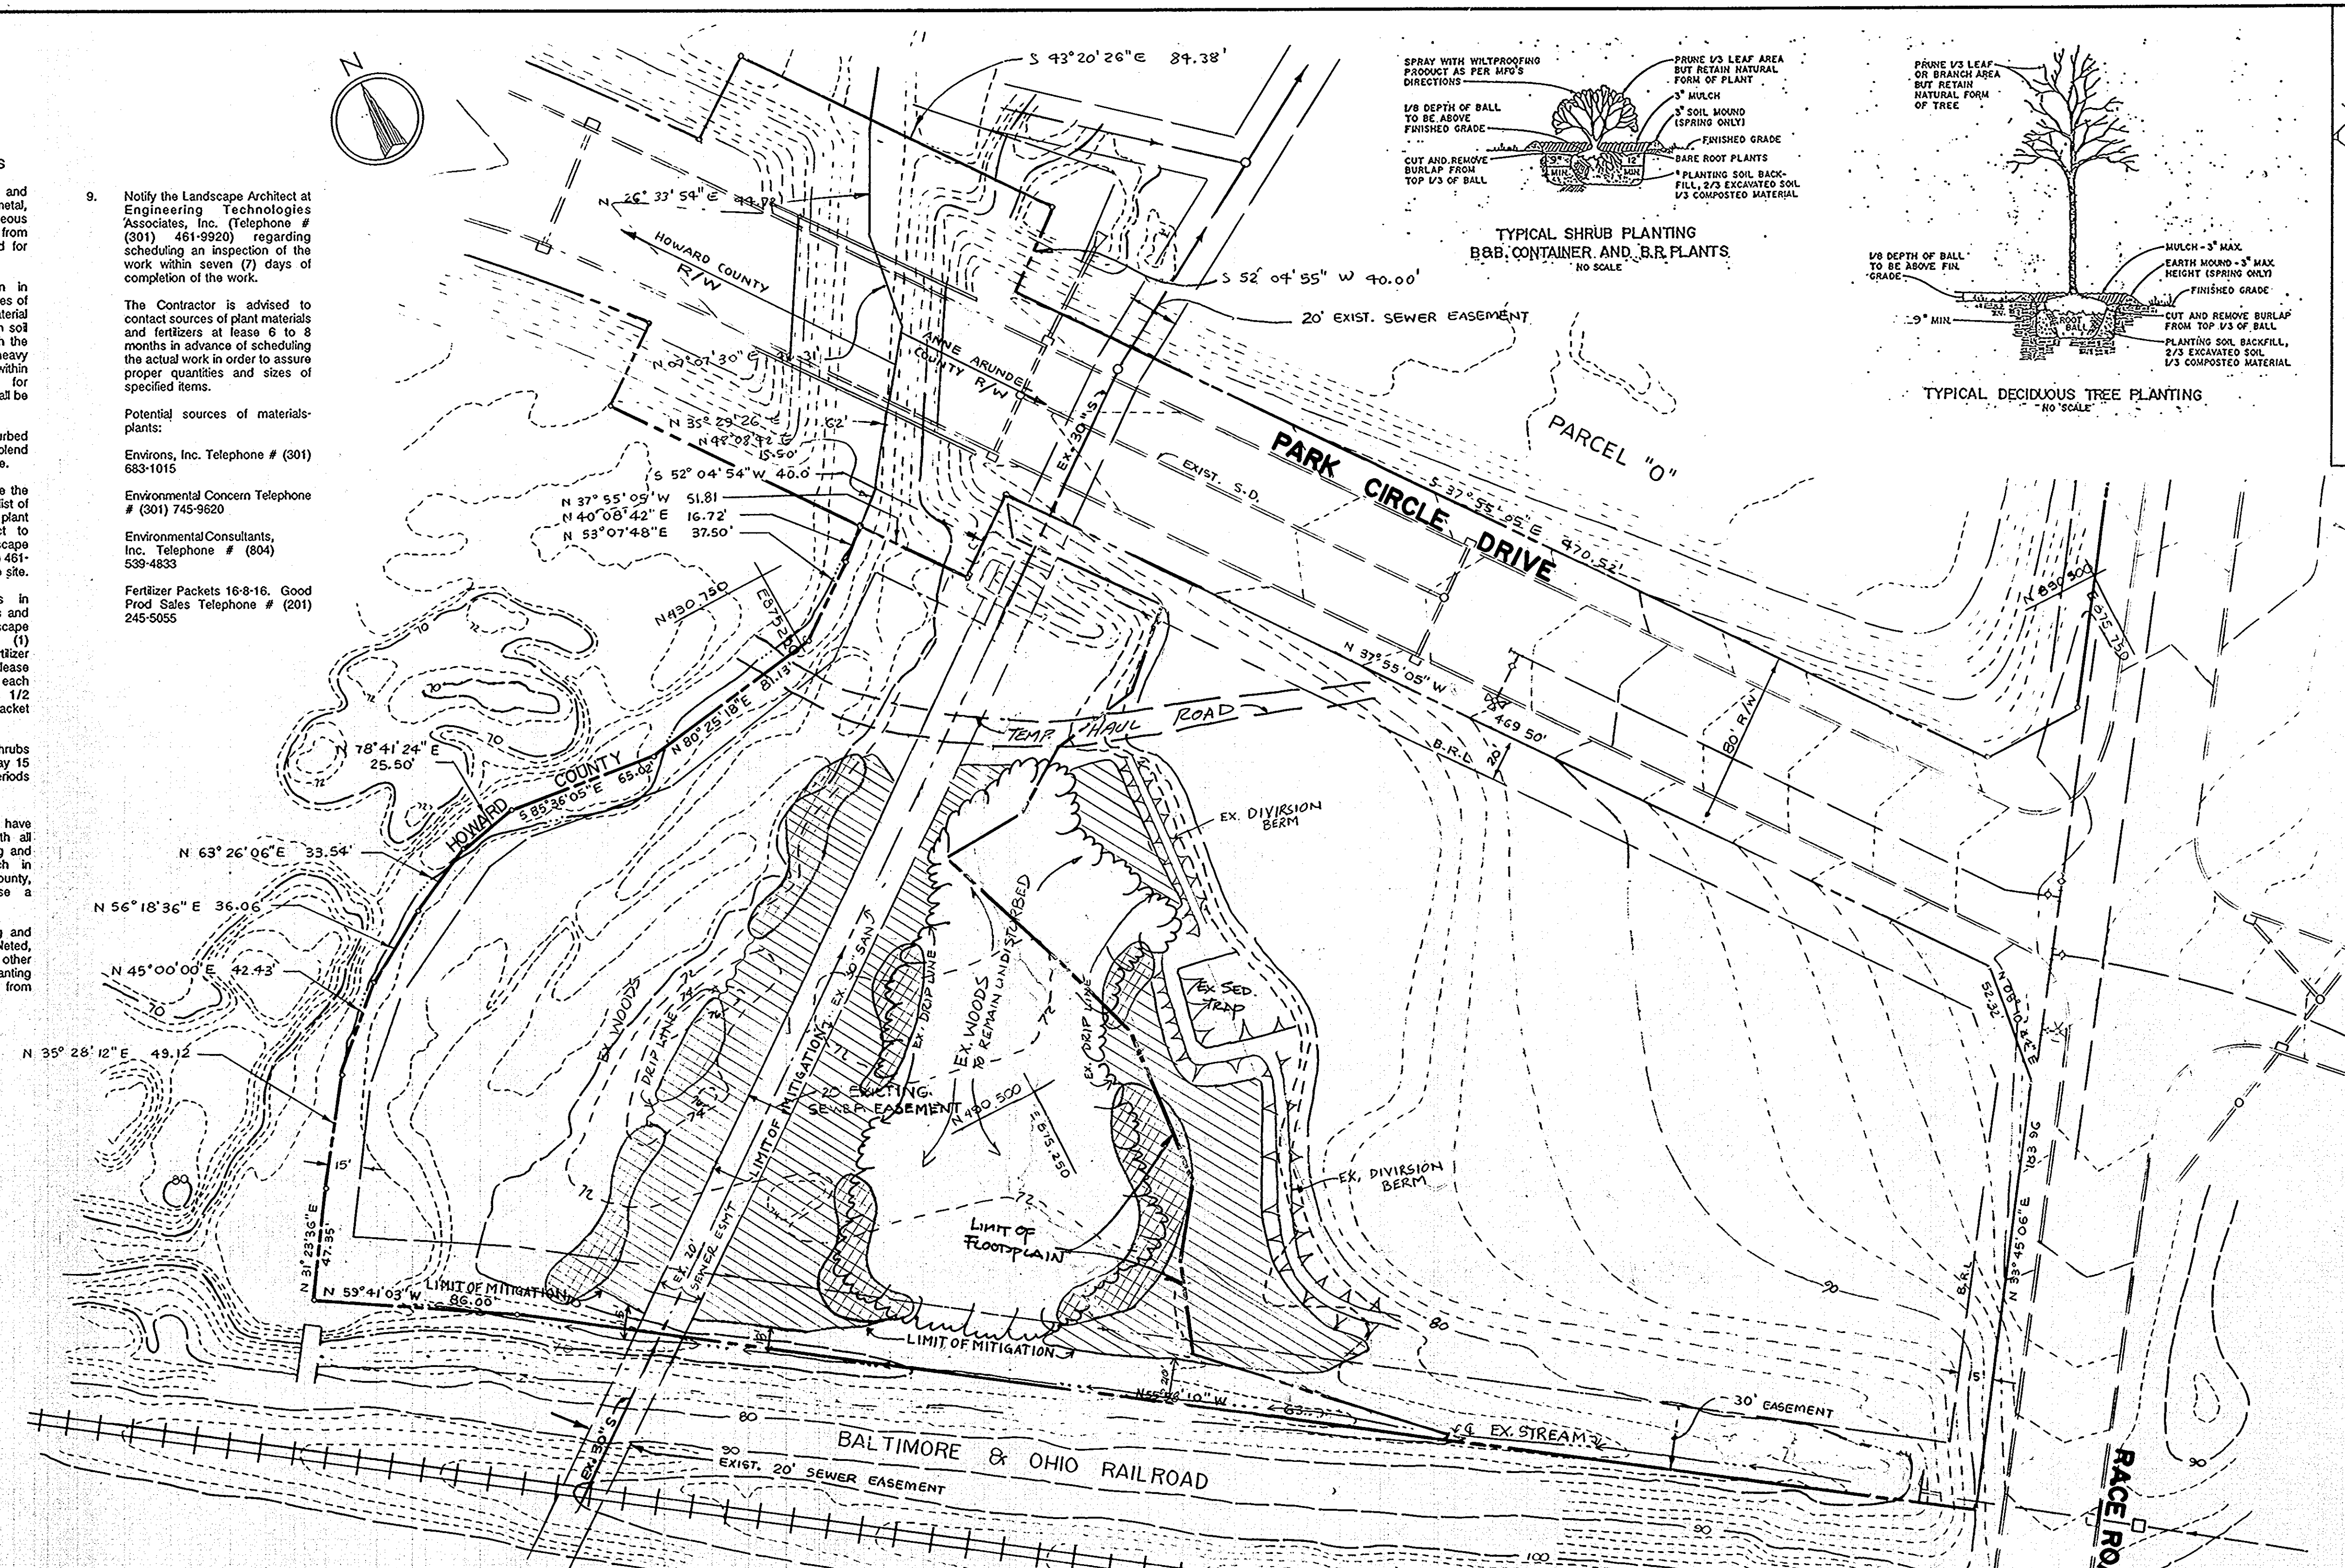

**LEGEND**

	EXISTING GROUND
	PROPOSED GRADES FOR BERM FOR INSIDE SLOPE
	ULTIMATE FILL GRADES
	SILT FENCE
	EARTH DIKE
	CONSTRUCTION ENTRANCE
	TEMPORARY SWALE

APPROVED: FOR PUBLIC WATER AND PUBLIC SEWERAGE SYSTEMS, HOWARD COUNTY HEALTH DEPARTMENT  
 [Signature] 3-21-90  
 COUNTY HEALTH OFFICER DATE

APPROVED: HOWARD COUNTY DEPARTMENT OF PLANNING AND ZONING  
 [Signature] 4-2-90  
 DIRECTOR DATE

CHIEF DIVISION OF COMMUNITY PLANNING AND LAND DEVELOPMENT

APPROVED: FOR PUBLIC WATER AND PUBLIC SEWERAGE, STORM DRAINAGE SYSTEMS AND PUBLIC ROADS HOWARD COUNTY DEPARTMENT OF PUBLIC WORKS  
 [Signature] 3-21-90  
 DIRECTOR DATE

[Signature] 3-2-90  
 CHIEF BUREAU OF ENGINEERING DATE

**PLAN**  
 SCALE: 1" = 40'

**BENCHMARK DESCRIPTION**  
 B.M. "RACE No. 1" ELEV. 91.00  
 R.R. SPIKE IN BASE OF C & P POLE  
 # 9 1/2, 130' ± S.W. OF R.R. TRACK  
 CROSSING RACE ROAD.

REVIEWED FOR HOWARD COUNTY SOIL CONSERVATION DISTRICT AND MEETS TECHNICAL REQUIREMENTS.  
 [Signature] 2-13-90  
 SOIL CONSERVATION SERVICE DATE

THIS DEVELOPMENT IS APPROVED FOR EROSION AND SEDIMENT CONTROL BY THE HOWARD COUNTY SOIL CONSERVATION DISTRICT  
 [Signature] 2-13-90  
 HOWARD COUNTY SOIL CONSERVATION DISTRICT DATE

HOWARD COUNTY SIGNATURE BLOCK

**APPROVED**  
 DIVISION OF COMMUNITY PLANNING & LAND DEVELOPMENT  
 HOWARD COUNTY, MARYLAND  
 DATE: \_\_\_\_\_

DESIGNED: K.E.M. 12/89  
 (WETLAND MITIGATION) DATE

DRAWN: S.G.P. 2/88  
 (BASE PLAN) DATE

CHECKED: K.E.M. DATE

APPROVED: DATE

**REVISIONS**

DATE	BY	DESCRIPTION
12-13-89	K.E.M.	ADDED PLANTING DETAILS, SEQUENCE OF OPERATIONS AND PLANT QUANTITIES

**ENGINEERING TECHNOLOGIES ASSOCIATES, INC.**  
 ENGINEERS, SURVEYORS, CONSTRUCTION MANAGERS.  
 9051 BALTIMORE NATIONAL PIKE  
 ELLICOTT CITY, MD. 21043  
 (301) 461-9920



HI-TECH VENTURE LIMITED PARTNERSHIP  
 OWNER AND DEVELOPER  
 7223 PARKWAY DRIVE  
 HANOVER, MARYLAND 21076  
 (301) 796 4446

**MITIGATION PLAN**  
**PARKWAY CENTER SECTION 1**  
 1st ELECTION DISTRICT  
 ANNE ARUNDEL COUNTY, MARYLAND  
 TAX MAP B

SCALE: 1" = 40' CONTRACT NO. DATE: 11/10/89 SHEET: 8 OF 8  
 SDP-89-275