


SIGNATURE BLOCK


SECTION NUMBER	ROAD NAME, STREET CLASSIFICATION	PAVING SECTION	INVERT ELEVATION	CONCRETE USE ALTERNATIVES
P-1	PARCEL N-1 AND PAVEMENT ALTERNATIVES AND COMMERCIAL INDUSTRIAL ZONES WITH 15' CONC. BASE	P-1 THROUGH P-4	1" BIT CONC. SURFACE 1" BIT CONC. BASE	1" BIT CONC. SURFACE 1" BIT CONC. BASE 1" BIT CONC. SURFACE 1" BIT CONC. BASE
P-2	HOWARD COURT, HARTLEIGH DEPARTMENT OF PUBLIC WORKS	P-1 THROUGH P-4	1" BIT CONC. SURFACE 1" BIT CONC. BASE	1" BIT CONC. SURFACE 1" BIT CONC. BASE 1" BIT CONC. SURFACE 1" BIT CONC. BASE

STRUCTURE	INV IN	INV OUT	TOP EL.	TYPE AND DETAIL
I-1	-	346.78	* 351.10	"8" COMB. INLET HO. CO. S-D-4-32
I-2	346.60	346.50	350.40	YARD INLET HO. CO. S-D-4-14
I-3	-	346.00	349.80	YARD INLET HO. CO. S-D-4-14
I-4	344.85	344.40	* 350.00	"8" COMB. INLET HO. CO. S-D-4-32
MH-1	343.50	347.50	347.50	SHALLOW MANHOLE HO. CO. G-5-12
MH-2	342.60	341.60	346.50	MODIFIED SHALLOW MANHOLE HO. CO. G-5-12
S-1	338.00	338.00	-	15" METAL END SECTION

* TOP OF CURB ELEVATION 359.57

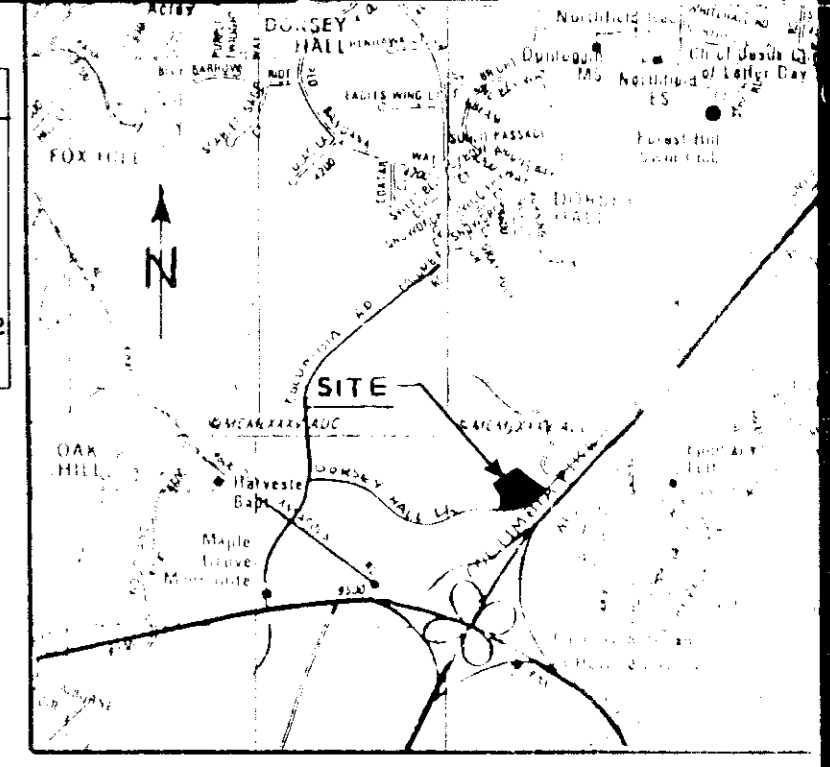

LOT #	STREET ADDRESS
GROUP A	5090 DORSEY HALL DRIVE
	5092 DORSEY HALL DRIVE
	5094 DORSEY HALL DRIVE
	5096 DORSEY HALL DRIVE
GROUP B	5070 DORSEY HALL DRIVE
	5072 DORSEY HALL DRIVE
	5074 DORSEY HALL DRIVE
	5076 DORSEY HALL DRIVE
GROUP C	5080 DORSEY HALL DRIVE
	5082 DORSEY HALL DRIVE
	5084 DORSEY HALL DRIVE
	5086 DORSEY HALL DRIVE

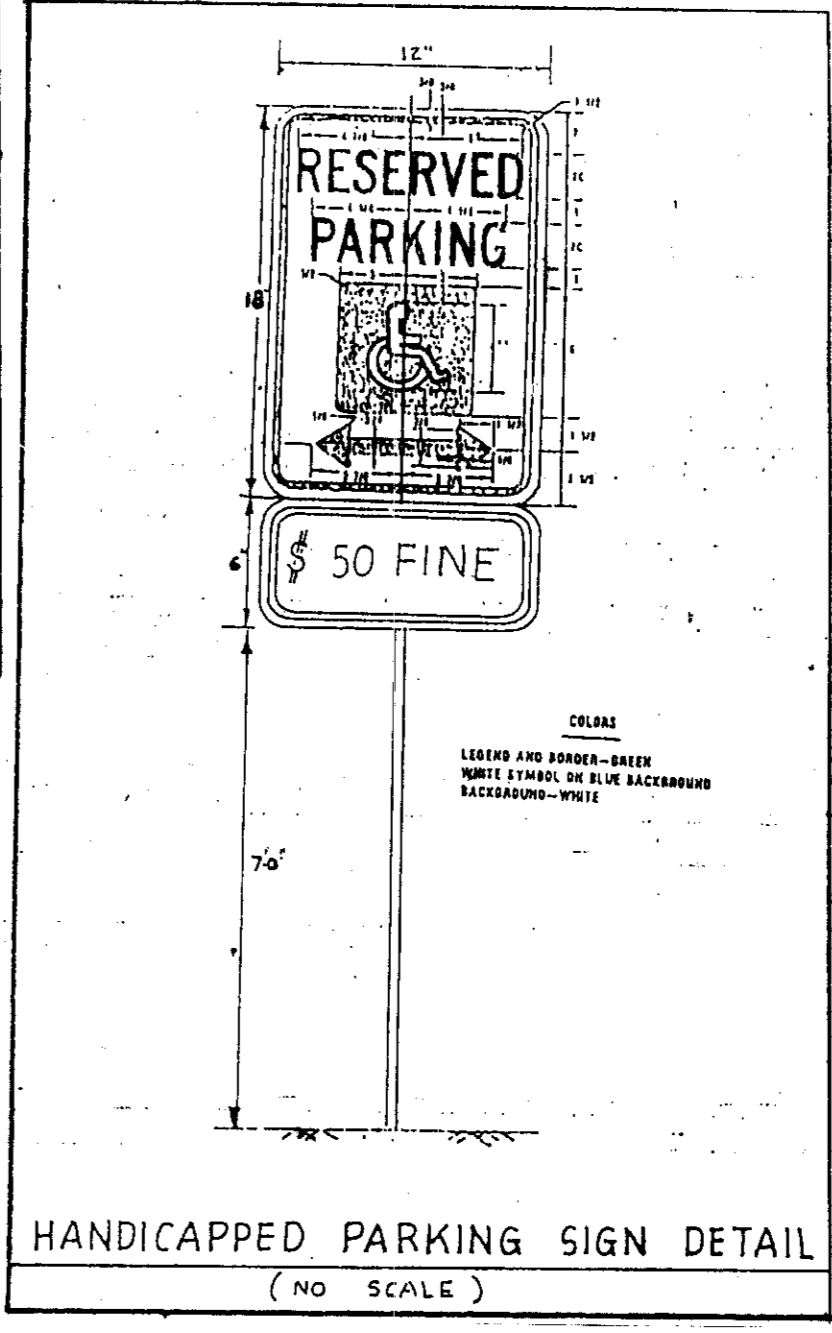

APPROVED FOR PUBLIC WATER AND PUBLIC SEWERAGE SYSTEM
HOWARD COUNTY HEALTH DEPARTMENT
Joseph Ziegler 11-15-91
COUNTY HEALTH OFFICER DATE

APPROVED, HOWARD COUNTY DEPT. OF PLANNING & ZONING
James Smith 12/20/91
Anna H. Hulmuth 12/20/91
DIRECTOR DATE
DIVISION OF COMMUNITY PLANNING AND LAND DEVELOPMENT
CM

APPROVED FOR PUBLIC WATER AND PUBLIC SEWERAGE, STORM DRAINAGE SYSTEMS AND PUBLIC ROADS, HOWARD COUNTY DEPARTMENT OF PUBLIC WORKS
James J. ... 11/6/91
DIRECTOR DATE
James J. ... 5-1-90
CHIEF BUREAU OF ENGINEERING DATE

PARKING DATA

OFFICE SPACE 3 x 14,234 = 42,702 SF
250 SF/1 EMPLOYEE
42,702 SF OFFICE SPACE YIELDS 171 EMPLOYEES 174

7 PARKING SPACES REQUIRED / 10 EMPLOYEES
174 EMPLOYEES REQUIRE 129 PARKING SPACES

120/120 PARKING SPACES REQUIRED
122 PARKING SPACES PROVIDED (INCLUDING 6 HANDICAP SPACES)

STANDARD PARKING SPACE 9' x 18'
HANDICAP PARKING SPACE 13' x 18'


SITE ANALYSIS

- TOTAL AREA OF SITE = 3.295 AC. OR 143,530 S.F.
- ZONING FOR PLANNED OFFICE AND RESEARCH
- OPEN SPACE (GREEN AREA) PROVIDED = 1.5 AC. (45%)
- BUILDING COVERAGE OF SITE = 7272 x 3 = 21,816 SF (15.2%)
- GROUPS = 14,234 SF EACH 22,216
43,502 = 42,702 SF TOTAL
- LANDSCAPED ISLANDS REQUIRED (5% OF PARKING AREA) = 2460 SF
LANDSCAPED ISLANDS PROVIDED = 8500 SF (13%)

REVIEWED FOR HOWARD COUNTY SOIL CONSERVATION DISTRICT AND MEETS TECHNICAL REQUIREMENTS
James H. ... 4-18-90
SOIL CONSERVATION DISTRICT
DEVELOPMENT IN APPROVED EROSION AND SEDIMENT CONTROL PLAN MEETS SOIL CONSERVATION DISTRICT REQUIREMENTS
John H. ... 4/18/90
SOIL CONSERVATION DISTRICT DATE


ENGINEER'S CERTIFICATE
I HEREBY CERTIFY THAT THIS PLAN FOR EROSION AND SEDIMENT CONTROL REPRESENTS A PRACTICAL AND WORKABLE PLAN BASED ON MY PERSONAL KNOWLEDGE OF THE SITE CONDITIONS AND THAT IT WAS PREPARED IN ACCORDANCE WITH THE REQUIREMENTS OF THE HOWARD SOIL CONSERVATION DISTRICT.
Dr. ... 4/13/90
SIGNATURE OF ENGINEER DATE

DEVELOPER'S CERTIFICATE
"I/WE CERTIFY THAT ALL DEVELOPMENT AND CONSTRUCTION WILL BE DONE ACCORDING TO THIS PLAN OF DEVELOPMENT AND PLAN FOR EROSION AND SEDIMENT CONTROL AND THAT ALL RESPONSIBLE PERSONNEL INVOLVED IN THE CONSTRUCTION PROJECT WILL HAVE A CERTIFICATE OF ATTENDANCE AT A DEPARTMENT OF NATURAL RESOURCES APPROVED TRAINING PROGRAM FOR THE CONTROL OF SEDIMENT AND EROSION BEFORE BEGINNING THE PROJECT. I ALSO AUTHORIZE PERIODIC ON-SITE INSPECTION BY THE HOWARD SOIL CONSERVATION DISTRICT OR THEIR AUTHORIZED AGENTS, AS ARE DEEMED NECESSARY."
Douglas L. ... 4-13-90
SIGNATURE OF DEVELOPER DATE

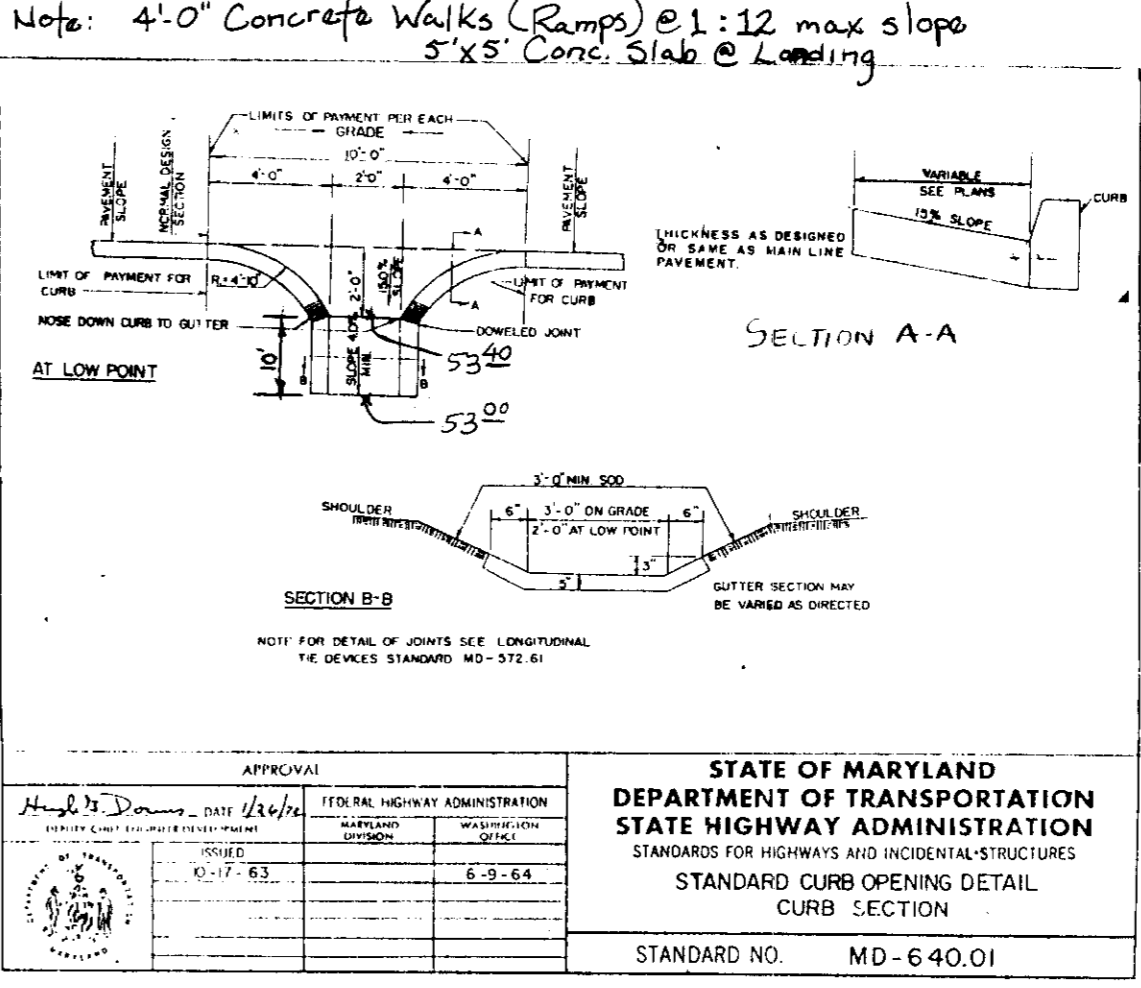

LEGEND

- (1) Dashed line: EXISTING CONTOUR
- (2) Solid line: PROPOSED CONTOUR
- (3) Dashed line with dots: EX. CONC. CURB AND GUTTER
- (4) Solid line with dots: PROP. CONC. CURB AND GUTTER
- (5) Arrow: FLOW DIRECTION
- (6) Stippled pattern: PROP. PAVING
- (7) Dotted pattern: PROP. CONC. WALK
- (8) Square with 'H': HANDICAPPED PARKING SPACE

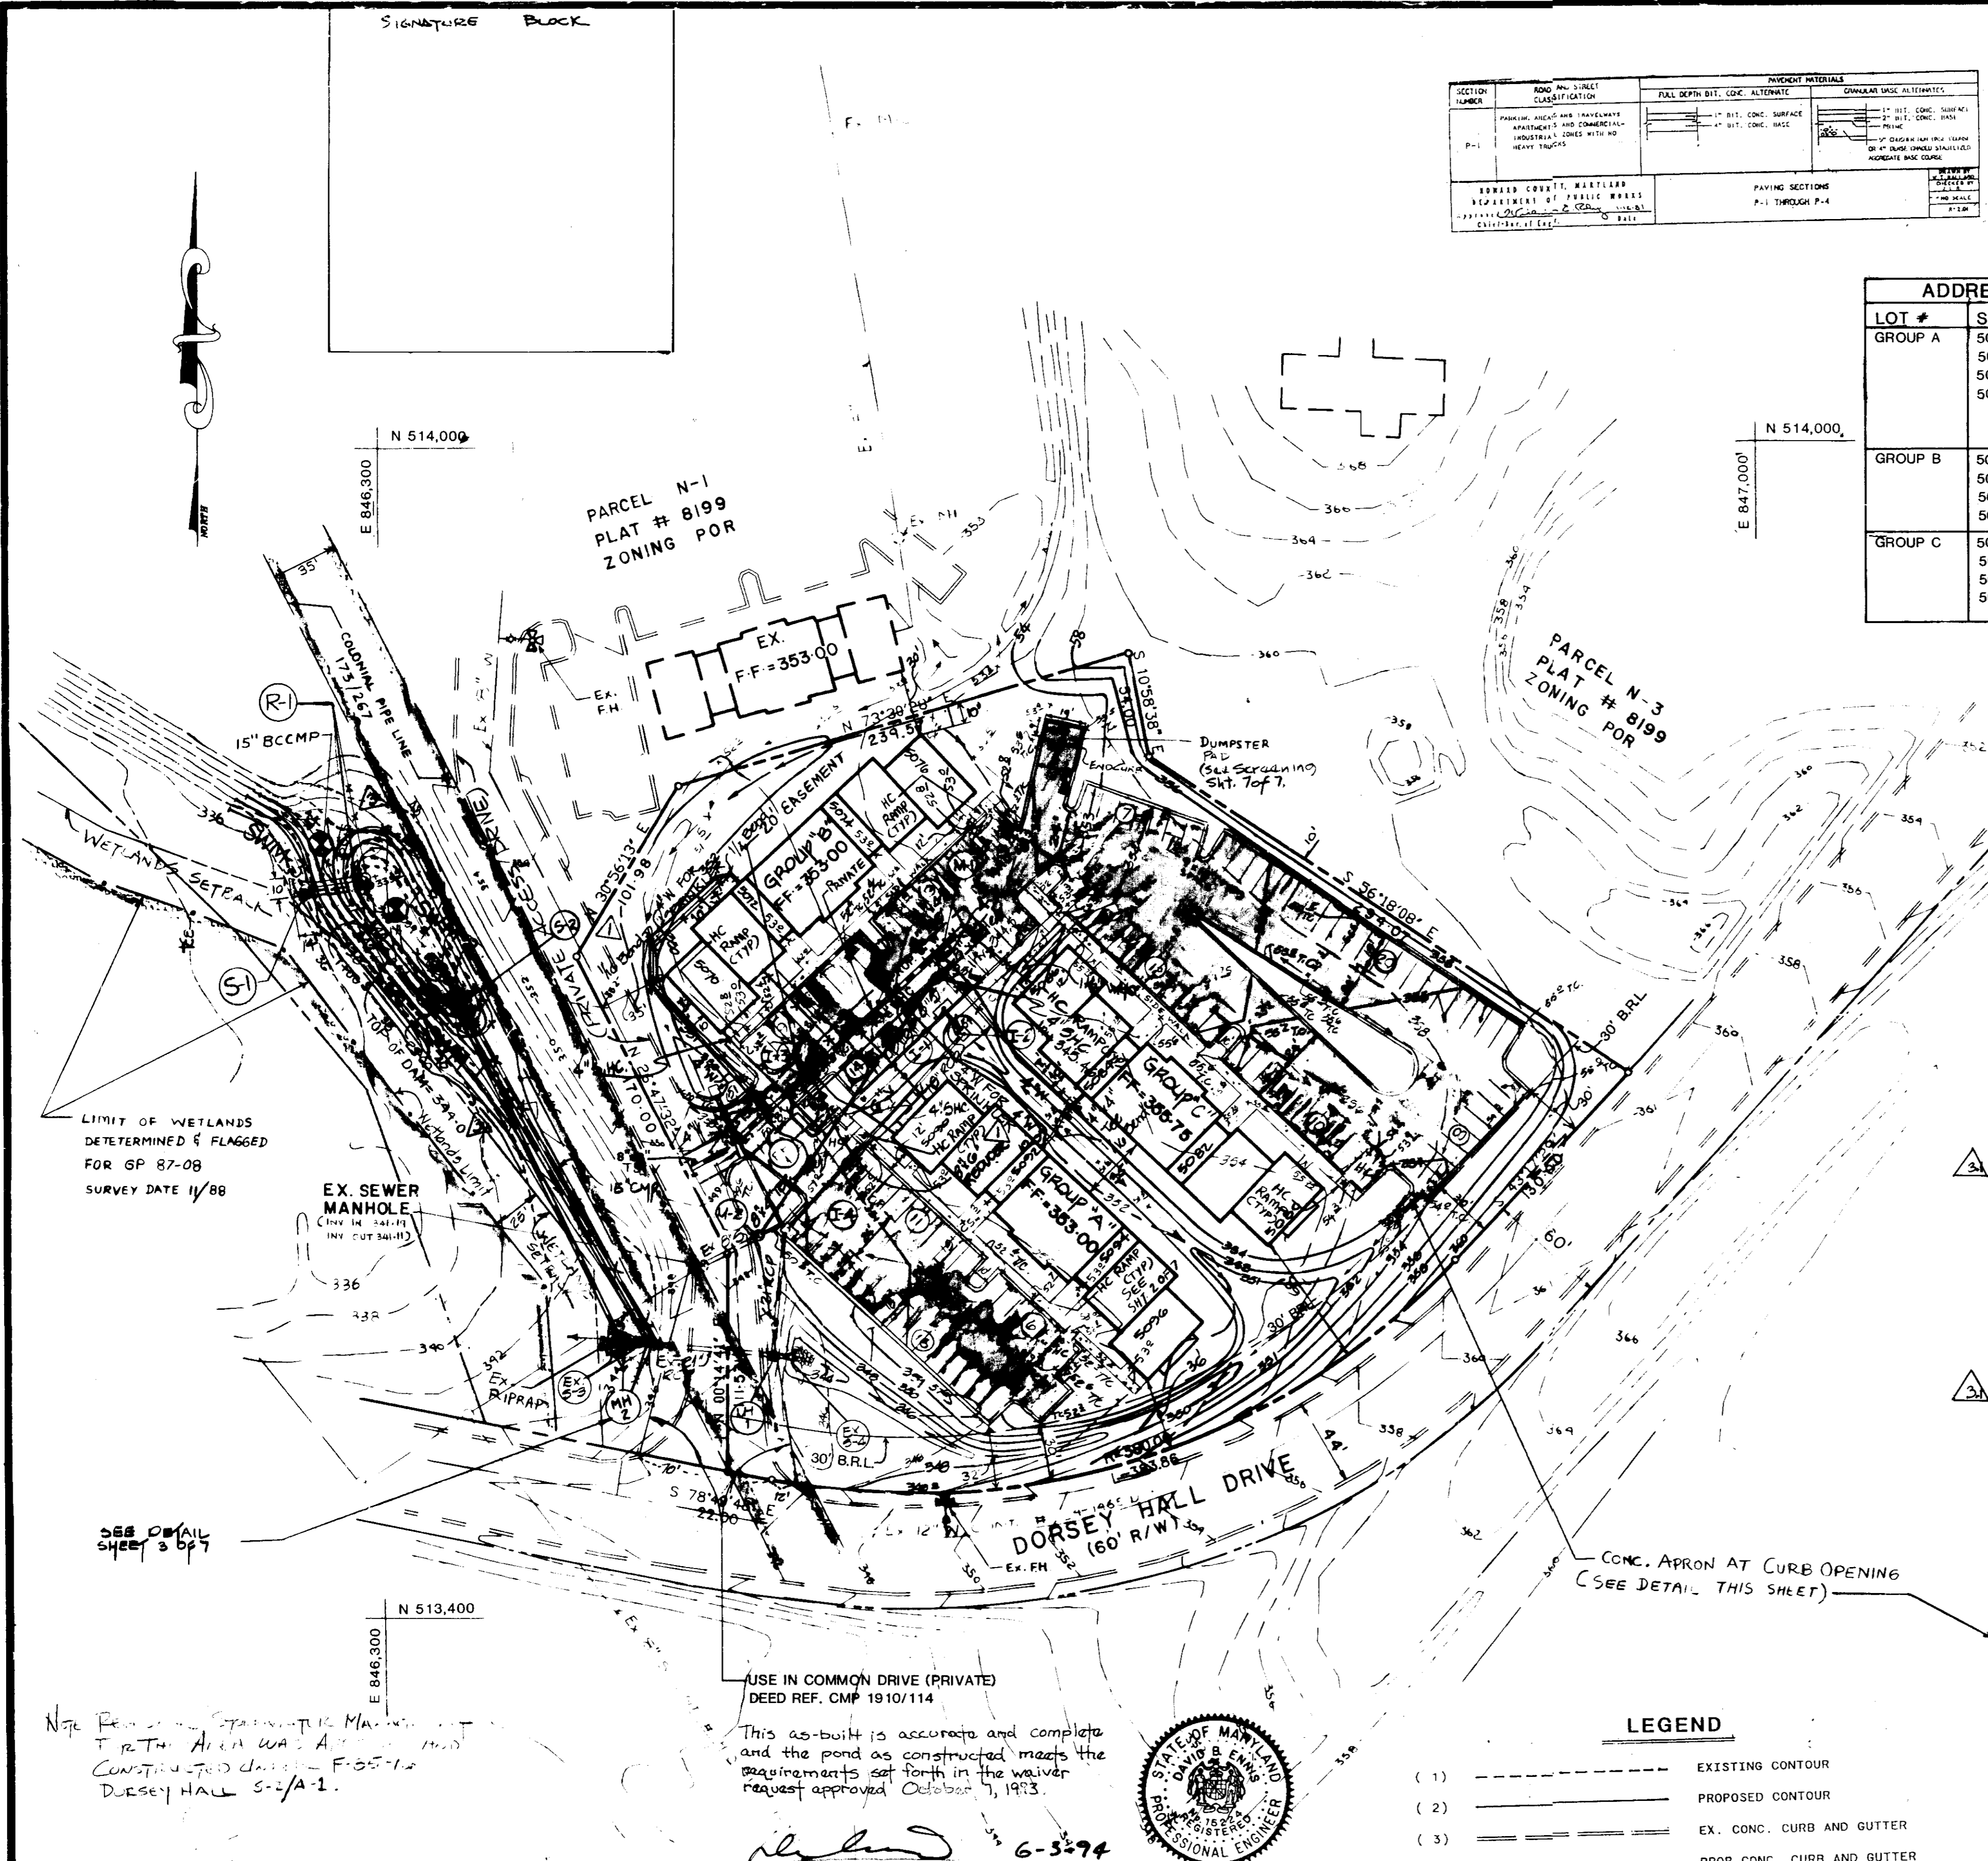

SUBDIVISION NAME	SECT./AREA	LOT/PARCEL
DORSEY HALL	2/5	N-2
PLAT #, OR L/F, BLOCK #	TAX/ZONE MAP	ELEC. DIST.
8159, 4, POR	30	21
CENSUS TR.	6023.01	
WATER CODE	SEWER CODE	
F00	5750000	

DAVID B. ENNIS
6-3-94
DATE
PLAN
SCALE 1"=50'

ENGINEERING TECHNOLOGIES ASSOCIATES, INC.
ENGINEERS * PLANNERS * SURVEYORS
3456 ELLICOTT CENTER DRIVE, SUITE 101
ELLICOTT CITY, MARYLAND 21043
BALTO. 461-9920 WASH. 821-4900

OWNER / DEVELOPER
ELLICOTT RIDGE CORPORATION II
DYSON CONSTRUCTION CO. INC.
3440 ELLICOTT CENTER DRIVE, SUITE 101
ELLICOTT CITY, MARYLAND 21043
(301) 461-4138

SITE DEVELOPMENT PLAN
TAX MAP 30 PARCEL N-2
DORSEY HALL
(OFFICE CONDOMINIUMS)
SECTION - 2 AREA - 5 PARCEL N-2
2ND ELECTION DISTRICT, HOWARD COUNTY, MARYLAND
SCALE: AS SHOWN CONTRACT NO. 8712/11 DATE: 9/93 SHEET 1 OF 7

REVISIONS

DATE	BY	DESCRIPTION
11-29-92	R.M.D.	ADDITION OF 4" W SPRINKLER SYSTEM.
8-2-93	W.H.N.	Redline - Remove 1 1/2" W.C. Remove Blow-Off, provide 8" x 8" R., Provide 4" Y's add 4" W. profiles
9-20-93	S.G.P.	Redline - Moved Pond, R-1, S-2, MH2, 15" CMP and Dam 5' Feet.

11-4-93 " " Add Buildings Group "A" & Group "C" Sht. 12, 4, 6, 7
5-25-94 ASBUILTS (swm)

These specifications are appropriate to ponds within the scope of the standard for practice 378.

I. SITE PREPARATION

Areas designated for borrow areas, embankment, and structural works shall be cleared, grubbed and stripped of topsoil. All trees, vegetation, roots and other objectionable material shall be removed. Channel banks and sharp breaks shall be sloped to no steeper than 1:1.

Areas to be covered by the pond or reservoir will be cleared of all trees, brush, logs, fences, rubbish and other objectionable material unless otherwise designated on the plans. Trees, brush and stumps shall be cut approximately level with the ground surface.

All cleared and grubbed material shall be disposed of outside and below the limits of the dam and reservoir as directed by the owner or his representative. When specified, a sufficient quantity of topsoil will be stockpiled in suitable location for use on the embankment and other designated areas.

II. EARTH FILL

Material

The fill material shall be taken from approved designated borrow areas or areas. It shall be free of roots, stumps, wood, rubbish, oversize stones, frozen or other objectionable materials. The embankment shall be constructed to an elevation which provides for anticipated settlement to the design elevation. The fill height all along the length of the embankment shall be increased above the design elevation (including freeboard) as shown on the plans.

Placement

Areas on which fill is to be placed shall be scarified prior to placement of fill. Fill materials shall be placed in 8-inch maximum thickness (before compaction) layers which are to be continuous over the entire length of the fill. The most porous borrow material shall be placed in the downstream portions of the embankment.

Compaction

The movement of the hauling and spreading equipment over the fill shall be controlled so that the entire surface of each lift shall be traversed by not less than one tread track of the equipment or compaction shall be achieved by a minimum of four complete passes of a sheepsfoot, rubber tired or vibratory roller. Fill material shall contain sufficient moisture such that the required degree of compaction can be obtained with the equipment used.

Where a minimum required density is specified, each layer of fill shall be compacted as necessary to obtain that density and is to be certified by the Engineer.

Cutoff Trench

Where specified, a cutoff trench shall be excavated along or parallel to the centerline of the embankment as shown on the plans. The bottom width of the trench shall be as shown on the drawings, with the minimum width being four feet. The depth shall be at least four feet or as shown on the plans. The side slopes of the trench shall be 1 to 1 or flatter. The backfill material for the cutoff trench shall be the most impervious material available and shall be compacted with equipment or rollers to assure maximum density and minimum permeability.

III. STRUCTURAL BACKFILL

Backfill material shall be of the type and quality conforming to that specified for the adjoining fill material. The fill shall be placed in horizontal layers not to exceed four inches in thickness and compacted by hand tampers or other compaction equipment. The material needs to fill completely all spaces under and adjacent to the pipe. At no time during the backfilling operation shall driven equipment be allowed to operate closer than four feet, measured horizontally, to any part of a structure. Under no circumstances shall equipment be driven over any part of a concrete structure or pipe unless there is a compacted fill of twenty-four inches or greater over the structure or pipe.

Backfill material shall be of the type and quality conforming to that specified for the adjoining fill material. The fill shall be placed in horizontal layers not to exceed four inches in thickness and compacted by hand tampers or other compaction equipment. The material needs to fill completely all spaces under and adjacent to the pipe. At no time during the backfilling operation shall driven equipment be allowed to operate closer than four feet, measured horizontally, to any part of a structure. Under no circumstances shall equipment be driven over any part of a concrete structure or pipe unless there is a compacted fill of twenty-four inches or greater over the structure or pipe.

IV. PIPE CONDUITS

All pipes shall be circular in cross section.

A. Corrugated Metal Pipe

1. Materials - (Steel Pipe) - This pipe and its appurtenances shall be galvanized and fully bituminous coated and shall conform to the requirements of AASHTO Specification M-190 Type A with watertight coupling bands. Any bituminous coating damaged or otherwise removed shall be replaced with cold applied bituminous coating compound.

Steel pipes with polymeric coatings shall have a minimum coating thickness of 0.01 inch (10 mil) on both sides of the pipe. The following coatings are commercially available: Nexon, Plastico-Crete, Blast-Klad, and Beth-Cut-Down. Coated corrugated steel pipe shall meet the requirements of AASHTO M-245 and M-246.

2. Connections - All connections with pipes must be completely watertight. The drain pipe or barrel connection to the riser shall be welded all around when the pipe and riser are metal. Watertight coupling bands or flanges shall be used at all joints. Anti-seep collars shall be connected to the pipe in such a manner as to the completely watertight. Dimple bands are not considered to be watertight.

3. Bedding - The pipe shall be firmly and uniformly bedded throughout its entire length. Where rock or soft, spongy or other unstable soil is encountered, all such material shall be removed and replaced with suitable earth compacted to provide adequate support.

4. Laying Pipe - The pipe shall be placed with inside circumferential laps pointing downstream and with the longitudinal laps at the sides.

5. Backfilling shall conform to structural backfill as shown above.

6. Other details (anti-seep collars, valves, etc.) shall be as shown on the drawings.

V. CONCRETE

1. Materials

a. Cement - Normal Portland cement shall conform to the latest ASTM Specification C-150.

b. Water - The water used in concrete shall be clean, free from oil, acids, alkalis, scales, organic matter or other objectionable substances.

c. Sand - The sand used in concrete shall be clean, hard, strong and durable, and shall be well graded with 100 percent passing a one-quarter inch sieve. Limestone sand shall not be used.

d. Coarse Aggregate - The coarse aggregate shall be clean, hard, strong and durable, and free from clay or dirt. It shall be well graded with a maximum size of one and one-half (1-1/2) inches.

e. Reinforcing Steel - The reinforcing steel shall be deformed bars of intermediate grade billet steel or rail steel conforming to ASTM Specification A-615.

2. Design Mix - The concrete shall be mixed in the following proportions, measured by weight. The water-cement ratio shall be 5-1/2 to 6 U.S. Gallons of water per 94 pound bag of cement. The proportion of materials for the trial mix shall be 1:1:2-1/2. The combination of aggregates may be adjusted to produce a plastic and workable mix that will not produce harshness in placing or honeycombing in the structure.

3. Mixing - The concrete ingredients shall be mixed in batch mixers until the mixture is homogeneous and of uniform consistency. The mixing of each batch shall continue for not less than one and one-half minutes after all the ingredients, except the full amount of water, are in the mixer. The minimum mixing time is predicted on proper control of the speed of rotation of the mixer and of the introduction of the materials, including water, into the mixer. Water shall be added prior to, during, and following the mixer-charging operations. Excessive overmixing requiring the addition of water to preserve the required concrete consistency shall not be permitted. Truck mixing will be allowed provided that the use of this method shall cause no violation of any applicable provisions of the specifications given here.

4. Forms - The forms shall have sufficient strength and rigidity to hold the concrete and to withstand the necessary pressure, tamping, and vibration without deflection from the prescribed lines. They shall be mortar-tight and constructed so that they can be removed without hammering or prying against the concrete. The inside of forms shall be oiled with a non-staining mineral oil or thoroughly wetted before concrete is placed. Forms may be removed 24 hours after the placement of concrete. All wire ties and other devices used shall be removed from the surface of the concrete.

5. Reinforcing Steel - All reinforcing material shall be free of dirt, rust, scale, oil, paint or any other coatings. The steel shall be accurately placed and securely tied and blocked into position so that no movement of the steel will occur during placement of concrete.

6. Consolidating - Concrete shall be consolidated with internal type mechanical vibrators. Vibration shall be supplemented by spading and hand tamping as necessary to insure smooth and dense concrete along form surfaces, in corners, and around embedded items.

7. Finishing - Defective concrete, honeycombed areas, voids left by the removal of the rods, ridges on all concrete surfaces permanently exposed to view or exposed to water on the finished structure, shall be repaired immediately after the removal of forms. All voids shall be reamed and completely filled with dry-patching mortar.

8. Protection and Curing - Exposed surfaces of concrete shall be protected from the direct rays of the sun for at least the first three (3) days. All concrete shall be kept continuously moist for at least ten (10) days after being placed. Moisture may be applied by spraying or sprinkling as necessary to prevent the concrete from drying. Concrete shall not be exposed to freezing during the curing period. Curing compounds may also be used.

9. Placing Temperature - Concrete may not be placed at temperatures below 37° F with the temperature falling, or 34° with the temperature rising.

VI. STABILIZATION

All borrow areas shall be graded to provide proper drainage and left in a slightly condition. All exposed surfaces of the embankment, spillway, spoil and borrow areas, and berms shall be stabilized by seeding, liming, fertilizing and mulching (if required) in accordance with the vegetative treatment specifications or as shown on the accompanying drawings.

VII. EROSION AND SEDIMENT CONTROL

Construction operations will be carried out in such a manner that erosion will be controlled and water and air pollution minimized. State and local laws concerning pollution abatement will be followed. Construction plans shall detail erosion and sediment control measures to be employed during the construction process.

SIGNATURE BLOCK
3-14-90
com

SEDIMENT CONTROL & POND CONSTRUCTION

() By the Developer:

"I/We certify that all development and/or construction will be done according to these plans, and that any responsible personnel involved in the construction project will have a Certificate of Attendance at a Department of Natural Resources Approved Training Program for the Control of Sediment and Erosion before beginning the project. I will provide the Howard Soil Conservation District with an "as-built" plan of the pond within 30 days of completion. I also authorize periodic on-site inspections by the Howard Soil Conservation District."

Douglas L. Dizon 4-13-90
Signature of Developer Date
Print name below signature

() By the Engineer:

"I certify that this plan for pond construction, erosion and sediment control represents a practical and workable plan based on my personal knowledge of the site conditions. This plan was prepared in accordance with the requirements of the Howard Soil Conservation District. I have notified the developer that he must provide the Howard Soil Conservation District with an "as-built" plan of the pond within 30 days of completion."

D. Kallas 4/13/90
Signature of Engineer Date
Print name below signature

() These plans have been reviewed for the Howard Soil Conservation District and meet the technical requirements for small pond construction, soil erosion and sediment control.

U.S. Soil Conservation Service Date

() These plans for small pond construction, soil erosion and sediment control meet the requirements of the Howard Soil Conservation District.

Howard Soil Conservation District Date

ENGINEER'S CERTIFICATE
I HEREBY CERTIFY THAT THIS PLAN FOR EROSION AND SEDIMENT CONTROL REPRESENTS A PRACTICAL AND WORKABLE PLAN BASED ON MY PERSONAL KNOWLEDGE OF THE SITE CONDITIONS AND THAT IT WAS PREPARED IN ACCORDANCE WITH THE REQUIREMENTS OF THE HOWARD SOIL CONSERVATION DISTRICT.
D. Kallas 4/13/90
SIGNATURE OF ENGINEER DATE

DEVELOPER'S CERTIFICATE
I/WE CERTIFY THAT ALL DEVELOPMENT AND CONSTRUCTION WILL BE DONE ACCORDING TO THIS PLAN OF DEVELOPMENT AND PLAN FOR EROSION AND SEDIMENT CONTROL AND THAT ALL RESPONSIBLE PERSONNEL INVOLVED IN THE CONSTRUCTION PROJECT WILL HAVE A CERTIFICATE OF ATTENDANCE AT A DEPARTMENT OF NATURAL RESOURCES APPROVED TRAINING PROGRAM FOR THE CONTROL OF SEDIMENT AND EROSION BEFORE BEGINNING THE PROJECT. I ALSO AUTHORIZE PERIODIC ON-SITE INSPECTION BY THE HOWARD SOIL CONSERVATION DISTRICT OR THEIR AUTHORIZED AGENTS WHEN DEEMED NECESSARY.
Douglas L. Dizon 4-13-90
SIGNATURE OF DEVELOPER DATE

APPROVED FOR PUBLIC WATER AND PUBLIC SEWERAGE SYSTEMS, HOWARD COUNTY HEALTH DEPARTMENT
Joan Boyer 11-15-91
COUNTY HEALTH OFFICER DATE





APPROVED HOWARD COUNTY DEPARTMENT OF PLANNING AND ZONING
James Satter 12/20/91
DIRECTOR DATE
Emma H. H. H. 12/20/91
CHIEF DIVISION OF COMMUNITY PLANNING AND LAND DEVELOPMENT DATE

APPROVED FOR PUBLIC WATER AND PUBLIC SEWERAGE SYSTEMS, DRAINAGE SYSTEMS AND PUBLIC ROADS, HOWARD COUNTY DEPARTMENT OF PUBLIC WORKS
James J. ... 12/16/91
DIRECTOR DATE
... 12/16/91
CHIEF BUREAU OF ENGINEERING DATE

REVIEWED FOR HOWARD COUNTY SOIL CONSERVATION DISTRICT AND MEETS TECHNICAL REQUIREMENTS
John ... 4-18-90
U.S. Soil Conservation Service Date
John ... 4/19/90
Howard Soil Conservation District Date


GENERAL NOTES

- ALL WORK SHALL BE DONE IN ACCORDANCE WITH HOWARD COUNTY STANDARDS, SPECIFICATIONS AND DETAILS FOR CONSTRUCTION.
- ANY DAMAGE TO PUBLIC RIGHT-OF-WAY, PAVING OR EXISTING UTILITIES WILL BE CORRECTED AT THE EXPENSE OF CONTRACTOR.
- ALL UTILITY COMPANIES MUST BE NOTIFIED 24 HOURS IN ADVANCE OF AN CONSTRUCTION.
- THE LAND INCLUDED IN THIS PLAN IS ZONED: POR (Planned Office & Research)
- THE AREA SHOWN IN THIS SUBMISSION IS LOCATED ON ZONE MAP NO: 30
- TYPE OF SOIL: MANOR LOAM
- THE CONTRACTOR OR DEVELOPER SHALL CONTACT THE CONSTRUCTION INSPECTION/SURVEY DIVISION, 24 HOURS IN ADVANCE OF COMMENCEMENT OF WORK AT 792-7272"

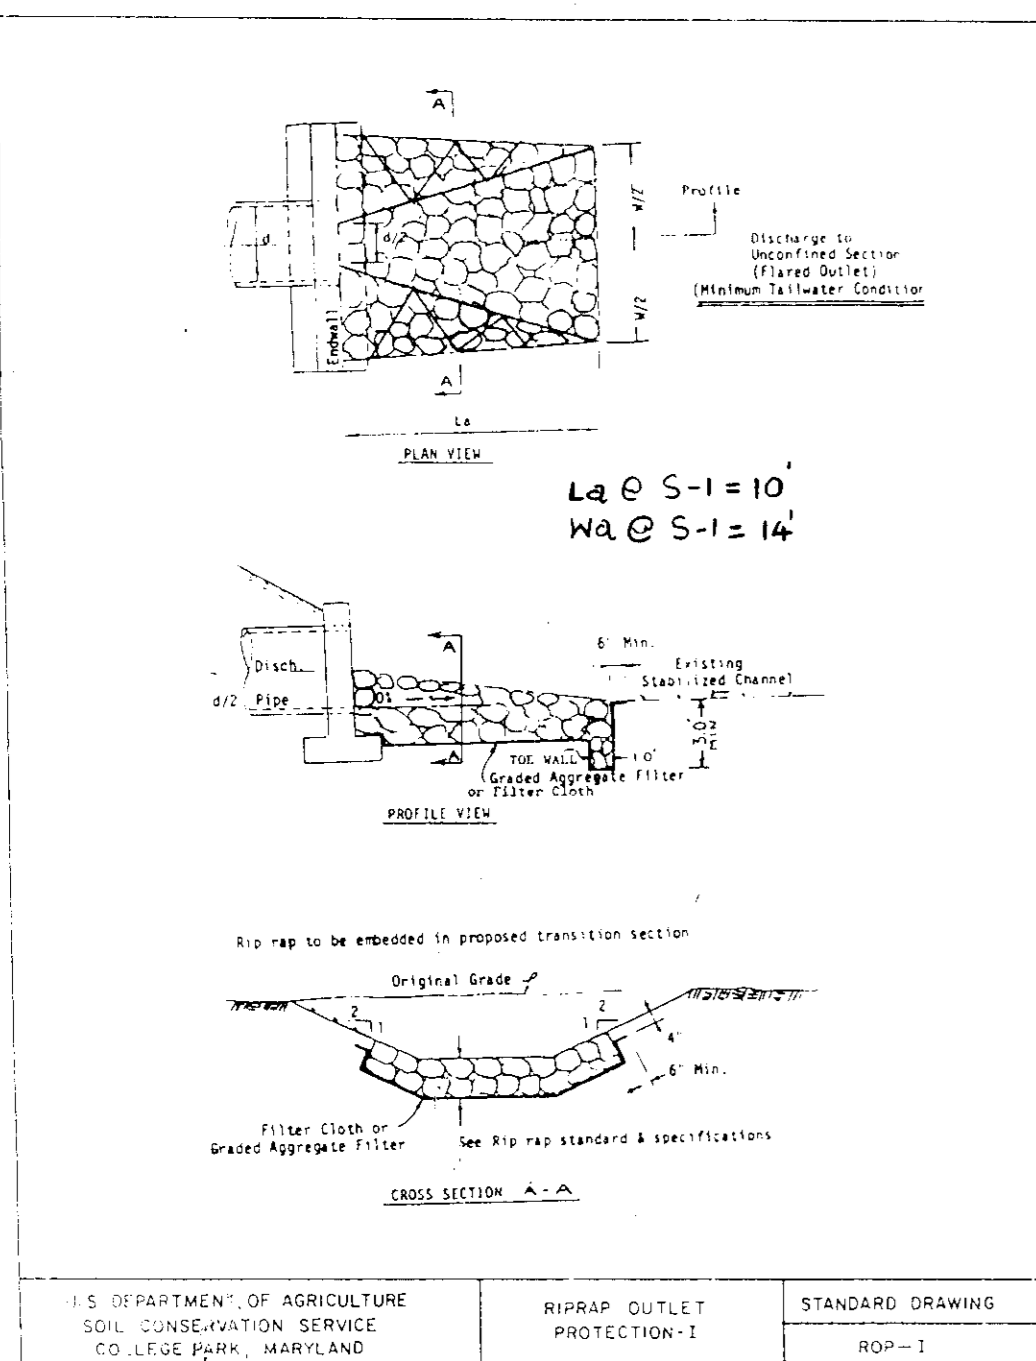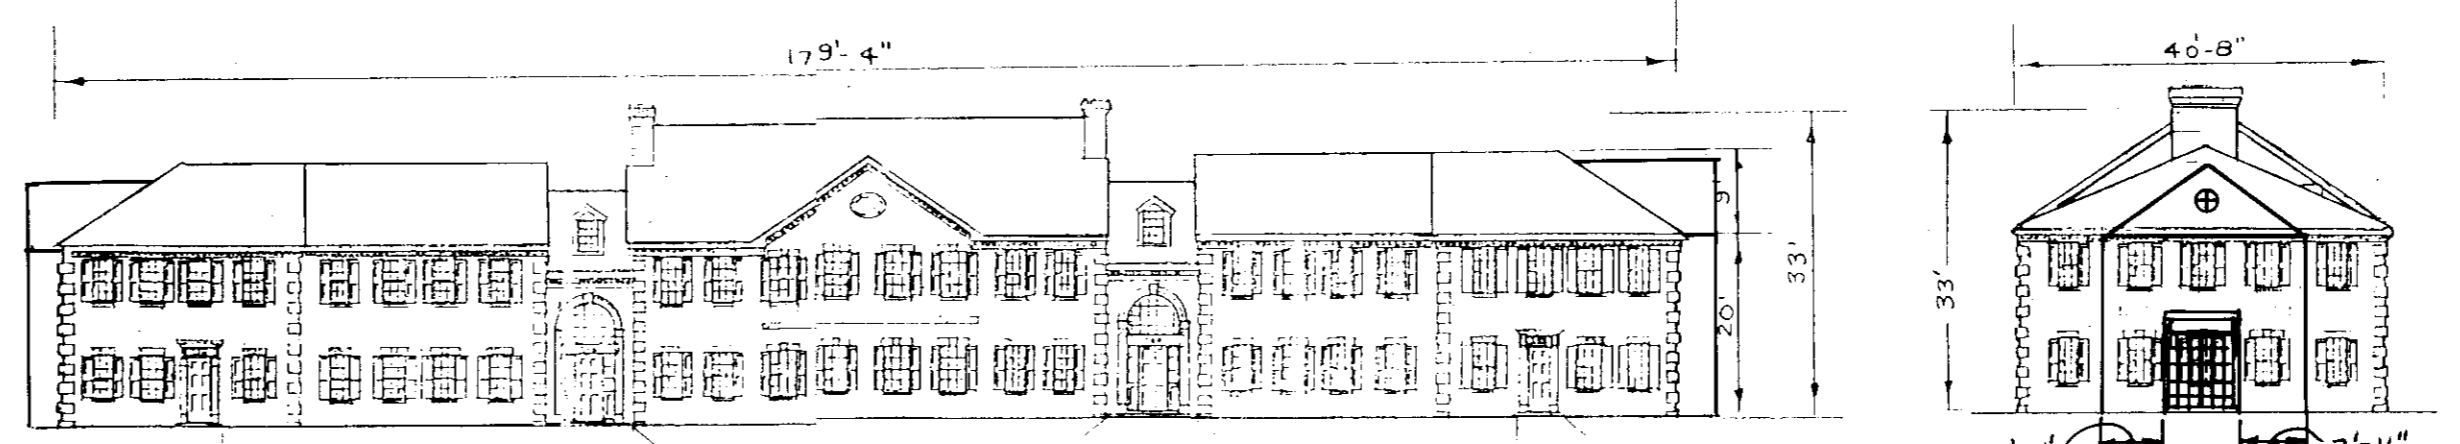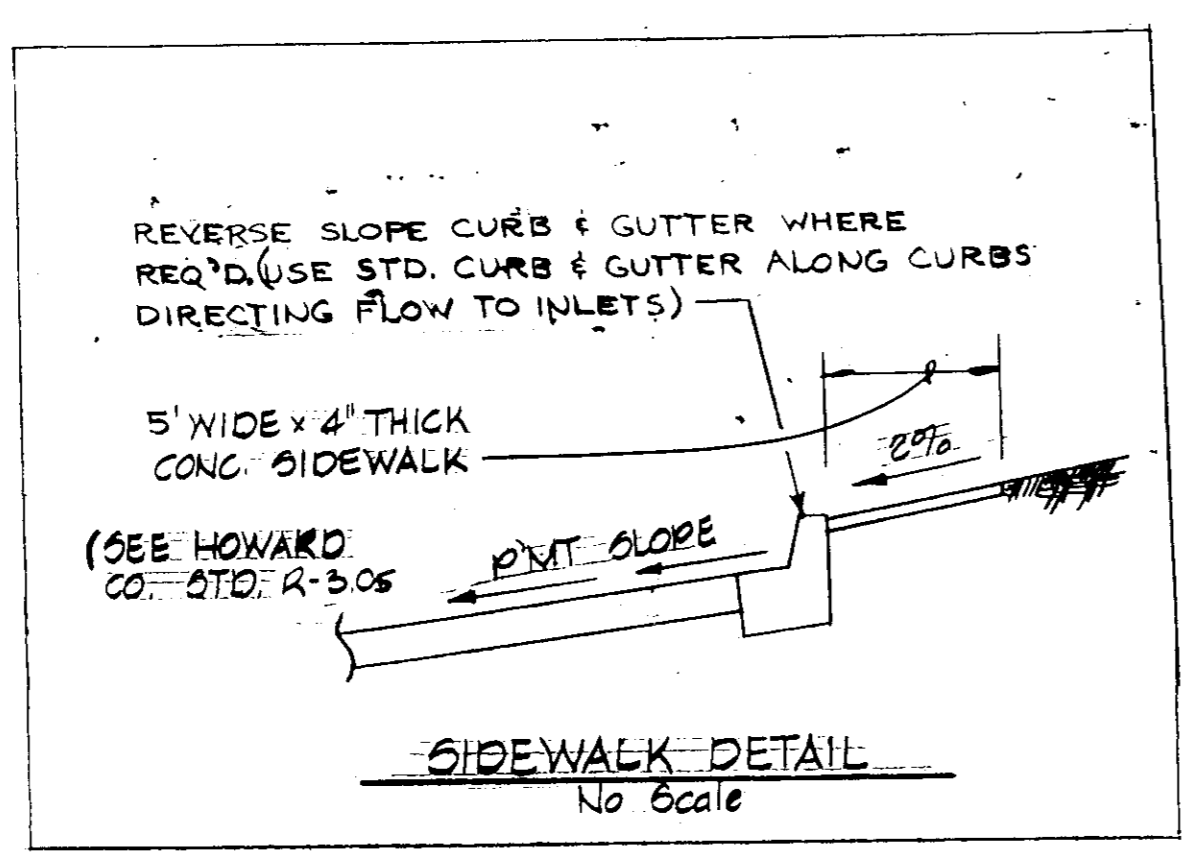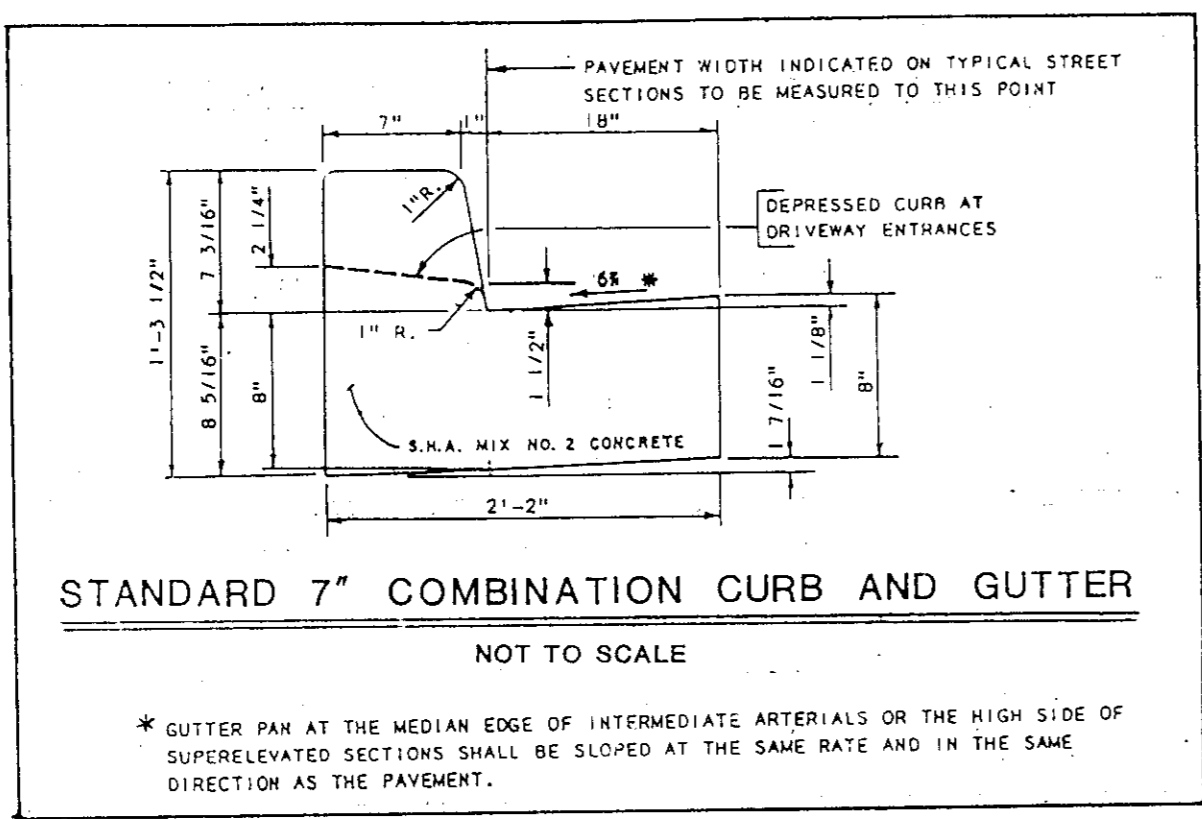










REVISIONS	
NO.	DESCRIPTION
1	3/89 DATE BY WHN Blg. Addition Group 'A' & 'C'
2	3/89 DATE BY WHN
3	3/89 DATE BY RHJ

ENGINEERING TECHNOLOGIES ASSOCIATES, INC.
ENGINEERS, PLANNERS, SURVEYORS
3458 ELLICOTT CENTER DRIVE SUITE 101
ELLICOTT CITY, MD 21043
(301) 461-9920

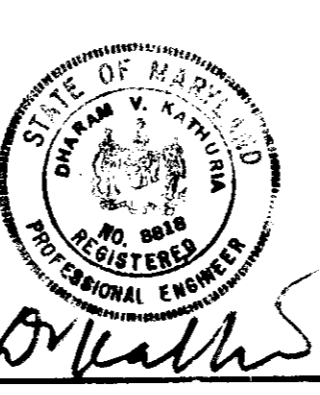

OWNER / DEVELOPER
ELLCOTT RIDGE CORPORATION II
DYSON CONSTRUCTION CO. INC.
3443 ELLICOTT CENTER DRIVE, SUITE 101
ELLICOTT CITY, MARYLAND 21043
(301) 461-4188

POND SPECIFICATIONS AND GENERAL DETAILS
DORSEY HALL
(OFFICE CONDOMINIUMS)
SECTION - 2 AREA - 5 PARCEL N-2
2ND ELECTION DISTRICT, HOWARD COUNTY, MARYLAND
SCALE AS SHOWN CONTRACT NO. DATE 3/89 SHEET 2 OF 7

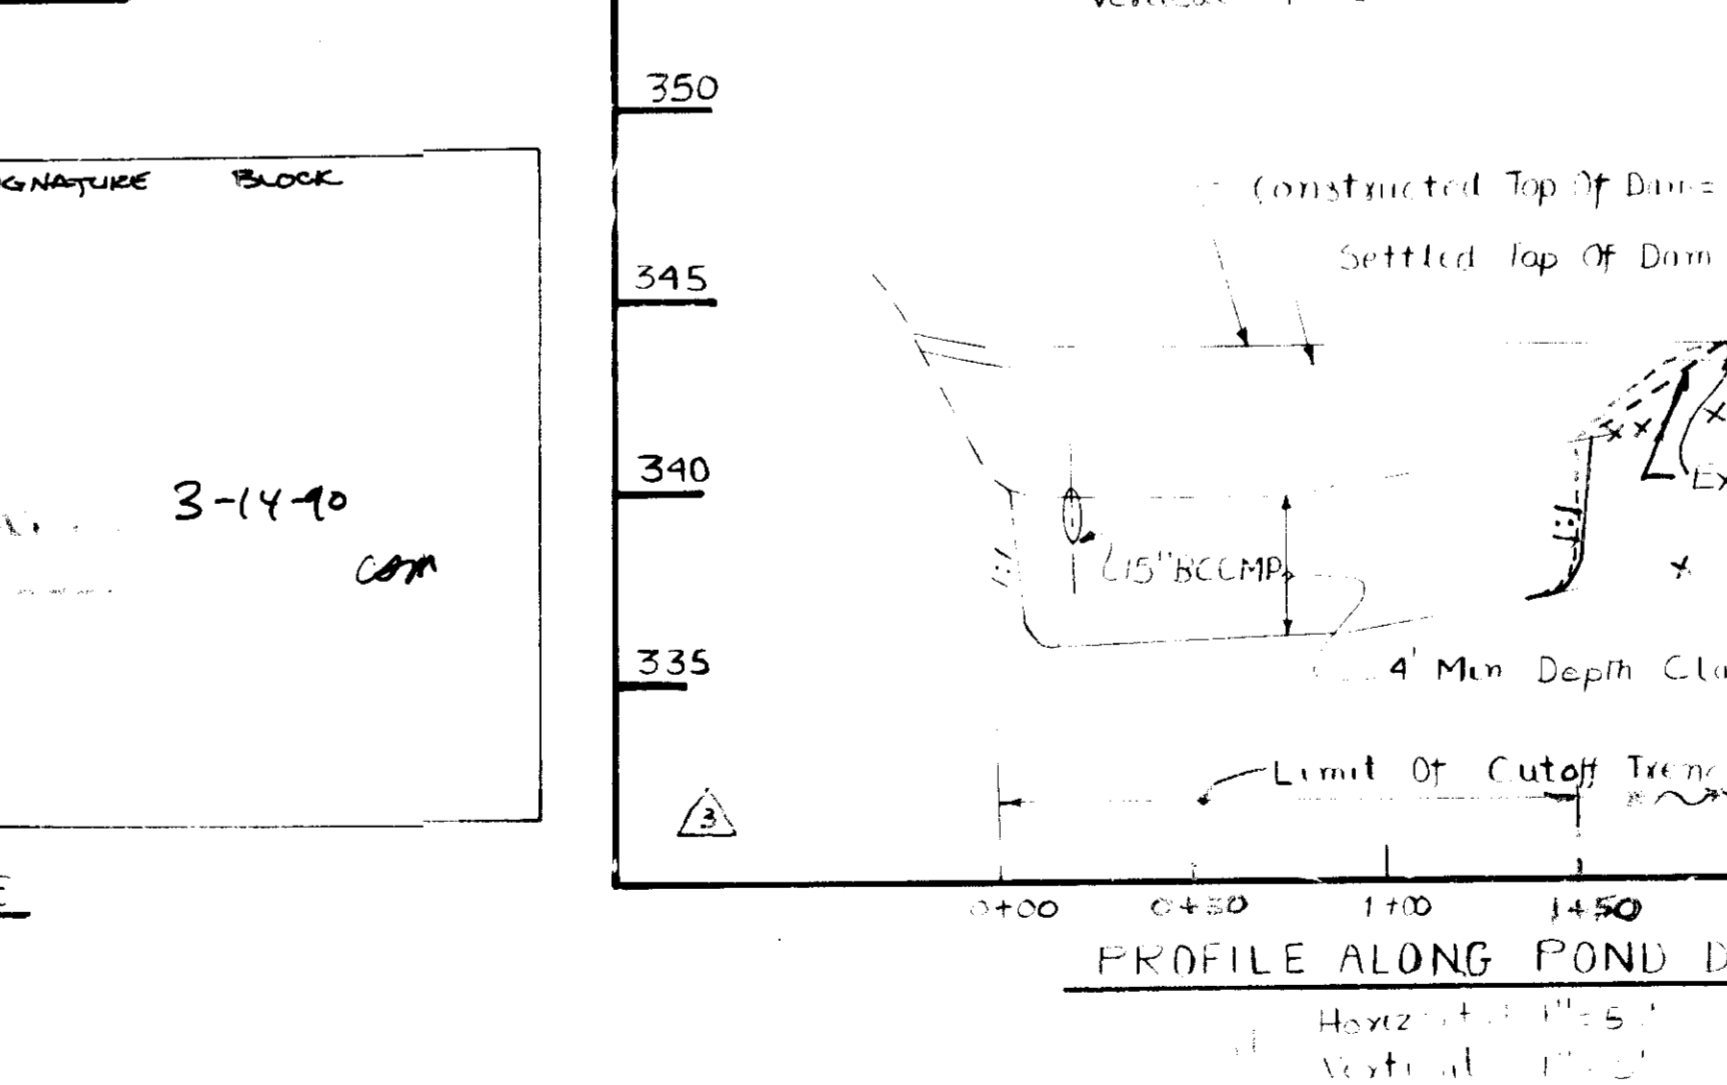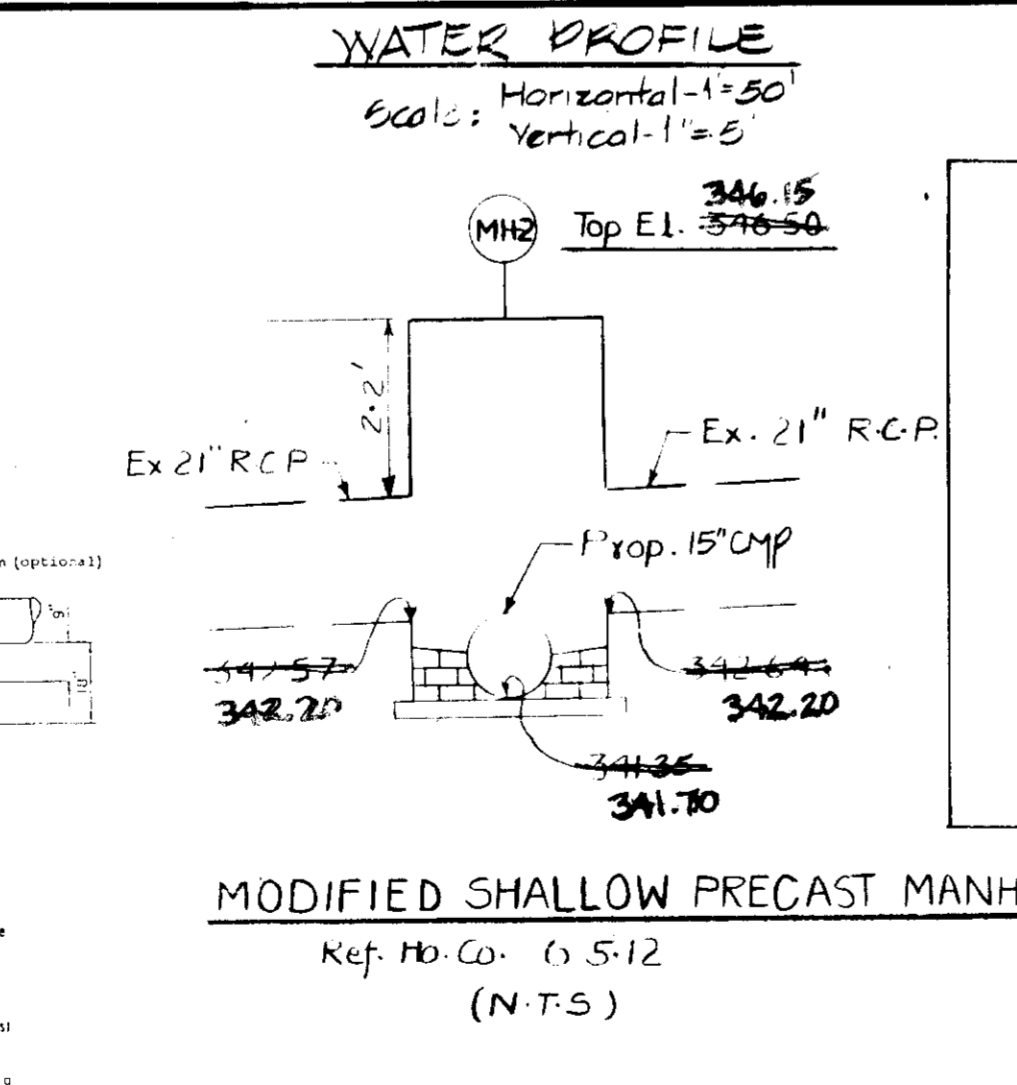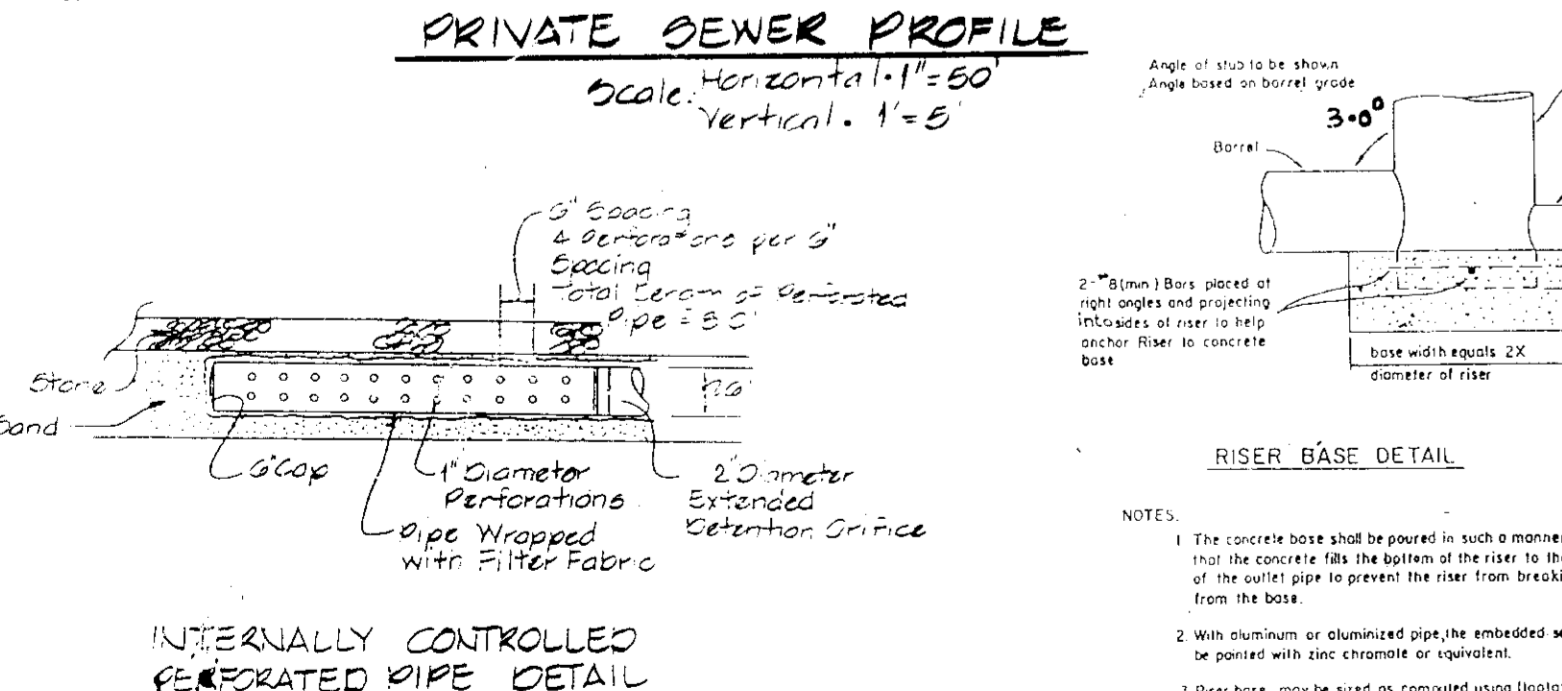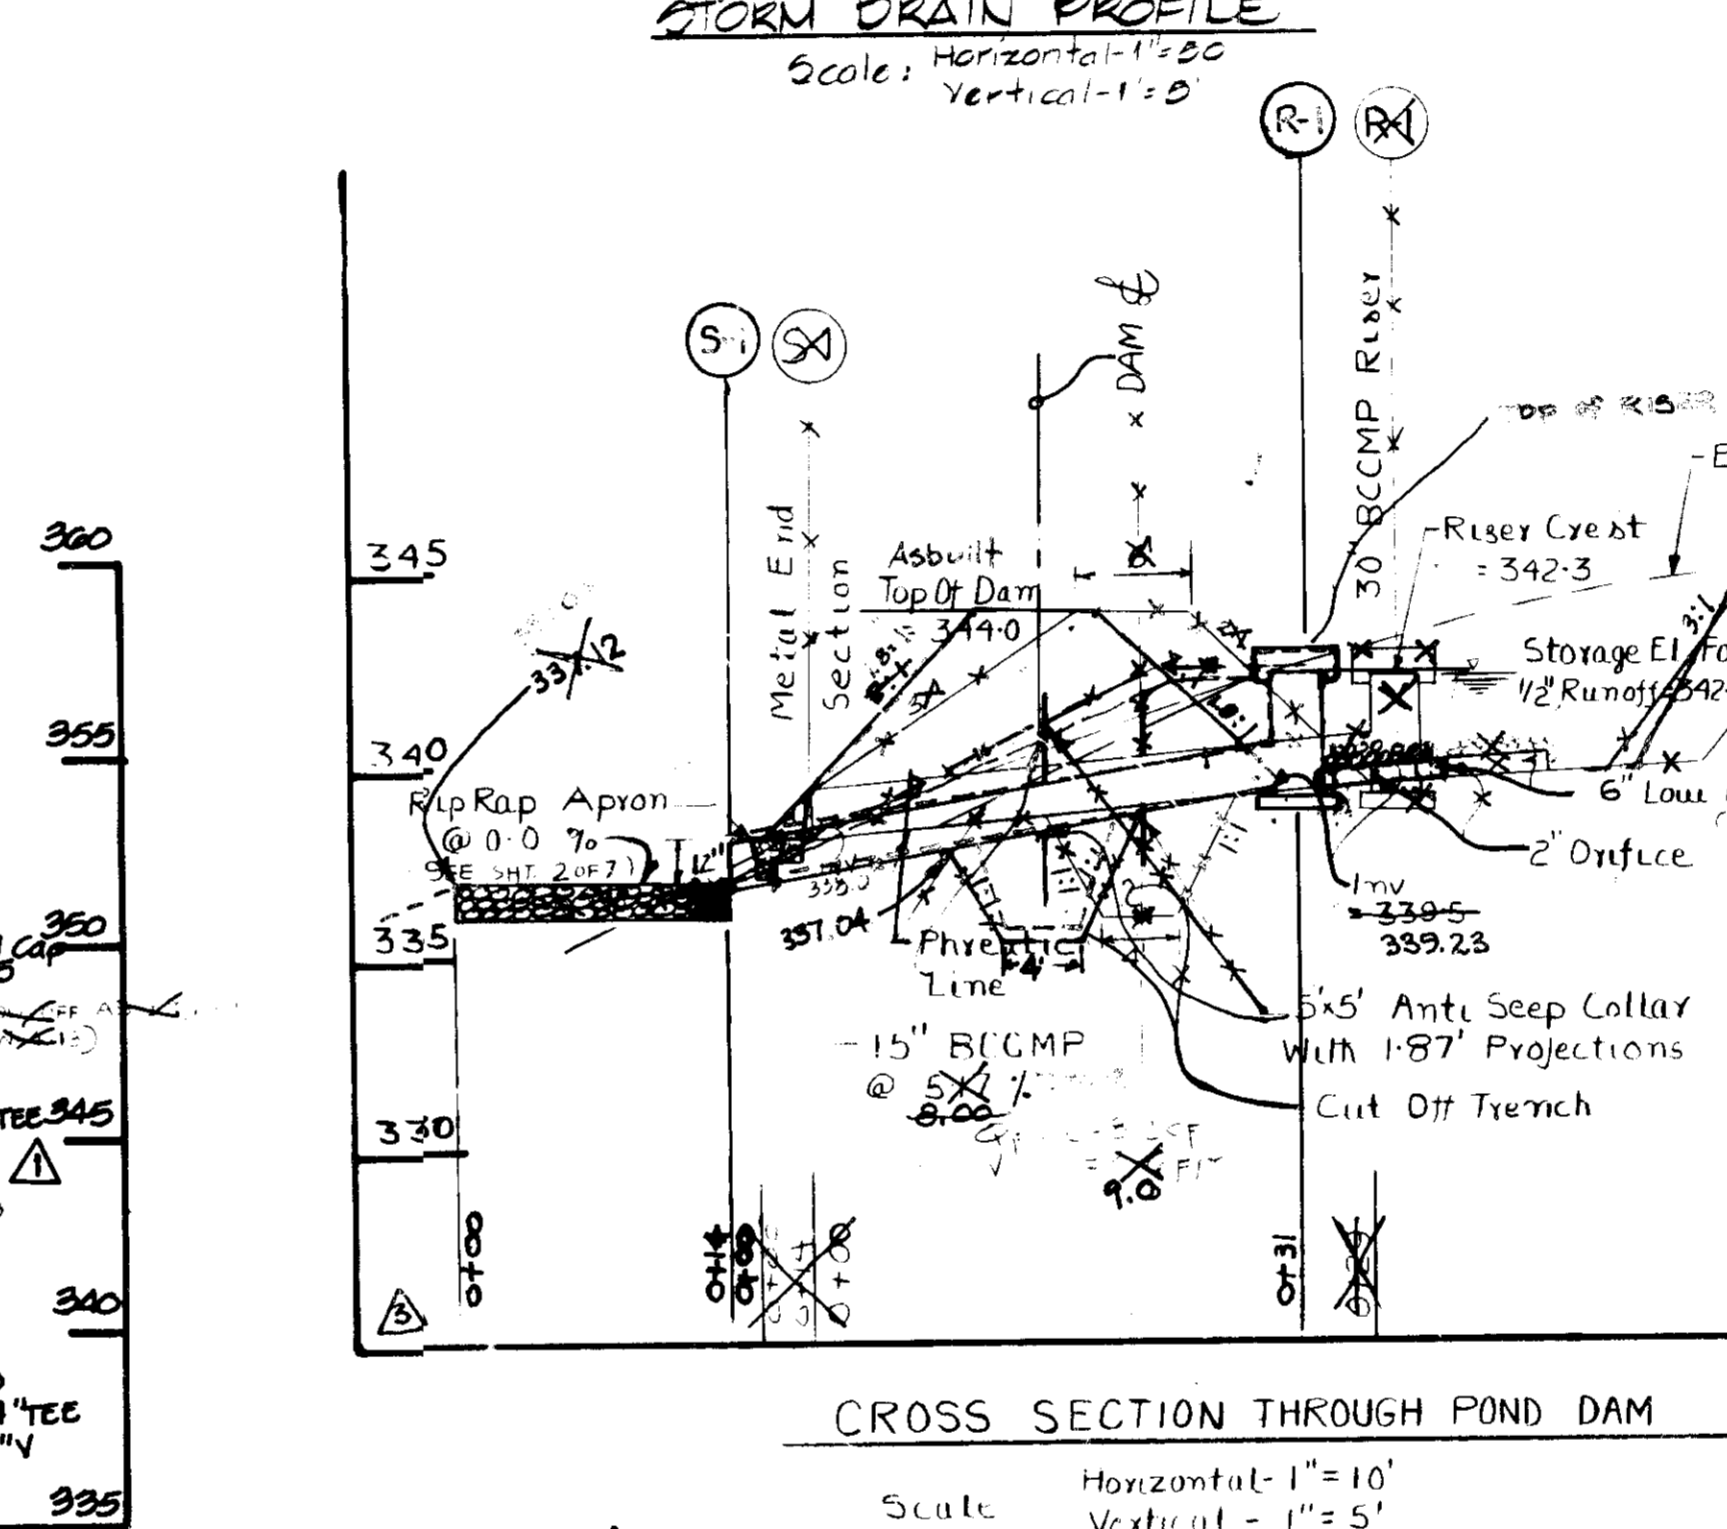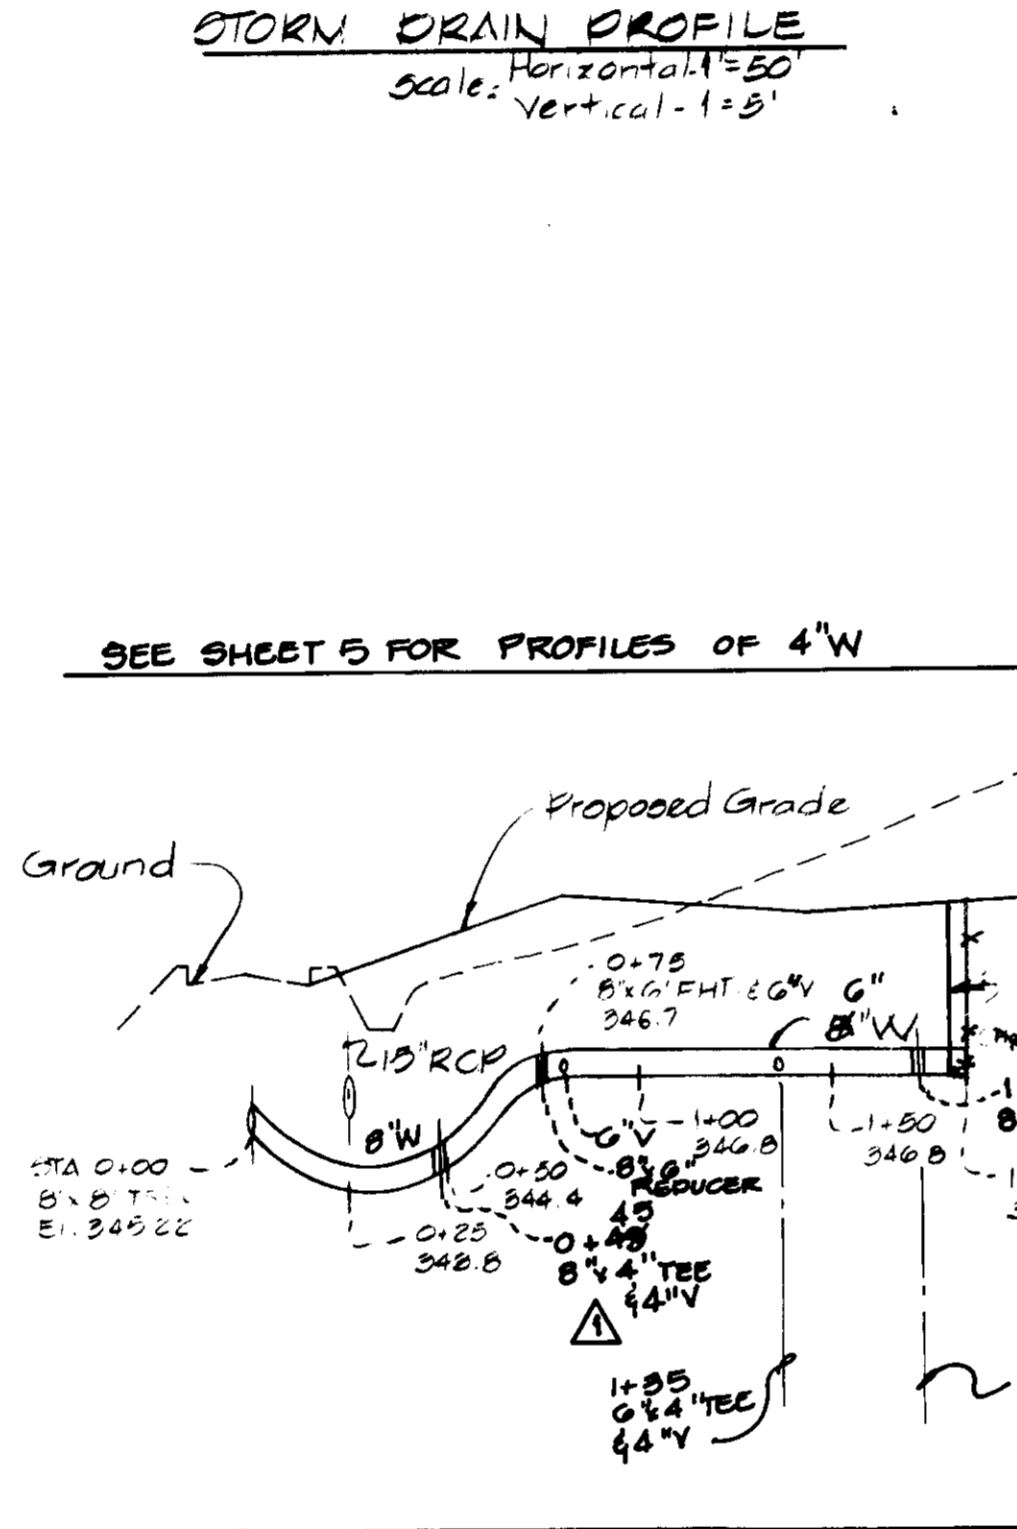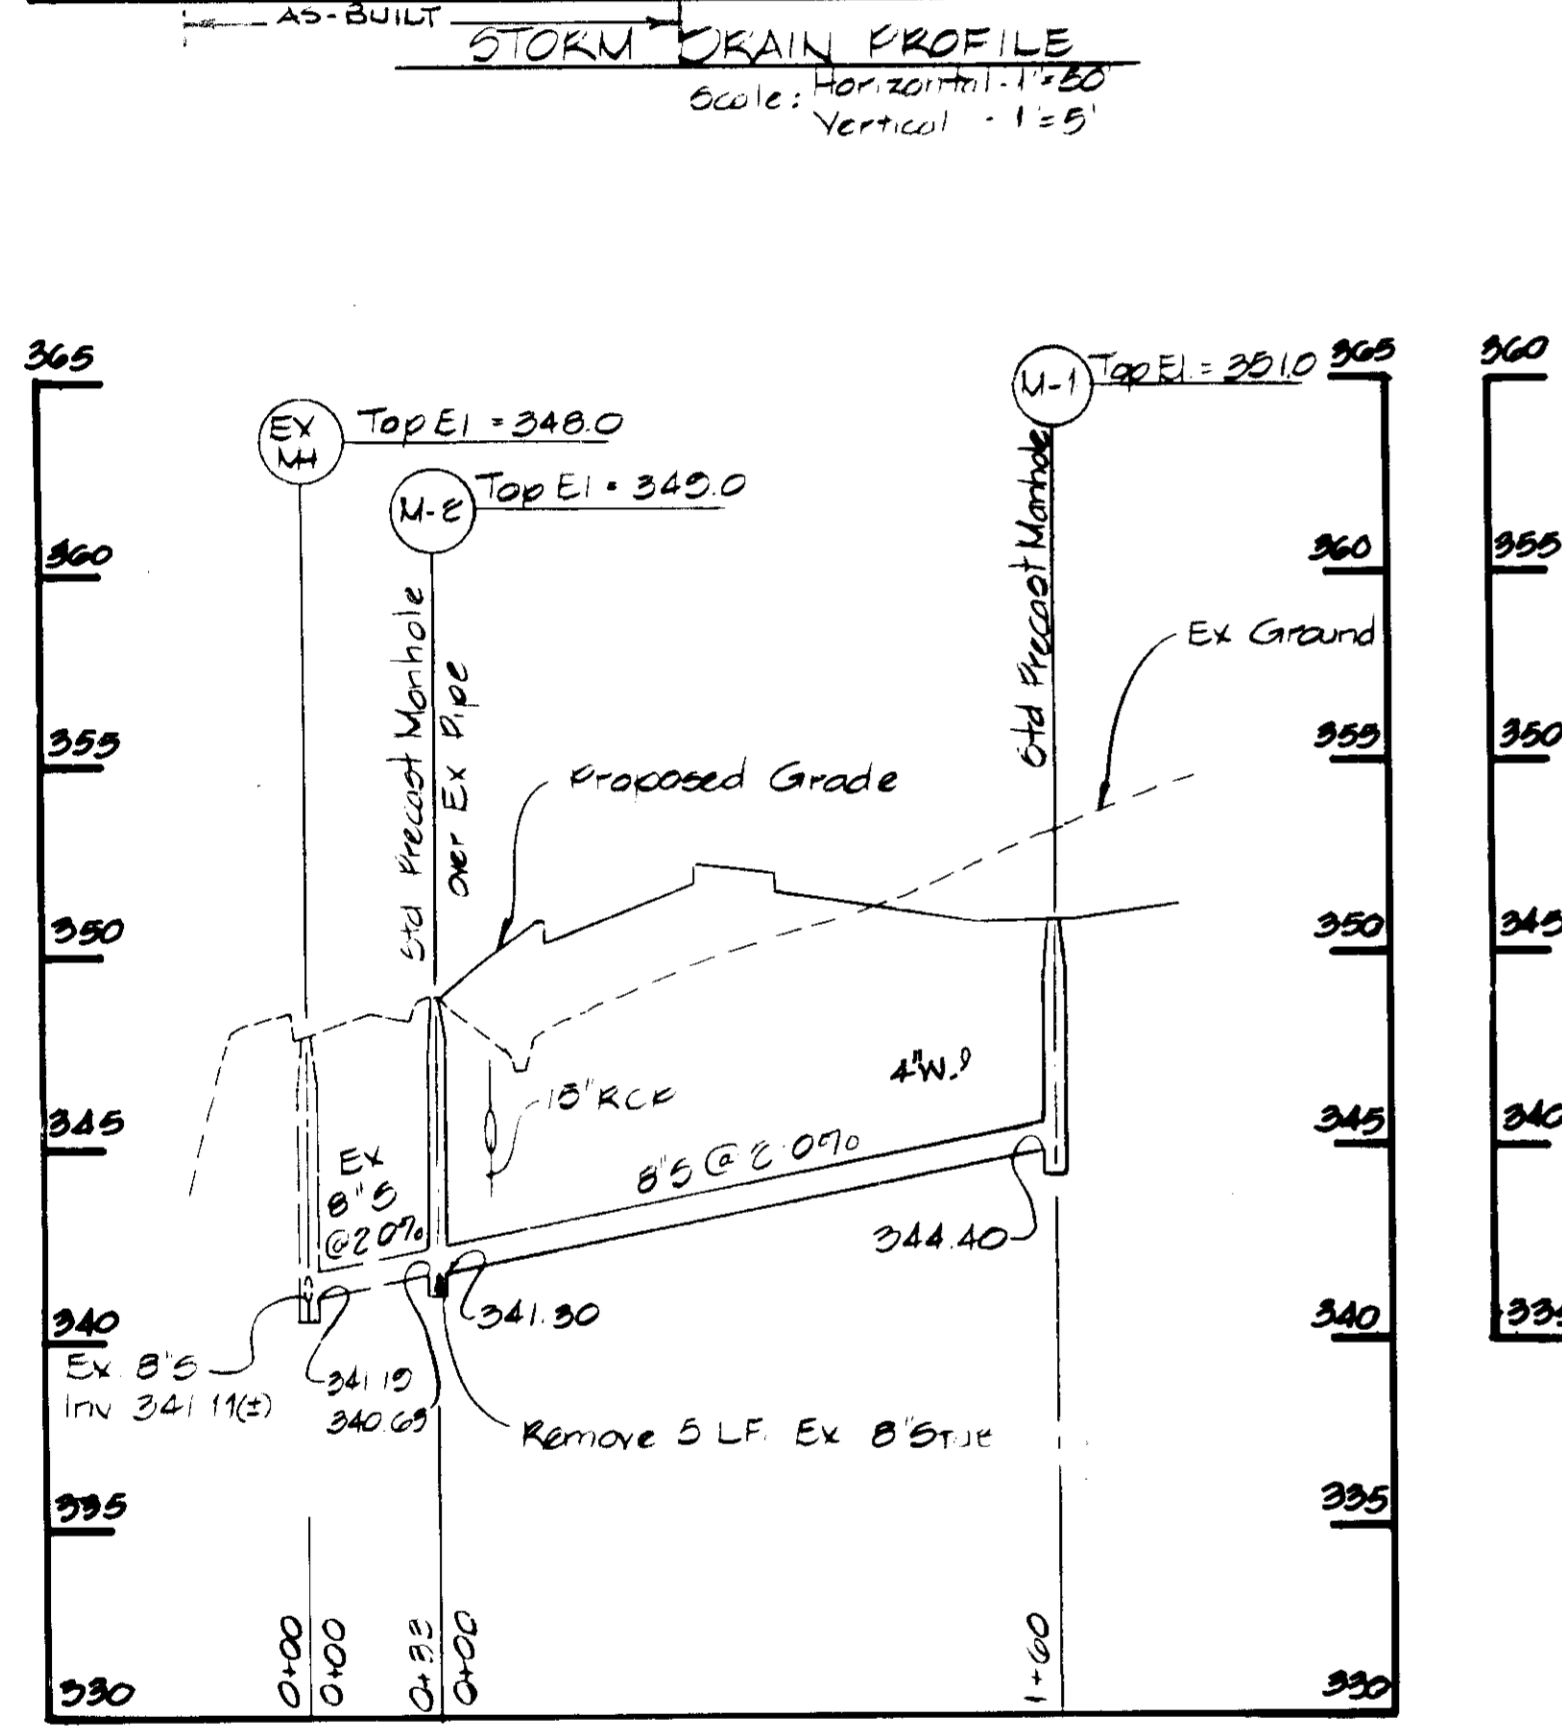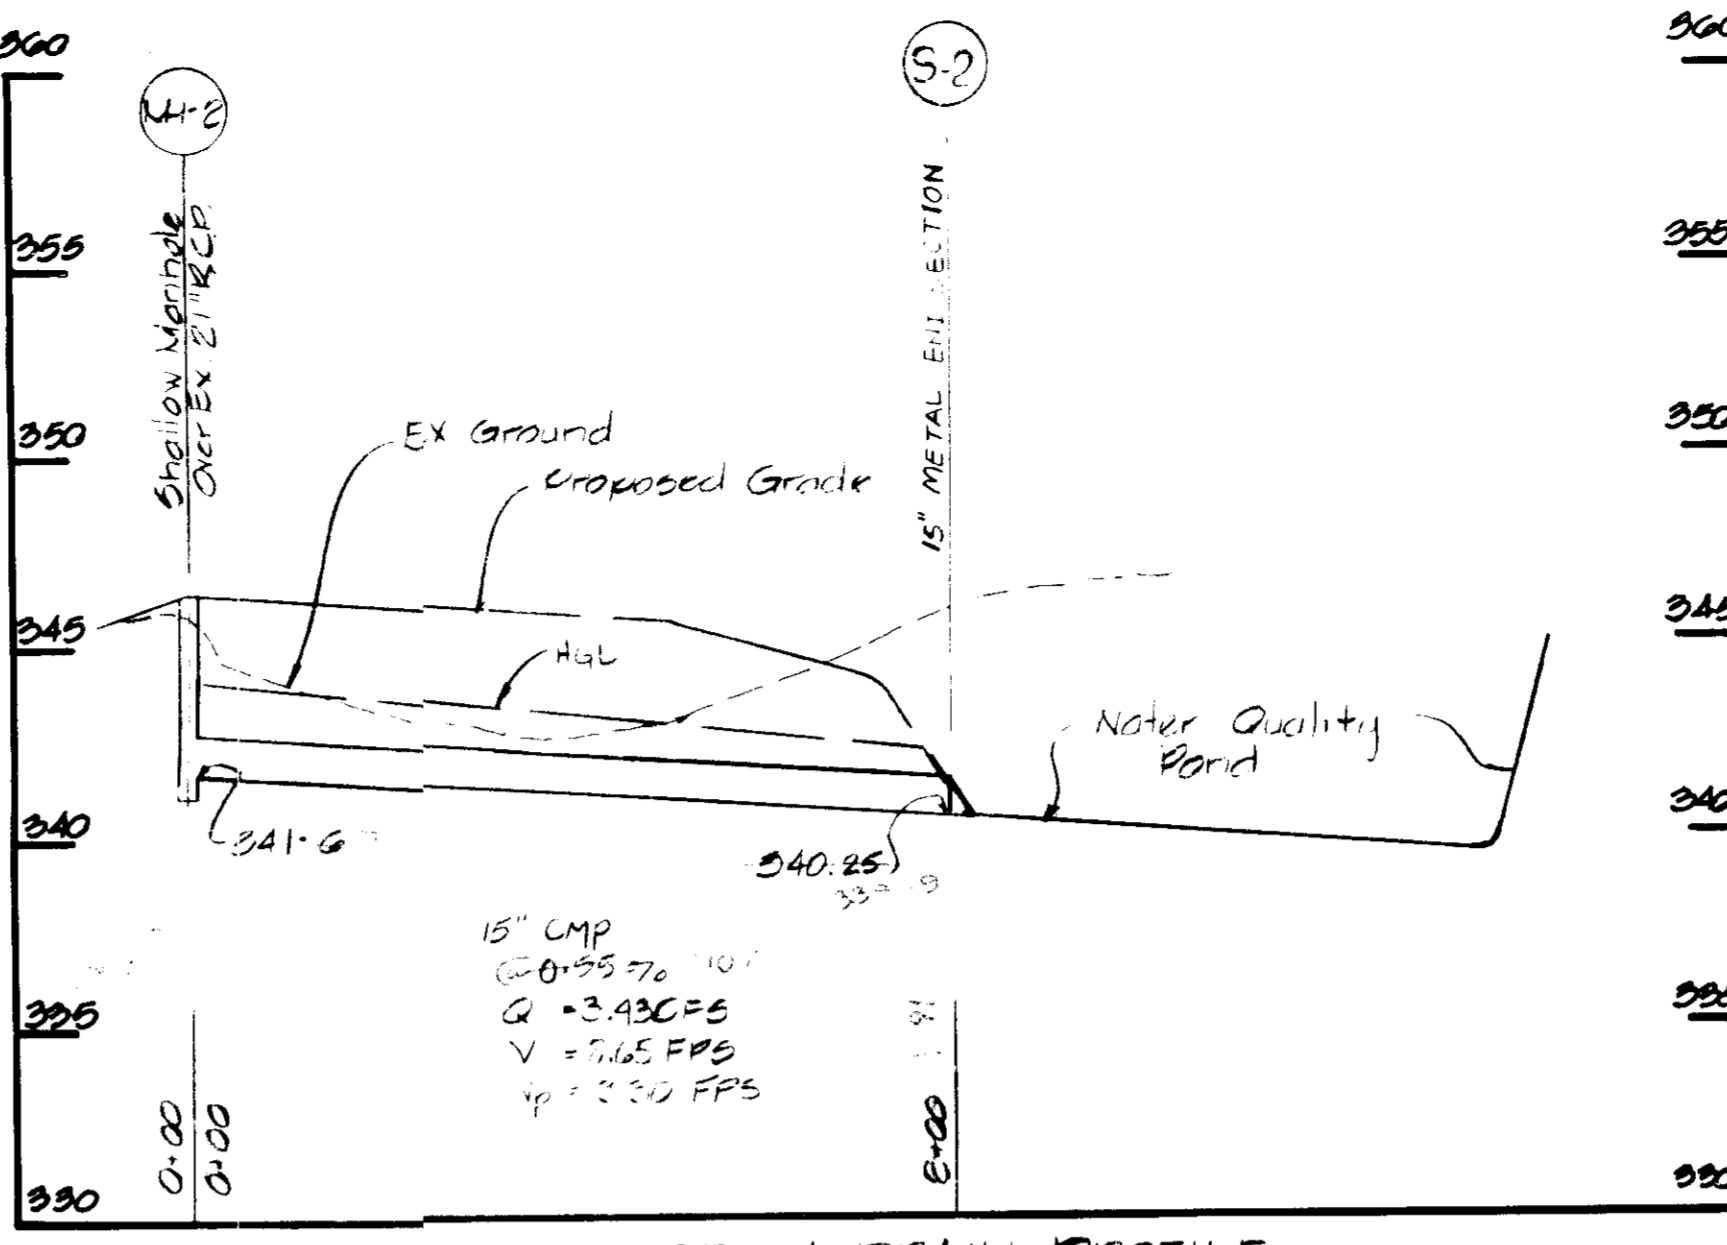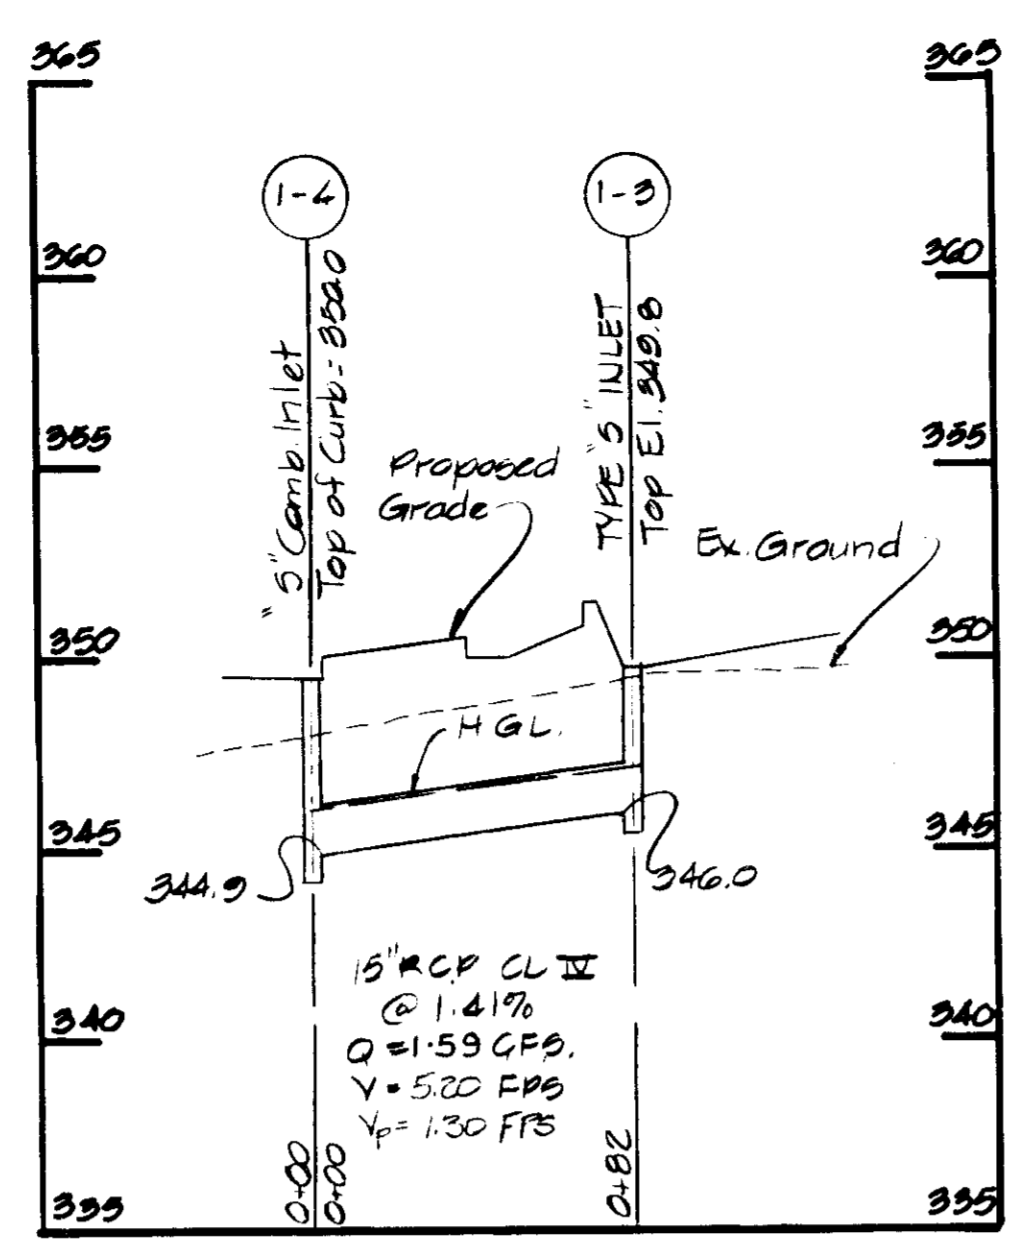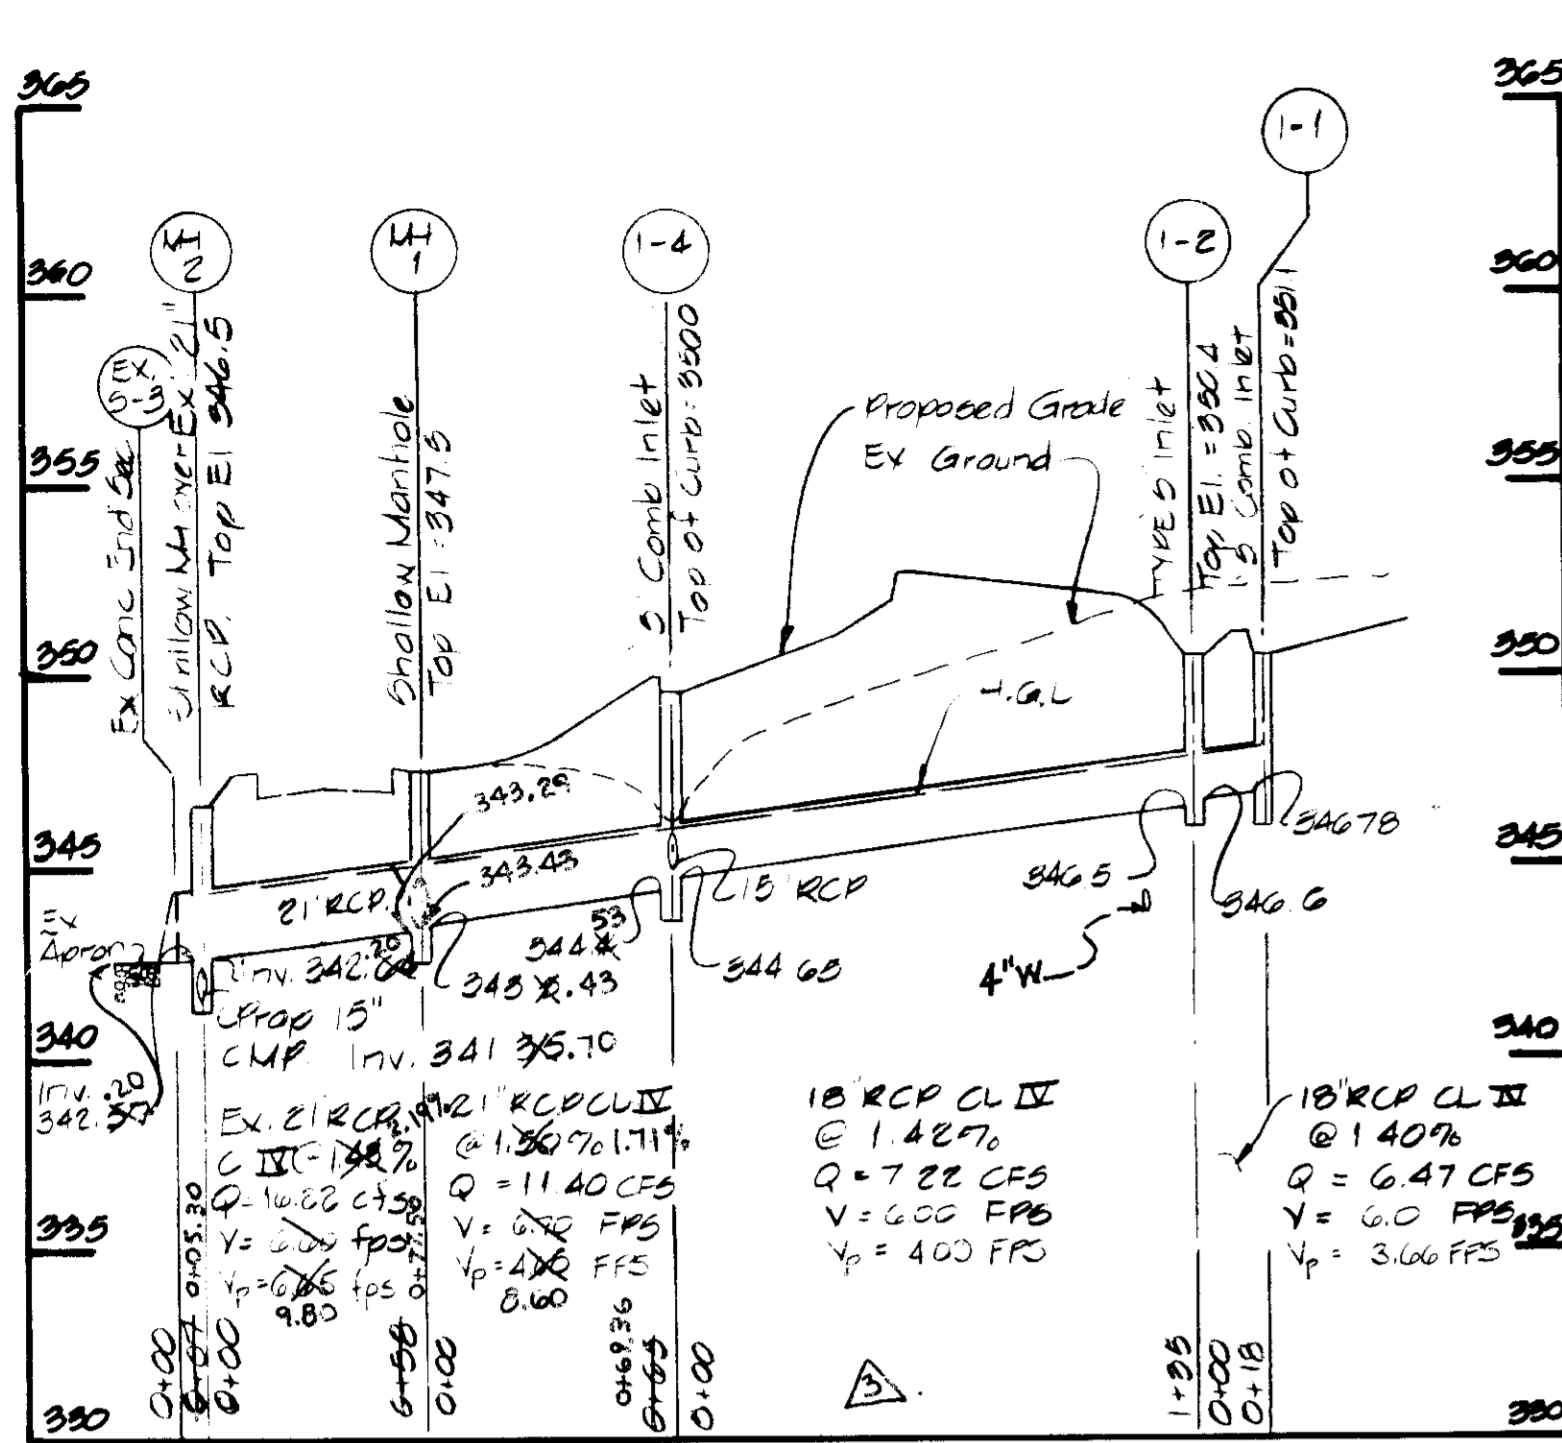

I, the undersigned, hereby certify that all development and construction will be done according to the plans and that any responsible personnel involved in the construction project will have a Certificate of Attendance at a Department of Natural Resources Approved Training Program for the Control of Erosion and Sedimentation before beginning the project. I will provide the Howard Soil Conservation District with a "best-management" plan for the pond which will be approved by the District. I also authorize the District to inspect the project by the Howard Soil Conservation District.

David A. Gunn 6-3-94
 Signature of Developer
 Print name below signature

Douglas L. Dym 4-13-90
 Signature of Engineer
 Print name below signature

By the Engineer:
 I certify that this project meets construction, erosion and sediment control requirements and that the plan based on my personal knowledge of the site conditions. This plan was prepared in accordance with the requirements of the Howard Soil Conservation District. I have notified the developer that he must provide the Howard Soil Conservation District with an approved plan of the pond within 30 days of completion.

D. Hall 4/13/90
 Signature of Engineer
 Print name below signature

These plans have been reviewed for the Howard Soil Conservation District and meet the requirements for construction, soil erosion and sediment control.

U.S. Soil Conservation Service Date

These plans for small pond construction, soil erosion and sediment control meet the requirements of the Howard Soil Conservation District.

Howard Soil Conservation District Date

APPROVED FOR PUBLIC WATER AND PUBLIC SEWERAGE BY HOWARD COUNTY HEALTH DEPARTMENT
John R. Robertson 11-5-91
 COUNTY HEALTH OFFICER DATE

APPROVED HOWARD COUNTY DEPT. OF PLANNING & ZONING
Emma J. Helmond 12/20/91
 DIRECTOR DATE
 CHIEF DIVISION OF COMMUNITY PLANNING AND LAND DEVELOPMENT DATE

APPROVED FOR PUBLIC WATER AND PUBLIC SEWERAGE BY DRAINAGE SYSTEMS AND PUBLIC ROADS HOWARD COUNTY DEPARTMENT OF PUBLIC WORKS
James P. Lee 11/6/91
 DIRECTOR DATE
 CHIEF BUREAU OF ENGINEERING DATE

REVIEWED FOR HOWARD COUNTY SOIL CONSERVATION DISTRICT AND METS TECHNICAL REQUIREMENTS
John R. Robertson 4-18-90
 SOIL CONSERVATION SERVICE DATE

THE DEVELOPMENT IS APPROVED FOR EROSION AND SEDIMENT CONTROL BY HOWARD SOIL CONSERVATION DISTRICT
John R. Robertson 4/18/90
 SOIL CONSERVATION DISTRICT DATE

AN ENGINEER'S CERTIFICATE
 I HEREBY CERTIFY THAT THE PLANS FOR THIS DEVELOPMENT CONTAIN NECESSARY EROSION AND SEDIMENT CONTROL MEASURES AND THAT THE DEVELOPER HAS BEEN ADVISED OF THE REQUIREMENTS AND THAT HE HAS AGREED TO COMPLY WITH THE EROSION AND SEDIMENT CONTROL REQUIREMENTS.
D. Hall 4/13/90
 SIGNATURE OF ENGINEER DATE

BY THE ENGINEER
 I ME CERTIFY THAT ALL DEVELOPMENT AND CONSTRUCTION WILL BE DONE ACCORDING TO THE PLANS AND THAT ANY RESPONSIBLE PERSONNEL INVOLVED IN THE CONSTRUCTION PROJECT WILL HAVE A CERTIFICATE OF ATTENDANCE AT A DEPARTMENT OF NATURAL RESOURCES APPROVED TRAINING PROGRAM FOR THE CONTROL OF EROSION AND SEDIMENTATION BEFORE BEGINNING THE PROJECT. I WILL PROVIDE THE HOWARD SOIL CONSERVATION DISTRICT WITH A "BEST-MANAGEMENT" PLAN FOR THE POND WHICH WILL BE APPROVED BY THE DISTRICT. I ALSO AUTHORIZE THE DISTRICT TO INSPECT THE PROJECT BY THE HOWARD SOIL CONSERVATION DISTRICT.
Douglas L. Dym 4-13-90
 SIGNATURE OF ENGINEER DATE


DATE	BY	DESCRIPTION
9/89	WVP	ADDED 8" 4" TEE
7/89	RMC	Redline - Remove 1 1/2" NHC, Remove Blon-Off, Provide 8" 4" R, Florida 4" 3" add 4" W profiles
9/89	RHT	Redline - Revised Profiles
9-20-93	sqp	
	WHN	

ENGINEERING TECHNOLOGIES ASSOCIATES, INC.
 ENGINEERS, PLANNERS, SURVEYORS
 3458 ELLICOTT CENTER DRIVE, SUITE 101
 ELLICOTT CITY, MD 21043
 (301) 461-9920

OWNER/DEVELOPER
 ELLICOTT RIDGE CORPORATION II
 DYSON CONSTRUCTION CO, INC.
 3440 ELLICOTT CENTER DRIVE SUITE 101
 ELLICOTT CITY, MARYLAND 21043
 (301) 461-4188


STORM DRAIN, WATER AND SEWER PROFILES
DORSEY HALL
 (OFFICE CONDOMINIUMS)
 SECTION - 2 AREA - 5 PARCEL - N-2
 2ND ELECTION DISTRICT, HOWARD COUNTY, MARYLAND

SCALE: HORIZONTAL: 1"=50' VERTICAL: 1"=5'
 AS-BUILTS
 SDP 1065

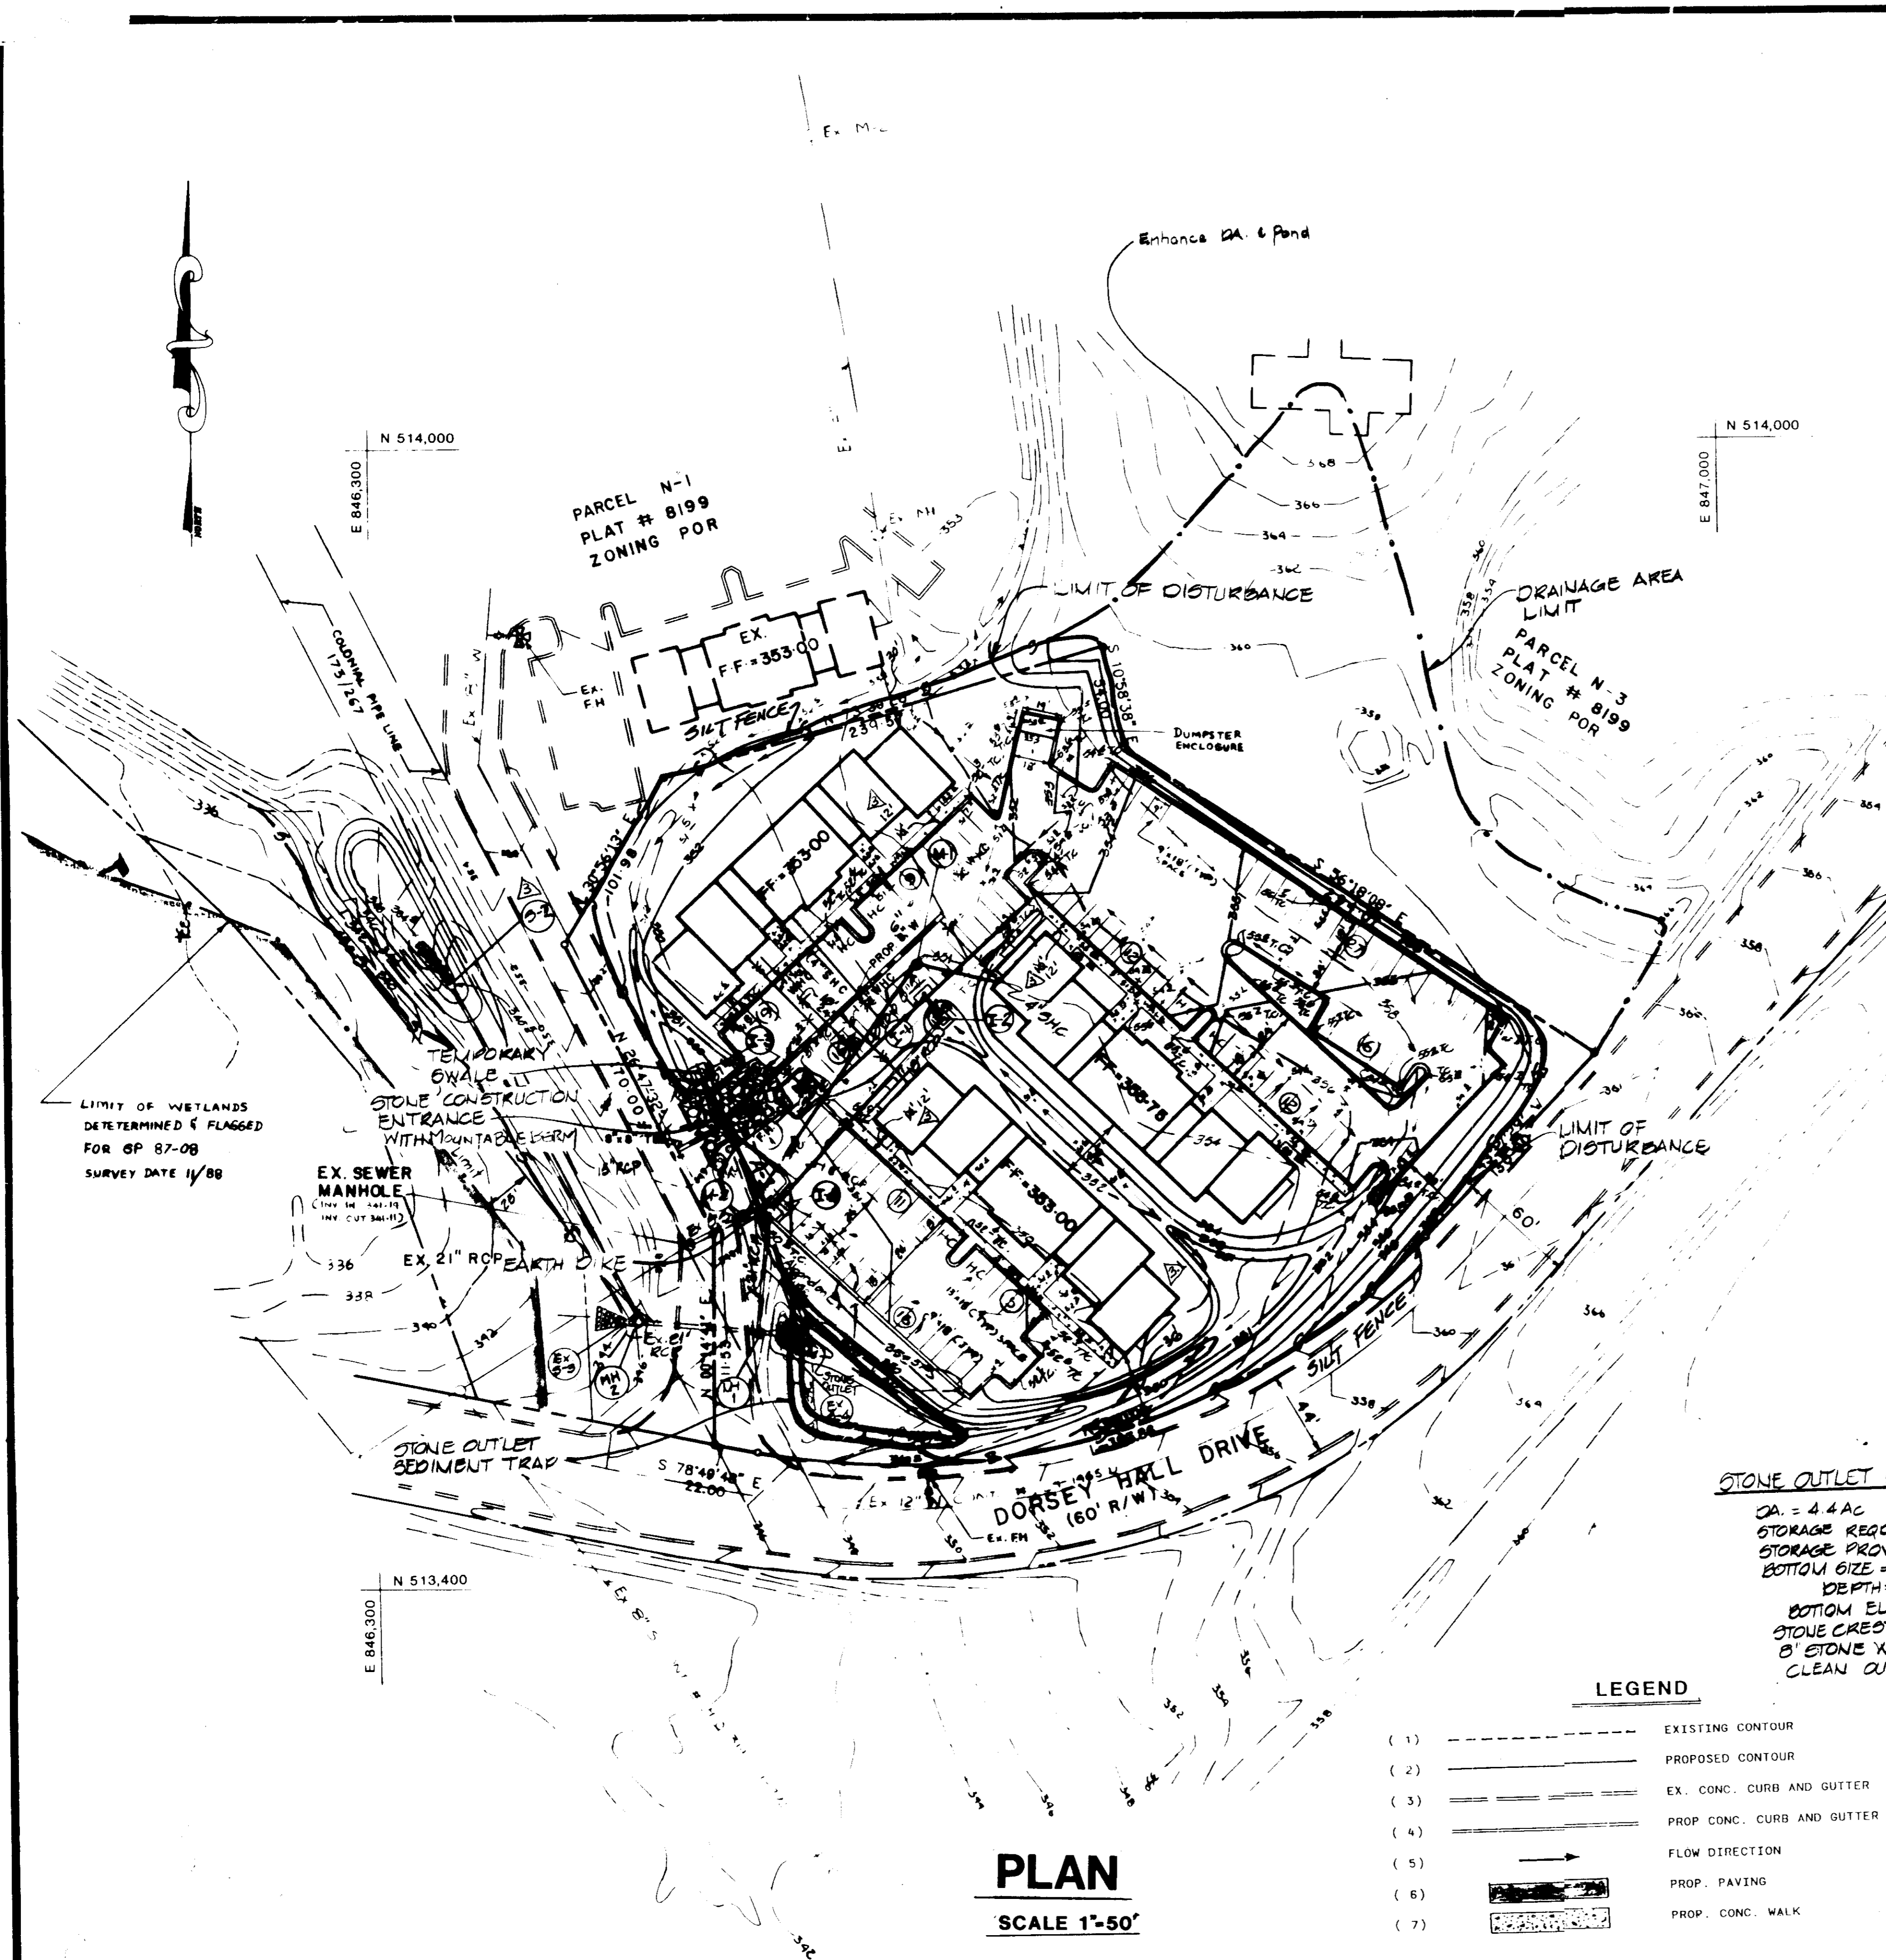

SEQUENCE OF CONSTRUCTION

1. OBTAIN GRADING PERMIT.
2. INSTALL SEDIMENT CONTROL MEASURES 2 DAYS
3. CLEAR AREAS WITHIN THE LIMITS OF DISTURBANCE AND ROUGH GRADE THE SITE. 1 WEEK
4. FINE GRADE THE SITE. INSTALL UTILITIES, STORM DRAIN SYSTEM, PAVEMENT AND APPURTENANCES, AND CONSTRUCT BUILDINGS. PROVIDE INLET PROTECTION AT STORM DRAIN INLETS. 6 MONTHS
5. CONSTRUCT THE WATER QUALITY POND IN ACCORDANCE WITH THE POND PLANS AND SPECIFICATIONS AS SHOWN, AND STABILIZE THE AFFECTED AREA IMMEDIATELY UPON COMPLETION. 1 WEEK
6. UPON COMPLETION OF INSTALLATION OF UTILITIES PAVEMENT AND BUILDINGS, STABILIZE ALL AREAS AS NEEDED. 1 WEEK
7. UPON APPROVAL FROM THE INSPECTOR, REMOVE ALL SEDIMENT CONTROL MEASURES AND STABILIZE THE AFFECTED AREAS IMMEDIATELY. 2 DAYS

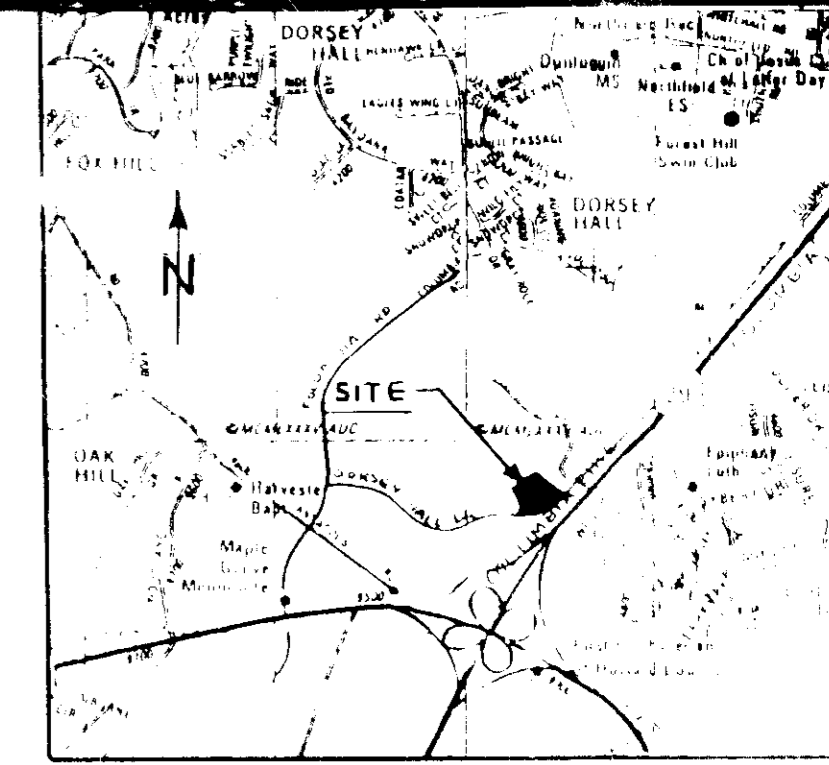

VICINITY MAP
SCALE 1" = 2000'

APPROVED FOR PUBLIC WATER AND PUBLIC SEWERAGE SYSTEMS
HOWARD COUNTY HEALTH DEPARTMENT

Joan Boyd 11-15-91
DATE

APPROVED HOWARD COUNTY OFFICE OF PLANNING & ZONING
PLANNING DIRECTOR

James Smith 12/20/91
Anna Holmuth 12/20/91
DATE

APPROVED FOR PUBLIC WATER AND PUBLIC SEWERAGE SYSTEMS
DRAINAGE SYSTEMS AND PUBLIC ROADS HOWARD COUNTY DEPARTMENT OF PUBLIC WORKS

James J. Lee 11/6/91
DATE

James J. Lee 11/6/91
DATE

PARKING DATA

OFFICE SPACE 3 x 14,234 = 42,702 SF 43,502 SF
250 SF/1 EMPLOYEE
42,702 SF OFFICE SPACE YIELDS 171 EMPLOYEES 174

7 PARKING SPACES REQUIRED / 10 EMPLOYEES
174/171 EMPLOYEES REQUIRE 125 PARKING SPACES

122 120' PARKING SPACES REQUIRED
122 125' PARKING SPACES PROVIDED (INCLUDING 6 HANDICAP SPACES)

STANDARD PARKING SPACE 9' x 18'
HANDICAP PARKING SPACE 13' x 18'

SITE ANALYSIS

1. TOTAL AREA OF SITE = 3.295 AC.
2. ZONING FOR PLANNED OFFICE AND RESEARCH
3. OPEN SPACE (GREEN AREA) PROVIDED = 1.5 AC. (45%)
4. BUILDING COVERAGE OF SITE = 7272 x 3 = 21,816 SF
5. GROUPS = 14,234 SF EACH 22,216
6. LANDSCAPED ISLANDS REQUIRED (5% OF PARKING AREA) = 2480 SF
LANDSCAPED ISLANDS PROVIDED = 8500 SF (13%)

STONE OUTLET SEDIMENT TRAP

CA = 4.4 AC
STORAGE REQD = 7920 CF
STORAGE PROVIDED = 8400 CF
BOTTOM SIZE = 1.575 SF
DEPTH = 4'
BOTTOM ELEV = 340.0
STONE CREST ELEV = 344.0
0' STONE WINDOW =
CLEAN OUT ELEV = 342.0

NOTE: THIS PLAN IS TO BE USED FOR SEDIMENT CONTROL MEASURES ONLY.

SIGNATURE BLOCK

[Signature]

DATE 3-14-90
com

REVIEWED FOR HOWARD COUNTY SOIL CONSERVATION DISTRICT AND METS TECHNICAL REQUIREMENTS

James J. Lee 4-18-90
DATE

DEVELOPMENT IS APPROVED FOR EROSION AND SEDIMENT CONTROL MEASURES
HOWARD COUNTY SOIL CONSERVATION DISTRICT

John R. Rhetson 4/18/90
DATE

ENGINEER'S CERTIFICATE

I HEREBY CERTIFY THAT THIS PLAN FOR EROSION AND SEDIMENT CONTROL REPRESENTS A PRACTICAL AND WORKABLE PLAN BASED ON MY PERSONAL KNOWLEDGE OF THE SITE CONDITIONS AND THAT IT WAS PREPARED IN ACCORDANCE WITH THE REQUIREMENTS OF THE HOWARD SOIL CONSERVATION DISTRICT.

[Signature] 4/1/90
SIGNATURE OF ENGINEER DATE

DEVELOPER'S CERTIFICATE

I/WE CERTIFY THAT ALL DEVELOPMENT AND CONSTRUCTION WILL BE DONE ACCORDING TO THIS PLAN OF DEVELOPMENT AND PLAN FOR EROSION AND SEDIMENT CONTROL AND THAT ALL RESPONSIBLE PERSONNEL INVOLVED IN THE CONSTRUCTION PROJECT WILL HAVE A CERTIFICATE OF ATTENDANCE AT A DEPARTMENT OF NATURAL RESOURCES APPROVED TRAINING PROGRAM FOR THE CONTROL OF SEDIMENT AND EROSION BEFORE BEGINNING THE PROJECT. I ALSO AUTHORIZE PERIODIC ON-SITE INSPECTION BY THE HOWARD SOIL CONSERVATION DISTRICT OR THEIR AUTHORIZED AGENTS, AS ARE DEEMED NECESSARY.

[Signature] 4-13-90
SIGNATURE OF DEVELOPER DATE

LEGEND

- (1) --- EXISTING CONTOUR
- (2) --- PROPOSED CONTOUR
- (3) --- EX. CONC. CURB AND GUTTER
- (4) --- PROP CONC. CURB AND GUTTER
- (5) --- FLOW DIRECTION
- (6) --- PROP. PAVING
- (7) --- PROP. CONC. WALK

PLAN
SCALE 1" = 50'

REVISIONS

DATE	BY	DESCRIPTION
9/89	JVP	DESIGNED
9/89	RMG	DRAWN
9/89	AJT	CHECKED
9-20-93	S.G.P.	Redline - Revised Dimensions & Outfall
11-4-93	"	add BLDG. Additions Group "A" & "C"

ENGINEERING TECHNOLOGIES ASSOCIATES, INC.
ENGINEERS * PLANNERS * SURVEYORS

3458 ELLICOTT CENTER DRIVE SUITE 101
ELLICOTT CITY, MARYLAND 21043
BALTO. 461-9920 WASH. 621-6880



OWNER / DEVELOPER




ELLICOTT RIDGE CORPORATION II
DYSON CONSTRUCTION CO. INC.
3440 ELLICOTT CENTER DRIVE, SUITE 101
ELLICOTT CITY, MARYLAND 21043
(301) 461-4188

SEDIMENT CONTROL PLAN

DORSEY HALL
(OFFICE CONDOMINIUMS)
SECTION - 2 AREA - 5 PARCEL N-2
2ND ELECTION DISTRICT, HOWARD COUNTY, MARYLAND

SCALE: AS SHOWN CONTRACT NO. DATE: 9/89 SHEET: 4 OF 7

SDP 9065

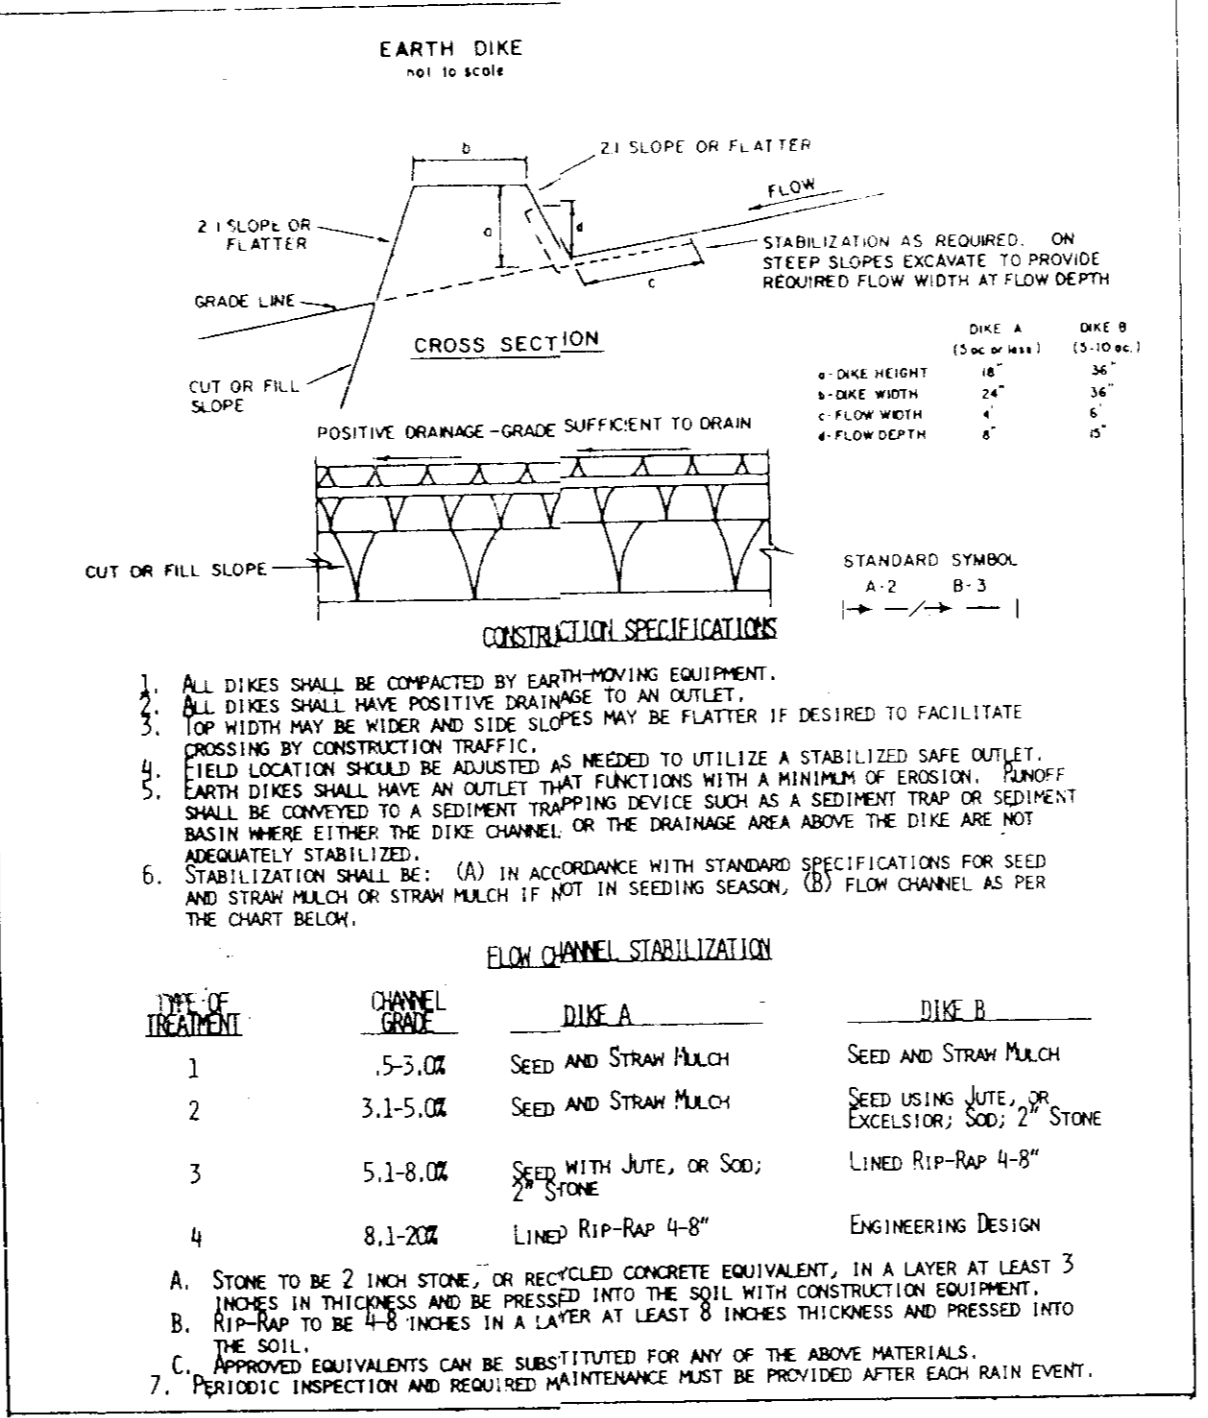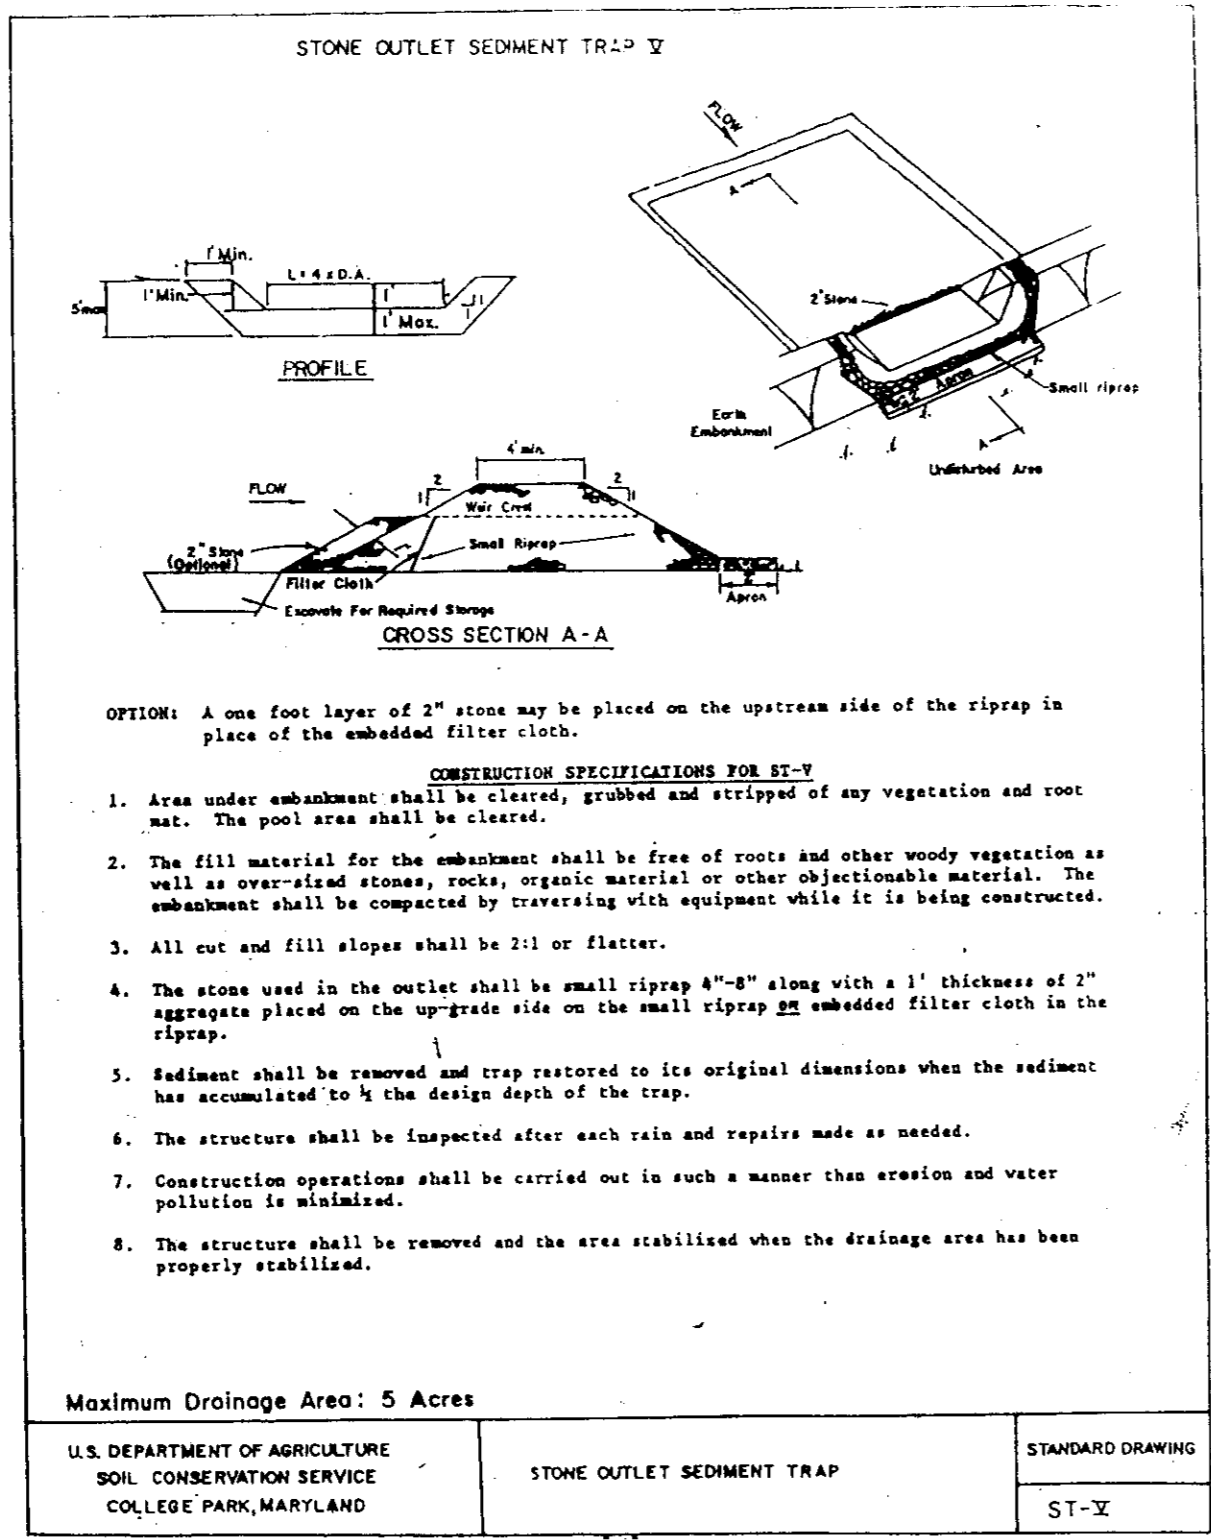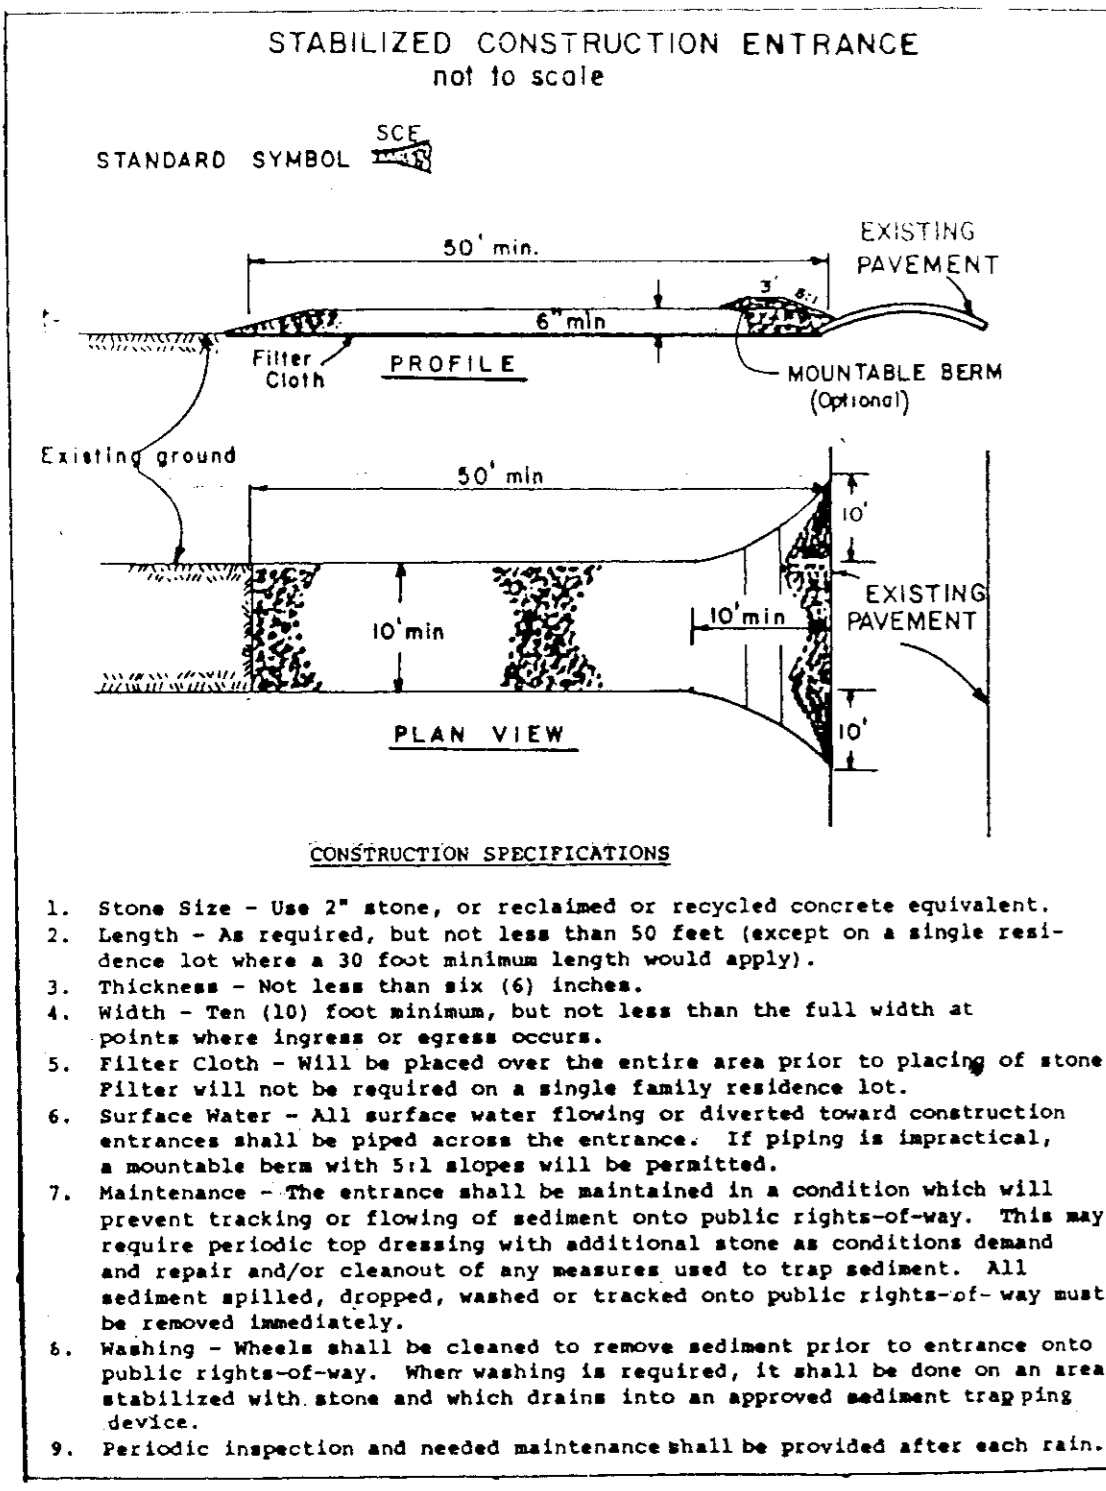

PERMANENT SEEDING NOTES

Seedbed Preparation: Loosen upper 3 inches of soil by raking, disking or other acceptable means before seeding, IF NOT PREVIOUSLY LOOSENEED.

Soil Amendments: Use one of the following schedules:

- Preferred - Apply 2 tons per acre dolomitic limestone (92 lbs./1000 square ft.) and 600 lbs. per acre 10-10-10 fertilizer (24 lbs./1000 square ft.) before seeding. Narrow or disc into upper three inches of soil. At time of seeding, apply 400 lbs. per acre 30-0-0 ureaseform fertilizer (9 lbs./1000 square ft.)
- Acceptable - Apply 2 tons per acre dolomitic limestone (92 lbs./1000 square ft.) and 1000 lbs. per acre 10-10-10 fertilizer (24 lbs./1000 sq. ft.) before seeding. Narrow or disc into upper three inches of soil.

Seeding: For the periods March 1 through April 30, and August 1 through October 15, seed with 60 lbs. per acre (1.4 lbs./1000 sq. ft.) of Kentucky 31 Tall Fescue. For the period May 1 through July 31, seed with 60 lbs. Kentucky 31 Tall Fescue per acre and 2 lbs. per acre (.05 lbs./1000 square ft.) of creeping lovegrass. During the period of October 15 through February 28, project site by Option (1) 2 tons per acre of well anchored straw mulch and seed as soon as possible in the spring. Option (2) Use seed. Option (3) Seed with 60 lbs./acre Kentucky 31 Tall Fescue and mulch with 2 tons/acre well anchored straw.

Mulching: Apply 1/4 to 2 tons per acre (70 to 90 lbs./1000 sq. ft.) of unrotted small grain straw immediately after seeding. Anchor mulch immediately after application using mulch anchoring tool or 238 gallons per acre (5 gal./1000 sq. ft.) of emulsified asphalt on flat areas. On slopes 8 feet or higher, use 348 gallons per acre (8 gal./1000 sq. ft.) for anchoring.

Maintenance: Inspect all seeded areas and make needed repairs, replacements and reseeding.


TEMPORARY SEEDING NOTES

Seedbed Preparation: Loosen upper 3 inches of soil by raking, disking or other acceptable means before seeding.

Soil Amendments: Apply 600 lbs. per acre 10-10-10 fertilizer (24 lbs./1000 sq. ft.).





Seeding: For periods March 1 through April 30 and from August 15 through November 15, seed with 24 lbs. per acre of annual type (2.2 lbs./1000 sq. ft.). For the period May 1 through August 15, seed with 3 lbs. per acre of creeping lovegrass (.07 lbs./1000 sq. ft.). For the period November 15 through February 28, project the site by applying 2 tons per acre of well anchored straw mulch and seed as soon as possible. In the spring or use seed.

Mulching: Apply 1/4 to 2 tons per acre (70 to 90 lbs./1000 sq. ft.) of unrotted small grain straw immediately after seeding. Anchor mulch immediately after application using mulch anchoring tool or 238 gal. per acre (5 gal./1000 sq. ft.) of emulsified asphalt on flat areas. On slopes 8 ft. or higher use 348 gal. per acre (8 gal./1000 sq. ft.) for anchoring.

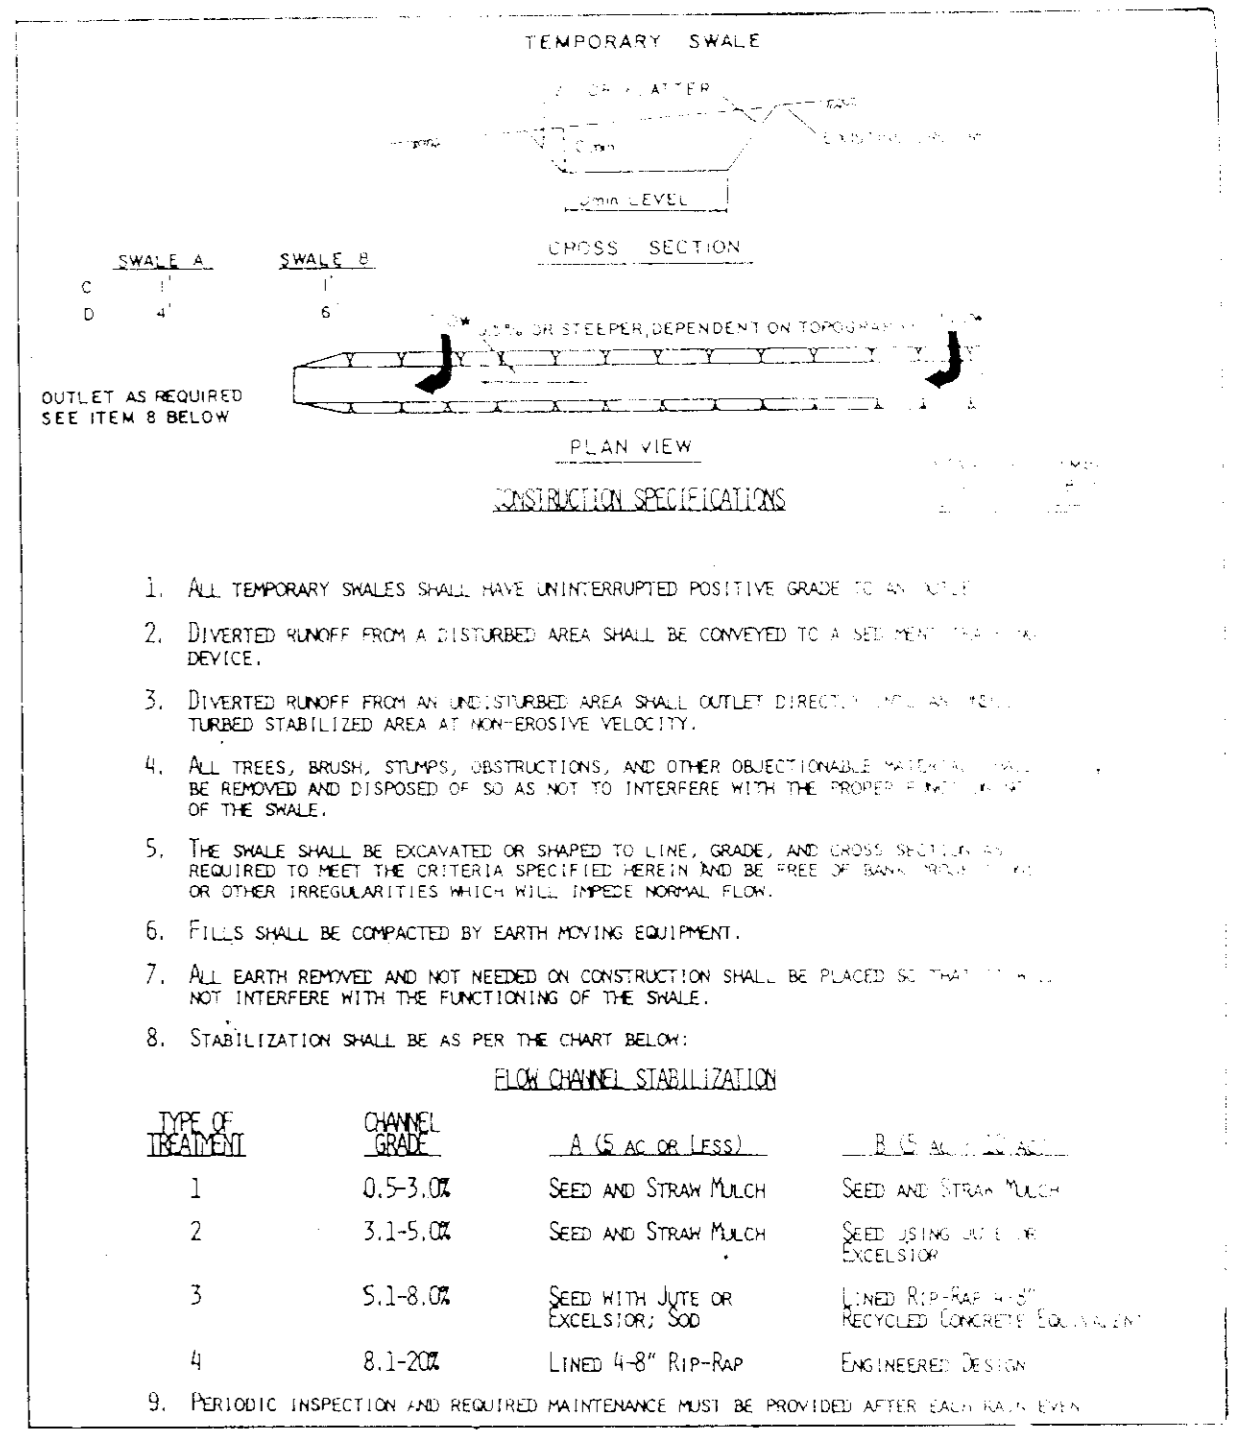

SEDIMENT CONTROL NOTES

- A minimum of 24 hours notice must be given to the Howard County Office of Inspection and Permitting prior to the start of any construction. (933-2432)
- All vegetative and structural practices are to be installed according to the provisions of this plan and are to be in conformance with the 1983 MARYLAND STANDARDS AND SPECIFICATIONS FOR SOIL EROSION AND SEDIMENT CONTROL.
- Following initial soil disturbance or redistribution, permanent or temporary stabilization shall be completed within: a) 7 calendar days for all perimeter sediment control structures, dikes, perimeter slopes and all slopes greater than 3:1; b) 14 days as to all other disturbed or graded areas on the project site.
- All sediment traps/basins shown must be fenced and warning signs posted around their perimeter in accordance with Vol. 1, Chapter 22, of the HOWARD COUNTY DESIGN MANUAL, Storm Drainage.
- All disturbed areas must be stabilized within the time period specified above in accordance with the 1983 MARYLAND STANDARDS AND SPECIFICATIONS FOR SOIL EROSION AND SEDIMENT CONTROL for permanent seedings (Sec. 31) and (Sec. 34), temporary seedings (Sec. 30) and mulching (Sec. 32). Temporary stabilization with mulch alone can only be done when recommended seeding dates do not allow for proper germination and establishment of grasses.
- All sediment control structures are to remain in place and are to be maintained in operative condition until permission for their removal has been obtained from the Howard County Sediment Control Inspector.
- Site Analysis:
Total Area of Site: 3.95 Acres
Area Disturbed: 3.20 Acres
Area to be roofed or paved: 1.25 Acres
Area to be vegetatively stabilized: 1.95 Acres
Total Cut: 350 Cu. yds.
Total Fill: 4200 Cu. yds.
Off-site waste/borrow area location:
- Any sediment control practice which is disturbed by grading activity for placement of utilities must be repaired on the same day of disturbance.
- Additional sediment controls must be provided, if deemed necessary by the Howard County DPM sediment control inspector.
- On all sites with disturbed areas in excess of 2 acres approval of the inspection agency shall be presented upon completion of installation of perimeter erosion and sediment controls, but before proceeding with any other earth disturbance or grading. Utility installing or grading inspection approvals may not be authorized until this initial approval by the inspection agency is made.

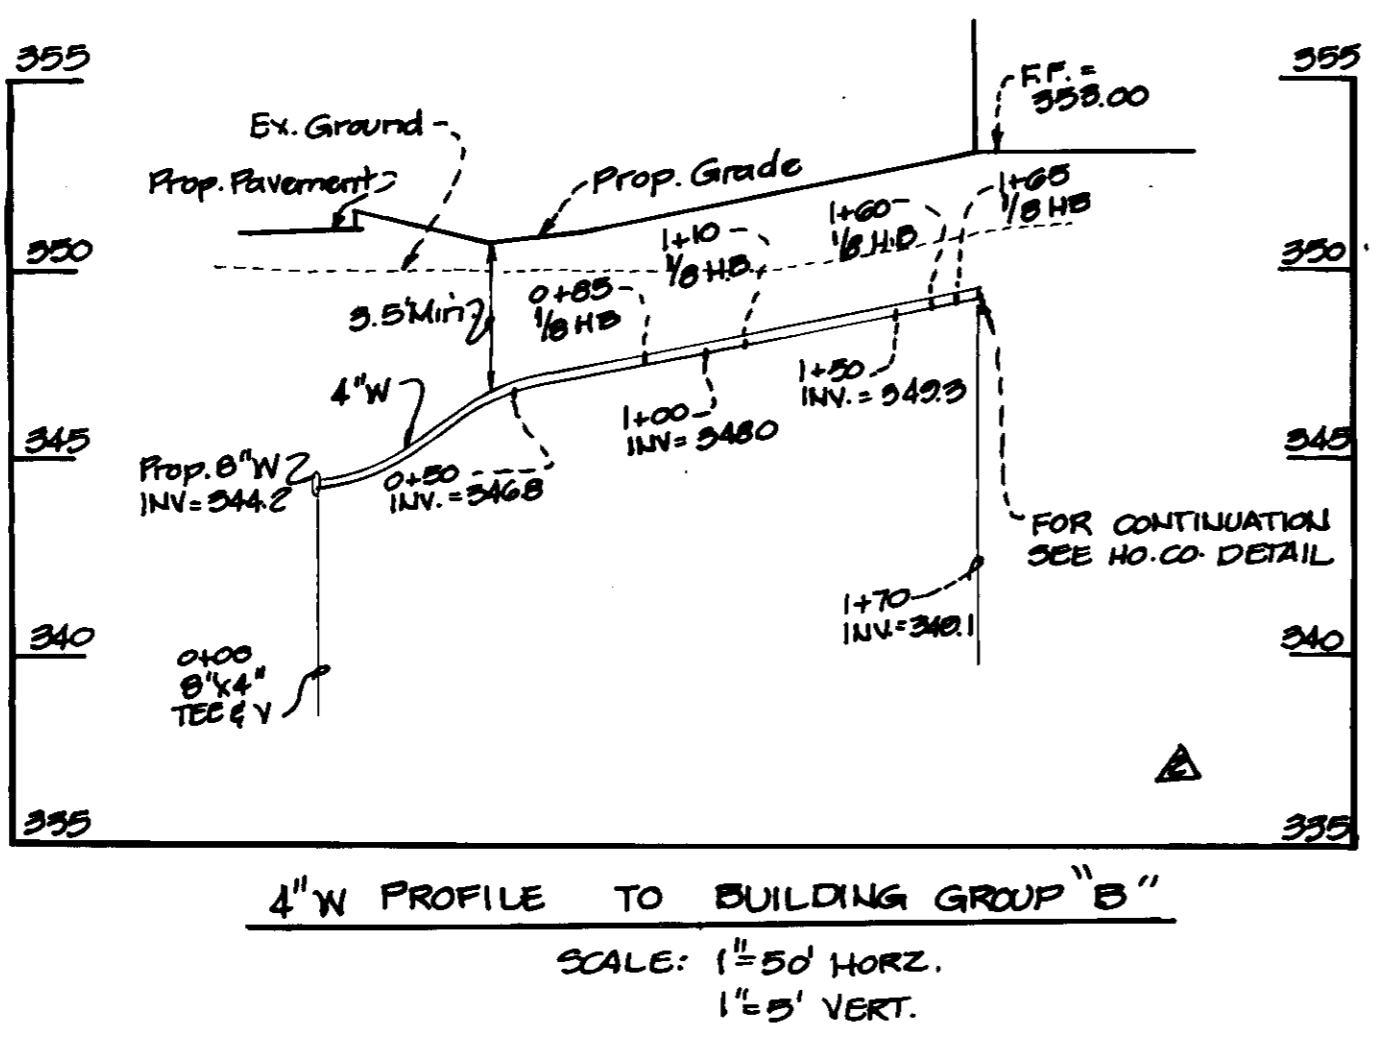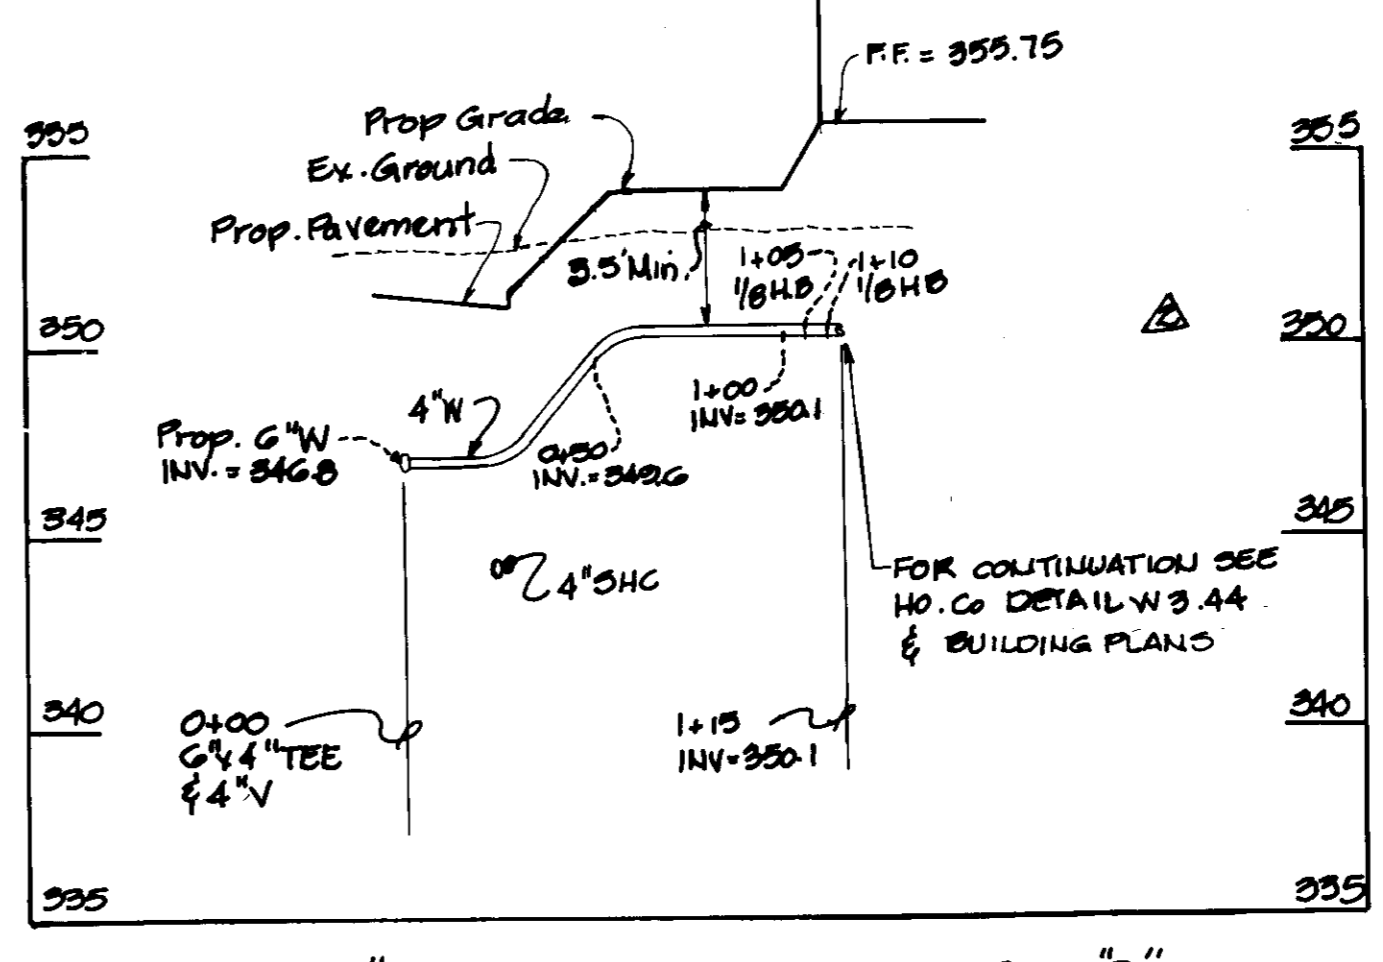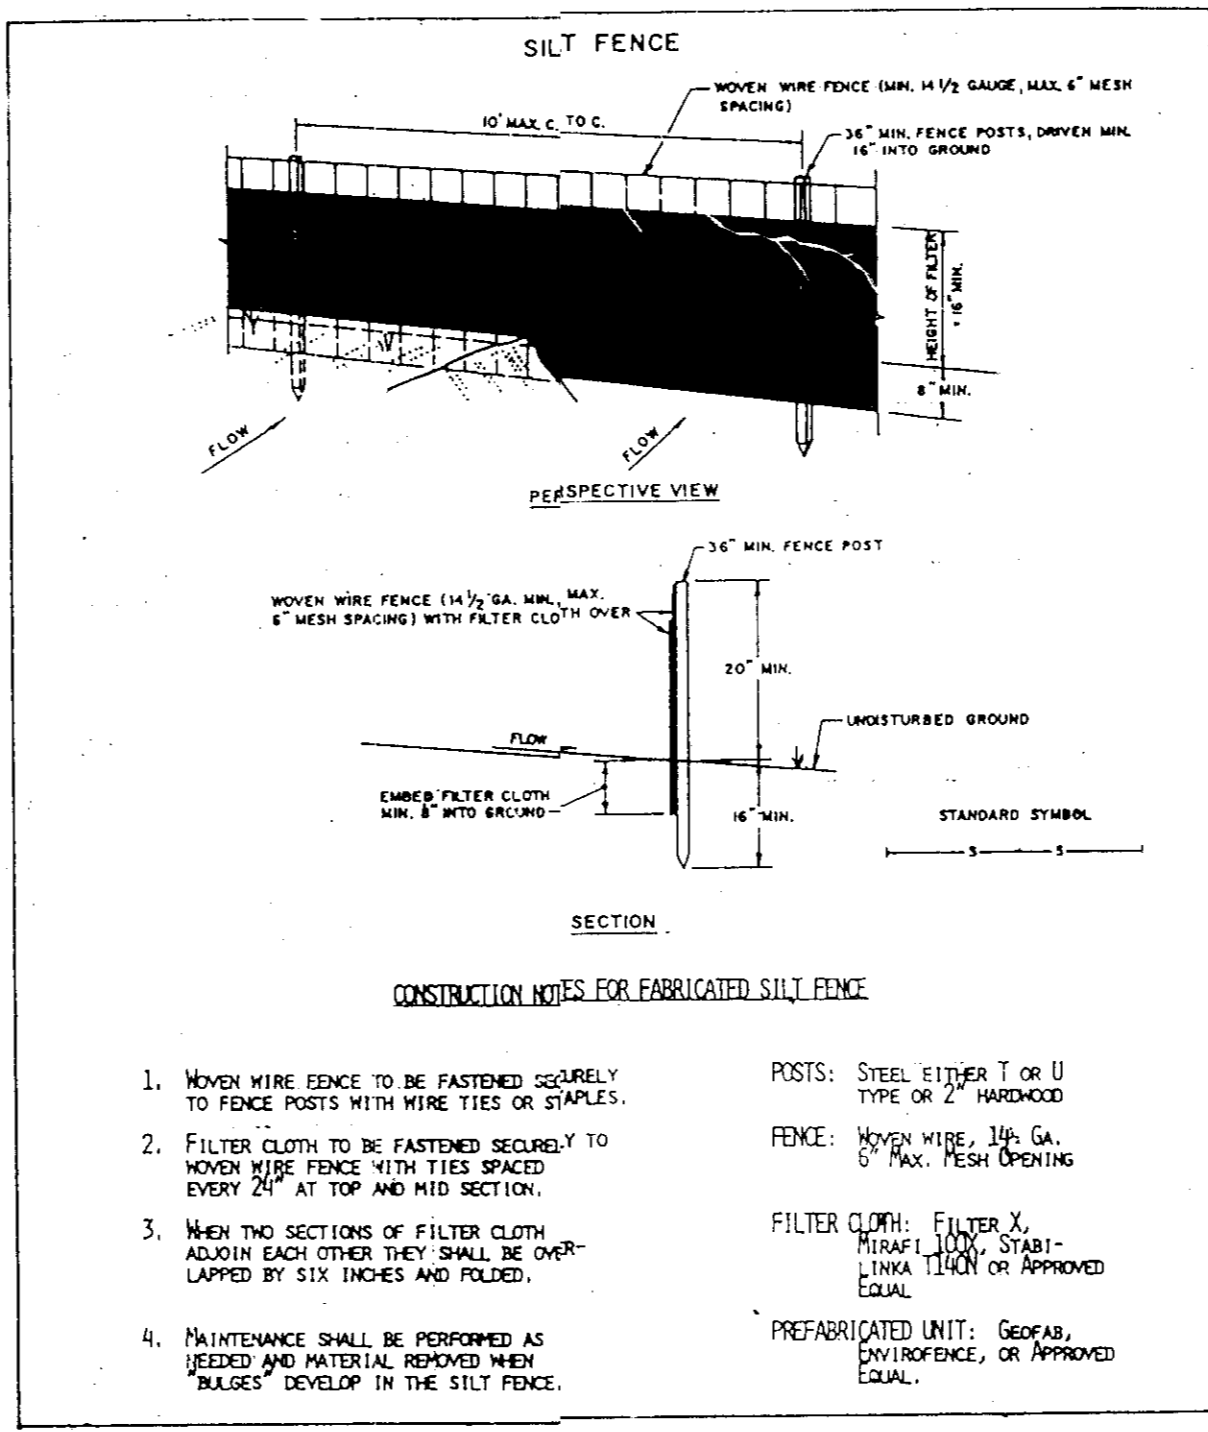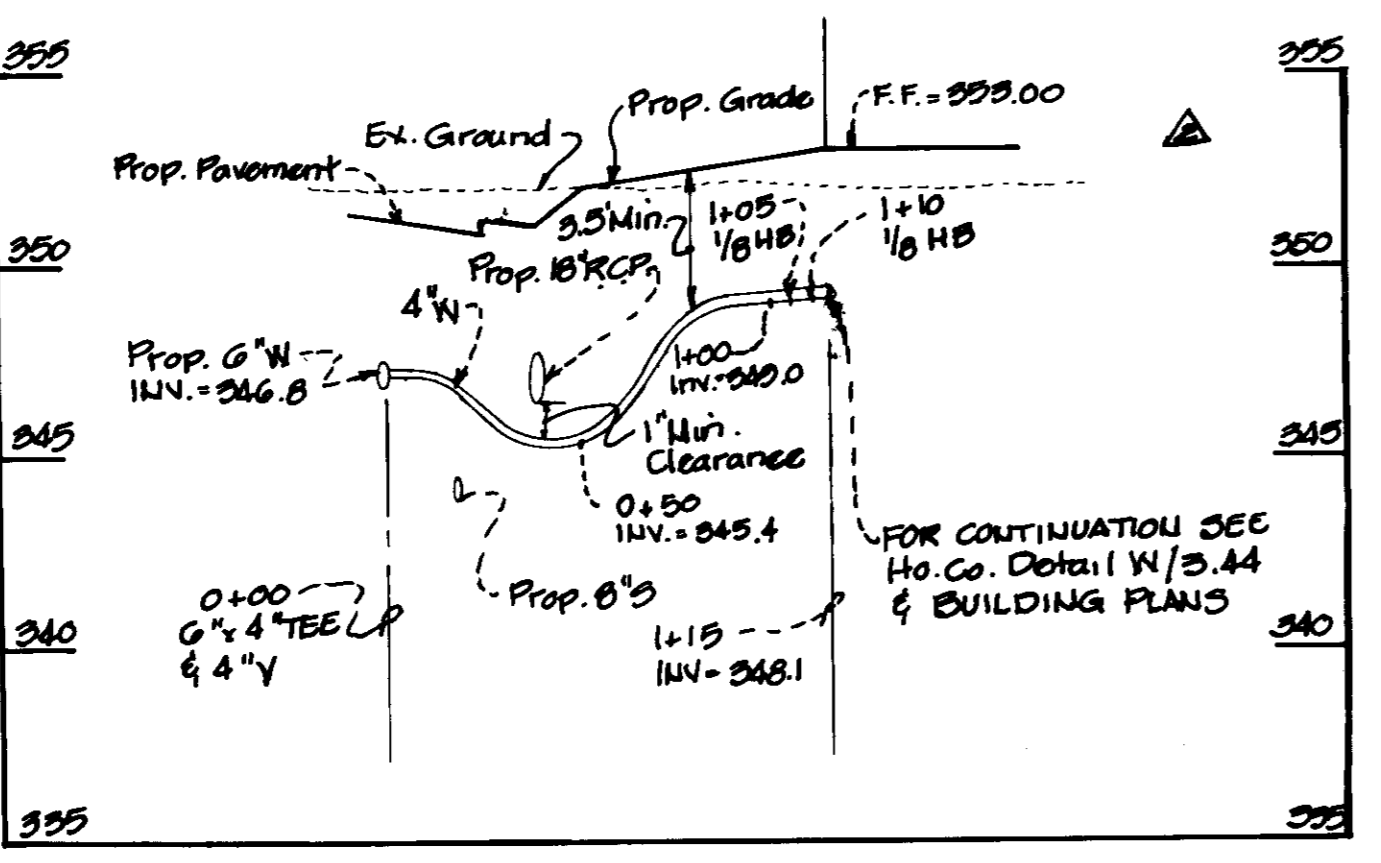

ENGINEER'S CERTIFICATE

I HEREBY CERTIFY THAT THIS PLAN FOR EROSION AND SEDIMENT CONTROL REPRESENTS A PRACTICAL AND WORKABLE PLAN BASED ON MY PERSONAL KNOWLEDGE OF THE SITE CONDITIONS AND THAT IT WAS PREPARED IN ACCORDANCE WITH THE REQUIREMENTS OF THE HOWARD SOIL CONSERVATION DISTRICT.

Signature of Engineer: [Signature] DATE: 4/13/90

DEVELOPER'S CERTIFICATE

"I/WE CERTIFY THAT ALL DEVELOPMENT AND CONSTRUCTION WILL BE DONE ACCORDING TO THIS PLAN OF DEVELOPMENT AND PLAN FOR EROSION AND SEDIMENT CONTROL AND THAT ALL RESPONSIBLE PERSONNEL INVOLVED IN THE CONSTRUCTION PROJECT WILL HAVE A CERTIFICATE OF ATTENDANCE AT A DEPARTMENT OF NATURAL RESOURCES APPROVED TRAINING PROGRAM FOR THE CONTROL OF SEDIMENT AND EROSION BEFORE BEGINNING THE PROJECT. I ALSO AUTHORIZE PERIODIC ON-SITE INSPECTION BY THE HOWARD SOIL CONSERVATION DISTRICT OR THEIR AUTHORIZED AGENTS, AS ARE DEEMED NECESSARY."

Signature of Developer: [Signature] DATE: 4-13-90

APPROVED: FOR PUBLIC WATER AND PUBLIC SEWERAGE SYSTEMS
HOWARD COUNTY HEALTH DEPARTMENT

Signature: [Signature] DATE: 11-15-91

APPROVED: HOWARD COUNTY DEPT. OF PLANNING & DESIGN

Signature: [Signature] DATE: 12/20/91

Signature: [Signature] DATE: 12/20/91

APPROVED: FOR PUBLIC WATER AND PUBLIC SEWERAGE SYSTEMS
DRAINAGE SYSTEMS AND PUBLIC ROADS DEPARTMENT OF PUBLIC WORKS

Signature: [Signature] DATE: 11/6/91

Signature: [Signature] DATE: 11/6/91

REVIEWED FOR HOWARD COUNTY SOIL CONSERVATION DISTRICT AND MEETS TECHNICAL REQUIREMENTS

Signature: [Signature] DATE: 4-18-90

Signature: [Signature] DATE: 4/8/90

DATE	BY	DESCRIPTION
9/09	JVP	
9/09	RMC	Redline - Remove 1 1/2" NHC; Remove blow-off, provide 8" x 8" R; Provide 4" x 4" profiles
9/09	RJT	

ENGINEERING TECHNOLOGIES ASSOCIATES, INC.

ENGINEERS, PLANNERS, SURVEYORS

3458 ELLICOTT CENTER DRIVE SUITE 101
ELLICOTT CITY, MD 21043
(301) 461-9920

OWNER / DEVELOPER

ELLICOTT RIDGE CORPORATION II
DYSON CONSTRUCTION CO., INC.
3440 ELLICOTT CENTER DRIVE, SUITE 101
ELLICOTT CITY, MARYLAND 21043
(301) 461-4188


SEDIMENT CONTROL NOTES AND DETAILS

DORSEY HALL


(OFFICE CONDOMINIUMS) PARCEL N-1
SECTION - 2 AREA - 5
2ND ELECTION DISTRICT, HOWARD COUNTY, MARYLAND

SCALE AS SHOWN CONT. ACT NO. DATE 9/09 SHEET 5 OF 7

SDP-9065

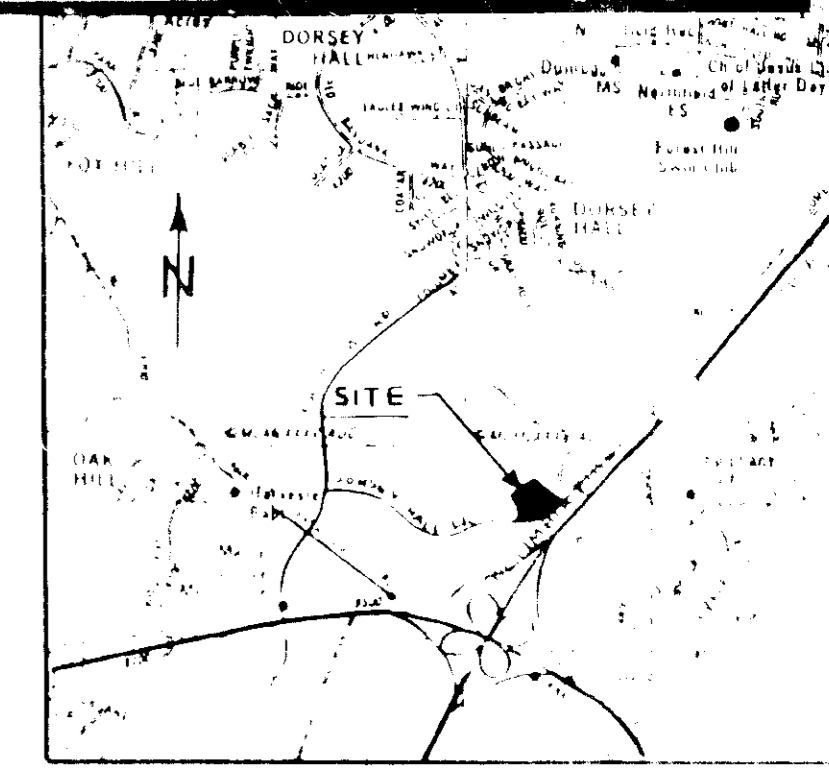

VICINITY MAP
SCALE 1" = 200'

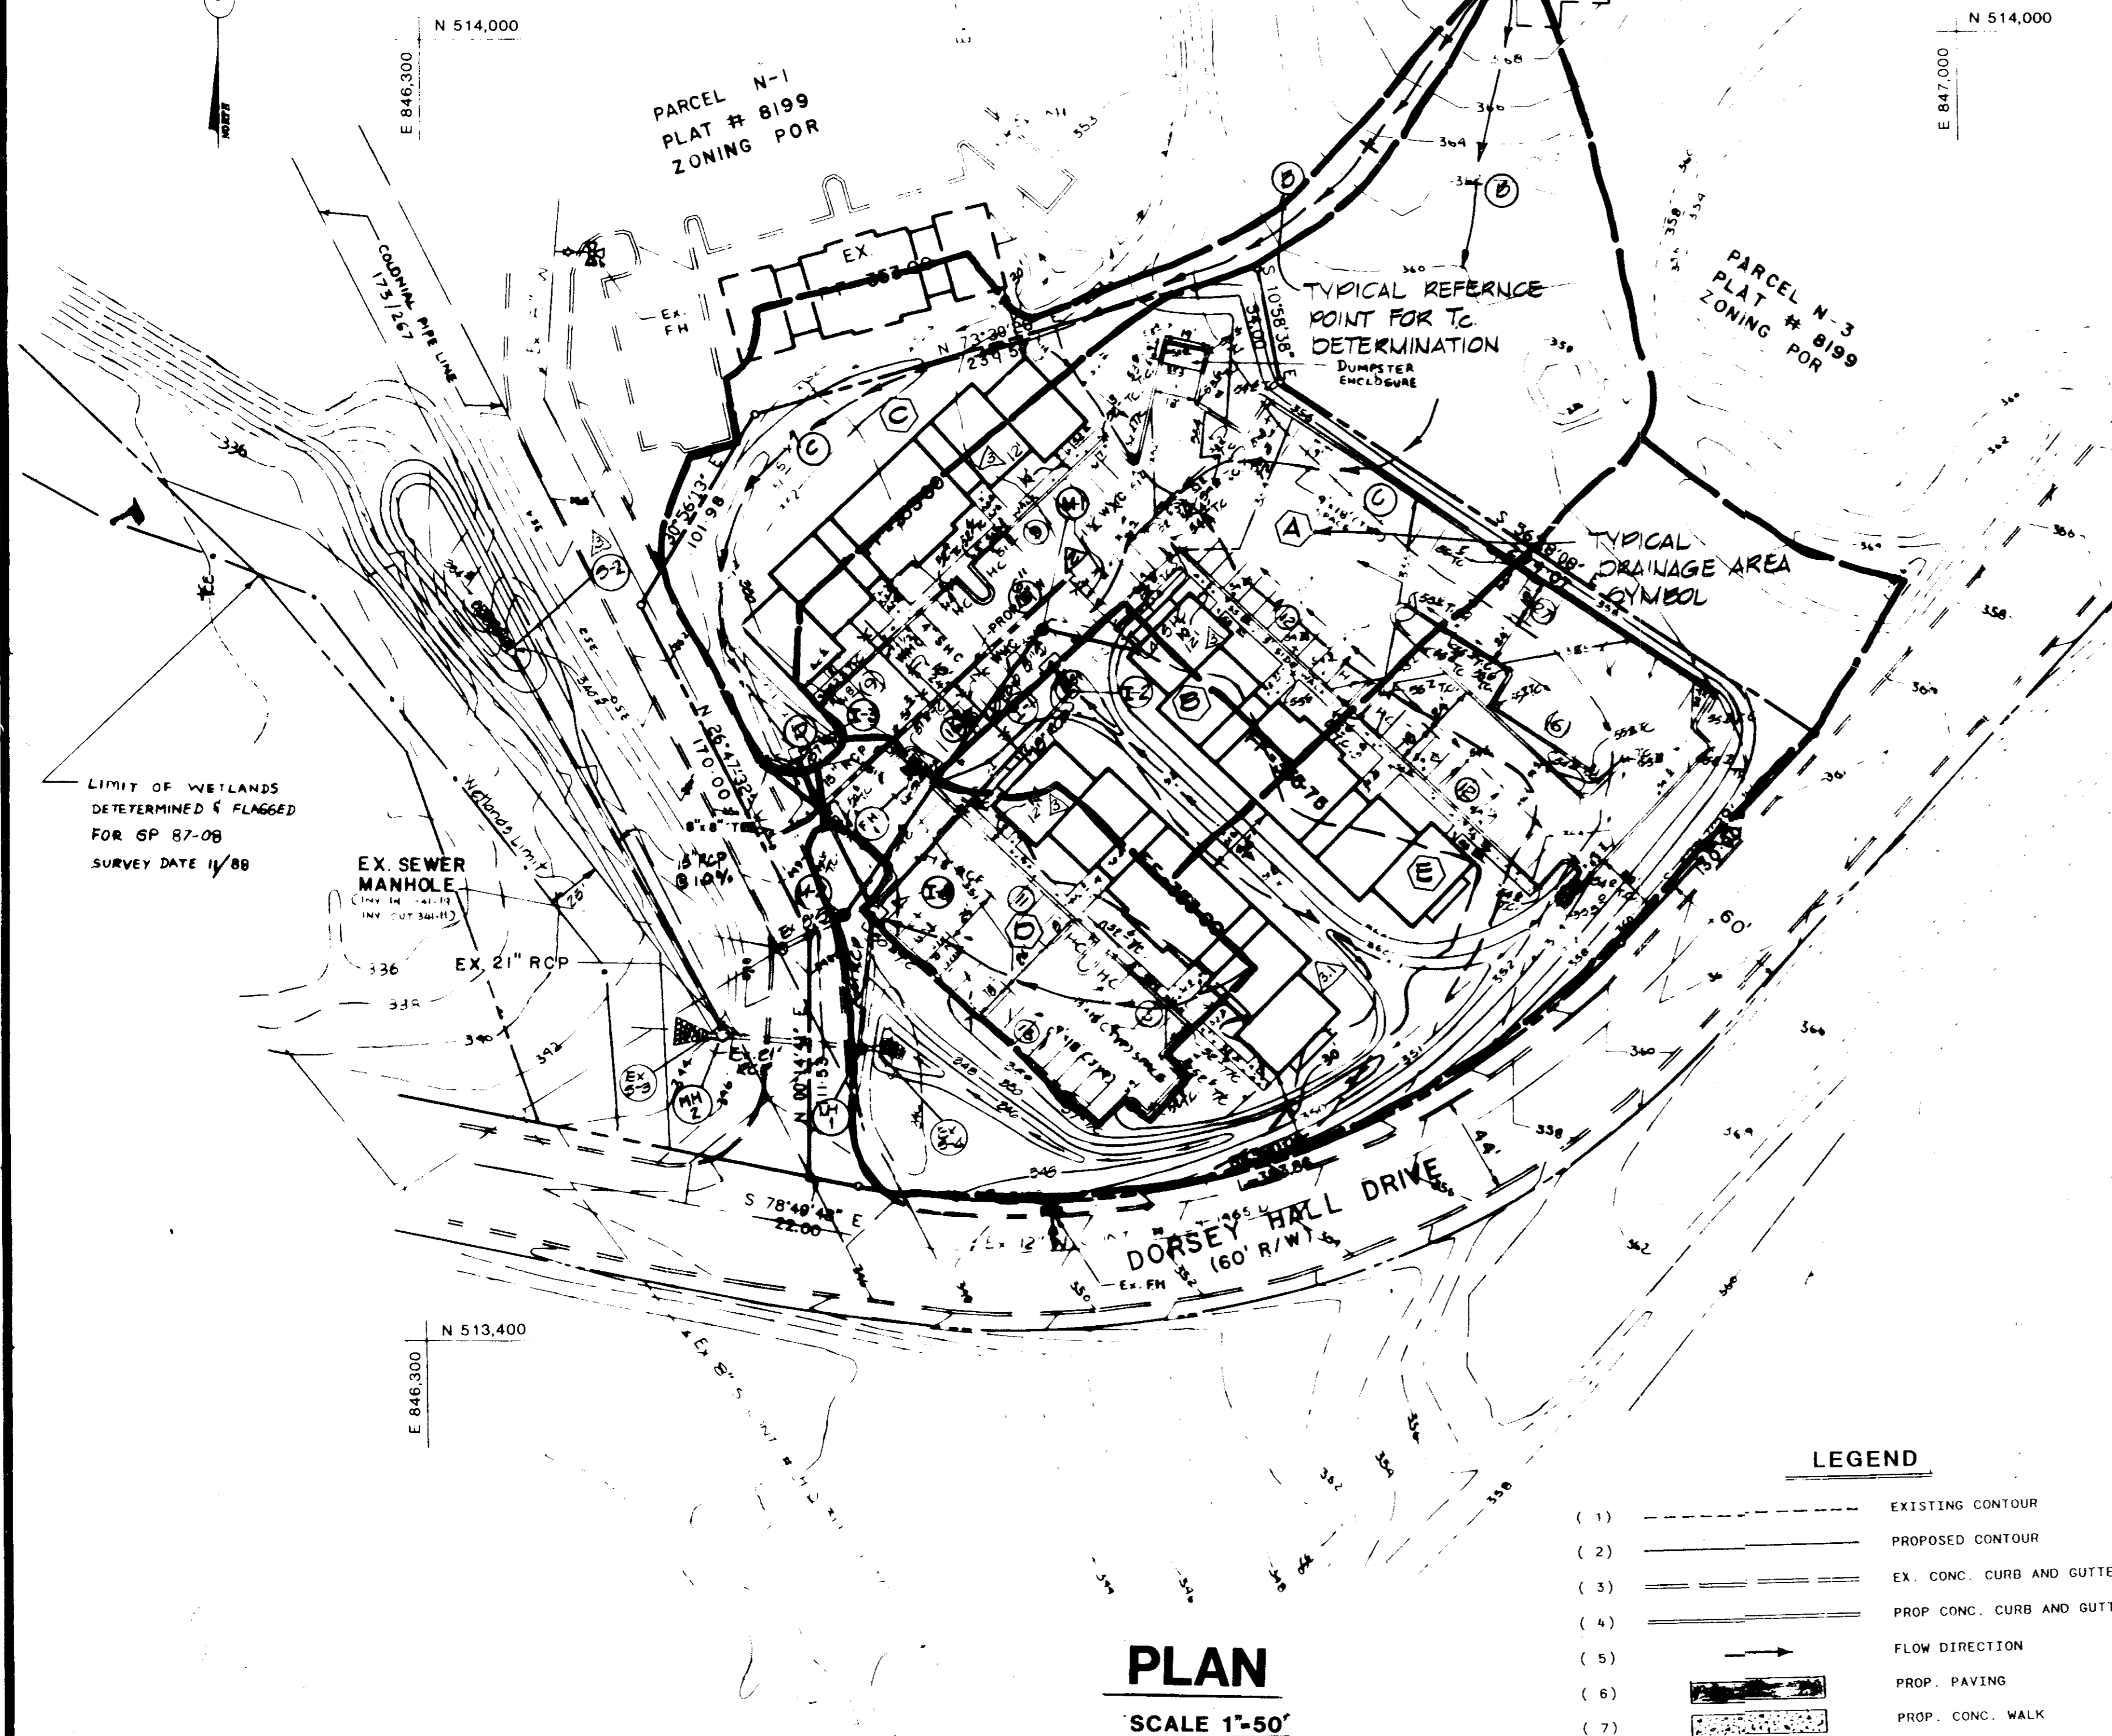

PARKING DATA

OFFICE SPACE 3 x 14,234 = 42,702 SF 43,502 SF
 250 SF/1 EMPLOYEE
 42,702 SF OFFICE SPACE YIELDS 171 EMPLOYEES
 7 PARKING SPACES REQUIRED / 10 EMPLOYEES
 171 EMPLOYEES REQUIRE 120 PARKING SPACES
 120 PARKING SPACES REQUIRED
 122 PARKING SPACES PROVIDED (INCLUDING 6 HANDICAP SPACES)
 STANDARD PARKING SPACE 9' x 18'
 HANDICAP PARKING SPACE 13' x 18'

SITE ANALYSIS

- TOTAL AREA OF SITE = 3.295 AC.
- ZONING FOR, PLANNED OFFICE AND RESEARCH
- OPEN SPACE (GREEN AREA) PROVIDED = 1.5 AC. (45%)
- BUILDING COVERAGE OF SITE = 7272 x 3 = 21,816 SF 22,216 SF
- GROUPS = 14,234 SF EACH = 42,702 SF TOTAL 43,502
- LANDSCAPED ISLANDS REQUIRED (5% OF PARKING AREA) = 2460 SF
 LANDSCAPED ISLANDS PROVIDED = 8500 SF (13%)

DRAINAGE TABULATION				
D.A.	AREA	C	STRUCTURE	PERVIOUS
A	1.20	0.92	I-1	46.7
B	0.60	0.47	I-2	40.0
C	0.6	0.92	I-3	10.0
D	0.5	0.80	I-4	20.0
E	1.60	0.80	EX. K-1	28.1

LEGEND

- (1) - - - - - EXISTING CONTOUR
- (2) ———— PROPOSED CONTOUR
- (3) ———— EX. CONC. CURB AND GUTTER
- (4) ———— PROP. CONC. CURB AND GUTTER
- (5) ———— FLOW DIRECTION
- (6) ———— PROP. PAVING
- (7) ———— PROP. CONC. WALK

PLAN
SCALE 1"=50'

NOTE: THIS PLAN IS TO BE UTILIZED FOR DRAINAGE AREA DEPICTION ONLY

Joey Byler 11-15-91
James R. Rutter 12/20/91
Amina Hilmath 12/20/91
James G. Lan 11/16/91
 CHIEF BUREAU OF ENGINEERING, B

James M. Hester 4-18-90
Paul Roberts 4/18/90


ENGINEER'S CERTIFICATE
 I HEREBY CERTIFY THAT THIS PLAN AND THE DRAINAGE AREA DEPICTION THEREON REPRESENTS A PRACTICAL AND FEASIBLE PLAN FOR EROSION AND SEDIMENT CONTROL AND THAT IT WAS PREPARED IN ACCORDANCE WITH THE REQUIREMENTS OF THE HARBOR SPILL CONSERVATION DISTRICT.
James M. Hester 4/13/90
 STRUCTURE OF ENGINEER

DEVELOPER'S CERTIFICATE
 I HEREBY CERTIFY THAT ALL DEVELOPMENT AND CONSTRUCTION WILL BE DONE ACCORDING TO THIS PLAN OF DEVELOPMENT AND THAT I HAVE ADEQUATE PERSONNEL INVOLVED IN THE CONSTRUCTION OF THIS PROJECT. I WILL HAVE A CERTIFICATE OF ATTENDANCE AT A TRAINING COURSE PROVIDED BY THE HARBOR SPILL CONSERVATION DISTRICT. I ALSO AUTHORIZE PERIODIC ON-SITE INSPECTIONS BY THE HARBOR SPILL CONSERVATION DISTRICT OR THEIR AUTHORIZED AGENTS, AS DEEMED NECESSARY.
James M. Hester 4-13-90
 SIGNATURE OF DEVELOPER

SIGNATURE BLOCK
 APPROVED
 3-14-90
cm


		REVISIONS	
DESIGNED	DATE	DATE	DESCRIPTION
JVP	9/89		
DRAWN	9/89	8-2-93	WHN Red line - Remove 1 1/2" NHC; Remove Blaw-off, provide 8" x 8" R, provide 4" V's add 4" N profiles
CHECKED	9/89		
APPROVED	9/89	1-20-93	sgp Redline - Revised Dimensions & Outfall
		11-4-93	" Bldg. Additions - Group "A" & "C"

ENGINEERING TECHNOLOGIES ASSOCIATES, INC.
 ENGINEERS * PLANNERS * SURVEYORS
 3458 ELLICOTT CENTER DRIVE SUITE 101
 ELLICOTT CITY, MARYLAND 21043
 BALTO. 461-9920 WASH. 621-1880

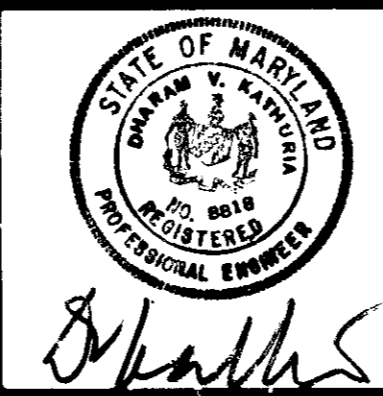


OWNER / DEVELOPER
 ELLICOTT RIDGE CORPORATION II
 D'YSON CONSTRUCTION CO. INC.
 3440 ELLICOTT CENTER DRIVE, SUITE 101
 ELLICOTT CITY, MARYLAND 21043
 (301) 461-4186

DRAINAGE AREA MAP
DORSEY HALL
 (OFFICE CONDOMINIUMS)
 SECTION - 2 AREA - 5 PARCEL N-2
 2ND ELECTION DISTRICT, HOWARD COUNTY, MARYLAND
 SCALE: AS SHOWN CONTRACT NO. DATE: SHEET: 6 OF 7

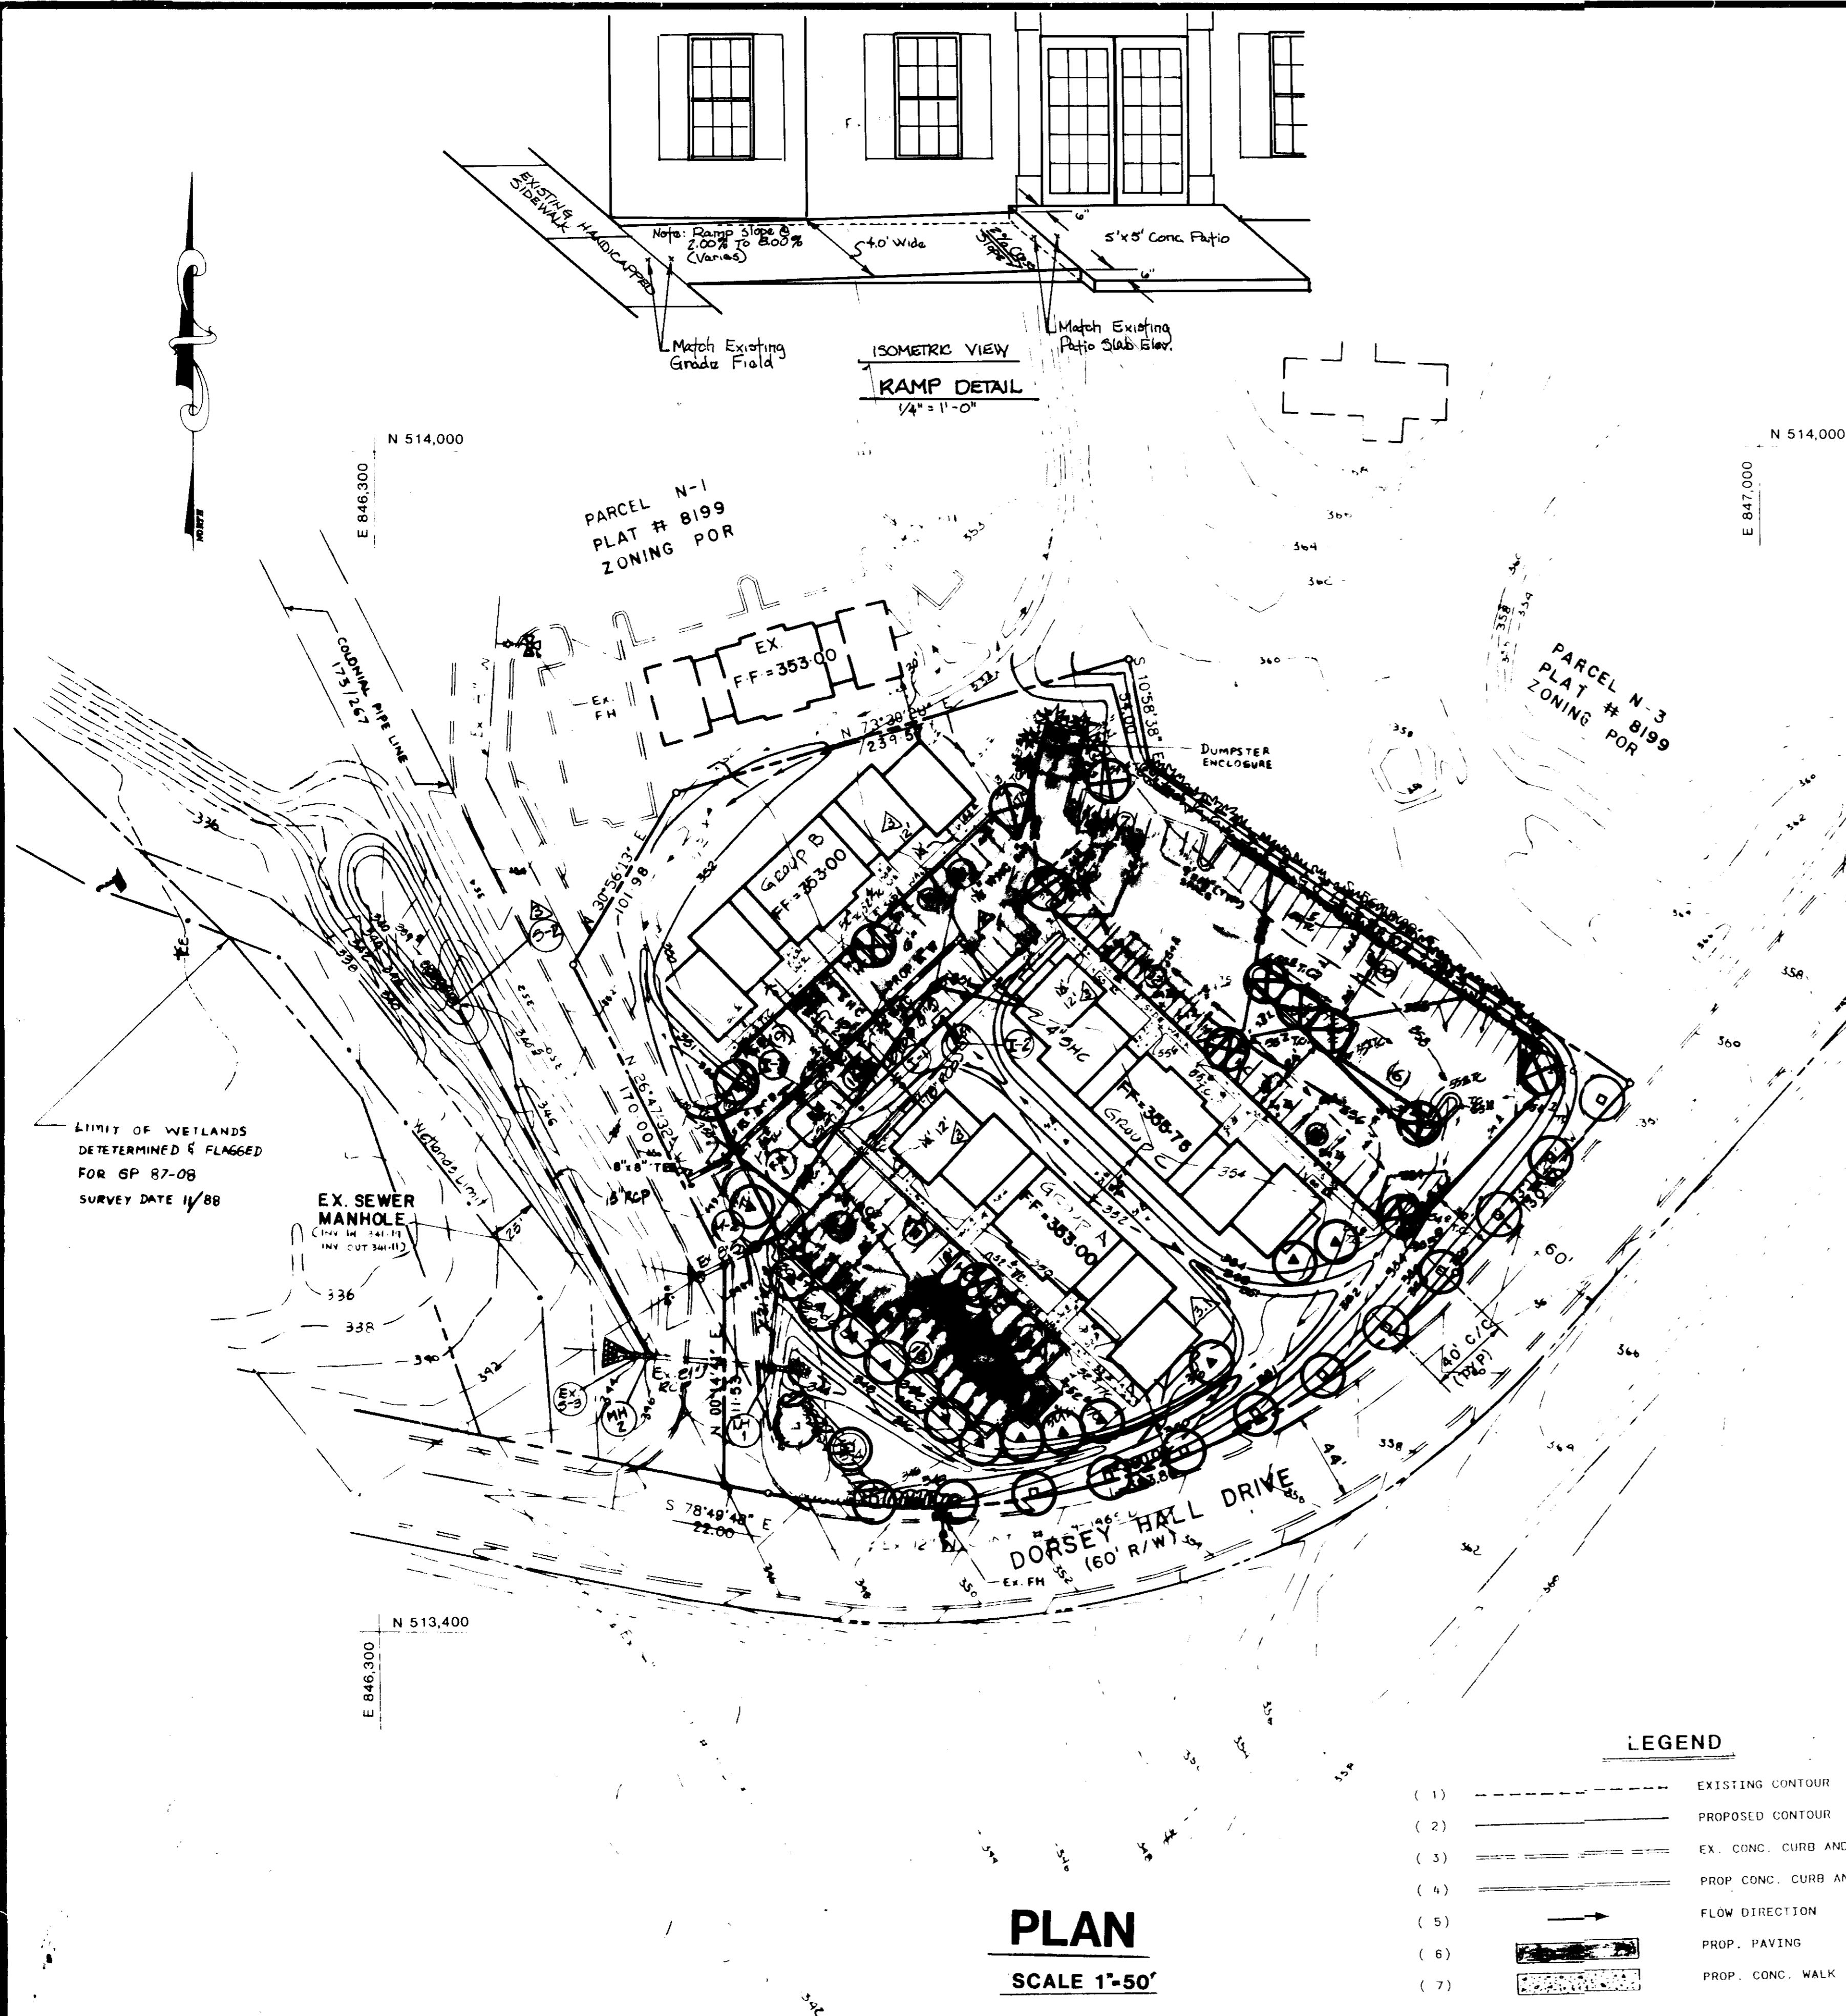

PLANT LIST

KEY	QUANTITY	BOTANICAL COMMON NAME	NAME	SIZE	COND.	NOTES
⊙	14	PLANTUS ACERFOLIA	LONDON PLANE TREE	2 1/2 - 3'	B & B	MATCHED
⊙	14	LIQUIDAMBAR STYRACIFLLIA	SWEETGUM	2 1/2 - 3"	B & B	
⊗	13	ACER RNBRUM	RED MAPPLE	2 1/2 - 3"	B & B	
⊘	40	EUONYMUS MANHATTEN	EVERGREEN EVONYMUS	3'	B & B	
⊙	29	PINUS STROBUS	E, WHITE PINE	6' - 8'	BB	

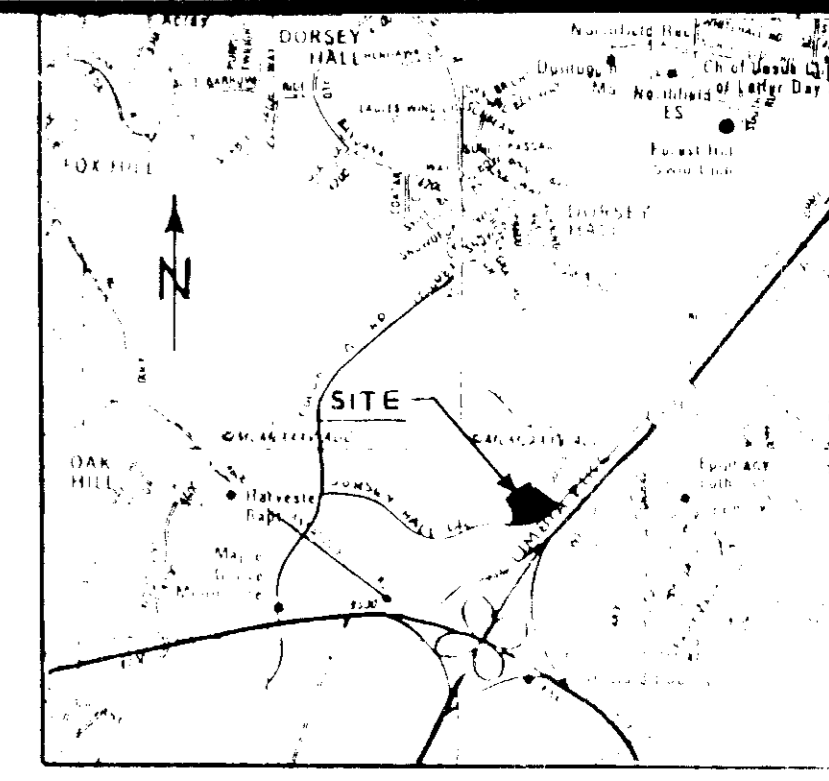

VICINITY MAP
SCALE 1" = 2000'

John Boyler 11-15-91
James R. Rosta 12/20/91
Emma N. Nisom 12/20/91
James J. Rosta 11/16/91
William E. Rosta 11/16/91

PARKING DATA

OFFICE SPACE 3 x 14,234 = 42,702 SF
 250 SF/1 EMPLOYEE
 42,702 SF OFFICE SPACE YIELDS 171 EMPLOYEES
 7 PARKING SPACES REQUIRED / 10 EMPLOYEES
 171 EMPLOYEES REQUIRE 120 PARKING SPACES
 120 PARKING SPACES REQUIRED
 122 PARKING SPACES PROVIDED (INCLUDING 6 HANDICAP SPACES)
 STANDARD PARKING SPACE 9' x 18'
 HANDICAP PARKING SPACE 13' x 18'

SITE ANALYSIS


- TOTAL AREA OF SITE = 3.295 AC.
- ZONING POR, PLANNED OFFICE AND RESEARCH
- OPEN SPACE (GREEN AREA) PROVIDED = 1.5 AC. (45%)
- BUILDING COVERAGE OF SITE = 7272 x 3 = 21,816 SF
- GROUPS = 14,234 SF EACH = 42,702 SF TOTAL
- LANDSCAPED ISLANDS REQUIRED (5% OF PARKING AREA) = 2460 SF
 LANDSCAPED ISLANDS PROVIDED = 6500 SF (13%)

NOTE: THIS PLAN TO BE USED FOR LANDSCAPING ONLY

LEGEND

- (1) - - - - - EXISTING CONTOUR
- (2) - - - - - PROPOSED CONTOUR
- (3) - - - - - EX. CONC. CURB AND GUTTER
- (4) - - - - - PROP. CONC. CURB AND GUTTER
- (5) - - - - - FLOW DIRECTION
- (6) - - - - - PROP. PAVING
- (7) - - - - - PROP. CONC. WALK

SIGNATURES BLOCK
APPROVED
 PLANNED AND
 ENGINEERED
 OF HOWARD COUNTY
 DATE 3-14-90
Cem

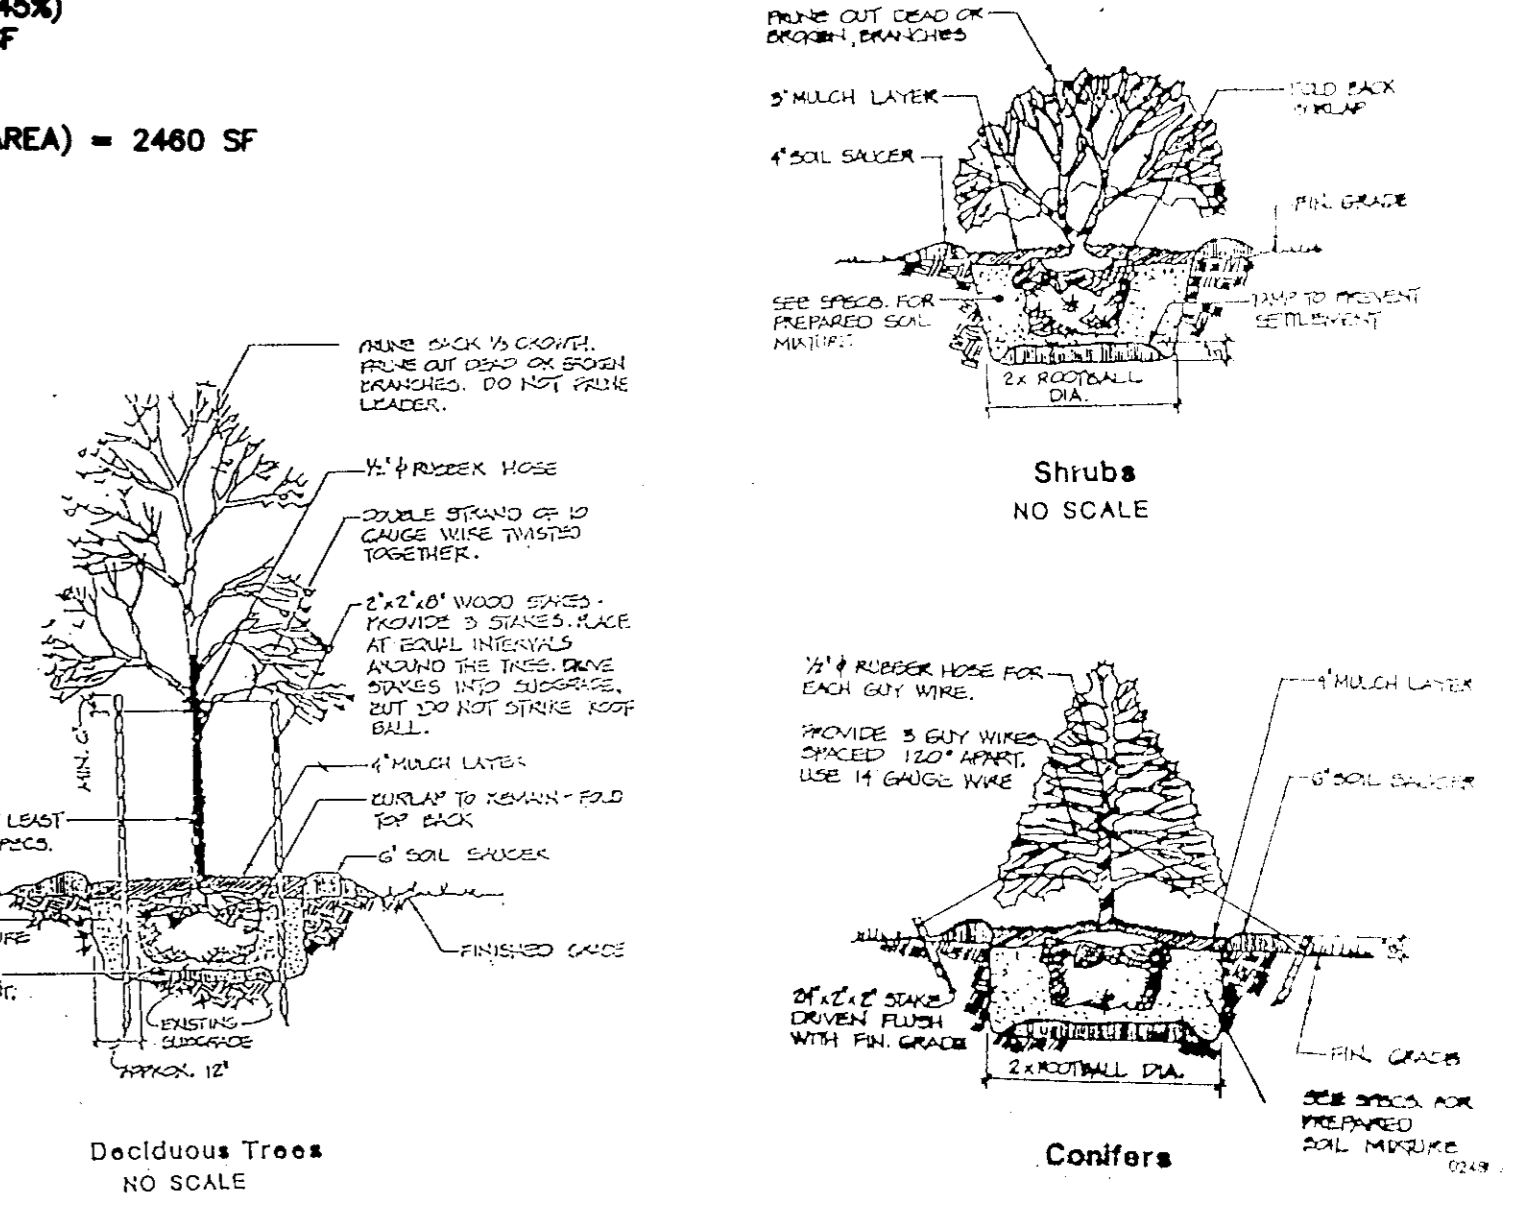

PLAN
SCALE 1" = 50'

DESIGNED	DATE	BY	DESCRIPTION
JVP	9/89		
DRAWN	9/89	W.H.N.	Redline - Remove 1 1/2" W.H.C. Remove Blow-Off, provide 8" x 6" R, provide 4" x 4" add 4" W profiles
CHECKED	9/89		
APPROVED	9-20-90	S.G.R.	Redline - Revised Dimensions & Outfall
	11-4-93		Bldg Additions Group "A" & "C" & Ramp Detail.

ENGINEERING TECHNOLOGIES ASSOCIATES, INC.
 ENGINEERS • PLANNERS • SURVEYORS
 3458 ELLICOTT CENTER DRIVE, SUITE 101
 ELLICOTT CITY, MARYLAND 21043
 BALTO. 461-9920 WASH. 621-4990



OWNER / DEVELOPER
 ELLICOTT RIDGE CORPORATION II
 BY: SON CONSTRUCTION CO. INC.
 3440 ELLICOTT CENTER DRIVE, SUITE 101
 ELLICOTT CITY, MARYLAND 21043
 301.246.4788

LANDSCAPE PLAN
DORSEY HALL
 (OFFICE CONDOMINIUMS)
 SECTION - 2 AREA - 5 PARCEL N-2
 2ND ELECTION DISTRICT, HOWARD COUNTY, MARYLAND
 SCALE AS SHOWN CONTRACT NO. DATE: 9/89 SHEET: 7 OF 7
 SDP 9065