



LEGEND:

Contour Interval	2 FT.
Existing Contour	--- 330 ---
Proposed Contour	--- 330 ---
Spot Elevation	+305
Direction of Drainage	→
Existing Storm Drain	--- 18" CMP ---
Proposed Storm Drain	--- 18" CMP ---
Existing Sewer	--- 8" S ---
Existing Water	--- 12" W ---
Grading By Others	--- 338 ---

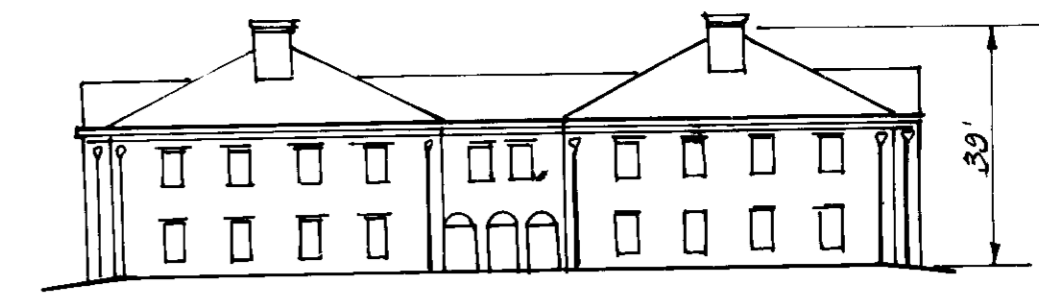

BUILDING ELEVATION
SCALE: 1"=30'

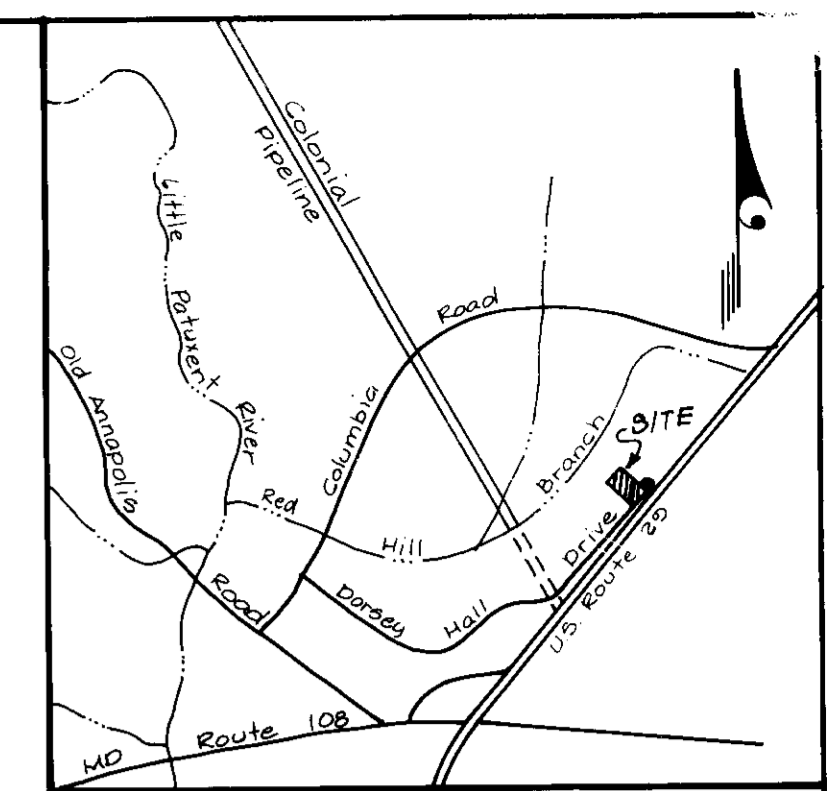

VICINITY MAP
Scale: 1"=2,000'

DORSEY HALL
SECTION 2 AREA 5
PLAT 7855
OPEN SPACE LOT 4
ZONED: P.O.R.

Ex. 100 YR Flood Plain, Drainage, Sewer
and Utility Easmt. Plat 7855

ENVIRONMENTAL CONDITIONS:

- The original site conditions have been altered by total mass grading per F-88-37 completed 8-88.
- Steep slopes at rear of site are as per wetland Mitigation Measures by H.R.D. Land Co.
- 100 Yr. Flood Plain limits of ultimate created wetlands as shown.
- No significant vegetation exists on the site.


SITE ANALYSIS:

- Area of Parcel: 2.147 Ac.
- Zoning: P.O.R. (Planned Office Research)
- Proposed use of structure: Office Building.
- Floor space: 1st floor = 12,422 sq gross
2nd floor = 12,422 sq gross
- Number of parking spaces required: 100 Employees = 70 proposed = 98
- Open Space (green area) to remain on-site = 0.887 Ac. or 41.0% of Net.
- Building coverage of site = 0.285 Ac. or 12,422 sq ft or 13.0% of Gross Ac.
- Handicap parking spaces required = 4 provided = 4
- Pile reference numbers: 5-78-20, P-84-27, P-86-26, F-85-16, F-85-56, VP-87-97, F-88-37, F-89-217 & P.B. 184.
- Proposed Parking Lot Area: 42,463 sq ft.
- Landscape Islands: 2825 sq ft or 7% of Parking Lot Area.

GENERAL NOTES:

- All materials and construction to be in accordance with Howard County Road Construction Codes & Specifications.
- Coordinates shown are extensions made from Maryland State Plane Coordinate System. Bearings refer to True North and are based on Maryland Bureau of Control Surveys Point "Columbia Reset 1966" N 512095.04 E 846139.78.
- All driveways are privately owned and maintained.
- Any damage to county owned rights of way to be corrected at the developer's expense.
- Installation of traffic control devices shall be in accordance with the latest edition of the "Manual of Uniform Traffic Control."
- Theography was compiled from actual field survey by C.F. & S. Inc. on 7-17-89 and is based on M.D. Coordinate Grid System.
- Information concerning underground utilities was obtained from available records, but the contractor must determine the exact location by digging test pits, by hand, at all crossings well in advance of construction.
- The contractor or developer shall contact the Construction Inspection Survey Division 24 hours in advance of work at 992-2017 or 792-7272.
- The developer agrees to work with the dept. of Licenses and Inspections to resolve any problem with roof water discharge.
- Handicap parking details shall be in accordance with the "Maryland Building Code for the Handicapped," Sect. 5.01-7.05 and detail sht. 2.
- Deed Reference: L-493 F-602 L-506 F-302
- Notify all utility companies 24 hours in advance of construction.
- All construction methods and materials for the on-site private W.P.S. system shall follow the current edition of the Howard County Plumbing Code, Supplement by the Howard County Std. details and specs. as amended in 1989 where necessary.
- Refuse removal is private.
- The area shown is located on Tax Map #30.
- Created wetlands and Grading by H.R.D. as per F-88-37 & a Mitigation Plan provided by H.R.D.

NOTE: STORM WATER MANAGEMENT IS PROVIDED IN A CENTRAL FACILITY. SEE APPROVED PLANS F-85-16.

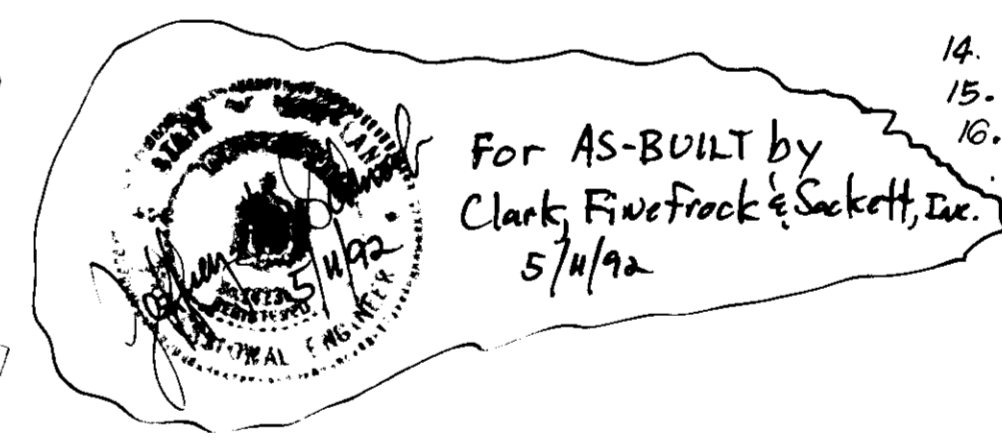

For AS-BUILT by
Clark, Finerock & Sackett, Inc.
5/1/92

ADDRESS CHART

LOT NO.	STREET ADDRESS
0-3	5310 Dorsey Hall Drive

OWNER:	SUBDIVISION NAME:	SECT./AREA:	PARCEL:
CONSOLIDATED CASUALTY JOINT VENTURE 6625 Selnick Drive Baltimore Md 21227	DORSEY HALL	2/5	0-3
PLAT NO:	BLOCK NO:	ZONE:	TAX MAP NO:
8886	4	P.O.R.	30
REC. DIST:	REC. DIST:	DENISUB:	OR:
2ND	2ND	6023.01	
WATER CODE:	SEWER CODE:		
F08	5750600		

CLARK • FINEROCK & SACKETT, INC. ENGINEERS • PLANNERS • SURVEYORS	
7135 MINSTREL WAY • COLUMBIA, MD. 21045 • (301) 381-7500 - BALTO. • (301) 621-8100 - WASH.	
DESIGNED:	RHG
DRAWN:	KIWM
CHECKED:	JLS
DATE:	10-5-89
FOR:	CONSOLIDATED HOME BUILDERS, INC. 6625 Selnick Drive Baltimore, Md. 21227
SCALE:	1"=30'
DRAWING:	10F6
JOB NO.:	88-14c.
FILE NO.:	88-14G X

APPROVED: FOR PUBLIC WATER AND PUBLIC SEWERAGE SYSTEMS,
HOWARD COUNTY HEALTH DEPARTMENT

James B. ... 2-6-90
COUNTY HEALTH OFFICER DATE

APPROVED: HOWARD COUNTY DEPT. OF PLANNING & ZONING

... 3-5-90
DIRECTOR DATE


APPROVED: FOR PUBLIC WATER AND PUBLIC SEWERAGE,
STORM DRAINAGE SYSTEMS AND PUBLIC ROADS
HOWARD COUNTY DEPARTMENT OF PUBLIC WORKS

... 2/2/90
DIRECTOR DATE


... 2-1-90
CHIEF BUREAU OF ENGINEERING DATE

REVISIONS

1	Add 3 Dumpster Pads, delete 2 Parking Spaces	9-9-91
2		

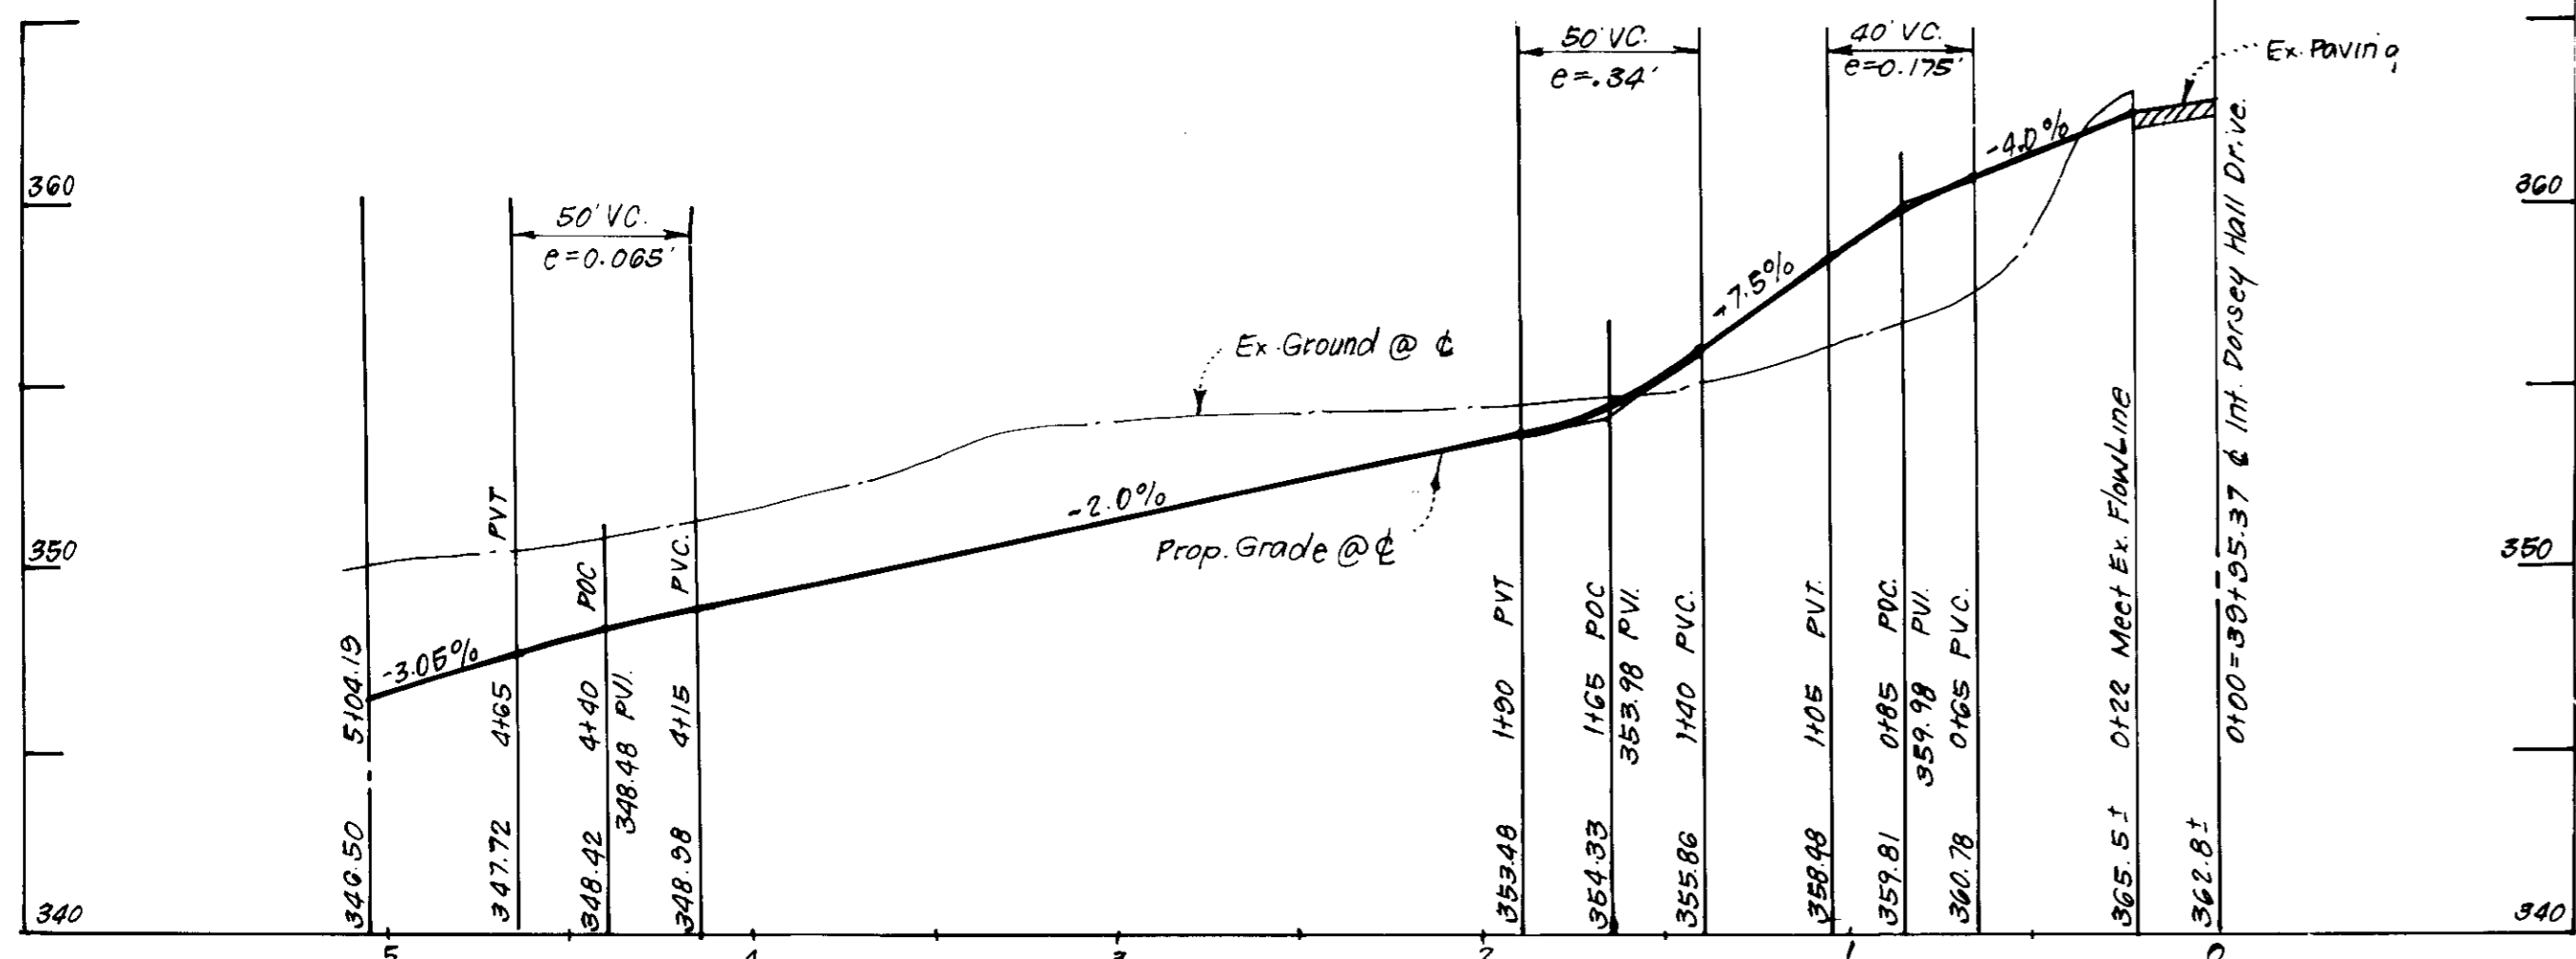


PROFILE
 SCALES: HORIZ. 1"=50'
 VERT. 1"=5'

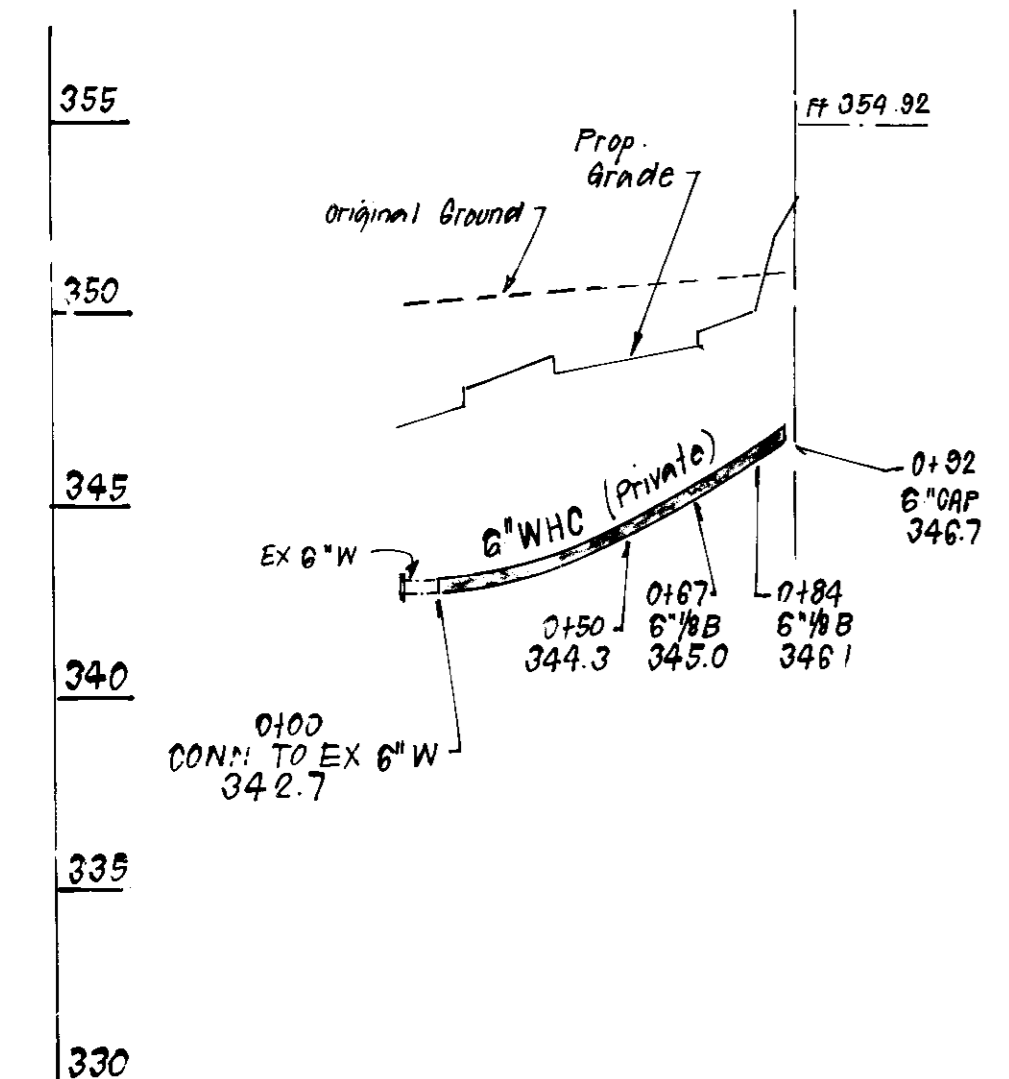

WATER & SEWER NOTES


- All construction methods and materials for on-site private water and sewer systems shall follow the current edition of the Howard County Plumbing Code, supplemented by the Howard County Standard Details and Specifications where necessary.
- Areas where water house connections are to be built shall be at final grade and connections shall be laid with a minimum of 3.5' cover.
- Water and sewer house connections shall be built to within 5' of building.
- 6" Water pipe shall be Ductile Iron, Class 52.
- 6" Sewer pipe shall be PVC unless otherwise noted on profile.

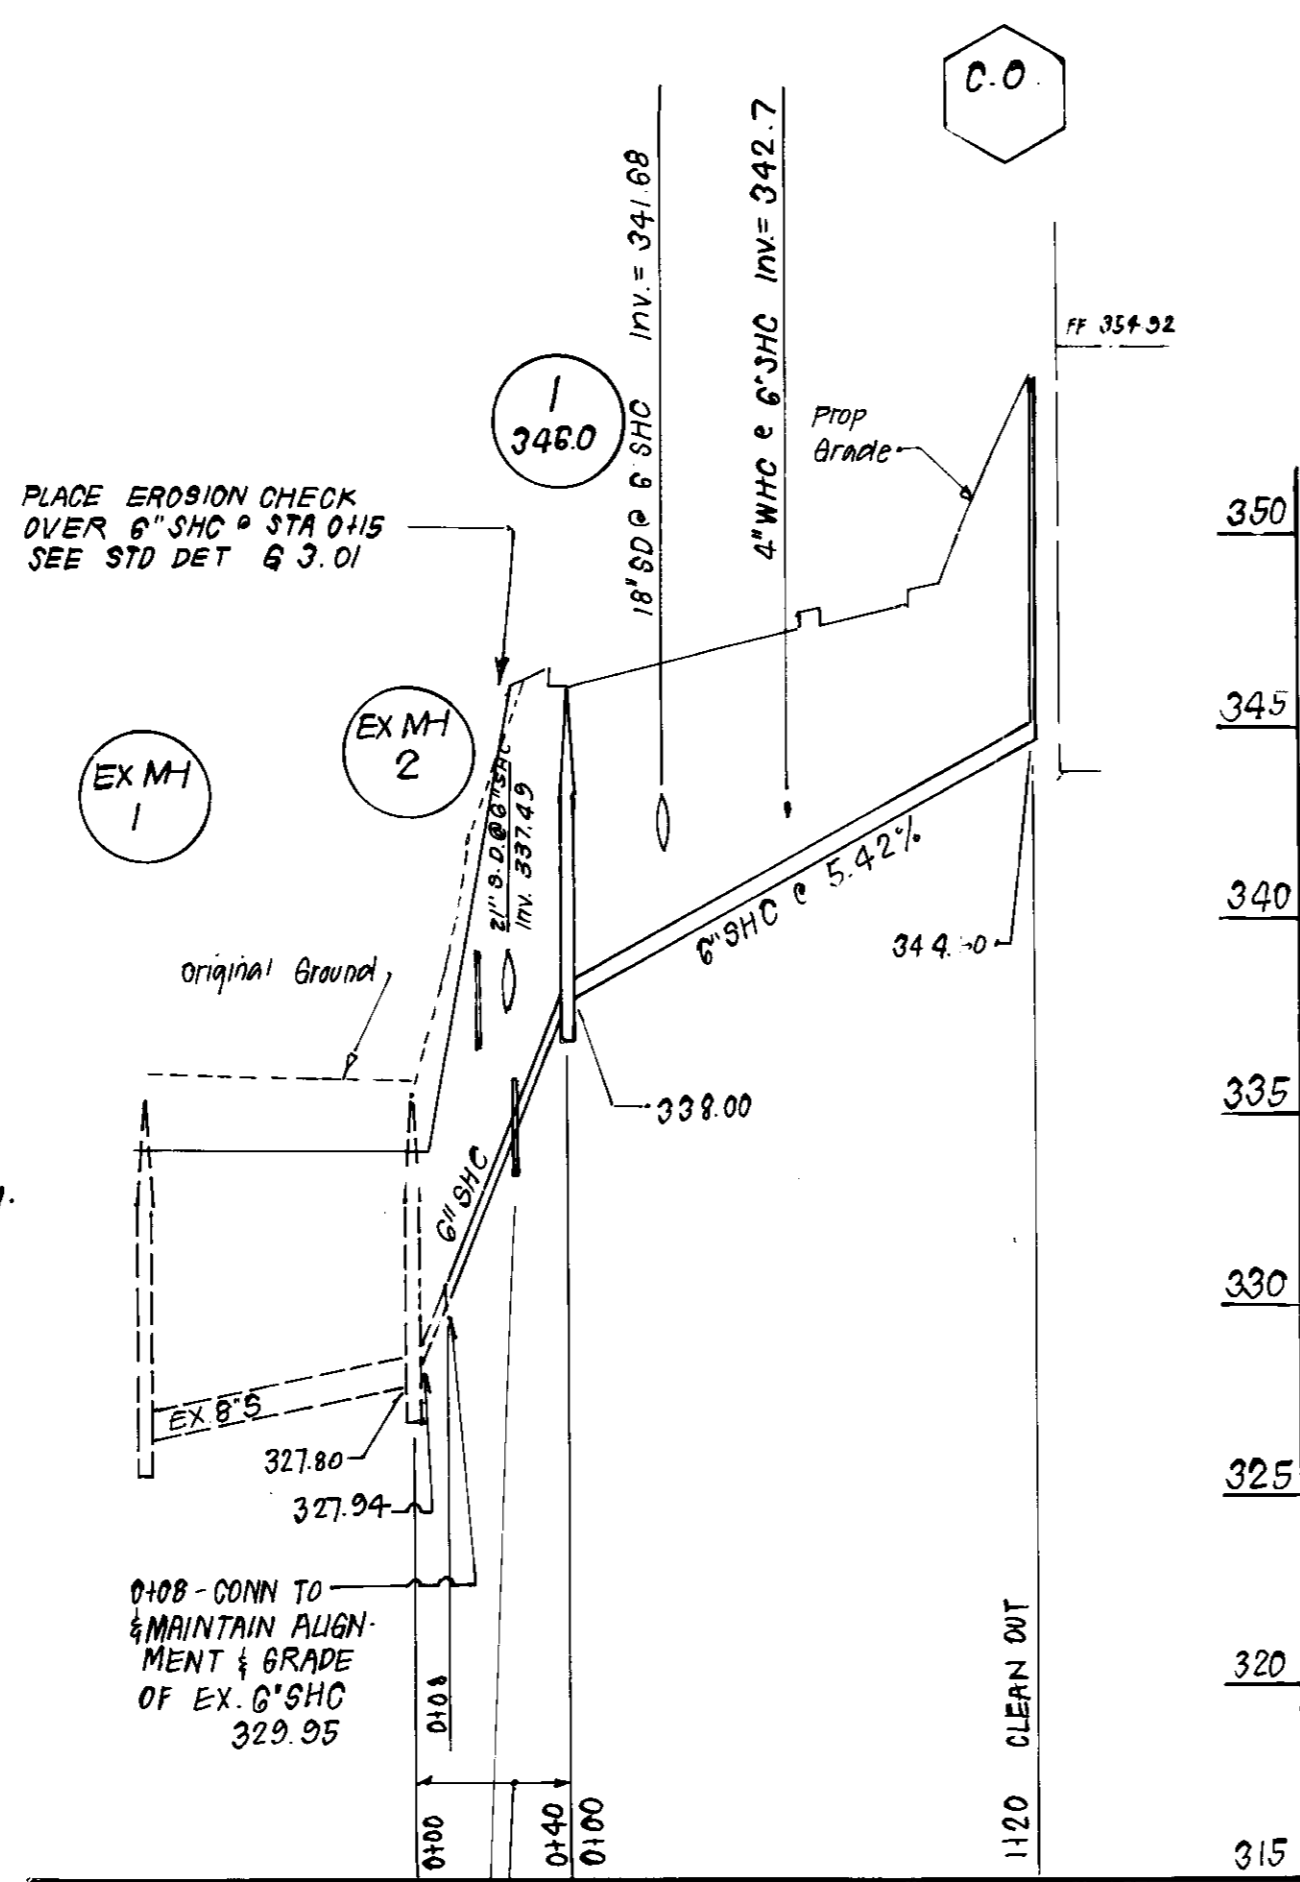


PLACE CONC ANCHOR ON DOWNSIDE OF BELL NEAREST STA 0126 SEE STD DET 6.3.01

6" DUCTILE IRON PIPE CLASS 52 @ 25.15%


NOTE: CONFIRM EXACT LOCATION (HOR & VERT) OF EX. 6" SHC WELL IN ADVANCE OF CONSTRUCTION IF CONFLICT APPEARS IMMINENT, CONTACT OF'S WITH RS-BUILT LOCATION

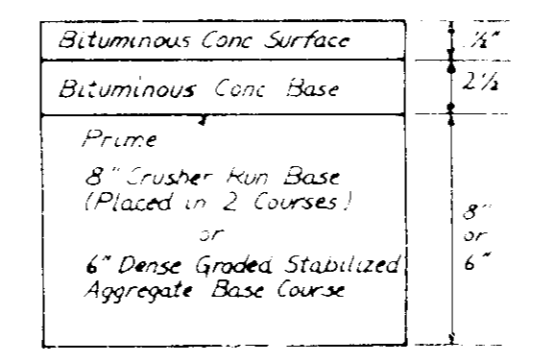


ALTERNATE PAVING SECTION FOR TRAVELLED WAY
 (SECTION P-2)
 NO SCALE

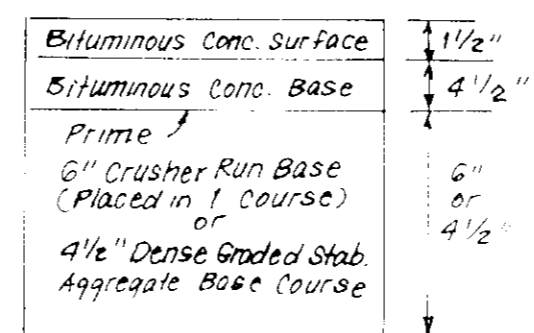


ALTERNATE PAVING SECTION FOR PUBLIC ROADS
 (SECTION P-3)
 NO SCALE

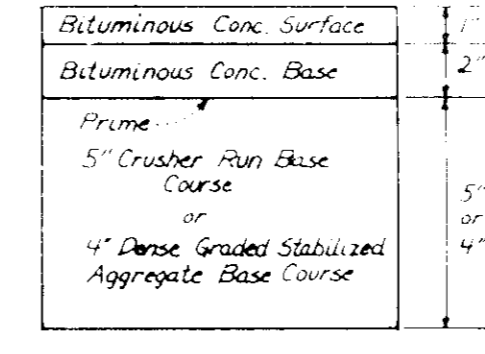


ALTERNATE PAVING SECTION FOR PARKING AREAS
 (SECTION P-1)
 NO SCALE

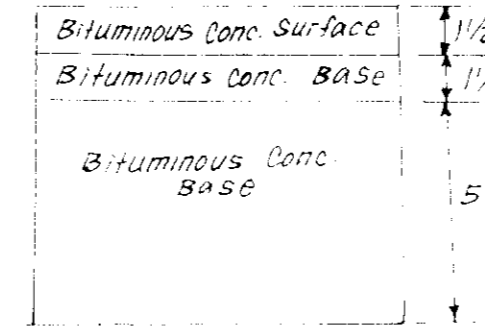


PAVING SECTION FOR PUBLIC ROAD
 (SECTION P-3)
 SEE PLAN VIEW

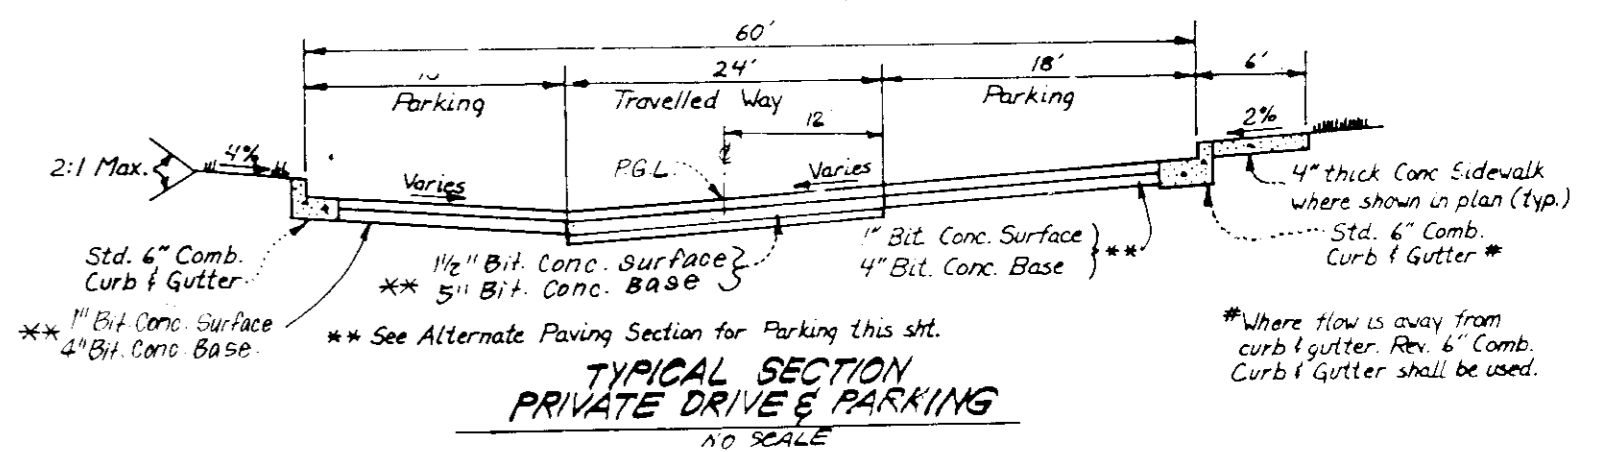


TYPICAL SECTION PRIVATE DRIVE & PARKING
 NO SCALE

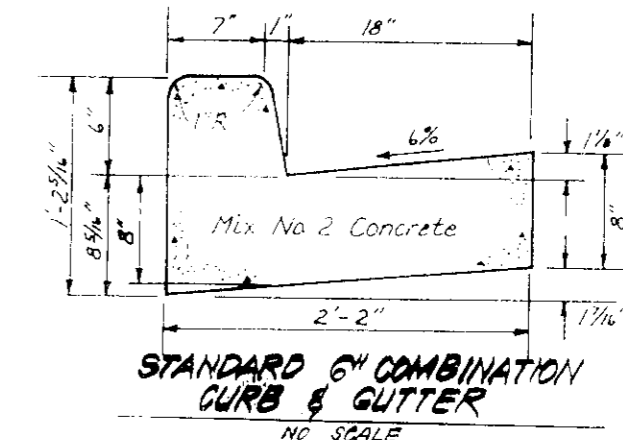


STANDARD 6" COMBINATION CURB & GUTTER
 NO SCALE

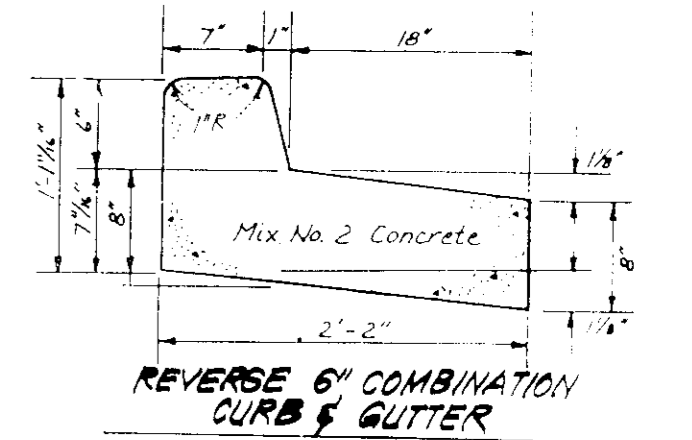

REVERSE 6" COMBINATION CURB & GUTTER
 NO SCALE

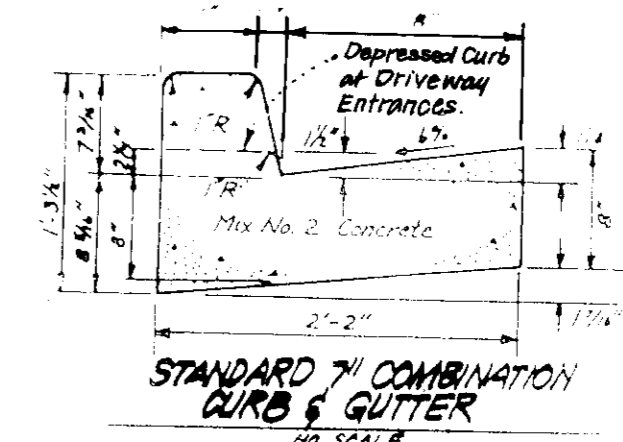


STANDARD 7" COMBINATION CURB & GUTTER
 NO SCALE

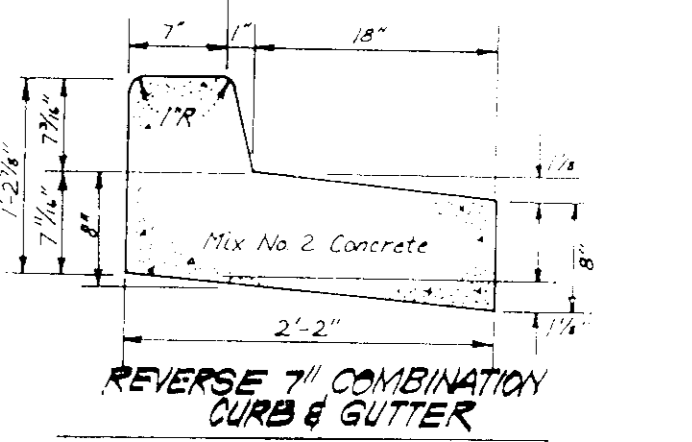


REVERSE 7" COMBINATION CURB & GUTTER
 NO SCALE




COLORS
 Letters and Border - Green
 White Symbol on Blue Background
 Background - White

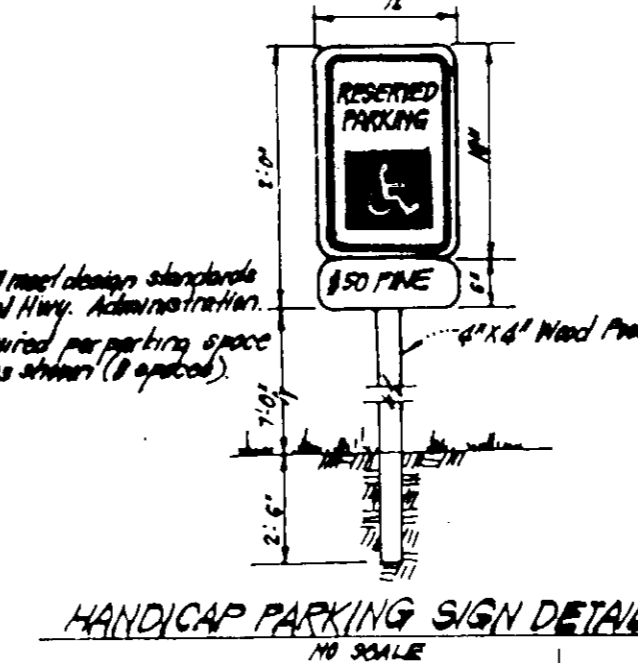


HANDICAP PARKING SIGN DETAIL
 NO SCALE

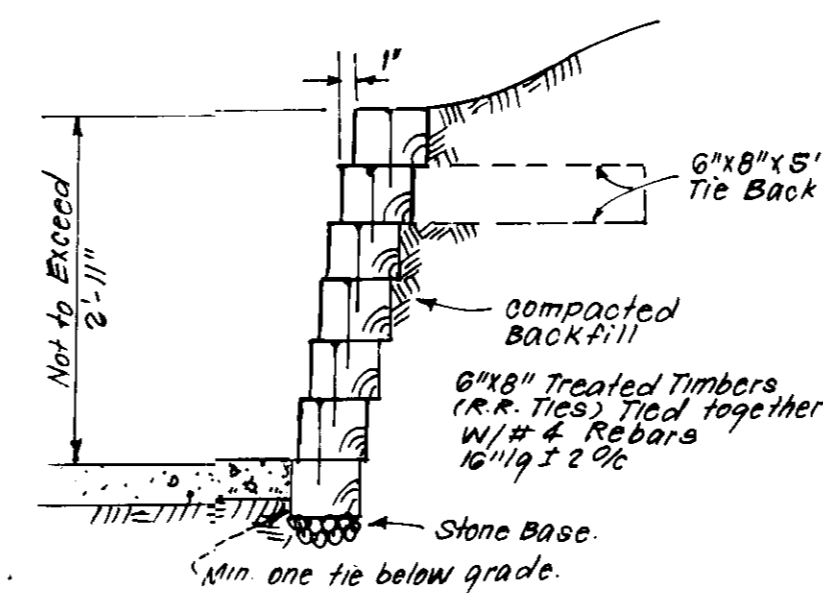

TYPICAL RETAINING WALL
 NO SCALE

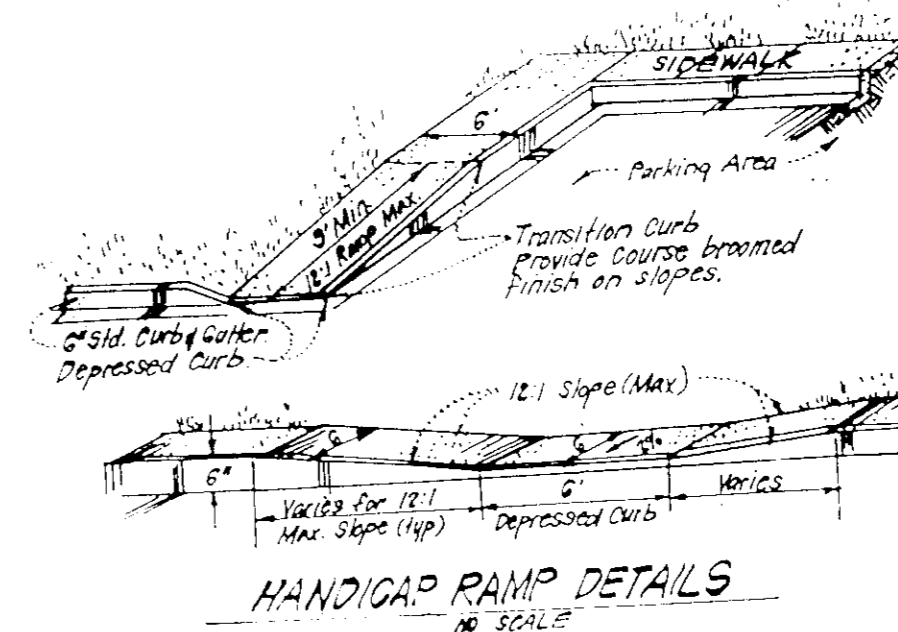

HANDICAP RAMP DETAILS
 NO SCALE

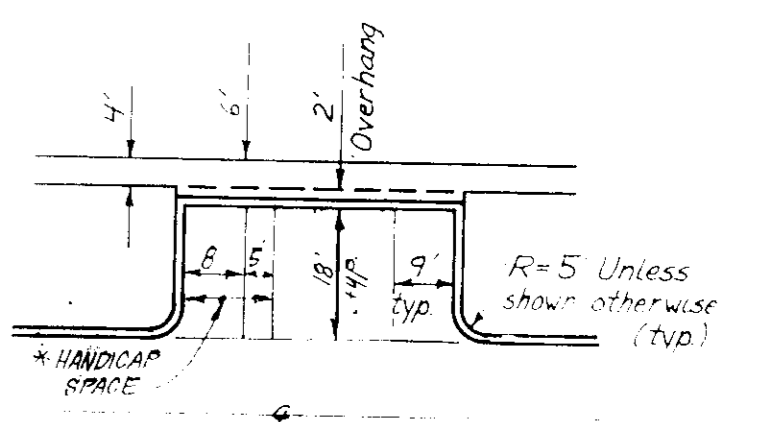

TYPICAL PARKING
 NO SCALE

12-6-89
 LS

OWNER:
 CONSOLIDATED CASUALTY JOINT VENTURE
 66 EB SEINICK DRIVE
 BALTIMORE MD. 21227

APPROVED: FOR PUBLIC WATER AND PUBLIC SEWERAGE SYSTEMS. HOWARD COUNTY HEALTH DEPARTMENT	<i>[Signature]</i> 2-6-90	DATE
COUNTY HEALTH OFFICER		
APPROVED: HOWARD COUNTY DEPT. OF PLANNING & ZONING	<i>[Signature]</i> 3-5-90	DATE
DIRECTOR		
APPROVED: FOR PUBLIC WATER AND PUBLIC SEWERAGE. STORM DRAINAGE SYSTEMS AND PUBLIC ROADS HOWARD COUNTY DEPARTMENT OF PUBLIC WORKS	<i>[Signature]</i> 2/2/90	DATE
DIRECTOR		
APPROVED: FOR PUBLIC WATER AND PUBLIC SEWERAGE. STORM DRAINAGE SYSTEMS AND PUBLIC ROADS HOWARD COUNTY DEPARTMENT OF PUBLIC WORKS	<i>[Signature]</i> 2-1-90	DATE
CHIEF BUREAU OF ENGINEERING		




CLARK • FINEBROCK & SACKETT, INC. ENGINEERS • PLANNERS • SURVEYORS		
DESIGNED	SITE DEVELOPMENT PLAN DETAILS	SCALE
DRAWN	PARCEL 03	As Shown
CHECKED	DORSEY HALL	DRAWING
DATE	SECTION 2 AREA 5	20FG
	2ND ELECTION DISTRICT	JOB NO.
	HOWARD COUNTY, MARYLAND.	88-146
		FILE NO.
		88-146-X

STRUCTURE DATA (OIL GRIT SEPARATOR)															
Str. No.	Drain. Area	Volume Req'd.	Volume Provided	DIMENSIONS							Floor Slab Elev.	18" ACCMP Elbow Inv.	Throat Length	Top Slab Elevation	
				A	B	C*	D*	E	F	G				Upper	Lower
OG #10	1.40	560 CF	569 CF	27'	5.34'	13.54'	6.78'	4.0'	14.2'	7.0'	336.58	340.58	10'	348.4	346.85
				27.17	13.5	13.54	6.78	4.0	14.17	7.0	337.44	341.54		347.27	346.85

NOTE: For storm drain inverts, see storm drain profiles.
 Storage required = 40 c.f. per 0.1 Ac. of drainage area.
 (Total storage computed to depth (S).
 * When combined length of oil and grit chambers exceed 12 Feet, "D" = 1/2 x "C" (= 2/3 total of "D" = 1/6 total).





- Notes:
- For 2" pipe see manufacturer's specs or field measure circumference of pipe and divide by 3.14.
 - Within road R/W, trench compaction density shall be 95% as determined A.S.H.T.O. T-100A.
 - For conditions requiring solid sheeting or trench shields "A" shall not exceed 30'.

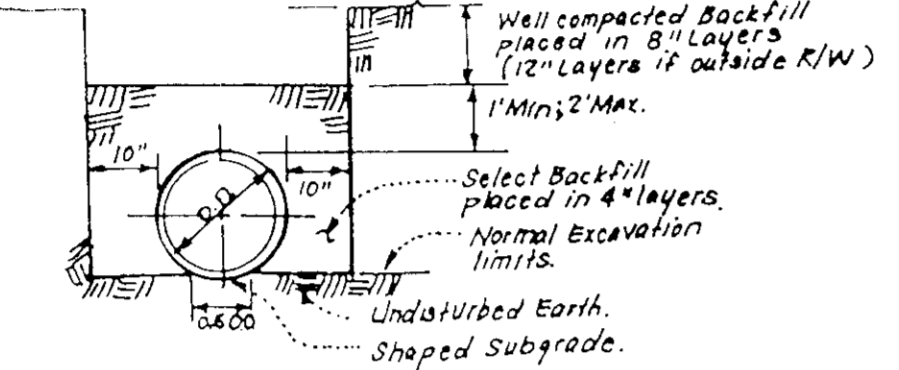

PIPE SCHEDULE		
SIZE	TYPE	LENGTH
18"	CMP	16.99
21"	CMP	16.99


2 1/2" x 1/2" Corrugations. *(Total)

STRUCTURE SCHEDULE A						
No.	TYPE	INV. IN	INV. OUT	TOP ELEVATION	REMARKS	LOCATION
8.1	A-10 Inlet	-	343.20	347.30	No. Co. Std. SD. 4.02 W=2'6" Sec. Plan.	

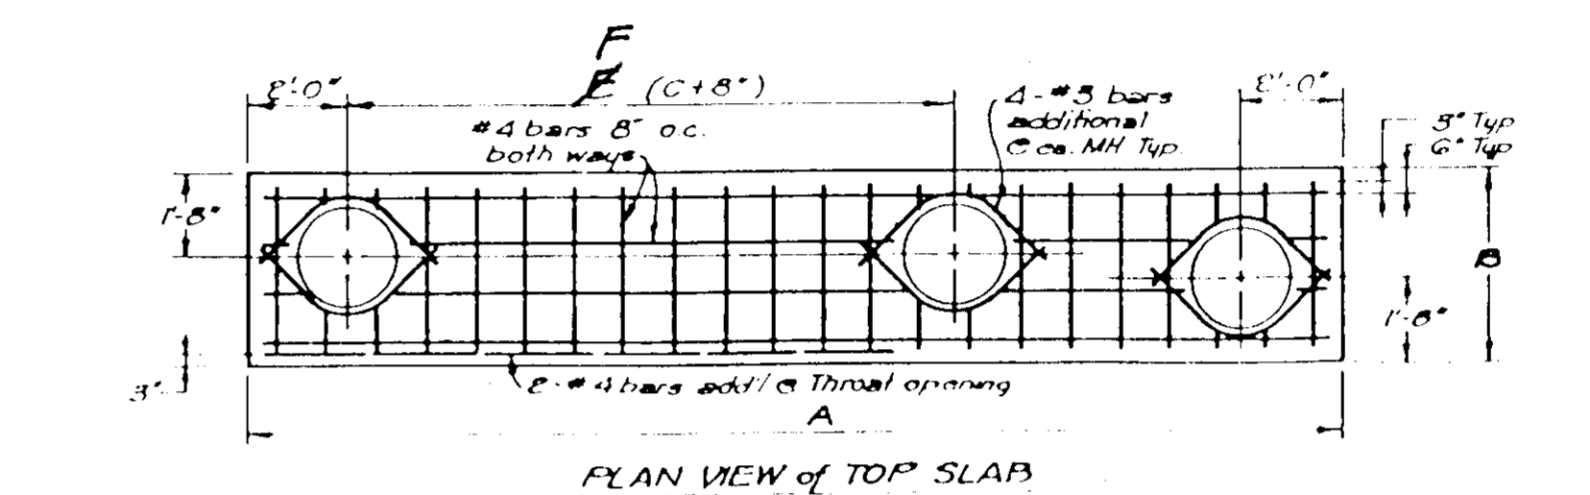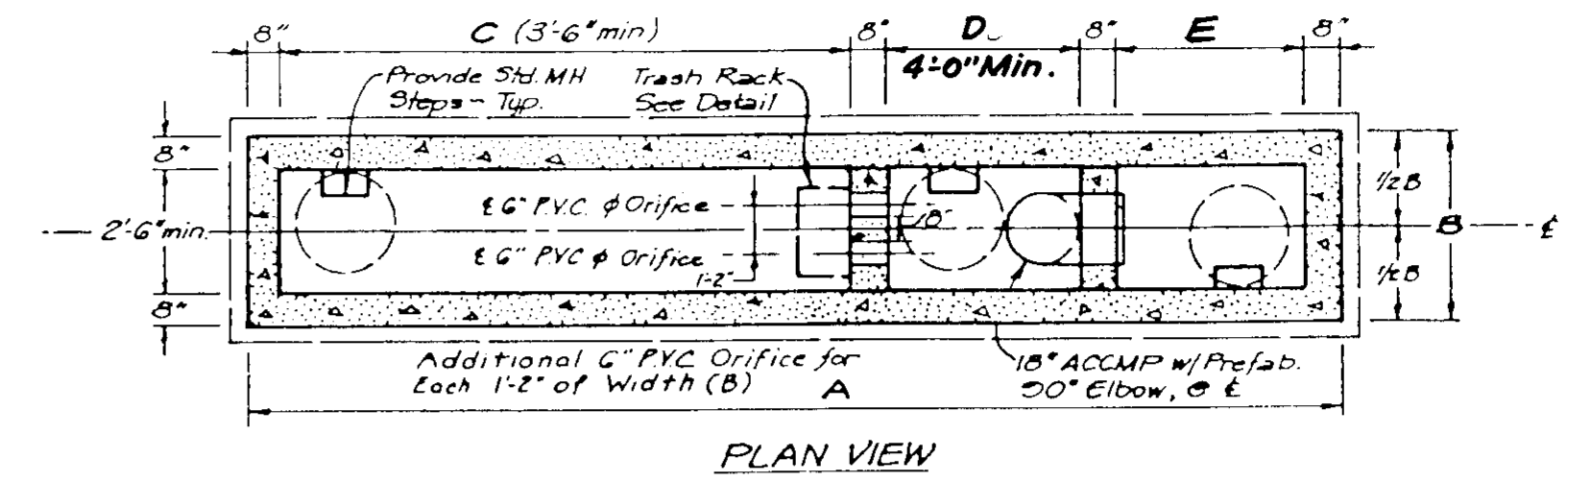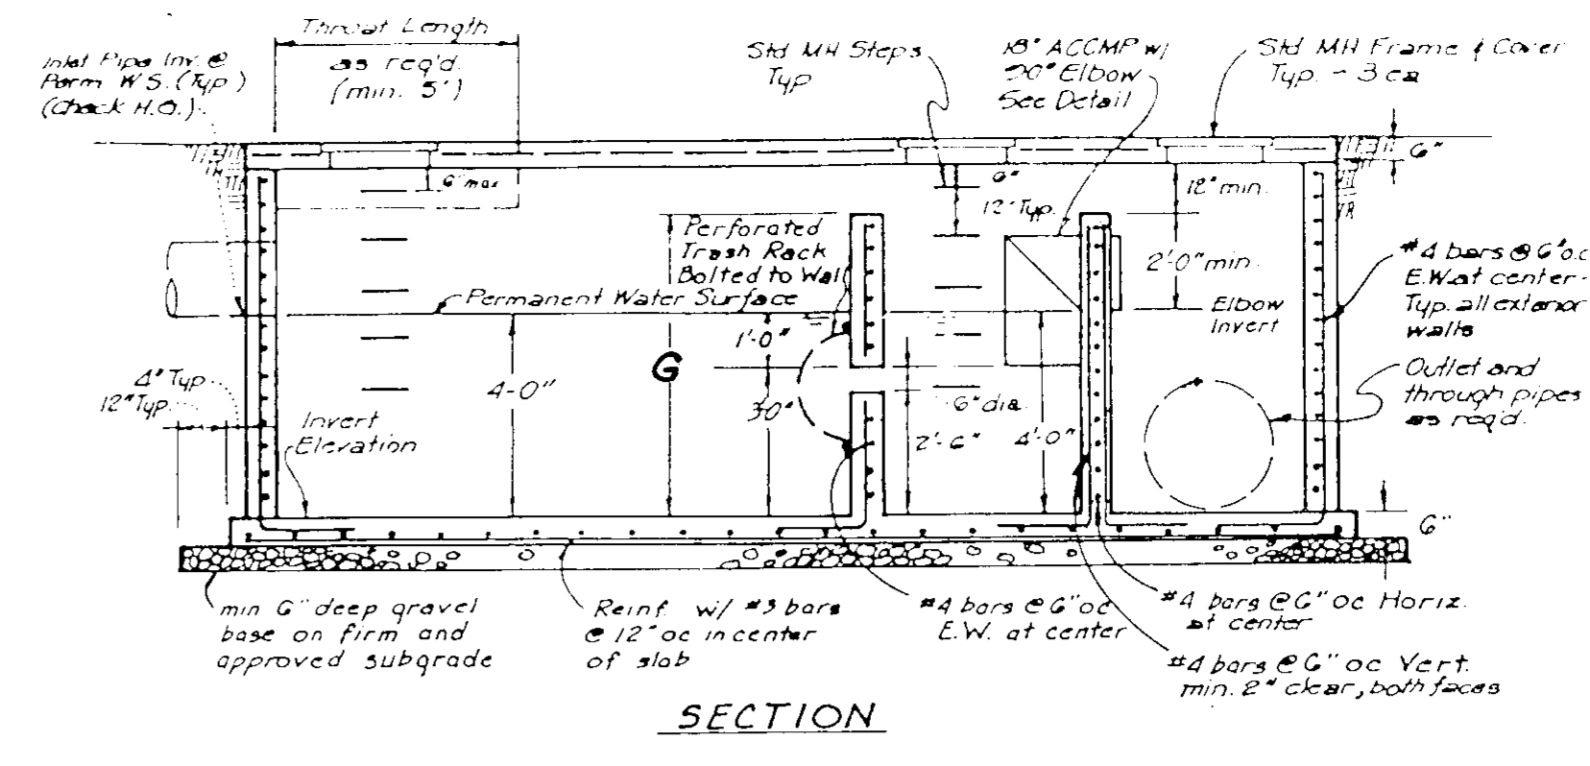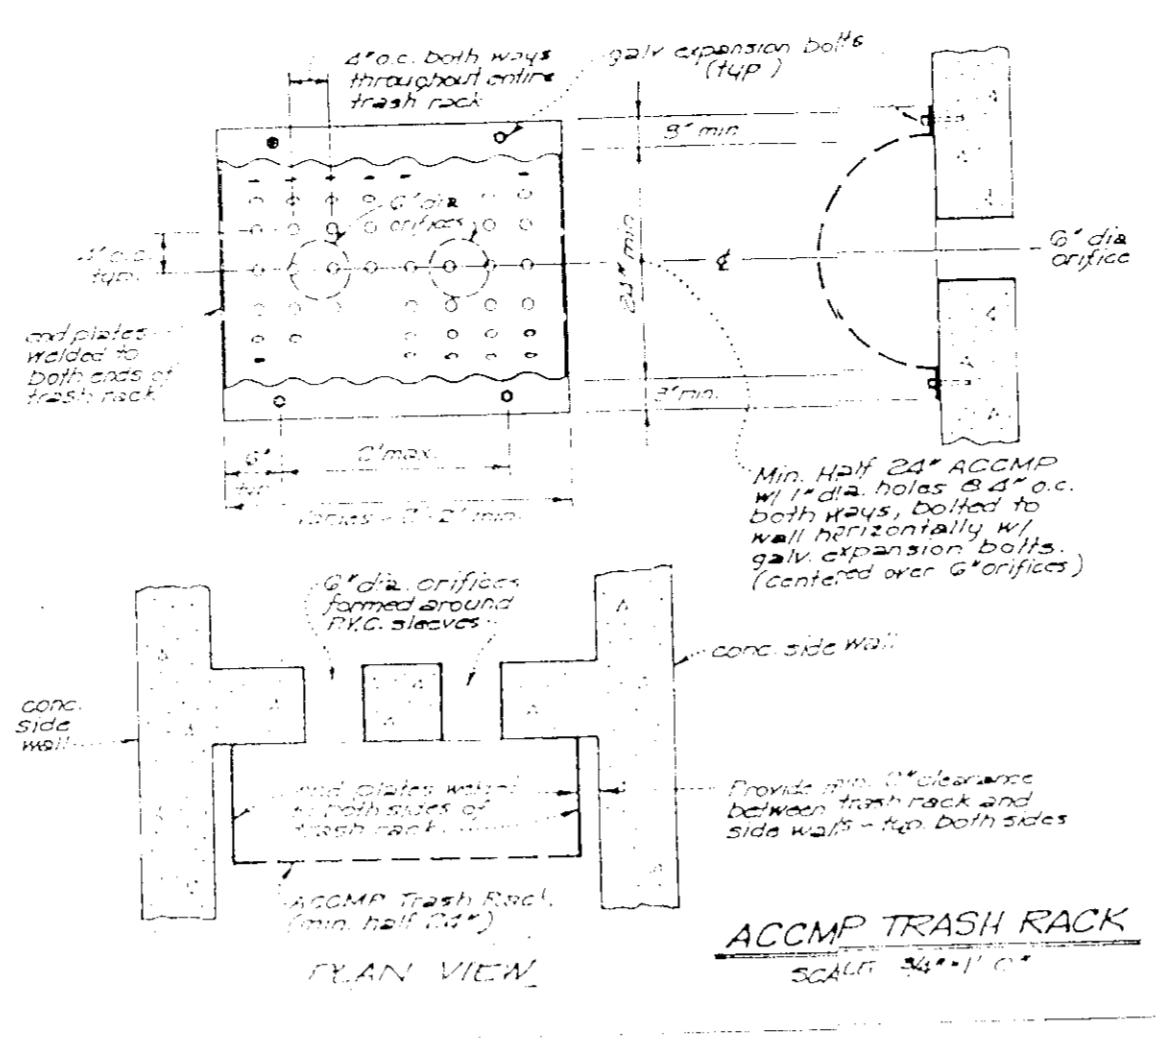

WATER QUALITY CONTROL STRUCTURE

- DESIGN AND GENERAL NOTES:
- Use poured-in-place concrete for the entire structure.
 - Refer to Maryland State Highway Administration for details of construction methods.
 - Wall thickness shall be as follows:
 - Minimum 8 inches thick for the first 3'-0" of depth and 12 inches thick for walls between 3'-0" and 12'-0" of depth and 16 inches thick for walls of depth greater than 12'-0". Depth to be measured to crown of outside pipe.
 - f/c = 3,500 psi at 28 days.
 - All reinforcing steel to be ASTM A615, Grade 60.
 - For details concerning throat openings, refer to the details on page 55.
- | Throat Length | No. of Pipe Supports |
|---------------|----------------------|
| 5' | 2 |
| 10' | 3 |
| 15' | 4 |
| 20' | 5 |
- pipe supports to be spaced at 5'-0" O.C.
- For details not noted in this standard, refer to M.D.C. Standard 55.
 - The top 4 inches of walls may be brick masonry for leveling, if required. Brick masonry shall comply with the latest S.D.C. Specification.
 - When grate opening is used, refer to the appropriate S.D.C. Standard for details. Details shall be shown on the plans.
 - When inside width of structure is greater than 4'-0", reinforcement shall be revised as needed.
 - When structure is subject to traffic loading, reinforcement shall be designed for the appropriate traffic loads. Design loads shall be indicated on the plans.
 - All inlets and incoming pipes shall be checked for proper alignment or tailwater problems.
- CONSTRUCTION NOTES:
- Silt and debris shall not be allowed to enter the structure until contributing drainage areas have been permanently stabilized.
 - All openings to structures shall be protected with the appropriate sediment control measures during construction.
- MAINTENANCE NOTES (WATER QUALITY STRUCTURE WASTE):
- Water Quality Structures will require periodic cleaning. Owners of these facilities will have to clean them as needed or on a frequency that the County determines is appropriate. Owners of storm water structures will be notified by the County of the frequency of maintenance.
 - Maintenance of these facilities will consist of cleaning out the Separator and disposal of the waste and the repair of the facility as needed. Periodic inspections of these facilities will be made by the County Stormwater Management group.
 - The disposal of the liquid and solid matter should be as follows:
 - All liquid material in the Separator inlet shall be pumped into a suitable tank truck and disposed of at an approved Sanitary District discharge manifold or be taken to an approved sewage treatment plant for discharge.
 - The solid material shall be landfilled in an approved Sanitary Landfill.
 - The inlet pipes, trash racks, grates, and structural parts shall be repaired as needed.

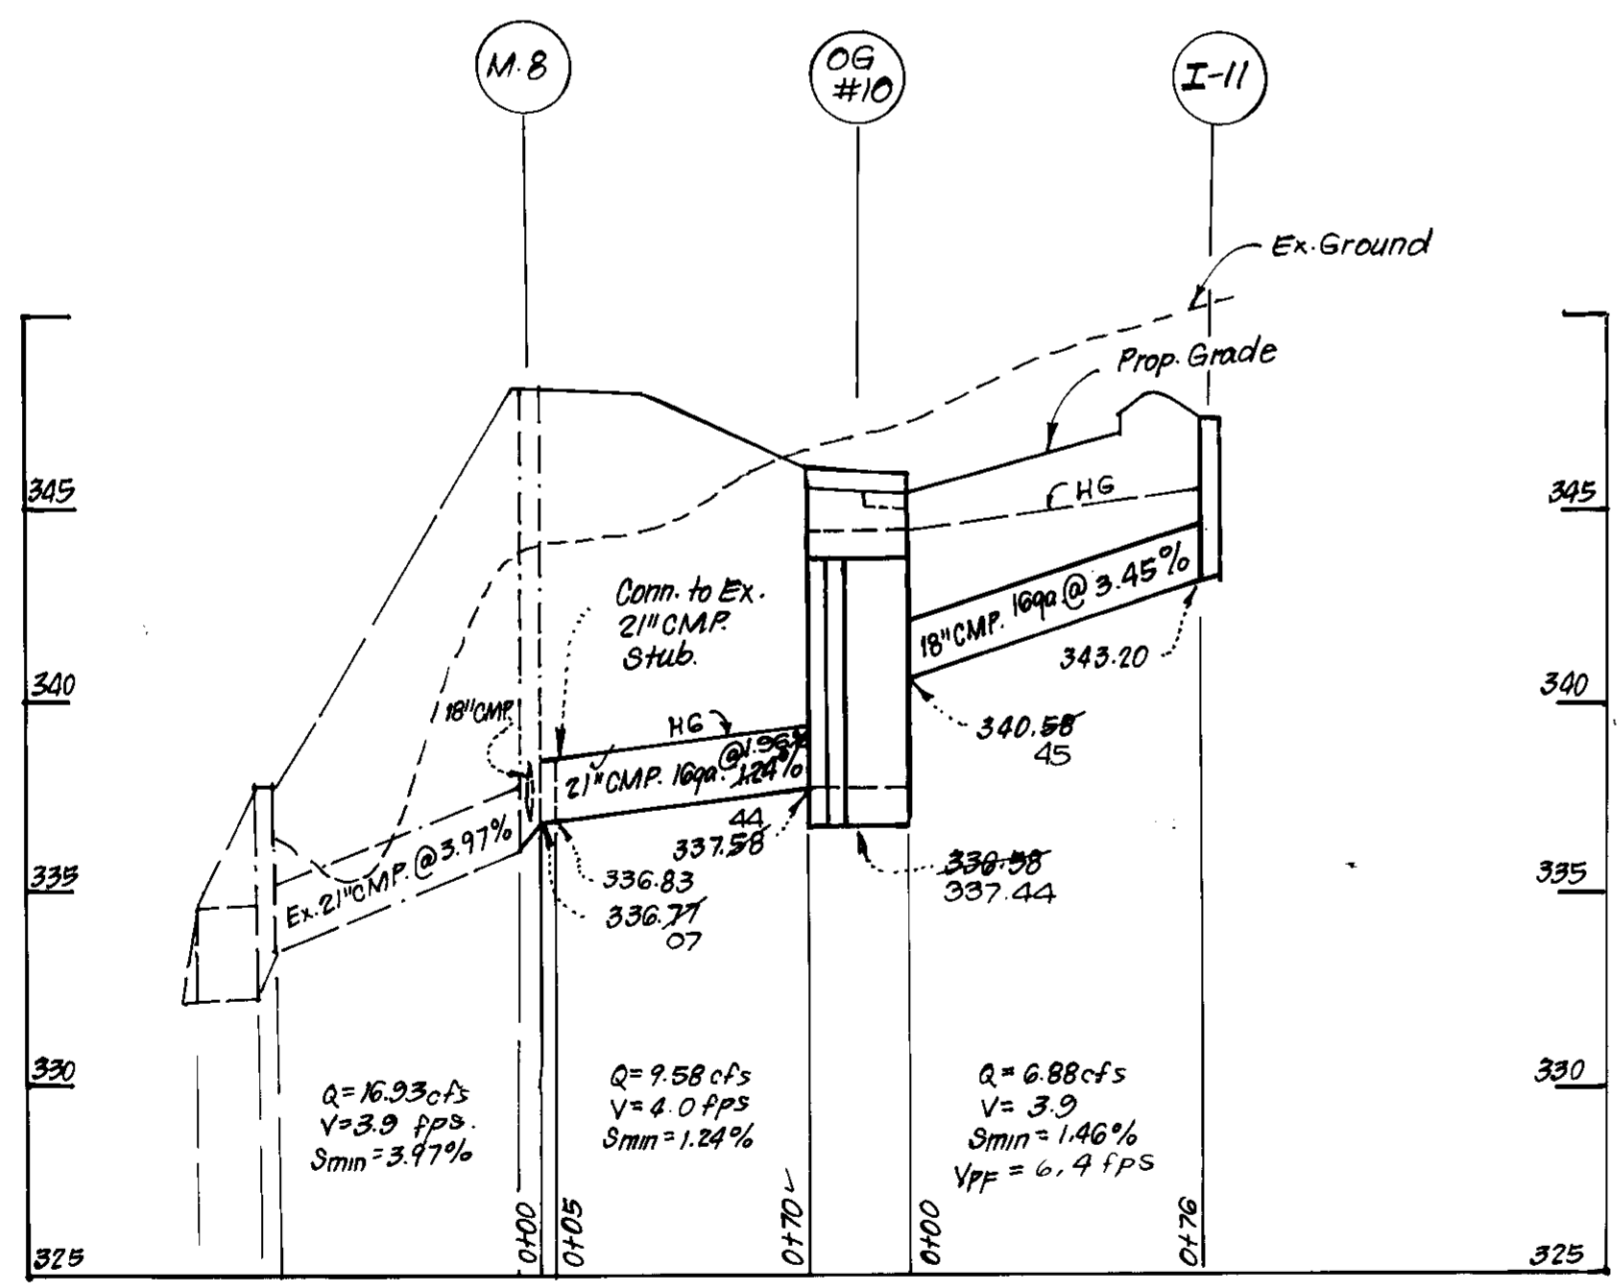

PROFILE
 SCALE: HORIZ. 1"=50'
 VERT. 1"=5'

APPROVED: FOR PUBLIC WATER AND PUBLIC SEWERAGE SYSTEMS.
 HOWARD COUNTY HEALTH DEPARTMENT

APPROVED: FOR HOWARD COUNTY DEPT. OF PLANNING & ZONING

APPROVED: FOR PUBLIC WATER AND PUBLIC SEWERAGE.
 STORM DRAINAGE SYSTEMS AND PUBLIC ROADS
 HOWARD COUNTY DEPARTMENT OF PUBLIC WORKS

For AS-BUILT by
 Clark, Finebrock & Sackett, Inc.
 5/1/92

APPROVED
 DATE: 12-6-89

OWNER:
 CONSOLIDATED CASUALTY JOINT VENTURE
 6625 Selnick Drive
 Baltimore Md. 21227

CLARK • FINEBROCK & SACKETT, INC.
 ENGINEERS • PLANNERS • SURVEYORS

DESIGNED: K/W/M
 DRAWN: K/W/M
 CHECKED: ULS
 DATE: 10-5-89


SITE DEVELOPMENT PLAN
 DETAILS
 PARCEL 03
DORSEY HALL
 SECTION 2 AREA 5
 2ND ELECTION DISTRICT
 HOWARD COUNTY, MARYLAND.

SCALE: As Shown
 DRAWING: 30F6
 JOB NO: 88-146
 FILE NO: 88-146




LEGEND:

Contour Interval	2 FT
Existing Contour	--- 330 ---
Proposed Contour	--- 330 ---
Spot Elevation	+30.5
Direction of Drainage	Ex. 18" CMP
Existing Storm Drain	--- 18" CMP ---
Proposed Storm Drain	--- 18" CMP ---
Existing Sewer	--- 8" S ---
Existing Water	--- 12" W ---
Grading By Others	--- 338 ---
Earth Dike	--- ED(A-1) ---
Silt Fence	--- S ---

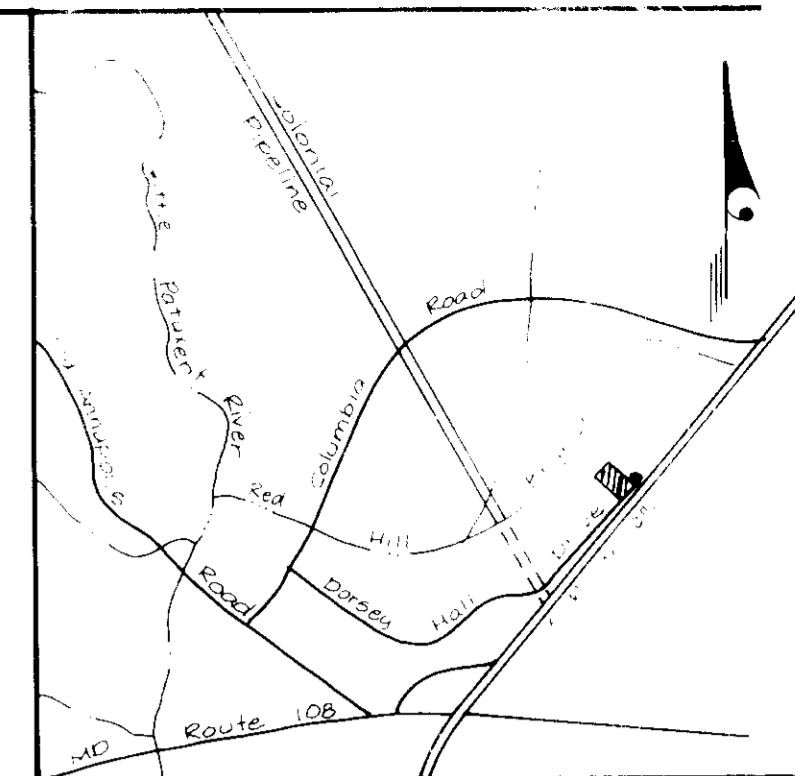

DORSEY HALL
SECTION 2 AREA 5
PLAT 7855
OPEN SPACE LOT 4
ZONED: P.O.R.

Ex. 100 YR Flood Plain, Drainage, Sewer
and Utility Easmt. Plat 7855

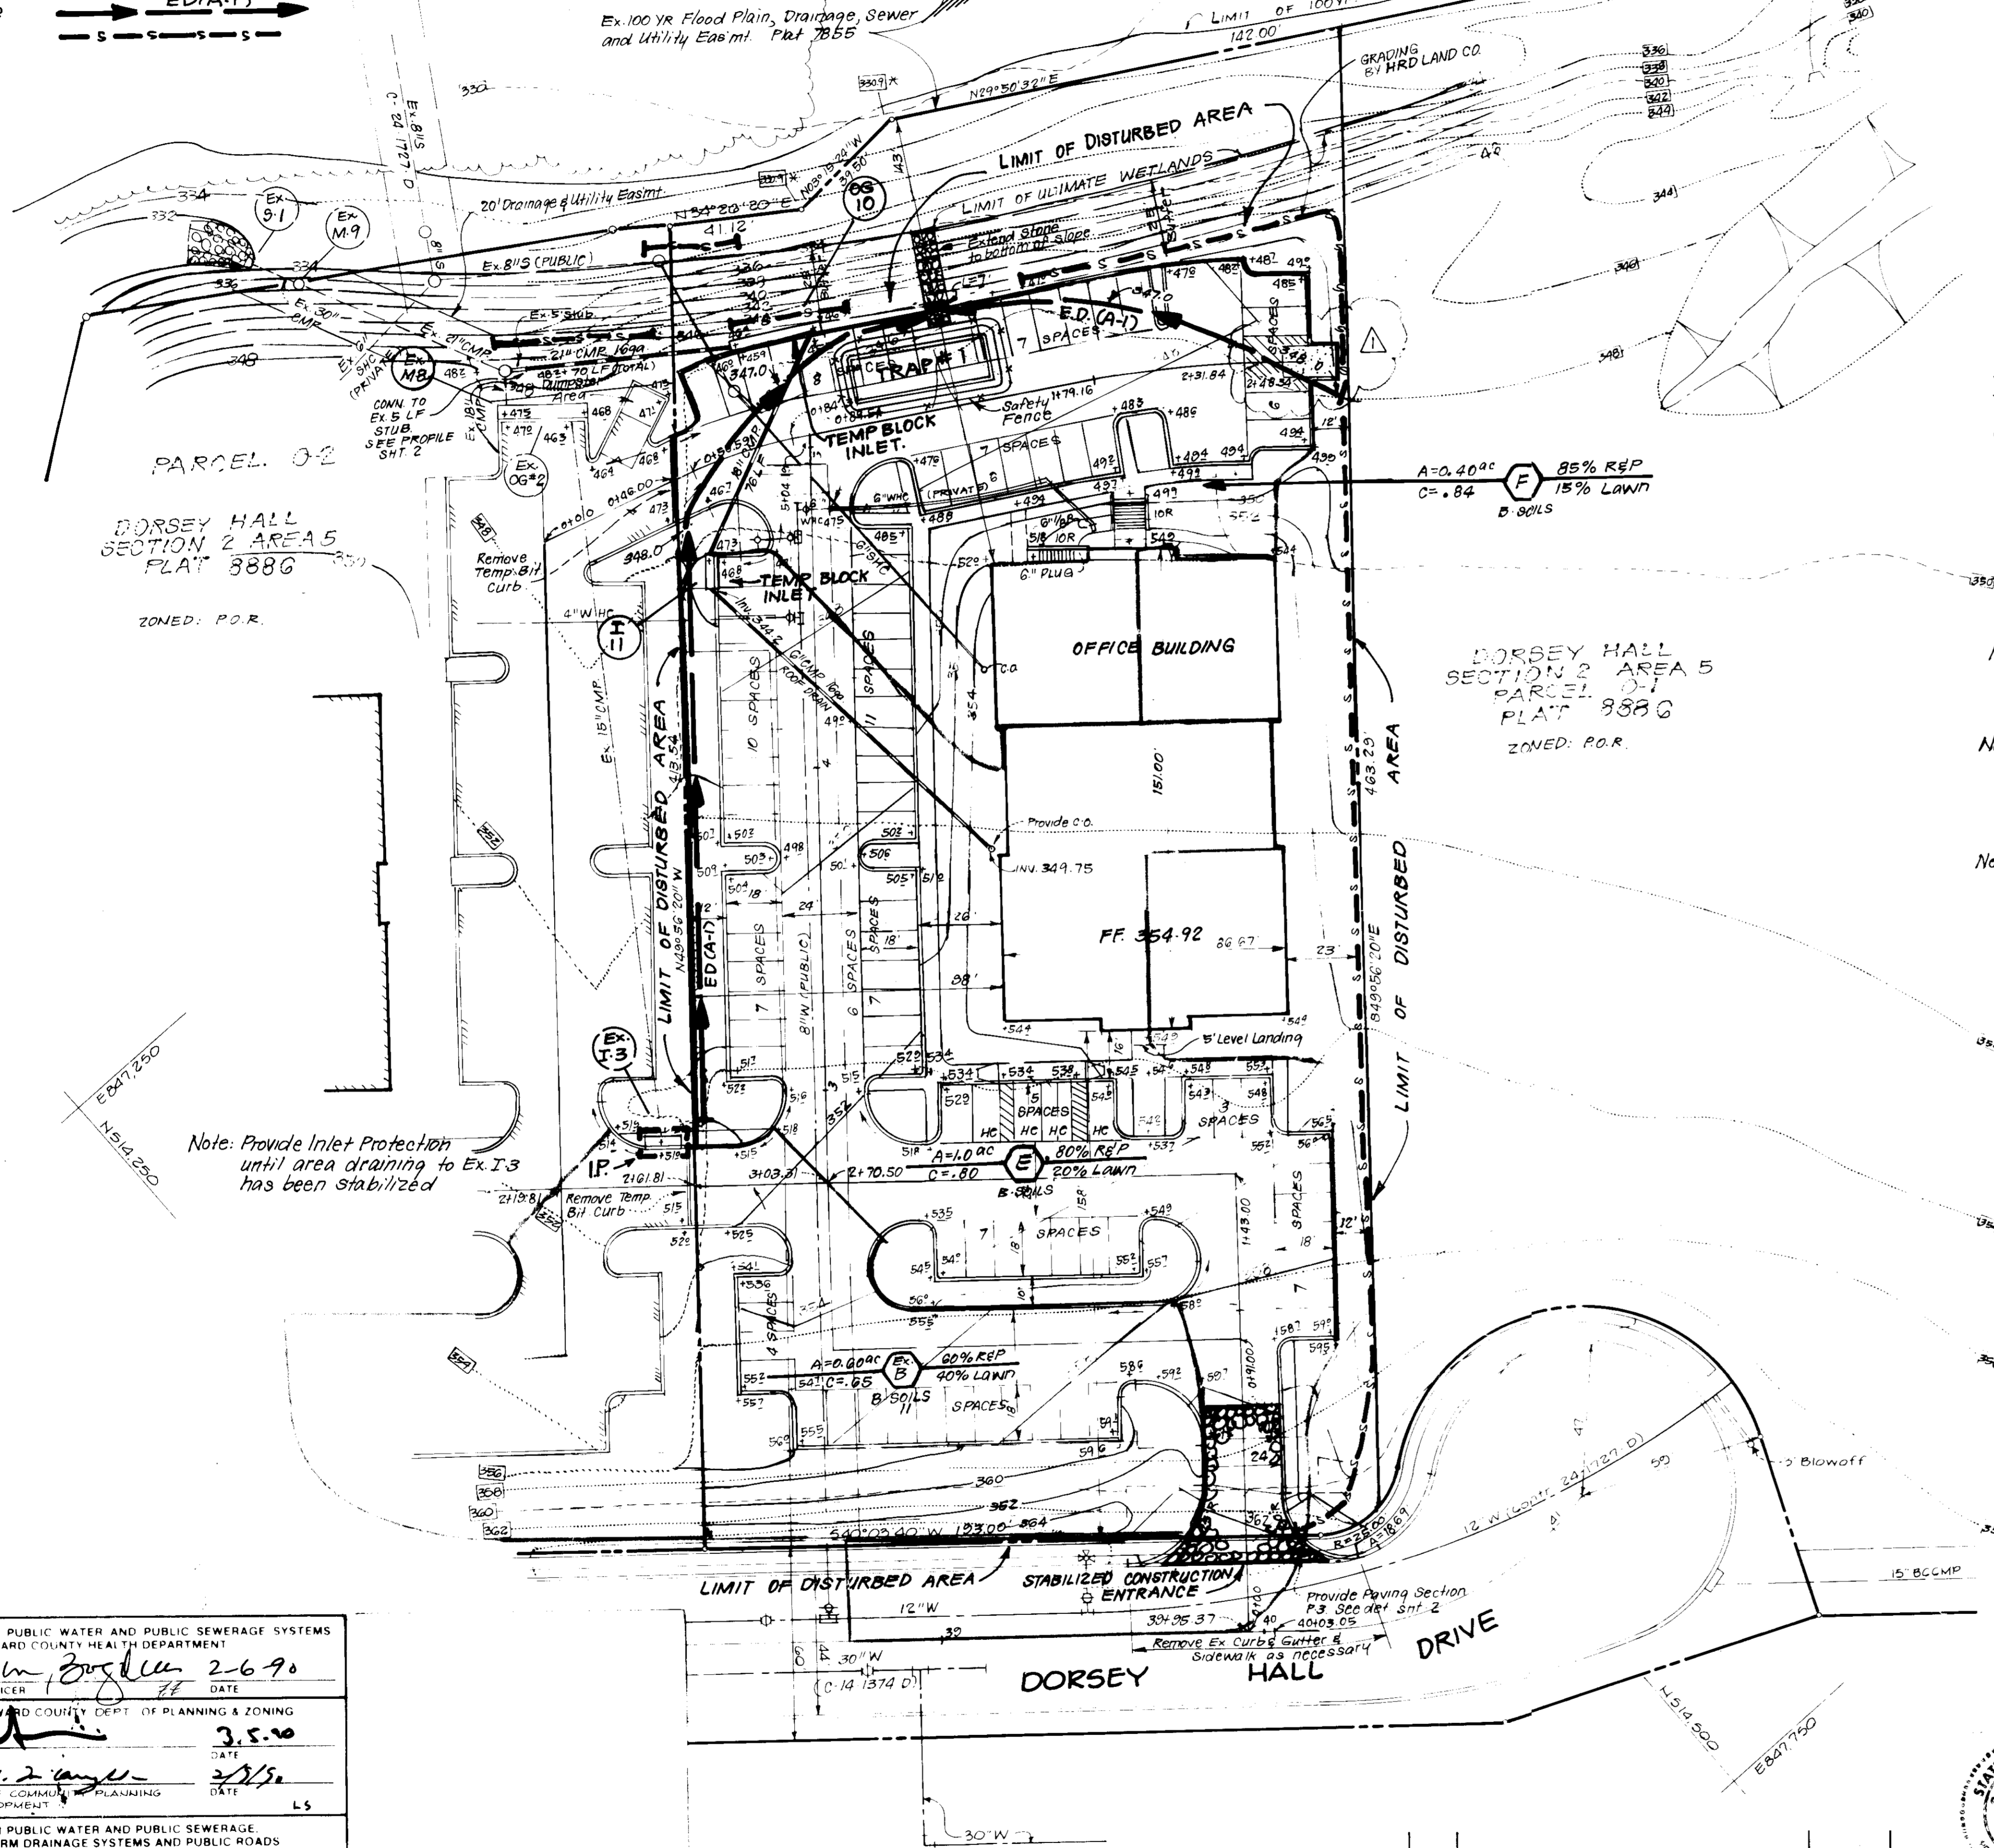

TRAP #1 S.O.S.T. (ST-V)
 Drainage Area = 1.4 Ac
 Storage Required = 3060 cf
 Storage Provided = 3060 cf
 Depth = 4'
 Top of Stone Weir = 346.5
 Bottom Elev. = 341.5
 Clean Out Elev. = 343.5
 Bottom Dimensions = 41' X 13'
 1:1 Side Slopes in Cut
 L=7'

Note: Area disturbed by storm drain installation and SHC shall be stabilized at the end of each day. Provide silt fence as required.

Note: The contractor shall provide continuous maintenance to Earth Dike at northwest end of parking area on a daily basis to insure positive drainage to Trap #1.

Note: sediment Controls are to be removed only after receiving permission from the sediment control inspector.

CONSTRUCTION SEQUENCE:

No. of Days	Description
7	1. Obtain Grading Permit
14	2. Install Sediment & Erosion Control Measures
30	3. Clear and Rough Grade Site
90	4. Construct Storm Drainage; Block Inlets as shown
90	5. Construct Utilities
120	6. Fine grade & construct paving except in area of Trap #1
180	7. Construct Building & Walks
30	8. Stabilize all disturbed areas in accordance with standards & specs.
7	9. Upon approval of the sediment control inspector, remove sediment & erosion control measures and construct remainder of parking area and stabilize as necessary.

Note: Provide Inlet Protection until area draining to Ex. I-3 has been stabilized

12-6-89
LS

Reviewed for... S.C.D.
Name
Signature
Date 12/19/89
U.S. Soil Conservation Service
THIS DEVELOPMENT PLAN IS APPROVED FOR SOIL EROSION AND SEDIMENT CONTROL BY THE U.S. SOIL CONSERVATION DISTRICT.

John R. Robertson 12/19/89
Approved Date

DEVELOPER'S/BUILDER'S CERTIFICATE
 "I/We certify that all development and construction will be done according to this plan of development and plan for erosion and sediment control and that all responsible personnel involved in the construction project will have a Certificate of Attendance at a Dept. of Natural Resources Approved Training Program for the Control of Sediment and Erosion before beginning the project. I also authorize periodic on-site inspection by the Howard Soil Conservation District or their authorized agents, as are deemed necessary."

Signature of Developer/Builder
Date 10-5-89

OWNER:
CONSOLIDATED CASUALTY JOINT VENTURE
6625 Selmick Drive
Baltimore Md. 21227

APPROVED FOR PUBLIC WATER AND PUBLIC SEWERAGE SYSTEMS
HOWARD COUNTY HEALTH DEPARTMENT
2-6-90
DATE

APPROVED FOR HOWARD COUNTY DEPT. OF PLANNING & ZONING
3-5-90
DATE

APPROVED FOR PUBLIC WATER AND PUBLIC SEWERAGE, STORM DRAINAGE SYSTEMS AND PUBLIC ROADS
HOWARD COUNTY DEPARTMENT OF PUBLIC WORKS
2-1-90
DATE

No	Added	Date
1	Added Dumpster Pad	9-9-91
REVISIONS		Date




ENGINEER'S CERTIFICATE
 I hereby certify that this plan for Erosion and Sediment Control represents a practical and workable plan based on my personal knowledge of the site conditions and that it was prepared in accordance with the requirements of the Howard Soil Conservation District.
 G. Nelson Clark 10-5-89
Date

CLARK • FINEROCK & SACKETT, INC.
 ENGINEERS • PLANNERS • SURVEYORS
 1105 MINISTREL WAY • LUMBER MILL • BALTIMORE, MARYLAND 21202

SEDIMENT & EROSION CONTROL PLAN AND DRAINAGE AREA MAP
 PARCEL 0-3
 DORSEY HALL
 SECTION 2 AREA 5
 2ND ELECTION DISTRICT
 HOWARD COUNTY, MARYLAND

SCALE 1"=30'
 DRAWING 40FG
 JOB NO 88-14G
 FILE NO 88-14GSE
 DATE 10-5-89

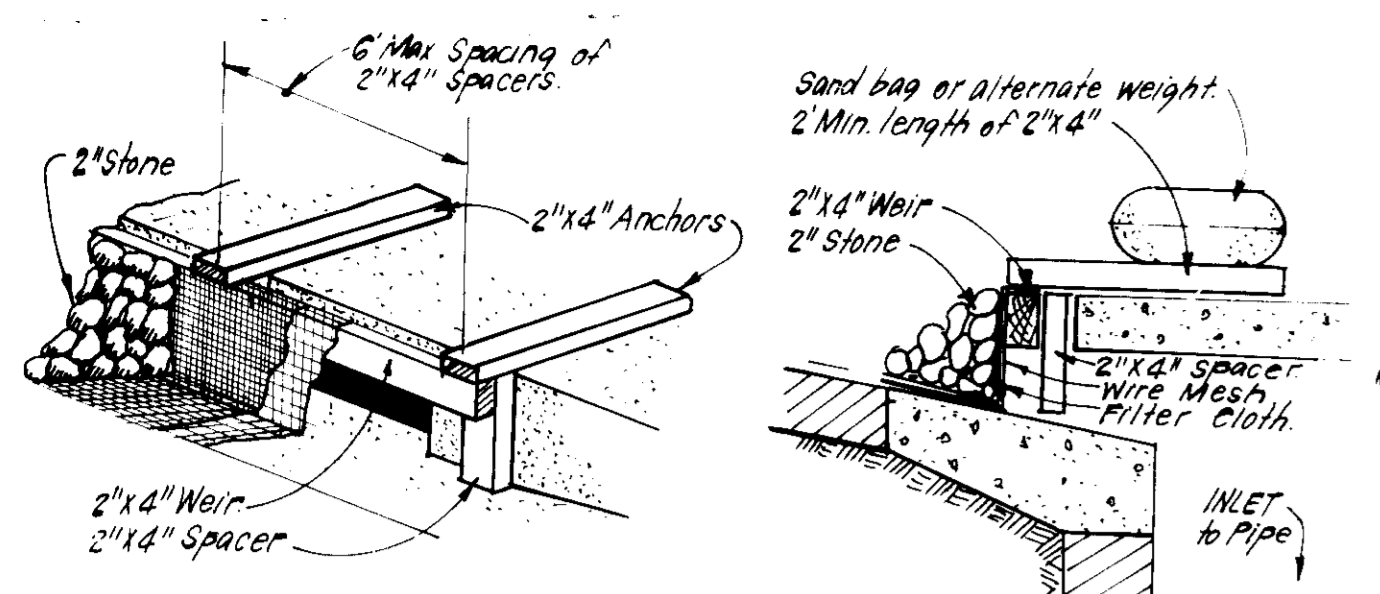

CURB INLET PROTECTION DETAIL

CONSTRUCTION SPECIFICATIONS:
MATERIALS: A. Wooden frame is to be constructed of 2x4's construction grade, treated.
 B. Wire mesh must be of sufficient strength to support filter fabric, and slope for curb inlets, with water fully impounded against it.
 C. Filter cloth must be of a type approved for this purpose, resistant to sunlight with sieve size #10, 40-85, to allow sufficient passage of water and removal of sediment.
 D. Stone is to be 2" in size and clean, since clogs would clog the cloth.

II. PROCEDURE: SWALE, DITCHLINE OR YARD INLET PROTECTION


1. Excavate completely around inlet to a depth of 18" below notch elevation.
2. Drive 2x4 post 1" into ground at four corners of inlet. Place nail strips between posts around inlet. Assemble top portion of 2x4 frame using overlap joint shown. Top of frame (weir) must be 8" below edge of roadway adjacent to inlet.
3. Stretch wire mesh tightly around frame and fasten securely. Ends must meet at post.
4. Stretch filter cloth tightly over wire mesh, the cloth must extend from top of frame to 18" below inlet notch elev. Position securely to frame. Ends must meet at post, be overlapped and folded, then fastened down.
5. Backfill around inlet in compacted 6" layers until layer of earth is even with notch elevation on ends and top elevation on sides.
6. If the inlet is not in a low point, construct a compacted earth dike in the ditch line below if the top of this earth dike is to be at least 6" higher than the top of frame (weir).
7. The structure must be inspected frequently and filter fabric replaced when clogged.

III. PROCEDURE: CURB INLET PROTECTION

1. Attach a continuous piece of wire mesh (30" min. width by throat length plus 4") to the 2x4 weir (measuring throat length plus 2") as shown on std. drawing.
2. Place a piece of approved filter cloth (40-85 sieve) of the same dimensions as the wire mesh over the wire mesh and securely attach to the 2x4 weir.
3. Securely nail the 2x4 weir to 9" long vertical spacers to be located between the weir and inlet face (max 6" apart).
4. Place the assembly against the inlet throat and nail (min 2" lengths of 2x4" to the top of the weir at spacer locations. These 2x4" anchors shall extend across the inlet top and be held in place by sandbags or alternate weight.
5. The assembly shall be placed so that the end spacers are a min 1" beyond the ends of throat opening.
6. From the wire mesh and filter cloth to the concrete gutter and against the face of curb on both sides of the inlet. Place clean 2" stone over the wire mesh and filter fabric in such a manner as to prevent water from entering the inlet under or around the filter cloth.
7. This type of protection must be inspected frequently and the filter cloth and stone replaced when clogged with sediment.
8. Assume that storm flow does not bypass inlet by installing temporary earth or asphalt dikes directing flow to inlet.

INLET PROTECTION DETAIL (I.P.D.)

NO SCALE

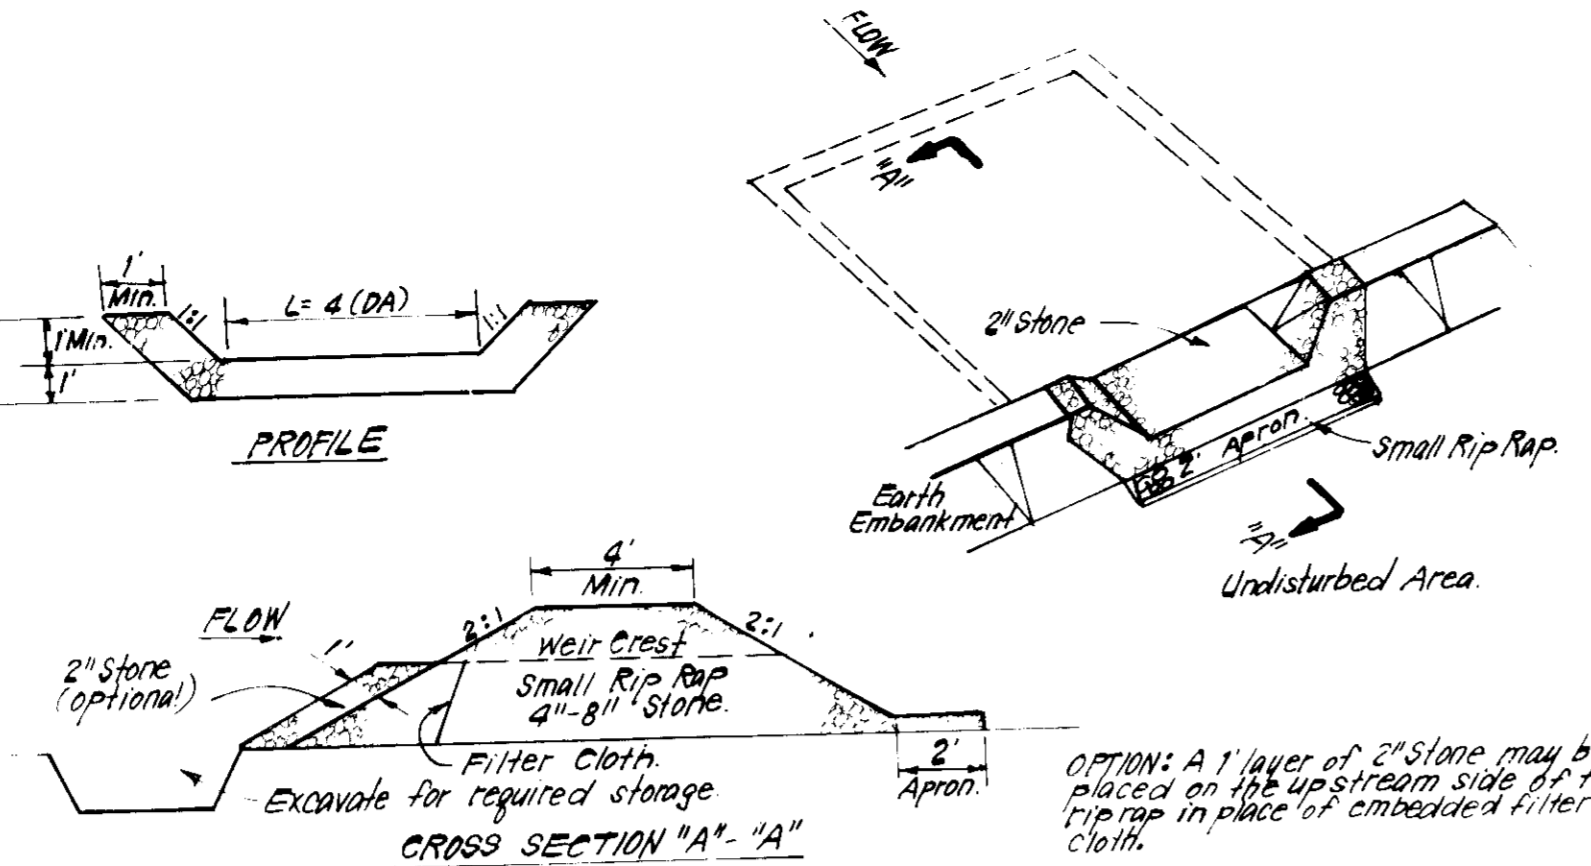


STONE OUTLET SEDIMENT TRAP (S.O.S.T.) STV

CONSTRUCTION SPECIFICATIONS:
 1. Area under embankment shall be cleared, grubbed and stripped of any vegetation and root mat. The soil area shall be cleared.
 2. The fill material for the embankment shall be free of roots and other woody vegetation as well as over-sized stones, rocks, organic material or other objectionable material. The embankment shall be compacted sized stones, rocks, organic material or other objectionable material. The embankment shall be compacted sized stones, rocks, organic material or other objectionable material. The embankment shall be compacted sized stones, rocks, organic material or other objectionable material.
 3. All cut and fill slopes shall be 2:1 or flatter.
 4. The stone used in the outlet shall be small rip rap 4"-8" along with 1" thickness of 2" aggregate placed on the up-grade side on the small rip rap or embedded filter cloth in the rip rap.
 5. Sediment shall be removed and trap restored to its original dimensions when the sediment has accumulated to 1/2 the design depth of the trap.
 6. The structure shall be inspected after each rain and repairs made as needed.
 7. Construction operations shall be carried out in such a manner that erosion and water pollution is minimized.
 8. The structure shall be removed and the area stabilized when the drainage area has been properly stabilized.

STONE OUTLET SEDIMENT TRAP (S.O.S.T.) STV

NO SCALE

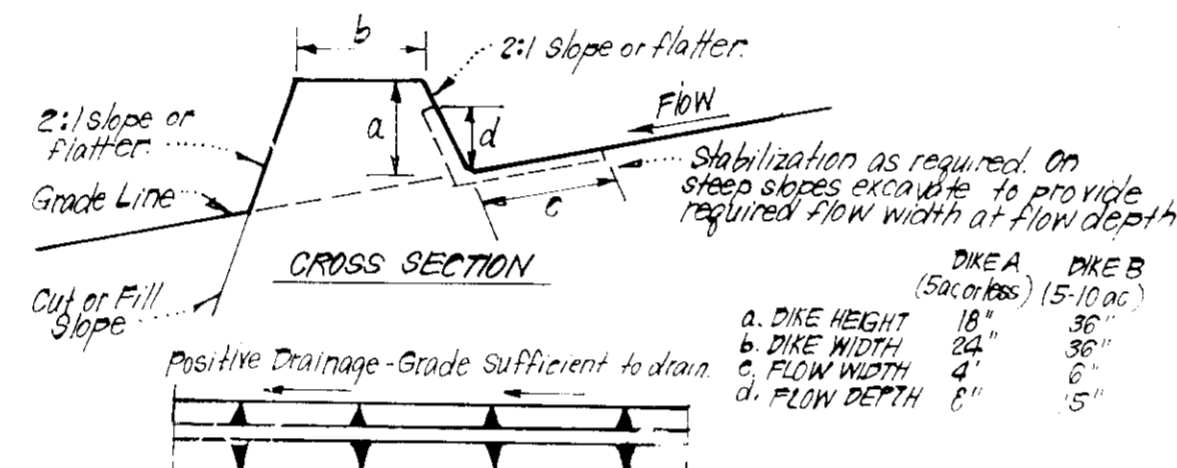

CONSTRUCTION SPECIFICATIONS:
 1. All dikes shall be compacted by earth-moving equipment.
 2. All dikes shall have positive drainage to an outlet.
 3. Top width may be wider and side slopes may be flatter if desired to facilitate crossing by construction traffic.
 4. Field location should be adjusted as needed to utilize a stabilized safe outlet.
 5. Earth dikes shall have an outlet that functions with a minimum of erosion. Runoff shall be conveyed to a sediment trapping device such as a sediment trap or sediment basin where either the dike or the drainage area above the dike are not adequately stabilized.
 6. Stabilization shall be: (A) in accordance with standard specifications for seed and straw mulch or straw mulch if not in seeding season, (B) flow channel as per chart below.

TYPE OF TREATMENT	CHANNEL GRAZE	DIKE A	DIKE B
1	0.5 - 3.0%	Seed & Straw Mulch	Seed or Straw Mulch
2	3.1 - 5.0%	Seed & Straw Mulch	Seed, Willow, or Excelsior, Sod, or Stone
3	5.1 - 8.0%	Seed, Willow or Sod, 2" Stone	Lined Rip Rap 4"-8" Stone
4	8.1 - 20.0%	Lined Rip Rap 4"-8" Stone	Engineering Design

A. Stone to be 2" stone, or recycled concrete equivalent, in a layer at least 3" thick and be pressed into soil with construction equipment.
 B. Rip Rap to be 4"-8" in a layer at least 8" thick, pressed into soil.
 C. Approved equivalents can be substituted for any of the above materials.

EARTH DIKE DETAIL (E.D.)

NO SCALE

PERMANENT SEEDING NOTES

Apply to graded or cleared areas not subject to immediate further disturbance where a permanent long-lived vegetative cover is needed.

Seedbed Preparation: Loosen upper three inches of soil by raking, disking or other acceptable means before seeding, if not previously loosened.

Soil Amendments: In lieu of soil test recommendations, use one of the following schedules:
 1) Preferred - Apply 2 tons per acre dolomitic limestone (92 lbs/1000 sq ft) and 600 lbs per acre 16-10-10 fertilizer (14 lbs/1000 sq ft) before seeding, harrow or disc into upper three inches of soil. At time of seeding, apply 4.0 lbs per acre 30-0-0 ureaform fertilizer (9 lbs/1000 sq ft).
 2) Acceptable - Apply 2 tons per acre dolomitic limestone (92 lbs/1000 sq ft) and 1000 lbs per acre 10-10-10 fertilizer (23 lbs/1000 sq ft) before seeding. Harrow or disc into upper three inches of soil.

Seeding: For the periods March 1 thru April 30, and August 1 thru October 15, seed with 60 lbs per acre (1.4 lbs/1000 sq ft) of Kentucky 31 Tall Fescue. For the period May 1 thru July 31, seed with 60 lbs Kentucky 31 Tall Fescue per acre and 2 lbs per acre (.05 lbs/1000 sq ft) of weeping lovegrass. During the period of October 16 thru February 28, protect site by: Option (1) 2 tons per acre of well anchored straw mulch and seed as soon as possible in the spring. Option (2) Use sod. Option (3) Seed with 60 lbs/acre Kentucky 31 Tall Fescue and mulch with 2 tons/acre well anchored straw.

Mulching: Apply 1 1/2 to 2 tons per acre (70 to 90 lbs/1000 sq ft) of unrotted small grain straw immediately after seeding. Anchor mulch immediately after application using mulch anchoring sod or 218 gallons per acre (5 gal/1000 sq ft) of emulsified asphalt on flat areas. On slopes 8 feet or higher, use 348 gallons per acre (8 gal/1000 sq ft) for anchoring.

Maintenance: Inspect all seeded areas and make needed repairs, replacements and reseedings.

TEMPORARY SEEDING NOTES

Apply to graded or cleared areas likely to be redisturbed where a short-term vegetative cover is needed.


Seedbed Preparation: Loosen upper three inches of soil by raking, disking or other acceptable means before seeding, if not previously loosened.

Soil Amendment: Apply 100 lbs per acre of 10-10-10 fertilizer (14 lbs/1000 sq ft)

Seeding: For periods March 1 thru April 30 and from August 15 thru November 15, seed with 25 lbs per acre of annual ryegrass (1.2 lbs/1000 sq ft). For the period May 1 thru August 14, seed with 4 lbs per acre of weeping lovegrass (.05 lbs/1000 sq ft). For the period November 16 thru February 28, protect site by applying 2 tons per acre of well anchored straw mulch and seed as soon as possible in the spring, or use sod.

Mulching: Apply 1 1/2 to 2 tons per acre (70 to 90 lbs/1000 sq ft) of unrotted small grain straw immediately after seeding. Anchor mulch immediately after application using mulch anchoring sod or 218 gal per acre (5 gal/1000 sq ft) of emulsified asphalt on flat areas. On slopes 8 ft or higher, use 348 gal per acre (8 gal/1000 sq ft) for anchoring.

Refer to the 1983 MARYLAND STANDARDS AND SPECIFICATIONS FOR SOIL EROSION AND SEDIMENT CONTROL for rates and methods not covered.

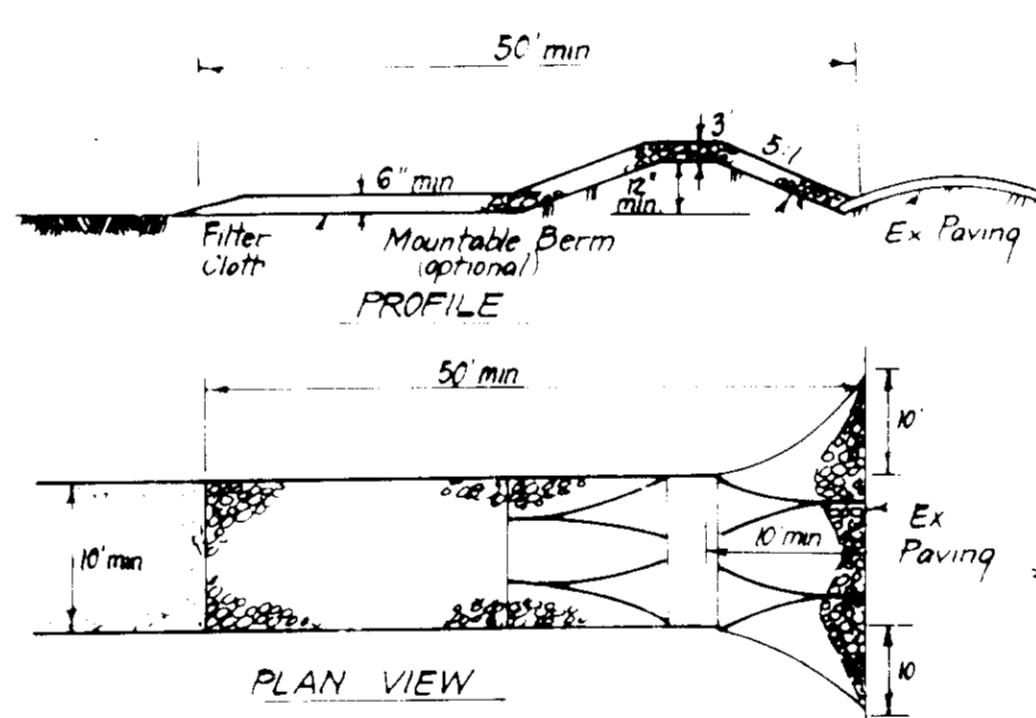

STABILIZED CONSTRUCTION ENTRANCE (SCE)

NO SCALE

CONSTRUCTION SPECIFICATIONS:
 1. Stone size - Use 2" stone or recycled concrete equivalent.
 2. Length - As required, but not less than 50 feet, except for a single residence lot where a 30 foot minimum length would apply.
 3. Thickness - Not less than six (6) inches.
 4. Width - Ten (10) foot minimum, but not less than the full width at points where ingress or egress occurs.
 5. Filter Cloth - Will be placed over the entire area prior to placement of stone. Filter will not be required on a single family residence lot.
 6. Surface Water - All surface water flowing or diverted toward construction entrances shall be piped across the entrance. If piping is impractical, a mound berm with 5:1 slopes will be permitted.
 7. Maintenance - The entrance shall be maintained in a condition which will prevent tracking or flowing of sediment onto public rights-of-way. This may require periodic top dressing with additional stone as conditions demand and repair and/or cleanout of any measures used to trap sediment. All sediment spoiled, dropped, washed or tracked onto public rights-of-way must be removed immediately.
 8. Washing - Wheels shall be cleaned to remove sediment prior to entrance onto public rights-of-way. When washing is required, it shall be done on an area stabilized with stone and which drains into an approved sediment trapping device.
 9. Periodic inspection and needed maintenance shall be provided after each rain.


DEVELOPER'S/BUILDER'S CERTIFICATE

"I/We certify that all development and construction will be done according to this plan of development and plan for erosion and sediment control and that all responsible personnel involved in the construction project will have a Certificate of Attendance at a Dept. of Natural Resources Approved Training Program for the Control of Sediment and Erosion before beginning the project. I also authorize periodic on-site inspection by the Howard Soil Conservation District or their authorized agents, as are deemed necessary."

Signature of Developer/Builder: [Signature] Date: 10-5-89

SEDIMENT CONTROL NOTES

- 1) A minimum of 24 hours notice must be given to the District Office of Inspection and Permits prior to the start of any construction. (992-2437)
- 2) All vegetative and structural practices are to be installed according to the provisions of this plan and are to be in conformance with the 1983 MARYLAND STANDARDS AND SPECIFICATIONS FOR SOIL EROSION AND SEDIMENT CONTROL.
- 3) Following initial soil disturbance or redisturbance, permanent or temporary stabilization shall be completed within: a) 7 calendar days for all perimeter sediment control structures, dikes, perimeter slopes and all slopes greater than 3:1, b) 14 days as to all other disturbed or graded areas on the project site.
- 4) All sediment traps/basins shown must be fenced and warning signs posted around their perimeter in accordance with Vol. 1, Chapter 24, of the HOWARD COUNTY DESIGN MANUAL, Storm Drainage.
- 5) All disturbed areas must be stabilized within the time period specified above in accordance with the 1983 MARYLAND STANDARDS AND SPECIFICATIONS FOR SOIL EROSION AND SEDIMENT CONTROL for permanent seedings (Sec. 51) and (Sec. 54), temporary seedings (Sec. 50) and mulching (Sec. 52). Temporary stabilization with mulch alone can only be done when recommended seeding dates do not allow for proper permission and establishment of grasses.
- 6) All sediment control structures are to remain in place and are to be maintained in operative condition until permission for their removal has been obtained from the Howard County Sediment Control Inspector.
- 7) Site Analysis:
 Total Area of Site: 2.147 Acres
 Area Disturbed: 1.92 Acres
 Area to be roofed or paved: 1.32 Acres
 Area to be vegetatively stabilized: 0.60 Acres
 Total Cut: 2977 Cu. yds
 Total Fill: 2254 Cu. yds
 Offsite waste/borrow area location: Undetermined
- 8) Any sediment control practice which is disturbed by grading activity for placement of utilities must be repaired on the same day of disturbance.
- 9) Additional sediment control must be provided, if deemed necessary by the Howard County DPW sediment control inspector.
- 10) On all sites with disturbed areas in excess of 2 acres, approval of the inspection agency shall be requested upon completion of installation of perimeter erosion and sediment controls, but before proceeding with any other earth disturbance or grading. Other building or grading inspection approvals may not be authorized until this initial approval by the inspection agency is made.
- 11) If houses are to be constructed on an "As-Built" basis, at random, Single Lot Sediment Control as shown below shall be implemented. N/A
- 12) All pipes to be blocked at the end of each day (see detail below). N/A
- 13) The total amount of straw bale dikes/silt fence equals 635 L.F.

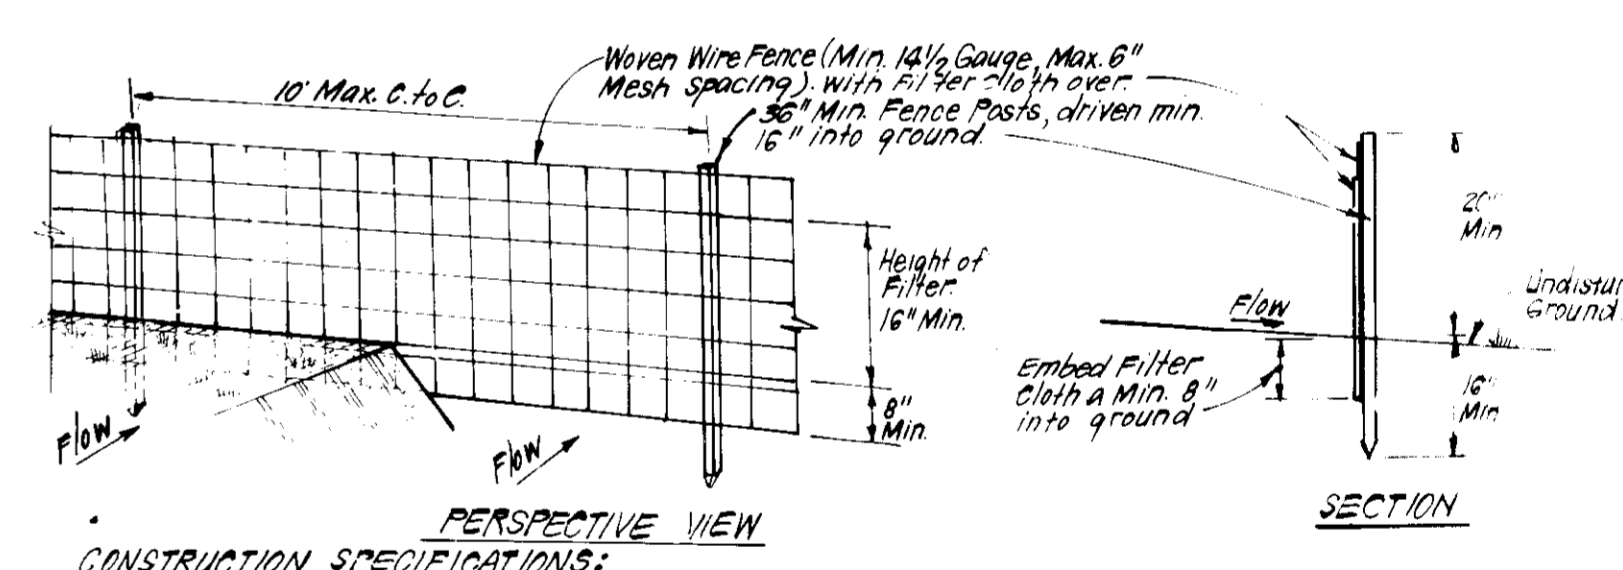

SILT FENCE DETAIL (S)

NO SCALE

CONSTRUCTION SPECIFICATIONS:
 1. Woven wire fence to be fastened securely to fence posts with wire ties or staples.
 2. Filter cloth to be fastened securely to woven wire fence with ties spaced every 24" at top and mid section.
 3. When 2 sections of filter cloth adjoin each other they shall be overlapped 48" on folds.
 4. Maintenance shall be performed as needed and material removed when bulges develop in silt fence.

DEVELOPER'S/BUILDER'S CERTIFICATE

"I/We certify that all development and construction will be done according to this plan of development and plan for erosion and sediment control and that all responsible personnel involved in the construction project will have a Certificate of Attendance at a Dept. of Natural Resources Approved Training Program for the Control of Sediment and Erosion before beginning the project. I also authorize periodic on-site inspection by the Howard Soil Conservation District or their authorized agents, as are deemed necessary."

Signature of Developer/Builder: [Signature] Date: 10-5-89

APPROVED: FOR PUBLIC WATER AND PUBLIC SEWERAGE SYSTEMS, HOWARD COUNTY HEALTH DEPARTMENT
 County Health Officer: [Signature] DATE: 2-6-90
 APPROVED: HOWARD COUNTY DEPT. OF PLANNING & ZONING
 Director: [Signature] DATE: 2-5-90
 APPROVED: FOR PUBLIC WATER AND PUBLIC SEWERAGE, STORM DRAINAGE SYSTEMS AND PUBLIC ROADS, HOWARD COUNTY DEPARTMENT OF PUBLIC WORKS
 Director: [Signature] DATE: 2-1-90

Reviewed for: [Signature] S.C.D. Name: [Signature]
 and meet Technical Requirements: [Signature] DATE: 12/19/89
 U.S. Soil Conservation Service
 THIS DEVELOPMENT PLAN IS APPROVED FOR SOIL EROSION AND SEDIMENT CONTROL BY THE HOWARD SOIL CONSERVATION DISTRICT.
 Approved: [Signature] DATE: 12/19/89

APPROVED: FOR PUBLIC WATER AND PUBLIC SEWERAGE SYSTEMS AND PUBLIC ROADS, HOWARD COUNTY DEPARTMENT OF PUBLIC WORKS
 Director: [Signature] DATE: 2-1-90

APPROVED: FOR PUBLIC WATER AND PUBLIC SEWERAGE SYSTEMS AND PUBLIC ROADS, HOWARD COUNTY DEPARTMENT OF PUBLIC WORKS
 Director: [Signature] DATE: 2-1-90

OWNER: CONSOLIDATED CASUALTY JOINT VENTURE
 6625 Belnick Drive
 Baltimore, Md. 21227

DESIGNED: [Signature]
 DRAWN: [Signature]
 CHECKED: [Signature]
 DATE: 10-5-89



DEVELOPER: CONSOLIDATED HOME BUILDERS, INC.
 6625 Belnick Drive
 Baltimore, Md. 21227

LEGEND:


Contour Interval	2 FT
Existing Contour	--- 330 ---
Proposed Contour	--- 330 ---
Spot Elevation	+30.5
Direction of Drainage	→
Existing Storm Drain	--- EX 18" CMP ---
Proposed Storm Drain	--- 18" CMP ---
Existing Sewer	--- 8" S ---
Existing Water	--- 12" W ---
Grading By Others	--- 338 ---

DORSEY HALL
SECTION 2 AREA 5
PLAN 7855
OPEN SPACE LOT 4
ZONED P.C.R.

Ex 100 YR Flood Plain, Drainage, Sewer
and Utility Easmt. Pat 7855

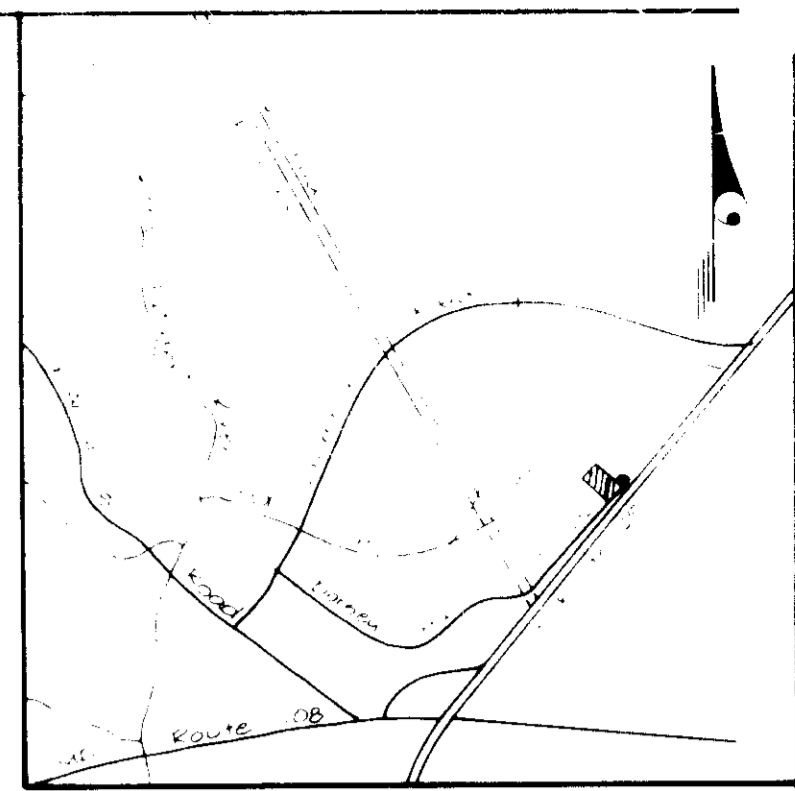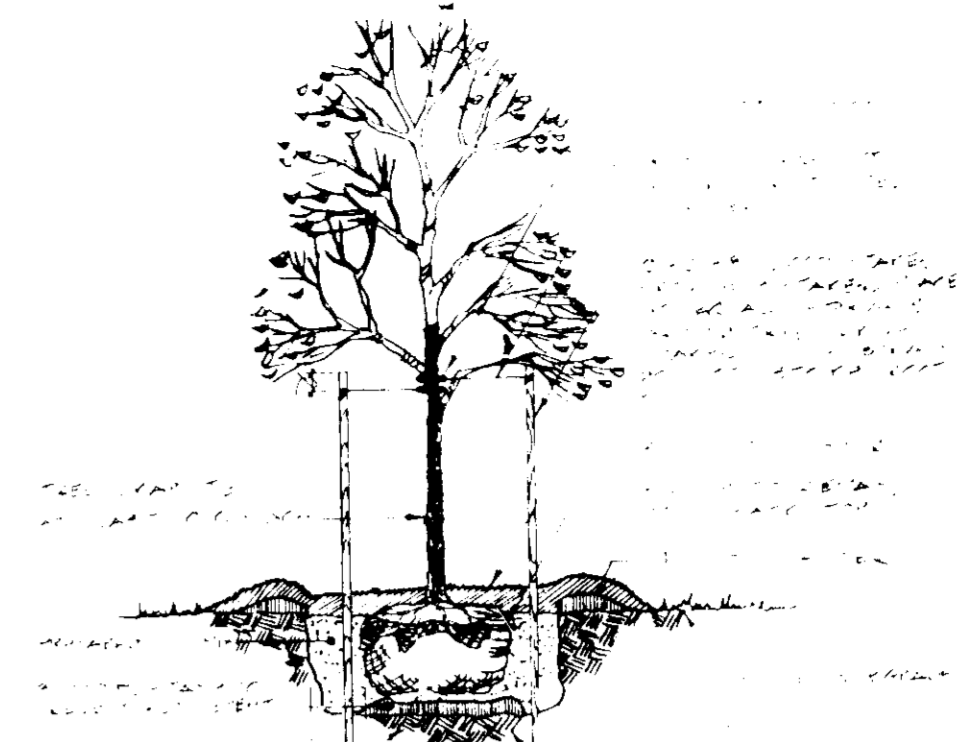

VICINITY MAP
Scale 1" = 5000'

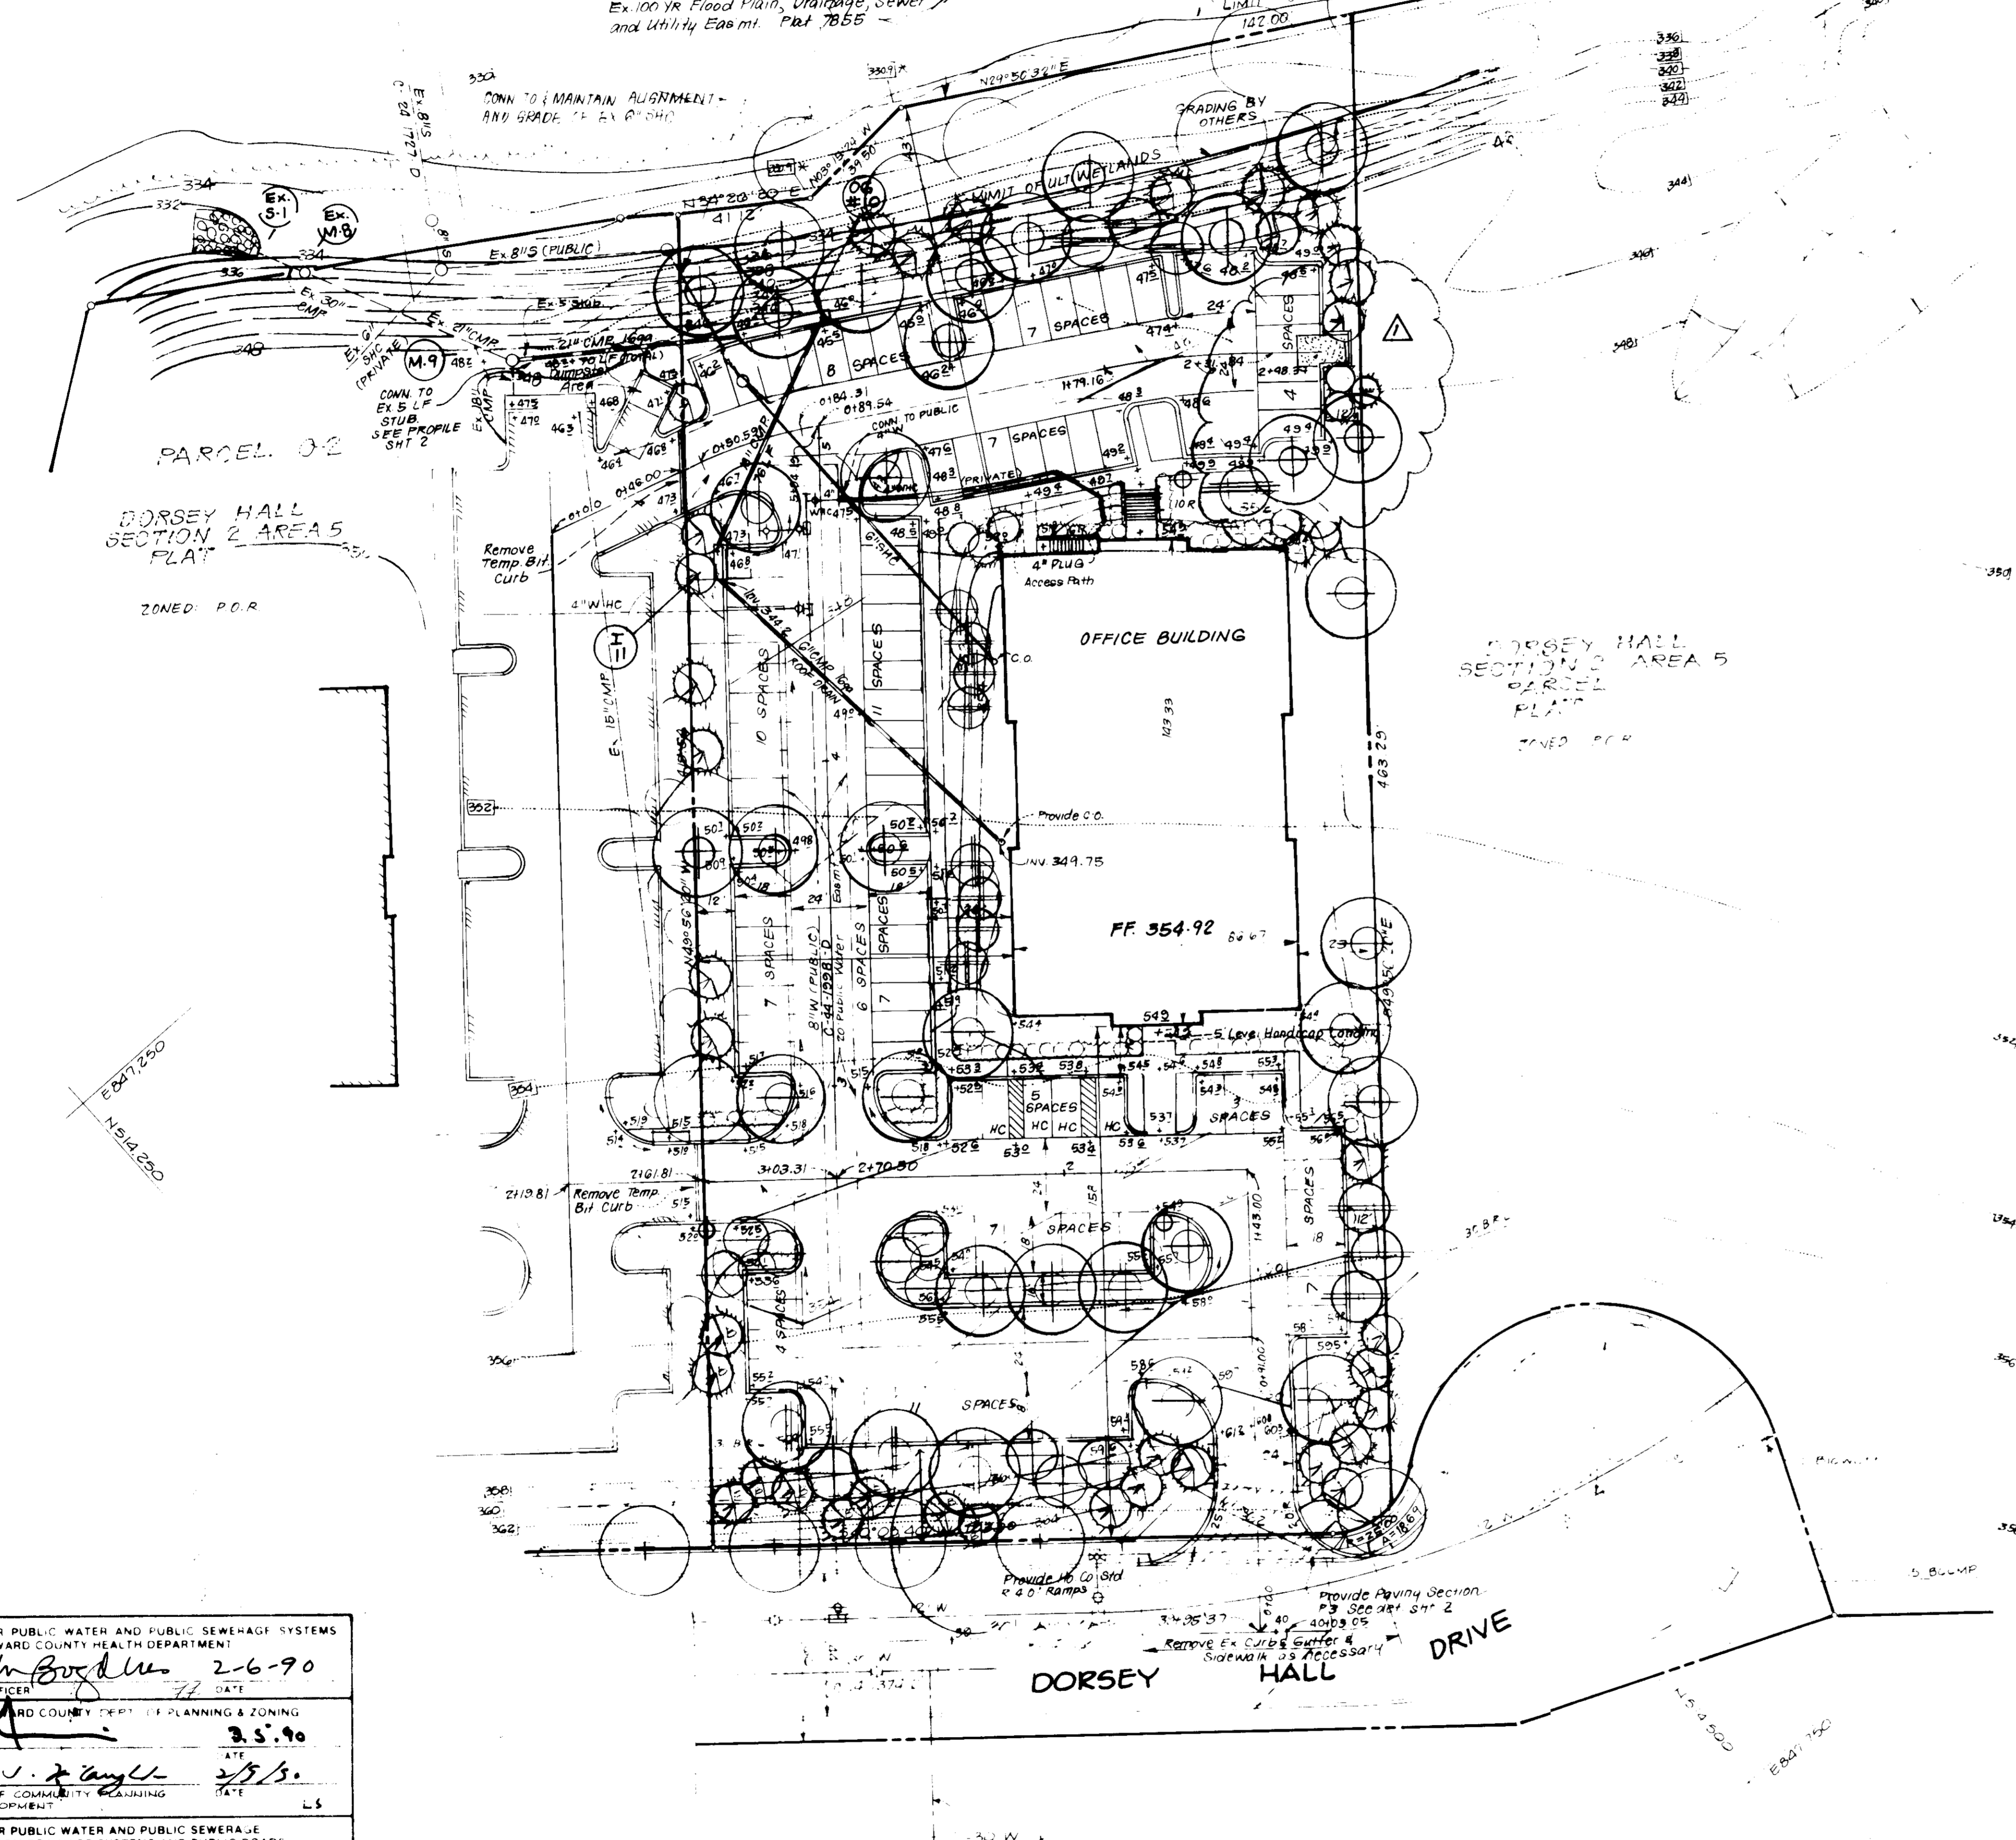

PLANT SCHEDULE

SYM	PLANT NAME	QTY	SIZE	REMARKS
MAJOR TREE				
⊕	ACER - RED LEAF	2	24"	FRONT YARD
⊕	FRAXINUS - WHITE BARK	1	24"	FRONT YARD
⊕	QUERCUS - WHITE	3	24"	FRONT YARD
⊕	ZELENYA - COMMON	1	24"	FRONT YARD
EVERGREEN				
⊕	PRUNUS - SPREADER	7	24"	FRONT YARD
⊕	YUCCA - SPREADER	28	24"	FRONT YARD
SMALL TREE				
⊕	QUERCUS - WHITE	2	18"	FRONT YARD
⊕	QUERCUS - WHITE	2	18"	FRONT YARD
⊕	QUERCUS - WHITE	2	18"	FRONT YARD
⊕	QUERCUS - WHITE	2	18"	FRONT YARD
SMALLER PLANTS				
⊕	SPERGANDIA - COMMON	7	12"	FRONT YARD
⊕	SPERGANDIA - COMMON	28	12"	FRONT YARD

APPROVED FOR PUBLIC WATER AND PUBLIC SEWERAGE SYSTEMS
HOWARD COUNTY HEALTH DEPARTMENT
[Signature] 2-6-90
COUNTY HEALTH OFFICER DATE

APPROVED HOWARD COUNTY DEPT. OF PLANNING & ZONING
[Signature] 3-5-90
DIRECTOR DATE

APPROVED FOR PUBLIC WATER AND PUBLIC SEWERAGE
STORM DRAINAGE SYSTEMS AND PUBLIC ROADS
HOWARD COUNTY DEPARTMENT OF PUBLIC WORKS
[Signature] 2-12-90
DIRECTOR DATE

[Signature] 2-1-90
CHIEF BUREAU OF ENGINEERING DATE

12-6-89
AKS

No	REVISIONS	Date
1	Added Dumpster Pad, Revised Landscaping	9-9-91

OWNER:
CONSOLIDATED CASUALTY MUTUAL VENTURE
6625 Selma Drive
Baltimore, MD 21227

CLARK • FINEFROCK & SACKETT, INC.
ENGINEERS • PLANNERS • SURVEYORS

DESIGNED BY: *[Signature]*
DRAWN BY: *[Signature]*
CHECKED BY: *[Signature]*
DATE: 1-1-89

FOR: CONSOLIDATED HOME BUILDERS INC
2625 Selma Drive
Baltimore, MD 21227

SCALE: 1" = 30'
DRAWING: F6
JOB NO: 88-146
FILE NO: 88-146

SDP- 90-80

