

NO	REVISIONS	Date
1	Rev. house and grade lot 3	11.13.91
2	Rev. house and grade lot 11	2.14.92
3	Rev. hse. & grad. Lot 12, Add hse. typical	6.8.92
4	Rev. hse. & grad. Lots 4 & 5 Add hse. typical	6.18.92
5	Rev. hse. & grad. lot 7 Add hse. typical	5.26.93



GENERAL NOTES

- Subject property zoned R20 as per B 2 85 Comprehensive Zoning Plan.
- The coordinates shown hereon are based on the Maryland State Grid System and derived from the following Howard County Control Stations 23443003 and 23243002.
- All roadways are public and existing.
- Total area included in this submission 254,267 sq ft or 5.8371 Ac.
- Total number of lots 13.
- Any damage to county owned right-of-ways shall be corrected at the Developer's expense.
- Maximum lot coverage is 30%.
- Reference plans S-89-36, P-90-05 and F-90-109.
- The Contractor or Developer shall contact the Construction Inspection Division, 24 hours in advance of commencement of work at 702-2630.
- The existing topography shown was field run by CLARK-FINEPROCK & SACKETT, INC on 9/29/88.
- The Stormwater Management pond will be constructed under F90-109.
- For driveway entrance details refer to Howard Co. Design Manual Volume II Ord. Details R-6.05 & R-6.03.
- The purpose of the reviewed SDP is to revise the house types on Lots 6-10/13 60' from the Rockland Ltd. Finish to 60' from the Final 30' type units.



VICINITY MAP
Scale: 1" = 2000'

LEGEND

- Contour Interval: 2 Ft
- Existing Contour: 410
- Proposed Contour: 415
- Direction of Drainage: 10 S
- Walk-out Basement: 10 S
- Trees to be saved: 10 S

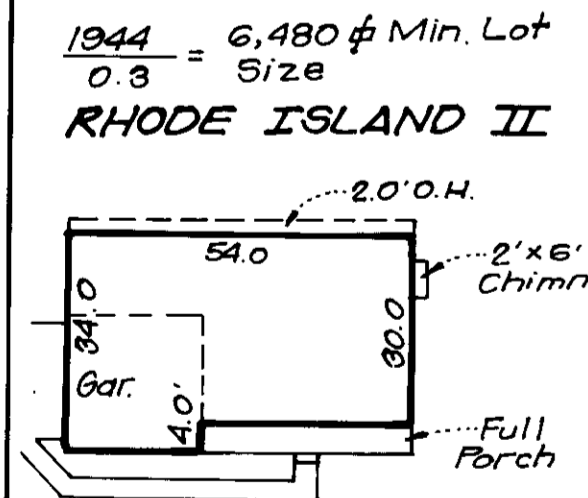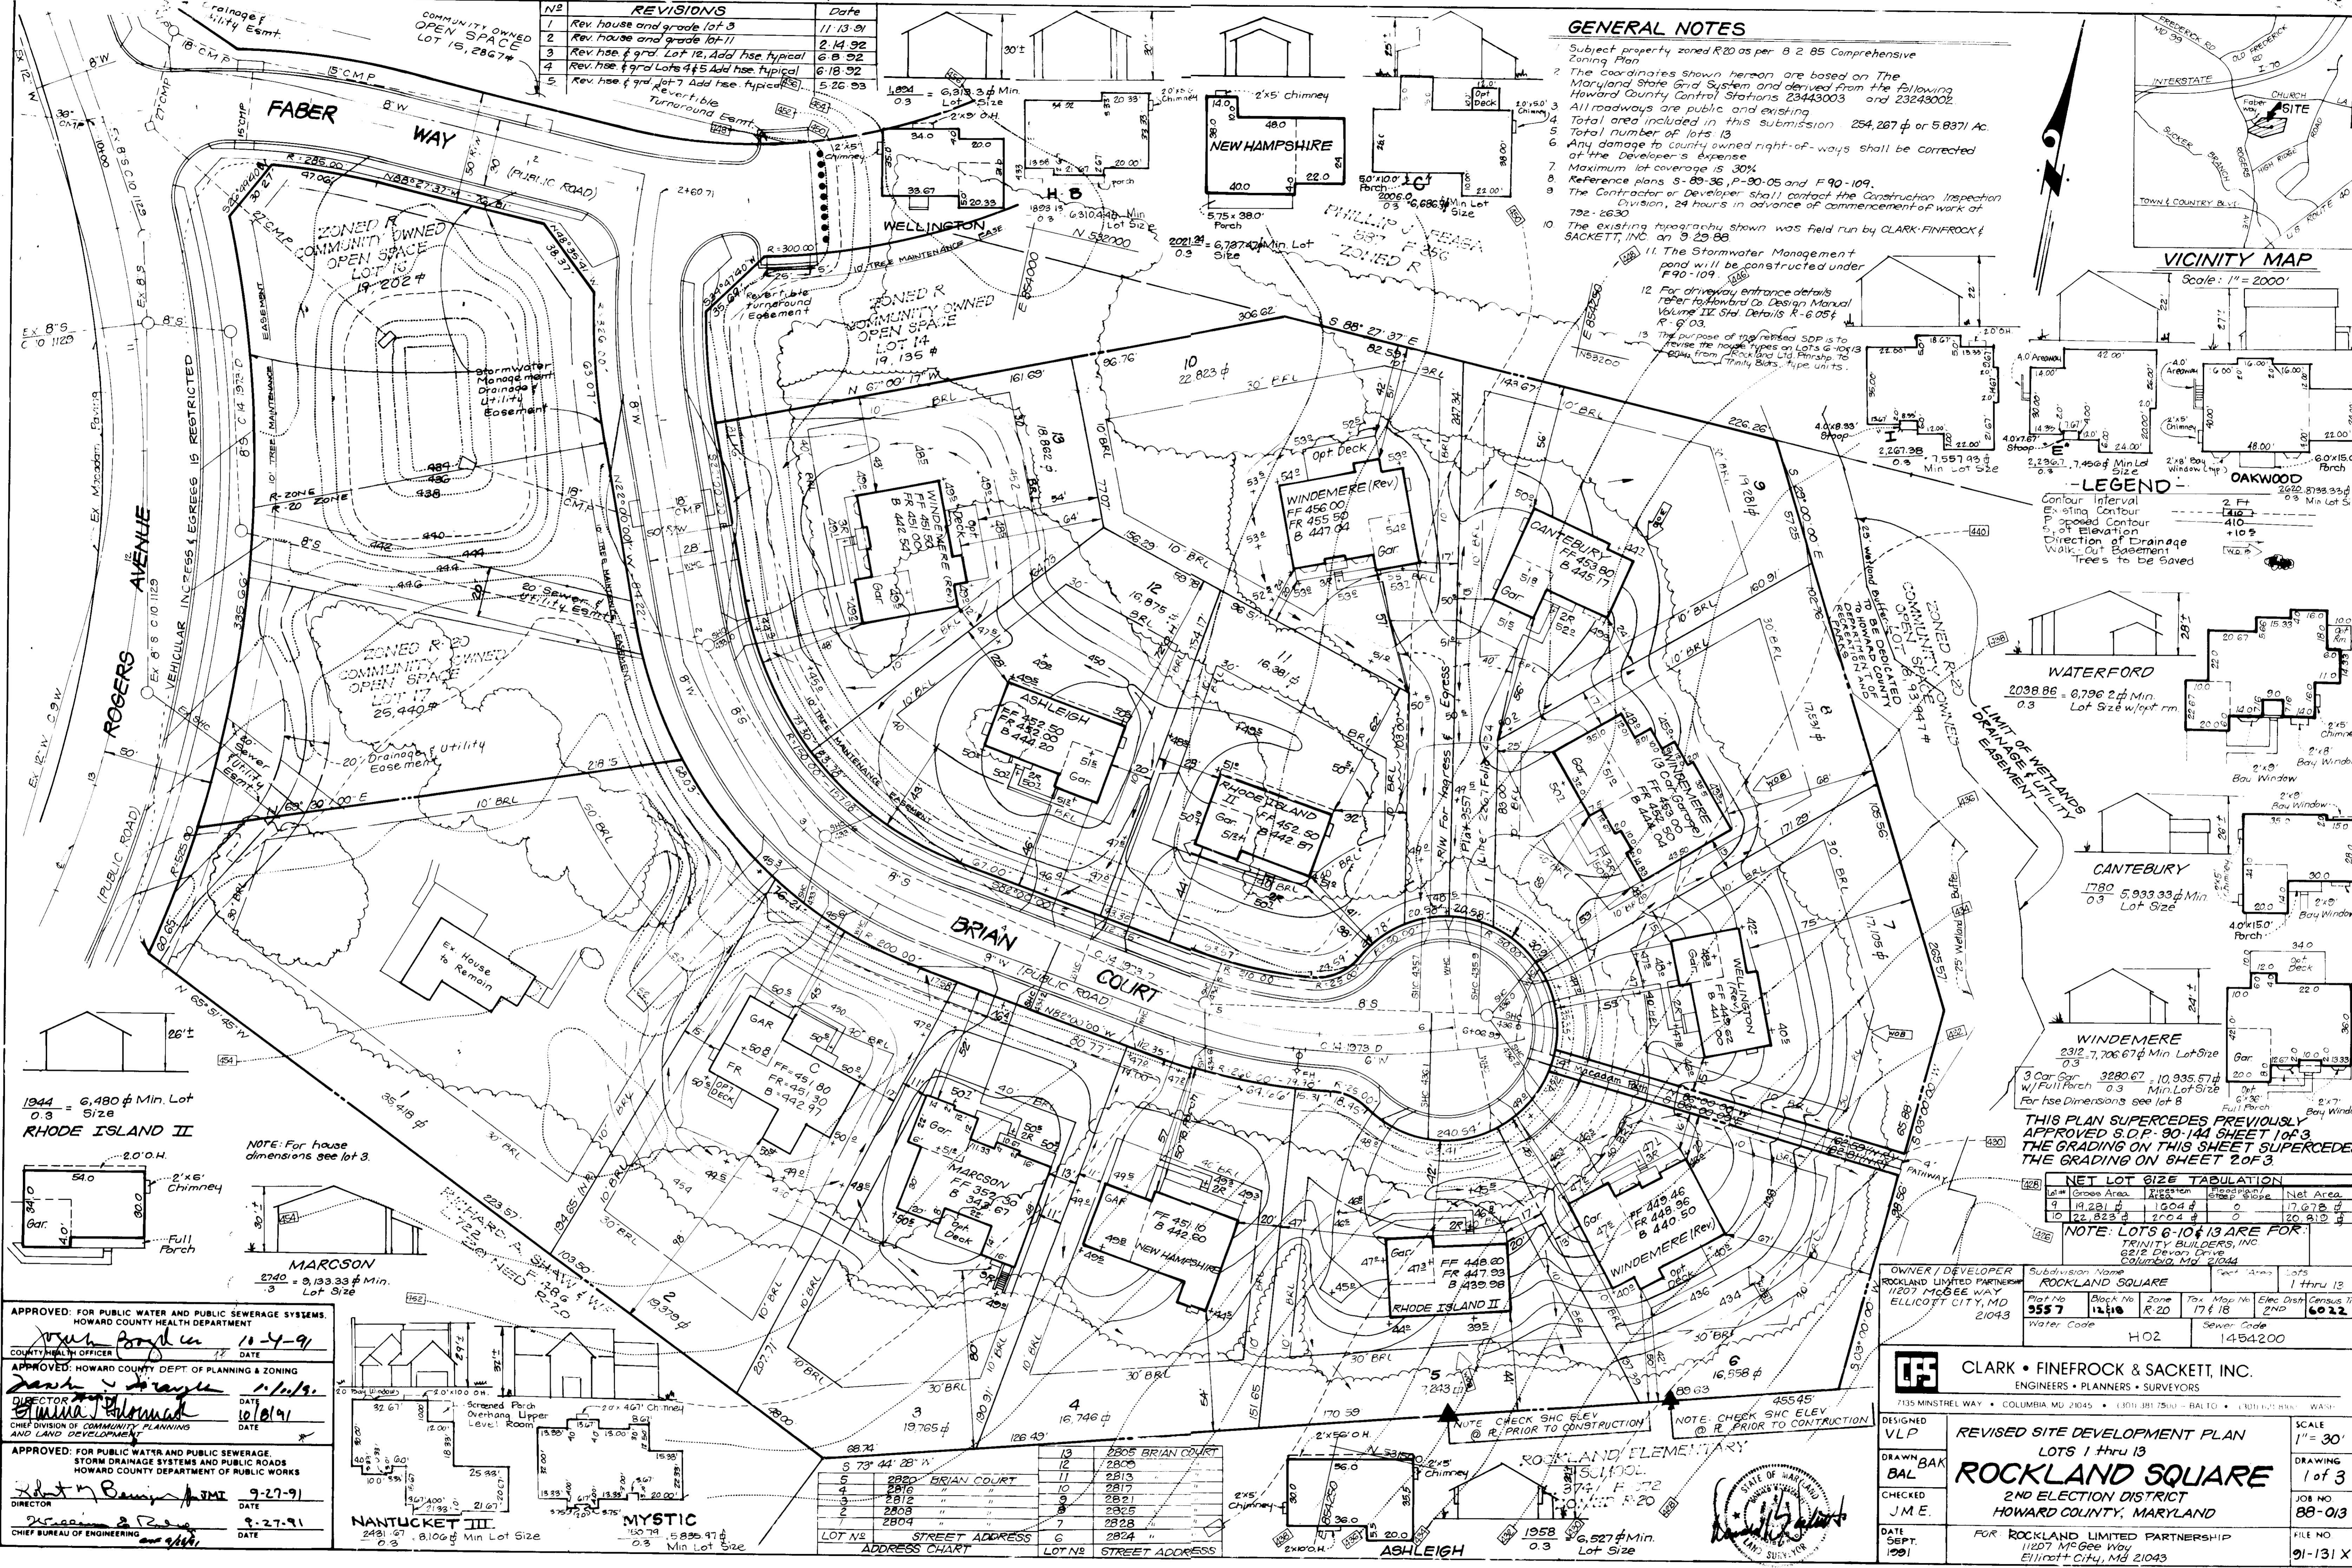

APPROVED: FOR PUBLIC WATER AND PUBLIC SEWERAGE SYSTEMS, HOWARD COUNTY HEALTH DEPARTMENT
 COUNTY HEALTH OFFICER: [Signature] 11-4-91
 APPROVED: HOWARD COUNTY DEPT OF PLANNING & ZONING
 DIRECTOR: [Signature] 11/1/91
 APPROVED: FOR PUBLIC WATER AND PUBLIC SEWERAGE, STORM DRAINAGE SYSTEMS AND PUBLIC ROADS, HOWARD COUNTY DEPARTMENT OF PUBLIC WORKS
 DIRECTOR: [Signature] 9-27-91
 CHIEF BUREAU OF ENGINEERING: [Signature] 9-27-91

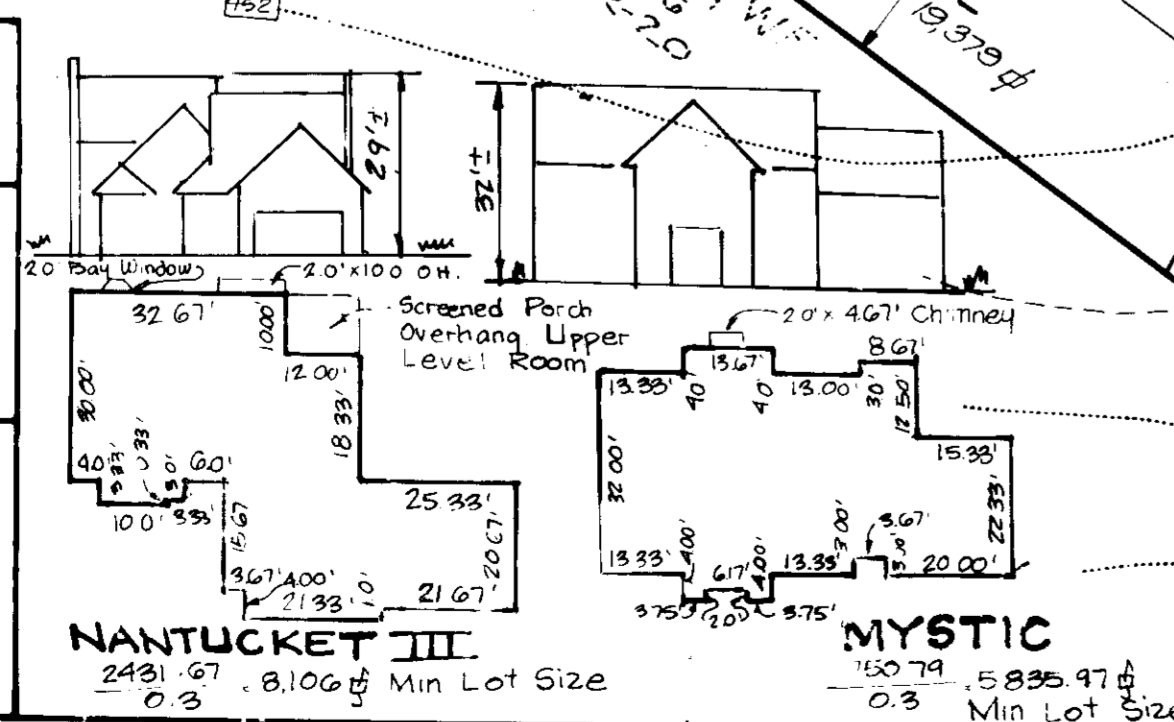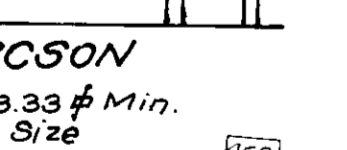

LOT NO	STREET ADDRESS	LOT NO	STREET ADDRESS
1	2805 BRIAN COURT	12	2805 BRIAN COURT
2	2806 "	11	2813 "
3	2816 "	10	2817 "
4	2812 "	9	2821 "
5	2808 "	8	2825 "
6	2804 "	7	2828 "

LOT #	GROSS AREA	MINIMUM LOT SIZE	NET AREA
9	19,281 sq ft	150'4"	17,678 sq ft
10	22,823 sq ft	210'4"	20,912 sq ft

NOTE: LOTS 6-10 & 13 ARE FOR TRINITY BUILDERS, INC 6212 Devora Drive Columbia, Md 21044

Subdivision Name	Parcel No.	Zone	Map No.	Elec Dist.	Census ID
ROCKLAND SQUARE	557	R-20	17 & 18	2ND	6022

CLARK • FINEPROCK & SACKETT, INC.
 ENGINEERS • PLANNERS • SURVEYORS
 7135 MINISTREL WAY • COLUMBIA, MD 21045 • (301) 381-7500 • BALTO • (410) 637-9900 • WASH.

DESIGNED: VLP
 DRAWN: BAK, BAL
 CHECKED: J.M.E.
 DATE: SEPT. 1991

REVISED SITE DEVELOPMENT PLAN
 LOTS 1 thru 13
ROCKLAND SQUARE
 2ND ELECTION DISTRICT
 HOWARD COUNTY, MARYLAND
 FOR ROCKLAND LIMITED PARTNERSHIP
 11207 McGeer Way
 Ellwood City, Md 21043

SCALE: 1" = 30'
 DRAWING: 1 of 3
 JOB NO: 88-013
 FILE NO: 91-131 X

SDP-90-144

DEVELOPER'S/BUILDER'S CERTIFICATE
 "I/We certify that all development and construction will be done according to this plan of development and plan for erosion and sediment control and that all responsible personnel involved in the construction project will have a Certificate of Attendance at a Dept. of Natural Resources Approved Training Program for the Control of Sediment and Erosion before beginning the project. I also authorize periodic on-site inspection by the Howard Soil Conservation District or their authorized agents as are deemed necessary."
Richard J.H. Stepp 2/6/90
 Signature of Developer/Builder

VICINITY MAP
 Scale: 1" = 2000'


LEGEND

- Contour Interval 2 FT
- Existing Contour (---)
- Proposed Contour (---)
- Spot Elevation (+10)
- Direction of Drainage (---)
- Walk out Basement (---)
- Ex Trees to be saved (---)
- Silt Fence (---)
- Earth Dike (---)
- Stabilized Construction Entrance (---)
- PROPOSED DRAINAGE DIVIDE TO TRAP (---)
- EXISTING DRAINAGE DIVIDE TO TRAP (---)

Reviewed for HOWARD S.C.D.
 Name: *James H. Stepp* 8/27/90
 Signature: *James H. Stepp*
 Date: 8/27/90
 U.S. Soil Conservation Service

THIS DEVELOPMENT PLAN IS APPROVED FOR SOIL EROSION AND SEDIMENT CONTROL BY THE HOWARD SOIL CONSERVATION DISTRICT.
James H. Stepp 8/27/90
 Approved Date

TRAP # 1 SOST (ST-V)
 D.A. = 2.90 AC. (EX.) 1.5 AC. (PROP.)
 Storage Required = 29(1800) = 5220 CF
 Storage Provided = 5440 CF
 Depth = 4'
 Top of Stone Crest = 428.5
 Bottom of elev = 423.5
 Clean out elev = 425.5
 Bottom Dimensions = 76' x 13'
 1:1 Side Slope in cut
 L = 12'

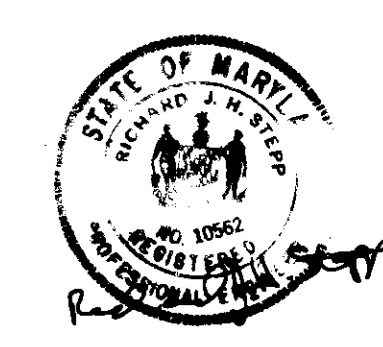

I hereby certify that this plan for Erosion and Sediment Control represents a practical and workable plan based on my personal knowledge of the site conditions and that it was prepared in accordance with the requirements of the Howard Soil Conservation District.

Owner / Developer: ROCKLAND LIMITED PARTNERSHIP
 11207 McGee Way, Ellicott City, MD 21043
 Date: 2/6/90


CLARK • FINEFROCK & SACKETT, INC.
 ENGINEERS • PLANNERS • SURVEYORS
 7135 MINSTREL WAY • COLUMBIA, MD 21045 • (301) 381-7500 • BALTO. • (301) 621-8100 • WASH.

DESIGNED: KIWM
 DRAWN: BAK
 CHECKED: KIWM
 DATE: JAN. 1990

SEDIMENT AND EROSION CONTROL PLAN
 SCALE: 1" = 30'
 DRAWING: 2 of 3
 JOB NO: 88-013
 FILE NO: 88-0139E

LOTS 1 thru 13
ROCKLAND SQUARE
 2ND ELECTION DISTRICT
 HOWARD COUNTY, MARYLAND

FOR: ROCKLAND LIMITED PARTNERSHIP
 11207 McGee Way, Ellicott City, MD 21043

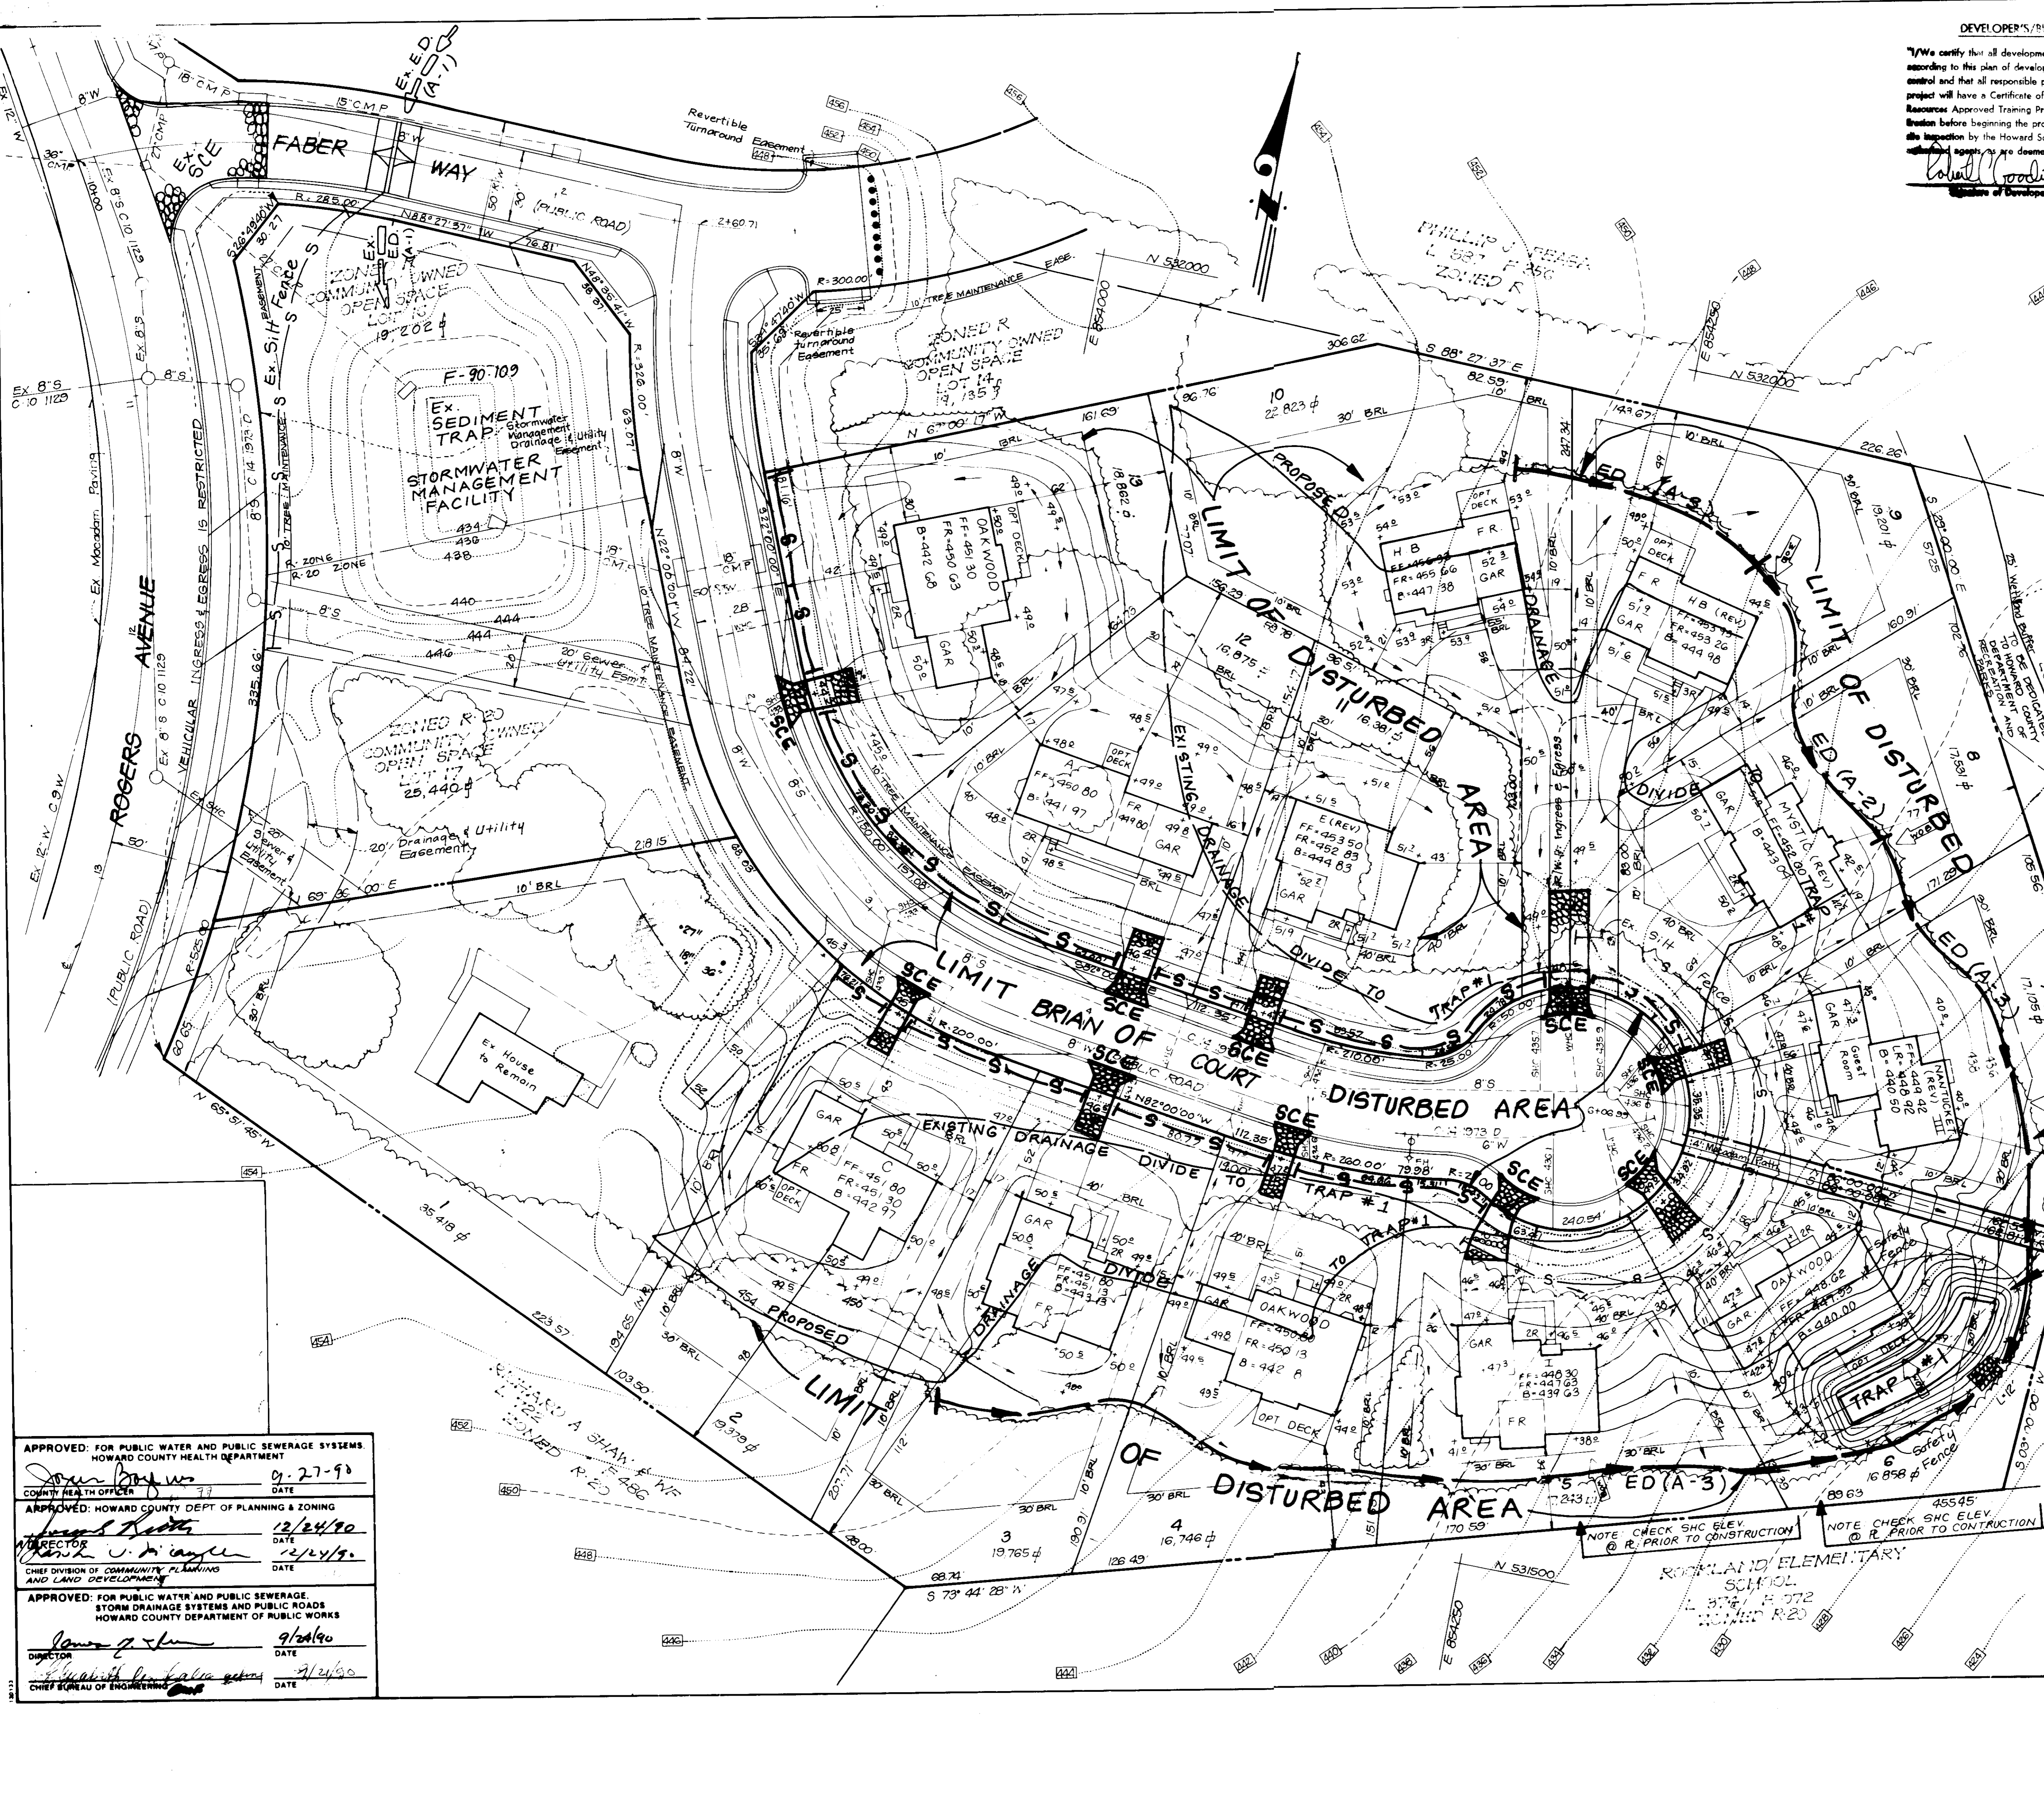

APPROVED: FOR PUBLIC WATER AND PUBLIC SEWERAGE SYSTEMS
 HOWARD COUNTY HEALTH DEPARTMENT
James H. Stepp 9/27/90
 COUNTY HEALTH OFFICER DATE

APPROVED: HOWARD COUNTY DEPT OF PLANNING & ZONING
James H. Stepp 12/24/90
 DIRECTOR DATE

APPROVED: FOR PUBLIC WATER AND PUBLIC SEWERAGE
 STORM DRAINAGE SYSTEMS AND PUBLIC ROADS
 HOWARD COUNTY DEPARTMENT OF PUBLIC WORKS
James H. Stepp 9/24/90
 DIRECTOR DATE

APPROVED: FOR PUBLIC WATER AND PUBLIC SEWERAGE
 STORM DRAINAGE SYSTEMS AND PUBLIC ROADS
 HOWARD COUNTY DEPARTMENT OF PUBLIC WORKS
James H. Stepp 9/24/90
 CHIEF OF BUREAU OF ENGINEERING DATE

SDP90-144

PERMANENT SEEDING NOTES

Apply to graded or cleared areas not subject to immediate further disturbance where a permanent long-lived vegetative cover is needed.

Seedbed Preparation: Loosen upper three inches of soil by raking, disking or other acceptable means before seeding, if not previously loosened.

Soil Amendments: In lieu of soil test recommendations, use one of the following schedules:

- 1) Preferred - Apply 2 tons per acre dolomitic limestone (92 lbs/1000 square ft) and 600 lbs per acre 10-10-10 fertilizer (14 lbs/1000 sq ft) before seeding. Harrow or disc into upper three inches of soil. At time of seeding, apply 400 lbs per acre 30-0-0 ureaform fertilizer (9 lbs/1000 sq ft).
- 2) Acceptable - Apply 2 tons per acre dolomitic limestone (92 lbs/1000 sq ft) and 1000 lbs per acre 10-10-10 fertilizer (23 lbs/1000 sq ft) before seeding. Harrow or disc into upper three inches of soil.

Seeding: For the periods March 1 thru April 30, and August 1 thru October 15, seed with 60 lbs per acre (1.4 lbs/1000 sq ft) of Kentucky 31 Tall Fescue. For the period May 1 thru July 31, seed with 60 lbs Kentucky 31 Tall Fescue per acre and 2 lbs per acre (.05 lbs/1000 sq ft) of weeping lovegrass. During the period of October 16 thru February 28, protect site by: Option (1) 2 tons per acre of well anchored straw mulch and seed as soon as possible in the spring. Option (2) Use sod. Option (3) Seed with 60 lbs/acre Kentucky 31 Tall Fescue and mulch with 2 tons/acre well anchored straw.

Mulching: Apply 1 1/2 to 2 tons per acre (70 to 90 lbs/1000 sq ft) of unrotted small grain straw immediately after seeding. Anchor mulch immediately after application using mulch anchoring tool or 2 1/8 gallon per acre (5 gal/1000 sq ft) of emulsified asphalt on flat areas. On slopes 8 feet or higher, use 348 gallon per acre (8 gal/1000 sq ft) for anchoring.

Maintenance: Inspect all seeded areas and make needed repairs, replacements and reseedings.

TEMPORARY SEEDING NOTES

Apply to graded or cleared areas likely to be redistributed where a short-term vegetative cover is needed.


Seedbed Preparation: Loosen upper three inches of soil by raking, disking or other acceptable means before seeding, if not previously loosened.

Soil Amendments: Apply 600 lbs per acre 10-10-10 fertilizer (14 lbs/1000 sq ft)

Seeding: For periods March 1 thru April 30 and from August 15 thru November 15, seed with 24 bushel per acre of annual ryegrass (3.2 lbs/1000 sq ft). For the period May 1 thru August 15, seed with 3 lbs per acre of weeping lovegrass (.07 lbs/1000 sq ft). For the period November 16 thru February 28, protect site by applying 2 tons per acre of well anchored straw mulch and seed as soon as possible in the spring, or use sod.

Mulching: Apply 1 1/2 to 2 tons per acre (70 to 90 lbs/1000 sq ft) of unrotted small grain straw immediately after seeding. Anchor mulch immediately after application using mulch anchoring tool or 2 1/8 gal per acre (5 gal/1000 sq ft) of emulsified asphalt on flat areas. On slopes, 8 ft or higher, use 348 gal per acre (8 gal/1000 sq ft) for anchoring.

Refer to the 1983 MARYLAND STANDARDS AND SPECIFICATIONS FOR SOIL EROSION AND SEDIMENT CONTROL for rate and methods not covered.

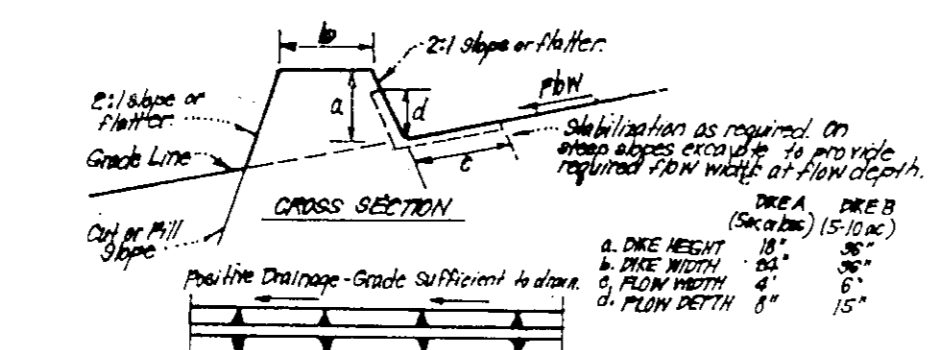

CONSTRUCTION SPECIFICATIONS:

1. All dikes shall be constructed by earth-moving equipment.
2. All dikes shall have a minimum top width of 12 inches.
3. Top width may be wider and side slopes may be flatter if desired, to facilitate crossing by construction equipment.
4. Final location should be adjusted as needed to utilize a stabilized site without disturbing the construction site.
5. Earth dikes shall have an outlet that functions with a minimum of erosion. Runoff shall be directed to a sediment trapping device such as a sediment trap or sediment basin where either the dike channel or the drainage area above the dike are not automatically stabilized.
6. Stabilization shall be: (A) in accordance with standard specifications for seed and straw mulch or straw mulch is not in seeding season, (B) flow channel as per chart below.

TYPE OF TREATMENT	CHANNEL	DIKE A	DIKE B
1	1.5 - 3.0%	Seed or Straw Mulch	Seed or Straw Mulch
2	3.1 - 5.0%	Seed or Straw Mulch	Seed or Straw Mulch
3	5.1 - 8.0%	Seed or Straw Mulch	Seed or Straw Mulch
4	8.1 - 10.0%	Seed or Straw Mulch	Seed or Straw Mulch


EARTH DIKE DETAIL (E.D.)
SCALE

SEDIMENT CONTROL NOTES


1. A minimum of 24 hours notice must be given to the Howard County Office of Inspection and Permitting at the start of any construction. (992-2433)
2. All construction and structural operations are to be installed in accordance with the provisions of this plan and are to be in conformance with the 1983 MARYLAND STANDARDS AND SPECIFICATIONS FOR SOIL EROSION AND SEDIMENT CONTROL.
3. Following initial soil disturbance or redistribution, permanent or temporary stabilization shall be completed within 30 calendar days for all perimeter sediment control structures, dikes, perimeter slopes and all slopes greater than 3:1, 14 days as to all other disturbed or graded areas on the project site.
4. All sediment traps/basins shown must be fenced and warning signs posted around their perimeter in accordance with Vol. 1, Chapter 11, of the HOWARD COUNTY DESIGN MANUAL, Storm Drainage.
5. All disturbed areas must be stabilized within the time period specified above in accordance with the 1983 MARYLAND STANDARDS AND SPECIFICATIONS FOR SOIL EROSION AND SEDIMENT CONTROL for permanent seedings and mulching (Sec. 22.1). Temporary stabilization with dates do not allow for proper germination and establishment of grasses.
6. All sediment control structures are to remain in place and are to be maintained in operative condition until permission for their removal has been obtained from the Howard County Sediment Control Inspector.
7. Site Analysis:
Total Area of Site: 6.87 Acres
Area Disturbed: 3.67 Acres
Area to be roofed or paved: 0.95 Acres
Area to be vegetatively stabilized: 2.74 Acres
Total Dirt: 18,170 Cu. Yds
Total Fill: 10,172 Cu. Yds
Offsite waste/harrow area location

8. Any sediment control practice which is disturbed by grading activity for placement of utilities must be repaired on the same day of disturbance.
9. Additional sediment control must be provided, if deemed necessary by the Howard County PWS sediment control inspector.
10. On all sites with disturbed areas in excess of 2 acres, approval of the inspection agency shall be requested upon completion of installation of perimeter erosion and sediment control, but before proceeding with any other earth disturbance or grading. Other building or grading inspection approvals may not be authorized until this initial approval by the inspection agency is made.
11. If houses are to be constructed on a "As-Built" basis, or random, Single lot Sediment Control as shown below shall be implemented.
12. All pipes to be installed in the wall of each trap (see detail below). N/A
13. The total amount of stone to be used is 720 L.F.

- CONSTRUCTION SEQUENCE:**
- A. Obtain Grading Permit and Install Sediment and Erosion Control Devices and Stabilize.
 - B. Excavate for Foundations and Rough Grade & Temporarily Stabilize.
 - C. Construct Structures, Sidewalks and Driveways.
 - D. Final Grade and Stabilize in accordance with Stds. & Specs. Upon approval of the sediment control inspector.
 - E. Remove sediment and erosion controls and stabilize.
- * Delay construction of house on lot G until Trap # 1 is removed.

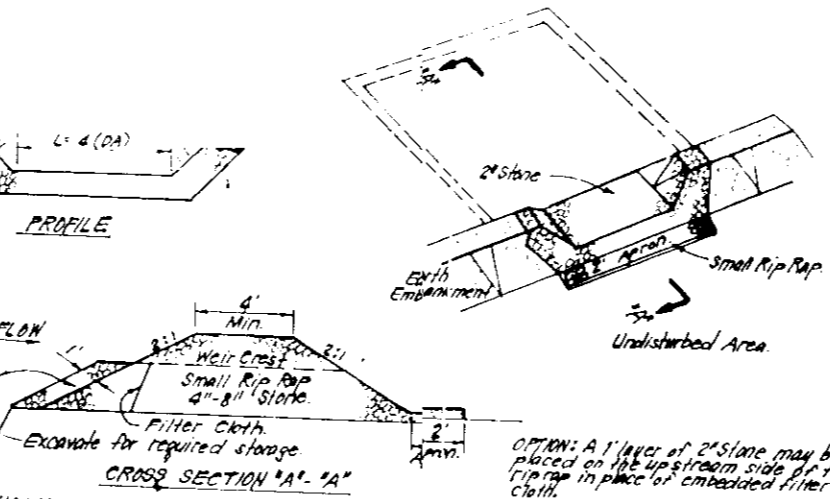


STONE OUTLET SEDIMENT TRAP (SOSIT) DETAIL
SCALE

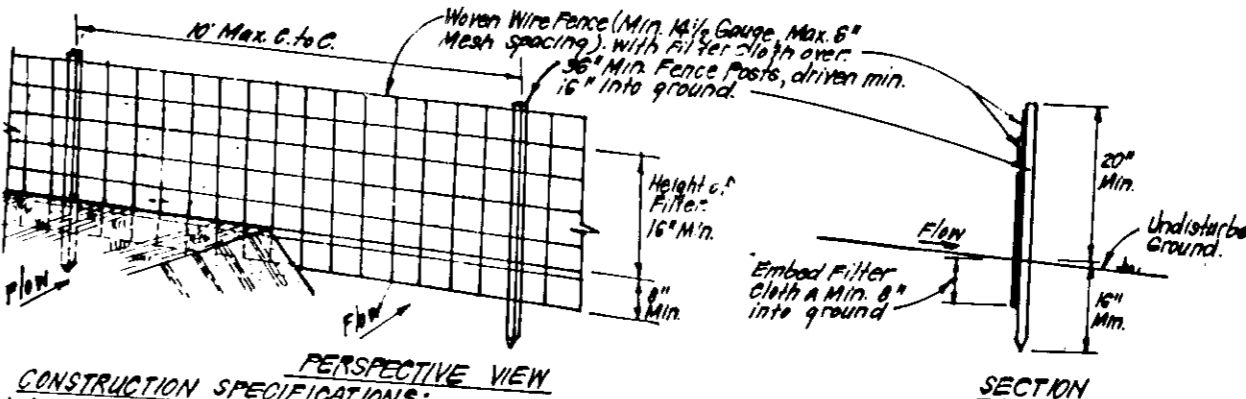

CONSTRUCTION SPECIFICATIONS:

1. Weep holes, 1/2" dia. to be placed securely to force water through filter fabric.
2. Weep holes to be placed at 10' intervals.
3. When 2 sections of filter fabric meet, each shall be overlapped by 6" and stapled.
4. Maintenance shall be performed as needed and material removed when "blow" develops in silt fence.


SILT FENCE DETAIL (S)
SCALE

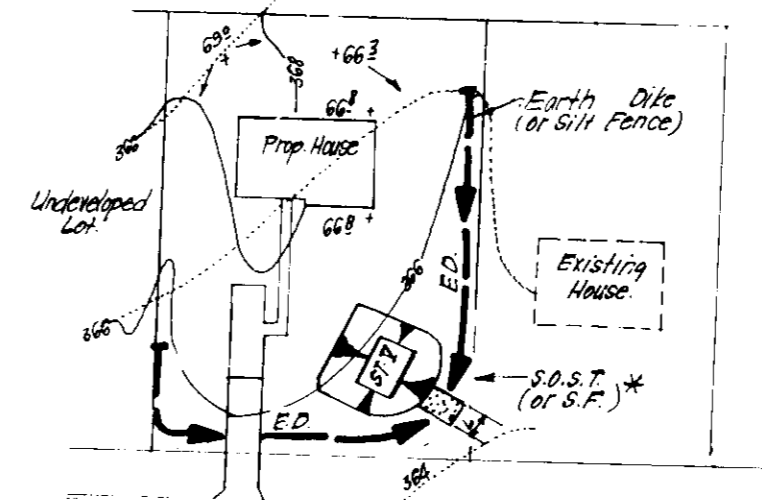

NO. OF DAYS

1	7
2	30
3	120
4	30
5	7

SINGLE LOT SEDIMENT CONTROL PLAN
SCALE

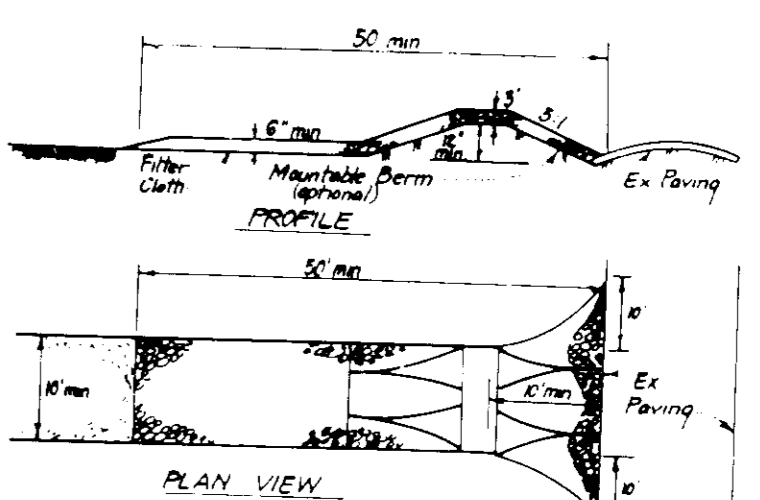

CONSTRUCTION SPECIFICATIONS:

1. Stone size: Use 2" stone or equivalent in recycled concrete equivalent.
2. Length: As required, but not less than 50 feet, except for a single residence of where a 30 foot minimum length would apply.
3. Thickness: Not less than 12 inches.
4. Width: Ten (10) feet minimum, unless less than the full width of points where ingress or egress occurs.
5. Filter Cloth: Will be placed over the entire area prior to placing of stone. Filter will not be required and stone firmly reseeded.
6. Surface Water: All surface water flowing or directed toward construction entrances shall be piped across the entrance. If piping is impractical, a marked silt berm with 5' slope will be permitted.
7. Maintenance: The entrance shall be maintained in a condition which will prevent tracking or flowing of sediment into public rights-of-way. This may require periodic top dressing with additional stone before the construction site is opened to any traffic. If any material is used to trap sediment, it must be removed immediately.
8. Sealing: Where it is desired to remove sediment or to prevent surface water from entering the site, a sealant shall be applied to the top of the stone area stabilized with stone and which drains into the sediment trapping device.
9. Periodic inspection and record maintenance shall be provided after each rain.

STABILIZED CONSTRUCTION ENTRANCE (SCE)
SCALE

DEVELOPER'S/BUILDER'S CERTIFICATE

"I/We certify that all development and construction will be done according to this plan of development and plan for erosion and sediment control and that all responsible personnel involved in the construction project will have a Certificate of Attendance at a Dept. of Natural Resources Approved Training Program for the Control of Sediment and Erosion before beginning the project. I also authorize periodic on-site inspection by the Howard Soil Conservation District or their authorized agents, as may be deemed necessary."

Signature of Developer/Builder: *Robert Woodier* Date: *2/24/90*

Reviewed for HOWARD S.C.D. Name: *Richard J. Stepp* Date: *2/27/90*
Signature: *Richard J. Stepp* Date: *2/27/90*
U.S. Soil Conservation Service

THIS DEVELOPMENT PLAN IS APPROVED FOR SOIL EROSION AND SEDIMENT CONTROL BY THE HOWARD SOIL CONSERVATION DISTRICT.

Approved: *Jeff Z. Smith* Date: *2/27/90*

I hereby certify that this plan for Erosion and Sediment Control represents a practical and workable plan based on my personal knowledge of the site conditions and that it was prepared in accordance with the requirements of the Howard Soil Conservation District.

Signature: *Richard J. Stepp* Date: *2/27/90*

APPROVED: FOR PUBLIC WATER AND PUBLIC SEWERAGE SYSTEMS, HOWARD COUNTY HEALTH DEPARTMENT
Signature: *James P. Smith* Date: *2/27/90*

APPROVED: HOWARD COUNTY DEPT. OF PLANNING & ZONING
Signature: *James P. Smith* Date: *2/24/90*

CHIEF DIVISION OF COMMUNITY PLANNING AND LAND DEVELOPMENT
Signature: *James P. Smith* Date: *2/24/90*

APPROVED: FOR PUBLIC WATER AND PUBLIC SEWERAGE, STORM DRAINAGE SYSTEMS AND PUBLIC ROADS, HOWARD COUNTY DEPARTMENT OF PUBLIC WORKS
Signature: *James P. Smith* Date: *2/24/90*

CHIEF BUREAU OF ENGINEERING
Signature: *James P. Smith* Date: *2/24/90*

CLARK • FINEPROCK & SACKETT, INC.
ENGINEERS • PLANNERS • SURVEYORS
7135 MINSTREL WAY • COLUMBIA, MD 21045 • (301) 381-7500 • BALTO • (301) 621-8000 • WASH

DESIGNED: *KIWM* SCALE: 1" = 30'

DRAWN: *BAL* DRAWING: 3 of 3

CHECKED: *KIWM* JOB NO: 88-013

DATE FEB. 1990 FOR: ROCKLAND LIMITED PARTNERSHIP 11207 McGee Way, Ellicott City, Md. 21043 FILE NO: 88-01358

ROCKLAND SQUARE
LOTS 1 thru 13
2ND ELECTION DISTRICT
HOWARD COUNTY, MARYLAND

SDP 90-144

