

SHEET INDEX	
NO	DESCRIPTION
1	TITLE SHEET
2	SITE DEVELOPMENT PLAN
3	GRADING & SEDIMENT CONTROL
4	LANDSCAPING PLAN
5	SEWER PROFILE & CONSTRUCTION DETAIL SHEET
6	CONSTRUCTION DETAIL SHEET
7	SEDIMENT CONTROL DETAIL SHEET
8	DRAINAGE AREA MAP
9	SOILS MAP

GENERAL NOTES

- ALL WATER LINES SHALL BE CONSTRUCTED A MINIMUM OF 42" COVER BELOW FINISHED GRADE.
- ALL WORK SHALL BE PERFORMED IN ACCORDANCE WITH THE HOWARD COUNTY DESIGN MANUAL, VOL. IV, I.E., STANDARD SPECIFICATIONS AND DETAILS FOR CONSTRUCTION.
- APPROXIMATE LOCATION OF EXISTING UTILITIES ARE SHOWN. THE CONTRACTOR SHALL TAKE ALL NECESSARY PRECAUTIONS TO PROTECT THE EXISTING UTILITIES AND MAINTAIN UNINTERRUPTED SERVICE. ANY DAMAGE INCURRED DUE TO CONTRACTOR'S OPERATION SHALL BE REPAIRED IMMEDIATELY AT THE CONTRACTOR'S EXPENSE.
- THE CONTRACTOR SHALL TEST PIT EXISTING UTILITIES, WHERE DIRECTED BY THE ENGINEER, A MINIMUM OF TWO WEEKS IN ADVANCE OF CONSTRUCTION OPERATIONS.
- CONTRACTOR SHALL NOTIFY THE FOLLOWING UTILITIES AT LEAST FIVE (5) DAYS BEFORE STARTING WORK ON THESE DRAWINGS:
 - UTILITY 1-800-257-7777
 - C&P TELEPHONE COMPANY 725-9976
 - HOWARD COUNTY BUREAU OF UTILITIES 992-2366
 - AT&T CABLE LOCATION DIVISION 393-3553
 - BALTIMORE GAS AND ELECTRIC COMPANY 685-0123
 - STATE HIGHWAY ADMINISTRATION 531-5533
 - HOWARD COUNTY CONSTRUCTION/INSPECTION SURVEY DIVISION (24 HOURS NOTICE) 792-7272
- ALL PIPE ELEVATIONS SHOWN ARE INVERT ELEVATIONS.
- THE CONTRACTOR SHALL PROVIDE A JOINT IN ALL SEWER MAINS WITHIN 2'-0" OF EXTERIOR MANHOLE WALLS.
- PROFILE STATIONS SHALL BE ADJUSTED AS NECESSARY TO CONFORM TO PLAN DIMENSIONS.
- NO PIPE SHALL BE LAID UNTIL LINES OF EXCAVATION HAVE BEEN BROUGHT TO SUBGRADE.
- TOPO TAKEN FROM FIELD RUN SURVEY DATED 4/7/87 BY KIDDE CONSULTANTS, INC.
- ALL PLAN DIMENSIONS ARE TO FACE OF CURB UNLESS OTHERWISE NOTED.
- SITE LIGHTING TO BE DIRECTED INWARD AND DOWNWARD AWAY FROM ALL RESIDENTIAL AREAS.
- HAZARDOUS WASTE PETITION # 85-163 GRANTED FROM SECTION 14.00 OF THE HOWARD COUNTY SUBDIVISION/ LAND DEVELOPMENT REGS. DATED JUNE 20, 1988 FOR THE PURPOSES OF REQUESTING AN EXTENSION OF CONDITIONAL APPROVAL.

BUILDING # 5 SITE TABULATION

NO.	DESCRIPTION	AREA (SQ. FT.)	TOTAL (SQ. FT.)
1	OFFICE	1,800	1,800
2	WAREHOUSE	10,000	10,000
3	OFFICE	1,800	1,800
4	WAREHOUSE	10,000	10,000
5	OFFICE	1,800	1,800
30	WAREHOUSE	10,000	10,000

SITE ANALYSIS

AREA OF SITE	150,020.64 SF, 3.444 AC
TOTAL AREA DISTURBED	140,875.64 SF
AREA ROOFED OR PAVED	110,119 SF
AREA VEGETATIVELY STABILIZED	30,756.64 SF
TOTAL CUT	9,997 CY
TOTAL FILL	9,176 CY
OFFSITE WASTE LOCATION TO BE STABILIZED PER APPROVED SEDIMENT CONTROL MEASURES	821 CY

SITE DEVELOPMENT PLAN



DORSEY RUN PARK

BUILDING 4 - UNIT NO. 1C

PUMP & POWER SHOP - ADDITION TO SDP-86 - 255 & 88-71 & 90 - 102

6TH ELECTION DISTRICT

HOWARD COUNTY, MARYLAND

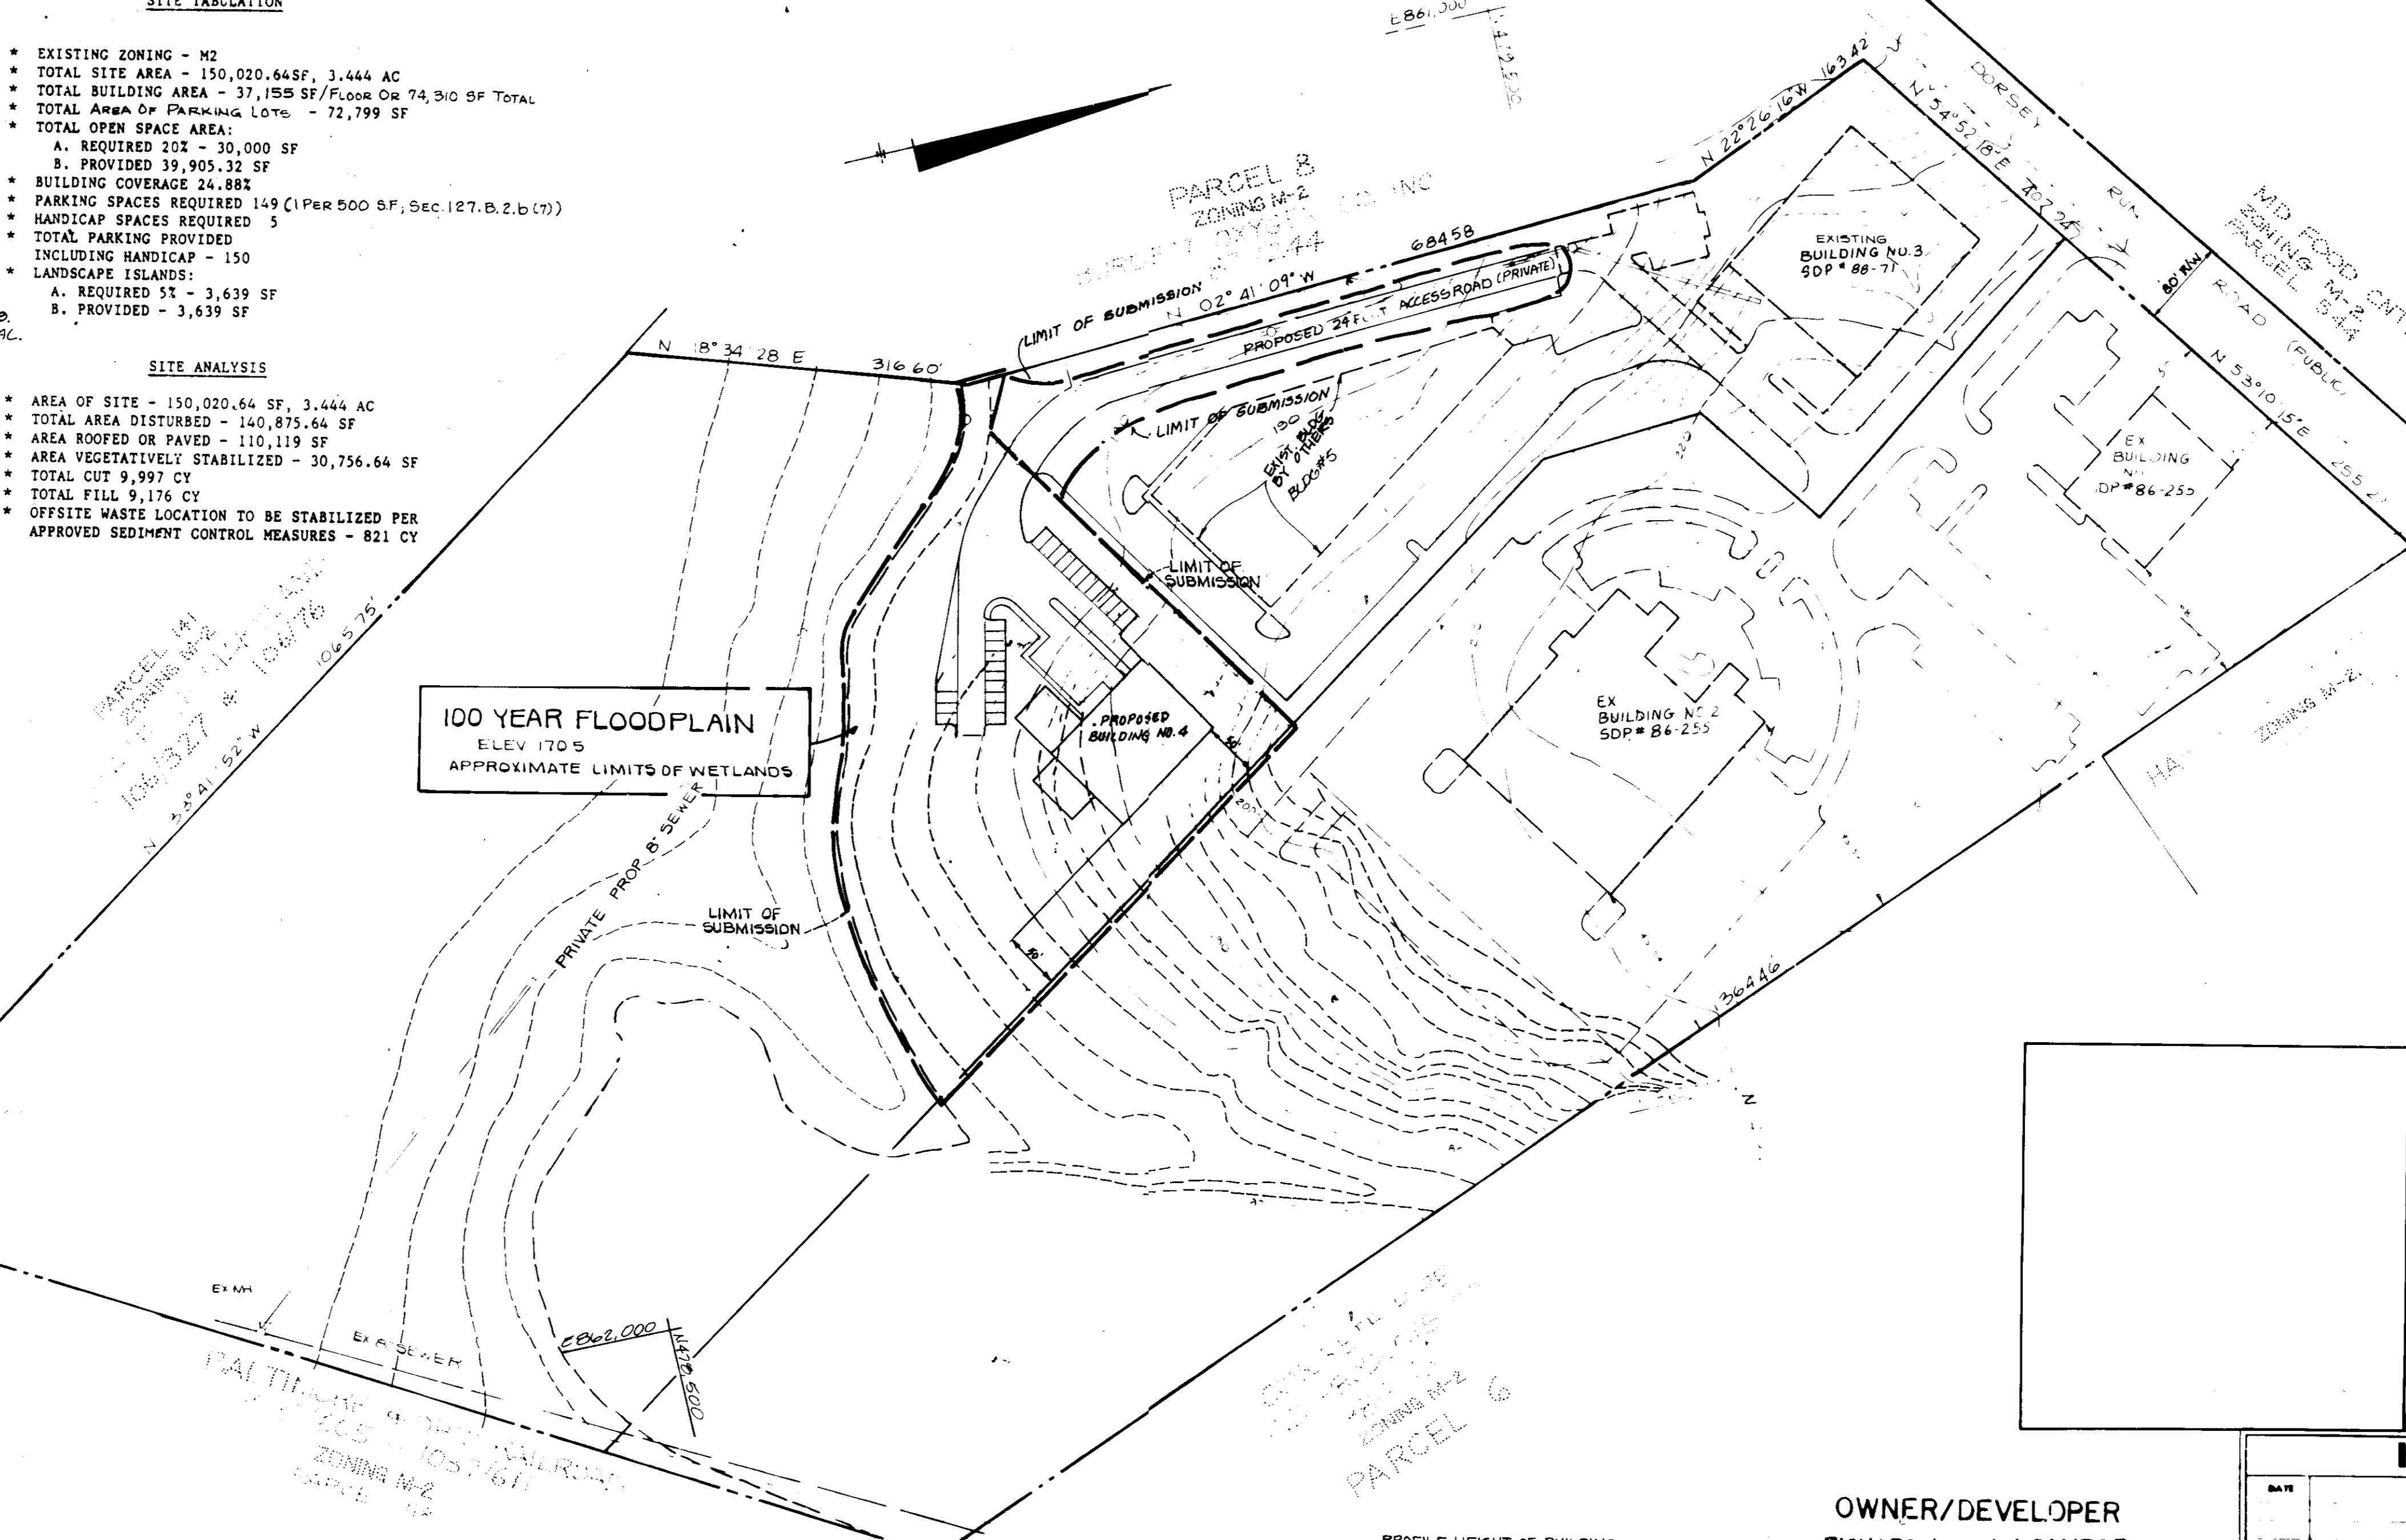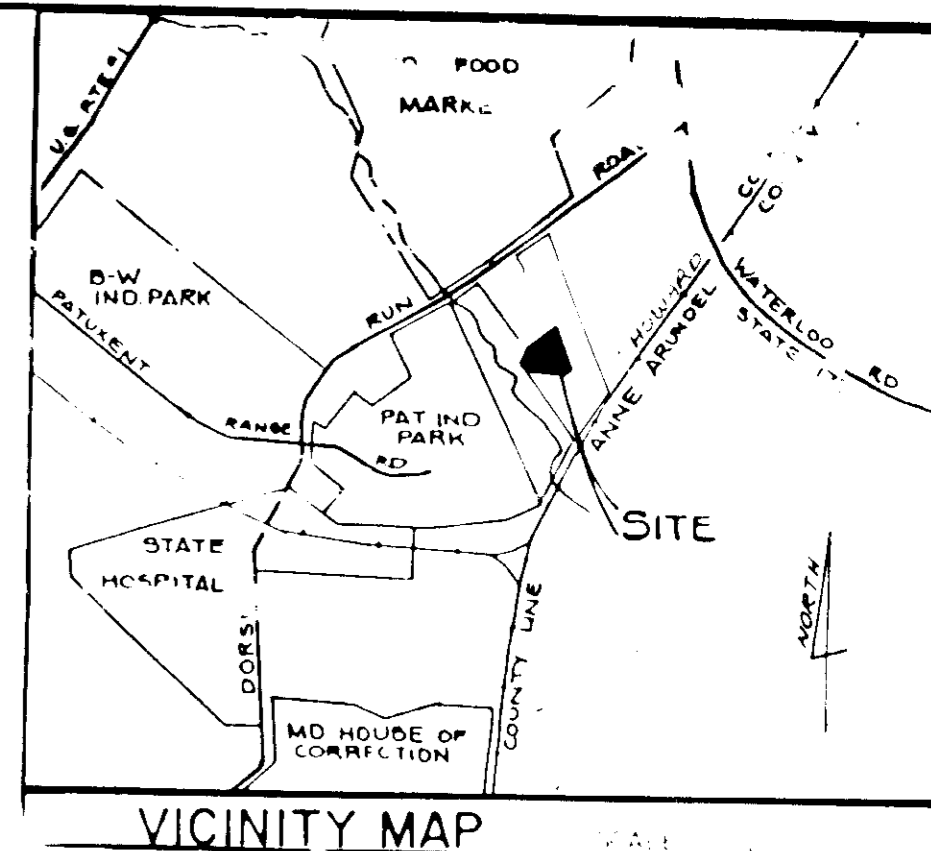

BUILDING # 4 SITE ANALYSIS

A. AREA OF PARCEL	32,549 AC. (1,417,834 SQ. FT.)
B. AREA OF PROPOSED SITE	3.0 AC. (130,680 SQ. FT.)
C. PRESENT ZONING	M-2
D. PROPOSED ZONING	M-2
E. BUILDING AREA SQ. FT.	12,600 SQ. FT.
F. PARKING SPACES REQUIRED	ONE SPACE/500 SQ. FT. OF FLOOR AREA
G. PARKING SPACES PROVIDED	30
H. HANDICAPPED SPACES REQUIRED	2
I. HANDICAPPED SPACES PROVIDED	2
J. OPEN SPACE REQUIRED	20% (26,136 SQ. FT.)
K. OPEN SPACE PROVIDED	85,521 (65% OF REQ.)
L. BUILDING COVERAGE	5.63%
M. LANDSCAPED ISLANDS REQUIRED	8% OF PARKING AREA (1,008 SQ. FT.)
N. LANDSCAPED ISLANDS PROVIDED	14,916 (8,764 SQ. FT.)
O. PARKING AREA	14,916 (8,764 SQ. FT.)
P. TOTAL SQ. FT. TOTALS	
- OFFICE: 1800 X 2	3,600 SF
- WAREHOUSE	10,000 SF
TOTAL	14,400 SF
Q. NO. OF EMPLOYEES	17 (SEVENTEEN)
- OFFICE	6
- WAREHOUSE	11
* ONE SPACE/500 SQ. FT. USED FOR OFFICE & WAREHOUSE PARKING	

ADDRESS LIST

1	802 DORSEY RUN ROAD
2	805 DORSEY RUN ROAD
3	808 DORSEY RUN ROAD
4	809 DORSEY RUN ROAD
5	810 DORSEY RUN ROAD

DORSEY RUN PARK
HOWARD COUNTY, MARYLAND

SUBDIVISION NAME	DORSEY RUN PARK	SECT./AREA	PARCEL NO.
PLAT NO. OR L/F BLOCK NO.	1000 155	ZONE	M-2
TAX/ZONE MAP/ELEC. DIST.	44	CENSUS TR.	
WATER CODE		SEWER CODE	

APPROVED: FOR PUBLIC WATER & SEWERAGE, STORM DRAINAGE SYSTEMS & PUBLIC ROADS, HOWARD COUNTY DEPT. OF PUBLIC WORKS.

Richard J. Span 2/10/91
DIRECTOR ACTING DATE

Richard J. Span 2-11-91
CHIEF BUREAU OF ENGINEERING DATE

APPROVED: FOR PUBLIC WATER & PUBLIC SEWERAGE SYSTEMS, HOWARD COUNTY DEPT. OF PUBLIC WORKS.

James W. Bralle 2/15/91
COUNTY HEALTH OFFICER DATE

APPROVED: HOWARD COUNTY DEPT. OF PLANNING & ZONING

Richard J. Span 2/27/91
DIRECTOR ACTING DATE

Richard J. Span 3/1/91
CHIEF BUREAU OF ENGINEERING DATE



KIDDE CONSULTANTS, INC.
ENGINEERS • PLANNERS • SURVEYORS

OWNER/DEVELOPER
RICHARD & SUSAN SANDER
233 CREEKWOOD DRIVE
FASTERVILLE, PA. 19047




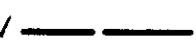
DATE: Aug., 1988


SHEET 1 OF 9

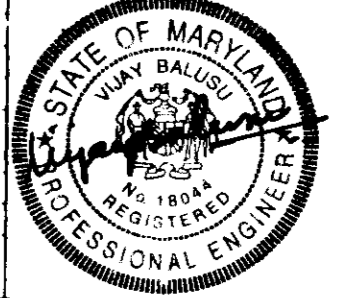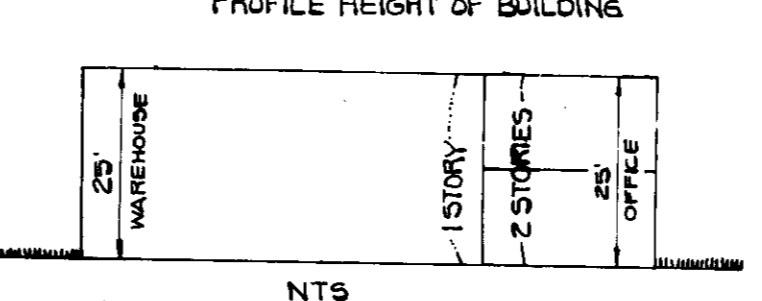NOTE: THIS SDP IS A REVISION TO SDP-89-58 WHICH WAS TENTATIVELY APPROVED ON AUGUST 28, 1989



LEGEND

- P-1 PAVING 
- P-2 PAVING 
- P-3 PAVING 
- LIMIT OF SUBMISSION 

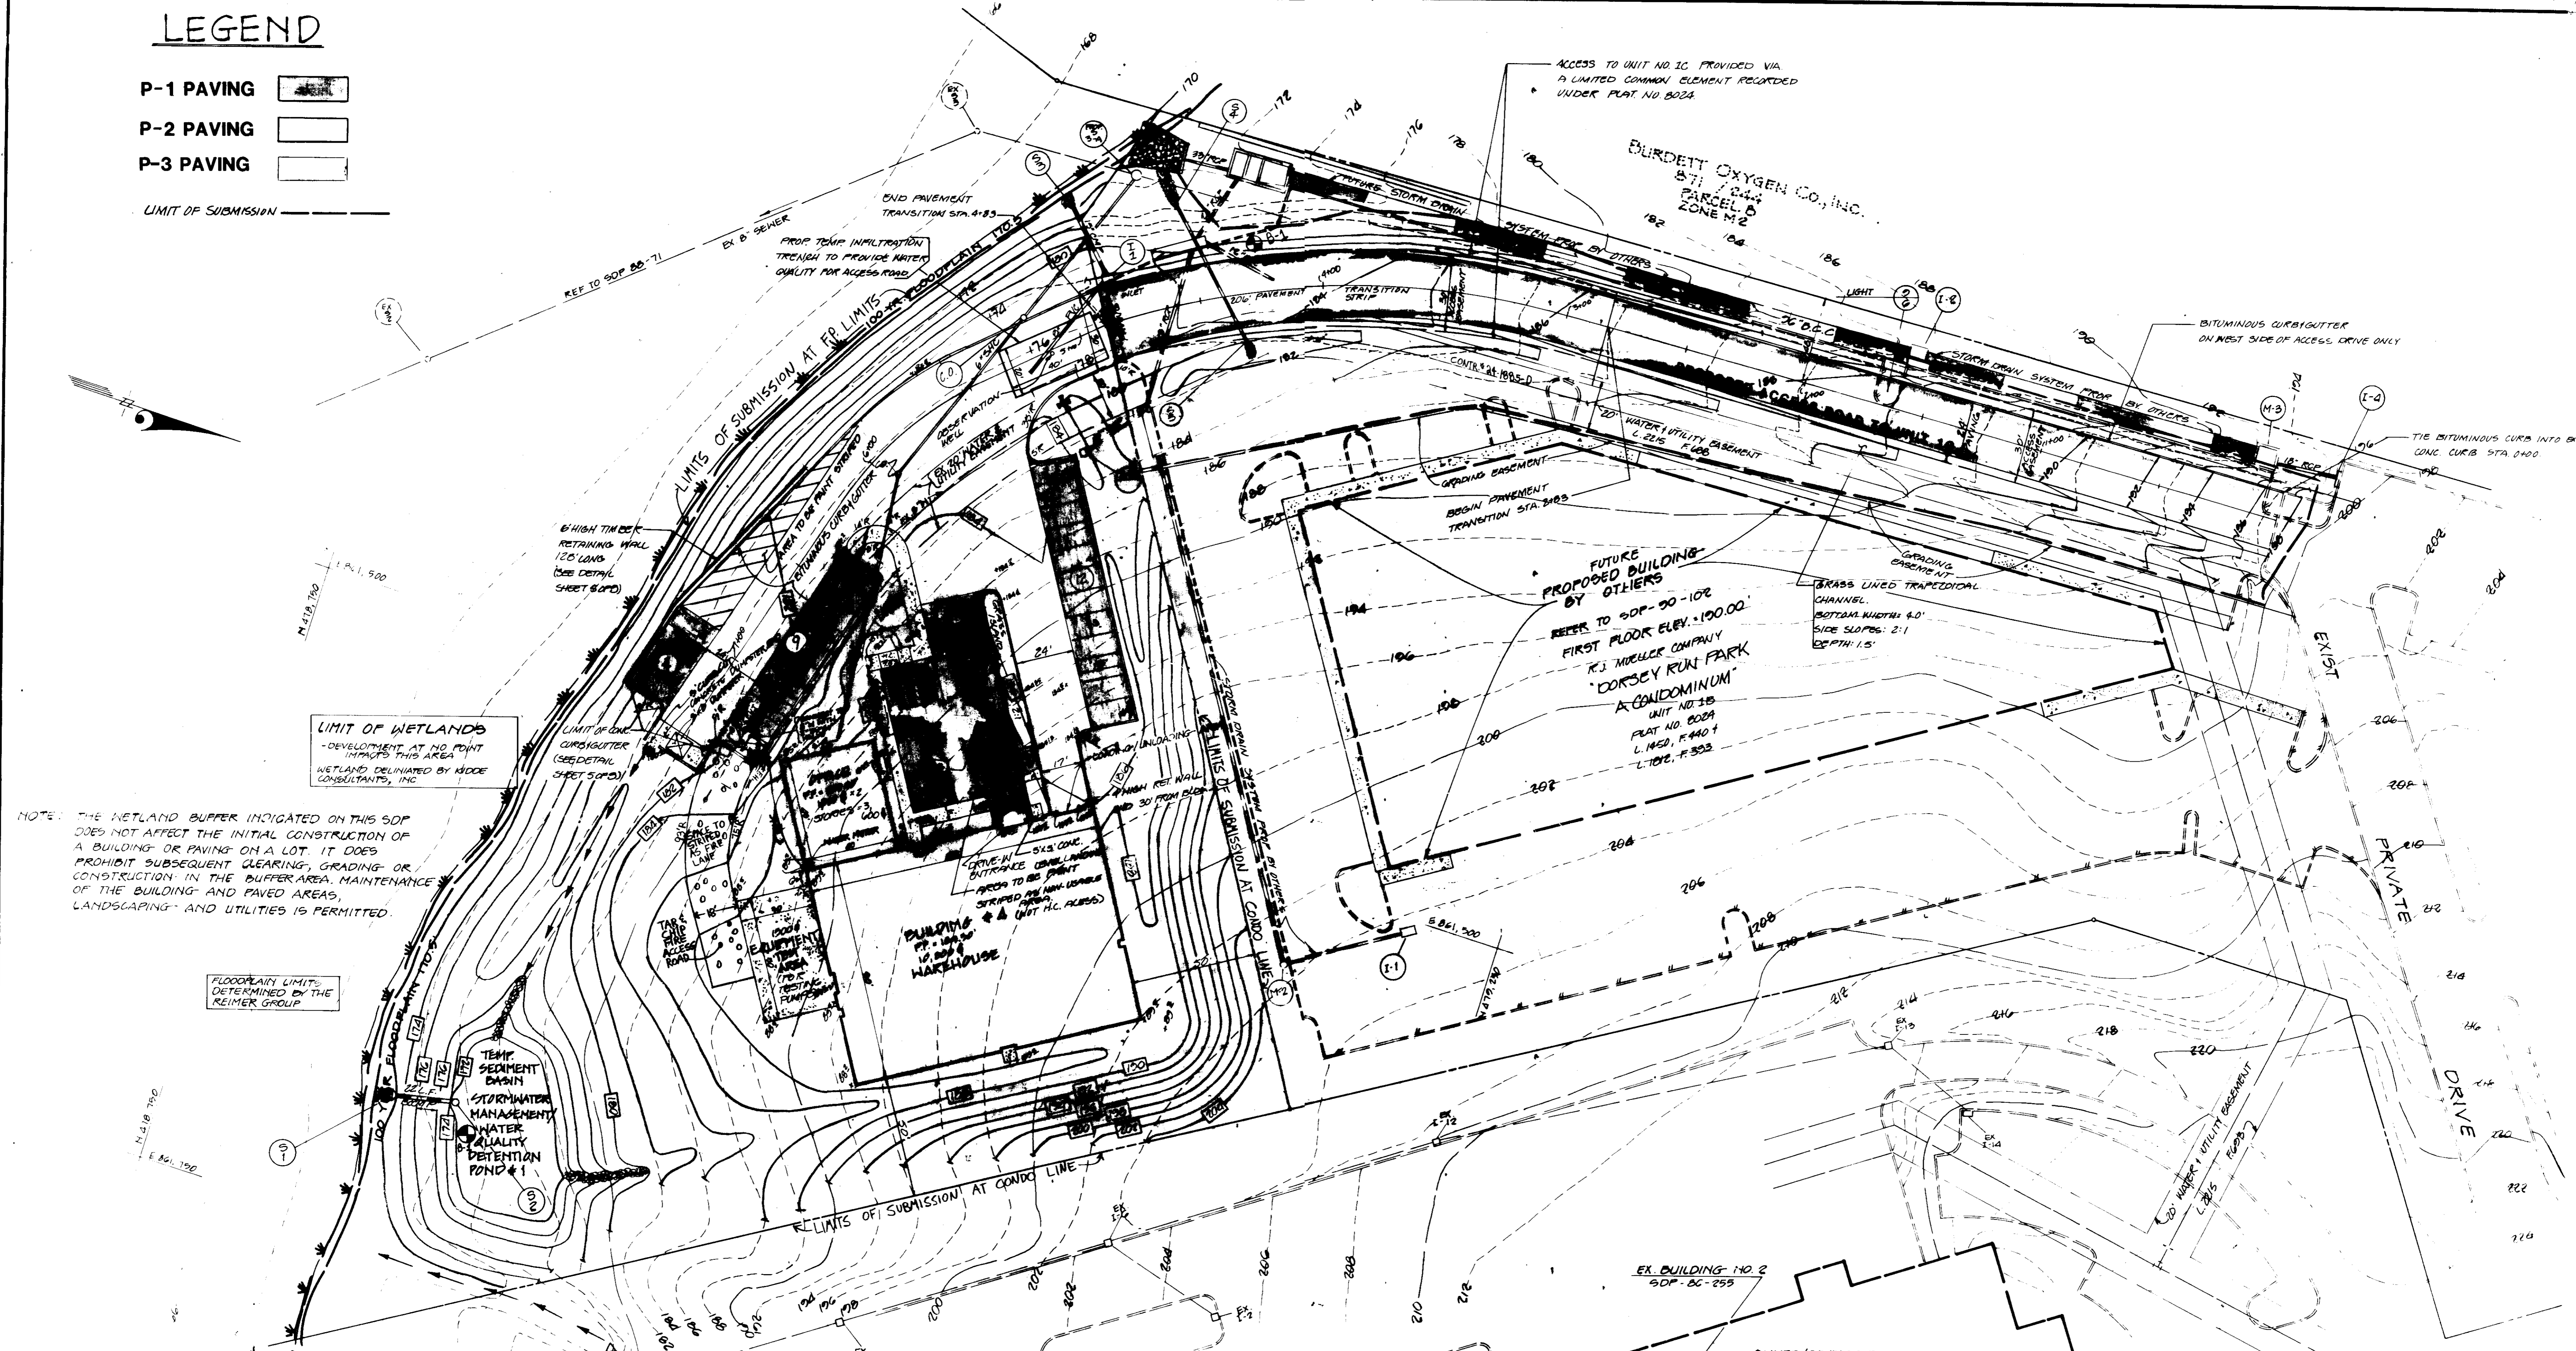

APPROVED: HOWARD COUNTY DEPARTMENT OF PLANNING AND ZONING
 DATE: 3/1/91

APPROVED: FOR PUBLIC WATER AND PUBLIC SEWERAGE, STORM DRAINAGE SYSTEMS AND PUBLIC ROADS
 HOWARD COUNTY DEPARTMENT OF PUBLIC WORKS
 DATE: 2/12/91

APPROVED: FOR PUBLIC WATER AND PUBLIC SEWERAGE SYSTEMS
 HOWARD COUNTY HEALTH DEPARTMENT
 DATE: 2/15/91

These plans have been reviewed for the Howard Soil Conservation District and meet the technical requirements for small pond construction, soil erosion and sediment control.
 DATE: 11-27-90

These plans for small pond construction, soil erosion and sediment control meet the requirements of the Howard Soil Conservation District.
 DATE: 11/27/90

ENGINEERS CERTIFICATE
 "I CERTIFY THAT THIS PLAN FOR EROSION & SEDIMENT CONTROL REPRESENTS A PRACTICAL AND WORKABLE PLAN BASED ON MY PERSONAL KNOWLEDGE OF THE SITE CONDITIONS AND THAT IT WAS PREPARED IN ACCORDANCE WITH THE REQUIREMENTS OF THE HOWARD SOIL CONSERVATION DISTRICT."
 DATE: 11-15-90

DEVELOPERS CERTIFICATE
 "I/WE CERTIFY THAT ALL DEVELOPMENT & CONSTRUCTION WILL BE DONE ACCORDING TO THIS PLAN, AND THAT ANY RESPONSIBLE PERSONNEL INVOLVED IN THE CONSTRUCTION PROJECT WILL HAVE A CERTIFICATE OF ATTENDANCE AT A DEPARTMENT OF NATURAL RESOURCES APPROVED TRAINING PROGRAM FOR THE CONTROL OF SEDIMENT & EROSION BEFORE BEGINNING THE PROJECT. I ALSO AUTHORIZE PERIODIC ON-SITE INSPECTION BY THE HOWARD SOIL CONSERVATION DISTRICT."
 DATE: 11/15/90

OWNER/DEVELOPER
 RICHARD E. SUSAN BANDER
 239 GREENWOOD DRIVE
 EASTERVILLE, PA 17027

OWNER/DEVELOPER
 RICHARD E. SUSAN BANDER
 239 GREENWOOD DRIVE
 EASTERVILLE, PA 17027

**PUMP & POWER WAREHOUSE
 SITE DEVELOPMENT PLAN
 DORSEY RUN PARK UNIT NO. 10
 BUILDING NO. 1**

HOWARD COUNTY, MARYLAND
 TAX MAP 25 PARCEL 5
 6TH ELECTION DISTRICT

KIDDE CONSULTANTS, INC.
 ENGINEERS • PLANNERS • SURVEYORS
 1100 WEST STREET SUITE 100 LAUREL, MD 20701
 (Wash. 301) 953-1821 792-8086 (Rmt)

DATE: MAY 1990 SCALE: 1"=30'

Drwg. No. 209

**NOTE: THIS PLAN FOR GRADING AND SEDIMENT CONTROL ONLY.
THIS SITE HAS BEEN PREVIOUSLY GRADED IN ACCORDANCE
WITH APPROVED GRADING PLAN GP-89-08**

- LEGEND**
- ED-A1 EARTH DIKE
 - LIMITS OF DISTURBANCE
 - S- SILT FENCE
 - ➔ MAXIMUM DRAINAGE AREA TO SEDIMENT BASIN
 - LIMIT OF SUBMISSION

LIMIT OF DISTURBANCE TO BE AT FLOODPLAIN LIMIT. FLOODPLAIN LIMITS TO BE FIELD STAKED PRIOR TO THE START OF CONSTRUCTION

6" HIGH TIMBER RETAINING WALL (26' LONG)

LIMITS OF CONCRETE CURB AND GUTTER (SEE DETAIL SHEET 509)

LIMIT OF WETLANDS (DENEWEL POINT AT N.C. POINT) (SEE DETAIL SHEET 509)

NOTE: THE WETLAND BUFFER INDICATED ON THIS SDP DOES NOT AFFECT THE INITIAL CONSTRUCTION OF A BUILDING OR PAVING ON A LOT. IT DOES PROHIBIT SUBSEQUENT CLEARING, GRADING OR CONSTRUCTION IN THE BUFFER AREA. MAINTENANCE OF THE BUILDING AND PAVED AREAS, LANDSCAPING AND UTILITIES IS PERMITTED.

SEDIMENT BASIN SCHEDULE	
MAX DRAINAGE AREA:	21.00 ACRES
REQ. STORAGE VOL.:	3,600 CU. FT.
PROV. STORAGE VOL.:	10,000 CU. FT.
BOTTOM ELEVATION:	172.50'
CLEANOUT ELEVATION:	173.70'

REVISION CHART	
DATE	REVISION

APPROVED: FOR PUBLIC WATER AND PUBLIC SEWERAGE, STORM DRAINAGE SYSTEMS AND PUBLIC ROADS
HOWARD COUNTY DEPARTMENT OF PUBLIC WORKS

Donald Sapan 2/12/91
DIRECTOR

Michael E. Ryan 2-11-91
CHIEF BUREAU OF ENGINEERING

APPROVED: FOR PUBLIC WATER AND PUBLIC SEWERAGE SYSTEMS
HOWARD COUNTY HEALTH DEPARTMENT

John J. Wozniak 2/15/91
COUNTY HEALTH OFFICER

These plans have been reviewed for the Howard Soil Conservation District and meet the technical requirements for small pond construction, soil erosion and sediment control.

James M. Hittler 11/27/90
U.S. SOIL CONSERVATION SERVICE

These plans for small pond construction, soil erosion and sediment control meet the requirements of the Howard Soil Conservation District.

Robert J. Zelin 11/27/90
HOWARD SOIL CONSERVATION DISTRICT

ENGINEER'S CERTIFICATE

"I certify that this plan for pond construction, erosion and sediment control represents a practical and workable plan based on my personal knowledge of the site conditions. This plan was prepared in accordance with the requirements of the Howard Soil Conservation District. I have notified the developer that he must provide the Howard Soil Conservation District with an "as built" plan of the pond within 30 days of completion."

Richard C. Sander 11-15-90
ENGINEER'S SIGNATURE

DEVELOPERS CERTIFICATE

"I certify that all development and/or construction will be done according to these plans, and that any responsible personnel involved in the construction project will have a Certificate of Attendance at a Department of Natural Resources Approved Training Program for the Control of Sediment and Erosion before beginning the project. I will provide the Howard Soil Conservation District with an "as-built" plan of the pond within 30 days of completion."

Richard C. Sander 11/15/90
DEVELOPERS SIGNATURE

PUMP & POWER WAREHOUSE
GRADING & SEDIMENT CONTROL PLAN
DORSEY RUN PARK-UNIT NO. 1C
BUILDING NO. 4

HOWARD COUNTY, MARYLAND
TAX MAP 25 PARCEL 5
6TH ELECTORAL DISTRICT

KIDDE CONSULTANTS, INC.
ENGINEERS • PLANNERS • SURVEYORS


8/14/90 SWM AS BUILT
11/27/90 AS BUILT

OTHERS: SDH, RUL, B.S. JCP

Drwg No 3093

MAY 1990

SDP 90-207

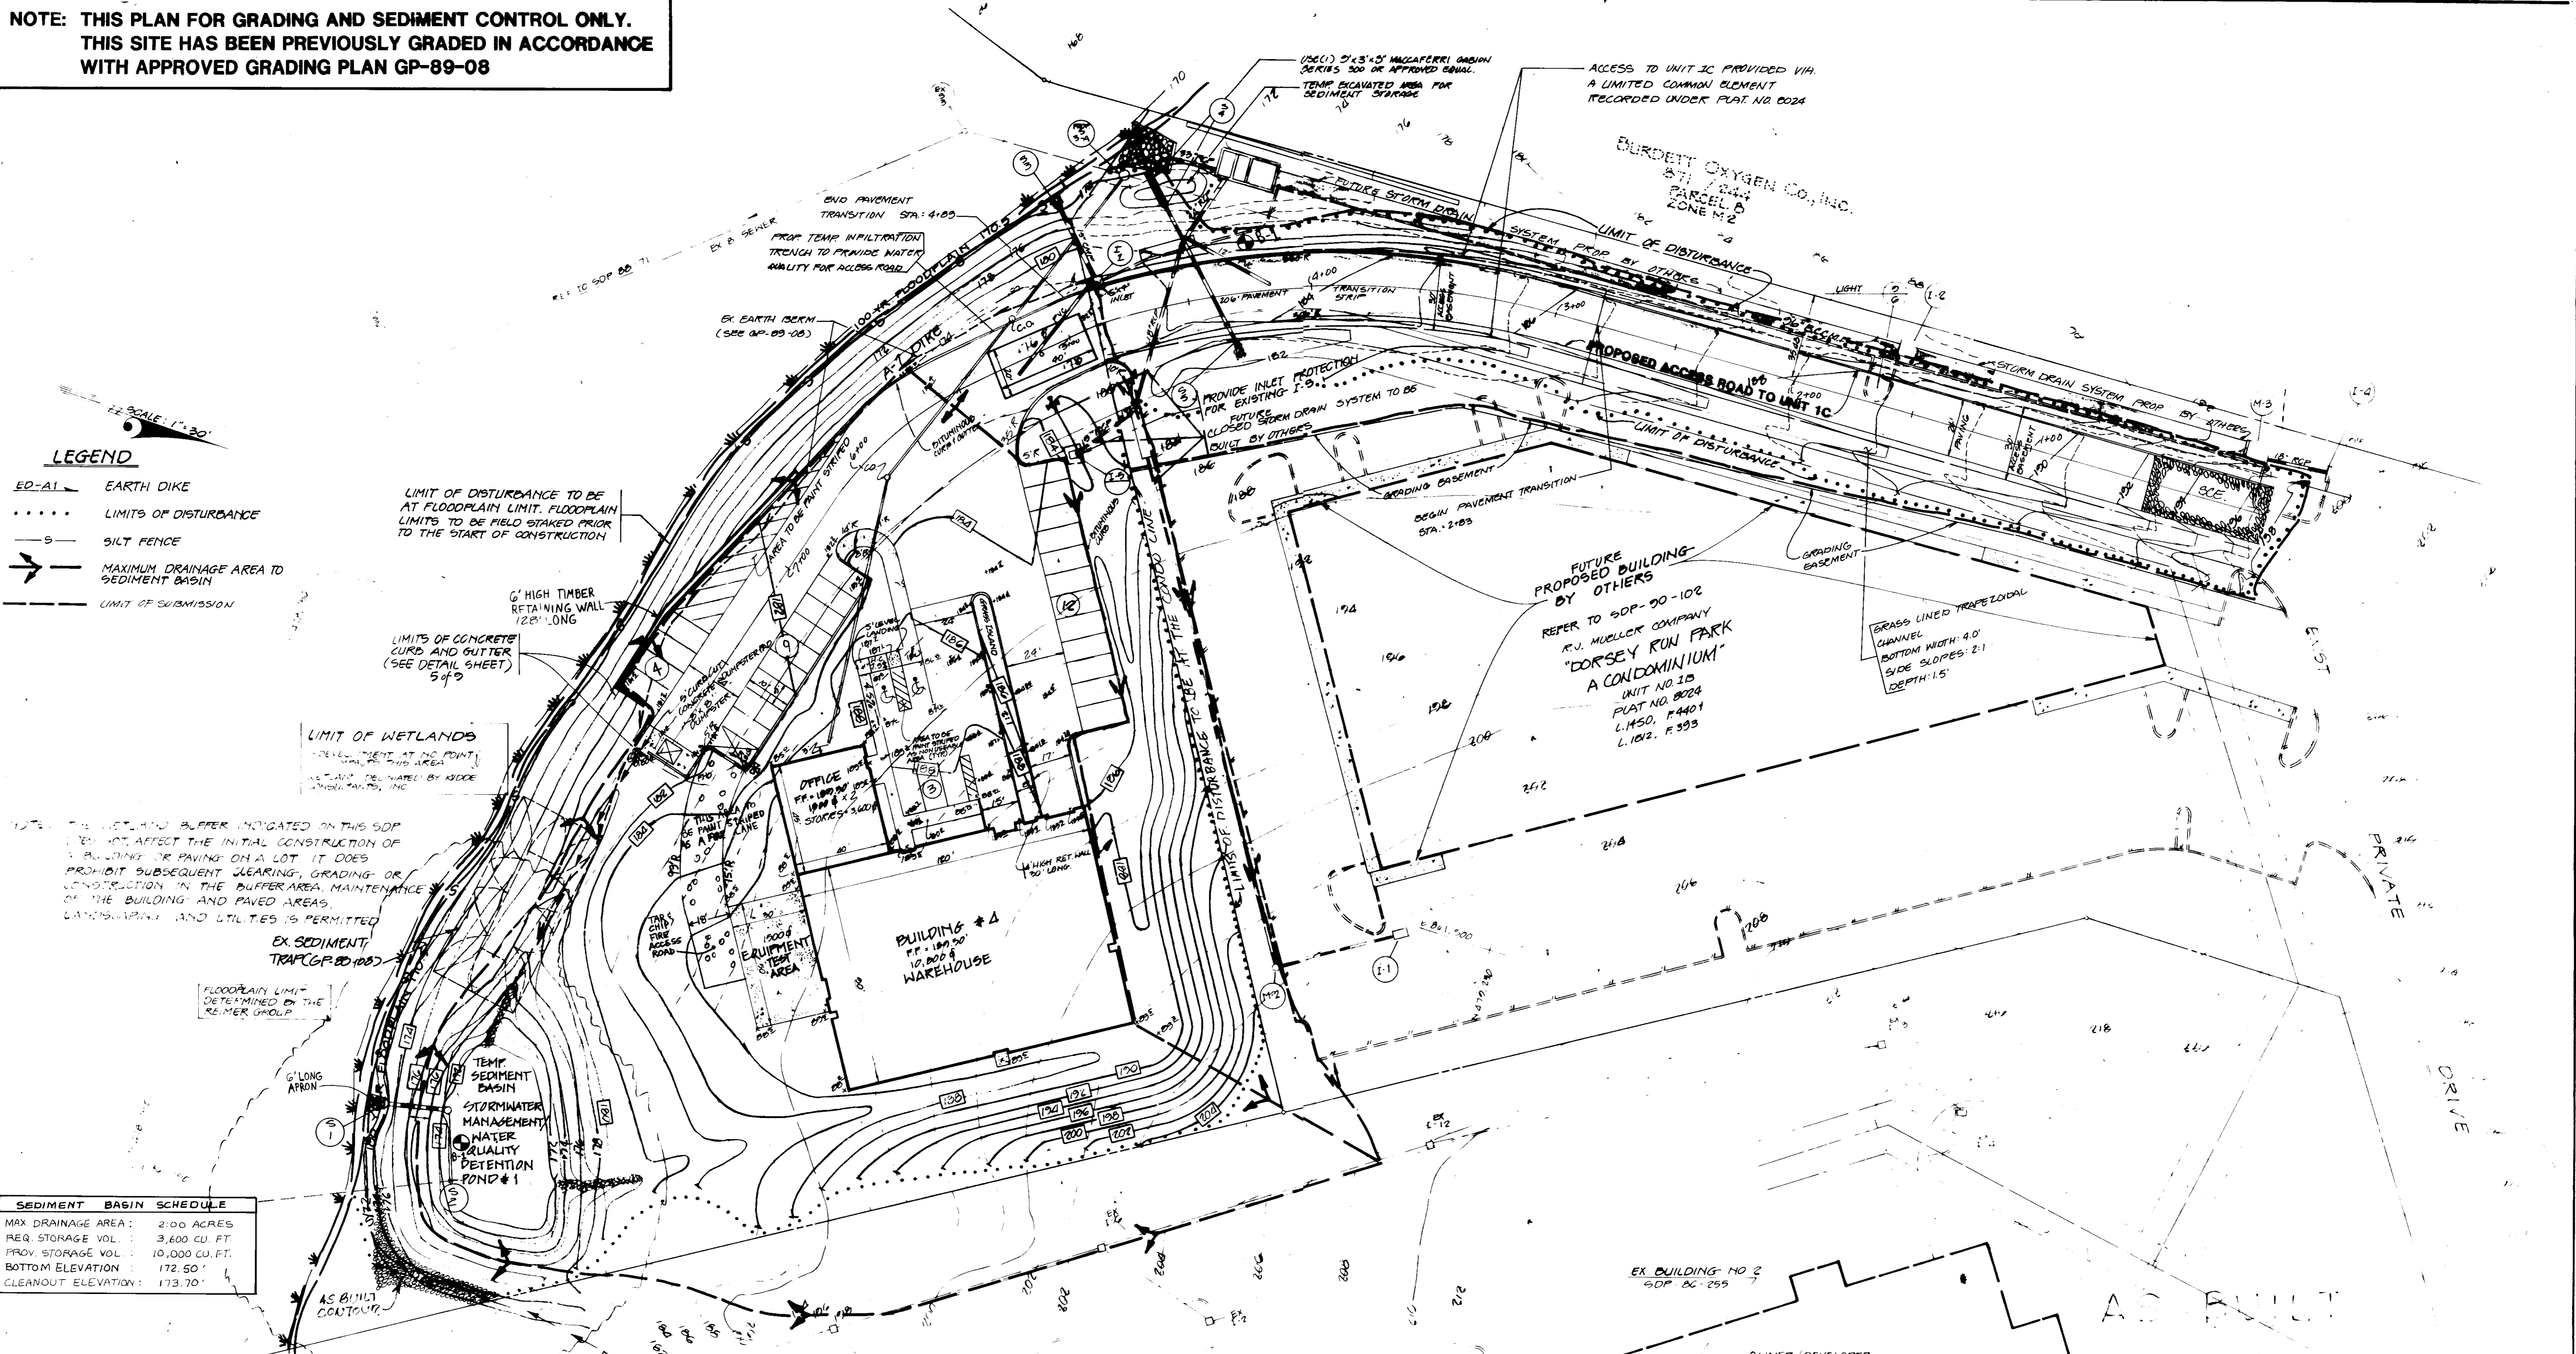


PLANT LIST

GENERAL LANDSCAPE NOTES

KEY	QUANTITY	BOTANICAL NAME COMMON NAME	SIZE	UNIT	SPACING
AR	2	Acer rubrum "Red Sunset" Red Sunset Glory Maple	2 1/2" x 3" Cal. 12" - 14" Ht.	B&B	As noted
OP	2	Ostrya phellos Willow Oak	2 1/2" x 3" Cal. 12" - 14" Ht.	B&B	As noted
EV	7	Pinus strobus Eastern White Pine	6" - 8" Ht.	B&B	10' O.C.
FL	4	Perus calleryana "Aristocrat" Aristocrat Callery Pear	1 1/2" x 3/4" Cal. 7'-9" Ht.	B&B	As noted
BT	14	Berberis thunbergii var. Aristocrat "Crimson Pygmy"	18" - 24" Spd.	Cont.	30' O.C.
IL	24	Ilex crenata "Mollis" Leaf Japanese Holly	18" - 24" Spd.	Cont.	30' O.C.
JH	14	Juniperus horizontalis "Hughes" Hughes Juniper	18" - 24" Spd.	Cont.	30' O.C.

- Plant names shall conform to the nomenclature of Standardized Plant Names. Substitutions shall not be made without approval of landscape architect. All plants shall be properly identified by name and size on legible labels securely attached to plants.
- All plants shall (1) be true to type and name, (2) typical of their species or variety, (3) have a normal well-developed branch structure with a vigorous root system.
- For a period of twelve months from the date that the work under this contract is certified as complete, the contractor shall: (1) guarantee all plants under this contract; (2) remove and replace, during the guarantee period, plants which die or are in a badly impaired condition; (3) replant with stock of same size and quality as originally specified; (4) give as specified, at no additional cost.
- Plants shall be staked out as indicated on plan.
- Topsoil shall not be placed when ground is excessively wet, or in a condition that the soil cannot be worked easily and dressed smooth.
- Provide 2" mulch at all plant beds, including tree and shrub pits. After completing mulching operations, water all newly planted areas until soaked to a minimum depth of 2".

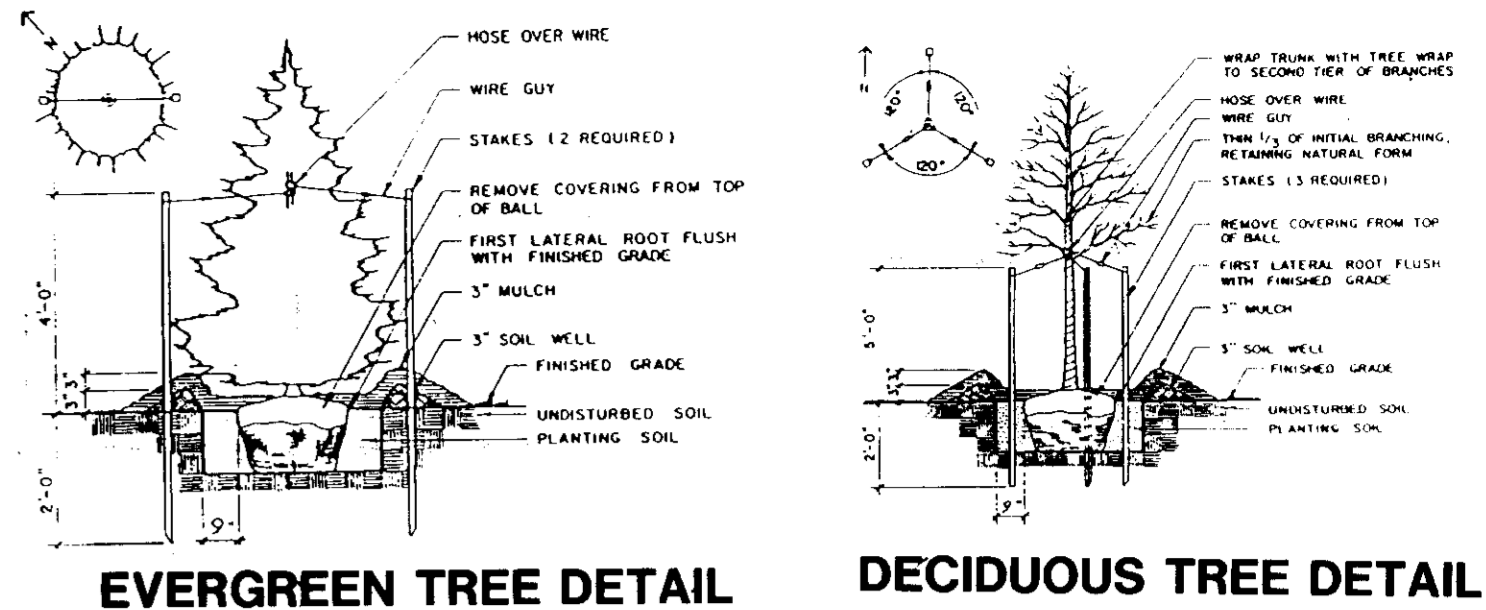

SHRUB DETAIL

- THIN DECIDUOUS SHRUBS BY 1/2 THE INITIAL SPACING FROM THE INITIAL SPACING FROM EACH OTHER
- COVERING FROM TOP OF BALL
- FIRST LATERAL ROOT FLUSH WITH FINISHED GRADE
- 3" MULCH
- OUT EDGE OF BED VERTICALLY FINISHED GRADE
- UNDISTURBED SOIL
- PLANTING SOIL


GROUND COVER DETAIL

SPACING "O"	ROW "A"	NO. OF PLANTS / S.F.
6" O.C.	5.20'	4.81
8" O.C.	6.93'	2.90
10" O.C.	8.58'	1.86
12" O.C.	10.40'	1.15
15" O.C.	13.00'	.73
18" O.C.	15.80'	.49
24" O.C.	20.90'	.29
30" O.C.	26.00'	.18
36" O.C.	30.00'	.12

NOTE FOR USE ONLY WHICH PLANTS ARE SPACED EQUIDISTANT FROM EACH OTHER AS SHOWN AND SPECIFIED IN THE PLANT LIST

REQUIRED PARKING LOT LANDSCAPE AREA:

20,571 s-ft = Area of Parking Lot
 5% = 1,028.5 s-ft (REQUIRED)
 8% = 1,695 s-ft (PROVIDED)

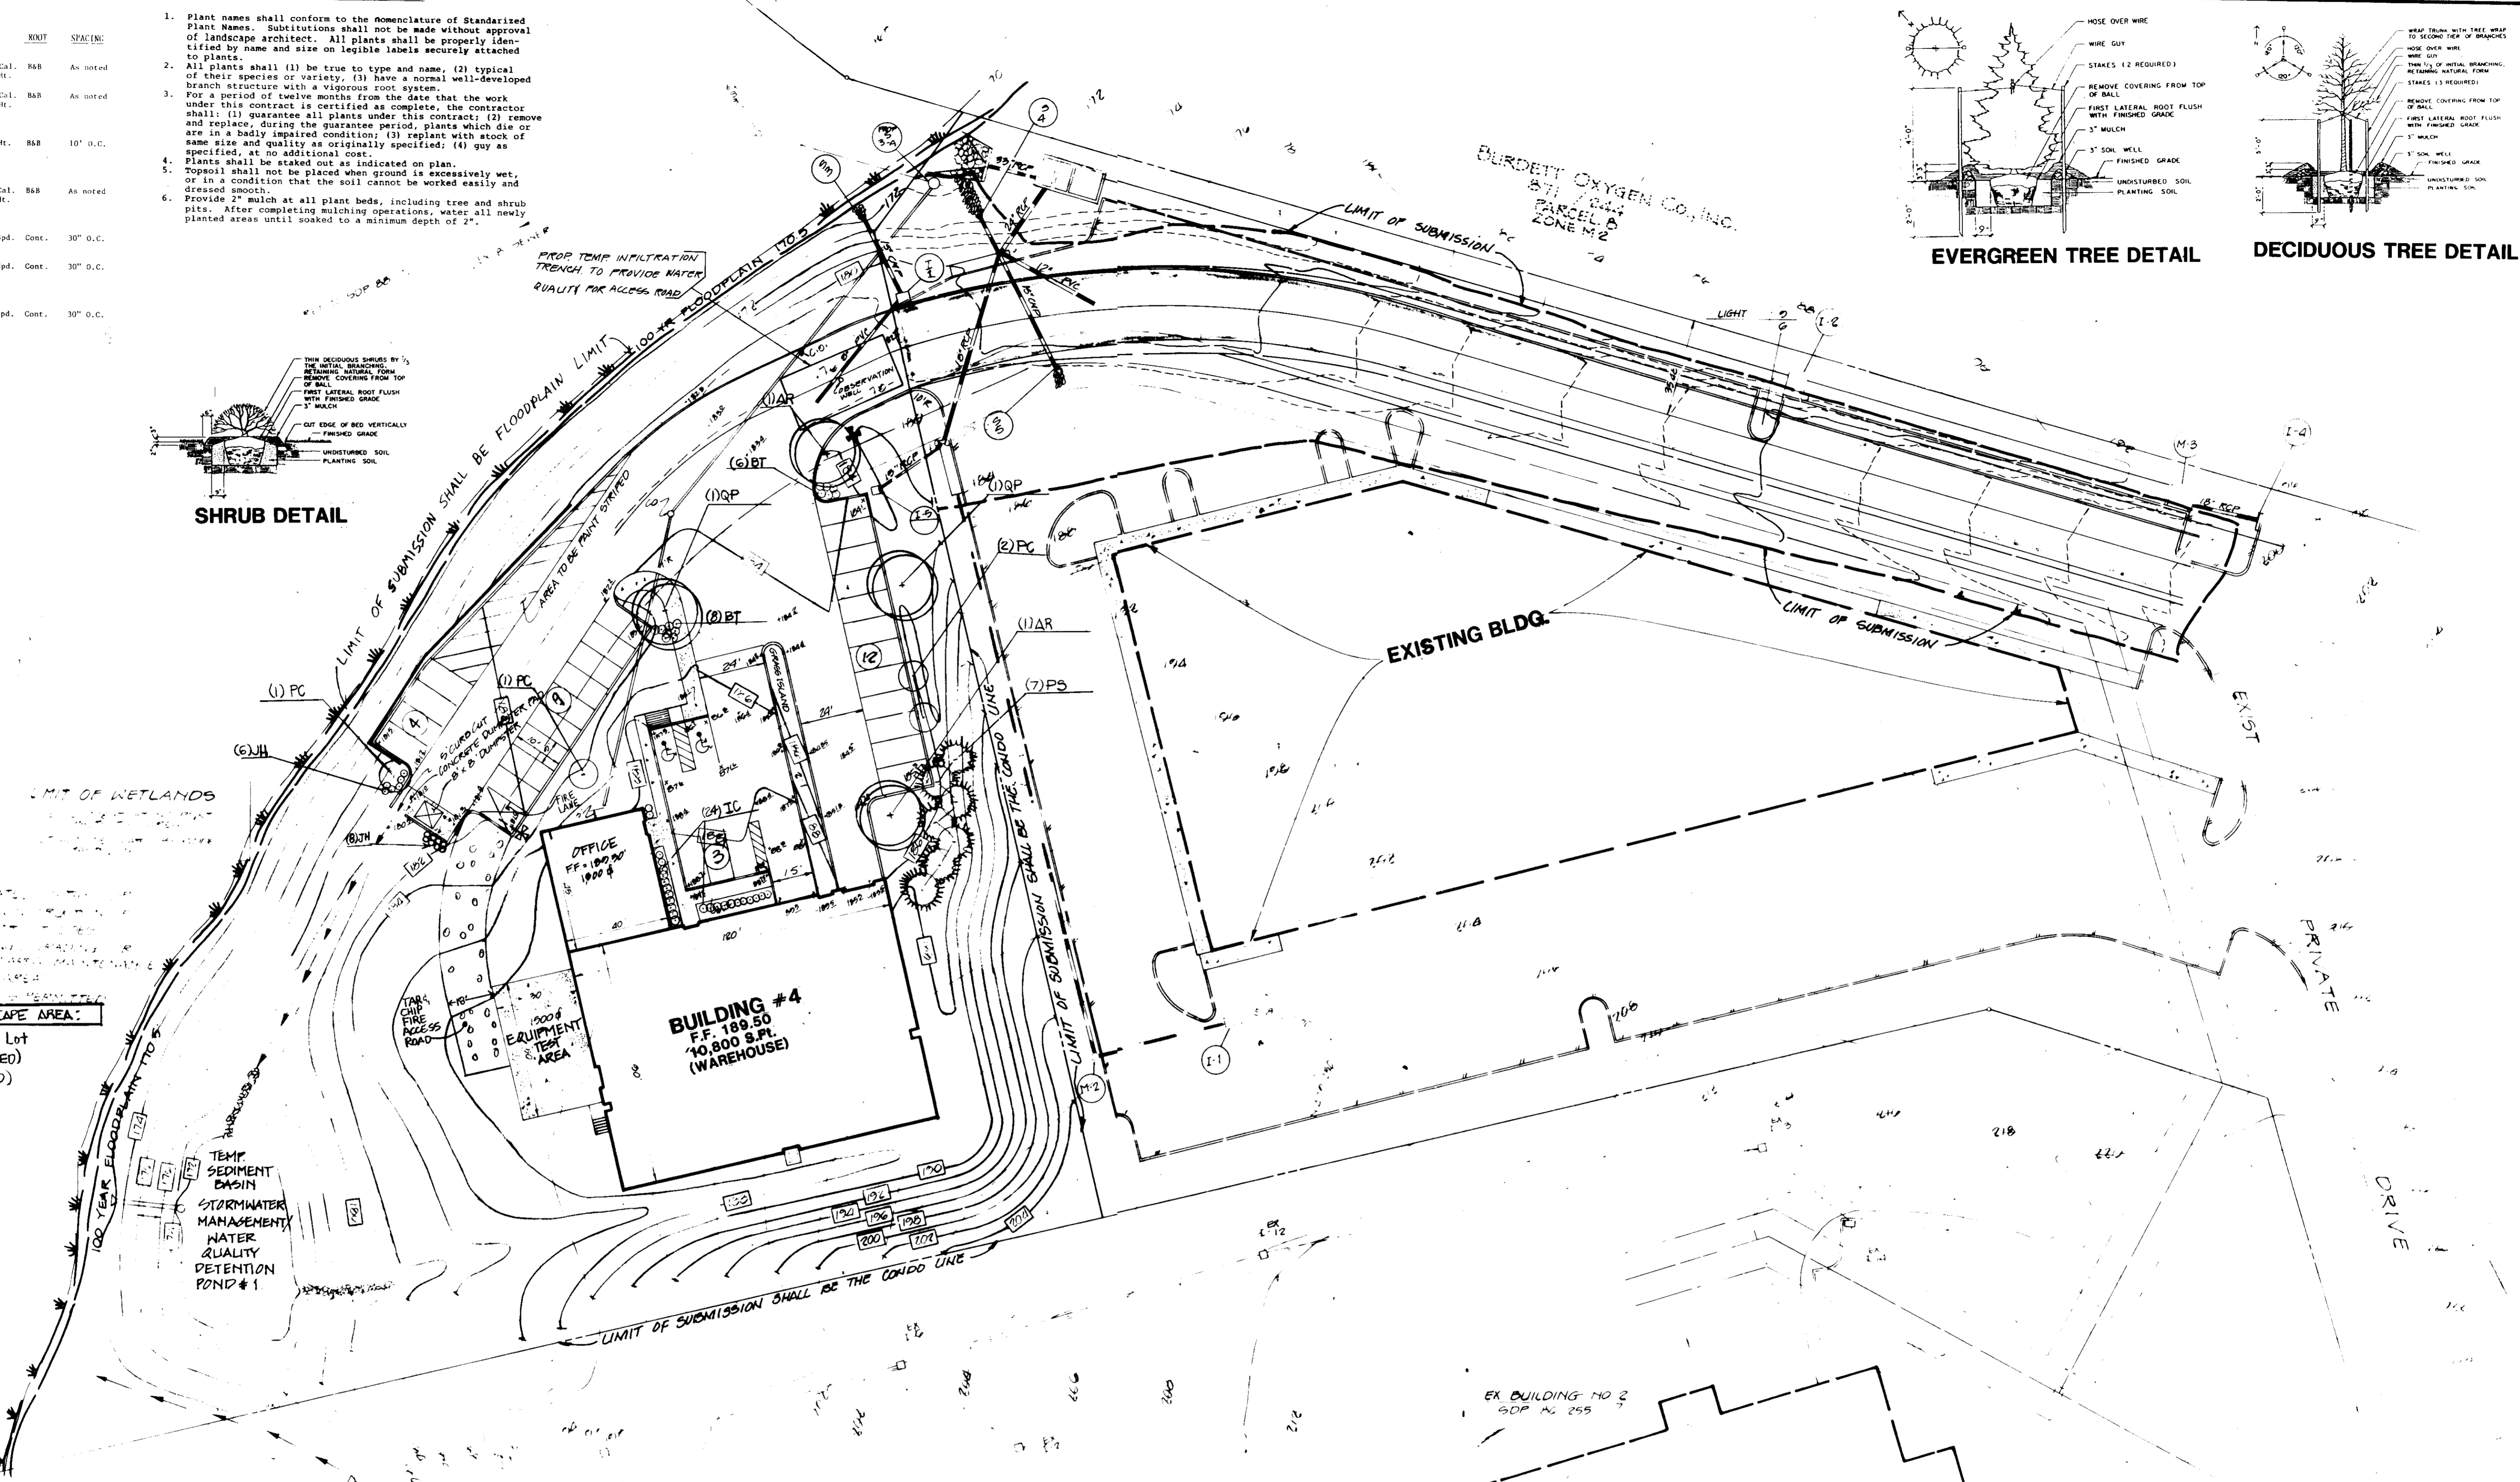

THIS PLAN FOR LANDSCAPE USE ONLY

Richard C. Sander 3/11/91
Richard E. Sander 2/27/91

REVISION	REVISION

Richard E. Sander 2/12/91
 DATE

Richard E. Sander 2-11-91
 DATE

Richard E. Sander 2/11/91
 DATE

ALL PROJECTS FOR WATER AND SEWERAGE SYSTEMS
 BY HOWARD COUNTY DEPARTMENT OF PUBLIC WORKS
 HEALTH DEPARTMENT

These plans have been reviewed for the Howard Soil Conservation District and meet the technical requirements for small pond construction, soil erosion and sediment control.

Richard E. Sander 11/27/90
 U.S. SOIL CONSERVATION SERVICE DATE

These plans for small pond construction, soil erosion and sediment control meet the requirements of the Howard Soil Conservation District.

Richard E. Sander 11/27/90
 HOWARD SOIL CONSERVATION DISTRICT DATE

ENGINEERS CERTIFICATE

I CERTIFY THAT THIS PLAN FOR EROSION & SEDIMENT CONTROL REPRESENTS A PRACTICAL AND WORKABLE PLAN BASED ON MY PERSONAL KNOWLEDGE OF THE SITE CONDITIONS AND THAT IT WAS PREPARED IN ACCORDANCE WITH THE REQUIREMENTS OF THE HOWARD SOIL CONSERVATION DISTRICT.

Richard C. Sander 11-15-90
 ENGINEERS SIGNATURE DATE

DEVELOPERS CERTIFICATE

I/WE CERTIFY THAT ALL DEVELOPMENT & CONSTRUCTION WILL BE DONE ACCORDING TO THIS PLAN, AND THAT ANY RESPONSIBLE PERSONNEL INVOLVED IN THE CONSTRUCTION PROJECT WILL HAVE A CERTIFICATE OF ATTENDANCE AT A DEPARTMENT OF NATURAL RESOURCES APPROVED TRAINING PROGRAM FOR THE CONTROL OF SEDIMENT & EROSION BEFORE BEGINNING THE PROJECT. I ALSO AUTHORIZE PERIODIC ON-SITE INSPECTION BY THE HOWARD SOIL CONSERVATION DISTRICT.

Richard C. Sander 11/15/90
 DEVELOPERS SIGNATURE DATE

PUMP & POWER WAREHOUSE
LANDSCAPE PLAN
 DORSEY RUN PARK-UNIT NO. 10
 BUILDING NO. 4

HOWARD COUNTY, MARYLAND
 TAX MAP 25 PARCEL 5
 9TH ELECTORAL DISTRICT

KIDDE CONSULTANTS, INC.











ENGINEERS • PLANNERS • SURVEYORS

11/27/91
 DESIGNED BY: DVO
 CHECKED BY: DVO
 DRAWN BY: SCH, Q/S



Richard C. Sander
 PROFESSIONAL ENGINEER

DATE 22 MAY 90 SCALE 1"=30'

SDP 90-207

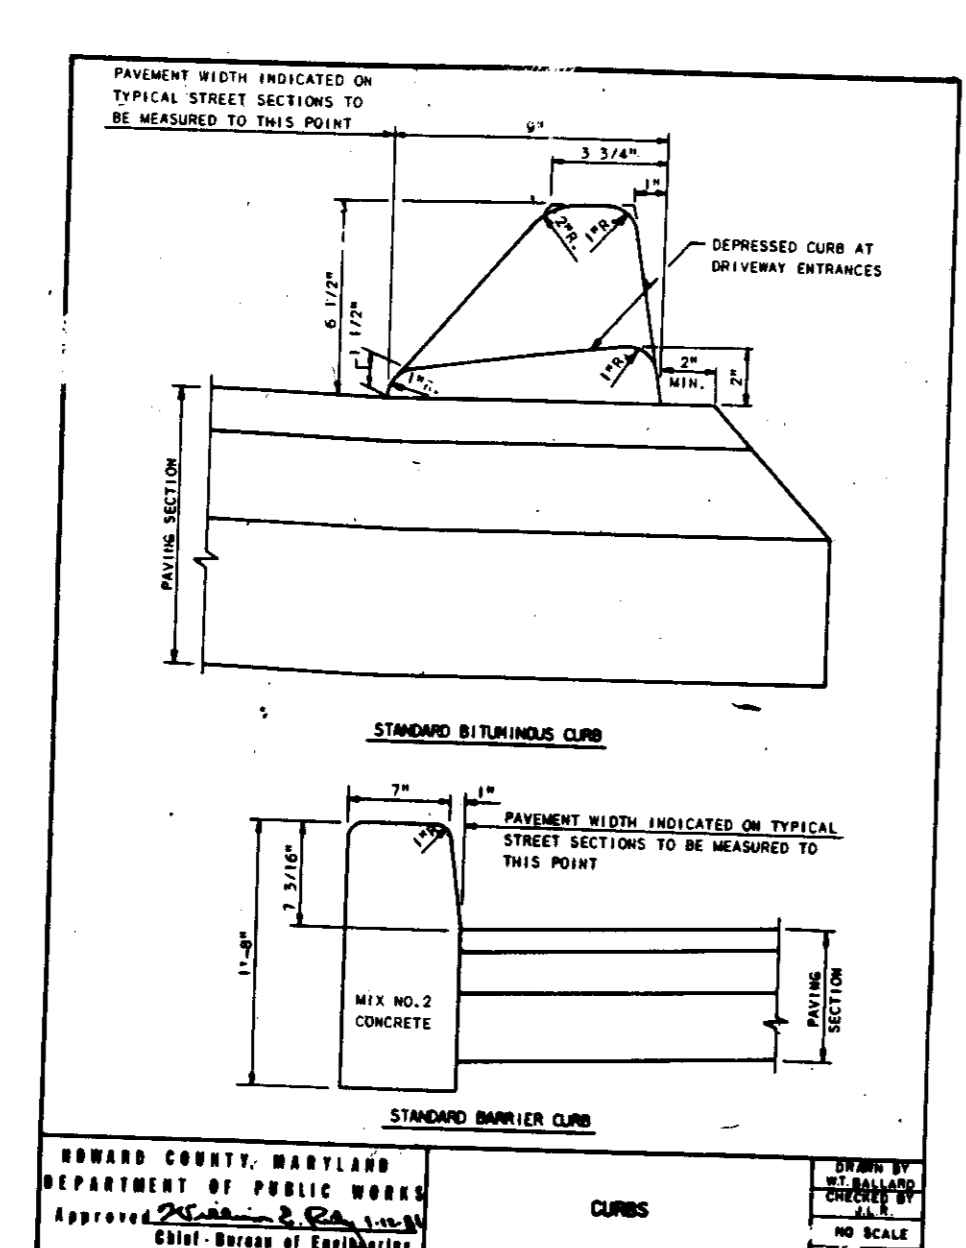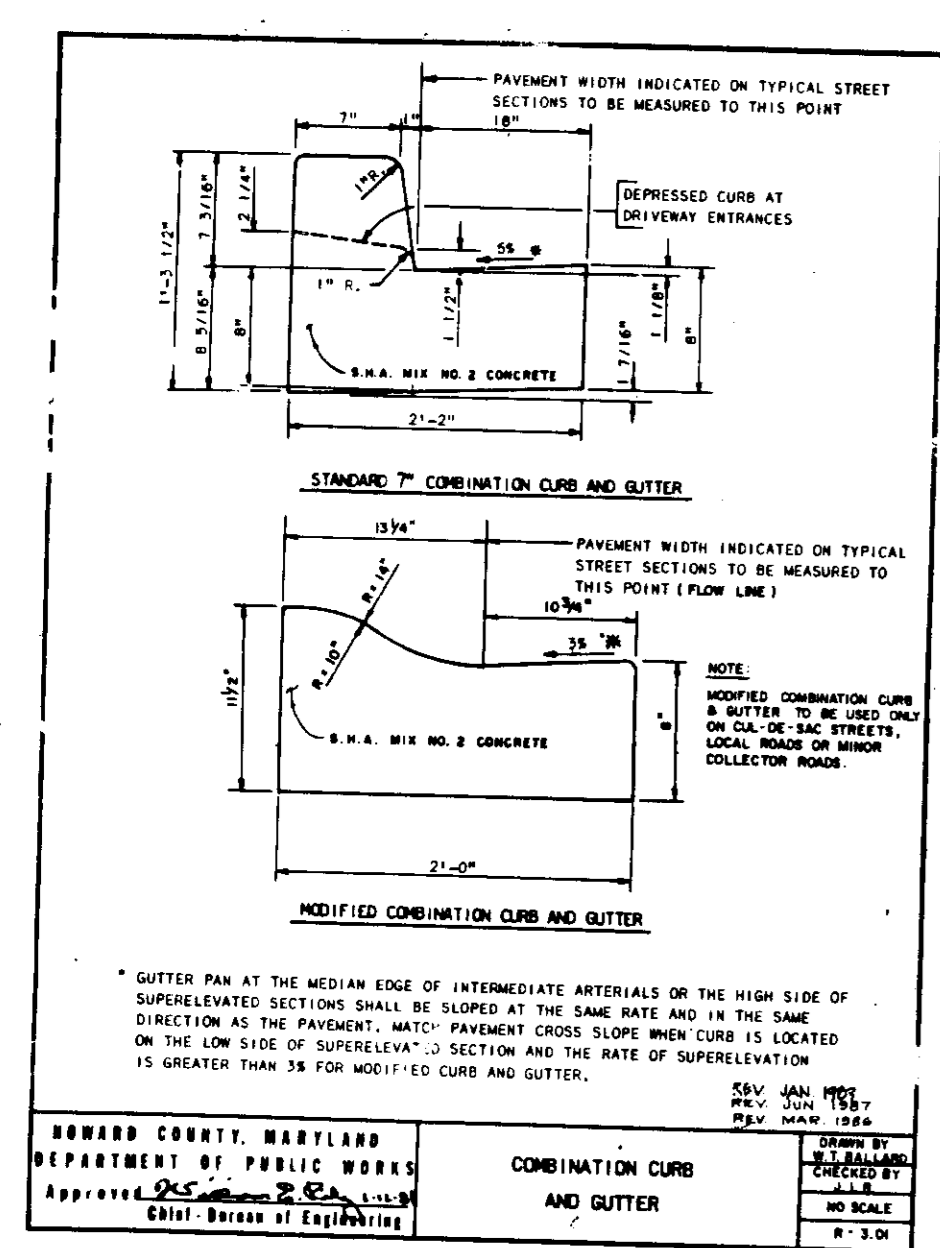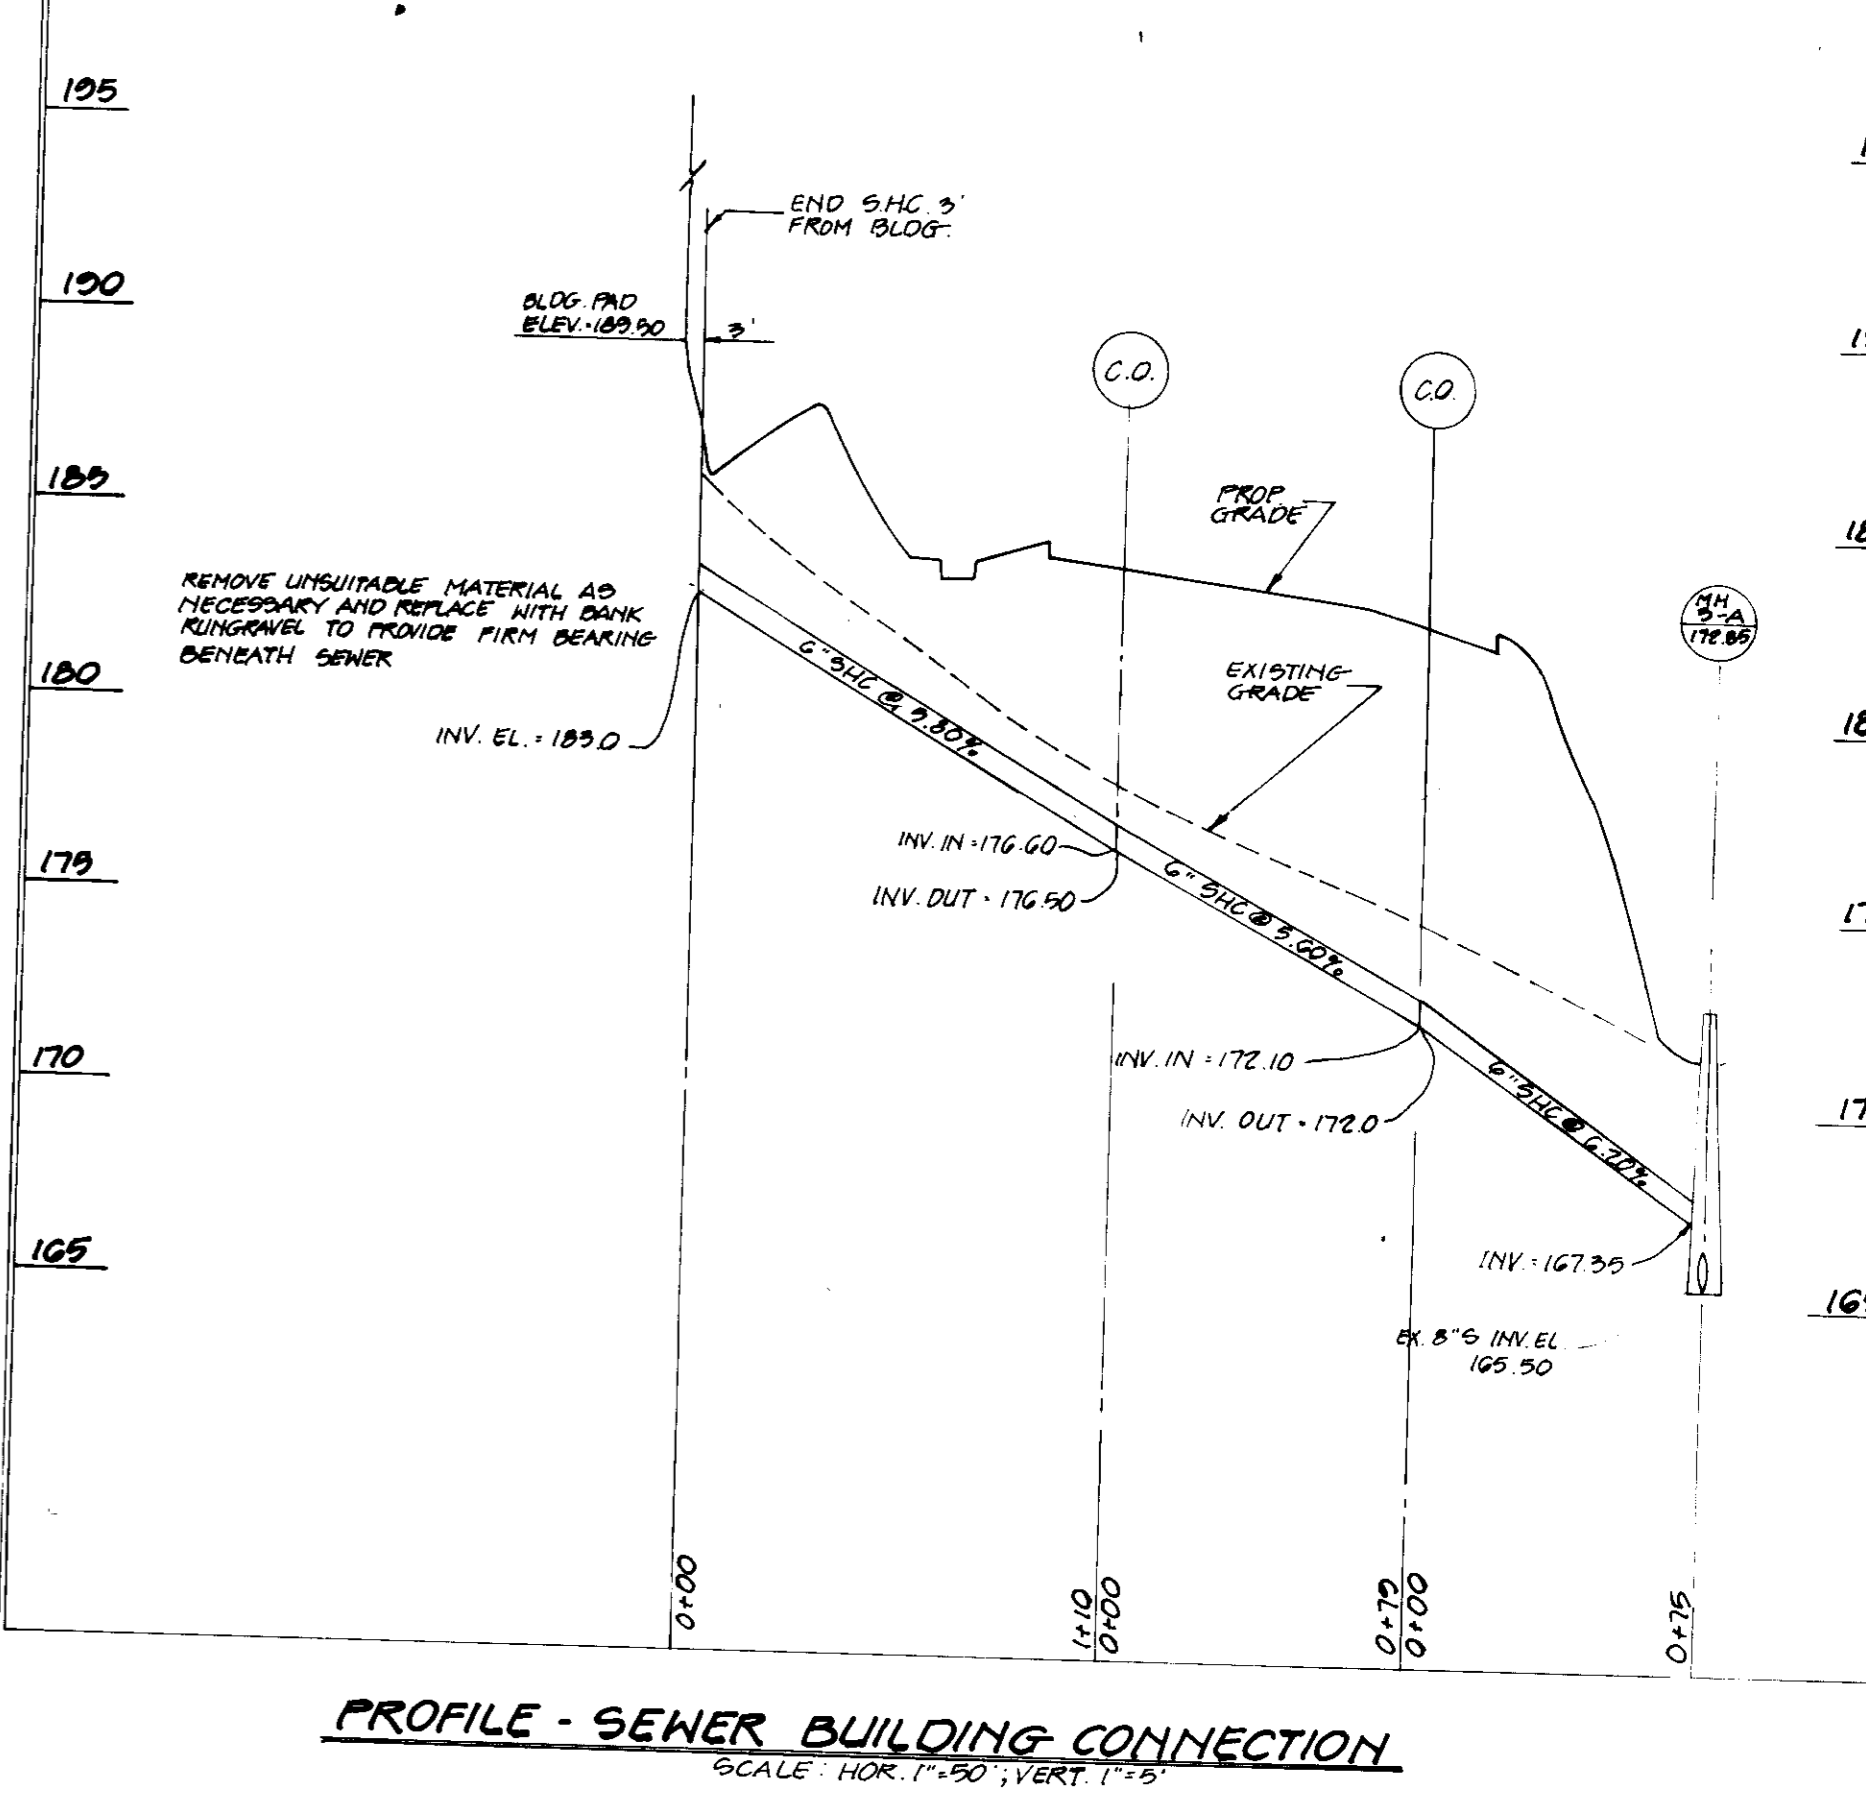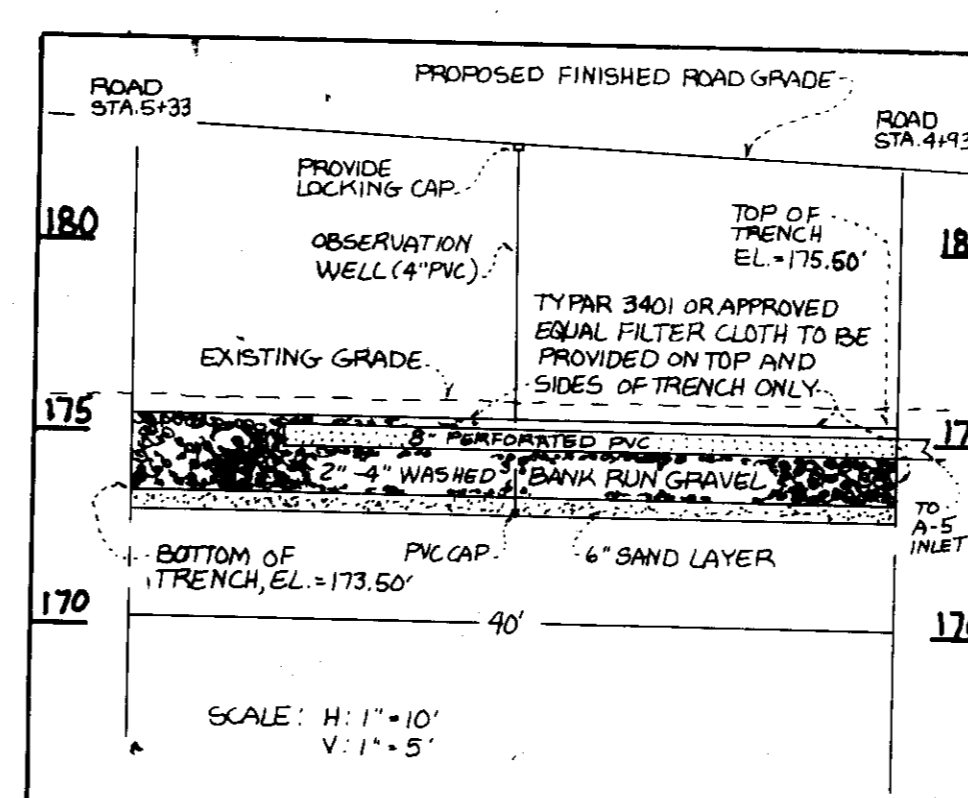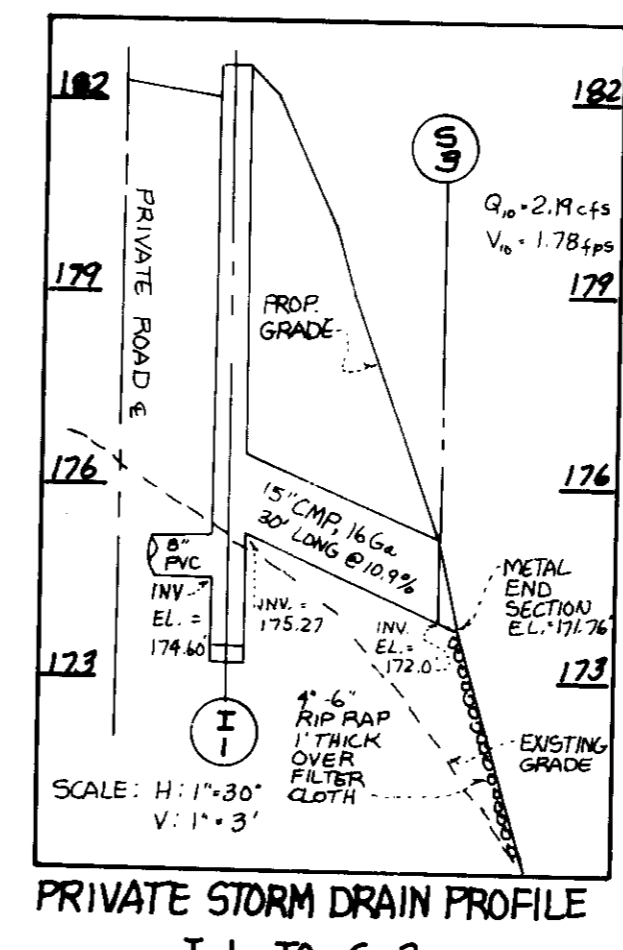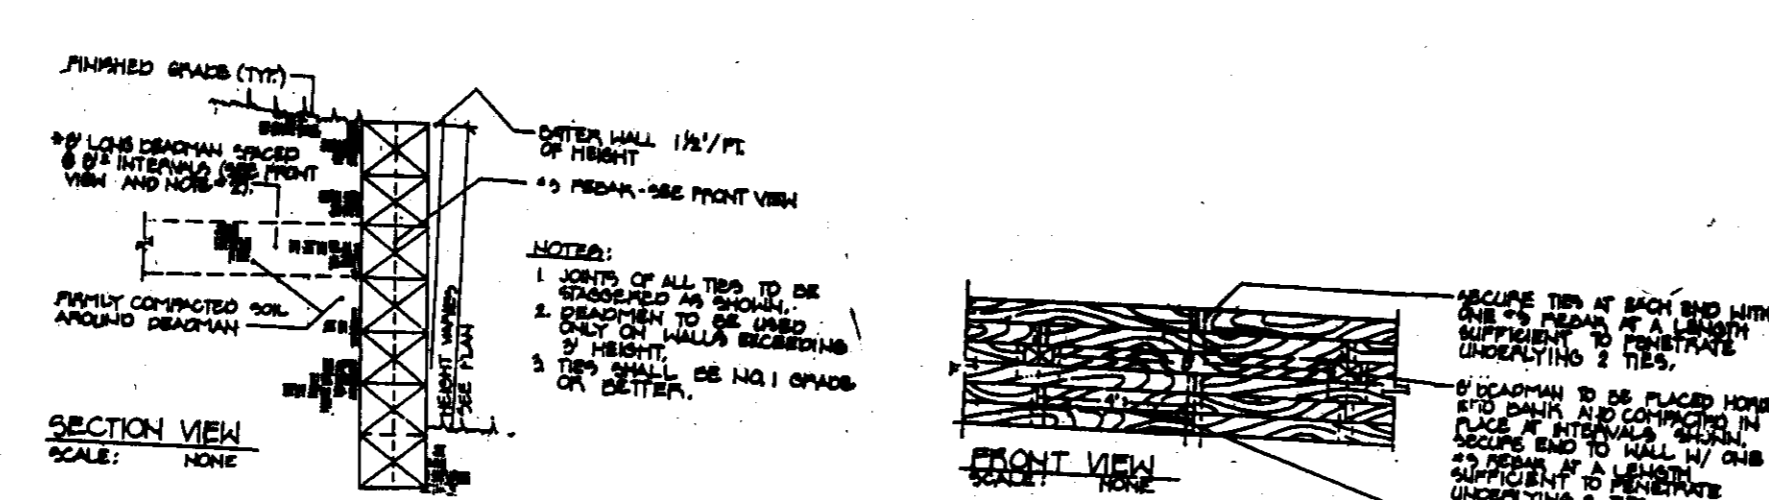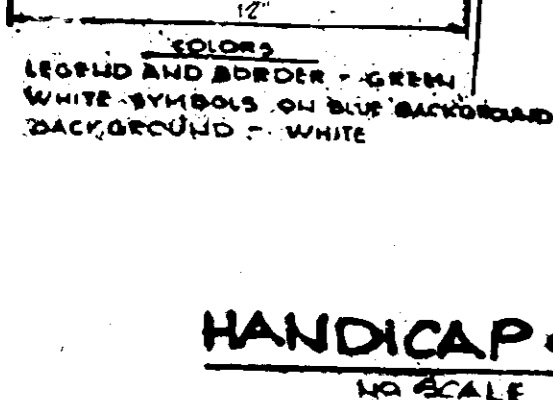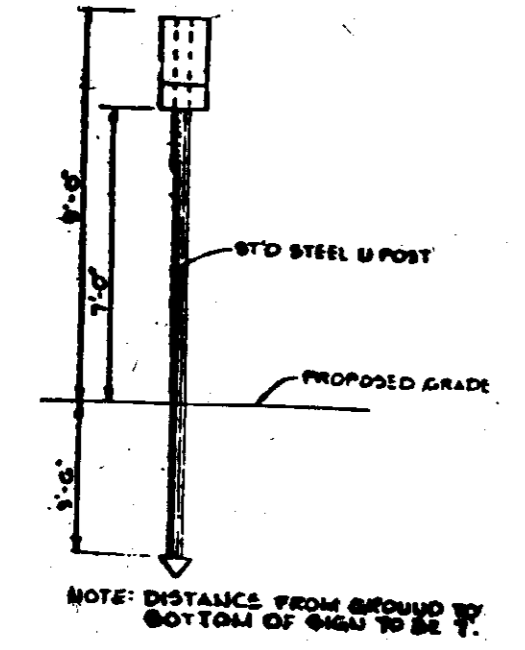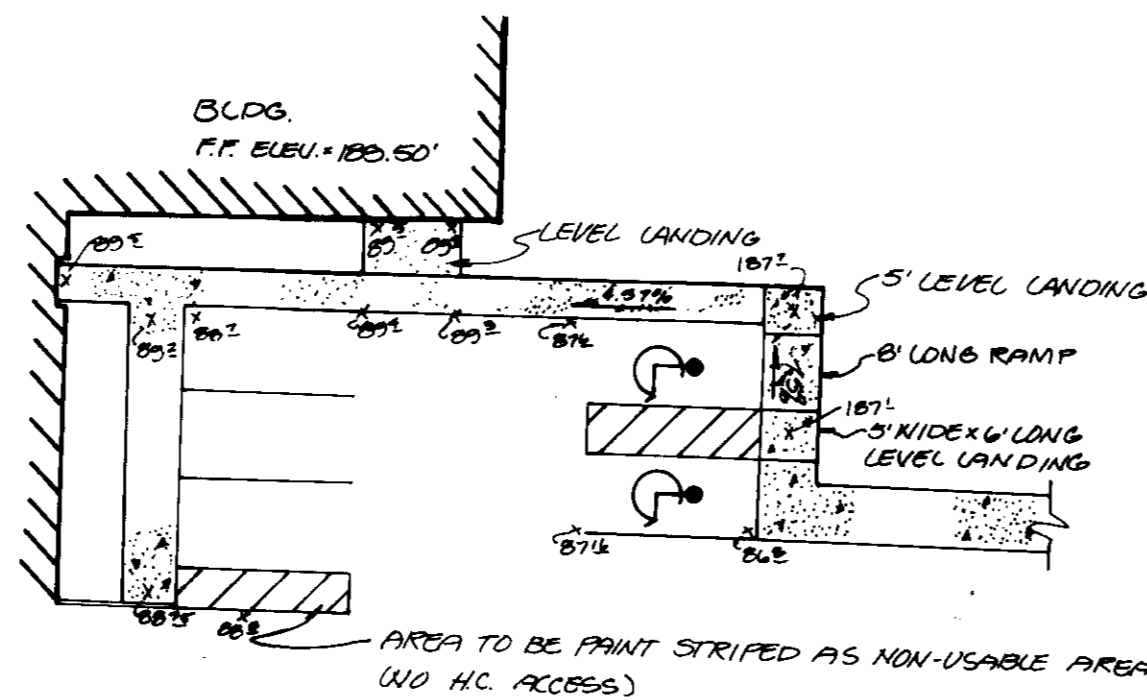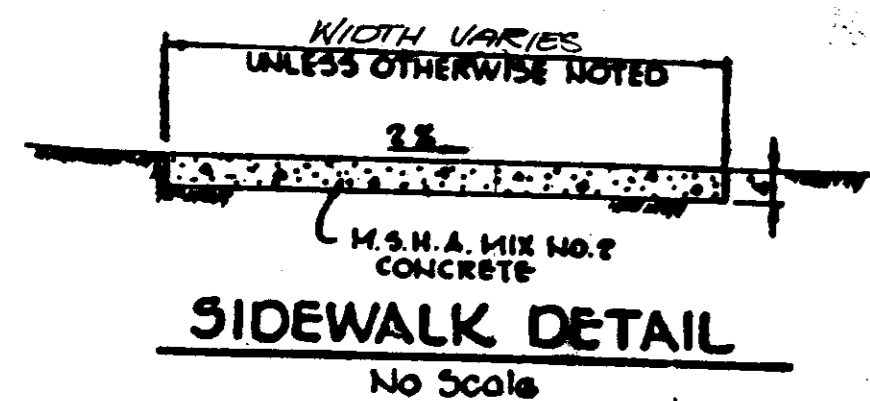

SECTION NUMBER	ROAD AND STREET CLASSIFICATION	PAVEMENT MATERIALS	
P-1	PARKING AREAS AND TRAVELWAYS APARTMENTS AND COMMERCIAL-INDUSTRIAL ZONES WITH NO HEAVY TRUCKS	FULL DEPTH BIT. CONC. ALTERNATE 1" BIT. CONC. SURFACE 4" BIT. CONC. BASE	GRANULAR BASE ALTERNATES 1" BIT. CONC. SURF. CE 2" BIT. CONC. BASE PRIME 3" CRUSHER RUN BASE COURSE OR 4" DENSE GRADED STABILIZED AGGREGATE BASE COURSE
P-2	RESIDENTIAL ZONES LOCAL, CUL-DE-SAC STS., ALLEYS AND INWAVE ROADS SERVING INDIVIDUAL LOTS PARKING AREAS APARTMENTS AND COMMERCIAL-INDUSTRIAL ZONES WITH NO MORE THAN 40 HEAVY TRUCKS PER DAY*	1 1/2" BIT. CONC. SURFACE 5" BIT. CONC. BASE	1 1/2" BIT. CONC. SURFACE 2 1/2" BIT. CONC. BASE PRIME 3" CRUSHER RUN BASE COURSE OR 4 1/2" DENSE GRADED STABILIZED AGGREGATE BASE COURSE
P-3	RESIDENTIAL ZONES MINOR AND MAJOR COLLECTORS COMMERCIAL-INDUSTRIAL ZONES LOCAL AND CUL-DE-SAC STREETS ALLEYS TRAVELWAYS APARTMENTS AND COMMERCIAL-INDUSTRIAL ZONES WITH MORE THAN 40 HEAVY TRUCKS PER DAY*	1 1/2" BIT. CONC. SURFACE 1 1/2" BIT. CONC. BASE 5" BIT. CONC. BASE	1 1/2" BIT. CONC. SURFACE 4 1/2" BIT. CONC. BASE PRIME 6" CRUSHER RUN BASE COURSE OR 4 1/2" DENSE GRADED STABILIZED AGGREGATE BASE COURSE

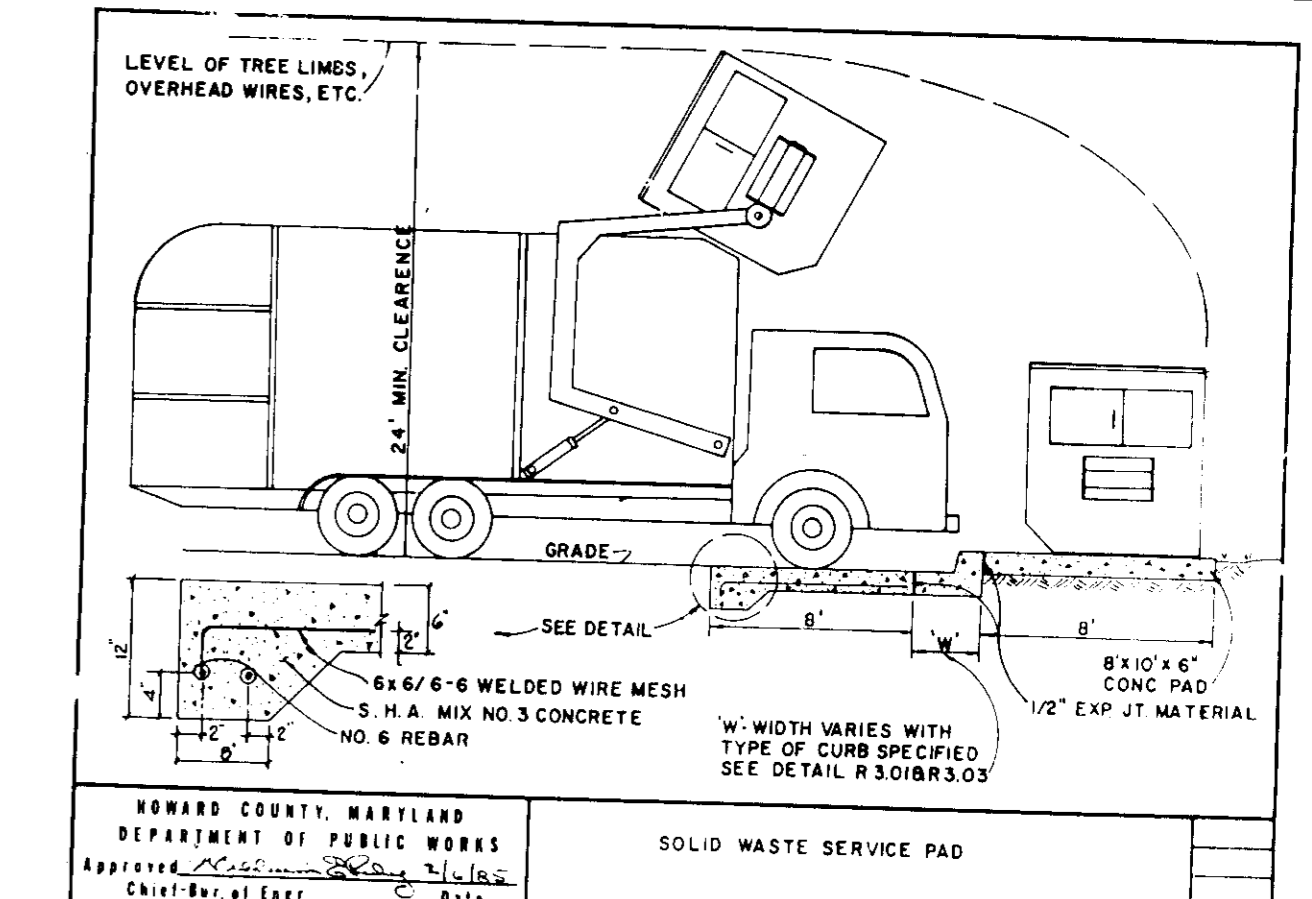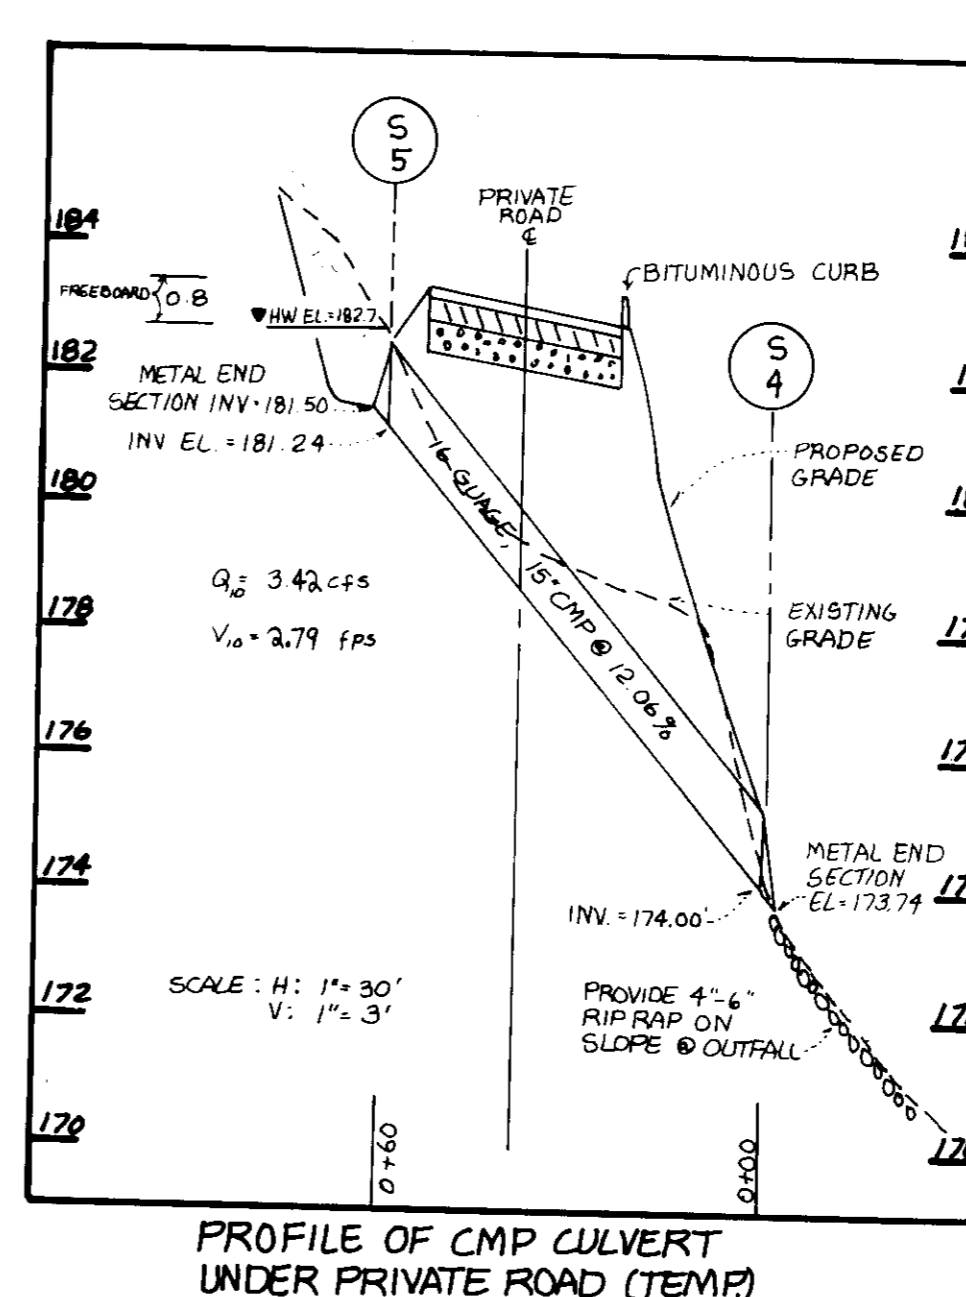

STRUCTURE NO.	INV. IN	INV. OUT	TOP ELEVATION	REMARKS
S-1	---	171.50	173.50	SWM POND OUTFALL METAL END SEC. NO. CO. STD. SD-5.61
S-2	---	---	174.77	SWM RISER SEE DETAIL SHEET 6 OF 9
S-3	172.00	171.76	173.25	METAL END SEC. NO. CO. STD. SD-5.61
S-4	174.00	173.74	175.25	METAL END SEC. NO. CO. STD. SD-5.61
S-5	181.50	181.24	182.49	METAL END SEC. NO. CO. STD. SD-5.61
I-1	---	175.27	182.54	MODIFIED TYPE A-5 INLET (SEE DETAIL SHEET 7 OF 9 & HO. CO. STD. SD-4.01)

DEPT. *Joseph R. Smith* 3/1/91
Marsha S. D'Amico 2/27/91

APPROVED BY: *Paul J. Sapan* 2/18/91
William E. Riley 2-11-91
John M. ... 2/15/91

REVIEWED FOR HOWARD SOIL CONSERVATION AND MEETS TECHNICAL REQUIREMENTS
James M. Helm 11/27/90
US SOIL CONSERVATION SERVICE DATE

ENGINEERS CERTIFICATE
I CERTIFY THAT THIS PLAN FOR EROSION & SEDIMENT CONTROL REPRESENTS A PRACTICAL AND WORKABLE PLAN BASED ON MY PERSONAL KNOWLEDGE OF THE SITE CONDITIONS AND THAT IT WAS PREPARED IN ACCORDANCE WITH THE REQUIREMENTS OF THE HOWARD SOIL CONSERVATION DISTRICT.
Richard C. Sander 11-15-90
ENGINEERS SIGNATURE DATE

DEVELOPERS CERTIFICATE
I/WE CERTIFY THAT ALL DEVELOPMENT & CONSTRUCTION WILL BE DONE ACCORDING TO THIS PLAN, AND THAT ANY RESPONSIBLE PERSONNEL INVOLVED IN THE CONSTRUCTION PROJECT WILL HAVE A CERTIFICATE OF ATTENDANCE AT A DEPARTMENT OF NATURAL RESOURCES APPROVED TRAINING PROGRAM FOR THE CONTROL OF SEDIMENT & EROSION BEFORE BEGINNING THE PROJECT. I ALSO AUTHORIZE PERIODIC ON-SITE INSPECTION BY THE HOWARD SOIL CONSERVATION DISTRICT.
Richard C. Sander 11/15/90
DEVELOPERS SIGNATURE DATE

**PUMP & POWER WAREHOUSE
SEWER PROFILES & CONSTRUCTION DETAILS**
DORSEY RUN PARK - UNIT NO. 1C
BUILDING NO. 4
HOWARD COUNTY, MARYLAND
TAX MAP 45 PARCEL 5
2ND ELECTION DISTRICT

KIDDE CONSULTANTS, INC.
ENGINEERS • PLANNERS • SURVEYORS
DATE MAY 1990 SCALE AS SHOWN

SOIL CONSERVATION SERVICE
CONSTRUCTION SPECIFICATIONS FOR PONDS

These specifications are applicable to ponds within the scope of the Standard Specification 376.

I. SITE PREPARATION

Areas designated for borrow areas, embankment, and structural works shall be cleared, grubbed and topped. All trees, vegetation, roots and other objectionable material shall be removed. Channel banks and steep banks shall be sloped to no steeper than 1:1.

Areas to be covered by the pond or reservoir will be cleared of all trees, brush, logs, fences, and other objectionable material unless otherwise designated on the plans. Trees, brush and stumps shall be cut approximately level with the ground surface.

All cleared and grubbed material shall be disposed of outside and below the limits of the dam and reservoir as directed by the owner or his representative. When specified, a sufficient quantity of "spoil" will be stockpiled in a suitable location for use on the embankment and other designated areas.

II. EMBANKMENT

Materials

The fill material shall be taken from approved designated borrow areas or areas. It shall be free of roots, stumps, wood, rubbish, oversize stones, iron ore or other objectionable material. The embankment shall be constructed to a minimum depth of 3 feet above the natural ground surface. The fill material shall be placed in layers along the length of the embankment. The fill material shall be compacted by hand, roller, or vibrator roller. Fill material shall contain sufficient moisture such that the required degree of compaction can be obtained with the equipment used.

Construction

The movement of the hauling and spreading equipment over the fill shall be controlled so that the entire surface of each lift shall be traversed by not less than one track of the equipment or compaction shall be achieved by a minimum of four passes of a sheepsfoot, rubber tire or vibratory roller. Fill material shall contain sufficient moisture such that the required degree of compaction can be obtained with the equipment used.

Where a minimum required density is specified, each layer of fill shall be compacted as necessary to obtain that density and is to be certified by the Engineer.

Cutoff Trench

Where specified, a cutoff trench shall be excavated along or parallel to the centerline of the embankment as shown on the drawings, with the minimum width being four feet. The trench shall be at least four feet or as shown on the plans. The side slopes of the trench shall be 1 to 1 or flatter. The backfill material for the cutoff trench shall be the most impervious material available and shall be compacted with equipment or rollers to secure maximum density and minimum permeability.

III. STRUCTURAL BACKFILL

Backfill material shall be of the type and quality conforming to that specified for the adjoining fill material. The fill shall be placed in horizontal layers not to exceed four inches in thickness and compacted by hand tamper or other compaction equipment. The material used to fill hand tampers or other compaction equipment shall be placed in layers not to exceed four inches in thickness and compacted by hand tamper or other compaction equipment. The material used to fill hand tampers or other compaction equipment shall be placed in layers not to exceed four inches in thickness and compacted by hand tamper or other compaction equipment.

IV. PIPE CONDUITS

All pipes shall be circular in cross section.

A. Corrugated Metal Pipe

1. Materials - (Steel Pipe) - This pipe and its appurtenances shall be galvanized and fully bituminous coated and shall conform to the requirements of AASHTO Specification M-196 Type A with water-tight coupling bands. Any bituminous coating damaged or otherwise removed shall be replaced with cold applied bituminous coating compound.

Steel pipes with polymeric coatings shall have a minimum coating thickness of 0.01 inch (10 mil) on both sides of the pipe. The following coatings are commercially available: Bason, Plastico, Plast-Coat, and Beth-Co-Loy. Coated corrugated steel pipe shall meet the requirements of AASHTO M-245 and M-246.

Materials - (Aluminized Steel Pipe) - This pipe and its appurtenances shall conform to the requirements of AASHTO Specification M-274-791 with watertight coupling bands or flanges.

Materials - (Aluminum Pipe) - This pipe and its appurtenances shall conform to the requirements of AASHTO Specification M-196 or M-111 with watertight coupling bands or flanges. Coupling bands, anti-seep collars, and sections, etc. must be composed of the same material as the pipe. Metals used for insulating material shall be at least 24 mils in thickness. Aluminum surfaces that are to be in contact with concrete shall be painted with one coat of zinc chromate primer. Hot dip galvanized bolts may be used for connections. The pH of the surrounding soils shall be less than 9 and greater than 4.





2. Connections - All connections with pipes must be completely watertight. The drain pipe or barrel connection to the riser shall be welded all around when the pipe and riser are metal. Watertight coupling bands or flanges shall be used at all joints. Anti-seep collars shall be connected to the pipe in such a manner as to be completely watertight. Diaple bands are not considered to be watertight.

3. Bedding - The pipe shall be firmly and uniformly bedded throughout its entire length. Where rock or soft, spongy or other unstable soil is encountered, all such material shall be removed and replaced with suitable earth compacted to provide adequate support.

4. Laying pipe - The pipe shall be placed with inside circumferential lap pointing downstream and with the longitudinal lap at the side.

5. Backfilling shall conform to structural backfill as shown above.

6. Other details (anti-seep collars, valves, etc.) shall be as shown on the drawings.

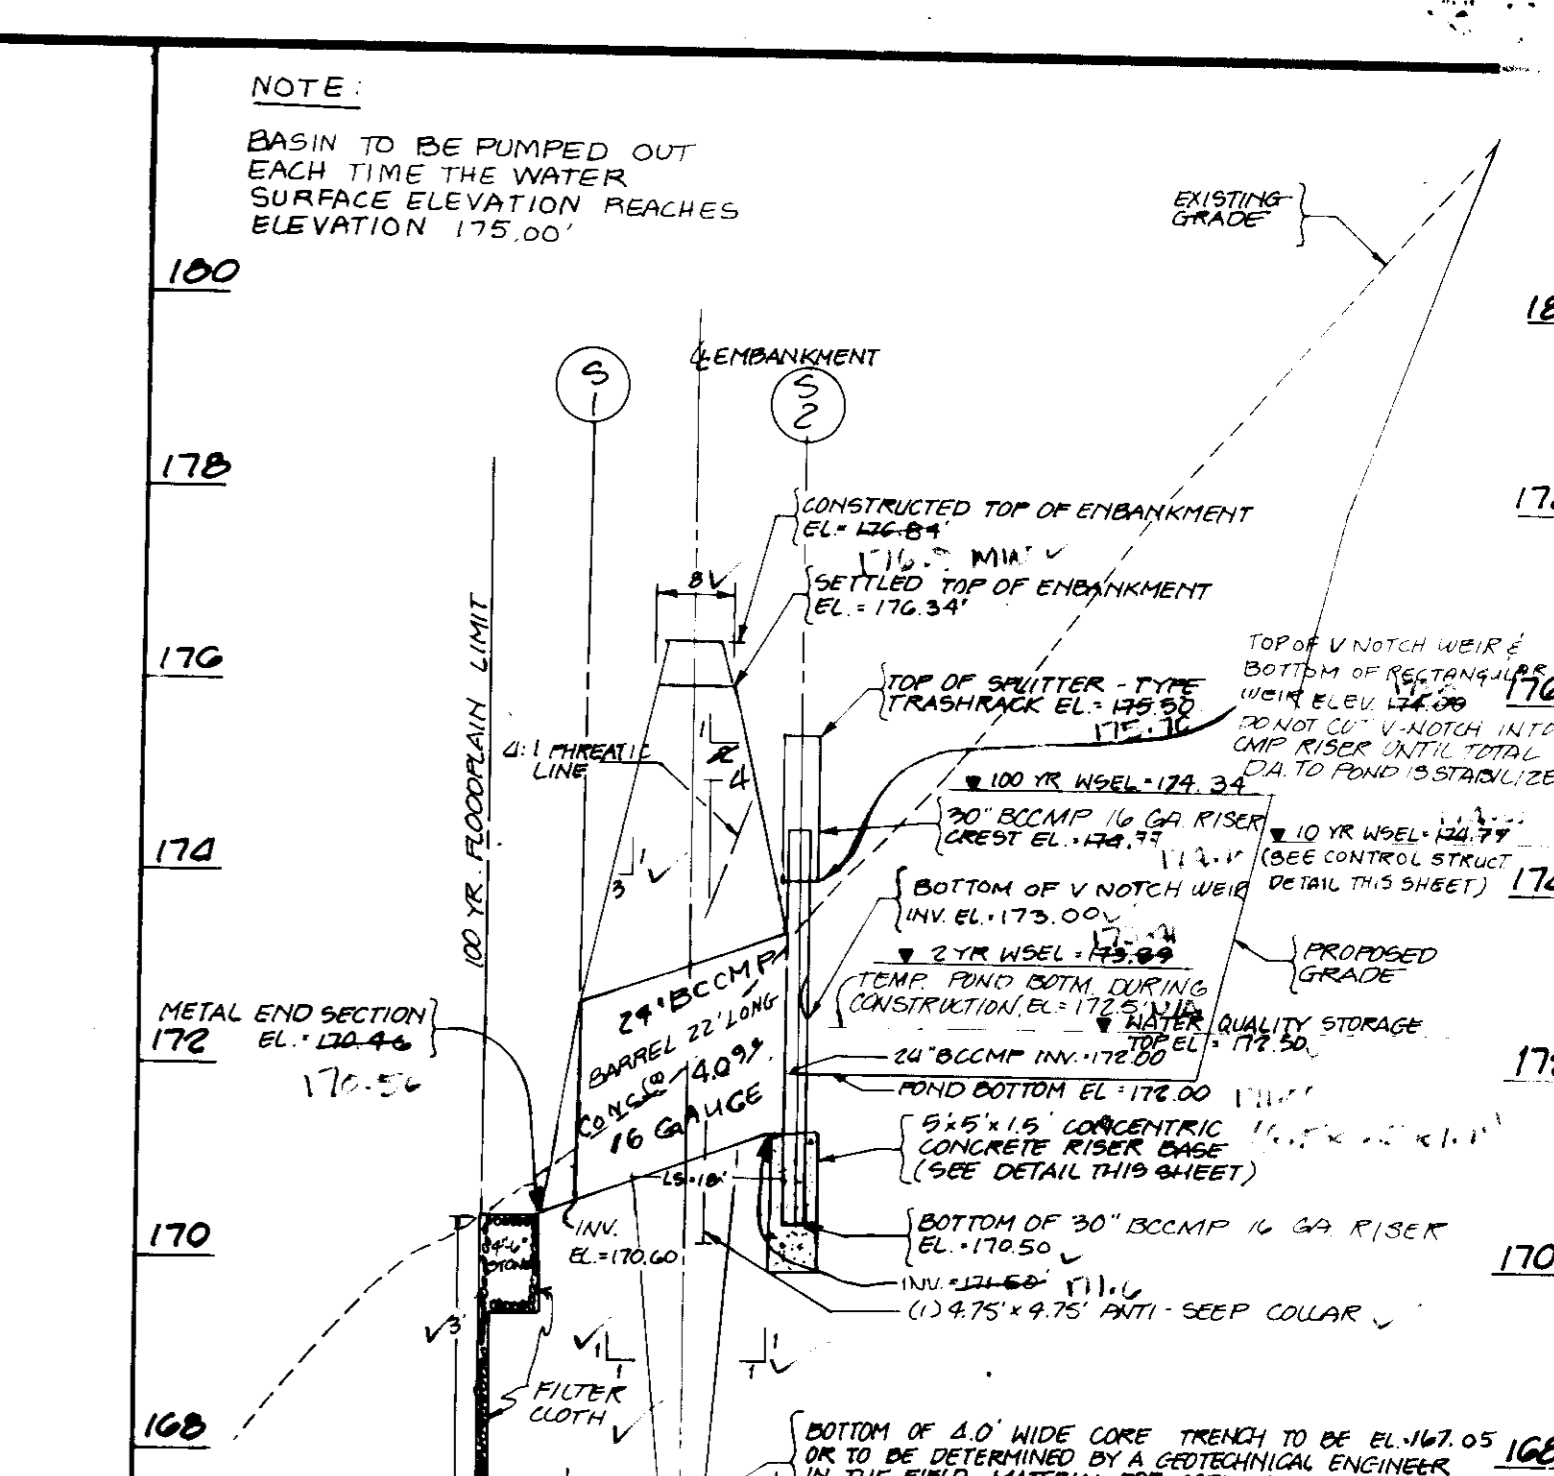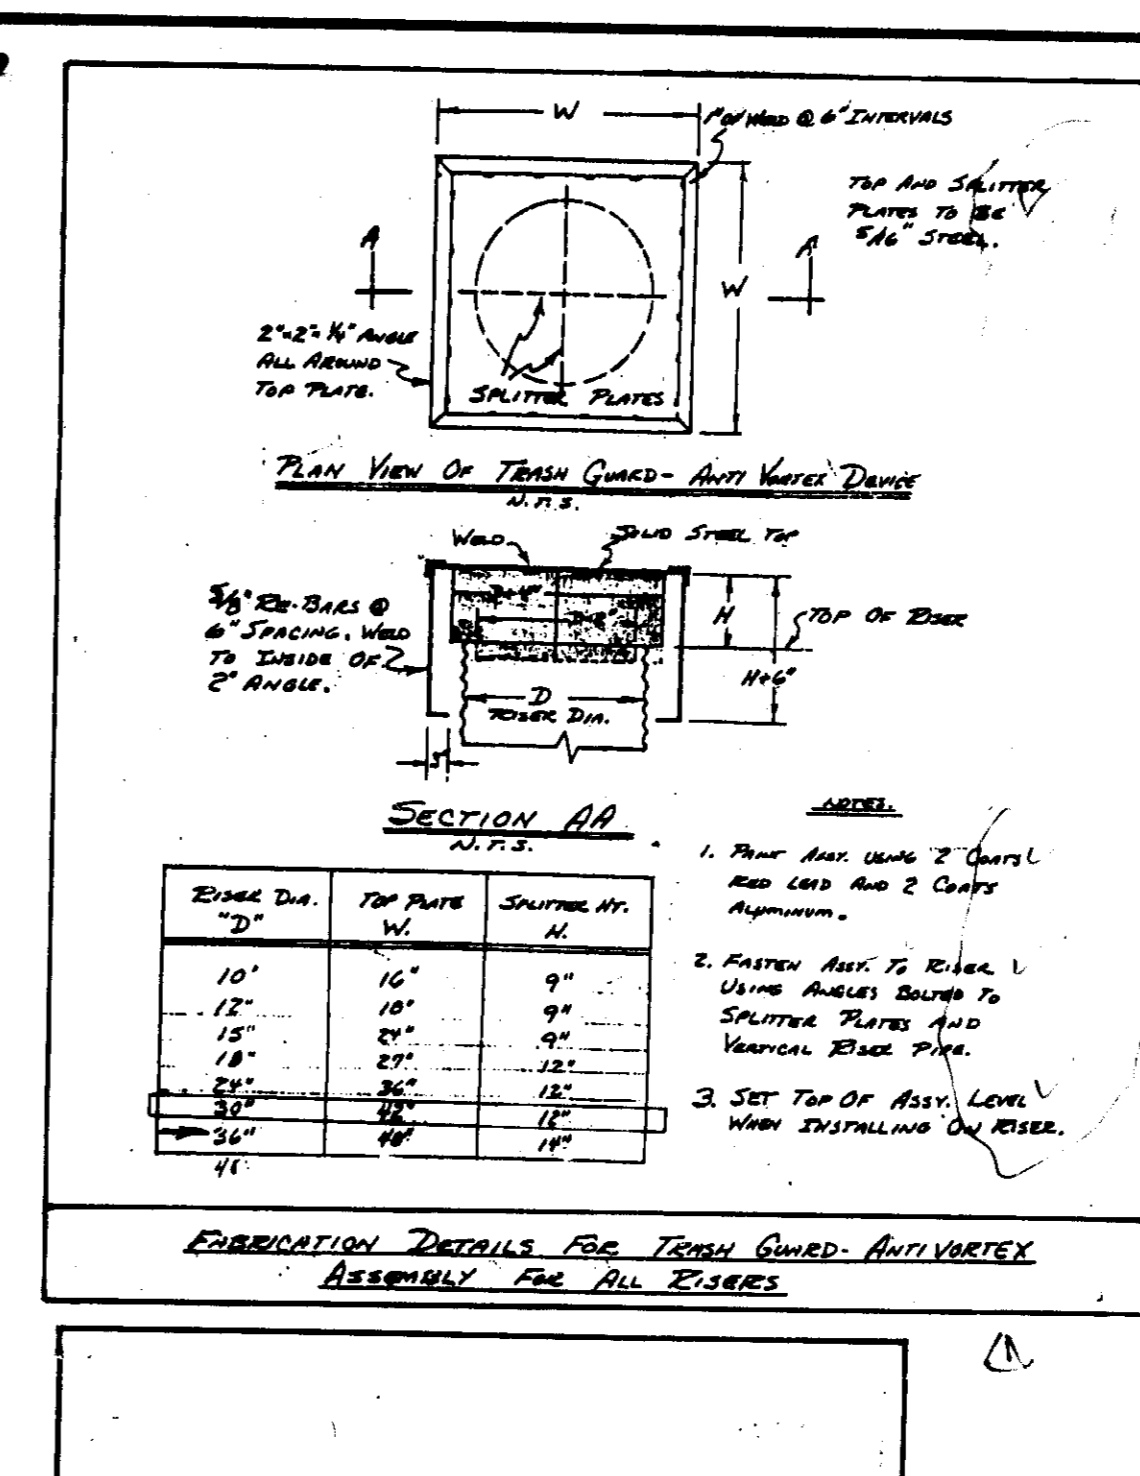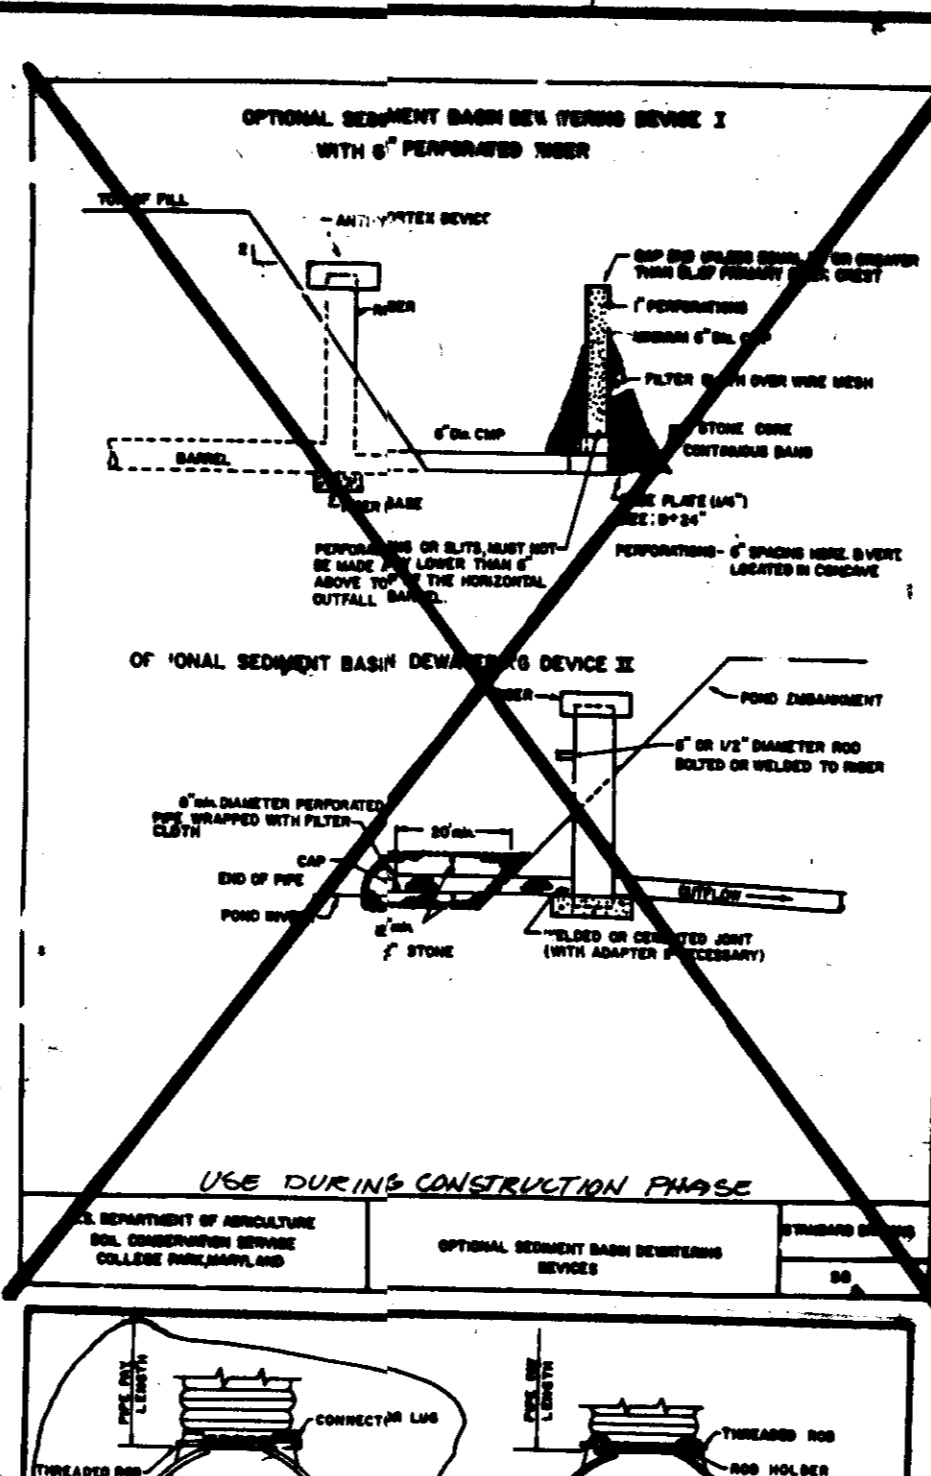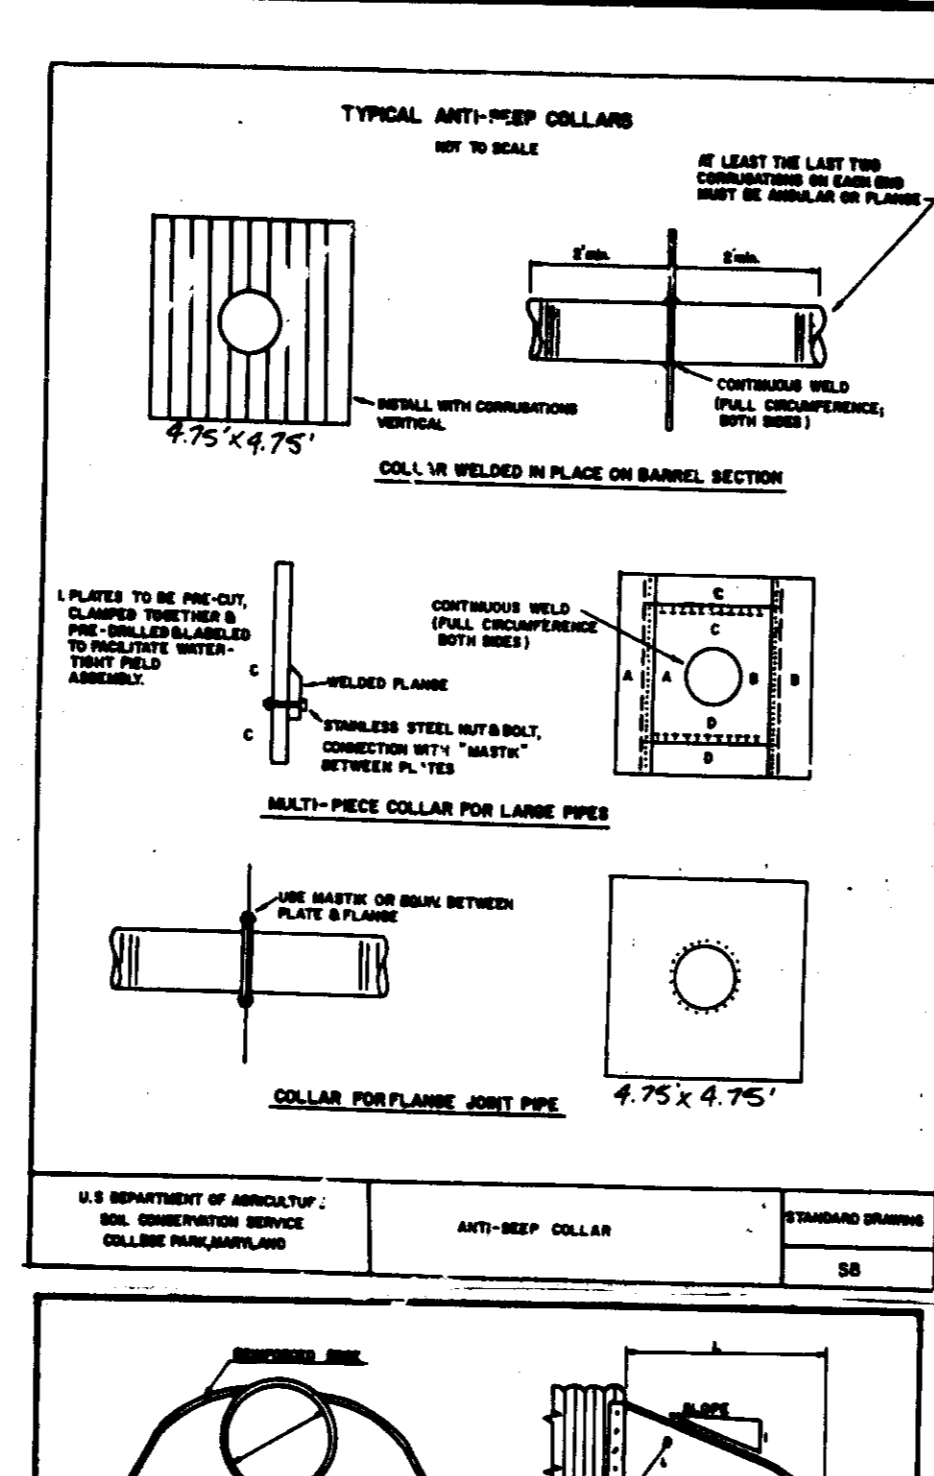

REVISION CHART

DATE	REVISION
3/11/91	APPROVED FOR PUBLIC WATER AND PUBLIC SEWERAGE, STORM DRAINAGE SYSTEMS AND PUBLIC ROADS
2/22/91	APPROVED FOR PUBLIC WATER AND PUBLIC SEWERAGE SYSTEMS
2/11/91	APPROVED FOR PUBLIC WATER AND PUBLIC SEWERAGE SYSTEMS
11/27/90	APPROVED FOR PUBLIC WATER AND PUBLIC SEWERAGE SYSTEMS
11/27/90	APPROVED FOR PUBLIC WATER AND PUBLIC SEWERAGE SYSTEMS


RECORD OF SOIL EXPLORATION

DORSEY RUN PARK
 HOWARD COUNTY, MD

NO.	DEPTH	DESCRIPTION	WETNESS	MOISTURE	CONC.
1	0-12"	Brown gray moist sandy silt with trace of mica, roots and gravel	W	142	
2	12-24"	[M]	W	142	
3	24-36"	[M]	W	142	
4	36-48"	Light brown moist silty sand with trace of mica	W	122	
5	48-60"	Gray moist silty sand with trace of mica	W	132	
6	60-72"	Gray moist silty sand with trace of mica	W	142	
7	72-84"	Gray moist silty sand with trace of mica	W	152	
8	84-96"	Gray moist silty sand with trace of mica	W	172	
9	96-108"	Gray moist silty sand with trace of mica	W	142	
10	108-120"	Bottom of test hole at 10.0'	W	142	

SEQUENCE OF CONSTRUCTION

- Obtain grading permit/revised grading permit. 1 Day
- Install all sediment controls including sediment basin, earth dikes, silt fence and trapezoidal ditch along access road. Install pipe from S-4 to S-5 and utilize existing sediment controls where possible. 1 Week
- Grade access road and site in accordance with the grading plan. Immediately stabilize all areas not to be roofed off or paved in accordance with the temporary stabilization notes. 2 Weeks
- Construct timber retaining wall on 2:1 slope adjacent to lower parking area. 3 Days
- Install 1-1 to S-3 and perforated pipe into temporary infiltration trench. Immediately block the inlet as per standard detail. 2 Days
- Construct temporary infiltration trench as per plan. 2 Days
- Install sewer and water house connections. 2 Days
- Construct building and the retaining wall next to loading area. 14 Months
- Install all curb and gutter and sidewalks onsite and bituminous curb along west side of access road. 1 Week
- Install all P-1, P-2, & P-3 paving. 1 Week
- Stabilize all remaining undisturbed areas. Once all disturbed areas are stabilized as per the permanent seeding notes, unblock inlet 1-1 and allow infiltration trench to function. 2 Days
- Convert temporary sediment basin into permanent stormwater detention/water quality pond. 3 Days
 - Excavate material from basin. Insure that permanent bottom elevation is 172.00.
 - Install rip-rap in swales entering the pond as shown on plan.
 - Stabilize the entire pond area in accordance with the permanent seeding notes on sheet 7 of 9.
- Cut V-notch weir into riser as per detail on this sheet. remove all sediment control devices and immediately stabilize all remaining disturbed areas in accordance with the permanent stabilization notes. 1 Week

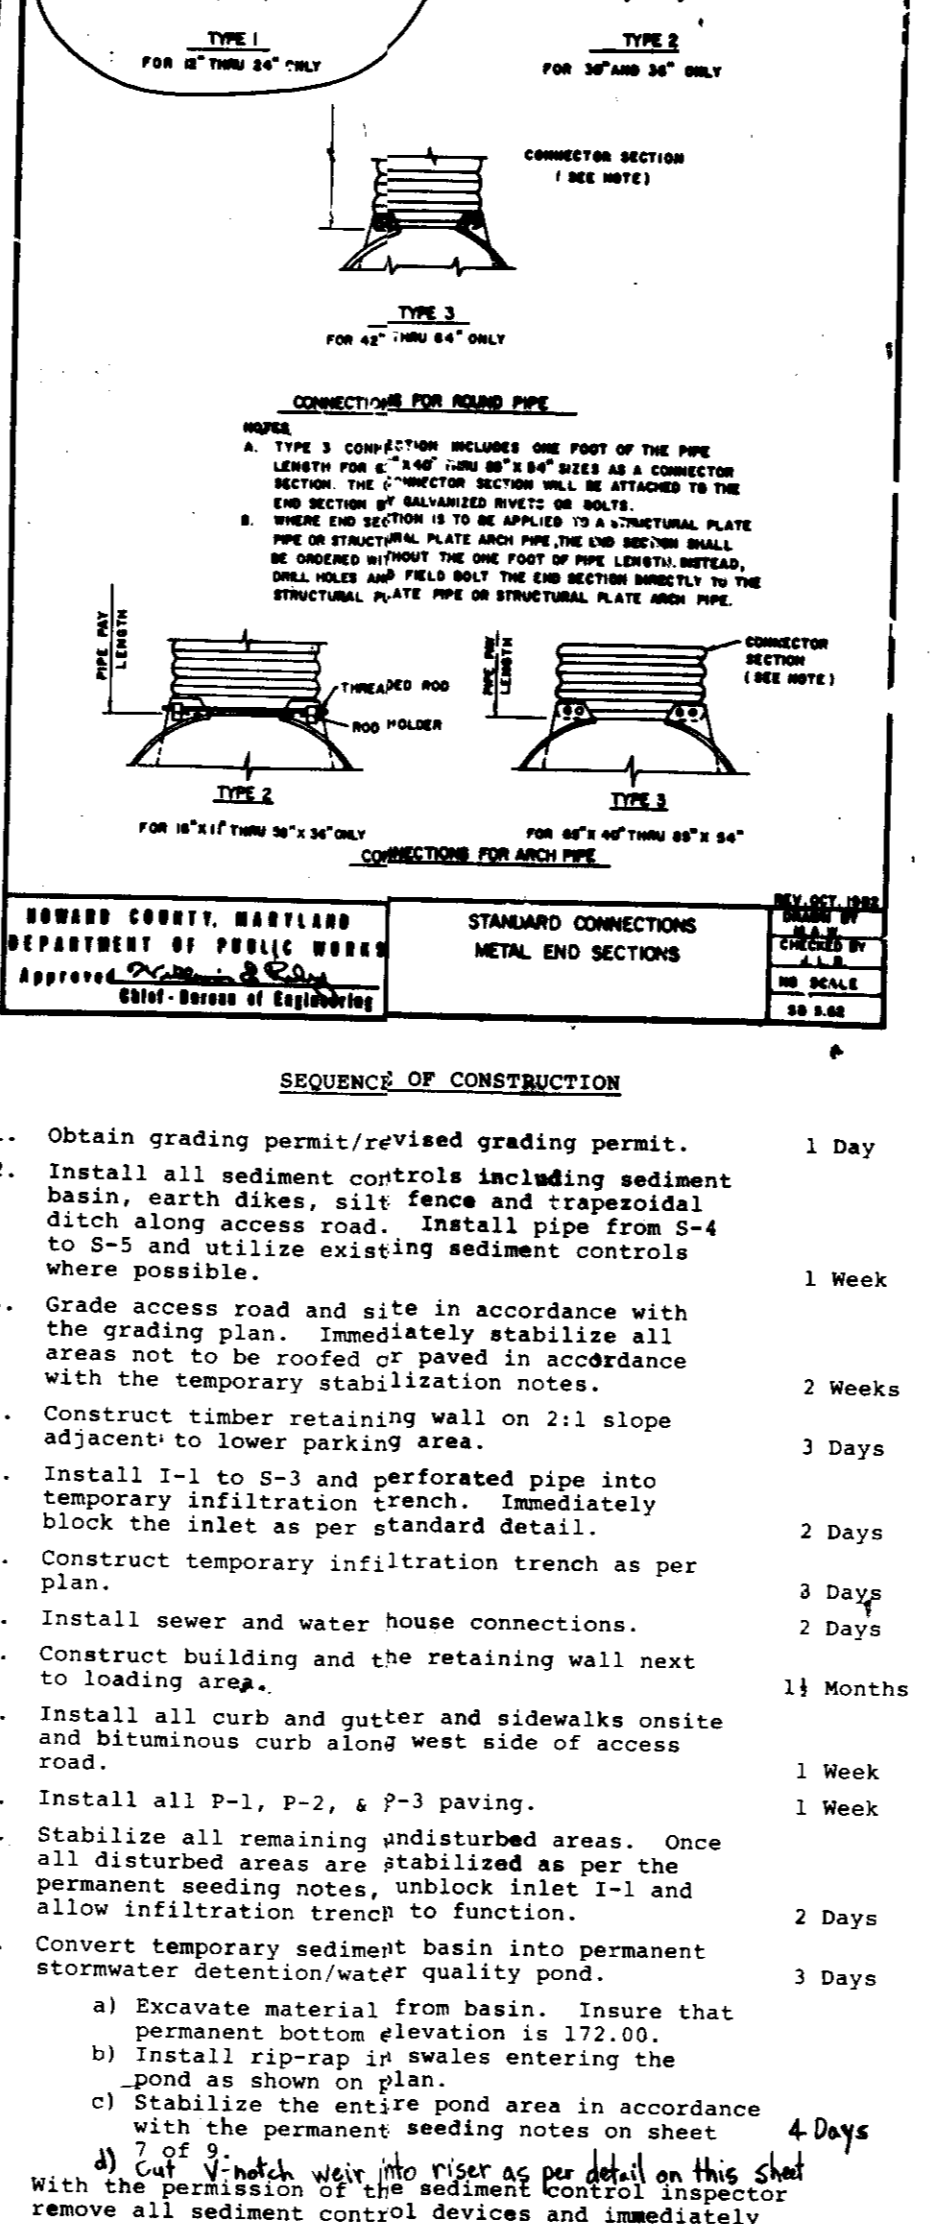


OWNER/DEVELOPER
 RICHARD & SUSAN SANDER
 233 CREEKWOOD DRIVE
 FASTERSVILLE, PA. 17047

ENGINEERS CERTIFICATE

"I certify that this plan for pond construction, erosion and sediment control represents a practical and workable plan based on my personal knowledge of the site conditions. This plan was prepared in accordance with the requirements of the Howard Soil Conservation District. I have notified the developer that he must provide the Howard Soil Conservation District with an "as-built" plan of the pond within 30 days of completion."

DEVELOPERS CERTIFICATE

"I certify that all development and/or construction will be done according to these plans, and that any responsible personnel involved in the construction project will have a Certificate of Attendance at a Department of Natural Resources Approved Training Program for the Control of Sediment and Erosion before beginning the project. I will provide the Howard Soil Conservation District with an "as-built" plan of the pond within 30 days of completion."

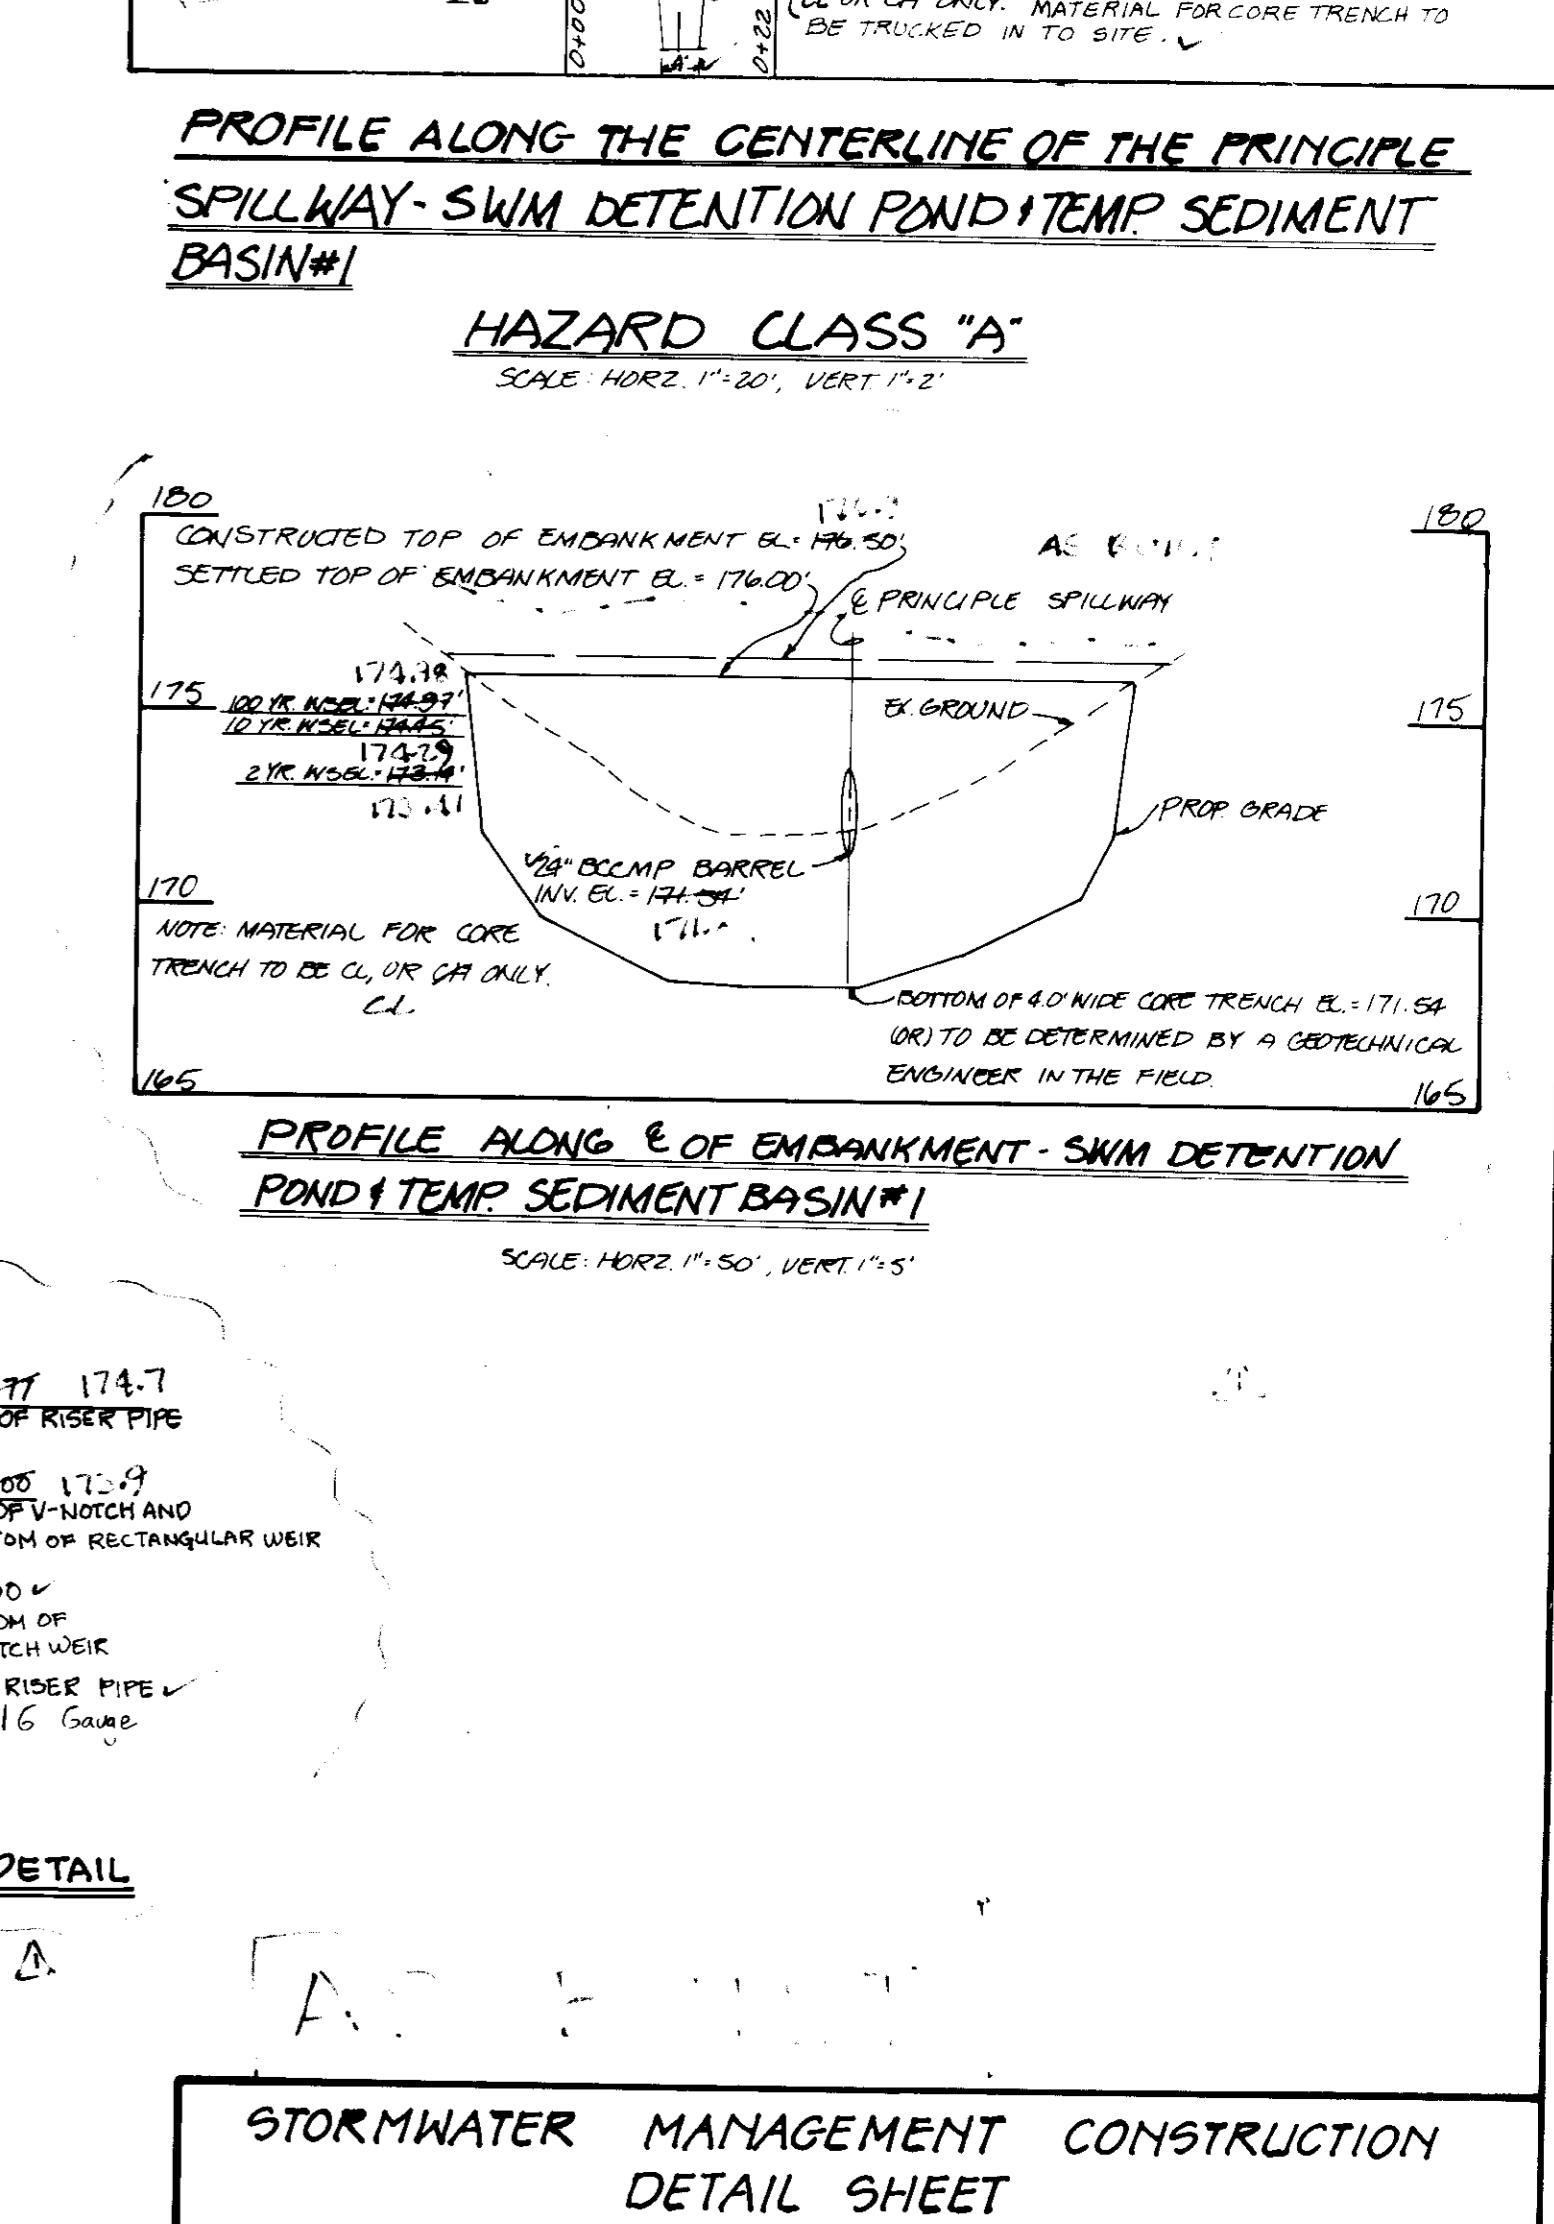

APPROVED: FOR PUBLIC WATER AND PUBLIC SEWERAGE, STORM DRAINAGE SYSTEMS AND PUBLIC ROADS
 HOWARD COUNTY DEPARTMENT OF PUBLIC WORKS

APPROVED: FOR PUBLIC WATER AND PUBLIC SEWERAGE SYSTEMS
 HOWARD COUNTY HEALTH DEPARTMENT

APPROVED: FOR PUBLIC WATER AND PUBLIC SEWERAGE SYSTEMS
 HOWARD COUNTY HEALTH DEPARTMENT

ENGINEERS CERTIFICATE

"I certify that this plan for pond construction, erosion and sediment control represents a practical and workable plan based on my personal knowledge of the site conditions. This plan was prepared in accordance with the requirements of the Howard Soil Conservation District. I have notified the developer that he must provide the Howard Soil Conservation District with an "as-built" plan of the pond within 30 days of completion."

DEVELOPERS CERTIFICATE

"I certify that all development and/or construction will be done according to these plans, and that any responsible personnel involved in the construction project will have a Certificate of Attendance at a Department of Natural Resources Approved Training Program for the Control of Sediment and Erosion before beginning the project. I will provide the Howard Soil Conservation District with an "as-built" plan of the pond within 30 days of completion."

REVISION CHART

DATE	REVISION
3/11/91	APPROVED FOR PUBLIC WATER AND PUBLIC SEWERAGE, STORM DRAINAGE SYSTEMS AND PUBLIC ROADS
2/22/91	APPROVED FOR PUBLIC WATER AND PUBLIC SEWERAGE SYSTEMS
2/11/91	APPROVED FOR PUBLIC WATER AND PUBLIC SEWERAGE SYSTEMS
11/27/90	APPROVED FOR PUBLIC WATER AND PUBLIC SEWERAGE SYSTEMS
11/27/90	APPROVED FOR PUBLIC WATER AND PUBLIC SEWERAGE SYSTEMS

RECORD OF SOIL EXPLORATION

DORSEY RUN PARK
 HOWARD COUNTY, MD

NO.	DEPTH	DESCRIPTION	WETNESS	MOISTURE	CONC.
1	0-12"	Brown gray moist sandy silt with trace of mica, roots and gravel	W	142	
2	12-24"	[M]	W	142	
3	24-36"	[M]	W	142	
4	36-48"	Light brown moist silty sand with trace of mica	W	122	
5	48-60"	Gray moist silty sand with trace of mica	W	132	
6	60-72"	Gray moist silty sand with trace of mica	W	142	
7	72-84"	Gray moist silty sand with trace of mica	W	152	
8	84-96"	Gray moist silty sand with trace of mica	W	172	
9	96-108"	Gray moist silty sand with trace of mica	W	142	
10	108-120"	Bottom of test hole at 10.0'	W	142	

OWNER/DEVELOPER
 RICHARD & SUSAN SANDER
 233 CREEKWOOD DRIVE
 FASTERSVILLE, PA. 17047

ENGINEERS CERTIFICATE

"I certify that this plan for pond construction, erosion and sediment control represents a practical and workable plan based on my personal knowledge of the site conditions. This plan was prepared in accordance with the requirements of the Howard Soil Conservation District. I have notified the developer that he must provide the Howard Soil Conservation District with an "as-built" plan of the pond within 30 days of completion."

DEVELOPERS CERTIFICATE

"I certify that all development and/or construction will be done according to these plans, and that any responsible personnel involved in the construction project will have a Certificate of Attendance at a Department of Natural Resources Approved Training Program for the Control of Sediment and Erosion before beginning the project. I will provide the Howard Soil Conservation District with an "as-built" plan of the pond within 30 days of completion."





STORMWATER MANAGEMENT CONSTRUCTION DETAIL SHEET
 DORSEY RUN PARK-UNIT NO. 1C
 BUILDING NO. 4
 HOWARD COUNTY, MARYLAND
 TAX MAP 45 PARCEL 9
 6TH ELECTION DISTRICT

KIDDE CONSULTANTS, INC.

ENGINEERS • PLANNERS • SURVEYORS

1100 WEST STREET SUITE 100 LAUREL MD 20646
 (301) 943-8271 FAX (301) 943-8086 FAX

DATE: 11/15/90
 DRAWN BY: B.S.J.K.
 CHECKED BY: B.S.J.K.
 DATE: MAY 1990

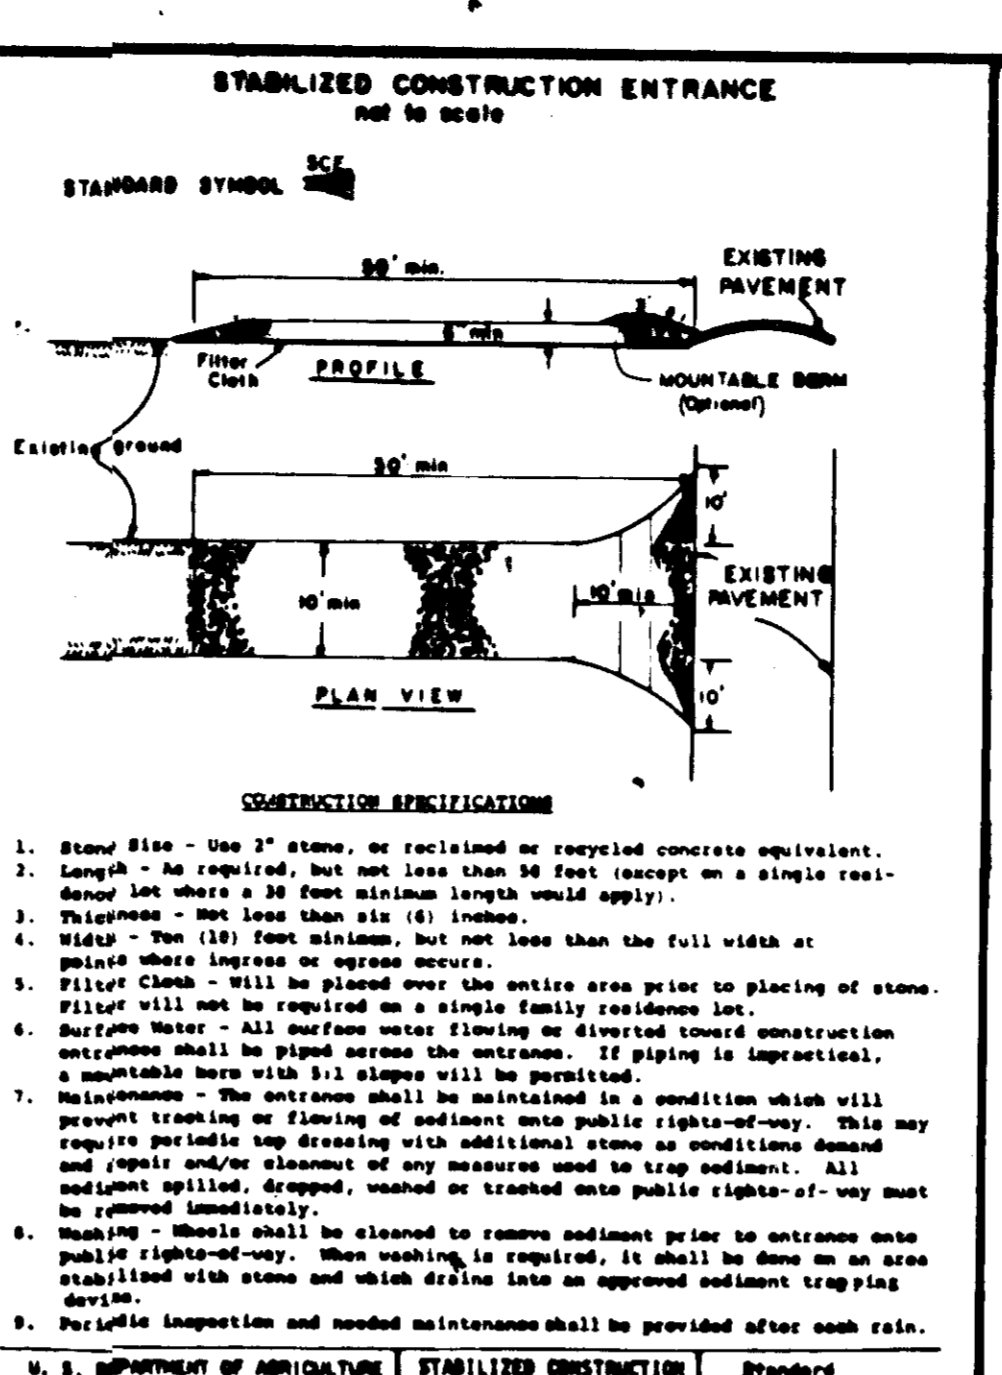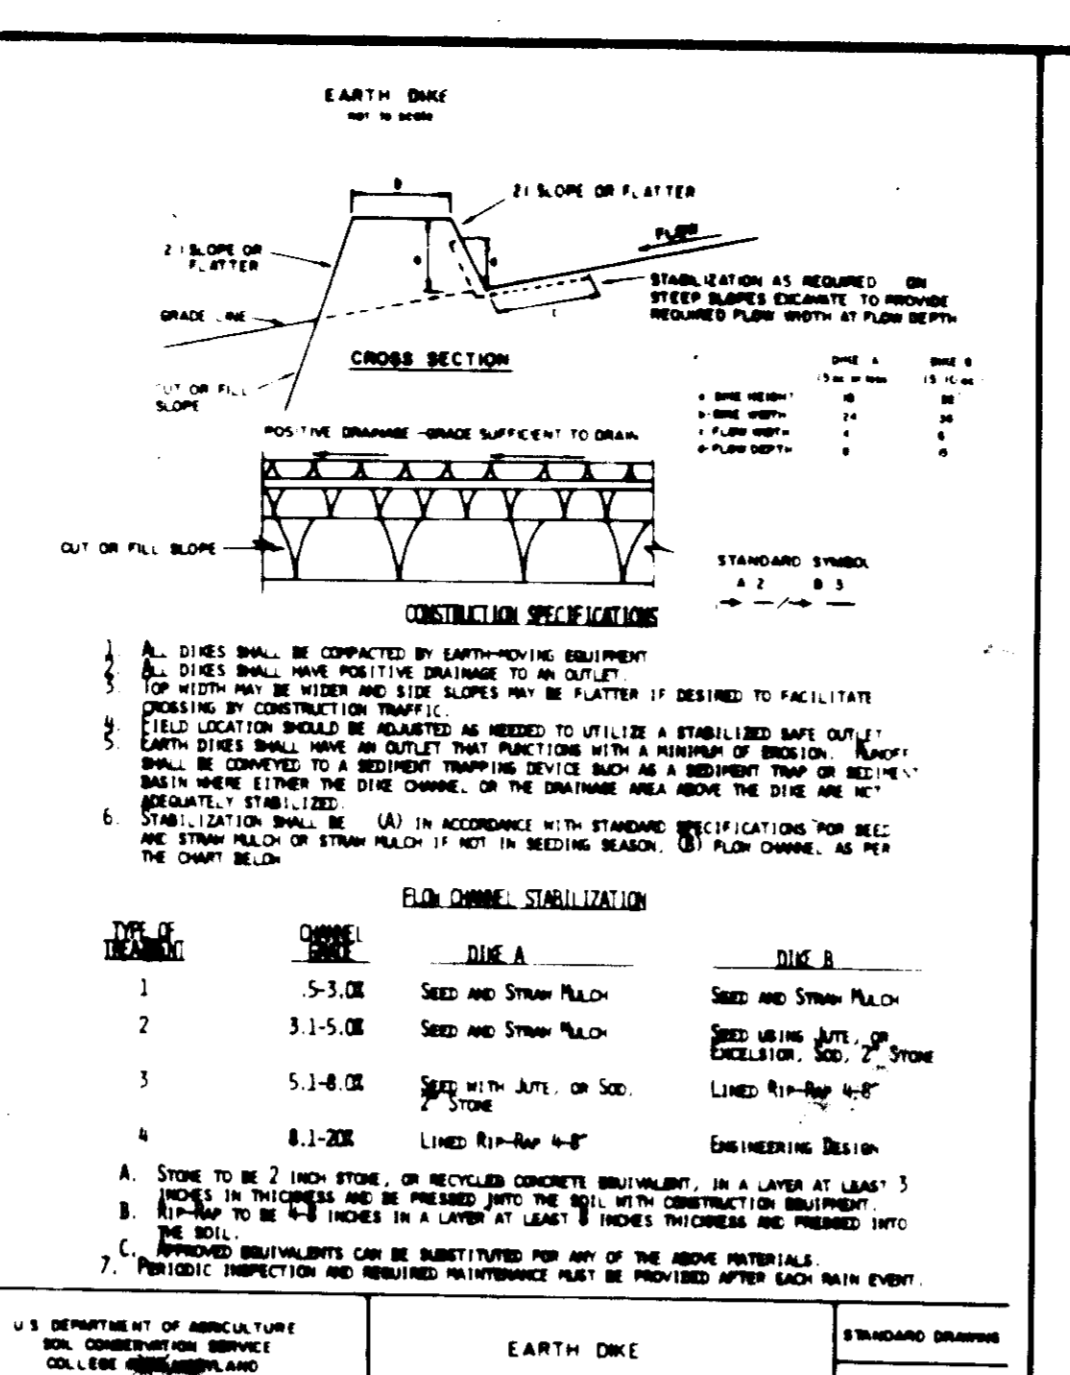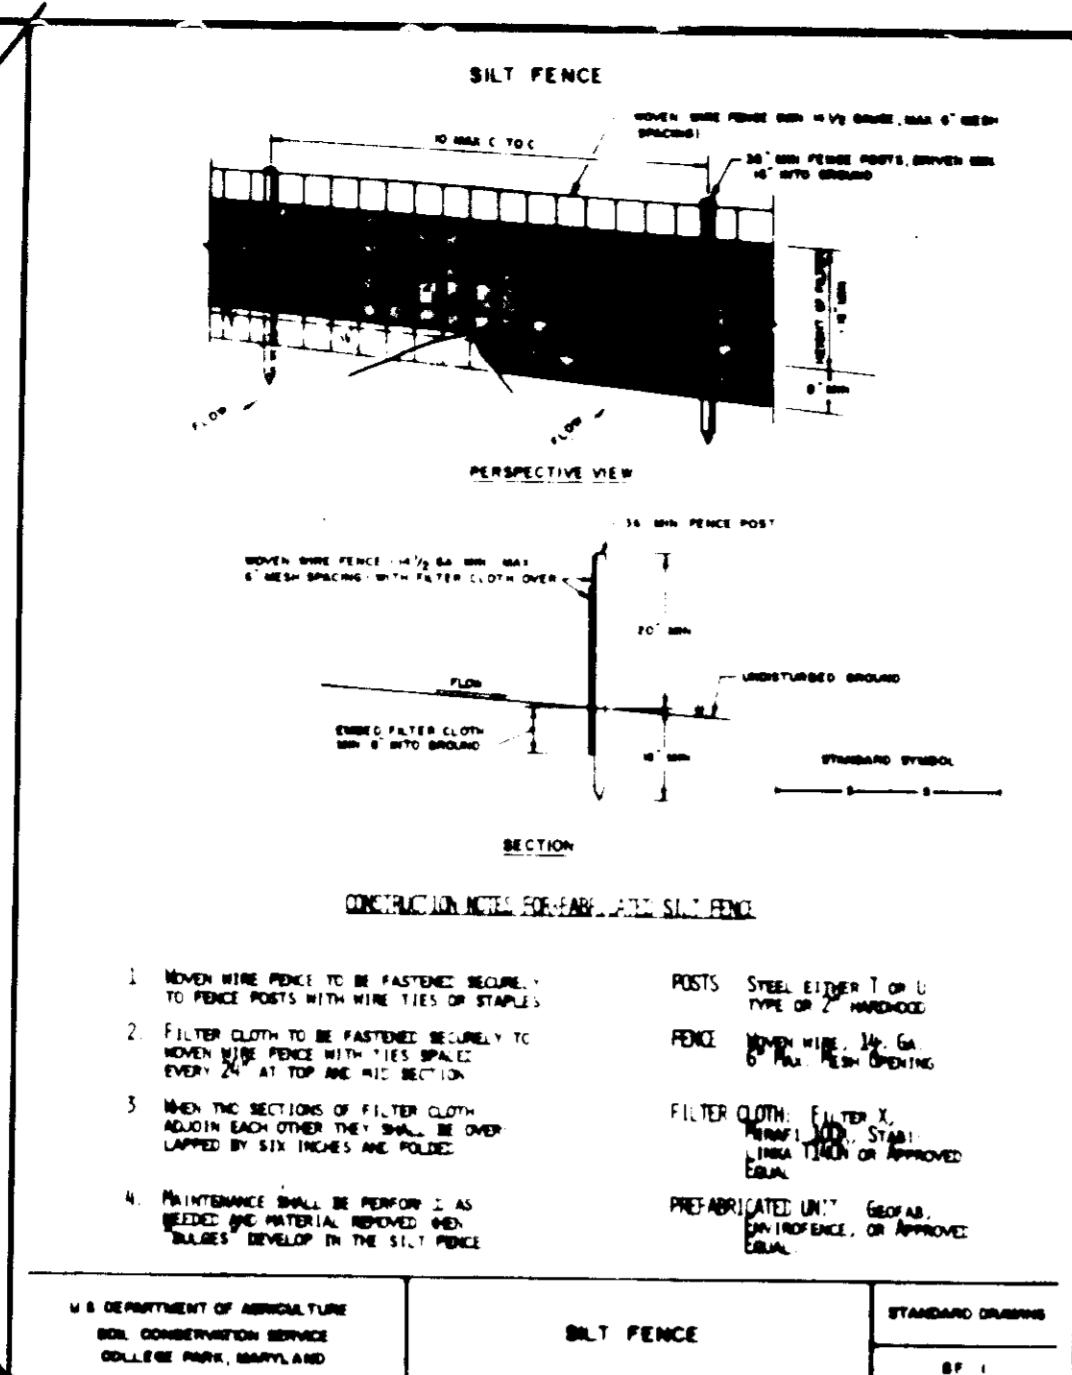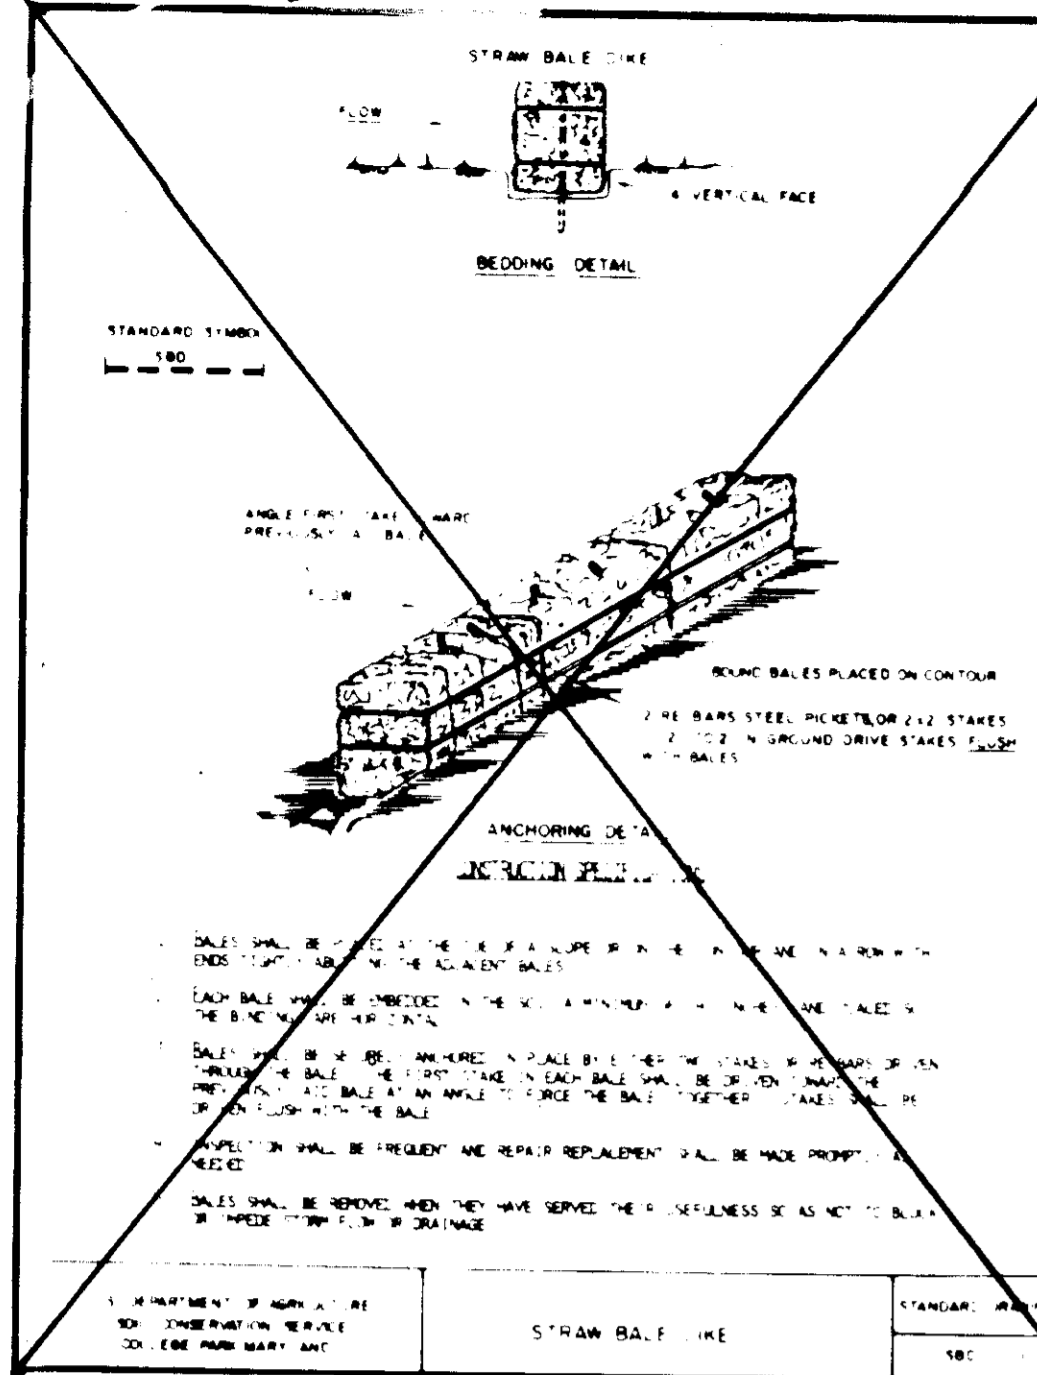

3.3.6. Construction Specifications

3.3.6.1. Timing

An infiltration trench shall not be constructed or placed in service until all of the contributing drainage area has been stabilized and approved by the responsible inspector.

3.3.6.2. Trench Preparation

Excavate the trench to the design dimensions. Excavated materials shall be placed away from the trench sides to enhance trench wall stability. Large tree roots must be trimmed flush with the trench sides in order to prevent fabric puncturing or tearing during subsequent installation procedures. The side walls of the trench shall be roughened where sheared and sealed by heavy equipment.

3.3.6.3. Fabric Layout

The filter fabric roll must be cut to the proper width prior to installation. The cut width must include sufficient material to conform to trench perimeter irregularities and for a 6-inch minimum top overlap. Place the fabric roll over the trench and unroll a sufficient length to allow placement of the fabric down into the trench. Stones or other anchoring objects should be placed on the fabric at the edge of the trench to keep the lined trench open during windy periods. When overlaps are required between rolls, the upstream roll should lap a minimum of 2 feet over the downstream roll in order to provide a shingled effect. The overlap excavations fabric continuity or to ensure that the fabric conforms to the excavation surface during adequate placement and compaction.

3.3.6.4. Stone Aggregate Placement and Compaction

The stone aggregate should be placed in lifts and compacted using plate compactors. As a rule of thumb, a maximum loose lift thickness of 12 inches is recommended. The compaction process ensures fabric conformity to the excavation sides, thereby reducing the potential for soil piping, fabric clogging, and settlement problems.

3.3.6.5. Overlapping and Covering

Following the stone aggregate placement, the filter fabric shall be folded over the stone aggregate to form a 6" minimum longitudinal lap. The desired fill soil or stone aggregate shall be placed over the lap at sufficient intervals to maintain the lap during subsequent backfilling.

3.3.6.6. Examination

Care shall be exercised to prevent natural or fill soils from intermixing with the stone aggregate. All contaminated stone aggregate shall be removed and replaced with uncontaminated stone aggregate.

3.3.6.7. Voids Behind Fabric

Voids can be created between the fabric and excavation sides and shall be avoided. Removing boulders or other obstacles from the trench walls is one source of such voids. Natural soils should be placed in these voids at the most convenient time during construction to ensure fabric conformity to the excavation sides. Soil piping, fabric clogging, and possible surface subsidence will be avoided by this remedial process.

3.3.6.8. Unstable Excavation Sides

Vertically excavated walls may be difficult to maintain in areas where the soil moisture is high or where soft cohesive or cohesionless soils predominate. These conditions may require laying back of the side slopes to maintain stability; trapezoidal rather than rectangular cross sections may result.

3.3.6.9. Vegetative Buffer

A vegetative buffer of at least 20 feet (wider, if possible) shall be used to intercept surface runoff from all impervious areas.

3.3.6.10. Traffic Control

Heavy equipment and traffic shall be restricted from traveling over the infiltration areas to minimize compaction of the soil.

3.3.6.11. Observation Well

An observation well, as described in subsection 3.3.4.8 and Figure 3-5 shall be provided. The depth of the well at the time of installation will be clearly marked on the well cap.

3.3.7. Maintenance

Infiltration trenches shall be designed to minimize maintenance. However, it is recognized that all infiltration facilities are subject to clogging by sediment, oil, grease, grit and other debris. In addition, the performance and longevity of these structures is not well documented. Consequently, a monitoring observation well is required for all infiltration structures.

The observation well shall be monitored periodically. For the first year after completion of construction, the well should be monitored on a quarterly basis and after every large storm. It is recommended that a log book be maintained indicating the rate at which the facility dewater after large storms and the depth of the well for each observation. Once the performance characteristics of the structure have been verified, the monitoring schedule can be reduced to an annual basis, unless the performance data indicate that a more frequent schedule is required.

Sediment build-up in the top foot of stone aggregates or the surface inlet should be monitored on the same schedule as the observation well. A monitoring well in the top foot of stone aggregate will be required when the trench has a stone surface. Sediment deposited shall not be allowed to build up to the point where it will reduce the rate of infiltration into the trench.

PERMANENT SEEDING NOTES

Apply to graded or cleared areas not subject to immediate further disturbance where a permanent long-lived vegetative cover is needed.

Seedbed Preparation: Loosen upper three inches of soil by raking, disking or other acceptable means before seeding.

Soil Amendments: In lieu of soil test recommendations, use one of the following schedules:

- 1) Preferred - Apply 2 tons per acre dolomitic limestone (92 lbs/1000 square ft) and 600 lbs per acre 10-10-10 fertilizer (14 lbs/1000 sq ft) before seeding. Narrow or disc into upper three inches of soil. At time of seeding, apply 400 lbs per acre 30-0-0 ureaform fertilizer (9 lbs/1000 sq ft).
- 2) Acceptable - Apply 2 tons per acre dolomitic limestone (92 lbs/1000 sq ft) and 1000 lbs per acre 10-10-10 fertilizer (23 lbs/1000 sq ft) before seeding. Narrow or disc into upper three inches of soil.

Seeding - For the periods March 1 thru April 30, and August 1 thru October 15, seed with 60 lbs per acre (1.4 lbs/1000 sq ft) of Kentucky 31 Tall Fescue. For the period May 1 thru July 31, seed with 60 lbs Kentucky 31 Tall Fescue per acre and 2 lbs per acre (0.5 lbs/1000 sq ft) of weeping lovegrass. During the period of October 16 thru February 28, protect site by: Option (1) 2 tons per acre of well anchored straw mulch and seed as soon as possible in the spring. Option (2) Use sod. Option (3) Seed with 60 lbs/acre Kentucky 31 Tall Fescue and mulch with 2 tons/acre well anchored straw.

Mulching - Apply 14 to 2 tons per acre (70 to 90 lbs/1000 sq ft) of unrotted small grain straw immediately after seeding. Anchor mulch immediately after application using mulch anchoring tool or 218 gallons per acre (5 gal/1000 sq ft) of emulsified asphalt on flat areas. On slopes 8 feet or higher, use 348 gallons per acre (8 gal/1000 sq ft) for anchoring.

Maintenance - Inspect all seeded areas and make needed repairs, replacements and reseedings.

TEMPORARY SEEDING NOTES

Apply to graded or cleared areas likely to be redisturbed where a short-term vegetative cover is needed.

Seedbed Preparation: Loosen upper three inches of soil by raking, disking or other acceptable means before seeding.

Soil Amendments: Apply 600 lbs per acre 10-10-10 fertilizer (14 lbs/1000 sq ft).

Seeding - For periods March 1 thru April 30 and from August 15 thru November 15, seed with 25 bushels per acre of annual ryegrass (3.2 lbs/1000 sq ft). For the period May 1 thru August 14, seed with 3 lbs per acre of weeping lovegrass (.07 lbs/1000 sq ft). For the period November 16 thru February 28, protect site by applying 2 tons per acre of well anchored straw mulch and seed as soon as possible in the spring, or use sod.

Mulching: Apply 14 to 2 tons per acre (70 to 90 lbs/1000 sq ft) of unrotted small grain straw immediately after seeding. Anchor mulch immediately after application using mulch anchoring tool or 218 gallons per acre (5 gal/1000 sq ft) of emulsified asphalt on flat areas. On slopes 8 feet or higher, use 348 gal per acre (8 gal/1000 sq ft) for anchoring.

Refer to the 1983 MARYLAND STANDARDS AND SPECIFICATIONS FOR SOIL EROSION AND SEDIMENT CONTROL for rate and methods not covered.






SEDIMENT CONTROL NOTES

- 1) A minimum of 24 hours notice must be given to the Howard County Office of Inspection and Permits prior to the start of any construction. (992-2437)
- 2) All vegetative and structural practices are to be installed according to the provisions of this plan and are to be in conformance with the 1983 MARYLAND STANDARDS AND SPECIFICATIONS FOR SOIL EROSION AND SEDIMENT CONTROL.
- 3) Following initial soil disturbance or redistribution, permanent or temporary stabilization shall be completed within: a) 7 calendar days for all perimeter sediment control structures, dikes, perimeter slopes and all slopes greater than 3:1, b) 14 days as to all other disturbed or graded areas on the project site.
- 4) All sediment traps/basins shown must be fenced and warning signs posted around their perimeter in accordance with Vol. 1, Chapter 12, of the HOWARD COUNTY DESIGN MANUAL, Storm Drainage.
- 5) All disturbed areas must be stabilized within the time period specified above in accordance with the 1983 MARYLAND STANDARDS AND SPECIFICATIONS FOR SOIL EROSION AND SEDIMENT CONTROL for permanent seedings (Sec. 51) and (Sec. 54), temporary seedings (Sec. 50) and mulching (Sec. 52). Temporary stabilization with which alone can only be done when recommended seeding dates do not allow for proper germination and establishment of grasses.
- 6) All sediment control structures are to remain in place and are to be maintained in operative condition until permission for their removal has been obtained from the Howard County Sediment Control Inspector.
- 7) Site Analysis:

Total Area of Site	3.83 Acres
Area Disturbed	3.05 Acres
Area to be roofed or paved	1.15 Acres
Area to be vegetatively stabilized	1.90 Acres
Total Cut	357000 Cu. yds
Total Fill	321000 Cu. yds
Offsite waste/borrow area location	N/A
- 8) Any sediment control practice which is disturbed by grading activity for placement of utilities must be repaired on the same day of disturbance.
- 9) Additional sediment controls must be provided, if deemed necessary by the Howard County DPW sediment control inspector.

On all sites with disturbed areas in excess of 2 acres, approval of the inspection agency shall be requested upon completion of installation of perimeter erosion and sediment control. Other building or grading inspection approvals may not be authorized until this initial approval by the inspection agency is made.

 NOTE: FOR SEQUENCE OF CONSTRUCTIONS, SEE SHEET 6 OF 9

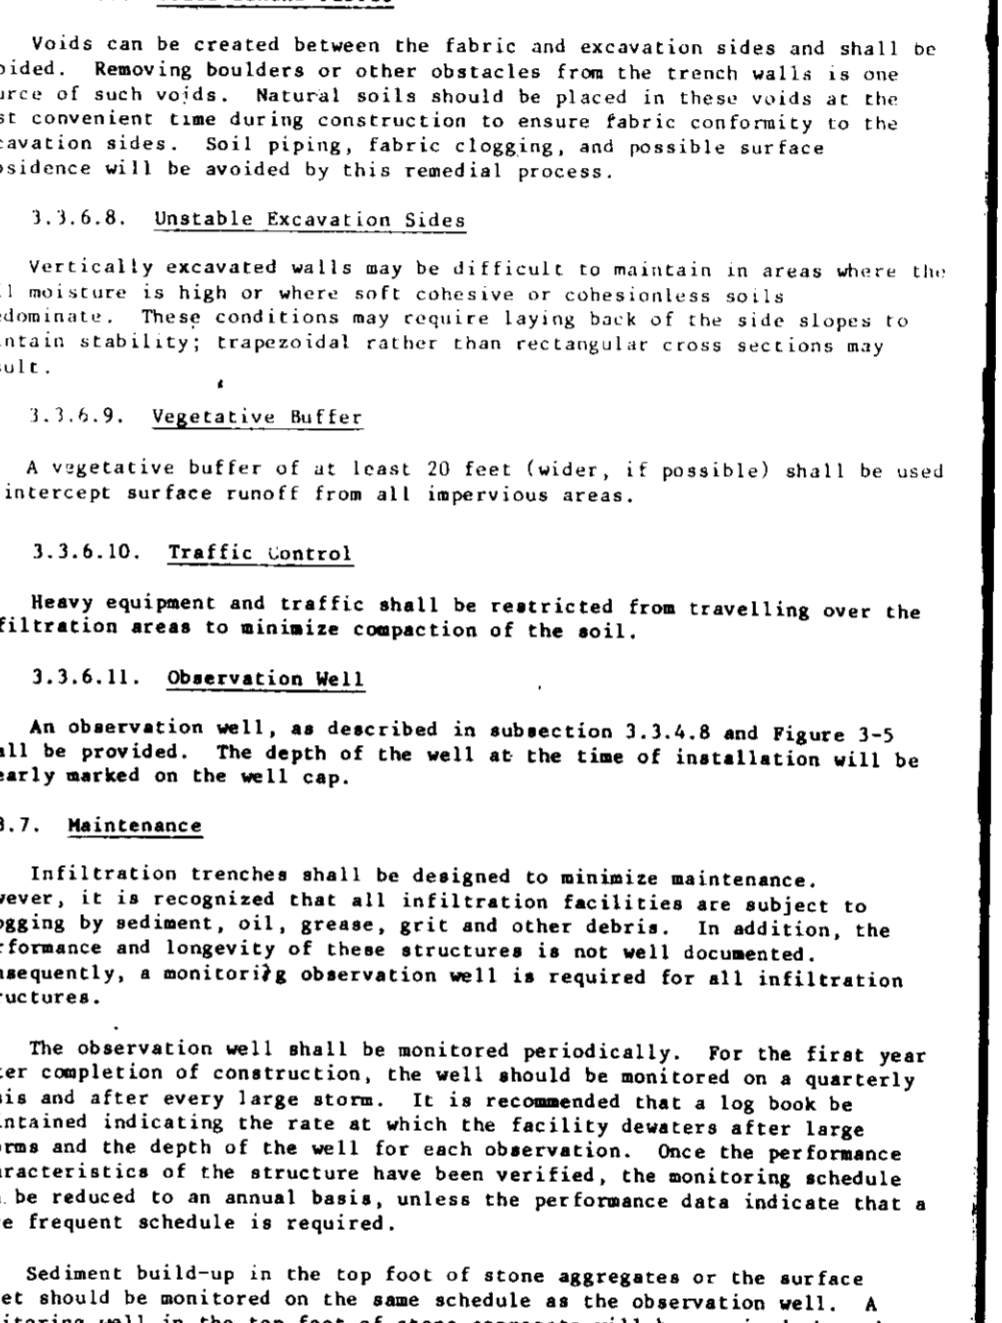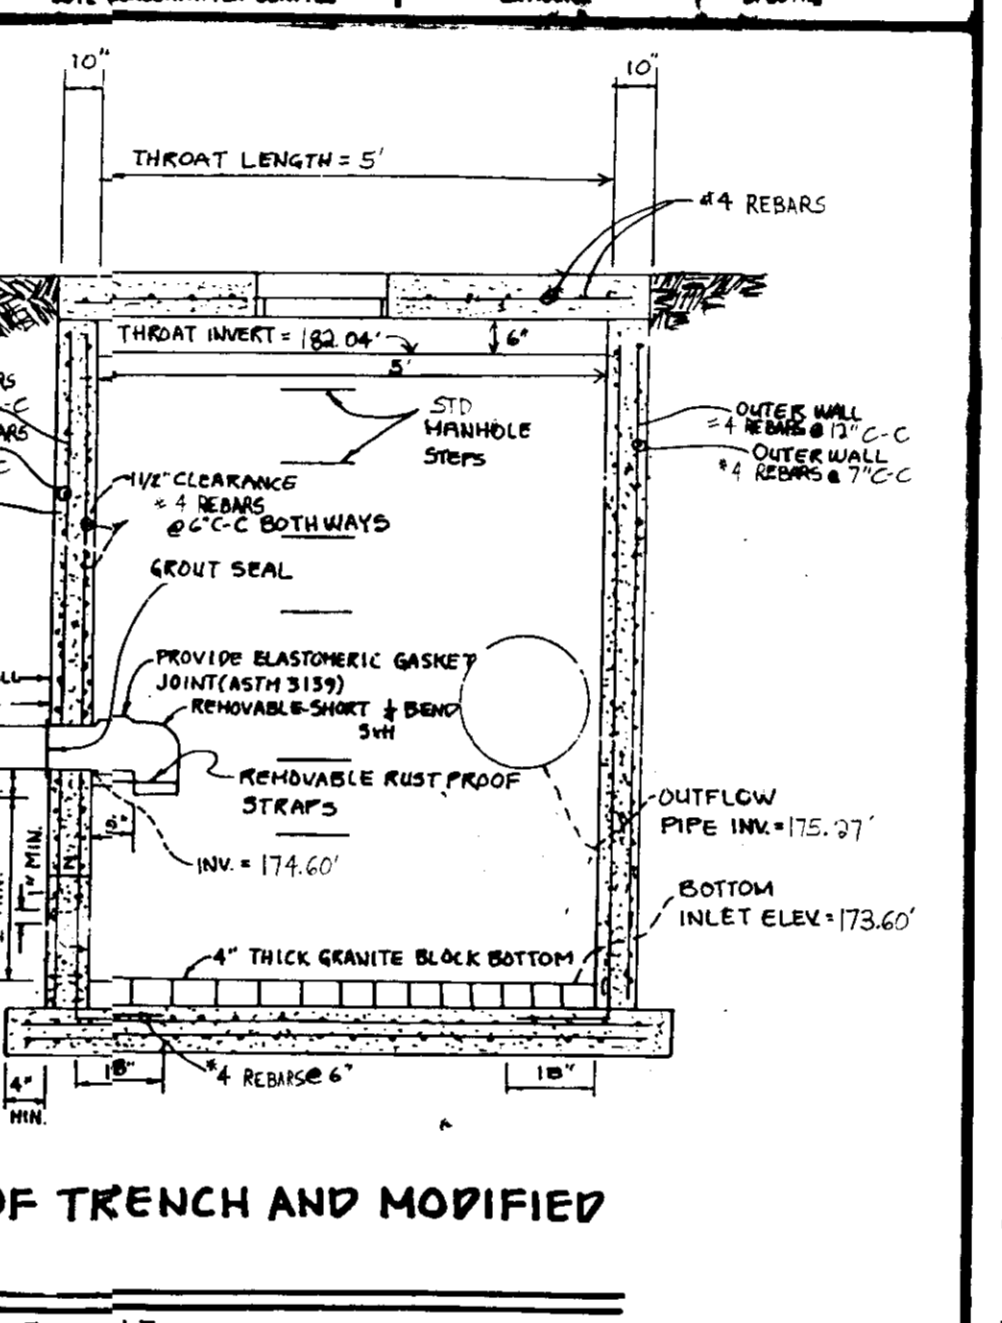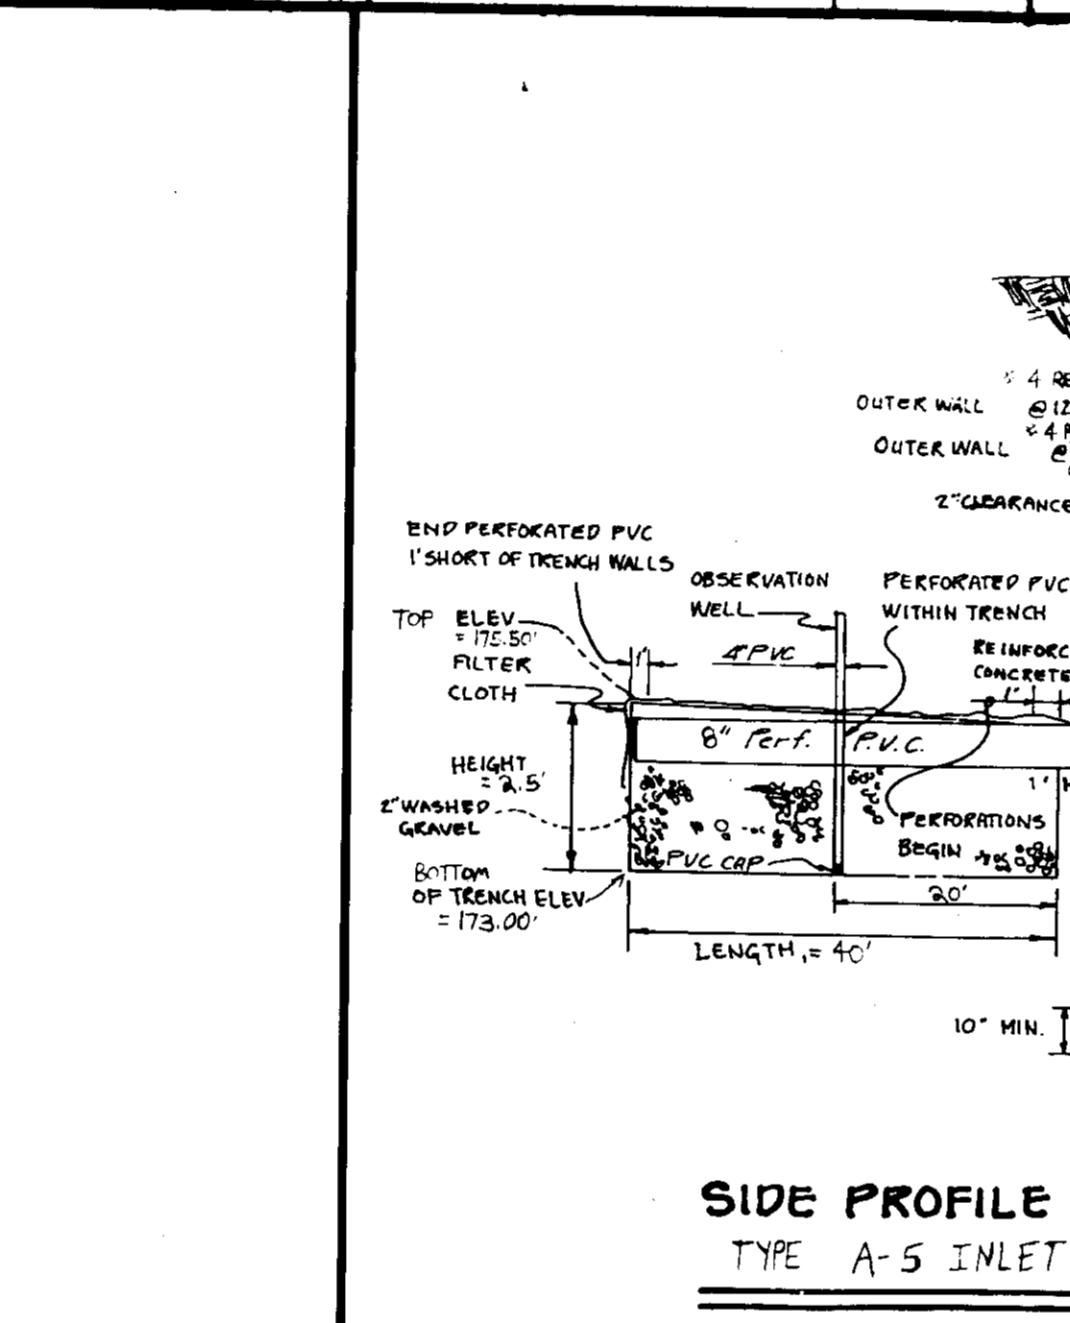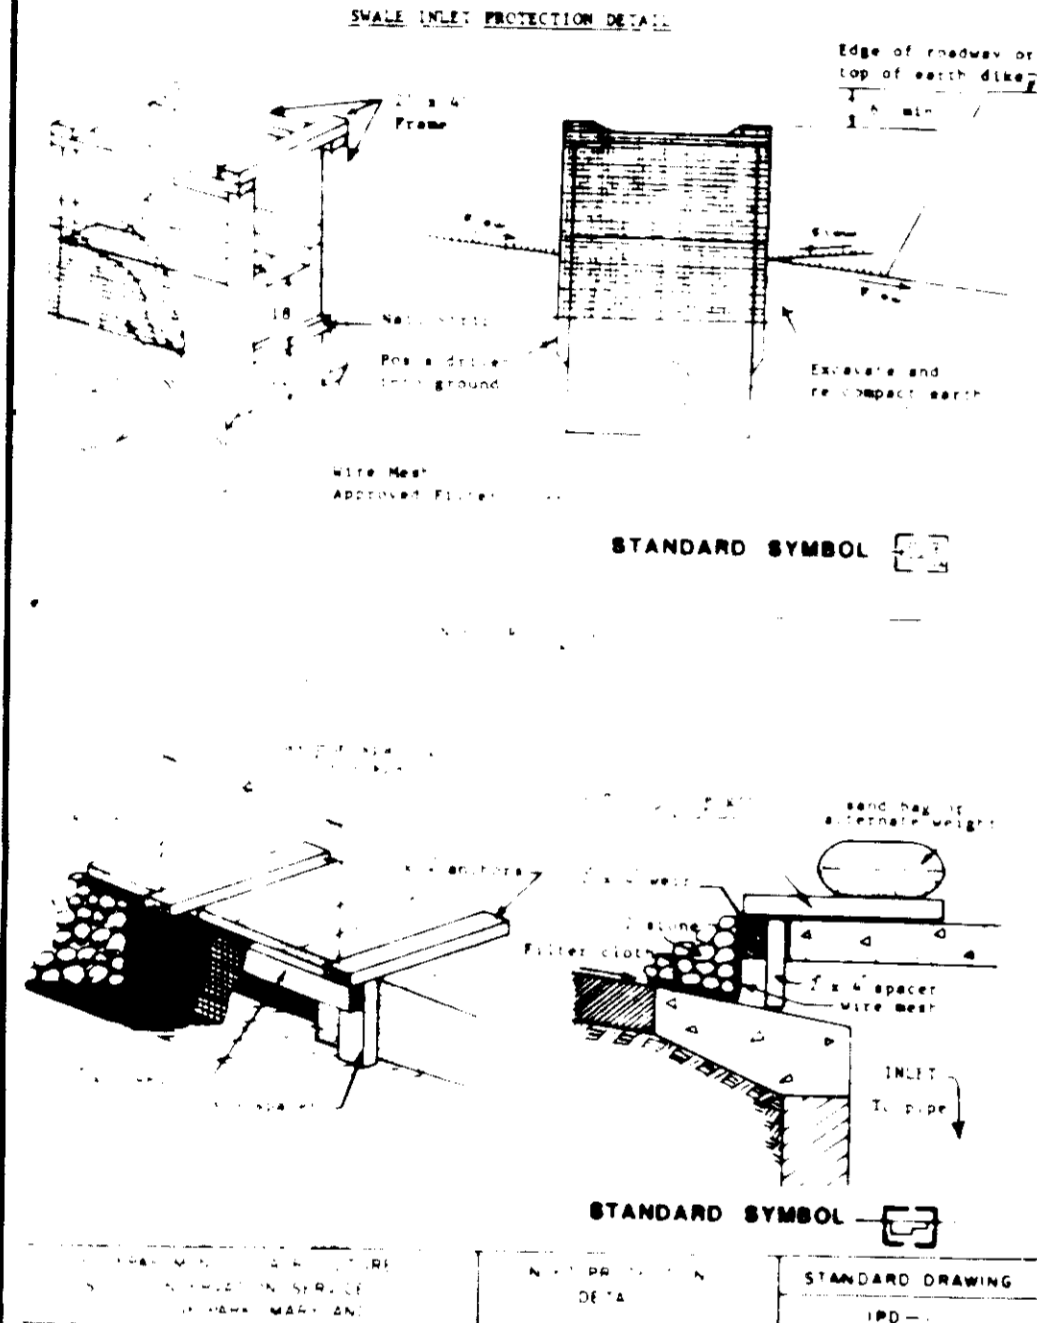

REVIEWED FOR HOWARD SOIL CONSERVATION DISTRICT AND MEETS TECHNICAL REQUIREMENTS.

Robert W. Zehn 11/27/90
SIGNATURE DATE

U.S. SOIL CONSERVATION SERVICE

THIS DEVELOPMENT PLAN IS APPROVED FOR SOIL EROSION AND SEDIMENT CONTROL BY THE HOWARD SOIL CONSERVATION DISTRICT.

James H. Hahn 11/27/90
Approved Howard SCD DATE

APPROVED: For Public Water and Public Sewerage Systems, Howard County Health Department

James H. Hahn 11/27/90
DATE

APPROVED: Howard County Dept. of Planning and Zoning

James H. Hahn 11/27/90
DATE

APPROVED: Howard County Dept. of Planning and Zoning

James H. Hahn 11/27/90
DATE

OWNER'S/ DEVELOPER'S CERTIFICATION

"I/We certify that all development and construction will be done according to this plan, and that any responsible personnel involved in the construction project will have a Certificate of Attendance at a Department of Natural Resources Approved Training Program for the Control of Sediment and Erosion before beginning the project. I also authorize periodic on-site inspection by the Howard Soil Conservation District."

Signature: *James H. Hahn* Date: 11/15/90
Name: James H. Hahn Title: President Phone No: 410-281-1100
Firm: Hahn & Sons, Inc. Complete Address: 1100 West Street, Suite 100, Laurel, MD 20707

ENGINEER'S CERTIFICATE

"I certify that this plan for erosion and sediment control represents a practical and workable plan based on my personal knowledge of the site conditions and that it was prepared in accordance with the requirements of the Howard Soil Conservation District."

Signature: *Vijay Balusu* Date: 11-15-90
Name: Vijay Balusu Date: 11-15-90
Registered Professional Engineer #18044

KIDDE CONSULTANTS, INC.
ENGINEERS • PLANNERS • SURVEYORS
1100 WEST STREET / SUITE 100 / LAUREL, MD 20707
(Wash.) (301) 963-1821 / 792-8086 (Balt.)

CHANGI DEVELOPER
RICHARD J. SUSAN SANDER
233 CREEKWOOD DRIVE
PASTERSVILLE, PA. 19047


SEDIMENT CONTROL DETAIL SHEET

DORSEY RUN PARK-UNIT NO. 1C
BUILDING NO. 4
HOWARD COUNTY, MARYLAND
TAX MAP 45 PARCEL 5
6TH ELECTION DISTRICT

Drawing R/L/I	DATE	REVISIONS	SHEET	DATE	JOB NUMBER
Choo SDH			7	MAY, 1990	
Choo SDH			OF	SCALE	
Choo D/S, JCF			9	AS SHOWN	16 88-052

FOR DRAINAGE AREA ONLY

- LEGEND**
- ← PROPOSED DRAINAGE DIVIDE
 - ▨ ON-SITE AREA TO BE MANAGED BY ADJACENT OWNERS SWM FACILITIES
 - FLOW DIRECTION
 - LIMIT OF SUBMISSION

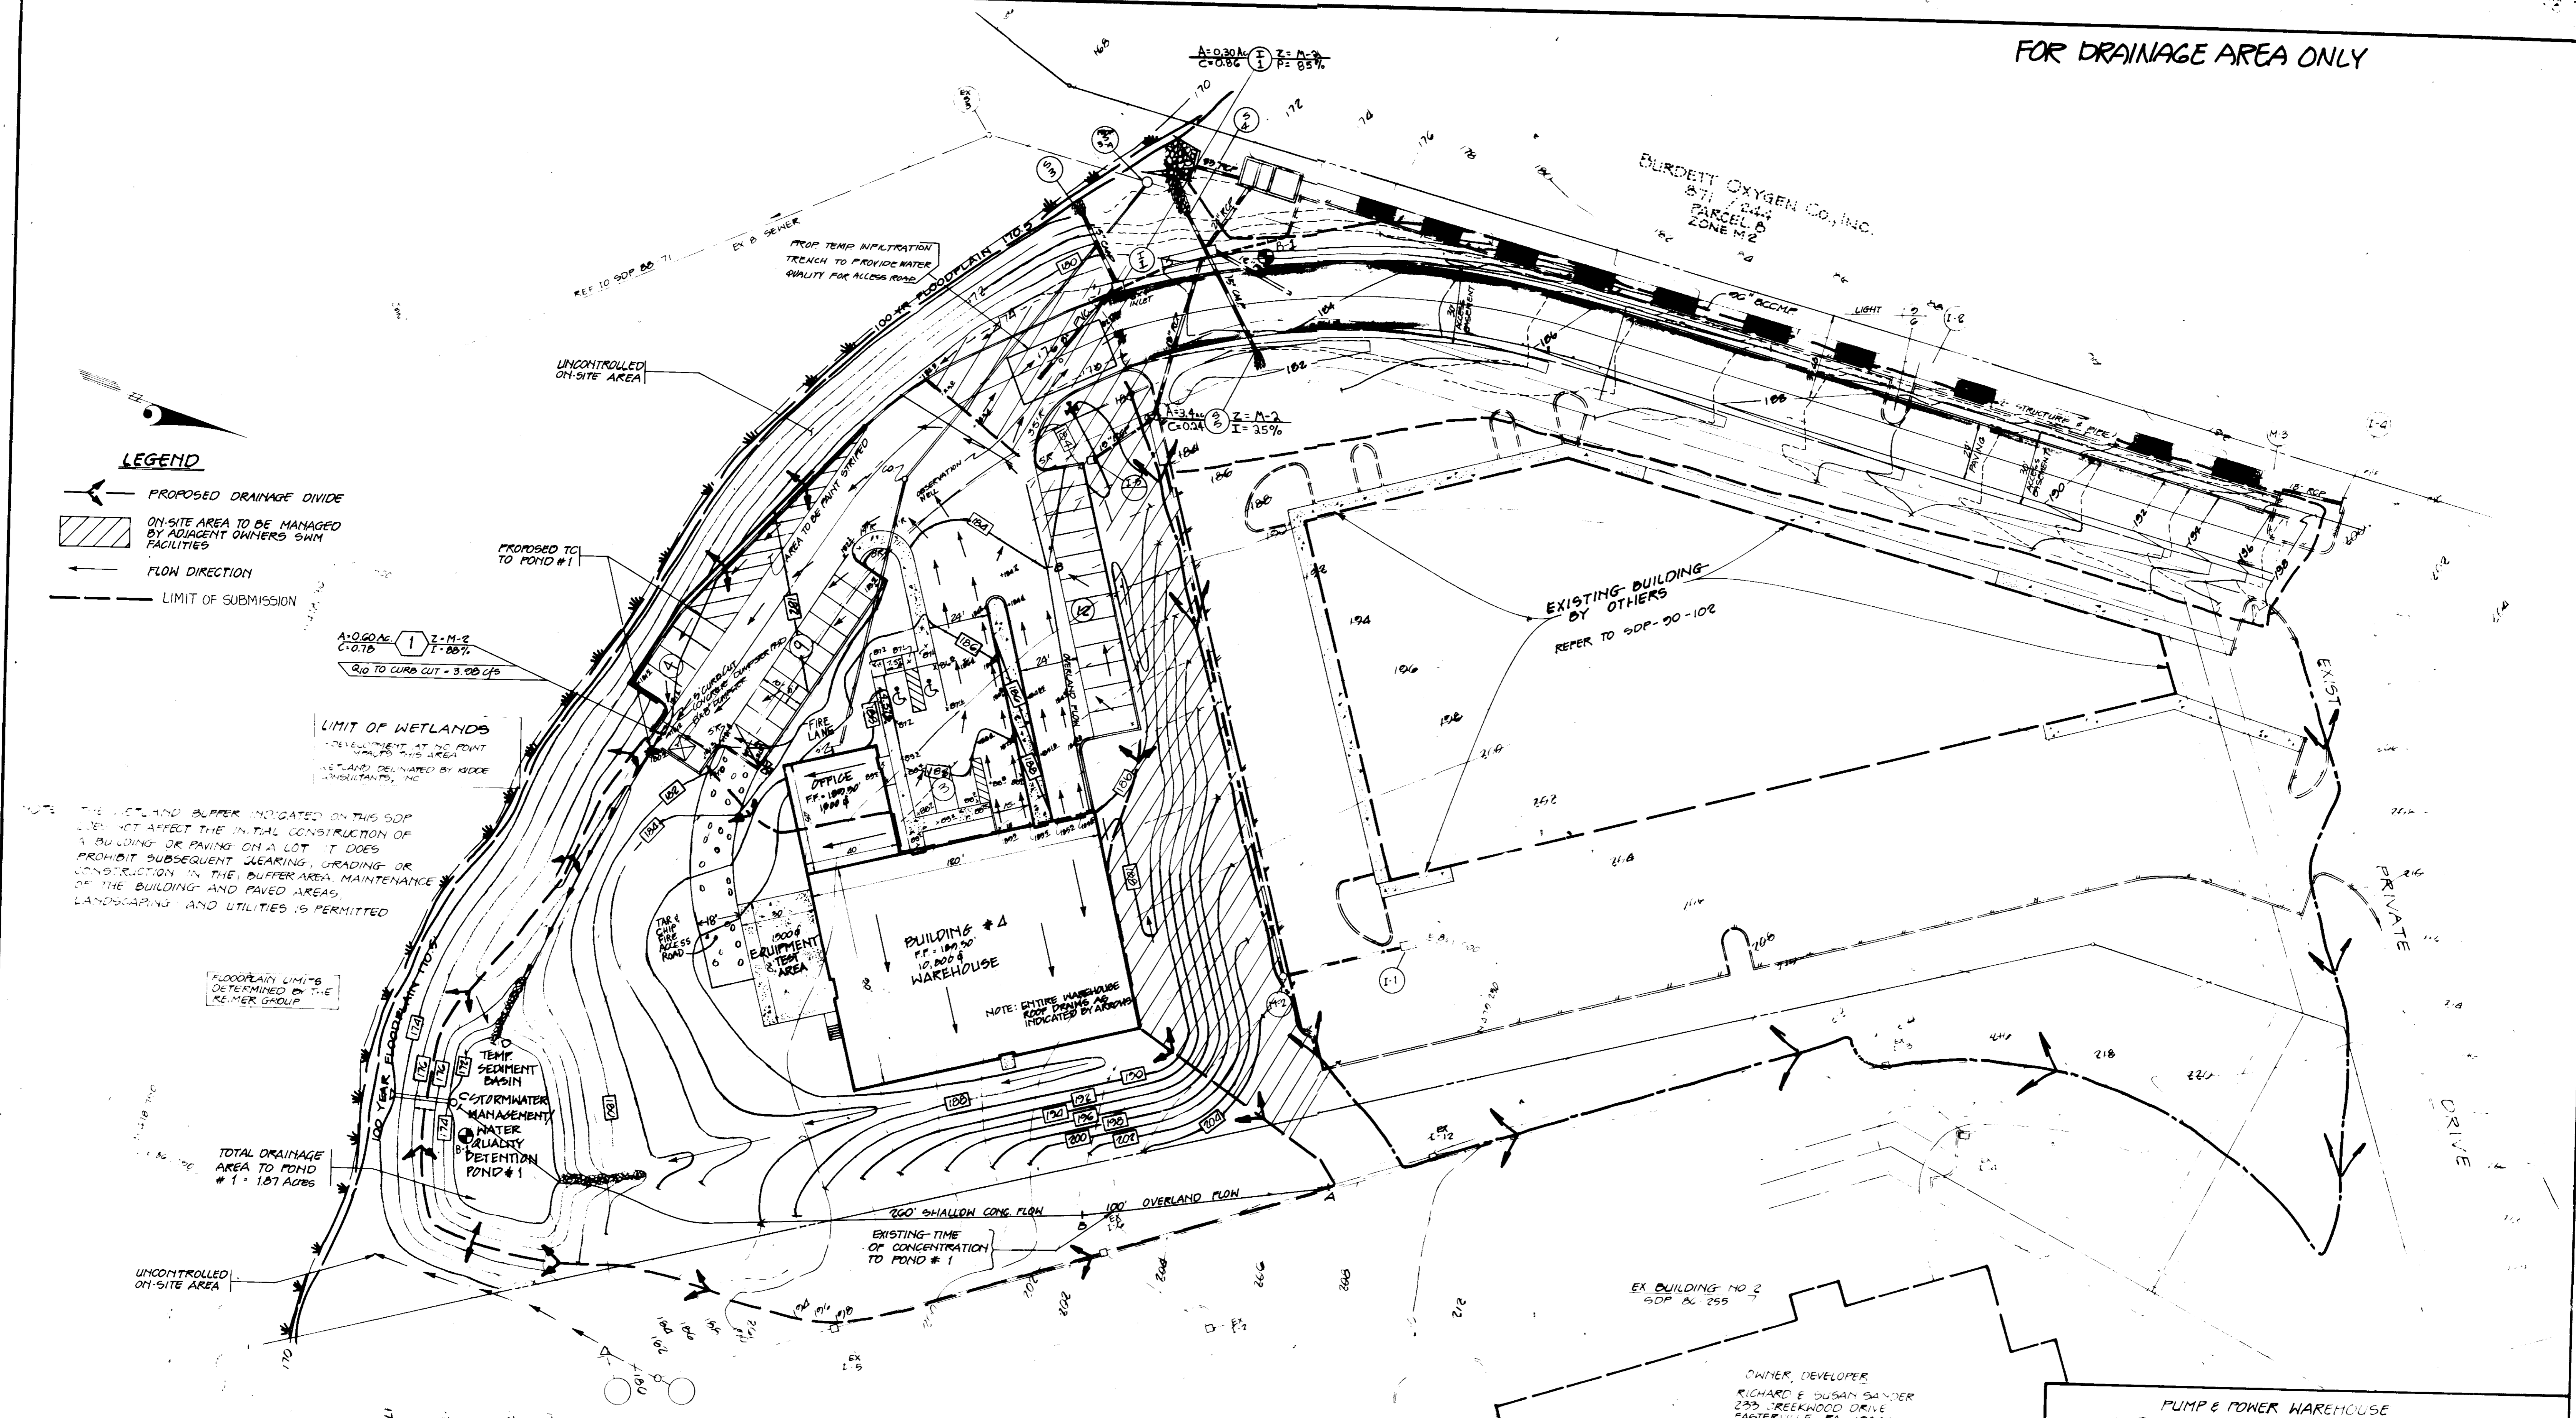

APPROVED BY HOWARD COUNTY DEPARTMENT OF PLANNING AND ZONING

James R. Kelly 3/1/91 DATE

Paul J. Taylor 2/23/91 DATE

CHIEF PLANNING AND ZONING

DATE	REVISION

APPROVED FOR PUBLIC WATER AND PUBLIC SEWERAGE, STORM DRAINAGE SYSTEMS AND PUBLIC ROADS HOWARD COUNTY DEPARTMENT OF PUBLIC WORKS

Richard W. Ziehm 2/12/91 DATE

Richard W. Ziehm 2-11-91 DATE

CHIEF BUREAU OF ENGINEERING

APPROVED FOR PUBLIC WATER AND PUBLIC SEWERAGE SYSTEMS HOWARD COUNTY HEALTH DEPARTMENT

James R. Kelly 2/15/91 DATE

COUNTY HEALTH OFFICER

These plans have been reviewed for the Howard Soil Conservation District and meet the technical requirements for small pond construction, soil erosion and sediment control.

James R. Kelly 11/27/90 DATE

USDA SOIL CONSERVATION SERVICE

These plans for small pond construction, soil erosion and sediment control meet the requirements of the Howard Soil Conservation District.

Richard W. Ziehm 11/27/90 DATE

HOWARD SOIL CONSERVATION DISTRICT

ENGINEERS CERTIFICATE

"I certify that this plan for pond construction, erosion and sediment control represents a practical and workable plan based on my personal knowledge of the site conditions. This plan was prepared in accordance with the requirements of the Howard Soil Conservation District. I have notified the developer that he must provide the Howard Soil Conservation District with an "as built" plan of the pond within 30 days of completion."

Richard W. Ziehm 11-15-90 DATE

ENGINEERS SIGNATURE DATE

DEVELOPERS CERTIFICATE

"I certify that all development and/or construction will be done according to these plans, and that any responsible personnel involved in the construction project will have a Certificate of Attendance at a Department of Natural Resources Approved Training Program for the Control of Sediment and Erosion before beginning the project. I will provide the Howard Soil Conservation District with an "as-built" plan of the pond within 30 days of completion."

Richard C. Sander 11/15/90 DATE

DEVELOPERS SIGNATURE DATE

PUMP & POWER WAREHOUSE DRAINAGE AREA MAP
 DORSEY R.L.N. PARK-UNIT NO. 1C
 BUILDING NO. 4
 HOWARD COUNTY, MARYLAND
 TAX MAP 25 PARCEL 5
 6TH ELECTION DISTRICT

KIDDE CONSULTANTS, INC.

ENGINEERS • PLANNERS • SURVEYORS

11/27/90, APPROVED FOR PUBLIC WORKS, SDP-90-102


OTHERS: SDH, B/S

DATE MAY 1990 SCALE 1"=30'

SDP 90-102

FOR SOILS ONLY

SOILS LEGEND		
SOILS TYPE	HYDROLOGIC GROUP	DESCRIPTION
SfD2	B	SASAPRASS GRAVELLY SANDY LOAM 10 TO 15 PERCENT SLOPES, MODERATELY ERODED
ChB2	C	CHILLUM-FAIRFAX LOAMS, 1 TO 5 PERCENT SLOPES, MODERATELY ERODED
Mo	B	MIXED ALLUVIAL LAND

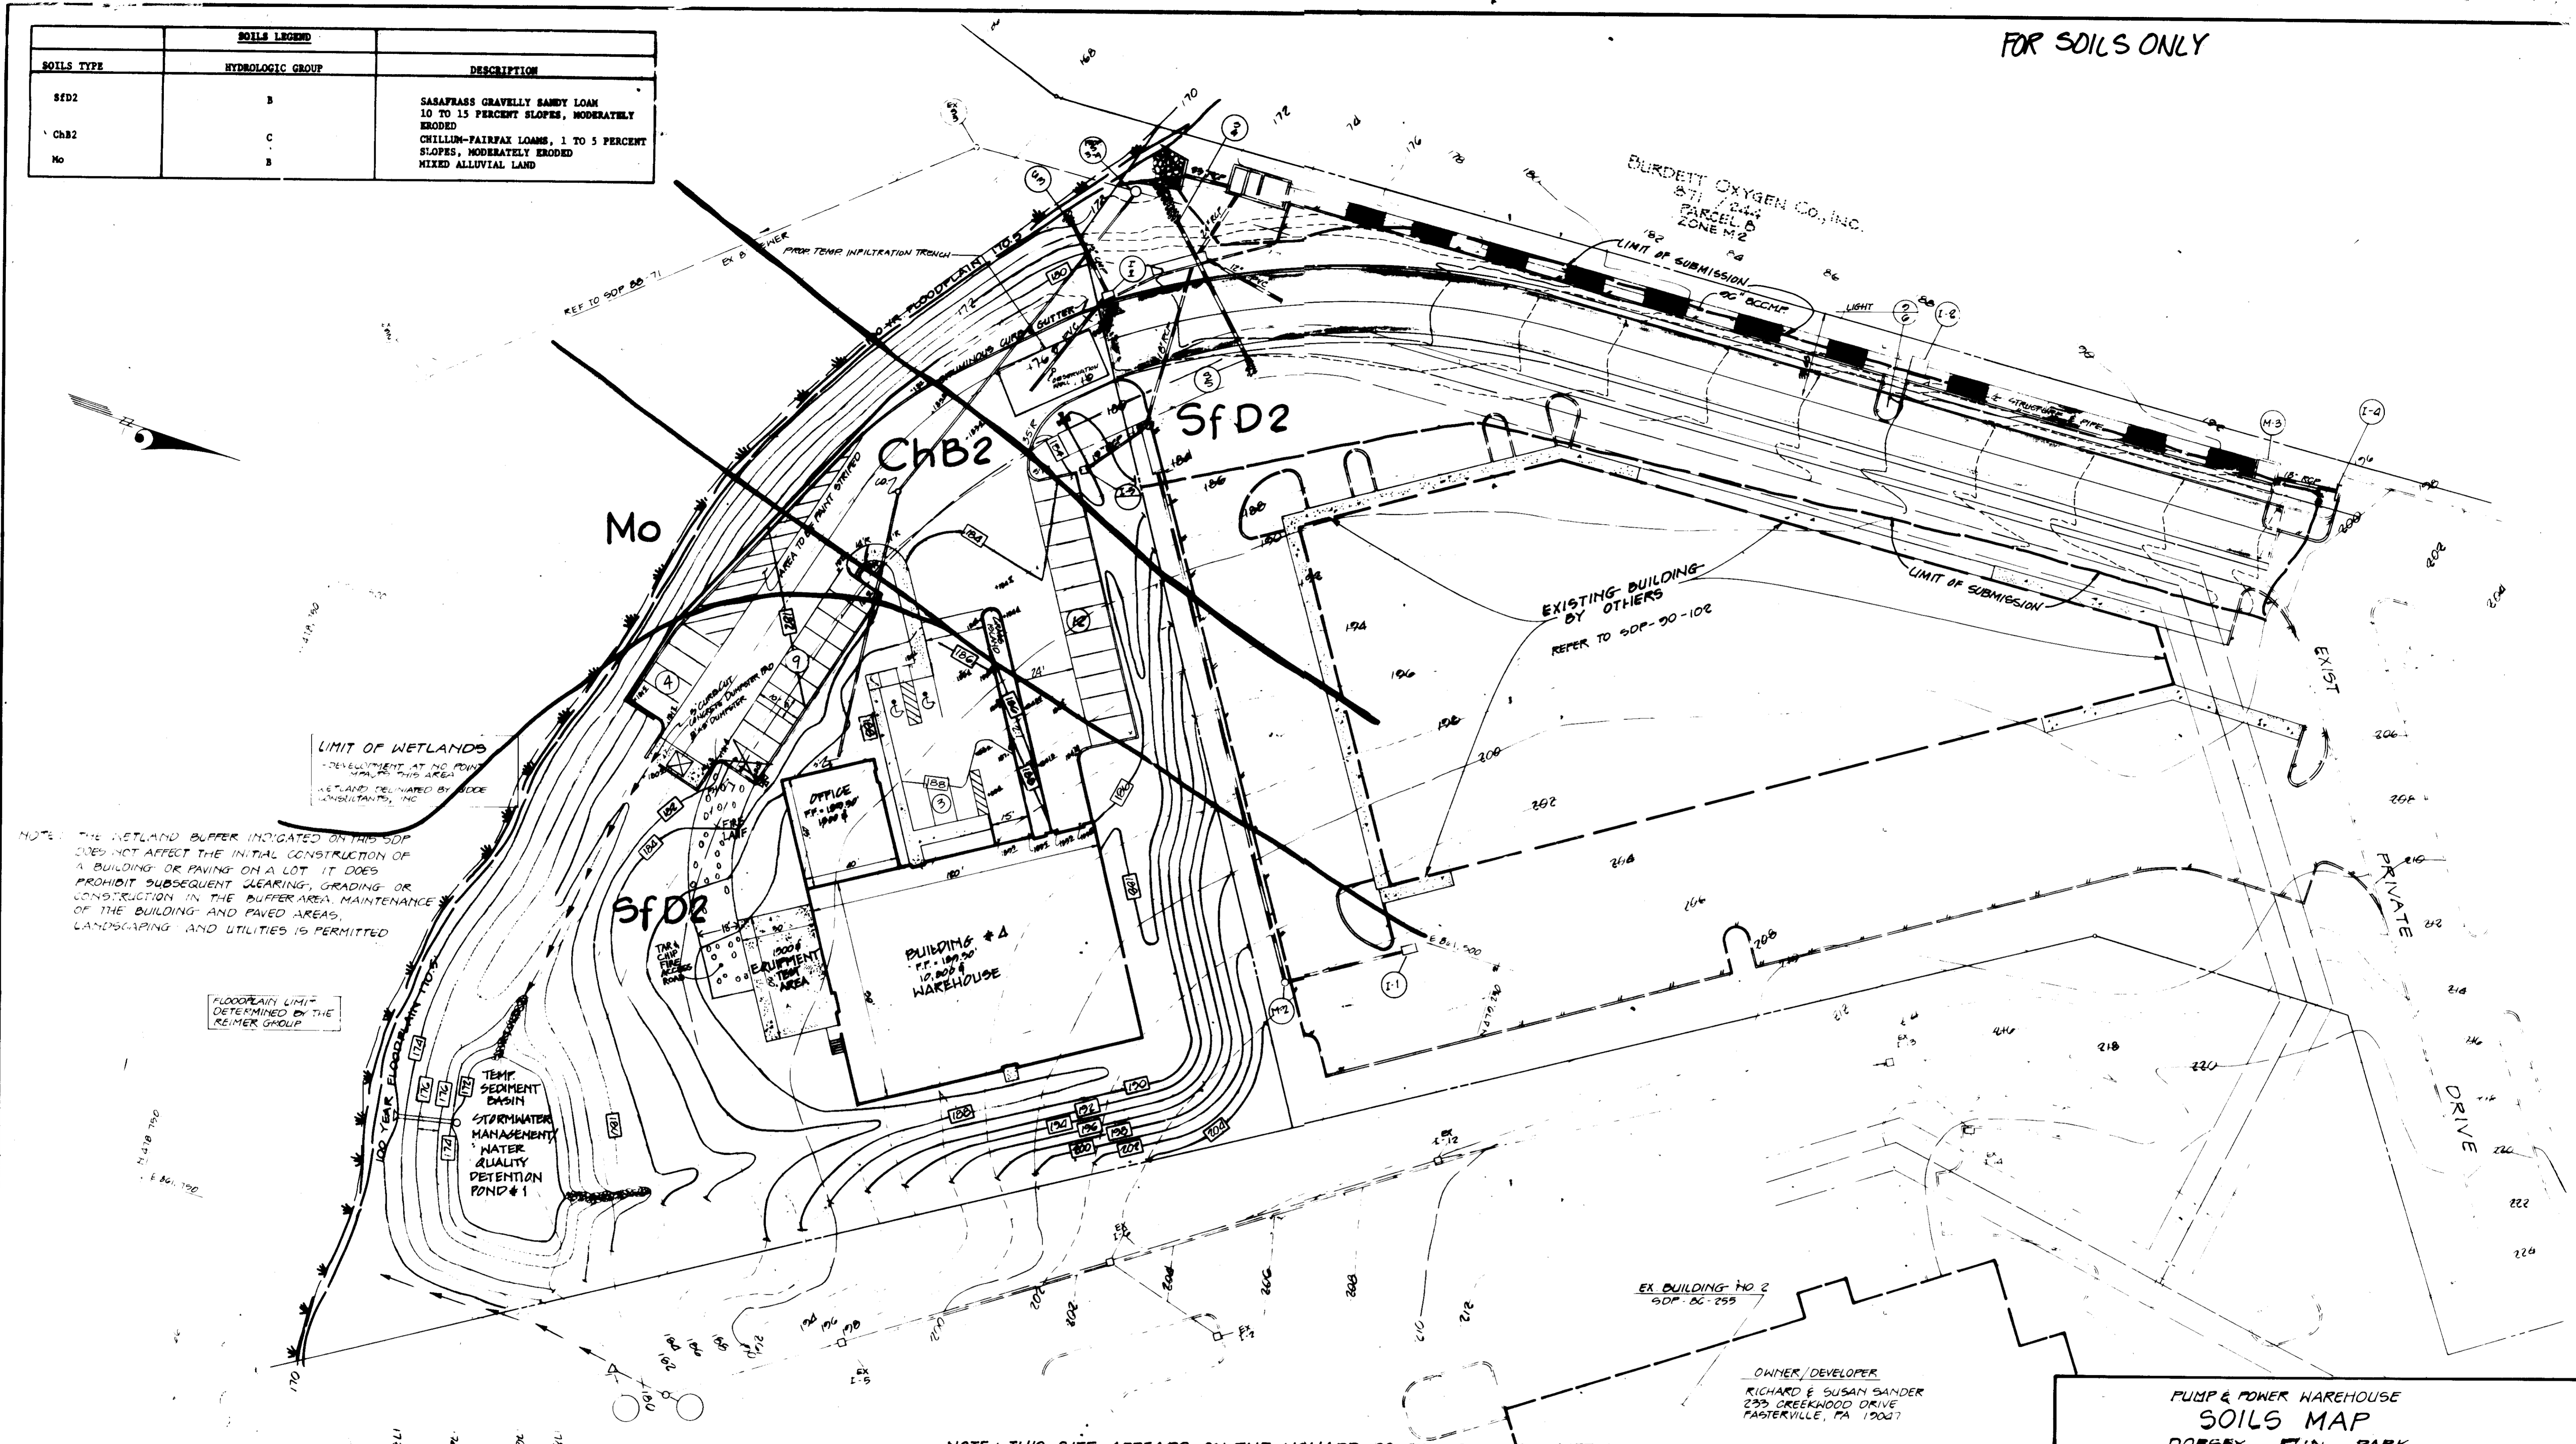

NOTE: THE WETLAND BUFFER INDICATED ON THIS SDP DOES NOT AFFECT THE INITIAL CONSTRUCTION OF A BUILDING OR PAVING ON A LOT. IT DOES PROHIBIT SUBSEQUENT CLEARING, GRADING OR CONSTRUCTION IN THE BUFFER AREA. MAINTENANCE OF THE BUILDING AND PAVED AREAS, LANDSCAPING AND UTILITIES IS PERMITTED.

LIMIT OF WETLANDS
DEVELOPMENT AT NO POINT SHALL BE THIS AREA
WETLANDS DELINEATED BY EDOCE CONSULTANTS, INC.

FLOODPLAIN LIMIT DETERMINED BY THE REIMER GROUP

NOTE: THIS SITE APPEARS ON THE HOWARD CO. SOIL SURVEY SHEET # 3A

APPROVED: HOWARD COUNTY DEPARTMENT OF PLANNING AND CONSTRUCTION
James S. Beatty 3/1/91
 DIRECTOR DATE
Mark W. DeLong 2/27/91
 CHIEF, DIVISION OF COMMUNITY PLANNING AND LAND DEVELOPMENT DATE

APPROVED: FOR PUBLIC WATER AND PUBLIC SEWERAGE, STORM DRAINAGE SYSTEMS AND PUBLIC ROADS
 HOWARD COUNTY DEPARTMENT OF PUBLIC WORKS
Paul W. Sporn 2/12/91
 DIRECTOR DATE
William E. Rader 2-11-91
 CHIEF BUREAU OF ENGINEERING DATE

These plans have been reviewed for the Howard Soil Conservation District and meet the technical requirements for small pond construction, soil erosion and sediment control.
James M. Helms 11/27/90
 U.S. SOIL CONSERVATION SERVICE DATE

ENGINEERS CERTIFICATE
 "I certify that this plan for pond construction, erosion and sediment control represents a practical and workable plan based on my personal knowledge of the site conditions. This plan was prepared in accordance with the requirements of the Howard Soil Conservation District. I have notified the developer that he must provide the Howard Soil Conservation District with an "as built" plan of the pond within 30 days of completion."
Richard C. Sander 11-15-90
 ENGINEERS SIGNATURE DATE

DEVELOPERS CERTIFICATE
 "I certify that all development and/or construction will be done according to these plans, and that any responsible personnel involved in the construction project will have a Certificate of Attendance at a Department of Natural Resources Approved Training Program for the Control of Sediment and Erosion before beginning the project. I will provide the Howard Soil Conservation District with an "as-built" plan of the pond within 30 days of completion."
Richard C. Sander 11/15/90
 DEVELOPERS SIGNATURE DATE

REVISION CHART	
DATE	REVISION

APPROVED: FOR PUBLIC WATER AND PUBLIC SEWERAGE SYSTEMS
 HOWARD COUNTY HEALTH DEPARTMENT
Paul W. Sporn 2/12/91
 COUNTY HEALTH OFFICER DATE

These plans for small pond construction, soil erosion and sediment control meet the requirements of the Howard Soil Conservation District.
Robert W. Ziehm 11/29/90
 HOWARD SOIL CONSERVATION DISTRICT DATE

PUMP & POWER WAREHOUSE
 SOILS MAP
 DORSEY RUN PARK
 BUILDING NO. 1
 HOWARD COUNTY, MARYLAND
 TAX MAP 25 PARCEL 5
 6TH ELECTION DISTRICT

KIDDE CONSULTANTS, INC.
 ENGINEERS • PLANNERS • SURVEYORS
 1100 WEST STREET, SUITE 100, LAUREL, MD 20646
 WASHINGTON, DC 20004-1823, 703/806-8411

DATE	REVISION	BY
11/27/91		

DESIGNED BY: OTHERS
 COMPUTED BY: SDH
 DRAWN BY: RUC
 CHECKED BY: BVS, SDH

STATE OF MARYLAND
 PROFESSIONAL ENGINEER
 RICHARD C. SANDER
 LICENSE NO. 1115190

DATE: MAY, 1990 SCALE: 1"=30'

Drwg. No. 90-20