

VICINITY MAP  
SCALE: 1" = 400'

INDEX OF SHEETS

- COVER SHEET
- SITE DEVELOPMENT PLAN
- SOILS MAP
- 10. GRADING AND SEDIMENT CONTROL PLAN
- SEDIMENT CONTROL NOTES & DETAILS

project	9207001.DWG
date	MAY 92
illustration	engineering
TIP	TIP
scale	1" = 400'
approval	RRM

no.	1	2	3	4	5	6	7	8	9	10
description	REVISED PER HOWARD CO. DPZ & J&S-O COMMENTS	REVISED PER HOWARD CO. DPZ	REVISED PER HOWARD CO. DPZ	REVISED PER HOWARD CO. DPZ	REVISED PER HOWARD CO. DPZ	REVISED PER HOWARD CO. DPZ	REVISED PER HOWARD CO. DPZ	REVISED PER HOWARD CO. DPZ	REVISED PER HOWARD CO. DPZ	REVISED PER HOWARD CO. DPZ
date	7/24/92	7/24/92	7/24/92	7/24/92	7/24/92	7/24/92	7/24/92	7/24/92	7/24/92	7/24/92

PROPOSED SIX HOLES  
TURF VALLEY WEST GOLF COURSE  
ELECTION DISTRICT No. 3  
HOWARD COUNTY, MARYLAND  
SITE DEVELOPMENT PLAN

APPROVED: HOWARD COUNTY DEPARTMENT OF PLANNING & ZONING  
*James M. Smith* 10/20/92  
 DIRECTOR DATE  
*Emma Halenath* 10/19/92  
 CHIEF, DIVISION OF COMMUNITY PLANNING AND LAND DEVELOPMENT DATE

APPROVED: HOWARD COUNTY DEPARTMENT OF PUBLIC WORKS FOR STORM DRAINAGE SYSTEMS AND ROADS  
*James M. Smith* 10/19/92  
 DIRECTOR DATE  
*James M. Smith* 10-1-92  
 CHIEF, BUREAU OF ENGINEERING DATE

REVIEWED: HOWARD COUNTY HEALTH DEPARTMENT NO WATER OR SANITARY FACILITIES REQUIRED  
*John P. Johnston* 10-13-92  
 COUNTY HEALTH OFFICER DATE

APPROVED: REVIEWED FOR HOWARD COUNTY SOIL CONSERVATION DISTRICT AND MEETS TECHNICAL REQUIREMENTS.  
*James M. Smith* 7/24/92  
 S.O.S. SOIL CONSERVATION SERVICES DATE


APPROVED: THIS DEVELOPMENT IS APPROVED FOR EROSION AND SEDIMENT CONTROL BY THE HOWARD COUNTY SOIL CONSERVATION DISTRICT.  
*John P. Johnston* 9/24/92  
 HOWARD SOIL CONSERVATION DISTRICT DATE

PLAN APPROVAL STAMP  
 APPROVED  
 PLANNING BOARD  
 OF HOWARD COUNTY  
 DATE 9-15-92

DEVELOPER'S CERTIFICATE  
 I/We certify that all development and construction will be done in accordance with this plan of development and plan for erosion and sediment control and that all responsible personnel involved in the construction of this project will have a certificate of attendance at a Department of the Environment approved training program for the control of sediment and erosion before beginning the project. I also authorize periodic onsite inspection by the Howard County Soil Conservation District or their authorized agents, as are deemed necessary.  
*Louis Mancini* 6/8/92  
 Signature of Developer Date  
 ENGINEER'S CERTIFICATE  
 I hereby certify that this plan for erosion and sediment control represents a practical and workable plan based on my personal knowledge of the site conditions and that it was prepared in accordance with the requirements of the Howard County Soil Conservation District.  
*Bob Mochi* 6-4-92  
 Robert M. Mochi, P.E. Date


OWNER  
 MANGIONE ENTERPRISES OF TURF VALLEY  
 1205 YORK ROAD - PENTHOUSE  
 LUTHERVILLE, MARYLAND 21093

ADDRESS CHART					
LOT No.	STREET ADDRESS				
1	2700 TURF VALLEY DRIVE				
SUBDIVISION NAME					
TURF VALLEY WEST GOLF COURSE PROPOSED SIX HOLES					
SECT./AREA	LOT/PARCEL	PREVIOUS FILE			
N/A	50 & P/D B	S-86-13, FDP PGCC-1 FDP PGCC-2 & PART OF PGCC-3 FDP PART OF PGCC-3 & PGCC-4			
PLAT No.	BLOCK No.	ZONE	TAX MAP	ELEC. DIST.	CENSUS
920/285 1263/124	10, 11, 16	PGCC	16	3	G022 & G030
WATER CODE			SEWER CODE		
N/A			N/A		

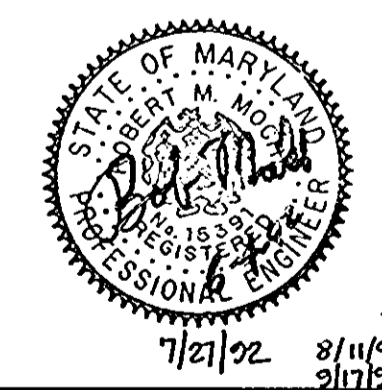

MILDENBERG, MOCHI & ASSOCIATES, INC.  
 ENGINEERS - SURVEYORS - PLANNERS  
 3300 North Ridge Road, Suite 235, Ellicott City, Maryland 21045-3350  
 (410) 461-0078 D.C. Metro: (301) 621-5168 Fax: (410) 750-6340



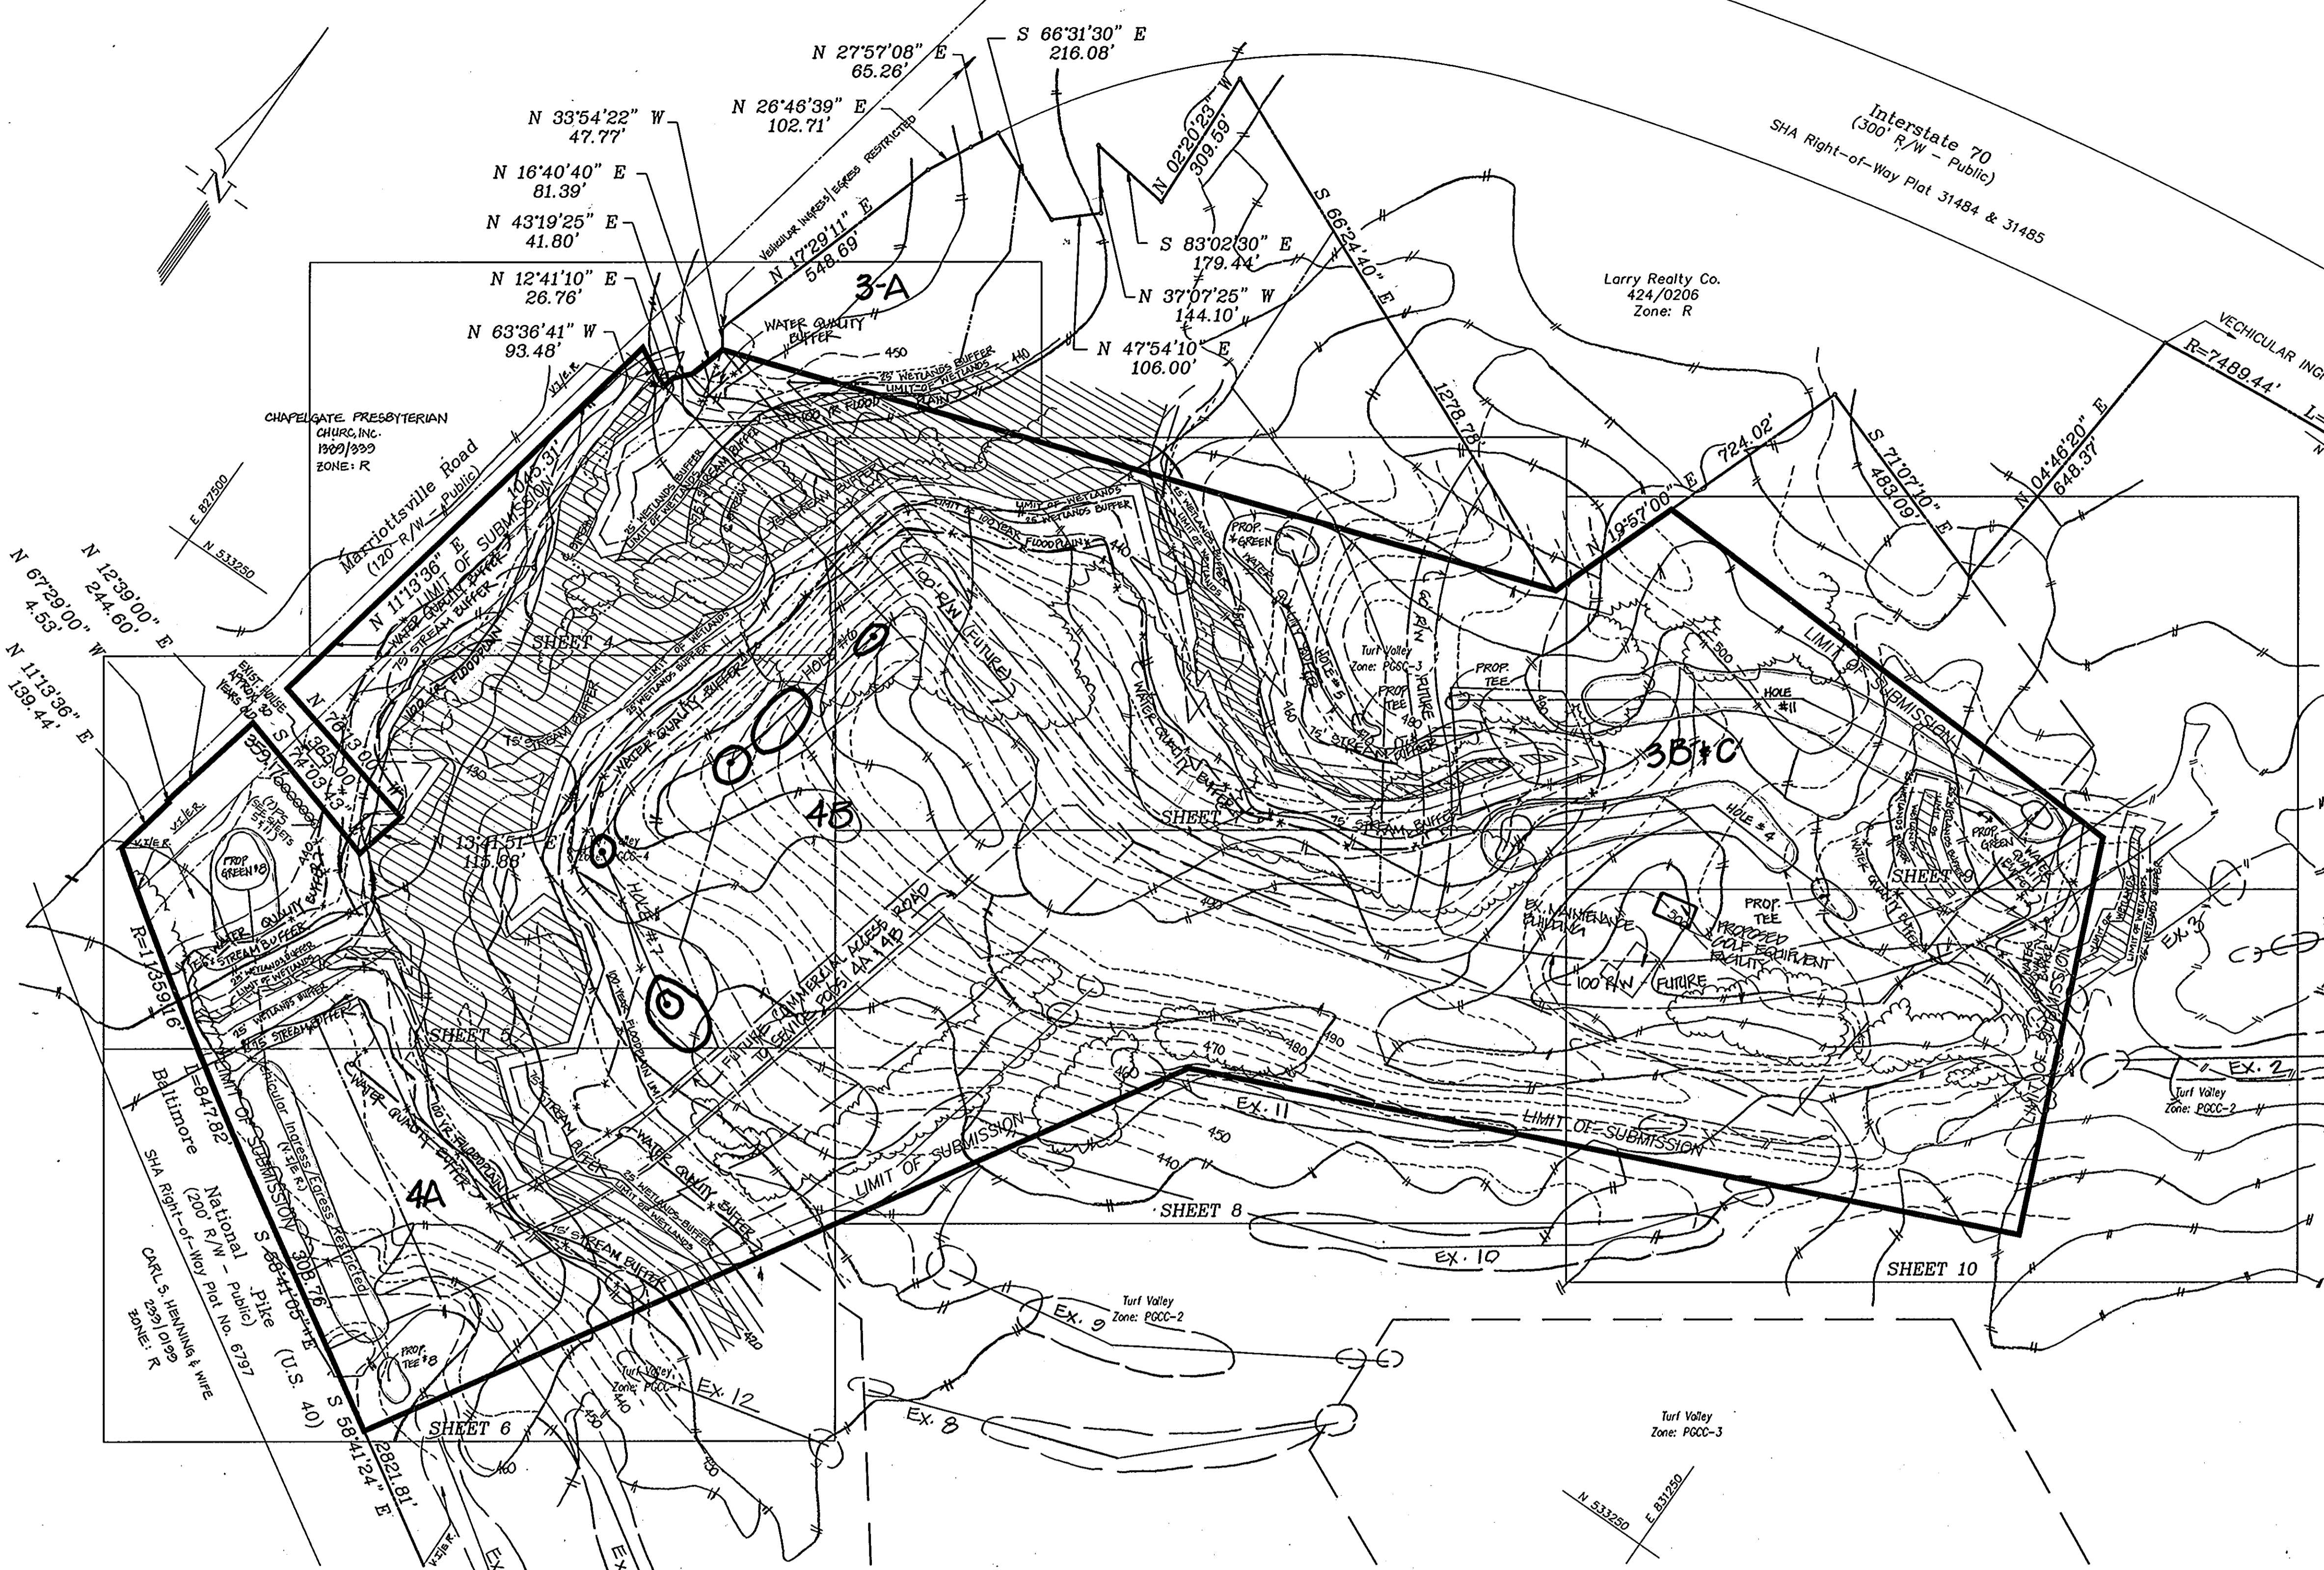

- GENERAL NOTES**
- All construction shall be in accordance with the latest standards and specifications of Howard County plus MSHA standards and specifications if applicable.
  - Total area of PGCC-1, PGCC-2, PGCC-3 & PGCC-4 = 29,181,279.60 sq. ft. = 669.91 Ac.
  - Total area of Limit of Submission = 5,674,561.20 sq. ft. = 130.27 Ac.  
Total area of Limit of Development = 2,348,564.55 sq. ft. = 53.92 Ac.  
Percentage of Golf/Open Space within Limits of Submission = 100%
  - Total Disturbed Area = 222,752.40 sq. ft. = 22.79 Ac.
  - Existing Zoning: PGCC
  - FDP Reference: FDP PGCC-1  
FDP PGCC-2 & Part of PGCC-3  
FDP Part of PGCC-3 & PGCC-4
  - Parking has been provided under SDP-87-30
  - The contractor shall notify the Department of Public Works/Bureau of Construction Inspection at (410) 792-7272 at least five (5) working days prior to the start of work.
  - The contractor shall notify "Miss Utility" at 1-800-257-7777 at least 48 hours prior to any excavation work.
  - Floodplain delineation taken from Little Patuxent River Floodplain Study - September 1987 prepared by Bernard Johnson, Inc.
  - Water and sewer will not be utilized for this golf course.
  - This plan is subject to FDP PGCC-1, FDP PGCC-2 & Part of PGCC-3, Part of PGCC-3 & PGCC-4 and S-86-13.
  - For details of grading, see grading and sediment control plan.
  - Existing trees around the fairways, tees and greens will remain.
  - No structures are proposed for this site development plan.
  - Wetlands delineation taken from study performed by Exploration Research, Inc. dated September, 1988 and approved by Howard County
  - Stormwater Management for this project is subject to the "Conceptual Stormwater Management Study" prepared by Mildenberg, Mochi & Associates and submitted to Howard County Department of Public Works - dated April 10, 1992.
  - This project is subject to the "Traffic Impact Analysis for Turf Valley County Club" prepared by The Traffic Group, Inc. - dated March 31, 1986.
  - Planning Board Case No: 181  
Approval Date: 1-22-86, 8-30-89
  - Previous File:  
S-86-13  
FDP PGCC-1  
FDP PGCC-2 & Part of PGCC-3  
FDP Part of PGCC-3 & PGCC-4
  - For bearings and distances of development pods see FDP, Turf Valley, Part of PGCC-3 and PGCC-4.
  - The Water Quality Buffer is provided as a measure of water quality as required for stormwater management. This undisturbed ground is provided for golf course development only. Future development within this buffer may occur provided that water quality measures are provided for the disturbed areas.
  - No cart paths are proposed under this site development plan.
  - No irrigation system is proposed under this site development plan.
  - For details of plantings around green no. 6 see sheets 5 and 8.
  - THIS RED LINE REVISION IS APPROVED BY THE HOWARD COUNTY PLANNING BOARD ON MARCH 16, 1993.**

NOTE: THIS PLAN SHOWS APPROXIMATE LOCATION OF HOLES, FOR DETAIL OF INDIVIDUAL HOLES SEE SHEETS 4 THRU 10.

APPROVED: HOWARD COUNTY DEPARTMENT OF PLANNING & ZONING  
*James B. Smith* 10/20/92  
 DIRECTOR DATE  
*Emma Helmuth* 10/19/92  
 CHIEF, DIVISION OF COMMUNITY PLANNING AND LAND DEVELOPMENT DATE

APPROVED: HOWARD COUNTY DEPARTMENT OF PUBLIC WORKS FOR STORM DRAINAGE SYSTEMS AND ROADS  
*James T. Kwan* 10/6/92  
 DIRECTOR DATE  
*William J. Riley* 10-1-92  
 CHIEF, BUREAU OF ENGINEERING DATE

REVIEWED: HOWARD COUNTY HEALTH DEPARTMENT NO WATER OR SANITARY FACILITIES REQUIRED  
*John B. ...* 10-13-92  
 COUNTY HEALTH OFFICER DATE

APPROVED: REVIEWED FOR HOWARD COUNTY SOIL CONSERVATION DISTRICT AND MEETS TECHNICAL REQUIREMENTS.  
*James M. Helmuth* 9/24/92  
 S. SOIL CONSERVATION SERVICE DATE

APPROVED: THIS DEVELOPMENT IS APPROVED FOR EROSION AND SEDIMENT CONTROL BY THE HOWARD COUNTY SOIL CONSERVATION DISTRICT.  
*John R. ...* 9/24/92  
 HOWARD SOIL CONSERVATION DISTRICT DATE

PLAN APPROVAL STAMP  
 APPROVED  
 9-15-92

DEVELOPER'S CERTIFICATE  
 I/We certify that all development and construction will be done in accordance with this plan of development and plan for erosion and sediment control and that all responsible personnel involved in the construction of this project will have a certificate of attendance at a Department of the Environment approved training program for the control of sediment and erosion before beginning the project. I also authorize periodic onsite inspection by the Howard County Soil Conservation District or their authorized agents, as or deemed necessary.  
*Dus Mangione* 6/8/92  
 Signature of Developer Date  
 ENGINEER'S CERTIFICATE  
 I hereby certify that this plan for erosion and sediment control represents a practical and workable plan based on my personal knowledge of the site conditions and that it was prepared in accordance with the requirements of the Howard County Soil Conservation District.  
*Robert M. Mochi, P.E.* 6-4-92  
 Date

OWNER  
 MANGIONE ENTERPRISES OF TURF VALLEY  
 1205 YORK ROAD - PENTHOUSE  
 LUTHERVILLE, MARYLAND 21093

SUBDIVISION NAME					
TURF VALLEY WEST GOLF COURSE PROPOSED SIX HOLES					
SECT./AREA	LOT/PARCEL	PREVIOUS FILE			
N/A	50 & P/O	S-86-13, FDP PGCC-1, FDP PGCC-2 & PART OF PGCC-3 FDP PART OF PGCC-3 & PGCC-4			
PLAT No.	BLOCK No.	ZONE	TAX MAP	ELEC. DIST.	CENSUS
920/205 1269/124	10, 11, 16	PGCC	16	3	6022 & 6030
WATER CODE			SEWER CODE		
N/A			N/A		

date	2007.00	illustration	TIP	approval
project	92007.00	illustration	TIP	approval
scale	1" = 200'	scale	1" = 200'	scale



no.	description	date
1	REVISION: ...	7/18/92
2	REVISION: ...	7/18/92
3	REVISION: ...	7/18/92
4	REVISION: ...	7/18/92
5	REVISION: ...	7/18/92
6	REVISION: ...	7/18/92
7	REVISION: ...	7/18/92

PROPOSED SIX HOLES  
**TURF VALLEY WEST GOLF COURSE**  
 HOWARD COUNTY, MARYLAND  
 ELECTION DISTRICT No. 3  
**SITE DEVELOPMENT PLAN**

MILDENBERG, MOCHI & ASSOCIATES, INC.  
 ENGINEERS - PLANNERS  
 3300 North Ridge Road, Suite 235, Ellicott City, Maryland 21043-3350  
 (410) 461-0078 D.C. Metro: (301) 621-5768 Fax: (410) 950-6340

2 OF 11  
 SDP-92-116



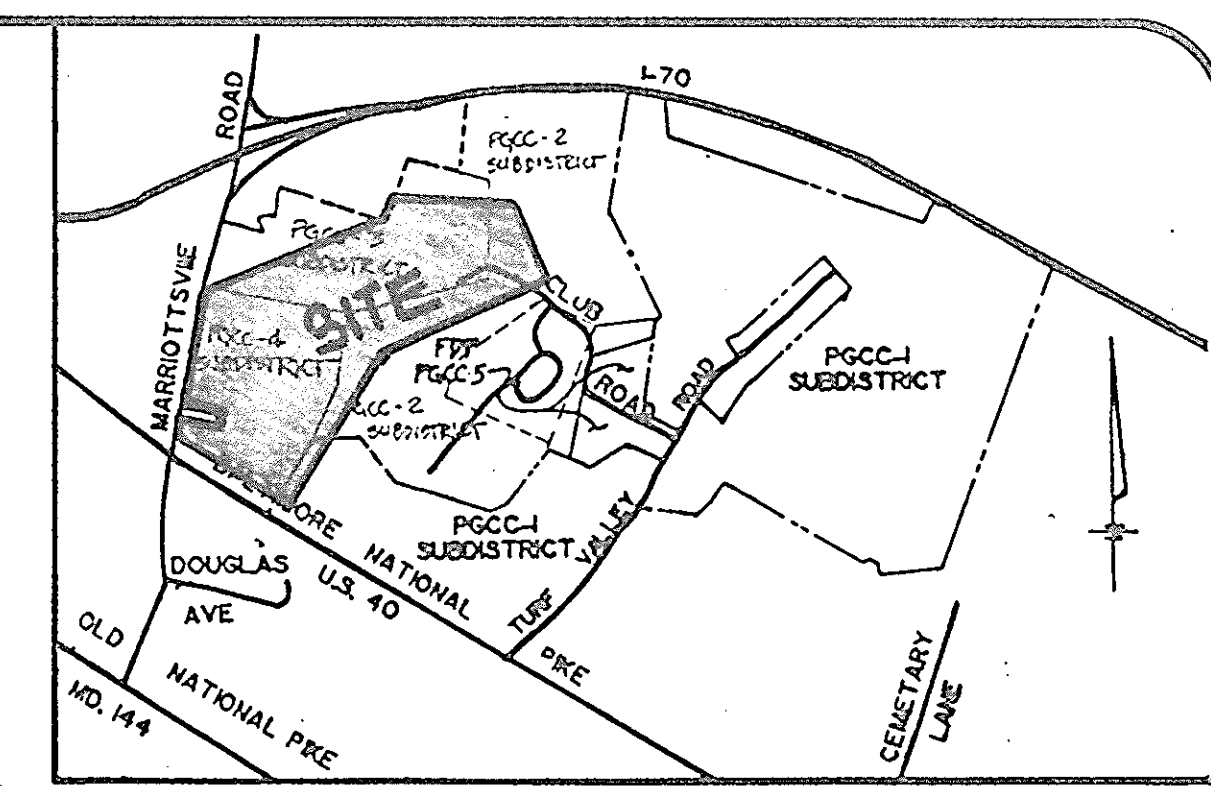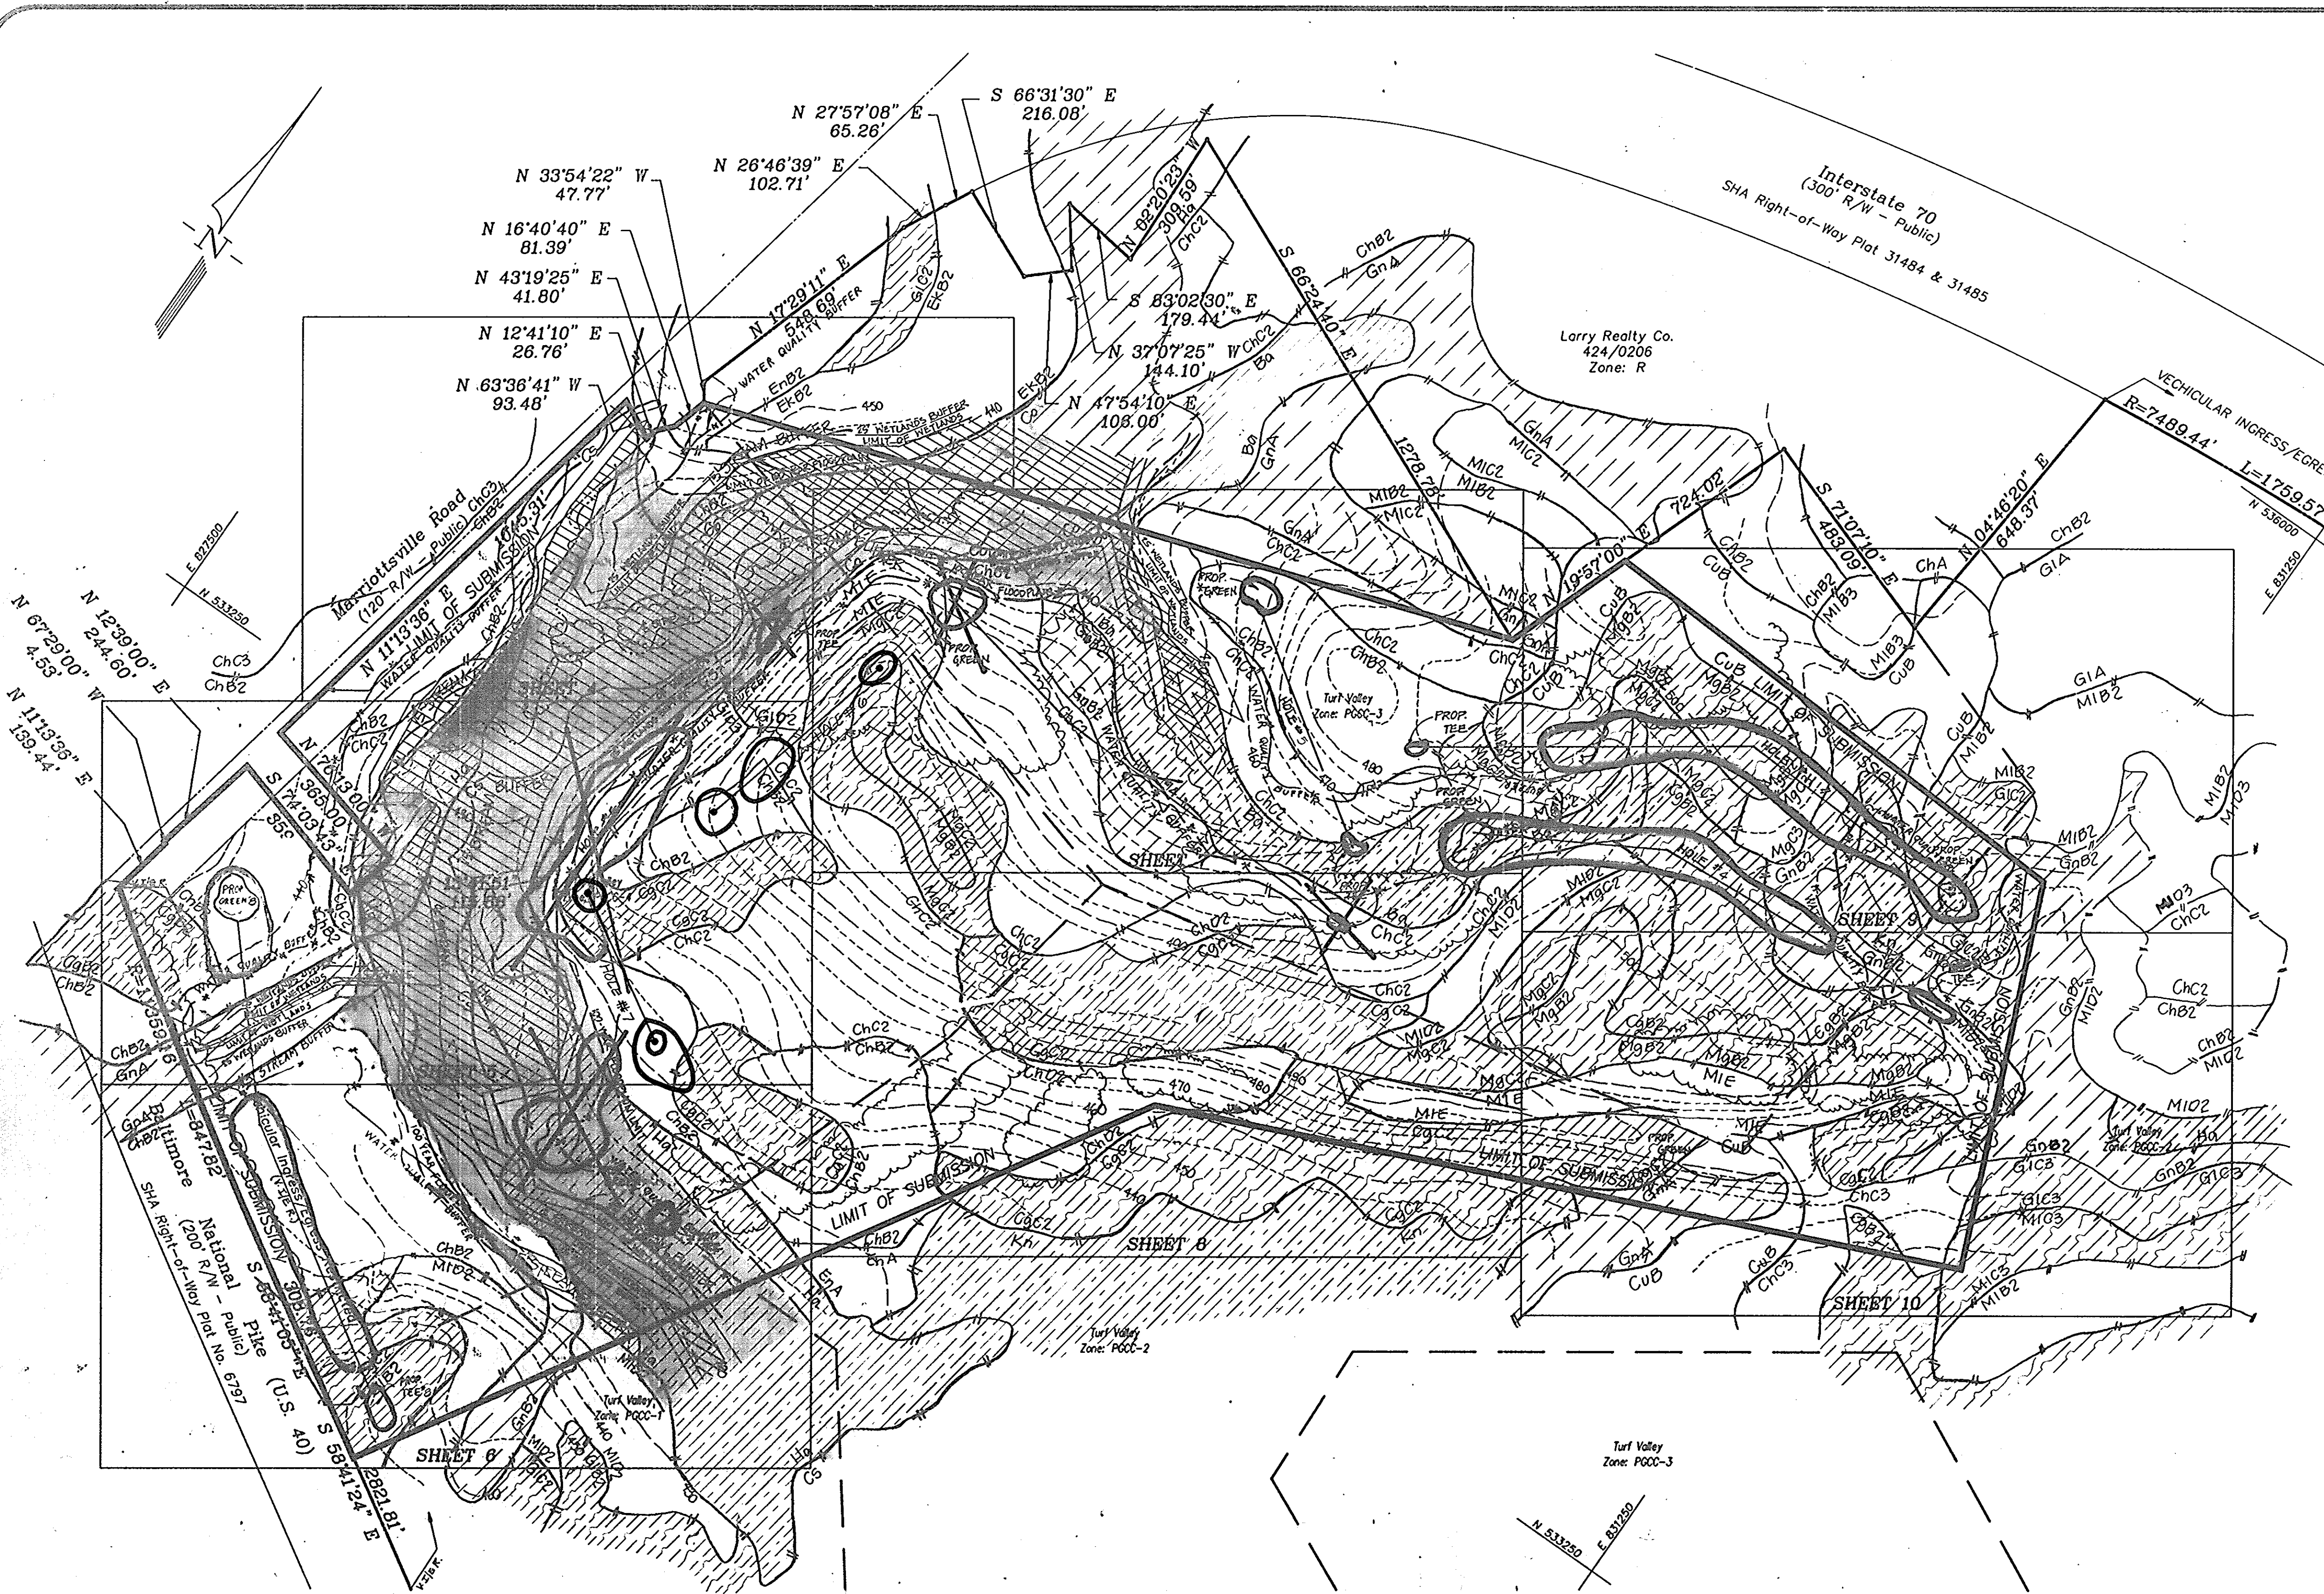

VICINITY MAP  
SCALE: 1" = 2,000'

SOILS

- Ekb2 - Elioak Silt Loam
- EnA - Elsinboro Loam
- EnB2 - Elsinboro Loam
- ChA - Chester Silt Loam
- ChB2 - Chester Silt Loam
- ChC2 - Chester Silt Loam
- ChD2 - Chester Silt Loam
- CgB2 - Chester Gravelly Silt Loam
- CgC2 - Chester Gravelly Silt Loam
- Cs - Comus Silt Loam
- Co - Codorus Silt Loam
- CuB - Comus Silt Loam
- Ha - Hatboro Silt Loam
- Kn - Kinkora Silt Loam
- Ba - Baile Silt Loam
- GIA - Glenelg Silt Loam
- GIB2 - Glenelg Silt Loam
- GIC2 - Glenelg Silt Loam
- GIC3 - Glenelg Silt Loam
- GID2 - Glenelg Silt Loam
- GID3 - Glenelg Silt Loam
- GnA - Glenville Silt Loam
- GnB2 - Glenville Silt Loam
- MIB2 - Manor Loam
- MIC2 - Manor Loam
- MIC3 - Manor Loam
- MID2 - Manor Loam
- MID3 - Manor Loam
- MIF - Manor Loam
- MgB2 - Manor Gravelly Loam
- MgC2 - Manor Gravelly Loam
- MgC3 - Manor Gravelly Loam

- Hydric soils
- Soils with Possible hydric inclusions
- Soils with slopes < 15%, significant erosion potential

NOTES:  
1. THIS PLAN INDICATES APPROXIMATE LOCATION OF HOLES, SEE SHEETS 4 THRU 10 FOR EXACT LOCATIONS OF HOLES WITH RELATION TO SOILS.  
2. GOLF HOLES NO. 4 & 5 ARE NOT INCLUDED IN THIS SUBMISSION.

APPROVED: HOWARD COUNTY DEPARTMENT OF PLANNING & ZONING  
*Juanita R. Ratts* 10/20/92  
DIRECTOR DATE  
*Emmas Kilmast* 10/19/92  
CHIEF, DIVISION OF COMMUNITY PLANNING AND LAND DEVELOPMENT DATE

APPROVED: HOWARD COUNTY DEPARTMENT OF PUBLIC WORKS FOR STORM DRAINAGE SYSTEMS AND ROADS  
*James G. Brown* 10/7/92  
DIRECTOR DATE  
*William S. Kelly* 10-1-92  
CHIEF, BUREAU OF ENGINEERING DATE

REVIEWED: HOWARD COUNTY HEALTH DEPARTMENT NO WATER OR SANITARY FACILITIES REQUIRED  
*Joyann Bell* 10-13-92  
COUNTY HEALTH OFFICER DATE

APPROVED: REVIEWED FOR HOWARD COUNTY SOIL CONSERVATION DISTRICT AND MEETS TECHNICAL REQUIREMENTS.  
*James M. Delaney* 9/24/92  
S.O. SOIL CONSERVATION SERVICE DATE

APPROVED: THIS DEVELOPMENT IS APPROVED FOR EROSION AND SEDIMENT CONTROL BY THE HOWARD COUNTY SOIL CONSERVATION DISTRICT.  
*John R. Rhoads* 9/24/92  
HOWARD SOIL CONSERVATION DISTRICT DATE

PLAN APPROVAL STAMP  
9-15-92

DEVELOPER'S CERTIFICATE  
I/We certify that all development and construction will be done in accordance with this plan of development and plan for erosion and sediment control and that all responsible personnel involved in the construction of this project will have a certificate of attendance at a Department of the Environment approved training program for the control of sediment and erosion before beginning the project. I also authorize periodic onsite inspection by the Howard County Soil Conservation District or their authorized agents, as are deemed necessary.  
*Louis Mangione* 6/8/92  
Signature of Developer Date

ENGINEER'S CERTIFICATE  
I hereby certify that this plan for erosion and sediment control represents a practical and workable plan based on my personal knowledge of the site conditions and that it was prepared in accordance with the requirements of the Howard County Soil Conservation District.  
*Robert M. Mochl, P.E.* 6-4-92  
Signature of Engineer Date

OWNER  
MANGIONE ENTERPRISES OF TURF VALLEY  
1205 YORK ROAD - PENTHOUSE  
LUTHERVILLE, MARYLAND 21093

SUBDIVISION NAME <b>TURF VALLEY WEST GOLF COURSE</b> PROPOSED SIX HOLES					
SECT./AREA ---	LOT/PARCEL 50 & 1/2 B	PREVIOUS FILE S-84-10, FDP PGCC-1, FDP PGCC-2 & PART OF PGCC-3 FDP PART OF PGCC-5 & PGCC-4			
PLAT No. 920/285 1203/724	BLOCK No. 10, 11, 16	ZONE PGCC	TAX MAP 16	ELEC. DIST. 3	CENSUS 6022 & 6030
WATER CODE N/A			SEWER CODE N/A		


PROJECT	DATE	BY	APPROVAL
9207002.DWG	MAY 92	engineering	TIP
92007.00	MAY 92	illustration	TIP
			approval
			scale 1" = 200'

NO.	DATE	REVISIONS
4	4/8/92	REVISED HOLES 6 & 7 PER DPZ COMMENTS
3	4/8/92	ADDED HOLES 6 & 7, REVISED HOLES 8/9/10/11/12/13/14/15
2	8/11/92	REMOVED HOLE 7, RELOCATED HOLE 6 & HOLES 8 & 9
1	1-24-92	ADDED WATER QUALITY BUFFER, REVISED PER HOWARD Co. PREP. DEP. & HOOD CONSULTANTS

PROPOSED SIX HOLES  
**TURF VALLEY WEST GOLF COURSE**  
ELECTION DISTRICT No. 3  
HOWARD COUNTY, MARYLAND  
SOIL MAP

MILDENBERG, MOCHL & ASSOCIATES, INC.  
DIRECTORS • SURVEYORS • PLANNERS  
3300 North Ridge Road, Suite 235, Ellicott City, Maryland 21043-3350  
(410) 461-0078 D.C. Metro: (301) 621-5768 Fax: (410) 750-6340



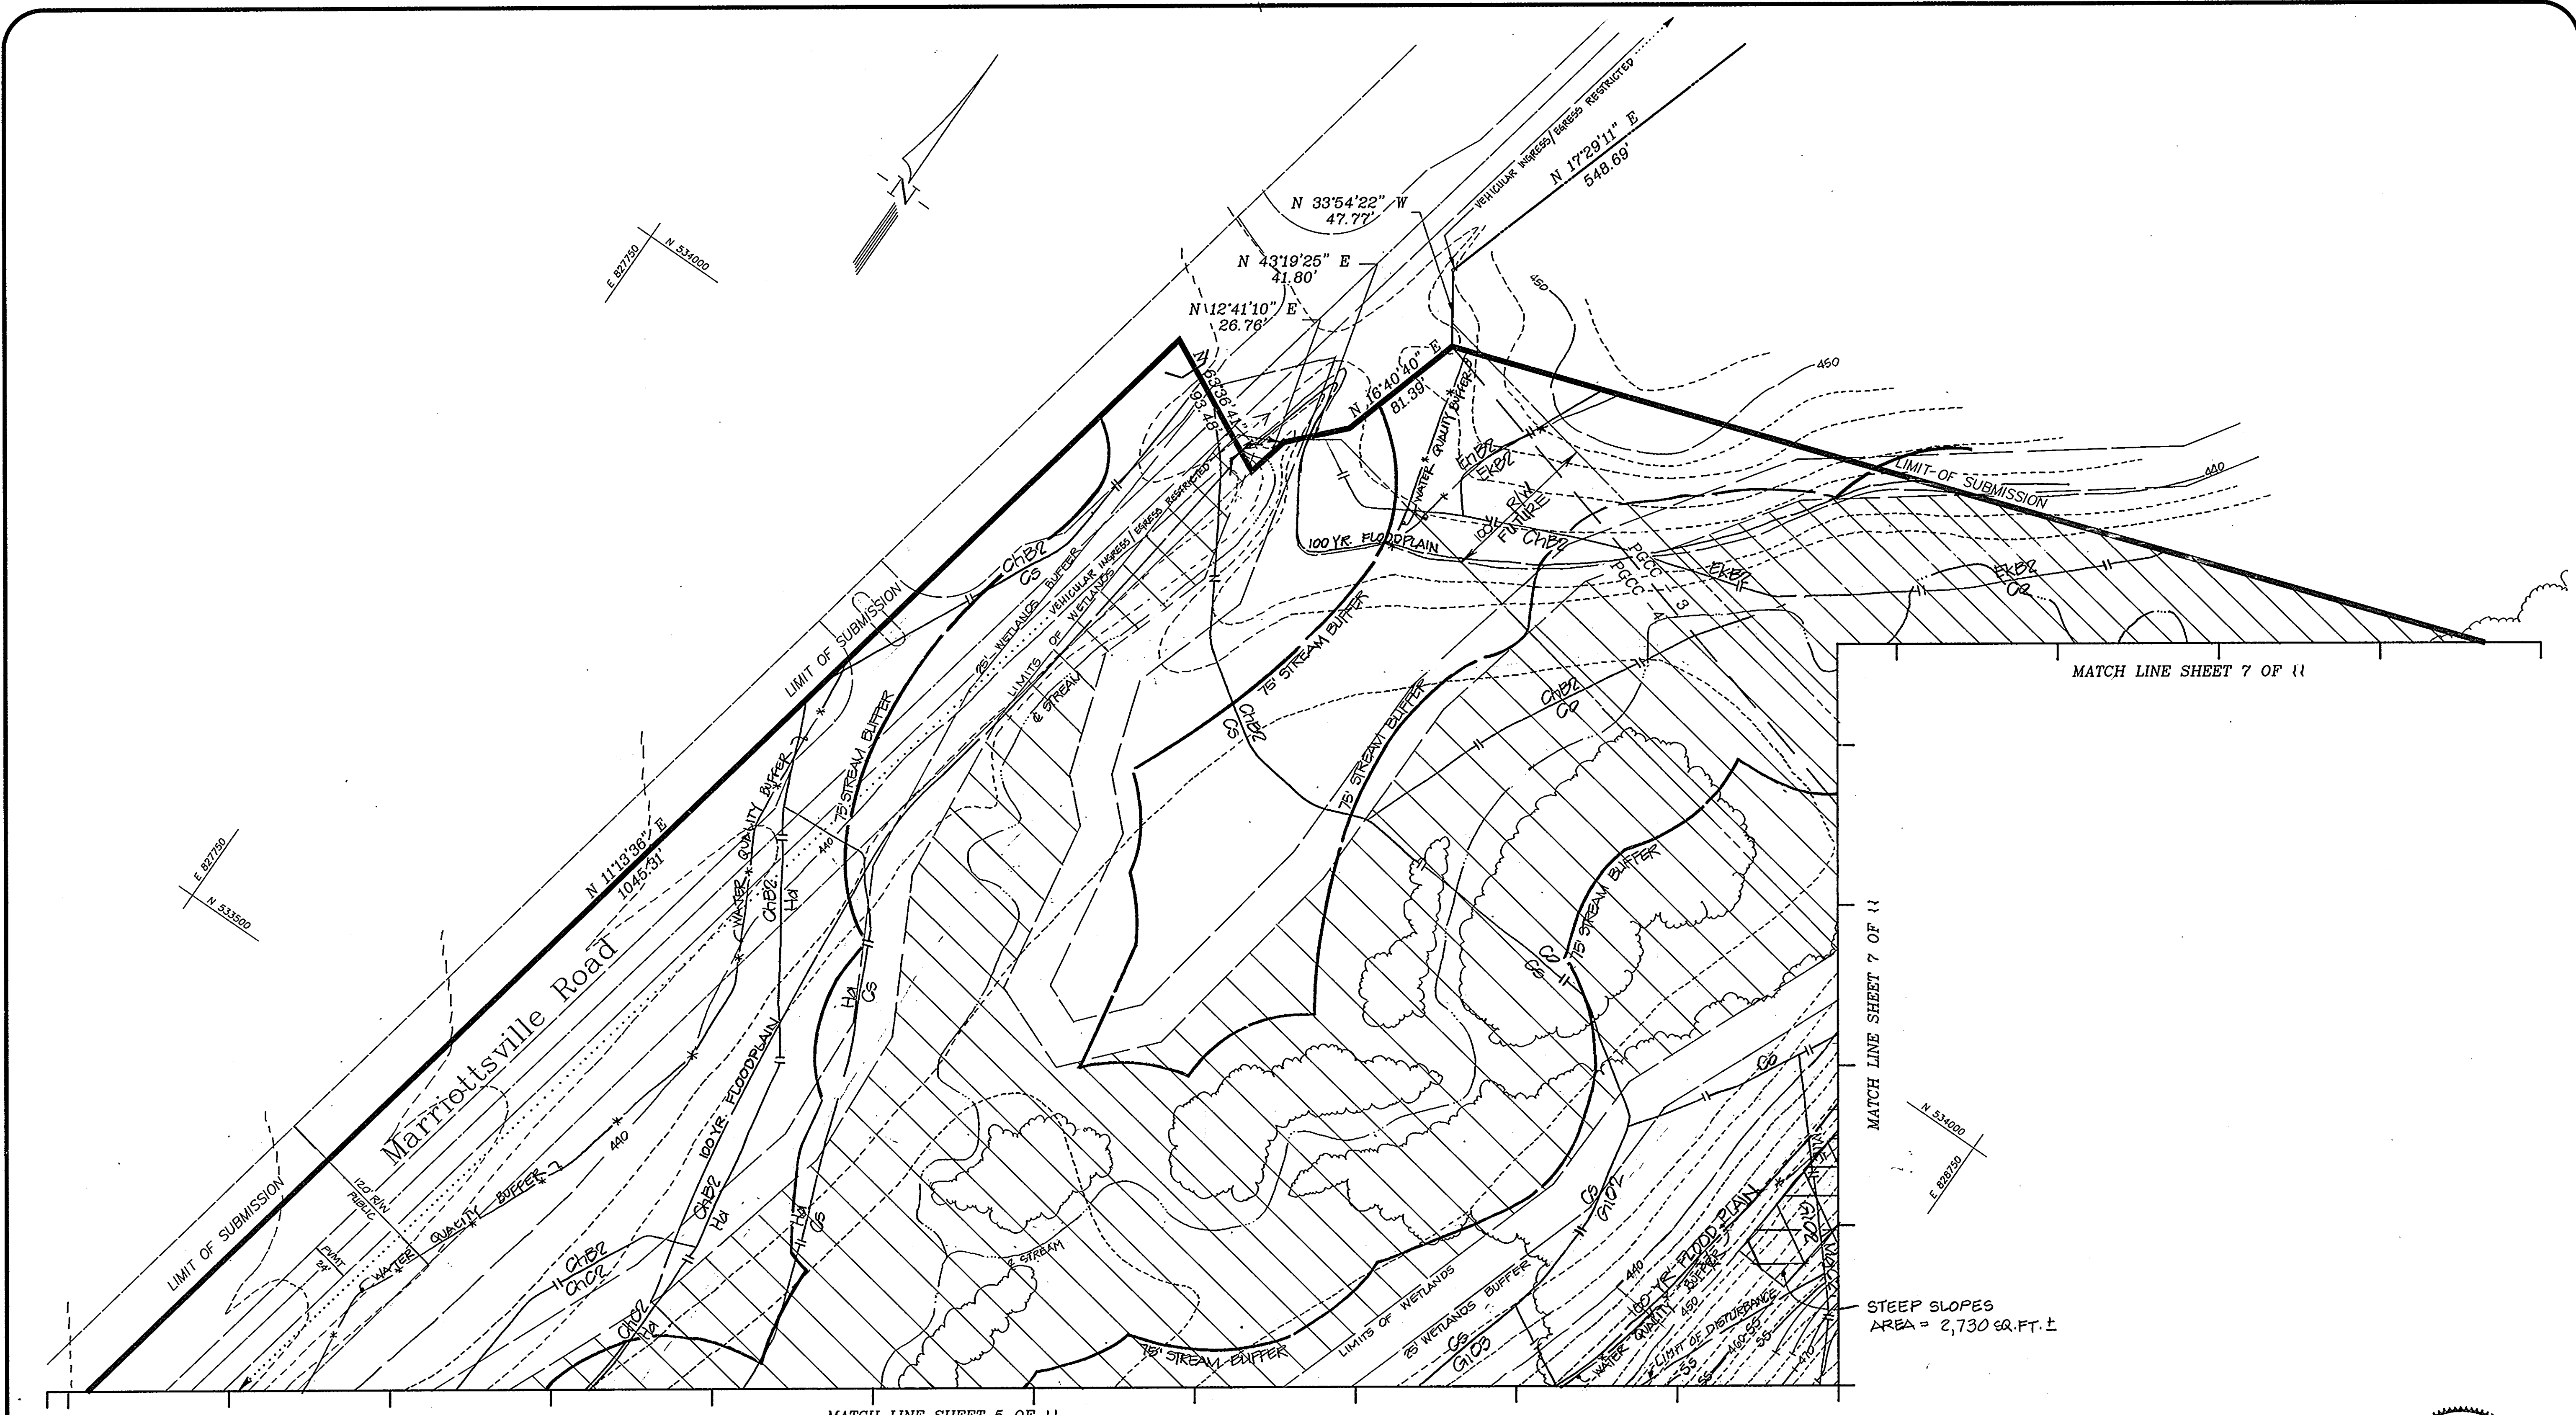

project	92007.00	date	MAY 92
illustration	TIP	engineering	TIP
scale	1" = 50'	approval	RAM

no.	4	date	4/8/92
description	REVISED HOLE #6 PER DPE COMMENTS	revision	1/24/92
	3		4/8/92
	2		4/8/92
	1		7/24/92

PROPOSED SIX HOLES  
**TURF VALLEY WEST GOLF COURSE**  
 ELECTION DISTRICT No. 3    HOWARD COUNTY, MARYLAND  
**GRADING & SEDIMENT CONTROL PLAN**

APPROVED: HOWARD COUNTY DEPARTMENT OF PLANNING & ZONING  
*James S. Ranta* 10/20/92  
 DIRECTOR DATE  
*Emmanuel Helms* 10/19/92  
 CHIEF, DIVISION OF COMMUNITY PLANNING AND LAND DEVELOPMENT DATE

APPROVED: HOWARD COUNTY DEPARTMENT OF PUBLIC WORKS FOR STORM DRAINAGE SYSTEMS AND ROADS  
*James G. Lewis* 10/1/92  
 DIRECTOR DATE  
*Michael J. Kelly* 10-1-92  
 CHIEF, BUREAU OF ENGINEERING DATE

REVIEWED: HOWARD COUNTY HEALTH DEPARTMENT NO WATER OR SANITARY FACILITIES REQUIRED  
*Joseph P. Jones* 10-13-92  
 COUNTY HEALTH OFFICER DATE

APPROVED: REVIEWED FOR HOWARD COUNTY SOIL CONSERVATION DISTRICT AND MEETS TECHNICAL REQUIREMENTS.  
*James M. Helms* 9/24/92  
 U. S. SOIL CONSERVATION SERVICE DATE


APPROVED: THIS DEVELOPMENT IS APPROVED FOR EROSION AND SEDIMENT CONTROL BY THE HOWARD COUNTY SOIL CONSERVATION DISTRICT.  
*John R. Robertson* 9/24/92  
 HOWARD SOIL CONSERVATION DISTRICT DATE

PLAN APPROVAL STAMP  
 APPROVED  
 PLANNING BOARD  
 OF HOWARD COUNTY  
 DATE 9-15-92

DEVELOPER'S CERTIFICATE  
 I/We certify that all development and construction will be done in accordance with this plan of development and plan for erosion and sediment control and that all responsible personnel involved in the construction of this project will have a certificate of attendance at a Department of the Environment approved training program for the control of sediment and erosion before beginning the project. I also authorize periodic onsite inspection by the Howard County Soil Conservation District or their authorized agents, as are deemed necessary.  
*Louis Mangione* 6/8/92  
 Signature of Developer Date  
 ENGINEER'S CERTIFICATE  
 I hereby certify that this plan for erosion and sediment control represents a practical and workable plan based on my personal knowledge of the site conditions and that it was prepared in accordance with the requirements of the Howard County Soil Conservation District.  
*Robert M. Mochi* 6-7-92  
 Robert M. Mochi, P.E. Date


OWNER  
**MANGIONE ENTERPRISES OF TURF VALLEY**  
 1205 YORK ROAD - PENTHOUSE  
 LUTHERVILLE, MARYLAND 21093

SUBDIVISION NAME TURF VALLEY WEST GOLF COURSE PROPOSED SIX HOLES					
SECT./AREA N/A	LOT/PARCEL 50 & P/08	PREVIOUS FILE S-86-13, FDP PGCC-1 FDP PGCC-2 & PART OF PGCC-3 FDP PART OF PGCC-3 & PGCC-4			
PLAT No. 920/285 1260/12A	BLOCK No. 10, 11, 16	ZONE PGCC	TAX MAP 16	ELEC. DIST. 3	CENSUS G022 & G030
WATER CODE N/A			SEWER CODE N/A		

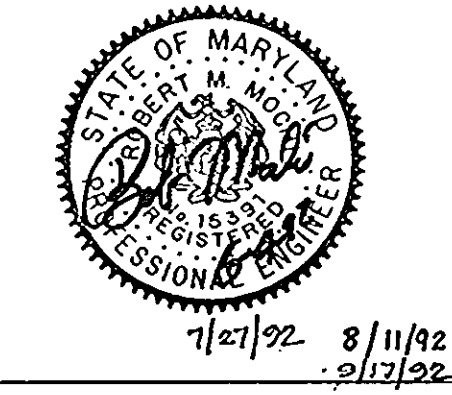

**MILDENBERG, MOCHI & ASSOCIATES, INC.**  
 ENGINEERS • SURVEYORS • PLANNERS  
 3300 North Ridge Road, Suite 235, Ellicott City, Maryland, 21043-3350  
 (410) 461-0078    D.C. Metro: (301) 621-5768    Fax: (410) 750-6340



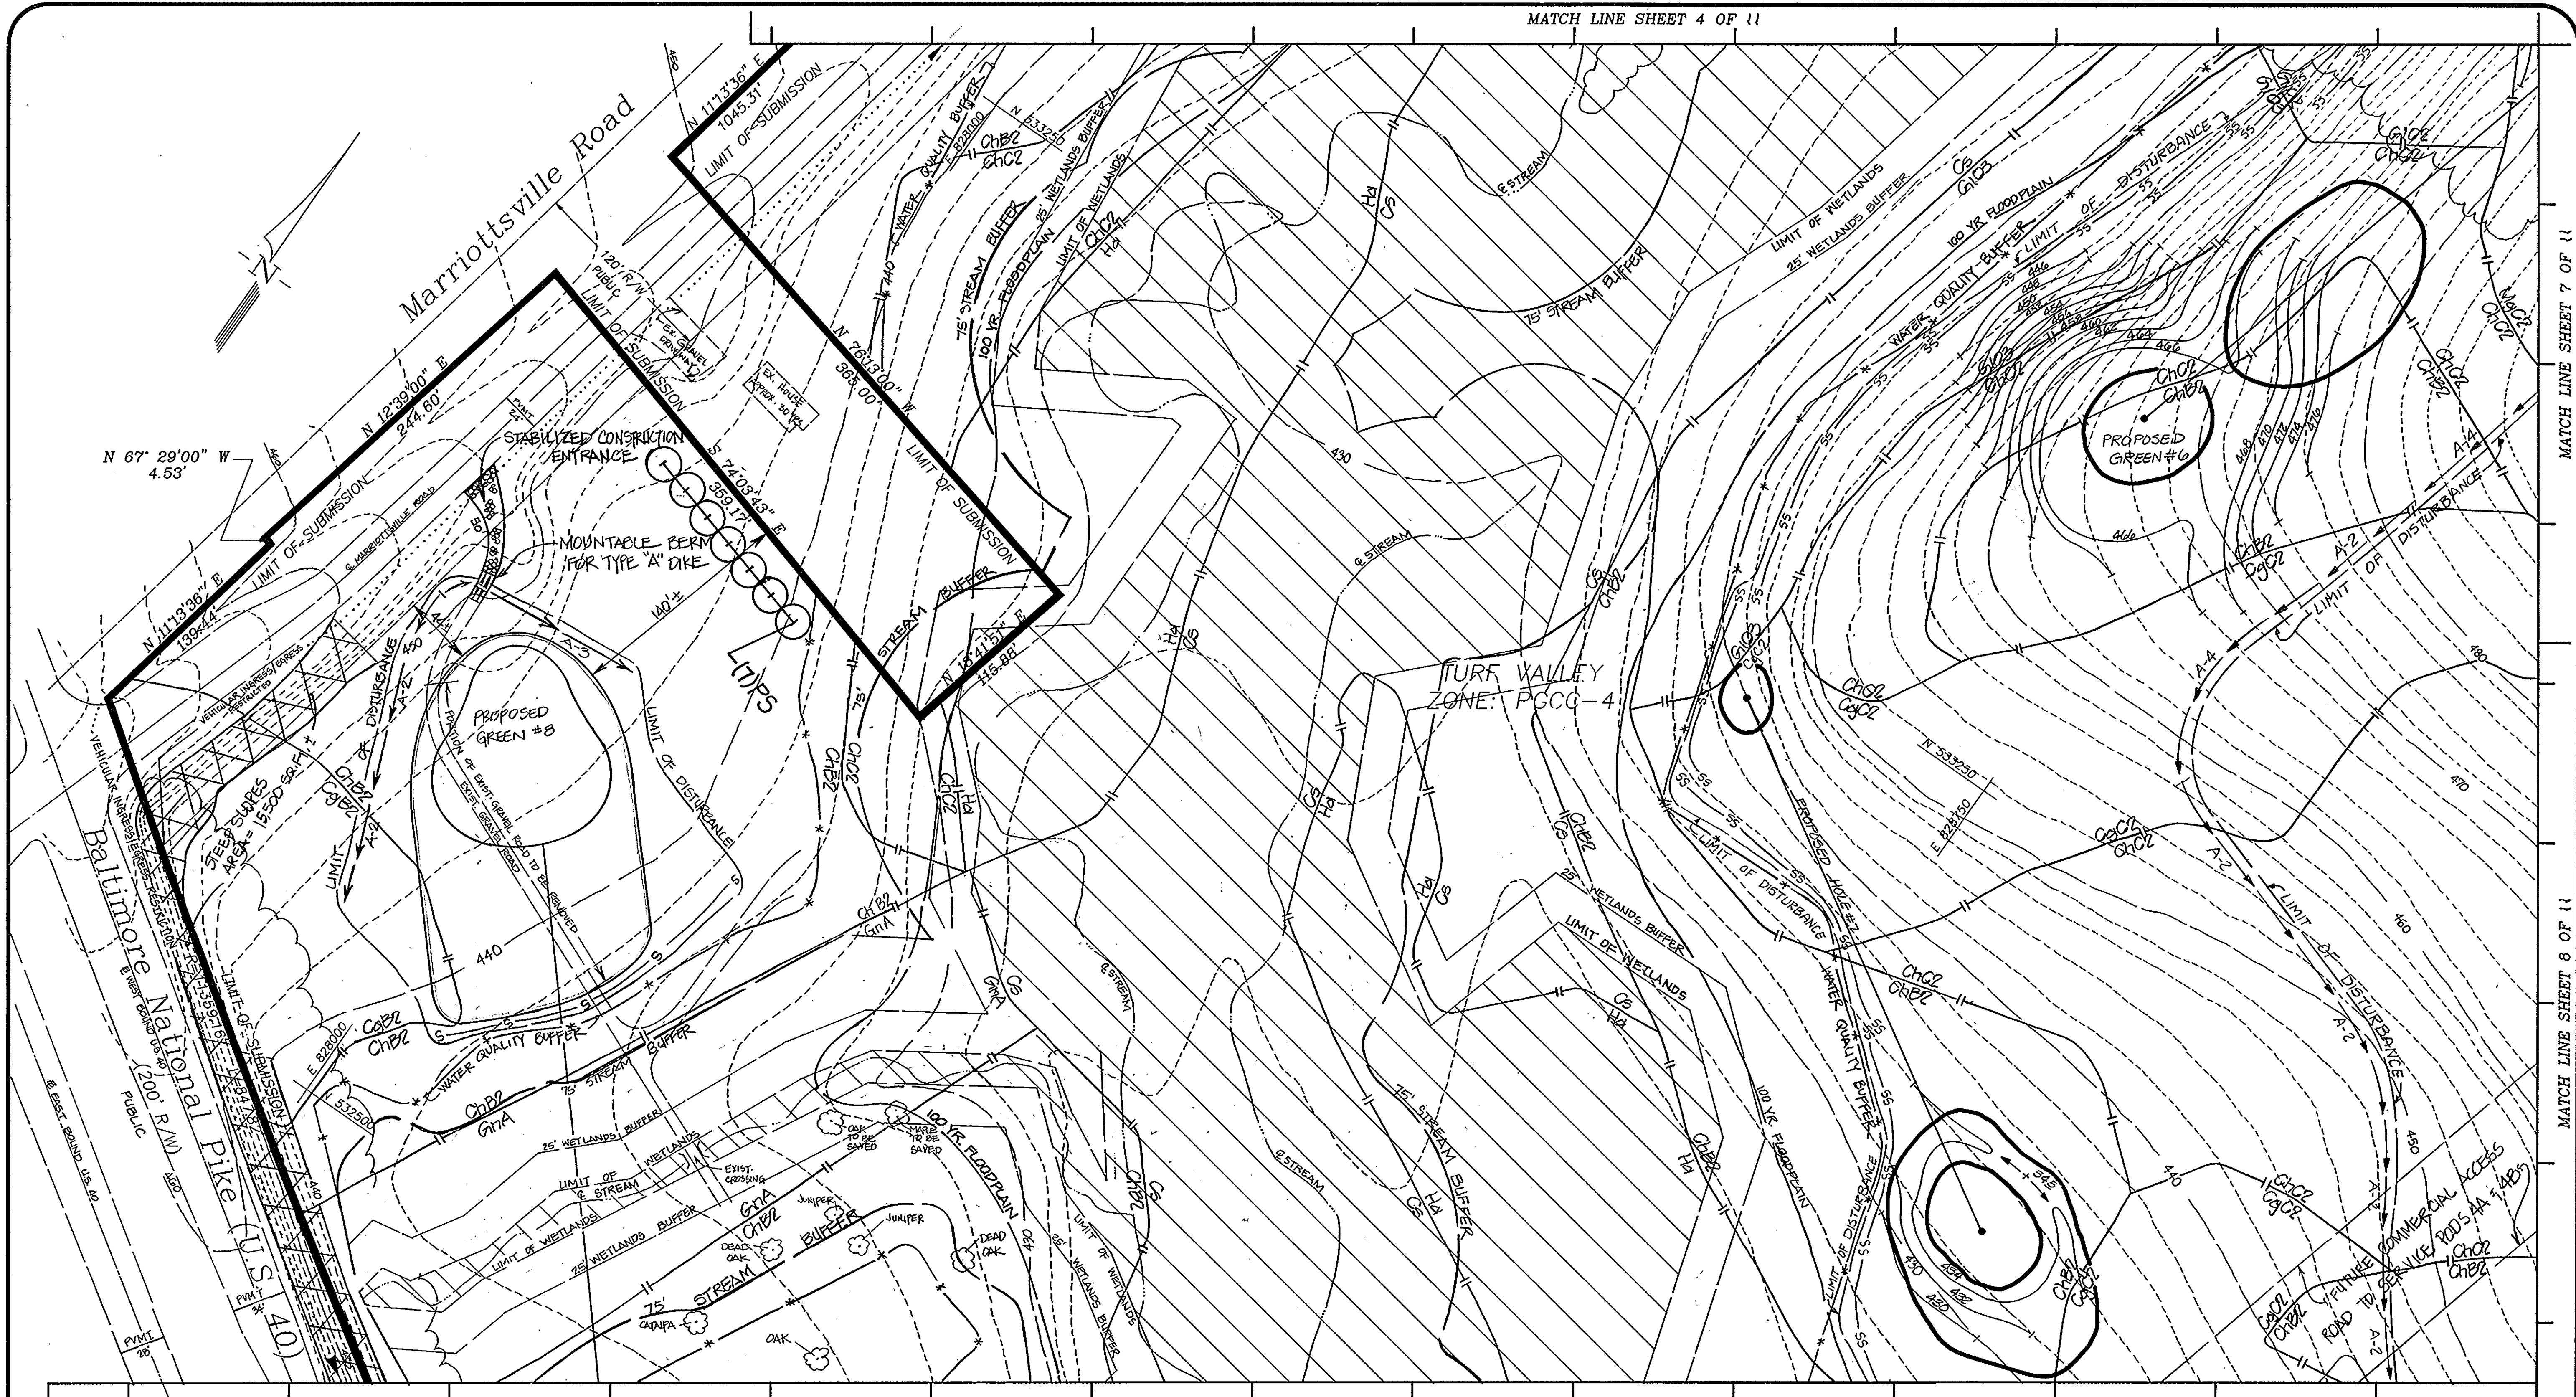

92007005.DWG

Project	92007.00	date	MAY 92
Illustration	TIP	scale	1" = 50'
Approval	TIP	date	1/24/92

NO.	DESCRIPTION	DATE
1	REVISED PLAN SET PER PER COMMENTS	4/18/92
2	REVISED PLAN SET PER PER COMMENTS	4/18/92
3	REVISED PLAN SET PER PER COMMENTS	4/18/92
4	REVISED PLAN SET PER PER COMMENTS	4/18/92
5	REVISED PLAN SET PER PER COMMENTS	4/18/92

**TURF VALLEY WEST GOLF COURSE**  
 ELECTION DISTRICT No. 3  
 HOWARD COUNTY, MARYLAND  
 GRADING & SEDIMENT CONTROL PLAN

**MILDENBERG, MOCH & ASSOCIATES, INC.**  
 ENGINEERS - PLANNERS  
 3300 North Ridge Road, Suite 235, Ellicott City, Maryland 21043-3350  
 (410) 461-0078 D.C. Metro: (301) 621-5766 Fax: (410) 790-6340

APPROVED: HOWARD COUNTY DEPARTMENT OF PLANNING & ZONING  
*James R. Smith* 10/20/92  
 DIRECTOR DATE  
*Emma J. Holman* 10/19/92  
 CHIEF, DIVISION OF COMMUNITY PLANNING AND LAND DEVELOPMENT DATE

APPROVED: HOWARD COUNTY DEPARTMENT OF PUBLIC WORKS FOR STORM DRAINAGE SYSTEMS AND ROADS  
*James R. Smith* 10/1/92  
 DIRECTOR DATE  
*William E. Kelly* 10/1/92  
 CHIEF, BUREAU OF ENGINEERING DATE

REVIEWED: HOWARD COUNTY HEALTH DEPARTMENT NO WATER OR SANITARY FACILITIES REQUIRED  
*Joseph M. Boyles* 10-13-92  
 COUNTY HEALTH OFFICER DATE

APPROVED: REVIEWED FOR HOWARD COUNTY SOIL CONSERVATION DISTRICT AND MEETS TECHNICAL REQUIREMENTS.  
*James M. Helm* 9/24/92  
 DISTRICT SOIL CONSERVATION OFFICER DATE

APPROVED: THIS DEVELOPMENT IS APPROVED FOR EROSION AND SEDIMENT CONTROL BY THE HOWARD COUNTY SOIL CONSERVATION DISTRICT.  
*John R. Clinton* 9/24/92  
 HOWARD COUNTY SOIL CONSERVATION DISTRICT DATE

PLAN APPROVAL STAMP  
**APPROVAL**  
 PLANNING BOARD  
 OF HOWARD COUNTY  
 DATE 9-15-92


**DEVELOPER'S CERTIFICATE**  
 I/We certify that all development and construction will be done in accordance with this plan of development and plan for erosion and sediment control and that all responsible personnel involved in the construction of this project will have a certificate of attendance at a Department of the Environment approved training program for the control of sediment and erosion before beginning the project. I also authorize periodic onsite inspection by the Howard County Soil Conservation District or their authorized agents, as are deemed necessary.  
*Louis Mangione* 4/8/92  
 Signature of Developer(s) Date

**ENGINEER'S CERTIFICATE**  
 I hereby certify that this plan for erosion and sediment control represents a practical and workable plan based on my personal knowledge of the site conditions and that it was prepared in accordance with the requirements of the Howard County Soil Conservation District.  
*Robert M. Moch* 6-4-92  
 Robert M. Moch, P.E. Date

**OWNER**  
 MANGIONE ENTERPRISES OF TURF VALLEY  
 1205 YORK ROAD - PENTHOUSE  
 LUTHERVILLE, MARYLAND 21093

SUBDIVISION NAME <b>TURF VALLEY WEST GOLF COURSE</b> PROPOSED SIX HOLES					
SECT./AREA N/A	LOT/PARCEL 50 & 110 B	PREVIOUS FILE S-80-19, PDP PAGE-1 PDP PAGE-2 & PART OF PAGE-3 PDP PART OF PAGE-3 & PAGE-4			
PLAT No. 920/105 1163/124	BLOCK No. 10.11.16	ZONE PGCC	TAX MAP 1G	ELEC. DIST. 3	CENSUS 6022 & 6030
WATER CODE N/A			SEWER CODE N/A		



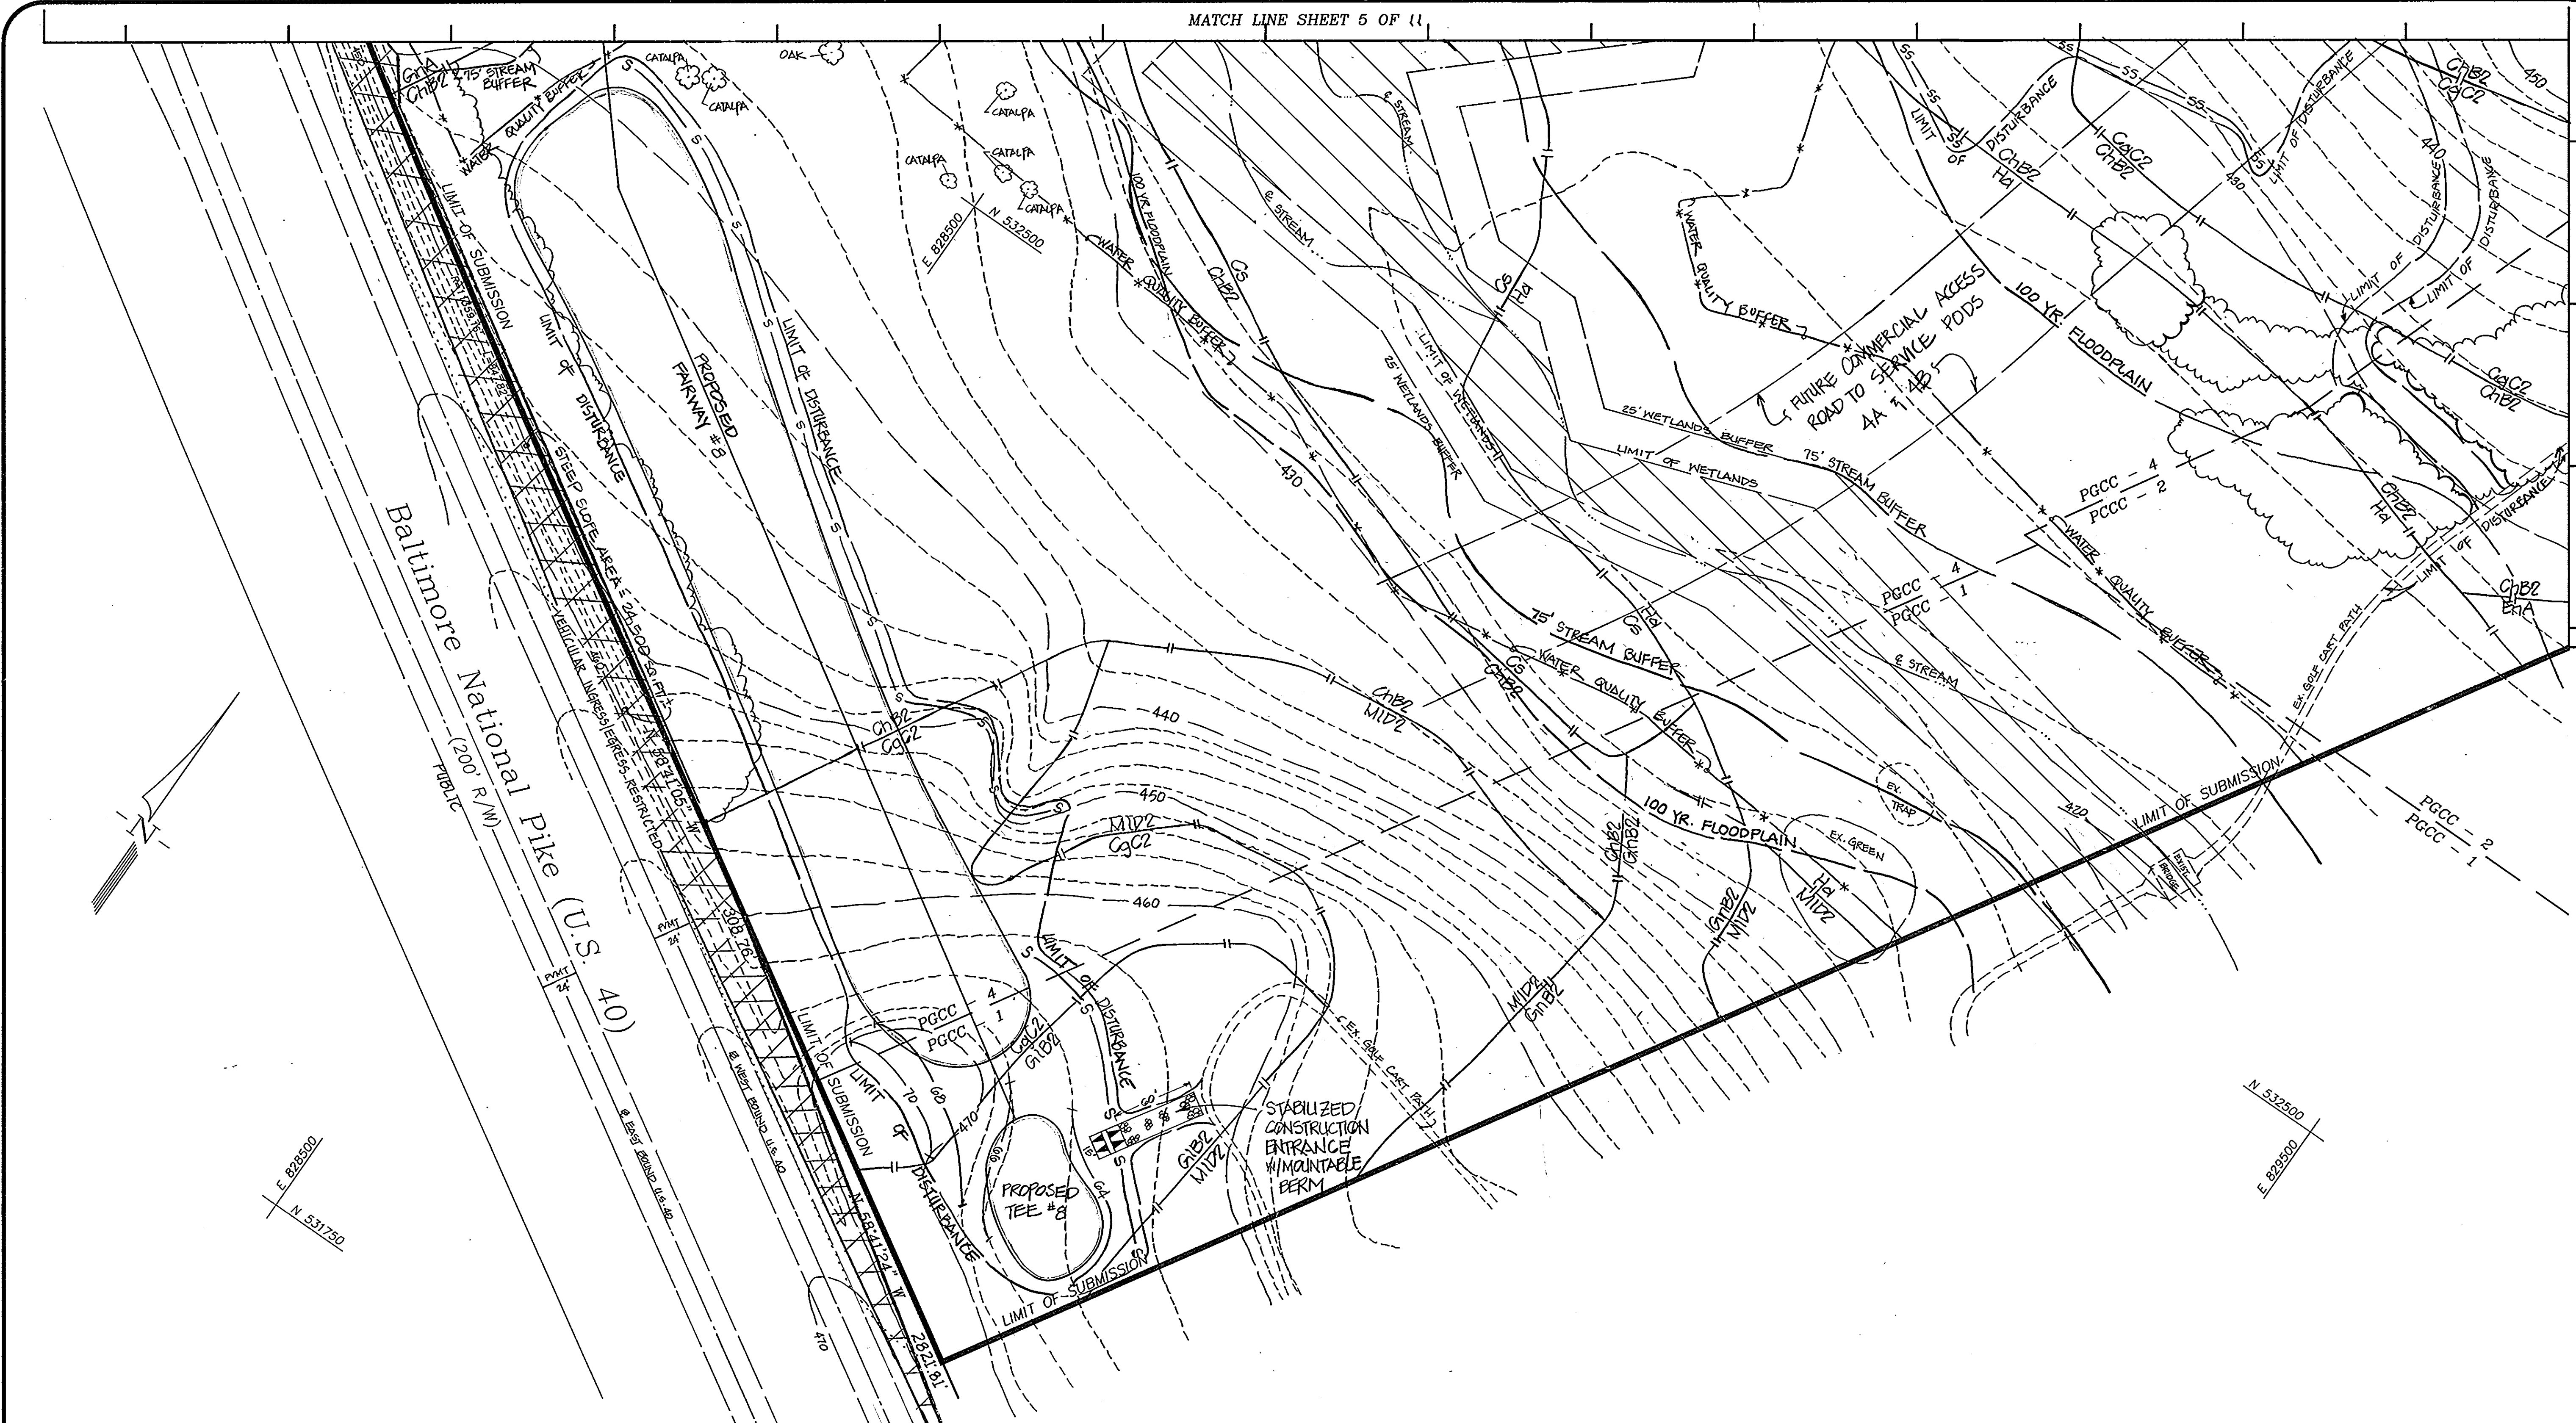

MATCH LINE SHEET 8 OF 11

project	92007.00	date	MAY 92
illustration	TIP	scale	1" = 50'
engineering	TIP	approval	RM

no.	description	revision	date
4	REVISED HOLE #7 PER DPE COMMENTS		4/18/92
3	REVISED LINE REVISIONS TO PFC		4/18/92
2	REMOVED HOLE #7 REVISIONS TO PFC		8/10/92
1	PROPOSED HOLE #8 WITH 100' YEAR FLOODPLAIN		7/24/92

PROPOSED SIX HOLES  
**TURF VALLEY WEST GOLF COURSE**  
 HOWARD COUNTY, MARYLAND  
 ELECTION DISTRICT No. 3  
**GRADING & SEDIMENT CONTROL PLAN**

**MILDENBERG MOCHI & ASSOCIATES, INC.**  
 ENGINEERS • SURVEYORS • PLANNERS  
 3300 North Ridge Road, Suite 235, Ellicott City, Maryland 21043-3350  
 (410) 461-0078 D.C. Metro: (301) 621-5766 Fax: (410) 750-6340

APPROVED: HOWARD COUNTY DEPARTMENT OF PLANNING & ZONING  
*James R. Smith* 10/20/92  
 DIRECTOR DATE  
*Elmira Holomach* 10/19/92  
 CHIEF, DIVISION OF COMMUNITY PLANNING AND LAND DEVELOPMENT DATE

APPROVED: HOWARD COUNTY DEPARTMENT OF PUBLIC WORKS FOR STORM DRAINAGE SYSTEMS AND ROADS  
*Samuel M. Brown* 10/19/92  
 DIRECTOR DATE  
*Debra M. Kelly* 10-19-92  
 CHIEF, BUREAU OF ENGINEERING DATE

REVIEWED: HOWARD COUNTY HEALTH DEPARTMENT NO WATER OR SANITARY FACILITIES REQUIRED  
*Joseph B. Jones* 10-13-92  
 COUNTY HEALTH OFFICER DATE

APPROVED: REVIEWED FOR HOWARD COUNTY SOIL CONSERVATION DISTRICT AND MEETS TECHNICAL REQUIREMENTS.  
*James M. Holomach* 9/24/92  
 CHIEF, SOIL CONSERVATION SERVICE DATE

APPROVED: THIS DEVELOPMENT IS APPROVED FOR EROSION AND SEDIMENT CONTROL BY THE HOWARD COUNTY SOIL CONSERVATION DISTRICT.  
*John L. Roberts* 9/24/92  
 CHIEF, HOWARD COUNTY SOIL CONSERVATION DISTRICT DATE

PLAN APPROVAL STAMP  
 APPROVED  
 DATE 9-15-92

DEVELOPER'S CERTIFICATE  
 I/We certify that all development and construction will be done in accordance with this plan of development and plan for erosion and sediment control and that all responsible personnel involved in the construction of this project will have a certificate of attendance at a Department of the Environment approved training program for the control of sediment and erosion before beginning the project. I also authorize periodic onsite inspection by the Howard County Soil Conservation District or their authorized agents, as are deemed necessary.  
*Luis Hernandez* 4/8/92  
 Signature of Developer Date


ENGINEER'S CERTIFICATE  
 I hereby certify that this plan for erosion and sediment control represents a practical and workable plan based on my personal knowledge of the site conditions and that it was prepared in accordance with the requirements of the Howard County Soil Conservation District.  
*Robert M. Mochi* 6-4-92  
 Robert M. Mochi, P.E. Date

OWNER  
**MANGIONE ENTERPRISES OF TURF VALLEY**  
 1205 YORK ROAD - PENTHOUSE  
 LUTHERVILLE, MARYLAND 21093

SUBDIVISION NAME <b>TURF VALLEY WEST GOLF COURSE</b>					
PROPOSED SIX HOLES					
SECT./AREA	LOT/PARCEL	PREVIOUS FILE			
N/A	50 & PLO B	S-06-13, FDP PACC-1 FDP PACC-2 & PART OF PACC-3 FDP PART OF PACC-3 & PACC-4			
PLAT No.	BLOCK No.	ZONE	TAX MAP	ELEC. DIST.	CENSUS
720/225 1203/124	10, 11, 16	PACC	16	3	6022 & 6030
WATER CODE			SEWER CODE		
N/A			N/A		





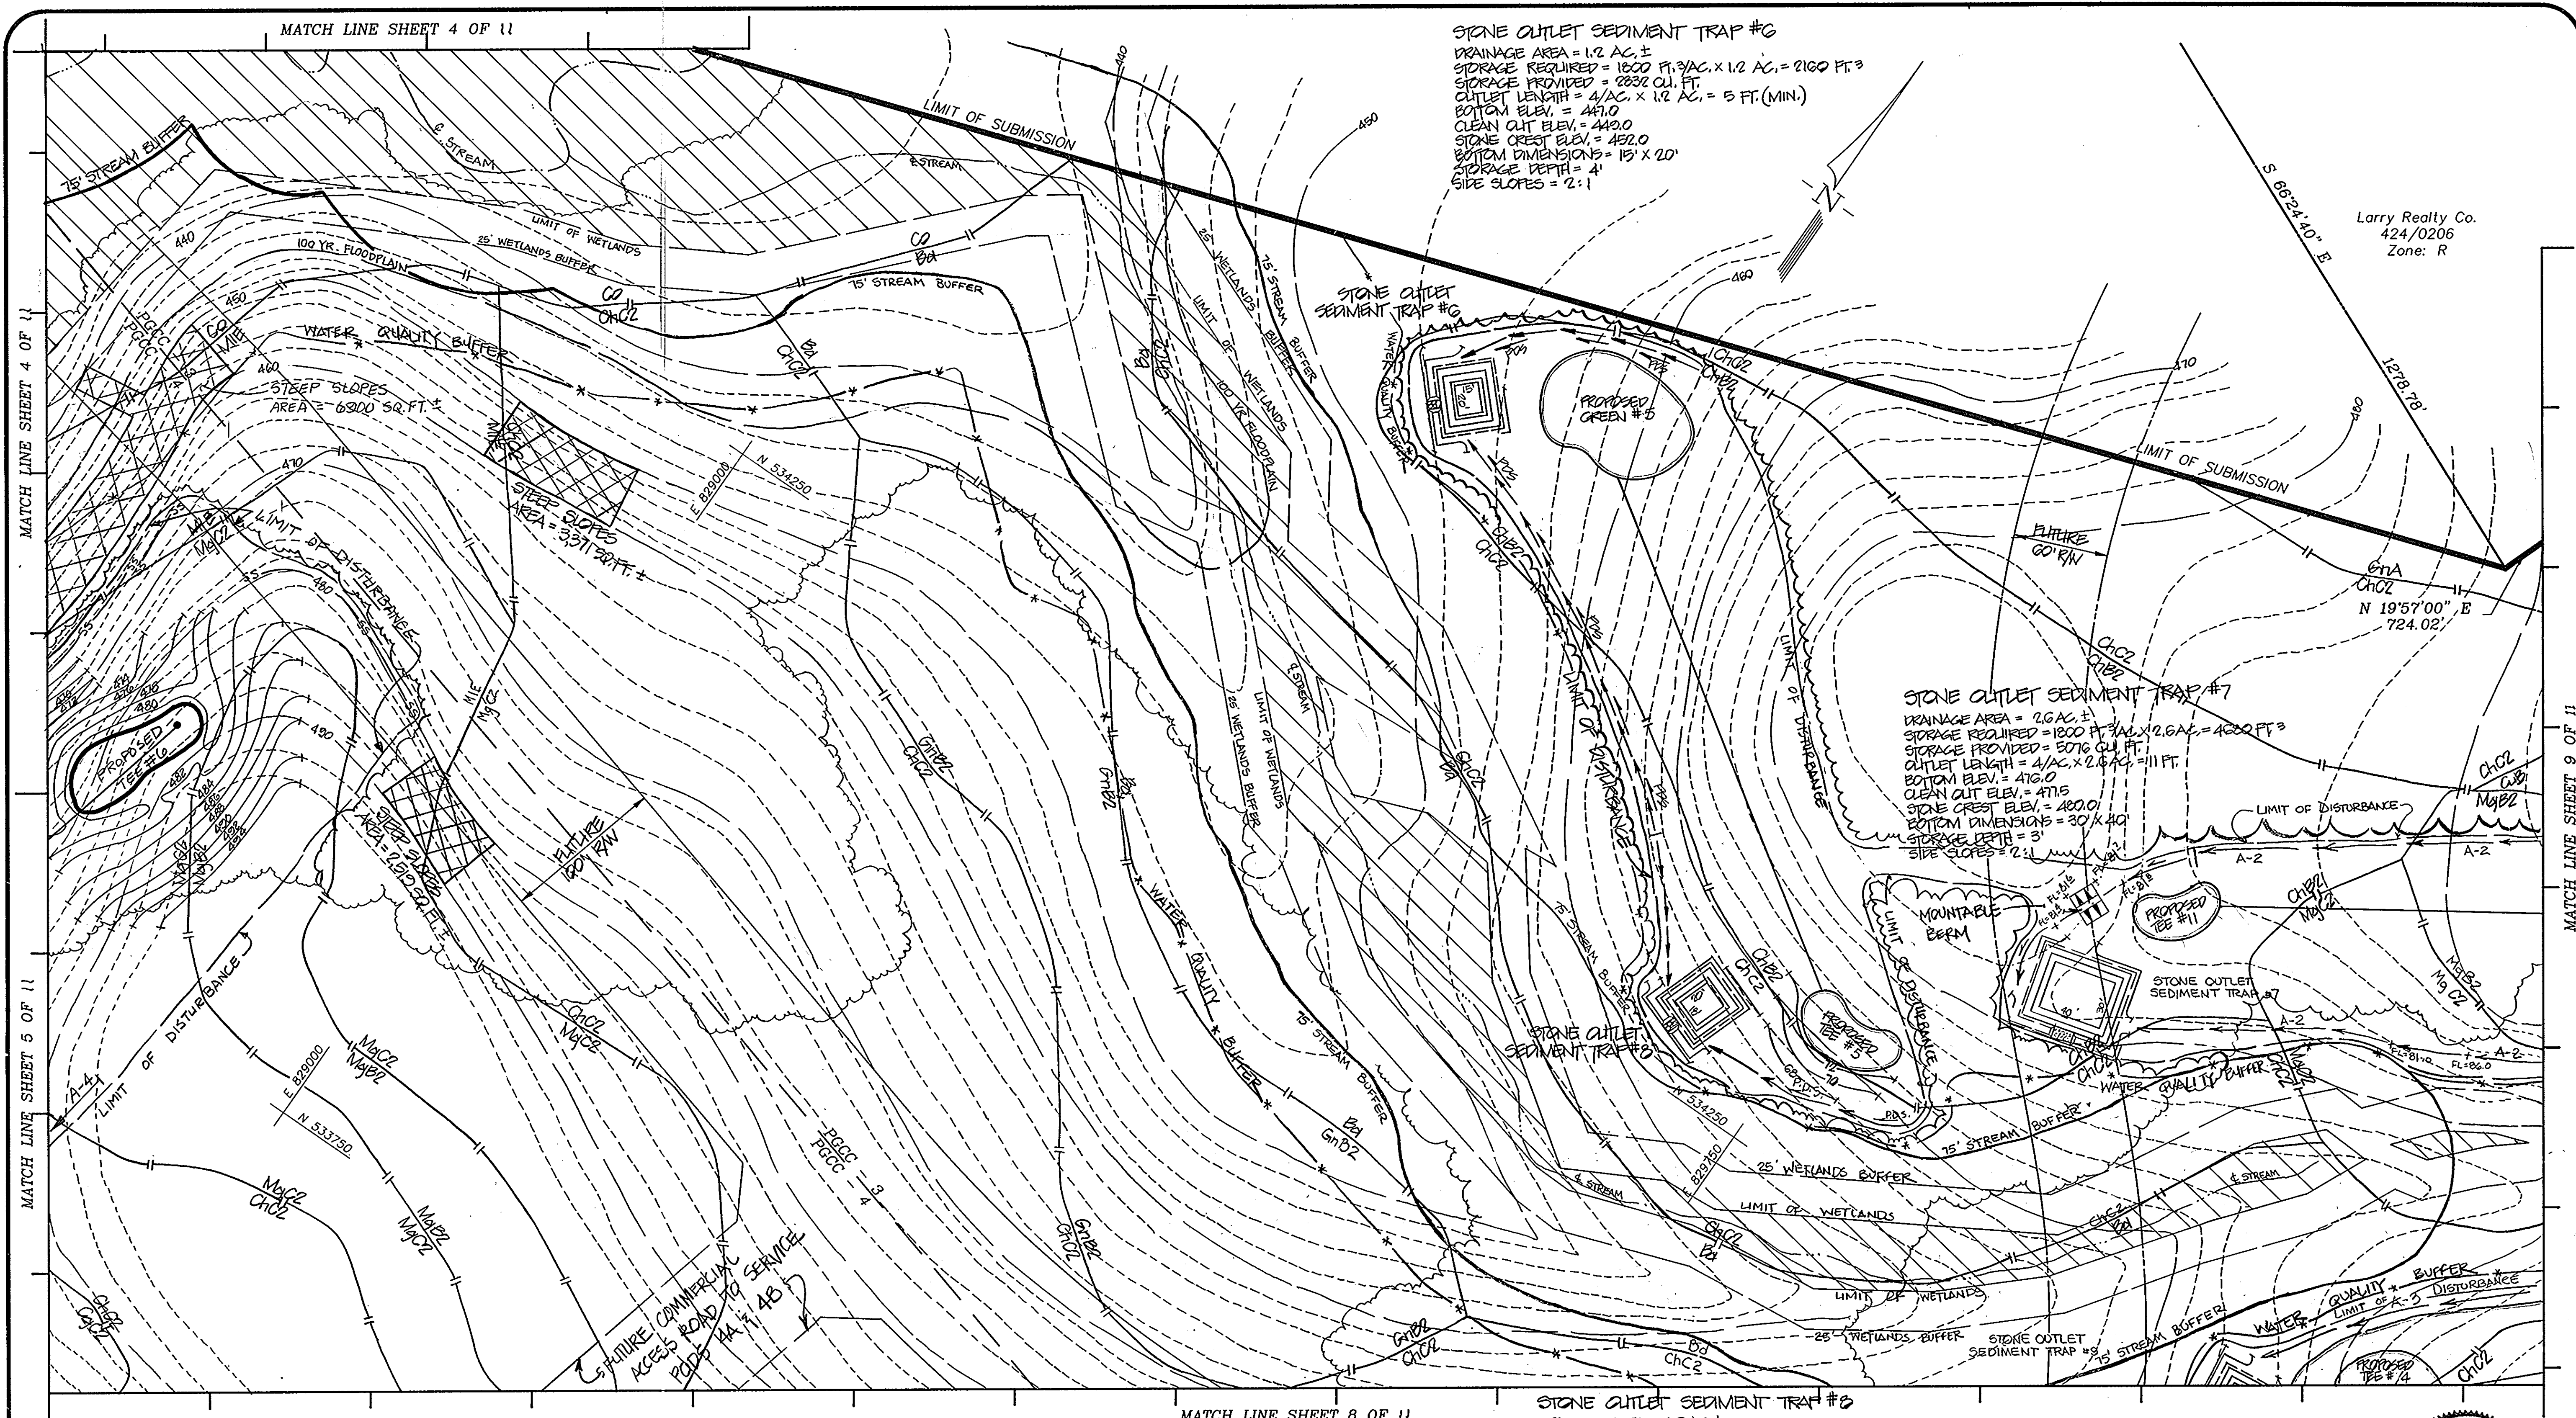

STONE OUTLET SEDIMENT TRAP #6  
 DRAINAGE AREA = 1.2 AC. ±  
 STORAGE REQUIRED = 1800 FT.³ AC. x 1.2 AC. = 2160 FT.³  
 STORAGE PROVIDED = 2832 CU. FT.  
 OUTLET LENGTH = 4/8 AC. x 1.2 AC. = 5 FT. (MIN.)  
 BOTTOM ELEV. = 447.0  
 CLEAN CUT ELEV. = 440.0  
 STONE CREST ELEV. = 452.0  
 BOTTOM DIMENSIONS = 15' x 20'  
 STORAGE DEPTH = 4'  
 SIDE SLOPES = 2:1

STONE OUTLET SEDIMENT TRAP #7  
 DRAINAGE AREA = 2.6 AC. ±  
 STORAGE REQUIRED = 1800 FT.³ AC. x 2.6 AC. = 4680 FT.³  
 STORAGE PROVIDED = 5076 CU. FT.  
 OUTLET LENGTH = 4/8 AC. x 2.6 AC. = 11 FT.  
 BOTTOM ELEV. = 416.0  
 CLEAN CUT ELEV. = 415  
 STONE CREST ELEV. = 420.0  
 BOTTOM DIMENSIONS = 30' x 40'  
 STORAGE DEPTH = 3'  
 SIDE SLOPES = 2:1

STONE OUTLET SEDIMENT TRAP #8  
 DRAINAGE AREA = 1.0 AC. ±  
 STORAGE REQUIRED = 1800 FT.³ AC. x 1.0 AC. = 1800 FT.³  
 STORAGE PROVIDED = 1980 CU. FT.  
 OUTLET LENGTH = 4/8 AC. x 1.0 AC. = 4.0 FT.  
 BOTTOM ELEV. = 450.0  
 CLEAN CUT ELEV. = 430.5  
 STONE CREST ELEV. = 433.0  
 BOTTOM DIMENSIONS = 15' x 20'  
 STORAGE DEPTH = 3'  
 SIDE SLOPES = 2:1

Larry Realty Co.  
 424/0206  
 Zone: R

MATCH LINE SHEET 4 OF 11

MATCH LINE SHEET 4 OF 11

MATCH LINE SHEET 5 OF 11

MATCH LINE SHEET 8 OF 11

MATCH LINE SHEET 9 OF 11

APPROVED: HOWARD COUNTY DEPARTMENT OF PLANNING & ZONING  
*Jessica Smith* 10/20/92  
 DIRECTOR DATE  
*Anna Thomas* 10/19/92  
 CHIEF, DIVISION OF COMMUNITY PLANNING AND LAND DEVELOPMENT DATE

APPROVED: HOWARD COUNTY DEPARTMENT OF PUBLIC WORKS FOR STORM DRAINAGE SYSTEMS AND ROADS  
*James P. Swan* 10/6/92  
 DIRECTOR DATE  
*William J. Kelly* 10-1-92  
 CHIEF, BUREAU OF ENGINEERING CD 1/30/92 DATE JH

REVIEWED: HOWARD COUNTY HEALTH DEPARTMENT NO WATER OR SANITARY FACILITIES REQUIRED  
*Jacqueline Adams* 10-13-92  
 COUNTY HEALTH OFFICER DATE JH

APPROVED: REVIEWED FOR HOWARD COUNTY SOIL CONSERVATION DISTRICT AND MEETS TECHNICAL REQUIREMENTS.  
*James M. Blum* 9/24/92  
 S. SOIL CONSERVATION SERVICE DATE

APPROVED: THIS DEVELOPMENT IS APPROVED FOR EROSION AND SEDIMENT CONTROL BY THE HOWARD COUNTY SOIL CONSERVATION DISTRICT.  
*John R. Blanton* 9/24/92  
 HOWARD SOIL CONSERVATION DISTRICT DATE

PLAN APPROVAL STAMP  
**APPROVED**  
 PLANNING BOARD OF HOWARD COUNTY  
 DATE 9-15-92

DEVELOPER'S CERTIFICATE  
 I/We certify that all development and construction will be done in accordance with this plan of development and plan for erosion and sediment control and that all responsible personnel involved in the construction of this project will have a certificate of attendance at a Department of the Environment approved training program for the control of sediment and erosion before beginning the project. I also authorize periodic onsite inspection by the Howard County Soil Conservation District or their authorized agents, as are deemed necessary.  
*Louis Mangione* 6/8/92  
 Signature of Developer Date

ENGINEER'S CERTIFICATE  
 I hereby certify that this plan for erosion and sediment control represents a practical and workable plan based on my personal knowledge of the site conditions and that it was prepared in accordance with the requirements of the Howard County Soil Conservation District.  
*Robert M. Mochi* 6-4-92  
 Robert M. Mochi, P.E. Date

OWNER  
 MANGIONE ENTERPRISES OF TURF VALLEY  
 1205 YORK ROAD - PENTHOUSE  
 LUTHERVILLE, MARYLAND 21093

SUBDIVISION NAME <b>TURF VALLEY WEST GOLF COURSE PROPOSED SIX HOLES</b>					
SECT./AREA N/A		LOT/PARCEL 50 & 170 B		PREVIOUS FILE S-86-19, FDP PGCC-1 FDP PGCC-2 & PART OF PGCC-3 FDP PART OF PGCC-3 & PGCC-4	
PLAT No. 0201285 12/01/72A	BLOCK No. 10, 11, 16	ZONE PGCC	TAX MAP 16	ELEC. DIST. 3	CENSUS 6022 1 6030
WATER CODE N/A			SEWER CODE N/A		




Project	9207007.DWG	Date	MAY '92	Approval	RAM
Illustration	9207007	Engineering	TIP	Approval	RAM
Scale	1" = 50'	Revision			

Revised Due to DTP Comments (Hole #6)	4/8/92	Date	
Revised Line Revisions to DTP Comments	4/27/92	Date	
Revised Line Revisions to DTP Comments	5/1/92	Date	
Revised Line Revisions to DTP Comments	5/1/92	Date	
Revised Line Revisions to DTP Comments	5/1/92	Date	
Revised Line Revisions to DTP Comments	5/1/92	Date	

PROPOSED SIX HOLES  
**TURF VALLEY WEST GOLF COURSE**  
 ELECTION DISTRICT No. 3  
 HOWARD COUNTY, MARYLAND  
**GRADING & SEDIMENT CONTROL PLAN**

MILDENBERG, MOCHI & ASSOCIATES, INC.  
 ENGINEERS • SURVEYORS • PLANNERS  
 3300 North Ridge Road, Suite 225, Ellicott City, Maryland, 21043-3350  
 (410) 461-0078 D.C. Metro: (301) 621-5768 Fax: (410) 750-6340



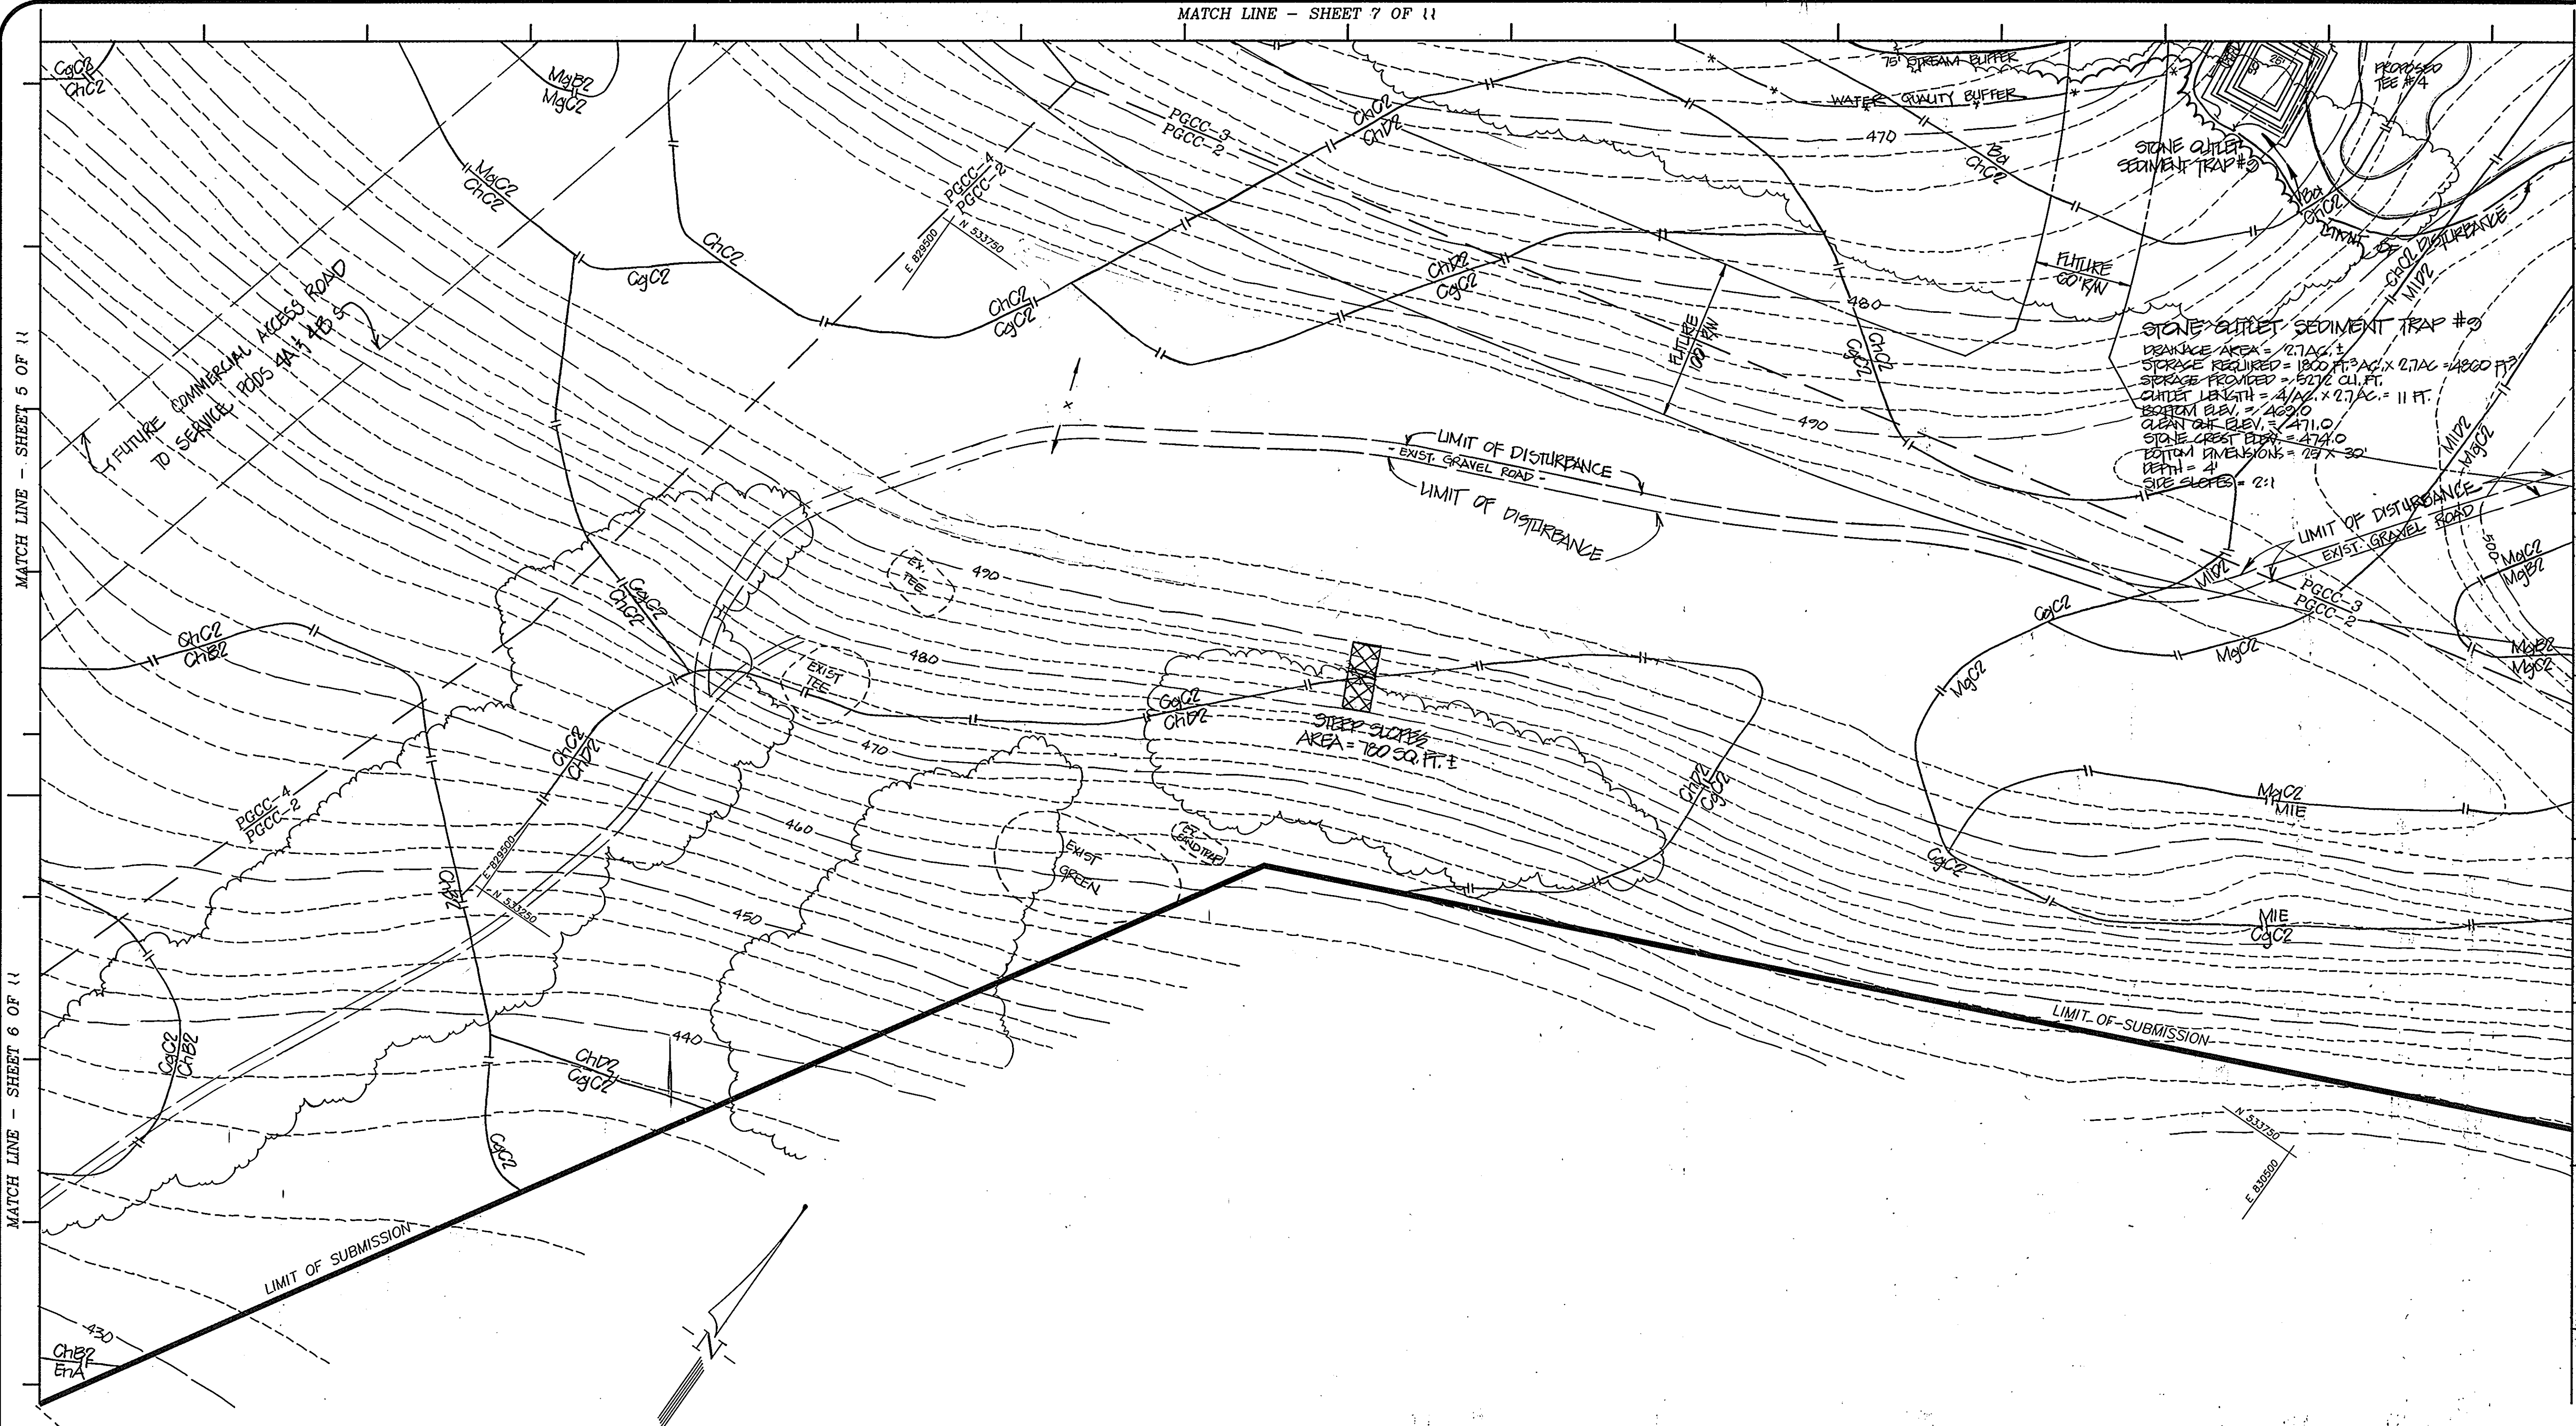

MATCH LINE - SHEET 5 OF 11

MATCH LINE - SHEET 6 OF 11

MATCH LINE SHEET 9 OF 11

MATCH LINE - SHEET 10 OF 11

Project	92007008.DWG
date	92007.00 MAY 92
illustration	engineering
TIP	TIP
scale	1" = 50'
approval	RAM

3	REP LINE REVISIONS TO DTP	4/15/92	date
2	ADDP WATER QUALITY BUFFER, LIMITATION ROAD	1/20/92	date
1	REVISIONS PERMITS, PERMITS CO. DTP, DPN & HSD		date
no.	description		revisions

PROPOSED SIX HOLES  
**TURF VALLEY WEST GOLF COURSE**  
 ELECTION DISTRICT No. 3  
 HOWARD COUNTY, MARYLAND  
 GRADING & SEDIMENT CONTROL PLAN

APPROVED: HOWARD COUNTY DEPARTMENT OF PLANNING & ZONING  
 Director *James R. Smith* 10/20/92  
 Chief, Division of Community Planning and Land Development *Bluma Holmrad* 10/19/92

APPROVED: HOWARD COUNTY DEPARTMENT OF PUBLIC WORKS FOR STORM DRAINAGE SYSTEMS AND ROADS  
 Director *James R. Smith* 10/19/92  
 Chief, Bureau of Engineering *James R. Smith* 10-1-92

REVIEWED: HOWARD COUNTY HEALTH DEPARTMENT NO WATER OR SANITARY FACILITIES REQUIRED  
 County Health Officer *James R. Smith* 10-13-92

APPROVED: REVIEWED FOR HOWARD COUNTY SOIL CONSERVATION DISTRICT AND MEETS TECHNICAL REQUIREMENTS.  
 S.S. SOIL CONSERVATION SERVICE *James M. Adam* 9/24/92

APPROVED: THIS DEVELOPMENT IS APPROVED FOR EROSION AND SEDIMENT CONTROL BY THE HOWARD COUNTY SOIL CONSERVATION DISTRICT.  
 HOWARD SOIL CONSERVATION DISTRICT *John P. Roberts* 9/24/92


PLAN APPROVAL STAMP  
**APPROVED**  
 PLANNING BOARD OF HOWARD COUNTY  
 DATE: 9-15-92

DEVELOPER'S CERTIFICATE  
 I/We certify that all development and construction will be done in accordance with this plan of development and plan for erosion and sediment control and that all responsible personnel involved in the construction of this project will have a certificate of attendance at a Department of the Environment approved training program for the control of sediment and erosion before beginning the project. I also authorize periodic onsite inspection by the Howard County Soil Conservation District or their authorized agents, as are deemed necessary.  
*Louis J. Mangione* 10/8/92  
 Signature of Developer Date

OWNER  
 MANGIONE ENTERPRISES OF TURF VALLEY  
 1205 YORK ROAD - PENTHOUSE  
 LUTHERVILLE, MARYLAND 21093


ENGINEER'S CERTIFICATE  
 I hereby certify that this plan for erosion and sediment control represents a practical and workable plan based on my personal knowledge of the site conditions and that it was prepared in accordance with the requirements of the Howard County Soil Conservation District.  
*Robert M. Mochi* 6-4-92  
 Robert M. Mochi, P.E. Date

SUBDIVISION NAME TURF VALLEY WEST GOLF COURSE PROPOSED SIX HOLES					
SECT./AREA N/A	LOT/PARCEL 50 & 110.8	PREVIOUS FILE 5-86-13, FDP PGCC-1 FDP PGCC-2 & PART OF PGCC-3 FDP PART OF PGCC-3 & PGCC-4			
PLAT No. 920/285 1203/124	BLOCK No. 10,11,16	ZONE PGCC	TAX MAP 1G	ELÉC. DIST. 3	CENSUS 6022 & 6030
WATER CODE N/A			SEWER CODE N/A		

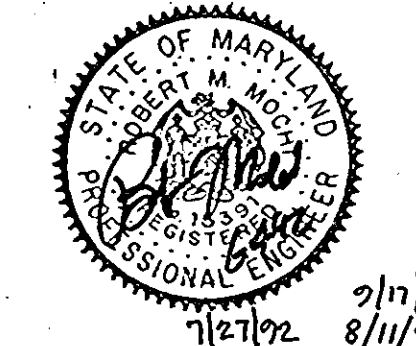

**MILDENBERG MOCHI & ASSOCIATES, INC.**  
 ENGINEERS • SURVEYORS • PLANNERS  
 3300 North Ridge Road, Suite 205, Ellicott City, Maryland 21043-3550  
 (410) 481-0078 D.C. Metro: (301) 821-5768 Fax: (410) 750-6340



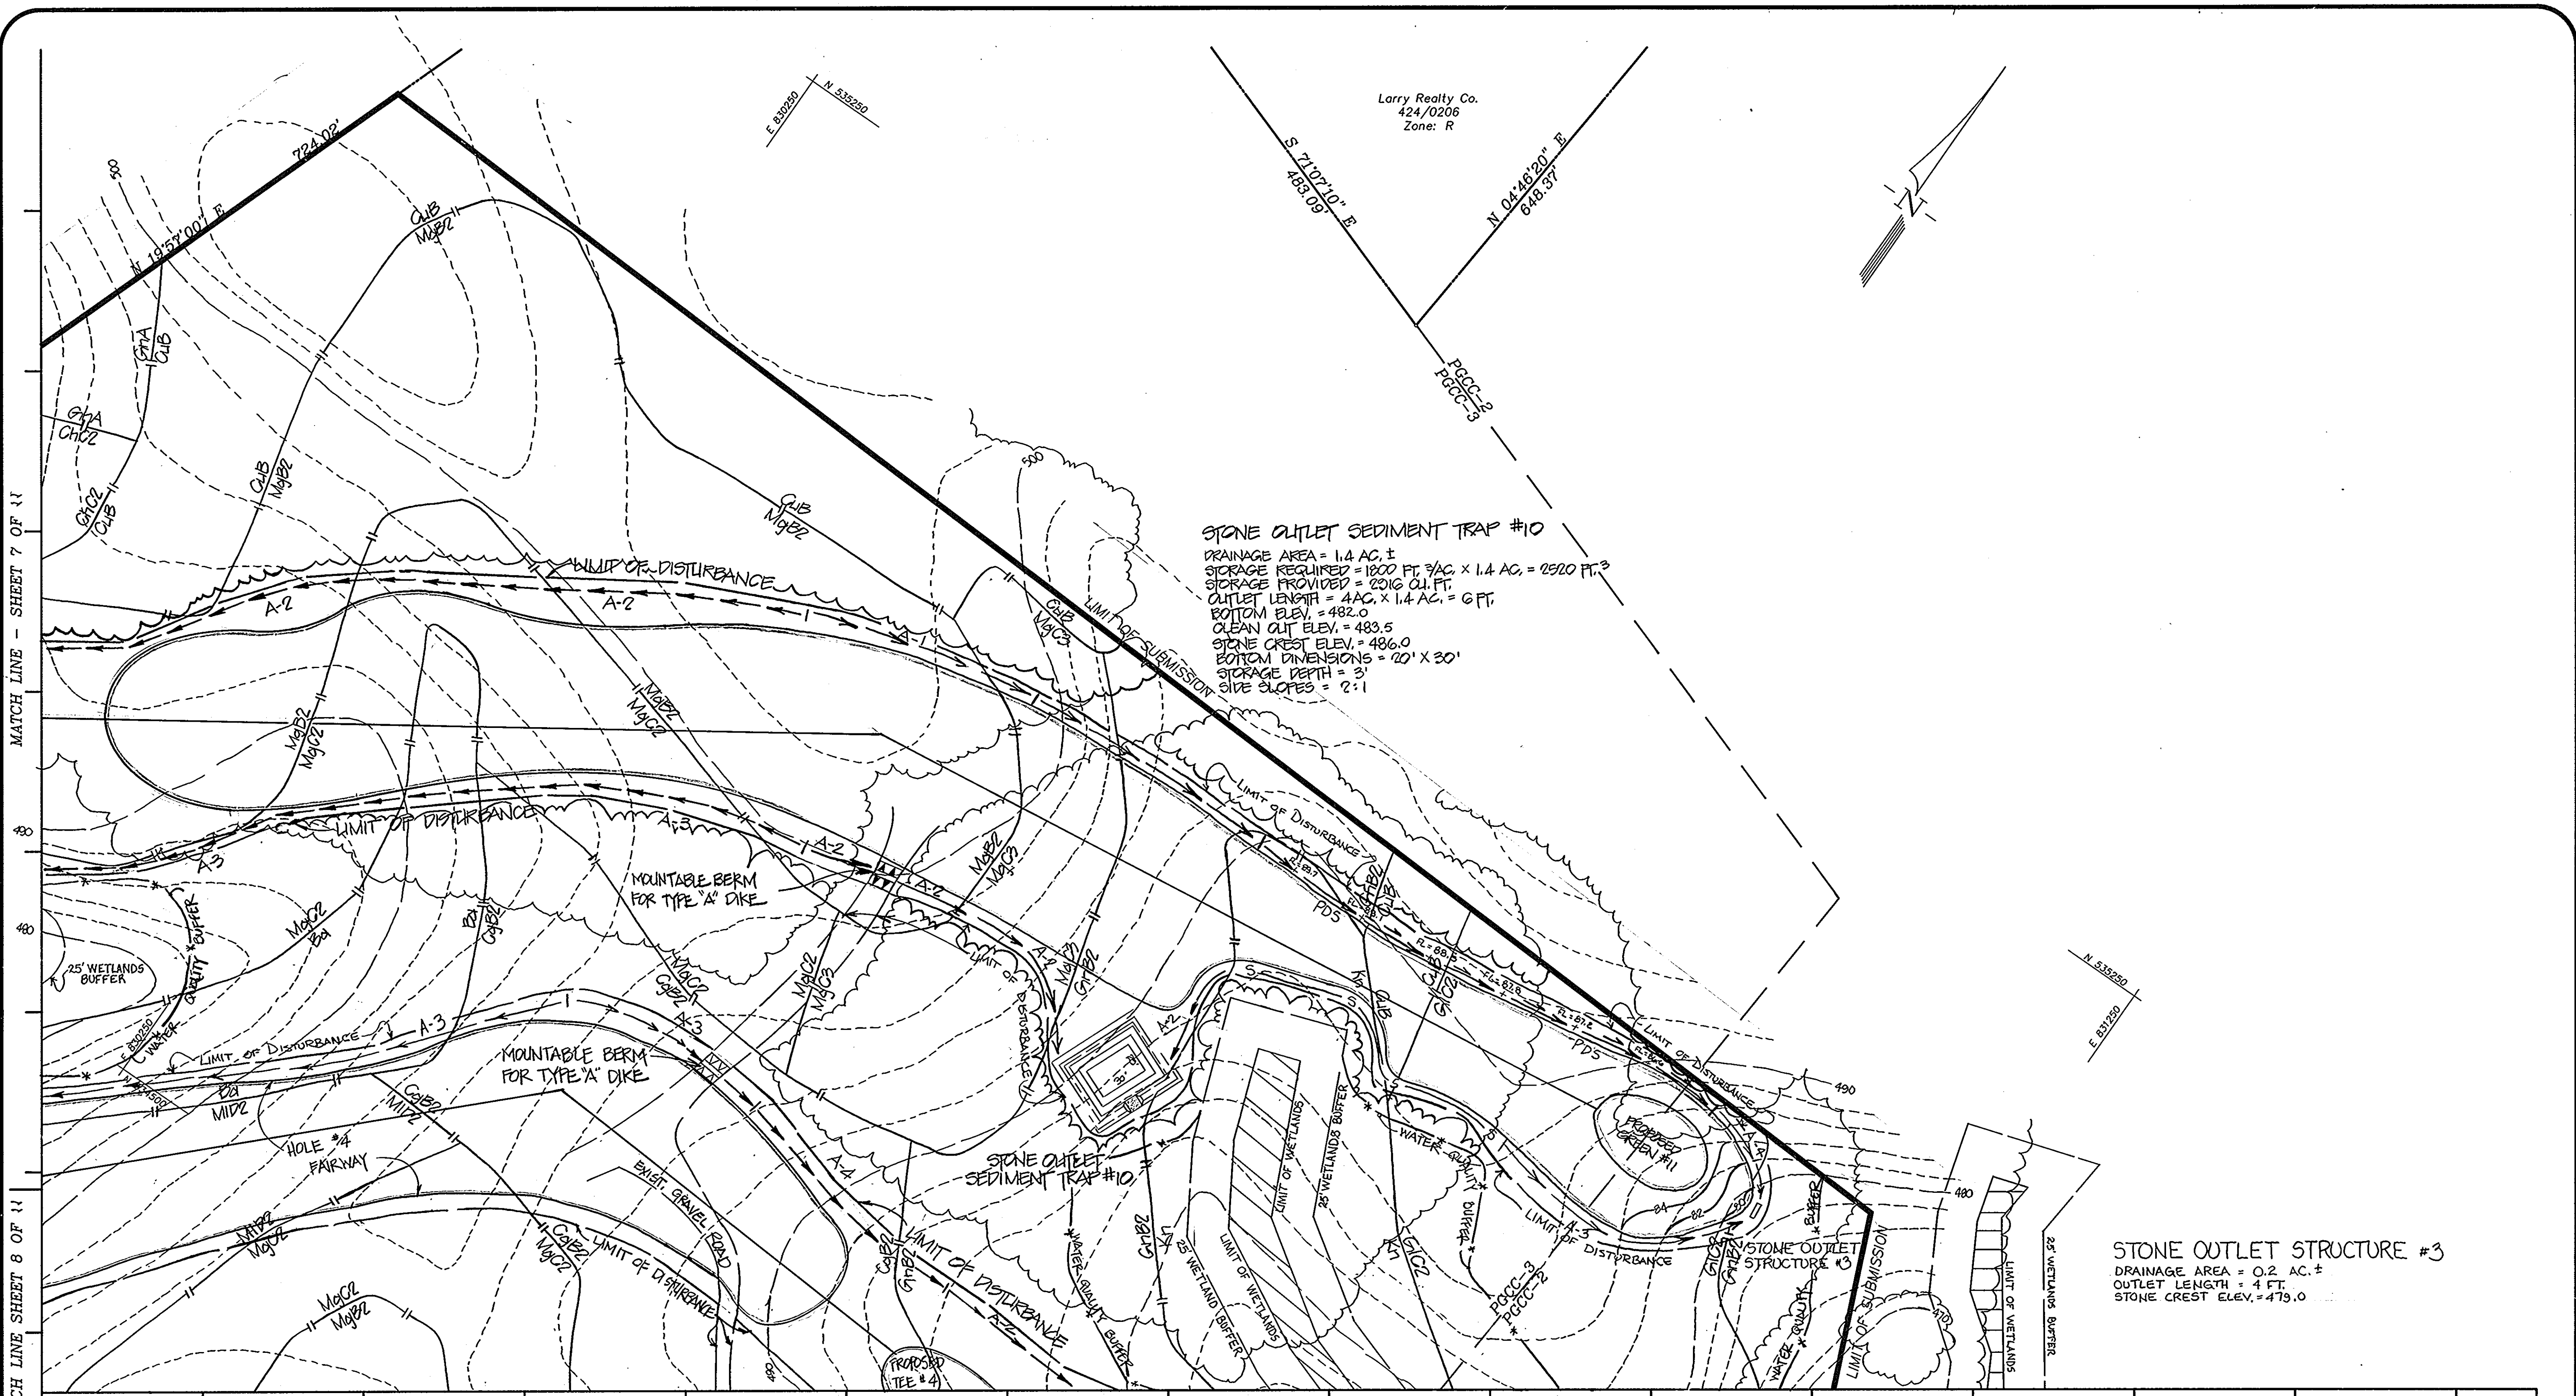

**STONE OUTLET SEDIMENT TRAP #10**  
 DRAINAGE AREA = 1.4 AC. ±  
 STORAGE REQUIRED = 1800 FT.³ AC. × 1.4 AC. = 2520 FT.³  
 STORAGE PROVIDED = 2016 CU. FT.  
 OUTLET LENGTH = 4 AC. × 1.4 AC. = 6 FT.  
 BOTTOM ELEV. = 482.0  
 CLEAN OUT ELEV. = 483.5  
 STONE CREST ELEV. = 486.0  
 BOTTOM DIMENSIONS = 20' X 30'  
 STORAGE DEPTH = 3'  
 SLOPE SLOPES = 2:1

**STONE OUTLET STRUCTURE #3**  
 DRAINAGE AREA = 0.2 AC. ±  
 OUTLET LENGTH = 4 FT.  
 STONE CREST ELEV. = 479.0

MATCH LINE - SHEET 7 OF 11

MATCH LINE SHEET 8 OF 11

MATCH LINE - SHEET 10 OF 11

**APPROVED:** HOWARD COUNTY DEPARTMENT OF PLANNING & ZONING  
 Director: *James H. Davis* 10/20/92  
 Chief, Division of Community Planning and Land Development: *Emmalyn G. Hornum* 10/19/92

**APPROVED:** HOWARD COUNTY DEPARTMENT OF PUBLIC WORKS FOR STORM DRAINAGE SYSTEMS AND ROADS  
 Director: *James P. ...* 10/1/92  
 Chief, Bureau of Engineering: *...* 10-1-92

**REVIEWED:** HOWARD COUNTY HEALTH DEPARTMENT NO WATER OR SANITARY FACILITIES REQUIRED  
 County Health Officer: *...* 10-13-92

**APPROVED:** REVIEWED FOR HOWARD COUNTY SOIL CONSERVATION DISTRICT AND MEETS TECHNICAL REQUIREMENTS.  
 S. Soil Conservation Service: *James M. ...* 9/24/92

**APPROVED:** THIS DEVELOPMENT IS APPROVED FOR EROSION AND SEDIMENT CONTROL BY THE HOWARD COUNTY SOIL CONSERVATION DISTRICT.  
 Howard Soil Conservation District: *John R. ...* 9/24/92


**PLAN APPROVAL STAMP**  
 APPROVED  
 PLANNING BOARD  
 OF HOWARD COUNTY  
 9-15-92

**DEVELOPER'S CERTIFICATE**  
 I/We certify that all development and construction will be done in accordance with this plan of development and plan for erosion and sediment control and that all responsible personnel involved in the construction of this project will have a certificate of attendance at a Department of the Environment approved training program for the control of sediment and erosion before beginning the project. I also authorize periodic onsite inspection by the Howard County Soil Conservation District or their authorized agents, as are deemed necessary.  
 Signature of Developer: *...* 6/8/92  
 Date

**ENGINEER'S CERTIFICATE**  
 I hereby certify that this plan for erosion and sediment control represents a practical and workable plan based on my personal knowledge of the site conditions and that it was prepared in accordance with the requirements of the Howard County Soil Conservation District.  
 Signature: *Robert M. Mochi* 6-7-92  
 Date  
 Robert M. Mochi, P.E.

**OWNER**  
 MANGIONE ENTERPRISES OF TURF VALLEY  
 1205 YORK ROAD - PENTHOUSE  
 LUTHERVILLE, MARYLAND 21093

SUBDIVISION NAME <b>TURF VALLEY WEST GOLF COURSE PROPOSED SIX HOLES</b>					
SECT./AREA N/A	LOT/PARCEL 50 & 110 B	PREVIOUS FILE S-86-13, FDP - PGCC-1 FDP PGCC-2 & PART OF PGCC-5 FDP PART OF PGCC-3 & PGCC-4			
PLAT No. 920/205 1209/124	BLOCK No. 10, 11, 16	ZONE PGCC	TAX MAP 16	ELEC. DIST. 3	CENSUS 6022 & 6030
WATER CODE N/A			SEWER CODE N/A		

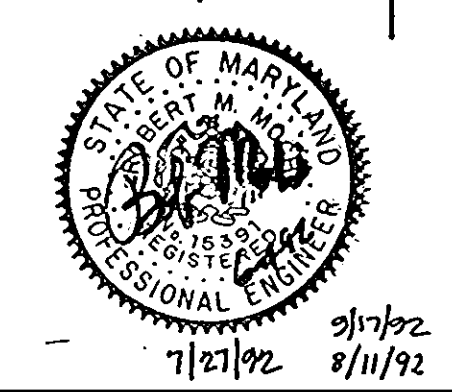

Project	date	description	approval
92007.00	MAY '92	engineering	TIP
92007.00	MAY '92	TIP	scale
92007.00	MAY '92	TIP	scale

no.	description	date
4	RED LINE REVISIONS TO DPZ	4/18/92
3	MOVED TEE #3 & SHORTENED FAIRWAY #3	5/14/92
2	ADDED WATER QUALITY BUFFER	6/10/92
1	REVISED PER HOWARD CO. DPZ, DPZ & HEAD COMMENTS	7/24/92

PROPOSED SIX HOLES  
**TURF VALLEY WEST GOLF COURSE**  
 ELECTION DISTRICT No. 3  
 HOWARD COUNTY, MARYLAND  
 GRADING & SEDIMENT CONTROL PLAN

**MILDENBERG, MOCHI & ASSOCIATES, INC.**  
 ENGINEERS • SURVEYORS • PLANNERS  
 3300 North Ridge Road, Suite 235, Ellicott City, Maryland 21045-3350  
 (410) 461-0078 D.C. Metro: (301) 621-5788 Fax: (410) 750-6340

9 OF 11  
 SDP-92-116



**SEDIMENT CONTROL SEQUENCE OF CONSTRUCTION**

1. Obtain grading permit.
2. Install sediment control devices for each hole before work for that hole is commenced.
3. Clear and grub and construct tees, green and fairways.
4. Stabilize all disturbed areas in accordance with standard specifications.
5. With approval of sediment control inspector, remove sediment control devices.

**SEDIMENT CONTROL NOTES**

1. A minimum of 24 hours notice must be given to the Howard County Office of Inspections and Permit prior to the start of any construction (313-2437).
2. All vegetative and structural practices are to be installed according to the provisions of this plan and are to be in conformance with the 1983 MARYLAND STANDARDS AND SPECIFICATIONS FOR SOIL EROSION AND SEDIMENT CONTROL.
3. Impacts to the riparian corridor and montane wetland areas for equipment access and sediment control devices should be minimized to the greatest extent possible. All unavoidable temporary impact areas should be restored to pre-construction conditions and vegetation within 100 feet upstream and downstream of the project site.
4. Sediment controls should be maintained after every storm event. Inspection of the sediment controls should occur at a minimum of two week intervals.
5. Clearing in the riparian corridor should be minimized to the greatest extent possible.
6. Following initial soil disturbance or redistribution, permanent or temporary stabilization shall be completed within:
  - a) 7 calendar days for all perimeter slopes and all slopes greater than 3:1;
  - b) 14 days as to all other disturbed or graded areas on the project site.
7. All sediment traps shown must be fenced and warning signs posted around their perimeter in accordance with Volume 1, Chapter 12 of the HOWARD COUNTY DESIGN MANUAL, Storm Drainage.
8. All disturbed areas must be stabilized within the time period specified above in accordance with the 1983 MARYLAND STANDARDS AND SPECIFICATIONS FOR SOIL EROSION AND SEDIMENT CONTROL for permanent seedings (Sec. 51), and (Sec. 54), temporary seedings (Sec. 50) and mulching (Sec. 52). Temporary stabilization with mulch alone can only be done when recommended seeding dates do not allow for proper germination and establishment of grasses.
9. All sediment control structures are to remain in place and are to be maintained in operative condition until permission for their removal has been obtained from the Howard County Sediment Control Inspector.
10. Site Analysis:
 

Total Area of Site:	29,181,279.00 SQ. FT. = 669.24 AC.
Area Disturbed:	1,204,814.40 SQ. FT. = 27.64 AC.
Area to be roofed or paved:	0 SQ. FT. = 0.00 AC.
Area to be vegetatively stabilized:	1,204,814.40 SQ. FT. = 27.64 AC.
Total Cut:	5959.02 YD.
Total Fill:	5916.04 YD.
11. Additional sediment controls must be provided, if deemed necessary by the Howard County DLP sediment control Inspector.
12. Earthwork quantities indicated in the Site Analysis are for sediment control purposes only, the contractor shall compute his own quantities.

**TEMPORARY SEEDING NOTES**

Apply to graded or cleared areas likely to be redistributed where a short-term vegetative cover is needed.

Seedbed Preparation: Loosen upper three inches of soil by raking, discing or other acceptable means before seeding, unless previously loosened.

Soil Amendments: Apply 600 lbs per acre 10-10-10 fertilizer (14 lbs/1000 square feet).

Seeding: For periods March 1 through April 30 and from August 15 through November 15, seed with 2-1/2 bushels per acre of annual ryegrass (3.2 lbs/1000 square feet). For the period May 1 through August 14, seed with 3 lbs per acre of weeping lovegrass (0.7 lbs/1000 square feet). For the period November 16 through February 28, protect site by applying 2 tons per acre of well anchored straw mulch and seed as soon as possible in the spring, or use sod.

Mulching: Apply 1-1/2 to 2 tons per acre (70 to 90 lbs/1000 square feet) of unrotted small grain straw immediately after seeding. Anchor mulch immediately after application using mulch anchoring tool or 218 gallons per acre (5 gallons/1000 square feet) of emulsified asphalt on flat areas. On slopes 8 feet or higher, use 348 gallons per acre (8 gallons/1000 square feet) for anchoring.

Refer to the 1983 MARYLAND STANDARDS AND SPECIFICATIONS FOR SOIL EROSION AND SEDIMENT CONTROL for rate and methods not covered.

**PERMANENT SEEDING NOTES**

Apply to graded or cleared areas not subject to immediate further disturbance where a permanent long-lived vegetative cover is needed.

Seedbed Preparation: Loosen upper three inches of soil by raking, discing or other acceptable means before seeding, unless previously loosened.





Soil Amendments: In lieu of soil test recommendations, use one of the following schedules:

1. Preferred: Apply two (2) tons per acre dolomitic limestone (92 lbs/1000 square feet) and 600 lbs. per acre 10-10-10 fertilizer (14 lbs/1000 square feet) before seeding. Harrow or disc into upper three (3) inches of soil. At time of seeding, apply 100 lbs. per acre 30-0-0 ureaform fertilizer (9 lbs/1000 square feet).
2. Acceptable: Apply two (2) tons per acre dolomitic limestone (92 lbs/1000 square feet) and 1000 lbs. per acre 10-10-10 fertilizer (23 lbs/1000 square feet) before seeding. Harrow or disc into upper three (3) inches of soil.

Seeding: For the periods March 1 through April 30, and August 1 thru October 15, seed with 60 lbs per acre (1.4 lbs/1000 square feet) of Kentucky 31 Tall Fescue. For the period May 1 through July 31, seed with 60 lbs/1000 square feet of Kentucky 31 Tall Fescue per acre and 2 lbs per acre (0.5 lbs/1000 square feet) of weeping lovegrass. During the period of October 16 through February 28, protect site by: Option 1) 2 tons per acre of well anchored straw mulch and seed as soon as possible in the spring. Option 2) use sod. Option 3) Seed with 60 lbs per acre Kentucky 31 Tall Fescue and mulch with 2 tons per acre well anchored straw.





Mulching: Apply 1-1/2 to 2 tons per acre (70 to 90 lbs/1000 square feet) of unrotted small grain straw immediately after seeding. Anchor mulch immediately after application using mulch anchoring tool or 218 gallons per acre (5 gallons/1000 square feet) of emulsified asphalt on flat areas. On slopes 8 feet or higher, use 348 gallons per acre (8 gallons/1000 square feet) for anchoring.

Maintenance: Inspect all seeded areas and make needed repairs, replacements and reseedings.

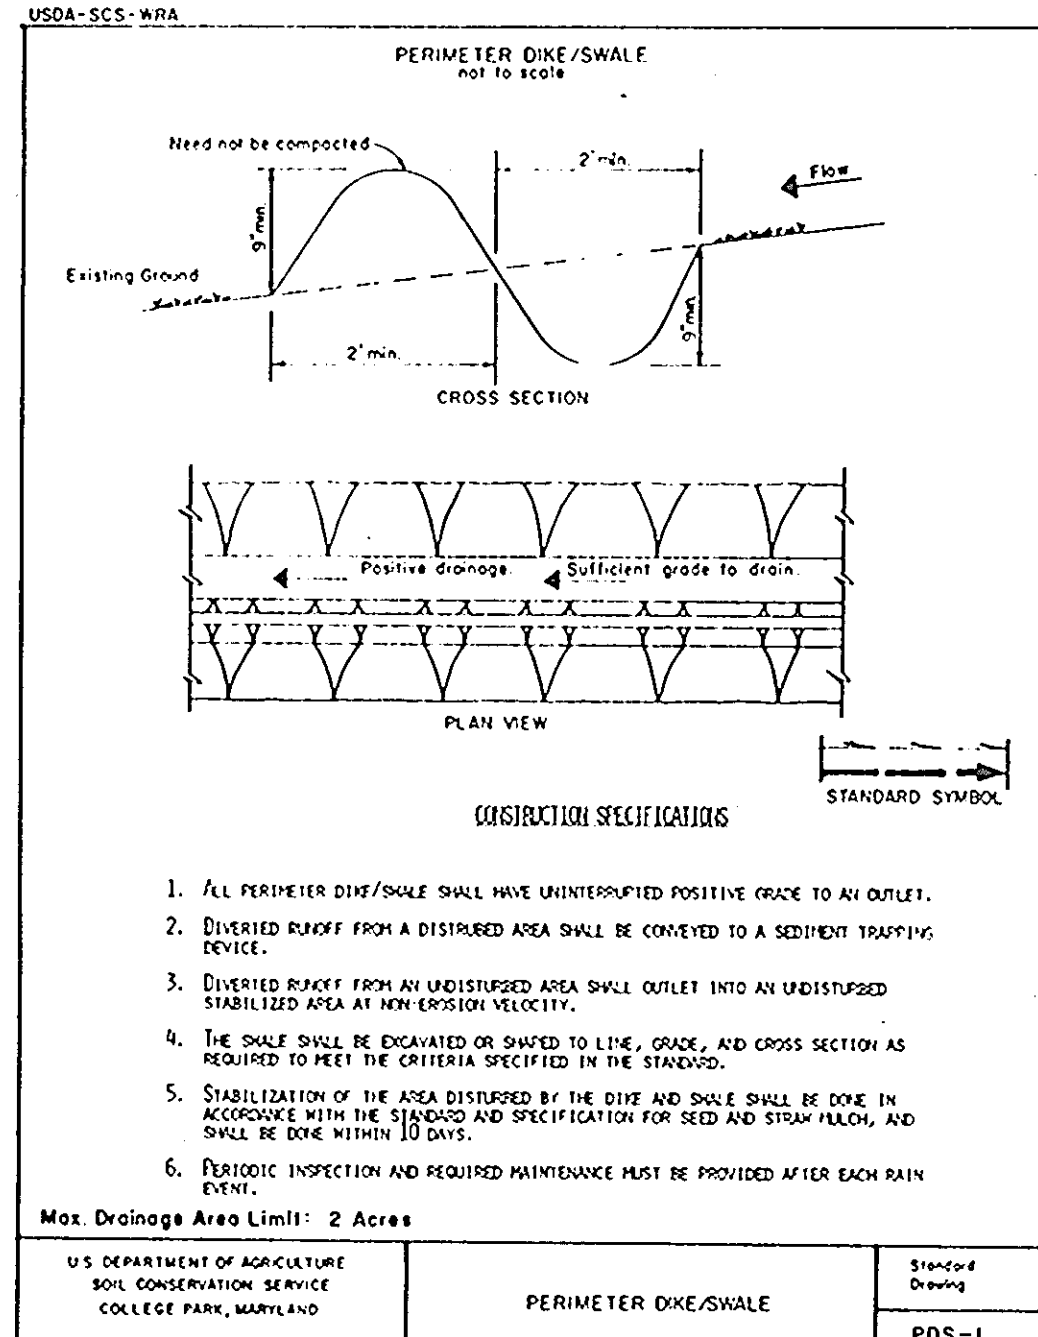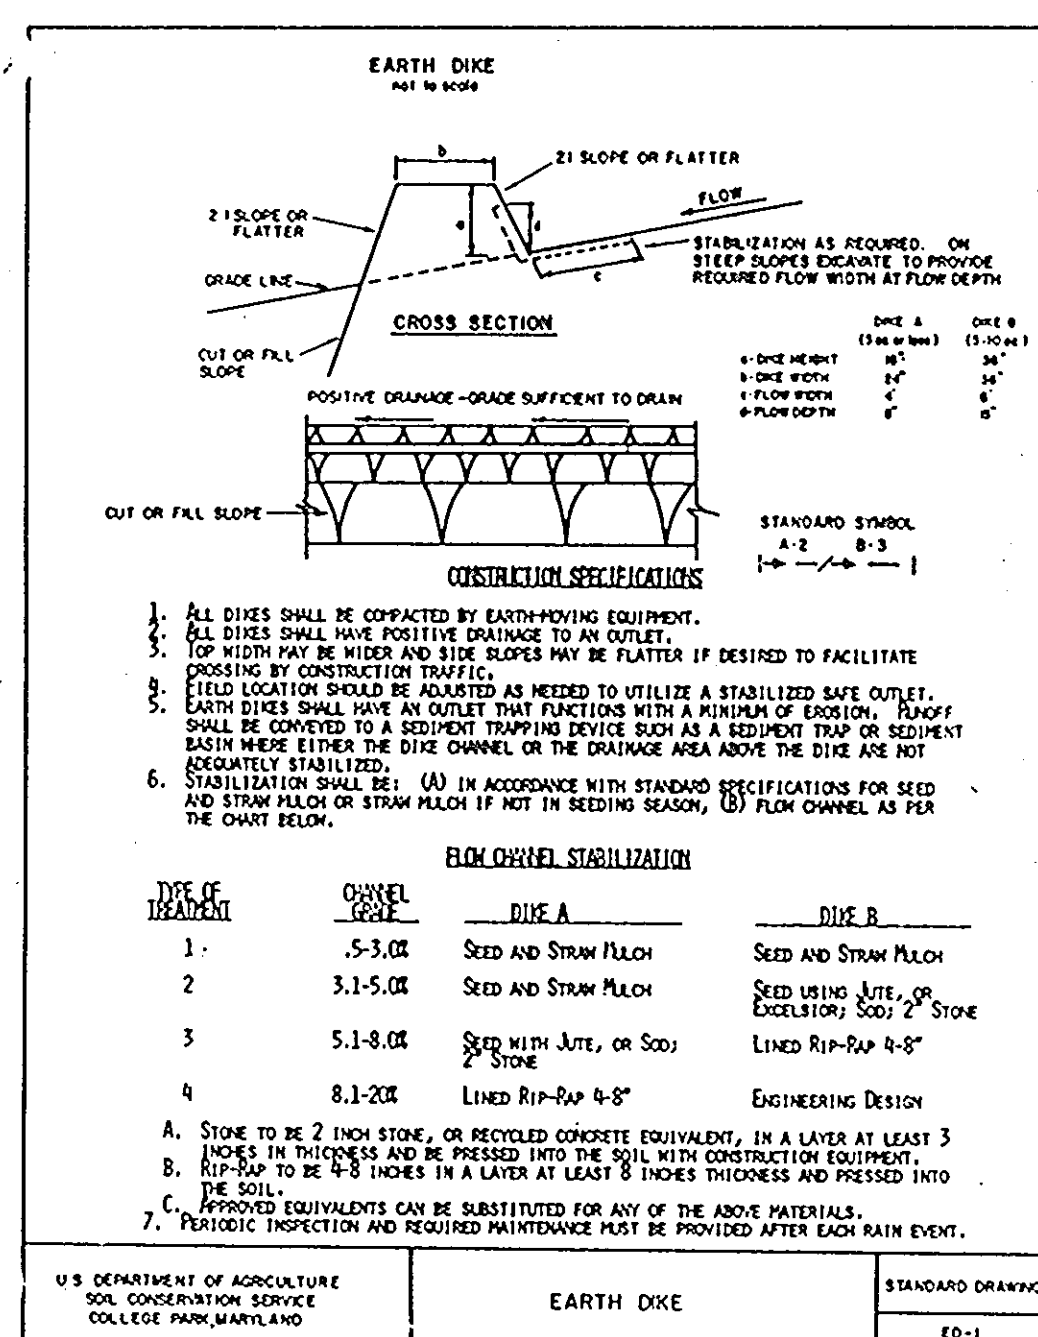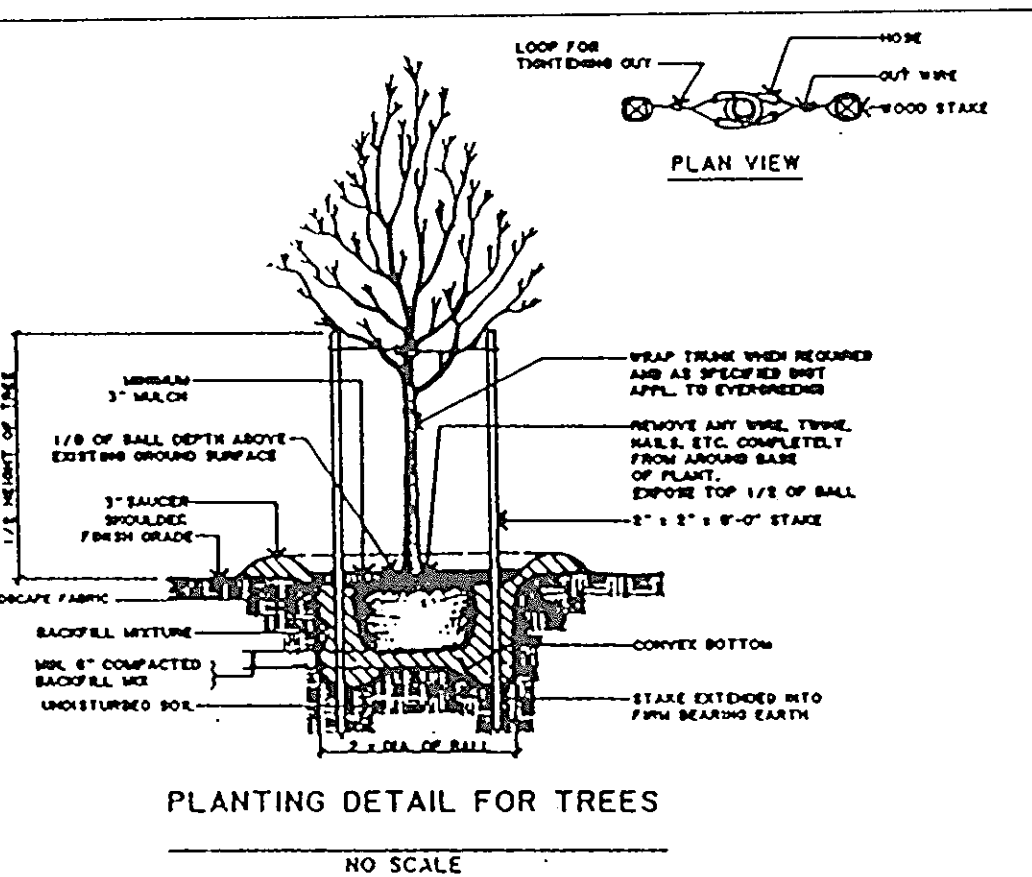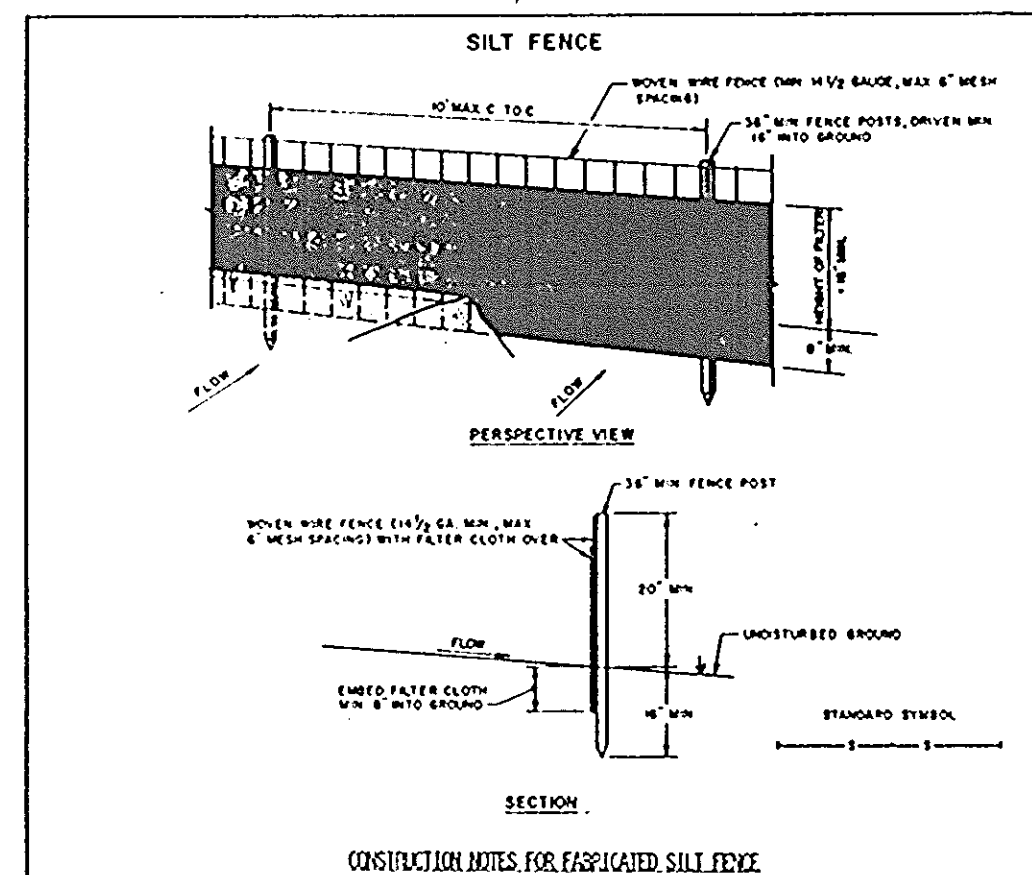

**PLANT LIST:**

KEY	QUAN.	BOTANICAL NAME	COMMON NAME	SIZE	COND.
PC	7	PINUS STROBUS	WHITE PINE	3-6' HT.	B & E

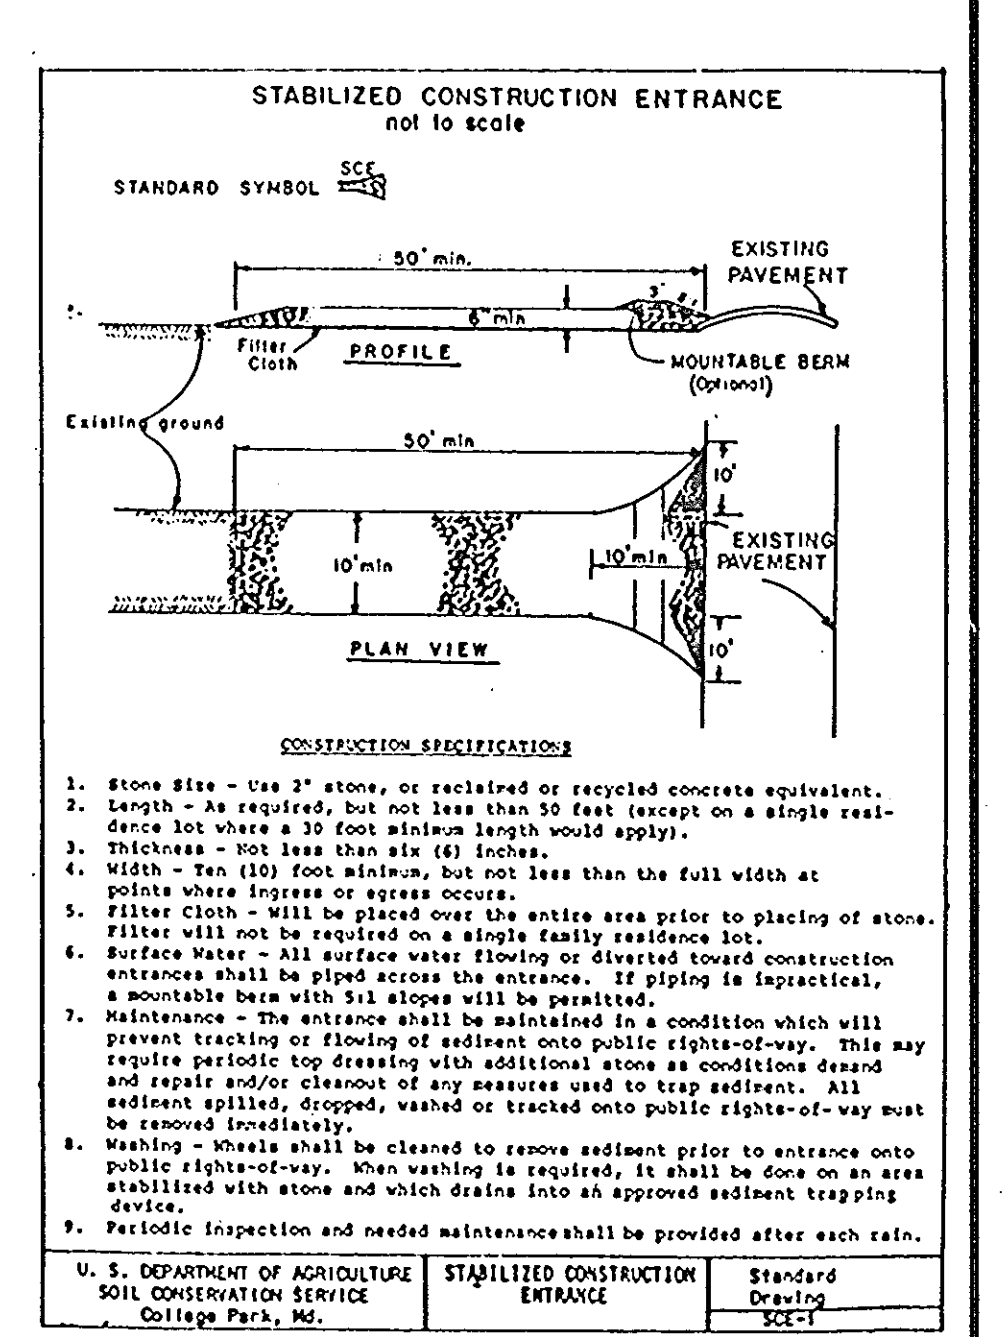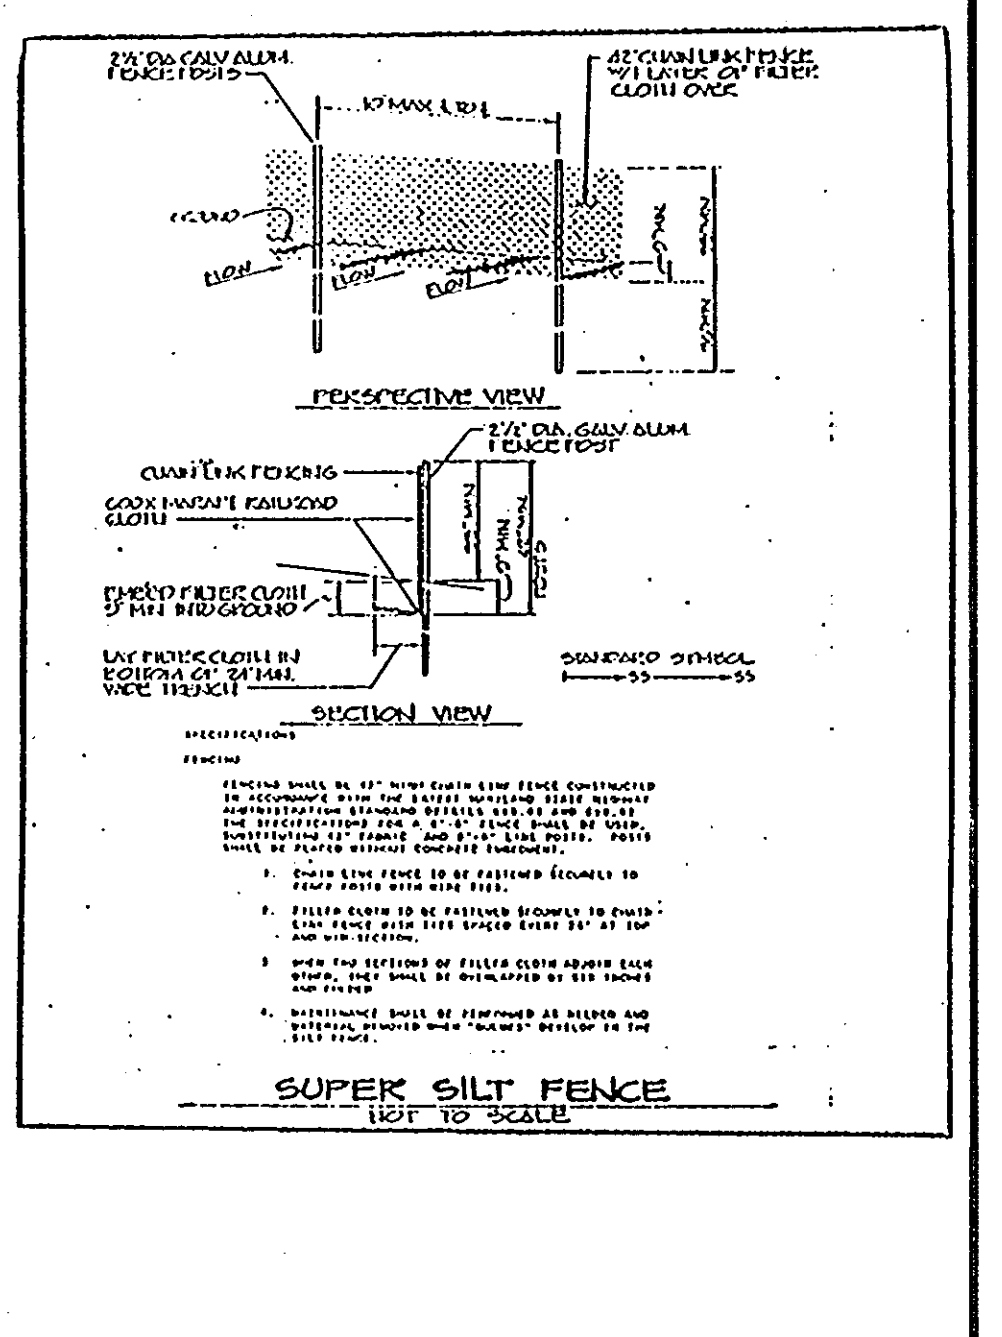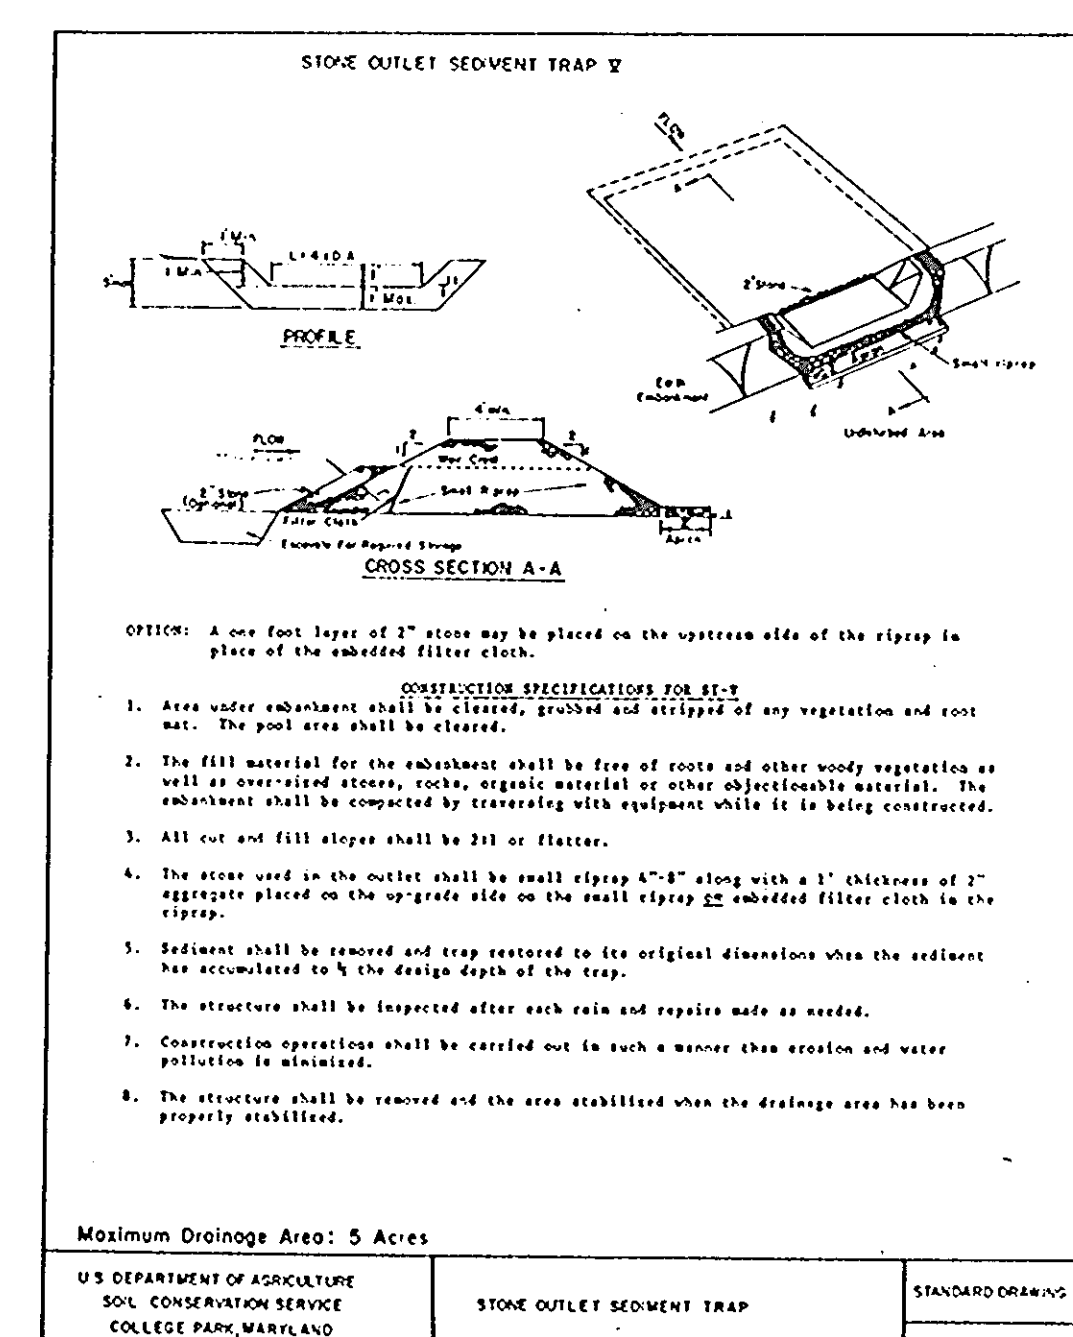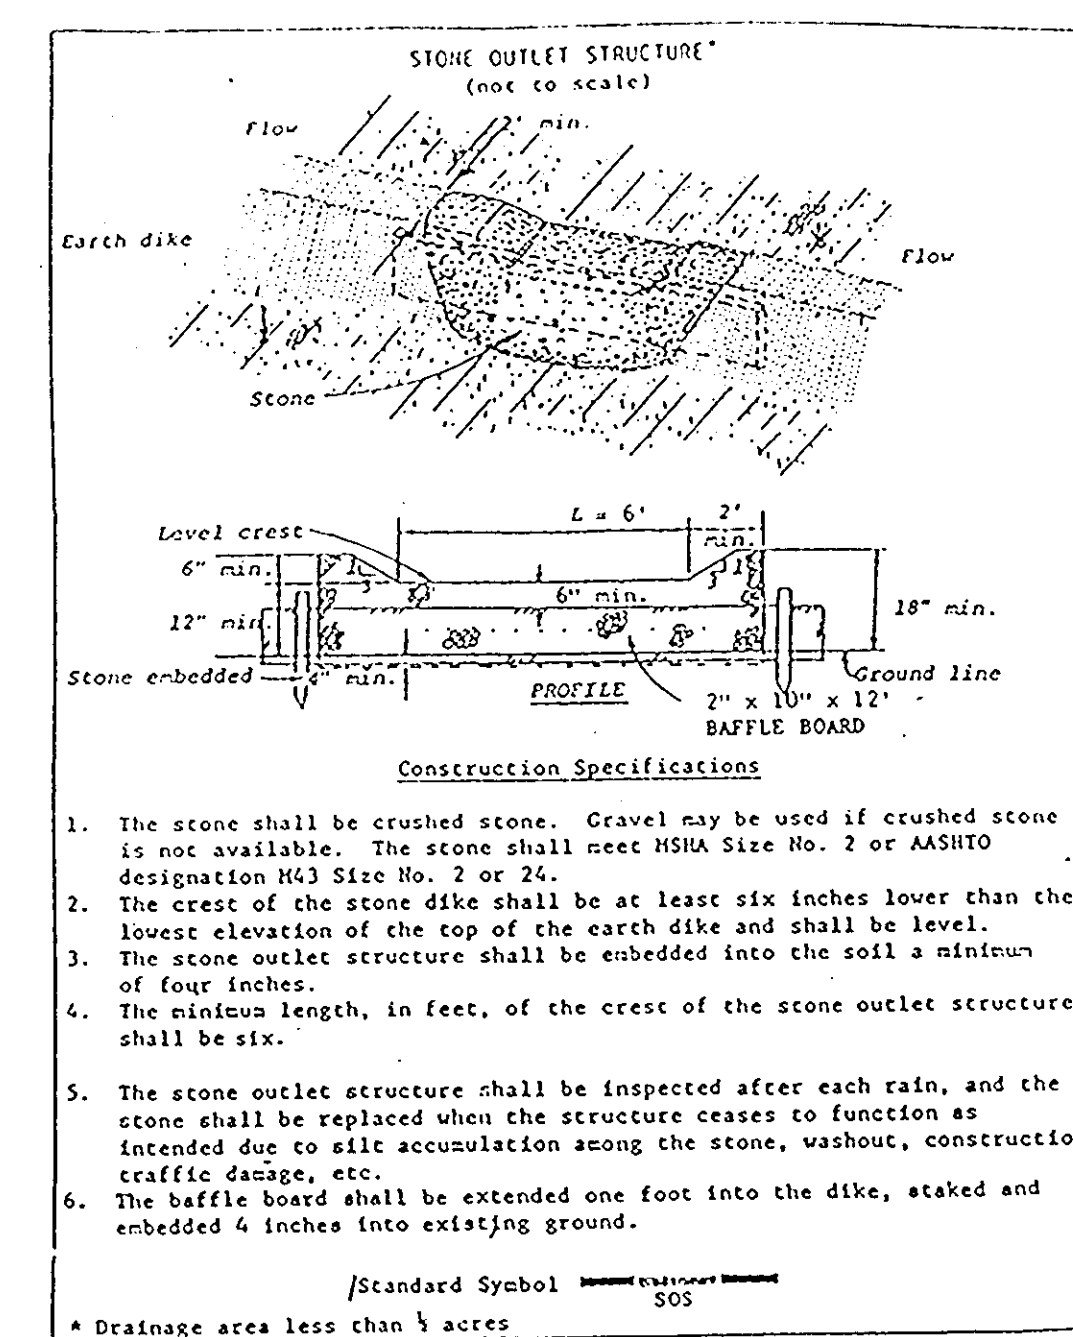

**APPROVED:** HOWARD COUNTY DEPARTMENT OF PLANNING & ZONING

*James R. Smith* 10/20/92  
DIRECTOR DATE

*Edward J. Blomard* 10/19/92  
CHIEF, DIVISION OF COMMUNITY PLANNING AND LAND DEVELOPMENT DATE

**APPROVED:** HOWARD COUNTY DEPARTMENT OF PUBLIC WORKS FOR STORM DRAINAGE SYSTEMS AND ROADS

*James M. Law* 10/7/92  
DIRECTOR DATE

*William R. Reid* 10-19-92  
CHIEF, BUREAU OF ENGINEERING DATE

**REVIEWED:** HOWARD COUNTY HEALTH DEPARTMENT NO WATER OR SANITARY FACILITIES REQUIRED

*Joseph J. Bolger* 10-13-92  
COUNTY HEALTH OFFICER DATE

**APPROVED:** REVIEWED FOR HOWARD COUNTY SOIL CONSERVATION DISTRICT AND MEETS TECHNICAL REQUIREMENTS.

*James M. Helms* 9/24/92  
U.S. SOIL CONSERVATION SERVICE DATE

**APPROVED:** THIS DEVELOPMENT IS APPROVED FOR EROSION AND SEDIMENT CONTROL BY THE HOWARD COUNTY SOIL CONSERVATION DISTRICT.

*John R. Robertson* 9/24/92  
HOWARD SOIL CONSERVATION DISTRICT DATE

**PLAN APPROVAL STAMP**

**APPROVED**

PLANNING BOARD

HOWARD COUNTY

DATE: 9-15-92

**DEVELOPER'S CERTIFICATE**

I/We certify that all development and construction will be done in accordance with this plan of development and plan for erosion and sediment control and that all responsible personnel involved in the construction of this project will have a certificate of attendance at a Department of the Environment approved training program for the control of sediment and erosion before beginning the project. I also authorize periodic onsite inspection by the Howard County Soil Conservation District or their authorized agents, as are deemed necessary.

*Quis Mangione* 6/8/92  
Signature of Developer Date

**ENGINEER'S CERTIFICATE**

I hereby certify that this plan for erosion and sediment control represents a practical and workable plan based on my personal knowledge of the site conditions and that it was prepared in accordance with the requirements of the Howard County Soil Conservation District.

*Bob Mochi* 6-9-92  
Robert M. Mochi, P.E. Date

**OWNER**

MANGIONE ENTERPRISES OF TURF VALLEY  
1205 YORK ROAD - PENTHOUSE  
LUTHERVILLE, MARYLAND 21093

SUBDIVISION NAME					
TURF VALLEY WEST GOLF COURSE PROPOSED SIX HOLES					
SECT./AREA	LOT/PARCEL	PREVIOUS FILE			
N/A	50 & P100	5-96-13, FDP PGCC-1 FDP PGCC-2 & PART OF PGCC-3 FDP PART OF PGCC-9 & PGCC-4			
PLAT No.	BLOCK No.	ZONE	TAX MAP	ELEC. DIST.	CENSUS
902/205 1205/124	10, 11, 16	PGCC	16	3	6022 & 6030
WATER CODE			SEWER CODE		
N/A			N/A		

9200701.DWG  
Project 92007.00  
Date MAY '92  
Engineering TJP  
Approval RMM

REVISIONS

NO.	DATE	DESCRIPTION
1 <td>4/10/93 <td>ADD LINE REVISION-ADDED SUPER SILT FENCE DET.</td> </td>	4/10/93 <td>ADD LINE REVISION-ADDED SUPER SILT FENCE DET.</td>	ADD LINE REVISION-ADDED SUPER SILT FENCE DET.
2 <td>8/10/92 <td>REVISION NOTE TO PER HSCD</td> </td>	8/10/92 <td>REVISION NOTE TO PER HSCD</td>	REVISION NOTE TO PER HSCD
3 <td>7/16/92 <td>ADDED S.C.E. DETAIL HSCD</td> </td>	7/16/92 <td>ADDED S.C.E. DETAIL HSCD</td>	ADDED S.C.E. DETAIL HSCD

PROPOSED SIX HOLES  
**TURF VALLEY WEST GOLF COURSE**  
HOWARD COUNTY, MARYLAND  
ELECTION DISTRICT No. 3  
**SEDIMENT CONTROL NOTES & DETAILS**

**MILDENBERG MOCHI & ASSOCIATES, INC.**  
ENGINEERS - PLANNERS  
SURVEYORS - SHARERS  
3300 N. Ridge Road, Suite 235, Ellicott City, Maryland 21043-3350  
(410) 461-0078 D.C. Metro: (301) 671-5768 Fax: (410) 750-6340

11 OF 11  
SDP-92-116