


TURF VALLEY

PGCC RESIDENTIAL SUBDISTRICT AND AREA H REGIONAL STORMWATER MANAGEMENT POND

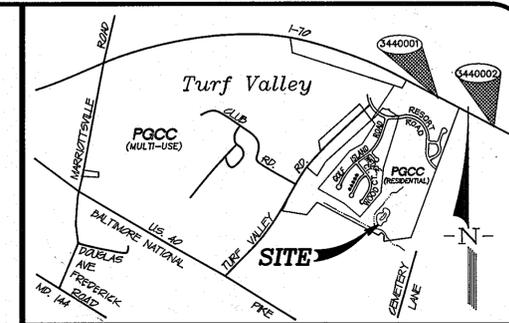


VICINITY MAP
SCALE: 1" = 2000'

GENERAL NOTES:

- The subject property is zoned PGCC - Residential per the Comprehensive Zoning effective October 18, 1993.
- Site Data:
 - Current Zoning: PGCC - Residential
 - Deed Reference: Liber 920 at Folio 285
 - Election District: 2nd
 - Tax Map: 16
 - Parcel: p/o Parcel 8
 - Referenced FDP: PGCC - Residential Subdistrict Area H
 - Gross Area of H: 73.6 Acres
 - Total Area of this submission: 4.67 A.
 - Total Number of proposed lots: none
 - Total Area of proposed lots: none
 - Total Area of Public Road R/W: none
- Topographic information established at two (2) foot contour intervals based on aerial survey performed by Wings Mapping Co., Inc. photographed April 23, 1992 and supplemental field run topography prepared by the R. M. Mochi Group, P.C. dated January 31, 1995.
- | | |
|--|---|
| | Denotes slopes between 15% and 24.9 % |
| | Denotes slopes equal to or greater than 25% |
- There are no steep slopes equal to or greater than 25% lying in a contiguous area of 20,000 s.f. or greater within the proposed limits of submission.
- Existing utilities taken from Howard County contract drawings.
- Soils information taken from Maps #9 and #15, Soil Survey, Howard County, Maryland, July 1968 issue.
- Survey Control is based on NAD '27 Maryland Coordinate System as projected by Howard County Geodetic Control Stations:

No. 3440001	N 534735.478	Elev. 486.341
	E 836286.297	
No. 3440002	N 533593.800	Elev. 462.306
	E 837983.249	
- This SWM facility will serve development pods A, p/o B,C,D,E, & F as shown on the FDP Turf Valley PGCC Residential Subdistrict. This is in accordance with study point No. 7 of the conceptual SWM study dated April 10, 1992.
- This project is subject to WP-95-127 approved on August 14, 1995 in which a waiver was granted from the Howard County Subdivision & Land Development Regulations, Section 16.115.C.2, that prohibits any work within floodplain land, Section 16.116.a.2.ii, that prohibits any grading within 75 feet of A perennial stream.
- The entire parcels from pod A-F shall be graded or shall be designed to drain in to the regional facility through a closed system. If this is not possible a separate pond will be designed and constructed for individual parcels at the development of each parcel.
- See Previous County File References:
 - FDP, Turf Valley Residential Subdistrict Plot # 3054-A-1435
 - 2nd Amended Comprehensive Sketch Plan S-86-13
- As per the geotechnical report prepared by Herbst and Associates dated January 4, 1995 construction of the dam embankment and core trench is not recommended during the wet season (typically December thru May) unless additional measures are taken to insure proper compaction to specified densities. Care should also be given to slope stability with the presence of ground water in certain areas after excavation. Corrective actions, if any, will depend upon field conditions and can be best evaluated at the time of construction.

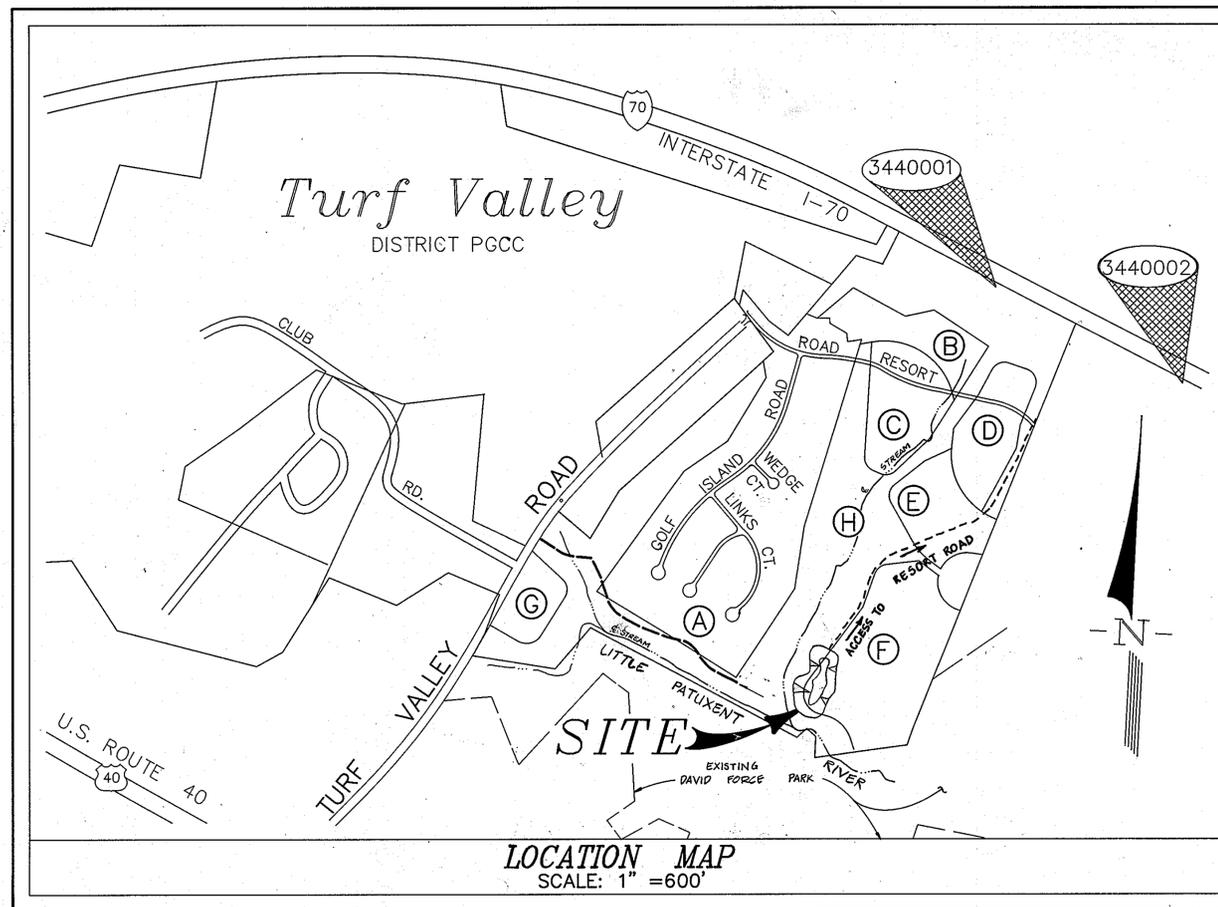

LOCATION MAP
SCALE: 1" = 600'

2nd ELECTION DISTRICT HOWARD COUNTY, MARYLAND

SHEET INDEX

- COVER SHEET
- SITE PLAN OF POND
- PROFILES & DETAILS
- PROFILES & DETAILS
- SPECIFICATIONS & DETAILS
- S.D. PROFILES, NOTES & DETAILS
- SEDIMENT CONTROL PLAN
- SEDIMENT CONTROL NOTES & DETAILS

DESIGN SUMMARY

DESIGN STORM	ALLOWABLE RELEASE RATE	FACILITY INFLOW	FACILITY DISCHARGE	WATER SURFACE ELEVATION	STORAGE VOLUME (Ac. ft.)
2 YEAR	6.6 CFS	99.5	3.3 CFS	398.25	4.15
10 YEAR	54.0 CFS	202.7	44.2 CFS	398.26	6.22
100 YEAR	N/A	344.7	136.2 CFS	400.70	10.41

STRUCTURE CLASSIFICATION: LOW HAZARD, CLASS "A" POND
 STORAGE - HEIGHT PRODUCT: 8.45 AC.FT. x 11.90' = 100.55
 WATERSHED AREA TO FACILITY (ACRES): ULTIMATE 63.0 ACRES
 LEVEL OF MANAGEMENT PROVIDED BY FACILITY: TWO AND TEN YEAR STORMS

PLANNING BOARD APPROVAL BLOCK	PERMIT INFORMATION CHART	ADDRESS CHART																			
<p>APPROVED PLANNING BOARD OF HOWARD COUNTY</p> <p>DATE: 28 Sept. 1995</p>	<table border="1"> <tr> <td>SUBDIVISION NAME: TURF VALLEY</td> <td>SECTION/AREA RESIDENTIAL FOD H</td> <td>LOT/PARCEL# p/o 8</td> <td>LOT No.</td> <td>STREET ADDRESS</td> </tr> <tr> <td>PLAT No. L/F 920/285</td> <td>BLOCK# 18</td> <td>ZONE PGCC R6</td> <td>TAX/ZONE MAP 16</td> <td>ELECT. DISTRICT 2nd</td> </tr> <tr> <td>WATER CODE N/A</td> <td>SEWER CODE N/A</td> <td>CENSUS TRACT 6022</td> <td></td> <td></td> </tr> </table>	SUBDIVISION NAME: TURF VALLEY	SECTION/AREA RESIDENTIAL FOD H	LOT/PARCEL# p/o 8	LOT No.	STREET ADDRESS	PLAT No. L/F 920/285	BLOCK# 18	ZONE PGCC R6	TAX/ZONE MAP 16	ELECT. DISTRICT 2nd	WATER CODE N/A	SEWER CODE N/A	CENSUS TRACT 6022			<table border="1"> <tr> <td>LOT No.</td> <td>STREET ADDRESS</td> </tr> <tr> <td>N/A</td> <td>2739 LINKS COURT</td> </tr> </table>	LOT No.	STREET ADDRESS	N/A	2739 LINKS COURT
	SUBDIVISION NAME: TURF VALLEY	SECTION/AREA RESIDENTIAL FOD H	LOT/PARCEL# p/o 8	LOT No.	STREET ADDRESS																
	PLAT No. L/F 920/285	BLOCK# 18	ZONE PGCC R6	TAX/ZONE MAP 16	ELECT. DISTRICT 2nd																
WATER CODE N/A	SEWER CODE N/A	CENSUS TRACT 6022																			
LOT No.	STREET ADDRESS																				
N/A	2739 LINKS COURT																				
<p>APPROVED: HOWARD COUNTY DEPARTMENT OF PUBLIC WORKS</p> <p><i>Michael J. ...</i> 4/22/96 CHIEF, DEVELOPMENT ENGINEERING DIVISION</p> <p><i>Gina ...</i> 4/29/96 CHIEF, DIVISION OF LAND DEVELOPMENT AND RESEARCH</p> <p><i>Joseph ...</i> 4/29/96 DIRECTOR</p>	<p>APPROVED: THESE PLANS FOR SMALL POND CONSTRUCTION, SOIL EROSION AND SEDIMENT CONTROL MEET THE REQUIREMENTS OF THE HOWARD SOIL CONSERVATION DISTRICT</p> <p><i>Robert ...</i> 4/16/96 HOWARD SOIL CONSERVATION DISTRICT</p>	<p>APPROVED: THESE PLANS HAVE BEEN REVIEWED FOR HOWARD SOIL CONSERVATION DISTRICT AND MEET THE TECHNICAL REQUIREMENTS FOR SMALL POND CONSTRUCTION, SOIL EROSION AND SEDIMENT CONTROL.</p> <p><i>John ...</i> 4/16/96 HOWARD SOIL CONSERVATION DISTRICT</p>																			

OWNER/DEVELOPER
 MANGIONE ENTERPRISES OF TURF VALLEY
 1205 York Road, Penthouse
 Lutherville, Maryland 21093
 (410)825-8400
 Attn: Mr. Louis Mangione

ENGINEER
 R.M. MOCHI GROUP, P.C.
 3300 North Ridge Road, Suite 235
 Ellicott City, Maryland 21043
 (410)461-0079
 Attn: Mr. Robert M. Mochi, P.E.

DEVELOPER'S CERTIFICATE

I, the undersigned, hereby certify that all development and/or construction will be done according to these plans and that any responsible personnel involved in the construction project will have a certificate of attendance at a department of the environment approved training program for the control of sediment and erosion before beginning the project. I shall engage a registered professional engineer to supervise pond construction and provide the HOWARD SOIL CONSERVATION DISTRICT WITH AN "AS-BUILT" PLAN OF THE POND WITHIN 30 DAYS OF COMPLETION. I ALSO AUTHORIZE PERIODIC ON-SITE INSPECTIONS BY THE HOWARD SOIL CONSERVATION DISTRICT.

Robert M. Mochi
 Signature of Developer
 6/15/95
 Date

ENGINEER'S CERTIFICATE

I, the undersigned, hereby certify that this plan for pond construction, erosion and sediment control represents a professional engineering plan based on my personal knowledge of the site conditions. This plan was prepared in accordance with the requirements of the HOWARD SOIL CONSERVATION DISTRICT. I HAVE NOTICED THAT HE/SHE MUST ENGAGE A REGISTERED PROFESSIONAL ENGINEER TO SUPERVISE POND CONSTRUCTION AND PROVIDE THE HOWARD SOIL CONSERVATION DISTRICT WITH AN "AS-BUILT" PLAN OF THE POND WITHIN 30 DAYS OF COMPLETION.


Robert M. Mochi
 Signature of Engineer
 6-15-95
 Date

project	95002.00	date	6/7/95
illustration	MNZ	engineering	AMY
scale	AS NOTED	approval	RAM


AS BUILT INFORMATION	11/09/98	date	9/10/95
ADDED	7/01/99	revisions	
DESCRIPTION	4-23-96	description	
REVISIONS	4/17/96	description	
DATE	9/10/95	description	

TURF VALLEY REGIONAL SWM POND
 ELECTION DISTRICT No. 2
 HOWARD COUNTY, MARYLAND
 COVER SHEET

R.M. MOCHI GROUP, P.C.
 3300 N. Ridge Road, Suite 235
 Ellicott City, MD 21043-3350
 (410) 461-0079
 Fax: (410) 750-6340

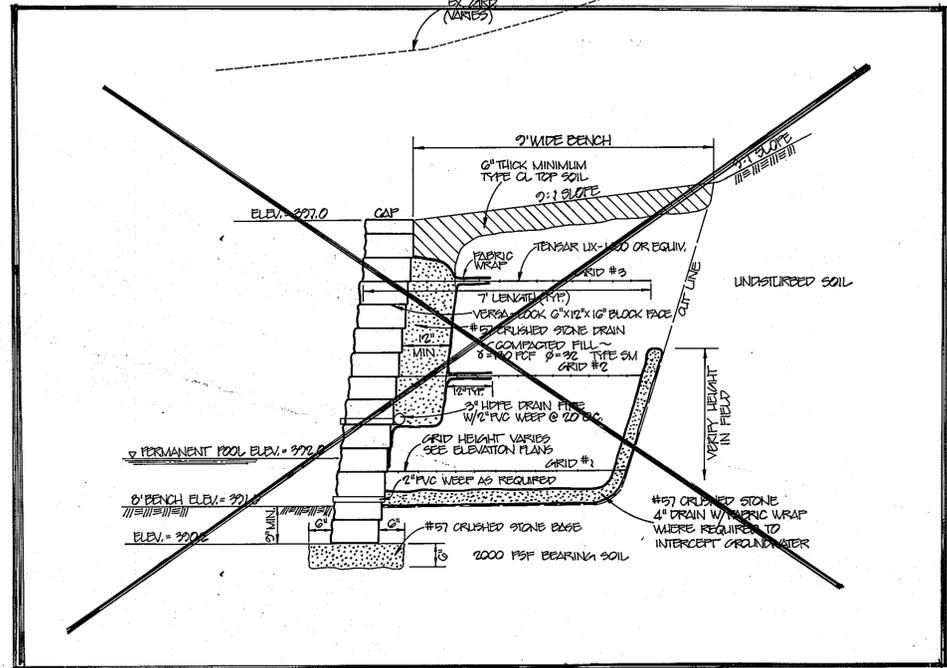


WALL SECTION A-A
NOT TO SCALE

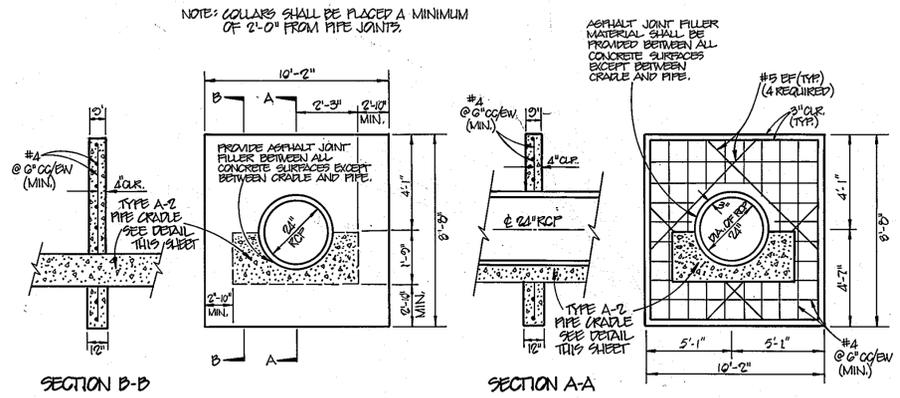


TYPICAL SECTION THROUGH
BARREL, CRADLE & ANTI-SEEP COLLAR
NOT TO SCALE


- NOTES**
1. CONCRETE SHALL BE MSHA MIX #3 (FC > 3,500 PSI)
 2. REINFORCING STEEL - GRADE 60
 3. FOR WALLS OF STRUCTURE SHALL UTILIZE L.M. SCOFIELD CO. FORM LINERS (RANDOM SLIT-FACE FLOCK) (OPTIONAL)
 4. PROVIDE BUSHING FROM FINISH
 5. ANCHOR BOLTS SHALL BE INSTALLED IN ACCORDANCE WITH SECTION G.07.03.93 OF THE MSHA STANDARDS AND SPECIFICATIONS.
 6. ALL REINFORCING SPLICES SHALL BE LAP SPLICES OF 30 BAR DIAMETERS UNLESS SHOWN OTHERWISE.

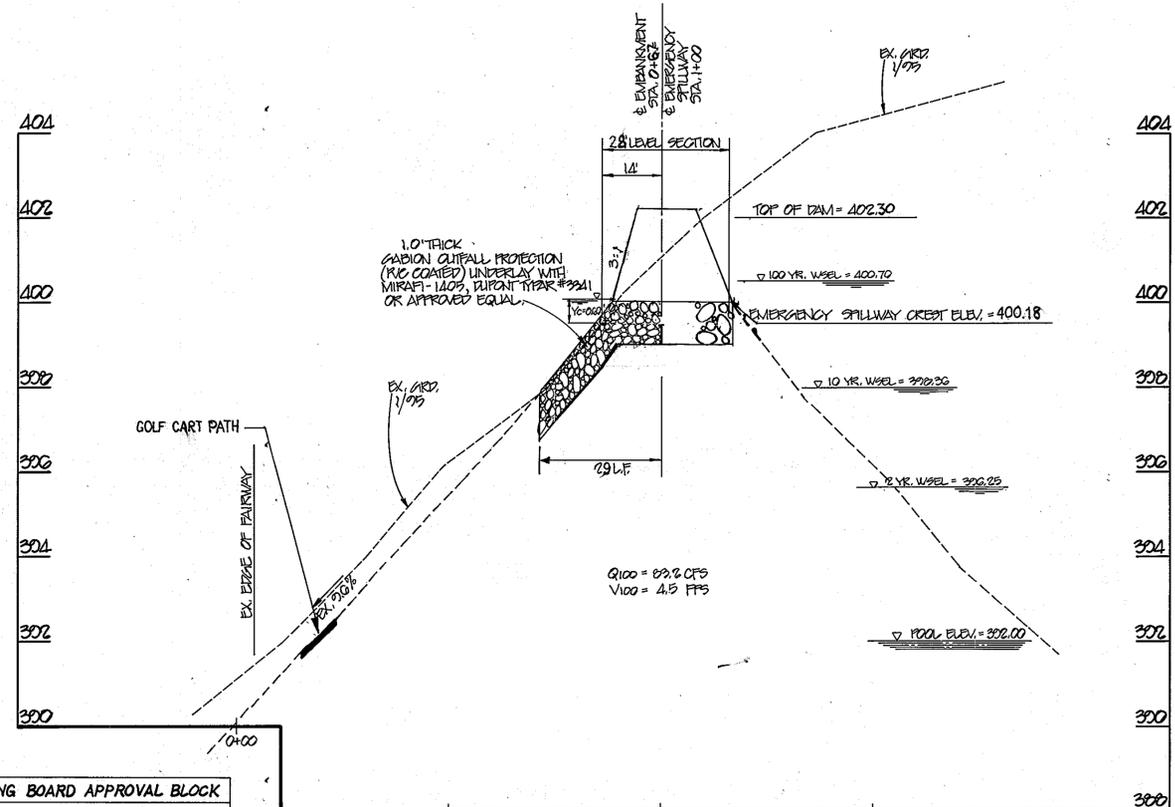

EMERGENCY SPILLWAY PROFILE

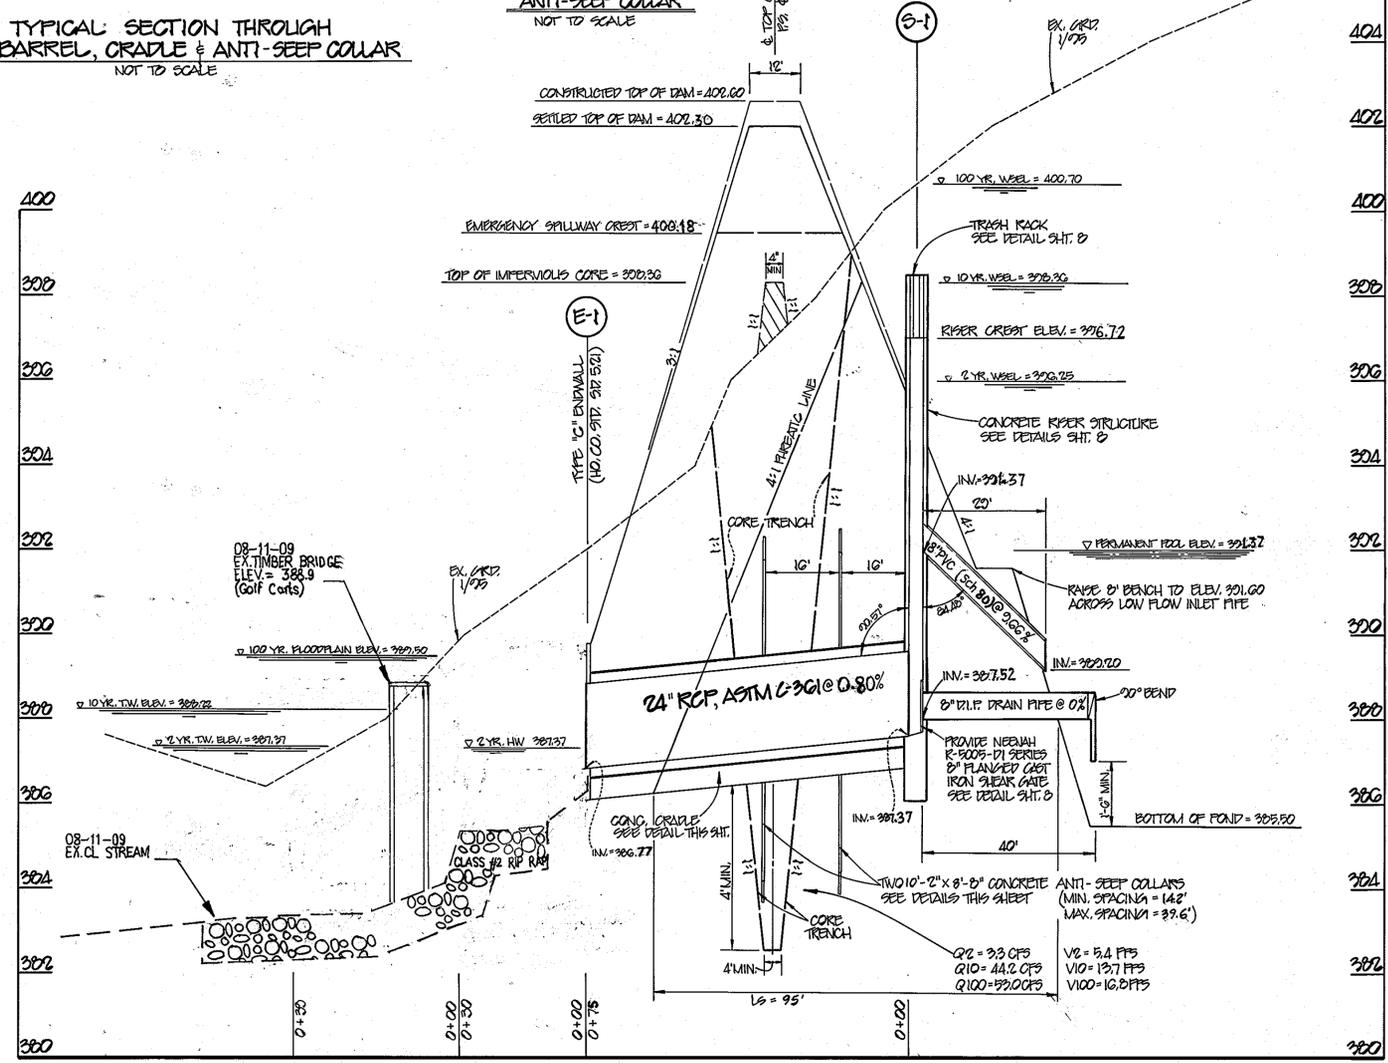

PRINCIPAL SPILLWAY PROFILE

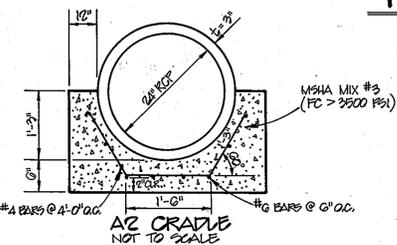

PLANNING BOARD APPROVAL BLOCK

APPROVED
PLANNING BOARD
OF HOWARD COUNTY
DATE 28 Sept. 95

APPROVED: HOWARD COUNTY DEPARTMENT OF PLANNING AND ZONING
 [Signature] 4/22/96
 CHIEF, DEVELOPMENT ENGINEERING DIVISION
 [Signature] 4/29/96
 CHIEF, DIVISION OF LAND DEVELOPMENT AND RESEARCH
 [Signature] 4/29/96
 DIRECTOR

APPROVED: THESE PLANS FOR SMALL POND CONSTRUCTION, SOIL EROSION AND SEDIMENT CONTROL MEET THE REQUIREMENTS OF THE HOWARD SOIL CONSERVATION DISTRICT
 [Signature] 4/16/96
 HOWARD SOIL CONSERVATION DISTRICT

APPROVED: THESE PLANS HAVE BEEN REVIEWED FOR HOWARD SOIL CONSERVATION DISTRICT AND MEET THE TECHNICAL REQUIREMENTS FOR SMALL POND CONSTRUCTION, SOIL EROSION AND SEDIMENT CONTROL.
 [Signature] 4/16/96
 FOR NATURAL RESOURCES CONSERVATION SERVICES

DEVELOPER'S CERTIFICATE
 "I HEREBY CERTIFY THAT ALL DEVELOPMENT AND/OR CONSTRUCTION SHALL BE DONE ACCORDING TO THESE PLANS AND THAT ANY RESPONSIBLE PERSONNEL INVOLVED IN THE CONSTRUCTION PROJECT WILL HAVE A CERTIFICATE OF ATTENDANCE AT A DEPARTMENT OF THE ENVIRONMENT APPROVED TRAINING PROGRAM FOR THE CONTROL OF SEDIMENT AND EROSION BEFORE BEGINNING THE PROJECT. I SHALL EMPLOY A REGISTERED PROFESSIONAL ENGINEER TO SUPERVISE POND CONSTRUCTION AND PROVIDE THE HOWARD SOIL CONSERVATION DISTRICT WITH AN 'AS-BUILT' PLAN OF THE POND WITHIN 90 DAYS OF COMPLETION. I ALSO AUTHORIZED PERIODIC ON-SITE INSPECTIONS BY THE HOWARD SOIL CONSERVATION DISTRICT."
 [Signature] 6/15/95
 Signature of Developer Date

ENGINEER'S CERTIFICATE
 "I CERTIFY THAT THIS PLAN FOR POND CONSTRUCTION, EROSION AND SEDIMENT CONTROL REPRESENTS A PROFESSIONAL AND WORKABLE PLAN BASED ON MY PERSONAL KNOWLEDGE OF THE SITE CONDITIONS. I HAVE ALSO PREPARED IN ACCORDANCE WITH THE REQUIREMENTS OF THE HOWARD SOIL CONSERVATION DISTRICT. I HAVE NOTIFIED THE DEVELOPER THAT HE/SHE MUST EMPLOY A REGISTERED PROFESSIONAL ENGINEER TO SUPERVISE POND CONSTRUCTION AND PROVIDE THE HOWARD SOIL CONSERVATION DISTRICT WITH AN 'AS-BUILT' PLAN OF THE POND WITHIN 90 DAYS OF COMPLETION."
 [Signature] 6-15-95
 Robert M. Mochi, P.E. Date

OWNER/DEVELOPER
 MANGIONE ENTERPRISES OF TURF VALLEY
 1205 York Road, Penthouse
 Lutherville, Maryland 21093
 (410)825-8400
 Attn: Mr. Louis Mangione


ENGINEER
 R.M. MOCHI GROUP, P.C.
 3300 North Ridge Road, Suite 235
 Ellicott City, Maryland 21043
 (410)461-0079
 Attn: Mr. Robert M. Mochi, P.E.

Project	Date	By	Scale	Approval
950002.00	1/17/95	AMY	AS SHOWN	RMA

AS BUILT INFORMATION	DATE	DESCRIPTION	REVISIONS
1	11/09/09	ADDED STORMWATER POND LAYOUT AND TRENCH ACCESS TO RESERT ROAD	1
2	7/01/09	ADDED COMMENTS	2
3	4-16-96	ADDED COMMENTS	3
4	4/17/95	ADDED COMMENTS	4
5	6/16/95	1ST SUBMITTAL TO HOWARD COUNTY DPE	5


PGCC DISTRICT - RESIDENTIAL SUBDISTRICT
TURF VALLEY REGIONAL SWM POND
 ELECTION DISTRICT NO. 2
 HOWARD COUNTY, MARYLAND
 STORMWATER MANAGEMENT NOTES & DETAILS

R.M. MOCHI GROUP, P.C.
 3300 N. Ridge Road, Suite 235
 Ellicott City, MD 21043-3350
 (410) 461-0079
 Fax: (410) 750-6340

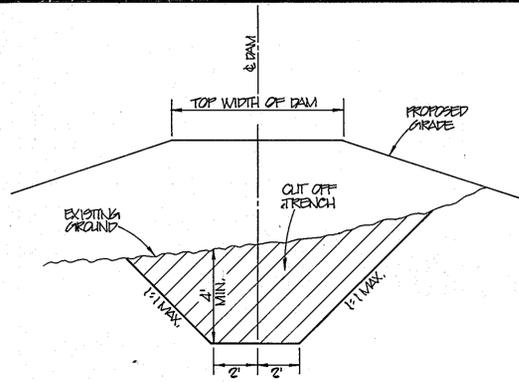


CUT OFF TRENCH DETAIL
NOT TO SCALE


- NOTES**
1. CENTER OF IMPERVIOUS FILL ON CENTERLINE OF DAM.
 2. IMPERVIOUS FILL SHALL MEET HIS CLASSIFICATION CL OR SC.
 3. COMPACT TO 95% OF AASHTO T-100 DENSITY.
 4. SIDE SLOPES SHALL BE 1 TO 1 (1:1) OR FLATTER.
 5. TRENCH SHALL EXTEND ALONG CENTERLINE OF FILL TO MINIMUM DEPTH OF 4 FEET BELOW EXISTING GRADE.
 6. CUT OFF TRENCH TO EXTEND 4 FEET BELOW ALL PIPES, STRUCTURES, ETC.
 7. CONTRACTOR SHALL KEEP CORE TRENCH PUMPED DRY WHILE DURING CONSTRUCTION.

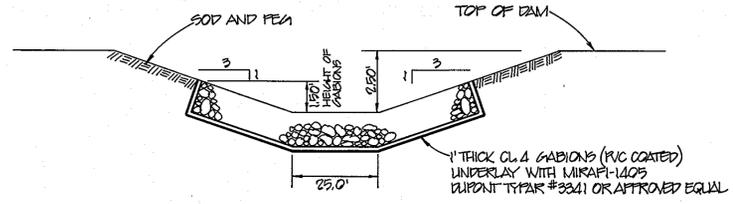


GABION TRAPEZOIDAL CHANNEL DETAIL @ EMERGENCY SPILLWAY
NOT TO SCALE

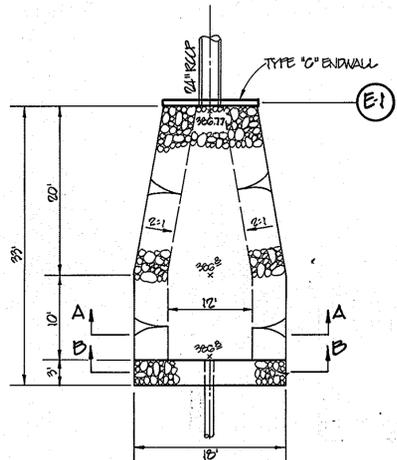


PLAN VIEW @ E-1
NOT TO SCALE

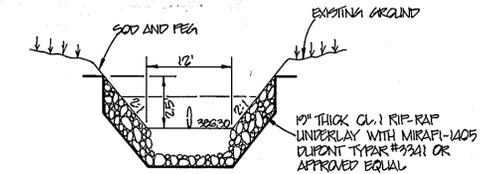

SECTION A-A
NOT TO SCALE

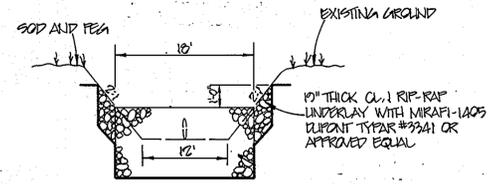

SECTION B-B
NOT TO SCALE

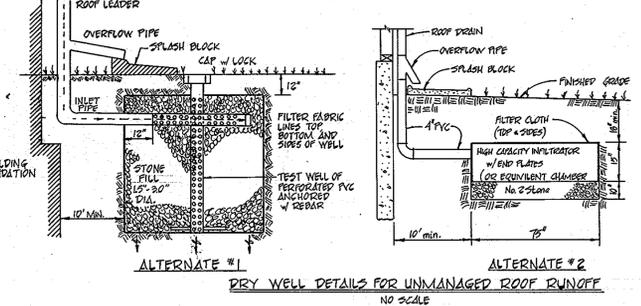

DIET WELL DETAILS FOR UNMANAGED ROOF RUNOFF
NO SCALE

PLANNING BOARD APPROVAL BLOCK

APPROVED


DATE 08 Sept. 95

APPROVED: HOWARD COUNTY DEPARTMENT OF PLANNING AND ZONING

[Signature] 4/22/96 DATE


[Signature] 4/29/96 DATE

[Signature] 4/29/96 DATE

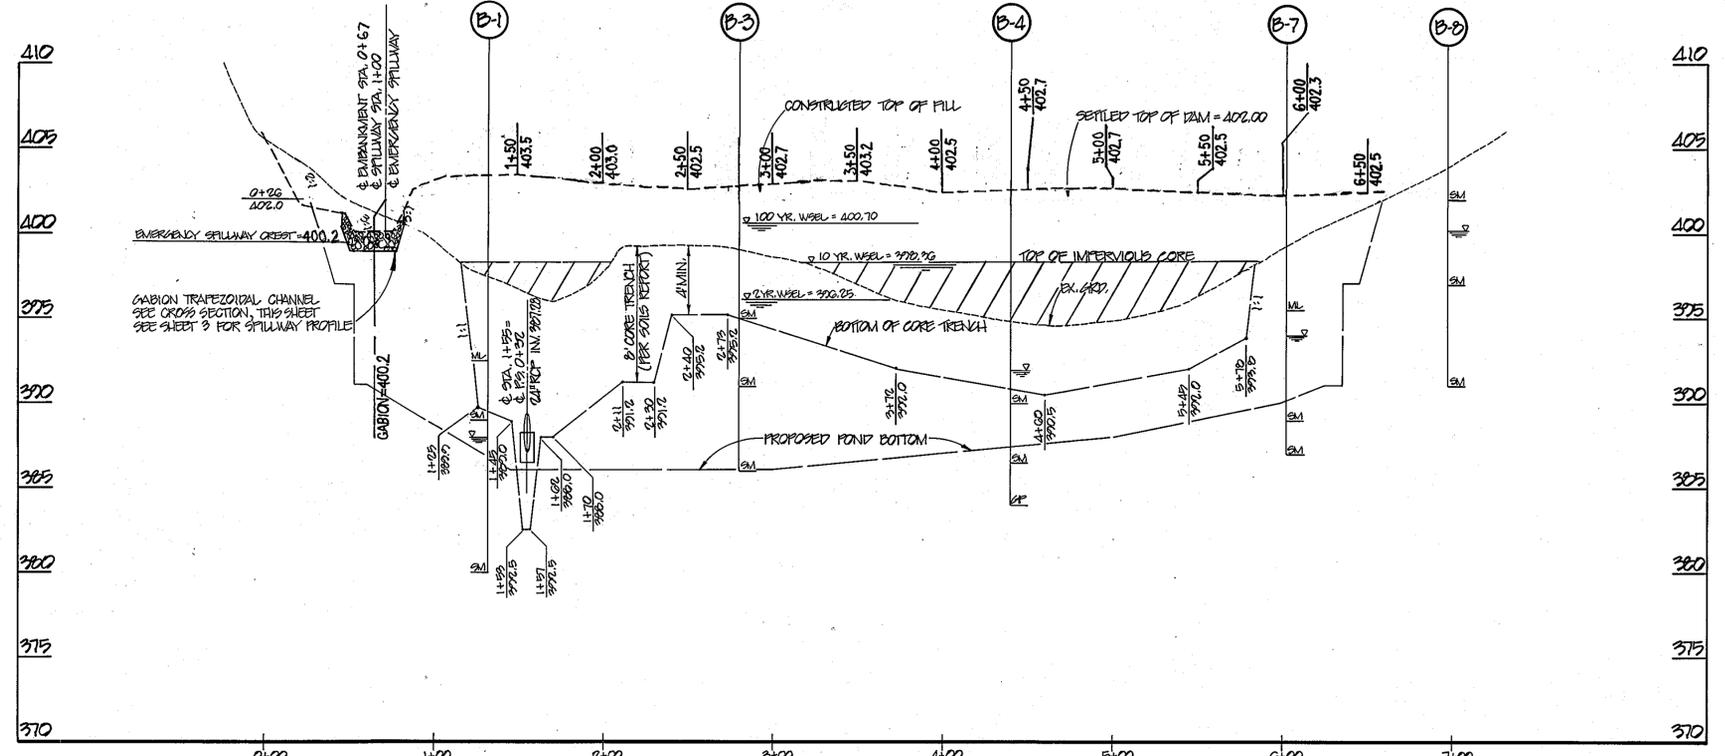

PROFILE ALONG E OF EMBANKMENT

SCALE: HORIZ. 1" = 50'
VERT. 1" = 5'

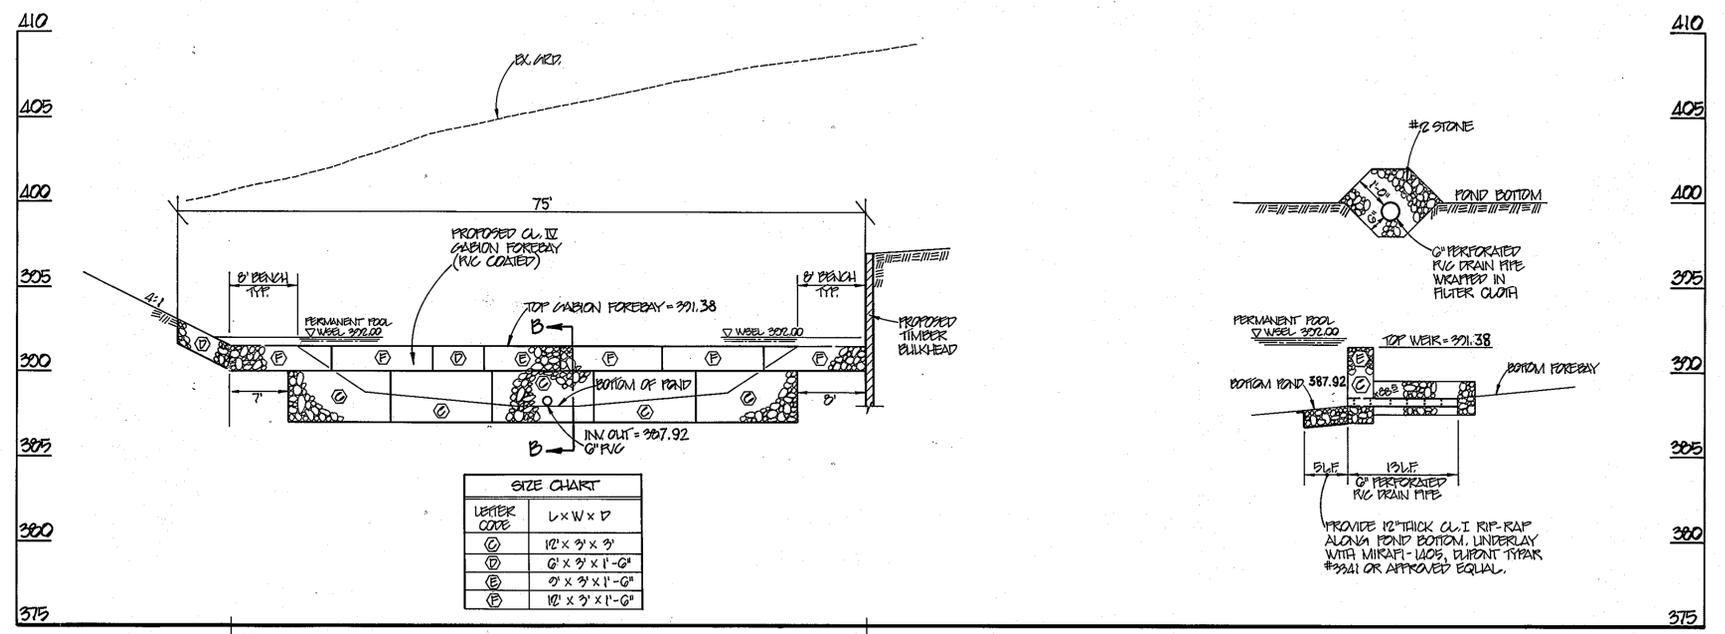

WATER QUALITY FOREBAY PROFILE

SCALE: HORIZ. 1" = 10'
VERT. 1" = 5'

NOTE: THESE ALTERNATIVE BMP DRY WELL DESIGNS FOR WATER QUALITY SHALL APPLY TO UNMANAGED ROOF RUNOFF FROM THE FOLLOWING PLOTS THAT ARE NOT TREATED BY APPROVED NON-STRUCTURAL BMP'S

POD	LOTS	ANY UNCONTROLLED RUNOFF
A	73-103-106-108-114-103-132-134	
B	ANY UNCONTROLLED ROOF RUNOFF	
C	"	
D	"	
E	"	
F	"	

OWNER/DEVELOPER

MANGIONE ENTERPRISES OF TURF VALLEY
1205 York Road, Penthouse
Lutherville, Maryland 21093
(410)825-8400
Attn: Mr. Louis Mangione

ENGINEER

R.M. MOCHI GROUP, P.C.
3300 North Ridge Road, Suite 235
Ellicott City, Maryland 21043
(410)461-0079
Attn: Mr. Robert M. Mochi, P.E.

DEVELOPER'S CERTIFICATE

"I/WE CERTIFY THAT ALL DEVELOPMENT AND/OR CONSTRUCTION WILL BE DONE ACCORDING TO THESE PLANS AND THAT ANY RESPONSIBLE PERSONNEL INVOLVED IN THE CONSTRUCTION PROJECT WILL HAVE A CERTIFICATE OF ATTENDANCE AT A DEPARTMENT OF THE ENVIRONMENT APPROVED TRAINING PROGRAM FOR THE CONTROL OF EROSION AND SEDIMENT BEFORE BEGINNING THE PROJECT. I SHALL EMPLOY A REGISTERED PROFESSIONAL ENGINEER TO SUPERVISE POND CONSTRUCTION AND PROVIDE THE HOWARD SOIL CONSERVATION DISTRICT WITH AN "AS-BUILT" PLAN OF THE POND WITHIN 30 DAYS OF COMPLETION. I ALSO AUTHORIZE PERIODIC ON-SITE INSPECTIONS BY THE HOWARD SOIL CONSERVATION DISTRICT."

[Signature] DATE 4/16/96

ENGINEER'S CERTIFICATE

"I CERTIFY THAT THIS PLAN FOR POND CONSTRUCTION, EROSION AND SEDIMENT CONTROL REPRESENTS A PROFESSIONAL AND WORKABLE PLAN BASED ON MY PERSONAL KNOWLEDGE OF THE SITE. CONSTRUCTION OF THIS POND WAS PREPARED IN ACCORDANCE WITH THE REQUIREMENTS OF THE HOWARD SOIL CONSERVATION DISTRICT. I HAVE ADVISED THE DEVELOPER THAT HE SHE MUST EMPLOY A REGISTERED PROFESSIONAL ENGINEER TO SUPERVISE POND CONSTRUCTION AND PROVIDE THE HOWARD SOIL CONSERVATION DISTRICT WITH AN "AS-BUILT" PLAN OF THE POND WITHIN 30 DAYS OF COMPLETION."

[Signature] DATE 6/15/95

APPROVED: THESE PLANS FOR SMALL POND CONSTRUCTION, SOIL EROSION AND SEDIMENT CONTROL MEET THE REQUIREMENTS OF THE HOWARD SOIL CONSERVATION DISTRICT

[Signature] 4/16/96 DATE

APPROVED: THESE PLANS HAVE BEEN REVIEWED FOR HOWARD SOIL CONSERVATION DISTRICT AND MEET THE TECHNICAL REQUIREMENTS FOR SMALL POND CONSTRUCTION, SOIL EROSION AND SEDIMENT CONTROL.

[Signature] 4/16/96 DATE


Project	950002.00	Date	1/17/95
Illustration	ELP	Engineering	AMY
Scale	AS SHOWN	Approval	RAM

1/17/95	1/17/95	4-19-96	4/17/96
1	2	1	2
1	2	1	2

PGCC DISTRICT - RESIDENTIAL SUBDISTRICT
TURF VALLEY REGIONAL SWM POND
ELECTION DISTRICT NO. 2
HOWARD COUNTY, MARYLAND
SEDIMENT CONTROL NOTES & DETAILS

R.M. MOCHI GROUP, P.C.

3300 N. Ridge Road, Suite 235
Ellicott City, MD 21043-3350
(410) 461-0079
Fax: (410) 750-8540

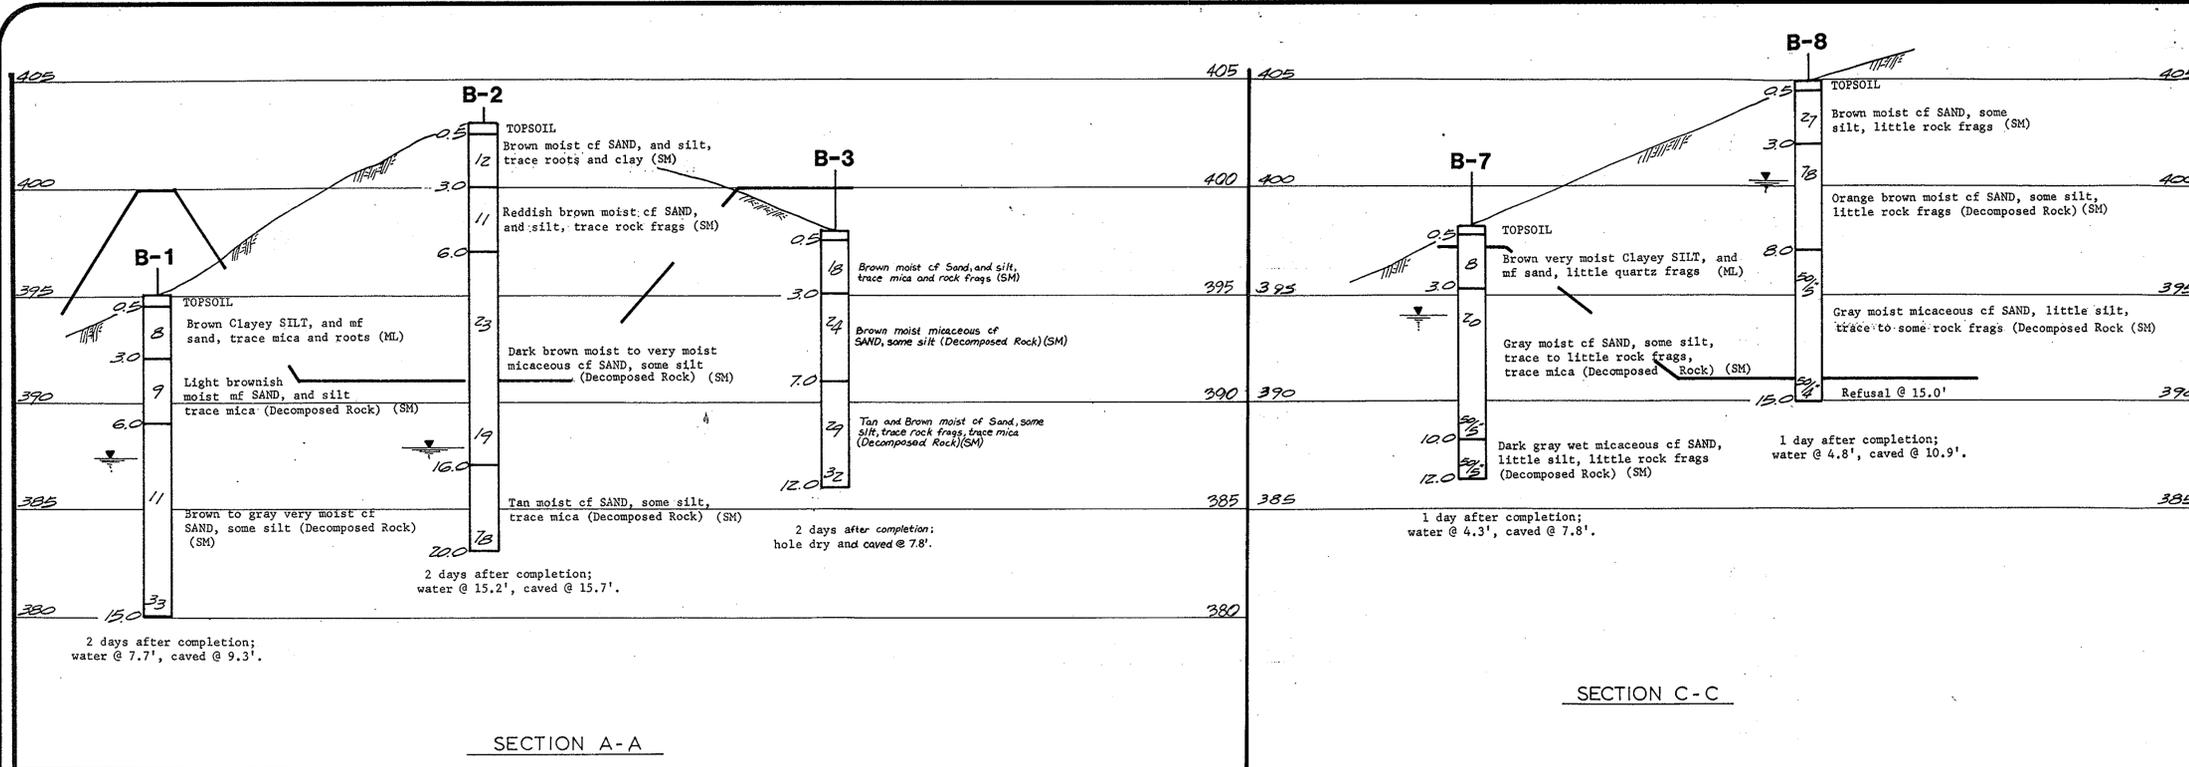

OPERATION AND MAINTENANCE SCHEDULE OF PRIVATELY OWNED AND MAINTAINED STORMWATER MANAGEMENT FACILITY

1. MAINTENANCE REQUIREMENTS

- Removal of silt when accumulation exceeds six (6) inches in forebay.
- Removal of accumulated paper, trash and debris as necessary.
- Vegetation growing on the embankment top and faces of the forebay or basin is not allowed to exceed 18 inches in height at any time.
- Annual inspection and repair of the structure.
- Corrective maintenance is required any time a forebay does not drain within 60 hours (i.e. no standing water is allowed unless designed for).

AS-BUILT CERTIFICATION

I hereby certify that the facility shown on this plan was constructed as shown on the "as-built" plans and meets the approved plans and specifications.


Signature _____ PE No. _____
Date _____

CERTIFICATION

Certify means to state or declare a professional opinion based upon onsite inspections and material tests which are conducted during construction. The onsite inspections and material tests are those inspections and tests deemed sufficient and appropriate by commonly accepted engineering standards. Certify does not mean or imply a guarantee by the engineer nor does an engineer's certification relieve any party from meeting requirements imposed by contract, employment, or other means, including meeting commonly accepted industry practices.

OPERATION, MAINTENANCE AND INSPECTION

Inspection of the pond(s) shown hereon shall be performed at least annually, in accordance with the checklist and requirements contained within USDA, SCS Standards and Specifications for Ponds (MD-378). The pond owner(s) and any heirs, successors, or assigns shall be responsible for the safety of the pond and the continued operation, surveillance, inspection, and maintenance thereof. The pond owner(s) shall promptly notify the Soil Conservation District of any unusual observations that may be indications of distress such as excessive seepage, turbid seepage, sliding or slumping.

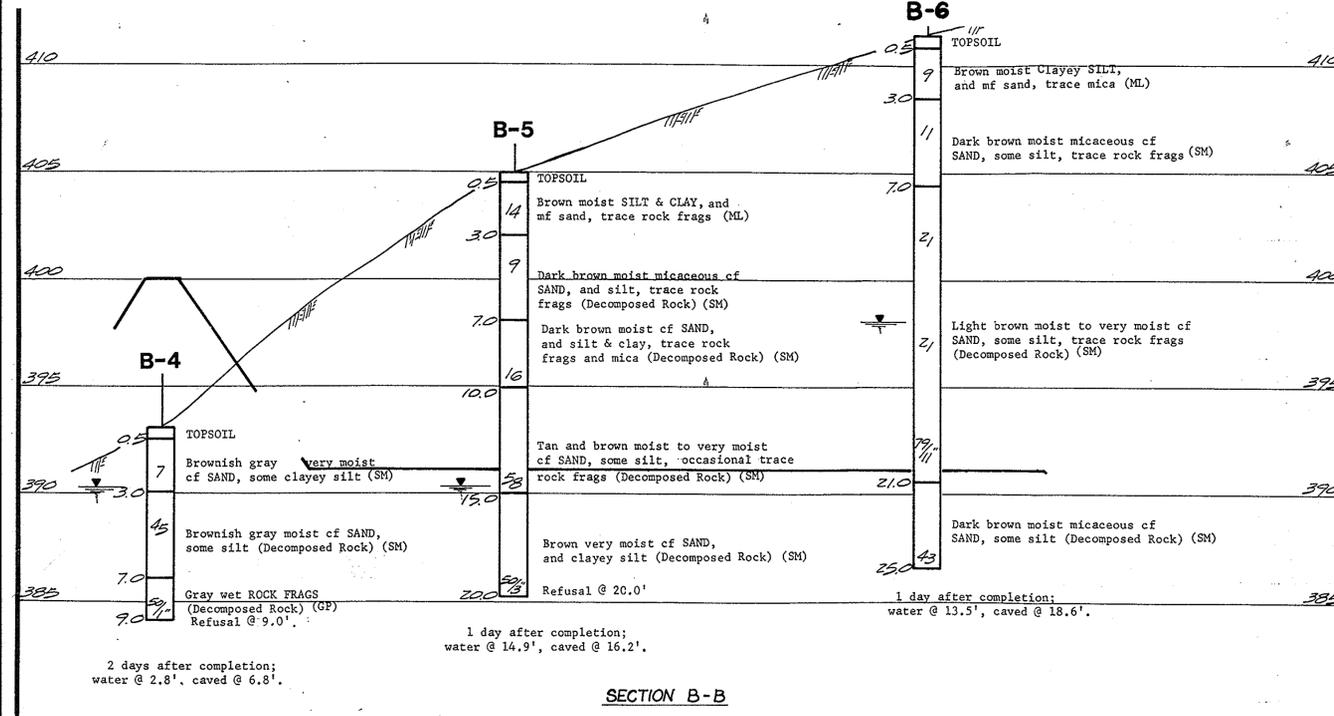

POND CONSTRUCTION SPECIFICATIONS

These specifications are appropriate to all ponds within the scope of the Standard for Practice MD-378. All references to ASTM and AASHTO specifications apply to the most recent version.

Site Preparation

Areas designated for borrow areas, embankment, and structural works shall be cleared, grubbed and stripped of topsoil. All trees, vegetation, roots and other objectionable material shall be removed. Channel banks and sharp breaks shall be sloped to no steeper than 1:1.

Where a minimum required density is specified, it shall not be less than 95% of maximum dry density with a moisture content within ±2% of the optimum. Each layer of fill shall be compacted as necessary to obtain that density, and is to be certified by the Engineer at the time of construction. All compaction is to be determined by AASHTO Method T-99.

Excavation

The cutoff trench shall be excavated into impervious material along or parallel to the centerline of the embankment as shown on the plans. The bottom width of the trench shall be governed by the equipment used for excavation, with the minimum width being four feet. The depth shall be at least four feet below existing grade or as shown on the plans. The side slopes of the trench shall be 1 to 1 or flatter.

Structure Backfill

Backfill adjacent to pipes or structures shall be of the type and quality conforming to that specified for the adjoining fill material. The fill shall be placed in horizontal layers not to exceed four inches in thickness and compacted by hand tampers or other manually directed compaction equipment. The material needs to fill completely all spaces under and adjacent to the pipe. At no time during the backfilling operation shall driven equipment be allowed to operate closer than four feet, measured horizontally, to any part of a structure. Under no circumstances shall equipment be driven over any part of a concrete structure or pipe, unless there is a compacted fill of 24" or greater over the structure or pipe.

Pipe Conduits

All pipes shall be circular in cross section.

Compaction

The movement of the hauling and spreading equipment over the fill shall be controlled so that the entire surface of each lift shall be traversed by not less than one track of the equipment or compaction shall be achieved by a minimum of four complete passes of a sheepsfoot, rubber tired or vibratory roller. Fill material shall contain sufficient moisture such that the required degree of compaction will be obtained with the equipment used. The fill material shall contain sufficient moisture so that if formed into a ball it will not crumble yet not be so wet that water can be squeezed out.

Reinforced Concrete Pipe

All of the following criteria shall apply for reinforced concrete pipe:

- Materials - Reinforced concrete pipe shall have bell and spigot joints with rubber gaskets and shall equal or exceed ASTM Designation C-361.
- Bedding - All reinforced concrete pipe conduits shall be laid in a concrete bedding for their entire length. This bedding shall consist of high slump concrete placed under the pipe and up the sides of the pipe at least 10% of its outside diameter with a minimum thickness of 3 inches, or as shown on the drawings.
- Laying pipe - Bell and spigot pipe shall be placed with the bell end upstream. Joints shall be made in accordance with recommendations of the manufacturer of the material. After the joints are sealed for the entire line, the bedding shall be placed so that all spaces under the pipe are filled. Care shall be exercised to prevent any deviation from the original line and grade of the pipe. The first joint must be located within 2 feet from the riser.
- Backfilling shall conform to "Structure Backfill".
- Other details (anti-seep collars, valves, etc.) shall be as shown on the drawings.

Polyvinyl Chloride (PVC) Pipe

All of the following criteria shall apply for polyvinyl chloride (PVC) pipe:

- Materials - PVC pipe shall be PVC-1120 or PVC-1220 conforming to ASTM D-1785 or ASTM D-2241.
- Joints and connections to anti-seep collars shall be completely watertight.
- Bedding - The pipe shall be firmly and uniformly bedded throughout its entire length. Where rock or soft, spongy or other unstable soil is encountered, all such material shall be removed and replaced with suitable earth compacted to provide adequate support.
- Backfilling shall conform to "Structure Backfill".
- Other details (anti-seep collars, valves, etc.) shall be as shown on the drawings.

Concrete

Concrete shall meet the requirements of Maryland Department of Transportation, State Highway Administration Standard Specifications for Construction and Materials, Section 608, Mix No. 3.

Rock Riprap

Rock riprap shall meet the requirements of Maryland Department of Transportation, State Highway Administration Standard Specifications for Construction and Materials, Section 905.

The riprap shall be placed to the required thickness in one operation. The rock shall be delivered and placed in a manner that will insure the riprap in place shall be reasonably homogeneous with the larger rocks uniformly distributed and firmly in contact one to another with the smaller rocks filling the voids between the larger rocks. Filter cloth shall be placed under all riprap and shall meet the requirements of Maryland Department of Transportation, State Highway Administration Standard Specifications for Construction and Materials, Section 919.12.

Care of Water during Construction

All work on permanent structures shall be carried out in areas free from water. The Contractor shall construct

PLANNING BOARD APPROVAL BLOCK

APPROVED
PLANNING BOARD
of HOWARD COUNTY

DATE: 10 Sept. '95

APPROVED: HOWARD COUNTY DEPARTMENT OF PLANNING AND ZONING

DATE: 4/22/96

DATE: 4/29/96

DATE: 4/29/96

APPROVED: THESE PLANS FOR SMALL POND CONSTRUCTION, SOIL EROSION AND SEDIMENT CONTROL MEET THE REQUIREMENTS OF THE HOWARD SOIL CONSERVATION DISTRICT

DATE: 4/16/96

APPROVED: THESE PLANS HAVE BEEN REVIEWED FOR HOWARD SOIL CONSERVATION DISTRICT AND MEET THE TECHNICAL REQUIREMENTS FOR SMALL POND CONSTRUCTION, SOIL EROSION AND SEDIMENT CONTROL.

DATE: 4/16/96

DEVELOPER'S CERTIFICATE

I, the undersigned, hereby certify that all development and/or construction will be done in accordance with these plans and that any responsible personnel involved in the construction project will have a certificate of attendance at a department of the environment approved training program for the control of erosion and sediment before beginning the project. I shall employ a registered professional engineer to supervise pond construction and provide the HOWARD SOIL CONSERVATION DISTRICT WITH AN "AS-BUILT" PLAN OF THE POND WITHIN 90 DAYS OF COMPLETION. I ALSO AUTHORIZE PERIODIC ON-SITE INSPECTIONS BY THE HOWARD SOIL CONSERVATION DISTRICT.

DATE: 6/15/95

ENGINEER'S CERTIFICATE

I hereby certify that this plan for pond construction, erosion and sediment control represents a professional and adequate plan based on my personal knowledge of the site and conditions. I have prepared this plan in accordance with the requirements of the HOWARD SOIL CONSERVATION DISTRICT. I HAVE NOTIFIED THE DEVELOPER THAT HE/SHE MUST EMPLOY A REGISTERED PROFESSIONAL ENGINEER TO SUPERVISE POND CONSTRUCTION AND PROVIDE THE HOWARD SOIL CONSERVATION DISTRICT WITH AN "AS-BUILT" PLAN OF THE POND WITHIN 90 DAYS OF COMPLETION.

DATE: 6/15/95

PROJECT: 95002.00
DATE: 6/6/95
ENGINEERING: AMY
ILLUSTRATION: MIZ
SCALE: AS NOTED
APPROVAL: RM

APPROVED BY: HOWARD COUNTY DEPARTMENT OF PLANNING AND ZONING
DATE: 4/29/96

TURF VALLEY REGIONAL SWM POND
HOWARD COUNTY, MARYLAND
ELECTION DISTRICT No. 2
SEDIMENT CONTROL NOTES & DETAILS




R.M. MOCHI GROUP, P.C.
1300 N. Ridge Road, Suite 235
Ellicott City, MD 21043-3058
(410) 461-0079
Fax: (410) 736-6340

Project:	95002.00	Date:	1/17/95
Illustration:	BLP	Engineering:	AMY
Scale:	BLP	Approval:	RAM
Sheet:	AP-242A		


Date:	11/09/98	Revised:	4/16/96
By:	AP-242A	Revised:	4/16/96
Checked:	AP-242A	Revised:	4/16/96
Approved:	AP-242A	Revised:	4/16/96

PGCC DISTRICT - RESIDENTIAL SUBDISTRICT
TURF VALLEY REGIONAL SWM POND
 HOWARD COUNTY, MARYLAND
 ELECTION DISTRICT NO. 2
 STORMWATER MANAGEMENT NOTES & DETAILS

R.M. MOCHI GROUP, P.C.
 ENGINEER
 3300 N. Ridge Road, Suite 235
 Ellicott City, MD 21045-3350
 (410) 461-0079
 Fax: (410) 750-6540

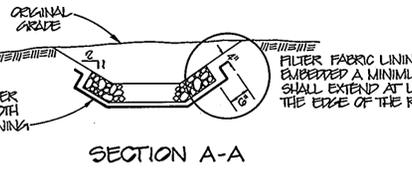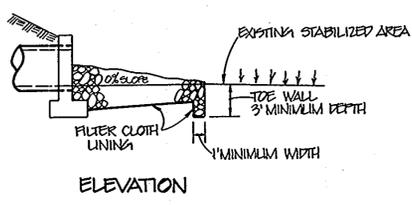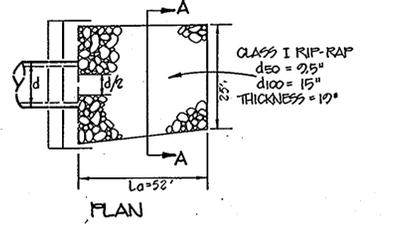

ROCK OUTLET PROTECTION @ E-2
 NOT TO SCALE

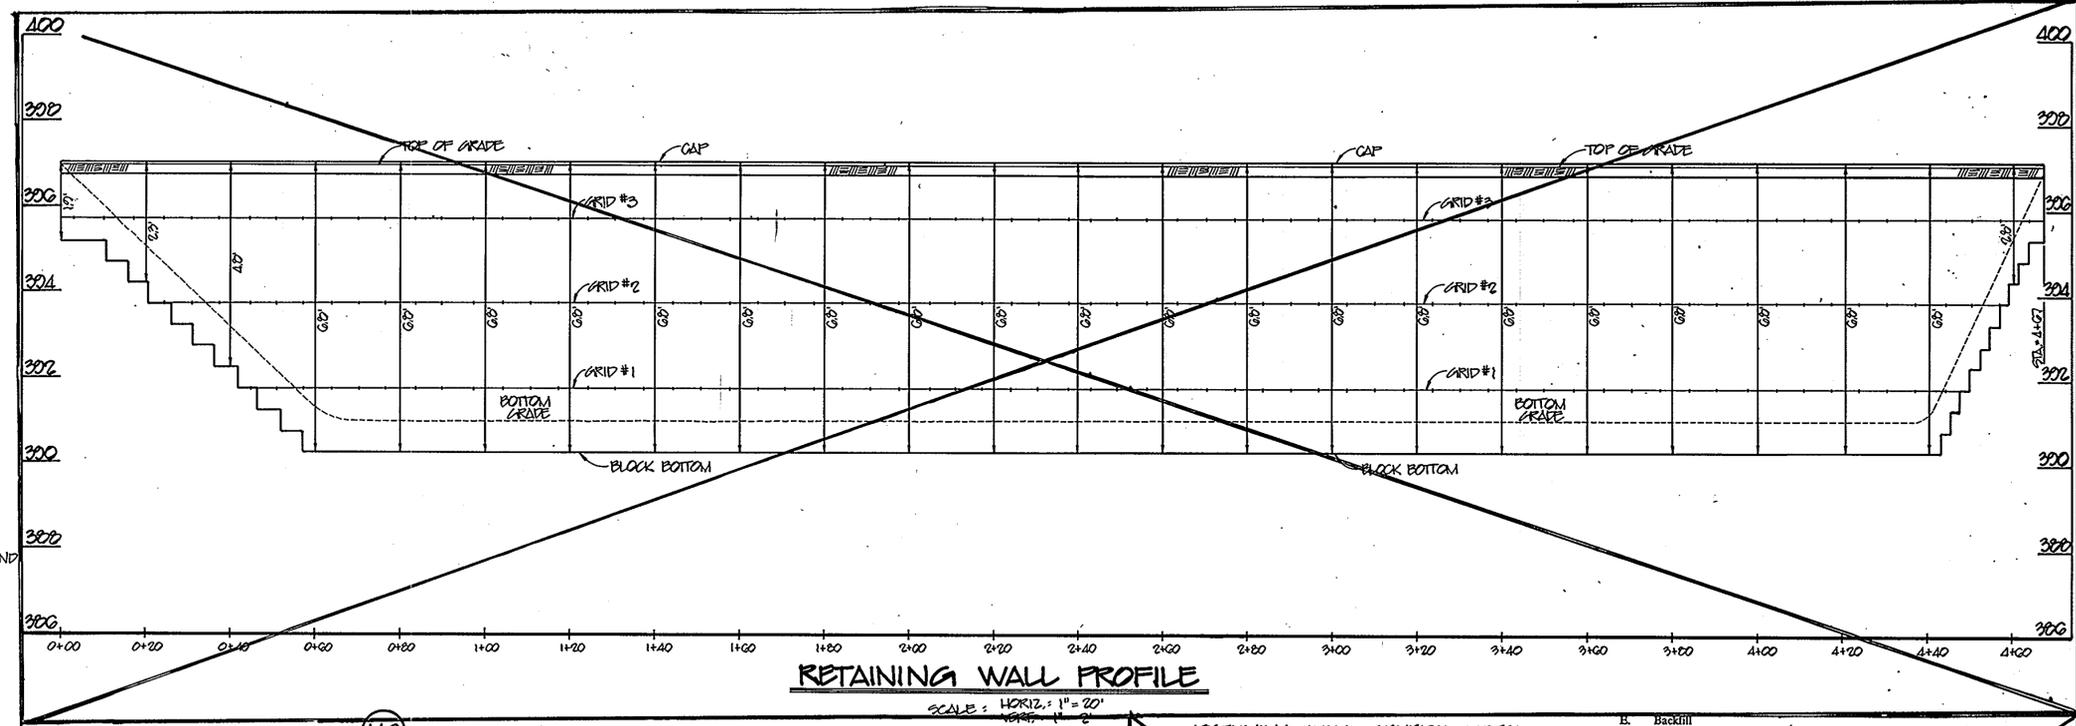

RETAINING WALL GENERAL NOTES

PART 1 - GENERAL

1.1 Work includes furnishing and installing modular block retaining wall units to the lines and grades designated on the construction drawings and as specified herein.

1.2 Applicable Sections of Related Work

A. Section - Geogrid Wall Reinforcement.

1.3 Reference Standards

A. ASTM C90-85 - Hollow Load Bearing Masonry Units
 B. ASTM C140-85 - Sampling and Testing Concrete Masonry Units
 C. ASTM C145-85 - Solid Load Bearing Concrete Masonry Units

PART 2 - RETAINING WALL

2.1 Materials

A. Units

- Concrete Masonry units shall be VERSALOK Retaining Wall Units as manufactured by.
- Concrete Masonry wall units shall have a minimum 28 day compressive strength of 3,000 psi in accordance with ASTM C-90. The concrete shall have adequate freeze/thaw protection with a maximum moisture absorption rate of 6 percent.
- Retaining wall units shall provide a minimum of 100 pounds per square foot of wall face area.
- Exterior face shall be textured. Units shall have angled sides and be capable of attaining concave and convex curves.
- Units shall be interlocked with non-corrosive nylon / fiberglass pins.
- The units shall be interlocked so as to provide a minimum of 3/4 inch setback per course of wall height.

B. Connecting Pins

- Nylon / fiberglass reinforced pins.

C. Base Material

- Material for footing shall consist of compacted sands, gravel and/or concrete as shown on the construction drawings.

D. Drainagefill

- Fill for drainage shall be free draining crushed stone or coarse gravel with no more than 5% passing the #200 sieve and less than 50% passing the #40 sieve.
- A minimum of 12-inches of drainage fill shall extend directly behind the wall to within 18" of final grade. Cap backfill with impervious material.

E. Backfill

- Material shall be native material unless otherwise specified in the drawings. Unsuitable soils as determined by the site engineer shall not be used within the reinforced soil mass when using geogrid for tiebacks.
- Backfill shall be placed in lifts not to exceed 12" and compacted to 95% standard Proctor density.

2.2 Retaining Wall Installation

A. Excavation

- Contractor shall excavate to the lines and grades shown on the construction drawings. Over-excavation shall be replaced with compacted fill, and/or VERSA-LOK wall units.
- Bench excavation of embankment.

B. Foundation Soil Preparation

- Foundation soil shall be excavated as required for footing dimensions shown on the construction drawings, or as directed by the engineer.
- Foundation soil shall be examined by the engineer to assure that the actual foundation soil strength meets or exceeds assumed design strength. Soils not meeting required strength shall be removed and replaced with acceptable material.


C. Base Footing

- Footing shall be placed as shown on the construction drawings with a minimum thickness of 4 inches.
- Footing materials shall be installed upon undisturbed native soils.
- Material shall be compacted so as to provide a level hard surface on which to place the first course of units. Compaction will be with mechanical compactors to 95 percent of standard.
- Footing shall be prepared to ensure complete contact of retaining wall unit with base. Gaps shall not be allowed.
- Footing materials shall be to the depths and widths shown. Contractor may use or use reduced depth of sands and gravel and using a concrete topping. Concrete shall be unreinforced and a minimum of one inch thick. The need for frost protection should be evaluated by the engineer.

D. Unit Installation

- First course of concrete wall units shall be placed on the prepared base. The units shall be checked for level and alignment. The first accurate and acceptable results.
- Ensure that units are in full contact with base.
- Units are placed side by side for full length of wall alignment. Alignment may be done by means of string line offset from base line.
- Place compact drainage and backfill as wall units are installed. Compact to 95% standard Proctor density.
- Sweep all excess material from top of units and install next course. Ensure all voids between units are filled.
- Lay up each course ensuring that pins extend into preceding courses a minimum of one inch. Two pins are required per unit. Pull unit forward as much as possible and backfill as the course is completed. Repeat procedure to the extent of wall height.

E. If geogrid is to be installed as tiebacks, follow the requirements of Geogrid Wall Reinforcement manufacturer.

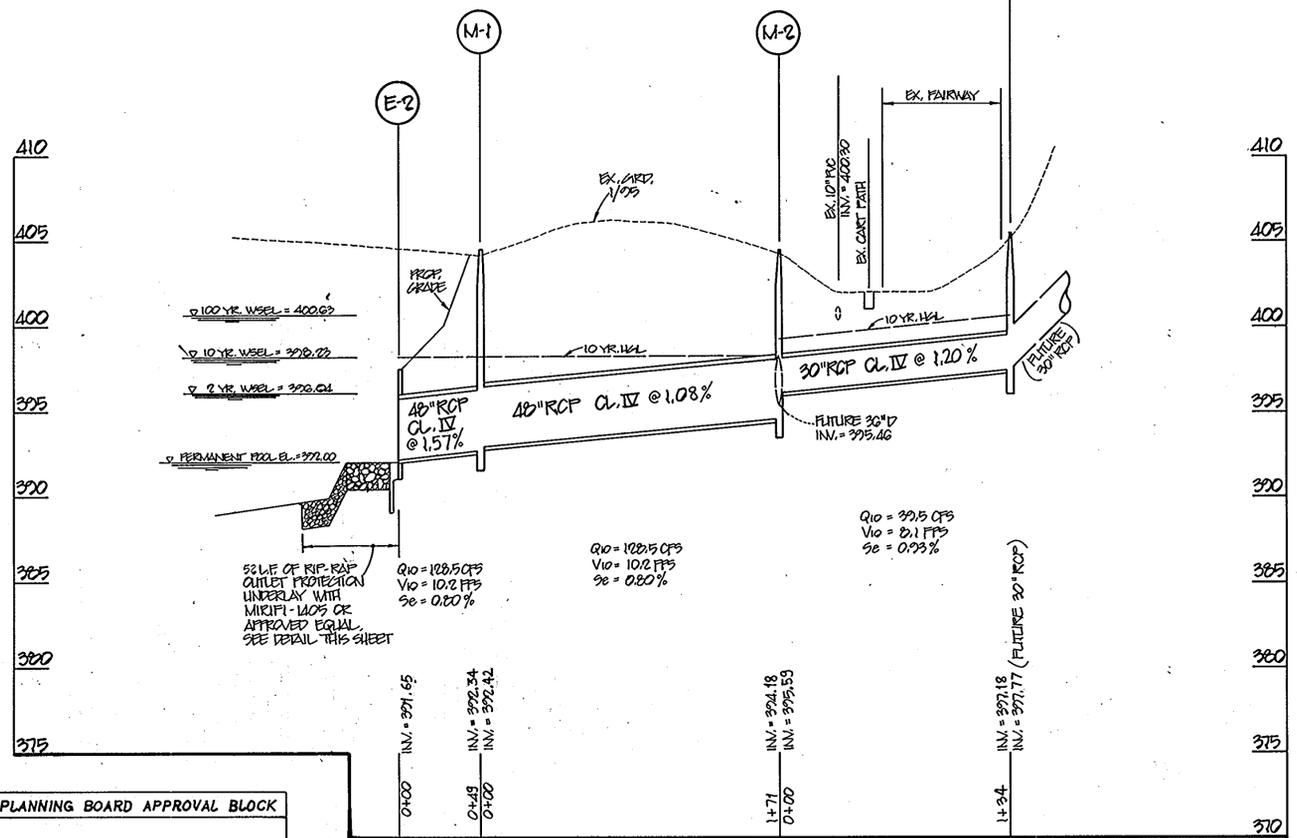

STRUCTURE TABLE

NO.	STR. TYPE	LOCATION	INV. IN	INV. OUT	TOP ELEV.	REMARKS
S-1	SEE PLAN	SEE PLAN	8\"/>			

AS BUILT SURVEY DATE 08/14/09

OWNER/DEVELOPER
 MANGIONE ENTERPRISES OF TURF VALLEY
 1205 York Ridge Road, Penthouse
 Lutherville, Maryland 21093
 (410)825-8400
 Attn: Mr. Louis Mangione

ENGINEER
 R.M. MOCHI GROUP, P.C.
 3300 North Ridge Road, Suite 235
 Ellicott City, Maryland 21043
 (410)461-0079
 Attn: Mr. Robert M. Mochi, P.E.

PLANNING BOARD APPROVAL BLOCK

APPROVED
 PLANNING BOARD
 of HOWARD COUNTY
 DATE 28 Sept. 95

APPROVED: HOWARD COUNTY DEPARTMENT OF PLANNING AND ZONING

[Signature] 4/22/96
 CHIEF, DEVELOPMENT ENGINEERING DIVISION

[Signature] 4/22/96
 CHIEF, DIVISION OF LAND DEVELOPMENT AND RESEARCH

[Signature] 4/29/96
 DIRECTOR

APPROVED: THESE PLANS FOR SMALL POND CONSTRUCTION, SOIL EROSION AND SEDIMENT CONTROL MEET THE REQUIREMENTS OF THE HOWARD SOIL CONSERVATION DISTRICT

[Signature] 4/16/96
 HOWARD SOIL CONSERVATION DISTRICT

APPROVED: THESE PLANS HAVE BEEN REVIEWED FOR HOWARD SOIL CONSERVATION DISTRICT AND MEET THE TECHNICAL REQUIREMENTS FOR SMALL POND CONSTRUCTION, SOIL EROSION AND SEDIMENT CONTROL.

[Signature] 4/16/96
 URBAN NATURAL RESOURCES CONSULTING SERVICES

DEVELOPER'S CERTIFICATE

I/WE CERTIFY THAT ALL DEVELOPMENT AND/OR CONSTRUCTION WILL BE DONE ACCORDING TO THESE PLANS AND THAT ANY RESPONSIBLE PERSONNEL INVOLVED IN THE CONSTRUCTION PROJECT WILL HAVE A CERTIFICATE OF ATTENDANCE AT A DEPARTMENT OF THE ENVIRONMENT APPROVED TRAINING PROGRAM FOR THE CONTROL OF SEDIMENT AND EROSION BEFORE BEGINNING THE PROJECT. I SHALL EMPLOY A REGISTERED PROFESSIONAL ENGINEER TO SUPERVISE POND CONSTRUCTION AND PROVIDE THE HOWARD SOIL CONSERVATION DISTRICT WITH AN "AS-BUILT" PLAN OF THE POND WITHIN 30 DAYS OF COMPLETION. I ALSO ALLOWED PERIOD ON-SITE INSPECTIONS BY THE HOWARD SOIL CONSERVATION DISTRICT.

[Signature] 6/15/95
 Date

ENGINEER'S CERTIFICATE

I CERTIFY THAT THIS PLAN FOR POND CONSTRUCTION, EROSION AND SEDIMENT CONTROL REPRESENTS A PRACTICAL AND WORKABLE PLAN BASED ON MY PERSONAL KNOWLEDGE OF THE SITE CONDITIONS. THIS PLAN WAS PREPARED IN ACCORDANCE WITH THE REQUIREMENTS OF THE HOWARD SOIL CONSERVATION DISTRICT. I HAVE NOTIFIED THE DEVELOPER THAT HE/SHE MUST EMPLOY A REGISTERED PROFESSIONAL ENGINEER TO SUPERVISE POND CONSTRUCTION AND PROVIDE AN "AS-BUILT" CONSTRUCTION DISTRICT WITH AN "AS-BUILT" PLAN OF THE POND WITHIN 30 DAYS OF COMPLETION.

[Signature] 6/15/95
 Date

PERMANENT SEEDING NOTES

Apply to graded or cleared area not subject to immediate further disturbance where a permanent long-lived vegetative cover is needed.

Seeded Preparation: Loosen upper three inches of soil by raking, discing or other acceptable means before seeding. (If not previously loosened)

Soil Amendments: In lieu of soil test recommendations, use on the following schedules:

- 1) Preferred - Apply 2 tons per acre dolomitic limestone (92 lbs/1000 sf) and 600 lbs per acre 10-10-10 fertilizer (14 lbs/1000 sf) before seeding. Harrow or disc into upper three inches of soil. At time of seeding, apply 400 lbs per acre 30-0-0 ureaform fertilizer (9 lbs/1000 sf).
- 2) Acceptable - Apply 2 tons per acre dolomitic limestone (92 lbs/1000 sf) and 1000 lbs per acre 10-10-10 fertilizer (23 lbs/1000 sf) before seeding. Harrow or disc into upper three inches of soil.

Seeding: For the periods March 1 through April 30 and August 1 through October 15, seed with 60 lbs per acre (1.4 lbs/1000 sf) of Kentucky 31 Tall Fescue. For the period May 1 through July 31, seed with 3 lbs per acre of Weeping Lovegrass (0.07 lbs/1000 sf). For the period November 15 through February 28, protect site by applying 2 tons per acre of well anchored straw mulch and seed as soon as possible in the spring. Option 2) use sod. Option 3) seed with 60 lbs/acre Kentucky 31 Tall Fescue and mulch with 2 tons/acre well anchored straw.

Mulching: Apply 1-1/2 to 2 tons per acre (70 to 90 lbs/1000 sf) of unrotted small grain straw immediately after seeding. Anchor mulch immediately after application using mulch anchoring tool or 218 gallons per acre (5 gal/1000 sf) of emulsified asphalt on flat areas. On slopes 8 feet or higher, use 348 gallons per acre (8 gal/1000 sf) for anchoring.

Maintenance: Inspect all seeded areas and make needed repairs, replacements and reseedings.

TEMPORARY SEEDING NOTES

Apply to graded or cleared areas likely to be redistributed where a short-term vegetative cover is needed.

Seeded Preparation: Loosen upper three inches of soil by raking, discing or other acceptable means before seeding. (If not previously loosened)

Soil Amendments: Apply 600 lbs per acre 10-10-10 fertilizer (14 lbs/1000 sf).

Seeding: For periods March 1 through April 30 and from August 15 through November 15, seed with 2-1/2 bushel per acre of annual rye (3.2 lbs/1000 sf). For the period May 1 through August 14, seed with 3 lbs per acre of Weeping Lovegrass (0.07 lbs/1000 sf). For the period November 15 through February 28, protect site by applying 2 tons per acre of well anchored straw mulch and seed as soon as possible in the spring, or use sod.

Mulching: Apply 1-1/2 to 2 tons per acre (70 to 90 lbs/1000 sf) of unrotted small grain straw immediately after seeding. Anchor mulch immediately after application using mulch anchoring tool or 218 gallons per acre (5 gal/1000 sf) of emulsified asphalt on flat areas. On slopes 8 feet or higher, use 348 gallons per acre (8 gal/1000 sf) for anchoring.

Refer to the 1983 Maryland Standards and Specifications for Soil Erosion and Sediment Control for rate and methods not covered.

SEDIMENT CONTROL NOTES

1. A minimum of 48 hours notice must be given to the Howard County Office of Inspections and Permits prior to the start of any construction. (313-1885)
2. All vegetative and structural practices are to be installed according to the provisions of this plan and are to be in conformance with the 1983 Maryland Standards and Specifications for Soil Erosion and Sediment Control.
3. Following initial soil disturbances or redistribution, permanent or temporary stabilization shall be completed within: a) 72 hours for all perimeter sediment control structures, dikes, perimeter slopes and all slopes greater than 3:1, b) 5 calendar days to all other disturbed or graded areas on the project site.
4. All disturbed areas must be stabilized within the time period specified above in accordance with the 1983 Maryland Standards and Specifications for Soil Erosion and Sediment Control for Permanent Seeding (Sec. 51) Sod (Sec. 54), Temporary Seeding (Sec. 50) and Mulching (Sec. 52). Temporary stabilization with mulch alone can only be done when recommended seeding dates do not allow for proper germination and establishment of grasses.
5. All sediment control structures are to remain in place and are to be maintained in operative condition until permission for their removal has been obtained from the Howard County Sediment Control Inspector.
6. Site Analysis:
Total Area of Site: 4.07 Ac.
Area to be Disturbed: 4.07 Ac. ±
Area to be roofed or paved: NONE
Area to be vegetatively stabilized: 3.04 Ac. ±
Total Cut: 15,000 cu. yd. ±
Total Fill: 15,000 cu. yd. ±
Offsite Waste/Borrow Area: None See Note 10 Below
7. Any sediment control practice which is disturbed by grading activity for placement of utilities must be repaired on the same day of disturbance. Additional sediment controls must be provided, if deemed necessary by the Howard County DILP Sediment Control Inspector.
8. Quantities and estimates shown are for sediment control purposes only. Contractor shall prepare his/her own quantity estimates to his/her satisfaction.
9. Earthwork spoil to be taken to a site with an approved sediment control plan.

SEQUENCE OF CONSTRUCTION

1. Obtain all required permits, approvals and licenses from appropriate agencies.
2. Notify Howard County Construction Inspection Division (313-1880) at least five (5) working days prior to starting work on these plans. (5 DAYS)
3. Install all tree protection fence prior to installation of sediment & erosion control devices. (1 DAY)
4. Clear and grub for sediment and erosion control measures only. Install stabilized construction entrance. (2 DAYS)
5. Install all sediment and erosion control measures and devices only as indicated on the plans. All sediment control devices are to be inspected daily and after each rainfall. Repair sediment devices as required. (5 DAYS)
6. Clear and grub for the remainder of the site. (5 DAYS)
7. Construct the proposed SWM facility, begin storm drain system from E-2 to M-3, after embankment is constructed. (20 DAYS)
8. Install sump pits as required keeping disturbed areas dry at all times through construction by sump pit dewatering.
9. Temporarily block the 12" CMP at E-1 until site is stabilized.
10. Stabilize all slopes immediately upon completion of grading.
11. When all contributing areas to the sediment control devices have been stabilized and with the permission of the sediment control inspector, the device may be removed and/or backfilled and the area brought to final design grade. Stabilize all remaining areas in accordance with permanent seeding notes. (5 DAYS)
12. Notify Howard County Office of Inspections and Permits for final inspection of completed project.

PLANNING BOARD APPROVAL BLOCK

APPROVED PLANNING BOARD OF HOWARD COUNTY

DATE 28 Sept. 95

APPROVED: HOWARD COUNTY DEPARTMENT OF PLANNING AND ZONING

4/22/96 DATE

4/29/96 DATE

4/29/96 DATE

APPROVED: THESE PLANS FOR SMALL POND CONSTRUCTION, SOIL EROSION AND SEDIMENT CONTROL MEET THE REQUIREMENTS OF THE HOWARD SOIL CONSERVATION DISTRICT

4/16/96 DATE

APPROVED: THESE PLANS HAVE BEEN REVIEWED FOR HOWARD SOIL CONSERVATION DISTRICT AND MEET THE TECHNICAL REQUIREMENTS FOR SMALL POND CONSTRUCTION, SOIL EROSION AND SEDIMENT CONTROL.

4/16/96 DATE

DEVELOPER'S CERTIFICATE


I HEREBY CERTIFY THAT ALL DEVELOPMENT AND/OR CONSTRUCTION WILL BE DONE ACCORDING TO THESE PLANS AND THAT ANY RESPONSIBLE PERSONNEL INVOLVED IN THE CONSTRUCTION PROJECT WILL HAVE OBTAINED THE NECESSARY APPROVALS FROM THE DEPARTMENT OF THE ENVIRONMENT APPROVED TRAINING PROGRAM FOR THE CONTROL OF SEDIMENT AND EROSION BEFORE BEGINNING THE PROJECT. I SHALL ENSURE A REGISTERED PROFESSIONAL ENGINEER TO SUPERVISE FINAL CONSTRUCTION AND PROVIDE THE HOWARD SOIL CONSERVATION DISTRICT WITH AN "AS-BUILT" PLAN OF THE POND WITHIN 30 DAYS OF COMPLETION. I ALSO AUTHORIZE PERIODIC ON-SITE INSPECTIONS BY THE HOWARD SOIL CONSERVATION DISTRICT.

Signature of Developer: [Signature] Date: 6/15/95


ENGINEER'S CERTIFICATE

I HEREBY CERTIFY THAT THIS PLAN FOR POND CONSTRUCTION, EROSION AND SEDIMENT CONTROL REPRESENTS A PRACTICAL AND WORKABLE PLAN BASED ON MY PERSONAL KNOWLEDGE OF THE SITE. THIS PLAN WAS PREPARED IN ACCORDANCE WITH THE REQUIREMENTS OF THE HOWARD SOIL CONSERVATION DISTRICT. I HAVE NOTIFIED THE DEVELOPER THAT HE/SHE MUST OBTAIN A REGISTERED PROFESSIONAL ENGINEER TO SUPERVISE FINAL CONSTRUCTION AND PROVIDE THE HOWARD SOIL CONSERVATION DISTRICT WITH AN "AS-BUILT" PLAN OF THE POND WITHIN 30 DAYS OF COMPLETION.


Signature of Engineer: [Signature] Date: 6-15-95

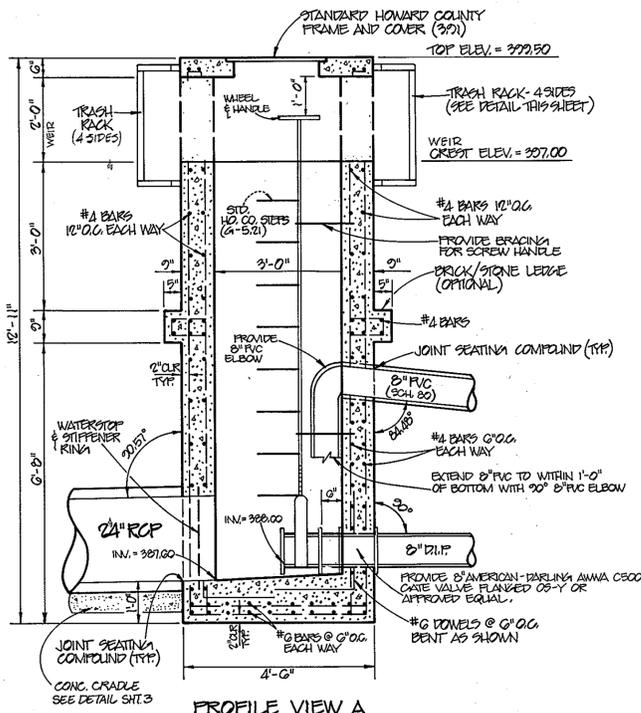

PROFILE VIEW A
CONCRETE RISER DETAIL
SCALE: 1/2" = 1'-0"

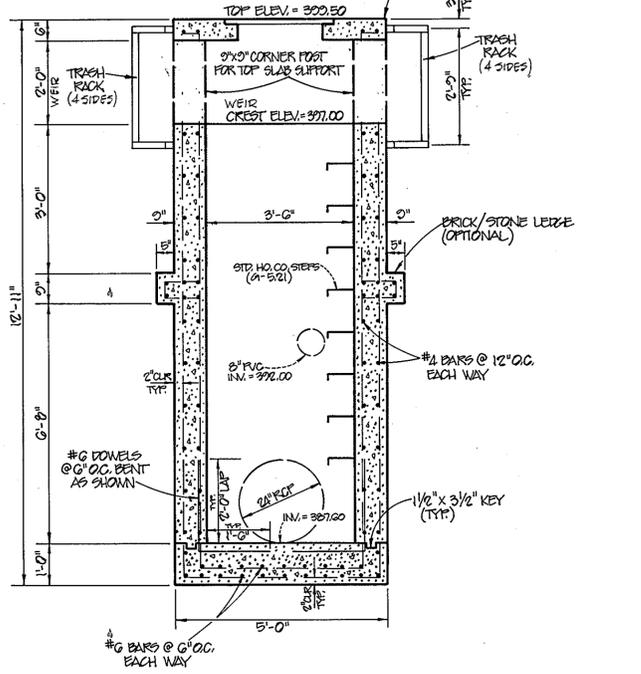


PROFILE VIEW B
CONCRETE RISER DETAIL
SCALE: 1/2" = 1'-0"

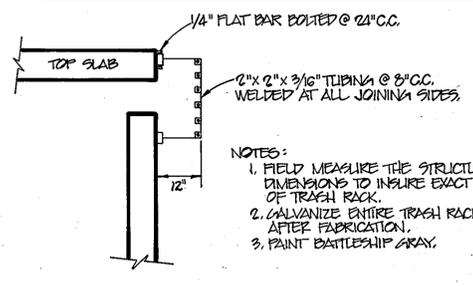


TRASH RACK DETAIL
NOT TO SCALE


- NOTES:**
1. FIELD MEASURE THE STRUCTURE DIMENSIONS TO INSURE EXACT FIT OF TRASH RACK.
 2. GALVANIZE ENTIRE TRASH RACK AFTER FABRICATION.
 3. PAINT BATTLESHIP GRAY.
- NOTES:**
1. CONCRETE SHALL BE MSHA MIX #3 (FC = 3,500 PSI)
 2. REINFORCING STEEL: GRADE 60
 3. FACE FORMS FOR WALLS OF OUTLET STRUCTURE SHALL UTILIZE L.M. SCOFFIELD CO. T-9085 FORM LINERS (RANDOM SPILT-PLACE ROCK), OPTIONAL
 4. PROVIDE ROUGH BROOM FINISH ON TOP OF SLAB
 5. ANCHOR BOLTS SHALL BE INSTALLED IN ACCORDANCE WITH SECTION G.07.03.09 OF THE MSHA STANDARDS AND SPECIFICATIONS
 6. ALL EXPOSED METAL SURFACES SHALL BE PAINTED IN ACCORDANCE WITH SECTION G.07.03.09 OF THE MSHA STANDARDS AND SPECIFICATIONS UNLESS SHOWN OTHERWISE
 7. ALL REINFORCING SPLICES SHALL BE LAP SPLICES OF 30 BAR DIAMETERS
 8. ALL FILTER FABRIC SHALL BE POLY-FILTER 'X' OR EQUIVALENT
 9. ALL EXPOSED EDGES OF CONCRETE TO BE CHAMFERED 1/2" X 1/2"

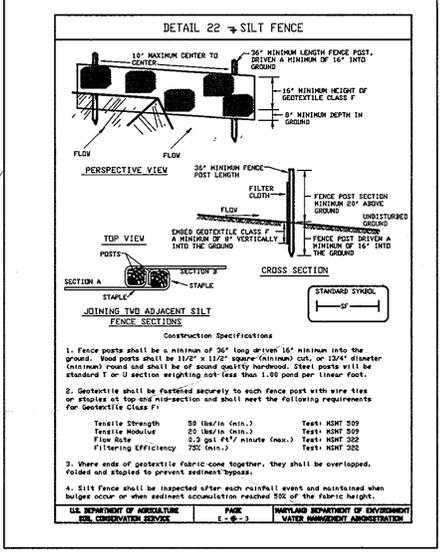


DETAIL 22 - SILT FENCE

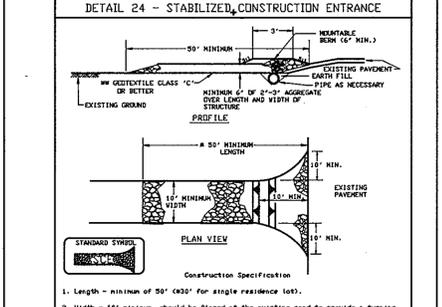


DETAIL 24 - STABILIZED CONSTRUCTION ENTRANCE

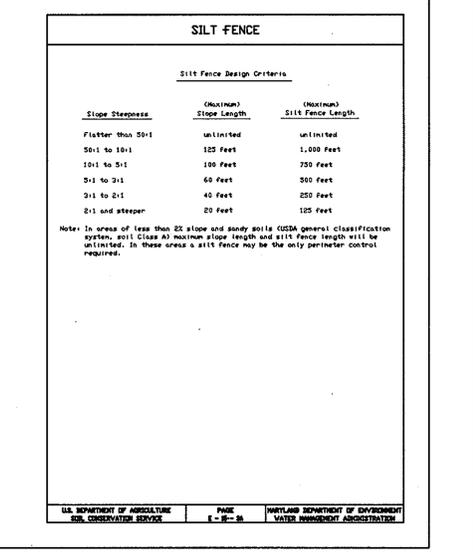

SILT FENCE

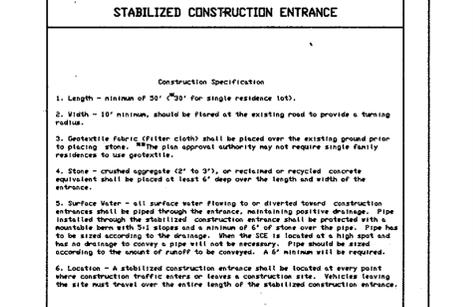

STABILIZED CONSTRUCTION ENTRANCE

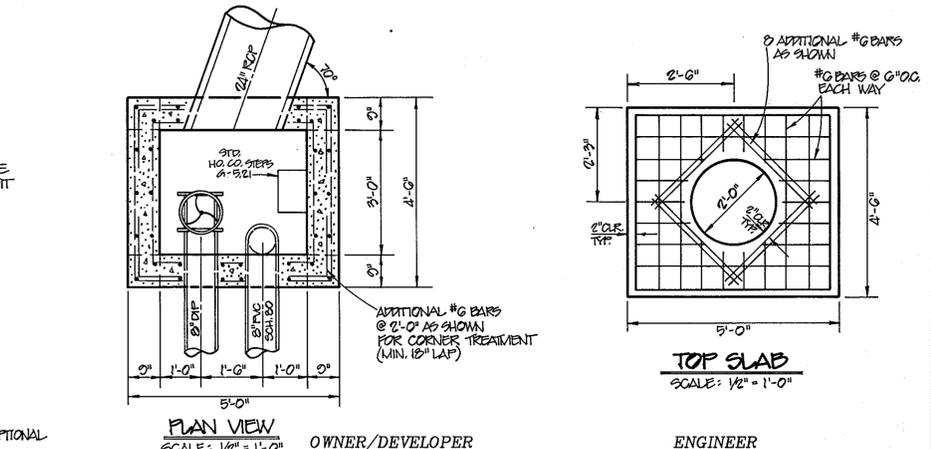

TOP SLAB
SCALE: 1/2" = 1'-0"

OWNER/DEVELOPER: MANGIONE ENTERPRISES OF TURF VALLEY, 1205 York Road, Penthouse, Lutherville, Maryland 21093, (410)825-8400, Attn: Mr. Louis Mangione

ENGINEER: R.M. MOCHI GROUP, P.C., 3300 North Ridge Road, Suite 235, Ellicott City, Maryland 21043, (410)461-0079, Attn: Mr. Robert M. Mochi, P.E.

Project	95002.00	Date	6/5/95
Illustration	Engineering	Scale	AS NOTED
Author	MWZ/BLP	Check	AMV
Design	AMV	Approval	RAM

APPROVED FOR SUBMITTAL TO HOWARD COUNTY DEPARTMENT OF PLANNING AND ZONING

TURF VALLEY REGIONAL SWM POND
ELECTION DISTRICT No. 2
HOWARD COUNTY, MARYLAND
SEDIMENT CONTROL NOTES & DETAILS

R.M. MOCHI GROUP, P.C.
1205 York Road, Penthouse
Lutherville, Maryland 21093
Tel: (410) 825-8400
Fax: (410) 720-6340