



Contour Interval 2 feet  
 Existing Contour: ---  
 Proposed Contour: ---  
 Direction of Drainage  
 Existing Storm Drain Ex. S.D.  
 Proposed Storm Drain Prop. S.D.  
 Limit of Disturbance

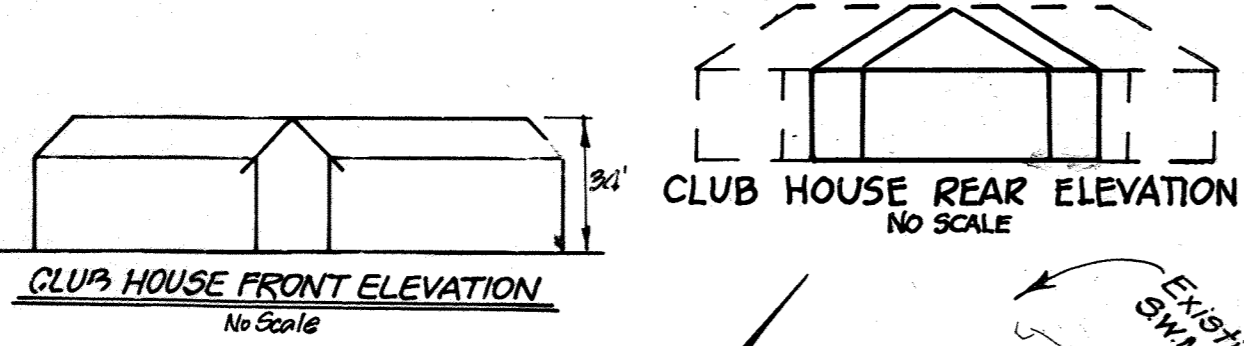

DRAWING INDEX	
SHEET 5	EXISTING CONDITIONS, DEMOLITION PLAN & PRIVATE SEWER PROFILES
SHEET 6	GRADING, EROSION AND SEDIMENT CONTROL PLAN
SHEET 7	SEPTIC PLAN
SHEET 8	SEPTIC PLAN DETAILS
SHEET 9	SEPTIC PLAN DETAILS
SHEET 10	SEPTIC PLAN DETAILS, RETAINING WALL PLAN, NOTES AND DETAILS

**SITE ANALYSIS:**

- A. TOTAL AREA OF PARCEL: 106.576 ACRES
- B. PRESENT ZONING: RC DEO
- C. USE OF STRUCTURE: Golf Course Clubhouse
- D. FLOOR SPACE: CLUBHOUSE - Ext. Bldg = 15,091 SF, BUILDING APPROXIMATE: 4,817 SF, OUTSIDE TERRACE AREA: 2,067 SF  
 POOL HOUSE 5,362 SF  
 HALFWAY HOUSE 300 SF  
 TOTAL: 21,978 SF
- E. MAXIMUM NUMBER OF EMPLOYEES: 37
- F. NUMBER OF PARKING SPACES: 196 (144 Golfers, 10 Swimming Pool, 20 Tennis Courts, 22 Clubhouse, 21,978 SF)  
 PROVIDED: 244 (including 12 H.C.)
- G. GREEN SPACE TO REMAIN ON SITE: 101.651 AC AND 95,040 SF NET AREA
- H. BUILDING COVERAGE OF SITE: 0.587 AC. AND 0.541% OF GROSS
- I. DISTURBED AREA: 3.8 ACRES

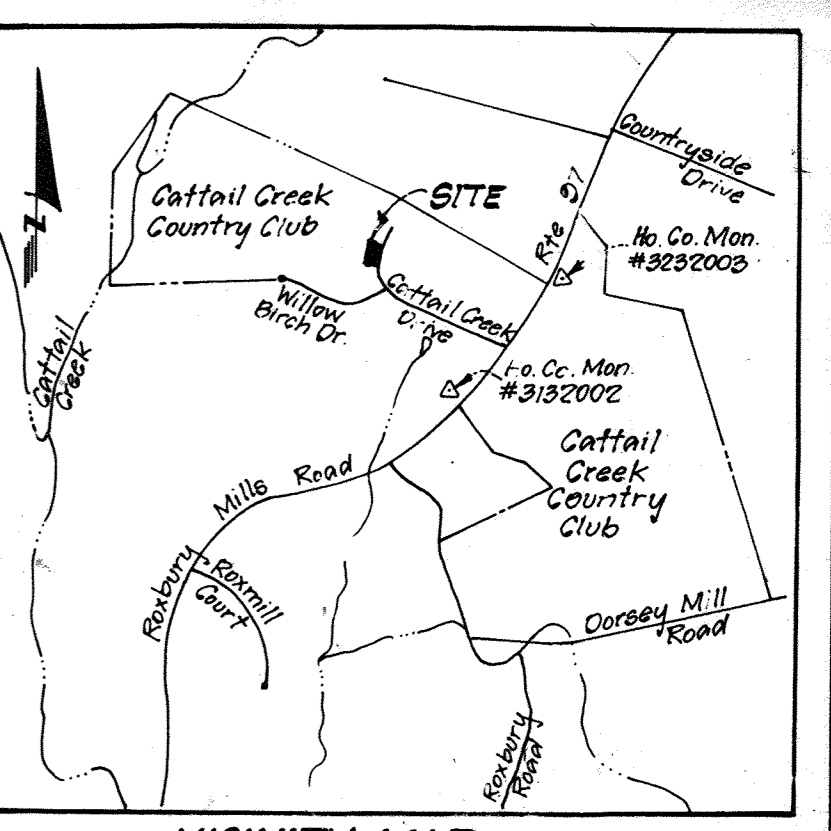





**WATER AND SEWER NOTES:**

1. All construction and materials for on-site private water and sewer systems shall follow the current edition of the Howard County Plumbing Code, supplemented by the Howard County Standard Details and Specifications where necessary.
2. 6-inch sewer house connection shall be built within 5 foot of building. PVC pipe shall meet the requirements of ASTM-D-3034, wall thickness classification SDR-35. Cleanouts to be provided every 75'.

**ON-SITE SEWAGE DISPOSAL PLANS**  
 CLUBHOUSE & PROSHOP: SDP-96-15  
 POOL HOUSE AND RESTROOMS ON 17: SDP-93-43  
 MAINTENANCE SHOP: SDP93-20

**GENERAL NOTES:**

1. All construction shall be in accordance with the latest standards and specifications of Howard County plus MSHA standards and specifications.
2. The contractor shall notify the Department of Public Works/Bureau of Construction Inspection at (410) 792-7272 at least (5) working days prior to the start of work.
3. The contractor shall notify "MISS UTILITY" at (1-800) 257-7777 at least 48 hours prior to start of work.
4. Traffic control devices, markings and signing shall be in accordance with the latest edition of the Manual on Uniform Traffic Control Devices (MUTCD). All street and regulatory signs shall be in place prior to the placement of any asphalt.
5. All plan dimensions are to the top of curb unless otherwise noted.
6. Existing topography was compiled from field survey by Clark, Finetrock & Sackett, Inc. dated December 1994 & July 1995.
7. Coordinates are based on NAD 27 Maryland Coordinate System as projected by Howard County Geodetic Control Stations No. 3132002 and No. 323003.
8. All water and sewer service is to be private.
9. Flood plain information was provided per the record plat prepared by Fisher, Collins and Carter, Inc. (F-90-62).
10. Stormwater management is to be provided in the existing ponds on site, SDP 91-106 Extended Detention.
11. No clearing, grading or construction is permitted within the required wetland areas except as permitted by WPA permit # 91-WC-0382 MDE # 91-WG-0400, CENAB-OP-90-1963-5 AND WF-91-03 granted April 22, 1993.
12. Existing utilities were compiled from available records and field survey.
13. All wells and septic systems within 200' of the sewage disposal easement have been shown.
14. The lots shown herein comply with minimum ownership width and lot area as required by the Maryland State Department of the Environment.
15. This area designates a private sewage easement as required by the Maryland State Department of the Environment for individual sewage. Improvements of any nature in this area are restricted until public sewer is available. These easements shall become null and void upon connection to a public sewer system. The county health officer shall have the authority to grant variances for encroachments into the private sewage easement. Recordation of a modified sewage easement plat shall not be necessary. See 4-22-91.
16. Subject property Zoned RC DEO per 10/29 Comprehensive Zoning Plan.
17. A water meter shall be installed on an incoming line in an accessible location for all buildings.
18. Any damage to county or state owned right-of-ways are to be repaired at the contractor's expense.
19. All exterior lighting fixtures shall be directed/reflected away from public roads.
20. See DPZ Files SDP-91-106, SDP-93-20, S-89-95, F-90-62 and BA-90-02, SDP 93-43, W.P. - 91-03, SDP-96-015
21. BA-90-02 decision and order was granted on October 6th, 1992.
22. Trench excavation over 4 feet in depth to comply with MOSHA.
23. Parking lots constructed and approved under SDP 93-43.
24. Existing temporary Clubhouse, Office & Pro Shop to be removed when the Clubhouse is built.
25. WF-91-03 granted 4-22-91 allowing fill wetlands.
26. UNDER REDLINE REVISION 8, THE 3,826 SF INCREASE IN IMPERVIOUS AREA IS EXEMPT FROM PROVIDING STORMWATER MANAGEMENT. ANY ADDITIONAL CHANGES WHERE THE CUMULATIVE INCREASE IS OVER 5,000 SF SHALL REQUIRE THAT STORMWATER MANAGEMENT BE ADDRESSED.

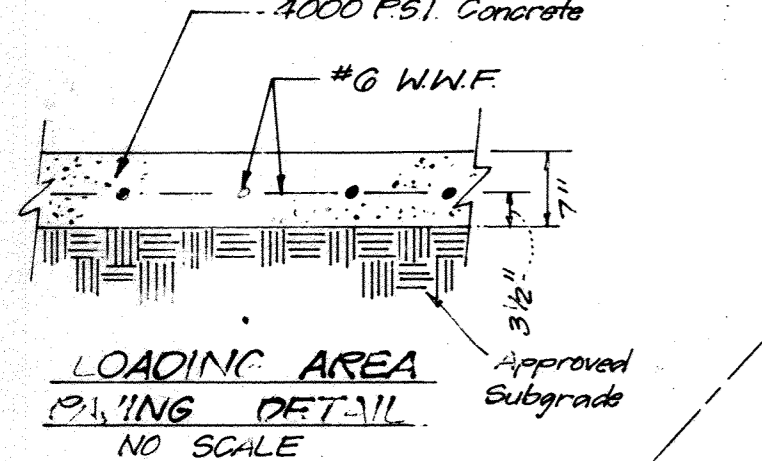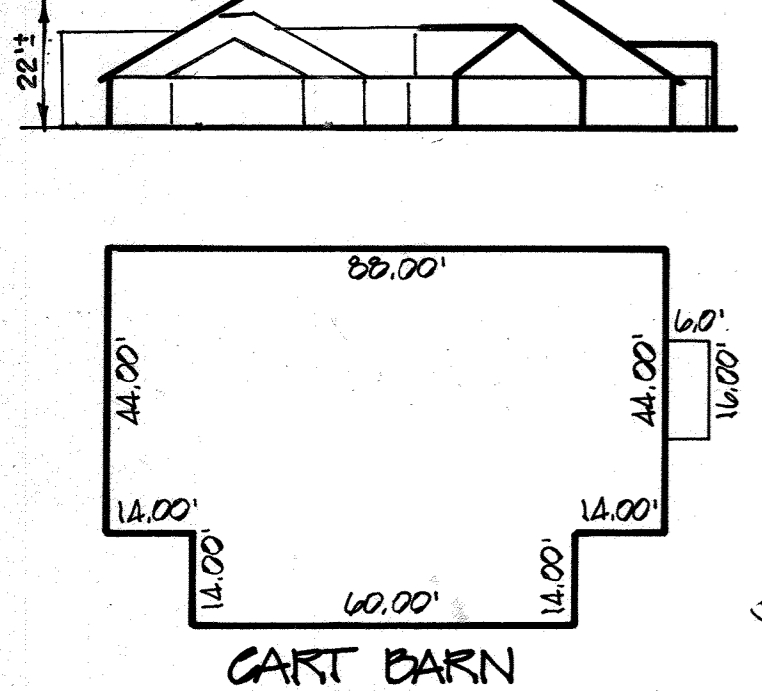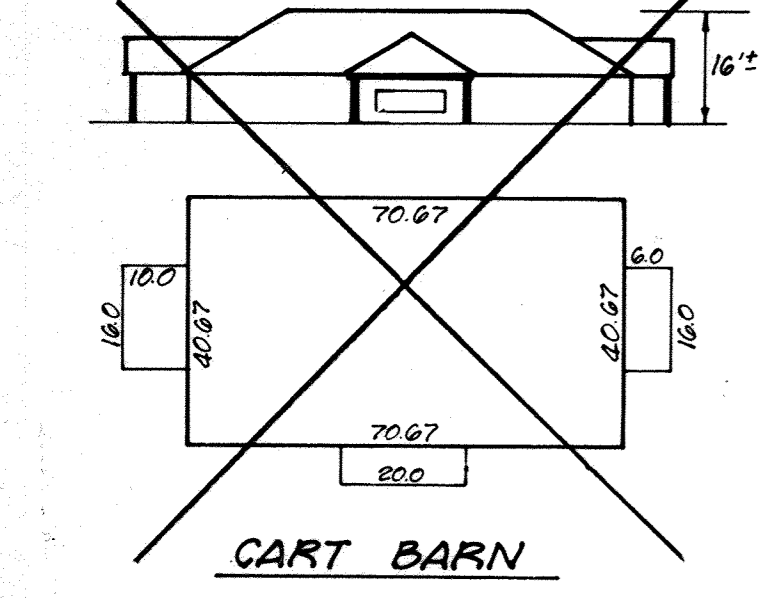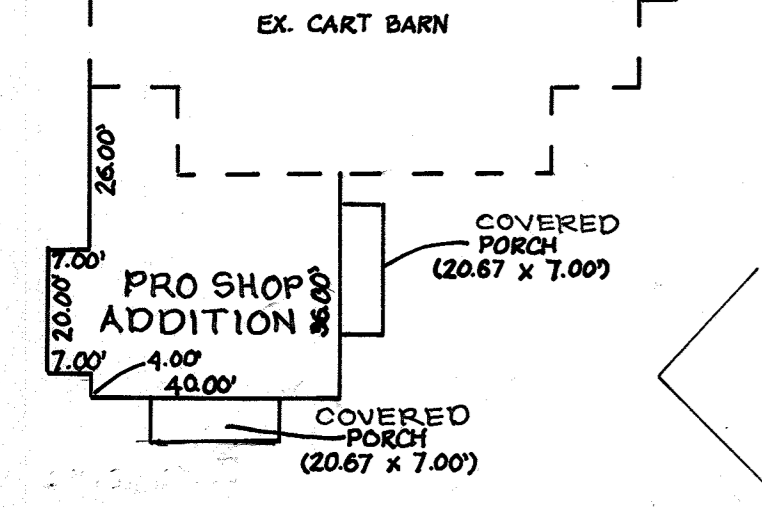

Note: Convert existing S.D. manhole M-3002 to yard inlet. Remove existing manhole cover and replace with Neenah Fournery Type "C" Grate R-2475 or approved equal. Top adjusted to Elev. 425.0

Note: Convert existing S.D. manhole M-3001 to yard inlet. Remove existing manhole cover and replace with Neenah Fournery Type "C" Grate R-2475 or approved equal. Top adjusted to elev. 482.7

Note: Remove Ex. 3" PVC as necessary and connect to Ex. 3" PVC WHC

Note: Remove Ex. 1/2" PVC as necessary and connect to Ex. 1/2" WHC

APPROVED HOWARD COUNTY HEALTH DEPARTMENT FOR ON-SITE WATER & PRIVATE SEWERAGE SYSTEMS.  
 JAMES M. BONDURSKI, HEALTH OFFICER, 10/3/95  
 APPROVED: DEPARTMENT OF PLANNING AND ZONING  
 MK, Chief, Development Engineering Division, 9/25/95  
 TC, Chief, Division of Land Development and Research, 10/4/95  
 Director, 10/3/95

Professional Engineer seals for James M. Bondurski, Robert J. Sackett, and others. Includes revision notes and dates.

NO.	REVISIONS	DATE
6	Rev. Pro Shop addition per new arch. plans by FCC	12-19-04
5	NEW CLUB HOUSE ADDITION, NEW PATIO AND PRO SHOP, NEW SERVICE AND CART PATHS BY FCC	8-27-04
4	REV. CART BARN, TOPO & PATH PER APPROVED 10/29-03	7-7-99
3	Rev. Plan to Add Cart Barn & grad.	1-29-97
2	Rev. loading dock, relocate Ref. Walls, Add Storm Drainage	7-8-96
1	Rev. Clubhouse per Architectural Revisions	12-12-95

DRAWING INDEX (SEE WHAT SHEET FOR CONTINUATION)	
SHEET 1	SITE DEVELOPMENT PLAN
SHEET 2	SEPTIC FIELD, RESERVE AREA & DRAINAGE AREA MAP
SHEET 3	SEDIMENT & EROSION CONTROL PLAN
SHEET 4	STORM DRAIN PROFILES & DETAILS


ADDRESS CHART			
Lot / Parcel	Street Address	Section / Area	Lots / Parcels
Parcel B	3600 Cattail Creek Drive	2	Parcel B
Subdivision Name	Cattail Creek Country Club		
Plot No.	11047 11052	Block No. 8	Zone RC DEO
Water Code	Private Water	Tax Map No. 21	Election District 4th
			Census Tract 6040

CLARK • FINETROCK & SACKETT, INC.  
 ENGINEERS • PLANNERS • SURVEYORS  
 7135 MINSTREL WAY • COLUMBIA MD 21045 • (410) 381-7500 • BALTO. • (301) 621-8100 • WASH.  
 DESIGNED: JLS (REVISED) SITE DEVELOPMENT PLAN CLUBHOUSE  
 DRAWN: ZAH  
 CHECKED: JLS  
 DATE: 7-28-95  
 SCALE: 1" = 30'  
 DRAWING: 1 of 10  
 JOB NO: 91-180  
 FILE NO: 94-180-X  
 SDP-96-15







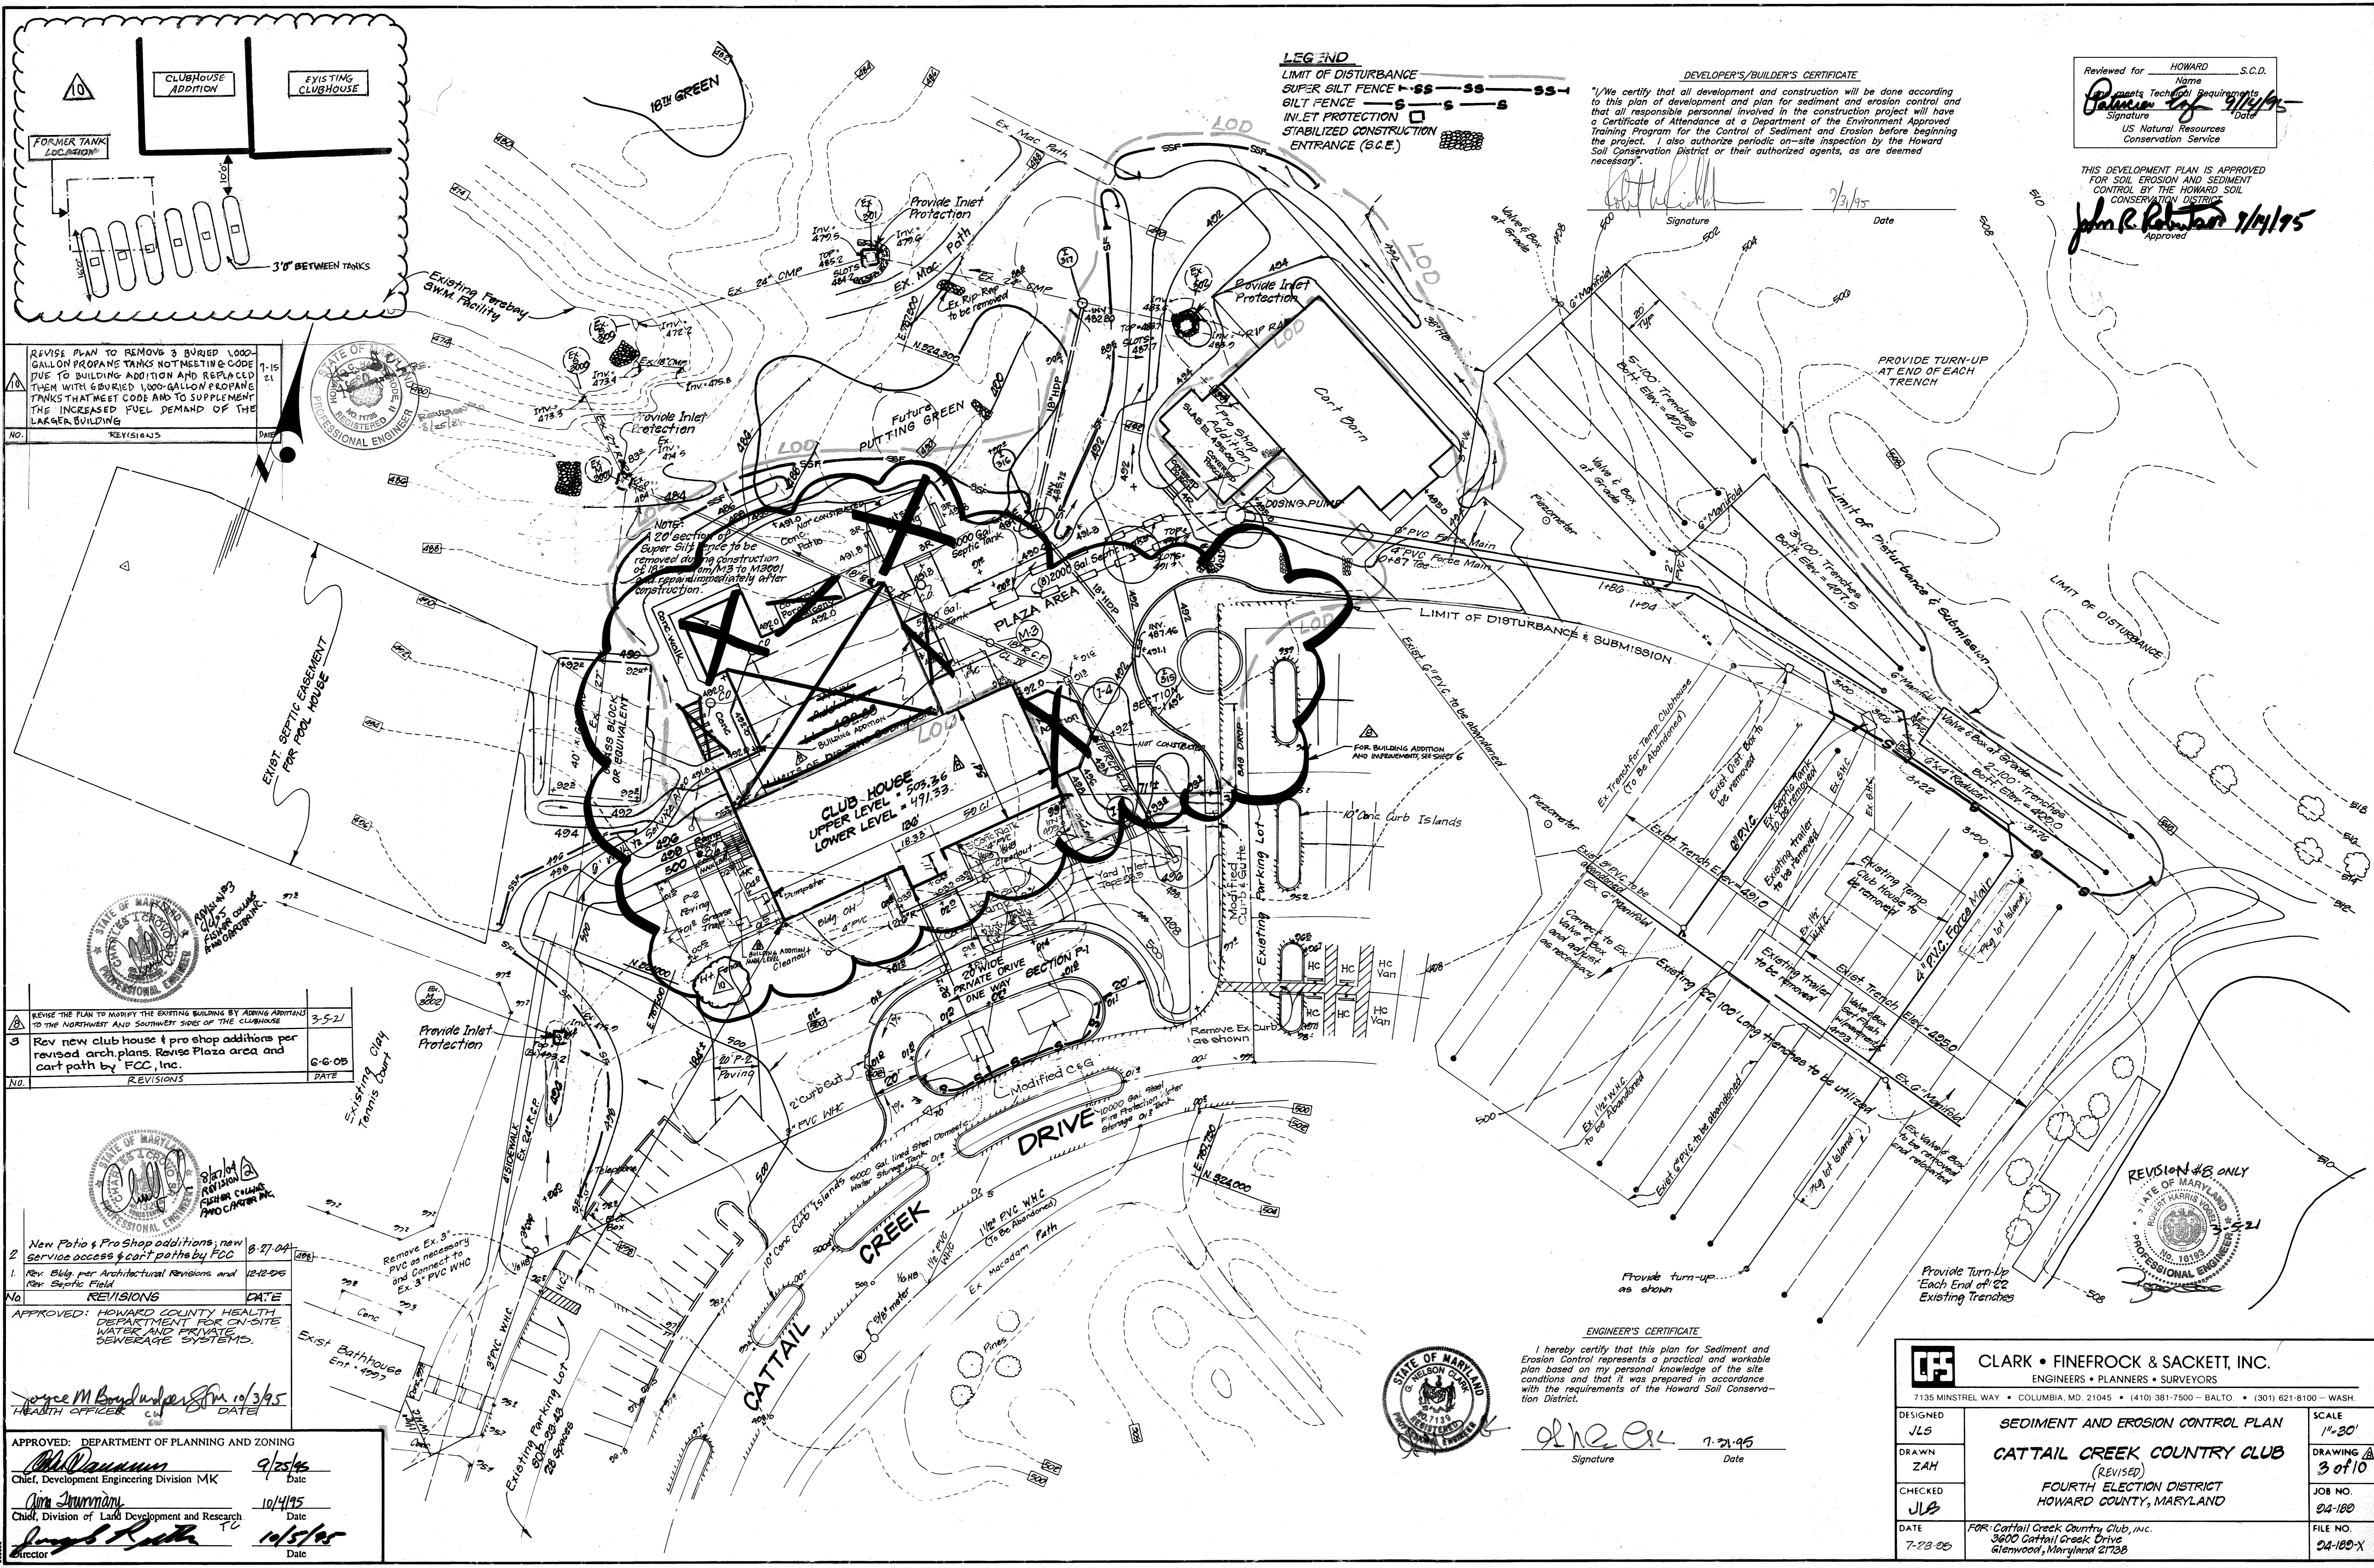

**LEGEND**  
 LIMIT OF DISTURBANCE ————  
 SUPER SILT FENCE ————  
 SILT FENCE ————  
 INLET PROTECTION □  
 STABILIZED CONSTRUCTION [hatched]  
 ENTRANCE (S.C.E.) [hatched]

**DEVELOPER'S/BUILDER'S CERTIFICATE**  
 I/We certify that all development and construction will be done according to this plan of development and plan for sediment and erosion control and that all responsible personnel involved in the construction project will have a Certificate of Attendance at a Department of the Environment Approved Training Program for the Control of Sediment and Erosion before beginning the project. I also authorize periodic on-site inspection by the Howard Soil Conservation District or their authorized agents, as are deemed necessary.

Reviewed for HOWARD S.C.D. Name: *James Technical Requirements* Date: *7/14/95*  
 Signature: *[Signature]*  
 US Natural Resources Conservation Service

THIS DEVELOPMENT PLAN IS APPROVED FOR SOIL EROSION AND SEDIMENT CONTROL BY THE HOWARD SOIL CONSERVATION DISTRICT  
*John R. Robertson* 7/14/95  
 Approved

REVISIONS  
 NO. REVISIONS DATE  
 1. REVISE PLAN TO REMOVE 3 BURIED 1000-GALLON PROPANE TANKS NOT MEETING CODE DUE TO BUILDING ADDITION AND REPLACED THEM WITH 6 BURIED 1000-GALLON PROPANE TANKS THAT MEET CODE AND TO SUPPLEMENT THE INCREASED FUEL DEMAND OF THE LARGER BUILDING  
 7-15  
 21  
 PROFESSIONAL ENGINEER

REVISIONS  
 NO. REVISIONS DATE  
 3. Rev new club house & pro shop additions per revised arch. plans. Revise Plaza area and cart path by FCC, Inc.  
 6-6-05  
 PROFESSIONAL ENGINEER

REVISIONS  
 NO. REVISIONS DATE  
 2. New Patio & Pro Shop additions; new Service access & cart paths by FCC  
 8-27-04  
 1. Rev. Eddy per Architectural Revisions and Rev. Septic Field  
 12-12-05  
 APPROVED: HOWARD COUNTY HEALTH DEPARTMENT FOR ON-SITE WATER AND PRIVATE SEWERAGE SYSTEMS.  
*Joyce M. Boyd* 10/3/95  
 HEALTH OFFICER DATE

APPROVED: DEPARTMENT OF PLANNING AND ZONING  
*[Signature]* 9/25/95  
 Chief, Development Engineering Division MK Date  
*[Signature]* 10/4/95  
 Chief, Division of Land Development and Research Date  
*[Signature]* 10/5/95  
 Director Date



**ENGINEER'S CERTIFICATE**  
 I hereby certify that this plan for Sediment and Erosion Control represents a practical and workable plan based on my personal knowledge of the site conditions and that it was prepared in accordance with the requirements of the Howard Soil Conservation District.  
*[Signature]* 7-21-95  
 Signature Date

**CLARK • FINEFROCK & SACKETT, INC.**  
 ENGINEERS • PLANNERS • SURVEYORS  
 7135 MINTREL WAY • COLUMBIA, MD. 21045 • (410) 381-7500 - BALTO. • (301) 621-8100 - WASH.

DESIGNED JLS	<b>SEDIMENT AND EROSION CONTROL PLAN</b> <b>CATTAIL CREEK COUNTRY CLUB</b> (REVISED) FOURTH ELECTION DISTRICT HOWARD COUNTY, MARYLAND	SCALE 1"=30'
DRAWN ZAH		DRAWING 3 of 10
CHECKED JLB		JOB NO. 04-180
DATE 7-23-95		FILE NO. 04-180-X

FOR: Cattail Creek Country Club, Inc.  
 3600 Cattail Creek Drive  
 Glenwood, Maryland 21728



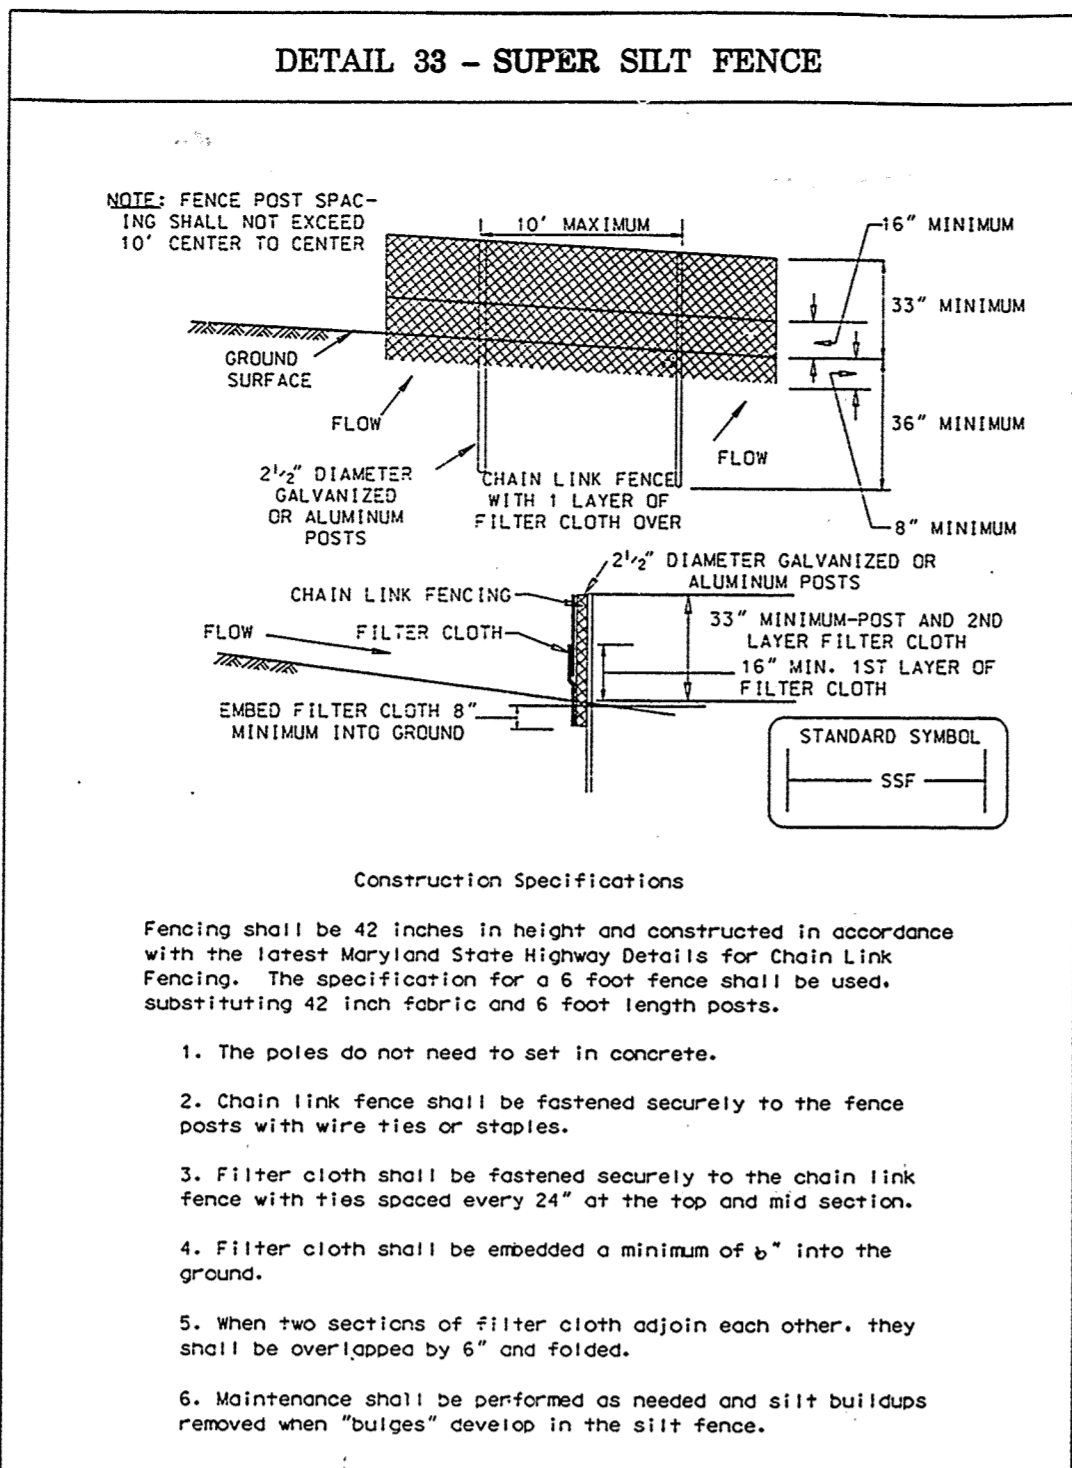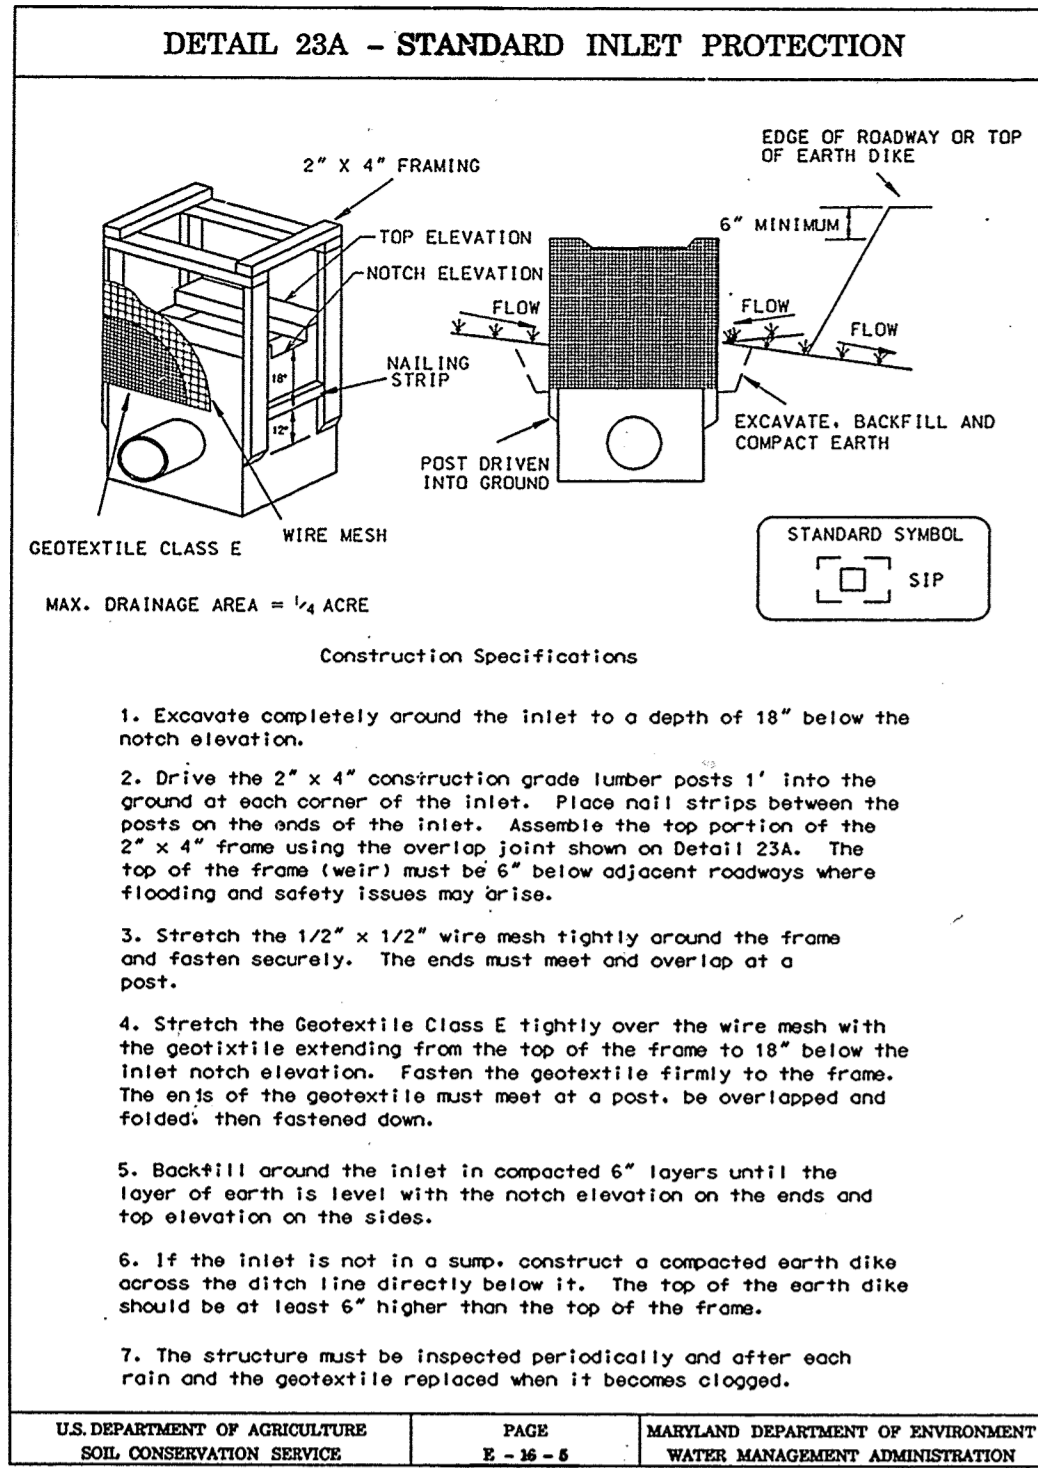

### SEDIMENT AND EROSION CONTROL NOTES

- A minimum of 48 hours notice must be given to the Howard County Office of Inspection and Permits prior to the start of any construction. (992-2437).
- All vegetation and structural practices are to be installed according to the provisions of this plan and are to be in conformance with the 2011 MARYLAND STANDARDS AND SPECS. FOR SOIL EROSION AND SEDIMENT CONTROL.
- Following initial soil disturbance or redistribution, permanent or temporary stabilization shall be completed within: a) 3 calendar days for all perimeter sediment control structures, dikes, perimeter slopes and all slopes greater than 3:1, b) 7 days as to all other disturbed or graded areas on the project site.
- All sediment traps/basins shown must be fenced and warning signs posted around their perimeters in accordance with Vol. 1, Chapter 12, of the HOWARD COUNTY DESIGN MANUAL, Storm Drainage.
- All disturbed areas must be stabilized within the time period specified above in accordance with the 2011 MARYLAND STANDARDS AND SPECIFICATIONS FOR SOIL EROSION AND SEDIMENT CONTROL for permanent seedings (Sec.51) and temporary seedings (Sec.52) and mulching (Sec.53). Temporary stabilization with mulch alone can only be done when recommended seeding dates do not allow for proper germination and establishment of grasses.
- All sediment control structures are to remain in place and are to be maintained in operative condition until permission for their removal has been obtained from the Howard County Sediment Control Inspector.
- SITE ANALYSIS:**

Total Area of Site:	106,978.64
Area to be roofed or paved:	33.42
Area to be vegetatively stabilized:	0.76
Total Cut:	3,026.62
Total Fill:	4,000.00
- On-site Waste/Borrow Area Location:
 

Area:	0.76
Volume:	3,026.62
- Any sediment control practice which is disturbed by grading activity for placement of utilities must be repaired on the same day of disturbance.
- Additional sediment control must be provided, if deemed necessary by the Howard County DPW Sediment Control Inspector.
- On all sites with disturbed areas in excess of 2 acres, approval of the inspection agency shall be requested upon completion of installation of perimeter erosion and sediment controls, but before proceeding with any other earth disturbance or grading. Other building or grading inspection approvals may not be authorized until this initial approval by the inspection agency is made.
- If houses are to be constructed on an "as sold" basis, at random, Single Family Sediment Control, as shown below shall be implemented.
- All pipes to be blocked at the end of each day (see detail this sheet).
- The total amount of silt fence = 655 LF SF + 216 LF SF

\* It is the responsibility of the contractor to identify the spoil/borrow site and notify and gain approval from the sediment control inspector of the site and it's grading permit number at the time of construction.

### PERMANENT SEEDING NOTES

APPLY TO GRADED OR CLEARED AREAS NOT SUBJECT TO IMMEDIATE FURTHER DISTURBANCE WHERE A PERMANENT LONG-LIVED VEGETATIVE COVER IS NEEDED.




**SEEDBED PREPARATION:** Loosen upper three inches of soil by raking, discing or other acceptable means before seeding, if not previously loosened.

**SOIL AMENDMENTS:** In lieu of soil test recommendations, use one of the following schedules:  
 1) Preferred - Apply 2 tons per acre dolomitic limestone (92 lbs/1000 sq ft) and 600 lbs per acre 10-10-10 fertilizer (14 lbs./1000 sq ft) before seeding. Harrow or disc into upper three inches of soil. At the time of seeding, apply 400 lbs. per acre 30-0-0 ureaform fertilizer (9 lbs./1000 sq ft.)  
 2) Acceptable - Apply 2 tons per acre dolomitic limestone (92 lbs./1000 sq ft.) and 1000 lbs. per acre 10-10-10 fertilizer (23 lbs./1000 sq ft.) before seeding. Harrow or disc into upper three inches of soil.

**SEEDING:** For the periods March 1 thru April 30, and August 1 thru October 15, seed with 5000 lbs per acre (1.4 lbs./1000 sq ft) of Kentucky 31 Tall Fescue. For the period May 1 thru July 31, seed with 60 lbs. Kentucky 31 Tall Fescue per acre and 2 lbs per acre (.05 lbs./1000 sq ft) of weeping lovegrass. During the period of October 16 thru February 28, protect site by: Option (1) 2 tons per acre well anchored straw mulch and seed as soon as possible in the spring. Option (2) Use sod. Option (3) Seed with 60 lbs./acre Kentucky 31 Tall Fescue and mulch with 2 tons/acre well anchored straw.

**MULCHING:** Apply 1 1/2 to 2 tons per acre (70 to 90 lbs./1000 sq ft) of unrattled small grain straw immediately after seeding. Anchor mulch immediately after application using mulch anchoring tool or 218 gallons per acre (5 gal./1000 sq ft) of emulsified asphalt on flat areas. On slopes 8 feet or higher, use 348 gallons per acre (8 gal./1000 sq ft) for anchoring.

**MAINTENANCE:** Inspect all seeded areas and make needed repairs, replacements and reseedings.

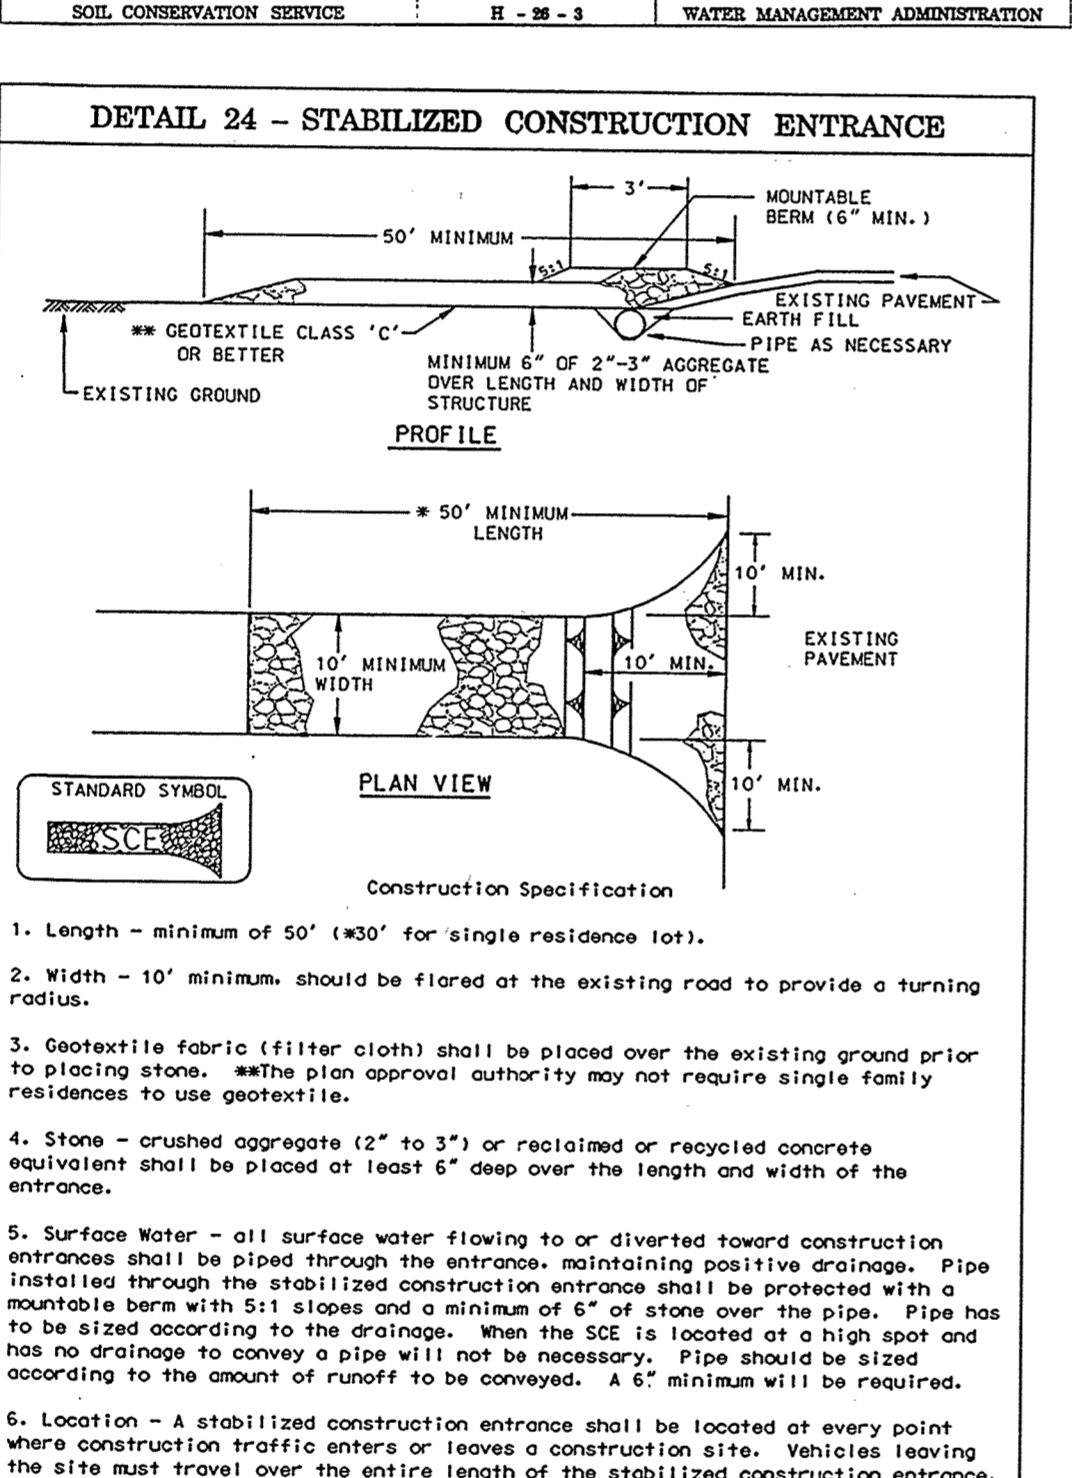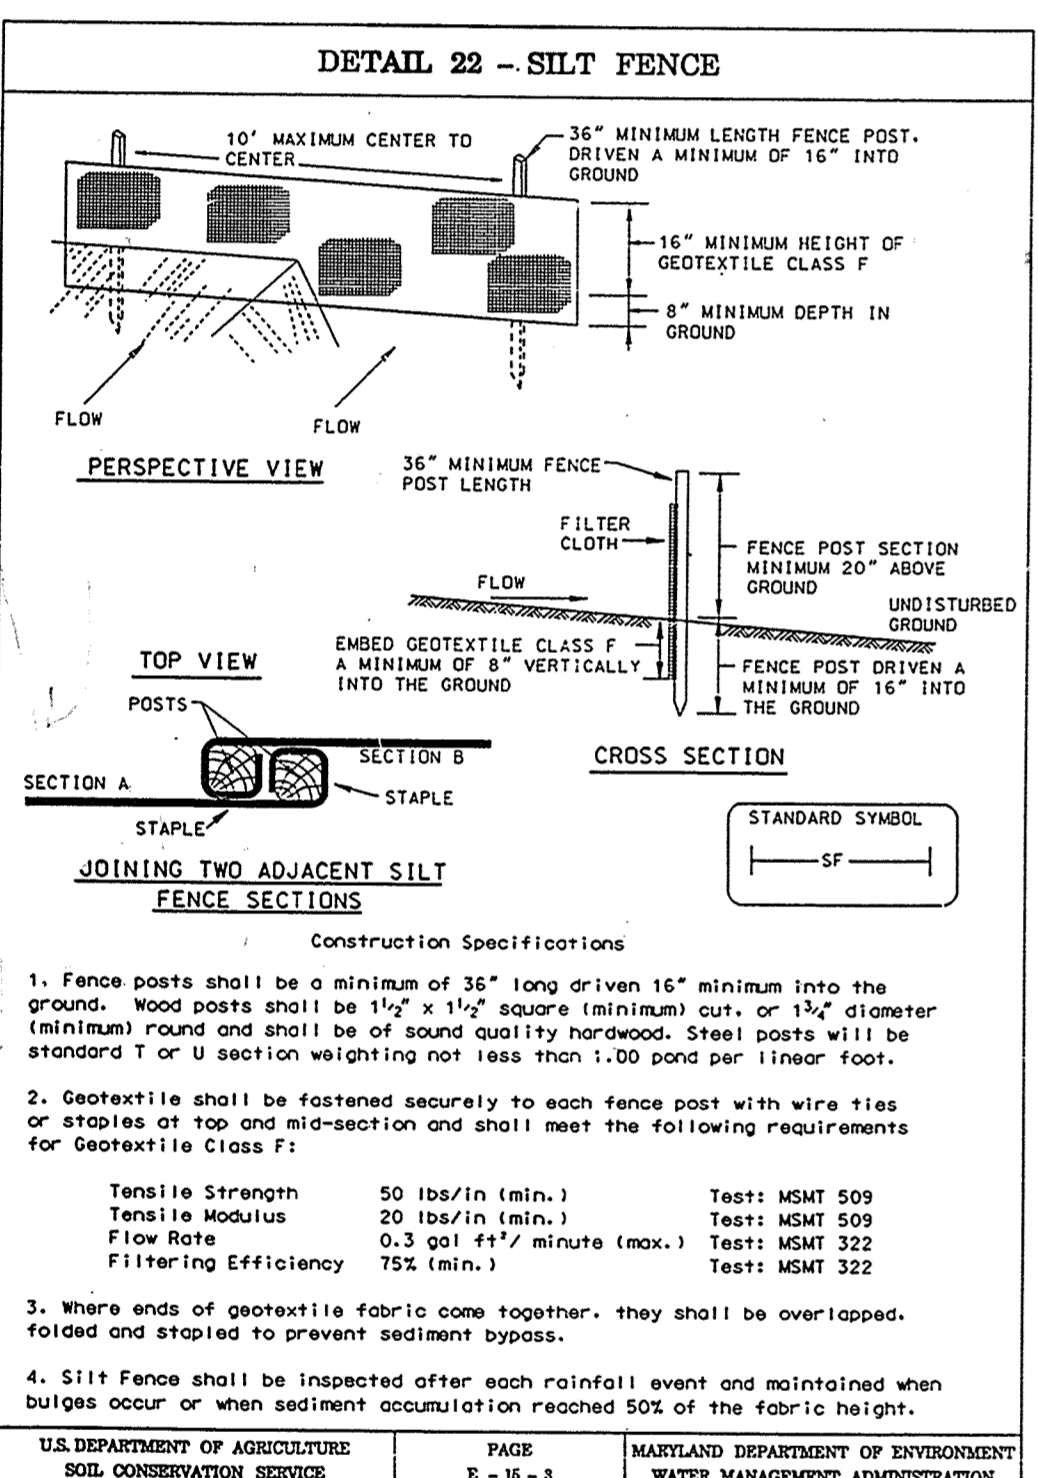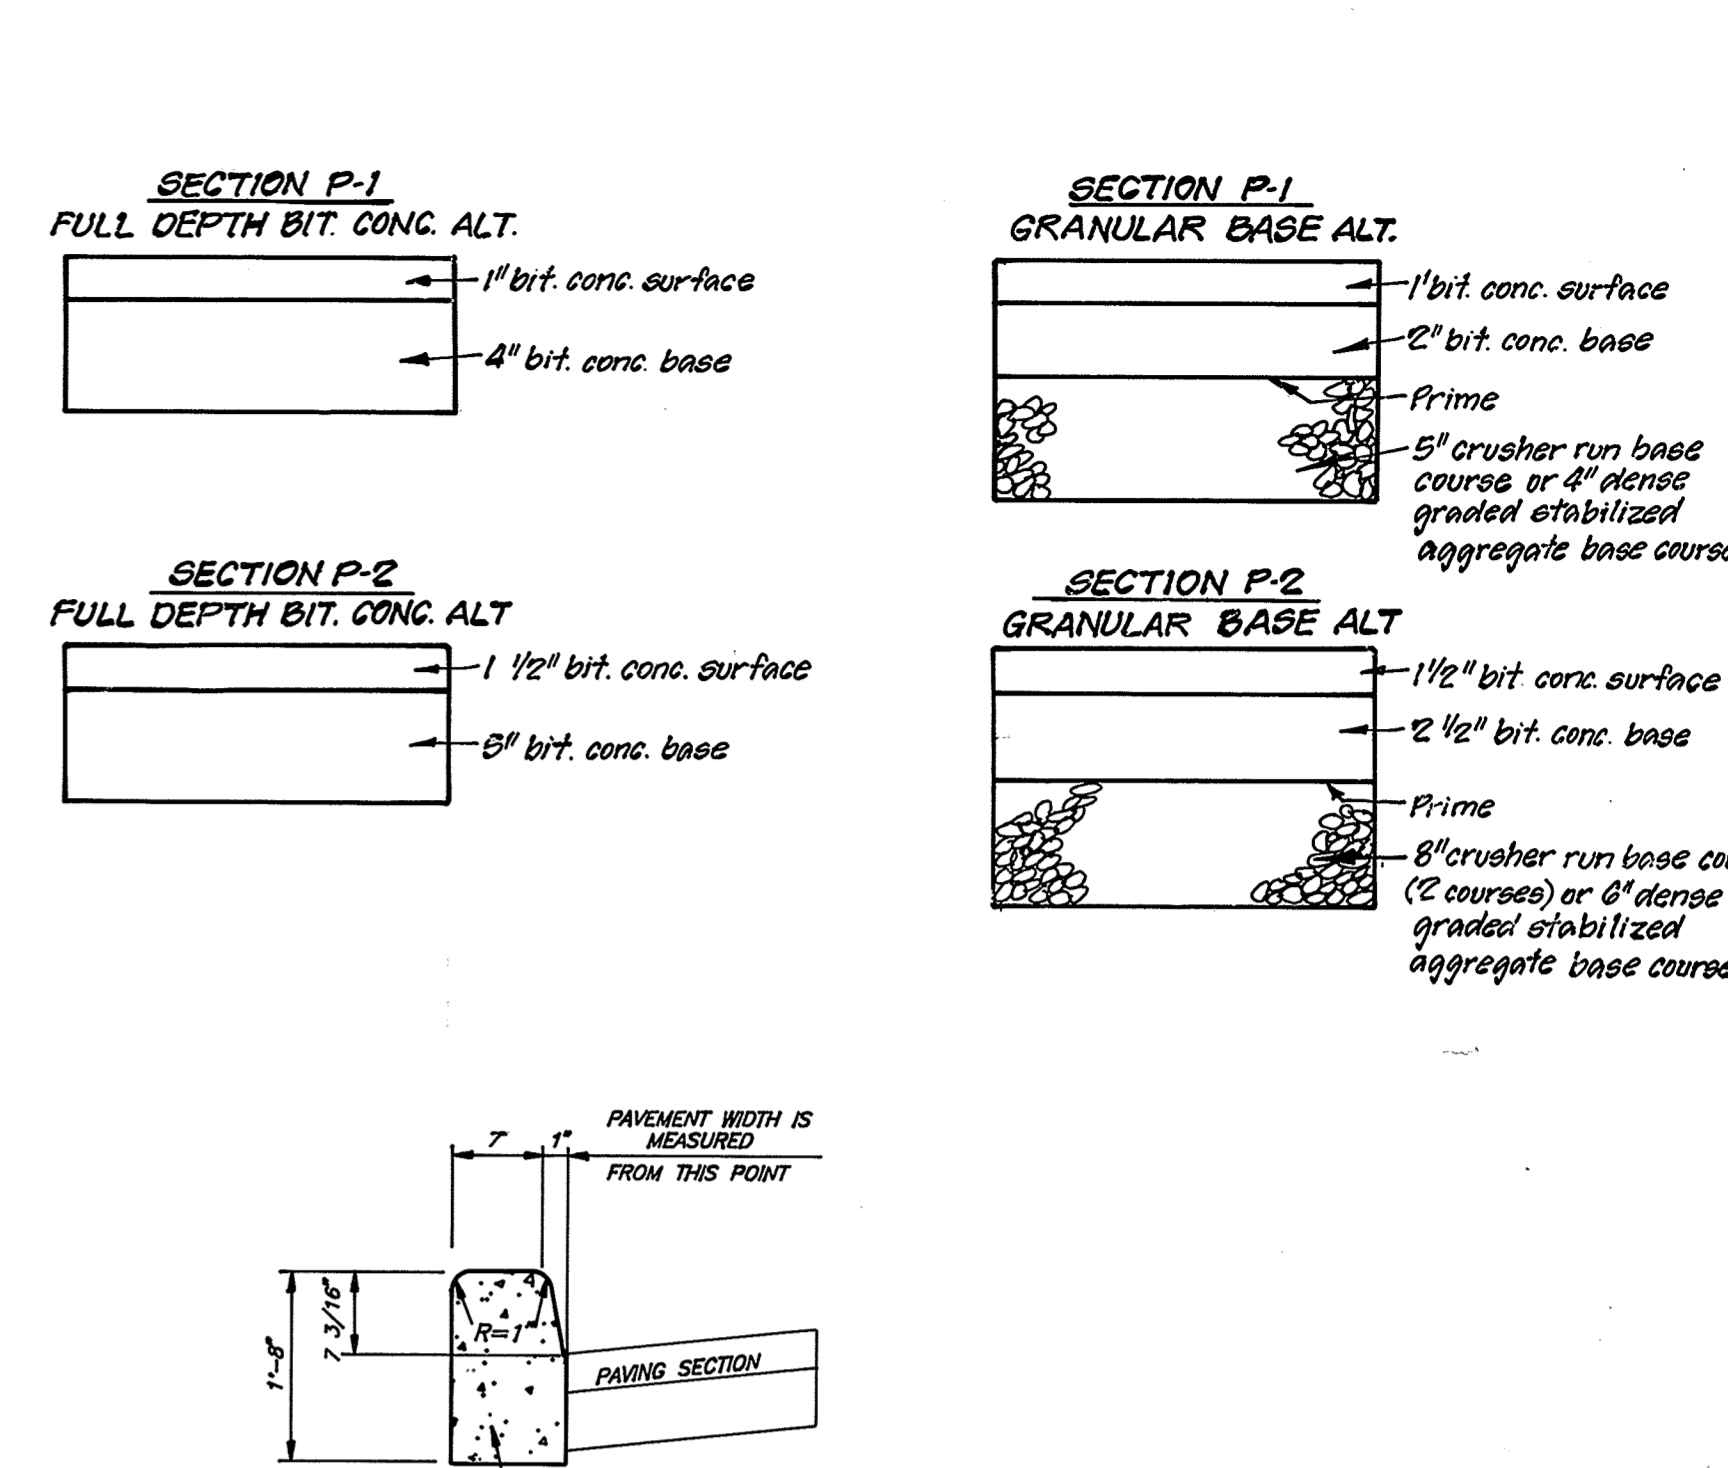

### STRUCTURE SCHEDULE

No	TYPE	INVERT	TOP ELEVATION		REMARKS	LOCATION
			IN	OUT		
I-5	5" Inlet	2'-7 1/2" sq	400.60	400.5	Top Elev: 404.7-405.5	Ho Co SHD SD A22 See Plan
I-4	5" Inlet	2'-7 1/2" sq	487.00	486.75	Top Elev: 491.0-490.8	Ho Co SHD SD A22 See Plan
M-3	Shallow Precast Manhole	4'-0" dia	486.75	483.62	491.0	Ho Co SHD G5 I2 See Plan
Ex-1	Existing Manhole		475.40	474.5	Top Elev: 482.1	See Plan
Ex-2	Inlet			400.25	Top Elev: 502.0	See Plan




### PIPE SCHEDULE

SIZE	TYPE	LENGTH
15"	R.C.P. CL II	91 LF
18"	R.C.P. CL II	211 LF
8"	P.V.C. SDR 35	369 LF

### CONSTRUCTION SEQUENCE:

NO. OF DAYS	
1. Obtain grading permit.	7
2. Install tree protection fence.	N/A
3. Install sediment and erosion control devices and stabilize.	30
4. Excavate for foundations, rough grade and temporarily stabilize.	30
5. Construct structures, sidewalks and driveways.	60
6. Final grade and stabilize in accordance with Stds. and Specs.	14
7. Upon approval of the sediment control inspector, remove sediment and erosion control devices and stabilize.	7

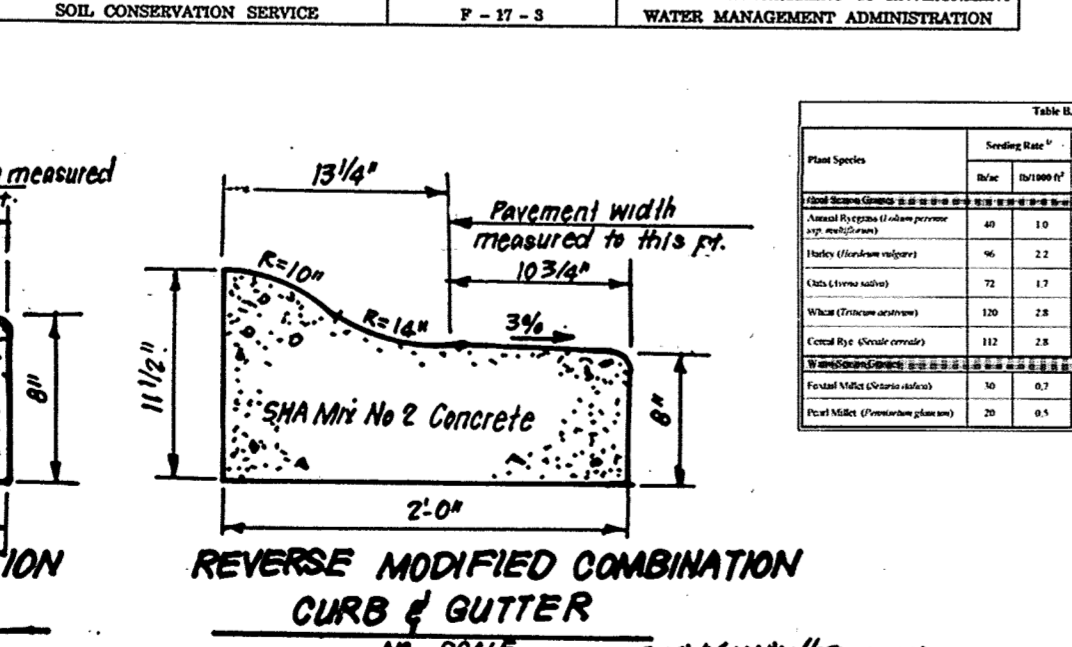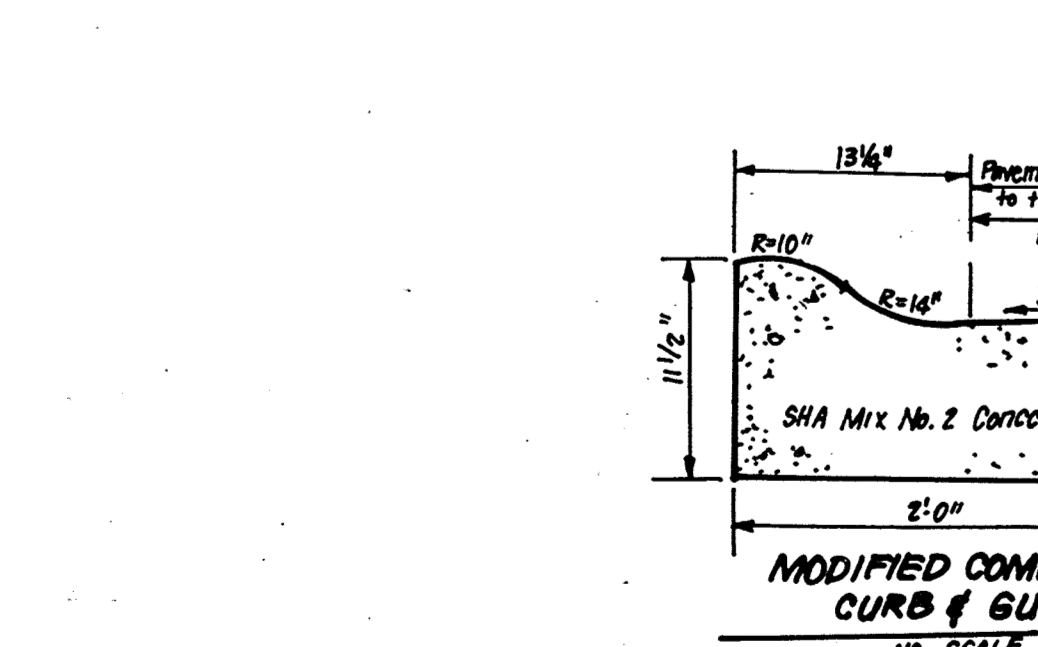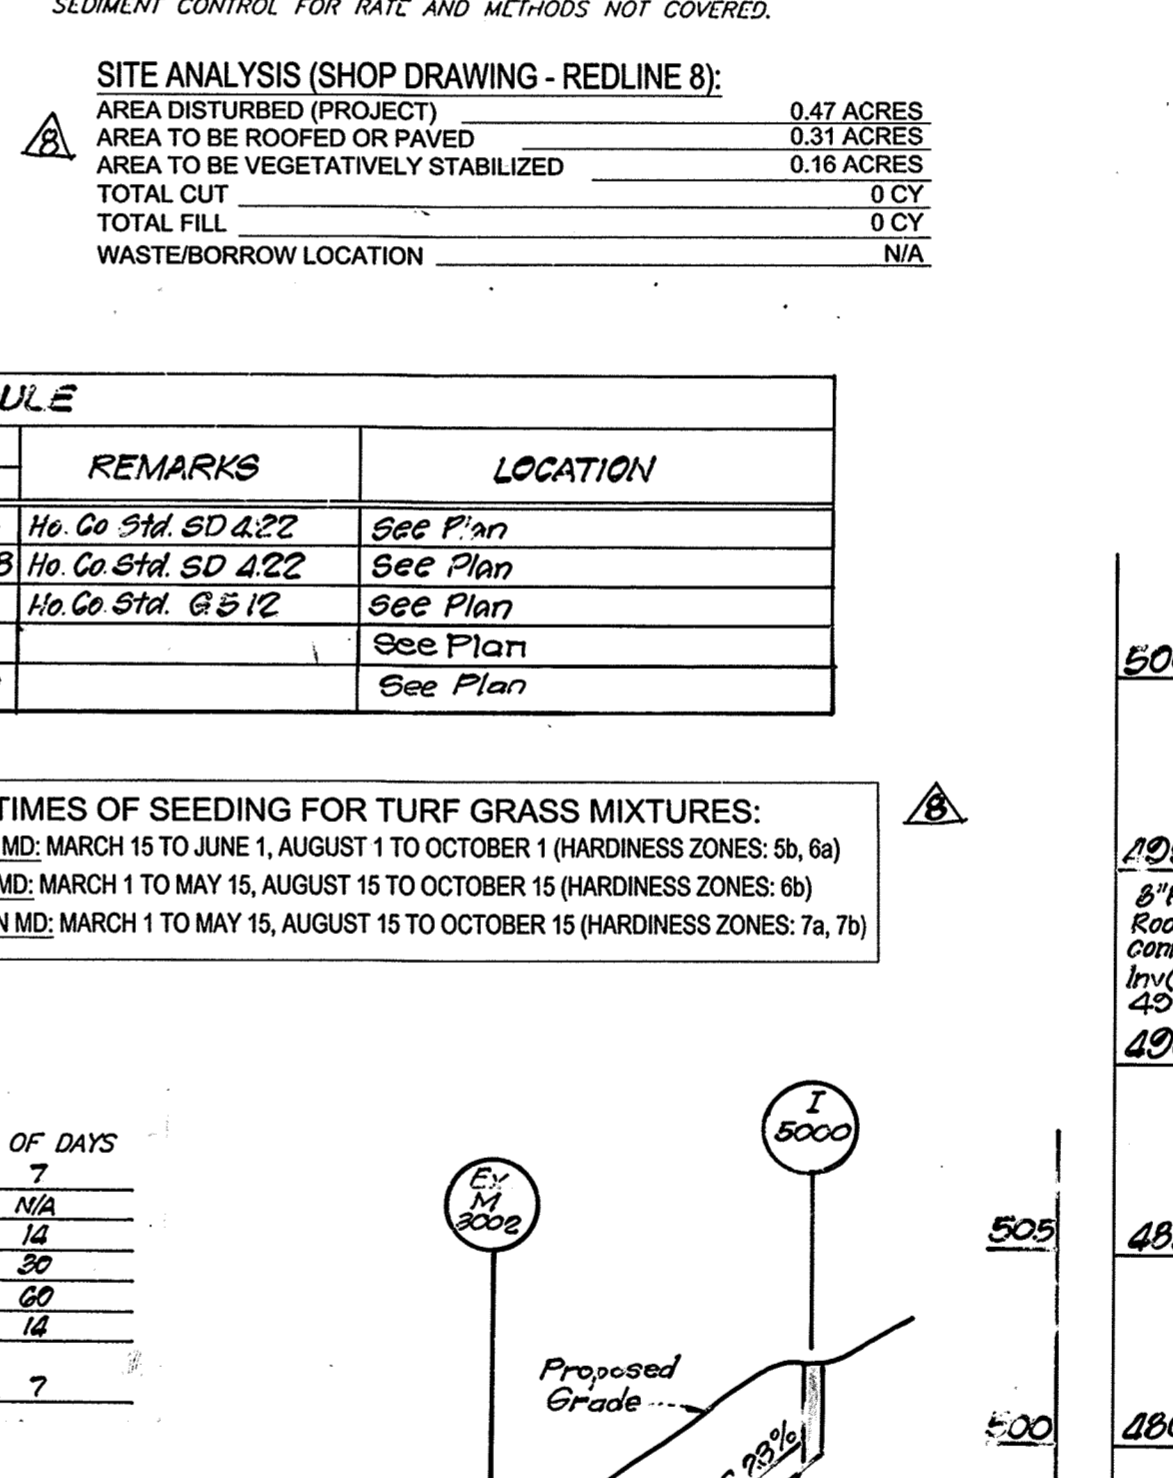

### REVISIONS

No.	REVISIONS	DATE
1	Rev. Add Storm Drain Profile, Add Fence Detail	7-8-96
2	Rev Storm Drain Profile For Rev. SDP	12-12-05
3	NEW PATIO ADDITION	7-27-04
4	NEW SERVICE ACCESS AND CART PATHS BY FCC	7-27-04

### DEVELOPER'S/BUILDER'S CERTIFICATE

I, Howard S.C.D., certify that all development and construction will be done according to this plan of development and plan for sediment and erosion control and that all responsible personnel involved in the construction project will have a Certificate of Attendance at a Department of the Environment Approved Training Program for the Control of Sediment and Erosion before beginning the project. I also authorize periodic on-site inspection by the Howard Soil Conservation District or their authorized agents, as are deemed necessary.

Signature: [Signature] Date: 7/31/95

### ENGINEER'S CERTIFICATE

I hereby certify that this plan for Sediment and Erosion Control represents a practical and workable plan based on my personal knowledge of the site conditions and that it was prepared in accordance with the requirements of the Howard Soil Conservation District.

Signature: [Signature] Date: 7-31-95

APPROVED: HOWARD COUNTY HEALTH DEPARTMENT FOR ON-SITE WATER & PRIVATE SEWERAGE SYSTEMS.  
[Signature] 10/3/95 DATE  
 Health Officer

APPROVED: DEPARTMENT OF PLANNING AND ZONING  
[Signature] 9/25/95 DATE  
 Chief, Development Engineering Division MK

[Signature] 10/14/95 DATE  
 Chief, Division of Land Development and Research

[Signature] 10/5/95 DATE  
 Director

REVISION #3 ONLY

STATE OF MARYLAND  
 REGISTERED PROFESSIONAL ENGINEER  
[Signature] 7/31/95  
 No. 18193

REVISIONS

No.	REVISIONS	DATE
1	Rev. Add Storm Drain Profile, Add Fence Detail	7-8-96
2	Rev Storm Drain Profile For Rev. SDP	12-12-05
3	NEW PATIO ADDITION	7-27-04
4	NEW SERVICE ACCESS AND CART PATHS BY FCC	7-27-04

Reviewed for HOWARD S.C.D. Name: Howard S.C.D.  
 and meets Technical Requirements  
[Signature] 9/14/95  
 Date: 9/14/95  
 US Natural Resources Conservation Service

THIS DEVELOPMENT PLAN IS APPROVED FOR SOIL EROSION AND SEDIMENT CONTROL BY THE HOWARD SOIL CONSERVATION DISTRICT.  
[Signature] 9/14/95  
 Approved

STATE OF MARYLAND  
 REGISTERED PROFESSIONAL ENGINEER  
[Signature] 7/31/95  
 No. 18193

CLARK • FINEFROCK & SACKETT, INC.  
 ENGINEERS • PLANNERS • SURVEYORS  
 7135 MINSTREL WAY • COLUMBIA, MD. 21045 • (410) 381-7500 - BALTO. • (301) 821-8100 - WASH.

DESIGNED: JLS  
 DRAWN: ZAH  
 CHECKED: JLS  
 DATE: 7-28-05

SCALE: As Shown  
 DRAWING: 4 of 10  
 JOB NO: 04-180  
 FILE NO: 04-180-X

STORM DRAIN PROFILE AND DETAIL SHEET  
 CATTAIL CREEK COUNTRY CLUB (REVISED)  
 FOURTH ELECTION DISTRICT  
 HOWARD COUNTY, MARYLAND

FOR: Cattail Creek Country Club, Inc.  
 3300 Cattail Creek Drive  
 Glenwood, Maryland 21738

SDP-96-15








- LEGEND:**
- 30' --- EXISTING CONTOUR
  - 40' --- PROPOSED CONTOUR
  - + 402.88 PROPOSED SPOT ELEVATION
  - + 402.88 EXISTING SPOT ELEVATION
  - ==== EXISTING CURB AND GUTTER
  - ==== PROPOSED CURB AND GUTTER
  - EXISTING UTILITY POLE
  - EXISTING LIGHT POLE
  - EXISTING SANITARY MANHOLE
  - EXISTING SANITARY LINE
  - EXISTING CLEANOUT
  - EXISTING FIRE HYDRANT
  - EXISTING WATER LINE
  - EXISTING TREES (FIELD LOCATED)
  - EXISTING TREELINE (FIELD LOCATED)
  - SOILS BOUNDARY
  - PROPOSED SIDEWALK
  - PROPOSED PAVERS


- SEQUENCE OF CONSTRUCTION**
1. OBTAIN HOWARD COUNTY GRADING PERMIT. (WEEK 1)
  2. NOTIFY HOWARD COUNTY AT LEAST 48 HOURS PRIOR TO START OF CONSTRUCTION. (WEEK 1)
  3. CONDUCT A PRE-CONSTRUCTION MEETING WITH THE SEDIMENT CONTROL INSPECTOR PRIOR TO ANY LAND DISTURBANCE. (WEEK 1)
  4. INSTALL STABILIZED CONSTRUCTION ENTRANCE WITH MOUNTABLE BERM. (WEEK 2)
  5. CLEARING AND GRUBBING AS NECESSARY FOR THE INSTALLATION OF PERIMETER CONTROLS. (2 DAYS)
  6. INSTALL ALL PERIMETER CONTROLS INCLUDING SILT FENCE, SUPER SILT FENCE AND EARTH DIKES, AS INDICATED ON PLANS. (WEEK 2)
  7. WITH APPROVAL OF SEDIMENT CONTROL INSPECTOR, CLEAR AND GRUB REMAINDER OF SITE. (WEEK 2)
  8. BEGIN BUILDING CONSTRUCTION. (3 MONTHS)
  9. WITH INSPECTOR'S APPROVAL, BEGIN INSTALLATION OF CURB AND GUTTER AND ON-SITE BASE COURSE PAVING. (2 WEEKS)
  10. COMPLETE BUILDING AND UTILITY CONSTRUCTION.
  11. COMPLETE ALL BASE COURSE PAVEMENT CONSTRUCTION. (1 WEEK)
  12. CONSTRUCT SURFACE COURSE PAVING AND PATHWAY. (1 WEEK)
  13. WITH THE INSPECTOR'S APPROVAL, FINE GRADE AND STABILIZE ALL AREAS OF PARCEL INCLUDING ANY EXPOSED EARTH AREAS OUTSIDE THE LOD. REMOVE ALL TRASH JUNK AND DEBRIS FROM ENTIRE PARCEL. (1 WEEK)
  14. INSTALL SITE LANDSCAPING. (WEEK 15)
  15. AFTER RECEIVING APPROVAL FROM THE SEDIMENT CONTROL INSPECTOR, STABILIZE ALL REMAINING DISTURBED AREAS.

**NOTE**  
1. PROPOSED BUILDING ADDITIONS TOTAL 4,847 SFT  
APPROVED AREA IS 6,715 SFT PER BA-19-019C.

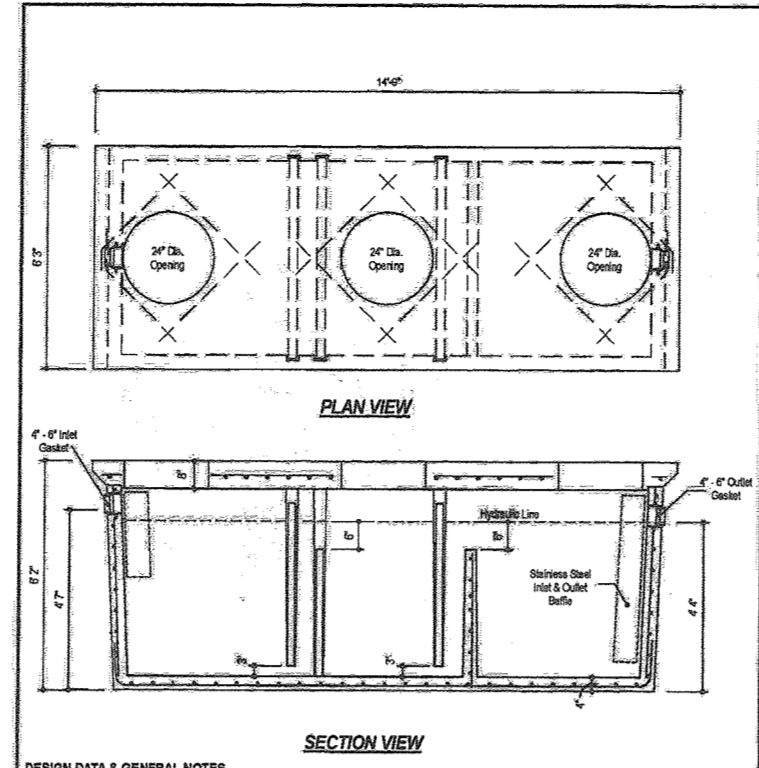


**USER SCHEDULE**

DESCRIPTION	ID	QD	H	I
24" Man Vault	24"	24"	30"	11.0"
24" P. Floor	24"	24"	12"	11.0"
24" P. Wall	24"	24"	30"	11.0"
30" x 12" Floor	30"	34"	12"	11.0"
30" x 12" Wall	30"	34"	30"	11.0"

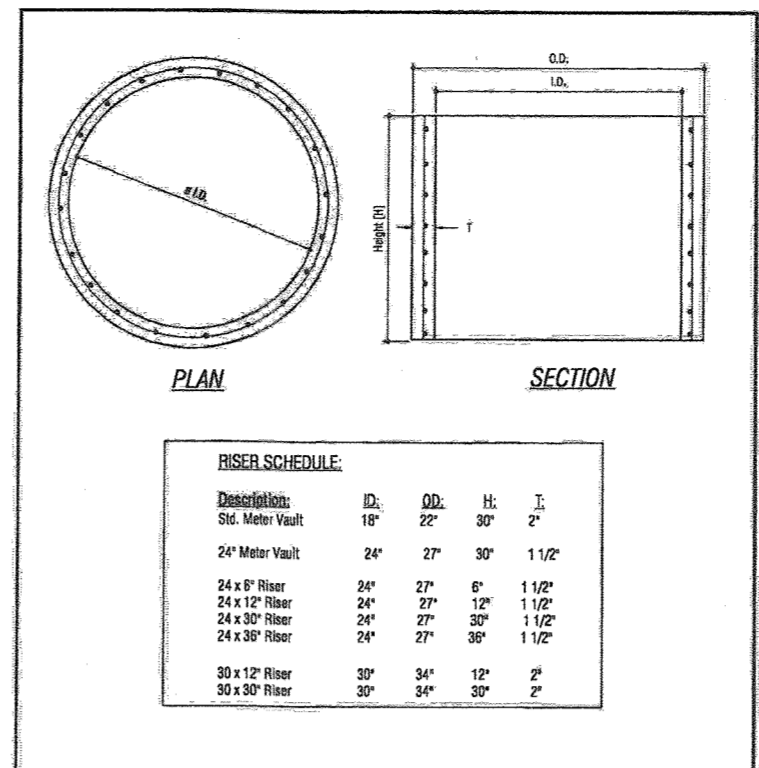




**GRADE ADJUSTMENT RINGS**

DESCRIPTION	QD	H	I
24" Man Vault	24"	24"	30"
24" P. Floor	24"	24"	12"
24" P. Wall	24"	24"	30"
30" x 12" Floor	30"	34"	12"
30" x 12" Wall	30"	34"	30"

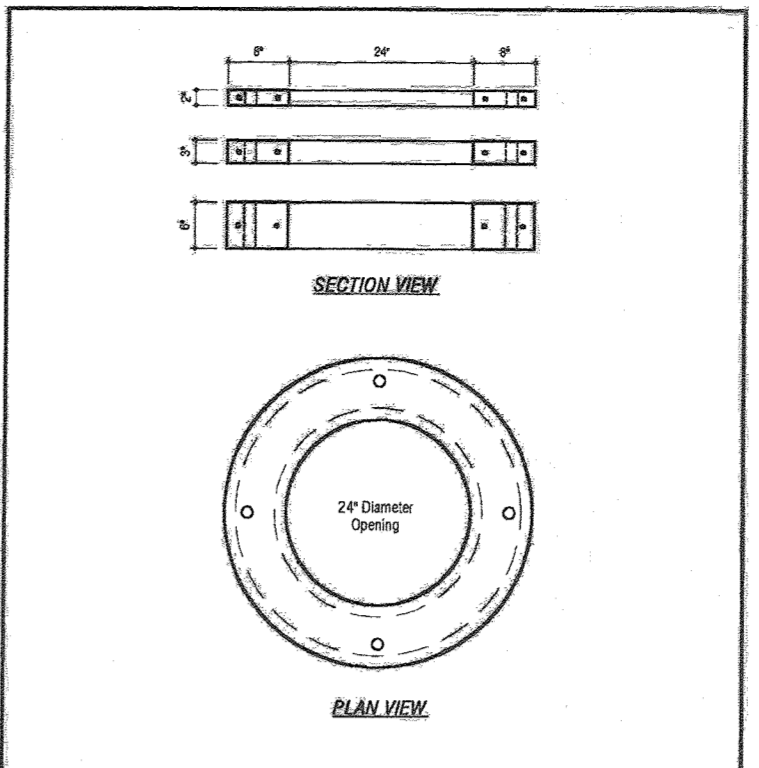


**GRADE ADJUSTMENT RINGS**

DESCRIPTION	QD	H	I
24" Man Vault	24"	24"	30"
24" P. Floor	24"	24"	12"
24" P. Wall	24"	24"	30"
30" x 12" Floor	30"	34"	12"
30" x 12" Wall	30"	34"	30"

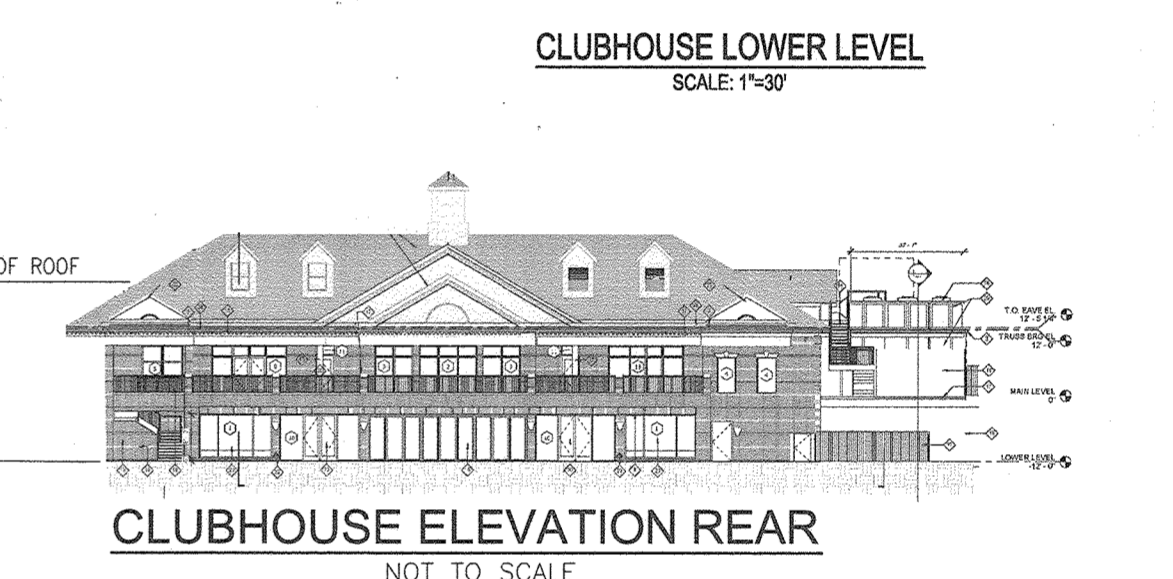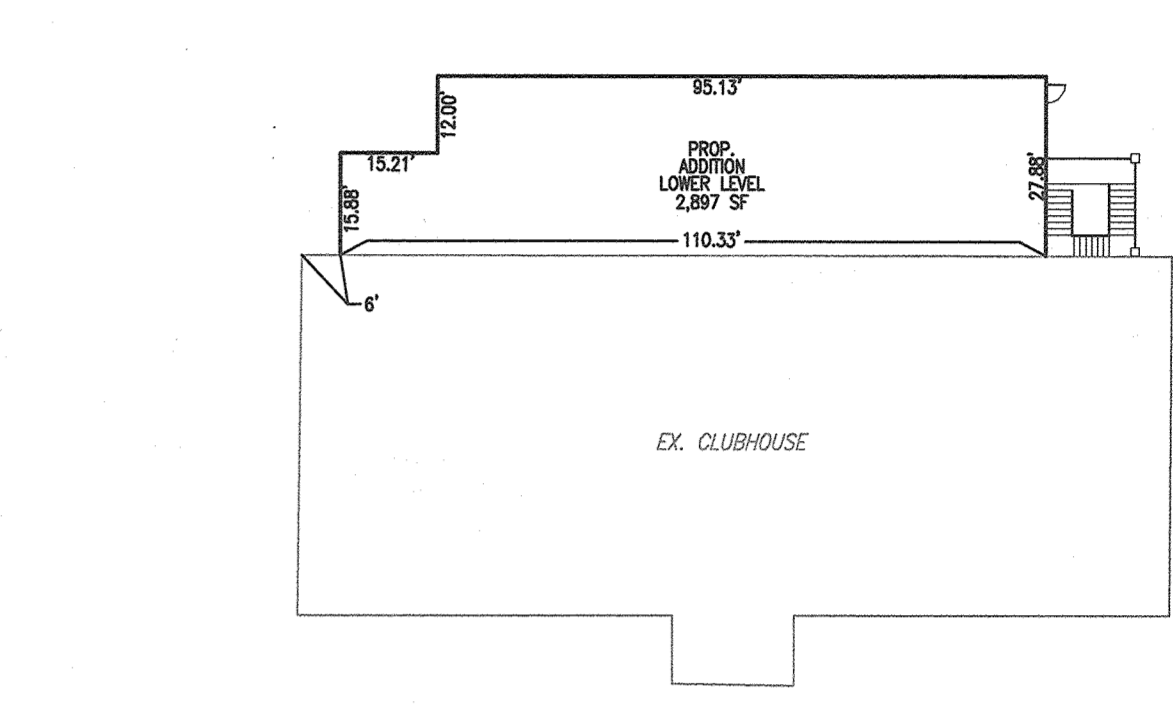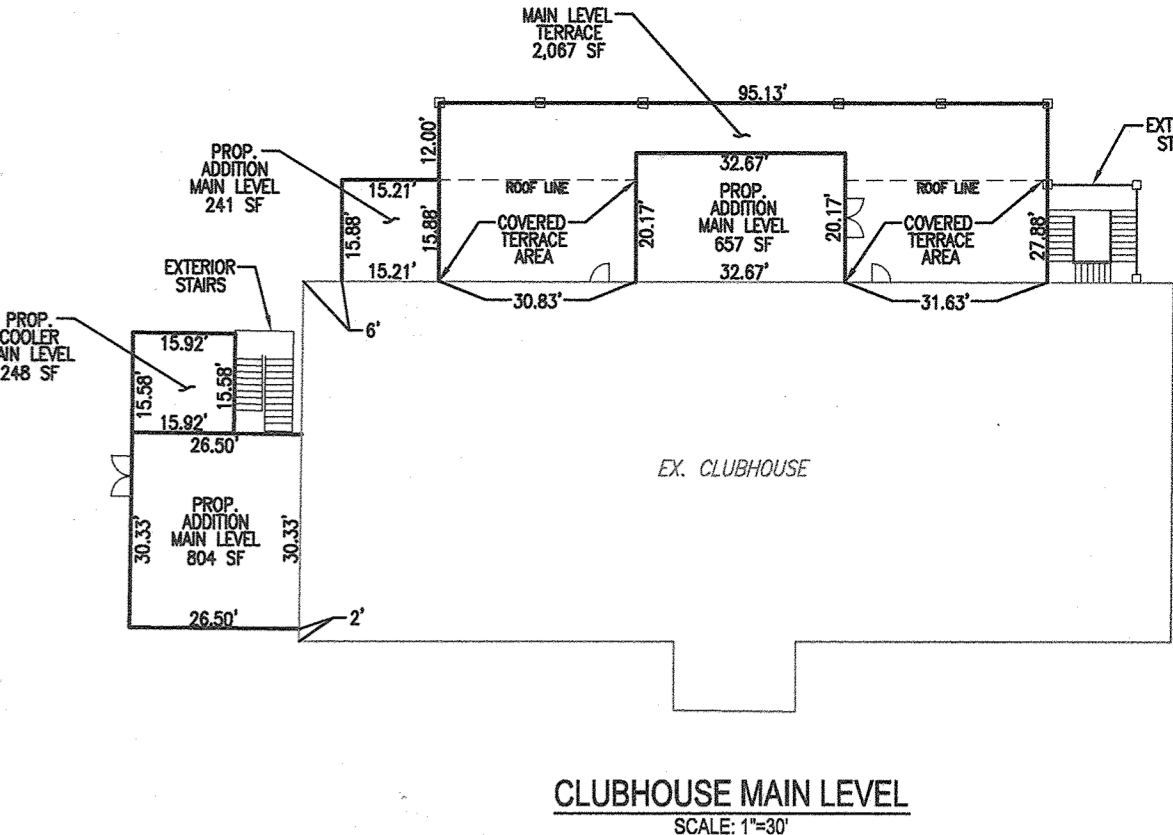

SEWER ELEVATIONS SHOWN ARE FROM FIELD SURVEYS AND BEST AVAILABLE RECORDS. CONTRACTOR TO CONFIRM ELEVATIONS PRIOR TO CONSTRUCTION.

2,000 GAL. GREASE TRAP  
INV. IN: 487.40  
INV. OUT: 487.15  
TOP OF TANK: 488.98  
PROP. GRADE: 491.50

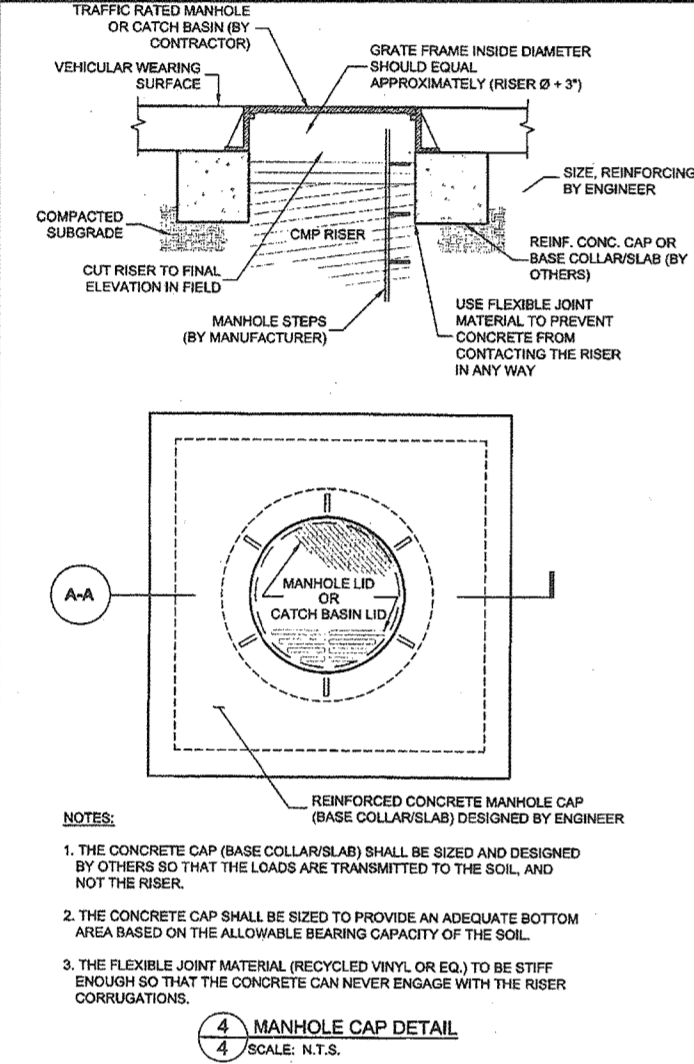

**NOTES:**

1. THE CONCRETE CAP (BASE COLLAR) SHALL BE SEED AND DESIGNED BY OTHERS TO THAT THE LOADS ARE TRANSMITTED TO THE SOIL, AND NOT THE RISER.
2. THE CONCRETE CAP SHALL BE SEED TO PROVIDE AN ADEQUATE BOTTOM AREA BASED ON THE ALLOWABLE BEARING CAPACITY OF THE SOIL.
3. THE FIBER JOINT MATERIAL (RECYCLED VINYL OR EPO) TO BE STIFF ENOUGH SO THAT THE CONCRETE CAP NEVER ENGAGE WITH THE RISER CORRUPTIONS.
4. MANHOLE CAP DETAIL SCALE: 1/8" = 1'-0"

**SOILS LEGEND**  
HOWARD COUNTY SOILS MAP #18

SYMBOL	NAME / DESCRIPTION	GROUP	K FACTOR	ERODIBLE	HYDRIC
WgB	WHEATON-GLENELG COMPLEX, 0 TO 8 PERCENT SLOPES	B	0.37	NO	NO



APPROVED: HOWARD COUNTY DEPARTMENT OF PLANNING AND ZONING

4-5-21  
DATE

4/7/21  
DATE

4-7-21  
DATE

OWNER/DEVELOPER CERTIFICATION:  
I HEREBY CERTIFY THAT ANY CLEARING, GRADING, CONSTRUCTION OR DEVELOPMENT WILL BE DONE PURSUANT TO THIS APPROVED EROSION AND SEDIMENT CONTROL PLAN, INCLUDING INSPECTING AND MAINTAINING CONTROLS, AND THAT ALL RESPONSIBLE PERSONNEL INVOLVED IN THE CONSTRUCTION PROJECT WILL HAVE A CERTIFICATE OF ATTENDANCE AT A MARYLAND DEPARTMENT OF THE ENVIRONMENT AND APPROVED TRAINING PROGRAM FOR THE CONTROL OF EROSION AND SEDIMENT PRIOR TO BEGINNING THE PROJECT. I CERTIFY RIGHT-OF-ENTRY FOR PERIODIC ON-SITE EVALUATION BY HOWARD COUNTY, THE HOWARD SOIL CONSERVATION DISTRICT AND/OR WDC.

3/5/21  
DATE

SEVEN SCHRENK, President  
PRINTED NAME & TITLE

DESIGN CERTIFICATION:  
I HEREBY CERTIFY THAT THIS PLAN HAS BEEN DESIGNED IN ACCORDANCE WITH CURRENT MARYLAND EROSION AND SEDIMENT CONTROL LAWS, REGULATIONS, AND STANDARDS, THAT IT REPRESENTS A PRACTICAL AND WORKABLE PLAN BASED ON MY PERSONAL KNOWLEDGE OF THE SITE, AND THAT IT WAS PREPARED IN ACCORDANCE WITH THE REQUIREMENTS OF THE HOWARD SOIL CONSERVATION DISTRICT.

3/17/21  
DATE

ROBERT H. VOGEL  
DESIGNER'S SIGNATURE  
PRINTED NAME



MD REGISTRATION NO. 16193  
R.L.S., OR R.L.A. (circle one)

APPROVED FOR SOIL EROSION AND SEDIMENT CONTROL BY THE HOWARD SOIL CONSERVATION DISTRICT.

APPROVED: FOR PRIVATE WATER AND PRIVATE SEWERAGE SYSTEMS.

3/17/21  
DATE

ROBERT H. VOGEL  
COUNTY HEALTH OFFICER  
HOWARD COUNTY HEALTH DEPARTMENT

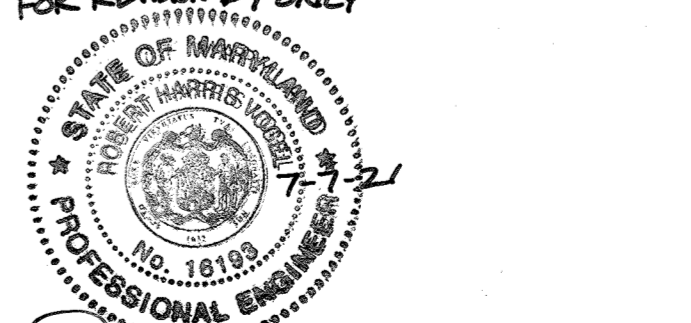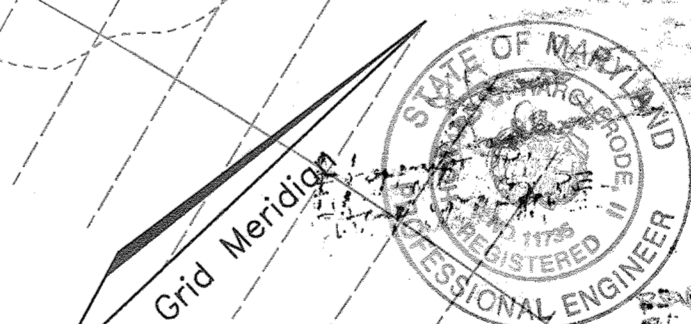

NO.	REVISION	DATE
1	REVISE THE PLAN TO SHOW RELOCATED PROPANE TANK LOCATION	
2	REVISE THE PLAN TO ADD A RETAINING WALL, SECTIONS AND DETAILS	7-7-21
3	REVISE THE PLAN TO MODIFY THE EXISTING BUILDING BY ADDING ADDITIONS TO THE NORTHWEST AND SOUTHWEST SIDES OF THE CLUBHOUSE	3-5-21

REVISED SITE DEVELOPMENT PLAN  
GRADING, EROSION AND SEDIMENT CONTROL PLAN AND SITE DETAILS  
CATTAIL CREEK COUNTRY CLUB  
3600 CATTAIL CREEK DRIVE  
ZONED: RC-DEO

TAX MAP: 21 GRID: B  
4TH ELECTION DISTRICT

PARCEL: 211  
HOWARD COUNTY, MARYLAND


**VOGEL ENGINEERING**  
TIMMONS GROUP  
3300 NORTH RIDGE ROAD, SUITE 110, ELLICOTT CITY, MD 21043  
P: 410.461.7666 F: 410.461.8961 www.timmons.com

DESIGN BY: RHV/LRC  
DRAWN BY: LRC  
CHECKED BY: RHV  
DATE: 02/23/21  
SCALE: AS SHOWN  
W.O. NO.: 42317

PROFESSIONAL CERTIFICATE  
I HEREBY CERTIFY THAT THESE DOCUMENTS WERE PREPARED OR APPROVED BY ME, AND THAT I AM A DULY LICENSED PROFESSIONAL ENGINEER UNDER THE LAWS OF THE STATE OF MARYLAND, LICENSE NO. 16193 EXPIRATION DATE: 09-27-2022

6 SHEET OF 10



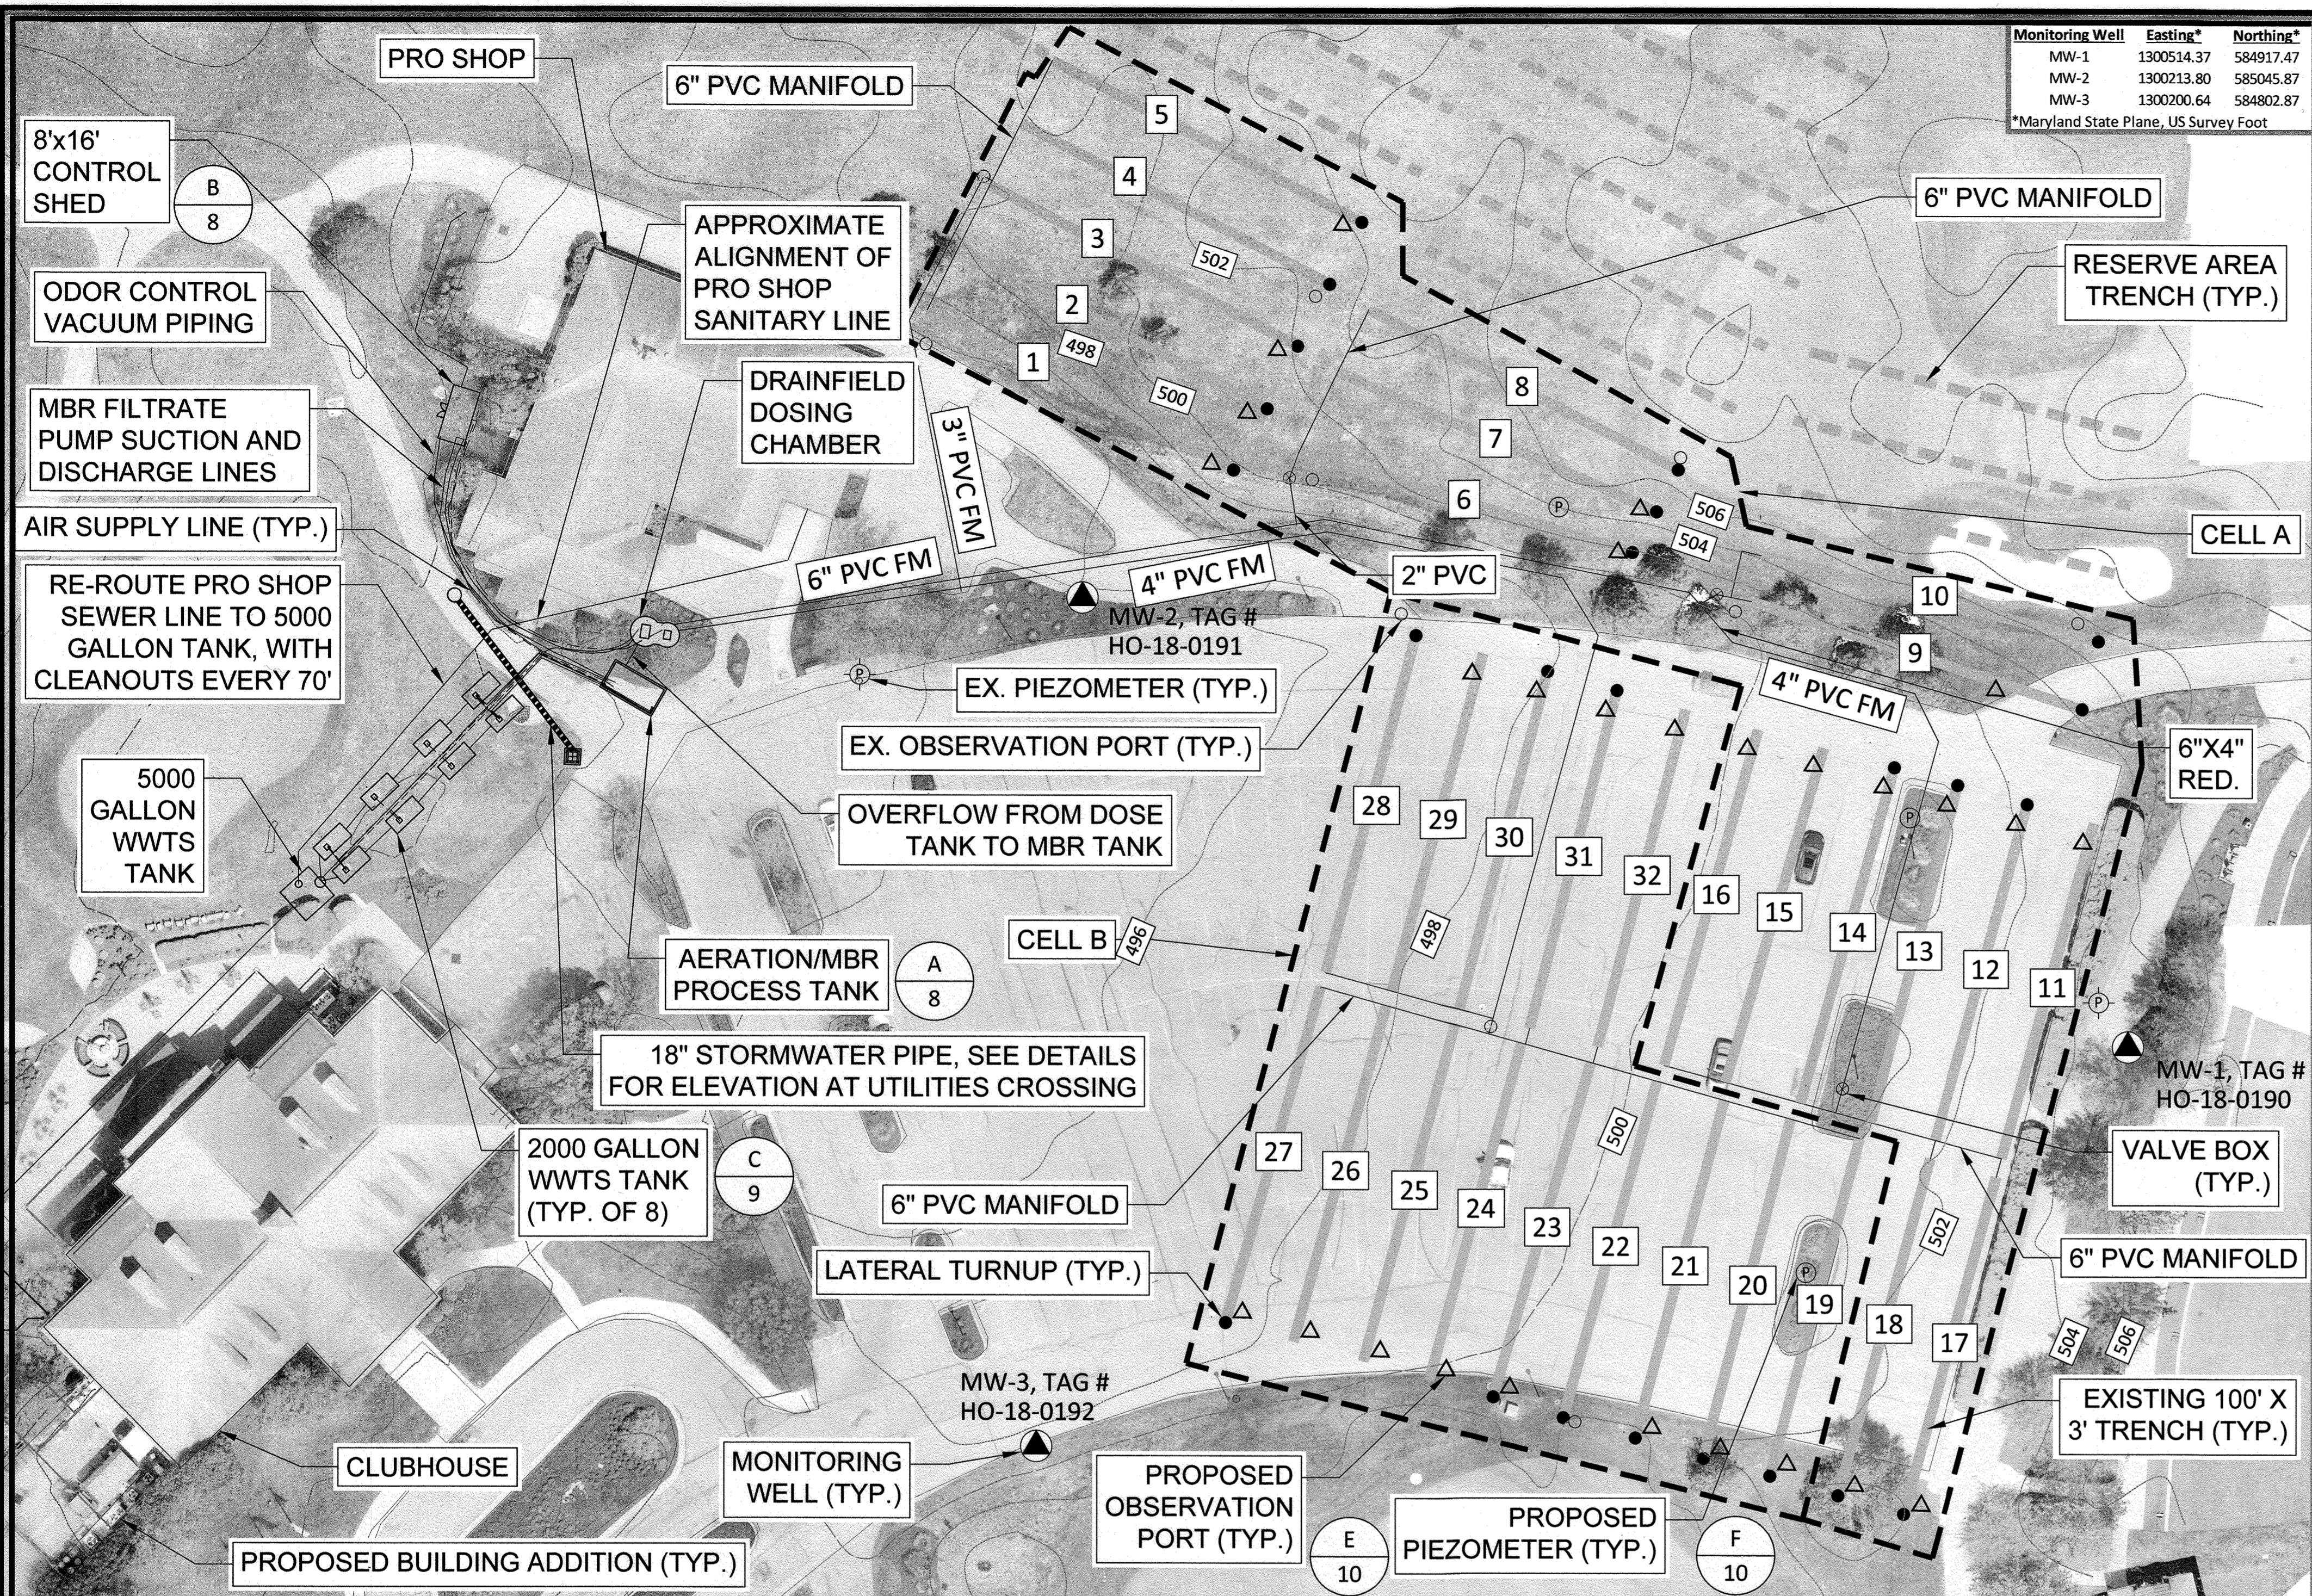

Monitoring Well	Easting*	Northing*
MW-1	1300514.37	584917.47
MW-2	1300213.80	585045.87
MW-3	1300200.64	584802.87

\*Maryland State Plane, US Survey Foot

**NOTES:**

- Site information is based upon data downloaded from the Howard County GIS department website.
- Existing on-site wastewater system components are located and labeled per as-built drawings by Clark, Finerock and Sackett, inc., dated 4-17-1996, job no. 94-189. Installed system is for initial design layout only, area for two repair systems is reserved.
- Site aerial drone imagery and component location verification data collected on 5-4-2020 by Hydro-Terra Group, Inc.
- Original trench capacity design is based on standard trench calculations (length x width x loading rate). The upgraded design is based on deep trench calculations given a 2' sidewall and loading rate for advanced treatment utilizing membrane bioreactor (MBR) technology.
- Eight (8) existing 2000-gallon septic tanks will be repurposed as anoxic/aerobic mixing tanks. The 2000-gallon tanks may be alternated between anoxic and aerobic bioprocesses as needed. The current functions of the existing 5000-gallon septic tank and drainfield dosing tank will remain as is.
- Field-conduit for electric and controls/monitoring cabling will be installed as necessary per local electrical codes. Field junction boxes and control panels will be installed per local electrical codes.
- All buried piping and conduit will be bedded on virgin soil or #57 stone with warning tape, and per local plumbing codes.
- New grease trap (not shown) will be installed and will process all kitchen flow.

**LEGEND**

- EX. OBSERVATION PORT
- △ PROPOSED OBSERVATION PORT
- EX. LATERAL TURN-UP
- ⊗ EX. VALVE BOX
- 9 TRENCH LABEL
- ⊕ EX. PIEZOMETER
- ⊕ PROPOSED PIEZOMETER
- ▲ MONITORING WELL

Use Projections (see historical data statistical analysis)

Design Wastewater Strength	Influent (Restaurant)	Effluent (MBR)
BOD (mg/L)	800	3
mass loading at ADF (lb/day)	25.0	0.09
TSS (mg/L)	500	1
mass loading at ADF (lb/day)	15.6	0.03
Total Nitrogen (mg/L as N)	120	3
mass loading at ADF (lb/day)	3.8	0.09
FOG (mg/L)	40	

Notes:  
*calculated values in italics*  
 ADF = average daily flow  
 MDF = maximum daily flow  
 Use data take into account expansion of clubhouse




Existing trenches dosed as two cells, deep trench design with MBR effluent loading rate

Cell	Trench	Approx. Existing Ground Elevation (feet msl)	Approx. Existing Trench Bottom Elevation (feet msl)	Lateral as-built Elevation (feet msl)	Per. Rate (lpm/inch)	SideWall Bottom Elevation (feet msl)	Trench Bottom Depth (feet)	Trench Length (feet)	Capacity (gpd) L x W x Depth (ft)	Cell Capacity (gpd)
A	1	499.0	494.40	492.4	6.6	100	960			
	2	499.5	494.80	492.7	6.7	100	960			
	3	500.5	494.70	492.7	7.8	100	960			
	4	502.0	494.60	492.6	9.4	100	960			
	5	503.5	494.60	492.6	10.9	100	960			
	6	504.0	499.70	497.7	6.3	100	960			
	7	505.0	499.70	497.7	7.3	100	960			
	8	506.0	499.70	497.7	8.3	100	960			
	9	504.0	501.00	499.0	5.0	100	960			
	10	506.0	501.00	499.0	7.0	100	960			17,280
B	11	503.0	497.20	495.2	7.8	100	960			
	12	502.0	497.20	495.2	7.3	100	960			
	13	502.0	497.20	495.2	6.8	100	960			
	14	501.5	497.20	495.2	6.3	100	960			
	15	501.0	497.20	495.2	5.8	100	960			
	16	500.5	497.20	495.2	5.3	100	960			
	17	503.0	497.10	495.1	7.9	100	960			
	18	502.7	497.20	495.2	7.5	100	960			
	19	502.3	497.10	495.1	7.2	100	960			
	20	502.0	497.10	495.1	6.9	100	960			
	21	501.5	497.50	495.5	6.0	100	960			
	22	501.0	493.70	491.7	9.3	100	960			13,440
23	500.5	493.40	491.4	9.1	100	960				
24	500.0	493.40	491.4	8.6	100	960				
25	499.7	493.40	491.4	8.3	100	960				
26	499.3	493.40	491.4	7.9	100	960				
27	499.0	493.20	491.2	7.8	100	960				
28	498.0	493.00	491.0	7.0	100	960				
29	498.0	493.00	491.0	7.0	100	960				
30	499.0	493.00	491.0	8.0	100	960				
31	499.5	493.10	491.1	8.4	100	960				
32	500.0	493.10	491.1	8.9	100	960				

Notes:  
 Sidewall height = 2 ft  
 Trench width = 3 ft  
 Application rate = 2.0 gpd/ft<sup>2</sup>, MBR effluent  
 trench length = 100 ft  
*calculated values in italics*  
 gpd = gallons per day  
 msl = mean sea level in feet  
 laterals in each trench are at same elevation  
 Installed capacity (gpd) 30,720

**WATER USE AND TREATMENT CRITERIA**

**TRENCH DESIGN**

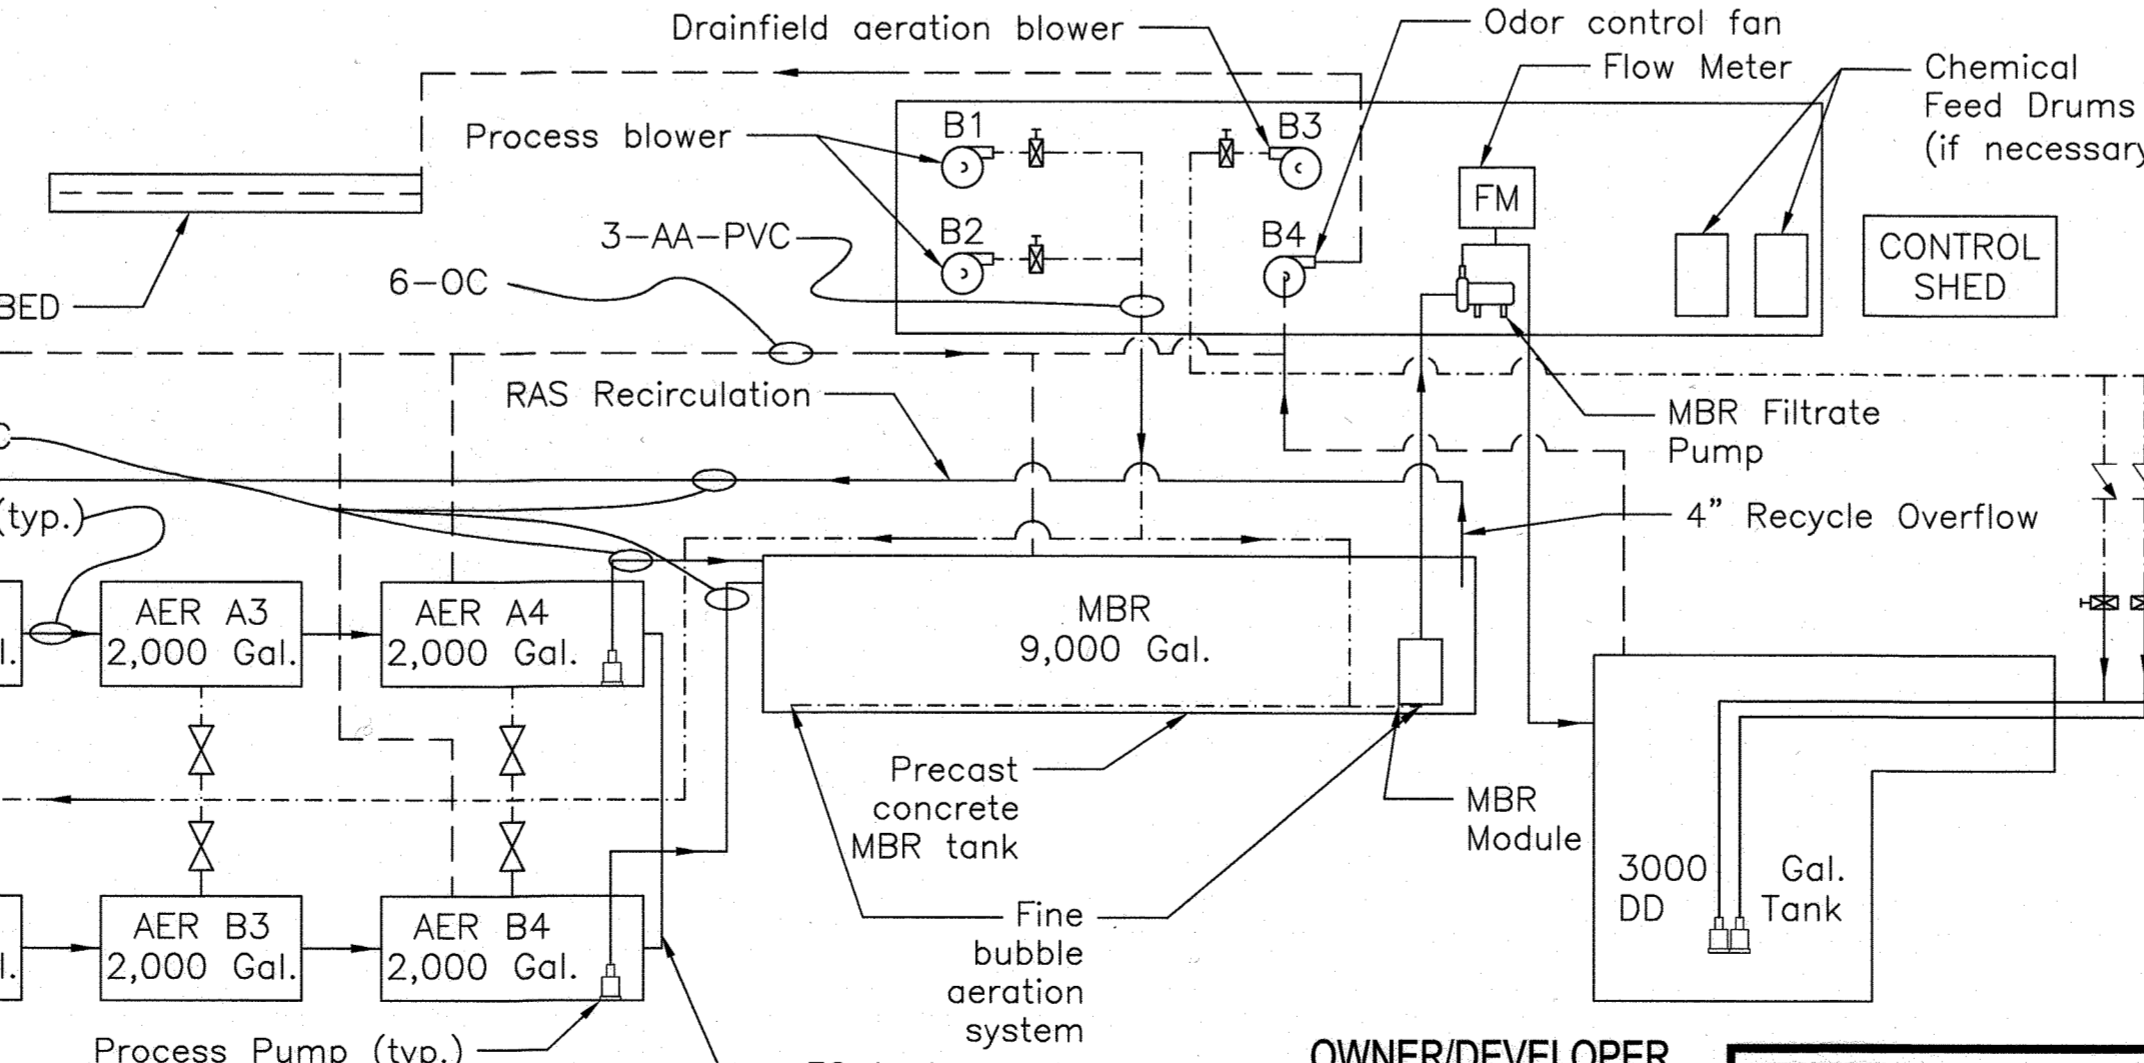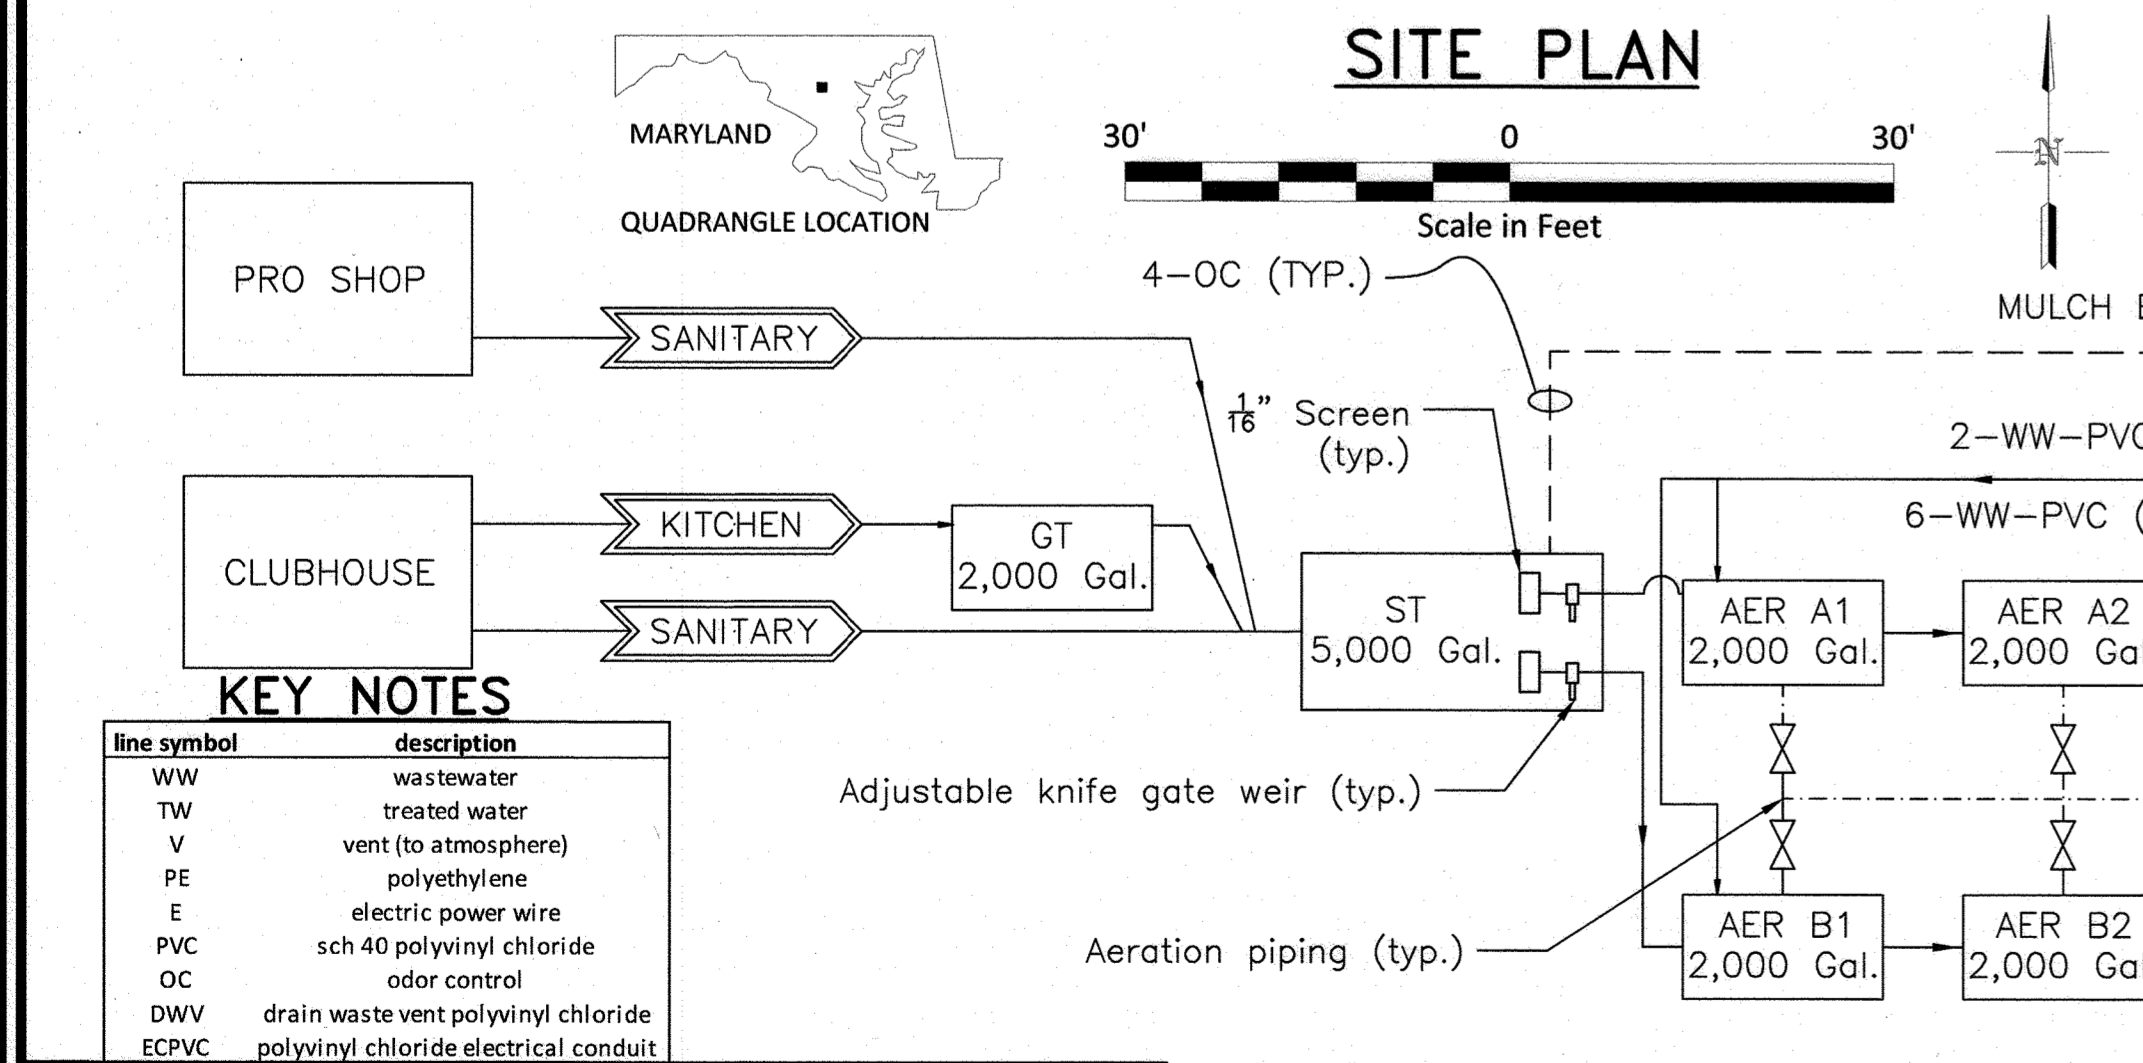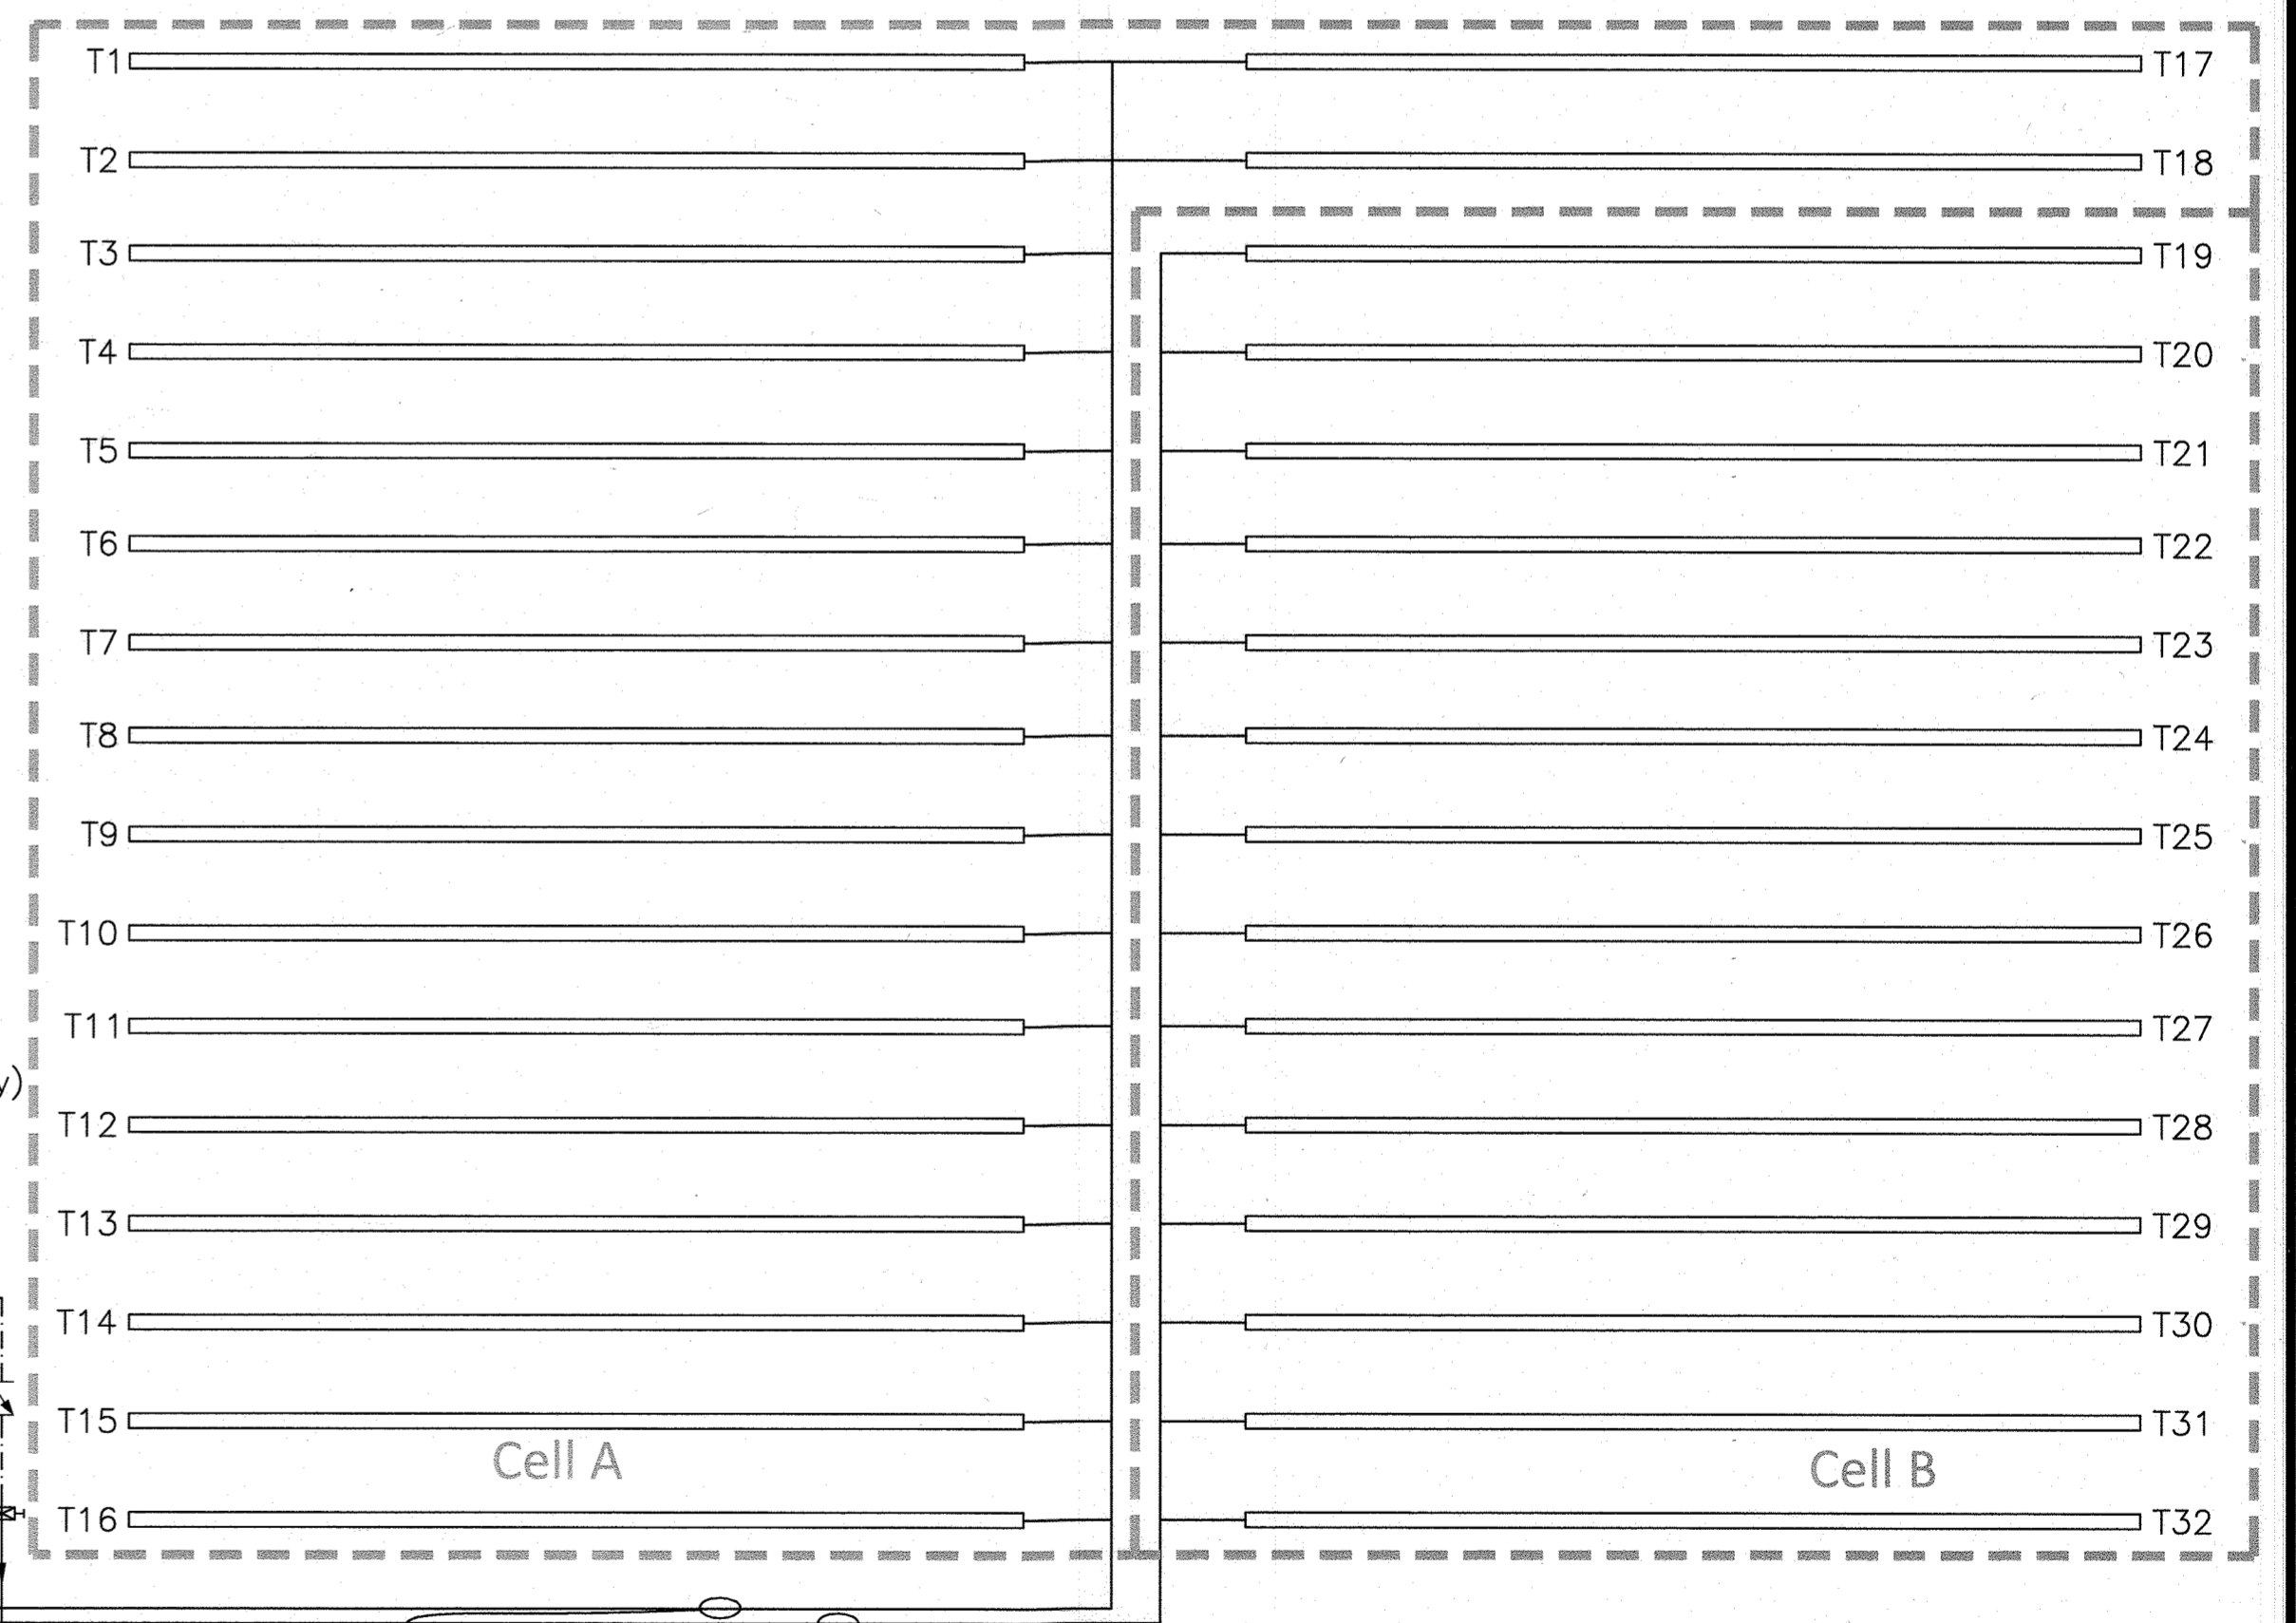

APPROVED: HOWARD COUNTY DEPARTMENT OF PLANNING AND ZONING

CHIEF, DEVELOPMENT ENGINEERING DIVISION DATE 4-5-21

CHIEF, DIVISION OF LAND DEVELOPMENT DATE 4/5/21

DIRECTOR DATE 4-7-21

APPROVED: FOR PRIVATE WATER AND PRIVATE SEWERAGE SYSTEMS

COUNTY HEALTH OFFICER DATE 3/12/2021

HOWARD COUNTY HEALTH DEPARTMENT

**PIPE IDENTIFIER:**

XX-XXX PIPE MATERIAL

PIPE FUNCTION

NOMINAL PIPE SIZE (IN INCHES)

NO.	REVISION	DATE
1	REVISE THE PLAN TO MODIFY THE EXISTING BUILDING BY ADDING ADDITIONS TO THE NORTHWEST AND SOUTHWEST SIDES OF THE CLUBHOUSE	3-5-21

OWNER/DEVELOPER  
 CATTAIL CREEK COUNTRY CLUB, INC.  
 3600 CATTAIL CREEK DRIVE  
 GLENWOOD, MD 21738  
 PHONE #: 410-489-4653

DESIGN BY: MJM  
 DRAWN BY: MJM  
 CHECKED BY: MDH  
 DATE: FEB. 2020  
 SCALE: AS SHOWN

PROFESSIONAL CERTIFICATE

I HEREBY CERTIFY THAT THESE DOCUMENTS WERE PREPARED OR APPROVED BY ME, AND THAT I AM A DULY LICENSED PROFESSIONAL ENGINEER UNDER THE LAWS OF THE STATE OF MARYLAND, LICENSE NO. 50923, EXPIRATION DATE: 12-15-2022

7 SHEET OF 10

REVISED SITE DEVELOPMENT PLAN

**CATTAIL CREEK COUNTRY CLUB**  
 3600 CATTAIL CREEK DRIVE  
 ZONED: RC-DEO


TAX MAP: 21 GRID: 8  
 4TH ELECTION DISTRICT

PARCEL: 211  
 HOWARD COUNTY, MARYLAND  
 SDP-96-015




**NOTES:**


1. Pipe penetrations in new concrete walls will be sealed via Press-Seal Cast-A-Seal boot connectors. Pipe penetrations in existing concrete structures will be sealed via Press-Seal PSX boot connectors.
2. All control panels will have NEMA 4X enclosures with hinged, lockable doors.
3. Membrane bioreactor (MBR) treatment system manufacturer (TSM) will be Biomicrobics, BioBarrier model HSMBR 6.0-N or approved equal.
4. Control building will have interior and exterior lighting, gable venting, insulation and temperature control to ensure chemicals remain within operational thermal range year-round and housed equipment is not operated above manufacturer's specified temperature. 120V convenience outlets will be spaced on walls every 8'.
5. A remote monitoring system (RMS) will be installed to allow remote observation of the treatment system and alert the owner and operators of alarm conditions. RMS will be by OnSet Computer Corporation, P/N RX3000. RMS will monitor, at a minimum, indoor and outdoor air temperature; filtrate pump suction pressure; blower air pressure; dose tank and MBR tank levels; filtrate pump discharge flow rate.
6. Chemical feed pumps will be Stenner-style tube pumps with sizing and rates as needed. Discharge tubing will be connected to recirculation line run through conduit from the treatment building to the treatment area.
7. FRP deck panel system will be Superplank CP150 by Creative Pultrusions or approved equal. Removable panels will be installed over membrane modules to allow for access for removal. Create access by removing bottom flange from hatchway groove, and bottom flange from adjacent panel's groove, and installing handles onto hatchway panel (see detail on sheet 10).
8. Precast concrete tank will be provided by Gillespie Precast or approved equal, and installed per these drawings. Pipe sleeves will be cast into walls as sch. 40 PVC pipes 2" in diameter larger than process pipe, and appropriate penetration seals will be provided.
9. Existing site layout base on site survey and drone mapping, and as-built drawings from Clark, Finerock and Sackett, Inc. dated 4-17-96 (SDP-96-15, job no. 94-189).
10. Fine bubble diffusers will be EDI FlexAir High-Capacity 9" diffusers with 3/4" NPT(M) connection and will be installed with a PVC 3/4" insertion bushing that is secured to the 2" air head via compression and solvent weld.
11. Installation, startup and sludge seeding of MBR will be completed per manufacturer's instructions. Refer to manufacturer's and Engineer's O&M manual for proper use and care of MBR modules.
12. Blowers will be Atlantic Blower model AB-700 or approved equal. Blowers will have separate, lockable hinged control panels.
13. RAS ALP depth and air flow rate will be set such that MBR water level is never drawn down below top of membrane modules. Once wetted, membrane modules cannot be unsubmerged unless by following strict protocol of membrane manufacturer.
14. Chemical feed systems for alkalinity or carbon addition are assumed to not be necessary. Should chemical analysis of effluent and process flows indicate otherwise, consult the Engineer.
15. System operation, maintenance, effluent sampling, and reporting will be conducted as stipulated by the groundwater discharge/NPDES permit, the issued Operation and Maintenance Manual, and other requirements imposed by the Owner, Engineer, or federal, state or local approving authorities.
16. Should re-route of pro shop gravity sewer line prove impossible via 1% gravity sewer pipe, consult with Engineer for alternatives.
17. Odor control fan will be Cincinnati Fan model PB-10A, or approved equal. Interior components contacting process air will be of corrosion-resistant construction (e.g. aluminum).

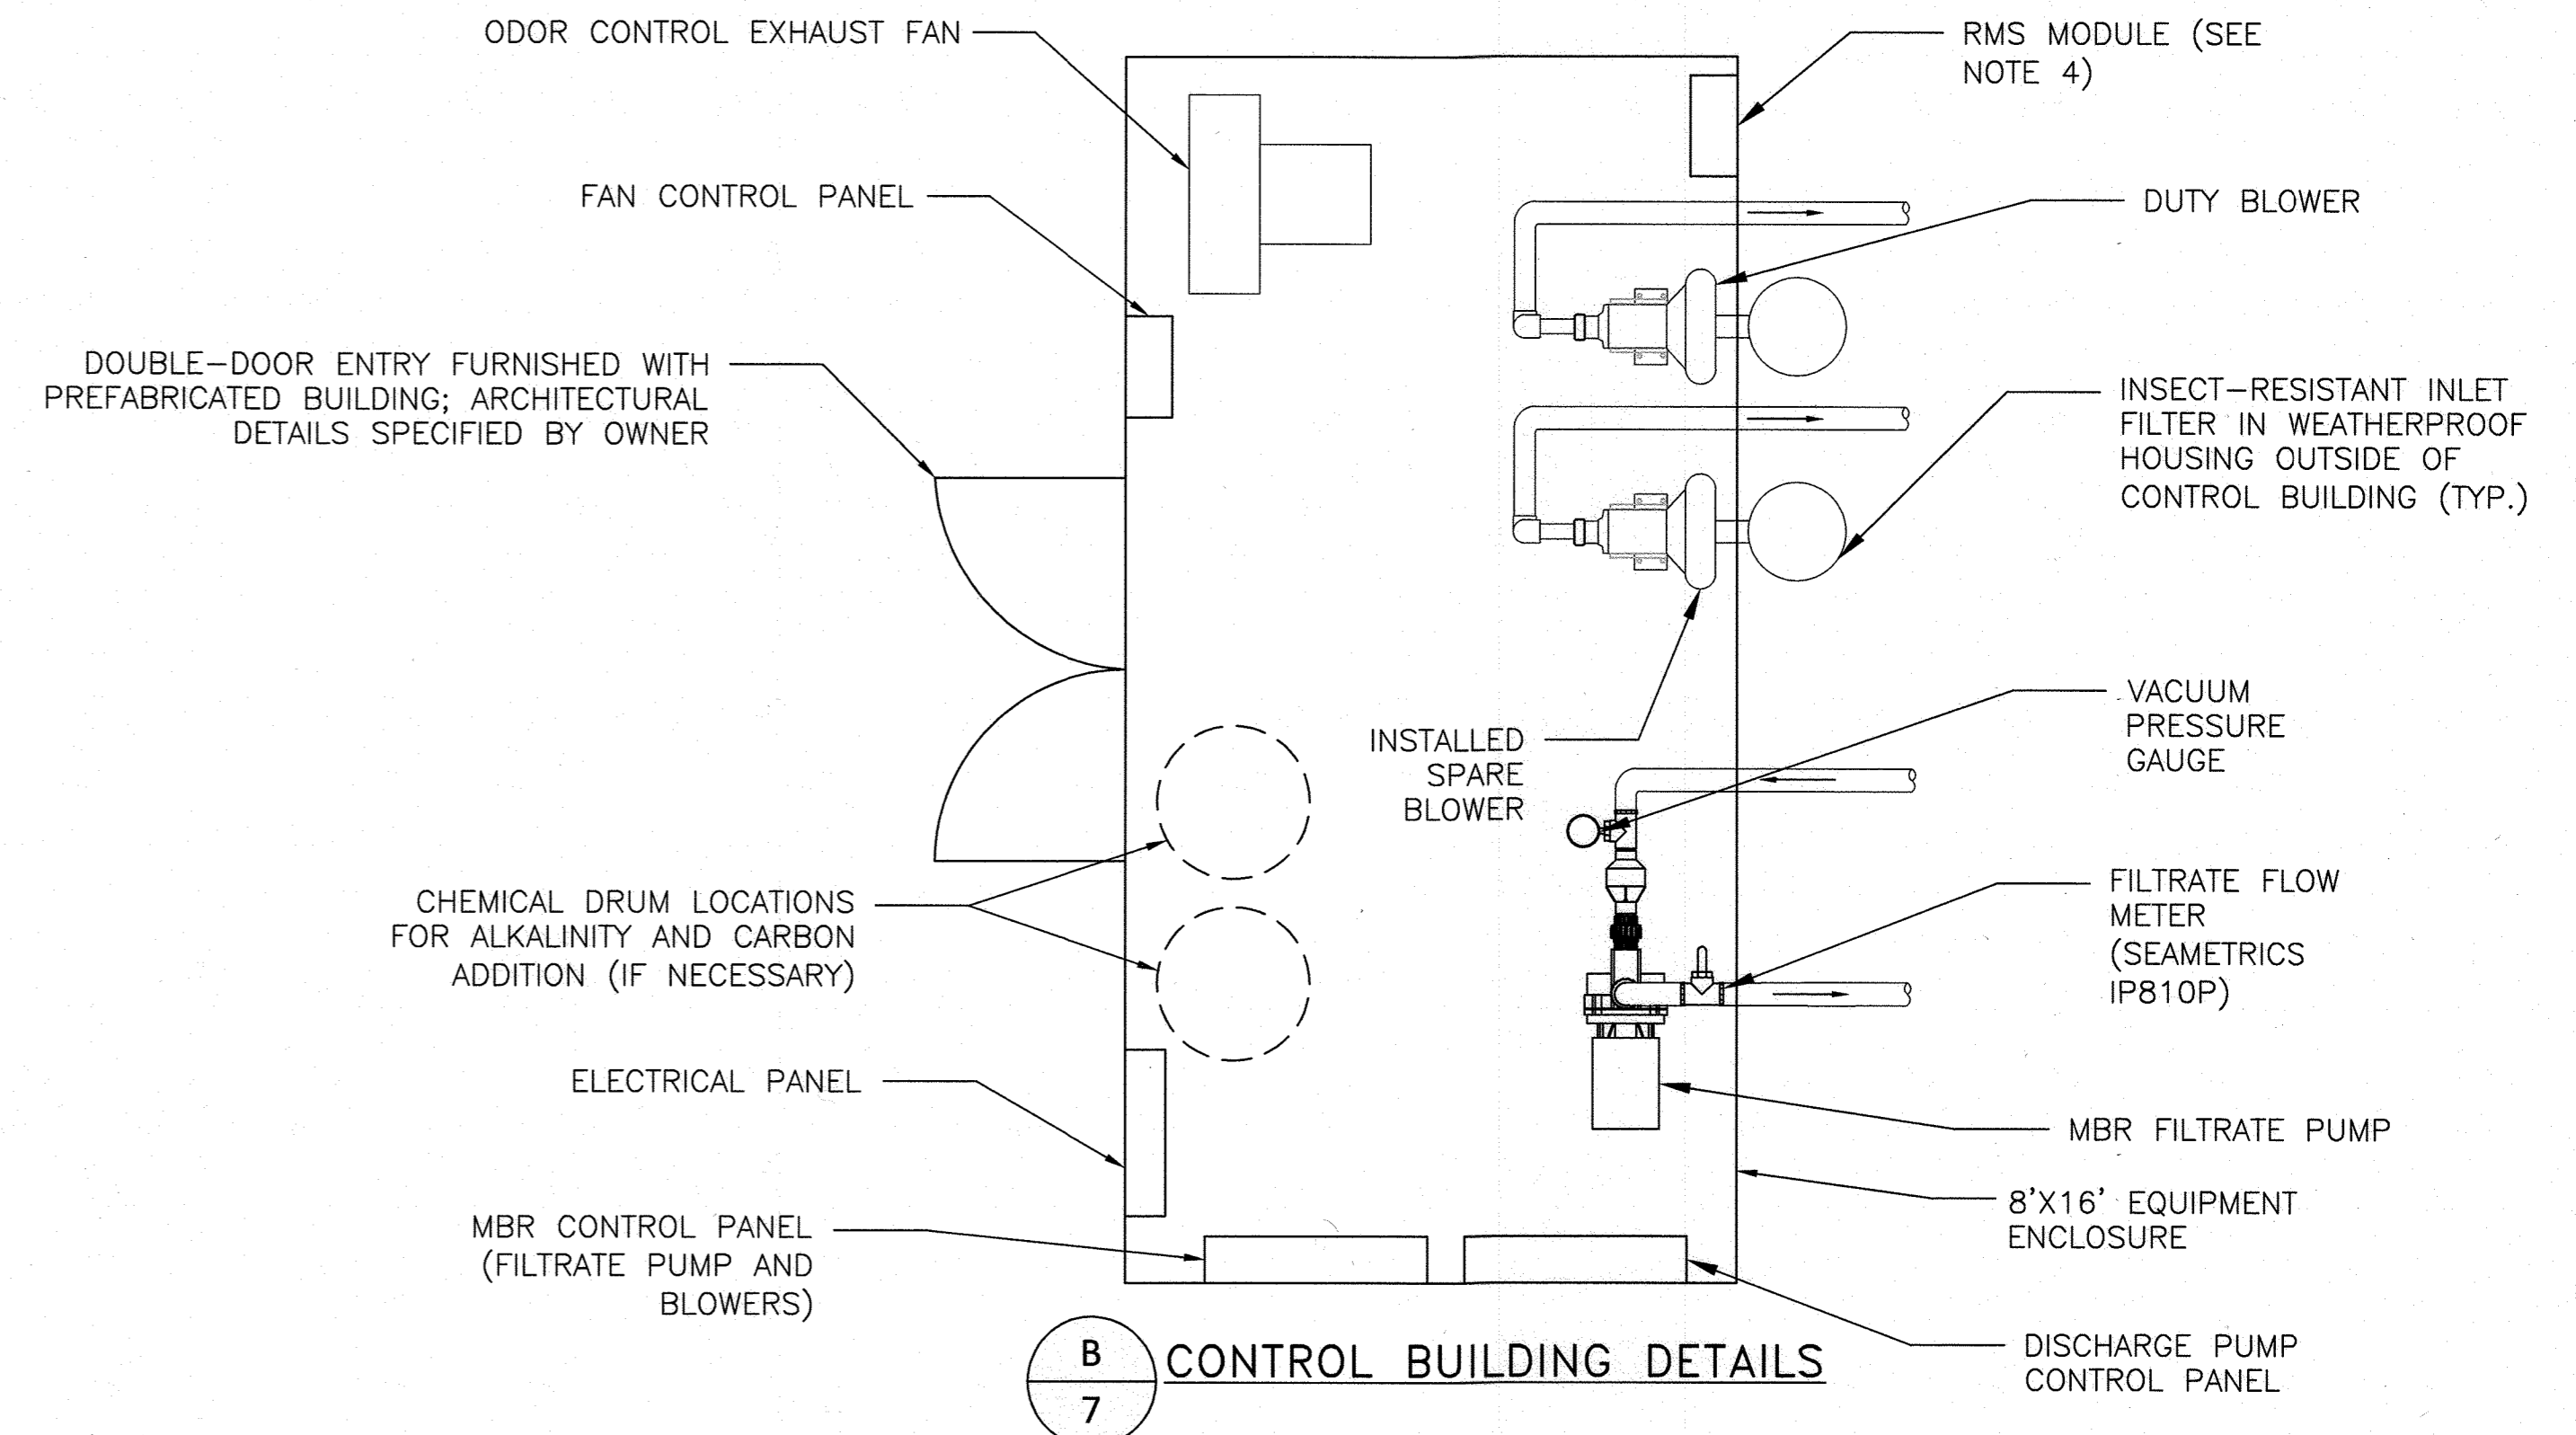

**B**  
CONTROL BUILDING DETAILS  
**7**

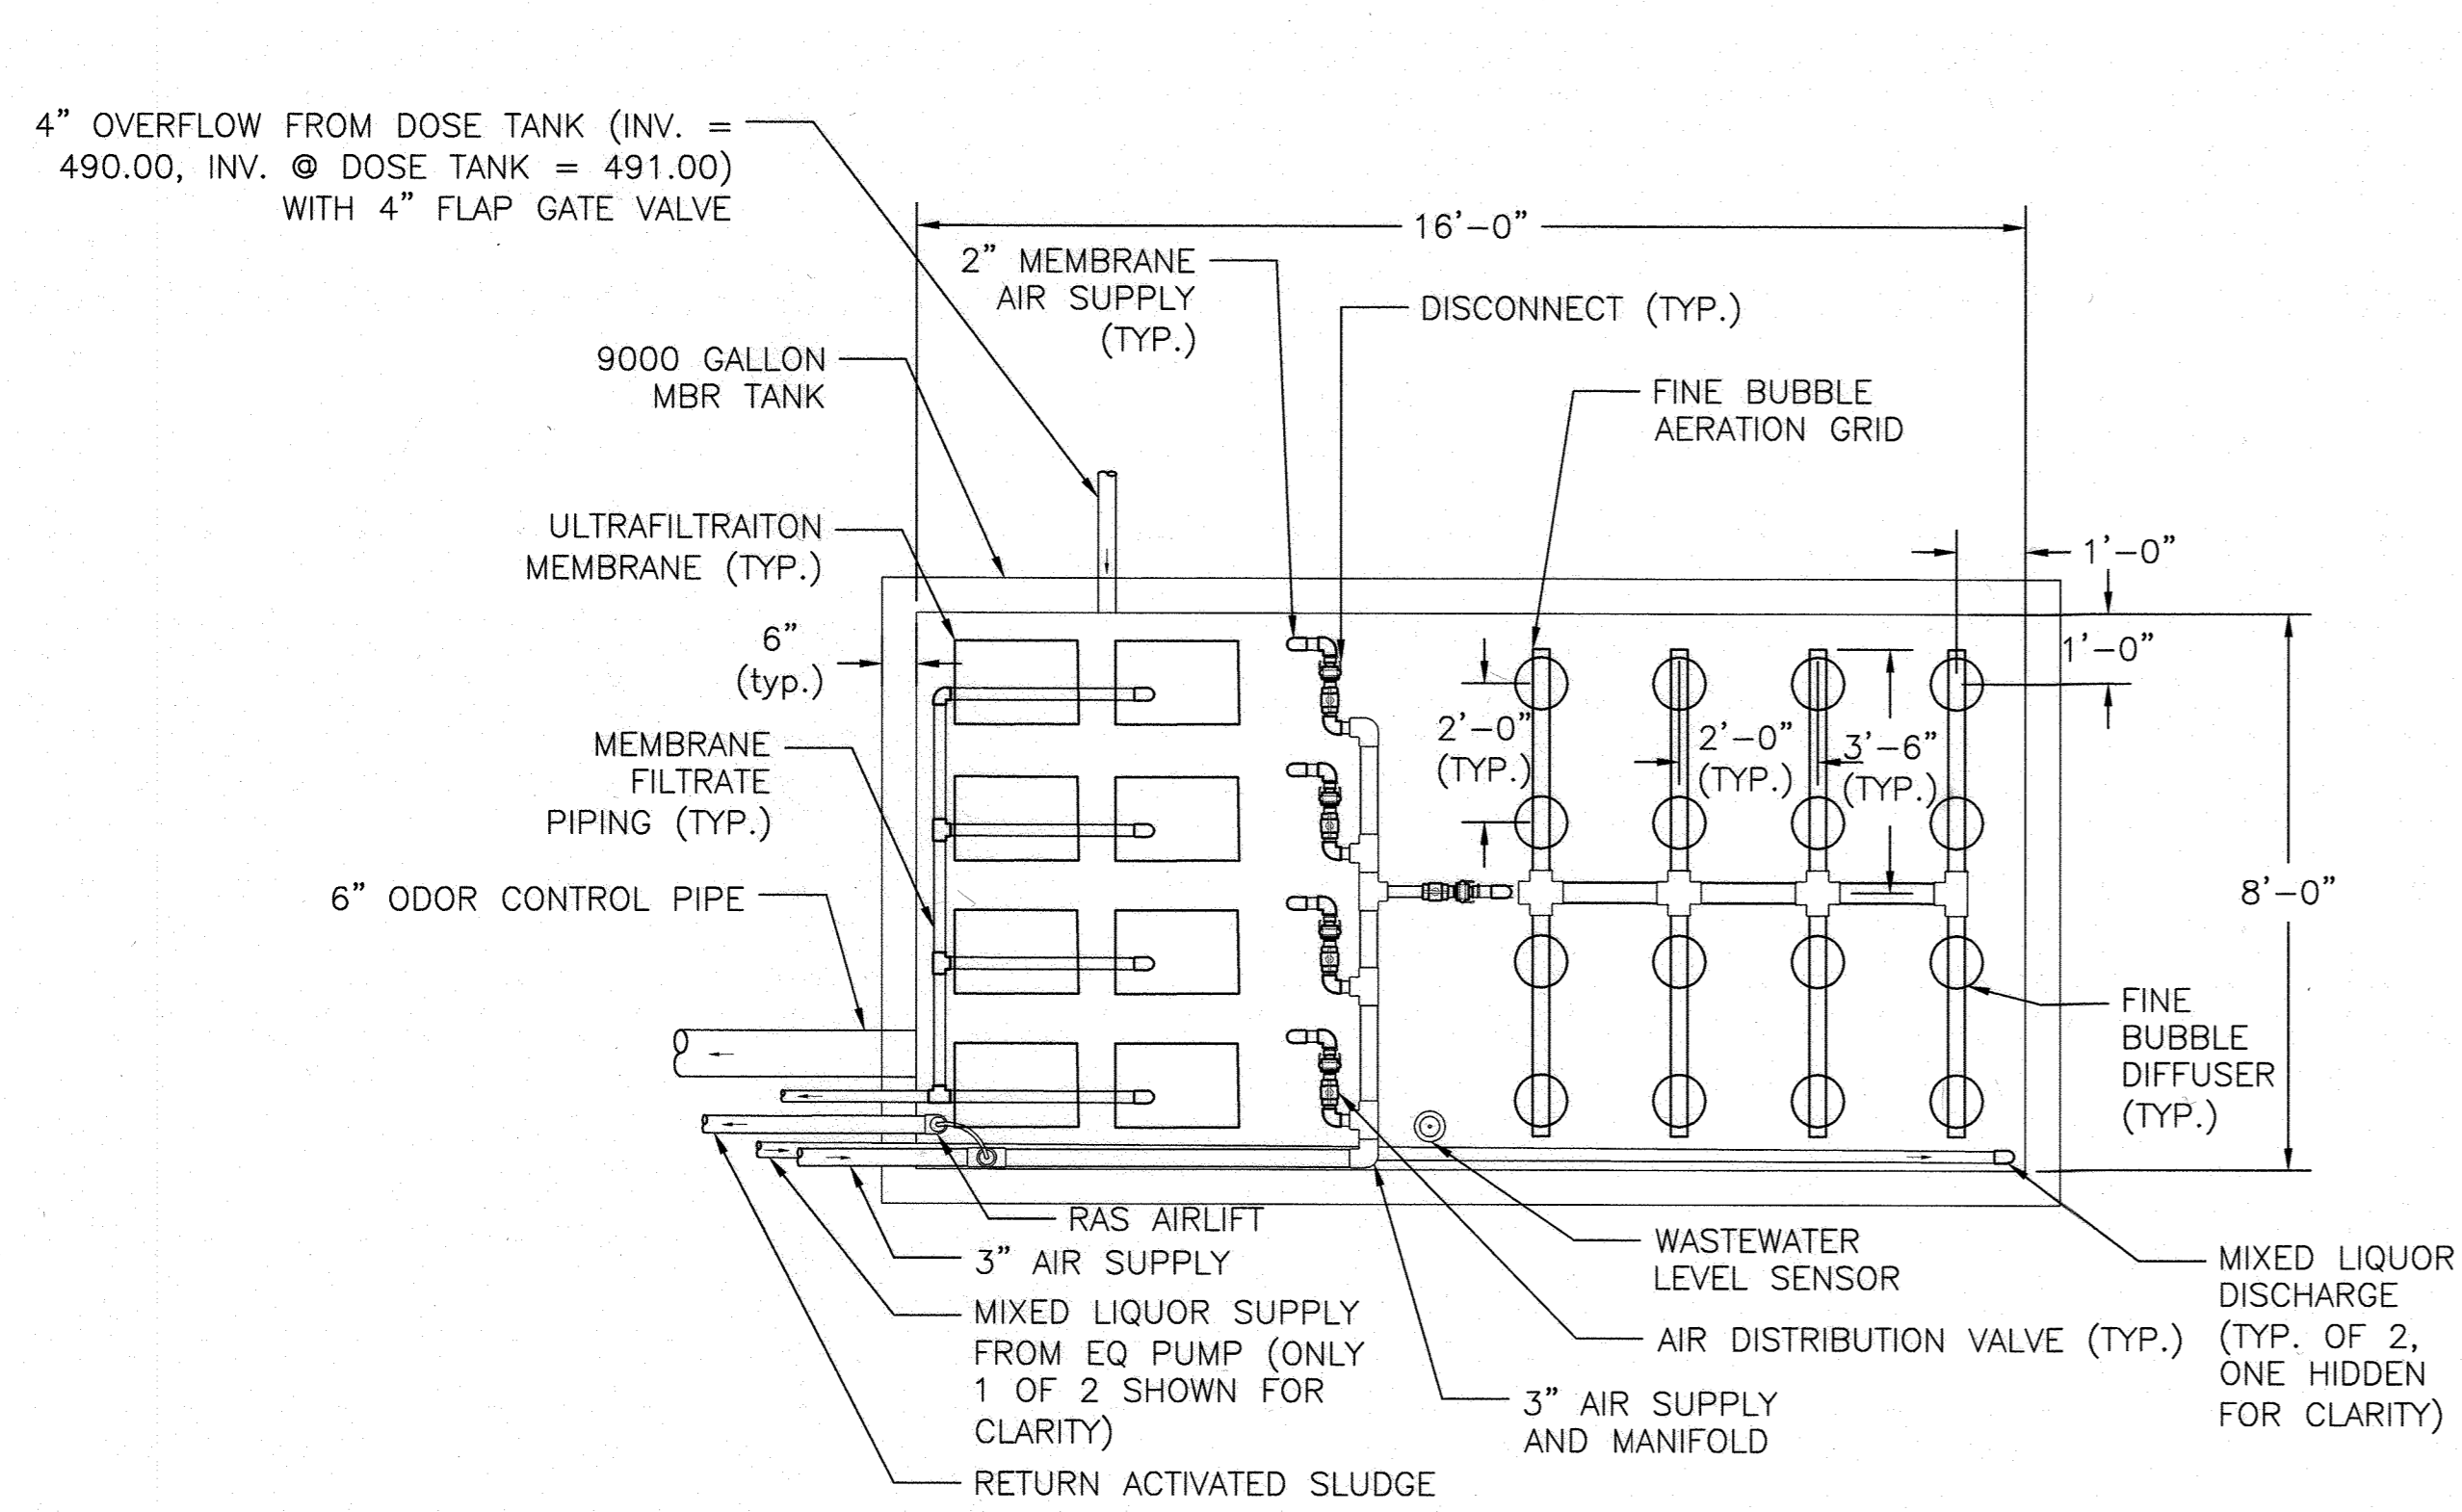

**A**  
MEMBRANE BIOREACTOR  
PLAN AND SECTION  
SCALE: 1" = 1'-0"

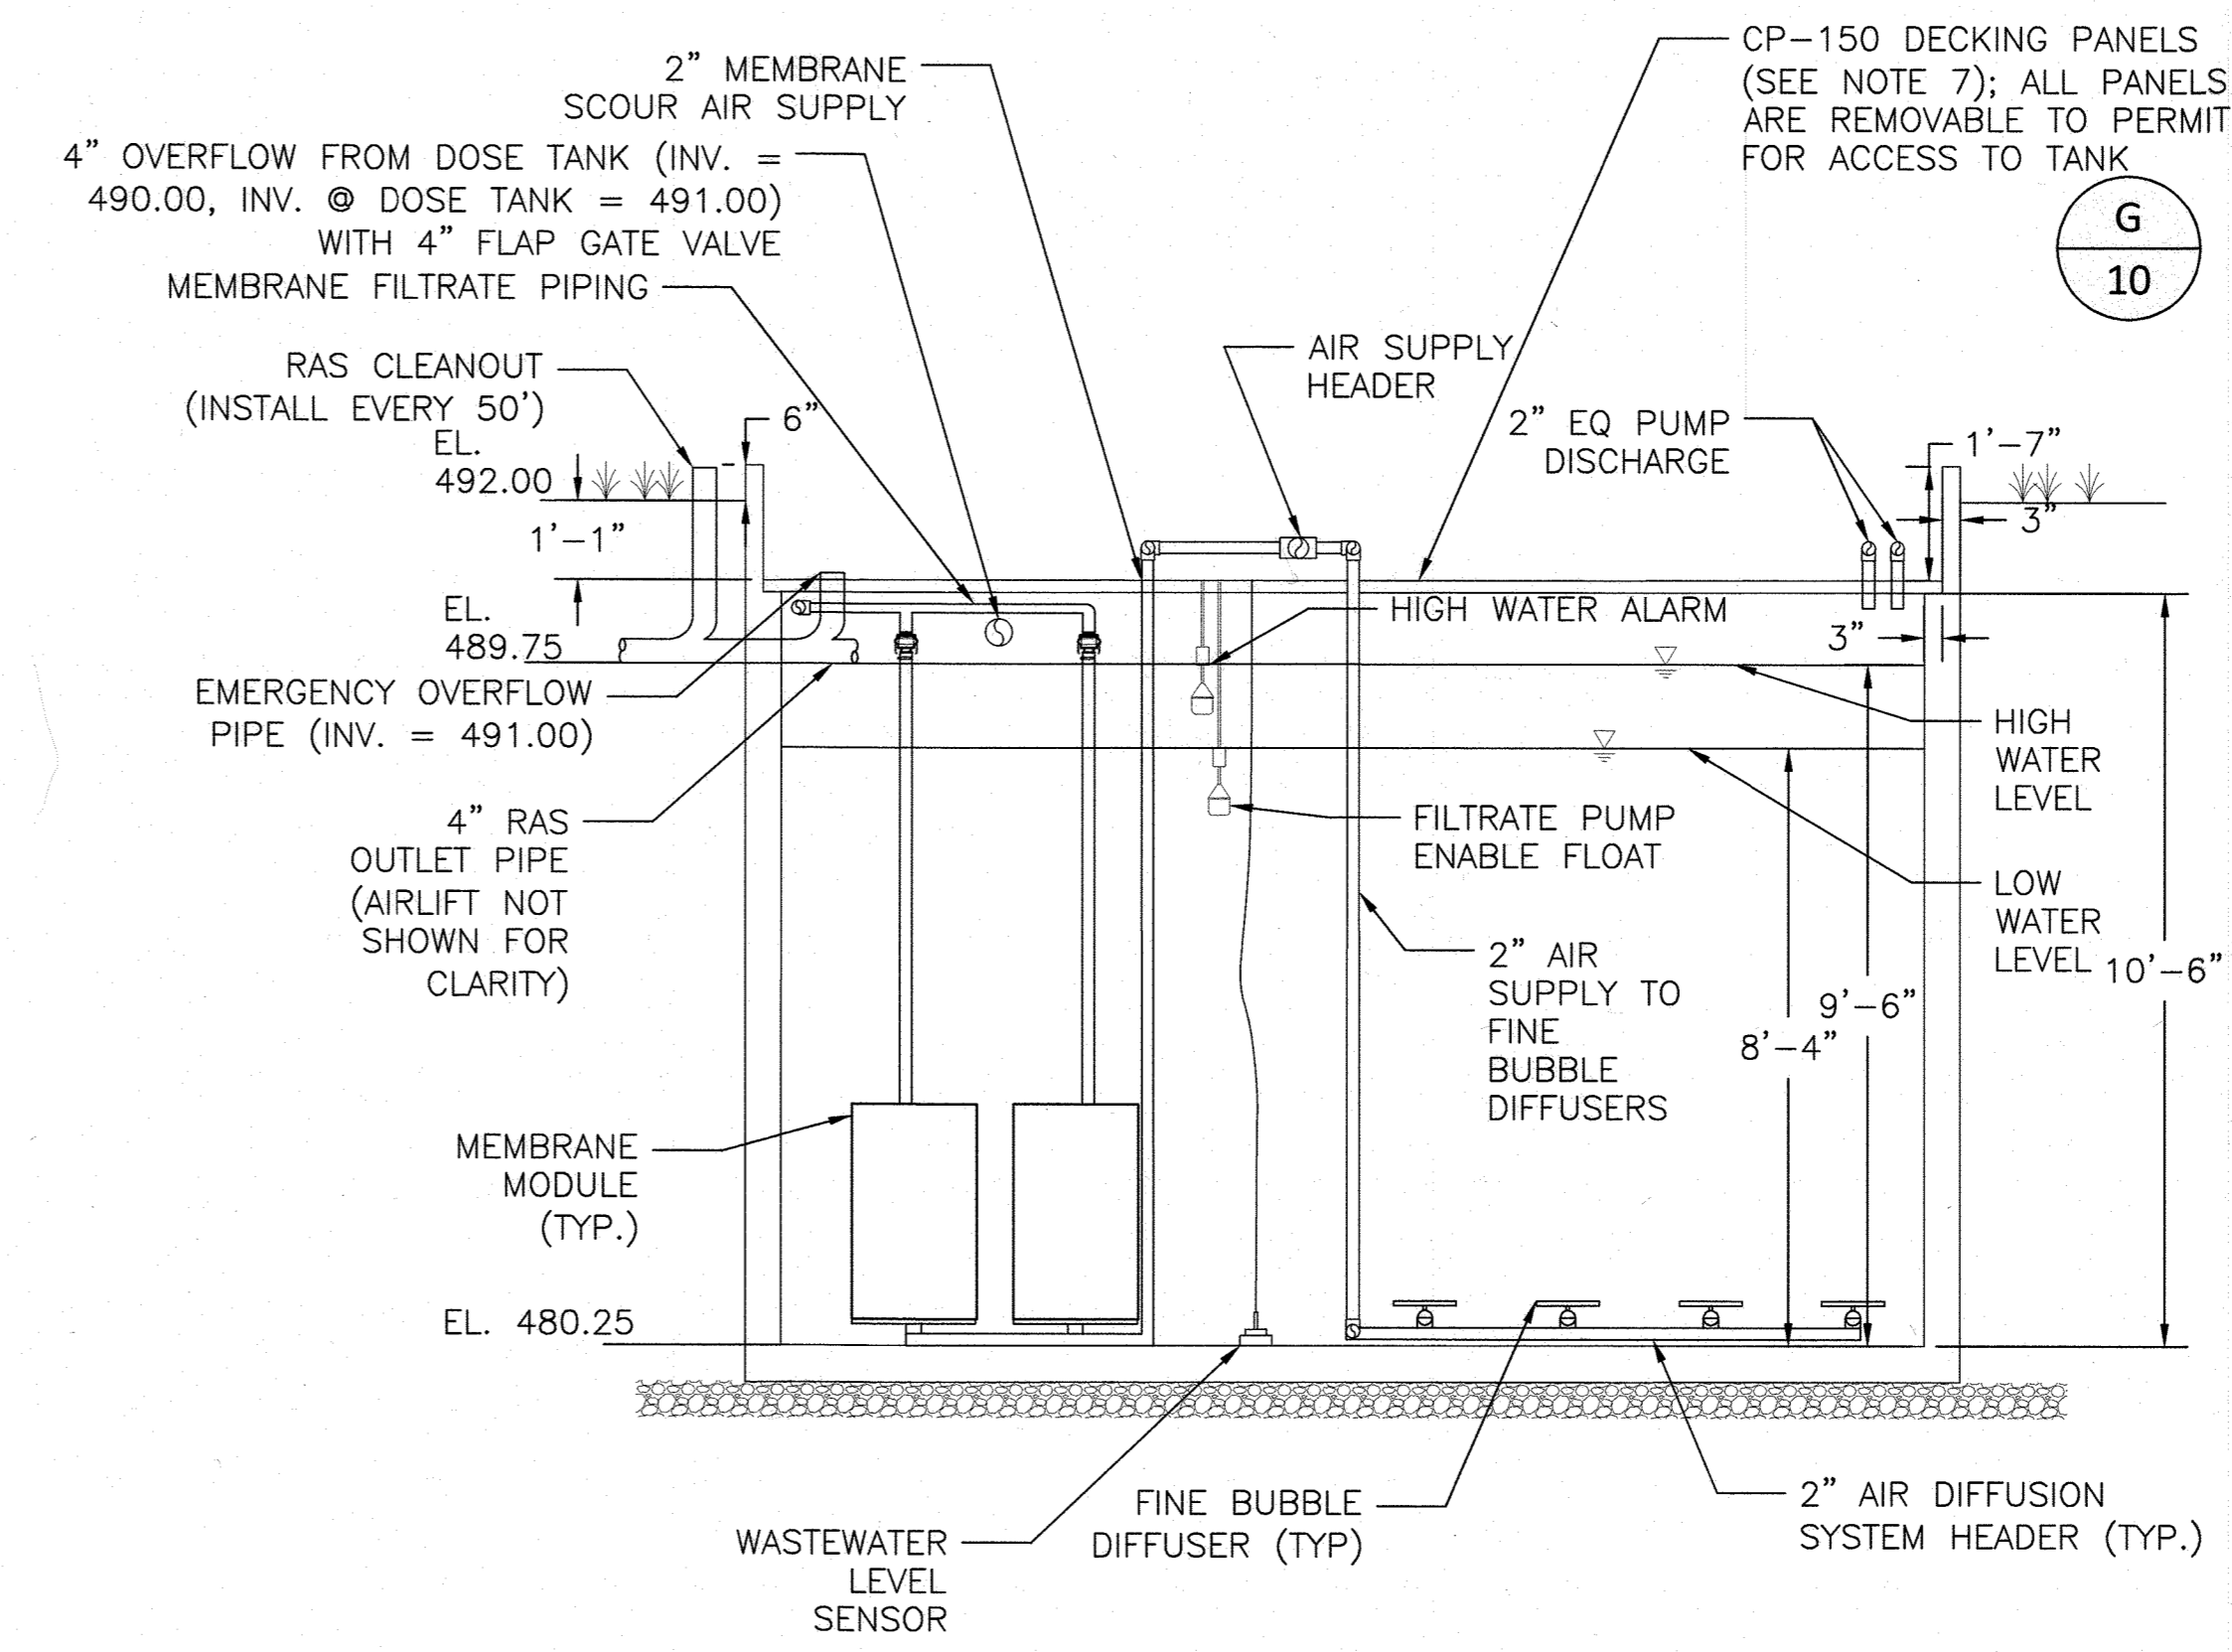


**G**  
10

APPROVED: HOWARD COUNTY DEPARTMENT OF PLANNING AND ZONING  
 CHIEF, DEVELOPMENT ENGINEERING DIVISION DATE 4.5.21  
 CHIEF, DIVISION OF LAND DEVELOPMENT DATE 4/7/21  
 DIRECTOR DATE 4-7-21

APPROVED: FOR PRIVATE WATER AND PRIVATE SEWERAGE SYSTEMS  
 COUNTY HEALTH OFFICER DATE 3/2/2021  
 HOWARD COUNTY HEALTH DEPARTMENT

NO.	REVISION	DATE
1	REVISE THE PLAN TO MODIFY THE EXISTING BUILDING BY ADDING ADDITIONS TO THE NORTHWEST AND SOUTHWEST SIDES OF THE CLUBHOUSE	3-5-21

OWNER/DEVELOPER  
 CATTAIL CREEK COUNTRY CLUB, INC.  
 3600 CATTAIL CREEK DRIVE  
 GLENWOOD, MD 21738  
 PHONE #: 410-489-4653

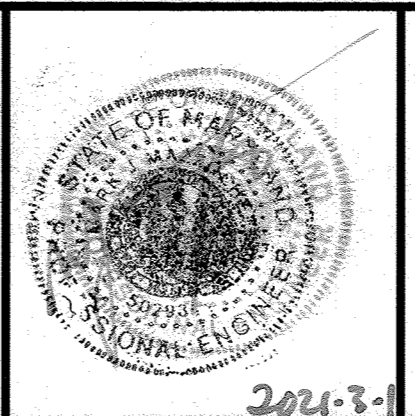


DESIGN BY: M.J.M.  
 DRAWN BY: M.J.M.  
 CHECKED BY: MDH  
 DATE: FEB. 2020  
 SCALE: AS SHOWN

PROFESSIONAL CERTIFICATE  
 I HEREBY CERTIFY THAT THESE DOCUMENTS WERE PREPARED OR APPROVED BY ME, AND THAT I AM A DULY LICENSED PROFESSIONAL ENGINEER UNDER THE LAWS OF THE STATE OF MARYLAND, LICENSE NO. 50223, EXPIRATION DATE: 12-15-2022


REVISED SITE DEVELOPMENT PLAN  
**CATTAIL CREEK COUNTRY CLUB**  
 3600 CATTAIL CREEK DRIVE  
 ZONED: RC-DEO  
 8 SHEET OF 10  
 TAX MAP: 21 GRID: 8  
 4TH ELECTION DISTRICT  
 PARCEL: 211  
 HOWARD COUNTY, MARYLAND

4TH ELECTION DISTRICT HOWARD COUNTY, MARYLAND  
 TAX MAP - 21 GRID - 8 PARCEL - 211



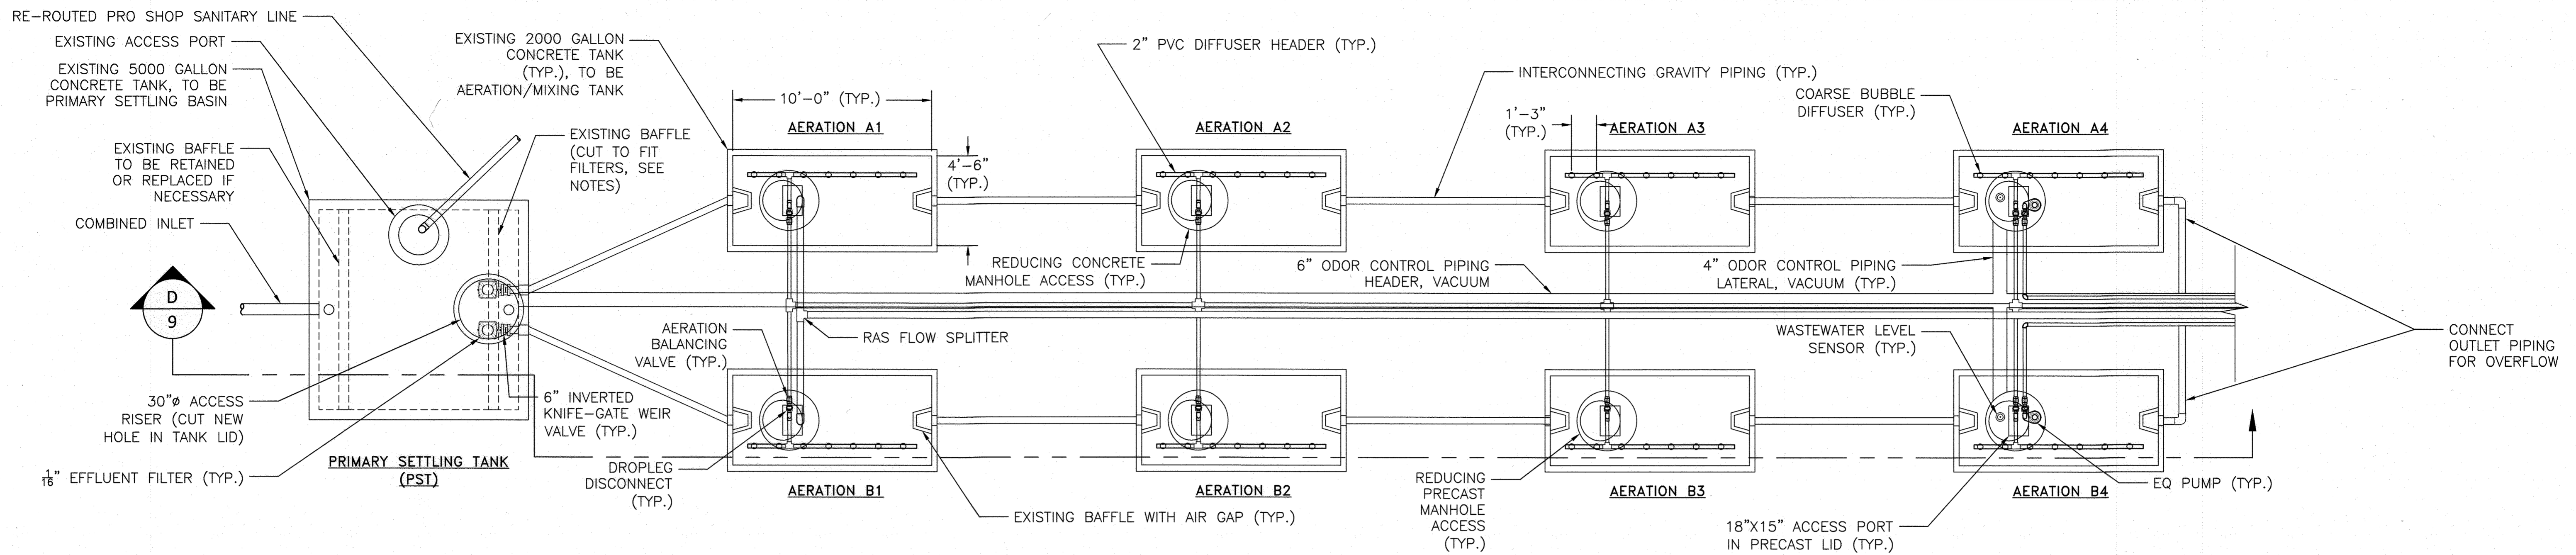

**C**  
**7**  
EXISTING TANK MODIFICATION -  
PLAN  
SCALE: 1" = 1'-0"

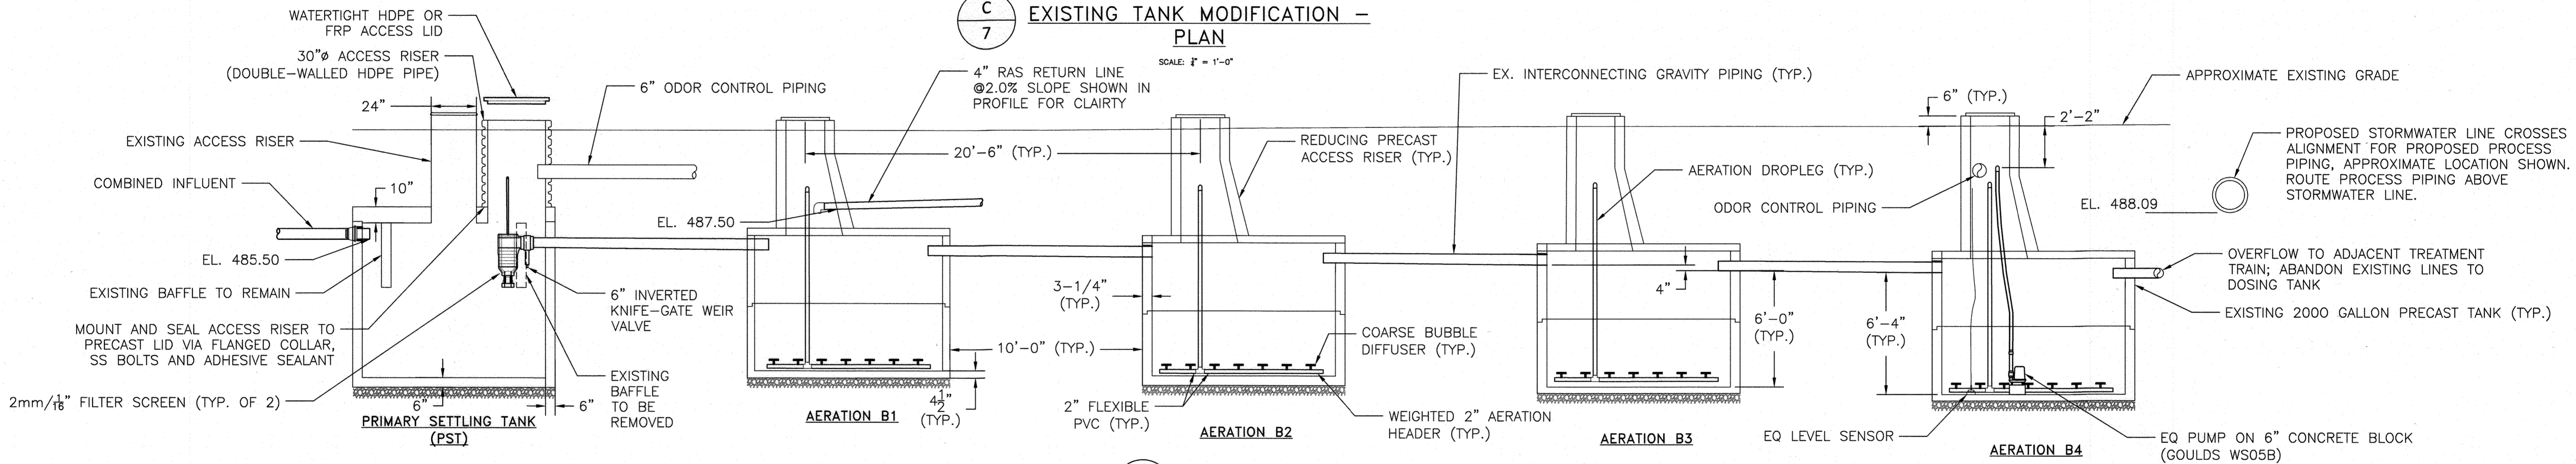

**D**  
**9**  
EXISTING TANK MODIFICATION -  
B TRAIN SECTION  
SCALE: 1" = 1'-0"

**NOTES:**


- All connections of risers and pipes to existing tanks will be sealed. Water-tight testing will be conducted post-installation (24 hr watertight test). Ensure tanks are filled to normal operating levels and cut off flow to tanks via pumping out PST. Record water levels when flow is cut off, and again after 24 hours. Readings will be within 0.5% of each other. Inspect concrete risers and covers for evidence of inflow and infiltration (I&I). Seal all new riser penetrations with watertight sealing methods (e.g. Press-Seal PSX connectors). Spray coat potential leakage areas (e.g. seams between concrete joints) with polyurethane coating.
- All components submerged in wastewater, exposed to wastewater tank headspace, or to the exterior environment (soil or outside air) will be of corrosion resistant construction. Examples of acceptable materials are PVC, HDPE, FRP, stainless steel, concrete and aluminum. Galvanized steel, coated steel, and cast iron components will not be permitted unless specifically noted.
- Pipe penetrations in existing concrete walls and access risers will be via core-drilled holes and sealed. Pipe penetrations through plastic access risers will be sealed with polyurethane expanding foam and marine adhesive sealant.
- Coarse bubble diffusers will be Hydro-Aerobic Hydro-Ceal HA-75 diffusers with 3/4" NPT(M) connection and will be installed with a PVC 3/4" insertion bushing that is secured to the 2" air head via compression and solvent weld.
- Flow will be split evenly between the A and B aeration trains via adjustable balancing weirs in the PST. Adjustability will be accomplished with rising stem extension via FRP and stainless steel threaded mounts.
- Odor control piping will be schedule 40 PVC pipe. Connections will be water- and air-tight.
- The services of both Miss Utility and private utilities locator(s) will be employed to determine utilities conflicts with proposed infrastructure. It will be the responsibility of the Contractor to identify all existing utilities in the vicinity of the proposed improvements, make all reasonable efforts to avoid contact with them during installation, and repair at their own expense any damaged utilities.
- A-train aeration section is mirror image of B-train section.
- Filter screen will be 1/8" filtration size Polylok PL-525 filter. Baffle will be removed via confined space entry utilizing OSHA-approved techniques.
- No tank lid will be removed to construct the improvements specified herein. Coarse bubble aeration components will be installed with flexible plumbing sections and weighted ends for entry-free installation.

APPROVED: HOWARD COUNTY DEPARTMENT OF PLANNING AND ZONING  
 [Signature] 4-5-21  
 CHIEF, DEVELOPMENT ENGINEERING DIVISION DATE  
 [Signature] 4/7/21  
 CHIEF, DIVISION OF LAND DEVELOPMENT DATE  
 [Signature] 4-7-21  
 DIRECTOR DATE

APPROVED: FOR PRIVATE WATER AND PRIVATE SEWERAGE SYSTEMS  
 [Signature] 3/19/21  
 COUNTY HEALTH OFFICER DATE  
 HOWARD COUNTY HEALTH DEPARTMENT

NO.	REVISION	DATE
1	REVISE THE PLAN TO MODIFY THE EXISTING BUILDING BY ADDING ADDITIONS TO THE NORTHWEST AND SOUTHWEST SIDES OF THE CLUBHOUSE	3-5-21

OWNER/DEVELOPER  
 CATTAIL CREEK COUNTRY CLUB, INC.  
 3600 CATTAIL CREEK DRIVE  
 GLENWOOD, MD 21738  
 PHONE #: 410-489-4653

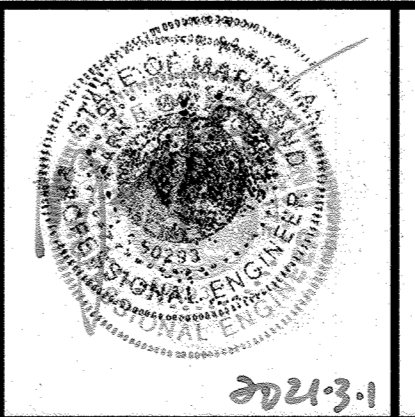


DESIGN BY: M.J.M.  
 DRAWN BY: M.J.M.  
 CHECKED BY: MDH  
 DATE: FEB. 2020  
 SCALE: AS SHOWN

PROFESSIONAL CERTIFICATE  
 I HEREBY CERTIFY THAT THESE DOCUMENTS WERE PREPARED OR APPROVED BY ME, AND THAT I AM A DULY LICENSED PROFESSIONAL ENGINEER UNDER THE LAWS OF THE STATE OF MARYLAND, LICENSE NO. 50293  
 EXPIRATION DATE: 12-15-2022

REVISED SITE DEVELOPMENT PLAN  
**CATTAIL CREEK COUNTRY CLUB**  
 3600 CATTAIL CREEK DRIVE  
 ZONED: RC-DEO  
 9 SHEET OF 10  
 TAX MAP: 21 GRID: 8  
 4TH ELECTION DISTRICT  
 PARCEL: 211  
 HOWARD COUNTY, MARYLAND  
 SDP-96-015

Copyright 2021 Hydro-Terra Group, Inc. The contents of this plan are proprietary and shall not be copied, reproduced, transmitted or utilized in any way without written authorization from Hydro-Terra Group. Only approved, signed and sealed plans shall be used for construction.



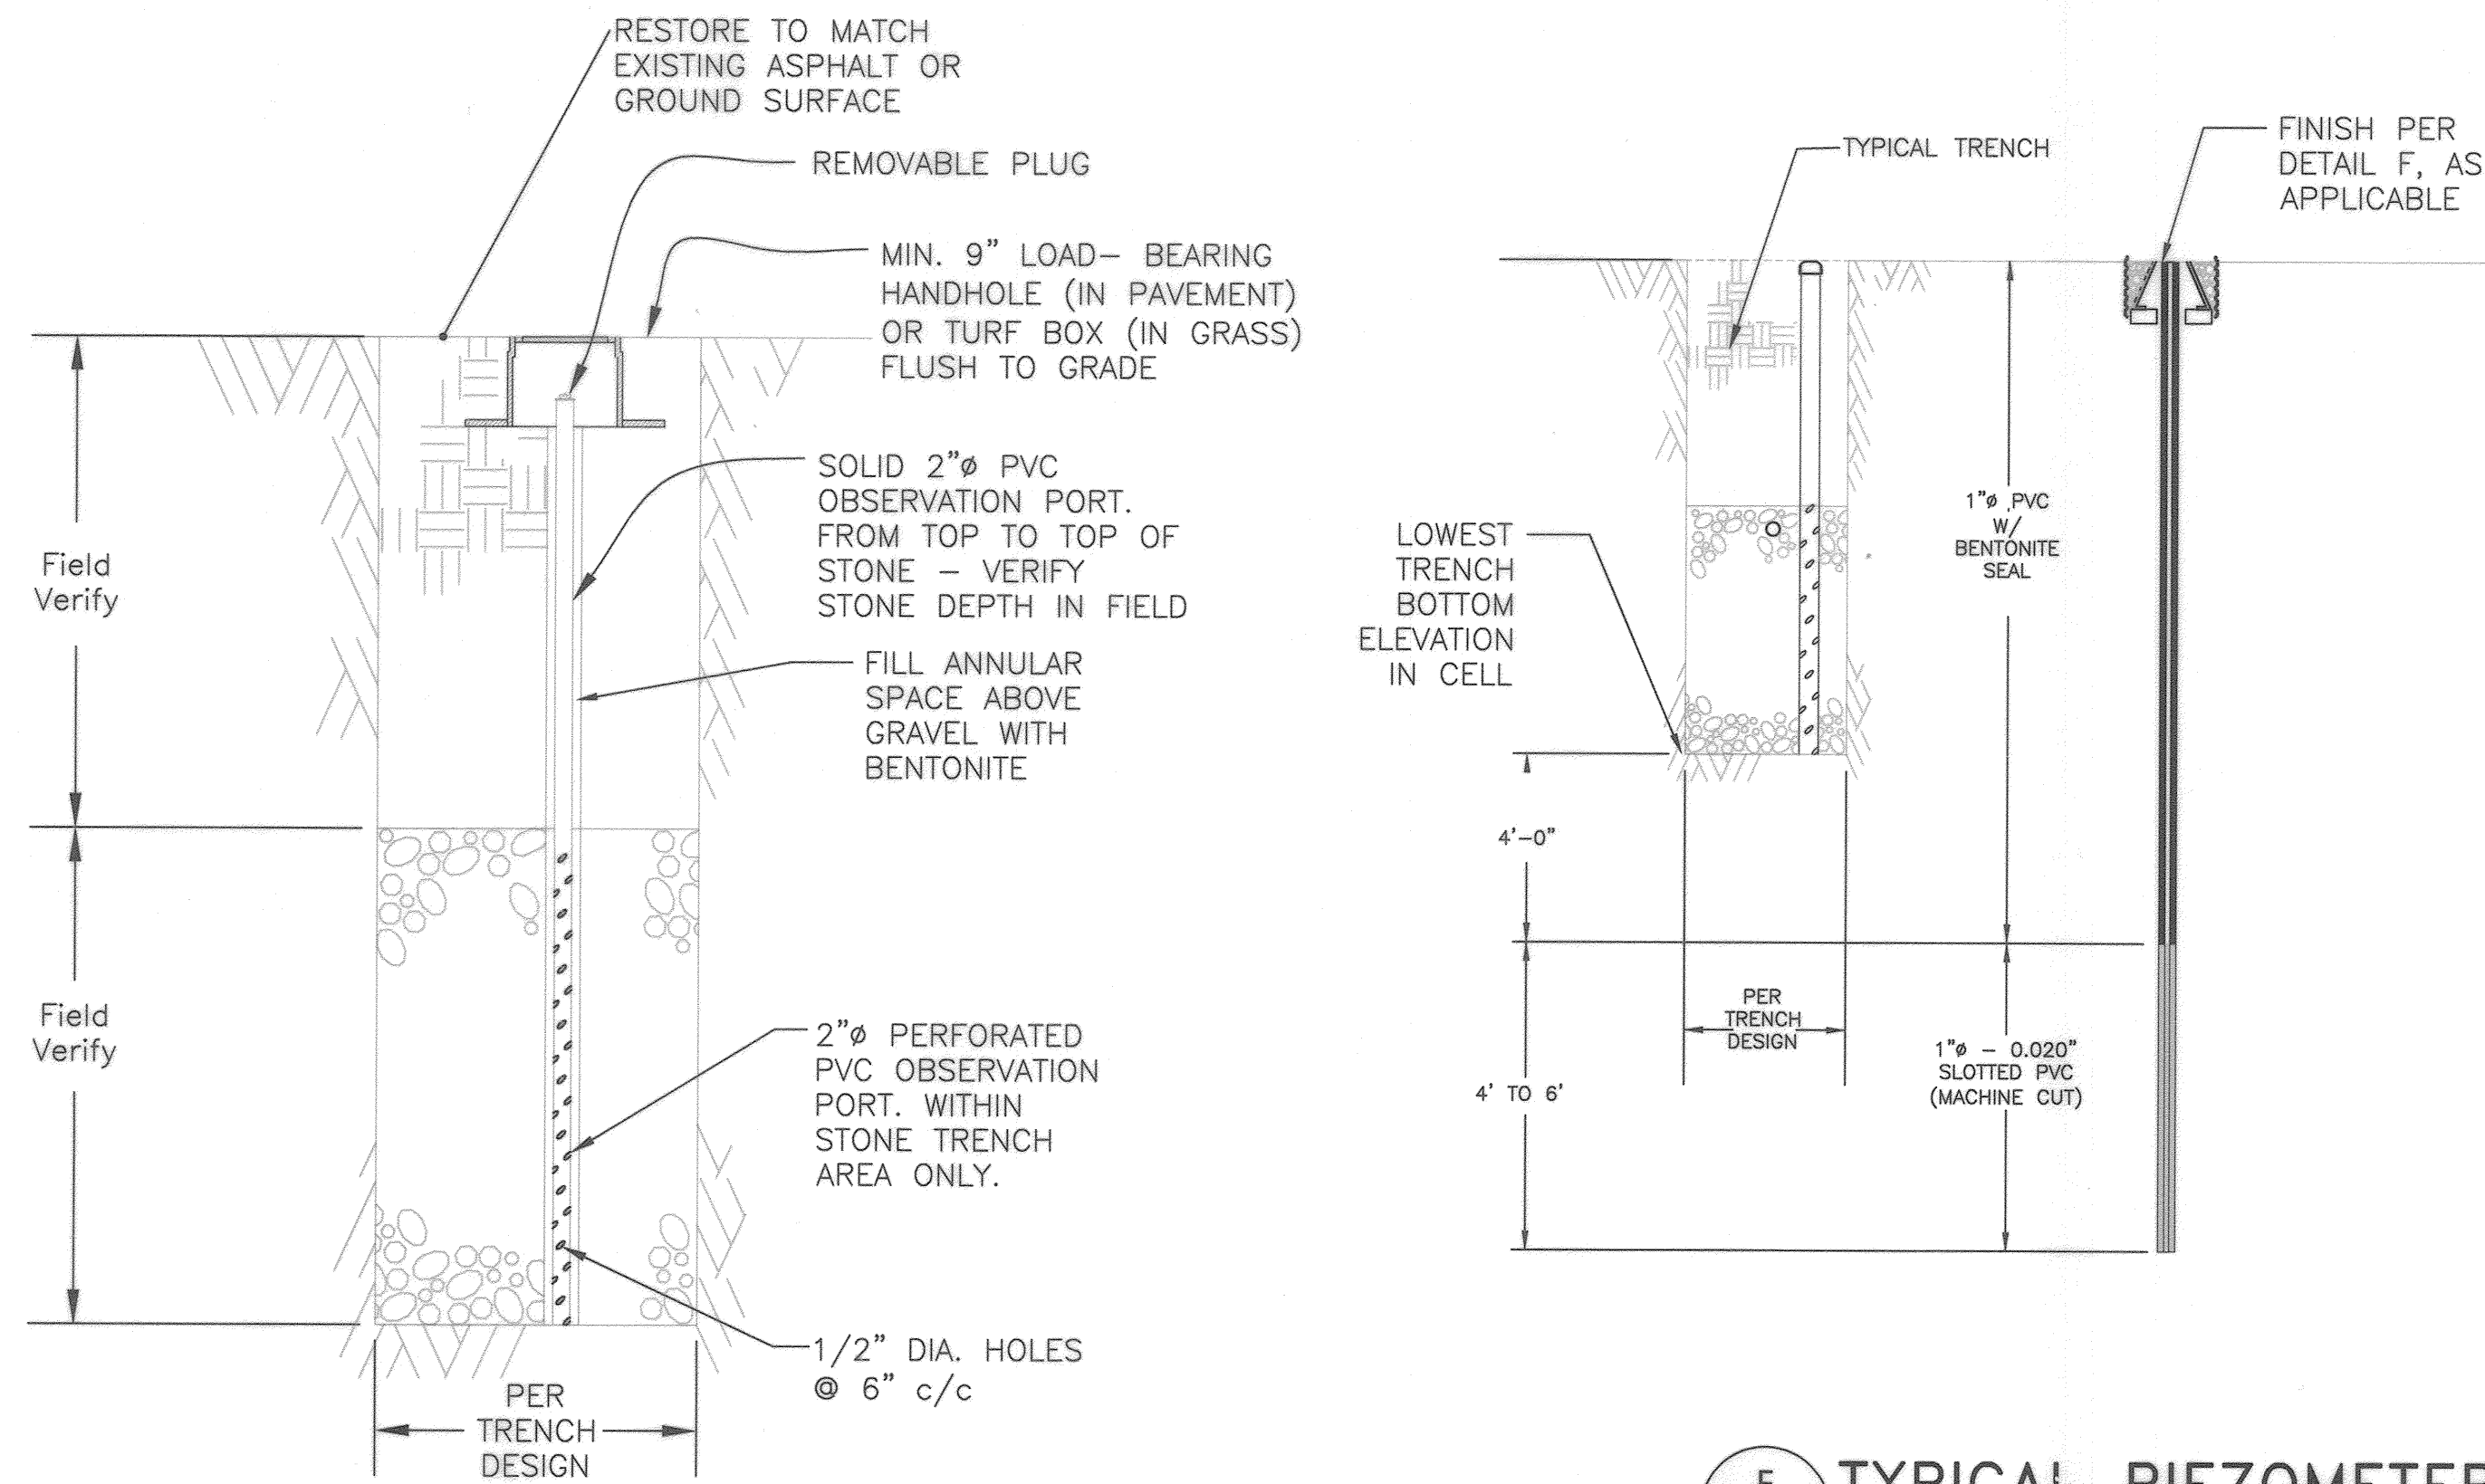

**OBSERVATION PORT/LATERAL TURNUP - UNDER PAVEMENT**

**TYPICAL PIEZOMETER**

**Cattail Creek Country Club Wastewater System Rehab**

**Membrane Bioreactor (MBR) Design**

Overall Site Water Use (total = 11,150 gpd)

Location	MDE (gpd)
*Clubhouse and Pro Shop	7500
Pool House	2750
Maintenance Shop	500
Halfway House	400

**\*Flow Processed by Proposed Treatment System Upgrade**

Parameter	Value
Maximum daily design flow	7,500 gpd
Maximum design flow to drainfield	7,500 gpd
Recirculation percentage	500 %
Equalized Flow (EF) with recirculation	45,000 gpd
	31.3 gpm

**Raw wastewater characteristics:**

Parameter	Value
BOD	800 mg/L
TSS	500 mg/L
TN	120 mg/L
FOG (post-grease trap)	<40 mg/L

**Design effluent wastewater characteristics:**

Parameter	Value
BOD	30 mg/L
TSS	30 mg/L
TN	10 mg/L

**Treatment Stage Specifications**

Parameter	PST	Anox	Aer1-4	MBR	Dose (dia.)	unit
Length	10.00	10.00	10.00	16.00	---	ft
Width	10.00	4.5	4.5	8	8	ft
Outlet Ht.	6.30	6.00	6.00	9.50	8.70	ft
# tanks	1	4	4	1	1	
Volume	4712	8078	8078	9096	3271	gal
Specific Capacity	62.33	112.20	112.20	79.79	31.33	gal/inch
Air Req'd		131		147		CFM
Pressure		79.2		118.8		inch H2O
Total length	40	40				ft
Diffuser Spacing	15	15				inch, C-C
Diffuser count	32	32		32		
CFM/diffuser		2.04		4.60		CFM

**Treatment System Parameters**

Parameter	Value	Value	Value
PST retention time	0.63 day	Total aeration req'd	278 cfm
Aerobic process retention time	4.31 hr	max water column	65 in H2O
Anoxic process retention time	4.31 hr	Blower (Atlantic)	AB-301
tank volume req'd for membranes (per M&E)	0.025 m <sup>3</sup> /m <sup>2</sup>	Total membrane area	1920 m <sup>2</sup>
Surface area per membrane cartridge	120 m <sup>2</sup>	Aer. vol. provided	17,174 gal
# cartridges	16	membrane tank vol.	48 m <sup>3</sup>
			12680.3 gal
			10 g/L
			18.4 day
			25.15 kg/day
			12 kg/m <sup>3</sup>
			48 m <sup>3</sup>
			12 kg/m <sup>3</sup>
			38.56 m <sup>3</sup>
			3 m <sup>3</sup> /day
			28.85 day
			0.5 gpm
			8 gpm
			9,600 gpd
			31.25 gpm
			2.067 in (2")
			72 ft
			12.4 ft
			18.12 ft
			WE03
			12 in
			250.30
			40
			WS05BHf
			31.25 gpm
			2.067 in (2")
			72 ft
			12.4 ft
			18.12 ft
			WE03
			12 in
			250.30
			40
			WS05BHf
			31.25 gpm
			2.067 in (2")
			72 ft
			12.4 ft
			18.12 ft
			WE03
			12 in
			250.30
			40
			WS05BHf
			31.25 gpm
			2.067 in (2")
			72 ft
			12.4 ft
			18.12 ft
			WE03
			12 in
			250.30
			40
			WS05BHf
			31.25 gpm
			2.067 in (2")
			72 ft
			12.4 ft
			18.12 ft
			WE03
			12 in
			250.30
			40
			WS05BHf
			31.25 gpm
			2.067 in (2")
			72 ft
			12.4 ft