



\ 080.40\ \0\max\ <000

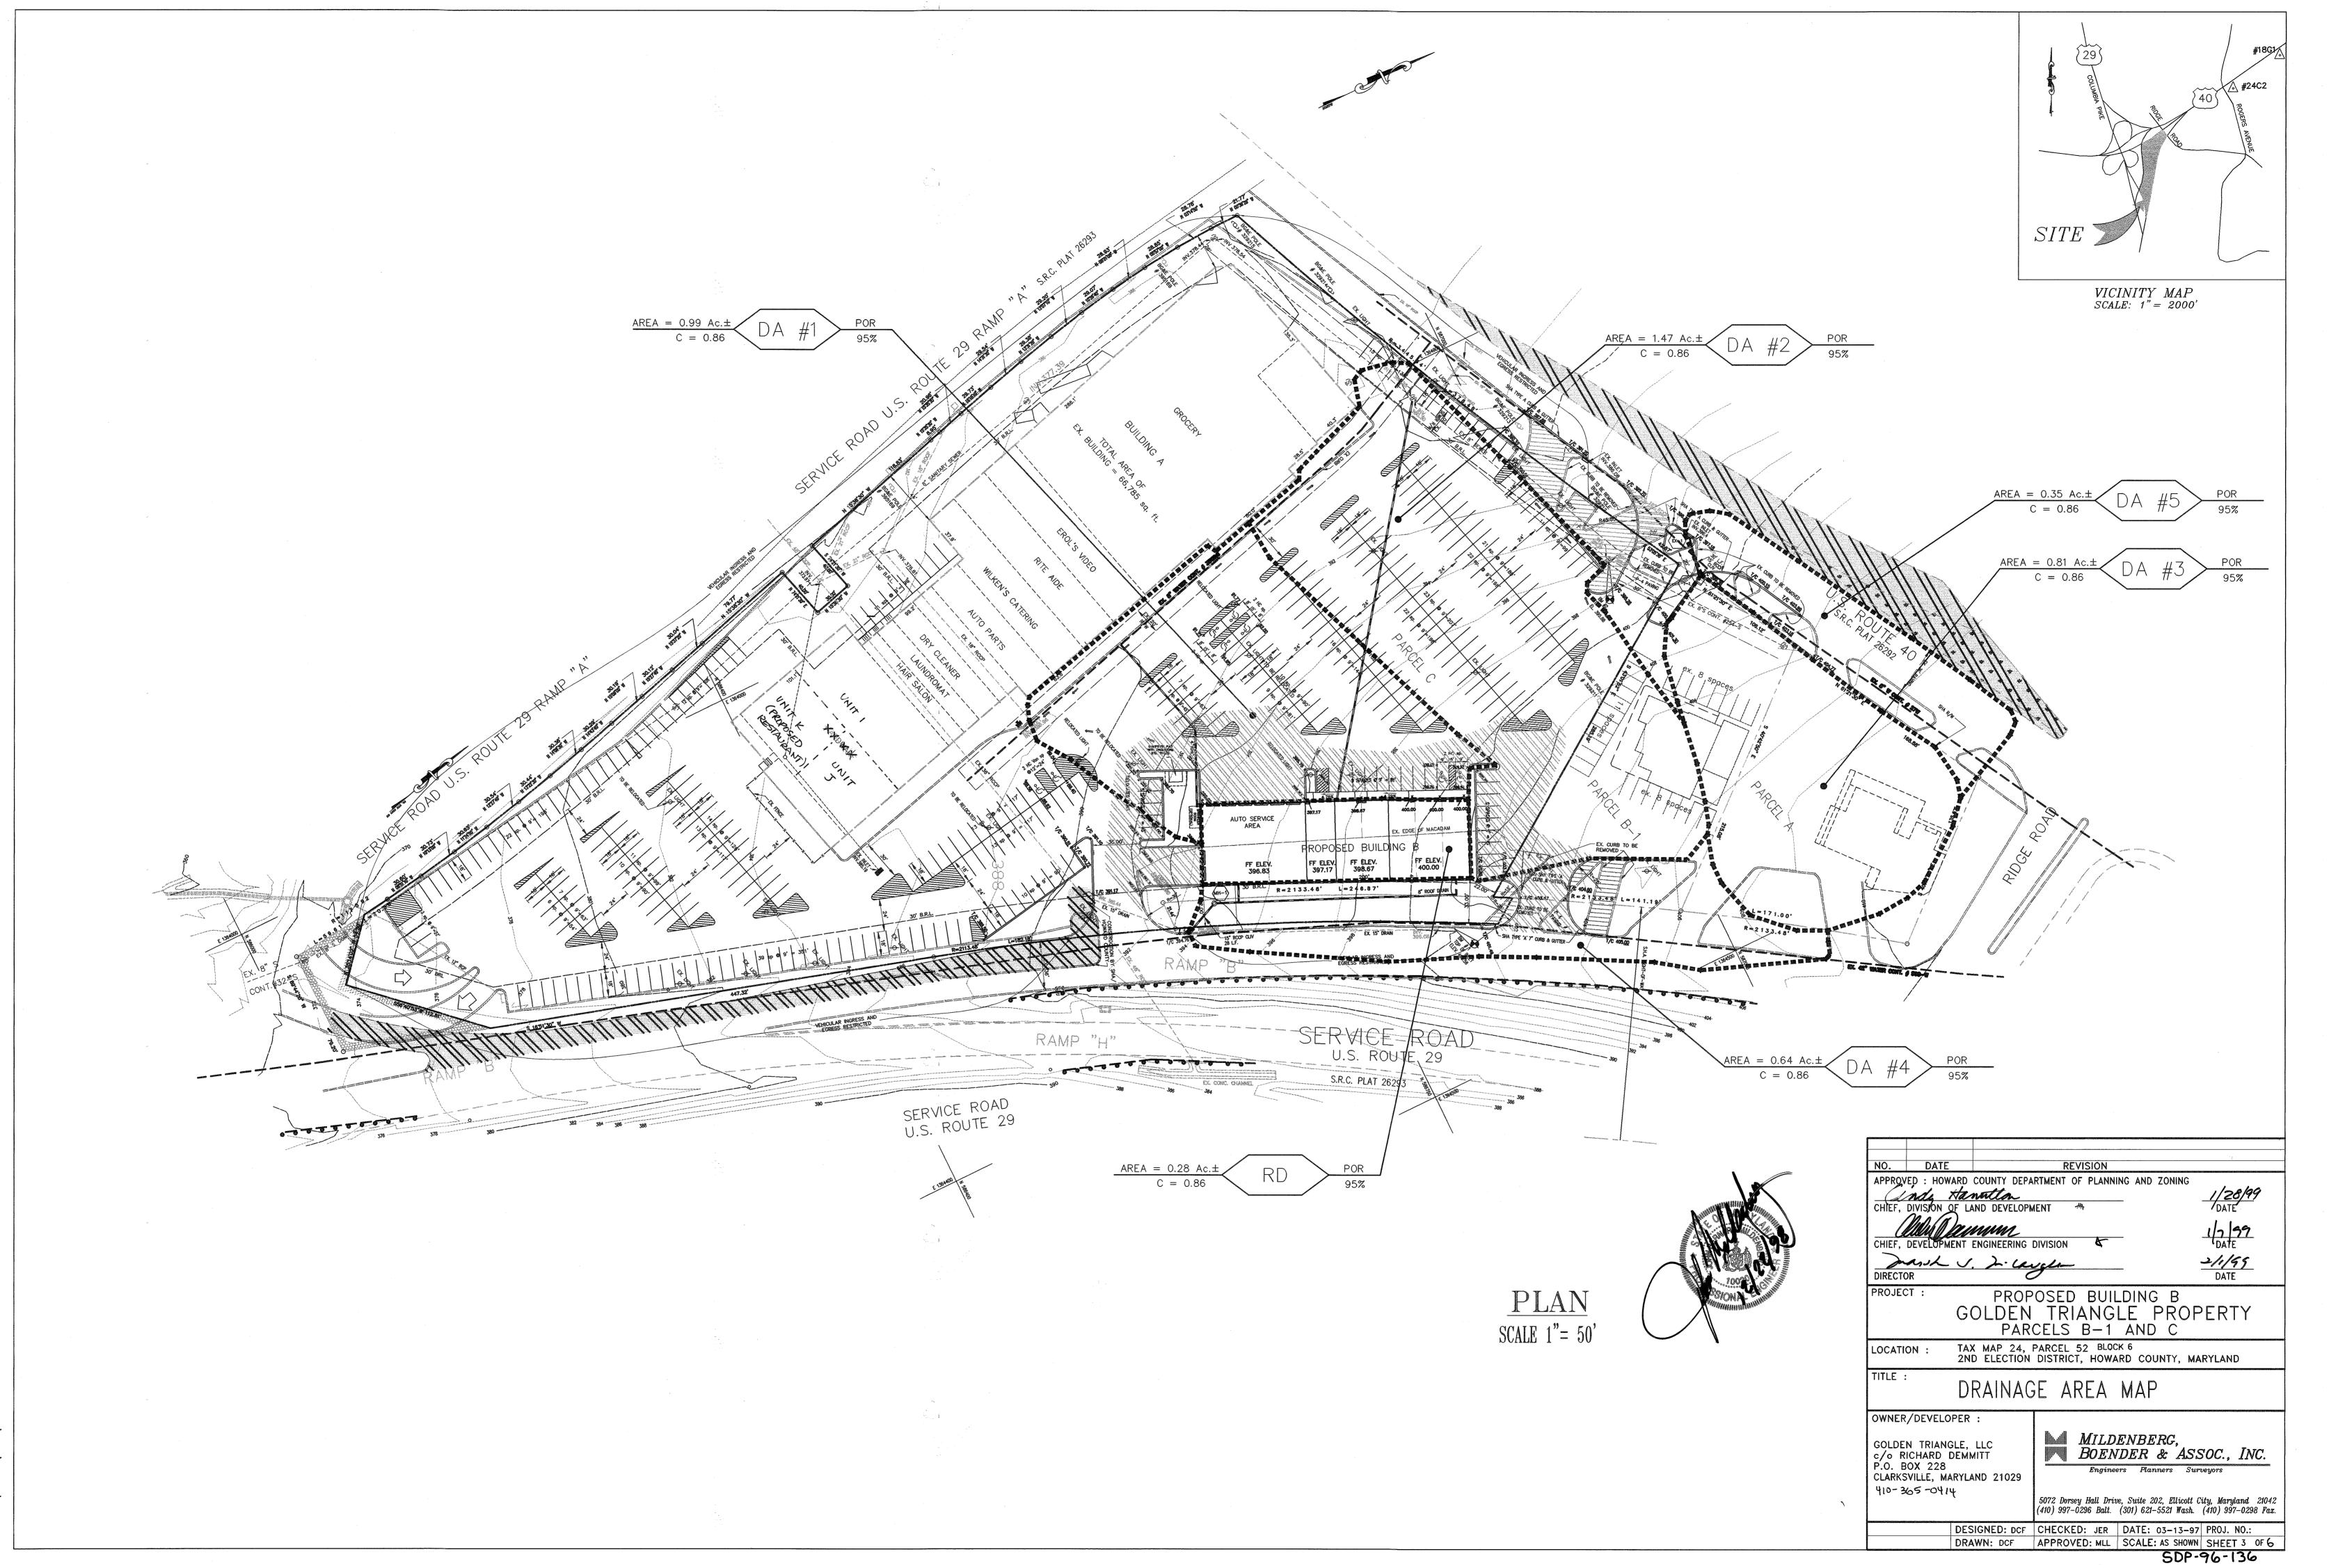

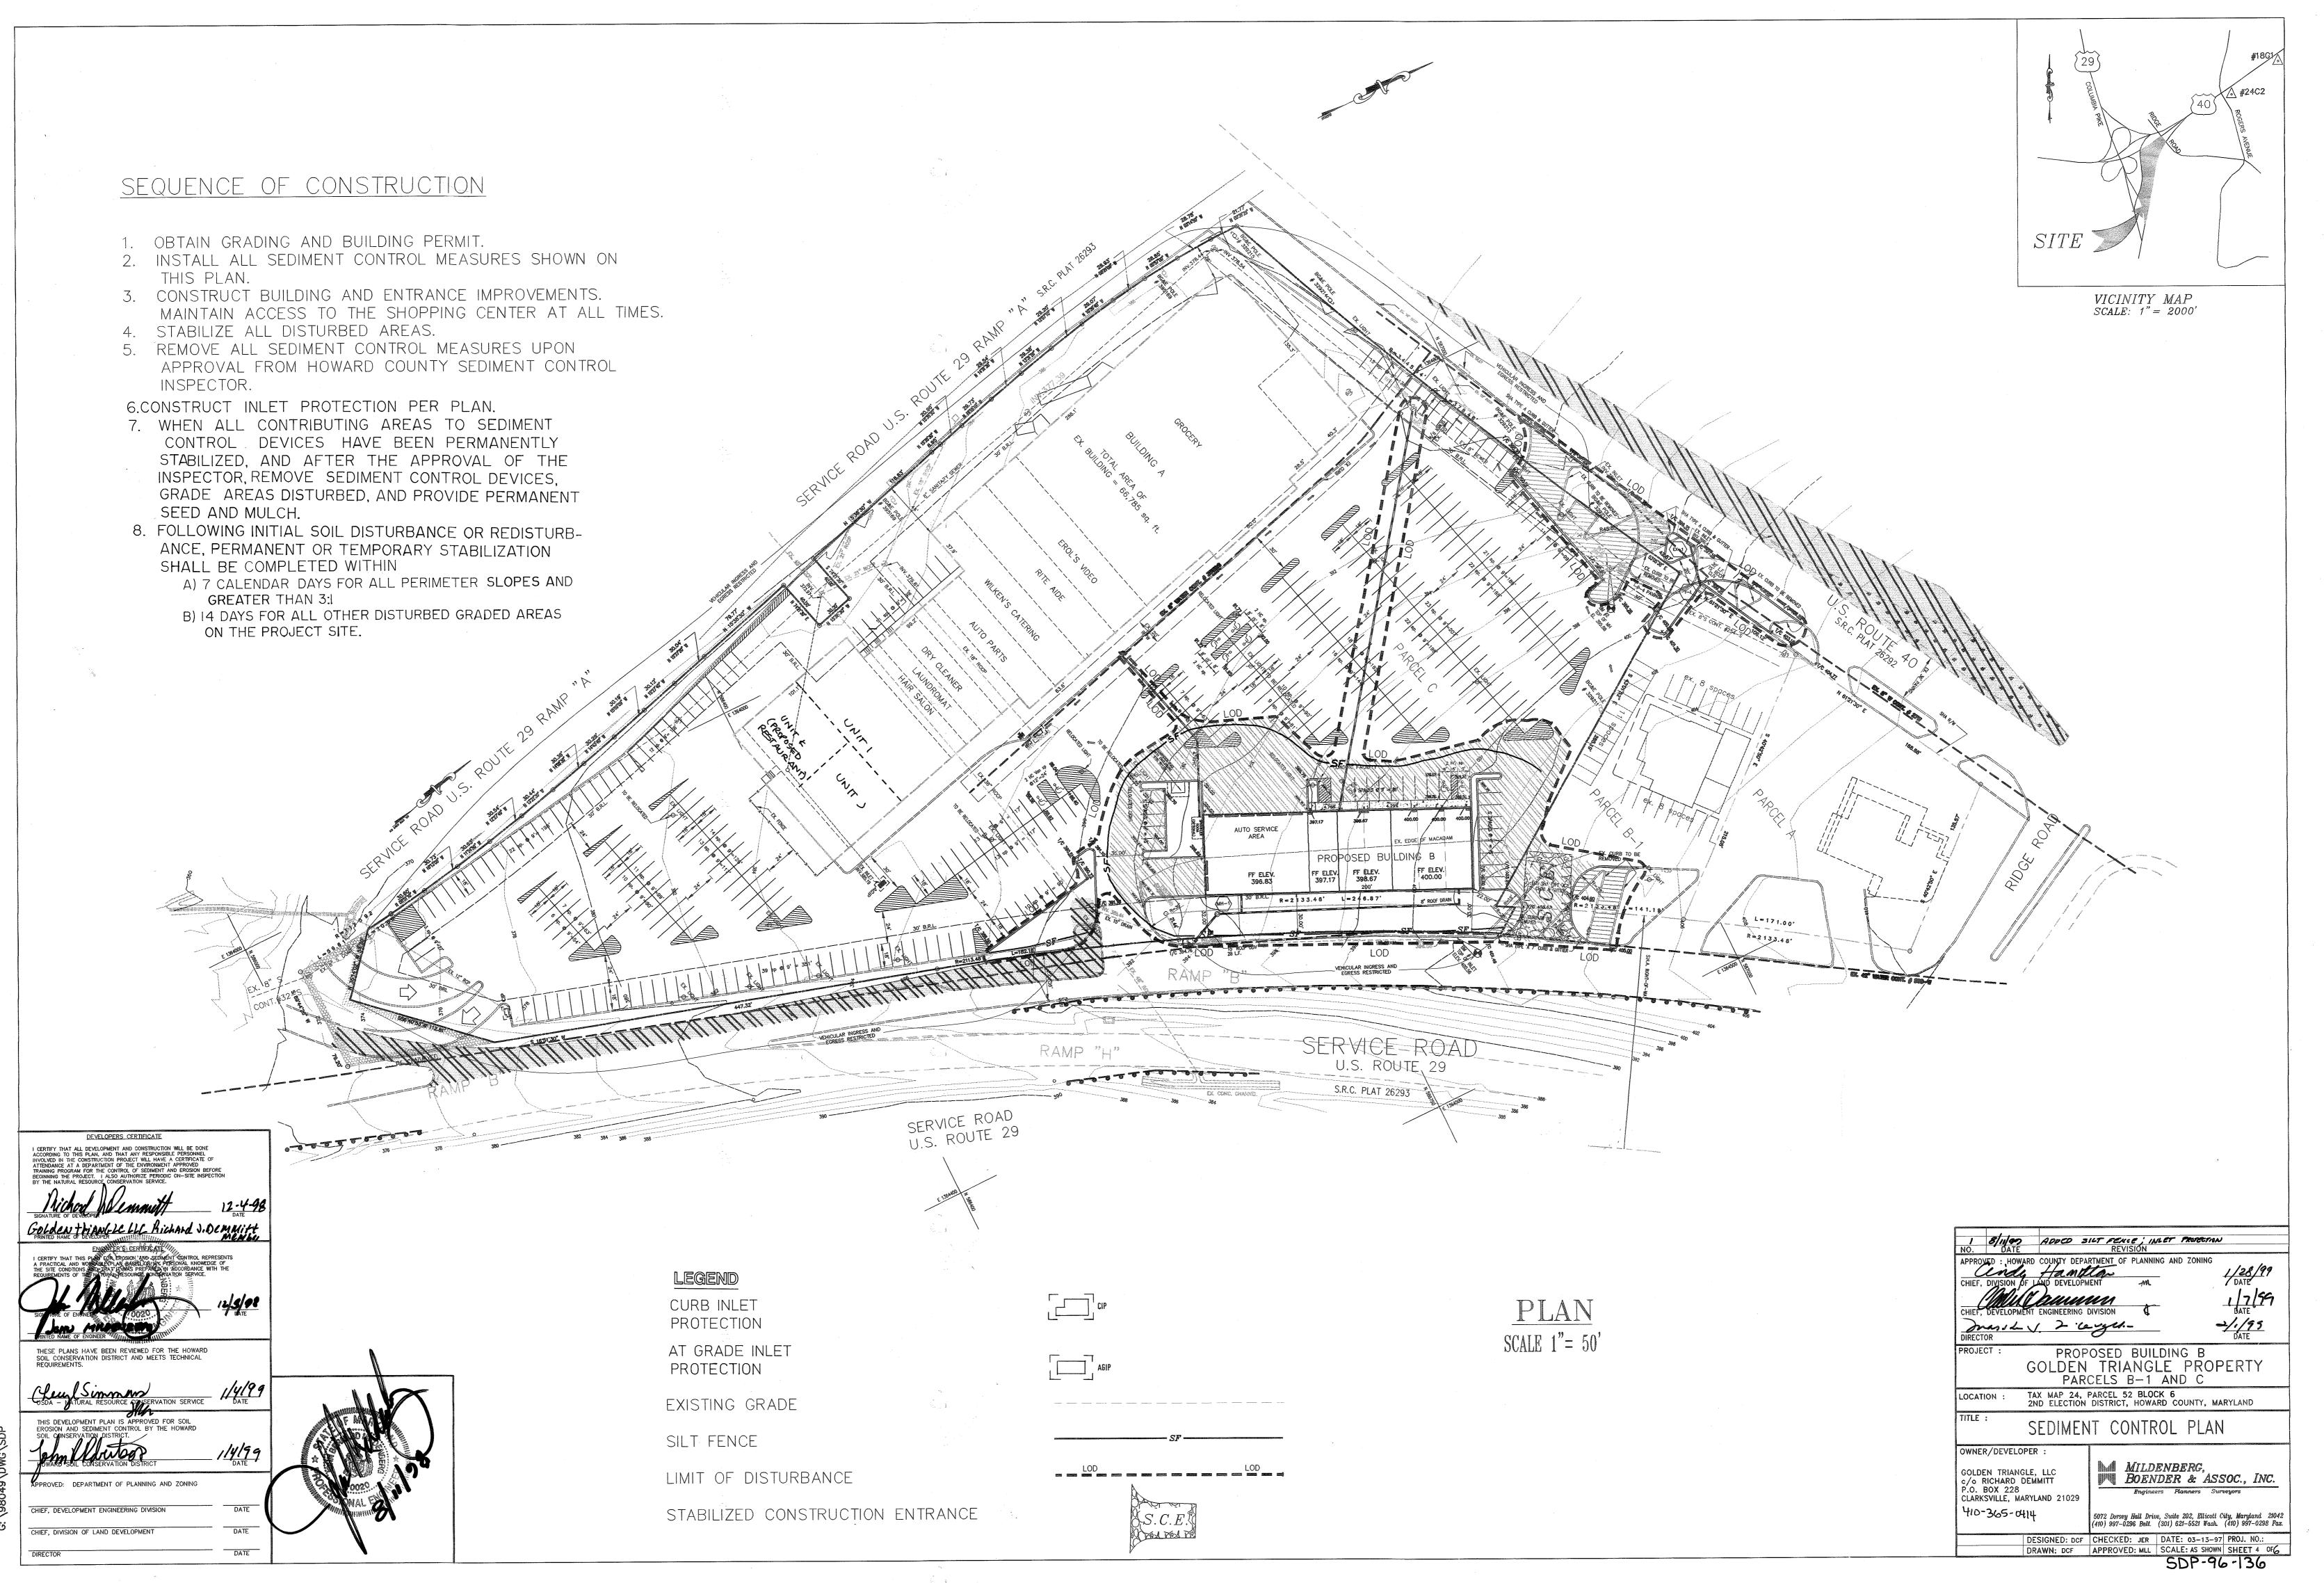

HOWARD SOIL CONSERVATION DISTRICT

PERMANENT SEEDING NOTES

APPLY TO GRADED OR CLEARED AREAS NOT SUBJECT TO IMMEDIATE FURTHER DISTURBANCE WHERE A PERMANENT LONG-LIVED VEGETATIVE COVER IS NEEDED.

SEEDBED PREPARATION: LOOSEN UPPER THREE INCHES OF SOIL BY RAKING, DISKING OR OTHER ACCEPTABLE MEANS BEFORE SEEDING, IF NOT PREVIOUSLY LOOSENED.

SOIL AMENDMENTS: IN LIEU OF SOIL TEST RECOMMENDATIONS, USE ONE OF THE FOLLOWING SCHEDULES: PREFERRED - APPLY 2 TONS PER ACRES DOLOMITIC LIMESTONE (92 LBS/1000 SQ.FT.) AND 600 LBS. PER ACRE 10-10-10 FERTILIZER (14 LBS/1000 SQ.FT.) BEFORE SEEDING. HARROW OR DISK INTO UPPER THREE INCHES OF SOIL. AT TIME OF SEEDING, APPLY 400 LBS. PER ACRE 30-0-0 UREAFORM FERTILIZER (9 LBS./1000 SQ.FT.). ACCEPTABLE - APPLY 2 TONS PER ACRE DOLOMITIC LIMESTONE (92 LBS./1000 SQ.FT.) AND 1000 LBS. PER ACRE 10-10-10 FERTILIZER (23 LBS./1000 SQ.FT.) BEFORE SEEDING. HARROW OR DISK INTO UPPER THREE INCHES OF SOIL.

SEEDING - FOR THE PERIODS MARCH 1 THRU APRIL 30, AND AUGUST 1 THRU OCTOBER 15, SEED WITH 60 LBS. PER ACRE 1.4 LBS/1000 SQ.FT.) OF KENTUCKY 31 TALL FESCUE. FOR THE PERIOD MAY 1 THRU JULY 31, SEED WITH 60 LBS. KENTUCKY 31 TALL FESCUE PER ACRE AND 2 LOBS. PER ACRE (.05 LBS./1000 SQ.FT.) OF WEEPING LOVEGRASS. DURING THE PERIOD OF OCTOBER 16 THRU FEBRUARY 28, PROTECT SITE BY: OPTION (1) - 2 TONS PER ACRE OF WELL ANCHORED STRAW MULCH AND SEED AS SOON AS POSSIBLE IN THE SPRING. OPTION (2) - USE SOD. OPTION (3) -SEED WITH 60 LBS./ACRE KENTUCKY 31 TALL FESCUE AND MULCH WITH 2 TONE/ACRE WELL ANCHORED STRAW.

MULCHING - APPLY 1-1/2 TO 2 TONS PER ACRE (70 TO 90 LBS./1000 SQ.FT) OF UNROTTED SMALL GRAIN STRAW IMMEDIATELY AFTER SEEDING. ANCHOR MULCH IMMEDIATELY AFTER APPLICATION USING MULCH ANCHORING TOOL OR 218 GALLONS PER ACRE (5 GAL/1000 SQ.FT.) OF EMULSIFIED ASPHALT ON FLAT AREAS. ON SLOPES 8 FEET OR HIGHER, USE 348 GALLONS PER ACRE (8 GAL/1000 SQ.FT.) FOR ANCHORING.

MAINTENANCE - INSPECT ALL SEEDING AREAS AND MAKE NEEDED REPAIRS, REPLACEMENTS AND RESEEDINGS.

TEMPORARY SEEDING NOTES

APPLY TO GRADED OR CLEARED AREAS LIKELY TO BE REDISTURBED WHERE A SHORT-TERM VEGETATIVE COVER IS NEEDED SEEDBED PREPARATION: LOOSEN UPPER THREE INCHES OF SOIL BY RAKING, DISKING OR OTHER ACCEPTABLE MEANS BEFORE SEEDING, FOR NOT PREVIOUSLY LOOSENED.

SOIL AMENDMENTS: APPLY 600 LBS. PER ACRE 10-10-10 FERTILIZER (14 LBS./1000 SQ.FT.)

SEEDING: FOR PERIODS MARCH 1 THRU APRIL 30 AND FROM AUGUST 15 THRU OCTOBER 15, SEED WITH 2-1/2 BUSHEL PER ACRE OF ANNUAL RYE (3.2 LBS./1000 SQ.FT.) FOR THE PERIOD MAY 1 THRU AUGUST 14, SEED WITH 3 LBS. PER ACRE OF WEEPING LOVEGRASS (.07 LBS./1000 SQ.FT.). FOR THE PERIOD NOVEMBER 16 THRU NOVEMBER 28, PROTECT SITE BY APPLYING 2 TONS PER ACRÉ OF WELL ANCHORED STRAW MULCH AND SEED AS SOON AS POSSIBLE

MULCHING: APPLY 1-1/2 TO 2 TONS PER ACRE (70 TO 90 LBS./1000 SQ.FT.) OF UNROTTED WEED FREE SMALL GRAIN STRAW IMMEDIATELY AFTER SEEDING. ANCHOR MULCH IMMEDIATELY AFTER APPLICATION USING MULCH ANCHORING TOOL OR 218 GAL PER ACRE (5 GAL/1000 SQ.FT.) OF EMULSIFIED ASPHALT ON FLAT AREAS. ON SLOPES 8 FEET OR HIGHER, USE 348 GAL PER ACRE (8 GAL/1000 SQ.FT.) FOR ANCHORING.

REFER TO THE 1983 MARYLAND STANDARDS AND SPECIFICATIONS FOR SOIL EROSION AND SEDIMENT CONTROL FOR ADDITIONAL RATES AND METHODS NOT COVERED.

HOWARD SOIL CONSERVATION DISTRICT STANDARD SEDIMENT CONTROL NOTES

- 1) A MINIMUM OF 48 HOURS NOTICE MUST BE GIVEN TO THE HOWARD COUNTY DEPARTMENT OF INSPECTIONS, LICENSES AND PERMITS, SEDIMENT CONTROL DIVISION PRIOR TO THE START OF NAY
- 2) ALL VEGETATIVE AND STRUCTURAL PRACTICES ARE TO BE INSTALLED ACCORDING TO THE PROVISIONS OF THIS PLAN AND ARE TO BE IN CONFORMANCE WITH THE MOST CURRENT "MARYLAND STANDARDS AND SPECIFICATIONS FOR SOIL EROSION AND SEDIMENT CONTROL", AND REVISIONS THERETO.
- 3) FOLLOWING INITIAL SOIL DISTURBANCE OR REDISTURBANCE, PERMANENT OR TEMPORARY STABILIZATION SHALL BE COMPLETED WITHIN: A) 7 CALENDAR DAYS FOR ALL PERIMETER SEDIMENT CONTROL STRUCTURES, DIKES, PERIMETER SLOPES AND ALL SLOPES GREATER THAN 3:1, B) 14 DAYS AS TO ALL OTHER DISTURBED OR GRADED AREAS ON THE PROJECT SITE.
- 4) ALL SEDIMENT TRAPS/BASINS SHOWN MUST BE FENCED AND WARNING SIGNS POSTED AROUND THEIR PERIMETER IN ACCORDANCE WITH VOL. 1, CHAPTER 12, OF THE HOWARD COUNTY DESIGN
- 5) ALL DISTURBED AREAS MUST BE STABILIZED WITHIN THE TIME PERIOD SPECIFIED ABOVE IN ACCORDANCE WITH THE 1991 MARYLAND STANDARDS AND SPECIFICATIONS FOR SOIL EROSION AND SEDIMENT CONTROL FOR PERMANENT SEEDING (SEC.51), SOD (SEC. 54). TEMPORARY SEEDING (SEC. 50) AND MUI CHING (SEC. 52). TEMPORARY STABILIZATION WITH MULCH ALONE CAN ONLY BE DONE WHEN RECOMMENDED SEEDING DATES DO NOT ALLOW FOR PROPER GERMINATION AND ESTABLISHMENT OF GRASSES.
- 6) ALL SEDIMENT CONTROL STRUCTURES ARE TO REMAIN IN PLACE AND ARE TO BE MAINTAINED IN OPERATIVE CONDITION UNTIL PERMISSION FOR THEIR REMOVAL HAS BEEN OBTAINED FROM THE HOWARD COUNTY SEDIMENT CONTROL INSPECTOR.

| 7) | SITE ANALYSIS: | | | |
|-----|----------------------------|-----------|----------|-----------|
| . / | TOTAL AREA OF SITE: | 7.2 | 0 AC | RES |
| | AREA DISTURBED: | 0.7 | 0 AC | RES |
| | AREA TO BE ROOFED OR PAV | ÆD . | 0.34 | ACRES |
| | AREA TO BE VEGITATIVELY ST | TABILIZED | 0.36 | _ ACRES |
| | TOTAL CUT | 100 | CU. YDS |). |
| | TOTAL FILL | 100 | CU. YDS. | |
| | TOTAL WASTE/BORROW AREA | LOCATION | | 0 |

- 8) ANY SEDIMENT CONTROL PRACTICE WHICH IS DISTURBED BY GRADING ACTIVITY FOR PLACEMENT OF UTILITIES MUST BE REPAIRED ON THE SAME DAY OF DISTURBANCE.
- 9) ADDITIONAL SEDIMENT CONTROL MUST BE PROVIDED, IF DEEMED NECESSARY BY THE HOWARD COUNTY SEDIMENT CONTROL INSPECTOR:
- 10) ON ALL SITES WITH DISTURBED AREAS IN EXCESS OF 2 ACRES, APPROVAL OF THE INSPECTION AGENCY SHALL BE REQUESTED UPON COMPLETION OF INSTALLATION OF PERIMETER EROSION AND SEDIMENT CONTROLS, BUT BEFORE PROCEEDING WITH ANY OTHER EARTH DISTURBANCE OR GRADING. OTHER BUILDING OR GRADING INSPECTION APPROVALS MAY NOT BE AUTHORIZED UNTIL THIS INITIAL APPROVAL BY THE INSPECTION AGENCY IS MADE.
- 11) TRENCHES FOR THE CONSTRUCTION OF UTILITIES IS LIMITED TO THREE PIPE LENGTHS OR THAT WHICH CAN BE BACK FILLED AND STABILIZED WITHIN ONE WORKING DAY, WHICHEVER IS SHORTER.

STANDARD AND SPECIFICATIONS FOR TOPSOIL

PLACEMENT OF TOPSOIL OVER A PREPARED SUBSOIL PRIOR TO ESTABLISHMENT OF PERMANENT VEGETATION.

TO PROVIDE A SUITABLE SOIL MEDIUM FOR VEGETATIVE GROWTH. SOILS OF CONCERN HAVE LOW MOISTURE CONTENT, LOW NUTRIENT LEVELS, LOW pH, MATERIALS TOXIC TO PLANTS, AND/OR UNACCEPTABLE SOIL GRADATION.

CONDITIONS WHERE PRACTICE APPLIES

THIS PRACTICE IS LIMITED TO AREAS HAVING 2:1 OR FLATTER SLOPES WHERE:

- a. THE TEXTURE OF THE EXPOSED SUBSOIL/PARENT MATERIAL IS NOT ADEQUATE TO PRODUCE VEGETATIVE
- b. THE SOIL MATERIAL IS SO SHALLOW THAT THE ROOTING ZONE IS NOT DEEP ENOUGH TO SUPPORT PLANTS OR FURNISH CONTINUING SUPPLIES OF MOISTURE AND PLANT NUTRIENTS.
- c. THE ORIGINAL SOIL TO BE VEGETATED CONTAINS MATERIAL TOXIC TO PLANT GROWTH.
- d. THE SOIL IS SO ACIDIC THAT TREATMENT WITH LIMESTONE IS NOT FEASIBLE.
- FOR THE PURPOSE OF THESE STANDARDS AND SPECIFICATIONS, AREAS HAVING SLOPES STEEPER THAN 2:1 REQUIRE SPECIAL CONSIDERATION AND DESIGN FOR ADEQUATE STABILIZATION. AREAS HAVING SLOPES STEEPER THAN 2:1 SHALL HAVE THE APPROPRIATE STABILIZATION SHOWN ON THE PLANS.

CONSTRUCTION AND MATERIAL SPECIFICATIONS

- TOPSOIL SALVAGED FROM THE EXISTING SITE MAY BE USED PROVIDED THAT IT MEETS THE STANDARDS AS SET FORTH IN THESE SPECIFICATION. TYPICALLY, THE DEPTH OF TOPSOIL TO BE SALVAGED FOR A GIVEN SOIL TYPE CAN BE FOUND IN THE REPRESENTATIVE SOIL PROFILE SECTION IN THE SOIL SURVEY PUBLISHED BY USDA-SCS IN COOPERATION WITH MARYLAND AGRICULTURAL EXPERIMENTAL STATION.
- II. TOPSOIL SPECIFICATIONS SOIL TO BE USED AS TOPSOIL MUST MEET THE FOLLOWING:
 - TOPSOIL SHALL BE A LOAM, SANDY LOAM, CLAY LOAM, SILT LOAM, SANDY CLAY LOAM, LOAMY SAND. OTHER SOILS MAY BE USED IF RECOMMENDED BY AN AGRONOMIST OR SOIL SCIENTIST AND APPROVED BY THE APPROPRIATE APPROVAL AUTHORITY. REGARDLESS, TOPSOIL SHALL NOT BE A MIXTURE OF CON-TRASTING TEXTURED SUBSOILS AND SHALL CONTAIN LESS THAN 5% BY VOLUME OF CINDERS, STONES, SLAG, COARSE FRAGMENTS, GRAVEL, STICKS, ROOTS, TRASH, OR OTHER MATERIALS LARGER THAN 1 1/2" IN
 - ii. TOPSOIL MUST BE FREE OF PLANTS OR PLANT PARTS SUCH AS BERMUDA GRASS, QUACKGRASS, JOHNSON-SON GRASS, NUTSEDGE, POISON IVY, THISTLE, OR OTHERS AS SPECIFIED.
 - WHERE THE SUBSOIL IS EITHER HIGHLY ACIDIC OR COMPOSED OF HEAVY CLAYS, GROUND LIMESTONE SHALL BE SPREAD AT THE RATE OF 4-8 TONS/ACRE (200-400 POUNDS PER 1,000 SQUARE FEET) PRIOR TO THE PLACEMENT OF TOPSOIL. LIME SHALL BE DISTRIBUTED UNIFORMLY OVER DESIGNATED AREAS AND WORKED INTO THE SOIL IN CONJUNCTION WITH TILLAGE OPERATIONS AS DESCRIBED IN THE FOLLOWING PROCEDURES.
- III. FOR SITES HAVING DISTURBED AREAS UNDER 5 ACRES:
 - PLACE TOPSOIL (IF REQUIRED) AND APPLY SOIL AMENDMENTS AS SPECIFIED IN 20.0 VEGETATIVE STABILIZATION - SECTION I - VEGETATIVE STABILIZATION METHODS AND MATERIALS.
- FOR SITES HAVING DISTURBED AREAS OVER 5 ACRES:
 - ON SOIL MEETING TOPSOIL SPECIFICATIONS, OBTAIN TEST RESULTS DICTATING FERTILIZER AND LIME AMENDMENTS REQUIRED TO BRING THE SOIL INTO COMPLIANCE WITH THE FOLLOWING:
 - a. ph for topsoils shall be between 6.0 and 7.5. If the tested soil demonstrates a ph of LESS THAN 6.0, SUFFICIENT LIME SHALL BE PERSCRIBED TO RAISE THE pH TO 6.5 OR HIGHER.
 - b. ORGANIC CONTENT OF TOPSOIL SHALL BE NOT LESS THAN 1.5 PERCENT BY WEIGHT.
 - c. TOPSOIL HAVING SOLUBLE SALT CONTENT GREATER THAN 500 PARTS PER MILLION SHALL NOT BE USED. d. NO SOD OR SEED SHALL BE PLACED ON SOIL WHICH HAS BEEN TREATED WITH SOIL STERILANTS OR CHEMICALS USED FOR WEED CONTROL UNTIL SUFFICIENT TIME HAS ELAPSED (14 DAYS MIN.) TO PERMIT

NOTE: TOPSOIL SUBSTITUTES OR AMENDMENTS, AS RECOMMENDED BY A QUALIFIED AGRONOMIST OR SOIL SCIENTIST AND APPROVED BY THE APPROPRIATE APPROVAL AUTHORITY, MAY BE USED IN LIEU OF NATURAL


ii. PLACE TOPSOIL (IF REQUIRED) AND APPLY SOIL AMENDMENTS AS SPECIFIED IN 20.0 VEGETATIVE


STABILIZATION - SECTION I - VEGETATIVE STABILIZATION METHODS AND MATERIALS.


- V. TOPSOIL APPLICATION
- WHEN TOPSOILING, MAINTAIN NEEDED EROSION AND SEDIMENT CONTROL PRACTICES SUCH AS DIVERSIONS, GRADE STABILIZATION STRUCTURES, EARTH DIKES, SLOPE SILT FENCE AND SEDIMENT TRAPS AND BASINS.
- GRADES ON THE AREAS TO BE TOPSOILED, WHICH HAVE BEEN PREVIOUSLY ESTABLISHED, SHALL BE
- MAINTAINED, ALBEIT 4" 8" HIGHER IN ELEVATION.

DISSIPATION OF PHYTO-TOXIC MATERIALS.


- iii. TOPSOIL SHALL BE UNIFORMLY DISTRIBUTED IN A 4" TO 8" LAYER AND LIGHTLY COMPACTED TO A MINIMUM THICKNESS OF 4". SPREADING SHALL BE PERFORMED IN SUCH A MANNER THAT SODDING OR SEEDING CAN PROCEED WITH A MINIMUM OF ADDITIONAL SOIL PREPARATION AND TILLAGE. ANY IRREGULARITIES IN THE SURFACE RESULTING FROM TOPSOILING OR OTHER OPERATIONS SHALL BE CORRECTED IN ORDER TO PREVENT THE FORMATION OF DEPRESSIONS OR WATER POCKETS.
- IV. TOPSOIL SHALL NOT BE PLACED WHILE THE TOPSOIL OR SUBSOIL IS IN A FROZEN OR MUDDY CONDITION, WHEN THE SUBSOIL IS EXCESSIVELY WET OR IN A CONDITION THAT MAY OTHERWISE BE DETRIMENTAL TO PROPER GRADING AND SEEDBED PREPARATION.
- ALTERNATIVE FOR PERMANENT SEEDING INSTEAD OF APPLYING THE FULL AMOUNTS OF LIME AND COMMERCIAL FERTILIZER, COMPOSTED SLUDGE AND AMENDMENTS MAY BE APPLIED AS SPECIFIED BELOW:
- i. COMPOSTED SLUDGE MATERIAL FOR USE AS A SOIL CONDITIONER FOR SITES HAVING DISTURBED AREAS OVER 5 ACRES SHALL BE TESTED TO PRESCRIBE AMENDMENTS AND FOR SITES HAVING AREAS UNDER 5 ACRES SHALL CONFORM TO THE FOLLOWING REQUIREMENTS:
- a. COMPOSTED SLUDGE SHALL BE SUPPLIED BY, OR ORIGINATE FROM, A PERSON OR PERSONS WHO ARE PERMITTED (AT THE TIME OF ACQUISITION OF THE COMPOST) BY THE MARYLAND DEPARTMENT OF THE ENVIRONMENT UNDER COMAR 26.04.06.
- b. COMPOSTED SLUDGE SHALL CONTAIN AT LEASE 1 PERCENT NITROGEN, 1.5 PERCENT PHOSPHOURUS, AND 0.2 PERCENT POTASSIUM AND HAVE A Ph OF 7.0 TO 8.0. IF COMPOST DOES NOT MEET THESE REQUIREMENTS, THE APPROPRIATE CONSTITUENTS MUST BE ADDED TO MEET THE REQUIREMENTS PRIOR TO USE.
- c. COMPOSTED SLUDGE SHALL BE APPLIED AT A RATE OF 1 TON/1,000 SQUARE FEET
- iv. COMPOSTED SLUDGE SHALL BE AMENDED WITH A POTASSIUM FERTILLIZER APPLIED AT THE RATE OF 4 LB/1,000 SQUARE FEET, AND 1/3 THE NORMAL LIME APPLICATION RATE.
- REFERENCES: GUIDELINE SPECIFICATIONS, SOIL PREPARATION AND SODDING. MD-VA, PUB. #1, COOPERATIVE EXTENSION SERVICE, UNIVERSITY OF MARYLAND AND VIRGINIA POLYTECHNIC INSTITUTES. REVISED 1973.

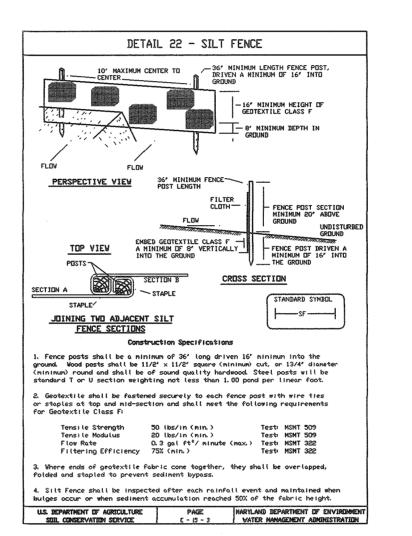


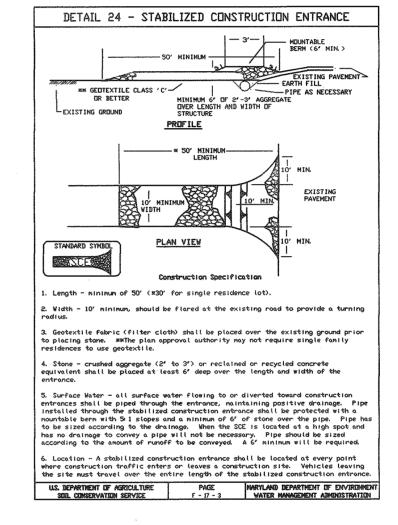

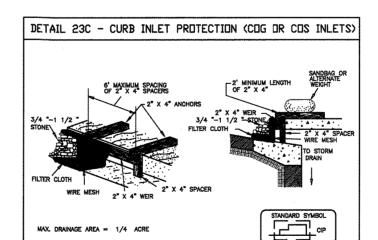

 Attach a continuous piece of wire mesh (30" minimum width by throat length plus 4") to the 2" x 4" weir (measuring throat length plus 2") as shown on the standard 2. Place a continuous piece of Geotextile Class E the same dimensions as the wire mesh over the wire mesh and securely attach it to the 2° x 4° weir. 3. Securely nail the 2" X 4" weir to a 9" long vertical spacer to be located between the weir and the inlet face (max. 4' apart). 4. Place the assembly against the inlet throat and nail (minimum 2* lengths of 2* x 4* to the top of the welf at spacer locations). These 2* x 4* anchors shall extend across the inlet top and be held in place by sandbags or alternate weight. 5. The assembly shall be placed so that the end spacers are a minimum 1' beyond both ends of the throat opening. 6. Form the 1/2 " x 1/2 " wire mesh and the geotextile fabric to the concrete gutter and against the face of the ourb on both sides of the inlet. Place clean 3/4 " x 1 1/2" stone over the wire mesh and geotextile in such a manner to prevent water from entering the inlet under or around the geotextile. 7. This type of protection must be inspected frequently and the filter cloth and stone replaced when clogged with sediment.

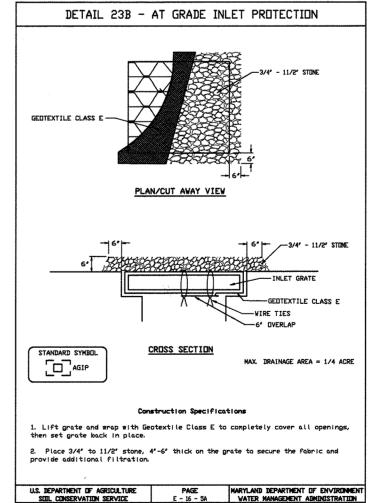


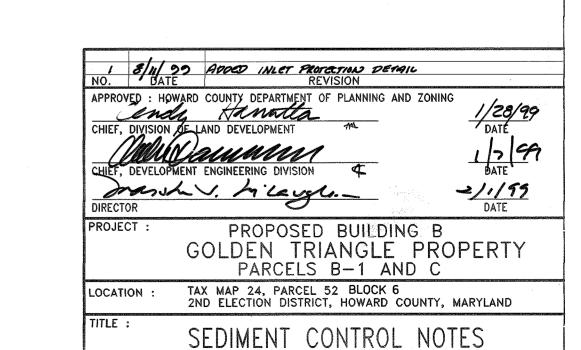

THIS DEVELOPMENT PLAN IS EROSION AND SEDIMENT CONTROL BY THE HOWARI APPROVED: DEPARTMENT OF PLANNING AND ZONING CHIEF, DEVELOPMENT ENGINEERING DIVISION CHIEF, DIVISION OF LAND DEVELOPMENT

THESE PLANS HAVE BEEN REVIEWED FOR THE HOWARD

DEVELOPERS CERTIFICATE

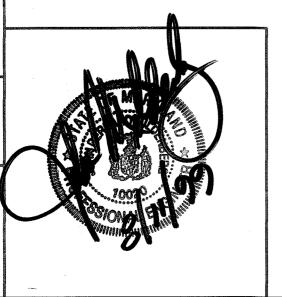

OWNER/DEVELOPER MILDENBERG. GOLDEN TRIANGLE BOENDER & ASSOC., INC. c/o RICHARD DEMMITT P.O. BOX 228 ngineers Planners Surveyors CLARKSVILLE, MARYLAND 21029 410-365-0414 5072 Dorsey Hall Drive, Suite 202, Ellicott City, Maryland 2104 (410) 997-0296 Balt. (301) 621-5521 Wash. (410) 997-0298 Fax. DESIGNED: DCF | CHECKED: JER | DATE: 03-13-97 | PROJ. NO.: DRAWN: DCF APPROVED: MLL SCALE: AS SHOWN SHEET 5 OF G

| | | Sha | red Parking (| Chart |
|----------------------|----------------------|------|---------------|---------------------------------|
| | - | Unit | SF | Percent of Total Square Footage |
| | Restaurants, | С | 4440 | |
| Spaces | Athletic Centers & | D | 3300 | |
| Spa | Religious Facilities | F | 2000 | |
| 14. | | 1 | 6000 | 2404 |
| 10- SF | | J | 3000 | 31% |
| · · · | | K | 3000 | |
| Requires Per 1000 | | Р | 2400 | |
| Req Per | | | | |

| | | All Other Uses | 1 | 2797 | | |
|--|------------|----------------|---|-------|------|--|
| | ses | | В | 37309 | | |
| | Spaces | | E | 2000 | | |
| | 59. | | G | 1867 | C00/ | |
| | 5 or SF | | Н | 1133 | 69% | |
| | -′ — | | N | 2400 | | |
| | | | 0 | 1200 | | |
| | Req Per | | Q | 6000 | | |

1. Per Section 133.0.D.8, the Director of Planning and Zoning determined based on a Parking Needs study submitted by Traffic Concepts, Inc in 2019 that a maximum of 31% of restaurant, athletic center or religious facility use is supported by the existing 39 parking spaces provided. At no time shall Parcel C have more than 31% of the existing building square footage with the following uses: restaurants, athletic centers or religious facilities unless a new parking study is submitted and approved by the Director of Planning and Zoning.

2. Any change in use that requires more than 6 parking spaces per 1000 SF will require a redline to the SDP.

3. The Parking Table does not include required or provided parking for Parcels A and B-1.

| Golden Triangle Shared Parking Table | | | | |
|---|------------|--------------------|------------------------------------|---|
| | | | | - - - - - |
| Use | Unit/Suite | Net Usable Area | Standard Parking Ratio Required | Standard Parking Spaces Required |
| Retail - Liquor Store | 1 | 2,797 | 5 sp/1000 sf | 14.0 |
| Retail - Grocery Store ² | В В | 37,309 | 5 sp/1000 sf | 186.5 |
| Restaurant ² | C | 4,440 | 14 sp/1000 sf | 62.2 |
| Restaurant ² | D | 3,300 | 14 sp/1000 sf | 46.2 |
| Medical Office | E | 2,000 | 5 sp/1000 sf | 10.0 |
| Restaurant ² | F | 2,000 | 14 sp/1000 sf | 28.0 |
| Personal Service Establishment - Laundry | G | 1,867 | 5 sp/1000 sf | 9.3 |
| Personal Service Establishment - Hair Salon | Н | 1,133 | 5 sp/1000 sf | 5.7 |
| Restaurant ² | ı | 6,000 | 14 sp/1000 sf | 84.0 |
| Restaurant ^{, 2} | J | 3,000 | 14 sp/1000 sf | 42.0 |
| Restaurant ² | K | 3,000 | 14 sp/1000 sf | 42.0 |
| Medical Office | N | 2,400 | 5 sp/1000 sf | 12.0 |
| Restaurant Carryout - Bakery ² | 0 | 1,200 | 6 sp/1000 sf | 7.2 |
| Restaurant ² | Р | 2,400 | 14 sp/1000 sf | 33.6 |
| Vehicle Uses - 8 Service Bays | Q | 6,000 | 2 sp/1000 sf + 3/service bay 1 | 26.0 |
| Total | | 78,846 | | 609 |

Notes:

1. Unit Q, Vehicle Uses - Of the 6,000 sf building, 1,000 sf is the building area excluding service bays.

2. Grocery and Restraurant parking percentages at peak times are based on parking study performed by Traffic Concepts dated May 17, 2019, and follow up letter dated August 16, 2019. 3. The Parking Table does not include required or provided parking for Parcels A and B-1.

ADDITIONAL GENERAL NOTES:

22. THE TRAFFIC STUDY FOR THIS PROJECT WAS PREPARED BY TRAFFIC CONCEPTS, INC, DATED JUNE, 2019, AND WAS APPROVED ON AUGUST 6, 2019.

23. THIS 2019 REDLINE REVISION TO THE APPROVED PLAN IS EXEMPT FROM STORMWATER MANAGEMENT AS LESS THAN 5,000 SF OF DISTURBANCE IS PROPOSED. WITH THIS PLAN, NO DISTURBANCE IS PROPOSED; ALL CHANGES TO THE BUILDING ARE INTERIOR.

AGREES TO REMOVE THE SHEDS, SHOPPING CART CORRALS AND OTHER OBSTRUCTIONS FROM THE PROVIDED PARKING SPACES PRIOR TO SIGNATURE APPROVAL OF ADDED SHEET 6. SUCH OBSTRUCTIONS ARE A ZONING VIOLATION TO THE APPROVED SDP.

25. PARKING TABULATION: TOTAL REQUIRED: 39\$ SP*
TOTAL PROVIDED: 39\$ SP (INCLUDES 8 HC SPACES) *PER PARKING NEEDS STUDY BY TRAFFIC CONCEPTS, INC IN 2019

GOLDEN TRIANGLE

SUITE SOUARE FOOTAGE AND USE TABLE

| SUITE SQUARE FOOTAGE AND USE TABLE | | | | | | |
|------------------------------------|--------|------------------------------------|--|--|--|--|
| UNIT | SF | USE | | | | |
| 1 | 2,797 | RETAIL | | | | |
| В | 37,309 | RETAIL | | | | |
| С | 4,440 | RESTAURANT | | | | |
| D | 3,300 | RESTAURANT | | | | |
| E | 2,000 | MEDICAL OFFICE | | | | |
| F | 2,000 | RESTAURANT | | | | |
| G | 1,867 | RETAIL | | | | |
| Н | 1,133 | PERSONAL SERVICE ESTABLISHMENT | | | | |
| 1 | 6,000 | RESTAURANT | | | | |
| J | 3,000 | RESTAURANT | | | | |
| К | 3,000 | RESTAURANT | | | | |
| N | 2,400 | MEDICAL OFFICE | | | | |
| 0 | 1,200 | RETAIL | | | | |
| Р | 2,400 | RESTAURANT | | | | |
| Q | 6,000 | AUTO REPAIR WITH 8 SERVICE BAYS | | | | |

PURPOSE STATEMENT:

THE PURPOSE OF THIS REVISED SITE DEVELOPMENT PLAN IS TO CHANGE ONE OF UNITS FROM AUTO REPAIR TO A RESTAURANT. PARKING TABULATIONS HAVE BEEN UPDATED AND A SHARED PARKING ANALYSIS IS PROVIDED.


DATE


9-23-1

DATE

PJS

BY

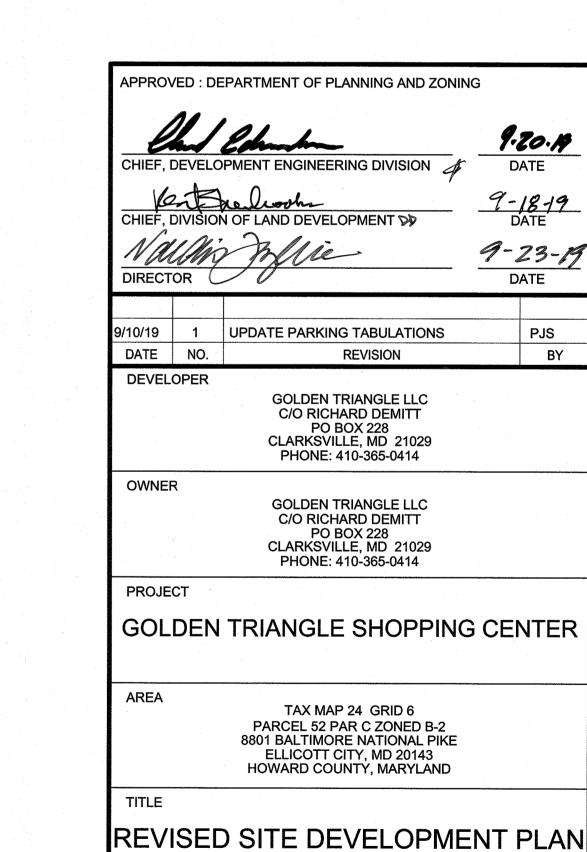

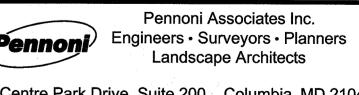

PARKING TABULATIONS

8818 Centre Park Drive, Suite 200 Columbia, MD 21045

T 410.997.8900 F 410.997.9282



DESIGNED BY: PJS DRAWN BY: PJS PROJECT NO: GTRA19001 DATE: SEPTEMBER 10, 2019

SCALE: NO SCALE DRAWING NO. 6 OF 6

SDP-96-136