


Sheet Index	
No.	Title
1	Title Sheet
2	Site Development Plan
3	Grading Sediment Control Plan
4	Drainage Area And Soils Plan
5	Sediment Control Construction Notes & Details
6	Stormwater Management Detail Plan
7	Quality Stormwater Management Notes & Details
8	Existing Features Plan
9	Landscape Plan

LEGEND

- BENCH MARK**
- USE RESTRICTION LINE**
- FLOW DIRECTION**
- SLOPES BETWEEN 15% - 24.9%**
- SLOPES GREATER THAN 25%**
- SILT FENCE**
- EARTH DIKE**
- LIMIT OF DISTURBANCE**
- DRAINAGE DIVIDE**
- EXISTING CONTOUR**
- PROPOSED CONTOUR**
- STABILIZED CONSTRUCTION ENTRANCE**
- SUPER SILT FENCE**

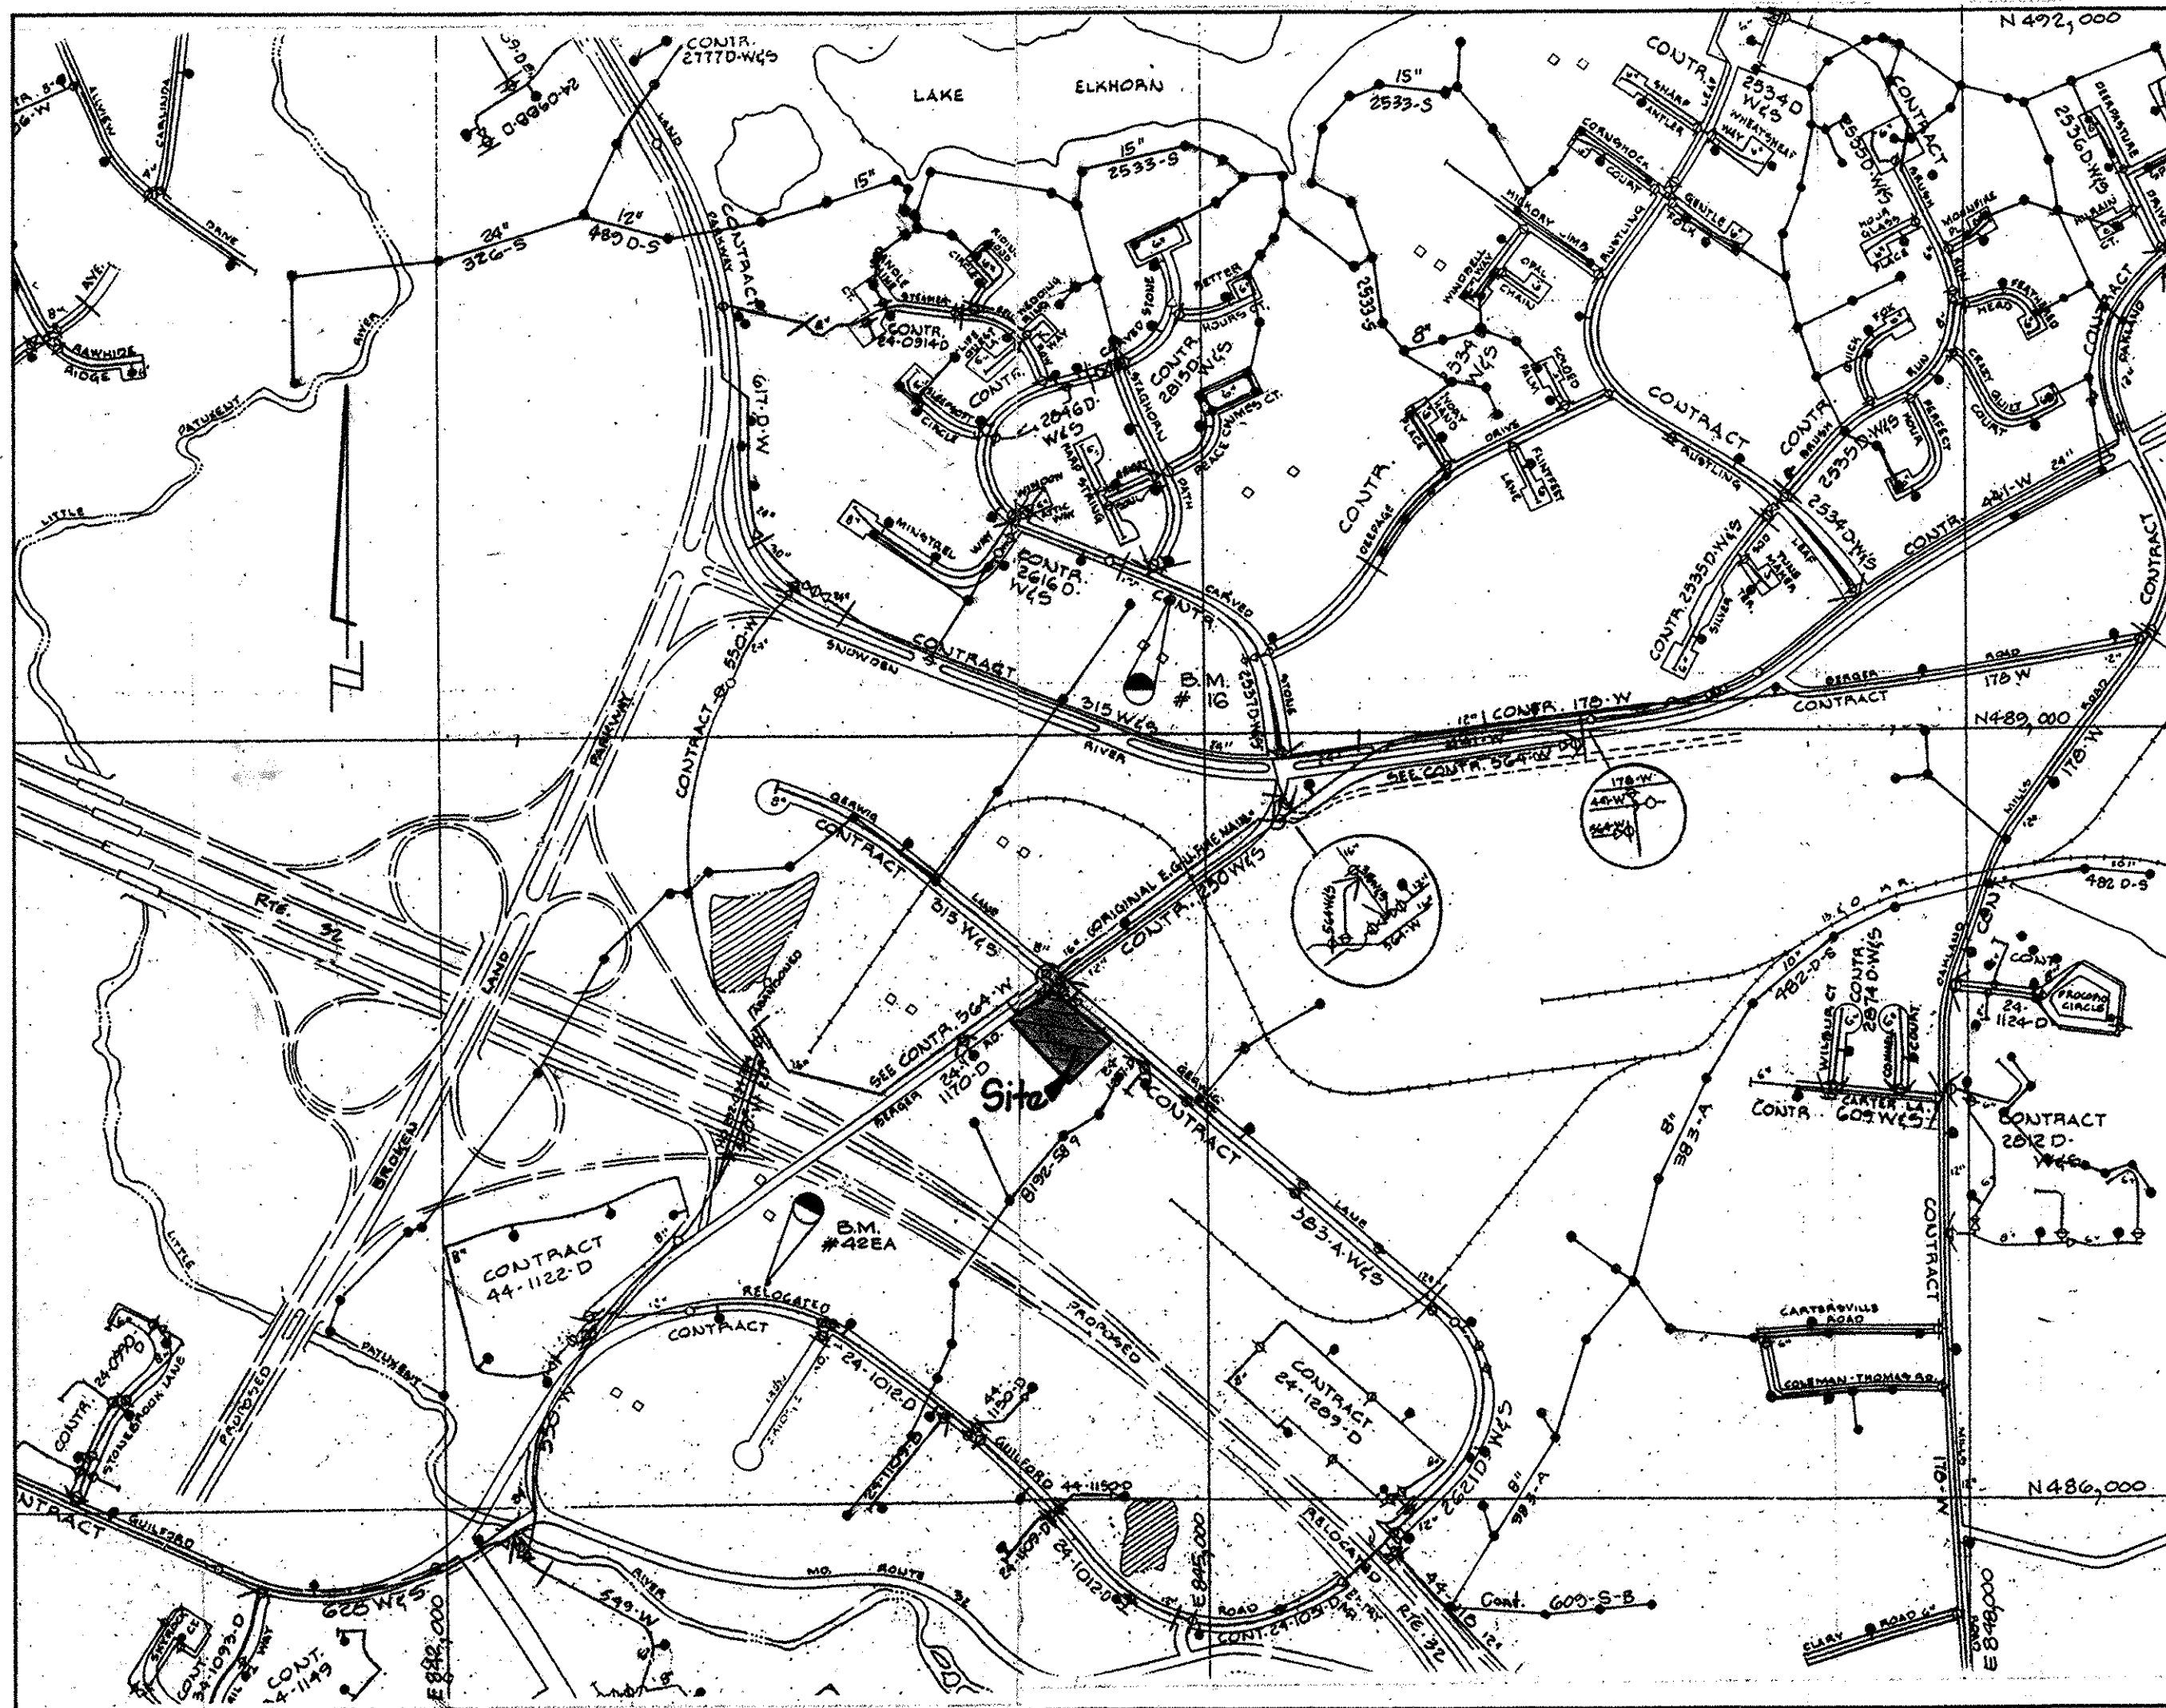

Location Map
Scale: 1" = 600'

British And American Auto Care Inc. Columbia E.G.U. Subdivision Parcel "C"

A Resubdivision of Lot 3 6th Election District Howard County, Maryland

BENCH MARKS

- Howard County Geodetic Control No. 42EA
Elevation = 313.28, Northing = 547604, Easting = 1355440.
Standard Howard County Survey Disc. Set on concrete monument.
On Guilford Road 0.3+/- miles northeast, leftside from intersection,
Murry Hill Road 9.3' off edge of paving, 20' +/- west from light pole
and 80' from water valve in Guilford Road.
- Howard County Geodetic Control No. 0016
Elevation = 359.59, Northing = 550279, Easting = 1357329.
Standard Howard County Survey Disc. Set on concrete monument.
Between Carved Stone Road and conc. sidewalk, 100' +/- east from
intersection Stag Horn Path and 41' +/- from inlet.

GENERAL NOTES

- Site Analysis Data:
 - Total Project Area: 1.786+ Acres (76,640 sq. ft.)
 - Area Reserved for Easement Dedication to Howard County: 0.231+ Acres of 10,000 sq. ft.
 - Net Area: 1.7045+ Acres (74,250 sq. ft.)
 - Area of Plan Submitter: 1.756+ Acres (76,640 sq. ft.)
 - Limit of Disturbed Area: 1.70+ Acres (74,052 sq. ft.)
 - Present Zoning: M-1 and New Town
 - Proposed Site and Structure Use: Automotive service center operation.
 - Building Floor Space: 1 Story Building
 - Office Space & Vestibule = 3,502 sq. ft.
 - Warehouse Space = 3,258 sq. ft.
 - Total Building Area = 13,650 sq. ft.
 - Total Number of Units Allowed: one (1) commercial building
 - Total Number of Proposed Units: One (1) 13,650 sq. ft. building
 - Maximum Number of Employees: 20
 - Parking Required: Vehicle service establishments: 3 spaces plus 3 spaces/vehicle bay (18 bays x 3 sq + 3 sq = 57 spaces)
 - Parking Provided: 55 Regular spaces + 2 Van Accessible handiapped spaces = 57 Total
 - Open Space: None required
 - Recreation Open Space: None required
 - Building Coverage of Site: 31.5+ Acres, 18.05% of gross site area.
 - Applicable DPZ File References: F-89-11, Amended FDP Phase 155-A
- Property Owner: Brian England
British and American Auto Care, Inc.
2535 Berger Road
Columbia, Maryland 21046
- Architect: Altum Architects
Suite 453
5537 Twin Knolls Road
Columbia, Maryland 21045-3270
Howard County, Md.
- There are no wetlands or forest on the subject property. An assessment was conducted by Dennis J. Laffare, M.S. and Associates, LLC on 8/23/97.
- This property is exempt from the requirements of the Howard County Forest Conservation Manual in accordance with Section 16.1220(b) of the County Code. There is no area of 100 year floodplain on the subject property.
- Boundary information per record plat No. 8163, dated 9/30/88 by Clark, Finetree & Sackett, Inc. Boundary information field verified by LDE, Inc. in March, 1994.
- Onsite topography shown herein was field run by LDE, Inc. on March 2, 1998. Control based on Maryland NAD83 horizontal and NAVD29 vertical datum from Howard County Control Stations 0016 and 42EA.
- All construction shall be performed in accordance with the latest standards and specifications of Howard County plus MSHA standards and specifications if applicable.
- Deviations from these plans and specifications without prior written consent of the civil engineer may cause the work to be unacceptable.
- Adjustments to the sequence of construction shall be approved by the Howard County Department of Inspections, Licenses and Permits prior to such adjustments.
- Approximate locations of existing utilities are shown. The contractor shall take all necessary precautions to protect existing utilities and maintain uninterrupted service. Any damage incurred due to contractor's operation shall be repaired immediately at the contractor's expense.
- Contractor shall comply with all sediment control notes on these plans.
- All plan dimensions are to face of curb unless noted otherwise.
- Traffic control devices, markings and signing shall be in accordance with the latest edition of the Manual of Uniform Traffic Control Devices (MUTCD). All street and regulatory signs shall be in place prior to the placement of any asphalt.
- There may be additional utilities not shown on these plans. The engineer assumes no responsibility for locations not shown and it shall be the responsibility of the contractor to verify the locations of all existing utilities within the limits of construction and notify the engineer prior to the start of construction.
- The contractor shall notify the following utilities or agencies at least five (5) working days before beginning construction:
 - "Miss Utility" at 1-800-251-7777
 - "BGE" at (410) 234-5691
 - "Bell Atlantic" at (410) 593-3648

APPROVED
PLANNING BOARD
OF HOWARD COUNTY

DATE: 1/27/99

Schnabel Engineering Associates, Inc.
Consulting Geotechnical Engineers
Test Pit Log

Topsoil Index	Final
Poody Graded SAND (SP) with silty and rock fragments, rock fragments	MC=10.3% @ 2'
Medium to coarse sand at 2'	
Medium to coarse sand at 2'	
Water encountered at bottom of pit at 2'	
Note: Water level reading on 42598: 4.8'	

Schnabel Engineering Associates, Inc.
Consulting Geotechnical Engineers
Test Pit Log

Contract No: 98093-00
Title: British and American Auto Care
Project: 2535 Berger Road
Location: 2535 Berger Road
Scale: 1" = 1' 0"
SEA Rep: J. Cooper

Date Sounded: 4/23/98
Date Sounding: 4/23/98
Water Elev: 305
Elevation Equip: Benchmark

Topsoil Index	Final
Poody Graded SAND (SP) with silty and rock fragments, rock fragments	MC=10.3% @ 2'
Medium to coarse sand at 2'	
Medium to coarse sand at 2'	
Water encountered at bottom of pit at 2'	
Note: Water level reading on 42598: 4.8'	

Schnabel Engineering Associates, Inc.
Consulting Geotechnical Engineers
Test Pit Log

Contract No: 98093-00
Title: British and American Auto Care
Project: 2535 Berger Road
Location: 2535 Berger Road
Scale: 1" = 1' 0"
SEA Rep: J. Cooper

Date Sounded: 4/23/98
Date Sounding: 4/23/98
Water Elev: 317.5
Elevation Equip: Benchmark

Topsoil Index	Final
Poody Graded SAND (SP) with silty and rock fragments, rock fragments	MC=10.3% @ 2'
Medium to coarse sand at 2'	
Medium to coarse sand at 2'	
Water encountered at bottom of pit at 2'	
Note: Water level reading on 42598: Dry to 4.8'	

Schnabel Engineering Associates, Inc.
Consulting Geotechnical Engineers
Test Pit Log

Contract No: 98093-00
Title: British and American Auto Care
Project: 2535 Berger Road
Location: 2535 Berger Road
Scale: 1" = 1' 0"
SEA Rep: J. Cooper

Date Sounded: 4/23/98
Date Sounding: 4/23/98
Water Elev: 317.5
Elevation Equip: Benchmark

Topsoil Index	Final
Poody Graded SAND (SP) with silty and rock fragments, rock fragments	MC=10.3% @ 2'
Medium to coarse sand at 2'	
Medium to coarse sand at 2'	
Water encountered at bottom of pit at 2'	
Note: Water level reading on 42598: Dry to 4.8'	

SUBDIVISION NAME	SECTION/AREA	PARCEL NO.
E.G.U. Subdivision	2/B	C

PLAT NO.	BLOCK NO.	ZONE	TAX MAP NO.	ELECTION DISTRICT	CENSUS TRACT
8163	9	M-1&2NT	42	6	6067.03

WATER CODE	SEWER CODE
E06	5241000

APPROVED: DEPARTMENT OF PLANNING AND ZONING

3/5/99
DATE

3/18/99
DATE

3/1/99
DATE

THESE PLANS HAVE BEEN REVIEWED FOR THE HOWARD SOIL CONSERVATION DISTRICT AND MEET THE TECHNICAL REQUIREMENTS.

3/3/99
DATE

3/3/99
DATE

3/3/99
DATE

ENGINEER'S CERTIFICATE


"I HEREBY CERTIFY THAT THIS ENGINEERING AND SEDIMENT CONTROL REPRESENTS A PRACTICAL AND SOUND DESIGN BASED ON MY PERSONAL KNOWLEDGE OF THE SITE CONDITIONS AND AS PREPARED IN ACCORDANCE WITH REQUIREMENTS OF THE HOWARD COUNTY SOIL CONSERVATION DISTRICT."

3/24/99
DATE

DEVELOPER'S CERTIFICATE

"I/WE CERTIFY THAT ALL DEVELOPMENT AND/OR CONSTRUCTION WILL BE DONE ACCORDING TO THESE PLANS AND THAT ANY RESPONSIBLE PERSONNEL INVOLVED IN THE CONSTRUCTION PROJECT WILL HAVE A CERTIFICATE OF ATTENDANCE AT A DEPARTMENT OF THE ENVIRONMENT APPROVED TRAINING PROGRAM FOR THE CONTROLS OF SEDIMENT AND EROSION BEGINNING THE PROJECT. I ALSO AUTHORIZE FE-RD/CDD/CSITE INSPECTIONS BY THE HOWARD SOIL CONSERVATION DISTRICT OR THEIR AUTHORIZED AGENTS AS DEEMED NECESSARY."

2/12/99
DATE

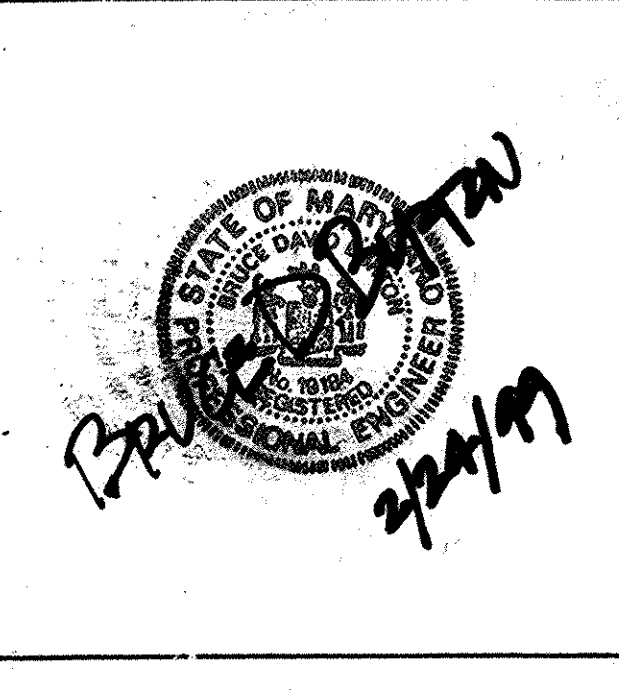

ADDRESS CHART

Lot Number	Street Address
Parcel 'C'	2577 Berger Road

REVISIONS

No.	Date	By	Description
1	2-28-99	SMC	Revised H.C. Parking and Associated grading in front of building for revised canopy column locations. Added (1) parking space on east of building, and revised exterior bollard locations.

LDE, INC.
9250 Rumsey Road, Suite 106, Columbia, MD. 21045
(410) 715-1070 (301) 596-3424 (410) 715-9540 (Fax)




DESIGNED	TITLE SHEET	SCALE
SDH	British And American Auto/Care Inc. Columbia E.G.U. Subdivision Parcel "C"	1" = 600'

DRAWN	JOB NO.
SMC	98-010

CHECKED	FILE NO.
B.D.B.	SDP 26-132

DATE: 7/28/98
4/98
REV 10/19/98

Owner/Developer
Brian England
British and American Auto/Care Inc.
2535 Berger Road
Columbia, Maryland 21046
(410) 381-2700

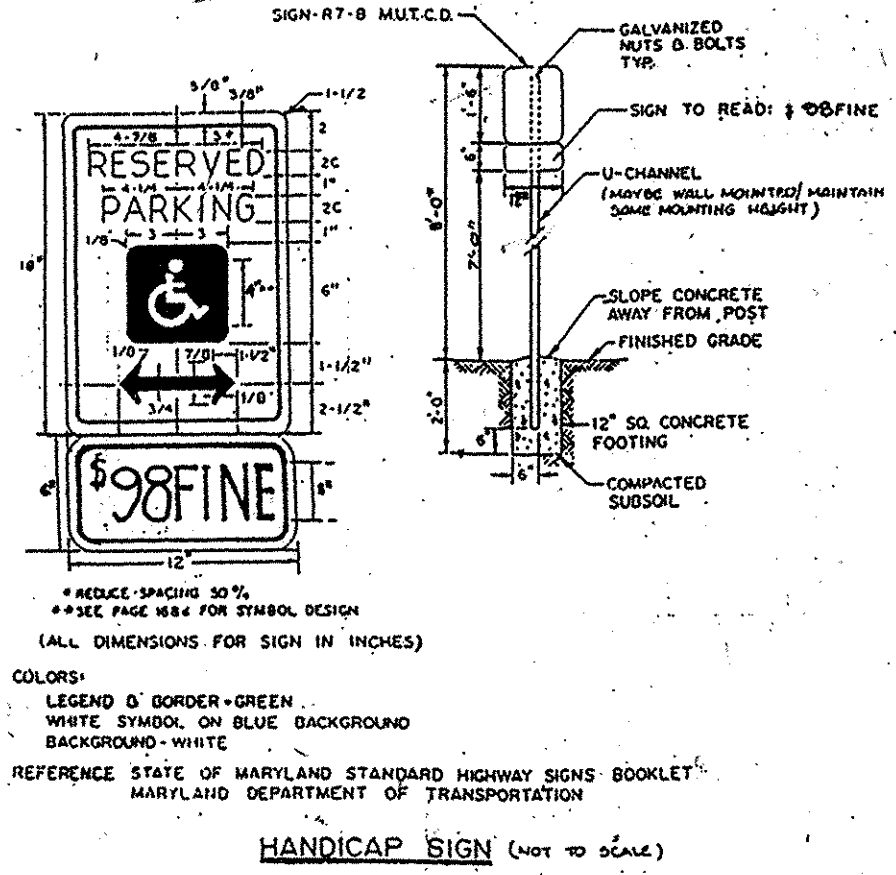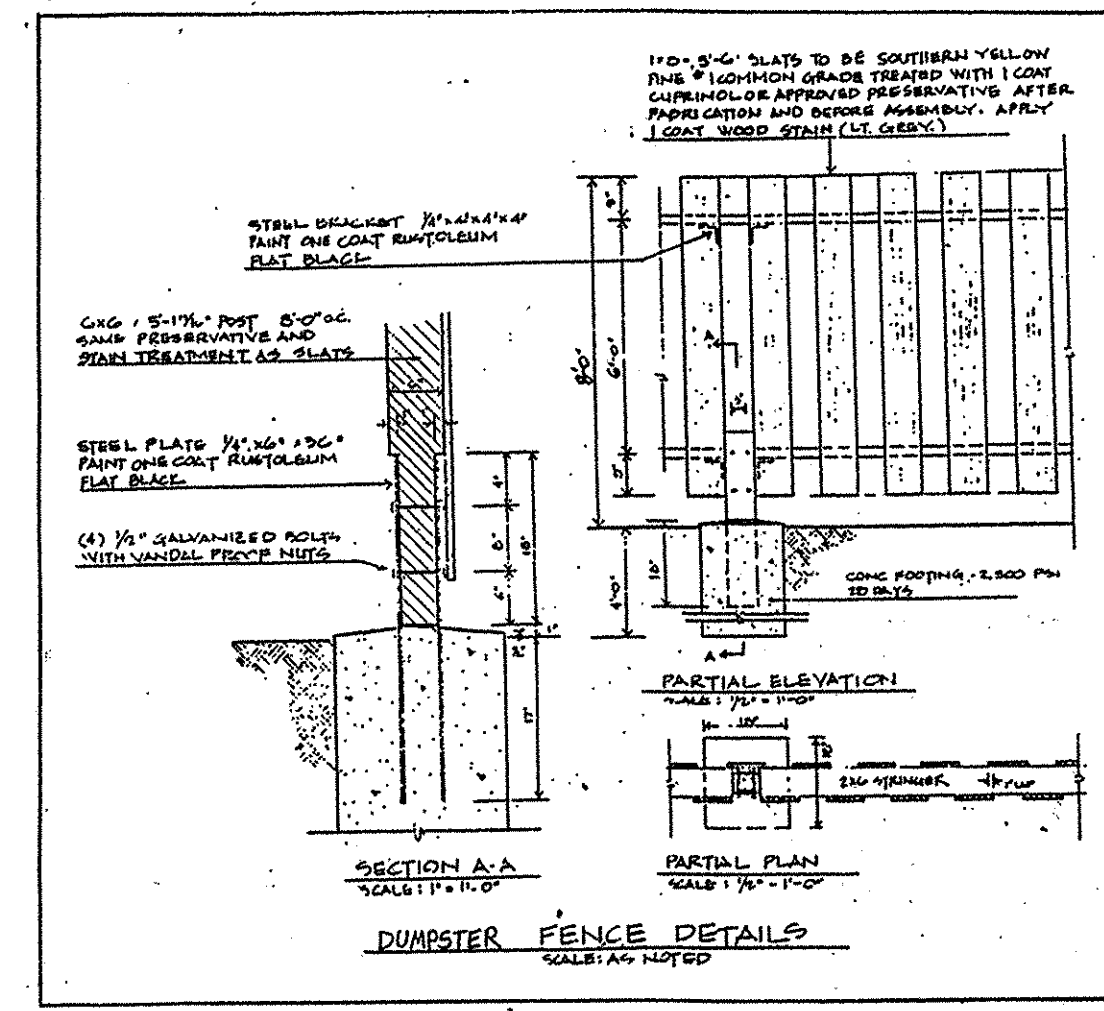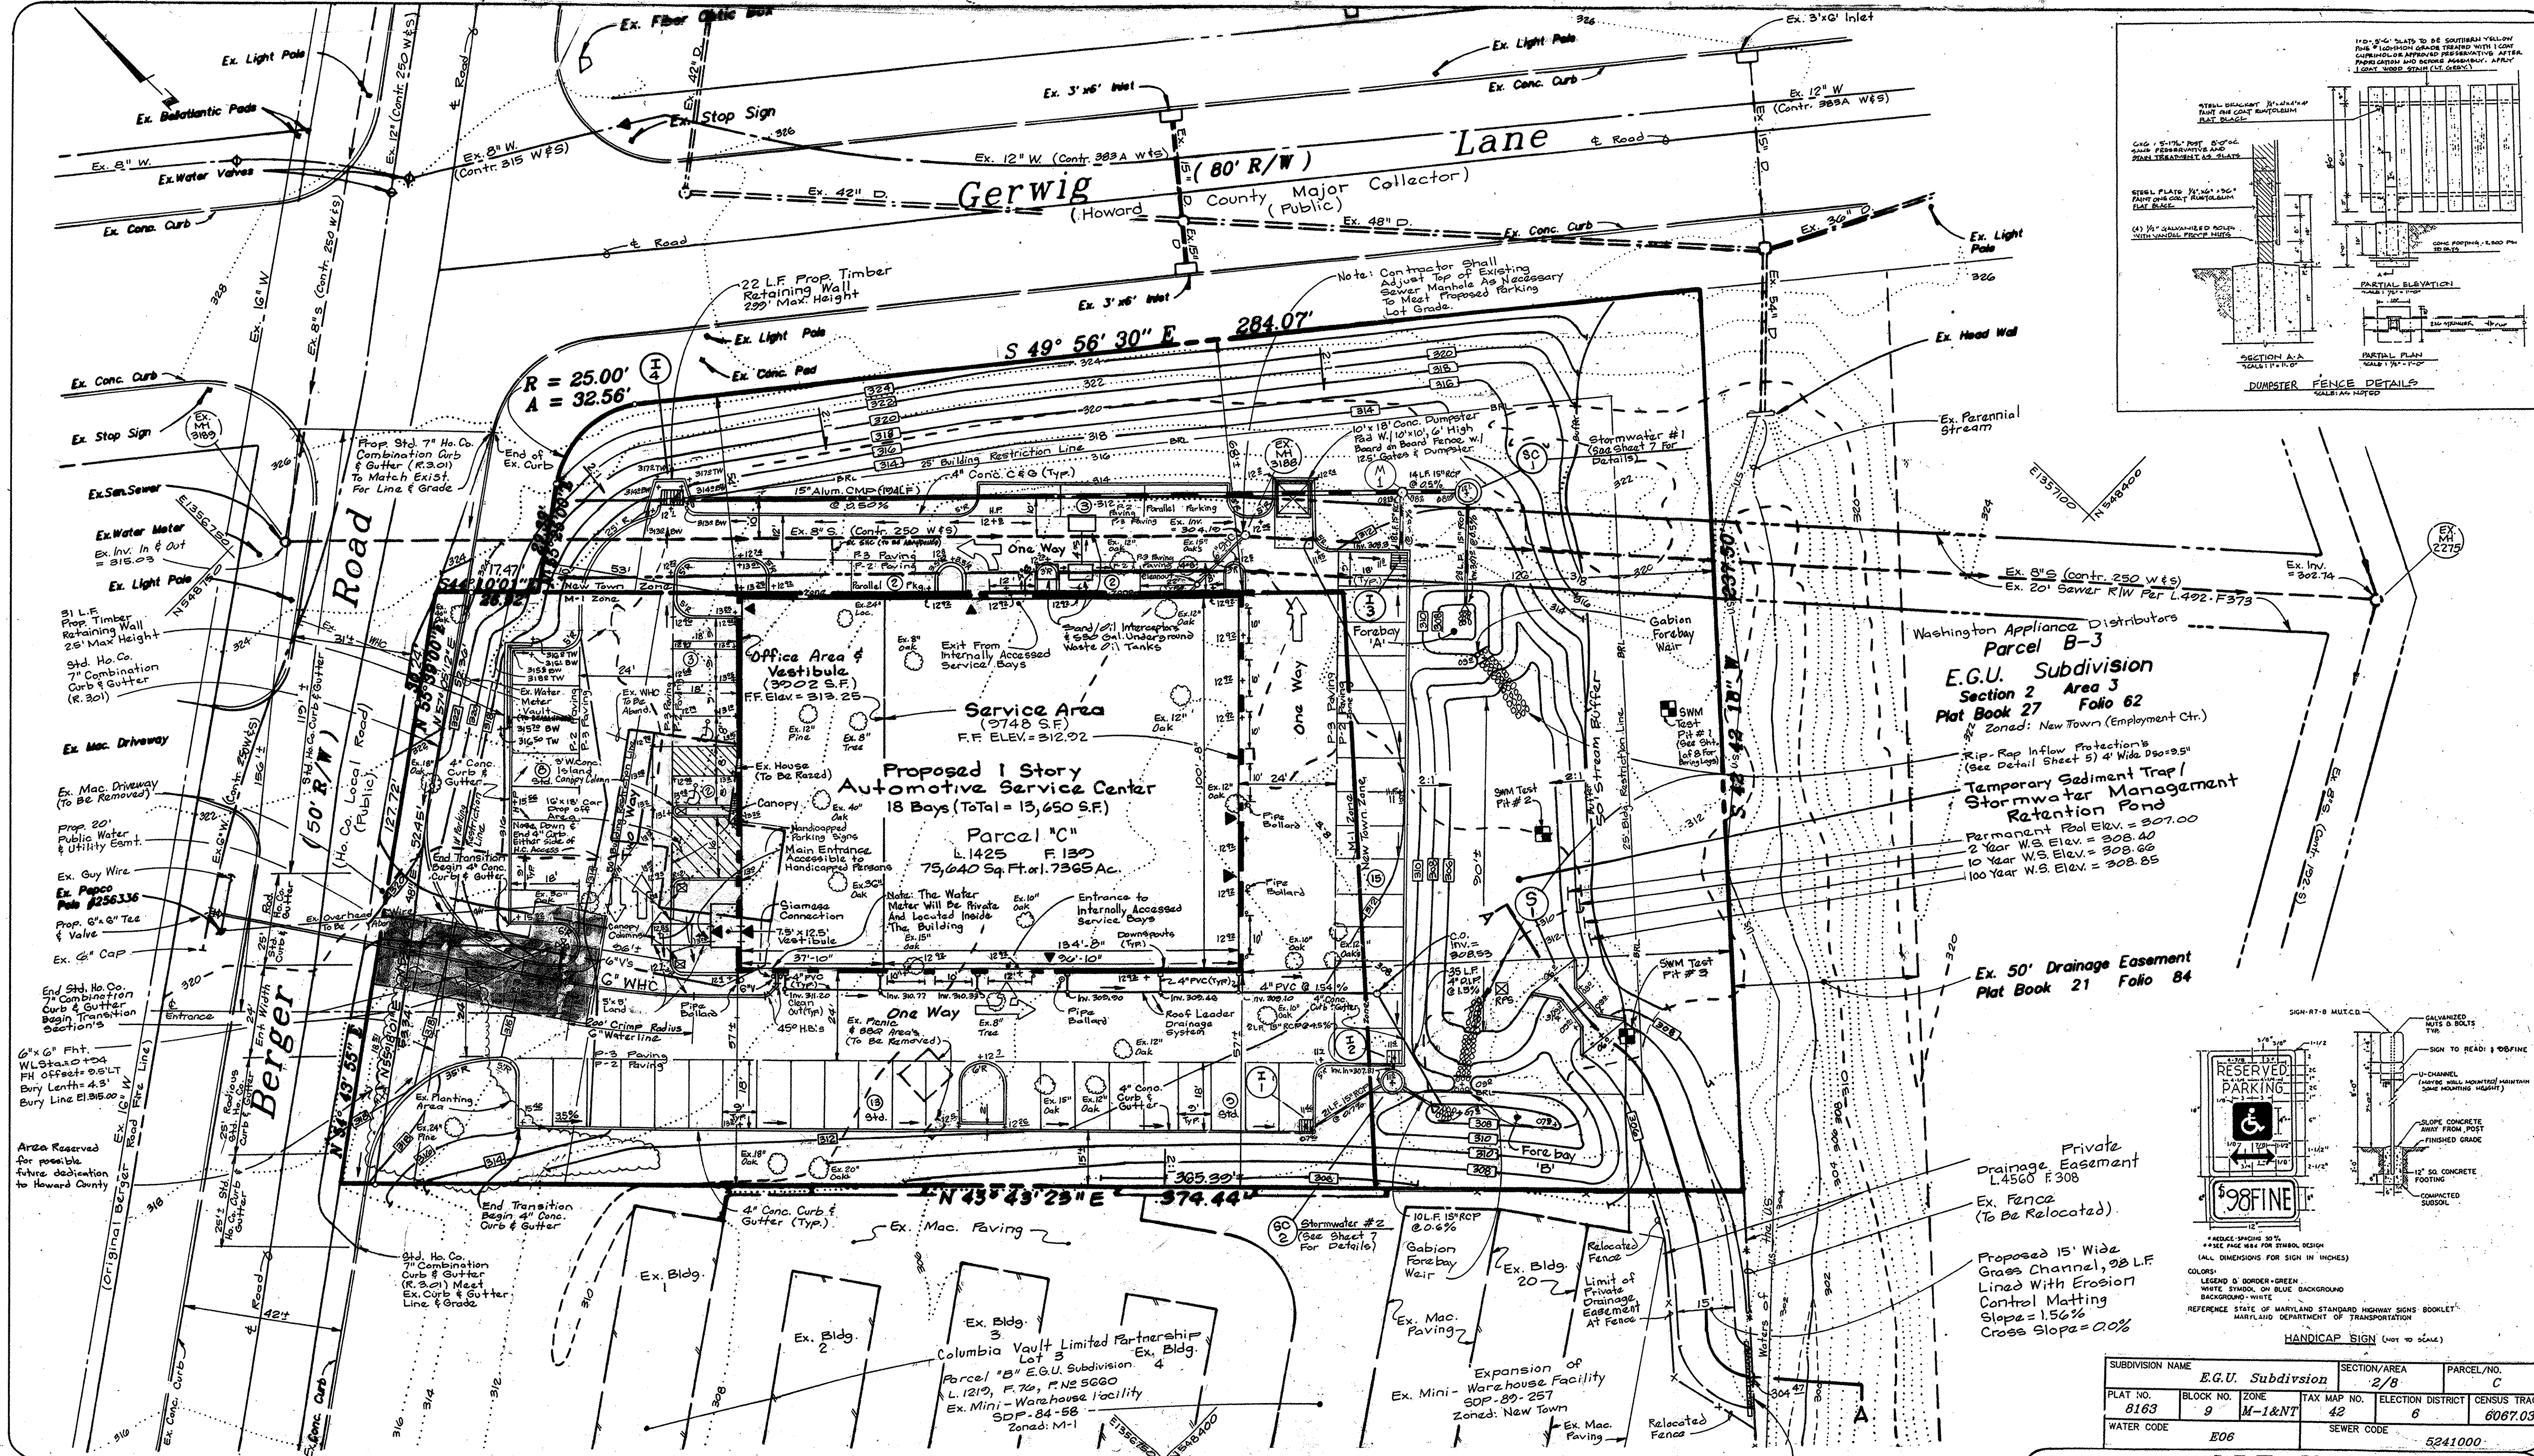

Washington Appliance Distributors
Parcel B-3
E.G.U. Subdivision
Section 2 Area 3
Plat Book 27 Folio 62
Zoned: New Town (Employment Ctr.)

Ex. 50' Drainage Easement
Plat Book 21 Folio 84

Private
Drainage Easement
L.4560 F.308
Ex. Fence
(To Be Relocated)

Proposed 15' Wide
Grass Channel, 98 L.F.
Lined With Erosion
Control Matting
Slope = 1.5%
Cross Slope = 0.0%

SUBDIVISION NAME		E.G.U. Subdivision	SECTION/AREA	2/8	PARCEL NO.	C					
PLAT NO.	8163	BLOCK NO.	9	ZONE	M-1&NT	TAX MAP NO.	42	ELECTION DISTRICT	6	CENSUS TRACT	6087.03
WATER CODE		E06		SEWER CODE		5241000					

APPROVED: DEPARTMENT OF PLANNING AND ZONING

CHIEF, DEVELOPMENT ENGINEERING DIVISION

3/18/99 DATE

CINDY HANDEL

CHIEF, DIVISION OF LAND DEVELOPMENT

3/18/99 DATE

3/18/99 DATE

THESE PLANS HAVE BEEN REVIEWED FOR THE HOWARD SOIL CONSERVATION DISTRICT AND MEET THE TECHNICAL REQUIREMENTS.

3/3/99 DATE

CHERYL SIMMONS / G.S.

NATURAL RESOURCE CONSERVATION

THIS DEVELOPMENT PLAN IS APPROVED FOR SOIL EROSION AND SEDIMENT CONTROL BY THE HOWARD SOIL CONSERVATION DISTRICT.

3/3/99 DATE

HOWARD SOIL CONSERVATION DISTRICT

ENGINEER'S CERTIFICATE

I HEREBY CERTIFY THAT THIS PLAN AND SEDIMENT CONTROL REPRESENTS A PRACTICAL AND KNOWLEDGEABLE PLAN BASED ON MY PERSONAL KNOWLEDGE OF THE SITE CONDITIONS AND THAT IT WAS PREPARED IN ACCORDANCE WITH REQUIREMENTS OF THE HOWARD SOIL CONSERVATION DISTRICT.

3/24/99 DATE

BRUCE D. [Signature]

SIGNATURE OF ENGINEER


DEVELOPER'S CERTIFICATE

I HEREBY CERTIFY THAT ALL DEVELOPMENT AND/OR CONSTRUCTION WILL BE DONE ACCORDING TO THESE PLANS AND THAT ANY RESPONSIBLE PERSONNEL INVOLVED IN THE CONSTRUCTION PROJECT WILL HAVE A CERTIFICATE OF ATTENDANCE AT A DEPARTMENT OF THE ENVIRONMENT-APPROVED TRAINING PROGRAM FOR THE CONTROL OF SEDIMENT AND EROSION. I ALSO AUTHORIZE PERIODIC ON-SITE INSPECTIONS BY THE HOWARD SOIL CONSERVATION DISTRICT OR THEIR AUTHORIZED AGENTS AS DEEMED NECESSARY.

2/23/99 DATE

[Signature]

SIGNATURE OF DEVELOPER

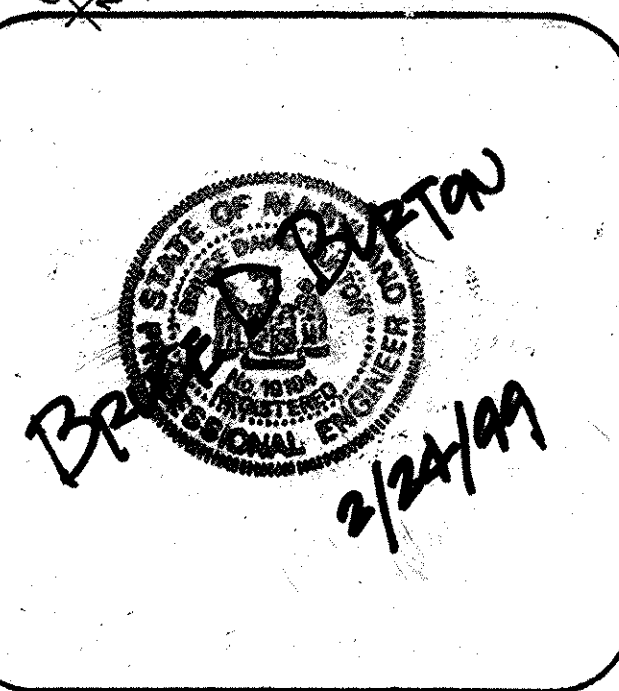

APPROVED PLANNING BOARD OF HOWARD COUNTY

DATE 1/27/99

REVISIONS

No.	Date	By	Description
1	4-28-99	SAC	Revised H.C. parking and associated grading in front of building for revised canopy column locations, added (1) parking space on east of building, and revised exterior bollard locations.

LDE, INC.

9250 Rumsey Road, Suite 106, Columbia, MD. 21045
(410) 715-1070 (301) 596-3424 (410) 715-9540 (Fax)

DESIGNED: SDH
DRAWN: SMC
CHECKED: B.D.B.

Site Development Plan
British And American Auto Care, Inc.
Columbia
E.G.U. Subdivision
Parcel "C"

Tax Map 42, P/O Parcel 366, Grid 9
8th Election District
Howard County, Maryland



Owner/Developer: British And American Auto Care Inc.
2535 Berger Road
Columbia Maryland 21046
(410) 381-2700

SCALE: 1" = 20'
DRAWING: 2 of 3
JOB NO.: 98-010
FILE NO.: SDP-98-132

SDP98-132

SEQUENCE OF CONSTRUCTION

- 1) Obtain grading permit. 1 DAY
 - 2) Notify the Howard County Department of Public Works, Construction Inspection Division at least 48 hours prior to beginning construction at (410) 313-1880. 1 DAY
 - 3) Install sediment control devices, including stabilized construction entrance, sediment basin with dewatering device and RPS, earth dikes, temporary rip-rap inflow protection and silt fence. Issue that will #1 on S-1 is blocked (see SD-7.00 detail, sheet 0). Do not install pond forebays. *At least 10 DAYS permission to proceed.*
 - 4) Grade site in accordance with the approved grading plan. Stabilize site in accordance with the temporary seeding notes. 10 DAYS
 - 5) Construct Building and install roof drainage system. 3 MONTHS
 - 6) Install utilities, including storm drainage system, water and sewer. 10 DAYS
 - 7) Fine grade for parking lot and travelways. Install retaining walls. 4 DAYS
 - 8) Install gravel base for parking lot. 3 DAYS
 - 9) Install base and surface paving. 5 DAYS
 - 10) Stabilize all remaining disturbed areas in accordance with the permanent seeding notes. 2 DAYS
 - 11) With permission from the Sediment Control Inspector, remove all remaining sediment control devices, including stabilized construction entrance, silt fence, earth dikes and temporary rip-rap inflow protection at the end of the earth dike. Convert the sediment trap into permanent stormwater management pond per approved grading plan and SWM construction detail sheet. Install forebays 'A' and 'B'. Stabilize all remaining disturbed areas in accordance with the permanent seeding notes. 10 DAYS
- TOTAL TIME: 146 DAYS

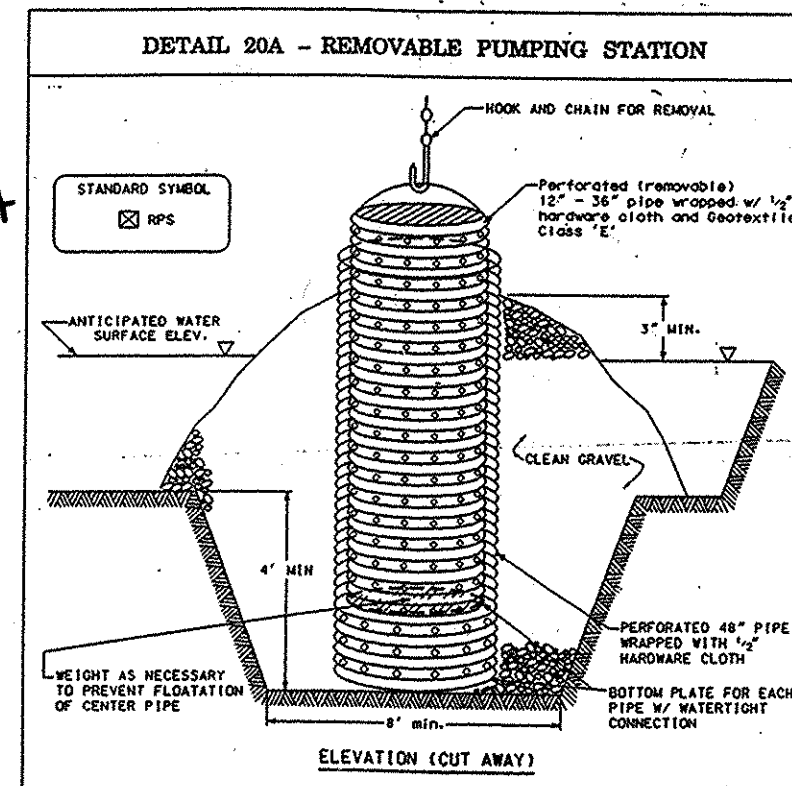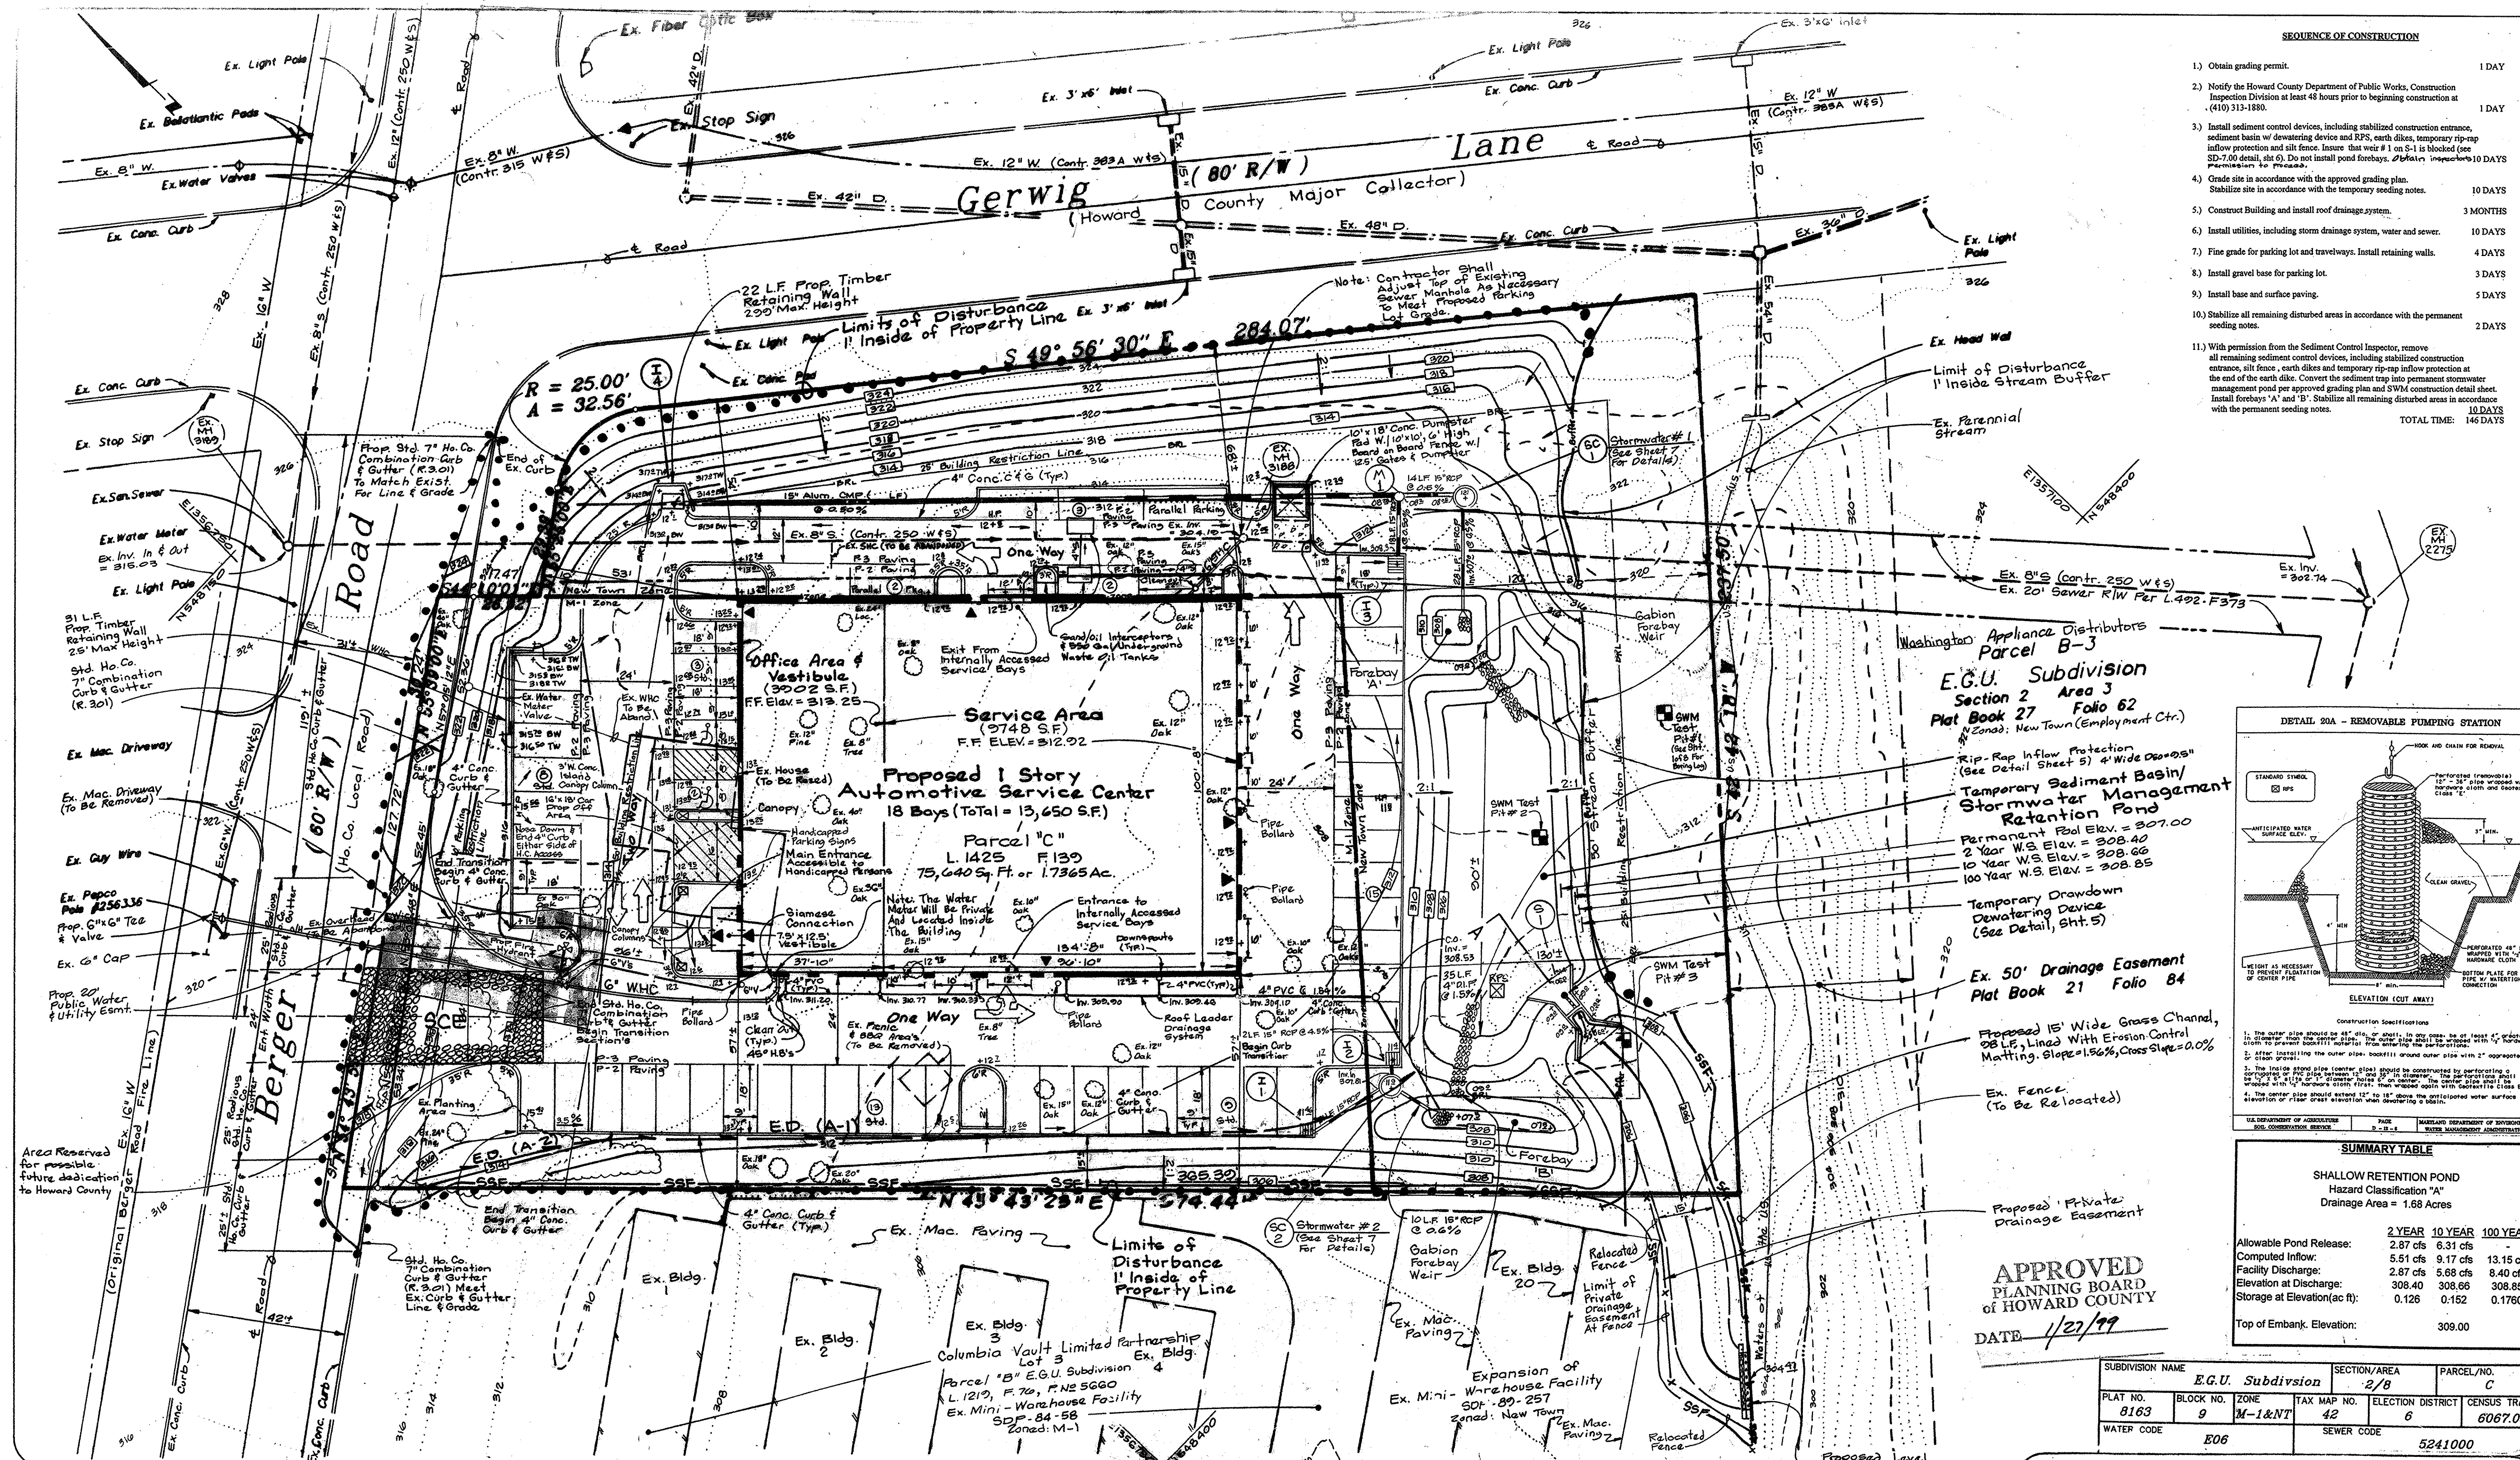

CONSTRUCTION SPECIFICATIONS

1. The outer pipe should be 48" dia. or larger. It should be at least 4' exterior to the structure. The structure should be at least 2' exterior to the structure. The structure should be at least 2' exterior to the structure.
2. After installing the outer pipe, backfill around outer pipe with 2" aggregate.
3. The inner pipe should be constructed by perforating a 48" dia. pipe with 1/2" dia. holes. The perforations should be spaced with 12" between holes. The outer pipe should be spaced with 12" between holes. The outer pipe should be spaced with 12" between holes.
4. The outer pipe should extend 12" to 18" above the anticipated water surface elevation of clear water above the dewatering station.

SUMMARY TABLE

SHALLOW RETENTION POND
Hazard Classification "A"
Drainage Area = 1.68 Acres

	2 YEAR	10 YEAR	100 YEAR
Allowable Pond Release:	2.87 cfs	6.31 cfs	13.15 cfs
Computed Inflow:	5.51 cfs	9.17 cfs	13.15 cfs
Facility Discharge:	2.87 cfs	5.88 cfs	8.40 cfs
Elevation at Discharge:	308.40	308.66	308.85
Storage at Elevation (ac ft):	0.126	0.152	0.1760
Top of Embank. Elevation:	309.00		

SUBDIVISION NAME		SECTION/AREA		PARCEL/NO.	
E.G.U. Subdivision		2/B		C	
PLAT NO.	BLOCK NO.	ZONE	TAX MAP NO.	ELECTION DISTRICT	CENSUS TRACT
8163	9	M-1&NT	42	6	6067.03
WATER CODE		SEWER CODE			
E06		5241000			

APPROVED
PLANNING BOARD
OF HOWARD COUNTY
DATE 1/27/99

APPROVED: DEPARTMENT OF PLANNING AND ZONING

THESE PLANS HAVE BEEN REVIEWED FOR THE HOWARD SOIL CONSERVATION DISTRICT AND MEET THE TECHNICAL REQUIREMENTS.

[Signature] 3/1/99
CHIEF, DEVELOPMENT ENGINEERING DIVISION

[Signature] 3/2/99
CHIEF, DIVISION OF LAND DEVELOPMENT

THESE PLANS HAVE BEEN REVIEWED FOR THE HOWARD SOIL CONSERVATION DISTRICT AND MEET THE TECHNICAL REQUIREMENTS.

[Signature] 3/3/99
NATIONAL RESOURCE CONSERVATION SERVICE

THIS DEVELOPMENT PLAN IS APPROVED FOR SOIL EROSION AND SEDIMENT CONTROL BY THE HOWARD SOIL CONSERVATION DISTRICT.

[Signature] 3/3/99
HOWARD SOIL CONSERVATION DISTRICT

ENGINEER'S CERTIFICATE


I HEREBY CERTIFY THAT THE PLAN FOR EROSION AND SEDIMENT CONTROL REPRESENTS A PRACTICAL AND WORKABLE PLAN BASED ON MY PERSONAL KNOWLEDGE OF THE SITE AND THAT THE PLAN WAS PREPARED IN ACCORDANCE WITH REQUIREMENTS OF THE HOWARD SOIL CONSERVATION DISTRICT.

[Signature] 2/24/99
SIGNATURE OF ENGINEER

DEVELOPER'S CERTIFICATE

I HEREBY CERTIFY THAT ALL DEVELOPMENT AND/OR CONSTRUCTION WILL BE DONE ACCORDING TO THESE PLANS AND THAT I AM RESPONSIBLE FOR THE DESIGN AND CONSTRUCTION OF THE EROSION AND SEDIMENT CONTROL MEASURES. I ALSO AUTHORIZE PERIODIC ON-SITE INSPECTION BY THE HOWARD SOIL CONSERVATION DISTRICT OR THEIR AUTHORIZED AGENTS AS DEEMED NECESSARY.

[Signature] 2/23/99
DATE

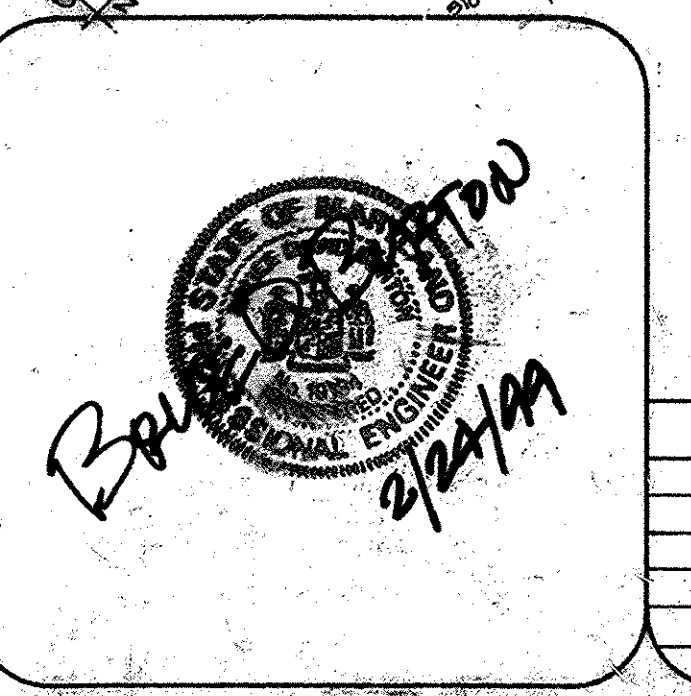

Sediment Basin Schedule

Basin No.	Max. D.A. Acres	Dry Stor. Req'd #3	Wet Stor. Req'd #3	Dry Stor. Prov'd #3	Wet Stor. Prov'd #3	Wet Stor. Elev. ft.	Dry Stor. Elev. ft.	Weir Length ft.	Bottom Elev. ft.	Clean Elev. ft.	Weir Depth ft.	Top Elev. ft.	Basin Size	Type
1	1.68	3024	3024	3024	3024	1.9	307.9	307.1	308	308.6	1.1	309	see plan	Basin

** Top of embankment elevation.
*** Concrete outlet structure consists of a .55' weir, Inv.=307.9 and a 4.0' weir, Inv.=308.38.

REVISIONS

No.	Date	By	Description
1	4-28-99	SMC	Revised H.C. Parking and Associated grading in front of building for revised canopy column locations added (1) parking spaces on east of building and revised exterior bollard locations.

LDE, INC.
9250 Rumsey Road, Suite 106, Columbia, MD. 21045
(410) 715-1070 (301) 596-3424 (410) 715-9540 (Fax)

DESIGNED: Grading and Sediment Control Plan
SDH


DRAWN: British And American Auto Care, Inc.
SMC

CHECKED: Columbia
B.D.B. E.G.U. Subdivision
Parcel "C"

DATE: 4/98
KAL: 7/98
4/98

OWNER/DEVELOPER: British And American Auto Care, Inc.
2935 Berger Road
Columbia, Maryland 21046
(410) 381-2700

SCALE: 1" = 20'
DRAWING: 3 of 9
JOB NO.: 98-010
FILE NO.: SDP 98-132

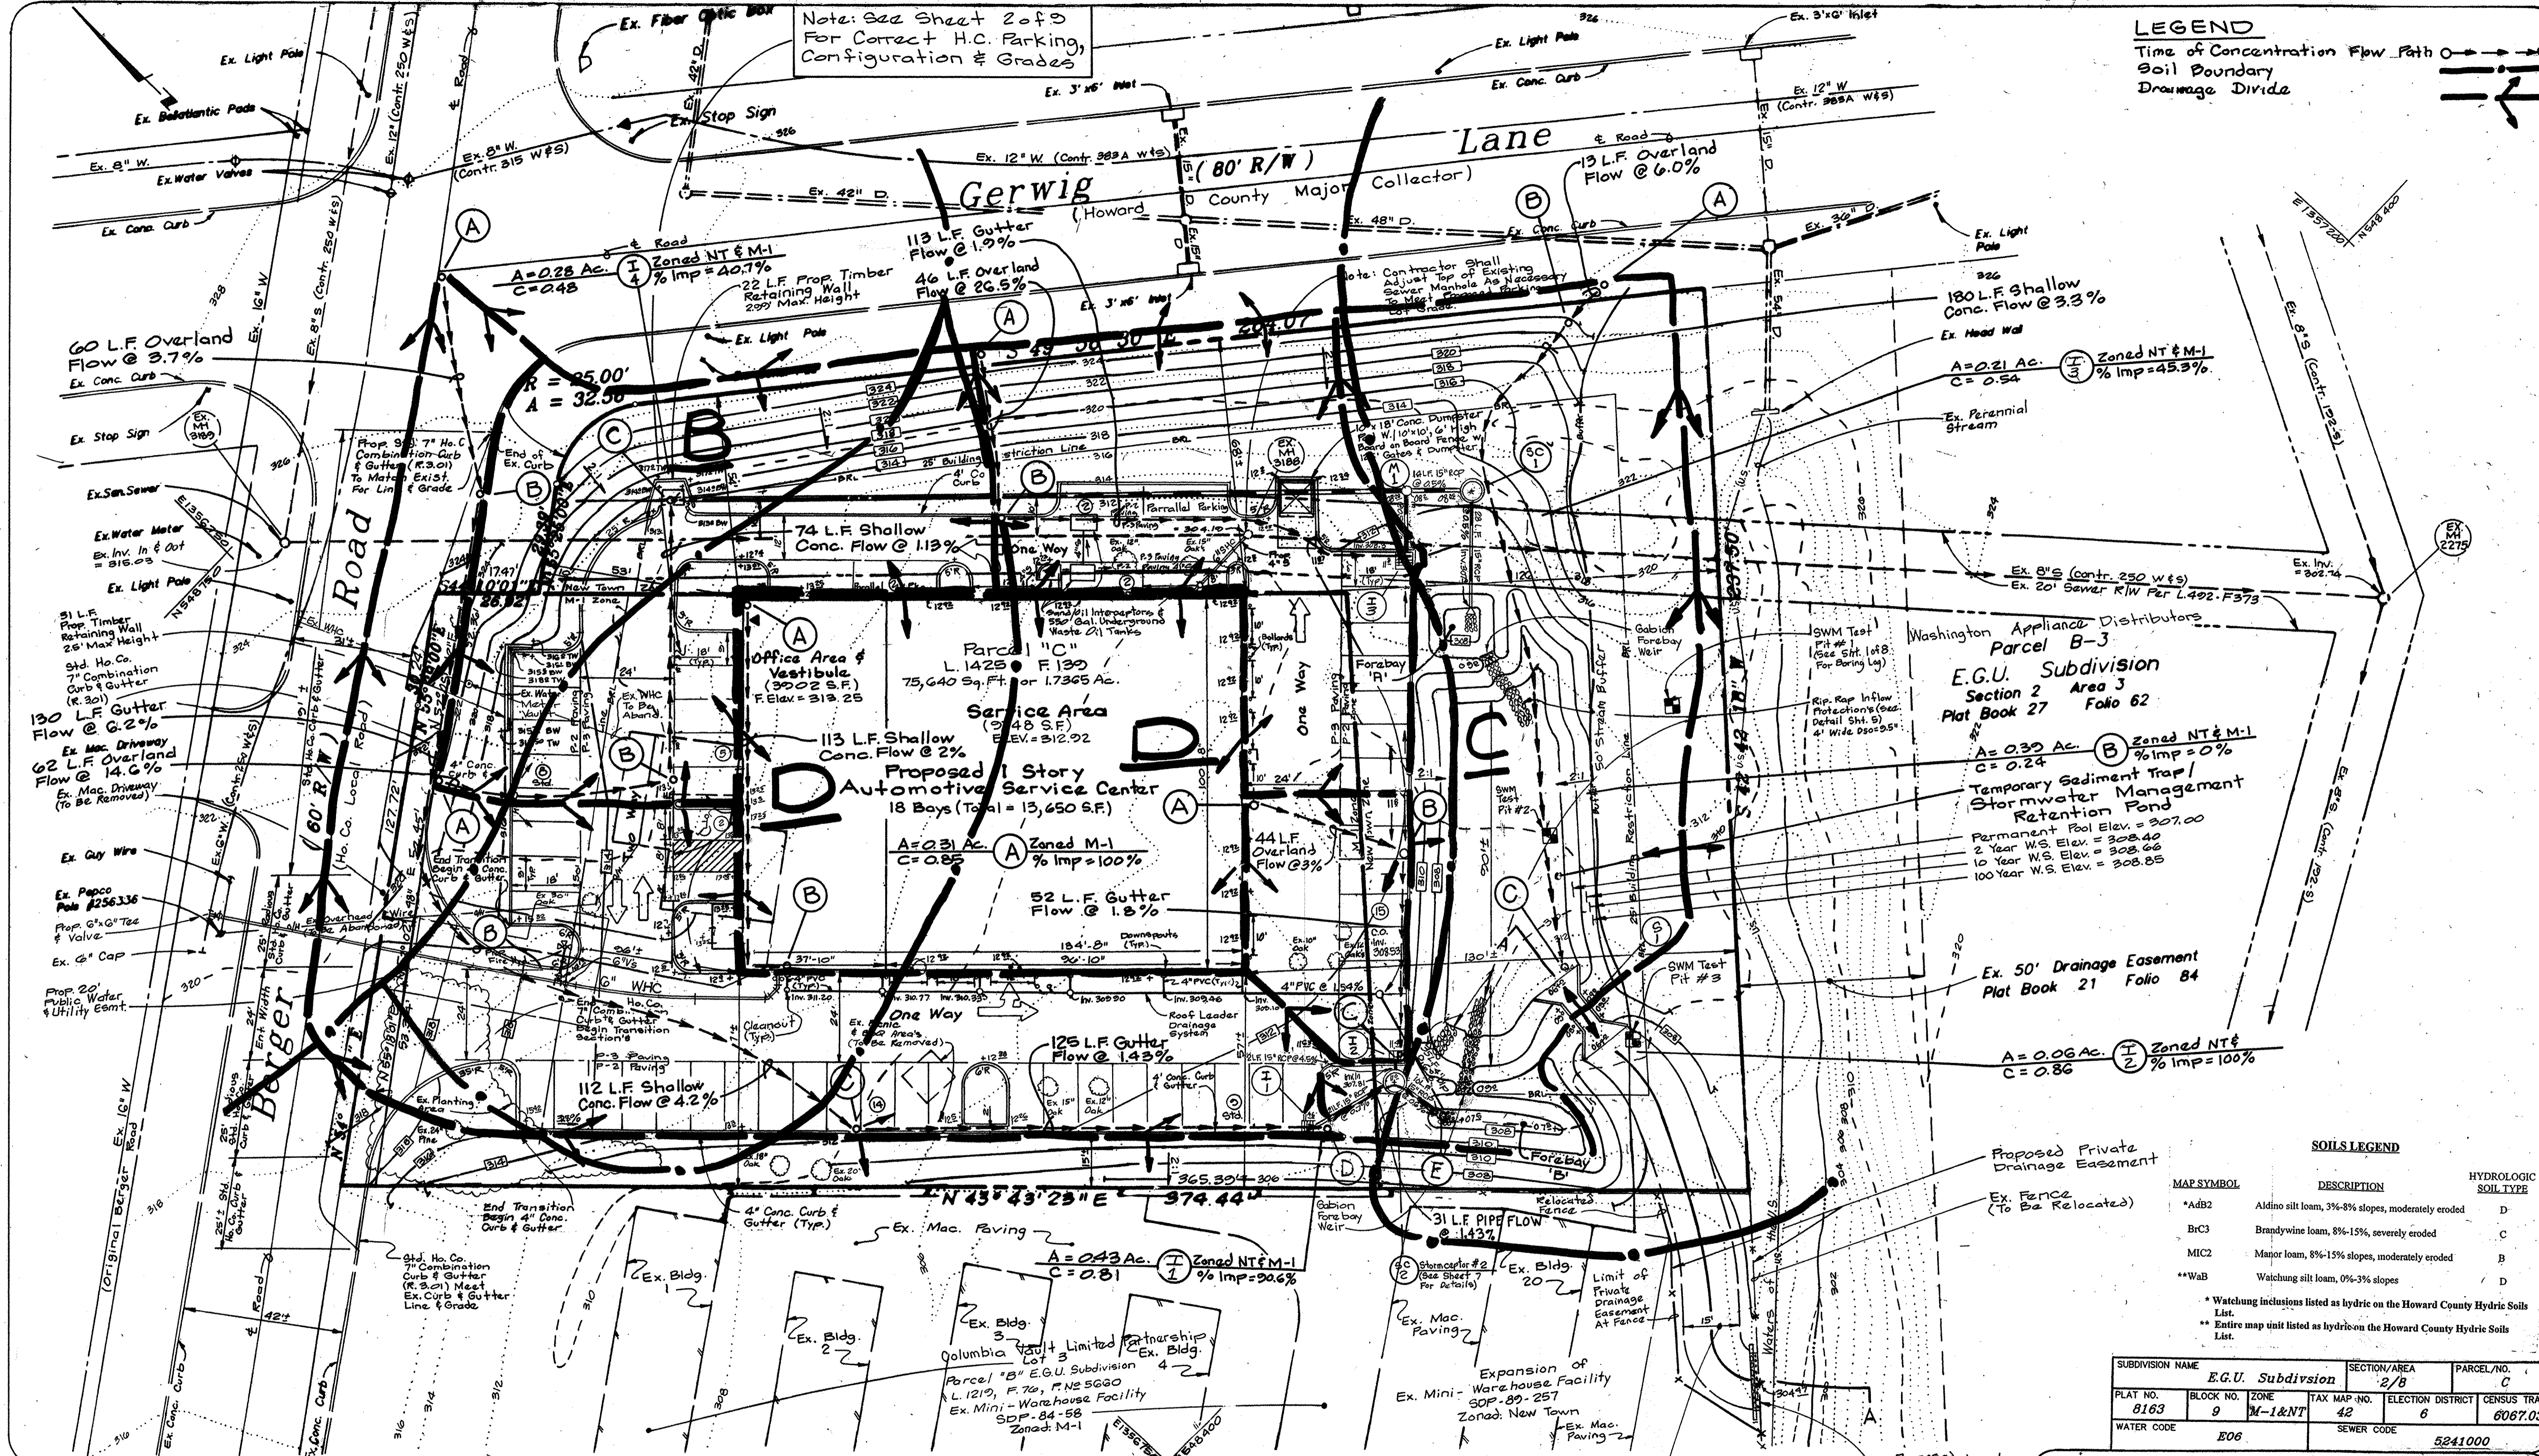

LEGEND
 Time of Concentration Flow Path
 Soil Boundary
 Drainage Divide

SOILS LEGEND

MAP SYMBOL	DESCRIPTION	HYDROLOGIC SOIL TYPE
*AD2	Aldino silt loam, 3%-8% slopes, moderately eroded	D
BR3	Brandywine loam, 8%-15%, severely eroded	C
MIC2	Major loam, 8%-15% slopes, moderately eroded	B
**W8	Watchung silt loam, 0%-3% slopes	D

* Watchung inclusions listed as hydric on the Howard County Hydric Soils List.
 ** Entire map unit listed as hydric on the Howard County Hydric Soils List.

SUBDIVISION NAME: E.G.U. Subdivision				SECTION/AREA: 2/B	PARCEL NO.: C
PLAT NO.: 8163	BLOCK NO.: 9	ZONE: M-1&NT	TAX MAP NO.: 42	ELECTION DISTRICT: 6	CENSUS TRACT: 6067.03
WATER CODE: E06			SEWER CODE: 5241000		

LDE, INC.
 9250 Rumsey Road, Suite 106, Columbia, MD. 21045
 (410) 715-1070 (301) 596-3424 (410) 715-9540 (Fax)

DESIGNED: SDH
 DRAWN: SMC
 CHECKED: B.D.B.

Drainage Area And Soils Map
 British And American Auto Care, Inc.
 Columbia
 E.G.U. Subdivision
 Parcel "C"

Tax Map 42, P/O Parcel 386, Grid 9
 6th Election District
 Howard County, Maryland

Owner/Developer: Brian Engano
 British And American Auto Care Inc.
 9235 Berger Road
 Columbia, Maryland 21046
 (410) 381-2700

DATE: 7/98
 REV: 4/98

SCALE: 1" = 20'
 DRAWING: 4 of 5
 JOB NO.: 98-010
 FILE NO.: SDP-08-132

APPROVED PLANNING BOARD OF HOWARD COUNTY
 DATE: 1/27/99

REVISIONS

No.	Date	By	Description
1	4-28-99	SMC	Added Note See Sht 2 of 3 for H.C. parking, Configuration & Grades

Proposed 15' Wide Grass Channel, 98 L.F., Lined With Erosion Control Matting.
 Slope = 1.50%
 Cross Slope = 2.00%
 2 Yr. Q = 2.87 cfs
 2 Yr. V = 1.51 fps
 2 Yr. D = 0.12 ft.
 10 Yr. Q = 5.68 cfs
 10 Yr. V = 1.96 fps
 10 Yr. D = 0.19 ft.
 100 Yr. Q = 8.40 cfs
 100 Yr. V = 2.28 fps
 100 Yr. D = 0.23 ft.

ENGINEER'S CERTIFICATE
 I HEREBY CERTIFY THAT THE EROSION AND SEDIMENT CONTROL REPRESENTS A PRACTICAL AND FEASIBLE PLAN BASED ON MY PERSONAL KNOWLEDGE OF THE SITE AND THE INFORMATION THAT IT WAS PREPARED IN ACCORDANCE WITH REGULATIONS ON EROSION AND SEDIMENT CONTROL DISTRICT.

SIGNATURE OF ENGINEER: [Signature]
 DATE: 1/23/99

DEVELOPER'S CERTIFICATE
 I HEREBY CERTIFY THAT ALL DEVELOPMENT AND/OR CONSTRUCTION WILL BE DONE ACCORDING TO THESE PLANS AND THAT ANY RESPONSIBLE PERSONNEL INVOLVED IN THE CONSTRUCTION PROJECT WILL HAVE A CERTIFICATE OF ATTENDANCE AT A DEPARTMENT OF THE ENVIRONMENT APPROVED TRAINING PROGRAM FOR THE CONTROL OF SEDIMENT AND EROSION DURING THE CONSTRUCTION OF THE PROJECT. I ALSO AUTHORIZE PERIODIC ON-SITE INSPECTION BY HOWARD SOIL CONSERVATION DISTRICT OR THEIR AUTHORIZED AGENTS, IF DEEMED NECESSARY.

SIGNATURE OF DEVELOPER: [Signature]
 DATE: 2/23/99

THESE PLANS HAVE BEEN REVIEWED FOR THE HOWARD SOIL CONSERVATION DISTRICT AND MEET THE TECHNICAL REQUIREMENTS.

NATURAL RESOURCE CONSERVATION SERVICE
 SIGNATURE: [Signature]
 DATE: 3/3/99

THIS DEVELOPMENT PLAN IS APPROVED FOR SOIL EROSION AND SEDIMENT CONTROL BY THE HOWARD SOIL CONSERVATION DISTRICT.

HOWARD SOIL CONSERVATION DISTRICT
 SIGNATURE: [Signature]
 DATE: 3/3/99

APPROVED: DEPARTMENT OF PLANNING AND ZONING

CHIEF, DEVELOPMENT ENGINEERING DIVISION
 SIGNATURE: [Signature]
 DATE: 3/1/99

CHIEF, DIVISION OF LAND DEVELOPMENT
 SIGNATURE: [Signature]
 DATE: 3/1/99

DATE: 3/11/99

4.0 Installation Procedures

The installation of the concrete Stormceptor® should conform in general to state highway or local specifications for the construction of manholes. Selected sections of a general specification that are applicable are summarized in the following sections.

Excavation
Excavation for the installation of the Stormceptor® should conform to state highway or local specifications. Topsoil that is removed during the excavation for the Stormceptor® should be stockpiled in designated areas and should not be mixed with subsoil or other materials. Topsoil stockpiles, and the general site preparation for the installation of the Stormceptor® should conform to state highway or local specifications.

The Stormceptor® should not be installed on frozen ground. Excavation should extend a minimum of 12 inches from the precast concrete surfaces plus an allowance for shoring and bracing where required. If the bottom of the excavation provides an unsuitable foundation additional excavation may be required.

In areas with a high water table, continuous dewatering should be provided to ensure that the excavation is stable and free of water.

Leveling
A 6 to 12 inch layer of granular material (conforming to local or state highway backfill specifications) should be compacted, and leveled at the bottom of the excavation to the proper elevation for the installation of the interceptor base.

Backfilling
Backfill material should conform to state highway or local specifications. Generally, backfill material should be placed in uniform layers not exceeding 12 inches in depth. Each layer should be compacted to the density required by local/state guidelines. Backfill is not to contain topsoil.

Stormceptor® Construction Sequence
The concrete Stormceptor® is installed in sections in the following sequence:
1. aggregate base
2. base slab
3. treatment chamber section(s)
4. transition slab (if required)
5. by-pass section with insert
6. connect inlet and outlet pipes
7. riser section and/or transition slab (if required)
8. maintenance riser section(s) (if required)
9. top slab oriented with clear access to vent and 24" opening
10. frame and access cover

The precast base should be placed level at the specified grade. The entire base should be in contact with the underlying compacted granular material. Subsequent sections, complete with joint seals, should be installed in accordance with the precast concrete manufacturer's recommendations.

Adjustment of the Stormceptor® can be performed by lifting the upper sections free of the excavated area, re-leveling the base, and re-installing the sections. Damaged sections and gaskets should be repaired or replaced as necessary. Once the Stormceptor® has been constructed, the lift holes should be plugged and mounted inside and outside.

Down Pipe and Riser Pipe
Once the by-pass section has been attached to the lower treatment chamber, the inlet down pipe, and outlet riser pipe can be attached. To install the inlet down pipe a worker enters the lower treatment chamber through the outlet riser pipe opening (24 inch diameter) in the by-pass section.

The inlet drop pipe is installed by coating the outside of the pipe with glue and pushing the pipe into the coupling. Chemrexx 948 caulking should be applied to the connection once the inlet drop pipe is securely in place. The seal at the end of the inlet drop pipe must be oriented such that water which enters the treatment chamber is directed tangentially around the inside walls of the chamber.


The outlet riser pipe (24 inch diameter) should be installed from the top of the fiberglass disc by sliding the pipe that is provided into the existing 24" sleeve from above. The 24" diameter pipe is manufactured with a flange on the end. Chemrexx 948 caulking should be applied underneath the flange to act as a permanent seal before the pipe is secured in place. Pressure should be carefully applied to the top of the flange to ensure that the pipe is fully extended into the lower chamber (i.e. the top elevation of the flange is level with the surrounding fiberglass disc) and that the caulking evenly seals the pipe in place.

Inlet and Outlet Pipes
Inlet and outlet pipes should be securely set into the by-pass chamber using grommet or approved pipe seals so that the structure is watertight. Flexible rubber boots are normally used and installed at the precast concrete plant prior to shipping. The flexible boots are applicable for pipes with an outside diameter up to 42 inches. The local Stormceptor affiliate should be notified if the pipe is to be grommeted in the field at the time of ordering since the boots are generally included in the price quotation.


Installation of the flexible boots should follow the manufacturer's recommendations. As previously mentioned, the boots will already be attached to the Stormceptor® at the manufacturer's plant.

Top Slab and Access Opening Installation
The final concrete piece to be installed is the top slab with the 30 inch access opening. Proper positioning of the top slab is extremely important to the proper operation and maintenance of the Stormceptor. The 30 inch opening must be positioned so the 6" vent pipe and the 24" discharge opening are both accessible from the surface opening (see drawing after page 25).




Frame and Cover Installation
Stormceptor provides a standard cast iron frame and cover with the name Stormceptor clearly embossed on it. Precast concrete adjustment units should be installed to set the frame and cover at the required elevation. The adjustment units should be laid in a full bed of mortar with successive units being joined using sealant recommended by the manufacturer. Frames for the cover should be set in a full bed of mortar at the elevation specified.

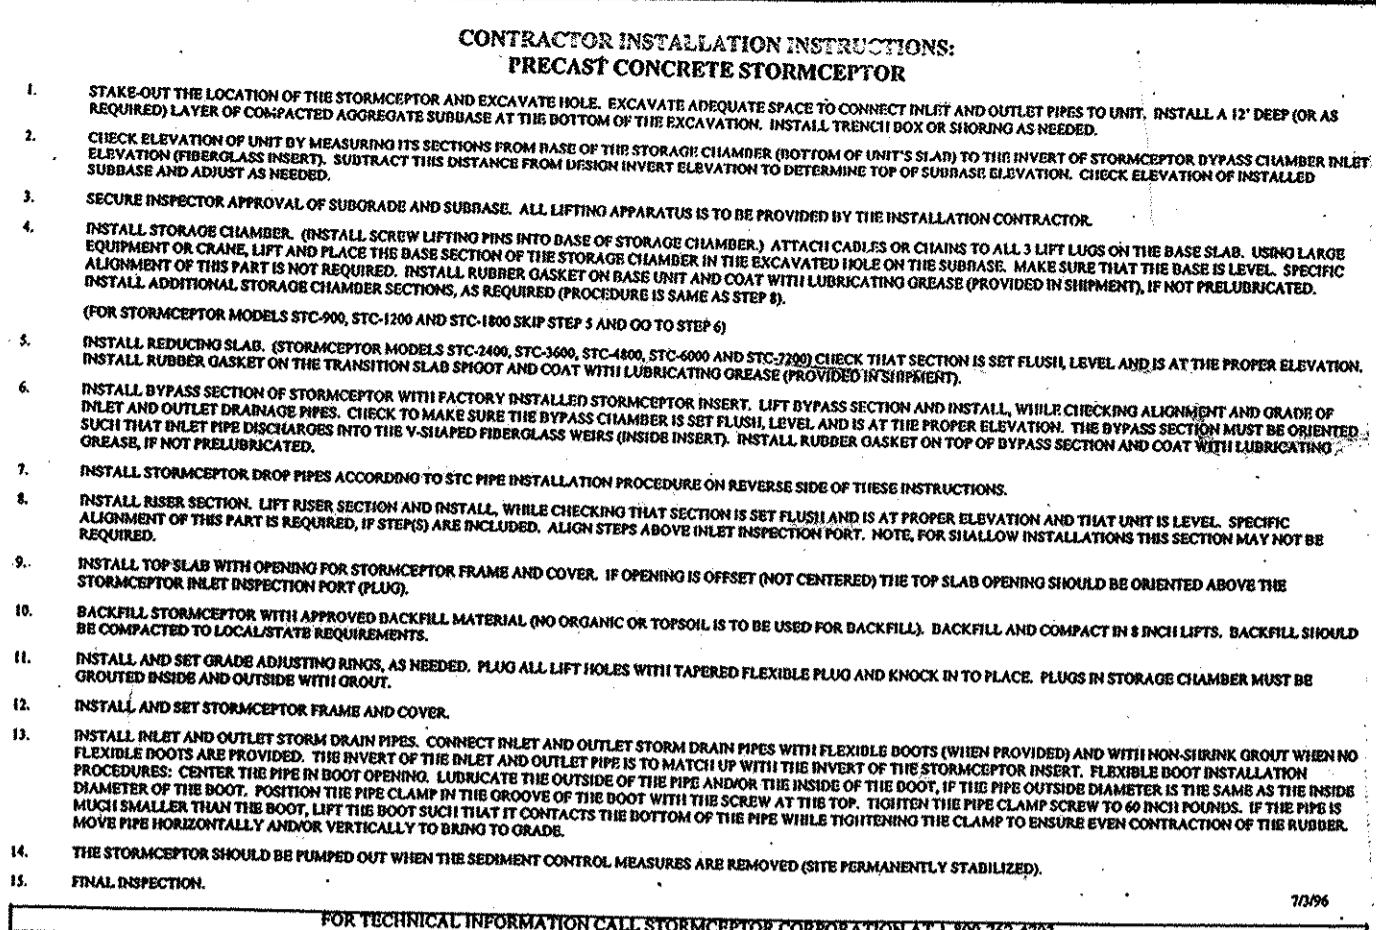

FOR TECHNICAL INFORMATION CALL STORMCEPTOR CORPORATION AT 1-800-762-4703


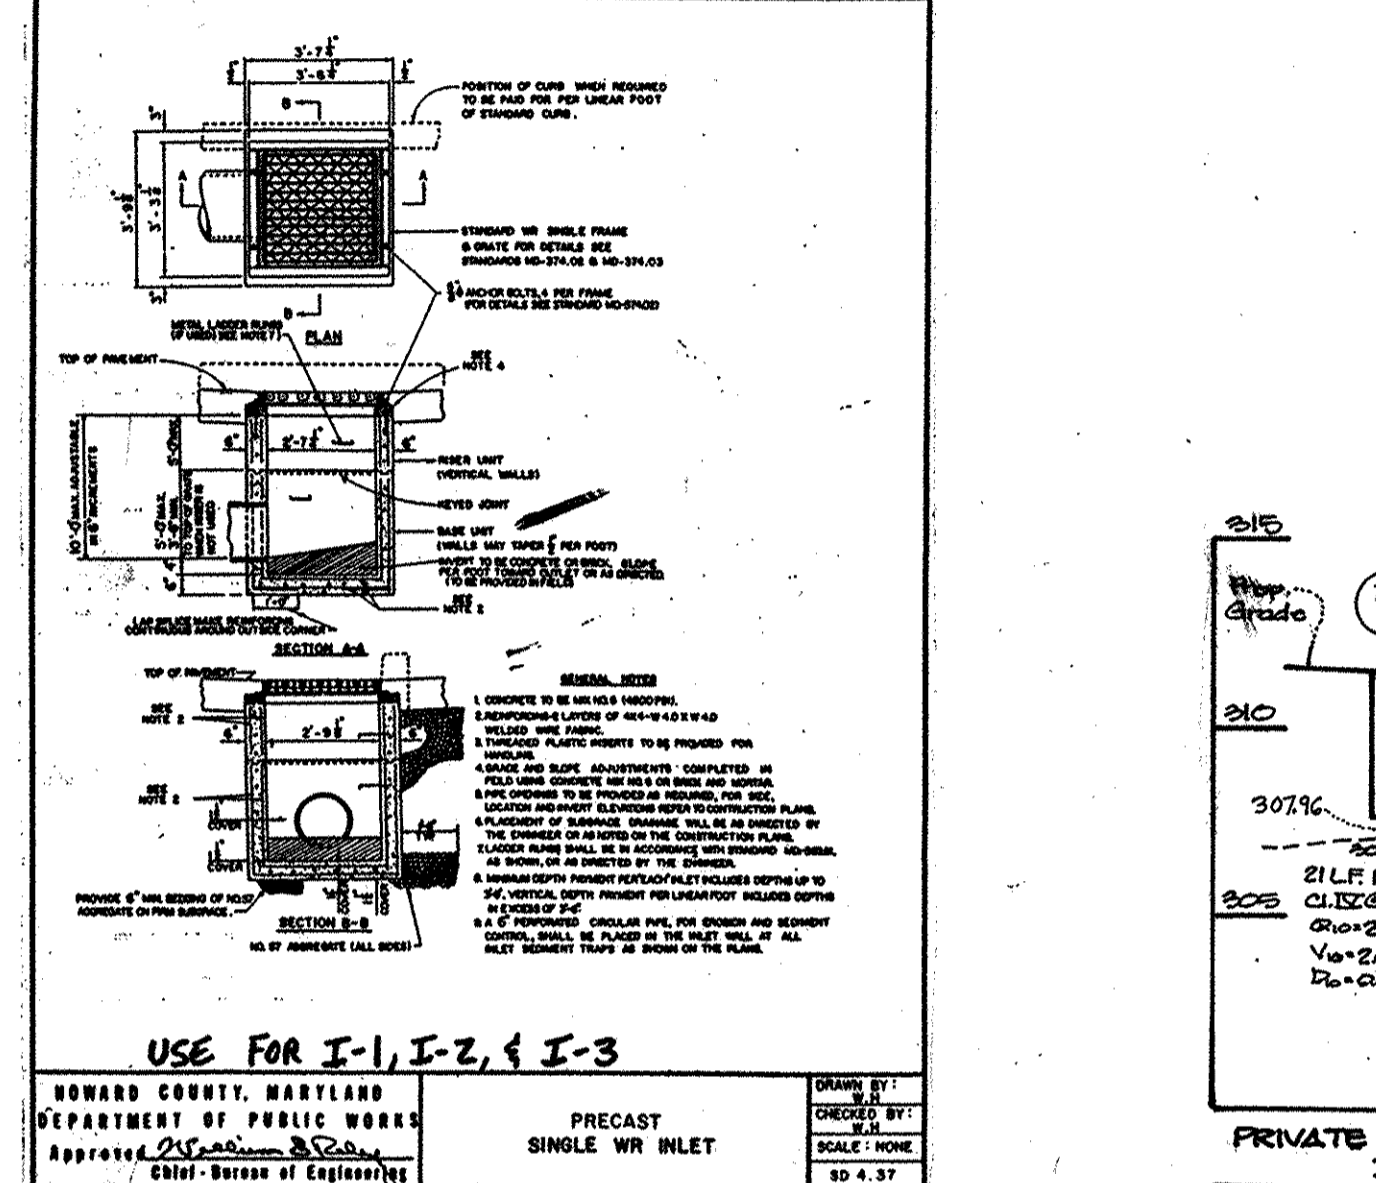


PRECAST SINGLE WR INLET

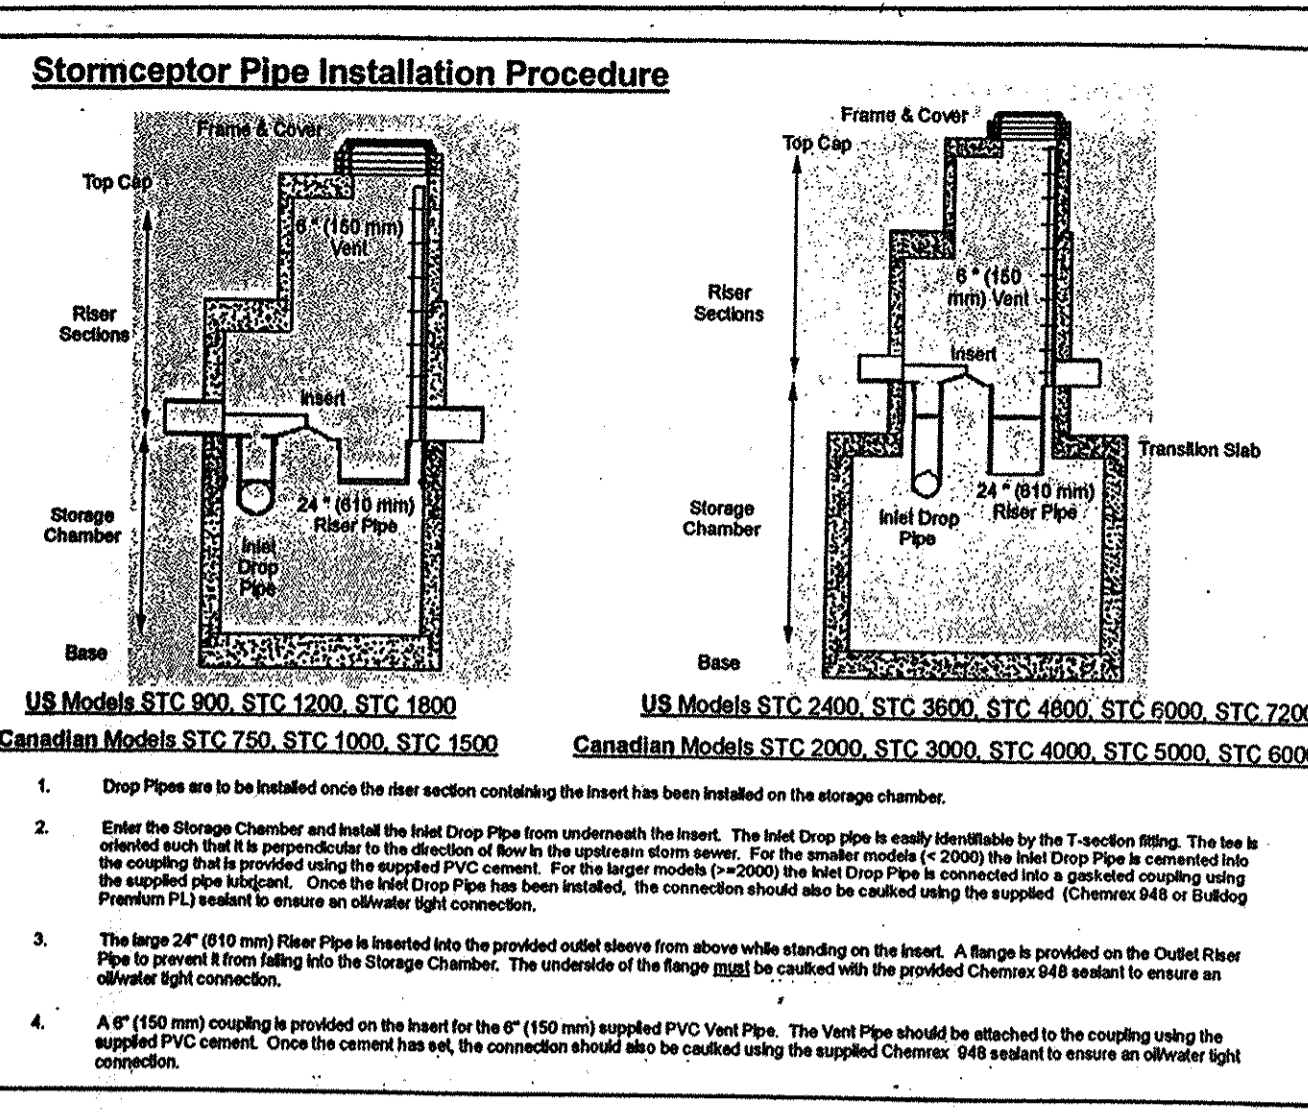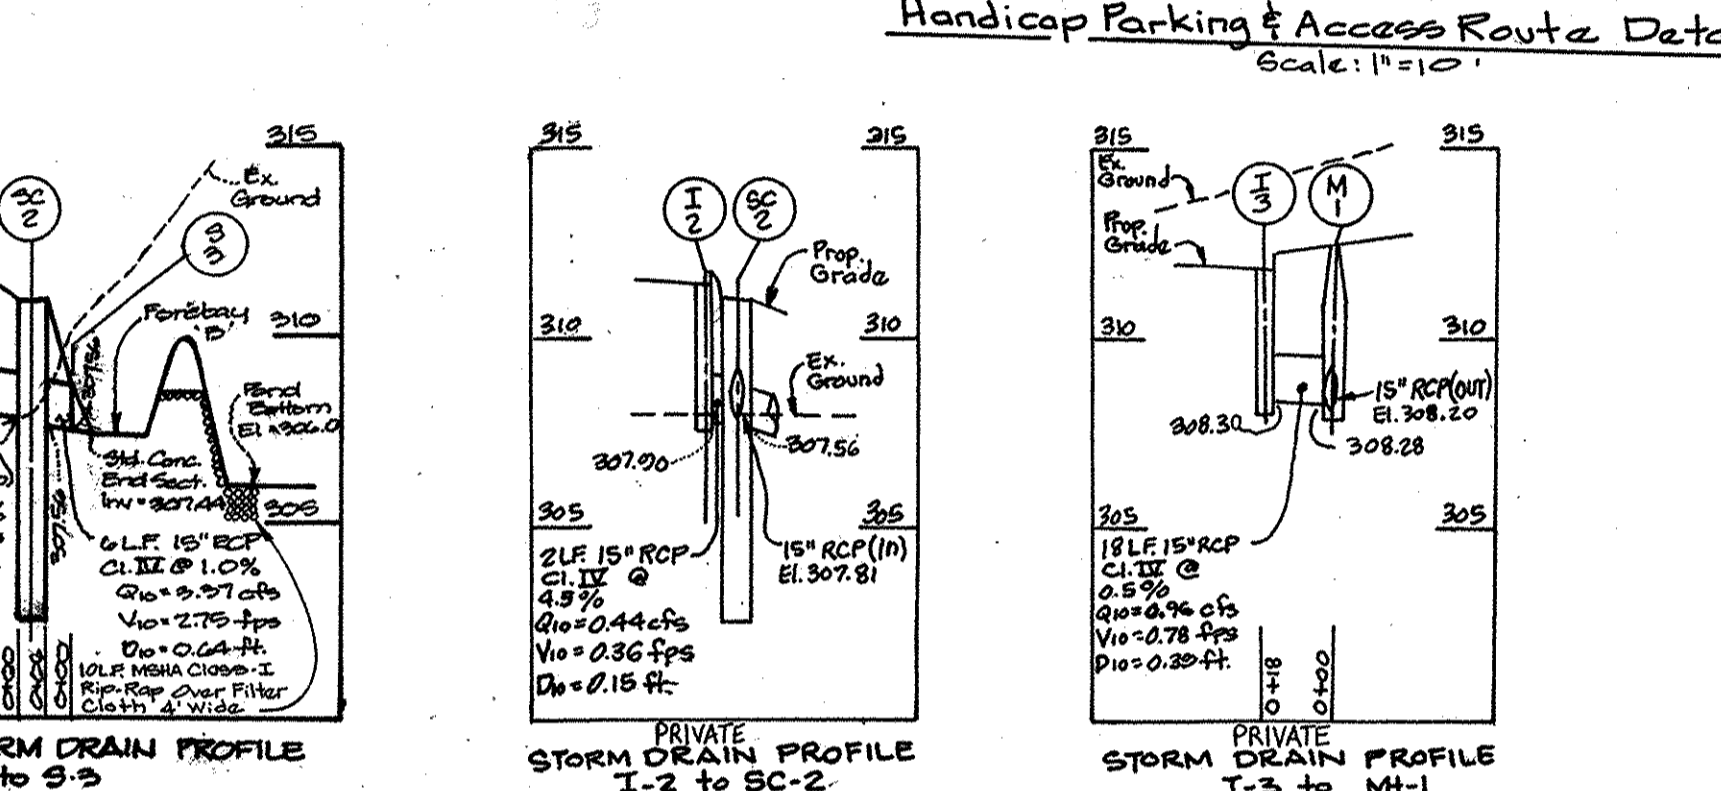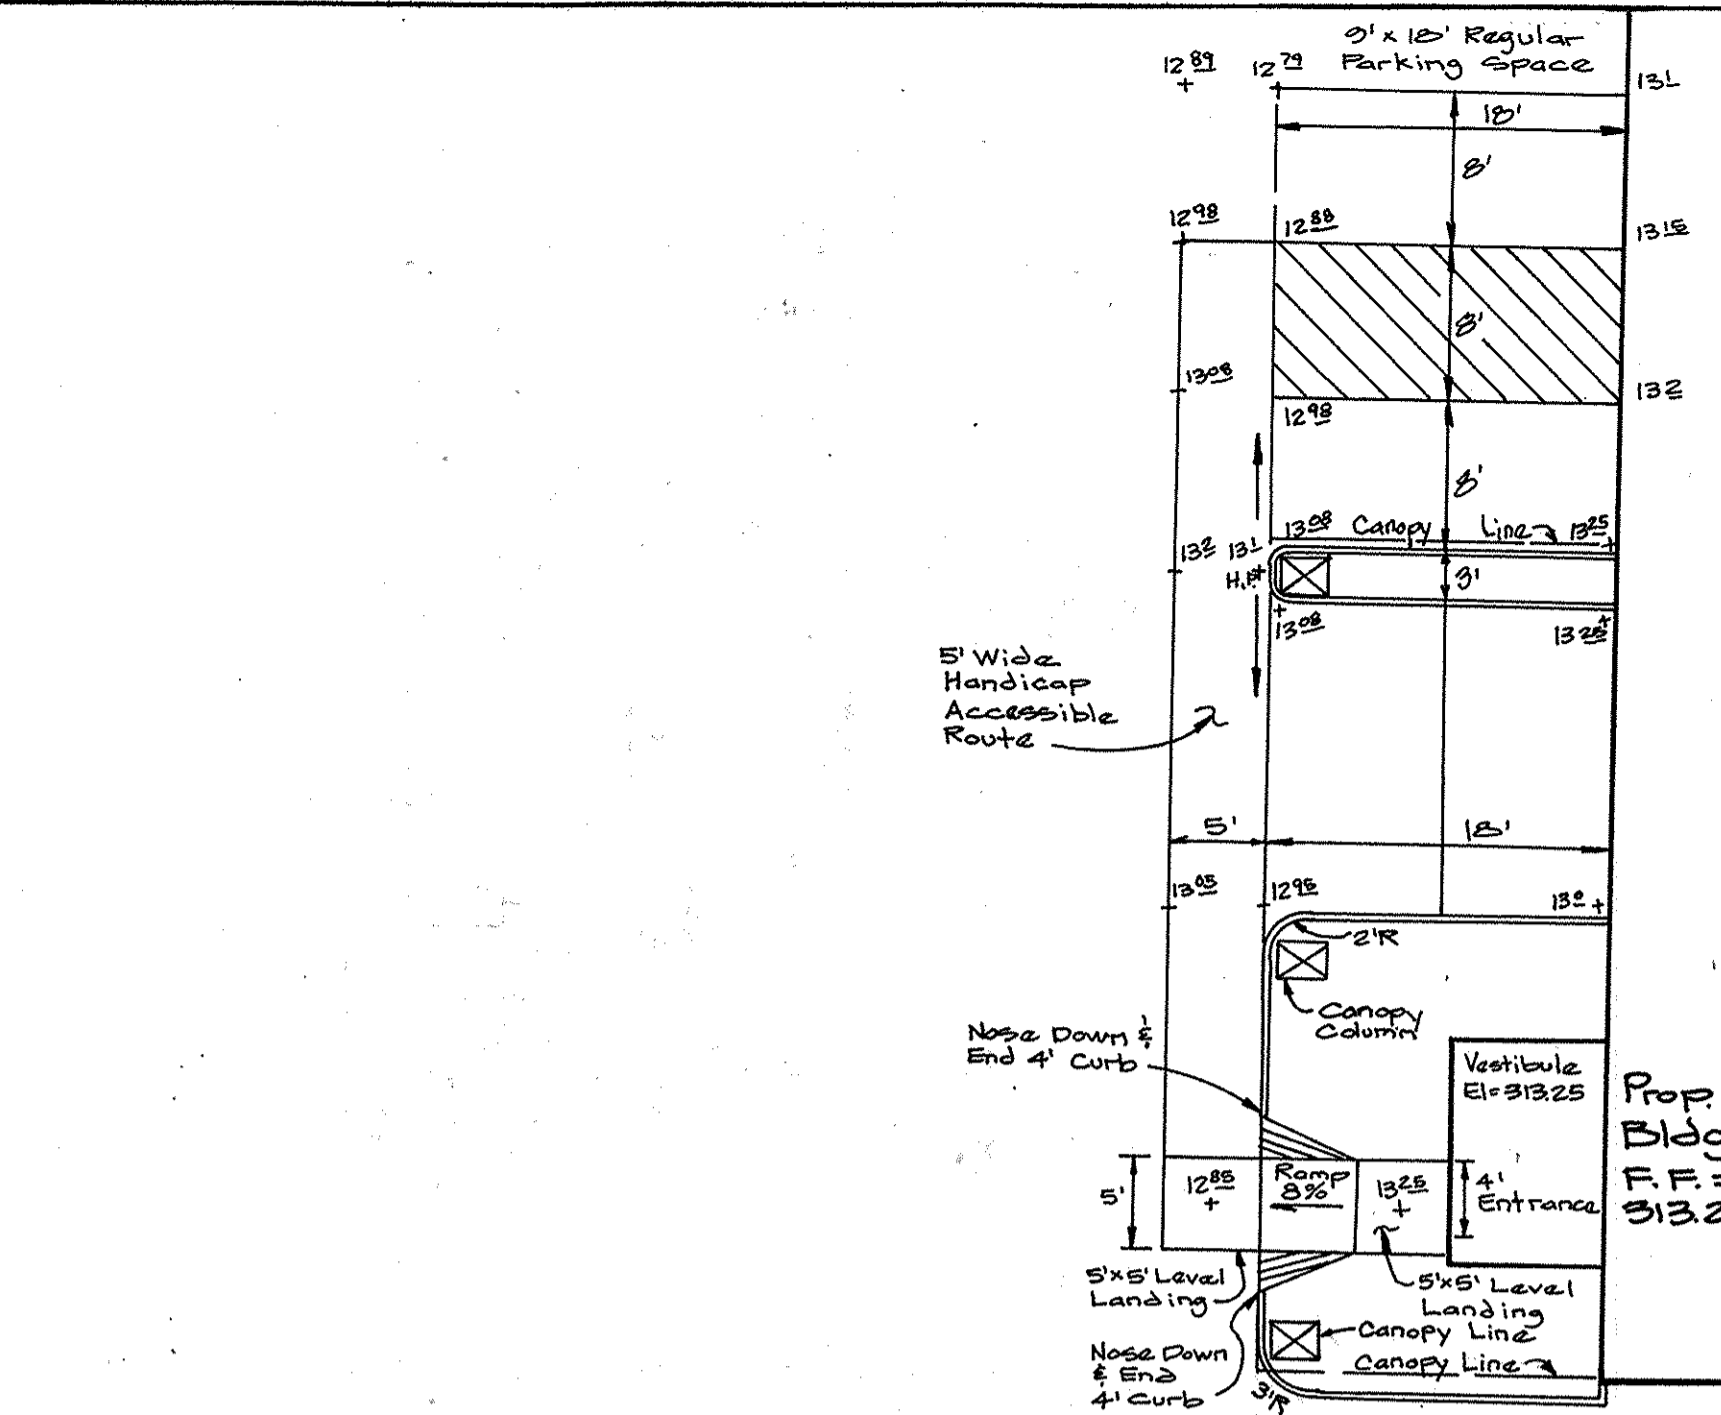


OPERATION AND MAINTENANCE SCHEDULE FOR STORMCEPTORS

- Owner's Maintenance Responsibilities:
1. Both Stormceptors shall be inspected annually for sediment and oil build up and inlet or outlet pipe obstructions.
2. When the sediment depth in the bottom of the structure exceeds 6 inches or excessive oil is observed in the structure, maintenance is required.
3. Maintenance of the structures is performed using a vacuum truck. Maintenance is required at least once annually or as indicated by visual inspection.
4. Oil shall be removed through the 6 inch vents. Sediment shall be removed through the 24 inch diameter outlet riser pipes.
5. In the event of an oil spill the Stormceptors shall be cleaned immediately by a licensed liquid waste hauler.
6. Based on visual inspection of the structures during the initial year of operation the Owner shall determine if maintenance is required more than once annually.

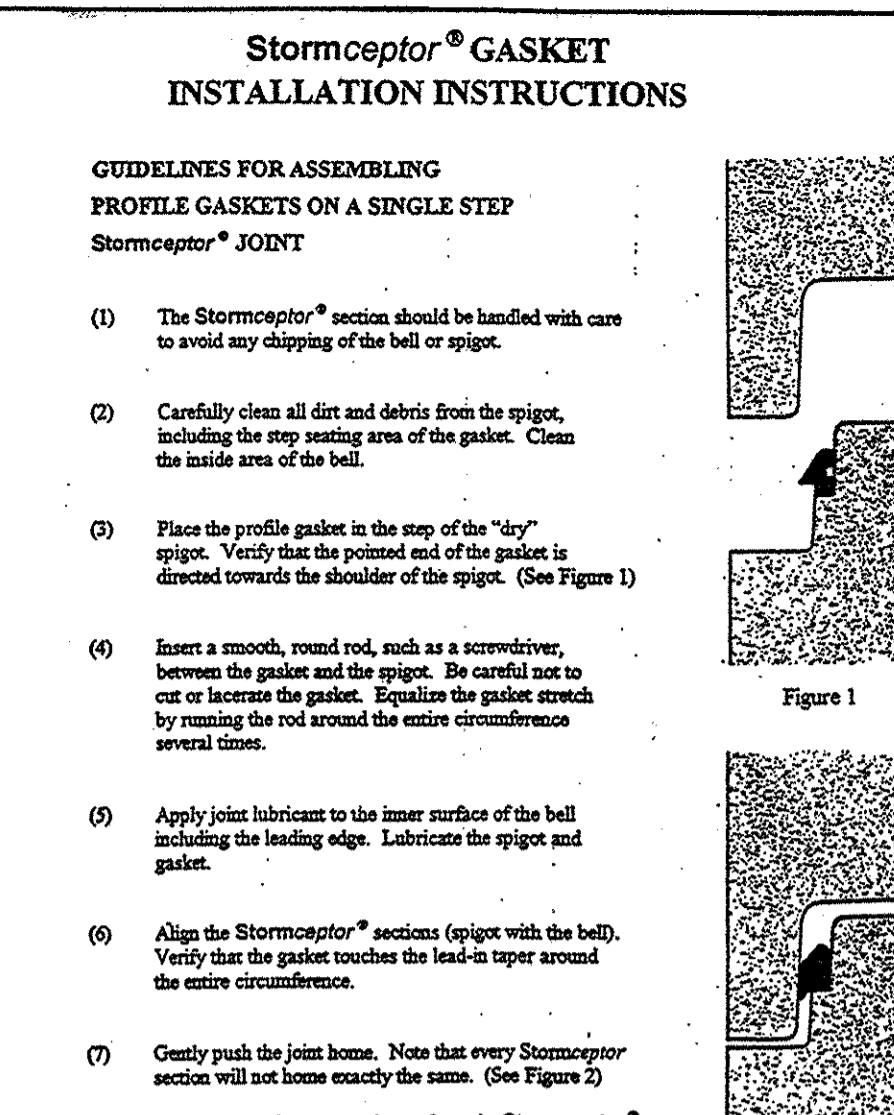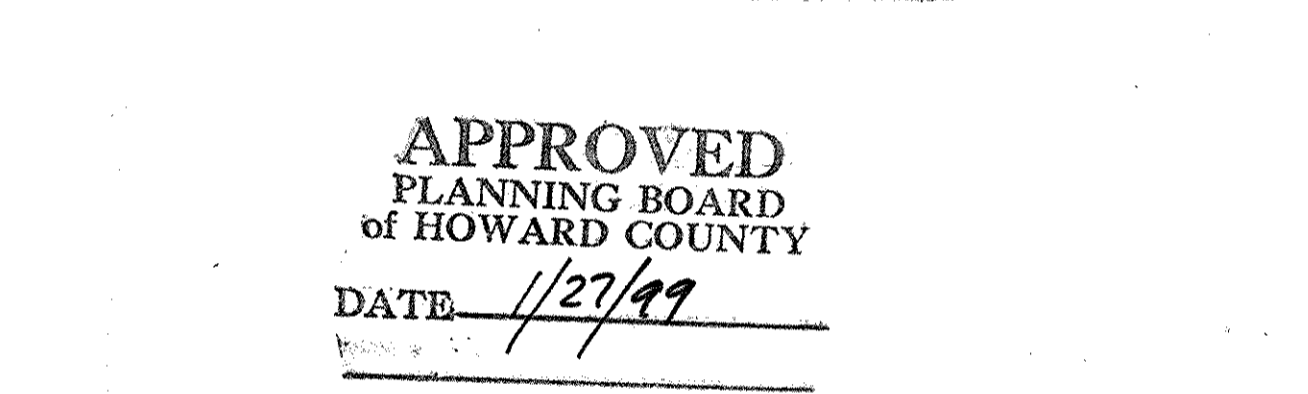



GUIDELINES FOR ASSEMBLING PROFILE GASKETS ON A SINGLE STEP Stormceptor® JOINT

- (1) The Stormceptor® section should be handled with care to avoid any chipping of the bell or spigot.
(2) Carefully clean all dirt and debris from the spigot, including the step seating area of the gasket. Clean the inside area of the bell.
(3) Place the profile gasket in the step of the "dry" spigot. Verify that the pointed end of the gasket is directed towards the shoulder of the spigot.
(4) Insert a smooth, round rod, such as a screwdriver, between the gasket and the spigot. Be careful not to cut or sever the gasket. Equalize the gasket stretch by turning the rod around the entire circumference several times.
(5) Apply joint lubricant to the inner surface of the bell including the leading edge. Lubricate the spigot and gasket.
(6) Align the Stormceptor® sections (spigot with the bell). Verify that the gasket touches the lead-in taper around the entire circumference.
(7) Gently push the joint home. Note that every Stormceptor section will not have exactly the same.
(8) If jointing problems arise, do not force the Stormceptor® sections together. Grading may occur. Contact CSR Hydro Coatings immediately.

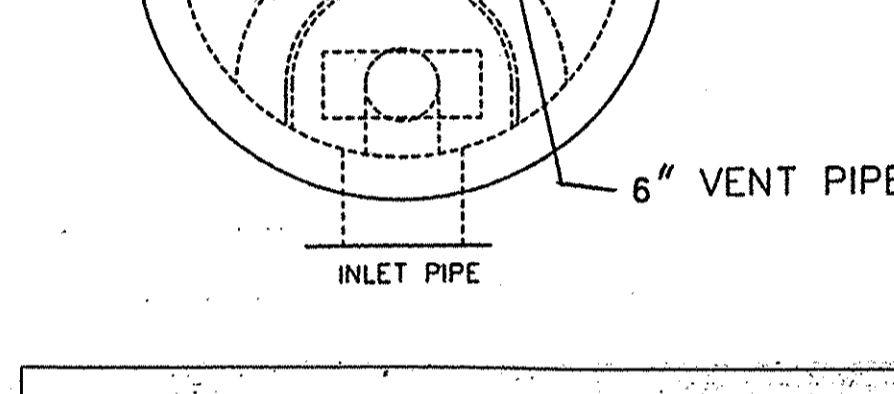

5C-1 Concrete Stormceptor® Order Request Form. A form for ordering a Stormceptor unit. It includes sections for Contractor Information, Owner Information, Stormceptor Model, and Project Information. It also includes a diagram of the Stormceptor unit and a list of specifications.

5C-2 Concrete Stormceptor® Order Request Form. A form for ordering a Stormceptor unit. It includes sections for Contractor Information, Owner Information, Stormceptor Model, and Project Information. It also includes a diagram of the Stormceptor unit and a list of specifications.

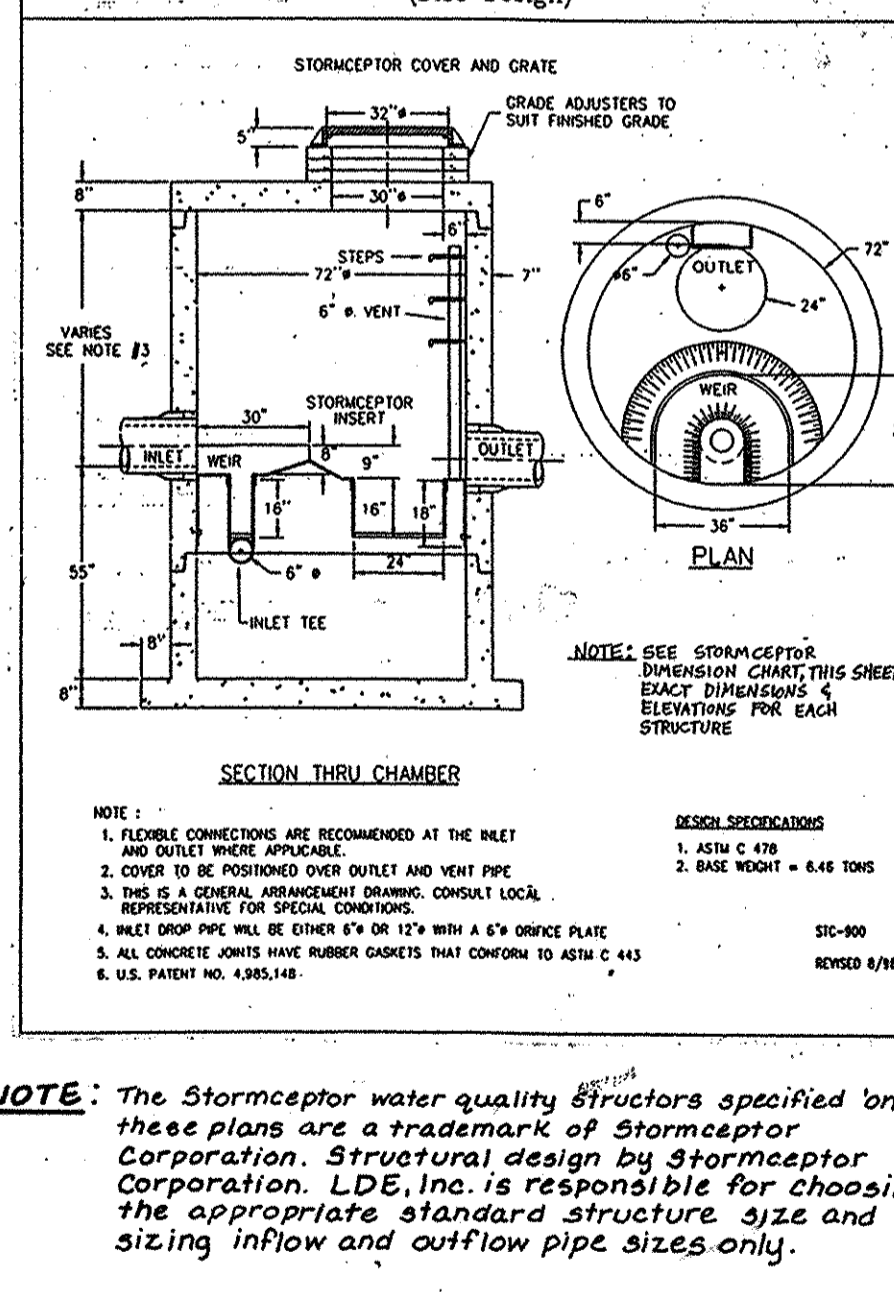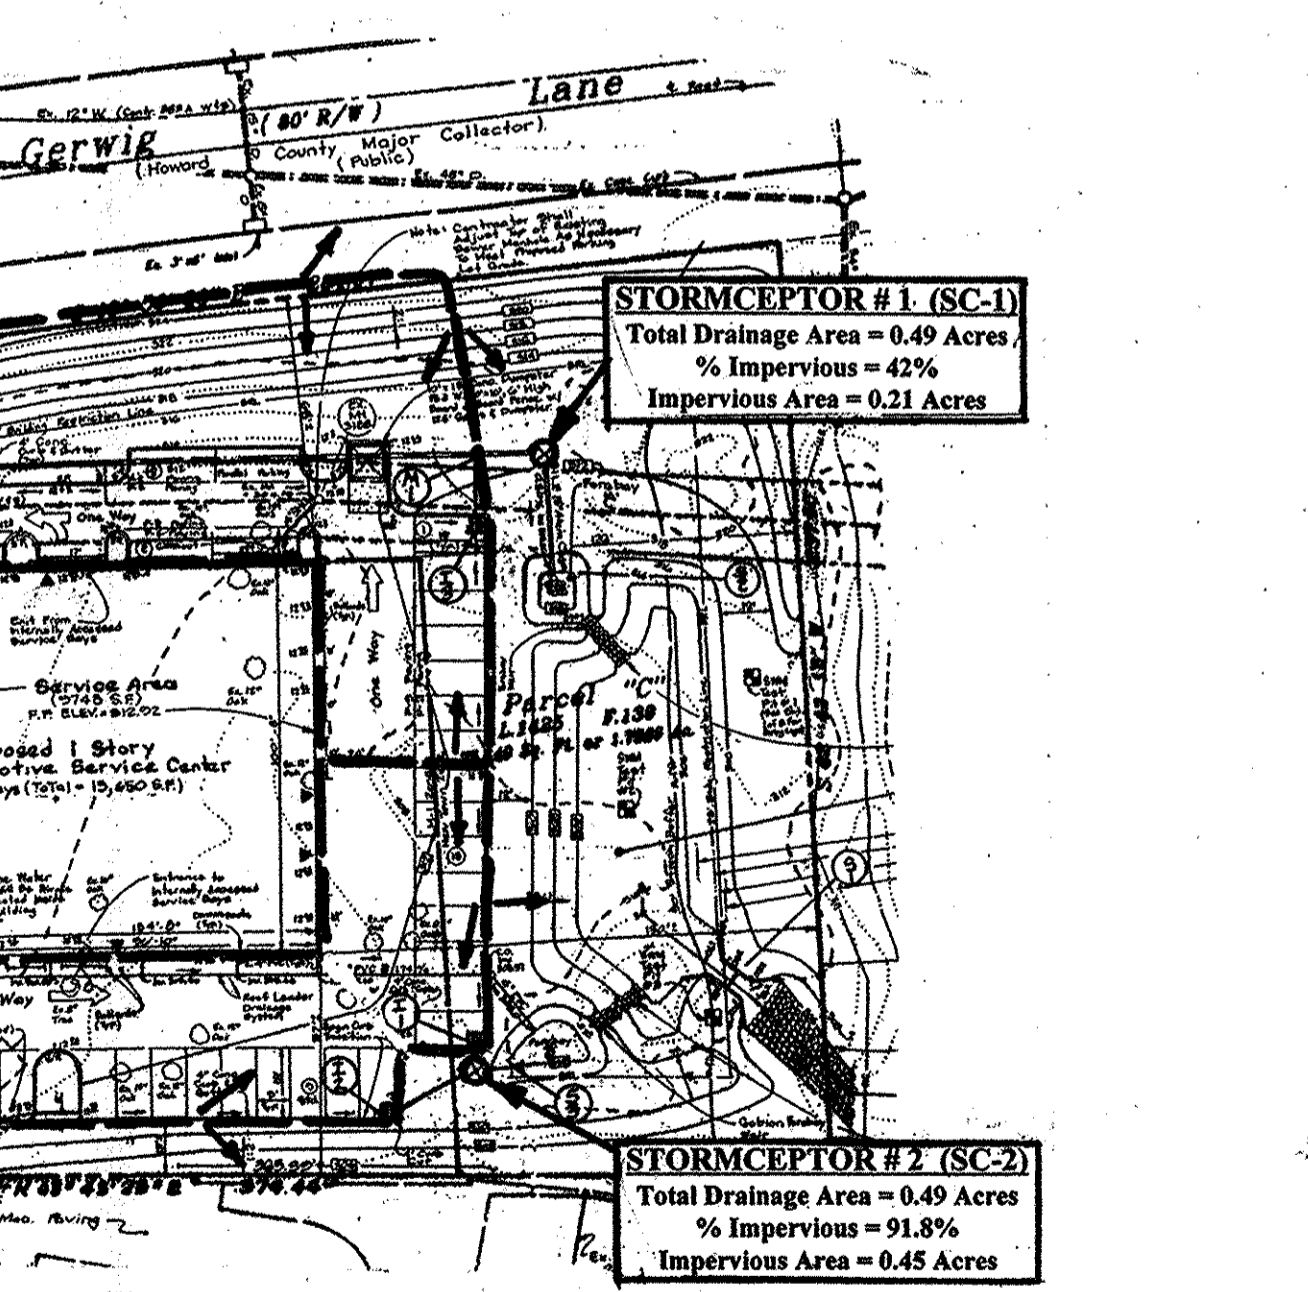


APPROVED: DEPARTMENT OF PLANNING AND ZONING. A stamp and signature block indicating approval of the plan. It includes the name 'APPROVED: DEPARTMENT OF PLANNING AND ZONING' and a date 'DATE 1/23/99'.

THESE PLANS HAVE BEEN REVIEWED FOR THE HOWARD SOIL CONSERVATION DISTRICT AND MEET THE TECHNICAL REQUIREMENTS. A stamp and signature block indicating approval of the plan. It includes the name 'HOWARD SOIL CONSERVATION DISTRICT' and a date 'DATE 1/23/99'.

ENGINEER'S CERTIFICATE. A stamp and signature block indicating approval of the plan. It includes the name 'ENGINEER'S CERTIFICATE' and a date 'DATE 1/23/99'.

REVISIONS. A table showing the revisions to the plan. It includes columns for 'No.', 'Date', 'By', and 'Description'. It also includes a table of Stormceptor dimensions and a note: 'NOTE: FOR TECHNICAL INFORMATION CONTACT VINCE BERG OF STORMCEPTOR CORPORATION AT 301-762-8361.'

LDE, INC. 9250 Rumsey Road, Suite 108, Columbia, MD. 21045. A stamp and signature block indicating approval of the plan. It includes the name 'LDE, INC.' and a date 'DATE 1/23/99'.

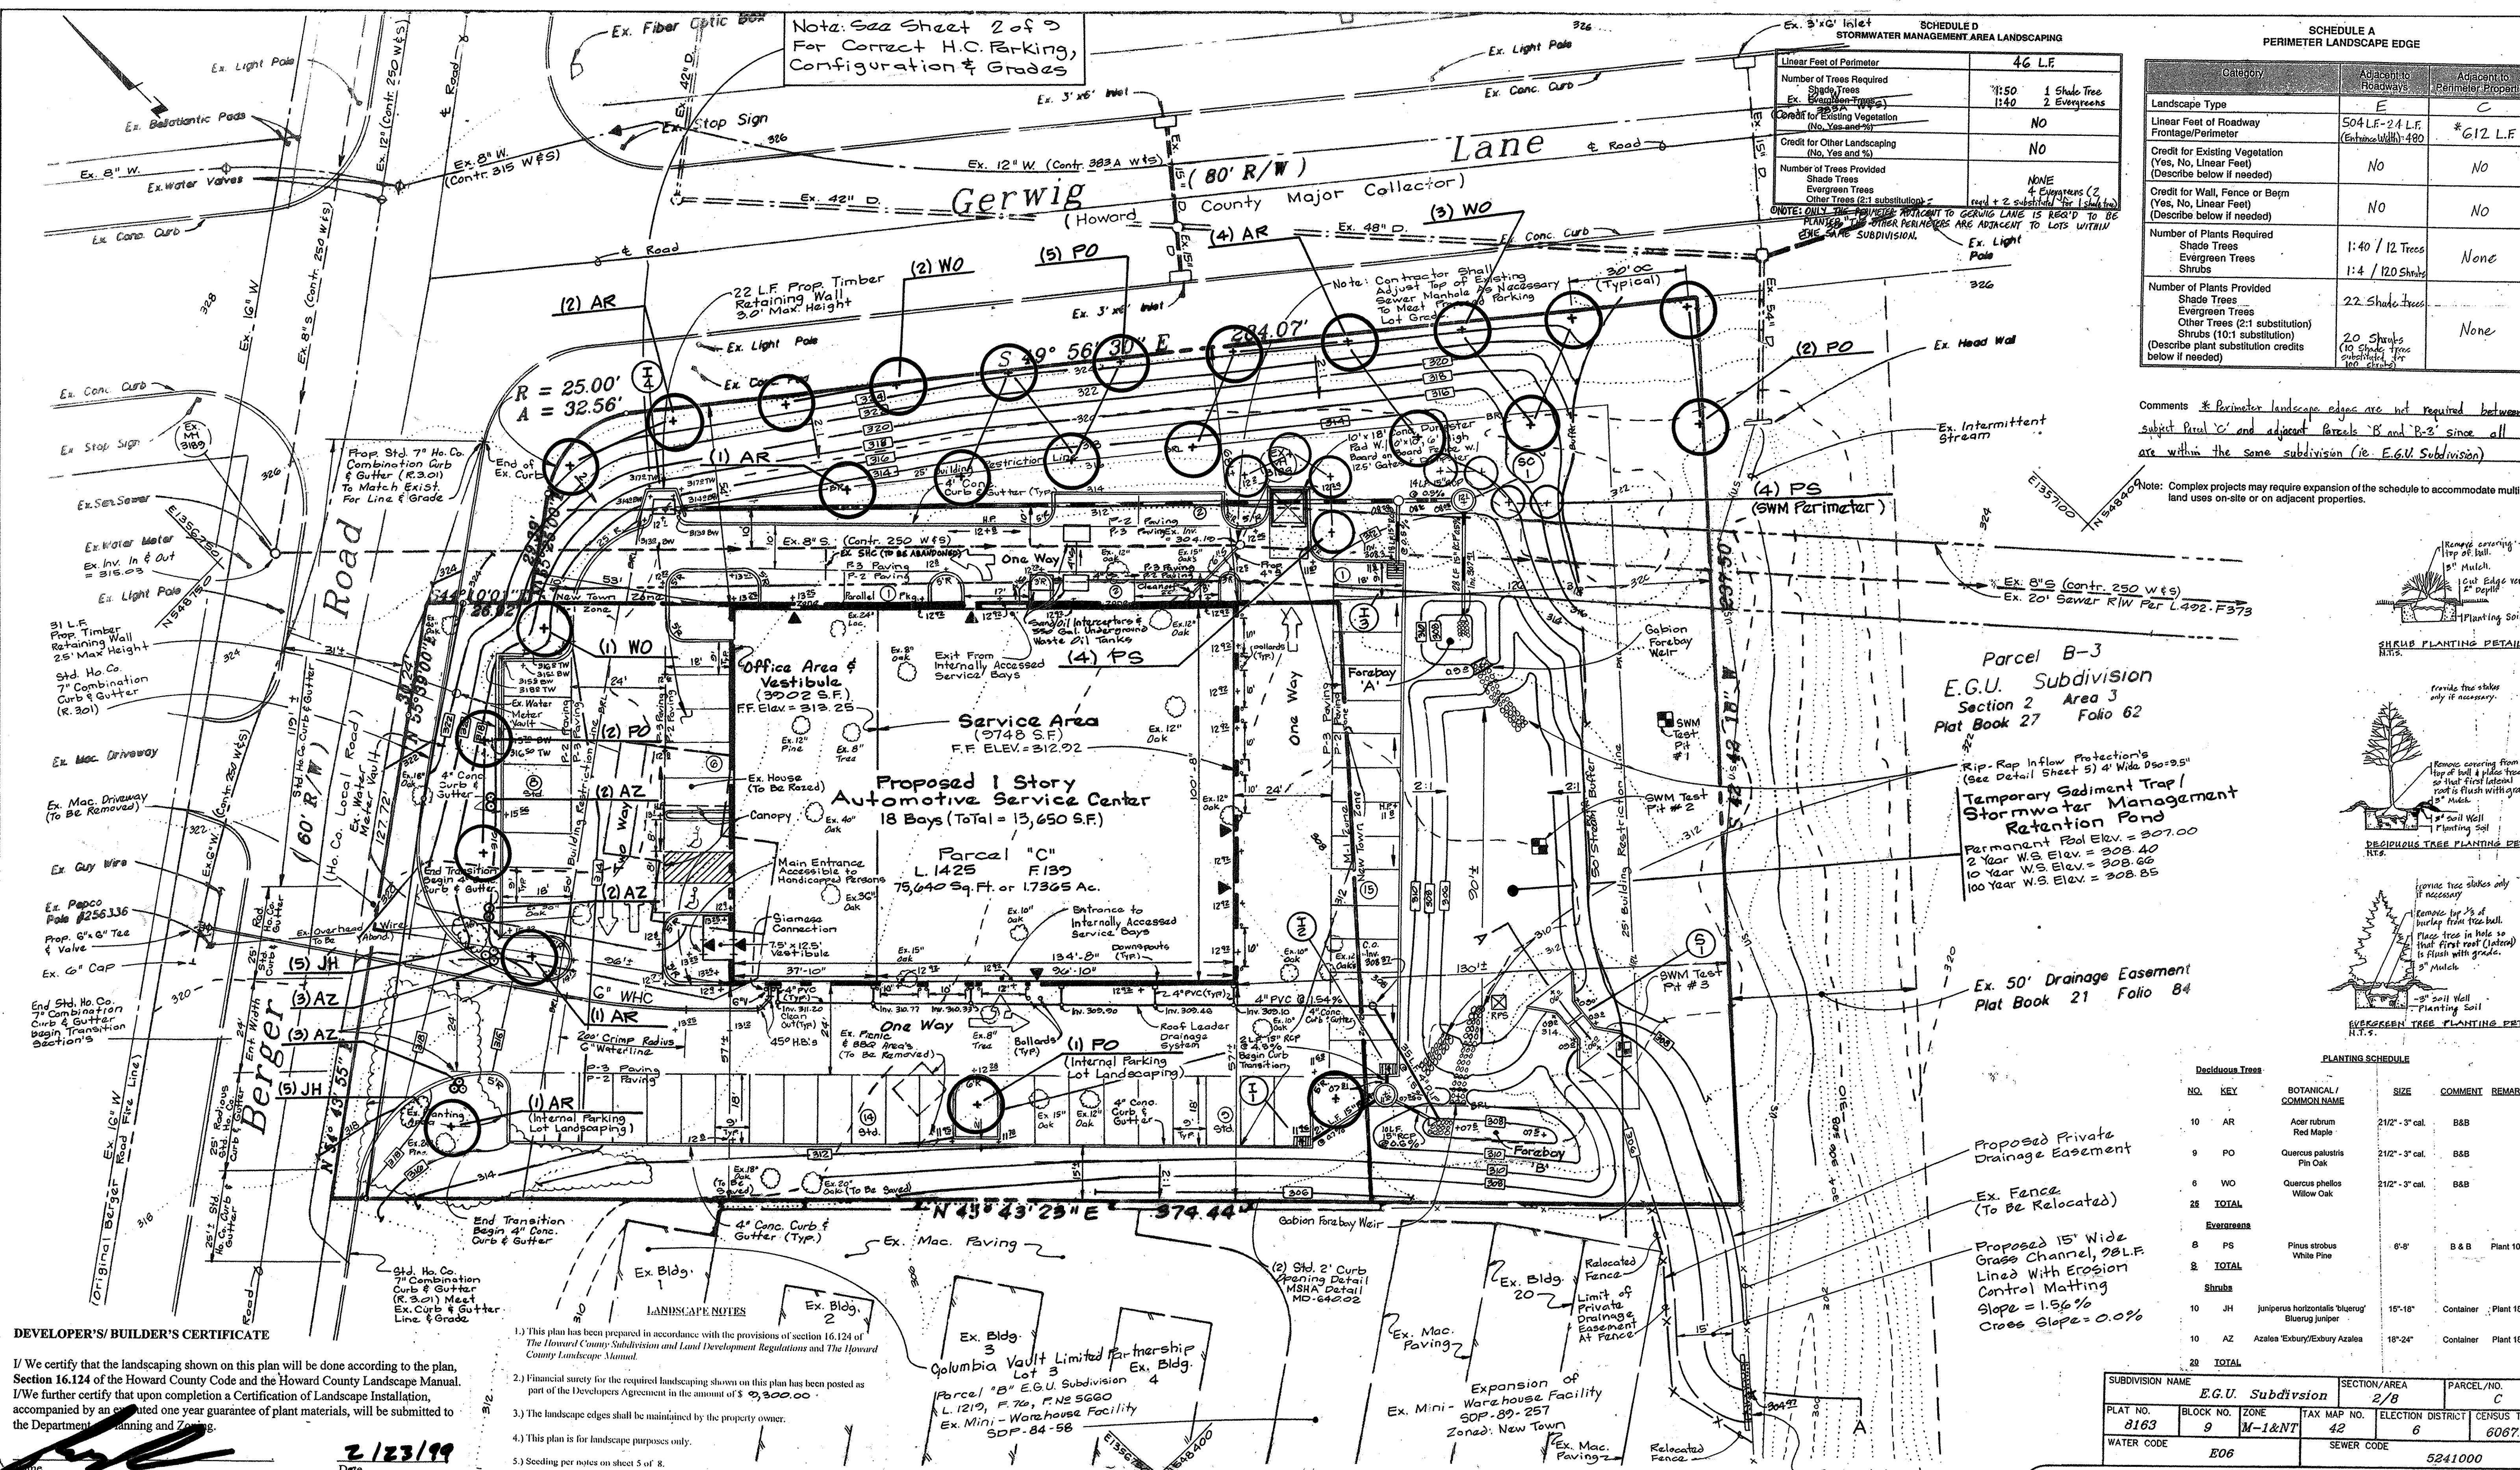

DEVELOPER'S/BUILDER'S CERTIFICATE

I/We certify that the landscaping shown on this plan will be done according to the plan, Section 16.124 of the Howard County Code and the Howard County Landscape Manual. I/We further certify that upon completion a Certification of Landscape Installation, accompanied by an executed one year guarantee of plant materials, will be submitted to the Department of Planning and Zoning.

Date: **2/23/99**

- LANDSCAPE NOTES**
- This plan has been prepared in accordance with the provisions of section 16.124 of the Howard County Subdivision and Land Development Regulations and the Howard County Landscape Manual.
 - Financial surety for the required landscaping shown on this plan has been posted as part of the Developers Agreement in the amount of \$ 9,500.00.
 - The landscape edges shall be maintained by the property owner.
 - This plan is for landscape purposes only.
 - Seeding per notes on sheet 5 of 8.

ENGINEER'S CERTIFICATE

"I HEREBY CERTIFY THAT THE PERIMETER LANDSCAPING AND SEDIMENT CONTROL REPRESENTS A PRACTICAL AND FEASIBLE DESIGN BASED ON MY PERSONAL KNOWLEDGE OF THE SITE AND THE PROJECT. IT WAS PREPARED IN ACCORDANCE WITH REQUIREMENTS OF THE HOWARD COUNTY SOIL CONSERVATION DISTRICT."

Signature of Engineer: **[Signature]** DATE: **2/24/99**

DEVELOPER'S CERTIFICATE

"I/WE CERTIFY THAT ALL DEVELOPMENT AND/OR CONSTRUCTION WILL BE DONE ACCORDING TO THESE PLANS AND THAT ANY RESPONSIBLE PERSONNEL INVOLVED IN THE CONSTRUCTION PROJECT WILL HAVE A CERTIFICATE OF ATTENDANCE AT A DEPARTMENT OF THE ENVIRONMENT APPROVED TRAINING PROGRAM FOR THE CONTROL OF SEDIMENT AND EROSION CONTROL. I ALSO AUTHORIZE PERIODIC ON-SITE INSPECTION BY THE HOWARD COUNTY SOIL CONSERVATION DISTRICT OR THEIR AUTHORIZED AGENTS IF NECESSARY."

Signature of Developer: **[Signature]** DATE: **2/23/99**

APPROVED: DEPARTMENT OF PLANNING AND ZONING

Chief, Development Engineering Division: **[Signature]** DATE: **2/23/99**

Chief, Division of Land Development: **[Signature]** DATE: **3/3/99**

Director: **[Signature]** DATE: **3/10/99**

HOWARD SOIL CONSERVATION DISTRICT

These plans have been reviewed for the HOWARD SOIL CONSERVATION DISTRICT and meet the technical requirements.

Natural Resource Conservation Service: **[Signature]** DATE: **2/23/99**

This development plan is approved for soil erosion and sediment control by the HOWARD SOIL CONSERVATION DISTRICT.

Howard Soil Conservation District: **[Signature]** DATE: **2/23/99**

STATE OF MARYLAND

PROFESSIONAL LANDSCAPE ARCHITECT

[Signature] DATE: **2/24/99**

SCHEDULE B PARKING LOT INTERNAL LANDSCAPING

Number of Parking Spaces	57
Number of Trees Required	1 Shade Tree: 20 Spaces = 3
Number of Trees Provided	3 Shade Trees
Other Trees (2:1 substitution)	

NOTE: THE AMENDED LANDSCAPE MANUAL, DATED MARCH 2, 1998 STATES THAT SWM PERIMETER LANDSCAPING IS REQUIRED IN ALL ZONING DISTRICTS EXCEPT M-1 AND M-2. THIS SITE IS ZONED BOTH M-1 AND NEW TOWN EMPLOYMENT CENTER. THE INTENT IS TO DEVELOP THE ENTIRE SITE AS AN AUTOMOTIVE SERVICE FACILITY, AN M-1 TYPE USE. THE CHARACTER OF THE EXISTING AREA IS ENTIRELY COMMERCIAL/INDUSTRIAL. THEREFORE IT WOULD NOT BE IN KEEPING WITH THE CHARACTER OF THE AREA TO PROVIDE STORMWATER MANAGEMENT PERIMETER LANDSCAPING. THEREFORE, STORMWATER MANAGEMENT PERIMETER PLANTINGS HAVE NOT BEEN PROVIDED.

APPROVED PLANNING BOARD OF HOWARD COUNTY

DATE: **1/27/99**

LDE, INC.
9250 Rumsey Road, Suite 106, Columbia, MD 21045
(410) 715-1070 (301) 596-3424 (410) 715-9540 (Fax)

DESIGNED: SDH
DRAWN: SMC
CHECKED: B.D.B.

BRITISH AND AMERICAN AUTO CARE, INC.
Columbia
E.G.U. Subdivision
Parcel "C"

Tax Map 42, P/O Parcel 386, Grid 9
6th Election District
Howard County, Maryland

Scale: 1" = 20'
Drawing: 3 of 3
Job No.: 98-010
File No.: SDP-98-132

Owner/Developer: **[Signature]** DATE: **2/23/99**

PLANTING SCHEDULE

NO.	KEY	BOTANICAL / COMMON NAME	SIZE	COMMENT	REMARKS
10	AR	Acer rubrum Red Maple	2 1/2" - 3" cal.	B&B	
9	PO	Quercus palustris Pin Oak	2 1/2" - 3" cal.	B&B	
8	WO	Quercus phellos Willow Oak	2 1/2" - 3" cal.	B&B	
28	TOTAL				
8	PS	Pinus strobus White Pine	6" - 8"	B & B	Plant 10' OC
2	TOTAL				
10	JH	Juniperus horizontalis 'bluewing' Bluewing Juniper	15" - 16"	Container	Plant 10' OC
10	AZ	Azalea 'Esbury/Esbury Azalea'	18" - 24"	Container	Plant 10' OC
20	TOTAL				

REVISIONS

No.	Date	By	Description
1	4-28-98	SDH	For Correct H.C. Parkings Configuration & Grades.

Subdivision Information:

Subdivision Name	E.G.U. Subdivision	Section/Area	2/8	Parcel/No.	C
Plat No.	8163	Block No.	9	Zone	M-1&NT
Water Code	E06	Tax Map No.	42	Election District	6
		Census Tract			6067.03
		Sever Code			5241000

Sheet Index	
No.	Title
1	Title Sheet
2	Site Development Plan
3	Grading Sediment Control Plan
4	Drainage Area And Soils Plan
5	Sediment Control Construction Notes & Details
6	Stormwater Management Detail Plan
7	Quality Stormwater Management Notes & Details
8	Existing Features Plan
9	Landscape Plan

LEGEND

BENCH MARK

USE RESTRICTION LINE

FLOW DIRECTION

SLOPES BETWEEN 15% - 24.9%

SLOPES GREATER THEN 25%

SILT FENCE

EARTH DIKE

LIMIT OF DISTURBANCE


DRAINAGE DIVIDE

EXISTING CONTOUR

PROPOSED CONTOUR

STABILIZED CONSTRUCTION ENTRANCE

SUPER SILT FENCE

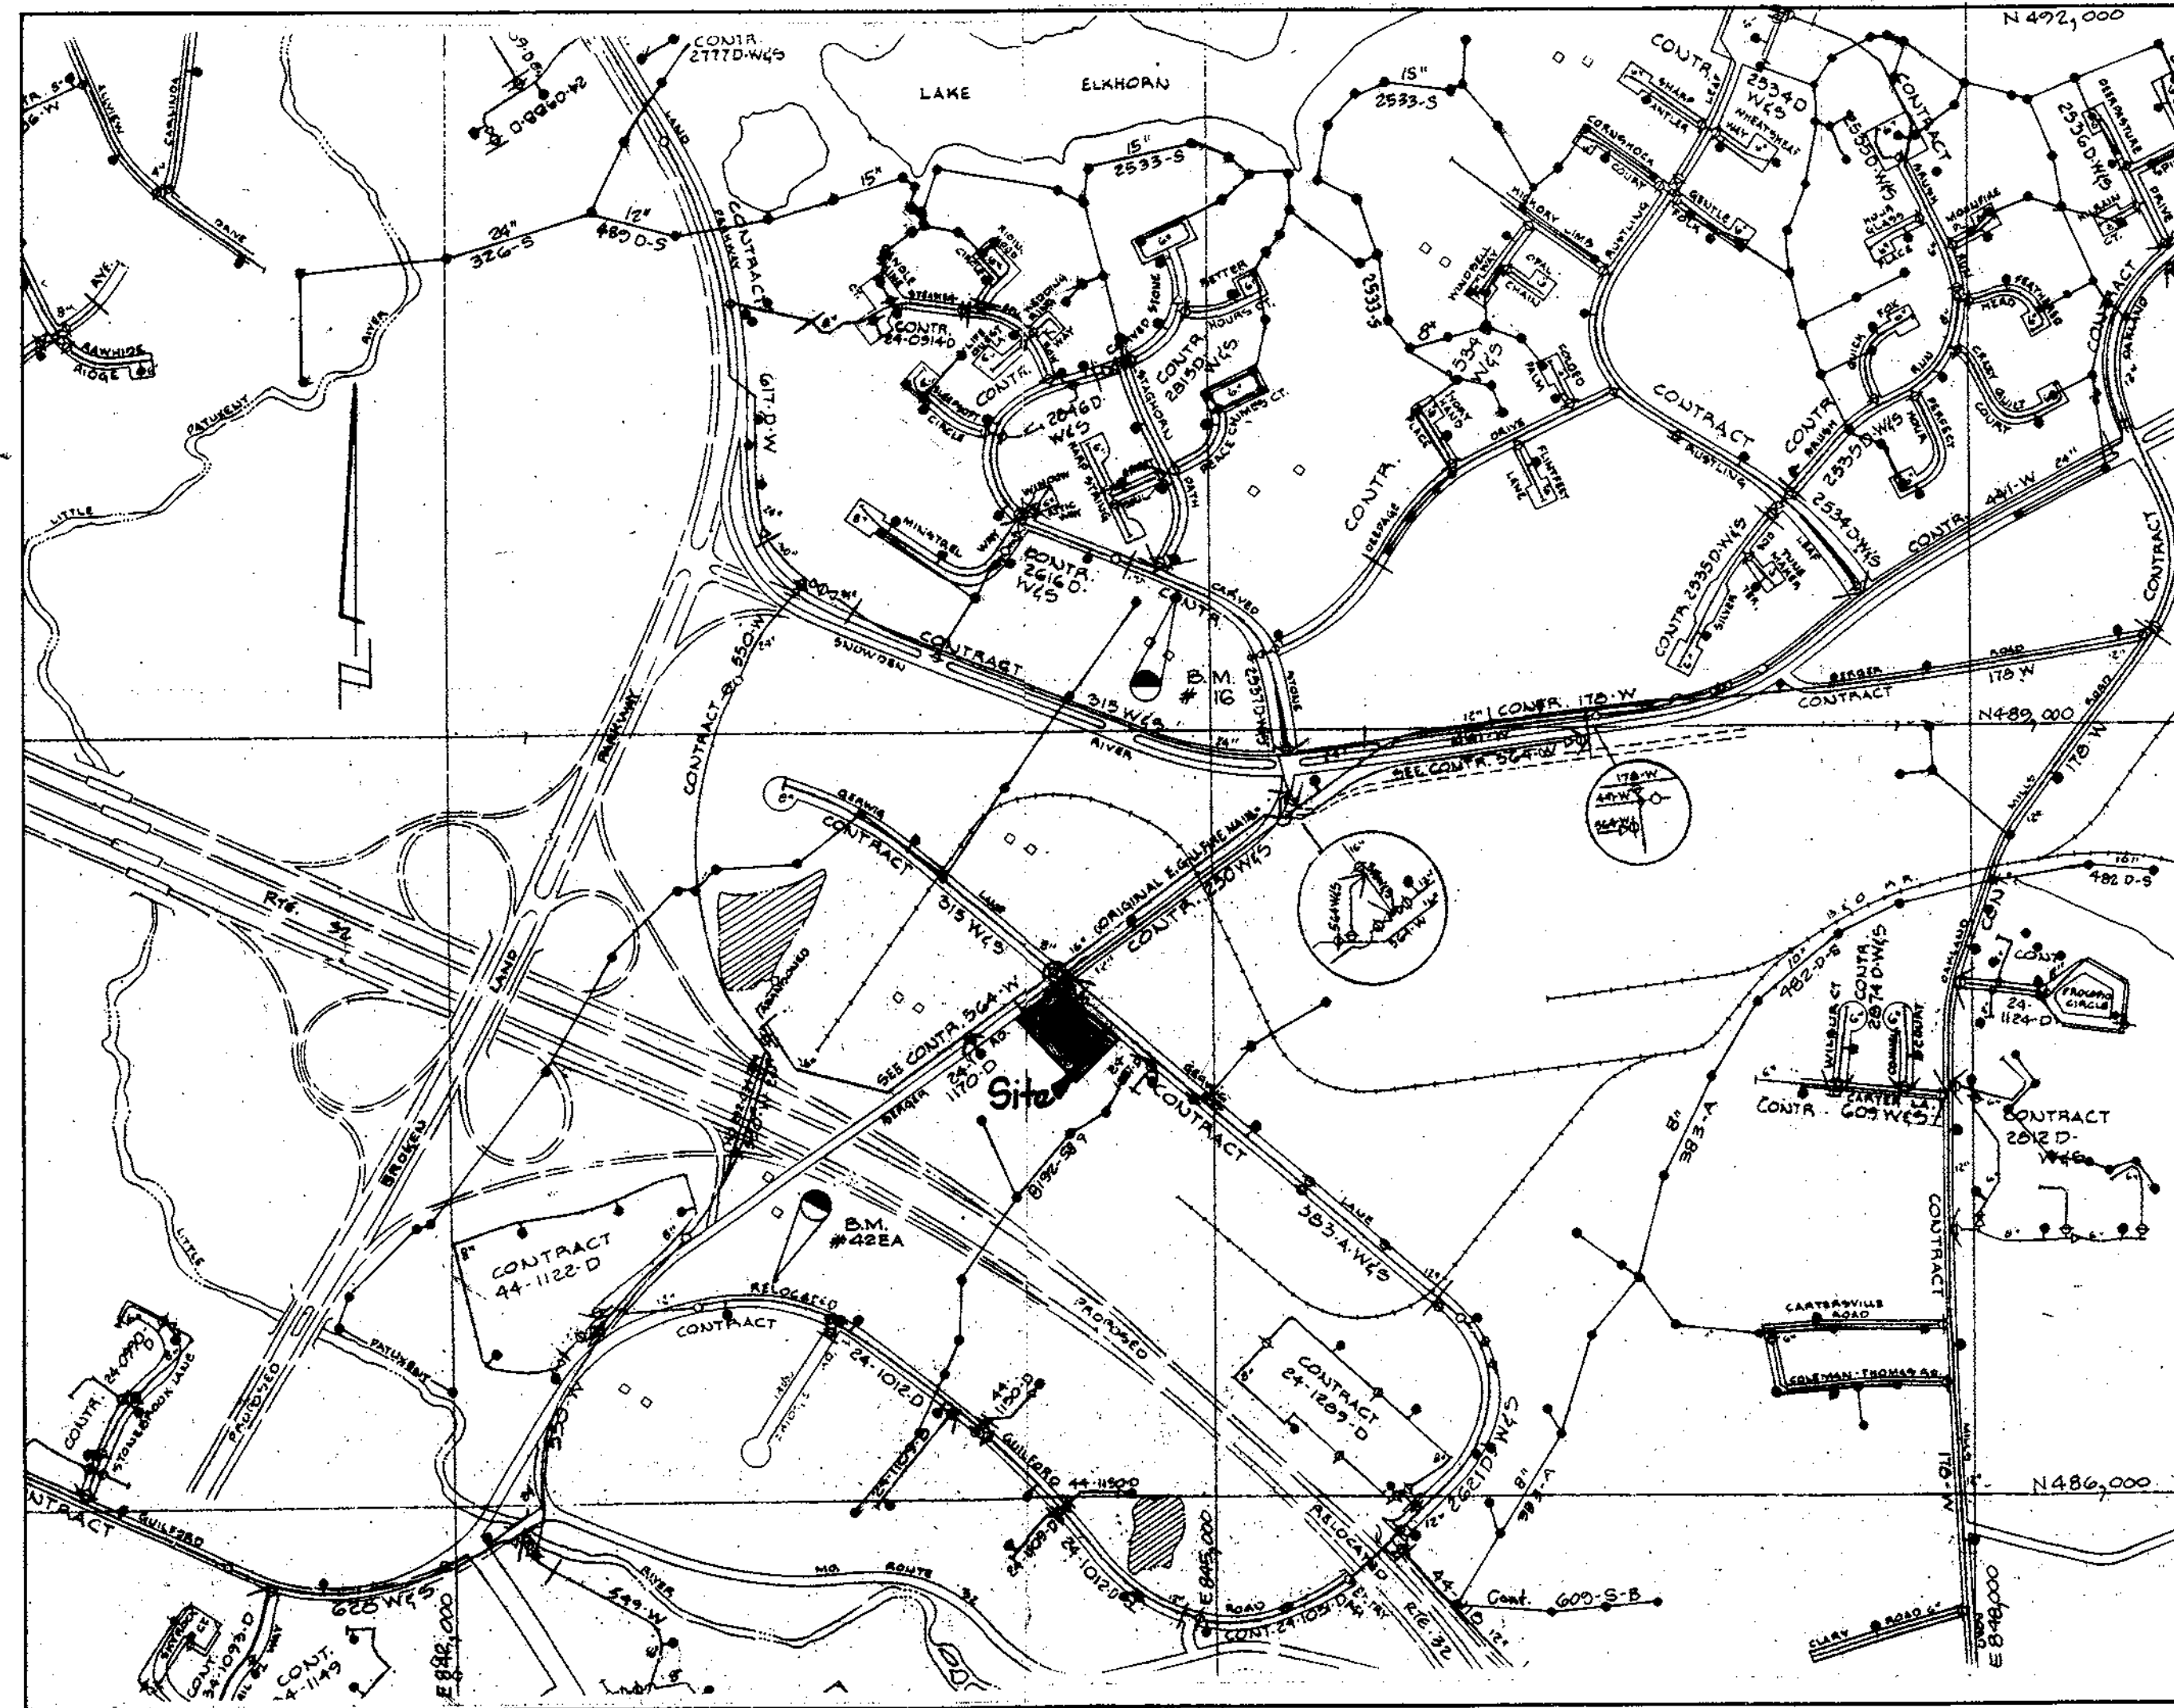


BENCH MARKS

- Howard County Geodetic Control No. 42EA
Elevation = 313.28, Northing = 547604, Easting = 1355440.
Standard Howard County Survey Disc. Set on concrete monument.
On Guilford Road 0.3+/- miles northeast, left side from intersection, Murry Hill Road 9.3' off edge of paving, 20' +/- west from light pole and 80' from water valve in Guilford Road.
- Howard County Geodetic Control No. 0016
Elevation = 359.59, Northing = 550279, Easting = 1357329.
Standard Howard County Survey Disc. Set on concrete monument.
Between Carved Stone Road and cont. sidewalk, 100' +/- east from intersection Stag Horn Path and 41' +/- from inlet.

GENERAL NOTES

- Site Analysis Data:
 - Total Project Area: 1.786+/- Acres (76,640 sq ft)
 - Area Reserved for Possible Relocation to Howard County: 0.0015 Acres (65 sq ft)
 - Net Area: 1.7845+/- Acres (76,220 sq ft)
 - Area of Plan Submission: 1.7845+/- Acres (76,640 sq ft)
 - Limit of Disturbed Area: 1.70+/- Acres (74,052 sq ft)
 - Present Zoning: M-1 and New Town
 - Proposed Site and Structure Use: Automotive service center operation.
- Building Floor Space: 1 Story Building
 - Office Space & Vestibule = 3,902 sq ft
 - Warehouse Space = 8,248 sq ft
 - Total Building Area = 12,150 sq ft
- Total Number of Proposed Units: One (1) commercial building
- Total Number of Proposed Units: One (1) 13,650 sq ft building
- Maximum Number of Employees: 20
- Parking Required: Vehicle service establishments: 3 spaces plus 3 spaces/ service bay (18 bays x 3 sp = 57 spaces)
- Parking Provided: 65 Regular spaces + 2 Van Accessible handicapped spaces = 67 Total
- Open Space: None required.
- Recreation Open Space: None required.
- Building Coverage of Site: 0.313+/- Acres: 18.05% of gross site area.
- Applicable DPZ File References: F-89-11, Amended FDP Phase 156-A
- Property Owner: Brian England
British and American Auto Care, Inc.
9235 Berger Road
Columbia, Maryland 21046
- Architect: Altum Architects
Suite 453
5537 Twin Knolls Road
Columbia, Maryland 21045-3270
- Plat Reference: No. 8163, recorded on 09/08/88 among the Land Records of Howard County, MD.
- There are no wetlands or forest on the subject property. An assessment was conducted by Dennis J. Labaree, M.S. and Associates, LLC on 02/29/97.
- This property is exempt from the requirements of the Howard County Forest Conservation Manual according to Section 15.20(2)(b) of the County Code.
- There is no area of 100 year floodplain on the subject property.
- Boundary information per record plat No. 8163, dated 09/08/88 by Clark, Finney & Sackell, Inc. Boundary information field verified by LDE, Inc. in March, 1992.
- Onsite topography shown herein was field run by LDE, Inc. on March 2, 1998.
- Control based on Maryland NAD83 horizontal and NAVD83 vertical datum from Howard County Control Stations 0018 and 42EA.
- All construction shall be performed in accordance with the latest standards and specifications of Howard County plus MSHA standards and specifications if applicable.
- Deviations from these plans and specifications without prior written consent of the civil engineer may cause the work to be unacceptable.
- Adjustments to the sequence of construction shall be approved by the Howard County Department of Inspections, Licenses and Permits prior to such adjustments.
- Approximate locations of existing utilities are shown. The contractor shall take all necessary precautions to protect existing utilities and maintain uninterrupted service. Any damage incurred due to contractor's operation shall be repaired immediately at the contractor's expense.
- Contractor shall comply with all sediment control notes on these plans.
- All plan dimensions are to face of curb unless noted otherwise.
- Traffic control devices, markings and signing shall be in accordance with the latest edition of the Manual of Uniform Traffic Control Devices (MUTCD). All street and regulatory signs shall be in place prior to the placement of any asphalt.
- There may be additional utilities not shown on these plans. The engineer assumes no responsibility for locations not shown and it shall be the responsibility of the contractor to verify the locations of all existing utilities within the limits of construction and notify the engineer prior to the start of construction.
- The contractor shall notify the following utilities or agencies at least five (5) working days before beginning construction:
 - Mass Utility at 1-800-257-7777
 - "BGE" at (410) 234-5691
 - Bell Atlantic at (410) 380-0000

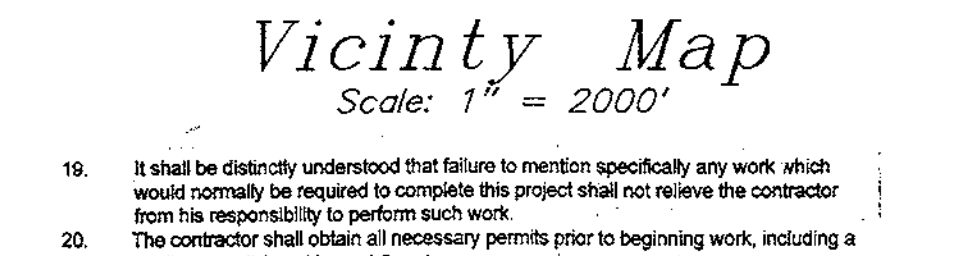


Location Map
Scale: 1" = 600'

Site Development Plan "AS-BUILT"

British And American Auto Care Inc.

Columbia E.G.U. Subdivision Parcel "C"

A Resubdivision of Lot 3 6th Election District Howard County, Maryland

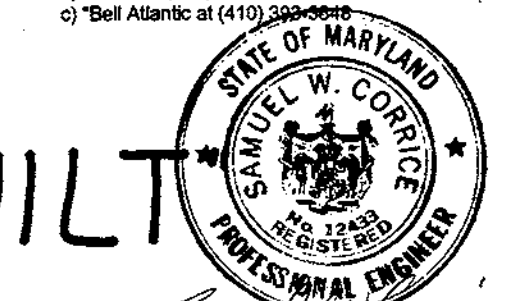

Schnabel Engineering Associates, Inc.
Consulting Geotechnical Engineers

Test Pit Log

Topsoil (ft)	Remarks	Depth (ft)	Remarks
0-1	Dark brown silty clay with 10% sand and 5% silt	4.0	Detail to estimate below 2.0' back fragments up to 1/4" in size
1-2	Dark brown silty clay with 10% sand and 5% silt	2.0	MC= 13.1% @ 2'
2-3	Dark brown silty clay with 10% sand and 5% silt	3.0	Water encountered at bottom of test pit
3-4	Dark brown silty clay with 10% sand and 5% silt	4.0	Water level reading on 42590: Day to 5.1'

Note: Water level reading on 42590: Day to 5.1'

"AS-BUILT" CERTIFICATION

I hereby certify that the facility shown on this plan was constructed as shown on the "As-Built" plans and meets the approved plans and specifications.

Brian W. Lewis 12-13-99 12-14-00
Signature P.E. No. Date

Certify means to state or declare a professional opinion based upon onsite inspections and material tests which are conducted during construction. The onsite inspections and material tests are those inspections and tests deemed sufficient and appropriate by commonly accepted engineering standards. Certify does not mean or imply a guarantee by the Engineer nor does an Engineer's certification relieve any other party from meeting requirements imposed by contract, employment or otherwise, including meeting commonly accepted industry practices.

Schnabel Engineering Associates, Inc.
Consulting Geotechnical Engineers

Test Pit Log

Topsoil (ft)	Remarks	Depth (ft)	Remarks
0-1	Dark brown silty clay with 10% sand and 5% silt	4.0	Detail to estimate below 2.0' back fragments up to 1/4" in size
1-2	Dark brown silty clay with 10% sand and 5% silt	2.0	MC= 13.1% @ 2'
2-3	Dark brown silty clay with 10% sand and 5% silt	3.0	Water encountered at bottom of test pit
3-4	Dark brown silty clay with 10% sand and 5% silt	4.0	Water level reading on 42590: Day to 5.1'


Note: Water level reading on 42590: Day to 5.1'

Schnabel Engineering Associates, Inc.
Consulting Geotechnical Engineers

Test Pit Log

Topsoil (ft)	Remarks	Depth (ft)	Remarks
0-1	Dark brown silty clay with 10% sand and 5% silt	4.0	Detail to estimate below 2.0' back fragments up to 1/4" in size
1-2	Dark brown silty clay with 10% sand and 5% silt	2.0	MC= 13.1% @ 2'
2-3	Dark brown silty clay with 10% sand and 5% silt	3.0	Water encountered at bottom of test pit
3-4	Dark brown silty clay with 10% sand and 5% silt	4.0	Water level reading on 42590: Day to 5.1'

Note: Water level reading on 42590: Day to 5.1'

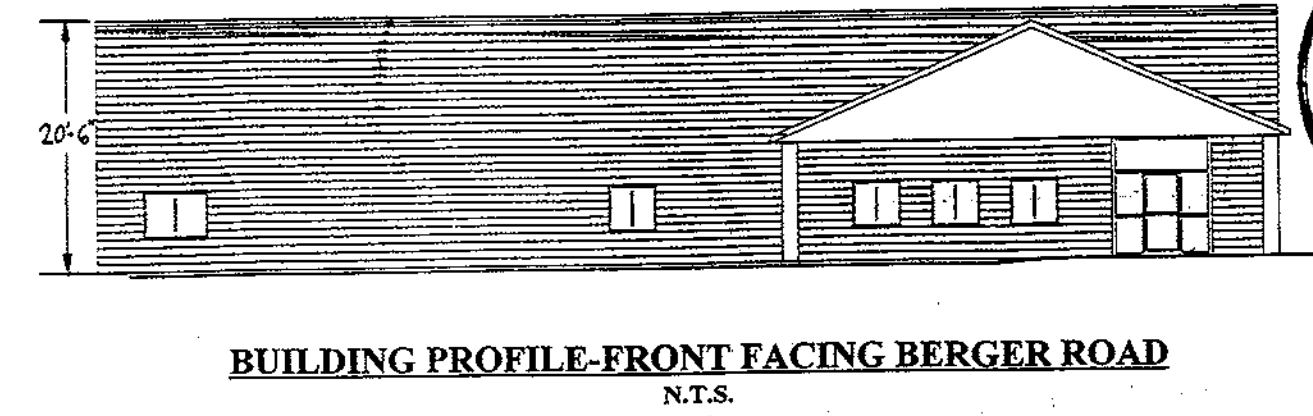

APPROVED: DEPARTMENT OF PLANNING AND ZONING

3/5/99 DATE

3/3/99 DATE

3/11/99 DATE

THESE PLANS HAVE BEEN REVIEWED FOR THE HOWARD SOIL CONSERVATION DISTRICT AND MEET THE TECHNICAL REQUIREMENTS.

3/3/99 DATE

THIS DEVELOPMENT PLAN IS APPROVED FOR SOIL EROSION AND SEDIMENT CONTROL BY THE HOWARD SOIL CONSERVATION DISTRICT.

3/3/99 DATE

ENGINEER'S CERTIFICATE

"I HEREBY CERTIFY THAT THIS SITE PLAN AND ASSOCIATED CONSTRUCTION REPRESENTS A PRACTICAL AND SOUND ENGINEERING DESIGN BASED ON MY PERSONAL KNOWLEDGE OF THE SITE CONDITIONS AND REQUIREMENTS OF THE HOWARD SOIL CONSERVATION DISTRICT."

3/2/99 DATE

DEVELOPER'S CERTIFICATE

"I/WE CERTIFY THAT ALL DEVELOPMENT AND/OR CONSTRUCTION WILL BE DONE ACCORDING TO THESE PLANS AND THAT ANY RESPONSIBLE PERSONNEL INVOLVED IN THE CONSTRUCTION PROJECT WILL HAVE A CERTIFICATE OF ATTENDANCE AT A DEPARTMENT OF THE ENVIRONMENT APPROVED TRAINING PROGRAM FOR THE CONTROL OF SEDIMENT AND EROSION BECOMING THE PROJECT. I/WE ALSO AUTHORIZE PERIODIC ON-SITE INSPECTIONS BY THE HOWARD SOIL CONSERVATION DISTRICT OR THEIR AUTHORIZED AGENTS AND AGREE TO ACCEPT ANY AND ALL RECOMMENDATIONS."

2/12/99 DATE



ADDRESS CHART

Lot Number	Street Address
Parcel 'C'	2577 Berger Road

REVISIONS

No.	Date	By	Description
1	4-28-99	SMC	Revised H.C. Parking and Associated grading in front of building for revised canopy column locations. Added (1) parking space on east of building, and revised exterior bollard locations.

LDE, INC.
9250 Rumsey Road, Suite 106, Columbia, MD. 21045
(410) 715-1070 (301) 596-3424 (410) 715-5040 (Fax)




DESIGNED: SDH
DRAWN: SMC
CHECKED: B.D.B.

DATE: 7/98
REV: 4/98
REV: 10/98

Owner/Developer: Brian England, British and American Auto/Care Inc., 9235 Berger Road, Columbia, Maryland 21046, (410) 381-2700

FILE NO.: SDP-26-32

Users:land/JOHN_ZEBITAM1,570

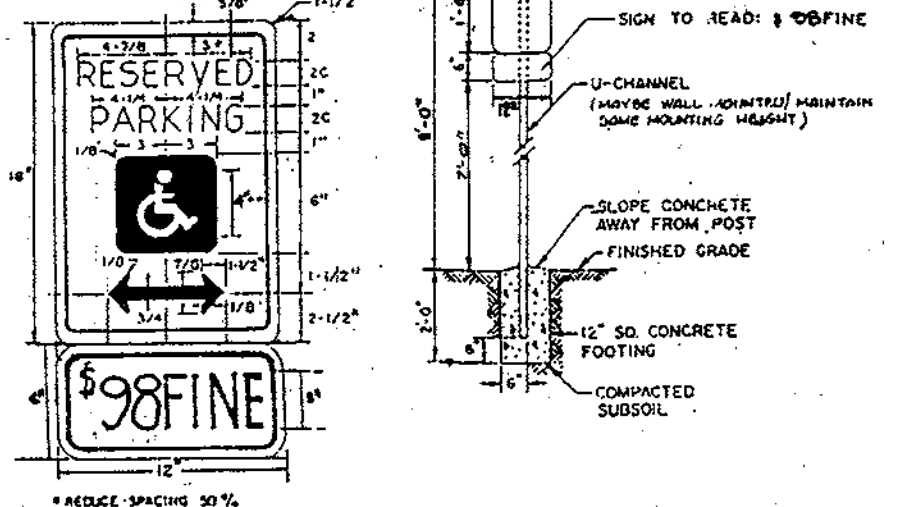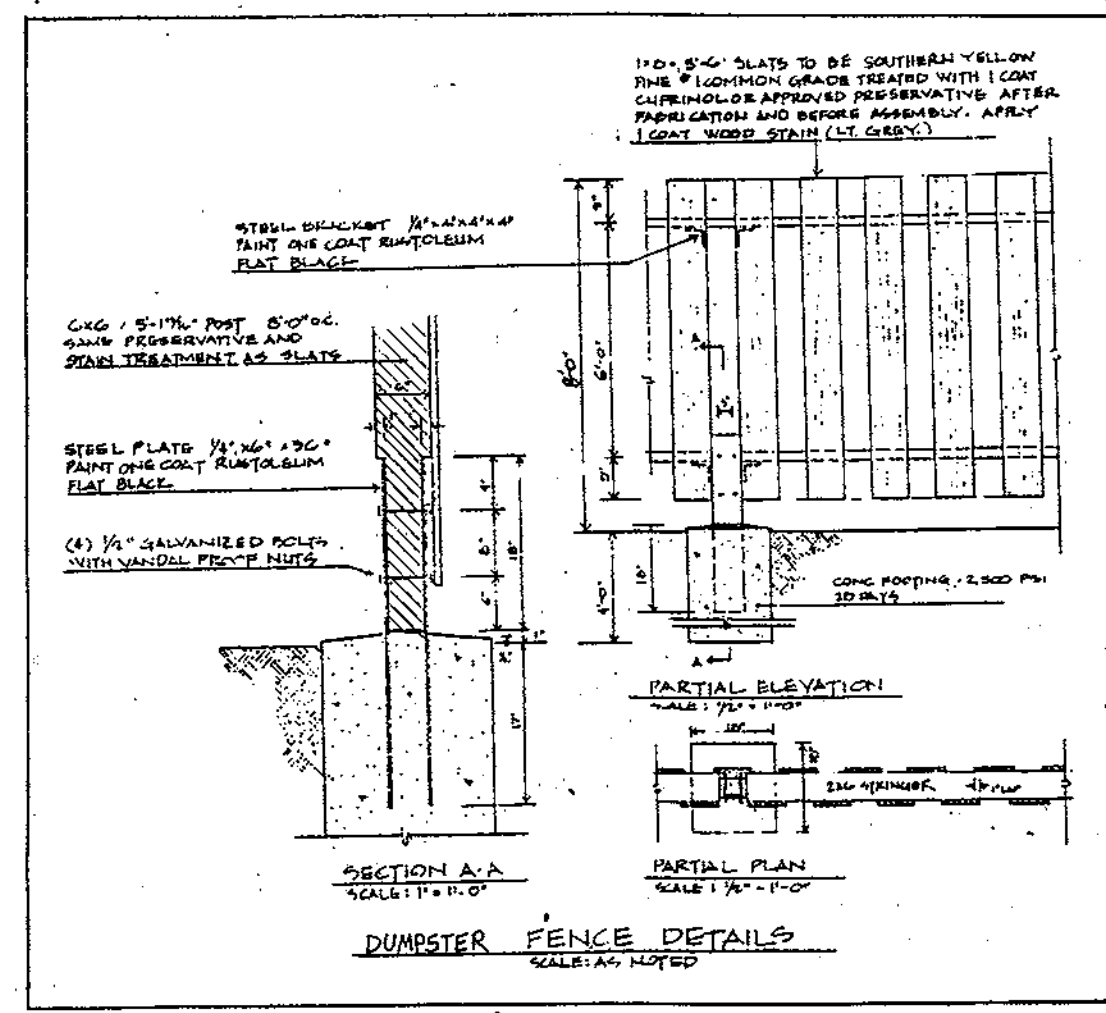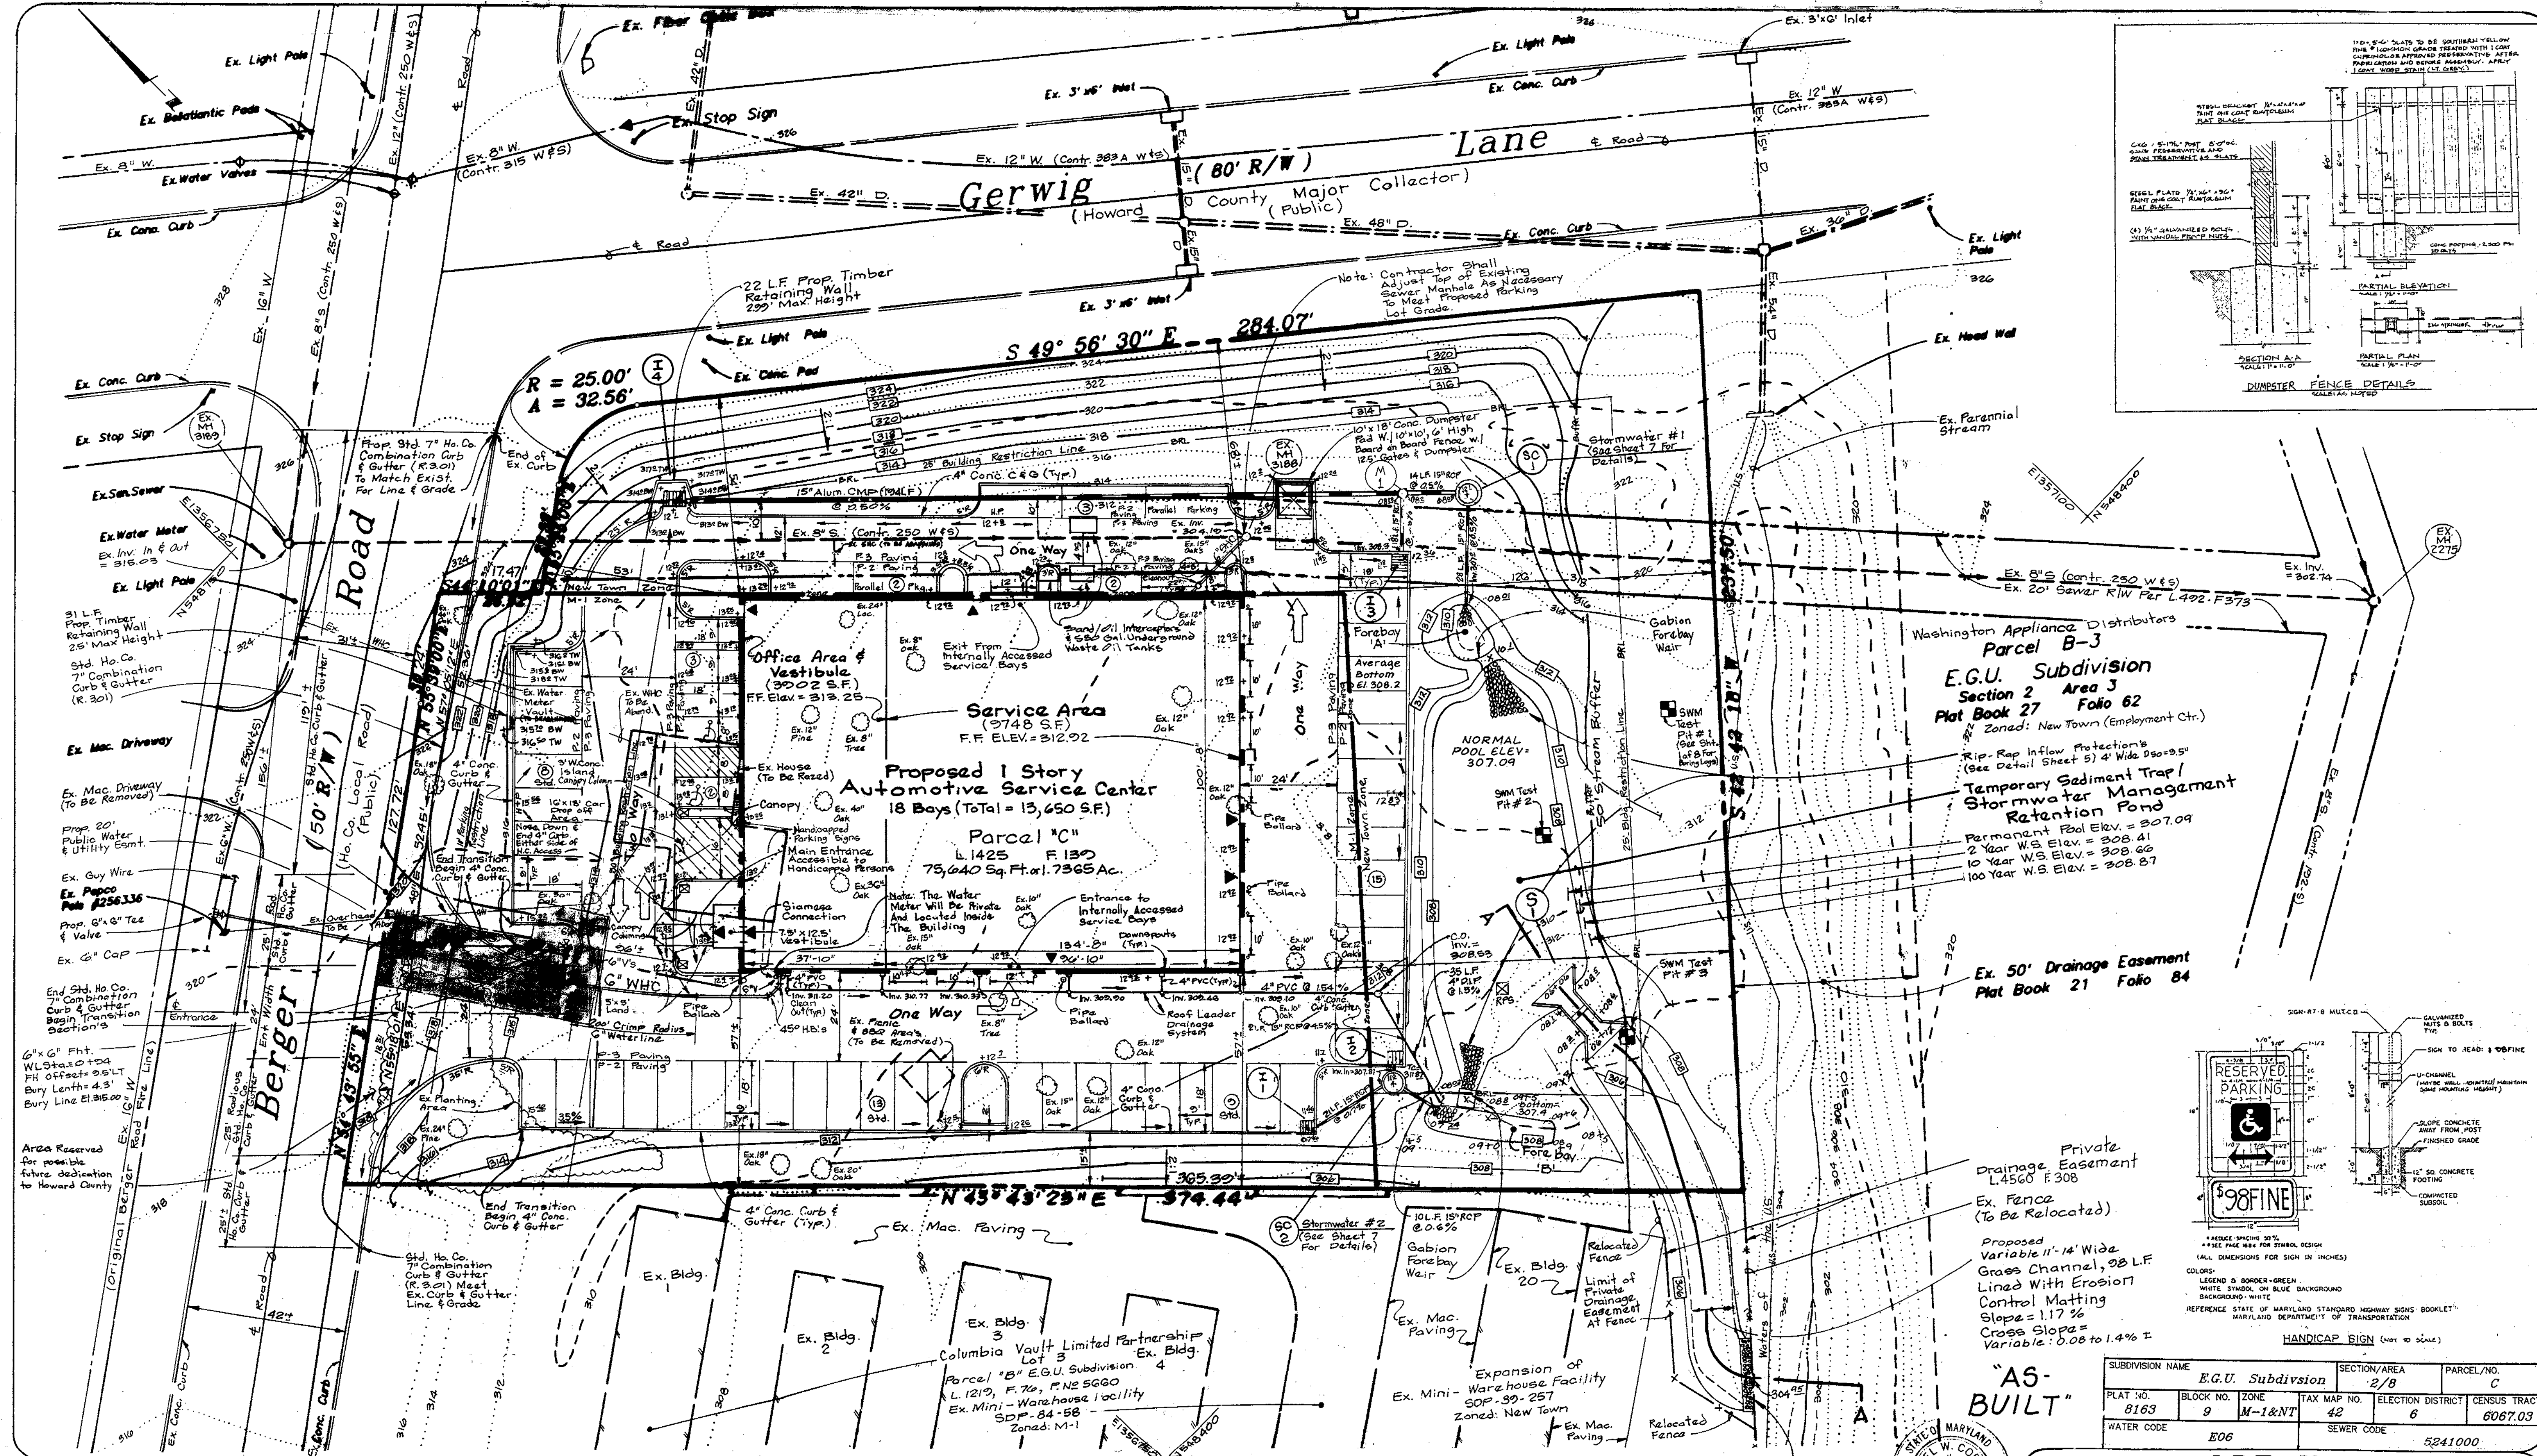

Washington Appliance Distributors
Parcel B-3
E.G.U. Subdivision
Section 27 Area 3
Plot Book 27 Folio 62
Zoned: New Town (Employment Ctr.)

Temporary Sediment Trap /
Stormwater Management
Retention Pond
Permanent Pool Elev. = 307.09
2 Year W.S. Elev. = 308.41
10 Year W.S. Elev. = 308.66
100 Year W.S. Elev. = 308.87

Ex. 50' Drainage Easement
Plat Book 21 Folio 84

Private
Drainage Easement
L.4560 F.308
Ex. Fence
(To Be Relocated)
Proposed
Variable 11'-14" Wide
Grass Channel, 28 LF.
Lined With Erosion
Control Matting
Slope = 1.17 %
Cross Slope =
Variable: 0.08 to 1.4 % ±

"AS-BUILT"

SUBDIVISION NAME	E.G.U. Subdivision	SECTION/AREA	2/8	PARCEL NO.	C
PLAT NO.	8163	BLOCK NO.	9	ZONE	M-1&NT
TAX MAP NO.	42	ELECTION DISTRICT	6	CENSUS TRACT	6067.03
WATER CODE	E06	SEWER CODE	5241000		

APPROVED: DEPARTMENT OF PLANNING AND ZONING

5/1/99 DATE

CHIEF, DEVELOPMENT ENGINEERING DIVISION

3/8/99 DATE

CHIEF, DIVISION OF LAND DEVELOPMENT

THESE PLANS HAVE BEEN REVIEWED FOR THE HOWARD SOIL CONSERVATION DISTRICT AND MEET THE TECHNICAL REQUIREMENTS.

3/3/99 DATE

CHIEF, NATURAL RESOURCE CONSERVATION SERVICE

THIS DEVELOPMENT PLAN IS APPROVED FOR SOIL EROSION AND SEDIMENT CONTROL BY THE HOWARD SOIL CONSERVATION DISTRICT.

3/3/99 DATE

CHIEF, HOWARD SOIL CONSERVATION DISTRICT

ENGINEER'S CERTIFICATE

I HEREBY CERTIFY THAT THESE PLANS AND SEDIMENT CONTROL REPRESENTS A PRACTICAL AND FEASIBLE DESIGN BASED ON MY PERSONAL KNOWLEDGE OF THE SITE CONDITIONS AND THAT I WAS PREPARED IN ACCORDANCE WITH REQUIREMENTS OF THE HOWARD SOIL CONSERVATION DISTRICT.

2/24/99 DATE

BRUCE D. [Signature]

DEVELOPER'S CERTIFICATE

I HEREBY CERTIFY THAT ALL DEVELOPMENT AND/OR CONSTRUCTION WILL BE DONE ACCORDING TO THESE PLANS AND THAT ANY RESPONSIBLE PERSONNEL INVOLVED IN THE CONSTRUCTION PROJECT WILL HAVE A CERTIFICATE OF ATTENDANCE AT A DEPARTMENT OF THE ENVIRONMENT APPROVED TRAINING PROGRAM FOR THE CONTROL OF SEDIMENT AND EROSION. I ALSO AUTHORIZE PERMITTING AGENCIES TO BEGINNING THE PROJECT. I ALSO AUTHORIZE PERMITTING AGENCIES TO BEGINNING THE PROJECT. I ALSO AUTHORIZE PERMITTING AGENCIES TO BEGINNING THE PROJECT. I ALSO AUTHORIZE PERMITTING AGENCIES TO BEGINNING THE PROJECT.

2/23/99 DATE

[Signature]

APPROVED PLANNING BOARD OF HOWARD COUNTY

DATE: 1/27/99

REVISIONS



No.	Date	By	Description
1	4-28-99	SAC	Revised H.C. parking and associated grading in front of building for revised canopy column locations, added (1) parking space on east of building, and revised exterior bollard locations.

LDE, INC.
9250 Rumsey Road, Suite 106, Columbia, MD. 21045
(410) 715-1070 (301) 596-3424 (410) 715-9540 (Fax)

DESIGNED: Site Development Plan
SDH
DRAWN: British And American Auto Care, Inc.
SMC
CHECKED: Columbia
B.D.B. E.G.U. Subdivision
Parcel "C"
JOB NO.: 98-010
FILE NO.: SDP-98-132

SEQUENCE OF CONSTRUCTION

- 1) Obtain grading permit. 1 DAY
 - 2) Notify the Howard County Department of Public Works, Construction Inspection Division at least 48 hours prior to beginning construction at (410) 313-1880. 1 DAY
 - 3) Install sediment control devices, including stabilized construction entrance, sediment basin with dewatering device and RPS, earth dikes, temporary rip-rap inflow protection and silt fence. Ensure that well #1 on S-1 is blocked (see SD-7.00 detail, sht 6). Do not install pond forebays. *Water Inspection 10 DAYS*
 - 4) Grade site in accordance with the approved grading plan. Stabilize site in accordance with the temporary seeding notes. 10 DAYS
 - 5) Construct building and install roof drainage system. 3 MONTHS
 - 6) Install utilities, including storm drainage system, water and sewer. 10 DAYS
 - 7) Fine grade for parking lot and travelways. Install retaining walls. 4 DAYS
 - 8) Install gravel base for parking lot. 3 DAYS
 - 9) Install base and surface paving. 5 DAYS
 - 10) Stabilize all remaining disturbed areas in accordance with the permanent seeding notes. 2 DAYS
 - 11) With permission from the Sediment Control Inspector, remove all remaining sediment control devices, including stabilized construction entrance, silt fence, earth dikes and temporary rip-rap inflow protection at the end of the earth dike. Convert the sediment trap into permanent stormwater management pond per approved grading plan and SWM construction detail sheet. Install forebays A and B. Stabilize all remaining disturbed areas in accordance with the permanent seeding notes. 10 DAYS
- TOTAL TIME: 146 DAYS

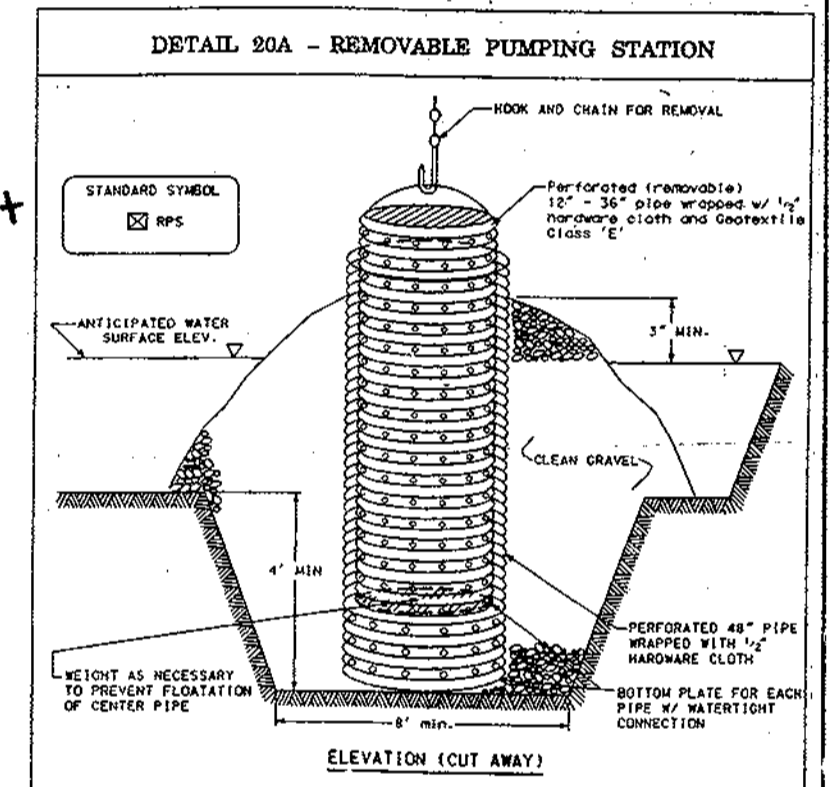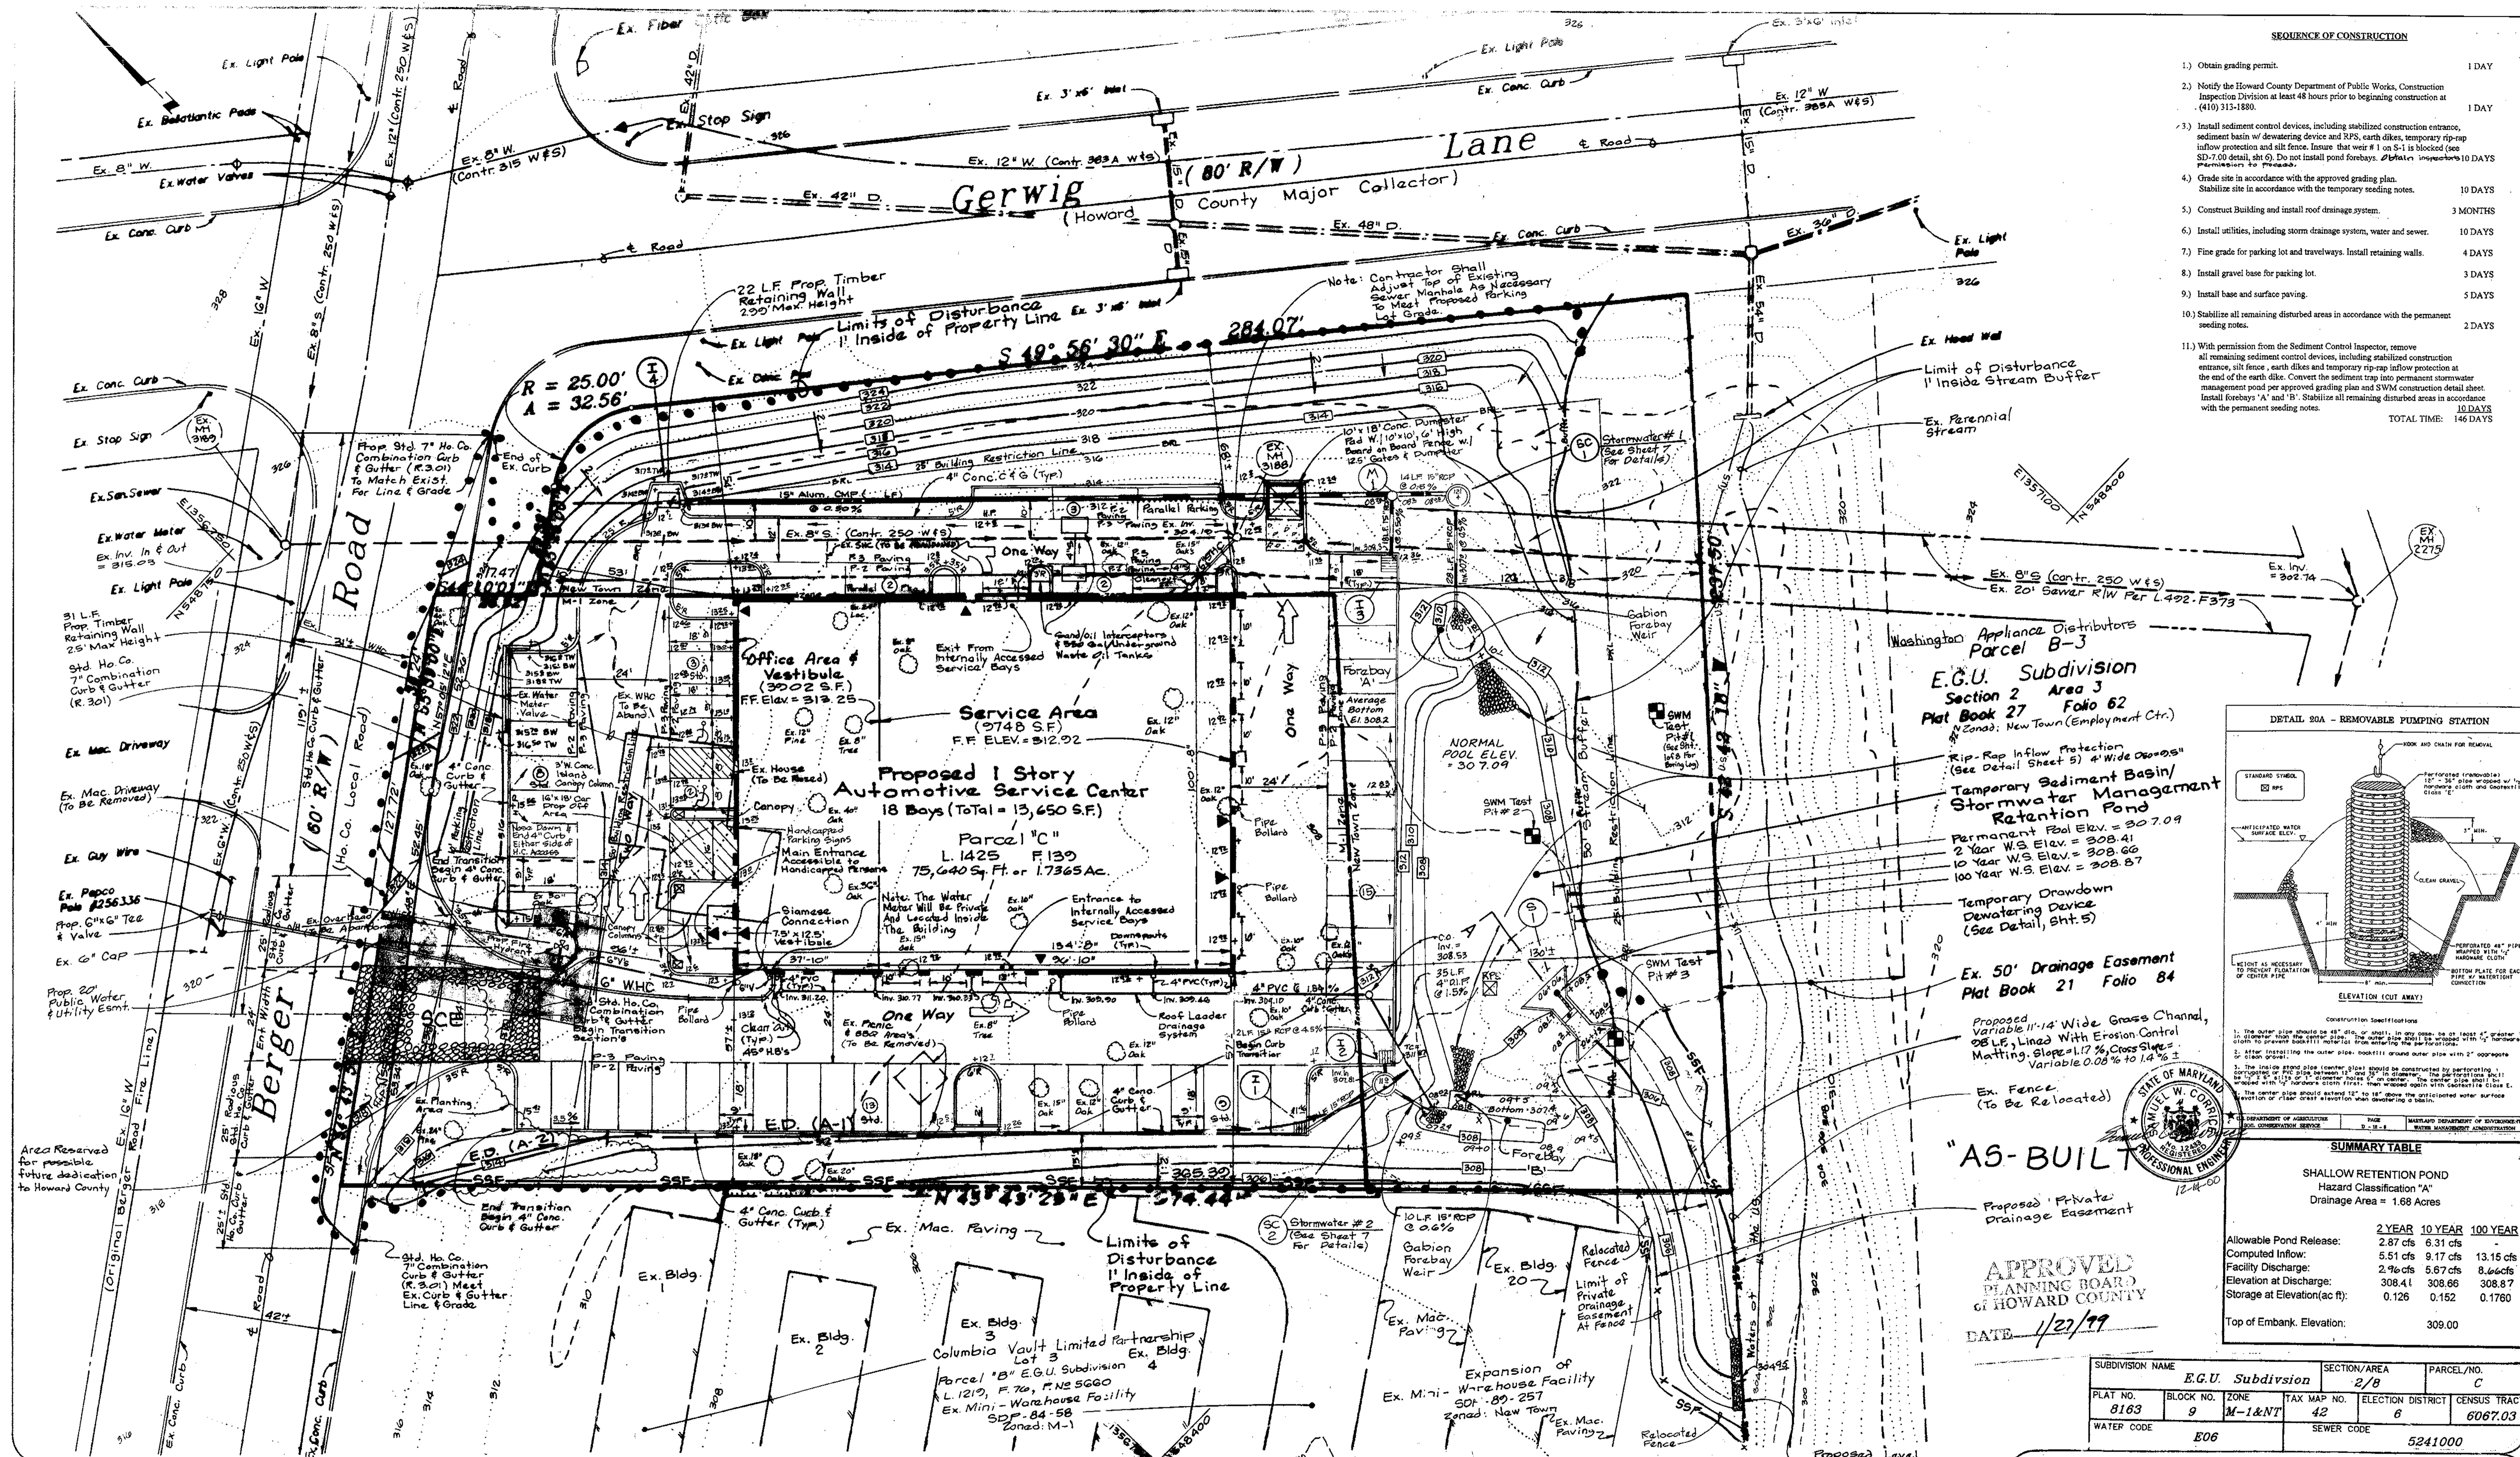

STATE OF MARYLAND
 DEPARTMENT OF PLANNING AND ZONING
 PROFESSIONAL ENGINEER
 12-14-99

SUMMARY TABLE

SHALLOW RETENTION POND
 Hazard Classification "A"
 Drainage Area = 1.68 Acres

	2 YEAR	10 YEAR	100 YEAR
Allowable Pond Release:	2.87 cfs	6.31 cfs	13.15 cfs
Computed Inflow:	5.51 cfs	9.17 cfs	13.15 cfs
Facility Discharge:	2.96 cfs	5.67 cfs	8.66 cfs
Elevation at Discharge:	308.41	308.66	308.87
Storage at Elevation (ac ft):	0.126	0.152	0.1760
Top of Embank. Elevation:	309.00		

SUBDIVISION NAME	SECTION/AREA	PARCEL/NO.
EGU Subdivision	2/8	C
PLAT NO. 8163	BLOCK NO. 9	ZONE M-1&N1
TAX MAP NO. 42	ELECTION DISTRICT 6	CENSUS TRACT 6067.03
WATER CODE E06	SEWER CODE 5241000	

Sediment Basin Schedule

Basin No.	Max. D.A. Acres	Dry Stor. Req'D	Wet Stor. Req'D	Dry Stor. Prov'D	Wet Stor. Prov'D	Dry Stor. Elev. ft.	Wet Stor. Elev. ft.	Bottom Elev. ft.	Clean Elev. ft.	Weir Depth ft.	Top Elev. ft.	Basin Size	Type
1	1.68	3024	3024	3024	3024	1.9	307.9	307.1	306	306.8	1.1	309	see plan Basin

** Top of embankment elevation.
 *** Concrete outlet structure consists of a .55' weir, Inv.=307.9 and a 4.0' weir, Inv.=308.38

REVISIONS

No.	Date:	By:	Description
1	4-28-99	SMC	Revised H.C. Parking and Associated grading in front of building for revised canopy column locations added (1) parking space on east of building, and revised exterior ballard locations.

APPROVED: DEPARTMENT OF PLANNING AND ZONING

DATE: 3/1/99

DATE: 3/1/99

DATE: 3/1/99

THESE PLANS HAVE BEEN REVIEWED FOR THE HOWARD SOIL CONSERVATION DISTRICT AND MEET THE TECHNICAL REQUIREMENTS.

DATE: 3/3/99

DATE: 3/3/99

DATE: 3/3/99

ENGINEER'S CERTIFICATE

"I HEREBY CERTIFY THAT THESE SOIL CONSERVATION AND SEDIMENT CONTROL PLANS REPRESENT A PRACTICAL AND FEASIBLE DESIGN BASED ON MY PERSONAL KNOWLEDGE OF THE SITE AND THE INFORMATION PROVIDED TO ME IN ACCORDANCE WITH REQUIREMENTS OF THE HOWARD SOIL CONSERVATION DISTRICT."

DATE: 2/24/99

DATE: 2/24/99

DATE: 2/23/99

DEVELOPER'S CERTIFICATE

"I HEREBY CERTIFY THAT ALL DEVELOPMENT AND/OR CONSTRUCTION WILL BE DONE ACCORDING TO THESE PLANS AND THAT ANY RESPONSIBLE PERSON SHALL BE A DEPARTMENT OF THE ENVIRONMENT APPROVED PARTICIPANT IN THE CONTROL OF SEDIMENT AND EROSION BEFORE THE PROJECT. I ALSO AUTHORIZE PERIODIC ON-SITE INSPECTION BY THE HOWARD SOIL CONSERVATION DISTRICT OR THEIR AUTHORIZED AGENTS AS REQUIRED HEREIN."

DATE: 2/23/99

LDE, INC.
 9250 Rumsey Road, Suite 106, Columbia, MD. 21045
 (410) 715-1070 (301) 596-3424 (410) 715-9540 (Fax)

DESIGNED: Grading And Sediment Control Plan
 SDH

DRAWN: British And American Auto Care, Inc.
 SMC

CHECKED: Columbia E.G.U. Subdivision
 B.D.B.

DATE: 7/98
 DATE: 4/98
 DATE: 10/98

Owner/Developer: Tax Map 42, P/O Parcel 386, Grid 9
 6th Election District
 Howard County, Maryland


Scale: 1" = 20'

Drawing: 3 of 9

Job No: 98-010

File No: SDP 98-132

LEGEND
 Time of Concentration Flow Path
 Soil Boundary
 Drainage Divide

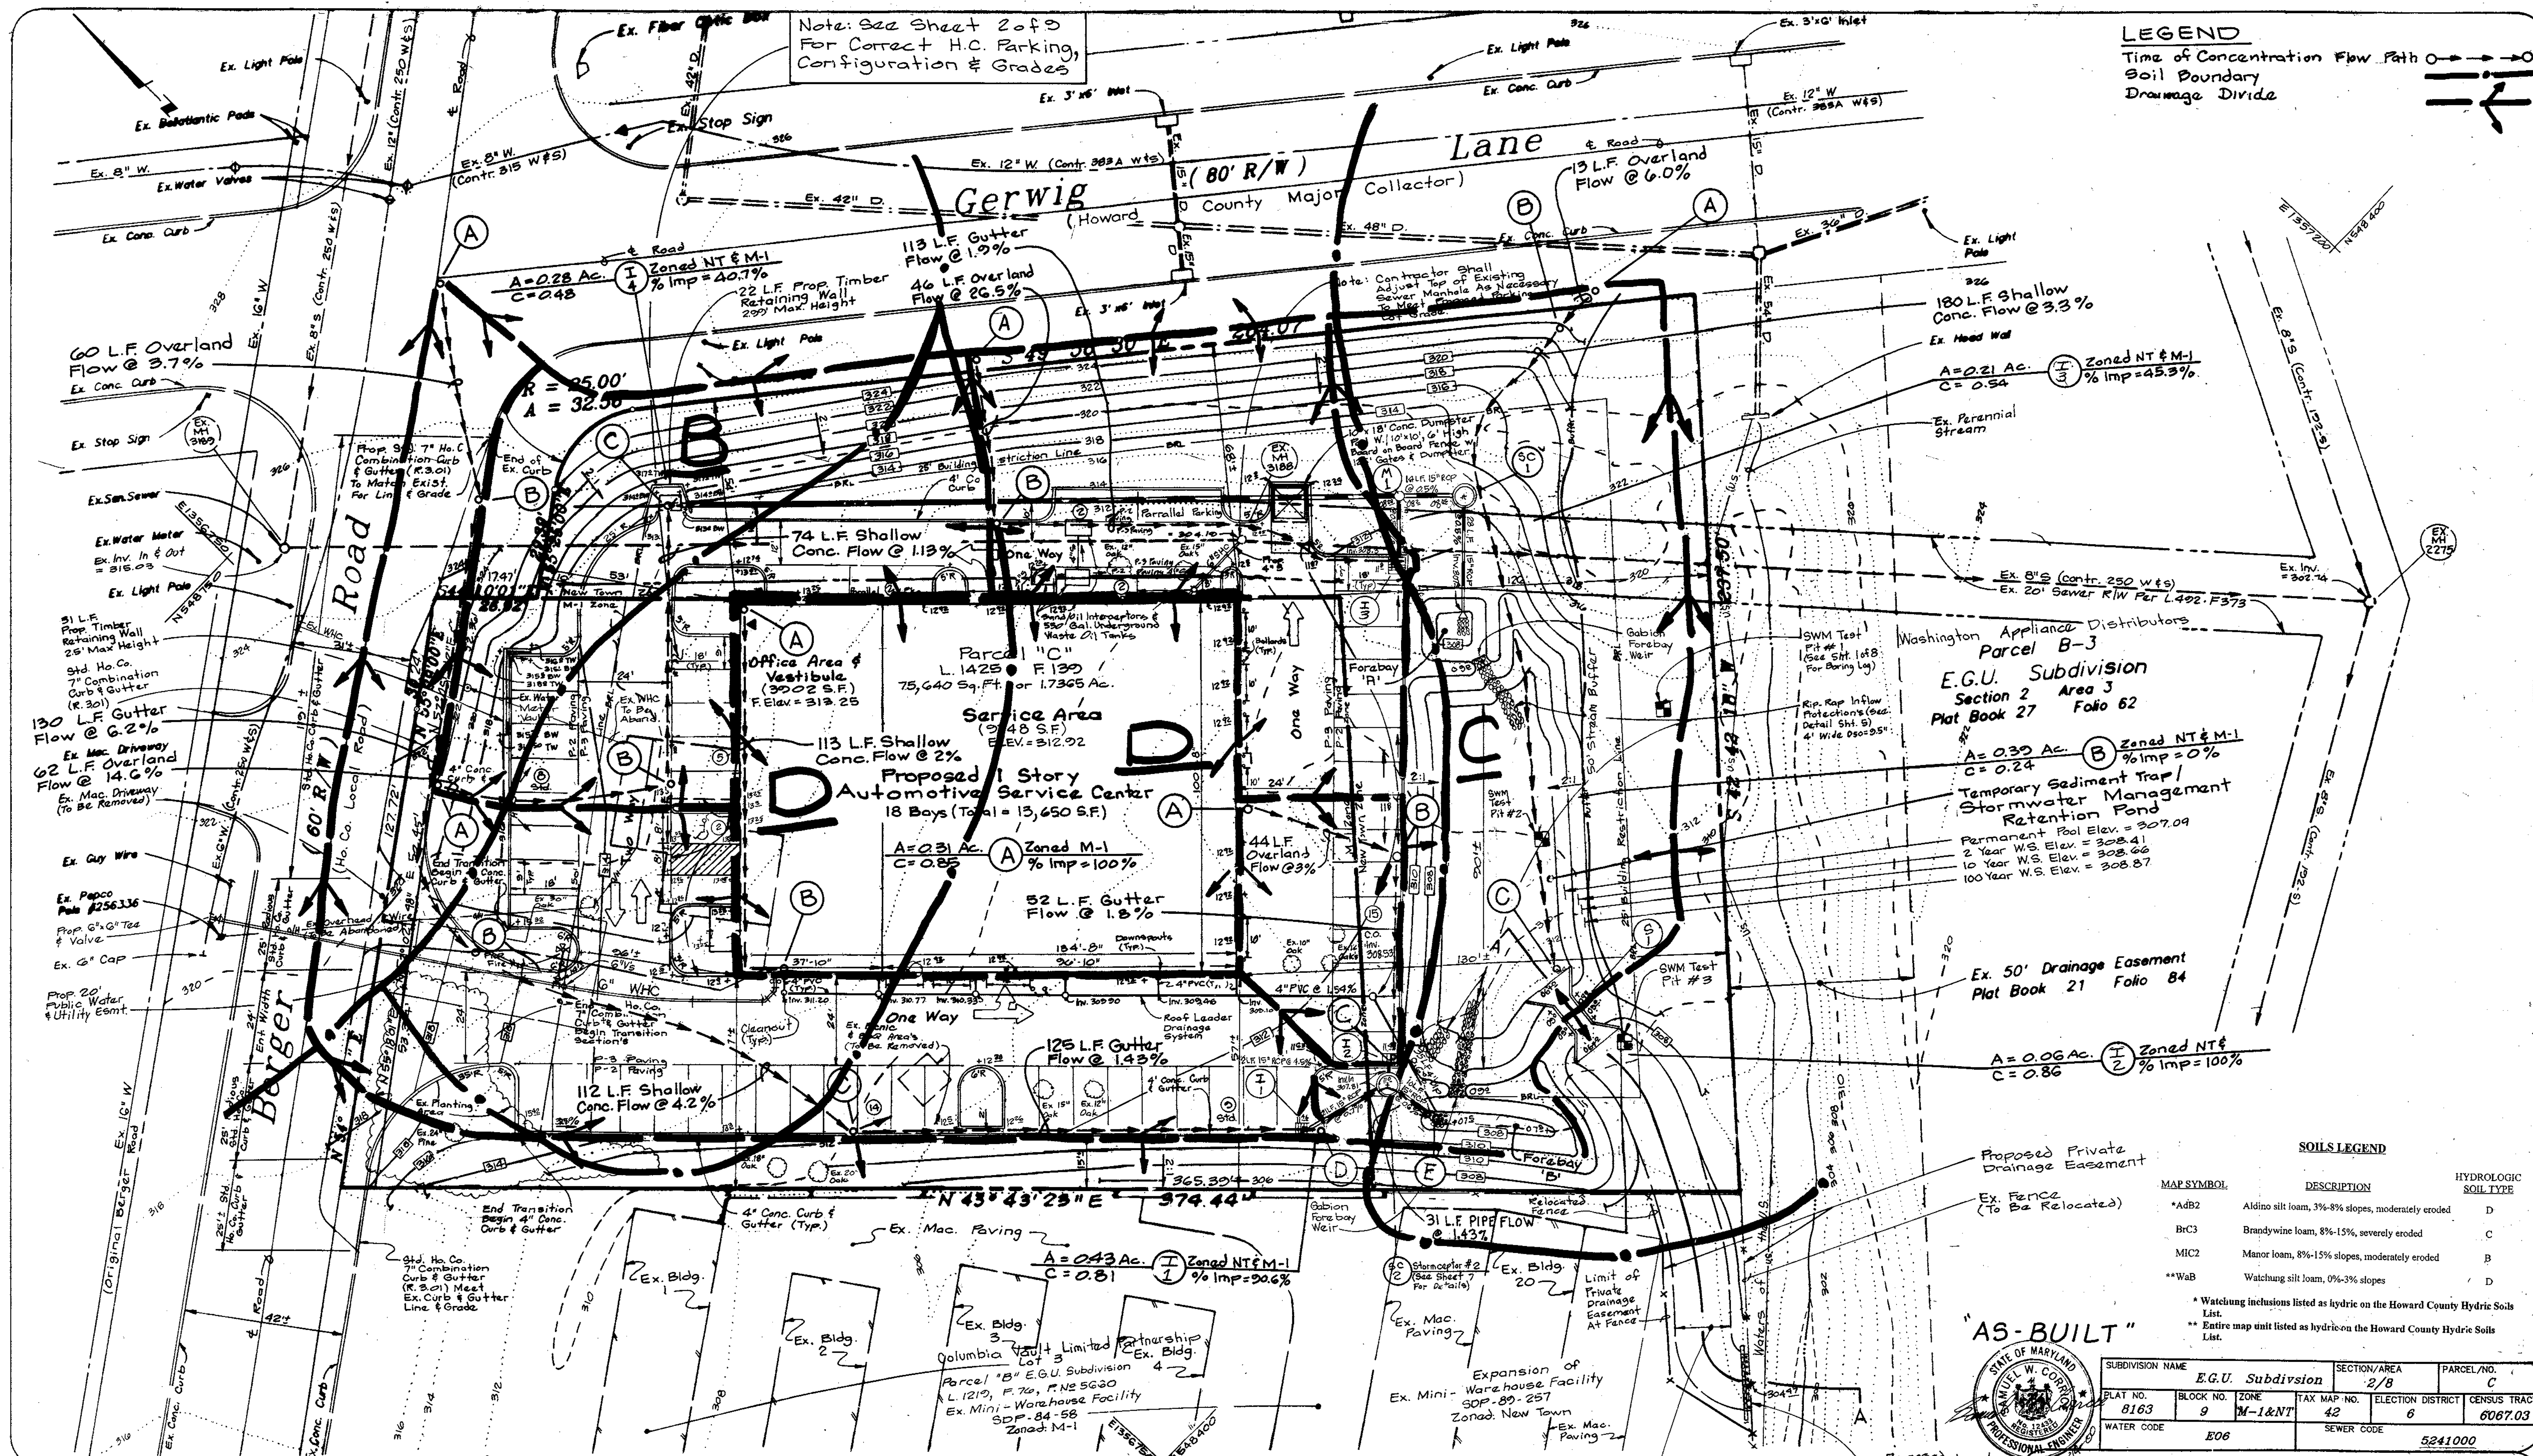

Washington Appliances Distributors
 Parcel B-3
 E.G.U. Subdivision
 Section 2 Area 3
 Plat Book 27 Folio 62

A = 0.30 Ac. Zoned NT & M-1
 C = 0.24 % Imp = 0%
 Temporary Sediment Trap /
 Stormwater Management
 Retention Pond
 Permanent Pool Elev. = 307.09
 2 Year W.S. Elev. = 308.41
 10 Year W.S. Elev. = 308.66
 100 Year W.S. Elev. = 308.87

Ex. 50' Drainage Easement
 Plat Book 21 Folio 84

A = 0.06 Ac. Zoned NT & M-1
 C = 0.86 % Imp = 100%

SOILS LEGEND

MAP SYMBOL	DESCRIPTION	HYDROLOGIC SOIL TYPE
*Adb2	Aldino silt loam, 3%-8% slopes, moderately eroded	D
BhC3	Brandywine loam, 8%-15%, severely eroded	C
MIC2	Manor loam, 8%-15% slopes, moderately eroded	B
**Wab	Watchung silt loam, 0%-3% slopes	D

* Watchung inclusions listed as hydric on the Howard County Hydric Soils List.
 ** Entire map unit listed as hydric on the Howard County Hydric Soils List.

"AS-BUILT"

SUBDIVISION NAME	E.G.U. Subdivision	SECTION/AREA	2/8	PARCEL/NO.	C
PLAT NO.	8163	BLOCK NO.	9	TAX MAP NO.	42
WATER CODE	E06	SEWER CODE	6	ELECTION DISTRICT	6067.03
				CENSUS TRACT	6067.03
				SEWER CODE	5241000

APPROVED: DEPARTMENT OF PLANNING AND ZONING

DATE: 3/1/99

DATE: 3/10/99

DATE: 3/11/99

THESE PLANS HAVE BEEN REVIEWED FOR THE HOWARD SOIL CONSERVATION DISTRICT AND MEET THE TECHNICAL REQUIREMENTS.

DATE: 3/3/99

DATE: 3/3/99

ENGINEER'S CERTIFICATE

I HEREBY CERTIFY THAT THE SOIL EROSION AND SEDIMENT CONTROL REPRESENTS A PRACTICAL PLAN BASED ON MY PERSONAL KNOWLEDGE OF THE SITE AND THAT IT WAS PREPARED IN ACCORDANCE WITH REGULATIONS AND THE HOWARD SOIL CONSERVATION DISTRICT.

DATE: 2/24/99

DEVELOPER'S CERTIFICATE

I HEREBY CERTIFY THAT ALL DEVELOPMENT AND/OR CONSTRUCTION WILL BE DONE ACCORDING TO THESE PLANS AND THAT ANY RESPONSIBLE PERSONNEL WHOSE CONSTRUCTION PROJECT WILL HAVE A CERTIFICATE OF ATTENDANCE AT A DEPARTMENT OF THE ENVIRONMENT APPROVED TRAINING PROGRAM FOR THE CONTROL OF SEDIMENT AND EROSION BEFORING THE PROJECT. I ALSO AUTHORIZE PERIODIC ON-SITE INSPECTION BY HOWARD SOIL CONSERVATION DISTRICT OR THEIR AUTHORIZED AGENTS. (SEEDED NECESSARY)

DATE: 2/23/99

STATE OF MARYLAND
 PROFESSIONAL ENGINEER

Proposed Variable 11'-1/2" Wide Grass Channel, 98 L.F., Lined With Erosion Control Matting.
 Slope = 1:1.7%
 Cross Slope = 0.08% to 1.4% ±
 2 Yr. Q = 2.96 cfs
 2 Yr. V = 1.32 fps
 2 Yr. D = 0.25 ft
 10 Yr. Q = 5.67 cfs
 10 Yr. V = 1.64 fps
 10 Yr. D = 0.31 ft
 100 Yr. Q = 8.60 cfs
 100 Yr. V = 1.92 fps
 100 Yr. D = 0.36 ft

APPROVED PLANNING BOARD OF HOWARD COUNTY
 DATE: 1/27/99

LDE, INC.
 9250 Rumsey Road, Suite 106, Columbia, MD. 21045
 (410) 715-1070 (301) 596-3424 (410) 715-9540 (Fax)

DESIGNED: Drainage Area And Soils Map
 DRAWN: British And American Auto Care, Inc.
 CHECKED: SMC
 DATE: 4/98

FILE NO. SDP-98-132

**HOWARD SOIL CONSERVATION DISTRICT
STANDARD SEDIMENT CONTROL NOTES**

1. A minimum of 48 hours notice must be given to the Howard County Department of Inspections, Licenses and Permits, Sediment Control Division prior to the start of any construction activity.
2. All vegetative and structural practices are to be installed according to the current MARYLAND STANDARDS AND SPECIFICATIONS FOR SOIL EROSION AND SEDIMENT CONTROL and revisions thereto.
3. Following initial soil disturbance, permanent or temporary stabilization shall be completed within 7 calendar days for all permanent sediment control structures, dikes, perimeter berms and all slopes greater than 3:1. 14 days for all other disturbed or graded areas on the project site.
4. All sediment from basins shall be fenced and warning signs posted around their perimeter in accordance with 101-1, Storm Drainage, HOWARD COUNTY DESIGN MANUAL, Storm Drainage.
5. All disturbed areas must be established within the time period specified above in accordance with the 1994 MARYLAND STANDARDS AND SPECIFICATIONS FOR SOIL EROSION AND SEDIMENT CONTROL and revisions thereto.
6. Temporary seeding, and mulching, temporary stabilization with such one year or less duration, and other temporary stabilization practices shall be maintained in operative condition until permanent stabilization has been achieved from the Howard County Sediment Control Inspector.
7. Site Analysis:
 - a. Total Area of Site: 1.57 Acres
 - b. Area Disturbed: 0.57 Acres
 - c. Area to be vegetatively stabilized: 0.22 Acres
 - d. Total Topsoil: 109,000 lbs.
8. Any sediment control practice which is disturbed by grading activity for placement of utilities shall be repaired on the same day of disturbance. Additional sediment control must be provided, if deemed necessary by the Howard County Sediment Control Inspector.
9. On all sites with disturbed areas in excess of 2 acres, approval of the inspection agency shall be required for the installation of permanent perimeter erosion and sediment controls, but before proceeding with any other earth disturbance activities, including grading, filling or excavation, approval may not be authorized until this initial approval by the inspection agency has been received.
10. The trench for the construction of utilities is limited to three pipe lengths or that which can be back filled and stabilized within one working day, whichever is shorter.

1. On soil testing (topsoil) specifications, obtain test results indicating fertility and lime amendments required to bring the soil into compliance with the following:
 - a. pH for topsoil shall be between 6.0 and 7.5. If the tested soil demonstrates a pH of less than 6.0, sufficient lime shall be prescribed to raise the pH to 6.5 or higher.
 - b. Organic content of topsoil shall be not less than 1.5 percent by weight.
 - c. Topsoil having soluble salt content greater than 500 parts per million shall not be used.
 - d. The soil or subsoil shall be placed on soil which has been treated with soil sterilants or chemicals used for weed control until sufficient time has elapsed (14 days min.) to permit dissipation of phytotoxic material.
2. Topsoil substitutes or amendments, as recommended by a qualified agronomist or soil scientist and approved by the appropriate approval authority, may be used in lieu of natural topsoil.
3. Place topsoil (if required) and apply soil amendments as specified in 20.0 Vegetative Stabilization - Section I - Vegetative Stabilization Methods and Materials.
4. Topsoil Application:
 - i. When topsoiling, maintain needed erosion and sediment control practices such as diversions, Grade Stabilization Structures, Earth Dikes, Slope Silt Fence and Basins.
 - ii. Grades on the areas to be topsoiled, which have been previously established, shall be maintained, about 4" - 8" higher in elevation.
 - iii. Topsoil shall be uniformly distributed in a 4" - 8" layer and lightly compacted to a minimum thickness of 4". Spreading shall be performed in such a manner that sodding or seeding can proceed with a minimum of additional soil preparation and tillage. Any irregularities in the surface resulting from topsoiling or other operations shall be frozen or matted condition, when the subsoil is excessively wet or in a condition that may otherwise be detrimental to proper grading and seedbed preparation.
 - iv. Topsoil shall not be placed while the topsoil or subsoil is in a frozen or matted condition, when the subsoil is excessively wet or in a condition that may otherwise be detrimental to proper grading and seedbed preparation.
5. Alternative for Permanent Seeding - Instead of applying the full amount of lime and commercial fertilizer, composted sludge and amendments may be applied as specified below:
 - i. Composted Sludge Material for use as a soil conditioner for sites having disturbed areas over 5 acres shall be tested to determine amendments and for sites having disturbed areas under 5 acres, shall conform to the following:
 - a. Composted sludge shall be supplied by, or originate from, a commercial source.
 - b. Composted sludge shall contain at least 1 percent nitrogen, 2 percent phosphorus, and 0.2 percent potassium and have a pH of 7.0 to 8.0. If compost does not meet these requirements, the appropriate constituents must be added to meet the requirements of 20.0 Vegetative Stabilization - Section I - Vegetative Stabilization Methods and Materials.
 - c. Composted sludge shall be applied at a rate of 1 ton/1,000 square feet.
 - d. Composted sludge shall be amended with a potassium fertilizer applied at the rate of 4 to 10,000 square feet, and 1/3 the normal lime application rate.
 - ii. References: Guidelines Specifications, Soil Preparation and Sodding, MD-VA, Pub. #1, Cooperative Extension Service, University of Maryland and Virginia Polytechnic Institute, Revised 1975.












**HOWARD SOIL CONSERVATION DISTRICT
PERMANENT SEEDING NOTES**

- Apply to graded or cleared areas not subject to immediate further disturbance where a permanent long-lived vegetative cover is needed.
- SEEDING PREPARATION: Loosen upper three inches of soil by raking, disking, or other acceptable means before seeding, if not previously loosened.
- SOIL AMENDMENTS: In lieu of soil test recommendations, use one of the following methods:
- 1) PREFERRED - Apply 2 tons per acre dolomitic limestone (80 lbs/1000sq. ft.) and 600 lbs per acre 10-10-10 fertilizer (14 lbs/1000 sq. ft.) before seeding. Harrow or disk into upper three inches of soil. At time of seeding, apply 2 tons per acre 30-0-0 ureaform fertilizer (6 lbs/1000sq. ft.) and 1000 lbs per acre dolomitic limestone (25 lbs/1000sq. ft.) and 1000 lbs per acre 10-10-10 fertilizer (25 lbs/1000 sq. ft.) before seeding. Harrow or disk into upper three inches of soil.
 - 2) ACCEPTABLE - Apply 2 tons per acre dolomitic limestone (80 lbs/1000sq. ft.) and 1000 lbs per acre 10-10-10 fertilizer (25 lbs/1000 sq. ft.) before seeding. Harrow or disk into upper three inches of soil.
- SEEDING - For the period March 1 thru April 30, and August 1 thru October 15, seed with 80 lbs per acre (14 lbs/1000sq. ft.) of Kentucky 31 Tall Fescue. For the period May 1 thru July 31, seed with 80 lbs per acre (14 lbs/1000sq. ft.) of Kentucky 31 Tall Fescue and 2 tons per acre (4 lbs/1000sq. ft.) of seeding vetch. During the period of October 16 thru February 28, seed with 2 tons per acre of well anchored straw mulch and seed as soon as possible in the spring. Option (2) - Use seed with 80 lbs per acre Kentucky 31 Tall Fescue and mulch 2 tons / acre well anchored straw.
- MULCHING - Apply 1-1/2 to 2 tons per acre (70 to 90 lbs/1000sq. ft.) of untreated small grain straw immediately after seeding. Anchor mulch immediately after application using mulch anchoring tool or 216 gallons per acre (5 gal/1000sq. ft.) of mulchified asphalt on flat areas. On slopes 6 feet or higher, use 348 gallons per acre (6 gal/1000sq. ft.) for anchoring.
- MAINTENANCE - Inspect all seeding areas and make needed repairs, replacements and reseedings.

TEMPORARY SEEDING NOTES

- Apply to graded or cleared areas likely to be redistributed over a short-term vegetative cover is needed.
- SEEDING PREPARATION: Loosen upper three inches of soil by raking, disking, or other acceptable means before seeding, if not previously loosened.
- SOIL AMENDMENTS: - Apply 600 lbs per acre 10-10-10 fertilizer (14 lbs/1000sq. ft.).
- SEEDING - For the period March 1 thru April 30, and August 1 thru October 15, seed with 80 lbs per acre (14 lbs/1000sq. ft.) of Kentucky 31 Tall Fescue. For the period May 1 thru July 31, seed with 80 lbs per acre (14 lbs/1000sq. ft.) of Kentucky 31 Tall Fescue and 2 tons per acre (4 lbs/1000sq. ft.) of seeding vetch. During the period of October 16 thru February 28, protect site by applying 2 tons per acre of well anchored straw mulch and seed as soon as possible in the spring, or seed with 80 lbs per acre Kentucky 31 Tall Fescue and mulch 2 tons / acre well anchored straw.
- MULCHING - Apply 1-1/2 to 2 tons per acre (70 to 90 lbs/1000sq. ft.) of untreated small grain straw immediately after seeding. Anchor mulch immediately after application using mulch anchoring tool or 216 gallons per acre (5 gal/1000sq. ft.) of mulchified asphalt on flat areas. On slopes 6 feet or higher, use 348 gallons per acre (6 gal/1000sq. ft.) for anchoring.
- Refer to the 1994 MARYLAND STANDARDS AND SPECIFICATIONS FOR SOIL EROSION AND SEDIMENT CONTROL for additional rates and methods not covered.

21.0 STANDARD AND SPECIFICATIONS FOR TOPSOIL

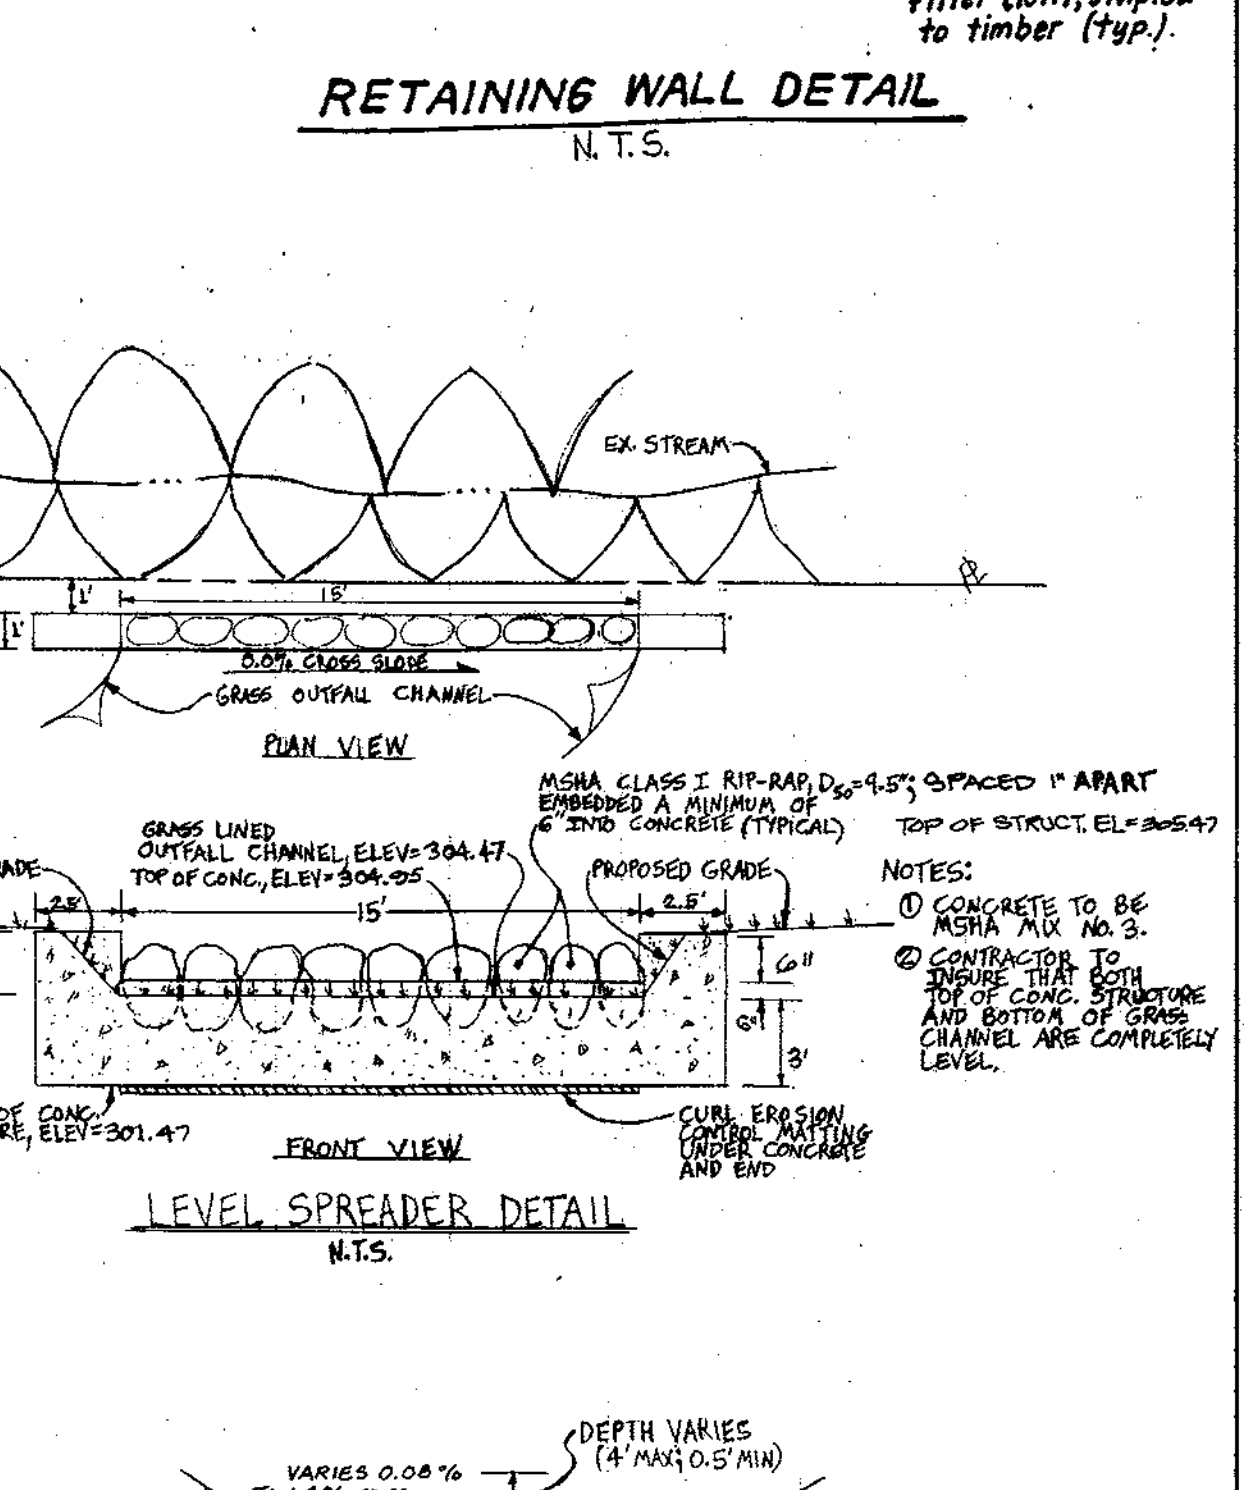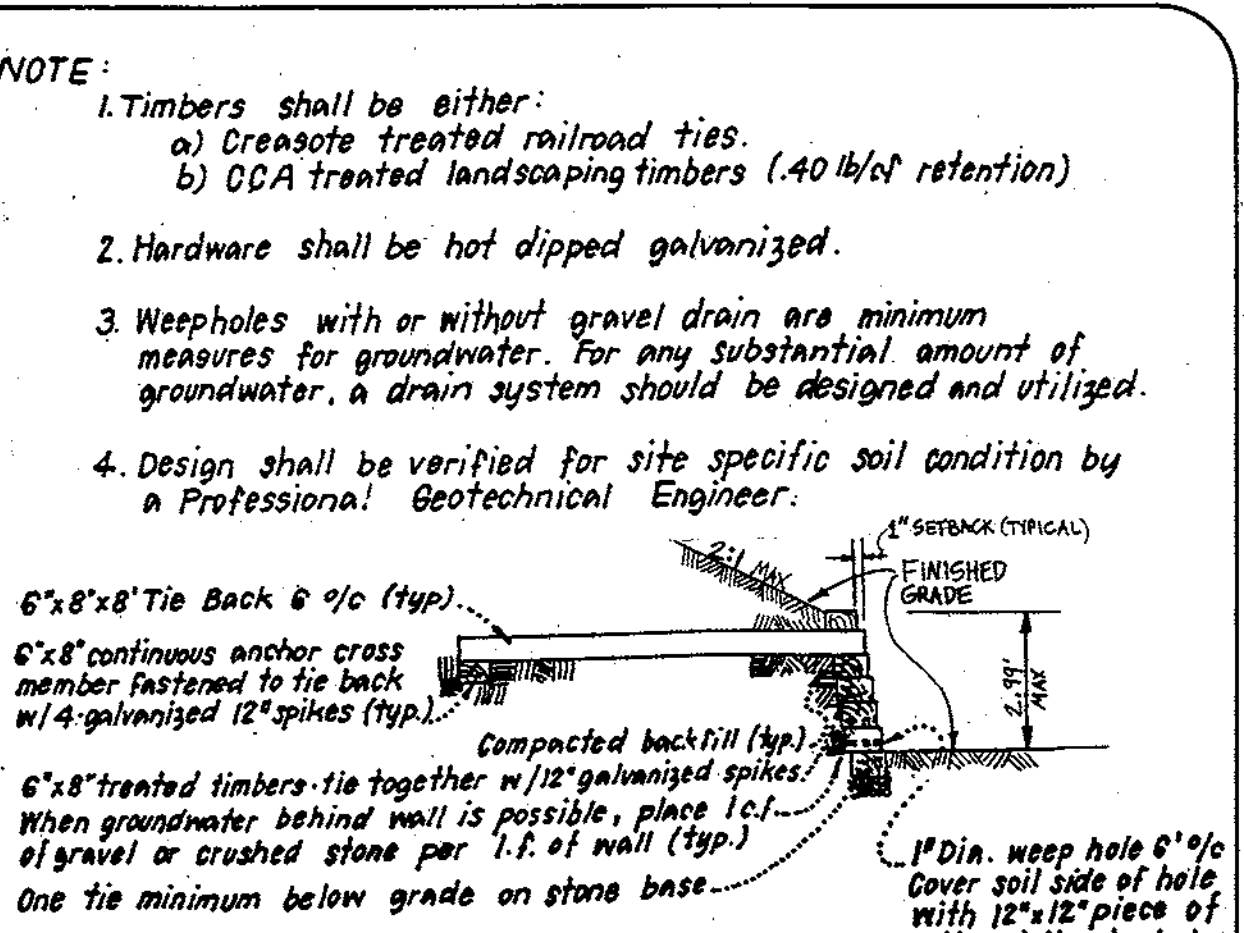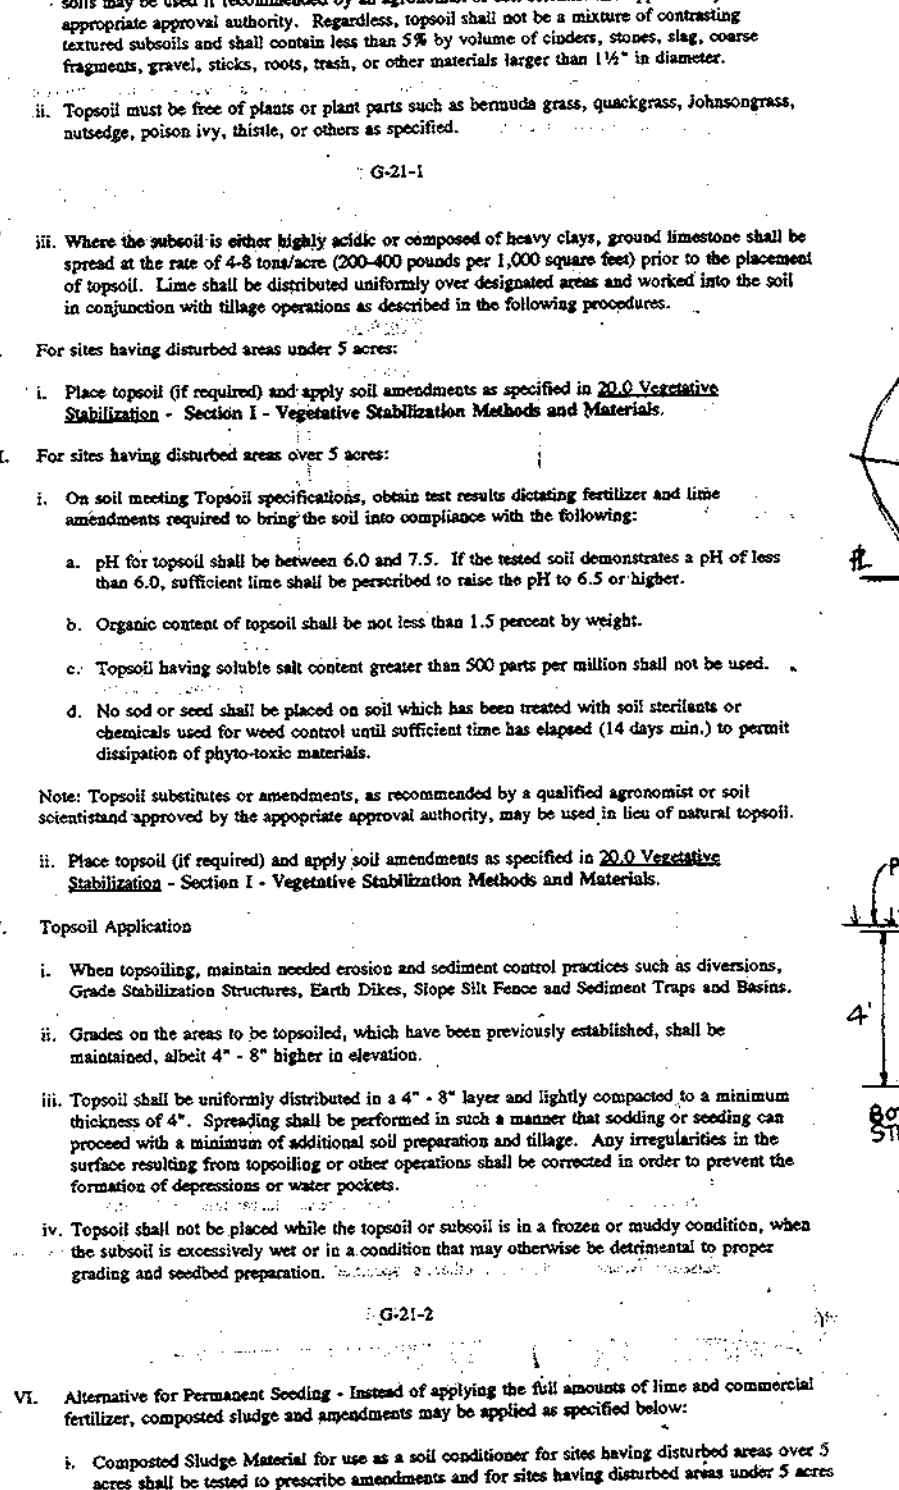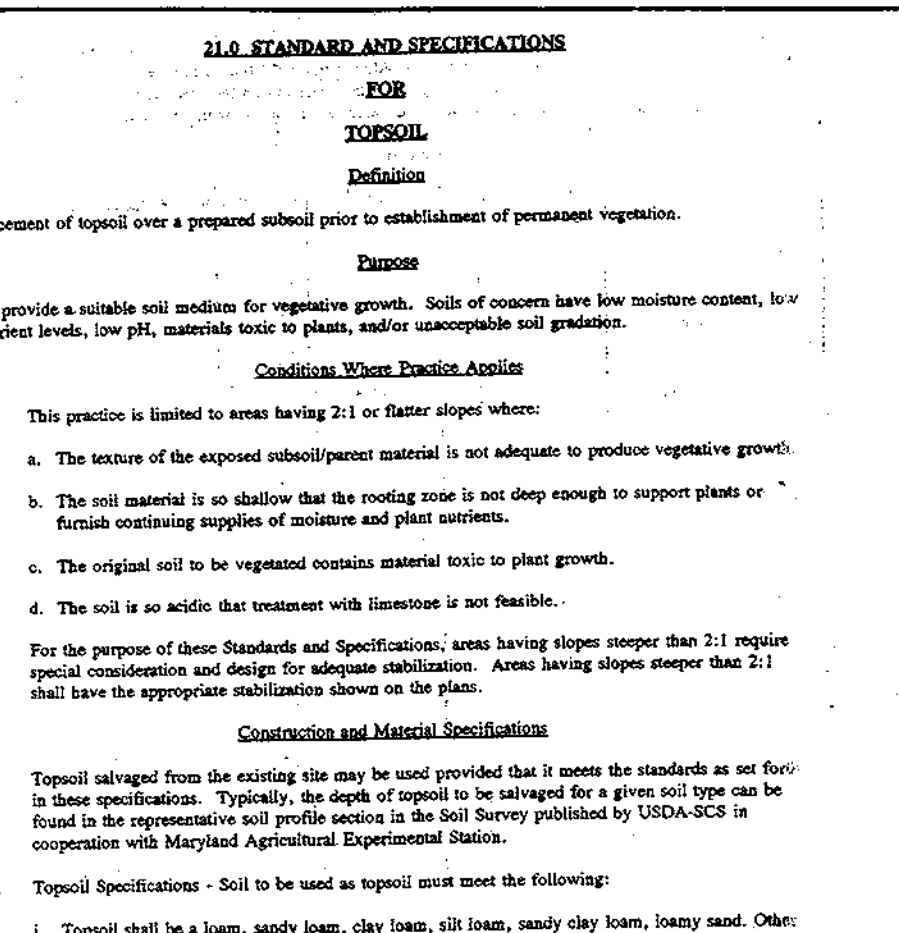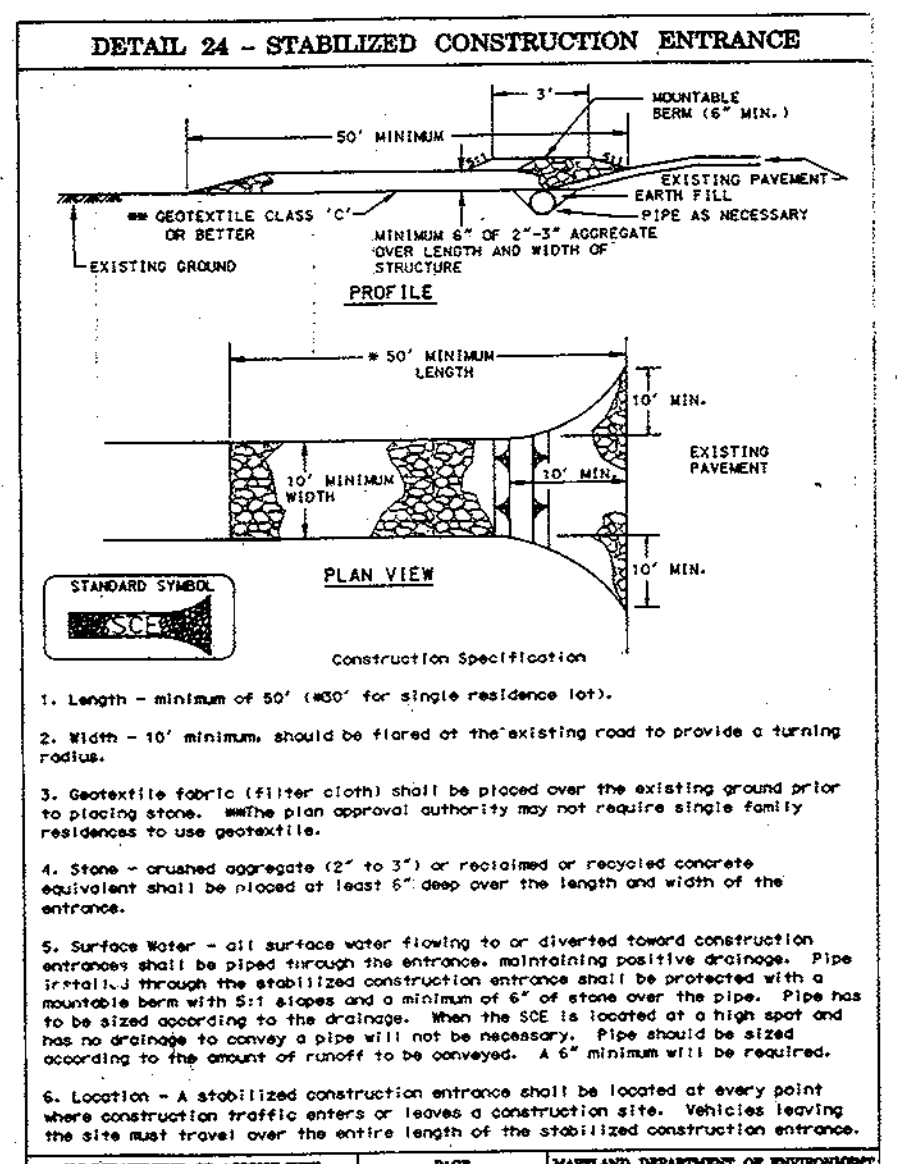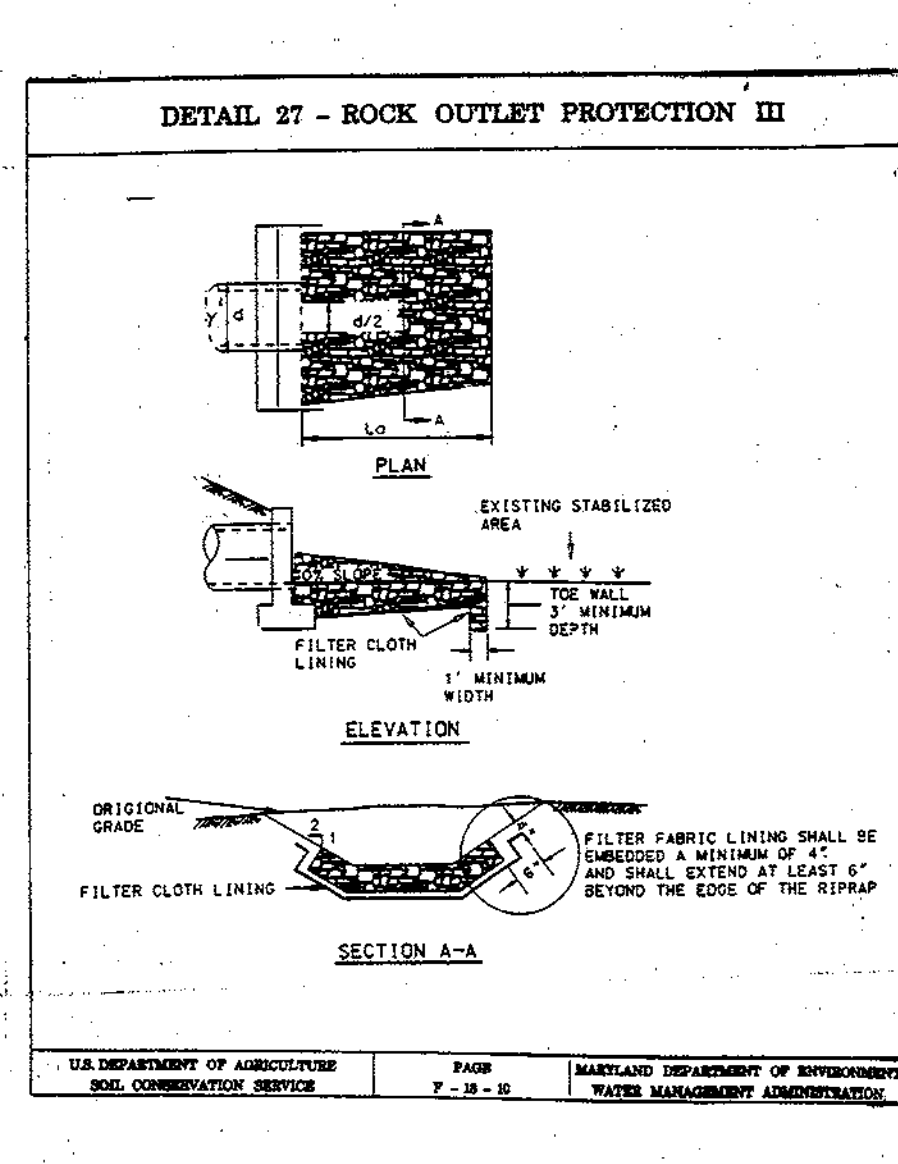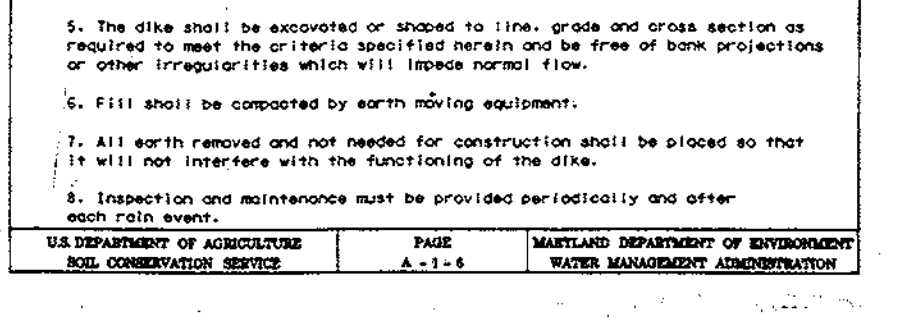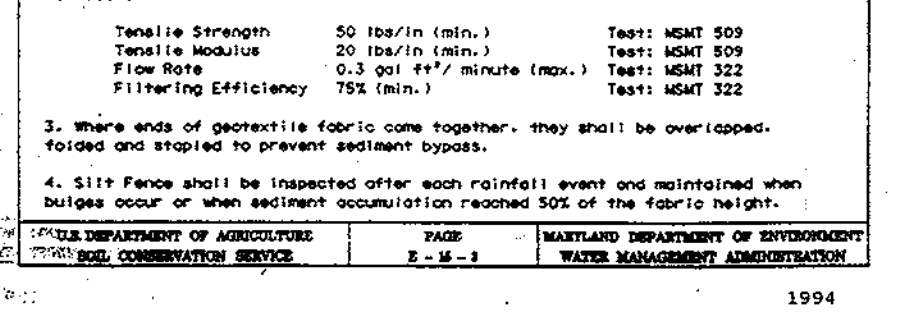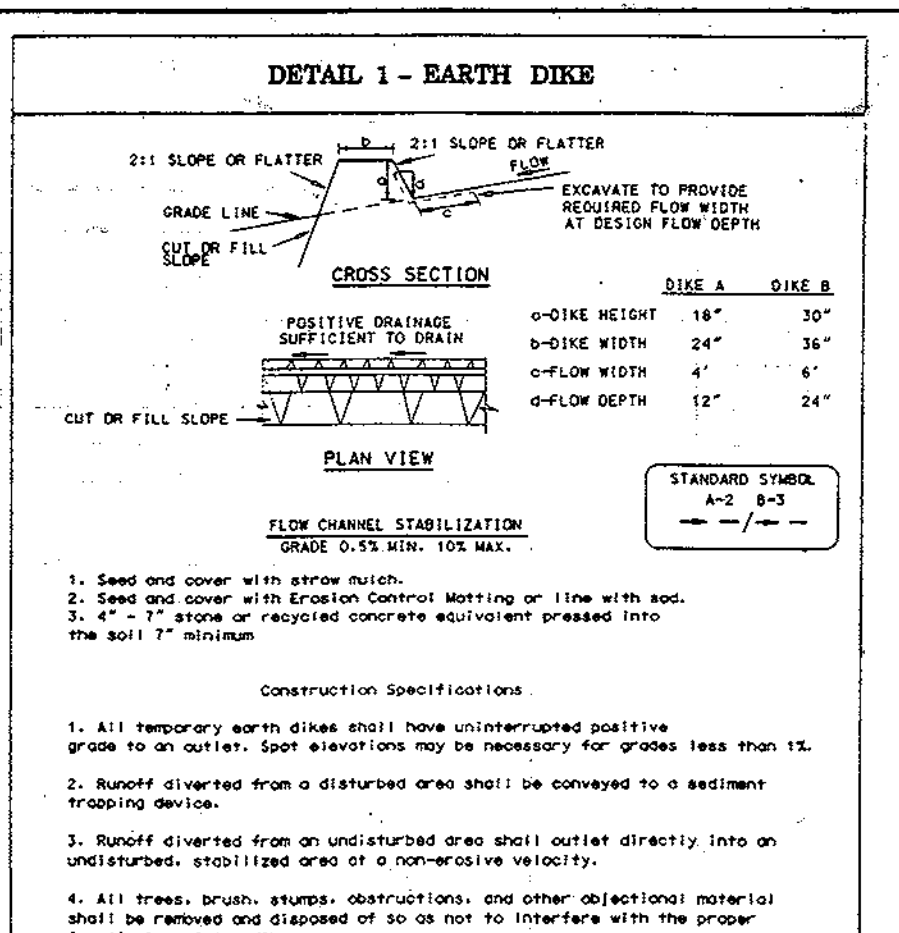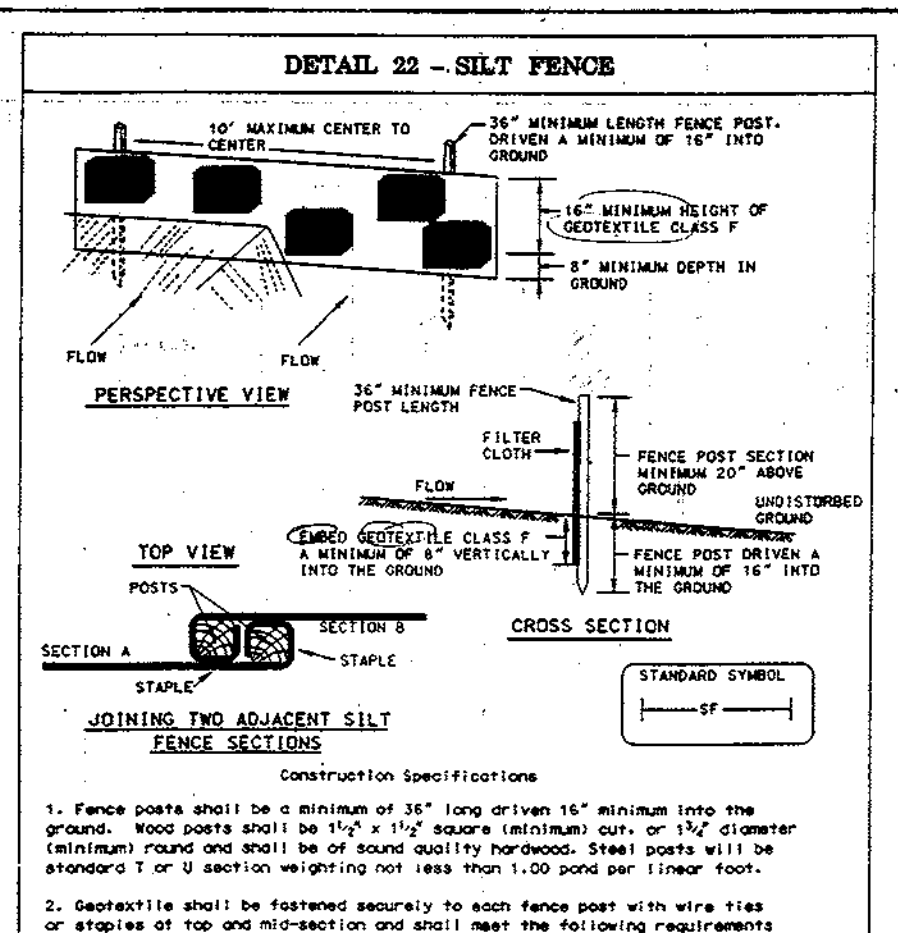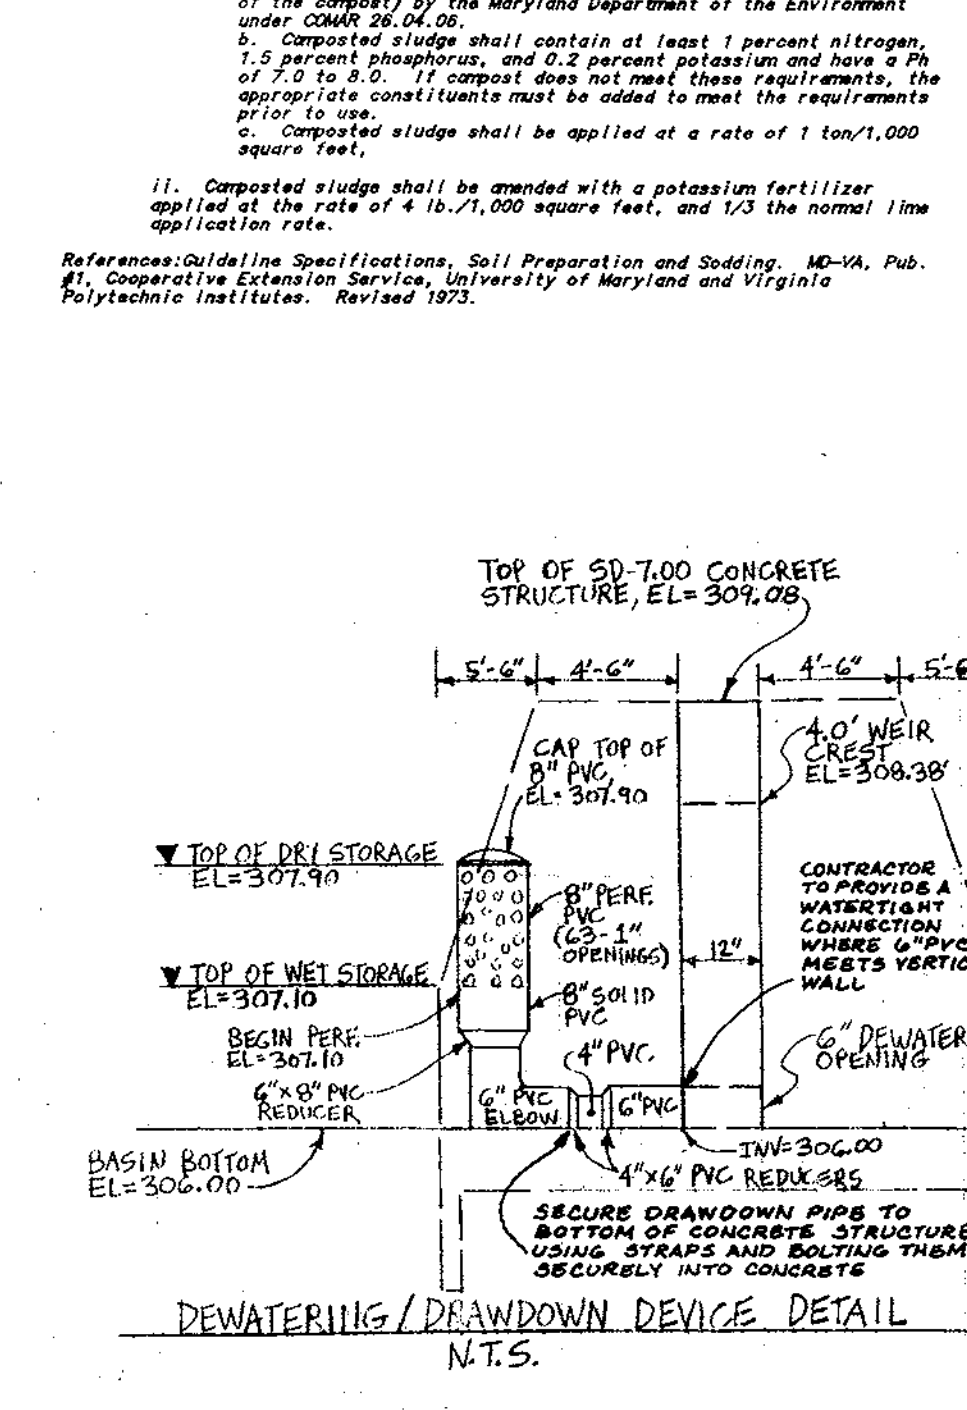

APPROVED: DEPARTMENT OF PLANNING AND ZONING

DATE: 3/1/99

DATE: 3/1/99

DATE: 3/1/99

THESE PLANS HAVE BEEN REVIEWED FOR THE HOWARD SOIL CONSERVATION DISTRICT AND MEET THE TECHNICAL REQUIREMENTS.

DATE: 3/3/99

DATE: 3/1/99

DATE: 3/1/99

ENGINEER'S CERTIFICATE

I HEREBY CERTIFY THAT THIS PLAN FOR EROSION AND SEDIMENT CONTROL REPRESENTS A PRACTICAL AND FEASIBLE DESIGN BASED ON MY PERSONAL KNOWLEDGE OF THE SITE AND THE INFORMATION PROVIDED. I WAS PREPARED IN ACCORDANCE WITH REQUIREMENTS OF THE HOWARD SOIL CONSERVATION DISTRICT.

DATE: 4/24/99

DEVELOPER'S CERTIFICATE

I/WE CERTIFY THAT ALL DEVELOPMENT AND/OR CONSTRUCTION WILL BE DONE ACCORDING TO THESE PLANS AND THAT ANY RESPONSIBLE PERSONNEL INVOLVED IN THE CONSTRUCTION PROJECT WILL HAVE A CERTIFICATE OF ATTENDANCE AT A DEPARTMENT OF THE ENVIRONMENT APPROVED TRAINING PROGRAM FOR THE CONTROL OF SEDIMENT AND EROSION BEING THE PROJECT. I ALSO AUTHORIZE PERMITS AND/OR PROTECTIVE MEASURES FOR THE HOWARD SOIL CONSERVATION DISTRICT OR THEIR AUTHORIZED AGENTS AS DEEMED NECESSARY.

DATE: 2/12/99

APPROVED PLANNING BOARD OF HOWARD COUNTY

DATE: 1/27/99

"AS-BUILT"

LDE, INC.

9250 Rumsey Road, Suite 106, Columbia, MD 21045
(410) 715-1070 (301) 596-3424 (410) 715-9540 (Fax)

British And American Auto Care, Inc.

Columbia
E.G.U. Subdivision
Parcel "C"

Tax Map 42, P/O Parcel 386, Grid 9
6th Election District
Howard County, Maryland

DATE: 7/9/98
4/98
8/10/98

FILE NO: SDP 98-132

SDH (DESIGNED)
SMC (DRAWN)
B.D.B. (CHECKED)

SCALE: AS SHOWN
DRAWING: 5 of 9
JOB NO.: 98-010
FILE NO.: SDP 98-132

POND CONSTRUCTION SPECIFICATIONS

These specifications are appropriate to all ponds within the scope of the Standard for practice MD-378. All references to ASTM and AASHTO specifications apply to the most recent version.

SITE PREPARATION

Areas designated for borrow areas, embankment and structural works shall be cleared, grubbed, and stripped of topsoil. All trees, vegetation, roots, and other objectionable material shall be removed. Channel banks and sharp breaks shall be sloped to no steeper than 1:1.

Areas to be covered by the reservoir will be cleared of all trees, brush, logs, stumps, rubbish, and other objectionable material unless otherwise designated on the plans. Trees, brush and stumps shall be cut approximately level to the ground surface. For dry stormwater management ponds, a minimum of a 50 foot radius around the inlet structure shall be cleared.

All cleared and grubbed material shall be disposed of outside and below the limits of the dam and reservoir as directed by the owner or his representative. When specified, a sufficient quantity of topsoil will be stockpiled in a suitable location for use on the embankment and other designated areas.

EARTH FILL

Material - The fill material shall be taken from approved designated borrow areas. It shall be free of cobbles, boulders, or other material larger than 6", frozen or other objectionable materials. Fill material for the center of the embankment and cut off trench shall conform to Unified Soil Classification G_z, S_z, C_z, or CL. Consideration may be given to the use of other materials in the embankment if design and construction are supervised by a geotechnical engineer.

Placement - Areas on which fill is to be placed shall be scarified prior to the placement of fill. Fill materials shall be placed in maximum 8 inch thick (before compaction) layers which are to be continuous over the entire length of fill. The most permeable material shall be placed in the downstream portions of the embankment. The principal spillway must be installed concurrently with fill placement and not excavated into the embankment.

Compaction - The movement of the hauling and spreading equipment over the fill shall be controlled so that the entire surface of each lift shall be traversed by not less than one tread track of the equipment or compaction shall be achieved by a minimum of four complete passes of a roller. The roller shall be operated so that the fill material shall contain sufficient moisture such that the required degree of compaction will be obtained with the equipment used. The fill material shall contain sufficient moisture so that if formed into a ball it will not crumble yet not be so wet that water can be squeezed out.

Where a minimum required density is specified, it shall not be less than 95% of maximum dry density with a moisture content within +/- 2% of the optimum. Each layer of fill shall be compacted as necessary to obtain that density, and is to be certified by the Engineer at the time of construction. All compaction is to be determined by AASHTO Method T-99.

Cut off Trench - The cutoff trench shall be excavated into impervious material along or parallel to the centerline of the embankment as shown on the plans. The bottom width of the trench shall be governed by the equipment used for excavation, with the minimum width being four feet. The depth shall be at least four feet below existing grade or as shown on the plans. The bottom of the trench shall be 1 to 1 of filler. The backfill shall be compacted with construction equipment, rollers, or hand tampers to assure maximum density and minimum permeability.

STRUCTURAL BACKFILL

Backfill adjacent to pipes or structures shall be of the type and quality conforming to that specified for the adjoining fill material. The fill shall be placed in horizontal layers not to exceed four inches in thickness and compacted by hand tampers or other manually directed compaction equipment. The material needs to fill completely all spaces under and adjacent to the pipe. At no time during the backfilling operation shall driven equipment be allowed to operate closer than four feet measured vertically to the pipe. Under no circumstances shall equipment be driven over any part of a concrete structure or pipe, unless there is compacted fill of 24" or greater over the structure or pipe.

PIPE CONDUITS

All pipes shall be circular in cross section.

CORRUGATED METAL PIPE - All of the following criteria shall apply for corrugated metal pipe:

1. Materials - (Steel Pipe) - This pipe and its appurtenances shall be galvanized and fully bituminous coated and shall conform to the requirements of AASHTO Specification M-190 Type A with watertight coupling bands. Any bituminous coating damaged or otherwise removed shall be replaced with cold applied bituminous coating compound. Steel pipes with polymeric coatings have a minimum coating thickness of 0.01 inch (10 mil) on both sides of the pipe. The following coating or an approved equal may be used: Naxox, Plasti-Cote, Blac-Klad, and Beth-Co-Loy. Coated corrugated steel pipe shall meet the requirements of AASHTO M-245 and M-246.

Materials - (Aluminum Coated Steel Pipe) - This pipe and its appurtenances shall conform to the requirements of AASHTO Specification M-274 with watertight coupling bands or flanges. Any aluminum coating damaged or otherwise removed shall be replaced with cold applied bituminous coating compound.

Materials - (Aluminum Pipe) - This pipe and appurtenances shall conform to the requirements of AASHTO Specifications M-198 or M-211 with watertight coupling bands or flanges. Aluminum surfaces that are to be in contact with concrete shall be painted with one coat of zinc chromate primer. Hot dip galvanized bolts may be used for connections. The pH of the surrounding soils shall be between 4 and 9.

2. Coupling bands, anti-seep collars, and sections, etc., must be composed of the same material as the pipe. Metals must be insulated from dissimilar materials with use of rubber or plastic insulating materials at least 24 mils in thickness.

3. Connections - All connections with pipes must be completely watertight. The drain or barrel connection to the riser shall be welded all around when the pipe and riser are metal. Anti-seep collars shall be connected to the pipe in such a manner as to be completely watertight. Dimple bands are not considered to be watertight.

All connections shall use a rubber or neoprene gasket when joining pipe sections. The end of each pipe shall be fitted an adequate number of corrugations to accommodate the band width. The following pipe connections are acceptable for pipes less than 24" in diameter: flanges on both ends of the pipe, a 12 inch wide standard lap type band with 12" wide by 3/8" thick closed cell circular neoprene gasket, and a 12 inch wide hugger type band with O-ring gaskets having a minimum diameter of 1/2 inch greater than the corrugated depth. Pipes 24" in diameter and larger shall be connected by a 24" long angular corrugated band using rods and nuts. A 12" wide by 3/8" thick closed cell circular neoprene gasket will be installed on the end of each pipe for a total of 24".

Helically corrugated pipe shall have either continuously welded seams or have lock seams with internal caulking or a neoprene bead.

4. Bedding - The pipe shall be firmly and uniformly bedded throughout its entire length. Where rock or soft, spongy or other unstable soil is encountered, all such material shall be removed and replaced with suitable earth compacted to provide adequate support.

5. Backfilling shall conform to "Structure Backfill."

6. Other details (anti-seep collars, valves, etc.) shall be as shown on the drawings.

REINFORCED CONCRETE PIPE - All of the following criteria shall apply for reinforced concrete pipe:

1. Materials - Reinforced concrete pipe shall have bell and spigot joints with rubber gaskets and shall equal or exceed ASTM Designation C-361.

2. Bedding - All reinforced concrete pipe conduits shall be laid in a concrete bedding for their entire length. This bedding shall consist of high slump concrete placed under the pipe and up the sides of the pipe at least 10" of its outside diameter with a minimum thickness of 3 inches, or as shown on the drawings.

3. Laying pipe - Bell and spigot pipe shall be placed with the bell and upstream. Joints shall be made in accordance with recommendations of the manufacturer of the material. After the joints are sealed for the entire line, the bedding shall be placed so that all spaces under the pipe are filled. Care shall be exercised to prevent any deviation from the original line and grade of the pipe. The first joint must be located within 2 feet from the riser.

4. Backfilling shall conform to "Structure Backfill."

5. Other details (anti-seep collars, valves, etc.) shall be as shown on the drawings.

POLYVINYL CHLORIDE (PVC) PIPE - All of the following criteria shall apply for polyvinyl chloride (PVC) pipe:

1. Materials - PVC pipe shall be PVC-1120 or PVC-1220 conforming to ASTM D-1785 or ASTM D-2241.

2. Joints and connections to anti-seep collars shall be completely watertight.

3. Bedding - The pipe shall be firmly and uniformly bedded throughout its entire length. Where rock or soft, spongy or other unstable soil is encountered, all such material shall be removed and replaced with suitable earth compacted to provide adequate support.

4. Backfilling shall conform to "Structure Backfill."

5. Other details (anti-seep collars, valves, etc.) shall be as shown on the drawings.

CONCRETE

Concrete shall meet the requirements of Maryland Department of Transportation, State Highway Administration Standard Specifications for Construction and Materials, Section 608, Mix No. 3.

ROCK RIPRAP

Rock riprap shall meet the requirements of Maryland Department of Transportation, State Highway Administration Standard Specifications for Construction and Materials, Section 905.

The riprap shall be placed to the required thickness in one operation. The rock shall be delivered and placed in a manner that will insure the riprap in place shall be reasonably homogeneous with the larger rocks uniformly distributed and firmly in contact one to another with the smaller rocks filling the voids between the larger rocks. Filter cloth shall be placed under all riprap and shall meet the requirements of Maryland Department of Transportation, State Highway Administration Standard Specifications for Construction and Materials, Section 915, 12.

CARE OF WATER DURING CONSTRUCTION


All work on permanent structures shall be carried out in areas free from water. The Contractor shall construct and maintain all temporary dikes, levees, cofferdams, drainage channels, and stream diversions necessary to protect the areas to be occupied by the permanent works. The contractor shall also furnish, install, operate and maintain all necessary pumping and other equipment required for removal of water from the various parts of the work and for maintaining the excavations, foundations, and other parts of the work free from water as required or directed by the engineer for constructing each part of the work. After having served their purpose, all temporary protective works shall be removed or leveled and graded to the extent required to prevent obstruction in any degree whatsoever of the flow of water to the spillway or outlet works and so as not to interfere in any way with the operation or maintenance of the structure. Stream diversions shall be maintained until the full flow can be passed through the permanent works. The removal of water from the required excavation and the foundation shall be accomplished in a manner and to the extent that will maintain stability of the excavation and bottom required excavations and will allow satisfactory performance of all construction operations. During the placing and compacting of material in required excavations the water level at the locations being refilled shall be maintained below the bottom of the excavation at such locations which may require draining the water to surfs from which the water shall be pumped.

STABILIZATION











All borrow areas shall be graded to provide proper drainage and left in a slightly condition. All exposed surfaces of the embankment, spillway, spoil and borrow areas, and berms shall be stabilized by seeding, liming, fertilizing and mulching in accordance with the Maryland Soil Conservation Service Standards and Specifications for Critical Area Planting (MS-312) or as shown on the accompanying drawings.

EROSION AND SEDIMENT CONTROL

Construction operations will be carried out in such a manner that erosion will be controlled and water and air pollution minimized. State and local laws concerning pollution abatement will be followed. Construction plans shall detail erosion and sediment control measures to be employed during the construction process.

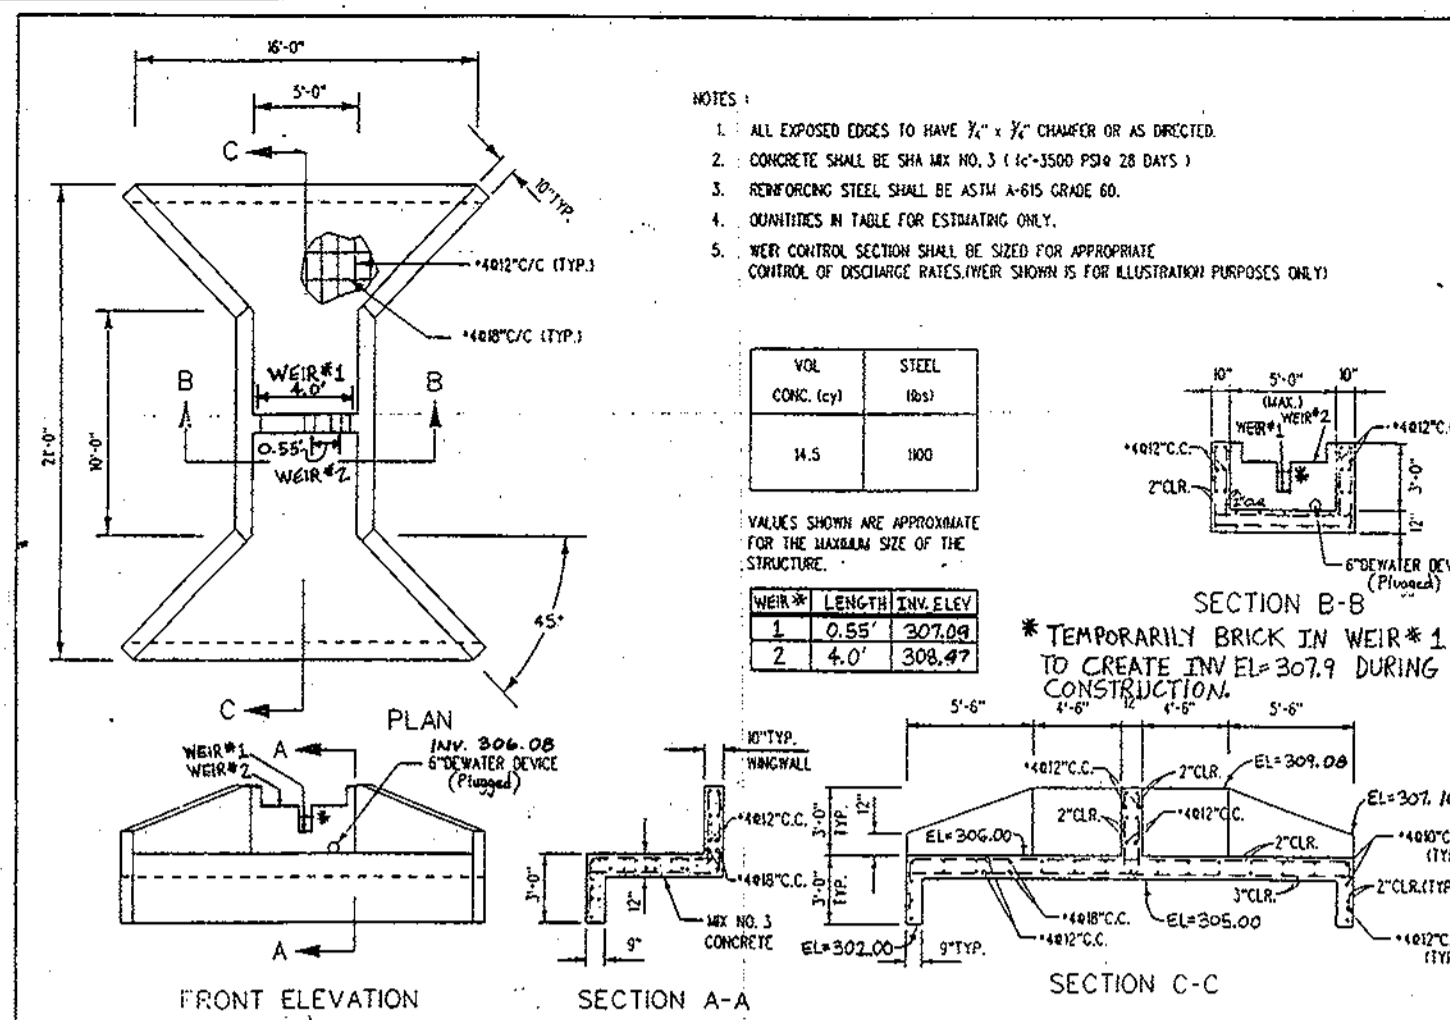

NO.	DESCRIPTION	QUANTITY	UNIT
1	1 1/2" BIT. CONC. SURFACE	100	SQ. YD.
2	3" BIT. CONC. BASE	100	SQ. YD.
3	1 1/2" BIT. CONC. SURFACE	100	SQ. YD.
4	3" BIT. CONC. BASE	100	SQ. YD.
5	1 1/2" BIT. CONC. SURFACE	100	SQ. YD.
6	3" BIT. CONC. BASE	100	SQ. YD.

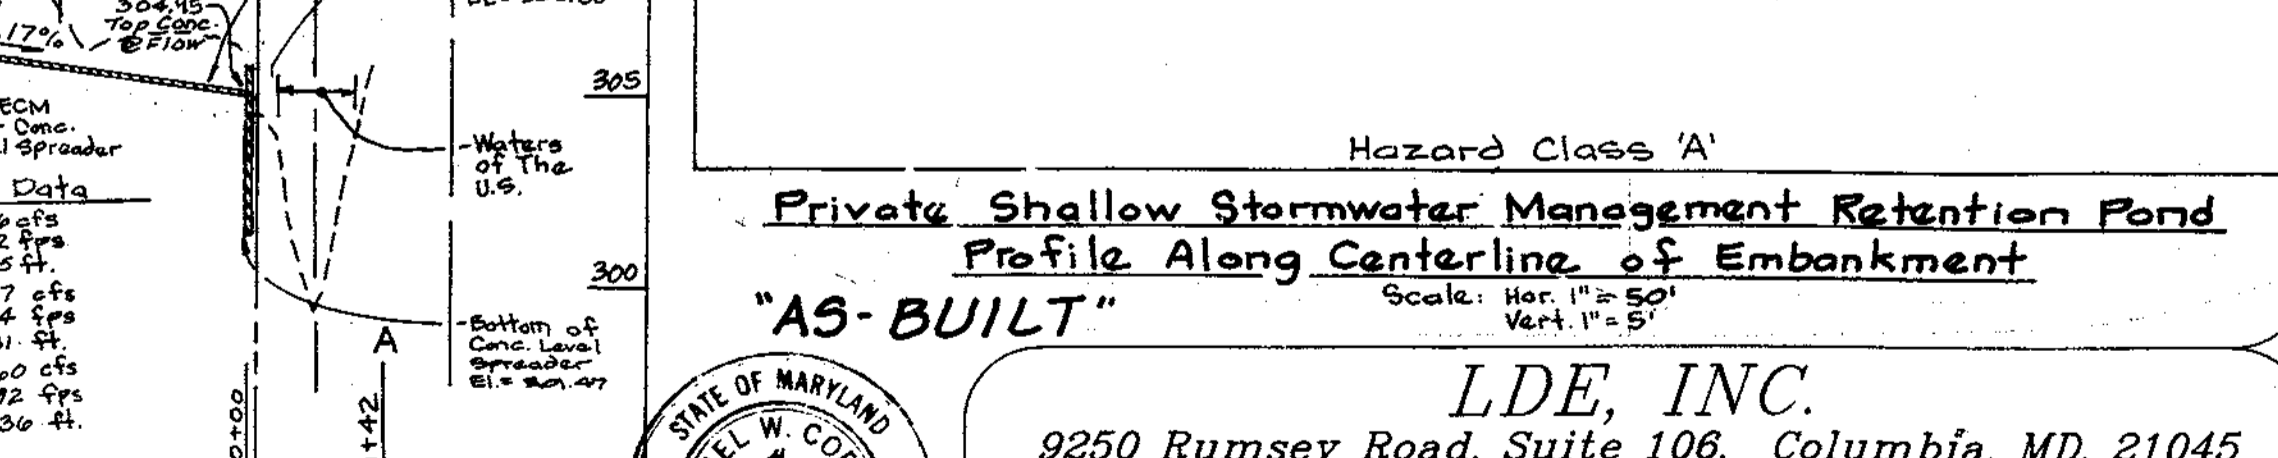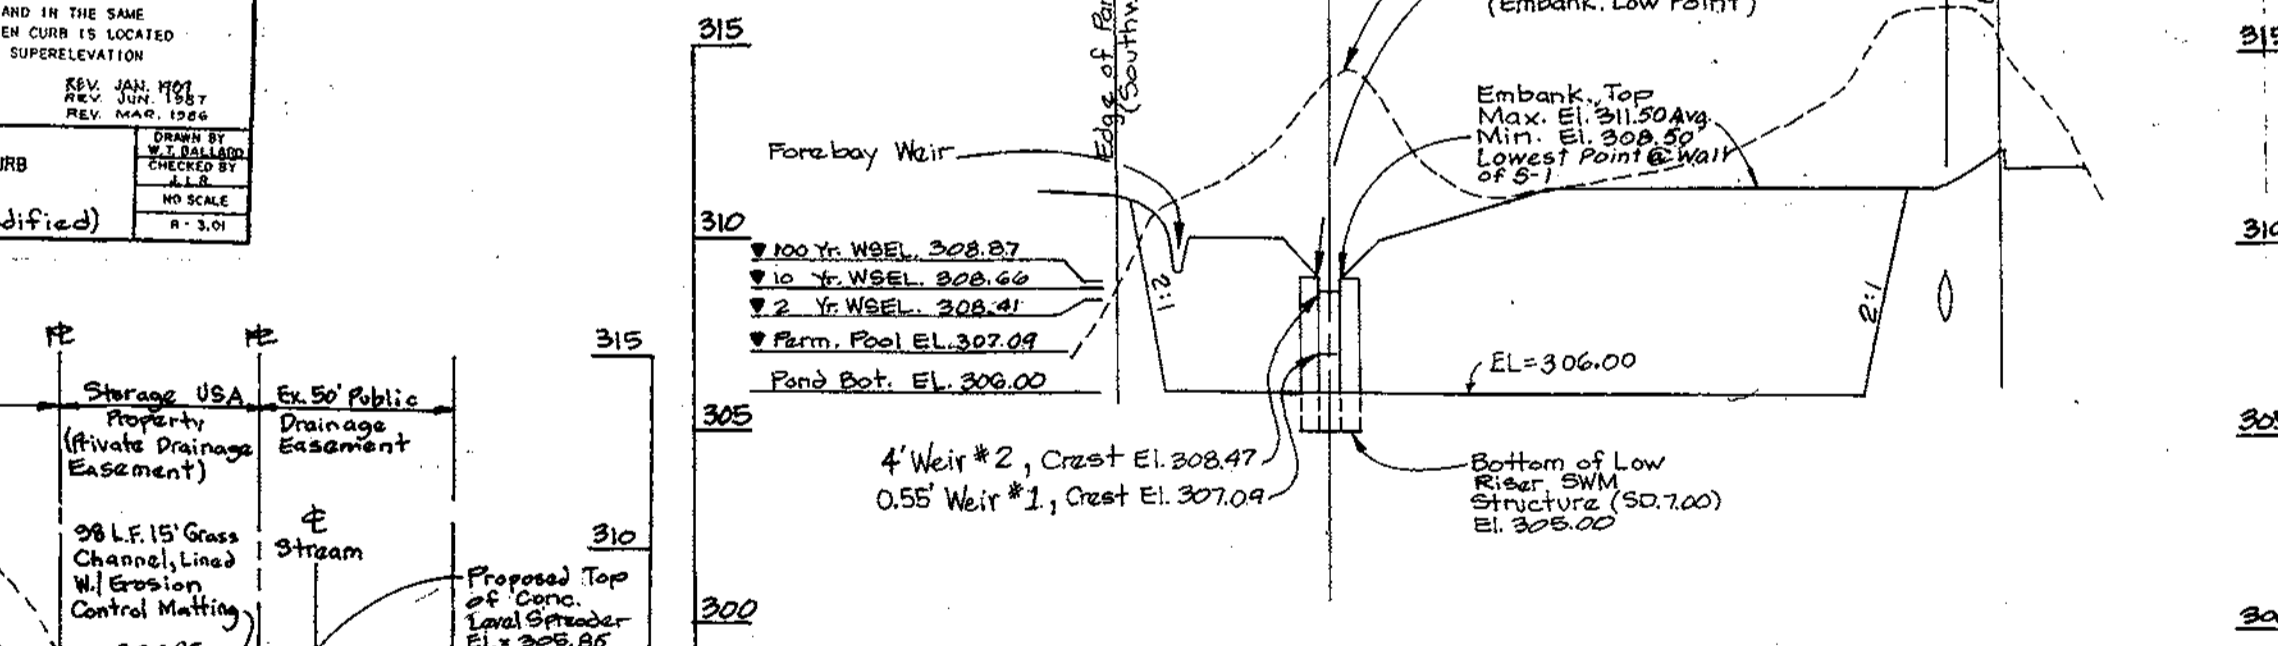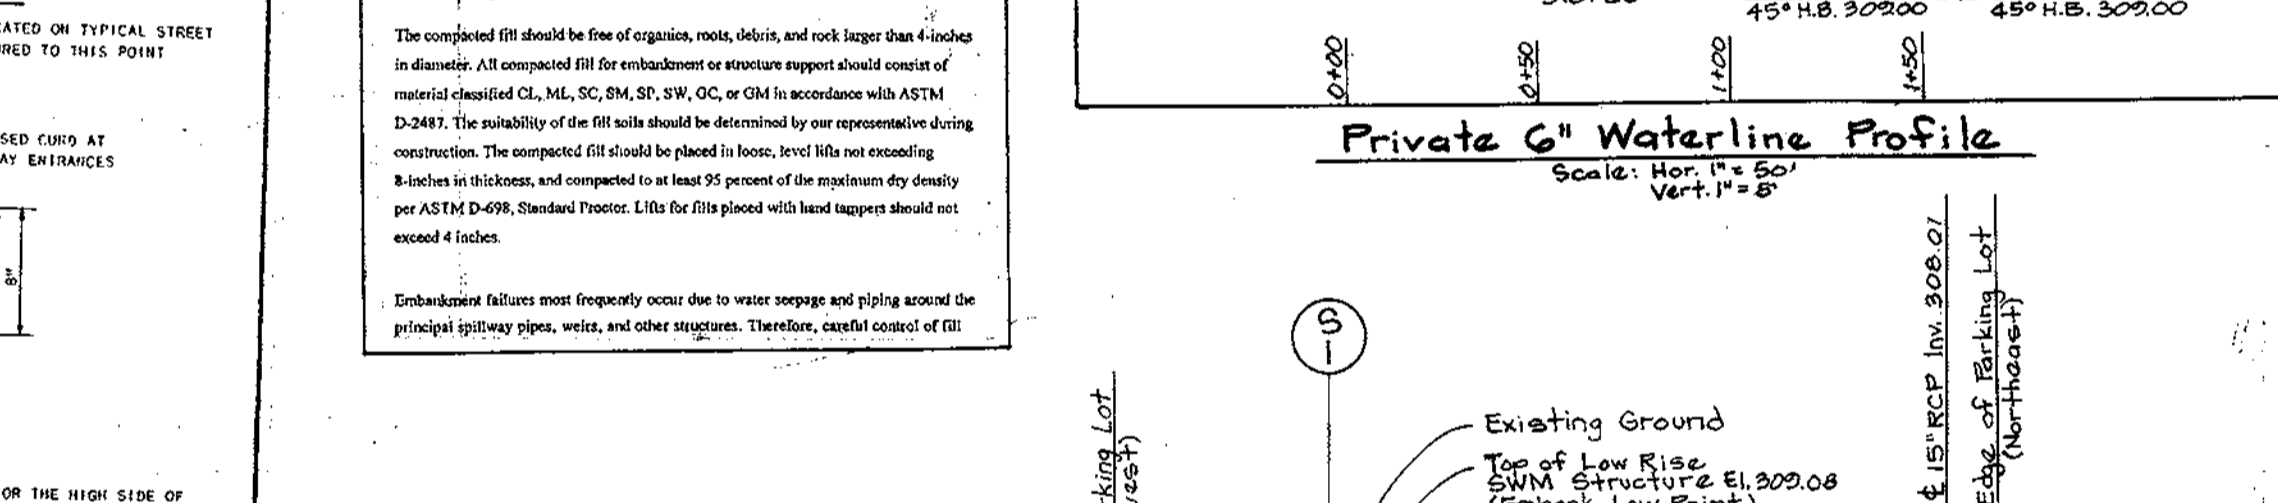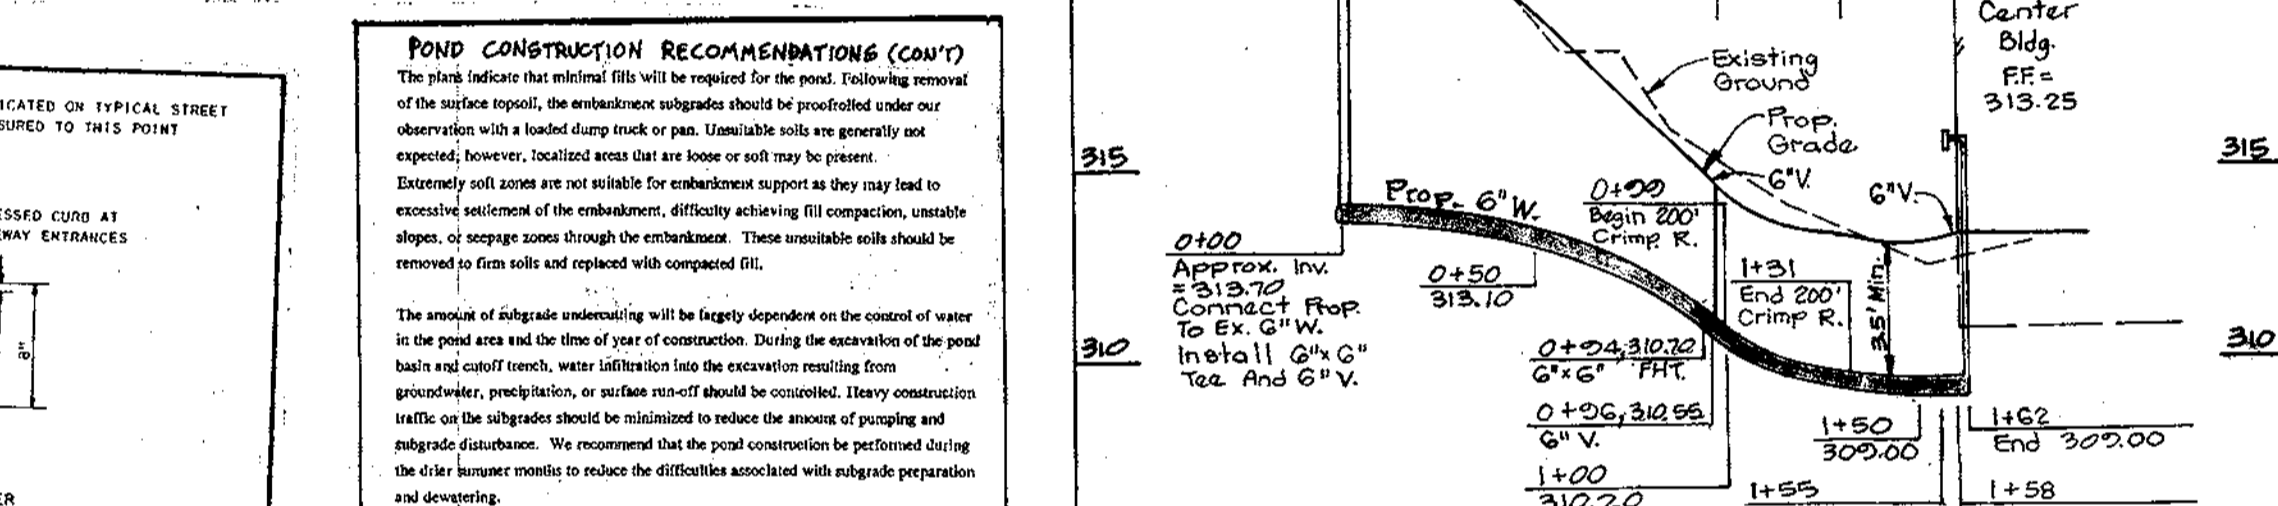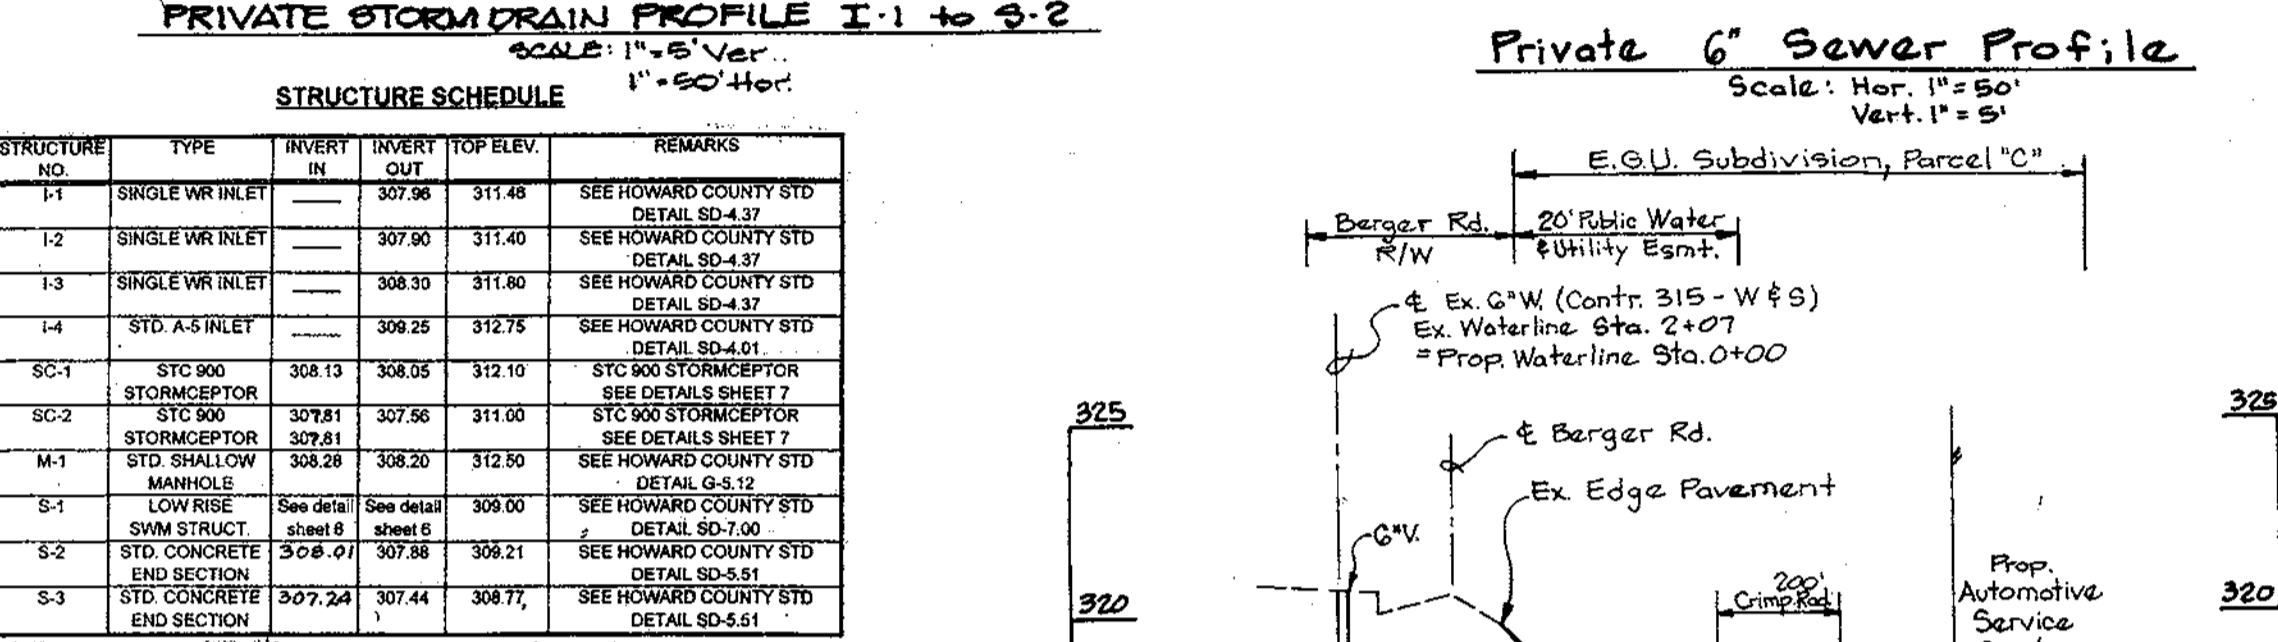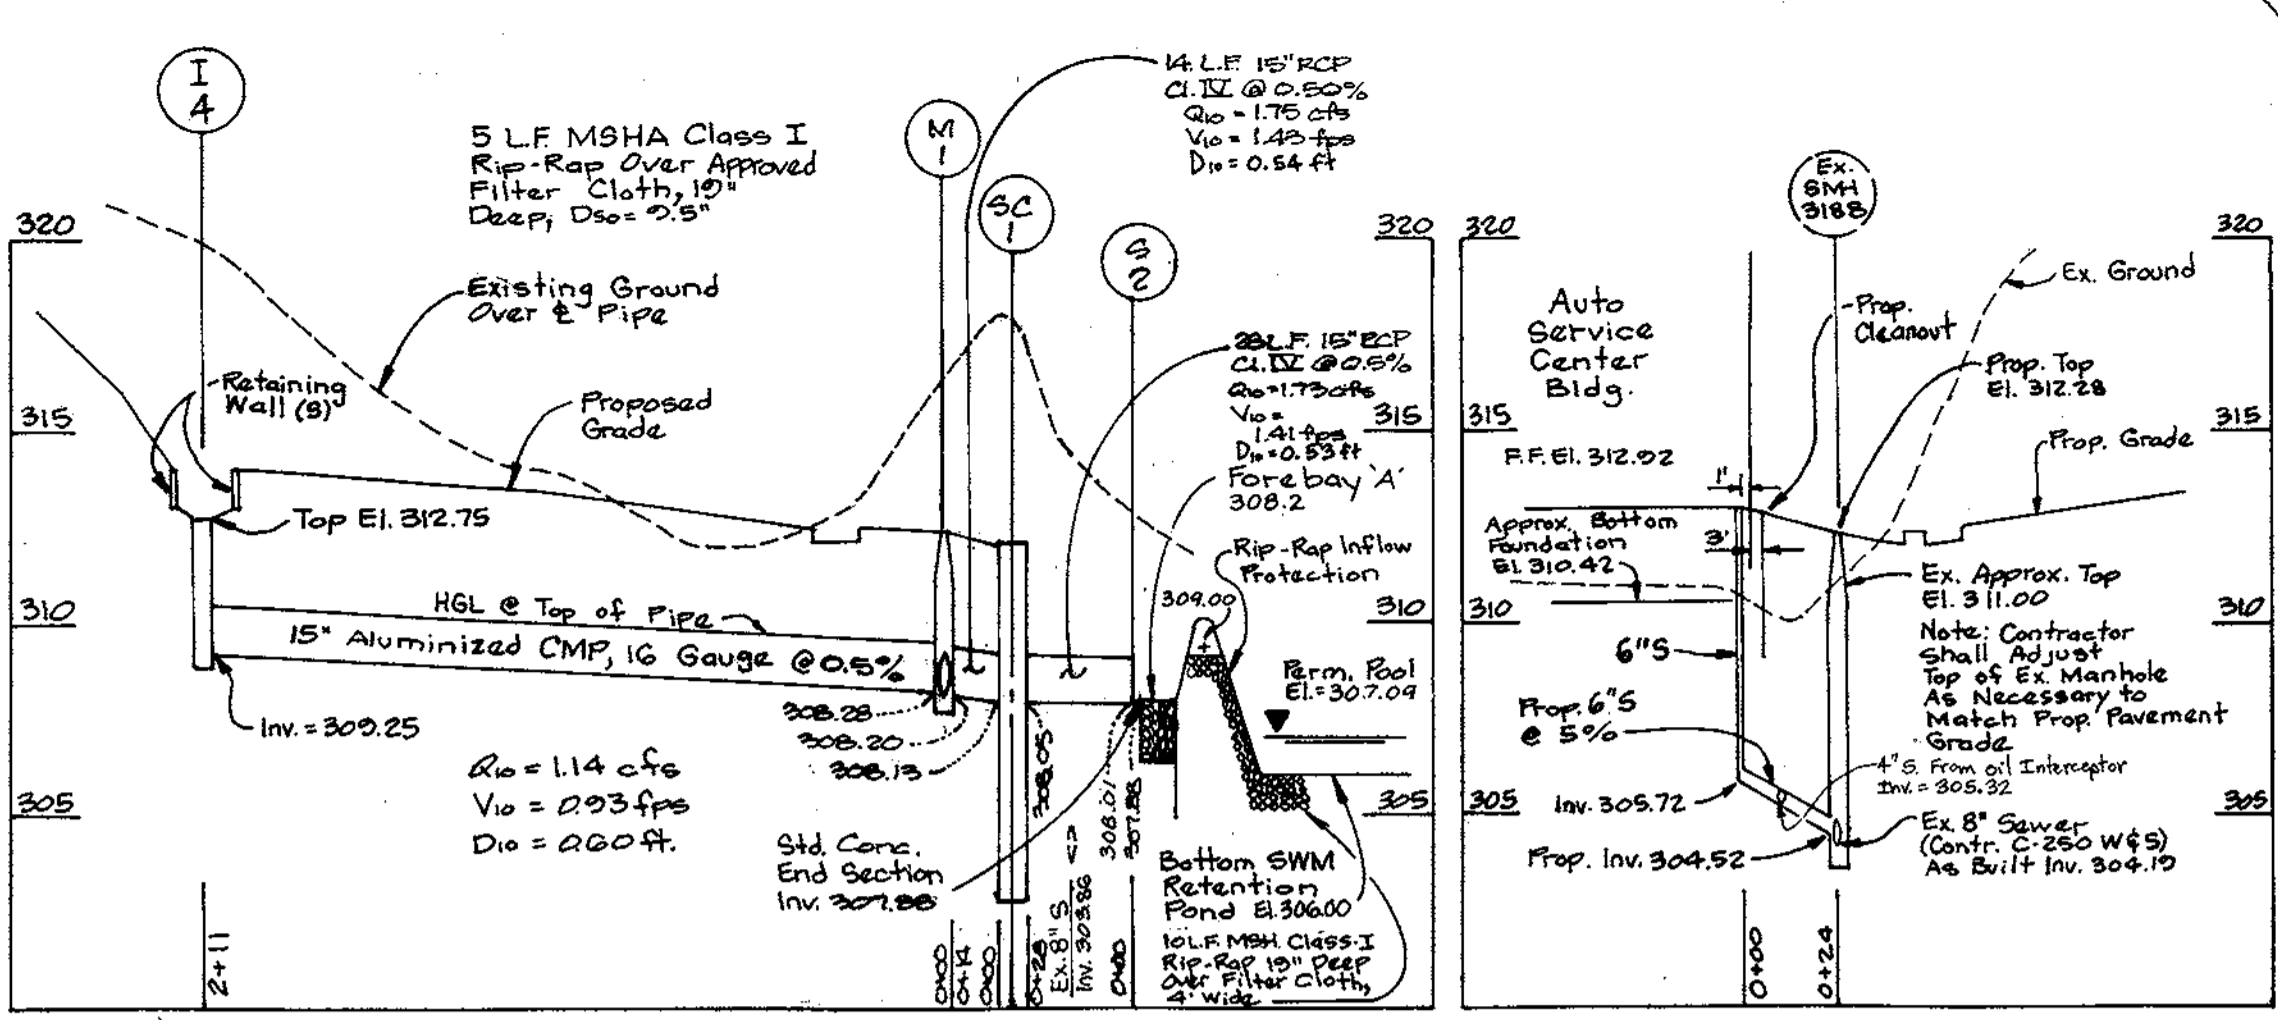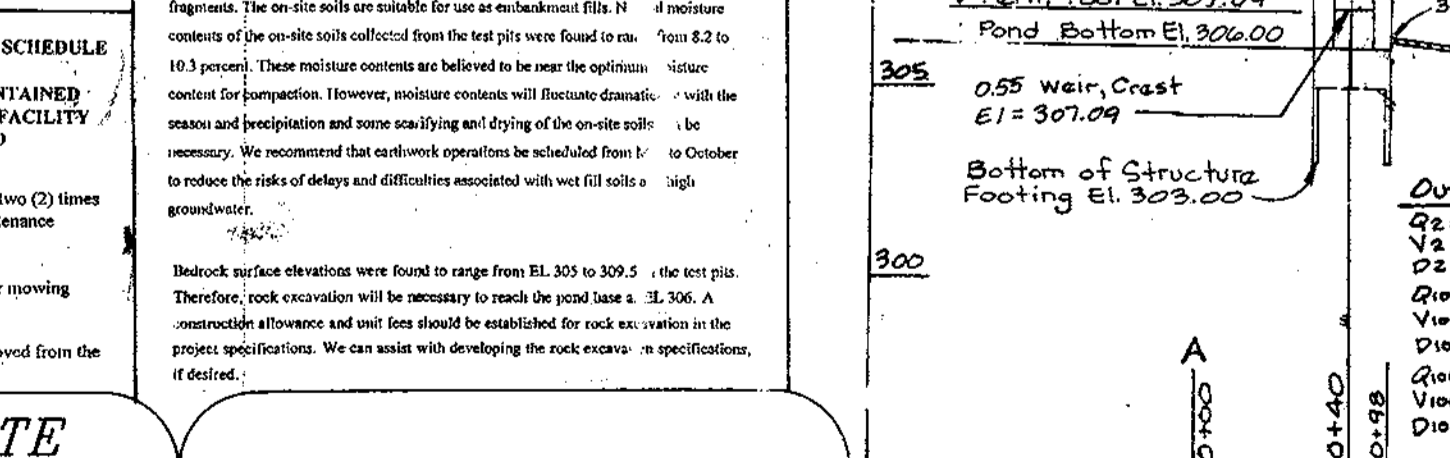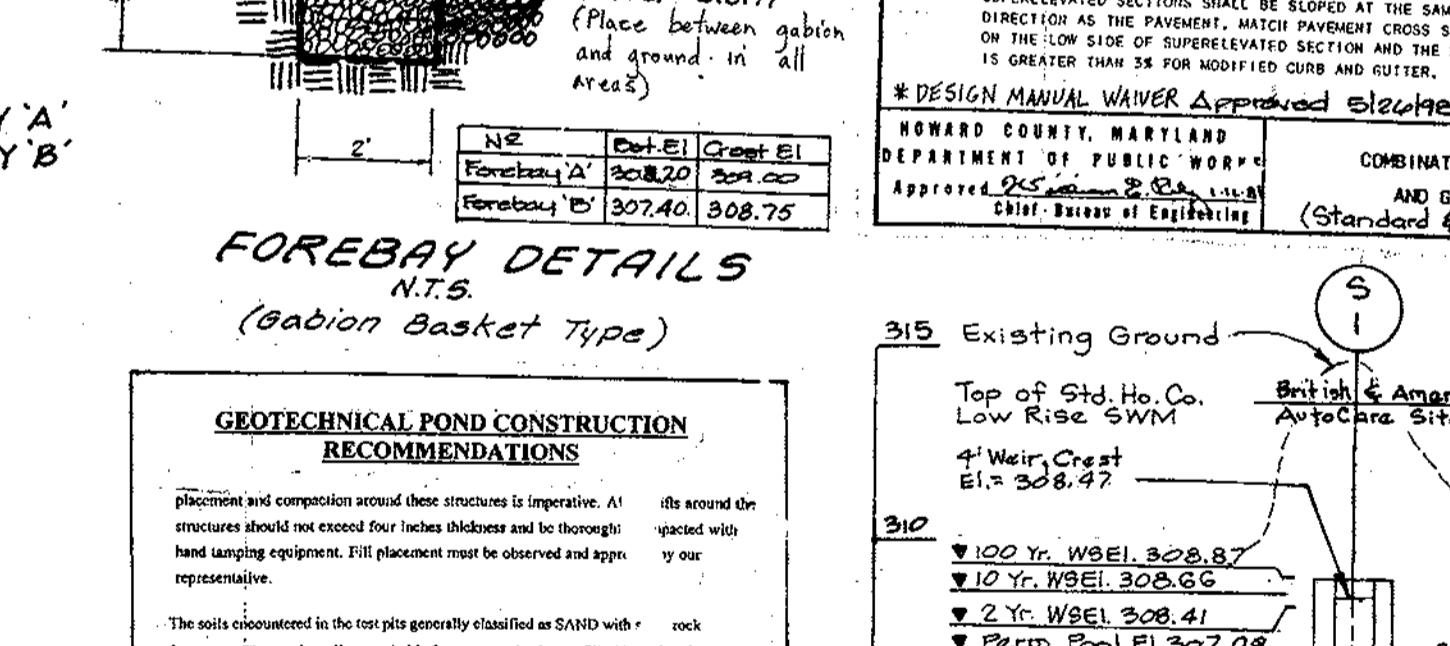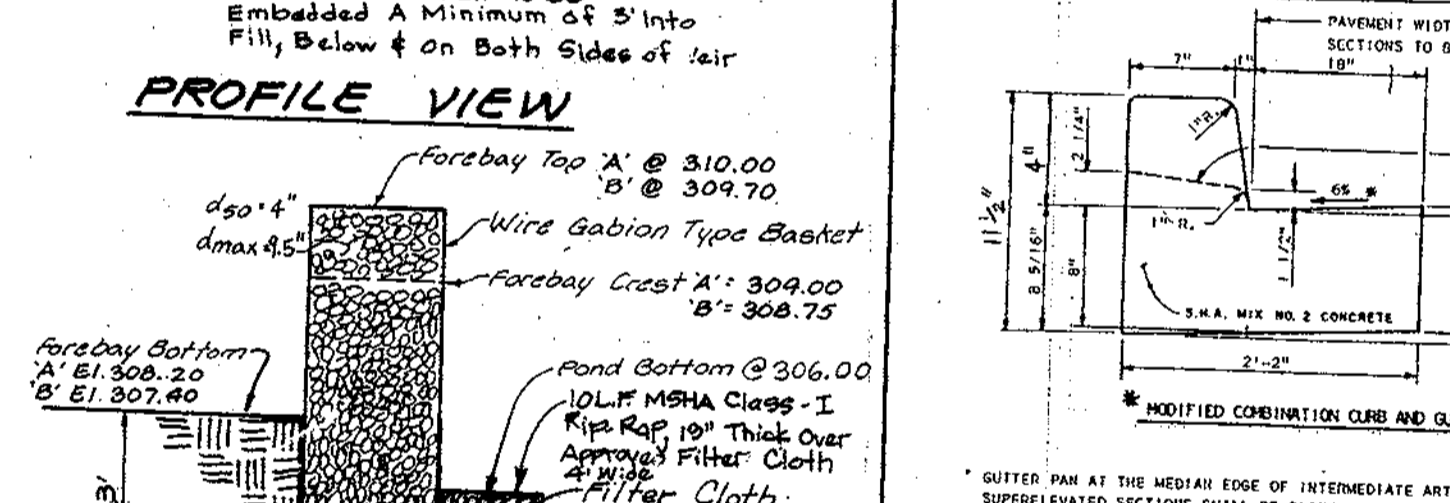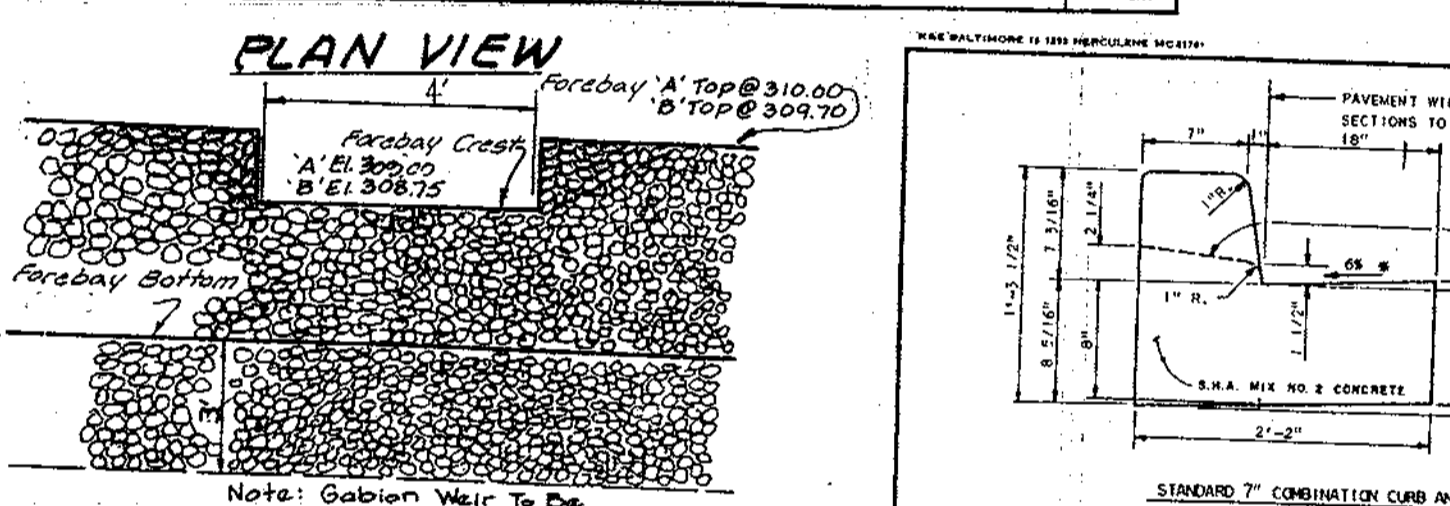

APPROVED: DEPARTMENT OF PLANNING AND ZONING

THESE PLANS HAVE BEEN REVIEWED FOR THE HOWARD SOIL CONSERVATION DISTRICT AND MEET THE TECHNICAL REQUIREMENTS.

3/1/99

3/3/99

3/1/99

3/3/99

3/1/99

3/3/99

ENGINEER'S CERTIFICATE

I HEREBY CERTIFY THAT THESE PLANS AND SPECIFICATIONS FOR EROSION AND SEDIMENT CONTROL REPRESENTS A PRACTICAL AND FEASIBLE PLAN BASED ON MY PERSONAL KNOWLEDGE AND THE INFORMATION PROVIDED TO ME BY THE CLIENT AND THE HOWARD SOIL CONSERVATION DISTRICT.

3/2/99

DEVELOPER'S CERTIFICATE

I HEREBY CERTIFY THAT ALL DEVELOPMENT AND/OR CONSTRUCTION WILL BE DONE ACCORDING TO THESE PLANS AND THAT ANY RESPONSIBLE PERSONNEL INVOLVED IN THE CONSTRUCTION PROJECT WILL BE AT A CERTIFICATE OF ATTENDANCE AT A DEPARTMENT OF THE ENVIRONMENT APPROVED TRAINING PROGRAM FOR THE CONTROL OF SEDIMENTATION AND EROSION. I HAVE BEEN ADVISED BY THE HOWARD SOIL CONSERVATION DISTRICT THAT THESE PLANS AND SPECIFICATIONS ARE DEEMED NECESSARY.

2/23/99

Private Shallow Stormwater Management Retention Pond - Section A-A - Profile

Through Centerline of Principal Spillway

Scale: Hor. 1" = 50' Vert. 1" = 5'

APPROVED: PLANNING BOARD OF HOWARD COUNTY

DATE: 1/27/99

Private Shallow Stormwater Management Retention Pond - Section A-A - Profile

Through Centerline of Principal Spillway

Scale: Hor. 1" = 50' Vert. 1" = 5'

DESIGNED: S.D.H.

DRAWN: S.M.C.

CHECKED: B.D.B.

DATE: 1/27/99

Stormwater Management, Storm Drain, Water & Sewer Construction Notes And Details

British And American Auto Care, Inc.

Columbia

E.G.U. Subdivision Parcel "C"

Tax Map 42, P/O Parcel 386, Grid 9

8th Election District

Howard County, Maryland

SCALE: AS SHOWN

DRAWING: 6 of 9

JOB NO.: 98-010

FILE NO.: SDP-98-132

4.0 Installation Procedures

The installation of the concrete Stormceptor should conform in general to state highway or local specifications for the construction of manholes. Selected sections of a general specification that are applicable are summarized in the following sections:

Excavation

Excavation for the installation of the Stormceptor should conform to state highway or local specifications. Topsoil that is removed during the excavation for the Stormceptor should be stockpiled in designated areas and should not be mixed with subsoil or other materials. Topsoil stockpiles, and the general site preparation for the installation of the Stormceptor should conform to state highway or local specifications.

The Stormceptor should not be installed on frozen ground. Excavation should extend a minimum of 12 inches from the precast concrete surfaces plus an allowance for shoring and bracing where required. If the bottom of the excavation provides an unsuitable foundation additional excavation may be required.

In areas with a high water table, continuous dewatering should be provided to ensure that the excavation is stable and free of water.

Leveling

A 6 to 12 inch layer of granular material (conforming to local or state highway backfill specifications) should be installed, compacted, and leveled at the bottom of the excavation to the proper elevation for the installation of the interceptor base.

Backfilling

Backfill material should conform to state highway or local specifications. Generally, backfill material should be installed, compacted, and leveled at the bottom of the excavation to the proper elevation for the installation of the interceptor base. Backfill is not to contain topsoil.

Stormceptor Construction Sequence

The concrete Stormceptor is installed in sections in the following sequence:

- 1. aggregate base
2. base slab
3. treatment chamber section(s)
4. transition slab (if required)
5. by-pass section with insert
6. connect inlet and outlet pipes
7. riser section and/or transition slab (if required)
8. maintenance riser section(s) (if required)
9. top slab oriented with clear access to vent and 24" opening
10. frame and access cover

The precast base should be placed level at the specified grade. The entire base should be in contact with the underlying compacted granular material. Subsequent sections, complete with joint seals, should be installed in accordance with the precast concrete manufacturer's recommendations.

Adjustment of the Stormceptor can be performed by lifting the upper sections free of the excavated area, re-leveling the base, and re-installing the sections. Damaged sections and gaskets should be repaired or replaced as necessary. Once the Stormceptor has been constructed, the lift holes should be plugged and mortared inside and outside.

Down Pipe and Riser Pipe

Once the by-pass section has been attached to the lower treatment chamber, the inlet down pipe, and outlet riser pipe can be attached. To install the inlet down pipe a woker enters the lower treatment chamber through the outlet riser pipe opening (24 inch diameter) in the by-pass section.

The inlet drop pipe is installed by coating the outside of the pipe with glee and pushing the pipe into the coupling. Chemres 948 caulking should be applied to the connection once the inlet drop pipe is securely in place. The tee at the end of the inlet drop pipe must be oriented such that water which enters the treatment chamber is directed tangentially around the inside walls of the chamber.

The outlet riser pipe (24 inch diameter) should be installed from the top of the fiberglass disc by sliding the pipe that is provided into the existing 24" sleeve from above. The 24" diameter pipe is manufactured with a flange on the end. Chemres 948 caulking should be applied underneath the flange to act as a permanent seal before the pipe is secured in place. Pressure should be carefully applied to the top of the flange to ensure that the pipe is fully extended into the lower chamber (i.e. the top elevation of the flange is level with the surrounding fiberglass disc) and that the caulking evenly seals the pipe in place.


Inlet and Outlet Pipes

Inlet and outlet pipes should be securely set into the by-pass chamber using grom or approved pipe seals so that the structure is watertight. Flexible rubber boots are normally used and installed at the precast concrete plant prior to shipping. The flexible boots are applicable for pipes with an outside diameter up to 42 inches. The local Stormceptor affiliate should be notified if the pipe is to be grommed in the field at the time of ordering since the boots are generally included in the price quotations.





Installation of the flexible boots should follow the manufacturer's recommendations. As previously mentioned, the boots will already be attached to the Stormceptor at the manufacturer's plant.

Top Slab and Access Opening Installation
The final concrete piece to be installed is the top slab with the 30 inch access opening. Proper positioning of the top slab is extremely important to the proper operation and maintenance of the Stormceptor. The 30 inch opening must be positioned so the 6" vent pipe and the 24" discharge opening are both accessible from the surface opening (see drawing after page 25).

Frame and Cover Installation
Stormceptor provides a standard cast iron frame and cover with the name Stormceptor clearly embossed on it. Precast concrete adjustment units should be installed to set the frame and cover at the required elevation. The adjustment units should be laid in a full bed of mortar with successive units being joined using sealant recommended by the manufacturer. Frames for the cover should be set in a full bed of mortar at the elevation specified.


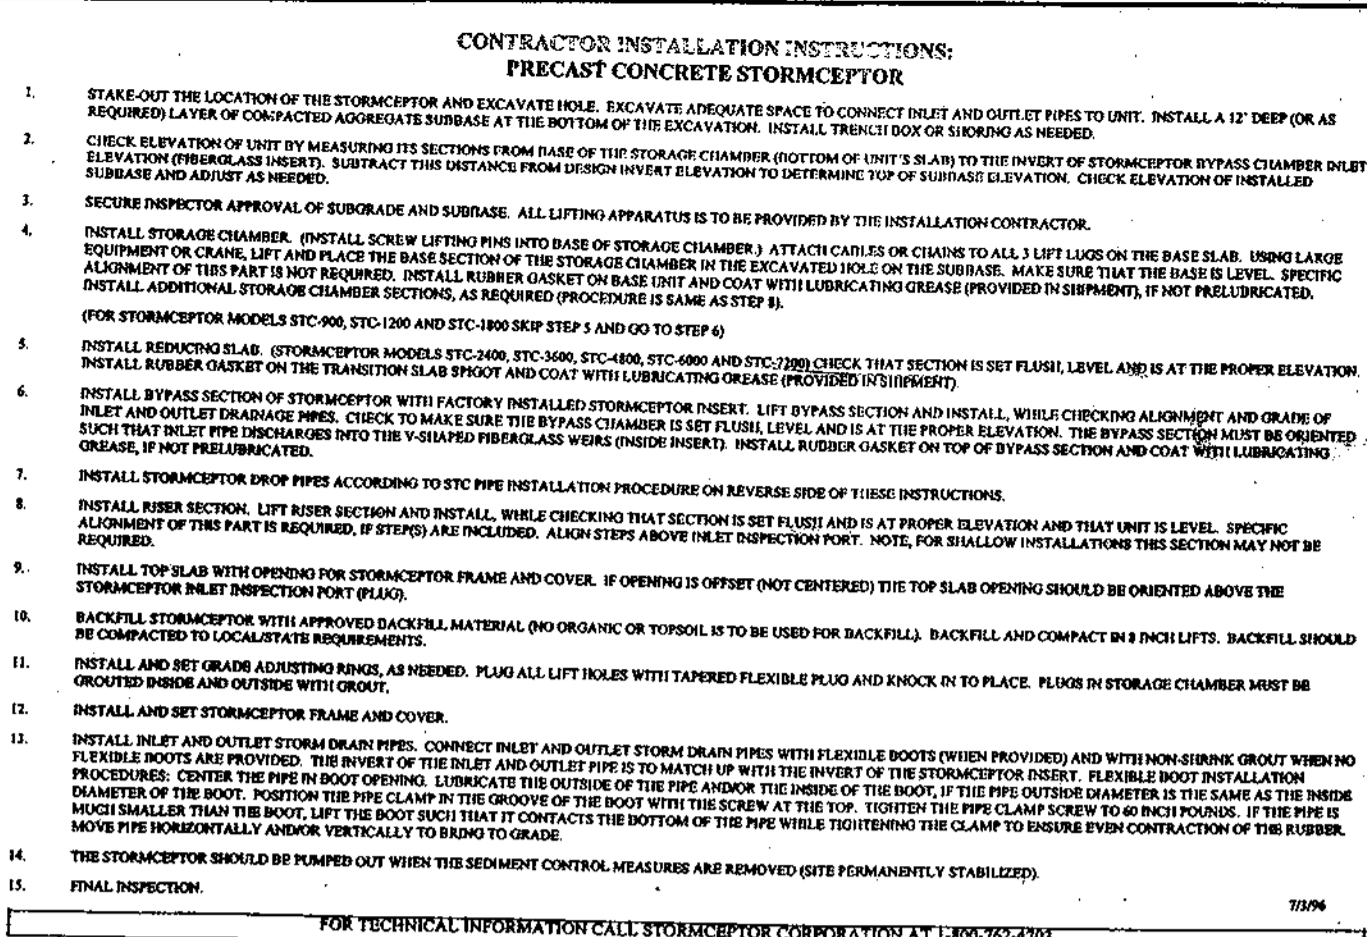


FOR TECHNICAL INFORMATION CALL STORMCEPTOR CORPORATION AT 1-800-762-4703

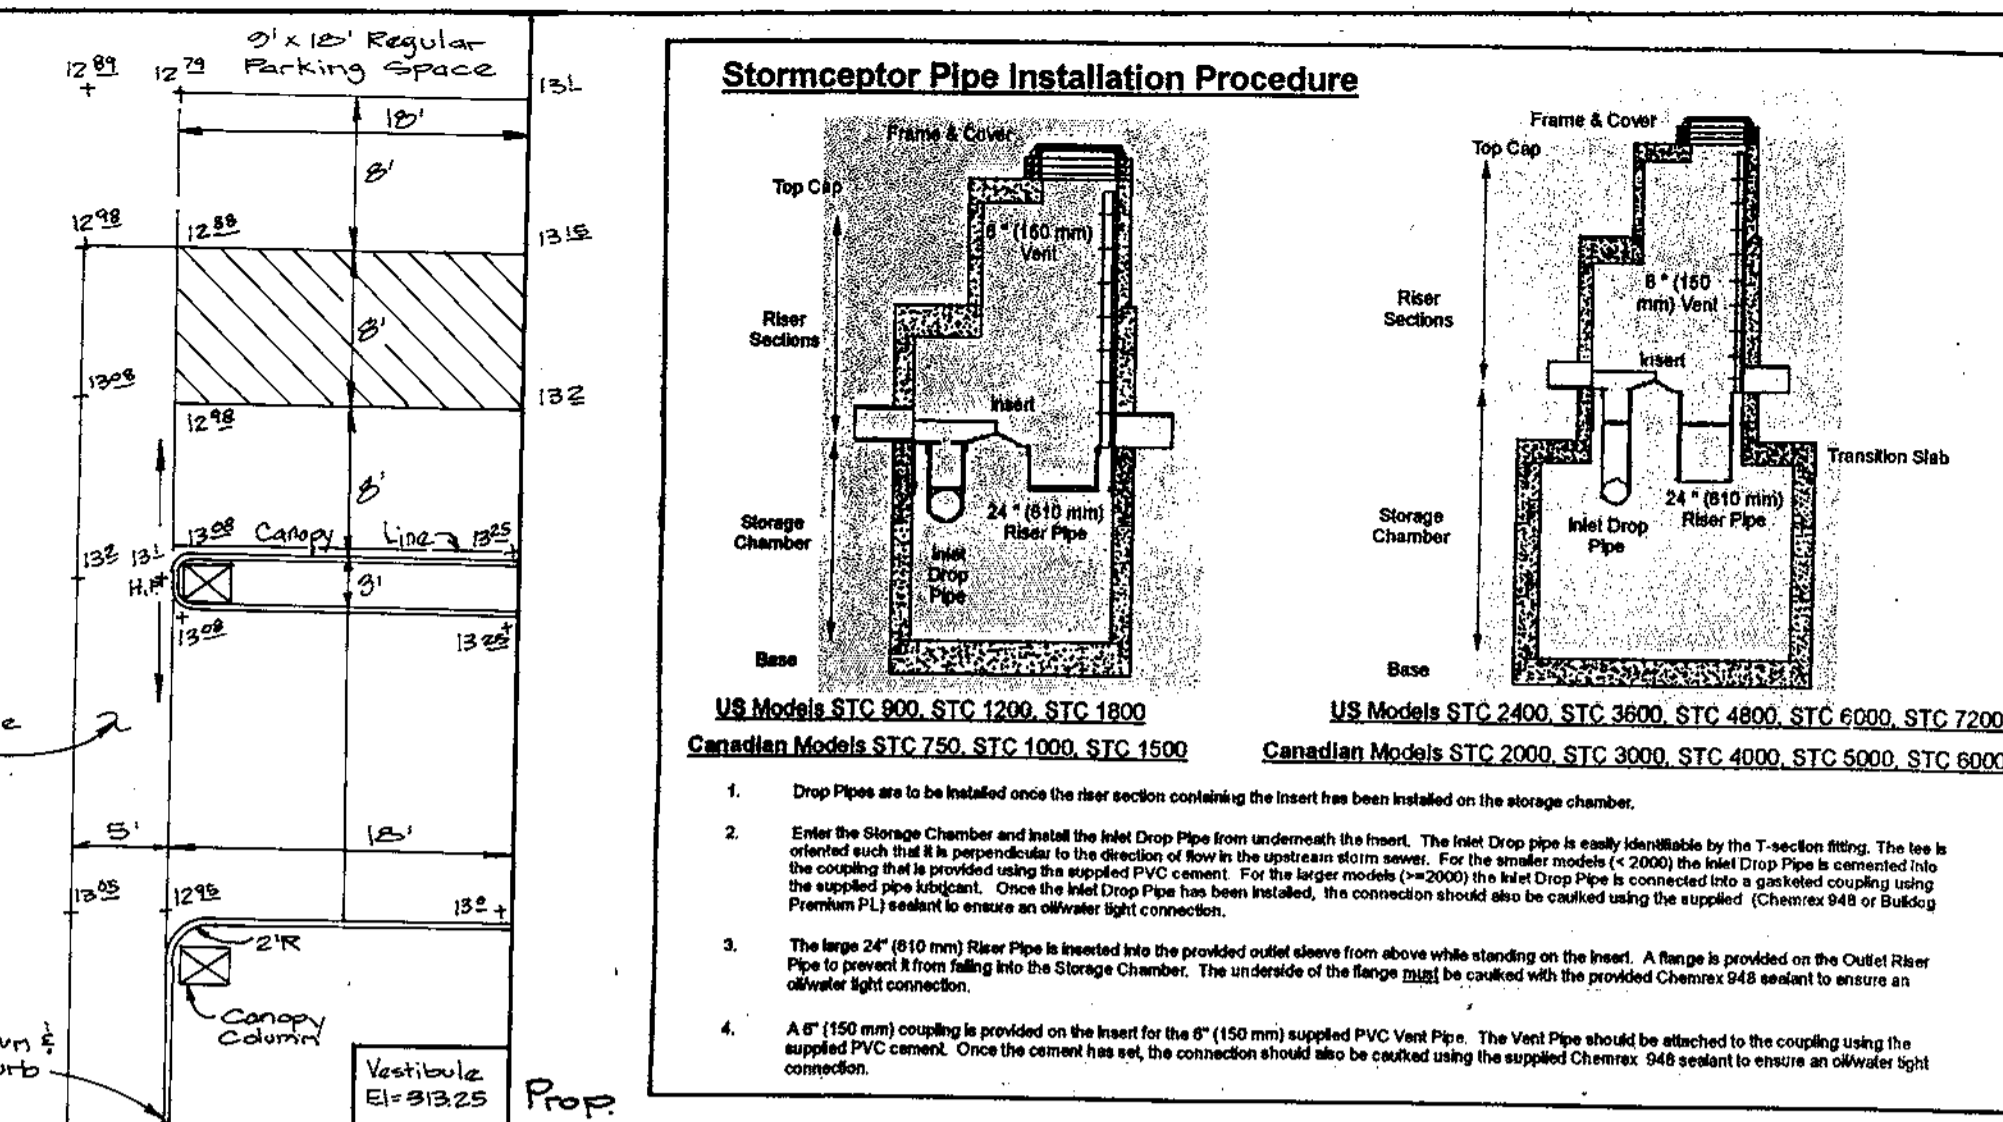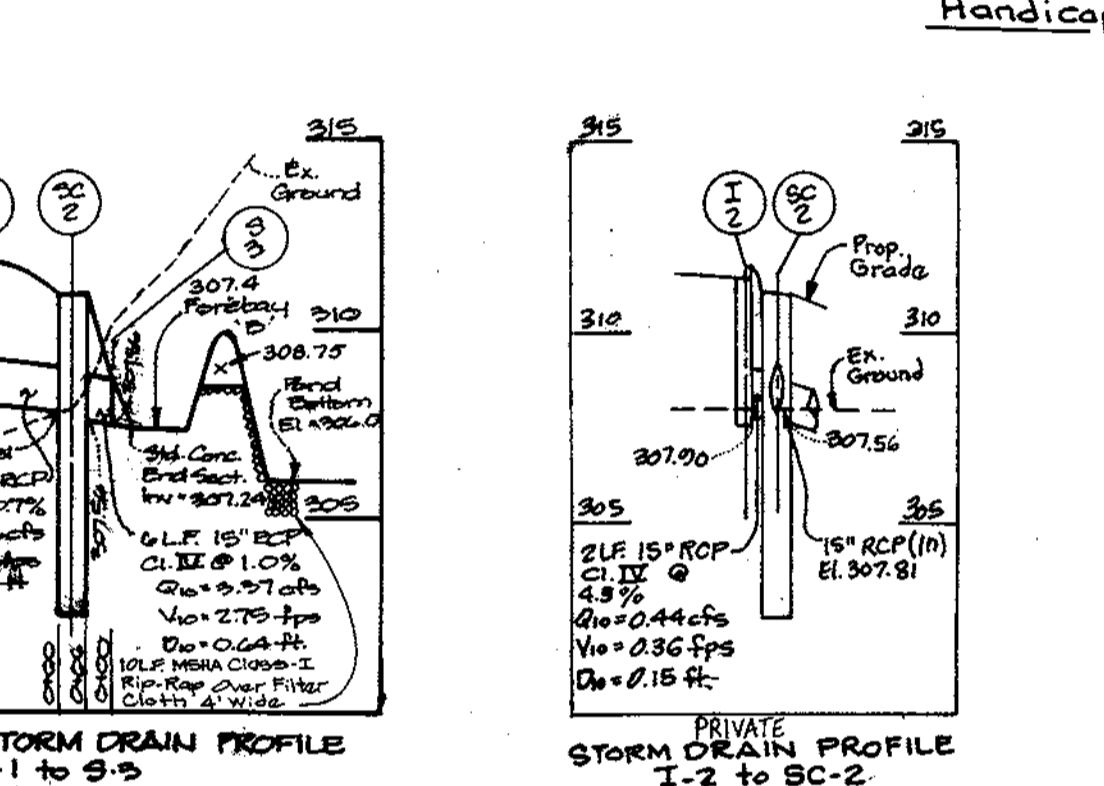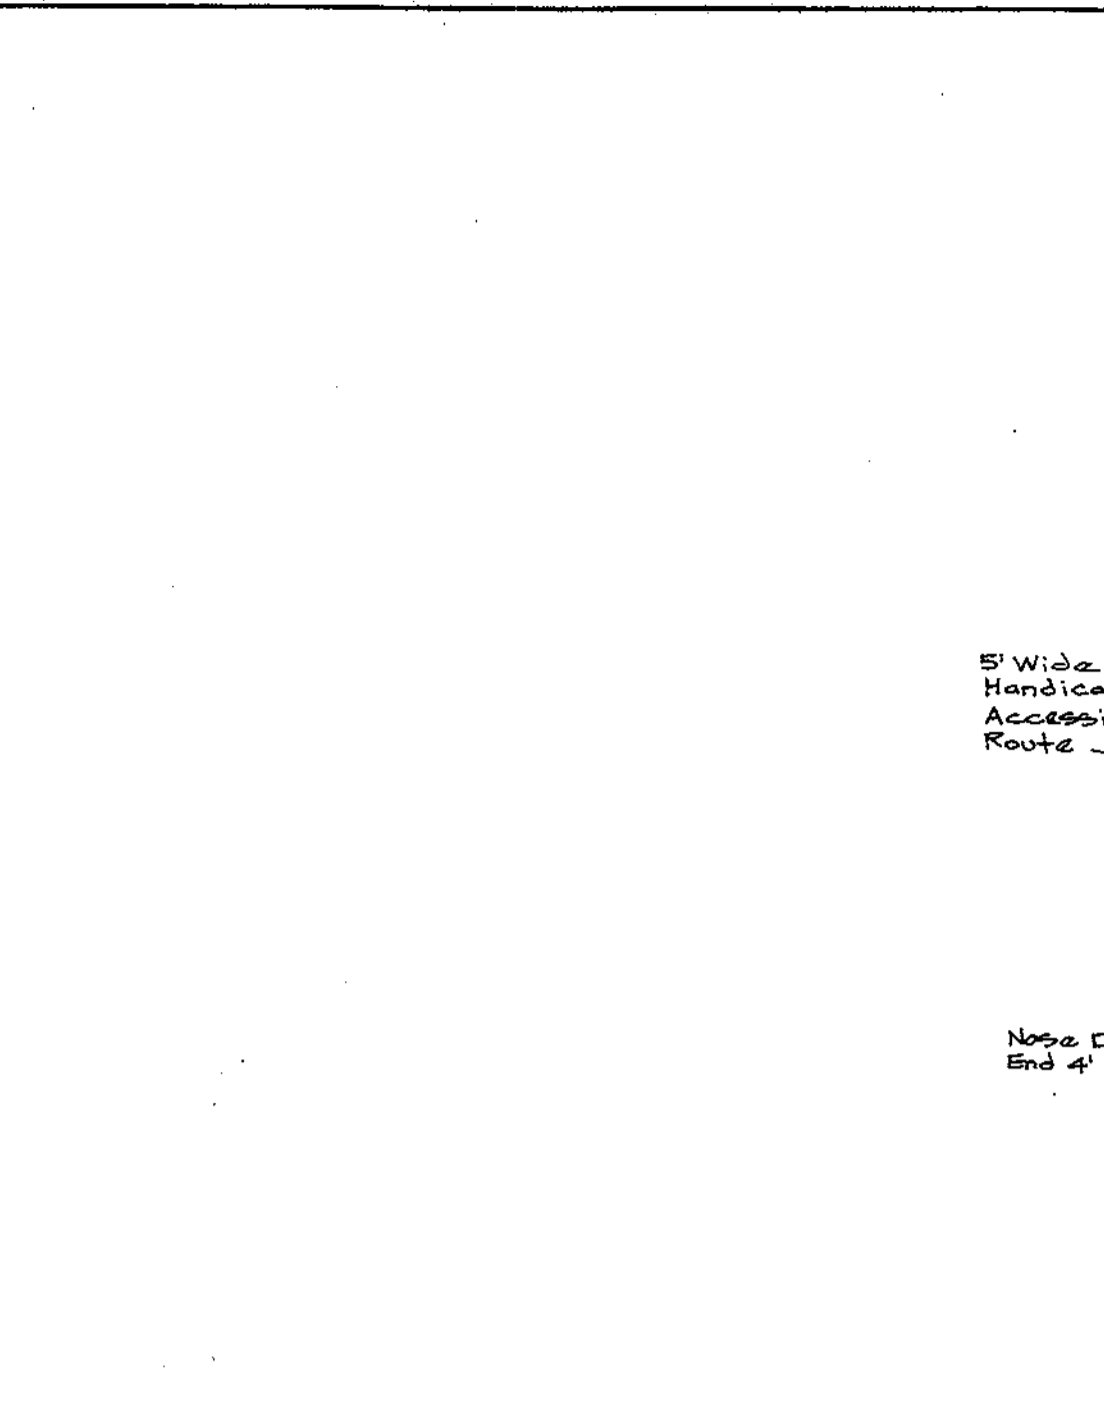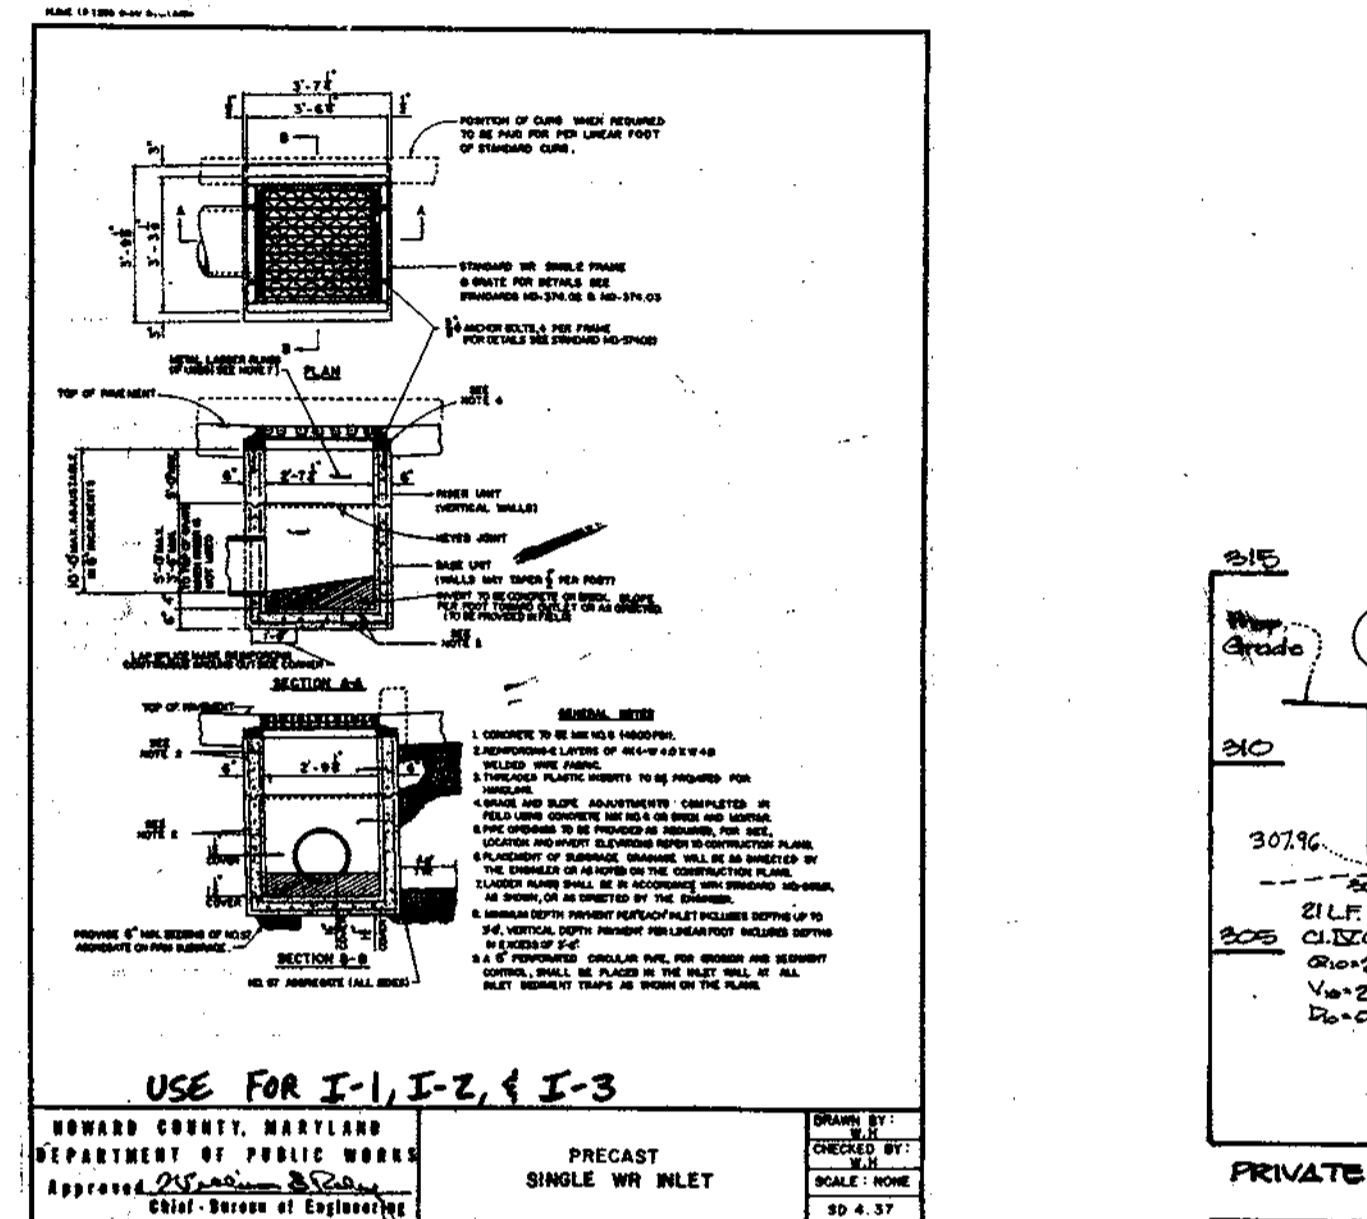


OPERATION AND MAINTENANCE SCHEDULE FOR STORMCEPTORS

- Owner's Maintenance Responsibilities:
1. Both Stormceptors shall be inspected annually for sediment and oil build up and inlet or outlet pipe obstructions.
2. When the sediment depth in the bottom of the structure exceeds 6 inches or excessive oil is observed in the structure, maintenance is required.
3. Maintenance of the structures is performed using a vacuum truck. Maintenance is required at least once annually or as indicated by visual inspection.
4. Oil shall be removed through the 6 inch vents. Sediment shall be removed through the 24 inch diameter outlet riser pipes.
5. In the event of an oil spill the Stormceptors shall be cleaned immediately by a licensed liquid waste hauler.
6. Based on visual inspection of the structures during the initial year of operation the Owner shall determine if maintenance is required more than once annually.

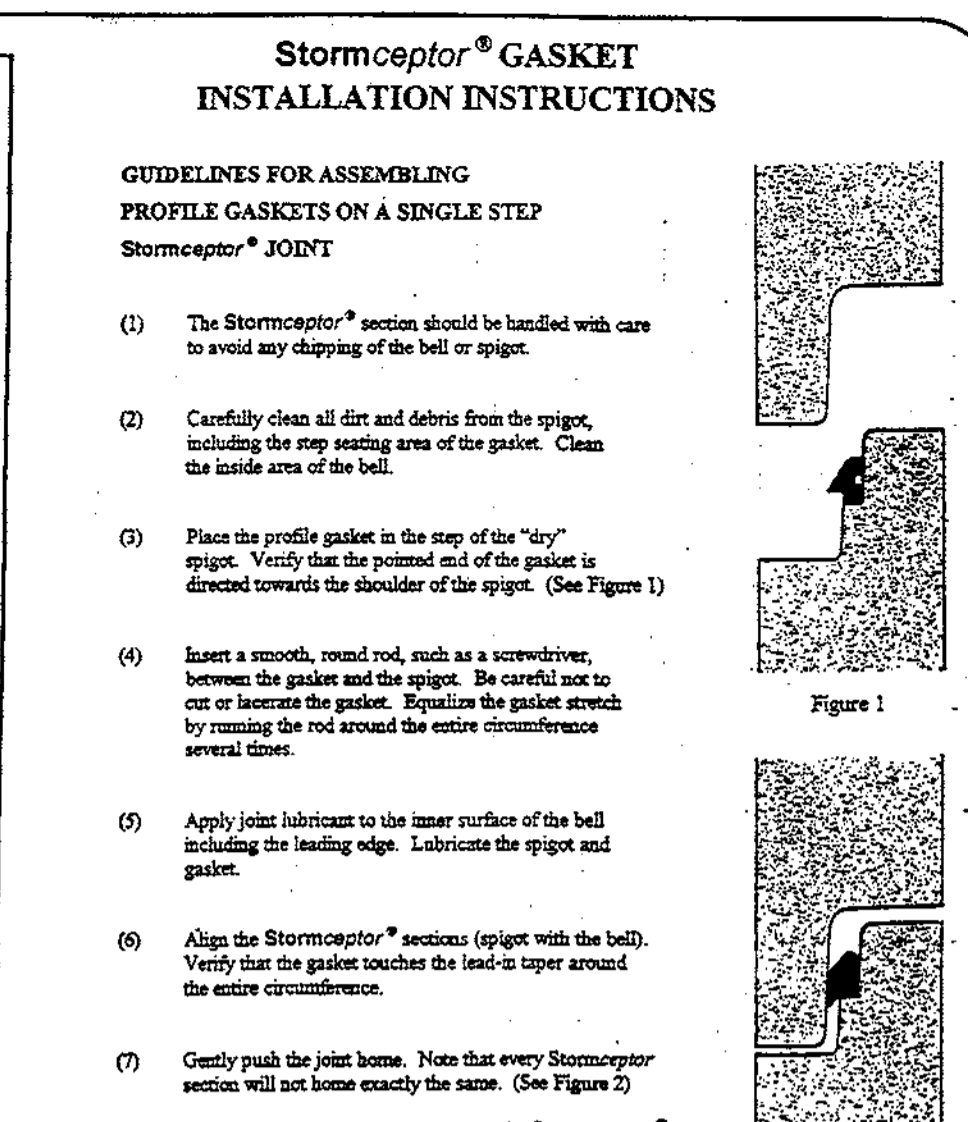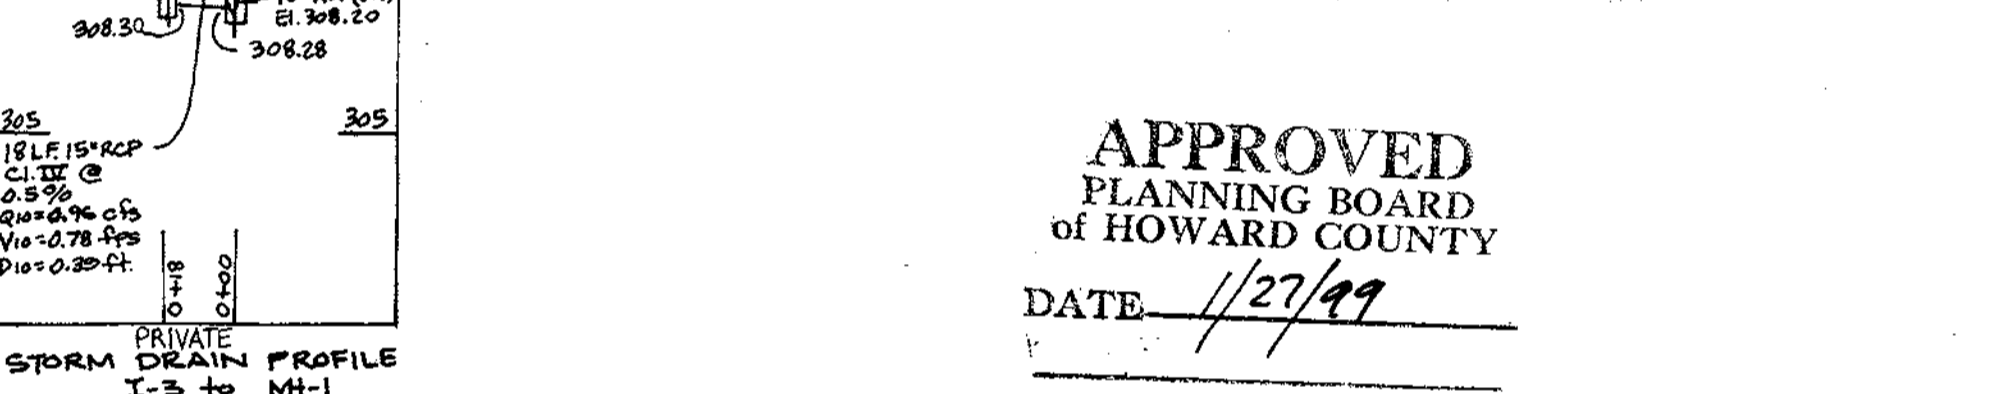



GUIDELINES FOR ASSEMBLING PROFILE GASKETS ON A SINGLE STEP

- 1. The Stormceptor section should be handled with care to avoid any chipping of the bell or spigot.
2. Carefully clean all dirt and debris from the spigot, including the pipe seating area of the gasket.
3. Place the profile gasket on the step of the 'dry' spigot.
4. Insert a smooth, round rod, such as a screwdriver, between the gasket and the spigot.
5. Apply joint lubricant to the inner surface of the bell including the leading edge.
6. Align the Stormceptor sections (spigot with the bell).
7. Gently push the joint home.

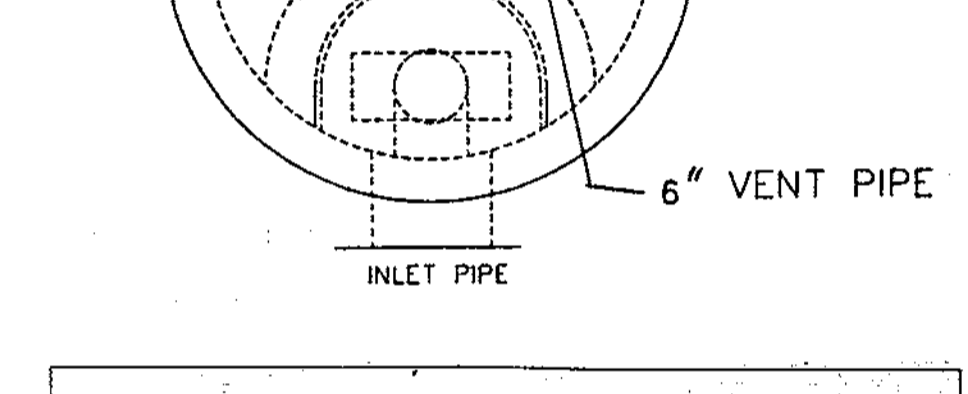

SC-1 Concrete Stormceptor Order Request Form. Includes Contractor Information, Owner Information, Stormceptor Model selection, and project details.

SC-2 Concrete Stormceptor Order Request Form. Includes Contractor Information, Owner Information, Stormceptor Model selection, and project details.

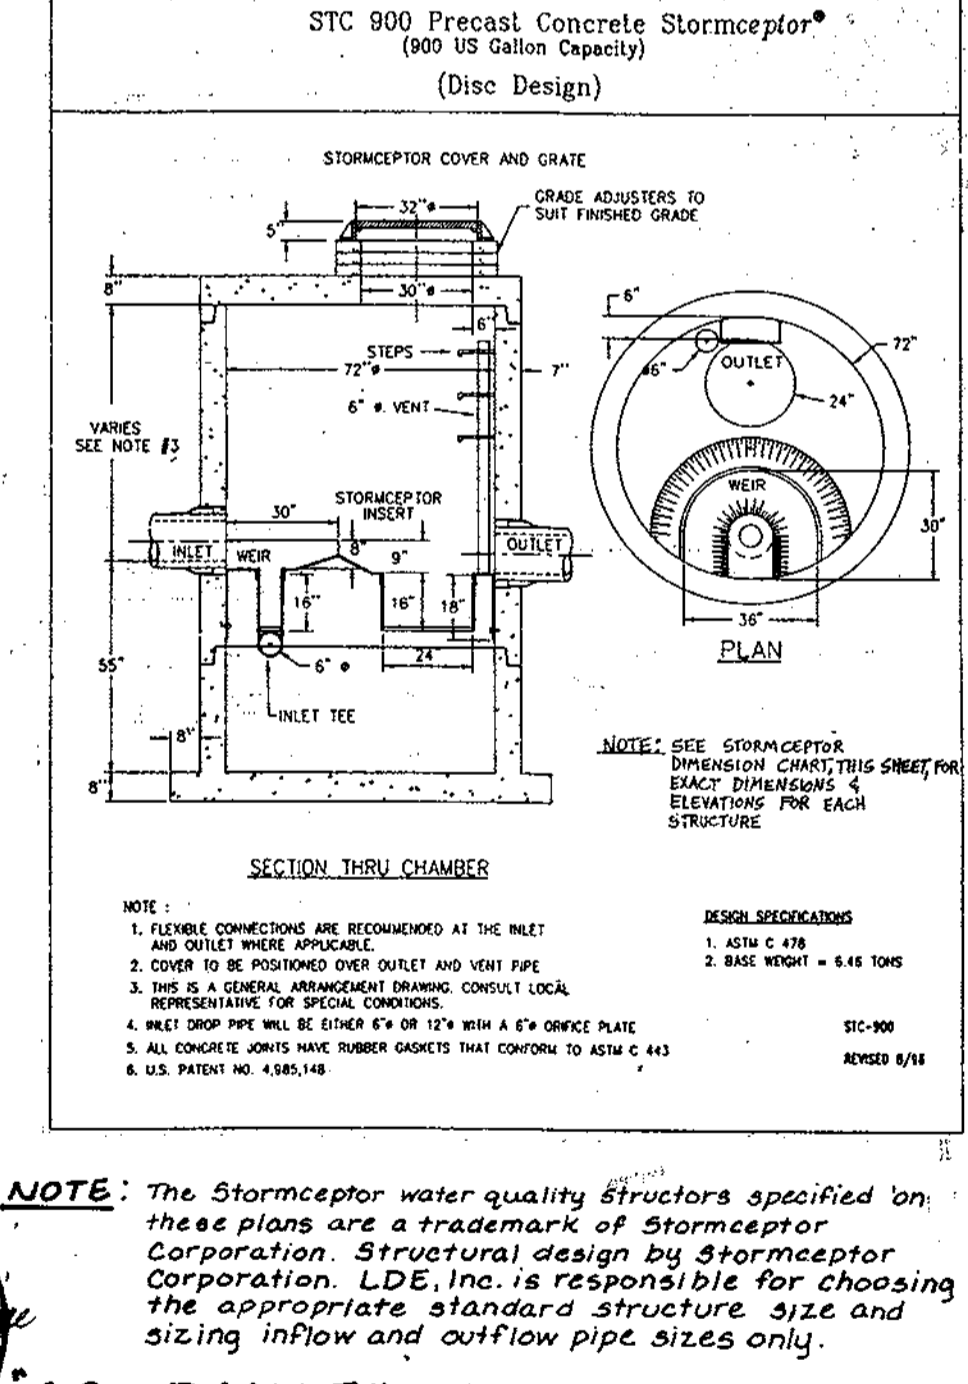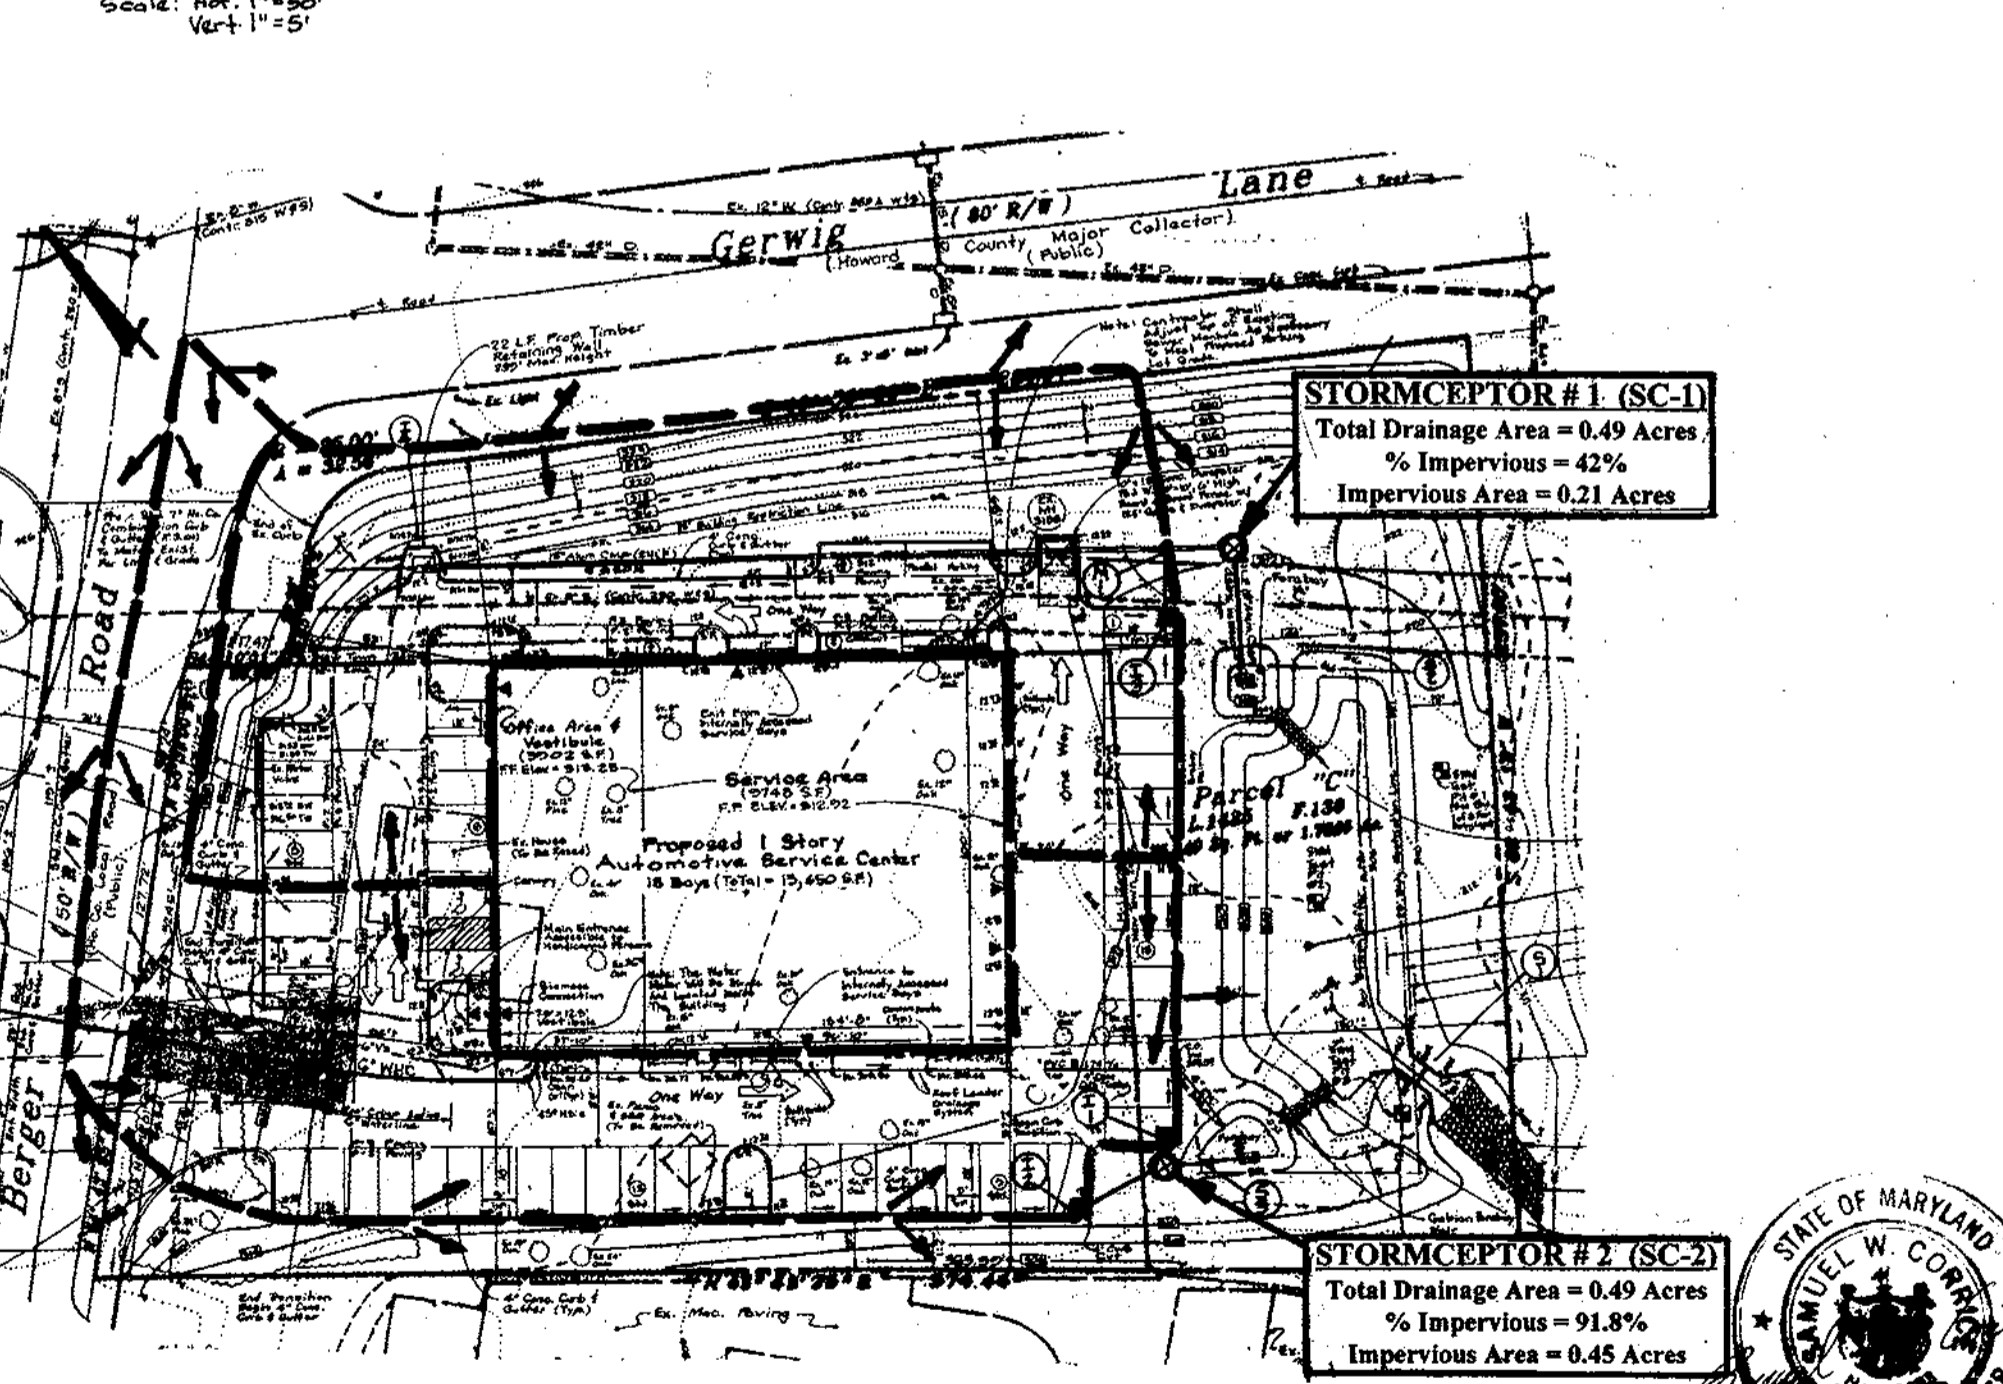

APPROVED: DEPARTMENT OF PLANNING AND ZONING. Includes signatures and dates for approval.

THESE PLANS HAVE BEEN REVIEWED FOR THE HOWARD SOIL CONSERVATION DISTRICT AND MEET THE TECHNICAL REQUIREMENTS. Includes signatures and dates for soil conservation approval.

ENGINEER'S CERTIFICATE. I HEREBY CERTIFY THAT THESE PLANS AND SEEDMENT CONTROL REPRESENTS A PRACTICAL DESIGN... Includes signature and date of the engineer.

REVISIONS table with columns for No., Date, By, and Description. Includes a table for STORMCEPTOR DIMENSIONS with columns for NO., TYPE, TOP ELEV., BOT. SLAB ELEV., TOP SLAB ELEV., INV. IN #1, INV. IN #2, INV. OUT.

AS-BUILT. LDE, INC. 9250 Rumsey Road, Suite 108, Columbia, MD. 21045. Includes project details and contact information.



APPROVED: DEPARTMENT OF PLANNING AND ZONING

3/8/99
DATE

3/8/99
DATE

3/11/99
DATE

THESE PLANS HAVE BEEN REVIEWED FOR THE HOWARD SOIL CONSERVATION DISTRICT AND MEET THE TECHNICAL REQUIREMENTS.

NATURAL RESOURCE CONSERVATION SERVICE

DATE

THIS DEVELOPMENT PLAN IS APPROVED FOR SOIL EROSION AND SEDIMENT CONTROL BY THE HOWARD SOIL CONSERVATION DISTRICT.

HOWARD SOIL CONSERVATION DISTRICT

DATE

ENGINEER'S CERTIFICATE

"I HEREBY CERTIFY THAT THE EROSION AND SEDIMENT CONTROL REPRESENTS A PRACTICAL AND FEASIBLE PLAN BASED ON MY PERSONAL KNOWLEDGE OF THE SITE AND THAT IT WAS PREPARED IN ACCORDANCE WITH REQUIREMENTS OF THE HOWARD SOIL CONSERVATION DISTRICT."

2/24/99
DATE

DEVELOPER'S CERTIFICATE

"I HEREBY CERTIFY THAT ALL DEVELOPMENT AND/OR CONSTRUCTION WILL BE DONE ACCORDING TO THESE PLANS AND THAT ANY RESPONSIBLE PERSONNEL INVOLVED IN THE CONSTRUCTION PROJECT WILL HAVE A CERTIFICATE OF ATTENDANCE AT A DEPARTMENT OF THE ENVIRONMENT APPROVED TRAINING PROGRAM FOR THE CONTROL OF SEDIMENT AND EROSION. I ALSO AUTHORIZED PERIODIC ON-SITE INSPECTIONS BY THE HOWARD SOIL CONSERVATION DISTRICT OR THEIR AUTHORIZED AGENTS AS NECESSARY."

2/23/99
DATE



APPROVED
PLANNING BOARD
OF HOWARD COUNTY

DATE 1/27/99


<p>LDE, INC. 9250 Rumsey Road, Suite 106, Columbia, MD. 21045 (410) 715-1070 (301) 596-3424 (410) 715-9540 (Fax)</p>		
DESIGNED	Existing Features Plan	SCALE
SDH	British And American Auto Care, Inc.	1" = 20"
DRAWN	Columbia	DRAWING
SMC	E.G.U. Subdivision	8 of 9
CHECKED	Parcel "C"	JOB NO.
B.D.B.	Tax Map 42, P/O Parcel 386, Grid 9	98-010
DATE	6th Election District	FILE NO.
Rev. 7/98	Howard County, Maryland	SDP-26-
4/98	Owner/Developer	132
	<p>Briton England British And American Auto-Care Inc. 5235 Berger Road Columbia, Maryland 21046 (410) 381-2700</p>	

Slope Legend

Slopes 15 - 24.9 %

Slopes 25% or Greater



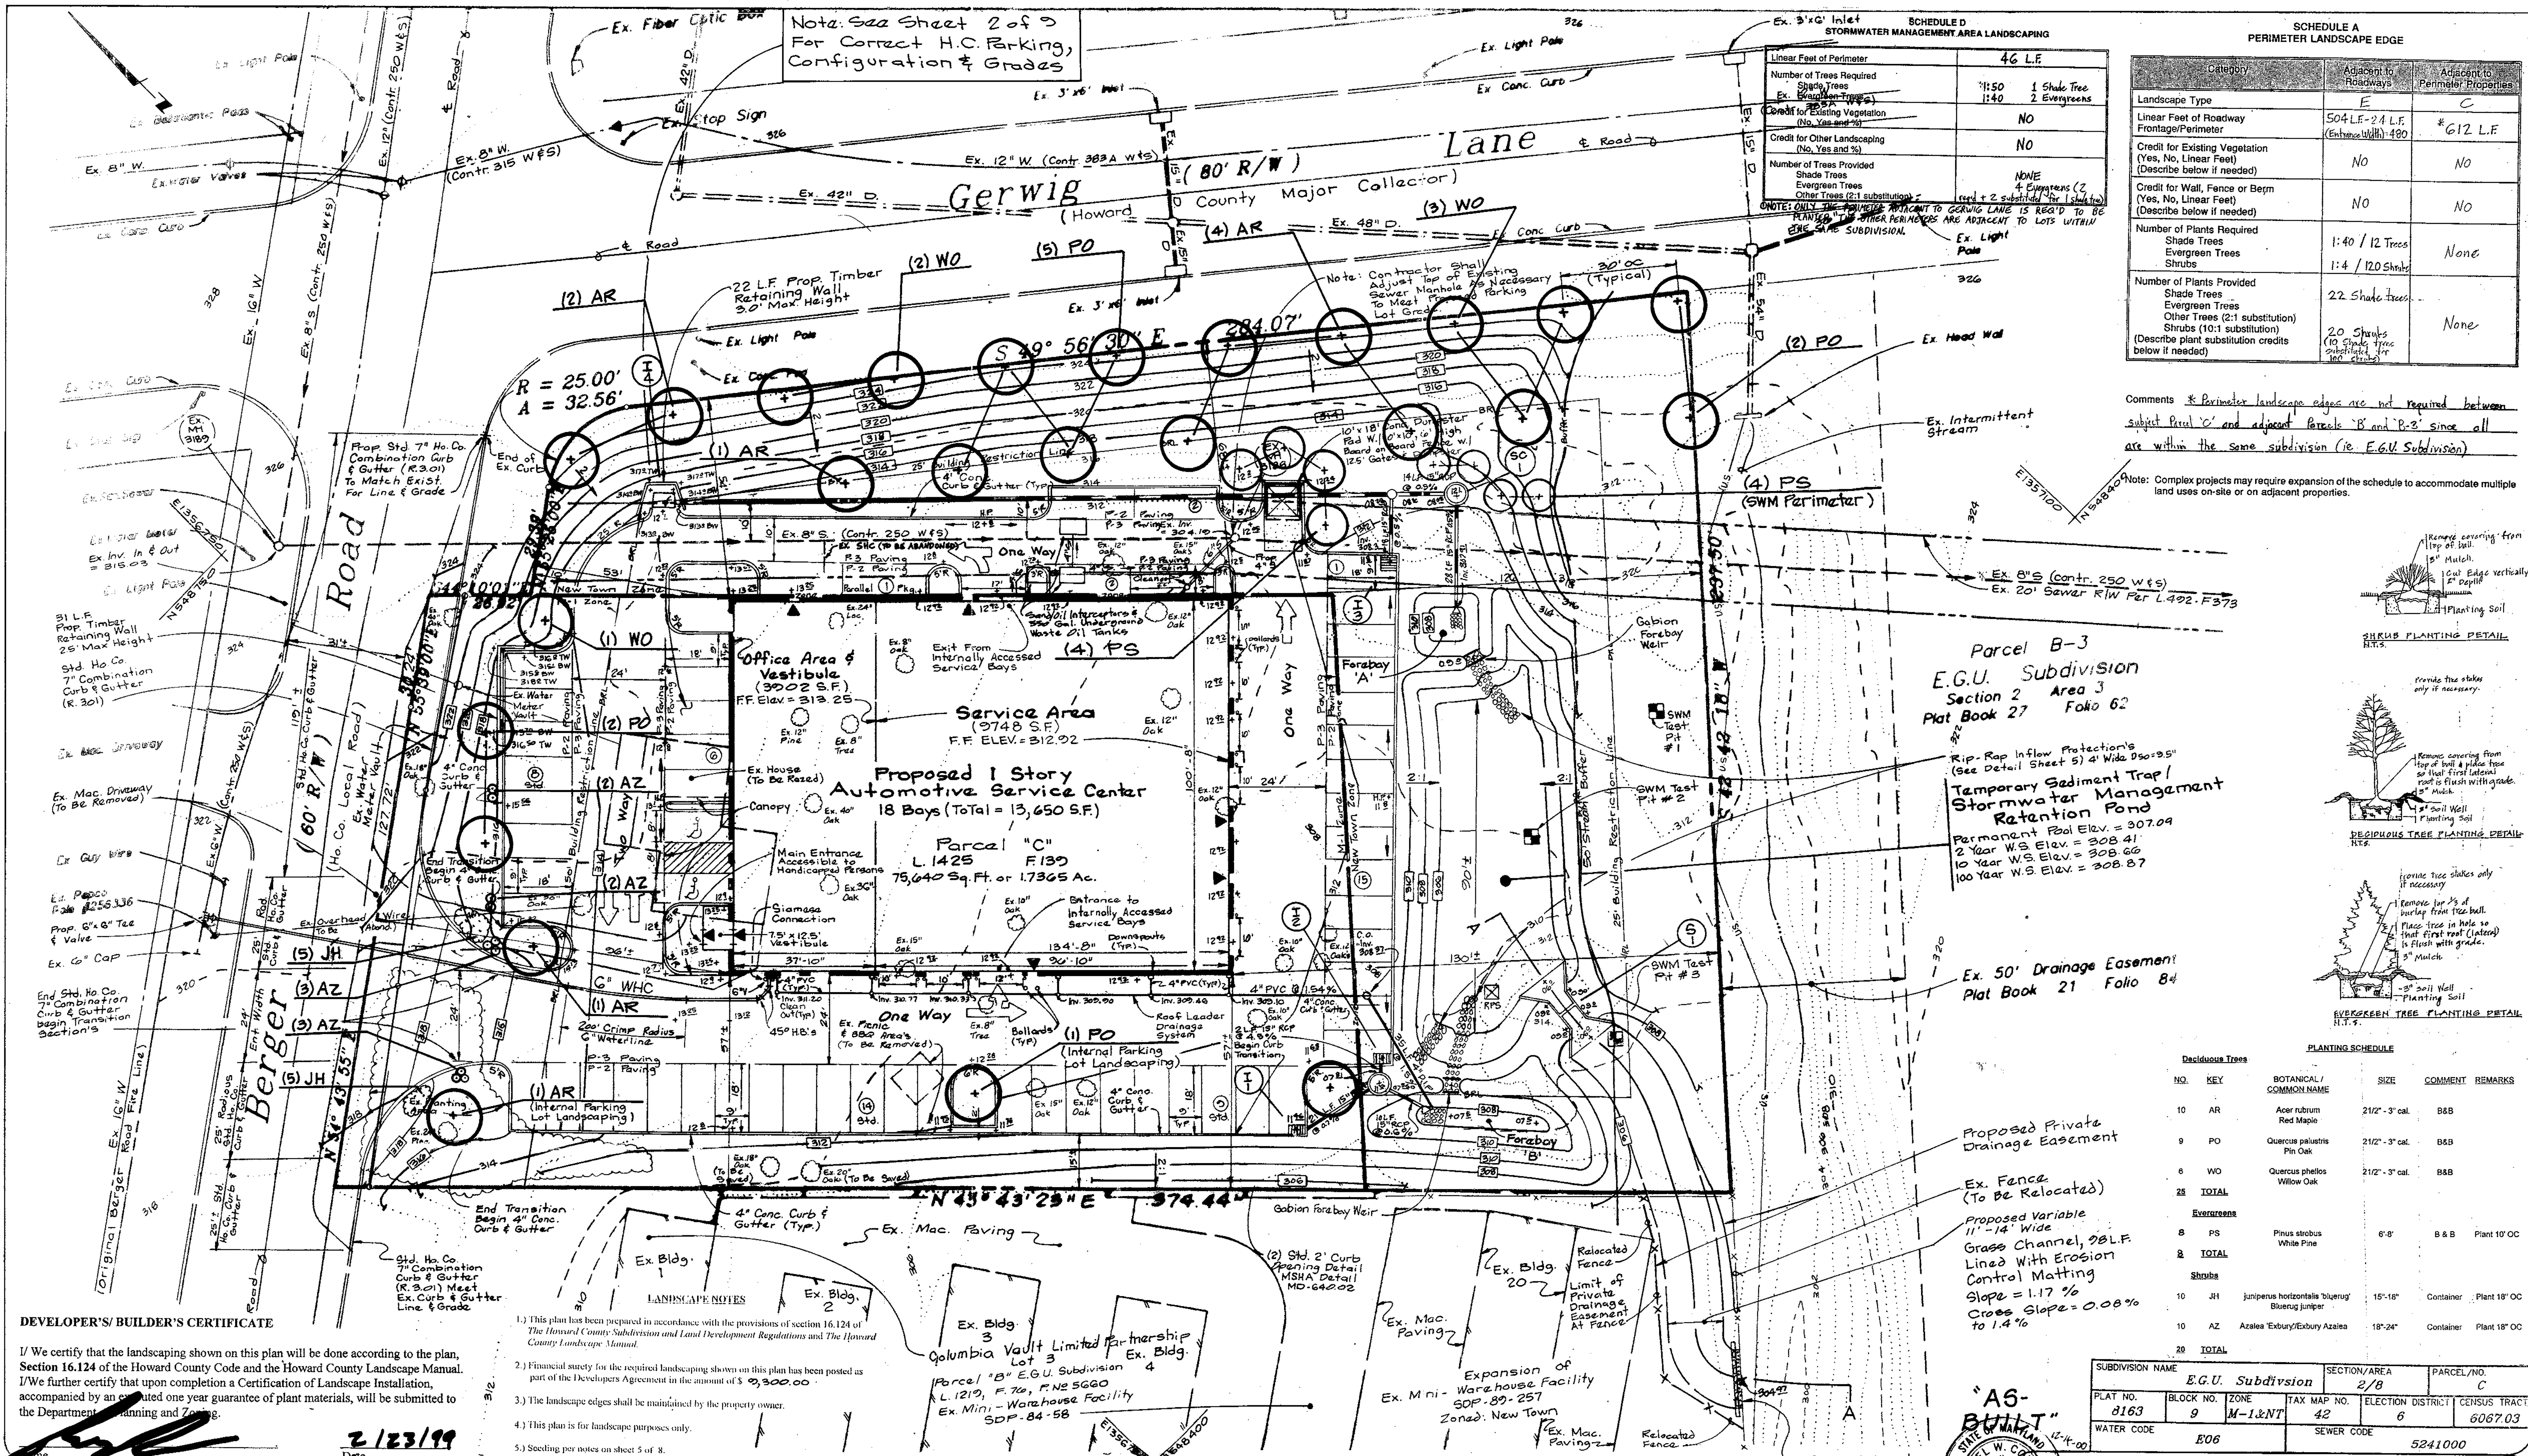

Note: See Sheet 2 of 3 For Correct H.C. Parking, Configuration & Grades

SCHEDULE D STORMWATER MANAGEMENT AREA LANDSCAPING

Linear Feet of Perimeter	46 L.F.	
Number of Trees Required	1150	1 Shade Tree
Ex. (Minimum Trees)	1140	2 Evergreens
Credit for Existing Vegetation (No, Yes and %)	NO	
Credit for Other Landscaping (No, Yes and %)	NO	
Number of Trees Provided	NONE	
Shade Trees	NONE	
Evergreen Trees	NONE	
Other Trees (2:1 substitution)	NONE	

NOTE: ONLY THE PERIMETER ADJACENT TO GERWIG LANE IS REQUIRED TO BE LANDSCAPED. OTHER PERIMETERS ARE ADJACENT TO LOTS WITHIN THE SAME SUBDIVISION.

SCHEDULE A PERIMETER LANDSCAPE EDGE

Category	Adjacent to Roadways	Adjacent to Perimeter Properties
Landscape Type	E	C
Linear Feet of Roadway Frontage/Perimeter (Enhance With) 480	504 L.F. - 24 L.F.	612 L.F.
Credit for Existing Vegetation (Yes, No, Linear Feet) (Describe below if needed)	NO	NO
Credit for Wall, Fence or Berm (Yes, No, Linear Feet) (Describe below if needed)	NO	NO
Number of Plants Required	1:40 / 12 Trees	None
Shade Trees	1:4 / 120 Shrubs	None
Evergreen Trees		
Shrubs		
Number of Plants Provided	22 Shade Trees	None
Shade Trees		
Evergreen Trees		
Other Trees (2:1 substitution)	20 Shrubs (10 Shade Types Substituted, 10C Shrubs)	None

Comments: * Perimeter landscape edges are not required between subject Parcel 'C' and adjacent Parcels 'B' and 'D' since all are within the same subdivision (ie. E.G.U. Subdivision)

Note: Complex projects may require expansion of the schedule to accommodate multiple land uses on-site or on adjacent properties.

DEVELOPER'S/BUILDER'S CERTIFICATE

I/We certify that the landscaping shown on this plan will be done according to the plan, Section 16.124 of the Howard County Code and the Howard County Landscape Manual. I/We further certify that upon completion a Certification of Landscape Installation, accompanied by an executed one year guarantee of plant materials, will be submitted to the Department of Planning and Zoning.

Date: 2/23/99

- LANDSCAPE NOTES**
- This plan has been prepared in accordance with the provisions of section 16.124 of the Howard County Subdivision and Land Development Regulations and the Howard County Landscape Manual.
 - Financial surety for the required landscaping shown on this plan has been posted as part of the Developers Agreement in the amount of \$ 9,300.00
 - The landscape edges shall be maintained by the property owner.
 - This plan is for landscape purposes only.
 - Seeding per notes on sheet 5 of 8.

ENGINEER'S CERTIFICATE

"I HEREBY CERTIFY THAT THE DESIGN AND CONSTRUCTION OF THIS PROJECT IS BASED ON MY PERSONAL KNOWLEDGE OF THE SITE AND THAT I HAVE ATTENDED TO ALL REQUIREMENTS OF THE HOWARD COUNTY SOIL CONSERVATION DISTRICT."

Signature: [Signature]
Date: 2/24/99

DEVELOPER'S CERTIFICATE

"I/WE CERTIFY THAT ALL DEVELOPMENT AND/OR CONSTRUCTION WILL BE DONE ACCORDING TO THESE PLANS AND THAT ANY RESPONSIBLE PERSONNEL INVOLVED IN THE CONSTRUCTION OF THIS PROJECT WILL MAINTAIN A CERTIFICATE OF ATTENDANCE AT A DEPARTMENT OF THE ENVIRONMENT APPROVED TRAINING PROGRAM FOR THE CONTROL OF SEDIMENT AND EROSION. I/WE ALSO AUTHORIZE PERIODIC ON-SITE INSPECTION BY THE HOWARD COUNTY SOIL CONSERVATION DISTRICT OR THEIR AUTHORIZED AGENTS, AS DEEMED NECESSARY."

Signature: [Signature]
Date: 2/23/99

APPROVED: DEPARTMENT OF PLANNING AND ZONING

Signature: [Signature]
Date: 2/23/99

HOWARD SOIL CONSERVATION DISTRICT

Signature: [Signature]
Date: 2/23/99

STATE OF MARYLAND

Signature: [Signature]
Date: 2/23/99

SCHEDULE B' PARKING LOT INTERNAL LANDSCAPING

Number of Parking Spaces	57
Number of Trees Required	1 Shade Tree / 20 Spaces = 3
Number of Trees Provided	3 Shade Trees
Other Trees (2:1 substitution)	

NOTE: THE AMENDED LANDSCAPE MANUAL, DATED MARCH 2, 1998 STATES THAT SWM PERIMETER LANDSCAPING IS REQUIRED IN ALL ZONING DISTRICTS EXCEPT M-1 AND M-2. THIS SITE IS ZONED BOTH M-1 AND NEW TOWN. EMPLOYMENT CENTER. THE INTENT IS TO DEVELOP THE ENTIRE SITE AS AN AUTOMOTIVE SERVICE FACILITY, AN M-1 TYPE USE. THE CHARACTER OF THE EXISTING AREA IS ENTIRELY COMMERCIAL/INDUSTRIAL. THEREFORE IT WOULD NOT BE IN KEEPING WITH THE CHARACTER OF THE AREA TO PROVIDE STORMWATER MANAGEMENT PERIMETER LANDSCAPING. THEREFORE, STORMWATER MANAGEMENT PERIMETER PLANTINGS HAVE NOT BEEN PROVIDED.

APPROVED PLANNING BOARD OF HOWARD COUNTY

DATE: 1/27/99

LDE, INC.
9250 Rumsey Road, Suite 106, Columbia, MD 21045
(410) 715-1070 (301) 596-3424 (410) 715-9540 (Fax)

British And American Auto Care, Inc.
Columbia
E.G.U. Subdivision
Parcel "C"

Tax Map 42, P/O Parcel 386 Grid 9
6th Election District
Howard County, Maryland

Owner/Developer: British And American Auto Care, Inc.
2535 Berger Road
Columbia, Maryland
(410) 381-1700

Scale: 1" = 20'

JOB NO.: 98-010
FILE NO.: SDP-98-132

Sheet Index	
No.	Title
1	Title Sheet
2	Site Development Plan
3	Grading Sediment Control Plan
4	Drainage Area And Soils Plan
5	Sediment Control Construction Notes & Details
6	Stormwater Management Detail Plan
7	Quality Stormwater Management Notes & Details
8	Existing Features Plan
9	Landscape Plan

LEGEND

BENCH MARK

USE RESTRICTION LINE

FLOW DIRECTION

SLOPES BETWEEN 15% - 24.0%

SLOPES GREATER THEN 25%

SILT FENCE

EARTH DIKE

LIMIT OF DISTURBANCE


DRAINAGE DIVIDE

EXISTING CONTOUR

PROPOSED CONTOUR

STABILIZED CONSTRUCTION ENTRANCE

SUPER SILT FENCE

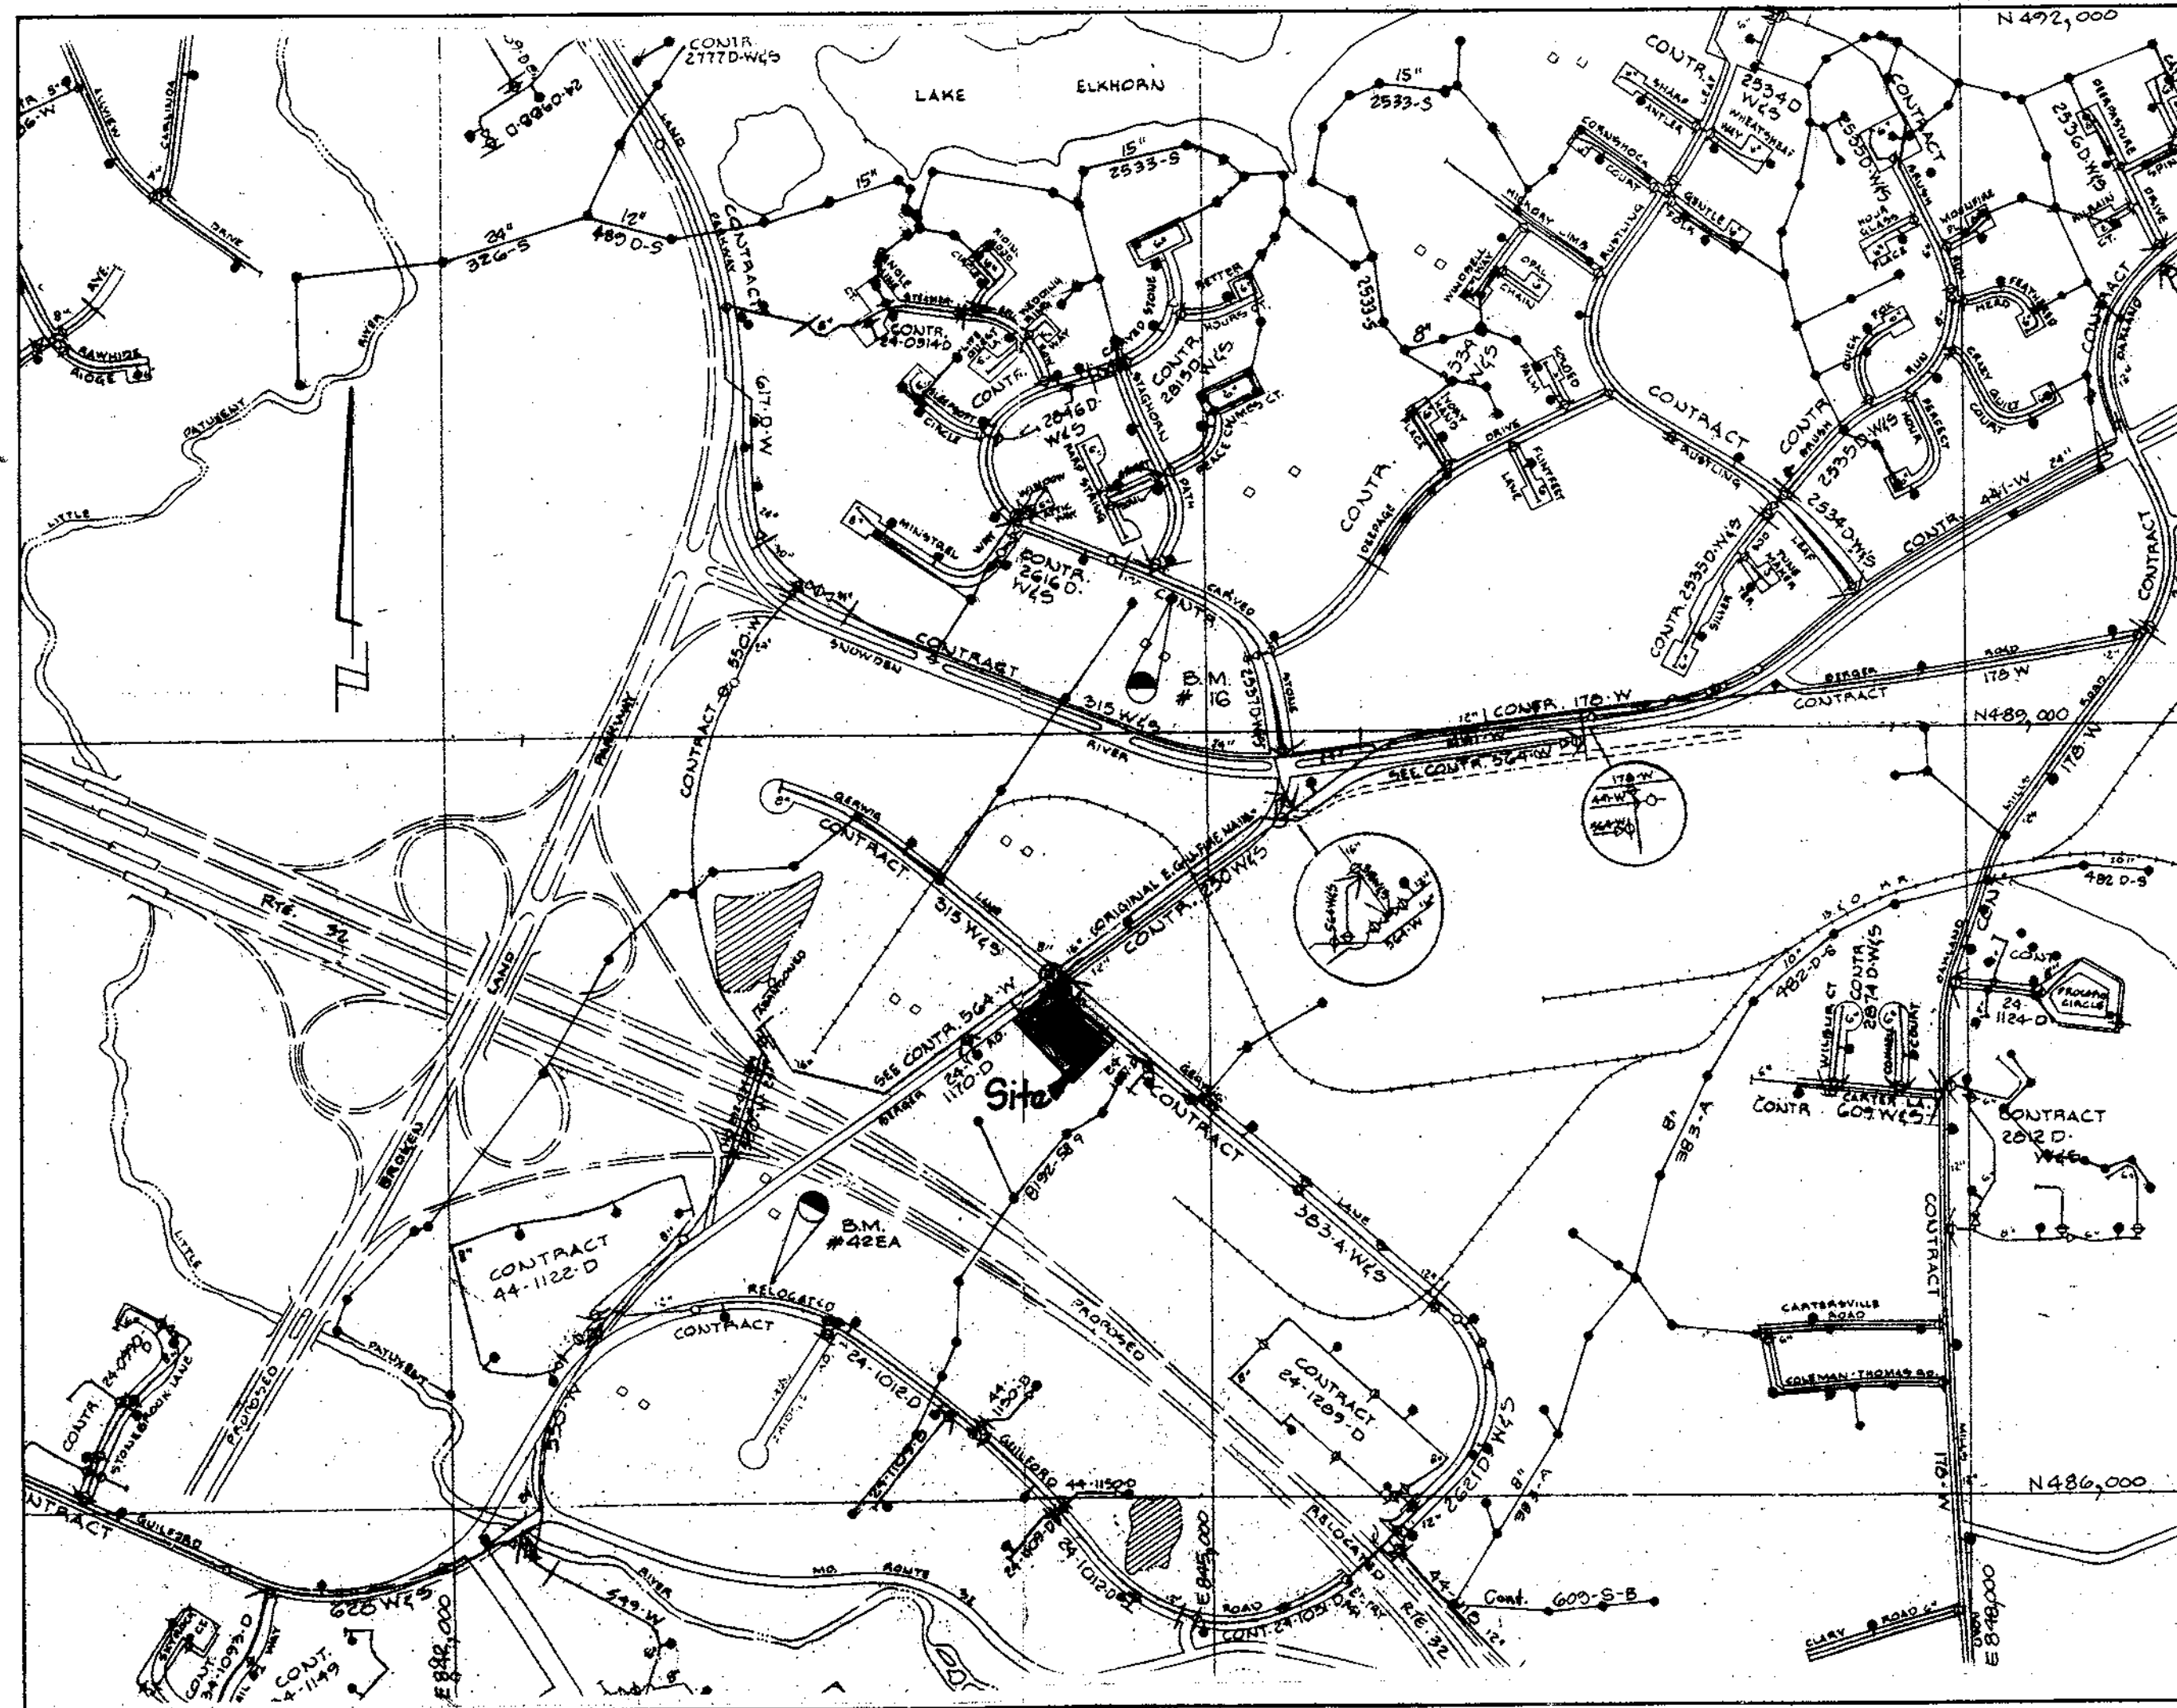

Location Map
Scale: 1" = 600'

BENCH MARKS

- Howard County Geodetic Control No. 42EA
Elevation = 313.28, Northing = 547604, Easting = 1355440.
Standard Howard County Survey Disc. Set on concrete monument.
On Guilford Road 0.3+/- miles northeast, leftside from intersection,
Murry Hill Road 9.3' +/- edge of paving, 20' +/- west from light pole
and 80' from water valve in Guilford Road.
- Howard County Geodetic Control No. 0016
Elevation = 359.59, Northing = 550729, Easting = 1357329.
Standard Howard County Survey Disc. Set on concrete monument.
Between Carved Stone Road and conc. sidewalk, 100' +/- east from
intersection Stag Horn Path and 41' +/- from inlet.

GENERAL NOTES

- Site Analysis Data:
 - Total Project Area: 1.736+/- Acres (75,640 sq ft).
 - Area of Plan Submitter: 1.736+/- Acres (75,640 sq ft).
 - Net Area: 1.045+/- Acres (45,250 sq ft).
 - Area of Disturbed Area: 1.70+/- Acres (74,052 sq ft).
 - Present Zoning: M-1 and New Town.
 - Proposed Site and Structure Use: Automotive service center operation.
 - Building Floor Space: 1 Story Building
 - Office Space & Vestibule = 3,902 sq. ft.
 - Warehouse Space = 9,748 sq. ft.
 - Total Building Area = 13,650 sq. ft.
 - Total Number of Units Allowed: One (1) commercial building.
 - Total Number of Proposed Units: One (1) 13,650 sq. ft. building.
 - Maximum Number of Employees: 20.
 - Parking Required: Vehicle service establishments: 3 spaces plus 3 spaces/ service bay (18 bays x 3 sp + 3 sp = 57 spaces).
 - Parking Provided: 64 Regular spaces + 2 Van Accessible handicapped spaces = 66 Total.
 - Open Space: None required.
 - Recreation Open Space: None required.
 - Building Coverage of Site: 0.313+/- Acres, 18.05% of gross site area.
 - Applicable DPZ File References: F-89-11, Amended FDP Phase 156-A.
- Property Owner: Brian England
British and American Auto Care, Inc.
9235 Berger Road
Columbia, Maryland 21046
- Architect: Alan Architects
Suite 453
5537 Twin Knolls Road
Columbia, Maryland 21045-3270
- Plat Reference: No. 8163, recorded on 9/30/88 among the Land Records of Howard County, Md.
- There are no wetlands or forest on the subject property. An assessment was conducted by Dennis J. LaBare, M.S. and Associates, LLC on 9/23/97.
- This property is exempt from the requirements of the Howard County Forest Conservation Manual in accordance with Section 15.102(b) of the County Code. There is no area of 100 year floodplain on the subject property.
- Boundary information per record plat No. 8163, dated 9/30/88 by Clark, Finetruk & Sackett, Inc. Boundary information field verified by LDE, Inc. in March, 1998. Onsite topography shown hereon was field run by LDE, Inc. on March 2, 1998. Control based on Maryland NAD83 horizontal and NAVD83 vertical datum from Howard County Control Stations 0016 and 42EA.
- All construction shall be performed in accordance with the latest standards and specifications of Howard County plus MSHA standards and specifications if applicable.
- Deviations from these plans and specifications without prior written consent of the civil engineer may cause the work to be unacceptable.
- Adjustments to the sequence of construction shall be approved by the Howard County Department of Inspections, Licenses and Permits prior to such adjustments.
- Approximate locations of existing utilities are shown. The contractor shall take all necessary precautions to protect existing utilities and maintain uninterrupted service. Any damage incurred due to contractor's operation shall be repaired immediately at the contractor's expense.
- Contractor shall comply with all sediment control notes on these plans.
- All plan dimensions are to face of curb unless noted otherwise.
- Traffic control devices, markings and signing shall be in accordance with the latest edition of the Manual of Uniform Traffic Control Devices (MUTCD). All street and regulatory signs shall be in place prior to the placement of any asphalt.
- There may be additional utilities not shown on these plans. The engineer assumes no responsibility for locations not shown and it shall be the responsibility of the contractor to verify the locations of all existing utilities within the limits of construction and notify the engineer prior to the start of construction.
- The contractor shall notify the following utilities or agencies at least five (5) working days before beginning construction:
 - "Miss Utility" at 1-800-257-7777
 - "Xcel" at (410) 234-5601
 - "Bell Atlantic" at (410) 380-0000

Vicinity Map
Scale: 1" = 2000'

- It shall be distinctly understood that failure to mention specifically any work which would normally be required to complete this project shall not relieve the contractor from his responsibility to perform such work.
- The contractor shall obtain all necessary permits prior to beginning work, including a grading permit from Howard County.
- The contractor shall repair and maintain all existing sediment control devices until all areas are stabilized. Once all areas are fully stabilized all sediment control devices shall be completely removed and those areas stabilized.
- The contractor shall contact the Howard County Department of Public Works Construction Inspection Division 24 hours prior to beginning construction at (410) 381-1880.
- Public water service is available for this site under W & S Contract No. 315 and public sewer is available under W & S Contract No. 250.
- Prior to the start of construction, contractor shall stakeout all construction and verify all offsets, setbacks and existing utility locations.
- The developer must request that the Department of Inspections, Licenses and Permits approve work completed in accordance with the approved Erosion and Sediment Control Plan, Grading Permit and the Ordinance.
- Stormwater management for this site is provided by an onsite retention pond. Water quality management provided by two (2) Stormwater Stormwater quantity management for this site is provided by an onsite retention pond. Water quality management provided by two (2) Stormwater.
- Any damage to County Rights-of-Way or paved public roads shall be repaired immediately at the contractor's expense in accordance with the Howard County Standards and Specifications.
- All fill shall be rolled to a minimum degree of compaction of 95% of the dry unit weight as determined by ASTM D-1587.
- The dimensional distances shall govern if scaled and dimensioned distances on this plan are found to be in disagreement.
- See architectural plans for exact building dimensions.
- The applicant will request a parking setback reduction from 25 feet to 10' in the New Town zoned portion of this project as part of the Planning Board approval process in accordance with amended FDP Phase 156-A. (See work # 39).
- The existing dwelling, paved driveway and picnic area shall be removed prior to commencement of site grading.
- The proposed shallow retention pond shall be privately owned and maintained by the property owner.
- The owner/developer shall request permission from the Department of Public Works, Bureau of Utilities Division to use the "Advanced Purchase Order" procedure to bond and construct the proposed 6 inch public watermain and fire hydrant under this site development plan.
- The Howard County Department of Planning & Zoning-Development Engineering Division, by letter dated 5/26/98, granted a waiver to Design Manual Volume IV, Detail R-3.01 to allow an outside standard 10" Co. curb and gutter height of 4".
- Existing septic and water house connection (undocumented connection-meter No. none) shall be properly abandoned in accordance with Ho. Co. Department of Environmental Health standards and inspectors. Location and schedule shall be submitted prior to SDP signature approval.
- A demolition permit is required from the Howard County Department of Inspections, Licenses and Permits for the removal of the existing crane structure.
- The Planning Director denied WP-99-04 to waive Section 16.116(a)(2)(ii) prohibiting grading or removal of vegetative cover within 50' of a perennial stream in a non-residential district on 8/27/98.
- The Planning Board approved this site plan on 1-27-99 and granted a parking setback reduction from 25' to 10' for the portion of the site which is zoned New Town.
- The Stormwater quantity management structures specified on these plans are a trademark of Stormceptor Corporation. Structural Stormceptor Corporation, L.P.E., Inc. is responsible for applying the appropriate standard structure size and sizing inflow & outflow pipe sizes only.

Schnabel Engineering Associates, Inc.
Consulting Geotechnical Engineers

Test Pit Log


Depth (ft)	Soil Description	Moisture (%)	Specific Gravity	Notes
0-1	Dark Grey Silty Clay	28	2.70	Difficult to excavate below 2.0 ft. Rock fragments to 1/2" in length below 2'
1-2	Dark Grey Silty Clay	28	2.70	
2-3	Dark Grey Silty Clay	28	2.70	
"AS-BUILT" CERTIFICATION

I hereby certify that the facility shown on this plan was constructed as shown on the "As-Built" plans and meets the approved plans and specifications.

Signature: Samuel W. Corvise Date: 12-14-00

Certify means to state or declare a professional opinion based upon onsite inspections and material tests which are conducted during construction. The onsite inspections and material tests are those inspections and tests deemed sufficient and appropriate by commonly accepted engineering standards. Certify does not mean or imply a guarantee by the Engineer nor does an Engineer's certification relieve any other party from meeting requirements imposed by contract, employment, or statute, including meeting commonly accepted industry practices.

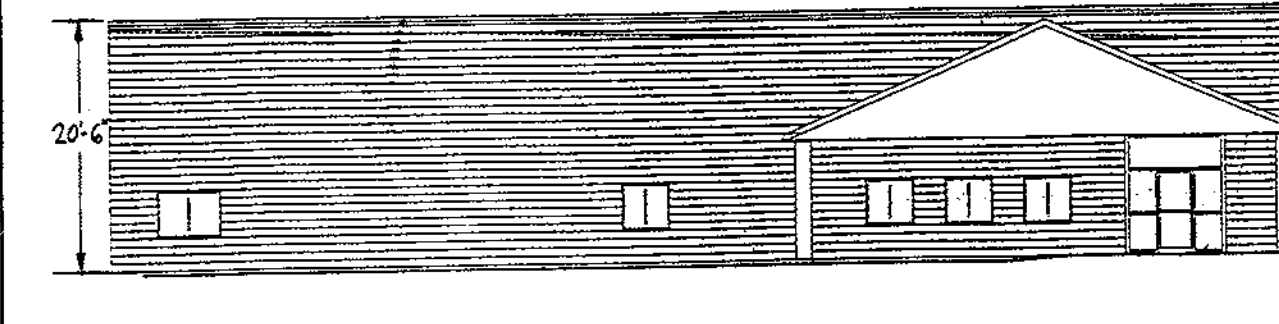

BUILDING PROFILE-FRONT FACING BERGER ROAD
N.T.S.

Site Development Plan "AS-BUILT"

British And American Auto Care Inc.

Columbia E.G.U. Subdivision Parcel "C"



A Resubdivision of Lot 3

6th Election District Howard County, Maryland

Schnabel Engineering Associates, Inc.
Consulting Geotechnical Engineers

Test Pit Log

Depth (ft)	Soil Description	Moisture (%)	Specific Gravity	Notes
0-1	Dark Grey Silty Clay	28	2.70	Difficult to excavate below 2.0 ft. Rock fragments to 1/2" in length below 2'
1-2	Dark Grey Silty Clay	28	2.70	
2-3	Dark Grey Silty Clay	28	2.70	
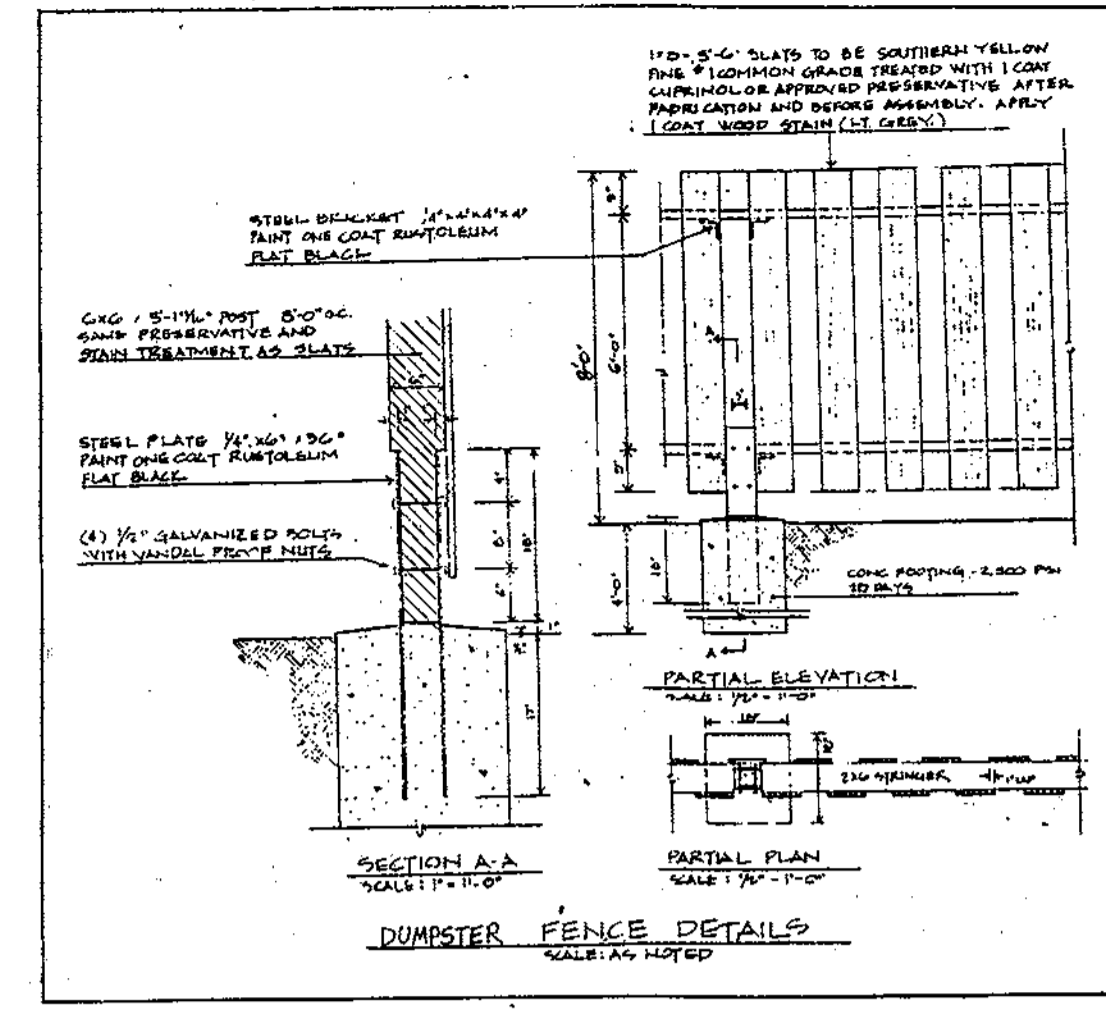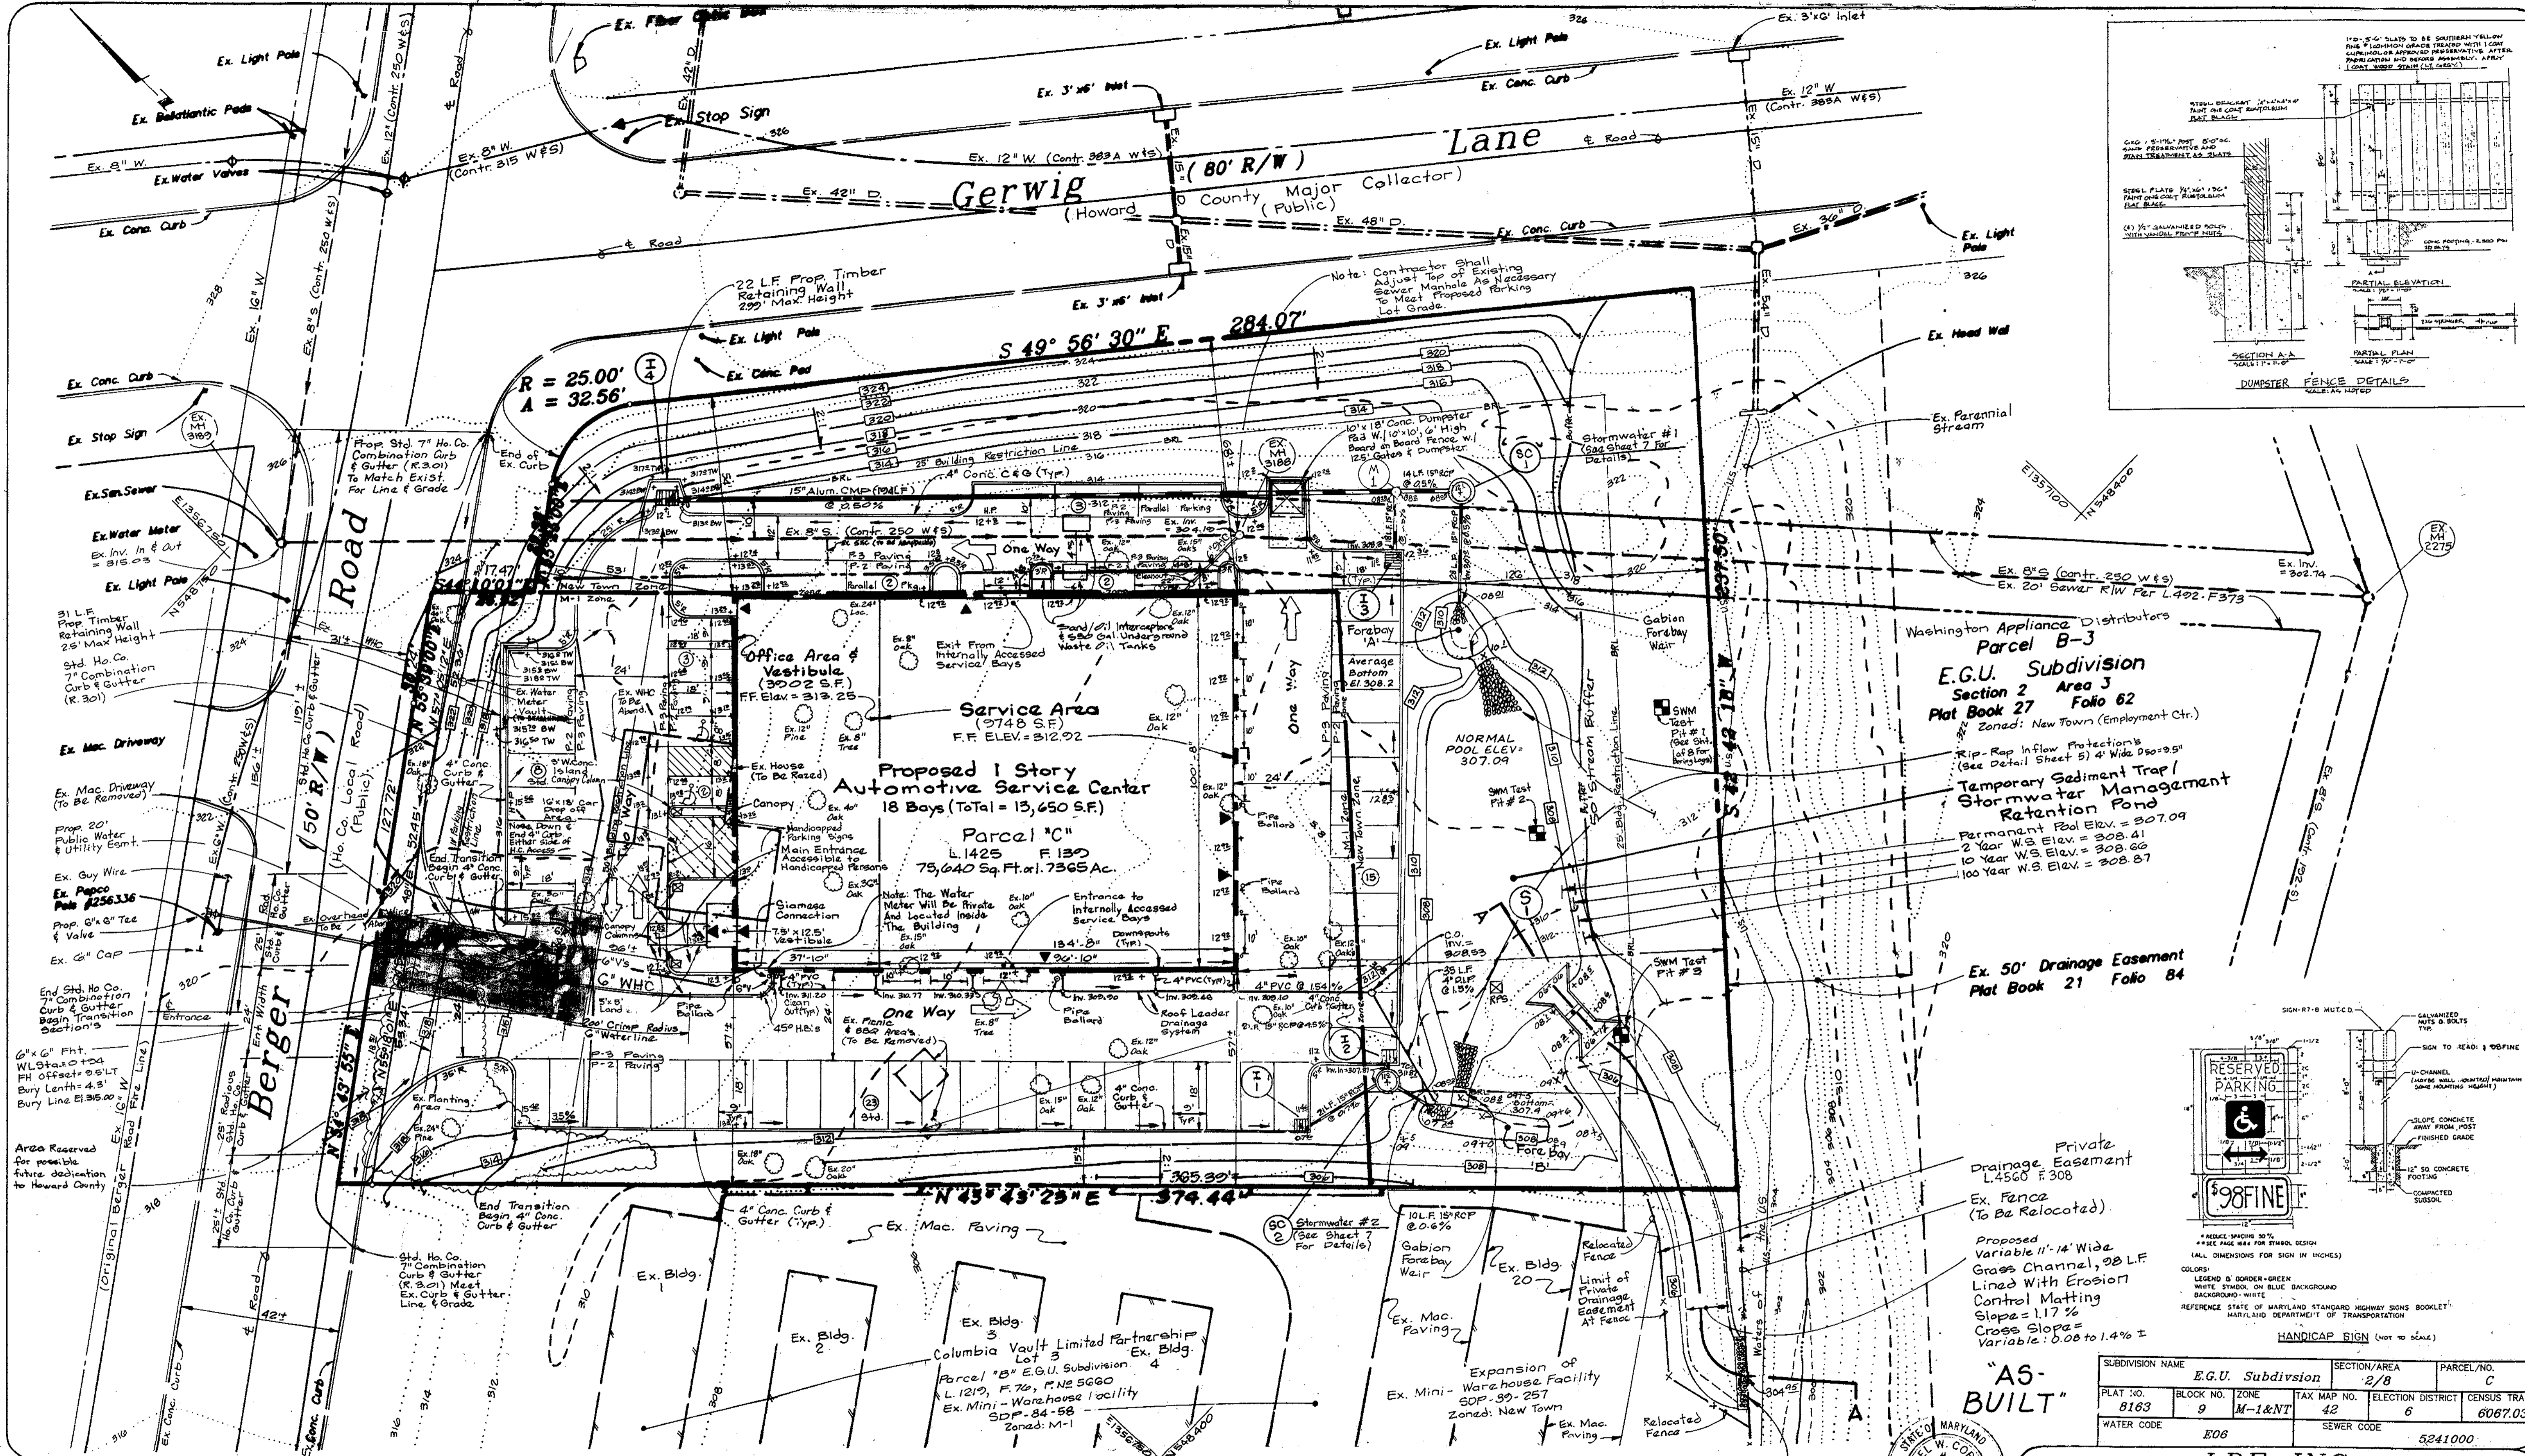


Washington Appliance Distributors
Parcel B-3
E.G.U. Subdivision
Section 2 Area 3
Plat Book 27 Folio 62
Zoned: New Town (Employment Ctr.)

Temporary Sediment Trap /
Stormwater Management
Retention Pond
Permanent Pool Elev. = 307.09
2 Year W.S. Elev. = 308.41
10 Year W.S. Elev. = 308.66
100 Year W.S. Elev. = 308.87

Private
Drainage Easement
1.4560 F.308
(Ex. Fence
To Be Relocated)

Proposed
Variable 11'-14" Wide
Grass Channel, 98 L.F.
Lined With Erosion
Control Matting
Slope = 1:17 %
Cross Slope =
Variable: 0.08 to 1.4% ±

"AS-BUILT"

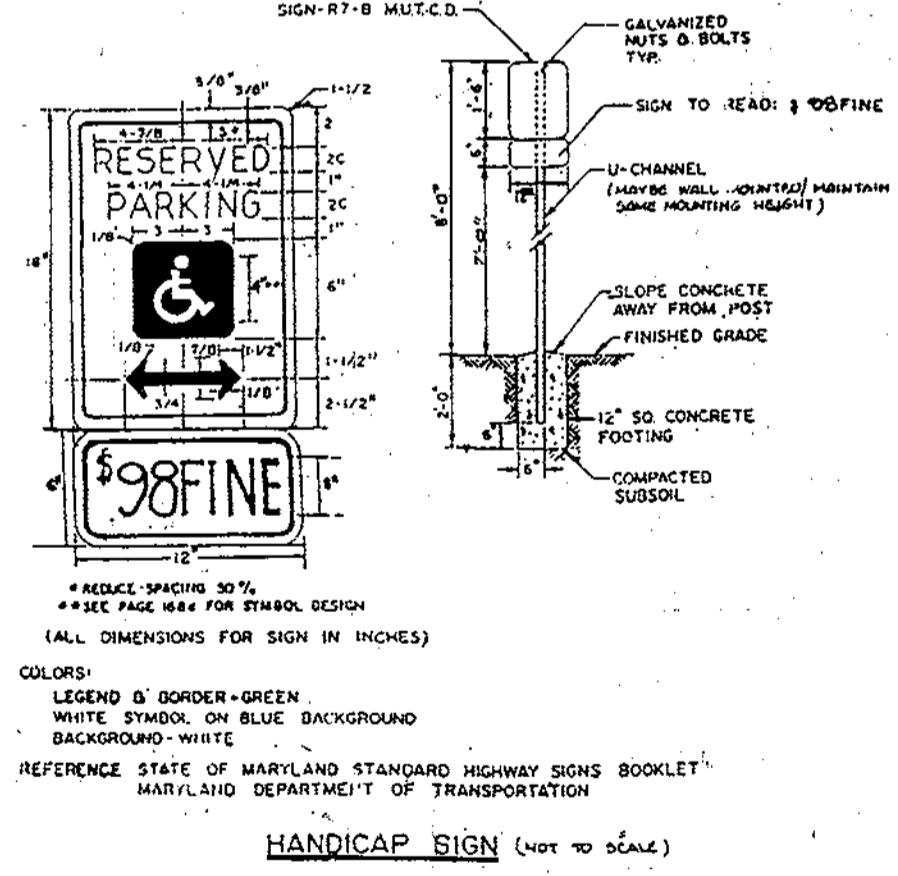

SUBDIVISION NAME		SECTION/AREA	PARCEL/NO.
E.G.U. Subdivision		2/B	C
PLAT NO.	BLOCK NO.	ZONE	TAX MAP NO.
8183	9	M-1&NT	42
ELECTION DISTRICT		CENSUS TRACT	
6		6067.03	
WATER CODE		SEWER CODE	
E06		5241000	

LDE, INC.
9250 Rumsey Road, Suite 106, Columbia, MD. 21045
(410) 715-1070 (301) 596-3424 (410) 715-9540 (Fax)

DESIGNED: SDH
DRAWN: SMC
CHECKED: B.D.B.
DATE: 7/98
REV: 4/98

SCALE: 1" = 20"
DRAWING: 2 of 3
JOB NO.: 98-010
FILE NO.: SDP-98-132

Owner/Developer: British And American Auto Care, Inc.
2535 Berger Road
Columbia, Maryland
(410) 381-2700

APPROVED: DEPARTMENT OF PLANNING AND ZONING

DATE: 3/1/99

DATE: 3/1/99

DATE: 3/1/99

THESE PLANS HAVE BEEN REVIEWED FOR THE HOWARD SOIL CONSERVATION DISTRICT AND MEET THE TECHNICAL REQUIREMENTS.

DATE: 3/3/99

DATE: 3/3/99

DATE: 3/3/99

ENGINEER'S CERTIFICATE
I HEREBY CERTIFY THAT THIS SITE PLAN AND SEDIMENT CONTROL REPRESENTS A PRACTICAL AND FEASIBLE DESIGN BASED ON MY PERSONAL KNOWLEDGE OF THE SITE CONDITIONS AND THAT IT WAS PREPARED IN ACCORDANCE WITH REQUIREMENTS OF THE HOWARD SOIL CONSERVATION DISTRICT.

DATE: 2/24/99

DEVELOPER'S CERTIFICATE
I/WE CERTIFY THAT ALL DEVELOPMENT AND/OR CONSTRUCTION WILL BE DONE ACCORDING TO THESE PLANS AND THAT ANY RESPONSIBLE PERSONNEL INVOLVED IN THE CONSTRUCTION PROJECT WILL HAVE A CERTIFICATE OF ATTENDANCE AT A DEPARTMENT OF THE ENVIRONMENT APPROVED TRAINING PROGRAM FOR THE CONTROL OF SEDIMENT AND EROSION. I ALSO AUTHORIZE PERIODIC ON-SITE INSPECTIONS BY THE HOWARD SOIL CONSERVATION DISTRICT OR THEIR AUTHORIZED AGENTS AS DEEMED NECESSARY.

DATE: 2/23/99

PROFESSIONAL ENGINEER
DATE: 2/24/99



APPROVED
BOARD OF ENGINEERS
DATE: 1/27/99

PROPOSED LEVEL SPREADER, SEE DETAIL SHEET 501.9
E1.304.95

No.	Date	By	Description
1	4-28-99	SMC	Revised H.C. parking and associated grading in front of building for revised canopy column locations, added (1) parking space on east of building, and revised exterior bollard locations.
2	2/01	LDE	Removed parking lot island, south side of building.

SEQUENCE OF CONSTRUCTION

- Obtain grading permit. 1 DAY
 - Notify the Howard County Department of Public Works, Construction Inspection Division at least 48 hours prior to beginning construction at (410) 313-1880. 1 DAY
 - Install sediment control devices, including stabilized construction entrance, sediment basin w/ dewatering device and RPS, earth dikes, temporary rip-rap inflow protection and silt fence. Ensure that weir #1 on S-1 is blocked (see SD-7.00 detail, sheet 6). Do not install pond forebays. *See notes on sheet 10* 10 DAYS
 - Grade site in accordance with the approved grading plan. 10 DAYS
 - Stabilize site in accordance with the temporary seeding notes. 10 DAYS
 - Construct Building and install roof drainage system. 3 MONTHS
 - Install utilities, including storm drainage system, water and sewer. 10 DAYS
 - Final grade for parking lot and travelways. Install retaining walls. 4 DAYS
 - Install gravel base for parking lot. 3 DAYS
 - Install base and surface paving. 5 DAYS
 - Stabilize all remaining disturbed areas in accordance with the permanent seeding notes. 2 DAYS
 - With permission from the Sediment Control Inspector, remove all remaining sediment control devices, including stabilized construction entrance, silt fence, earth dikes and temporary rip-rap inflow protection at the end of the earth dike. Convert the sediment trap into permanent stormwater management pond per approved grading plan and SWM construction detail sheet. Install Forebays "A" and "B". Stabilize all remaining disturbed areas in accordance with the permanent seeding notes. 10 DAYS
- TOTAL TIME: 146 DAYS

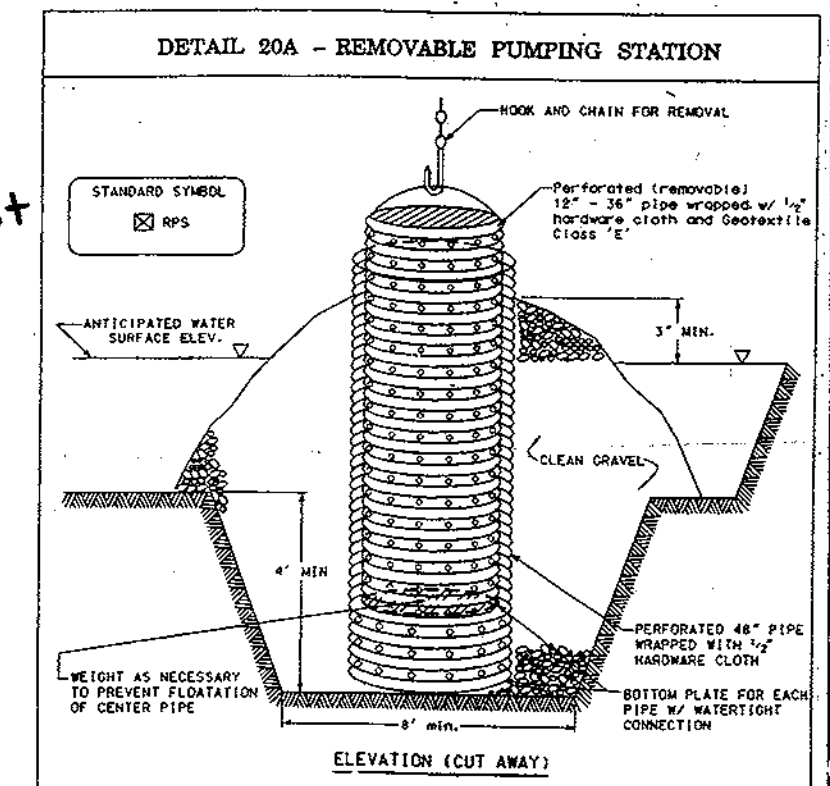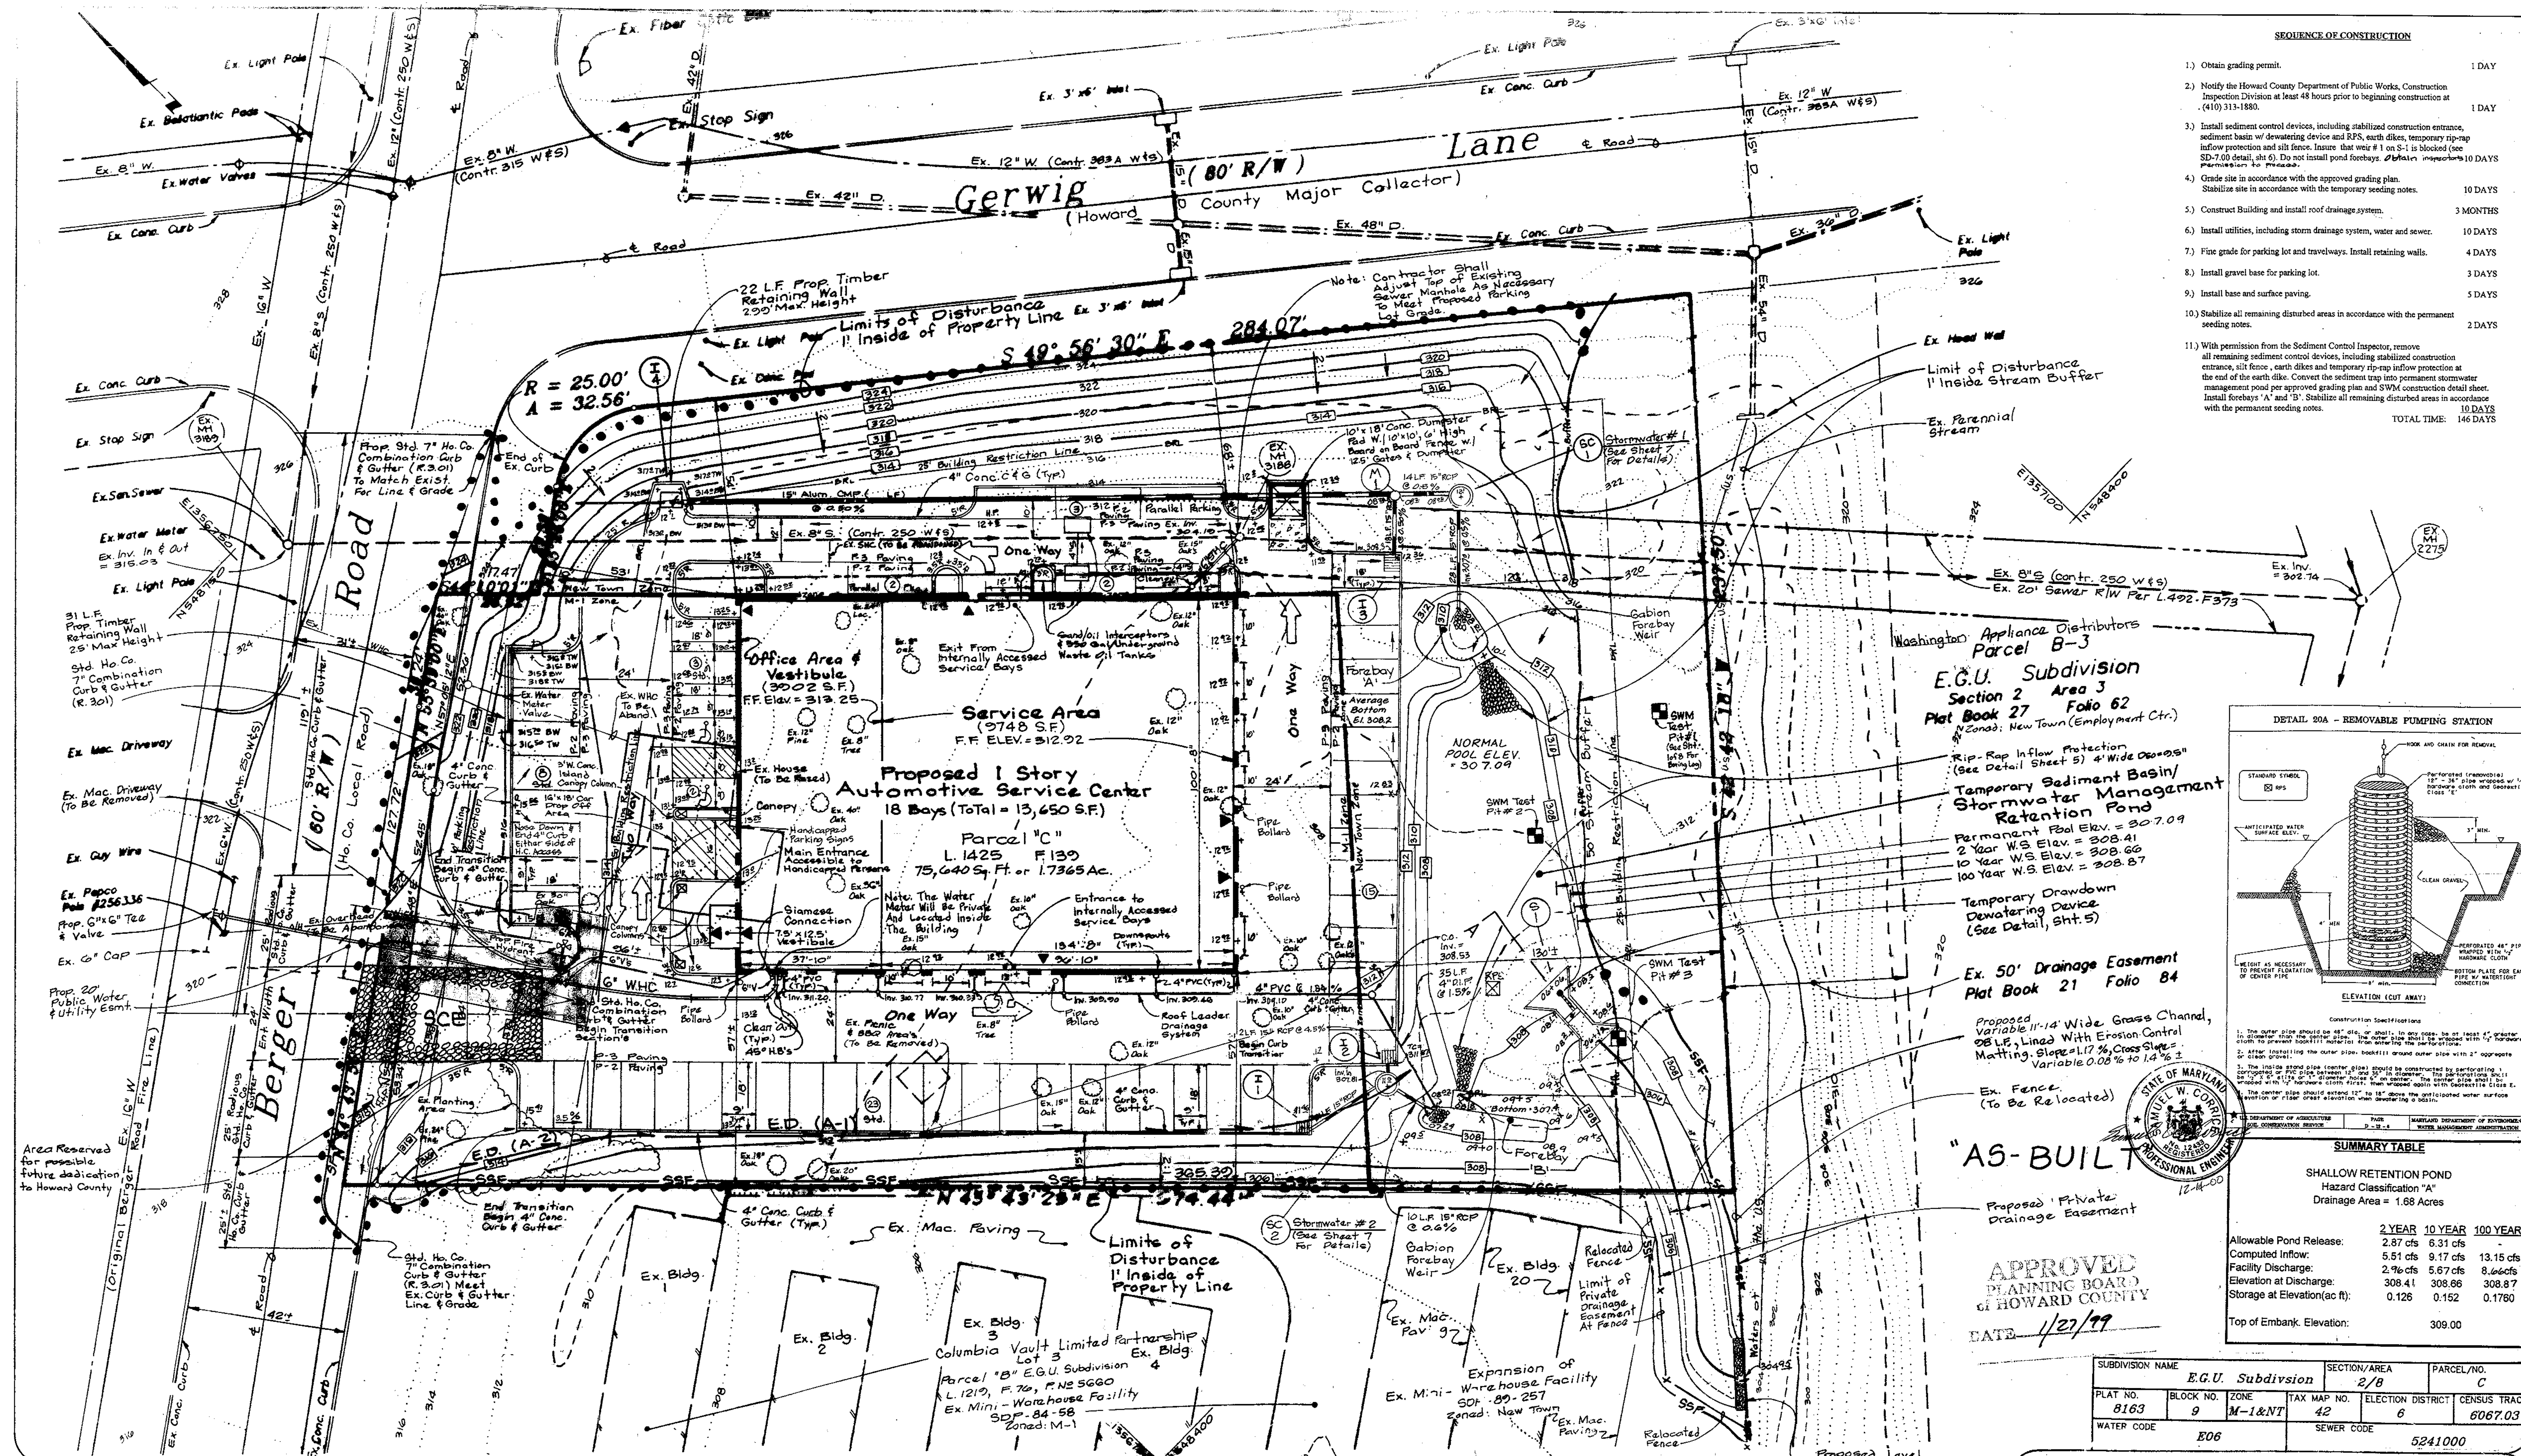

SUMMARY TABLE

SHALLOW RETENTION POND
 Hazard Classification "A"
 Drainage Area = 1.88 Acres

	2 YEAR	10 YEAR	100 YEAR
Allowable Pond Release:	2.87 cfs	6.31 cfs	13.15 cfs
Computed Inflow:	5.51 cfs	9.17 cfs	13.15 cfs
Facility Discharge:	2.9% cfs	5.67 cfs	8.66 cfs
Elevation at Discharge:	308.41	308.66	308.87
Storage at Elevation (ac ft):	0.126	0.152	0.1780
Top of Embank. Elevation:	309.00		

SUBDIVISION NAME		SECTION/AREA		PARCEL NO.
E.G.U. Subdivision		2/B		C
PLAT NO.	BLOCK NO.	ZONE	TAX MAP NO.	ELECTION DISTRICT
8163	9	M-1N7	42	6
WATER CODE		SEWER CODE		
E06		5241000		

APPROVED: DEPARTMENT OF PLANNING AND ZONING

3/1/99

CINDY HAMMILL
 CHIEF, DIVISION OF LAND DEVELOPMENT

3/1/99

3/1/99

THESE PLANS HAVE BEEN REVIEWED FOR THE HOWARD SOIL CONSERVATION DISTRICT AND MEET THE TECHNICAL REQUIREMENTS.

3/3/99

HOWARD SOIL CONSERVATION DISTRICT

3/3/99

THIS DEVELOPMENT PLAN IS APPROVED FOR SOIL EROSION AND SEDIMENT CONTROL BY THE HOWARD SOIL CONSERVATION DISTRICT.

3/3/99

ENGINEER'S CERTIFICATE

I HEREBY CERTIFY THAT THE SOIL CONSERVATION AND SEDIMENT CONTROL REPRESENTS A PRACTICAL AND FEASIBLE PLAN AND THAT MY PERSONAL KNOWLEDGE OF THE SITE AND THE INFORMATION I WAS PREPARED IN ACCORDANCE WITH REQUIREMENTS OF THE HOWARD SOIL CONSERVATION DISTRICT.

2/24/99

DEVELOPER'S CERTIFICATE

I HEREBY CERTIFY THAT ALL DEVELOPMENT AND/OR CONSTRUCTION WILL BE DONE ACCORDING TO THESE PLANS AND THAT ANY PERSONAL KNOWLEDGE OF THE SITE AND THE INFORMATION I WAS PREPARED IN ACCORDANCE WITH REQUIREMENTS OF THE HOWARD SOIL CONSERVATION DISTRICT.

2/23/99

STATE OF MARYLAND

PROFESSIONAL ENGINEER

2/24/99

Sediment Basin Schedule

Basin No.	Max. D.A. Acres	Dry Req'd R ² D	Wet Req'd R ² D	Dry Prov'D R ² D	Wet Prov'D R ² D	Stor. Depth ft.	Wet Elev. ft.	Wet Length ft.	Bottom Elev. ft.	Clean. Elev. ft.	Weir Depth ft.	Top Elev. ft.	Basin Size	Type
1	1.88	3024	3024	3024	3024	1.8	307.9	307.1	306	306.8	1.1	309	see plan	Basin

Top of embankment elevation.
 Concrete outlet structure consists of a 55" weir, Inv.=307.9 and a 4.0' weir, Inv.=308.38.

REVISIONS

No.	Date	By	Description
1	4-28-99	SMC	Revised H.C. Marking and Associated grading in front of building for revised canopy column locations added (1) parking space on east of building, and revised exterior bollard locations.
2	2/01	LDE	Removed parking lot island, south side of building.

LDE, INC.
 9250 Rumsey Road, Suite 106, Columbia, MD 21045
 (410) 715-1070 (301) 596-3424 (410) 715-9540 (Fax)

DESIGNED: Grading and Sediment Control Plan
 SDH


DRAWN: British And American Auto Care, Inc.
 SMC

CHECKED: Columbia E.G.U. Subdivision
 B.D.B.

DATE: Tax Map 42, P/O Parcel 386, Grid 9
 7/98
 4/98

Owner/Developer: British And American Auto Care, Inc.
 9235 Berger Road
 Columbia, Maryland 21046
 (410) 381-2700

SCALE: 1" = 20'
 DRAWING: 3 of 9
 JOB NO.: 98-010
 FILE NO.: SDP 98-132

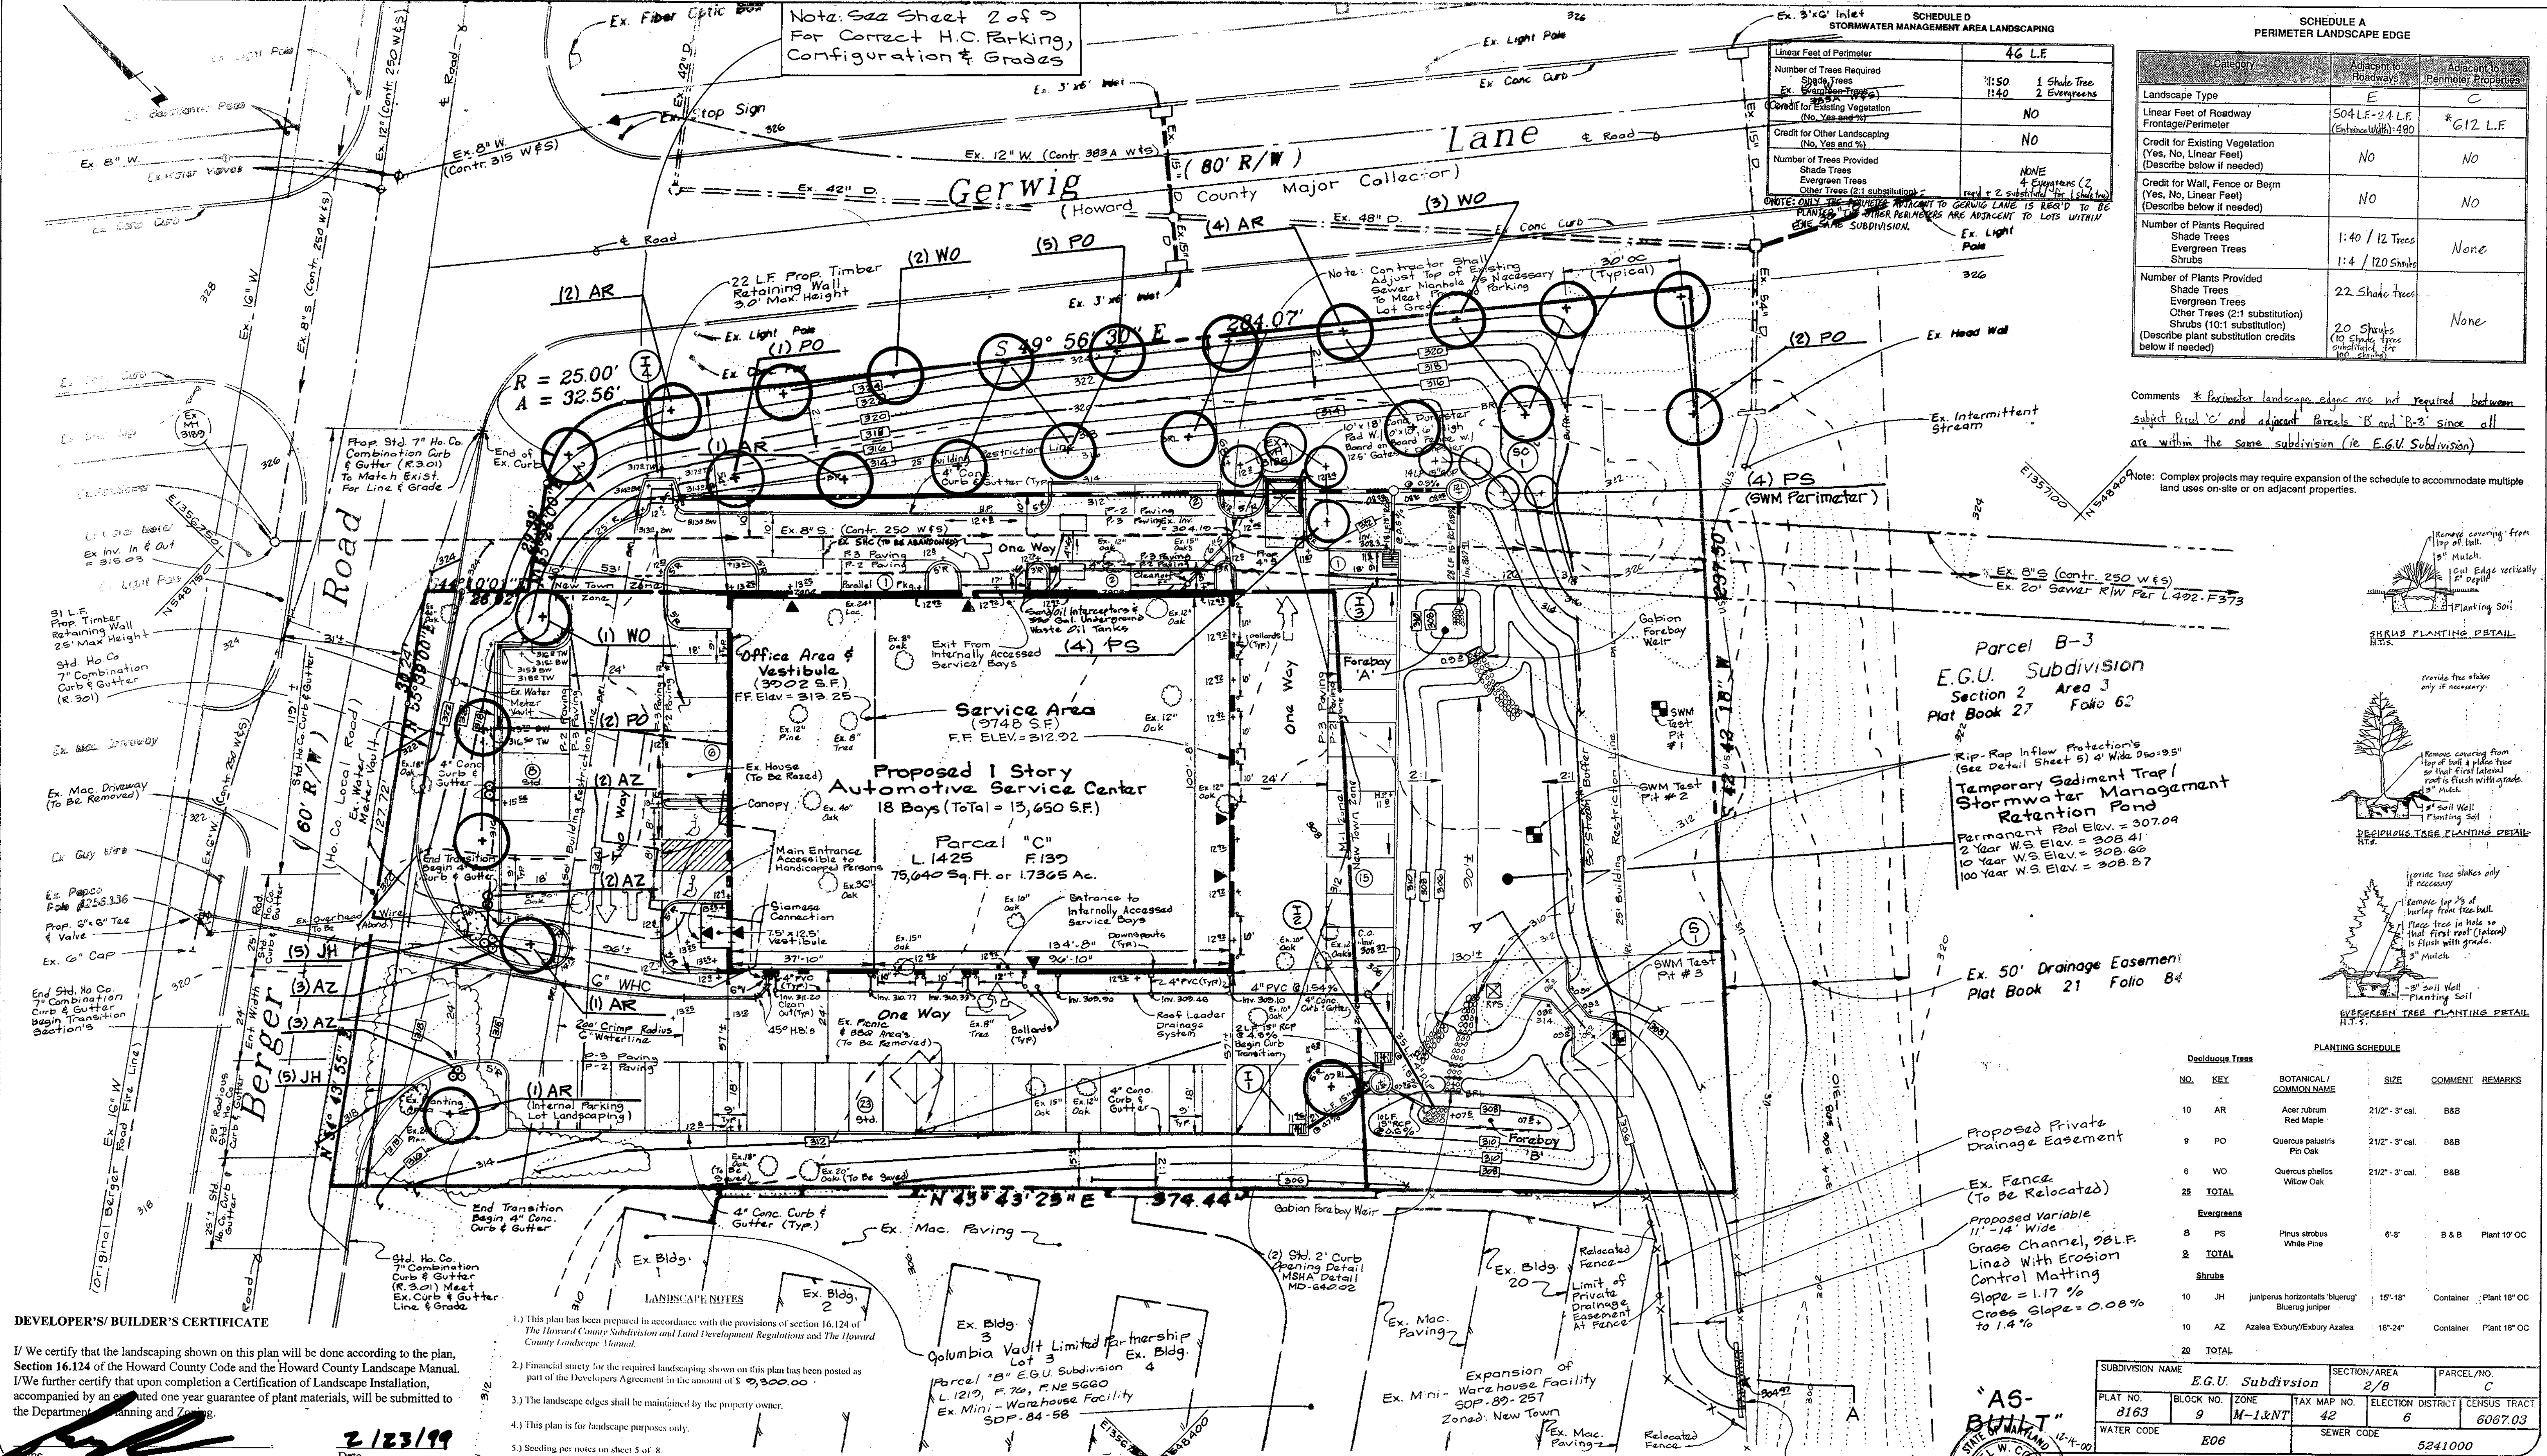

Note: See Sheet 2 of 3 For Correct H.C. Parking, Configuration & Grades

SCHEDULE D STORMWATER MANAGEMENT AREA LANDSCAPING

Linear Feet of Perimeter	46 L.F.
Number of Trees Required	1:50 1 Shade Tree 1:40 2 Evergreens
Credit for Existing Vegetation (No, Yes and %)	NO
Credit for Other Landscaping (No, Yes and %)	NO
Number of Trees Provided	NONE
Shade Trees	None
Evergreen Trees	None
Other Trees (2:1 substitution)	None


NOTE: ONLY THE PERIMETER ADJACENT TO GERWIG LANE IS REQUIRED TO BE PLANTED. ALL OTHER PERIMETERS ARE ADJACENT TO LOTS WITHIN THE SAME SUBDIVISION.

SCHEDULE A PERIMETER LANDSCAPE EDGE

Category	Adjacent to Roadways	Adjacent to Perimeter Properties
Landscape Type	E	C
Linear Feet of Roadway Frontage/Perimeter	504 L.F. - 24 L.F. (Excludes 480)	* 612 L.F.
Credit for Existing Vegetation (Yes, No, Linear Feet) (Describe below if needed)	NO	NO
Credit for Wall, Fence or Berm (Yes, No, Linear Feet) (Describe below if needed)	NO	NO
Number of Plants Required	1:40 / 12 Trees	None
Shade Trees	1:4 / 120 Shrubs	None
Evergreen Trees		
Shrubs		
Number of Plants Provided	22 Shade Trees	None
Shade Trees	20 Shrubs	None
Evergreen Trees		
Other Trees (2:1 substitution)		
Shrubs (10:1 substitution)		
(Describe plant substitution credits below if needed)		

Comments: * Perimeter landscape edges are not required between subject Parcel 'C' and adjacent Parcels 'B' and 'D' since all are within the same subdivision (i.e. E.G.U. Subdivision)

Note: Complex projects may require expansion of the schedule to accommodate multiple land uses on-site or on adjacent properties.

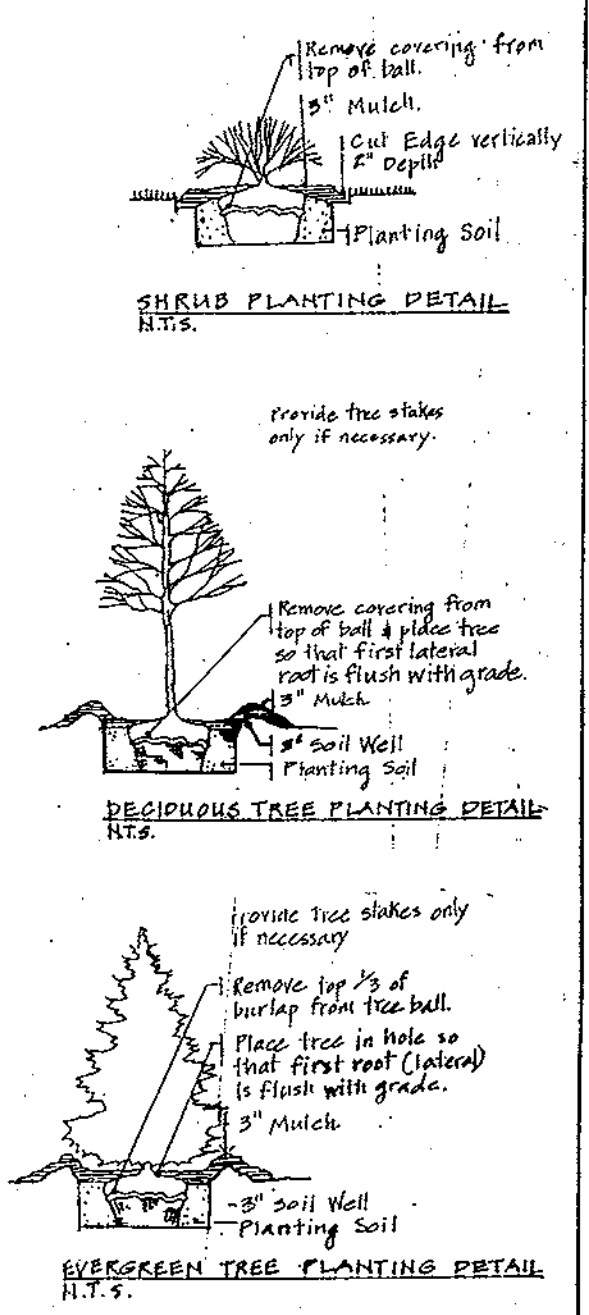

Parcel B-3
E.G.U. Subdivision
Section 2 Area 3
Plat Book 27 Folio 62

Temporary Sediment Trap/
Stormwater Retention Pond
Permanent Pool Elev. = 307.04
2 Year W.S. Elev. = 308.41
10 Year W.S. Elev. = 308.66
100 Year W.S. Elev. = 308.87

Ex. 50' Drainage Easement/
Plat Book 21 Folio 84

DEVELOPER'S/BUILDER'S CERTIFICATE

I/We certify that the landscaping shown on this plan will be done according to the plan, Section 16.124 of the Howard County Code and the Howard County Landscape Manual. I/We further certify that upon completion a Certification of Landscape Installation, accompanied by an estimated one year guarantee of plant materials, will be submitted to the Department of Planning and Zoning.

Date: 2/23/99

LANDSCAPE NOTES

- This plan has been prepared in accordance with the provisions of section 16.124 of the Howard County Subdivision and Land Development Regulations and the Howard County Landscape Manual.
- Financial surety for the required landscaping shown on this plan has been posted as part of the Developers Agreement in the amount of \$ 9,500.00.
- The landscape edges shall be maintained by the property owner.
- This plan is for landscape purposes only.
- Seeding per notes on sheet 5 of 8.

Ex. Bldg. 3
Columbia Vault Limited Partnership
Lot 3
Parcel 'B' E.G.U. Subdivision
L 1219, F. 70, P. N.E. 5600
Ex. Mini-Warehouse Facility
SDP-84-58

SCHEDULE B PARKING LOT INTERNAL LANDSCAPING

Number of Parking Spaces	58
Number of Trees Required	1 Shade Tree / 20 Spaces = 3
Number of Trees Provided	3 Shade Trees
Shade Trees	
Other Trees (2:1 substitution)	

APPROVED PLANNING BOARD OF HOWARD COUNTY

DATE: 1/27/99

LDE, INC.
2550 Rumsey Road, Suite 106, Columbia, MD 21045
(410) 715-1070 (301) 596-3424 (410) 715-9540 (Fax)

Scale: 1" = 20'

British And American Auto Care, Inc.
Columbia
E.G.U. Subdivision
Parcel "C"

Job No. 98-010
File No. SDP-98-132

APPROVED: DEPARTMENT OF PLANNING AND ZONING

DATE: 2/23/99

DATE: 3/3/99

DATE: 3/1/99

ENGINEER'S CERTIFICATE

I HEREBY CERTIFY THAT THE PERIMETER AND SEDIMENT CONTROL REPRESENTS A PRACTICAL AND FEASIBLE SOLUTION BASED ON MY PERSONAL KNOWLEDGE OF THE SITE. THIS PROJECT WAS PREPARED IN ACCORDANCE WITH REQUIREMENTS OF THE HOWARD COUNTY LANDSCAPE DISTRICT.

DATE: 2/24/99

DEVELOPER'S CERTIFICATE

I/WE CERTIFY THAT ALL DEVELOPMENT AND/OR CONSTRUCTION WILL BE DONE ACCORDING TO THESE PLANS AND THAT ANY RESPONSIBLE PERSONNEL INVOLVED IN THE CONSTRUCTION PROJECT WILL HAVE A CERTIFICATE OF ATTENDANCE AT A DEPARTMENT OF THE ENVIRONMENT APPROVED TRAINING PROGRAM FOR THE CONTROL OF SEDIMENT AND EROSION. I/WE ALSO AGREE TO PERIODIC ON-SITE INSPECTION BY THE HOWARD COUNTY LANDSCAPE DISTRICT OR THEIR AUTHORIZED AGENTS, AS DEEMED NECESSARY.

DATE: 2/23/99

REVISIONS

No.	Date	By	Description
1	4/28/98	SDH	Added Note: See Sht 28D
2	2/2/99	SMC	For Correct H.C. Parking, Configuration & Grades
3	2/2/99	SMC	Amended parking lot island, relocated (1) PO to near I-4

NOTE: THE AMENDED LANDSCAPE MANUAL, DATED MARCH 2, 1998 STATES THAT SWM PERIMETER LANDSCAPING IS REQUIRED IN ALL ZONING DISTRICTS EXCEPT M-1 AND M-2. THIS SITE IS ZONED BOTH M-1 AND NEW TOWN. EMPLOYMENT CENTER. THE INTENT IS TO DEVELOP THE ENTIRE SITE AS AN AUTOMOTIVE SERVICE FACILITY, AN M-1 TYPE USE. THE CHARACTER OF THE EXISTING AREA IS ENTIRELY COMMERCIAL/INDUSTRIAL. THEREFORE IT WOULD NOT BE IN KEEPING WITH THE CHARACTER OF THE AREA TO PROVIDE STORMWATER MANAGEMENT PERIMETER LANDSCAPING. THEREFORE, STORMWATER MANAGEMENT PERIMETER PLANTINGS HAVE NOT BEEN PROVIDED.

OWNER/DEVELOPER

British And American Auto Care, Inc.
2550 Rumsey Road
Columbia, Maryland
(410) 381-2700