

LITTLE PATUXENT

LANE

PARKWAY




CEDAR

SIGN "A"
YIELD
WHEN TURNING
ON GREEN
36" x 48" RI-2C

SIGN "B"
LEFT
TURN
SIGNAL
24" x 36"
RIO-10

WIRING DIAGRAM
(NOT TO SCALE)

- A 2-CONDUCTOR CABLE (ALUM SHIELDED) - PROPOSED
- B 2-CONDUCTOR CABLE (ALUM SHIELDED) - PROPOSED
- C 2-CONDUCTOR CABLE (ALUM. SHIELDED) - EXISTING
- ~~D 2-CONDUCTOR CABLE (ALUM. SHIELDED) - PROPOSED~~
- E 2-CONDUCTOR CABLE (ALUM SHIELDED) - PROPOSED
- ~~F 2-CONDUCTOR CABLE (ALUM. SHIELDED) - PROPOSED~~
- ~~G 2-CONDUCTOR CABLE (ALUM SHIELDED) - PROPOSED~~
- H 2-CONDUCTOR CABLE (ALUM SHIELDED) - PROPOSED
- I 5-CONDUCTOR CABLE (NO 14 AWG) - EXIST
- J 5-CONDUCTOR CABLE (NO 14 AWG) - EXIST
- K 5-CONDUCTOR CABLE (NO 14 AWG) - EXIST
- L 5-CONDUCTOR CABLE (NO 14 AWG) - EXIST
- M 7-CONDUCTOR CABLE (NO 14 AWG) - PROP
- N 7-CONDUCTOR CABLE (NO 14 AWG) - PROP
- O 5-CONDUCTOR CABLE (NO 14 AWG) - EXIST
- P 5-CONDUCTOR CABLE (NO 14 AWG) - PROP
- Q 5-CONDUCTOR CABLE (NO 14 AWG) - EXIST
- R 5-CONDUCTOR CABLE (NO 14 AWG) - EXIST

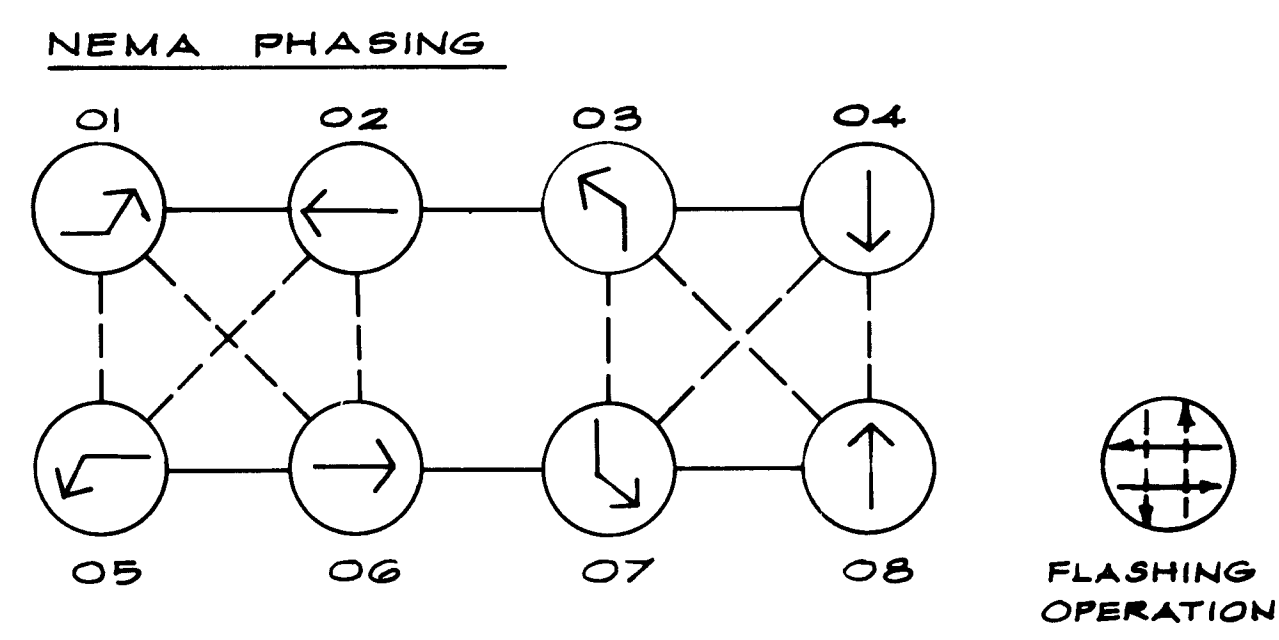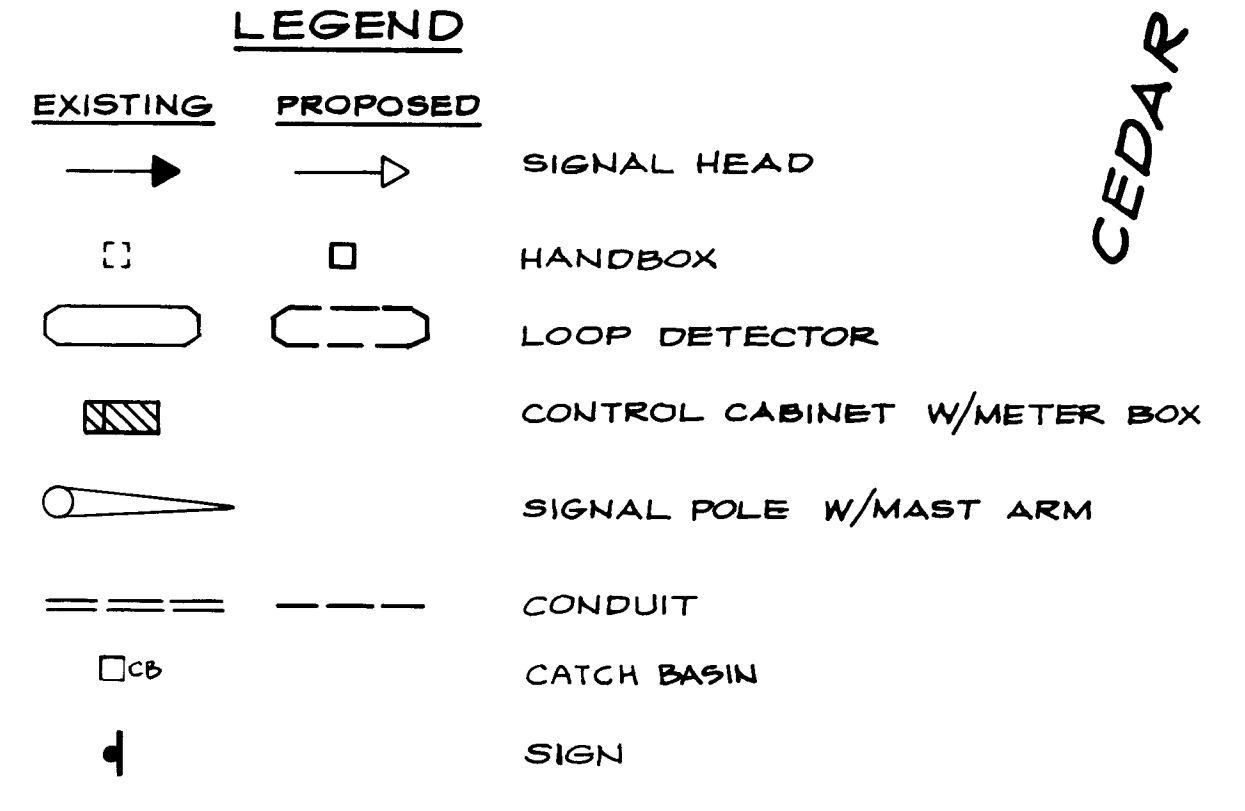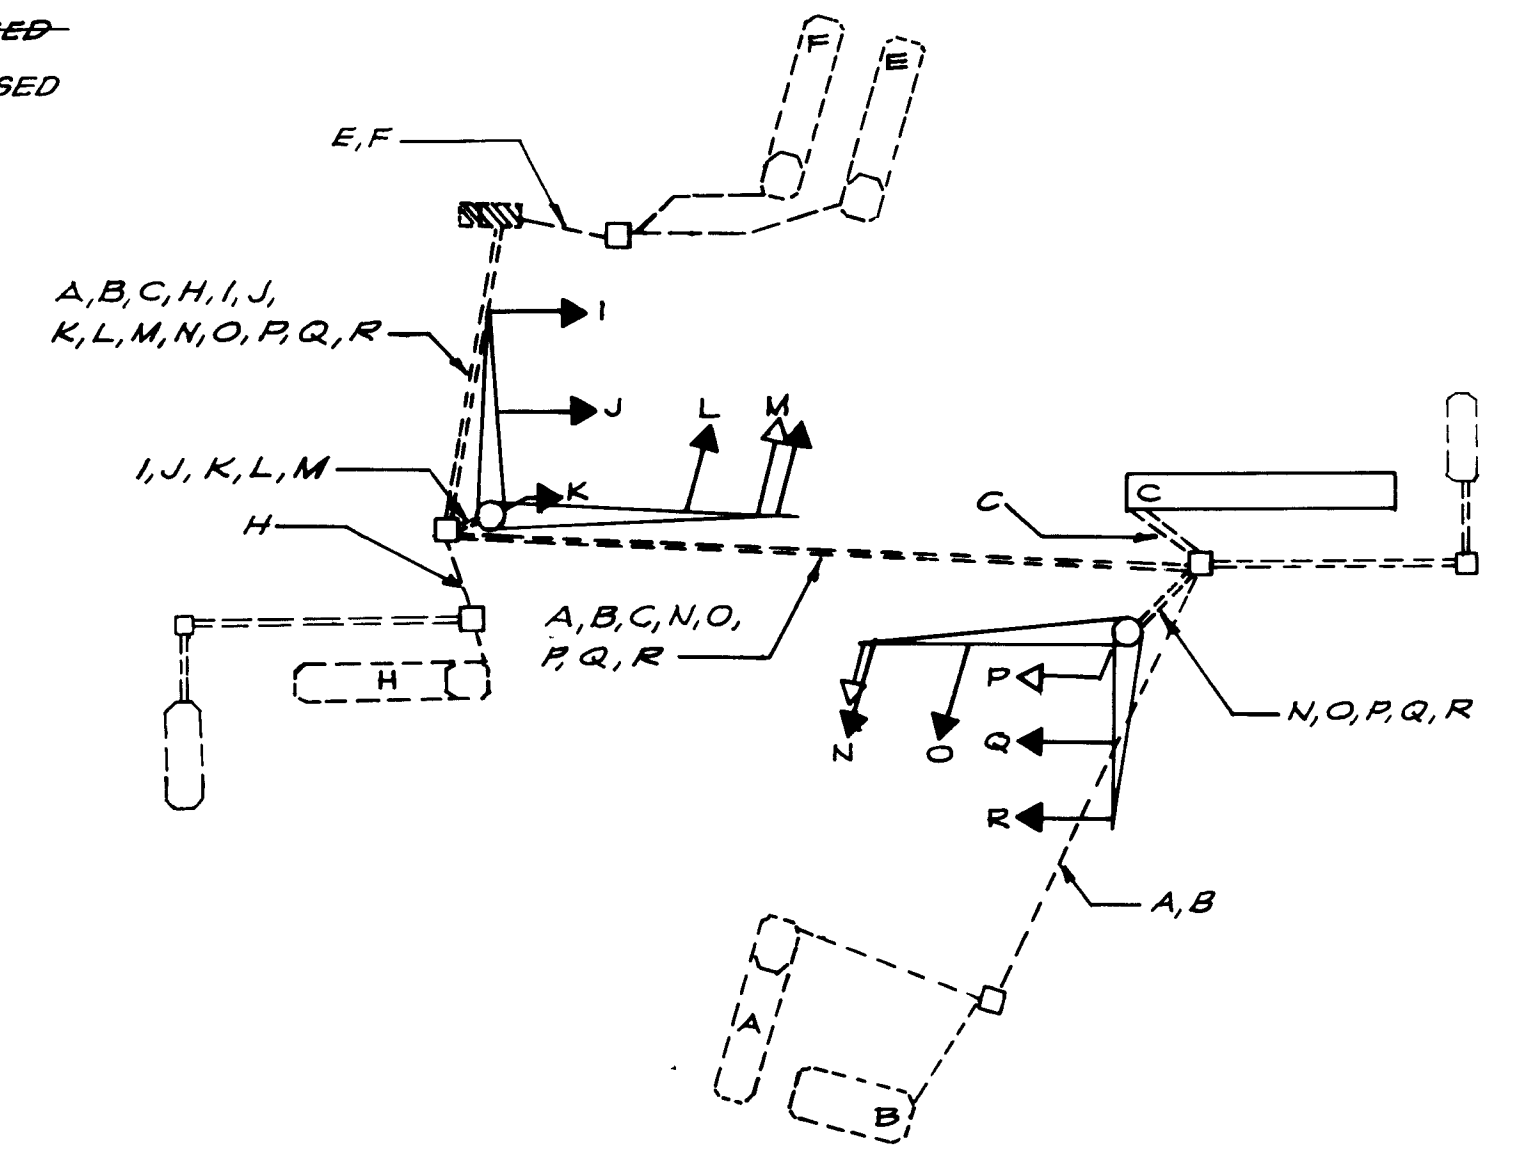

- 1 PHASES ASSOCIATED BY A SOLID LINE WILL NOT OPERATE CONCURRENTLY
- 2 PHASES ASSOCIATED BY A DASHED LINE MAY/WILL OPERATE CONCURRENTLY
- 1 REMAINS IF PHASE B FOLLOWS PHASE A
- 2 REMAINS IF PHASE B ALT FOLLOWS PHASE A
- 3 REMAINS IF PHASE E ALT. FOLLOWS PHASE D.
- 4 REMAINS IF PHASE E FOLLOWS PHASE D

PHASE, SEQUENCE & TIMING DIAGRAM	TRAFFIC SIGNAL HEADS										MIN GREEN	PASSAGE	YELLOW	RED CLEARANCE	MAX I	MAX II	SECONDS PER ACTUATION	TIME TO REDUCTION	TIME BEFORE REDUCTION	MIN GAP	RECALL	MEMORY	
	(R)	(R)	(R)	(R)	(R)	(R)	(R)	(R)	(R)	(R)													
	(Y)	(Y)	(Y)	(Y)	(Y)	(Y)	(Y)	(Y)	(Y)	(Y)													
↙	PHASE A	R	R		R			R	R	R	R	3	3		15	10					OFF	NON LOCK	
	PHASE A CLEAR	R	R		R			R	R	R	R			4									
↘	PHASE B	G	G		R	R	R	R	R	R	R	3	3		30	20					OFF	NON LOCK	
	PHASE B CLEAR	Y	Y		R	R	R	R	R	R	R			4									
↔	PHASE B ALT	R	R	R	R	R		G	G	R	R	3	3		30	15					OFF	NON LOCK	
	PHASE B ALT CLEAR	R	R	R	R	R		Y	Y	R	R			4									
→	PHASE C	G	G	R	R	R	R	G	G	R	R	7	3		30	20	1.5	15	20	30	ON	LOCK	
	PHASE C CLEAR	Y	Y	R	R	R	R	Y	Y	R	R			4									
↖	PHASE D	R	R	R		R	R	R	R	R		3	3		15	10					OFF	NON LOCK	
	PHASE D CLEAR	R	R	R		R	R	R	R	R				4									
↗	PHASE E	R	R	R	R	R	R	R	R	G	G	3	3		15	10					OFF	NON LOCK	
	PHASE E CLEAR	R	R	R	R	R	R	R	R	G	Y	G			4								
↕	PHASE E ALT	R	R	R		G	G	R	R	R	R	3	3		15	10					OFF	NON LOCK	
	PHASE E ALT CLEAR	R	R	R		Y	Y	R	R	R	R			4									
↔↔	PHASE F	R	R	R	G	G	R	R	R	G	G	3	3		30	25					OFF	NON LOCK	
	PHASE F CLEAR	R	R	R	Y	Y	R	R	R	Y	Y			4									
↔↔↔	FLASH OPER	FL/Y	FL/Y	FL/R	FL/R	FL/R	FL/R	FL/Y	FL/Y	FL/R	FL/R												

SCALE 1" = 30'

DEPARTMENT OF PUBLIC WORKS
HOWARD COUNTY, MARYLAND

George F. Neumy
DIRECTOR OF PUBLIC WORKS
DATE 2-19-87

Chief, Bureau of Engineering
DATE 2/18/87
Chief, Roads, Bridges & Storm Drainage Division
DATE

ARI ENGINEERING
8150 Leesburg Pike Suite 503
Vienna, Virginia 22180
(703) 442-0202

DES PAP	
DRN A CM	
CHK RHP	
DATE FEB 87	BY NO
REVISION	DATE

TRAFFIC SIGNAL PLAN
LITTLE PATUXENT PARKWAY
AT CEDAR LANE
TF 227

LITTLE PATUXENT PARKWAY
INTERSECTION IMPROVEMENT
CAPITAL PROJECT NO T-7033
ELECTION DISTRICT NO 3
HOWARD COUNTY, MARYLAND

SCALE AS SHOWN
SHEET 2 OF 4