

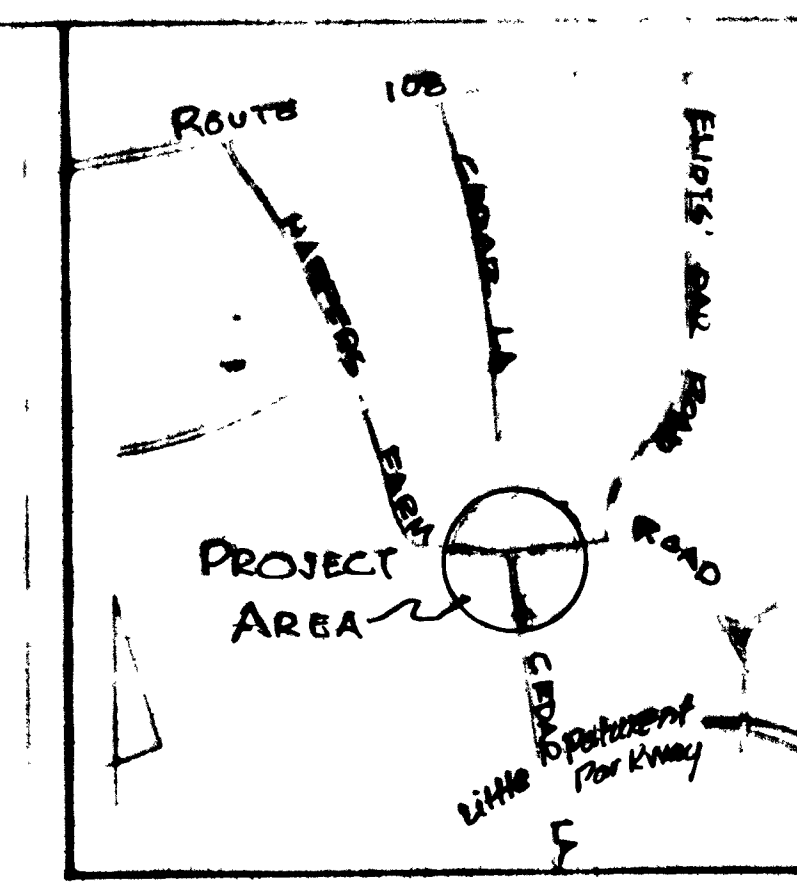


PHASE & SEQUENCE DIAGRAM	TRAFFIC SIGNAL HEADS			
	2	1,5	3,4	6,7
	(R)	(R)	(R)	(R)
	(A)	(A)	(A)	(A)
	(G)	(G)	(G)	(R)
	(A)	(A)	(A)	(R)
	(R)	(R)	(R)	(G)
	(R)	(R)	(R)	(A)
FLASH PHASE	F/A	F/A	F/A	F/R

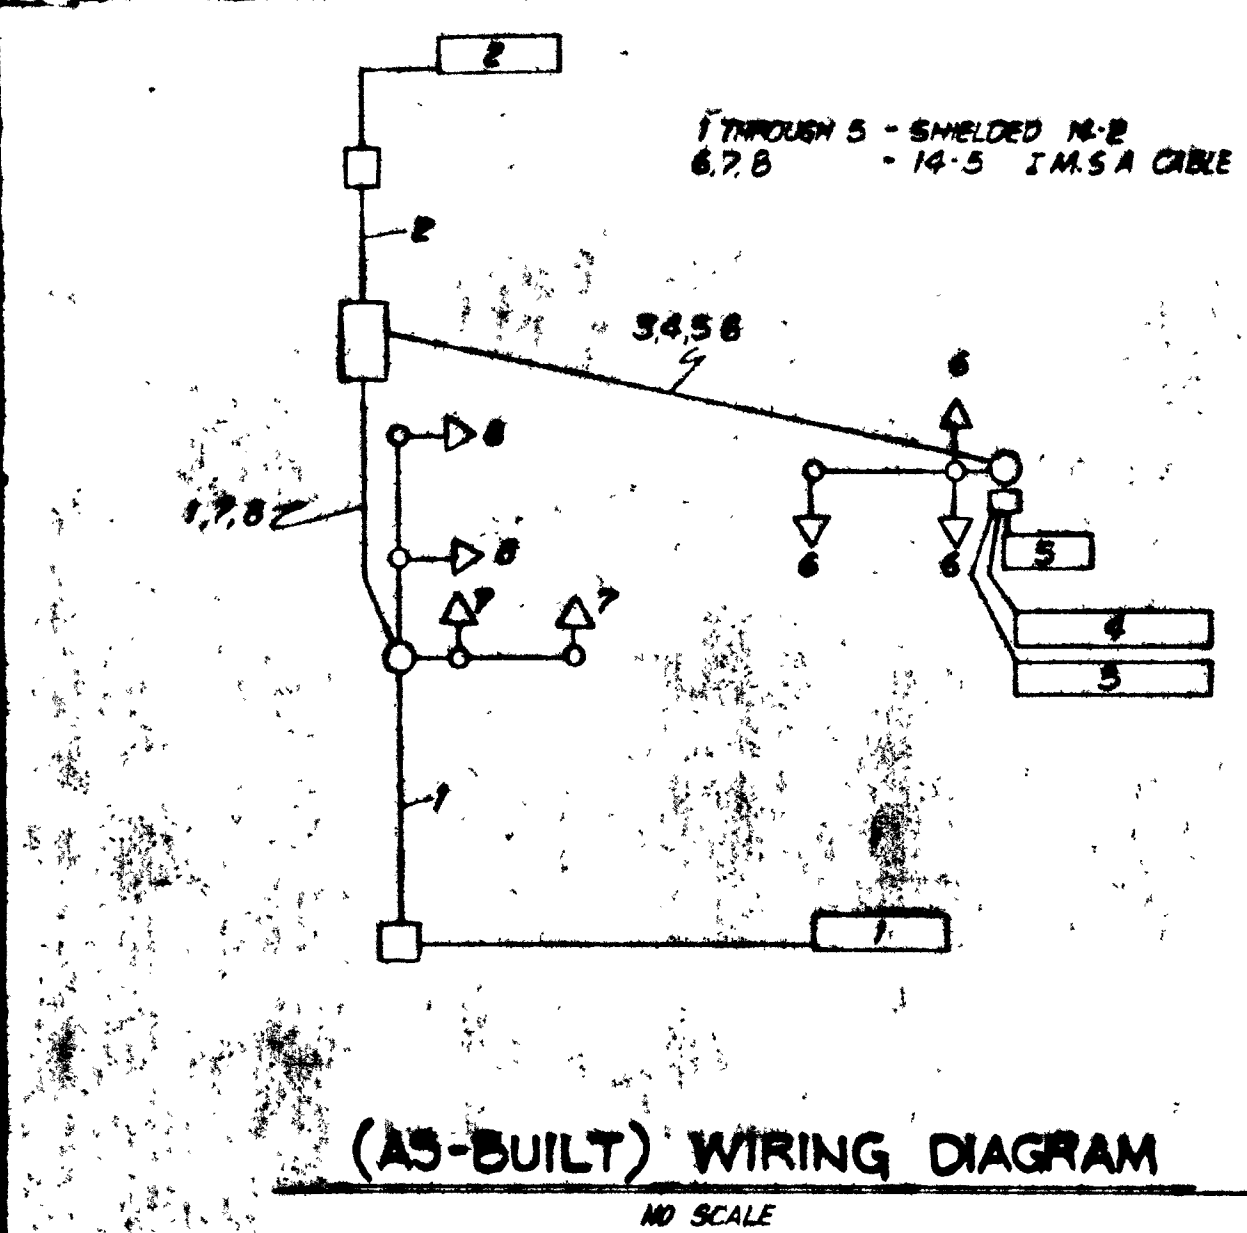

VICINITY  
Scale 1"=2000'

- SYMBOLS**
- Signal Heads
  - Vehicle Loop Detector
  - ⊠ Hand Box
  - ⊞ Meter
  - ⊞ Control Cabinet
  - Steel Pole (Proposed)
  - Street Light (Existing)

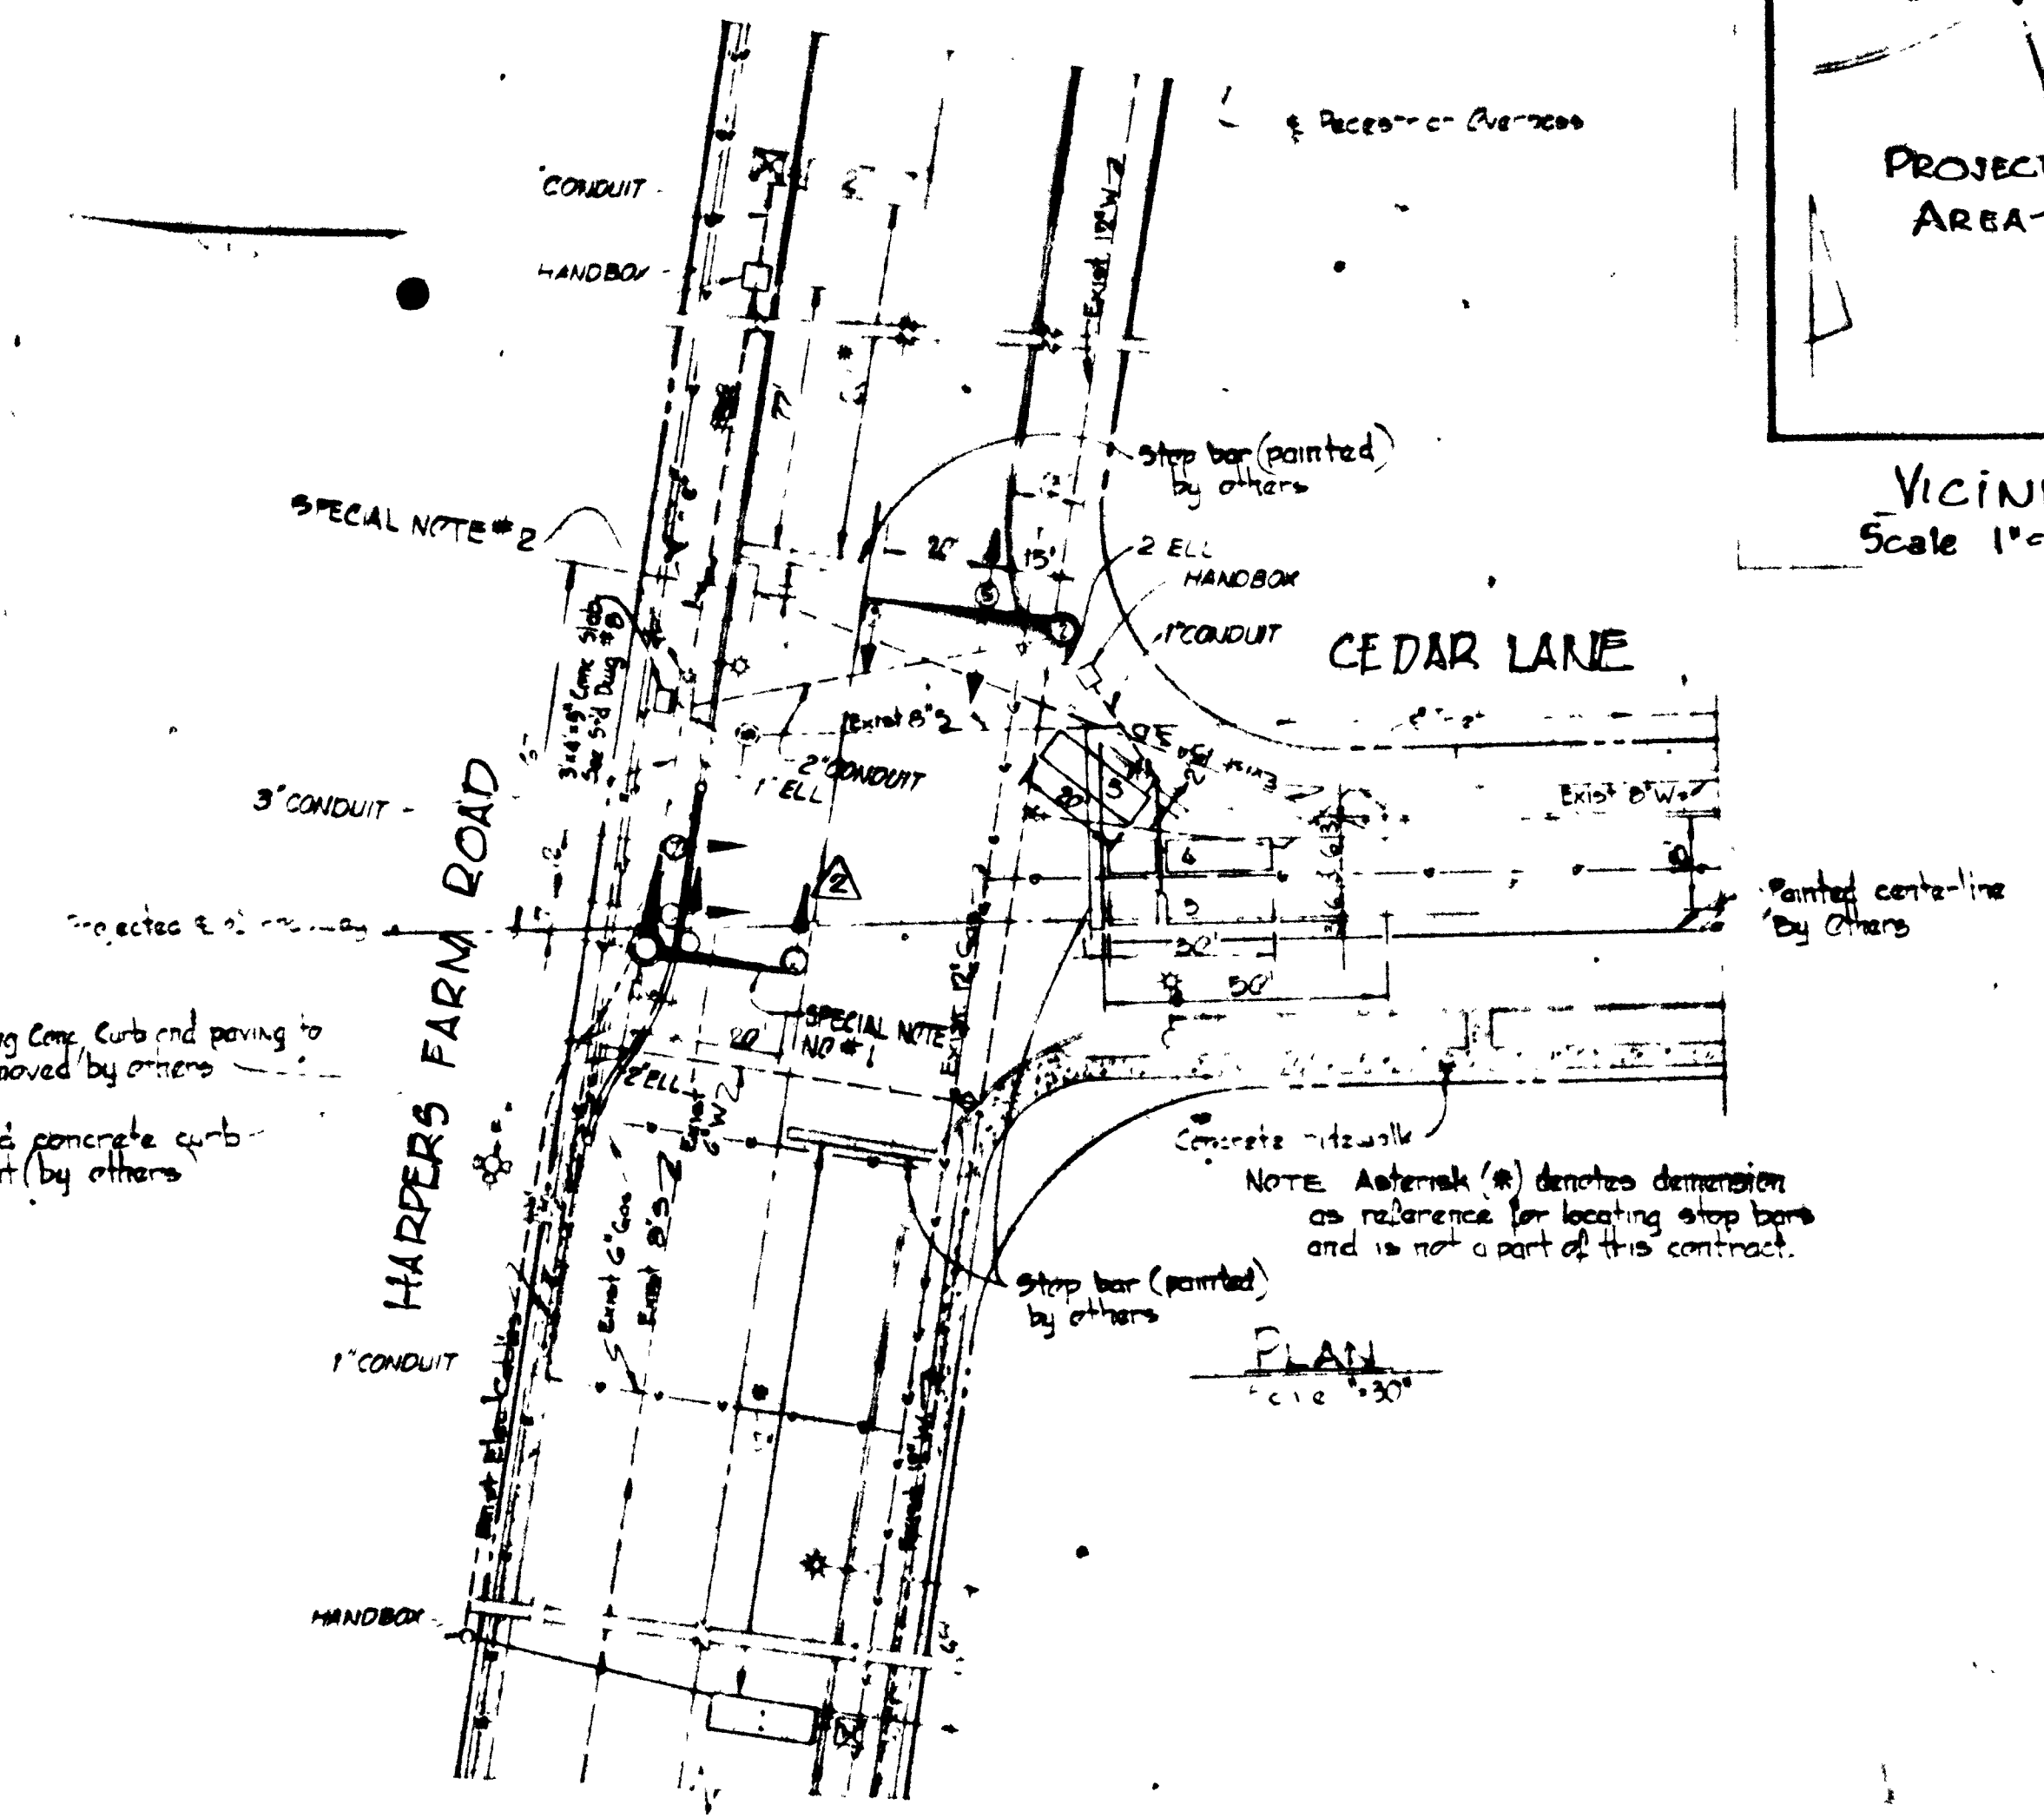

(AS-BUILT) WIRING DIAGRAM  
NO SCALE

**EXISTING EQUIPMENT LIST**  
SEE PAGE 9-11 OF SPECIFICATIONS FOR MAKE/MODEL

- A CONTROLLER**
- 1 Fully actuated two (2) phase solid state digital modulator controller expandable to three (3) vehicle phases fully actuated plus all red pedestrian phase actuated
  - 2 Memory and recall for each phase
  - 3 Standard Police Panel (ref. 4.8.A.10 General Specifications) without manual override
  - 4 All red clearance interval for each phase
  - 5 Conflict monitor with solid state signal loading switches
  - 6 Two (2) Loop detector amplifiers (standard)
  - 7 Minimum acceptable adjustment ranges
    - a) Major & Minor street initial period and unit extension 2-30 sec
    - b) Major & Minor street extension 10-60 sec
    - c) Vehicle clearance interval and all red clearance interval 4p/10 sec
  - 8 Base mounted control cabinet large enough to accommodate the ultimate 3 phase and pedestrian phase
  - 9 Control cabinet to be finished bronze
  - 10 Two loop detector amplifiers with adjustable delayed timer.
- C SIGNAL HEADS**
- 1 A signal heads shall have 12" red, 8" amber and 8" green indications with standard cap visors
- D. POLES - MAST ARM**
- | No. (see p. 11) | Description  |
|-----------------|--|
| 1               | Two arm support with 90° angle of separation, with 28' span supporting an ultimate 3 signal heads and the 16' span supporting 2 signal heads |
| 2               | Single arm 24' span supports 3 signal heads  |
- Poles Finish - Manufacturers prime coat with exterior bronze finish to be applied in the field
- Pole Design - Style and appearance equivalent to UNION METAL DESIGN 20300.
- E SPECIAL NOTE #1**
- Signal heads 1&2 must be mounted at a maximum clearance of 16' above the roadway surface to obtain maximum visibility from beyond Pedestrian Overpass
- F. SPECIAL NOTE #2**
- In accordance with the D.G.E. requirements, a impreg steel (12ga) or aluminum (12ga) enclosure with loop steel be provided for vandal protection.

- LEFT-TURN EQUIPMENT**
- A SIGNAL HEADS - STD. CAP VISORS**  
Remove existing signal head #2, and replace with 3 head. COMBINATION No. (see plan):  
Traffic Signal #2  
Size of indication:  
12" Red  
12" Amber, 12" Amber Arrow  
12" Green, 12" Green Arrow
- H. CONTROLLER MODIFICATIONS**  
Phase module(s), Solid State load switch(es)

**GENERAL NOTES**

- 1 The Contractor shall not be responsible for highway markings
- 2 The timing of the Traffic Signal System shall be furnished by the Traffic Engineer (Reference 4.7.9, General Specifications)
- 3 The Contractor shall comply with the General Specifications for Installation of and Equipment for Traffic Signals prepared by HOWARD COUNTY Dept. of Public Works, Bureau of Engineering, Division of Traffic Engineering - Oct. 1974 and Feb. 1976
- 4 The Contractor shall locate all underground utilities prior to construction as required
- 5 All disturbed areas shall be seeded and mulched.

Rev. No.	Revision Description	Rev. No.
3/24/81	LEFT TURN PHASES	
3-277	RELOCATED CONCRETE CURBS	
HOWARD COUNTY DEPARTMENT OF PUBLIC WORKS		
BUREAU OF ENGINEERING		
CAPITAL PROJECT T-1-7012		
TRAFFIC SIGNAL CONSTRUCTION PLAN		
AND EQUIPMENT LIST		
CAPITAL IMPROVEMENT PROJ. T-1-7012		
HARPERS FARM ROAD AT CEDAR LANE		
Scale as noted		
Date: 3/24/81		
Drawn: J.K. & DC		
Check: J.K. & DC		

#746