



Howard County Department Of Planning And Zoning

3430 Courthouse Drive ■ Ellicott City, Maryland 21043 ■ 410-313-2350

Marsha S. McLaughlin, Director

www.howardcountymd.gov

FAX 410-313-3467

TDD 410-313-2323

October 11, 2012

Mr. Warren Woo-Project Manager
BITHENERGY, Inc.
113 West Monument Street
Baltimore, MD. 21201

PHRA
ATTN: Mr. P. Stone
8818 Centre Park Drive
Columbia, MD. 21045

RE: WP-13-018 (Nixon Farms Solar-Phase I)

Dear Interested Parties:

The Department of Planning and Zoning hereby grants **approval** of the Supplemental Plan for WP-13-018 (Nixon Farms Solar-Phase I) for a 9.46-acre solar array farm located on Nixon's Farm Lane in the Third Election District of Howard County, Maryland. Signature of original drawings is complete.

Per the conditions of approval for WP-13-018, the following applies:

1. Within 1 year of waiver approval (**on or before August 28, 2013**), Forest Conservation of Phase 1 of the project will be addressed with the submission of the Site Development Plan for Phase 2 of the project which will address forest conservation requirements for both Phase 1 and 2; OR within 1 year of waiver approval (**on or before August 28, 2013**) a fee-in-lieu payment of \$78,212.00 (payable to the *Director of Finance of Howard County*) must be made to address the forest conservation obligation for Phase I of development consisting of a Limit of Disturbance of 9.46 acres (if a Site Development Plan for Phase 2 is not submitted within 1 year.)
Not yet completed

2. The LOD for Phase I of the project may Not exceed 9.46 acres as indicated on the waiver exhibit.
Reminder

3. A minimum landscape buffer (**Type 'C'**) shall be provided along the **entire** eastern portion of the solar array, along S00°31'59"W. This would equate to a buffer 953' in length (taking into account proposed credit areas) for a total of 24 shade trees and 48 evergreens for a total surety of \$14,400.00.
Not yet completed

4. A landscape surety of \$14,400.00 will be posted as part of the developer's agreement for this project.
Completed

5. A corrected waiver exhibit, (including an amended and signed (by the developer/builder) landscape plan which reflects changes to buffer type ('C' buffer-entire length of perimeter), plant lists, surety notes) and addressing all attached comments from the Division of Land Development shall be submitted to Planning and Zoning within 2 weeks of waiver approval (**on or before September 11, 2012**).
Completed

6. In accordance with the attached comments from the Development Engineering Division dated August 23, 2012, the developer agreements for the construction and maintenance of the stormwater management facility shall be executed by the developer and returned to the County (Real Estate Services Division-DPW) to be executed simultaneously with the signing of the Supplemental Plan for the Waiver Petition, within 45 days of waiver approval (**on or before October 12, 2012**).

Completed

7. The signature approved Supplemental Plan (Waiver Plan Exhibit) shall serve as the substitution for a Site Development Plan for development of Phase 1 for this project. All improvements shown on the signed plan exhibit must be constructed per the signature approved Supplemental Plan exhibit.

Reminder

8. The waiver petition shall apply only to the uses and structures described and as shown on the signature approved Supplemental Plan exhibit and not to any other activities, uses, structures or additions to this property.

Reminder

9. Compliance with all applicable County and State Regulations including all necessary permits from the Department of Inspections, Licenses and Permits (DILP) prior to initiating any on-site development is required. The signature approved Supplemental Plan exhibit shall be submitted for any permits required from DILP.

Reminder

If you have any questions, please contact me at (410) 313-2350 or email at tmaenhardt@howardcountymd.gov.


Sincerely,

Kent Sheubrooks, Chief
Division of Land Development



KS/tkm/waivers 2012/Nixon Farms Solar supp plan WP-13-018 signed 10-11-12

cc: Research
DED
Zoning-C. Hamilton
RES-T. Hackett
DILP-B. Francis
M. McLaughlin

NIXON FARMS SOLAR PHASE 1 SITE DEVELOPMENT PLAN 2800 NIXON'S FARM LANE WEST FRIENDSHIP, MD 21792

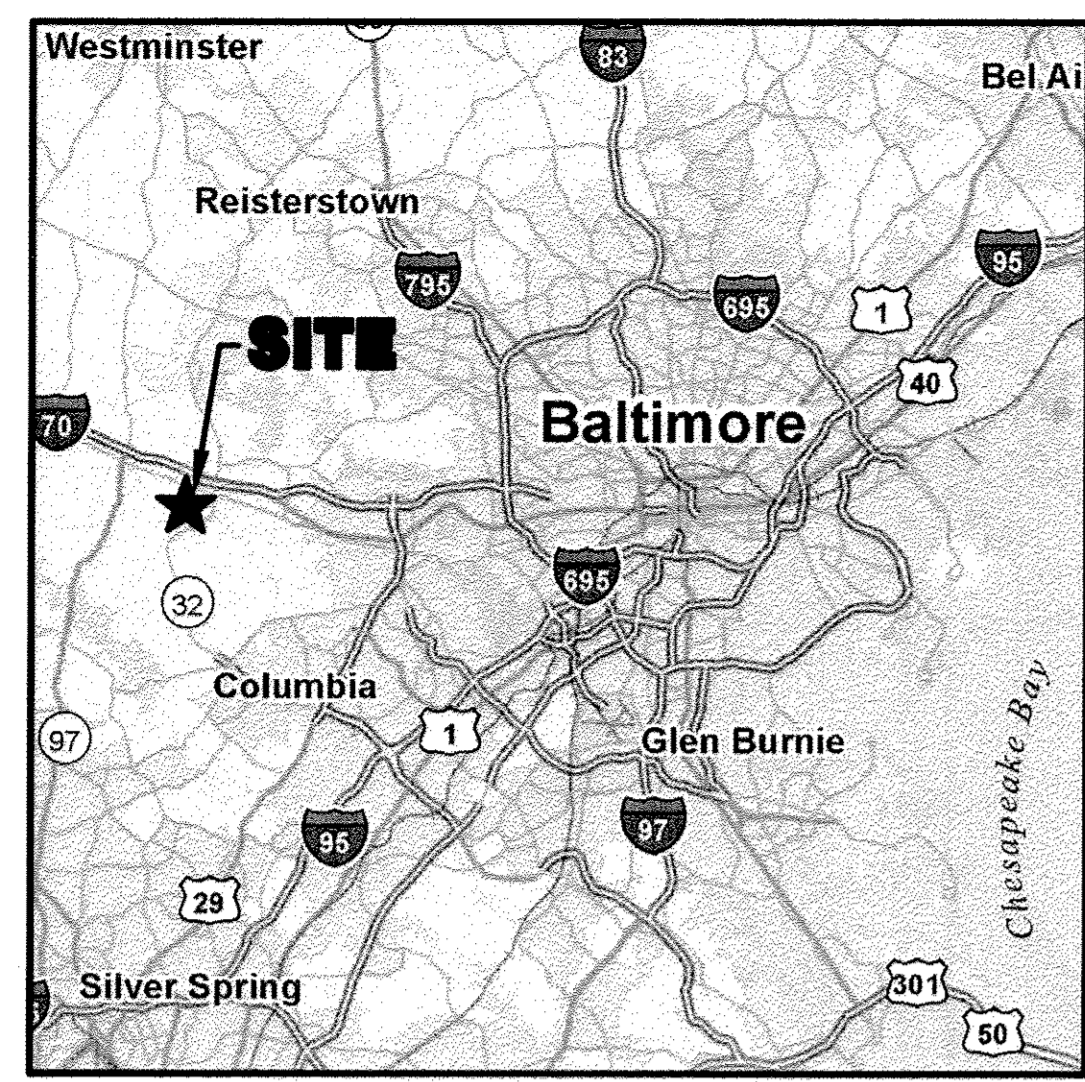

VICINITY MAP

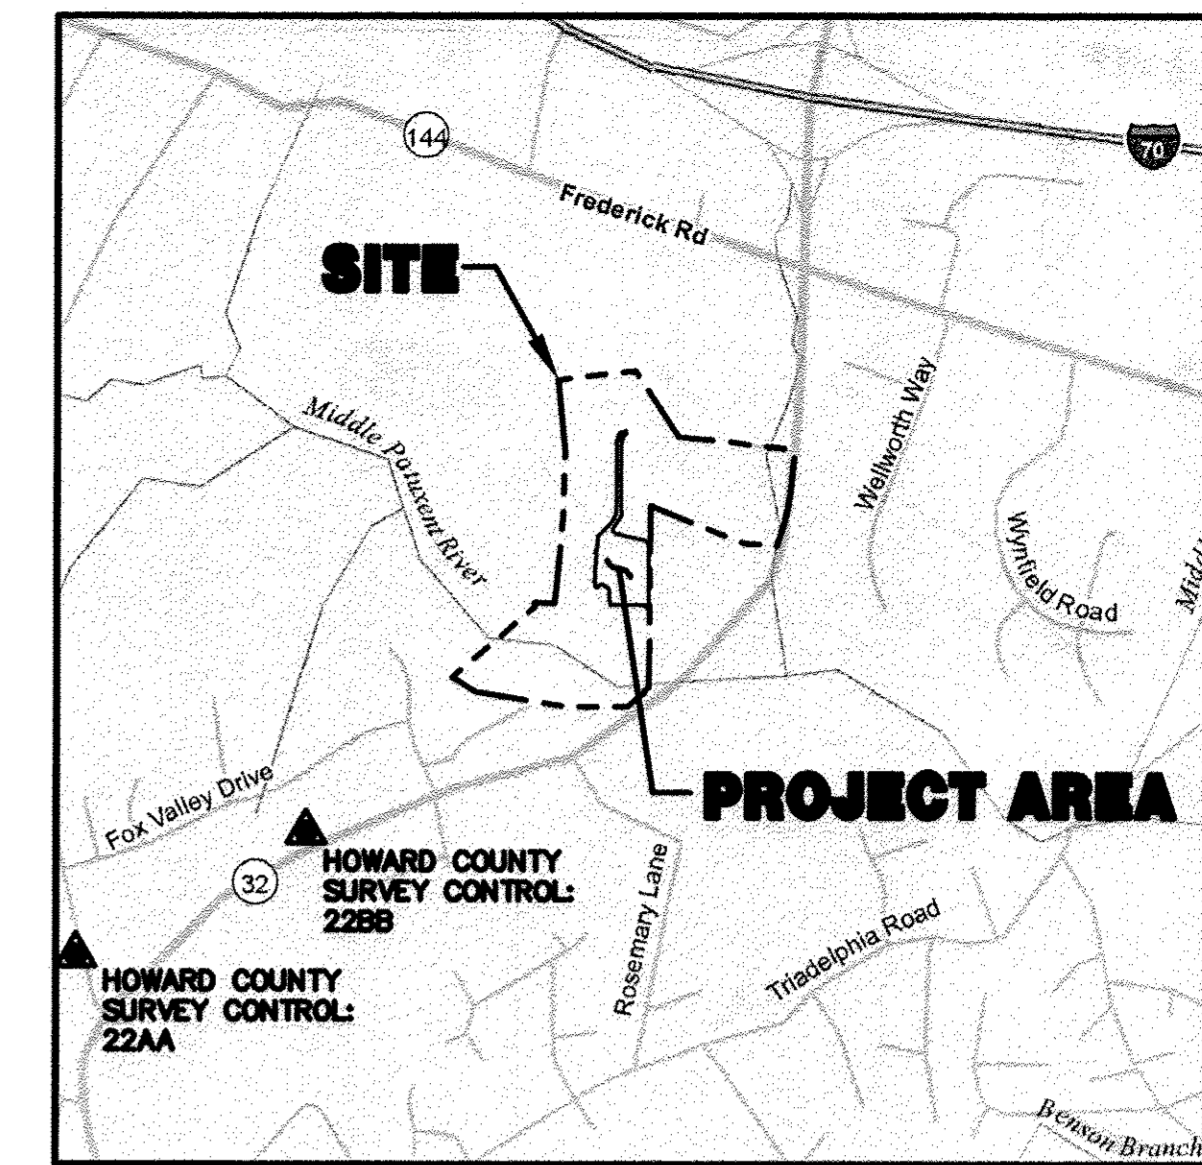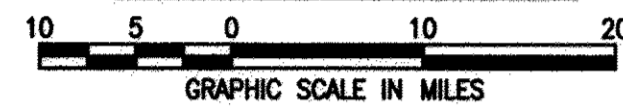

LOCATION MAP



DESIGN NARRATIVE

NATURAL RESOURCE PROTECTION AND ENHANCEMENT

THE PROJECT DOES NOT IMPACT ADJACENT NATURAL RESOURCES. NEARBY TREES WILL NOT BE REMOVED AND A NEARBY NON-TIDAL WETLAND AND ITS BUFFER WILL NOT BE IMPACTED. ADDITIONAL PLANTINGS WILL BE PROVIDED BETWEEN THE SITE AND ADJACENT SUBDIVISION TO CREATE A LANDSCAPE BUFFER.

MAINTENANCE OF NATURAL FLOW PATTERNS

THE PROJECT DOES NOT ALTER NATURAL DRAINAGE PATTERNS.

REDUCTION OF IMPERVIOUS AREAS

THE NEW IMPERVIOUS AREA ASSOCIATED WITH THE PROJECT IS MINIMAL. THE PROPOSED ACCESS ROADS ARE AS NARROW AS POSSIBLE TO REDUCE IMPERVIOUSNESS AND THE SUPPORT SYSTEM FOR THE SOLAR PANELS CONSISTS OF ONLY AUGERED 8 INCH TUBES. THERE ARE NO ADDITIONAL FOUNDATION ELEMENTS ON THE SURFACE.

INTEGRATION OF EROSION AND SEDIMENT CONTROL IN THE SWM STRATEGY

THE PROPOSED EROSION AND SEDIMENT CONTROL MEASURES ARE COMPATIBLE WITH THE PROPOSED ESD PRACTICES.

IMPLEMENTATION OF ESD PLANNING TECHNIQUES AND PRACTICES

THE PROPOSED PROJECT WILL UTILIZE NON-ROOFTOP DISCONNECTION CREDITS FOR A PORTION OF THE REQUIRED ESD VOLUME. FOR ANY REMAINING VOLUME WHERE DISCONNECTION CANNOT BE UTILIZED DUE TO STEEP SLOPES, EXISTING IMPERVIOUS AREAS ON SITE WILL BE REMOVED TO OFFSET THE NEW IMPERVIOUS BEING ADDED.

Table 5.1 Natural Resources and the Corresponding Regulatory Authorities

FEDERAL	STATE	LOCAL
Wetlands	Shown Tidal and Non-Tidal Wetlands	Shown Steep Slopes
Major Waterways	Not Present Wetlands of Special State Concern	Not Present Highly Erodible Soils
Floodplains	Not Present Wetland Buffers	Not Present Enhanced Stream Buffers
	Stream Buffers	Not Present Topography/Slopes
	Perennial Streams	Not Present Springs
	Floodplains	Not Present Seeps
	Forests	Shown Intermittent Streams
	Forest Buffers	Not Present Vegetative Cover
	Critical Areas	Not Present Soils
		Bedrock/Geology
		Existing Drainage Areas

HYDROLOGIC SOIL GROUP - HOWARD COUNTY, MARYLAND*

MAP UNIT SYMBOL	MAP UNIT NAME	HSG RATING	k RATING
GgA	Glenlg loam, 0-3% Slopes	B	0.20
GgB	Glenlg loam, 3-8% Slopes	B	0.20
GgC	Glenlg loam, 8-15% Slopes	B	0.20
GmB	Glenville silt loam, 3-8% Slopes	C	0.37
GoB	Glenville-Codorus silt loams, 0-8% Slopes	C	0.37
MaC	Manor loam, 8-15% Slopes	B	0.24

*Soils information provided from USDA NRCS Web Soil Survey

NOTE:


- NO GRADING, REMOVAL OF VEGETATIVE COVER OR TREES, PAVING AND NEW STRUCTURES SHALL BE PERMITTED WITHIN THE REQUIRED WETLANDS, STREAM(S) OR THEIR BUFFERS, FOREST CONSERVATION EASEMENT AREAS AND 100 YEAR FLOODPLAIN.
- THE SYSTEM OF COORDINATES USED BY HOWARD COUNTY IS BASED IN THE FOLLOWING DATUMS AND PROJECTIONS:
 - HORIZONTAL: MARYLAND NAD83
 - VERTICAL: NAVD83

GENERAL NOTES:

- ALL CONSTRUCTION SHALL BE IN ACCORDANCE WITH THE LATEST STANDARDS AND SPECIFICATIONS OF HOWARD COUNTY PLUS MSHA STANDARDS AND SPECIFICATION IF APPLICABLE.
- THE CONTRACTOR SHALL NOTIFY THE DEPARTMENT OF PUBLIC WORKS/BUREAU OF ENGINEERING/CONSTRUCTION INSPECTION DIVISION AT (410) 313-1880 AT LEAST FIVE (5) WORKING DAYS PRIOR TO THE START OF WORK.
- THE CONTRACTOR SHALL NOTIFY "MISS UTILITY" AT 1-800-257-7777 AT LEAST 48 HOURS PRIOR TO ANY EXCAVATION WORK BEING DONE.
- ALL SIGN POSTS USED FOR TRAFFIC CONTROL SIGNS INSTALLED IN THE COUNTY RIGHT-OF-WAY SHALL BE MOUNTED ON A 2" GALVANIZED STEEL, PERFORATED, SQUARE TUBE POST (14 GAUGE) INSERTED INTO A 2-1/2" GALVANIZED STEEL, PERFORATED, SQUARE TUBE SLEEVE (12 GAUGE) - 3' LONG. A GALVANIZED STEEL POLE CAP SHALL BE MOUNTED ON TOP OF EACH POST.
- ALL PLAN DIMENSIONS ARE TO FACE OF CURB UNLESS OTHERWISE NOTED.
- THE EXISTING TOPOGRAPHY IS TAKEN FROM AN AERIAL SURVEY WITH CONTOUR INTERVALS PREPARED BY VIRGINIA RESOURCE MAPPING, INC. DATED JANUARY 2005 AND SUPPLEMENTED BY FIELD SURVEY PREPARED BY PHR&A DATED JANUARY 2005.
- THE COORDINATES SHOWN HEREON ARE BASED UPON THE HOWARD COUNTY GEODETIC CONTROL, WHICH IS BASED UPON THE MARYLAND STATE PLAN COORDINATE SYSTEM. HOWARD COUNTY MONUMENT NOS. 22AA AND 22BB WERE USED FOR THIS PROJECT.
- WATER IS PRIVATE.
- SEWER IS PRIVATE.
- STORMWATER MANAGEMENT IS PROVIDED VIA A COMBINATION OF A PRIVATE MICRO-BIORETENTION FACILITY AND PRIVATE NON-ROOFTOP DISCONNECTIONS AND WILL BE OWNED AND MAINTAINED BY 2800 NIXONS FARM LANE, LLC.
- EXISTING UTILITIES ARE BASED ON THE SURVEY PREPARED BY VIRGINIA RESOURCE MAPPING, INC. DATED JANUARY 2005 AND AND BY FIELD SURVEY PREPARED BY PHR&A DATED JANUARY 2005.
- THE FLOODPLAIN STUDY FOR THIS PROJECT WAS PREPARED BY PHR&A DATED MAY 2005 AND WAS APPROVED IN NOVEMBER 2005.
- THE WETLANDS DELINEATION STUDY FOR THIS PROJECT WAS PREPARED BY MCCARTHY & ASSOCIATES, INC., DATED MARCH 2005, AND WAS APPROVED IN MARCH 2005.
- NO TRAFFIC STUDY IS REQUIRED FOR THIS PROJECT.

DRAWING SHEET DRAWING TITLE

DRAWING NUMBER	SHEET NUMBER	DRAWING TITLE
T-1	1 OF 13	TITLE SHEET
C-1	2 OF 13	EXISTING CONDITIONS I
C-2	3 OF 13	EXISTING CONDITIONS II
C-3	4 OF 13	STORMWATER MANAGEMENT PLAN I
C-4	5 OF 13	STORMWATER MANAGEMENT PLAN II
C-4A	6 OF 13	STORMWATER MANAGEMENT PLAN III
C-5	7 OF 13	STORMWATER MANAGEMENT DETAILS AND SPECIFICATIONS
C-6	8 OF 13	EROSION AND SEDIMENT CONTROL PLAN I
C-7	9 OF 13	EROSION AND SEDIMENT CONTROL PLAN II
C-8	10 OF 13	EROSION AND SEDIMENT CONTROL DETAILS
C-9	11 OF 13	EROSION AND SEDIMENT CONTROL NOTES AND SPECIFICATIONS
L-1	12 OF 13	LANDSCAPE PLAN
L-2	13 OF 13	LANDSCAPE NOTES AND DETAILS

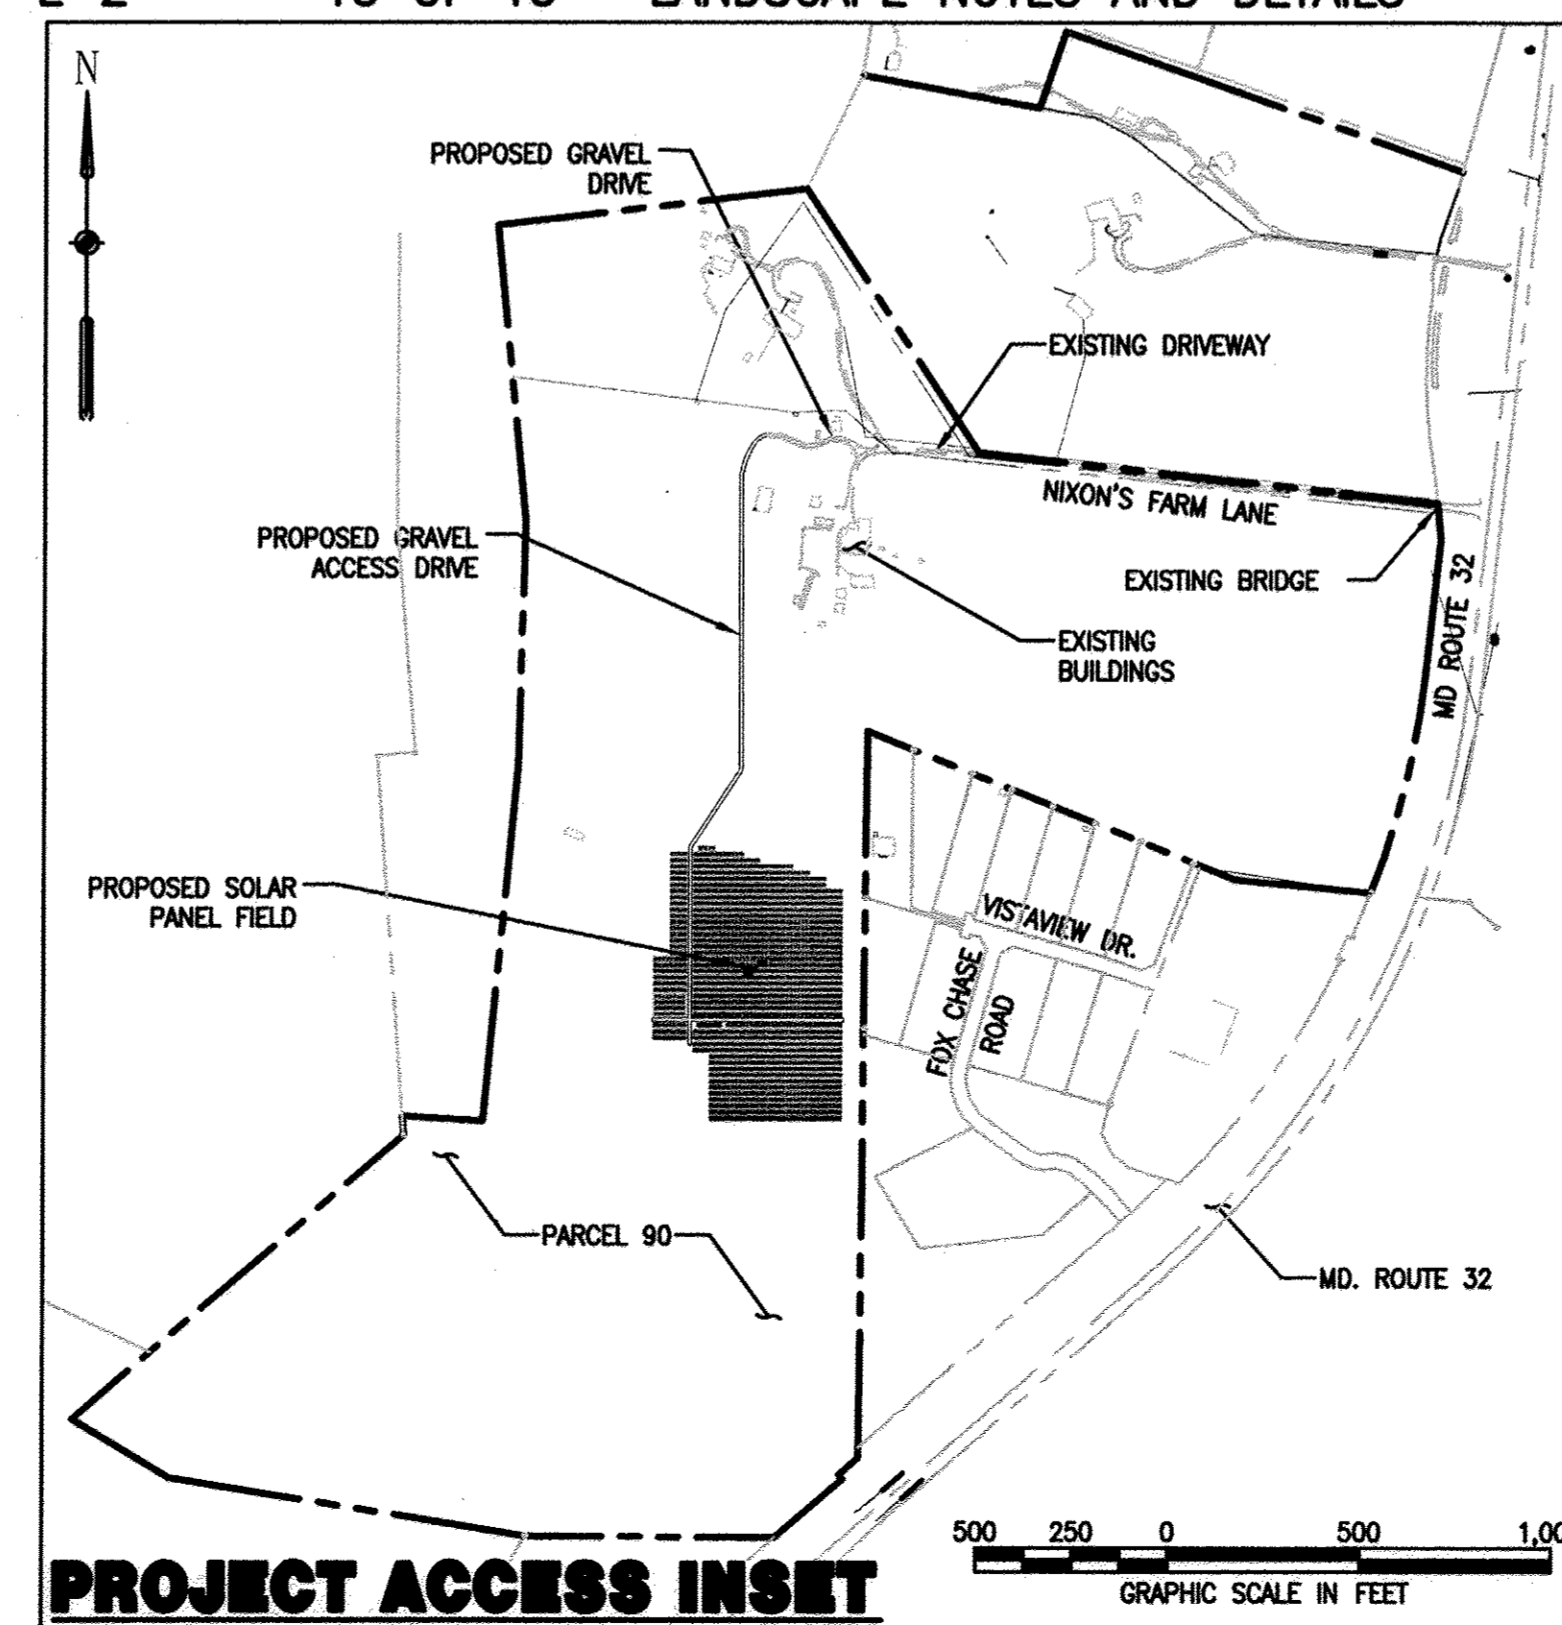

LEGEND

- EX. TREELINE
- PROPERTY LINE
- ADJACENT PROPERTY LINE
- LIMIT OF FIELD RUN TOPO
- EX. MAJOR CONTOUR
- EX. MINOR CONTOUR
- EX. WETLAND BUFFER
- EX. WETLAND
- EX. BUILDING
- EX. WELL
- EX. UTILITY POLE
- EX. IRON PIN
- SLOPE 15% TO 25%
- SLOPE GREATER THAN 25%
- SOIL TYPE BOUNDARY
- EX. TREE
- PROP. FENCE (TO BE INSTALLED IN FUTURE PHASE)
- PROP. CONTOURS
- PROP. LIMIT OF DISTURBANCE
- DF PROP. DIVERSION FENCE
- SSF PROP. SUPER SILT FENCE
- UE PROP. UNDERGROUND ELECTRIC
- SD PROP. DIVERSION PIPE
- PROP. SOLAR PANEL
- SWM DISCONNECTION AREA
- SWM NON-DISCONNECTION AREA
- MOUNTABLE BERM
- EROSION AND SEDIMENT CONTROL DRAINAGE AREA LIMIT
- PROP. EARTH DIKE

DEVELOPER:

BITH ENERGY
ATTN: R. DANIEL WALLACE
113 WEST MONUMENT ST.
BALTIMORE, MD 21201
PHONE: (410) 962-1188

OWNER:

2800 NIXONS FARM LANE, LLC
17500 FREDERICK ROAD
MT. AIRY, MD 21771
PHONE: (410) 461-7200

SITE ANALYSIS

SITE AREA: 96.920 AC
WETLAND AREA: 18.17 AC
WETLAND BUFFER AREA: 2.90 AC
FLOODPLAIN AREA: N/A
FORESTED AREA: 34.43 AC
SLOPES > 15% AREA: 21.98 AC
LIMIT OF DISTURBANCE AREA: 9.46 AC
PROPOSED SITE USE: SOLAR PANEL ARRAY
GREEN OPEN AREA: 122.10 AC
PROPOSED IMPERVIOUS AREA: 0.50 AC

APPROVED: DEPARTMENT OF PLANNING AND ZONING

10/26/12
10/09/12
10/16/12

ADDRESS CHART	
LOT/PARCEL #	STREET ADDRESS
P.90	2800 NIXONS FARM LANE


PERMIT INFORMATION CHART					
Subdivision Name	Section/Area	Lot/Parcel No.	Year Map No.	Election District	County/Trust
N/A	N/A	90	16/17	3	
Water Code	Sewer Code				
N/A	N/A				

NIXON FARMS SOLAR
PHASE 1
2800 NIXON'S FARM LANE, WEST FRIENDSHIP, MARYLAND 21792


GRID: 16, 17, 22
ZONING: RC-DEO
TAX MAP: 0015



DATE: AUGUST 2012
DESIGNED BY: MBS
DRAWN BY: JAP
CHECKED BY: GAT
PROJECT MANAGER: JMH
PROJECT NUMBER: 14825.02
DRAWING NUMBER: T-1
SHEET NUMBER: 1 OF 13

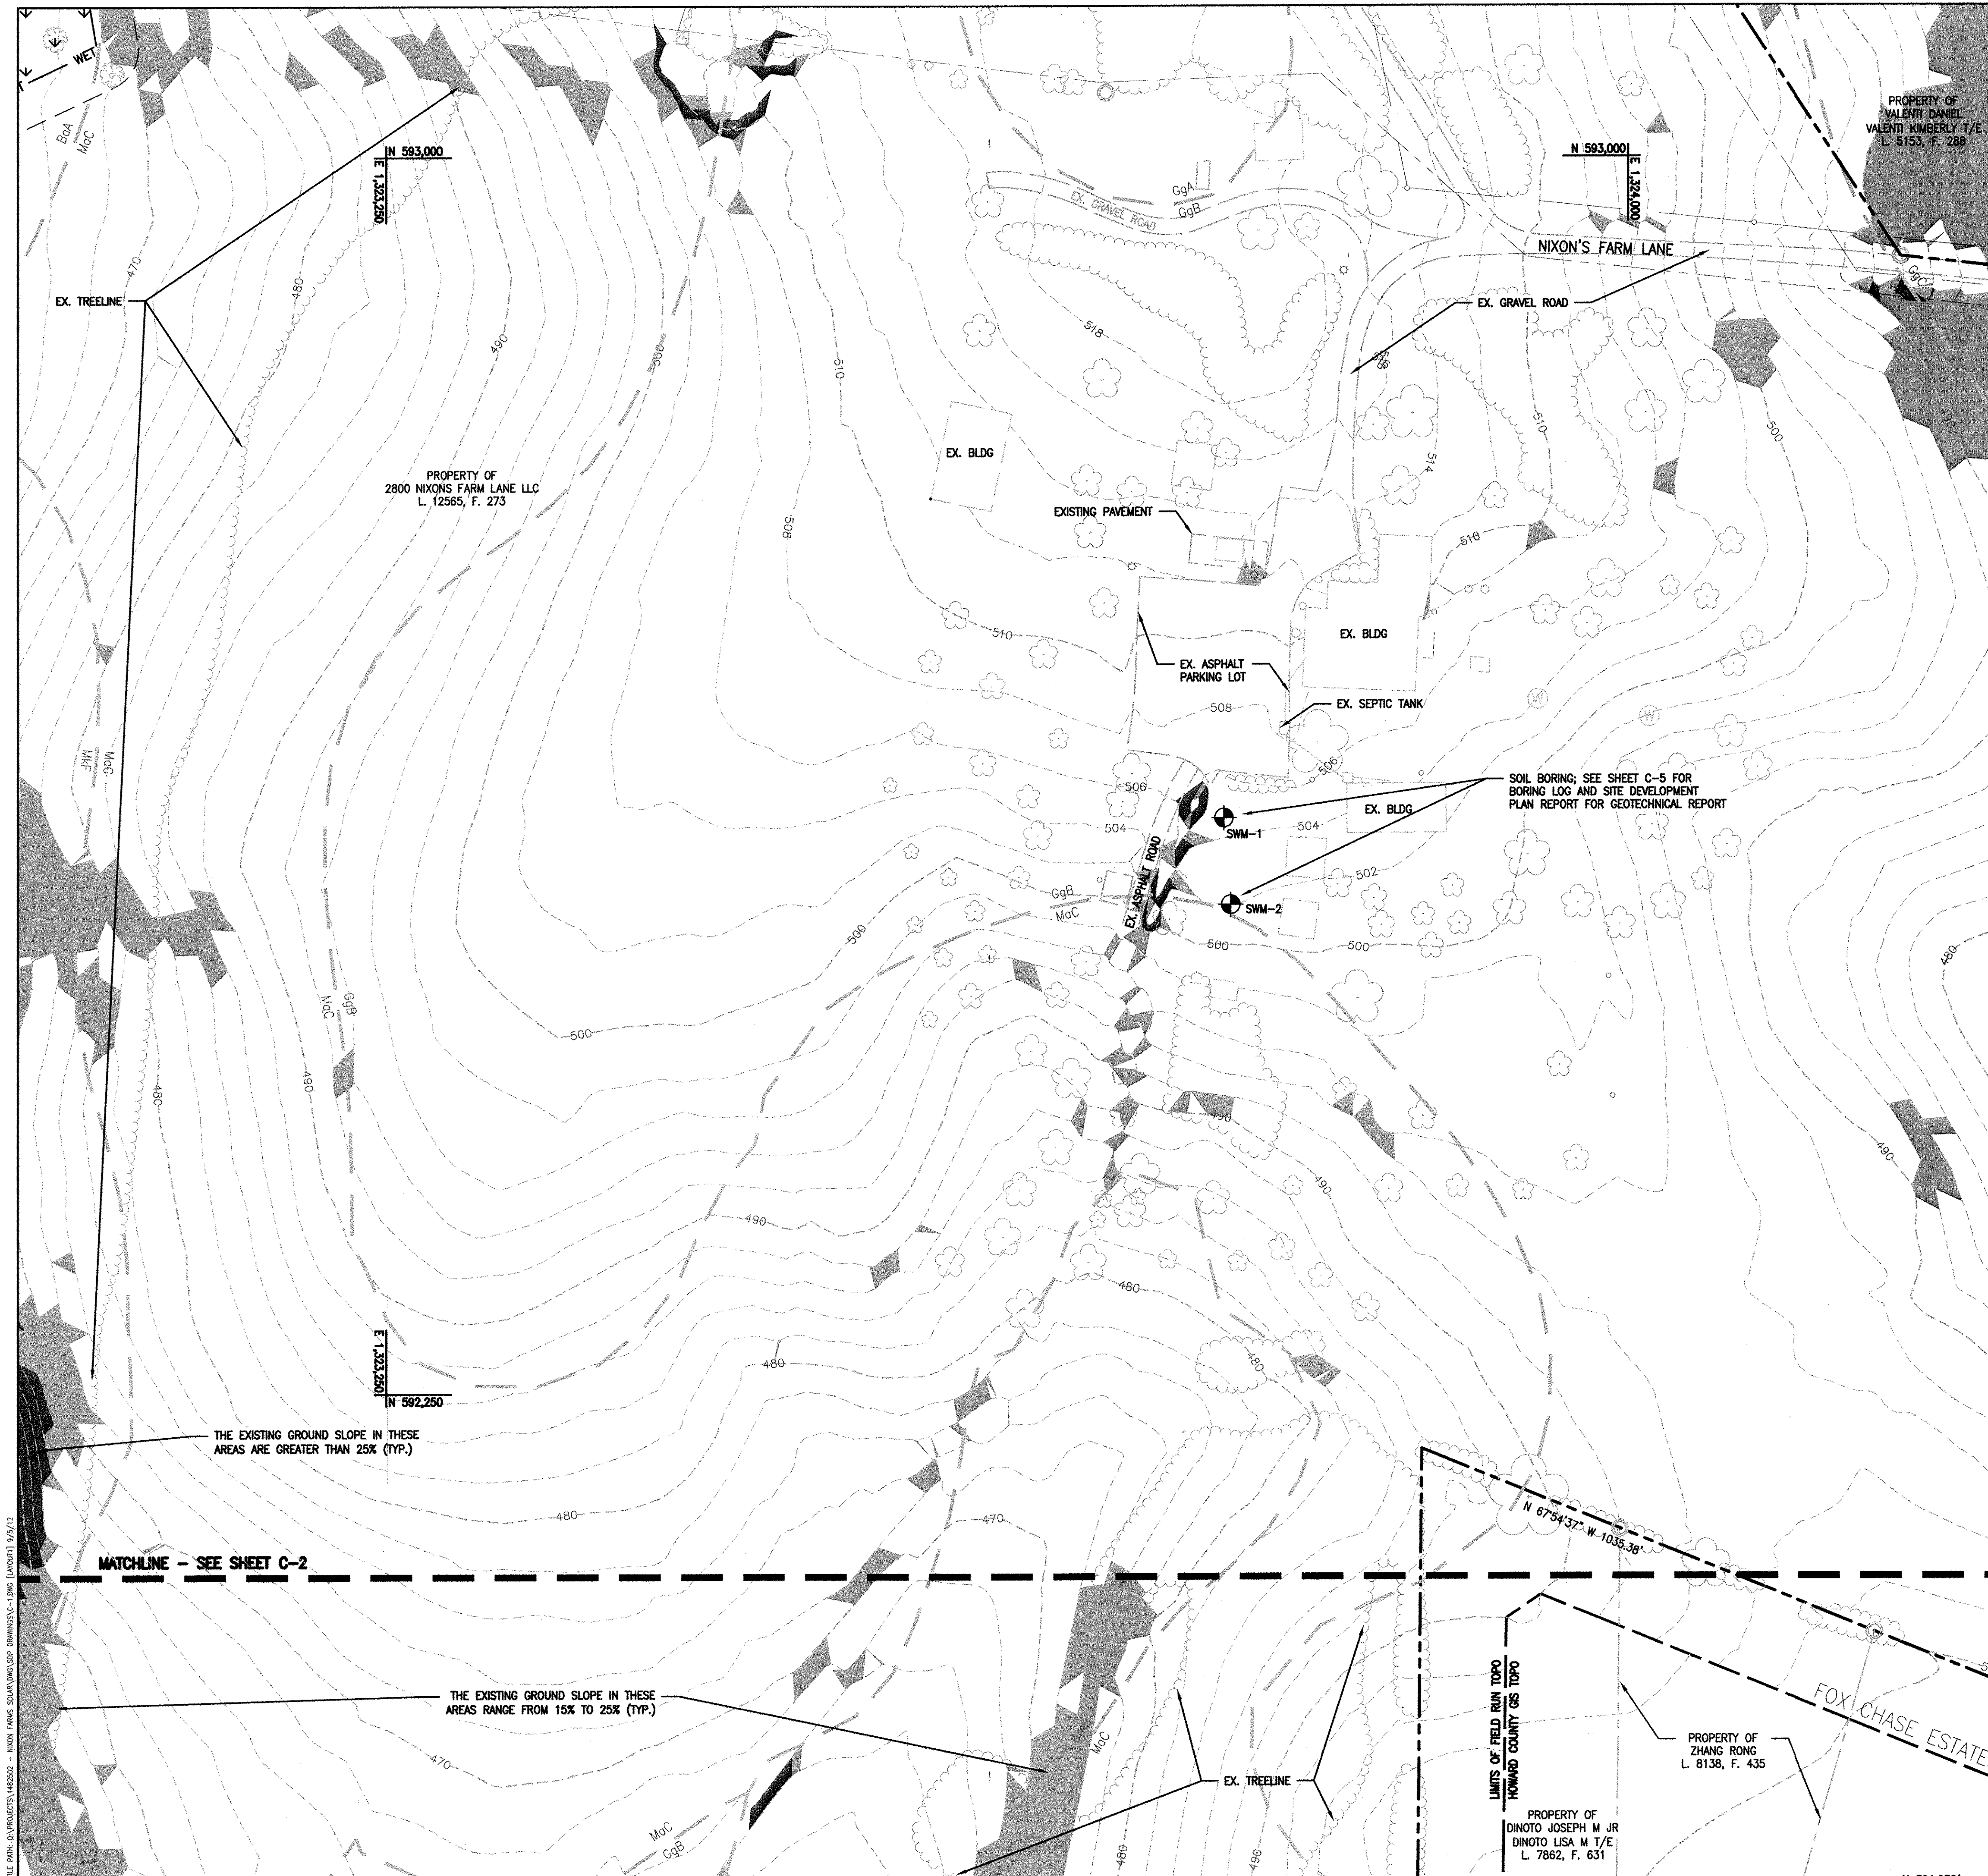

- LEGEND**
- EX. TREELINE
 - PROPERTY LINE
 - ADJACENT PROPERTY LINE
 - LIMIT OF FIELD RUN TOPO
 - - - EX. MAJOR CONTOUR
 - - - EX. MINOR CONTOUR
 - - - EX. WETLAND BUFFER
 - - - EX. WETLAND
 - EX. BUILDING
 - EX. WELL
 - EX. UTILITY POLE
 - EX. IRON PIN
 - ▬ SLOPE 15% TO 25%
 - ▬ SLOPE GREATER THAN 25%
 - GgC SOIL TYPE BOUNDARY
 - GgB SOIL TYPE BOUNDARY
 - EX. TREE
 - SWM-1 SOIL BORING LOCATION

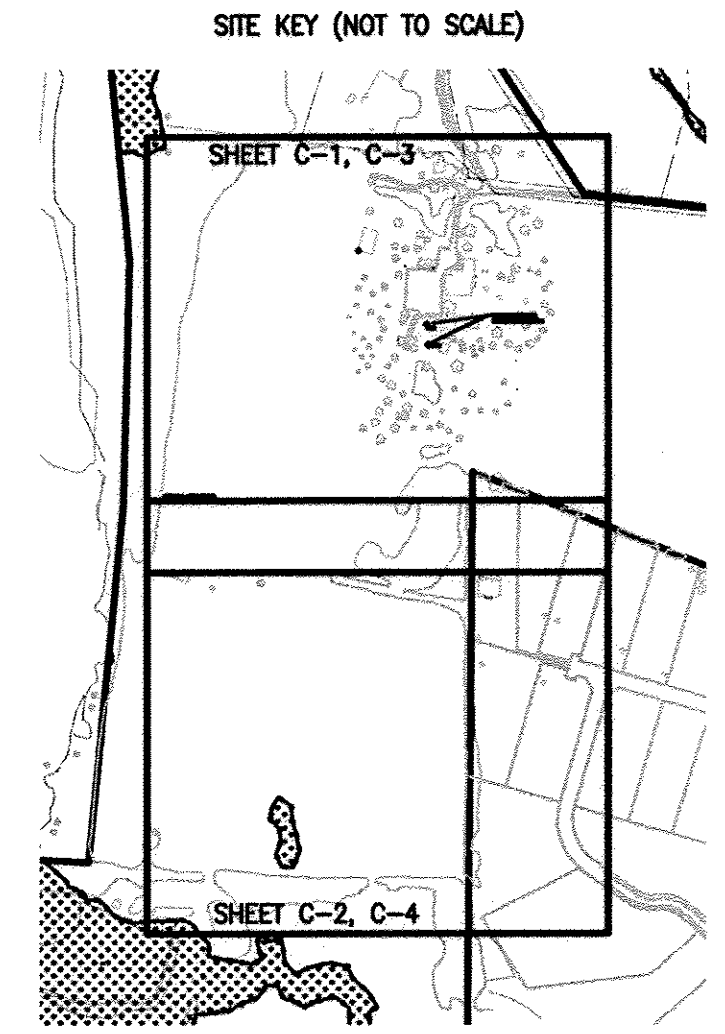

- BENCHMARK INFORMATION**
- HOWARD COUNTY SURVEY CONTROL: 22BB
ELEVATION 538.976
N 508,502.739 E 1,317,897.957
LOCATION IS 24 FT. FROM FACE OF CURB AT THE INTERSECTION OF MD RT.32 AND RIVER VALLEY CHASE
 - HOWARD COUNTY SURVEY CONTROL: 22AA
ELEVATION 569.713
N 587, 502.739 E 1,317,897.957
LOCATION IS 4 FT. FROM EDGE OF MD RT. 32 PAVING, 0.45 MILES EAST OF PFEFFERKORN ROAD AND 0.25 MILES WEST OF IVORY ROAD.
 - THE SYSTEM OF COORDINATES USED BY HOWARD COUNTY IS BASED ON THE FOLLOWING DATUMS AND PROJECTIONS:
 - HORIZONTAL: MARYLAND NAD83
 - VERTICAL: NAVD88

- DATA SOURCES**
- THE EXISTING TOPOGRAPHY IS TAKEN FROM FIELD RUN SURVEY WITH CONTOUR INTERVALS PREPARED BY VIRGINIA RESOURCE MAPPING, INC. DATED JANUARY 2005.
 - ALL INFORMATION LOCATED OUTSIDE OF THE LIMIT OF FIELD RUN TOPO LINE HAS BEEN TAKEN FROM THE HOWARD COUNTY GIS DATABASE.

APPROVED: DEPARTMENT OF PLANNING AND ZONING


[Signature] 10/2/12
CHIEF, DEVELOPMENT ENGINEERING DIVISION DATE

[Signature] 10/09/12
CHIEF, DIVISION OF LAND DEVELOPMENT DATE


[Signature] 10/9/12
DIRECTOR DATE

DEVELOPER: BITH ENERGY
ATTN: R. DANIEL WALLACE
113 WEST MONUMENT ST.
BALTIMORE, MD 21201
PHONE: (410) 962-1188

OWNER: 2800 NIXONS FARM LANE, LLC
17500 FREDERICK ROAD
MT. AIRY, MD 21771
PHONE: (410) 461-7200

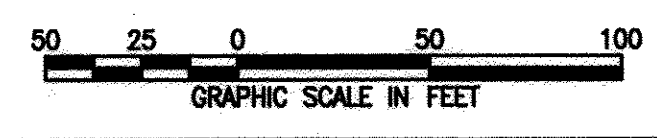


REVISIONS	DESCRIPTION
NO.	
BY	
DATE	
NO.	
PROFESSIONAL CERTIFICATION: I HEREBY CERTIFY THAT THESE DOCUMENTS WERE PREPARED OR APPROVED BY ME, AND THAT I AM A DULY LICENSED PROFESSIONAL ENGINEER UNDER THE LAWS OF THE STATE OF MARYLAND, LICENSE NO. 13653, EXPIRATION DATE: JULY 02, 2013.	
BLOCK: N/A PARCEL: 0090 ELECTION DISTRICT: 3	NIXON FARMS SOLAR PHASE 1 2800 NIXONS FARM LANE, WEST FRIENDSHIP, MARYLAND 21792 EXISTING CONDITIONS I
GRID: 16, 17, 22 ZONING: RC-DEO TAX MAP: 0015	<p>EA ENGINEERING, SCIENCE, AND TECHNOLOGY Loveton Center 15 Loveton Circle Sparks, Maryland 21152 (410) 771-4950</p>
DATE	AUGUST 2012
DESIGNED BY	MBS
DRAWN BY	JSP
CHECKED BY	GAT
PROJECT MANAGER	JMH
PROJECT NUMBER	14825.02
DRAWING NUMBER	C-1
SHEET NUMBER	2 OF 13

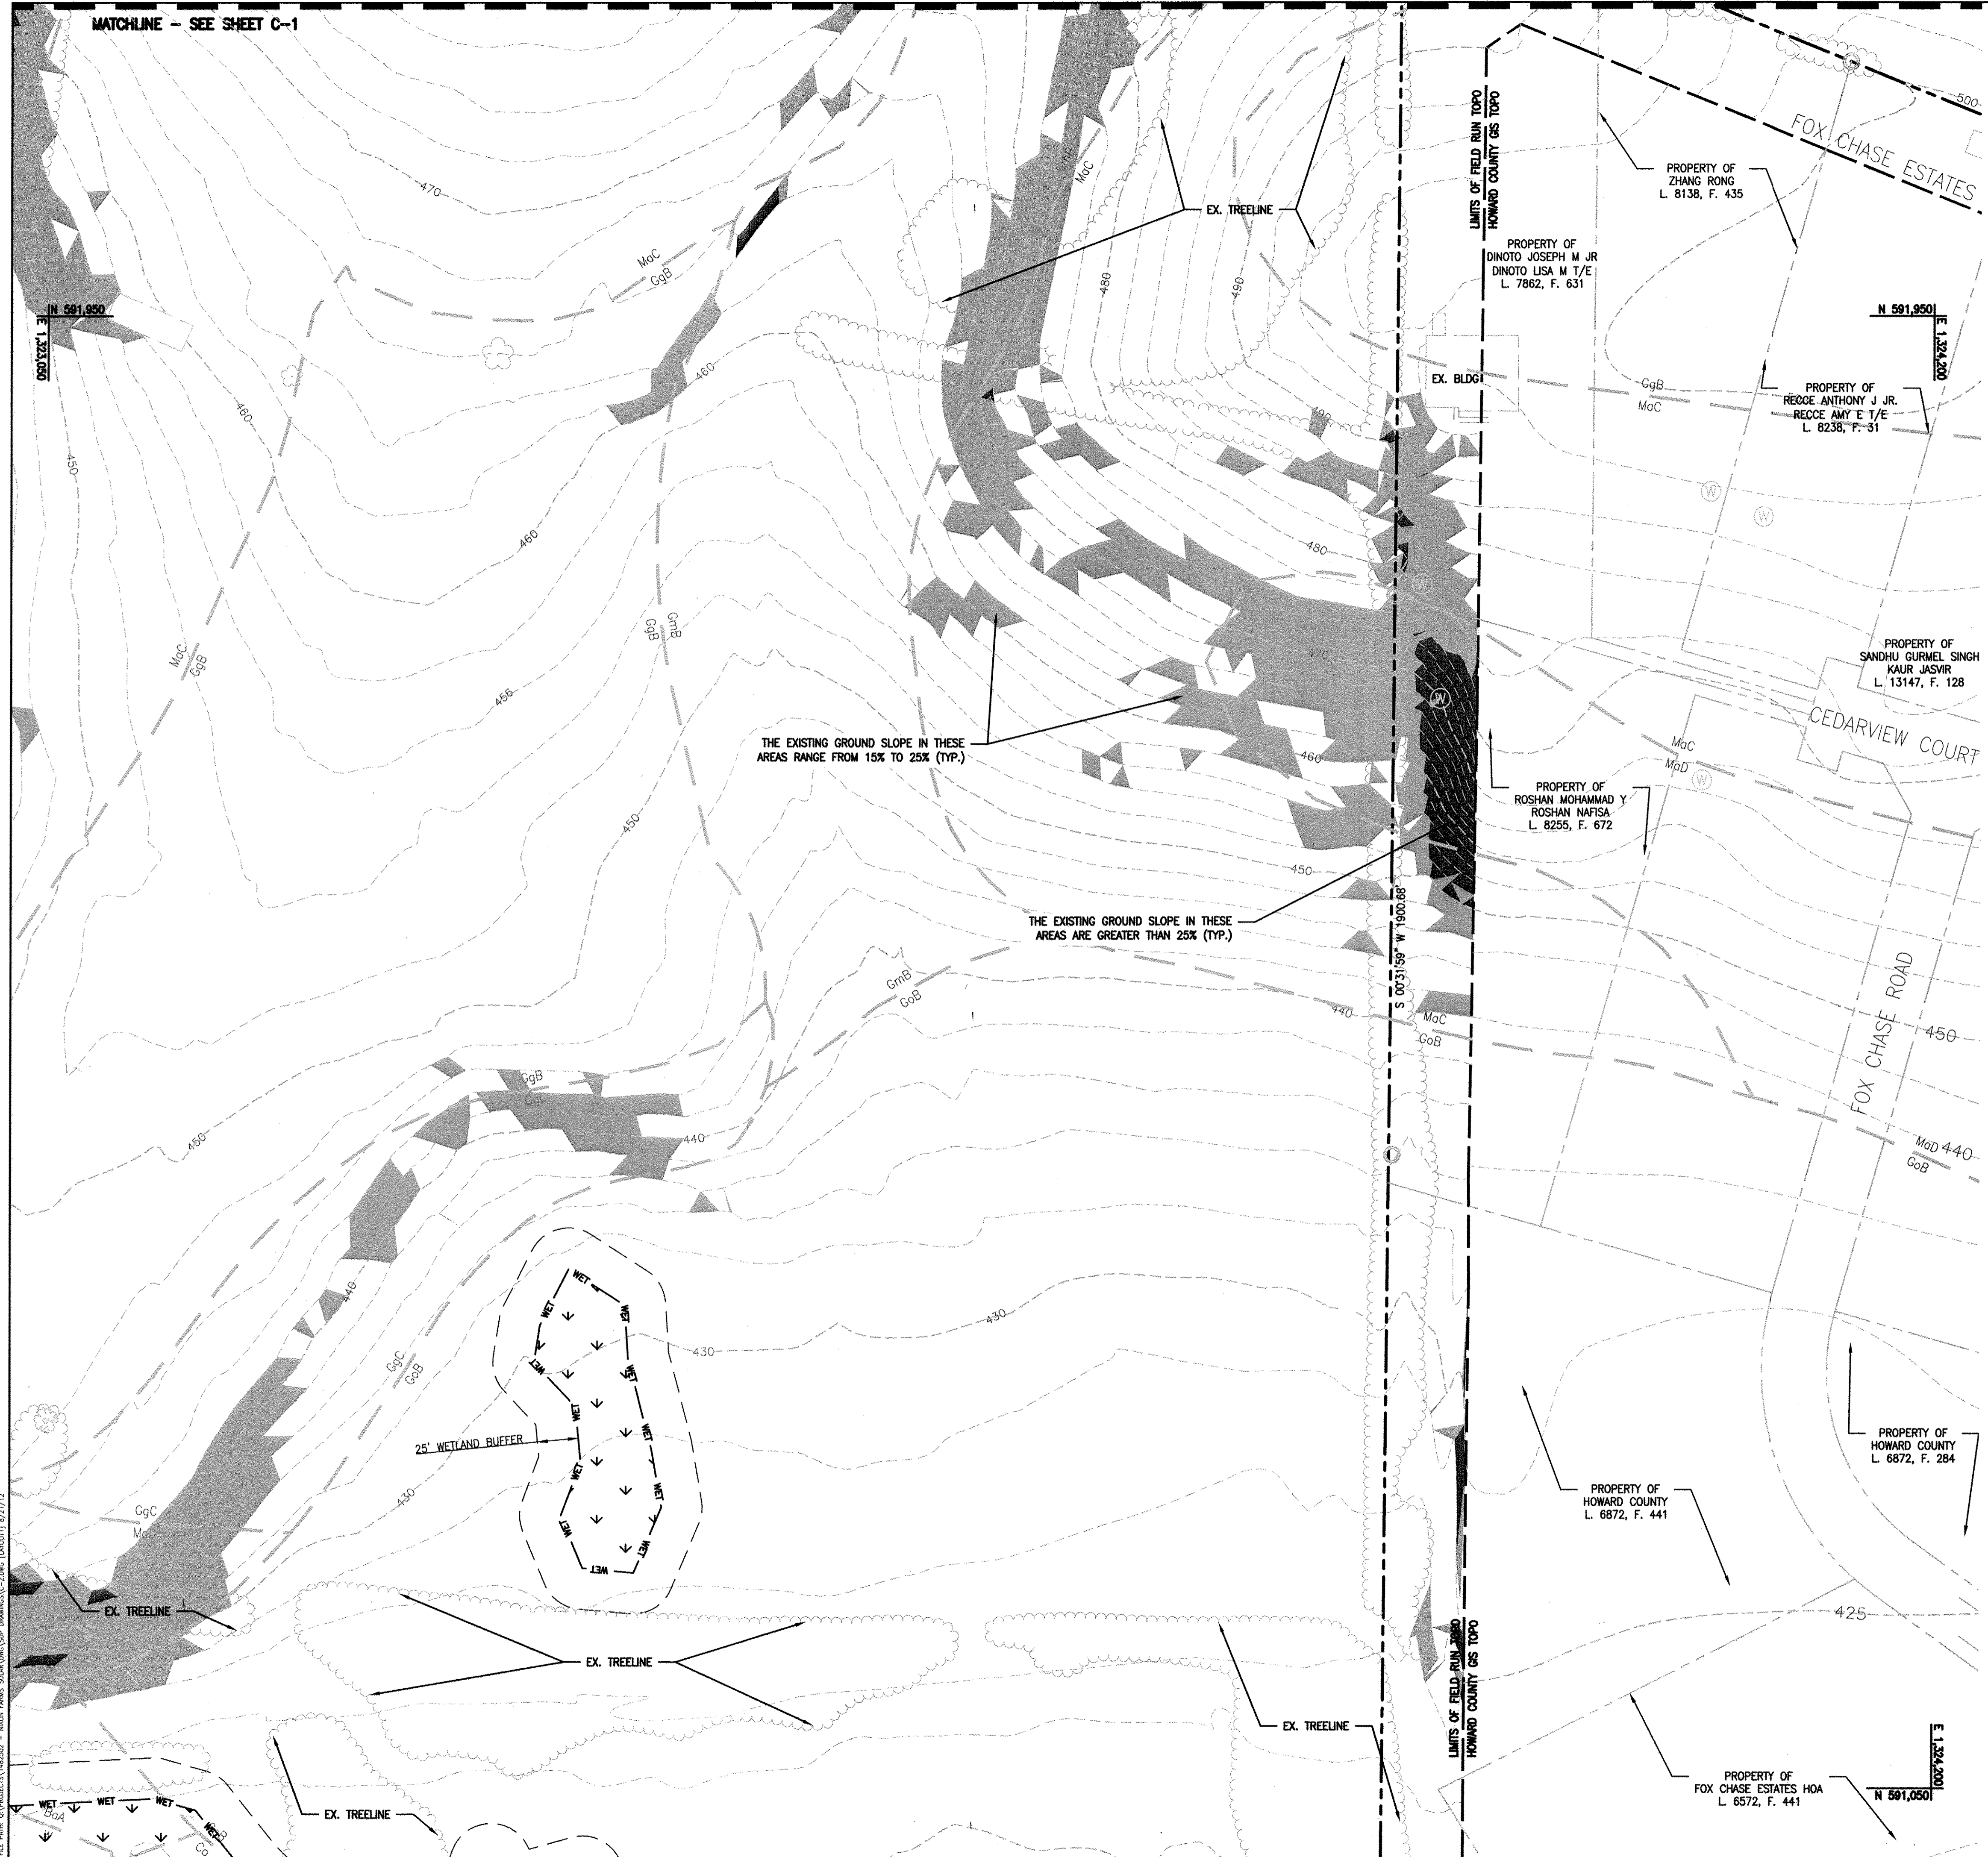

LEGEND

	EX. TREELINE
	PROPERTY LINE
	ADJACENT PROPERTY LINE
	LIMIT OF FIELD RUN TOPO
	EX. MAJOR CONTOUR
	EX. MINOR CONTOUR
	EX. WETLAND BUFFER
	EX. WETLAND
	EX. BUILDING
	EX. WELL
	EX. UTILITY POLE
	EX. IRON PIN
	SLOPE 15% TO 25%
	SLOPE GREATER THAN 25%
	SOIL TYPE BOUNDARY
	EX. TREE

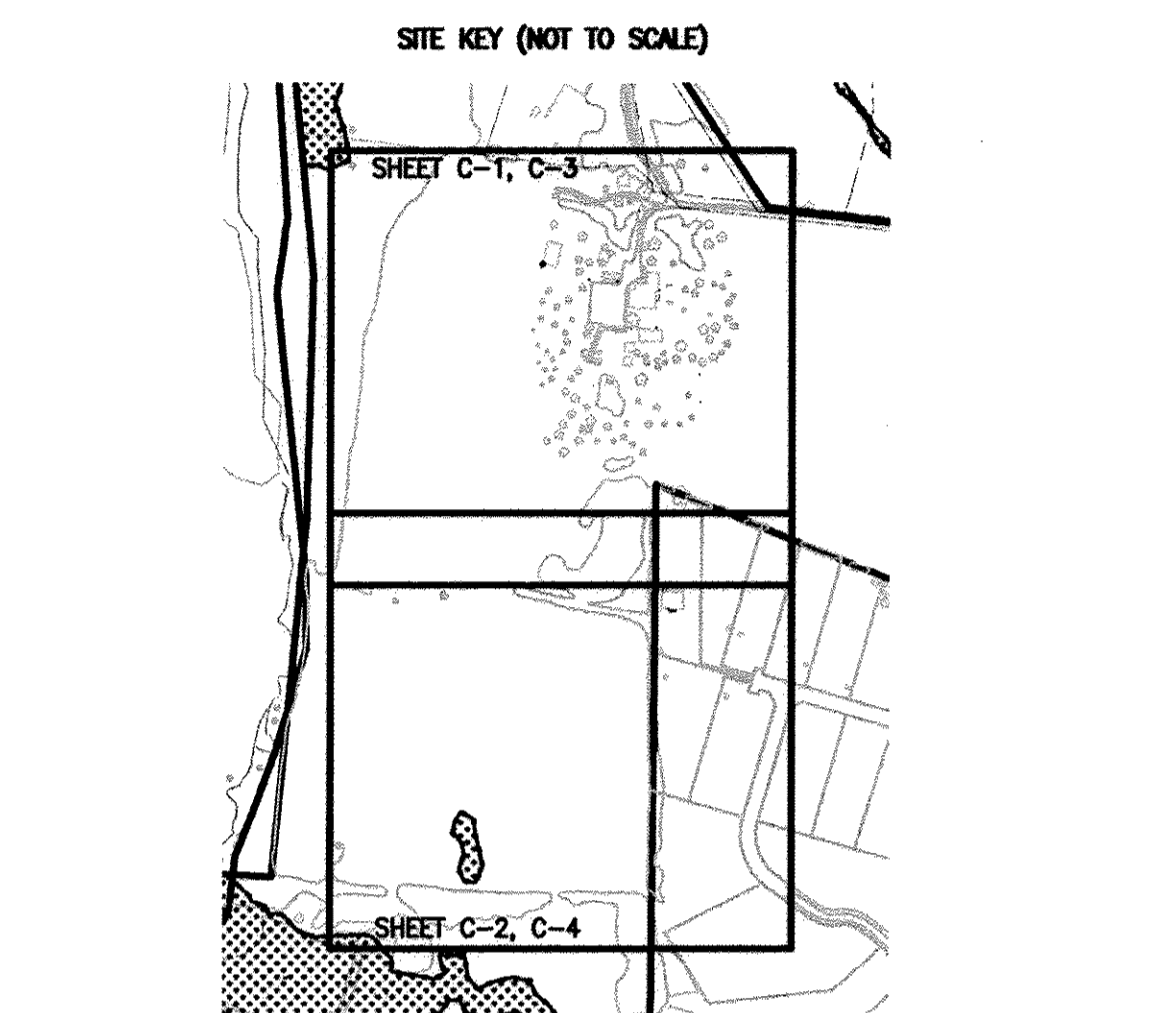

- BENCHMARK INFORMATION**
- HOWARD COUNTY SURVEY CONTROL: 228B
ELEVATION 538.976
N 588,502.739 E 1,317,897.957
LOCATION IS 24 FT. FROM FACE OF CURB AT THE INTERSECTION OF MD RT.32 AND RIVER VALLEY CHASE.
 - HOWARD COUNTY SURVEY CONTROL: 22AA
ELEVATION 569.713
N 587,502.739 E 1,317,897.957
LOCATION IS 4 FT. FROM EDGE OF MD RT. 32 PAVING, 0.45 MILES EAST OF PFEFFERKORN ROAD AND 0.25 MILES WEST OF IVORY ROAD.
 - THE SYSTEM OF COORDINATES USED BY HOWARD COUNTY IS BASED ON THE FOLLOWING DATUMS AND PROJECTIONS:
 - HORIZONTAL: MARYLAND NAD83
 - VERTICAL: NAVD88

- DATA SOURCES**
- THE EXISTING TOPOGRAPHY IS TAKEN FROM FIELD RUN SURVEY WITH CONTOUR INTERVALS PREPARED BY VIRGINIA RESOURCE MAPPING, INC. DATED JANUARY 2005.
 - ALL INFORMATION LOCATED OUTSIDE OF THE LIMIT OF FIELD RUN TOPO LINE HAS BEEN TAKEN FROM THE HOWARD COUNTY GIS DATABASE.

APPROVED: DEPARTMENT OF PLANNING AND ZONING

CHIEF, DEVELOPMENT ENGINEERING DIVISION *[Signature]* 10/2/12 DATE

CHIEF, DIVISION OF LAND DEVELOPMENT *[Signature]* 10/09/12 DATE

DIRECTOR *[Signature]* 10/9/12 DATE

DEVELOPER: BITH ENERGY
ATTN: R. DANIEL WALLACE
113 WEST MONUMENT ST.
BALTIMORE, MD 21201
PHONE: (410) 962-1188

OWNER: 2800 NIXON'S FARM LANE, LLC
17500 FREDERICK ROAD
MT. AIRY, MD 21771
PHONE: (410) 461-7200



REVISIONS	DESCRIPTION
BY	
DATE	
NO.	

PROFESSIONAL CERTIFICATION: I HEREBY CERTIFY THAT THESE DOCUMENTS WERE PREPARED OR APPROVED BY ME, AND THAT I AM A DULY LICENSED PROFESSIONAL ENGINEER UNDER THE LAWS OF THE STATE OF MARYLAND, LICENSE NO. J5453, EXPIRATION DATE: JULY 02, 2013.

SEALED: *[Signature]* 10/15/12

BLOCK: N/A
PARCEL: 0080
ELECTION DISTRICT: 3

NIXON FARMS SOLAR PHASE 1
2800 NIXON'S FARM LANE, WEST FRIENDSHIP, MARYLAND 21792

EXISTING CONDITIONS II

GRID: 16, 17, 22
ZONING: RC-DEO
TAX MAP: 0015

EA ENGINEERING, SCIENCE AND TECHNOLOGY
15 Loveton Circle
Sparks, Maryland 21152
(410) 771-4950

DATE: AUGUST 2012

DESIGNED BY: MBS

DRAWN BY: JAP

CHECKED BY: GAT


PROJECT MANAGER: JMH

PROJECT NUMBER: 14825.02

DRAWING NUMBER: C-2

SHEET NUMBER: 3 OF 13

WP-13-018

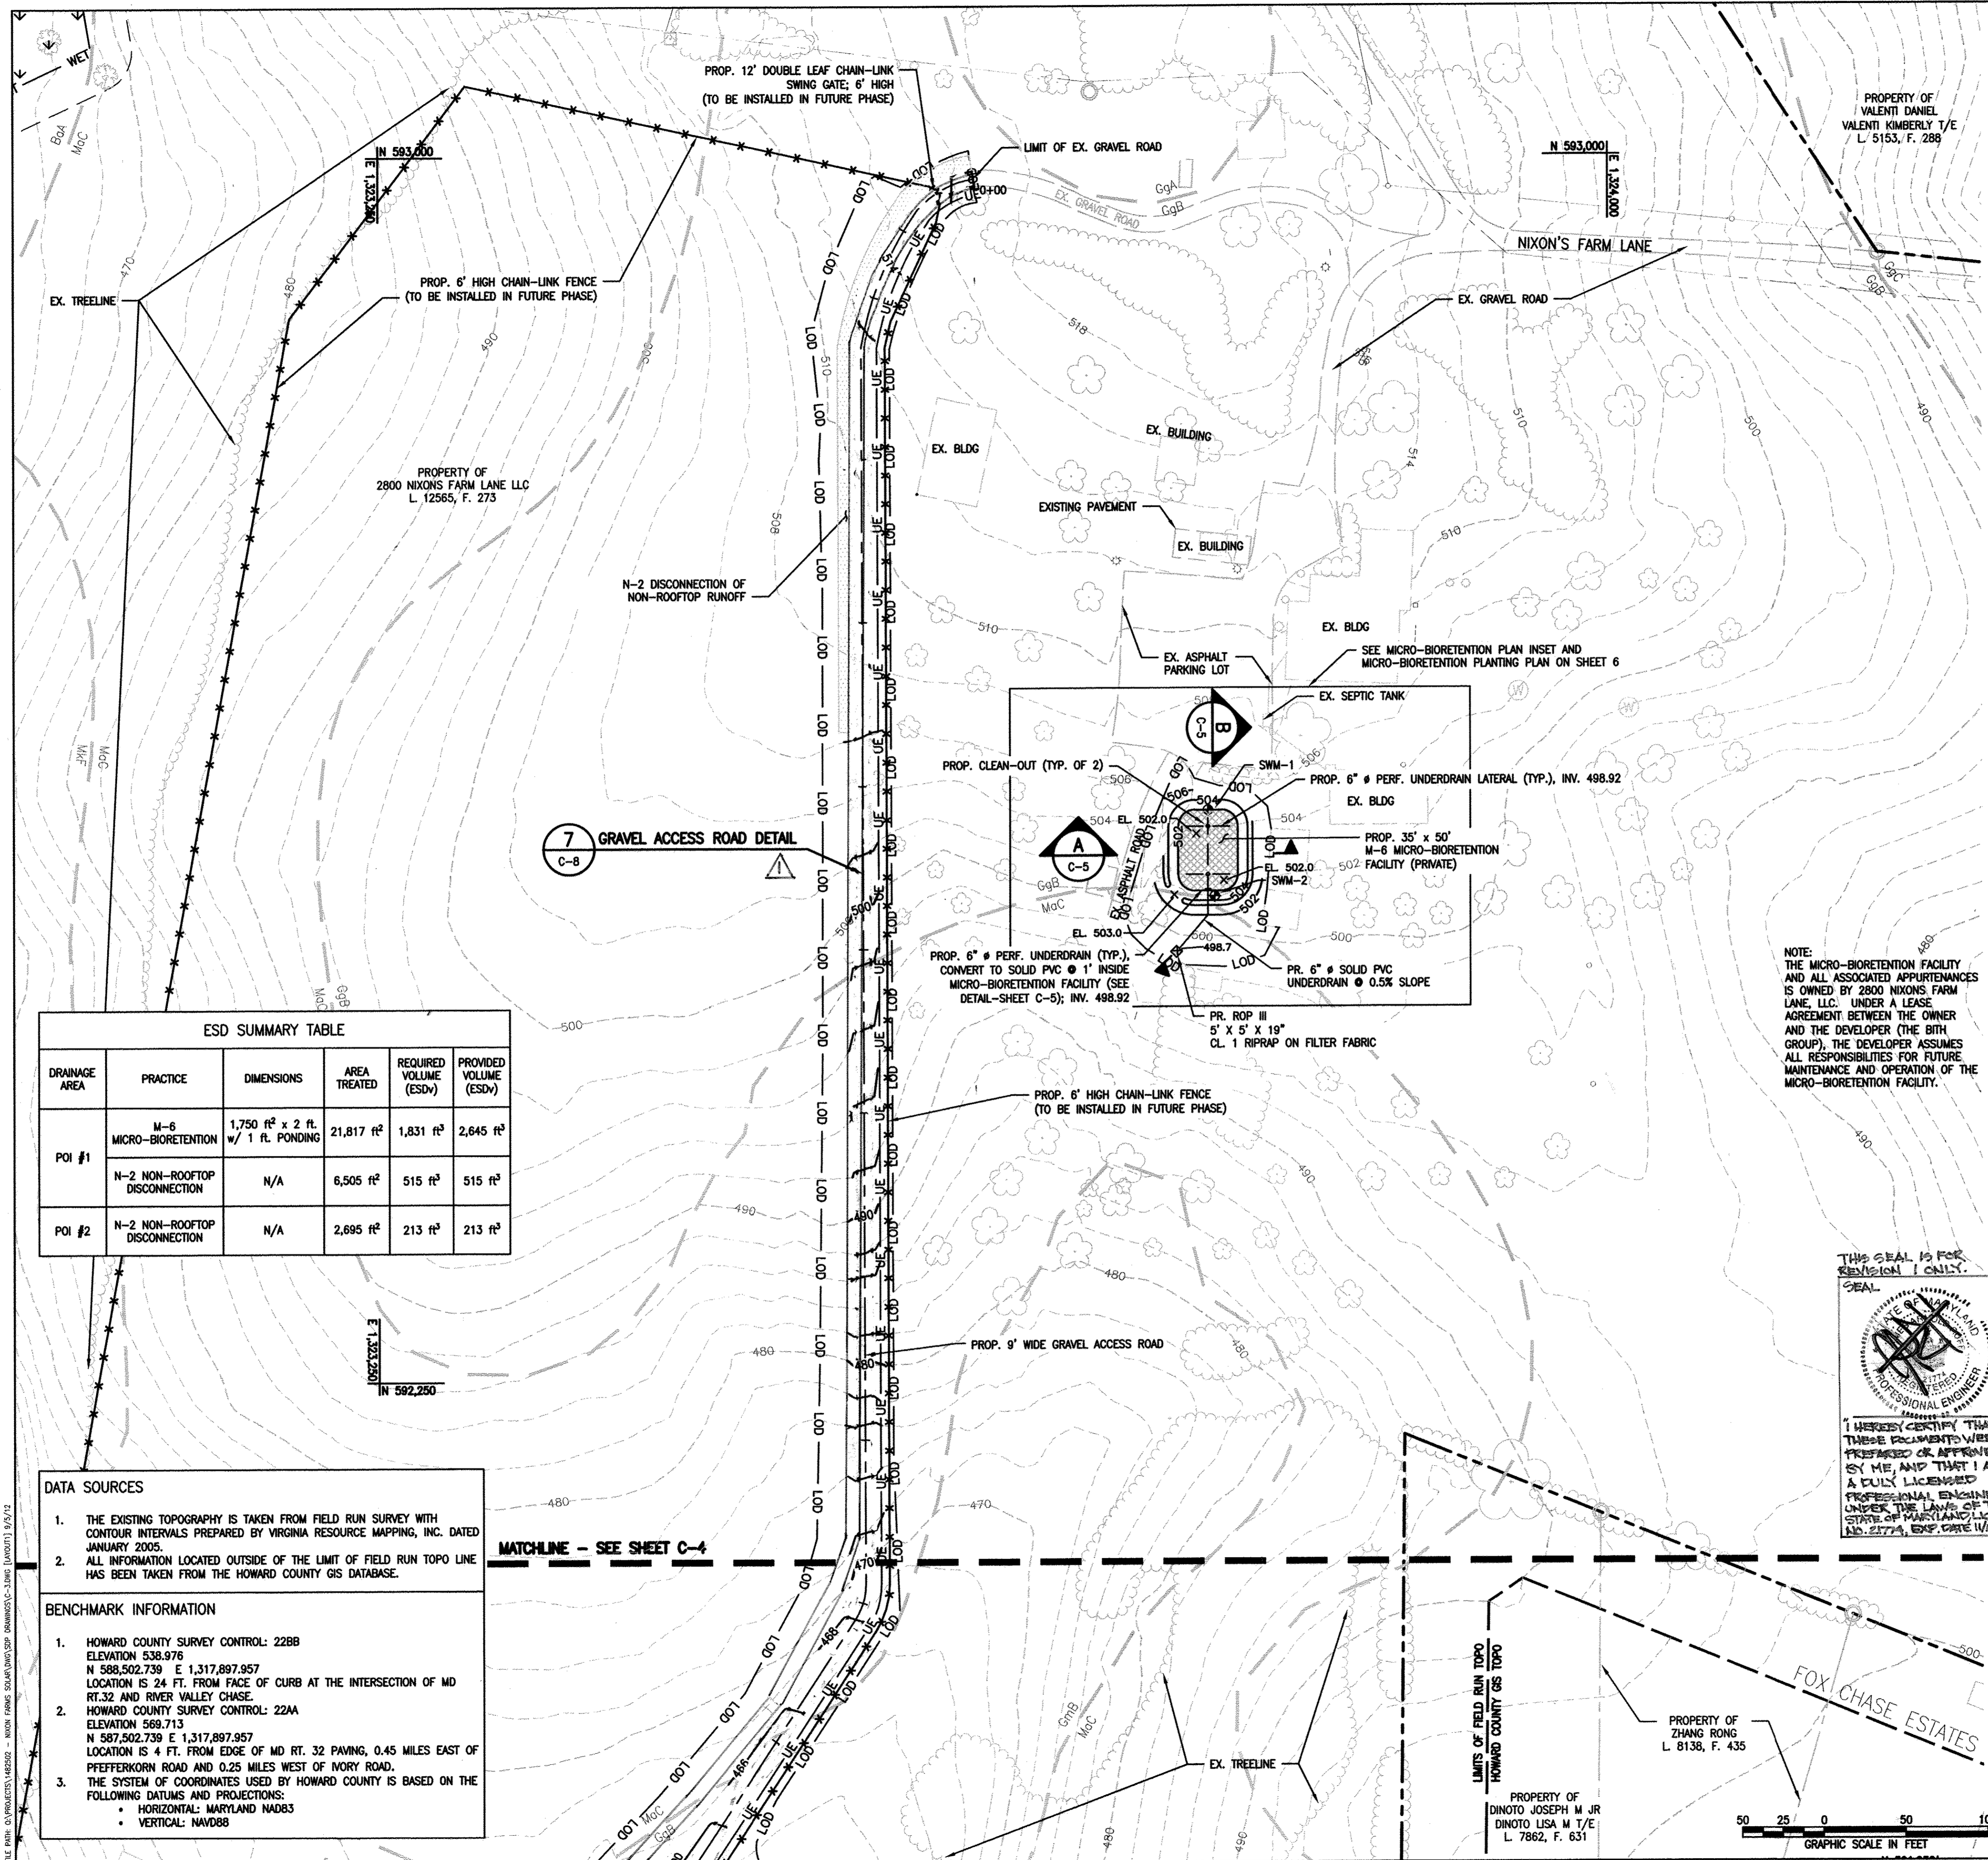

LEGEND

- EX. TREELINE
- PROPERTY LINE
- ADJACENT PROPERTY LINE
- LIMIT OF FIELD RUN TOPO
- EX. MAJOR CONTOUR
- EX. MINOR CONTOUR
- EX. WETLAND BUFFER
- EX. WETLAND
- EX. BUILDING
- EX. WELL
- EX. UTILITY POLE
- EX. IRON PIN
- SLOPE 15% TO 25%
- SLOPE GREATER THAN 25%
- GgC SOIL TYPE BOUNDARY
- GgB SOIL TYPE BOUNDARY
- EX. TREE
- PROP. FENCE (TO BE INSTALLED IN FUTURE PHASE)
- PROP. CONTOURS
- LOD PROP. LIMIT OF DISTURBANCE
- DF PROP. DIVERSION FENCE
- SSF PROP. SUPER SILT FENCE
- UE PROP. UNDERGROUND ELECTRIC
- SD PROP. DIVERSION PIPE
- PROP. SOLAR PANEL
- SWM DISCONNECTION AREA
- SWM NON-DISCONNECTION AREA
- MOUNTABLE BERM
- EROSION AND SEDIMENT CONTROL DRAINAGE AREA LIMIT
- PROP. EARTH DIKE
- SWM-1 SOIL BORING LOCATION

ESD SUMMARY TABLE




DRAINAGE AREA	PRACTICE	DIMENSIONS	AREA TREATED	REQUIRED VOLUME (ESDv)	PROVIDED VOLUME (ESDv)
POI #1	M-6 MICRO-BIORETENTION	1,750 ft ² x 2 ft. w/ 1 ft. PONDING	21,817 ft ²	1,831 ft ³	2,645 ft ³
	N-2 NON-ROOFTOP DISCONNECTION	N/A	6,505 ft ²	515 ft ³	515 ft ³
POI #2	N-2 NON-ROOFTOP DISCONNECTION	N/A	2,695 ft ²	213 ft ³	213 ft ³

DATA SOURCES

- THE EXISTING TOPOGRAPHY IS TAKEN FROM FIELD RUN SURVEY WITH CONTOUR INTERVALS PREPARED BY VIRGINIA RESOURCE MAPPING, INC. DATED JANUARY 2005.
- ALL INFORMATION LOCATED OUTSIDE OF THE LIMIT OF FIELD RUN TOPO LINE HAS BEEN TAKEN FROM THE HOWARD COUNTY GIS DATABASE.

BENCHMARK INFORMATION

- HOWARD COUNTY SURVEY CONTROL: 22BB
ELEVATION 538.976
N 508,502.739 E 1,317,897.957
LOCATION IS 24 FT. FROM FACE OF CURB AT THE INTERSECTION OF MD RT. 32 AND RIVER VALLEY CHASE.
- HOWARD COUNTY SURVEY CONTROL: 22AA
ELEVATION 569.713
N 587,502.739 E 1,317,897.957
LOCATION IS 4 FT. FROM EDGE OF MD RT. 32 PAVING, 0.45 MILES EAST OF PFEFFERKORN ROAD AND 0.25 MILES WEST OF NORVY ROAD.
- THE SYSTEM OF COORDINATES USED BY HOWARD COUNTY IS BASED ON THE FOLLOWING DATUMS AND PROJECTIONS:
 - HORIZONTAL: MARYLAND NAD83
 - VERTICAL: NAVD88

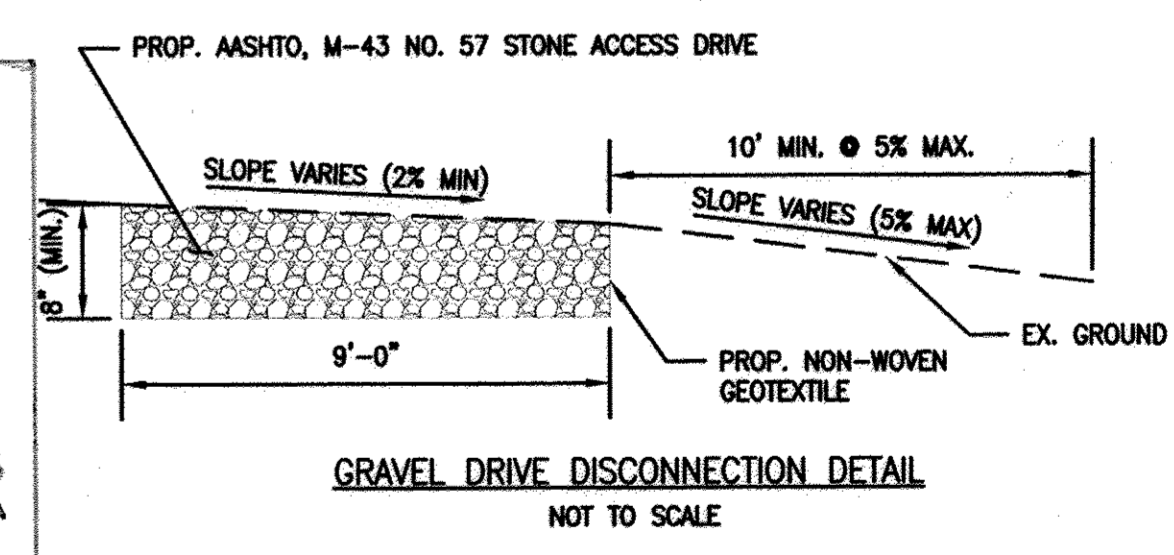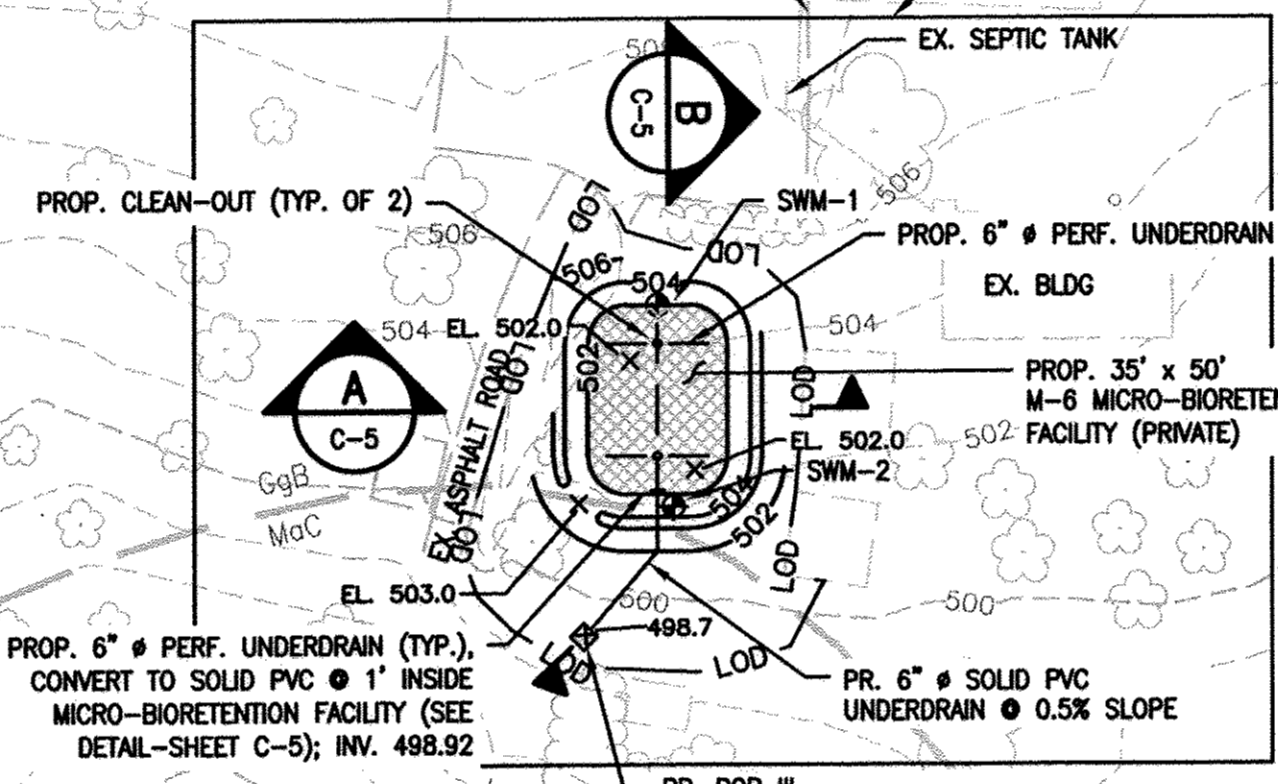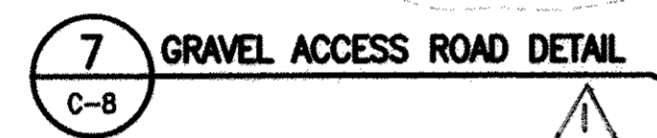

THIS SEAL IS FOR REVISION 1 ONLY.

I HEREBY CERTIFY THAT THESE DOCUMENTS WERE PREPARED OR APPROVED BY ME, AND THAT I AM A DULY LICENSED PROFESSIONAL ENGINEER UNDER THE LAWS OF THE STATE OF MARYLAND LICENSE NO. 21774, EXP. DATE 10/31/12.

APPROVED: DEPARTMENT OF PLANNING AND ZONING


[Signature] 10/2/12
CHIEF, DEVELOPMENT ENGINEERING DIVISION DATE

[Signature] 10/9/12
CHIEF, DIVISION OF LAND DEVELOPMENT DATE

[Signature] 10/3/12
DIRECTOR DATE

DEVELOPER: BITH ENERGY
ATTN: R. DANIEL WALLACE
113 WEST MONUMENT ST.
BALTIMORE, MD 21201
PHONE: (410) 982-1188

OWNER: 2800 NIXON'S FARM LANE, LLC
17500 FREDERICK ROAD
MT. AIRY, MD 21771
PHONE: (410) 461-7200

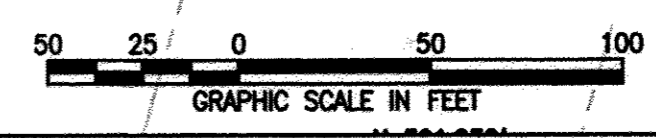

REVISIONS: DESCRIPTION, BY, DATE, NO.

PROFESSIONAL CERTIFICATION: I HEREBY CERTIFY THAT THESE DOCUMENTS WERE PREPARED OR APPROVED BY ME, AND THAT I AM A DULY LICENSED PROFESSIONAL ENGINEER UNDER THE LAWS OF THE STATE OF MARYLAND LICENSE NO. 21774, EXPIRATION DATE: JULY 02, 2013.

SEAL: [Professional Engineer Seal]

BLOCK: N/A
PARCEL: 0080
ELECTION DISTRICT: 3


NIXON FARMS SOLAR PHASE 1
2800 NIXON'S FARM LANE, WEST FRIENDSHIP, MARYLAND 21792

GRID: 16, 17, 22
ZONING: RC-BEO
TAX MAP: 0015

EA ENGINEERING, SCIENCE, AND TECHNOLOGY
Loveton Center
Sparks, Maryland 21152
(410) 771-4950

DATE: AUGUST 2012
DESIGNED BY: MS
DRAWN BY: JSP
CHECKED BY: GAT
PROJECT MANAGER: JMH
PROJECT NUMBER: 14825.02
DRAWING NUMBER: C-3
SHEET NUMBER: 4 OF 13

WIP-13-016

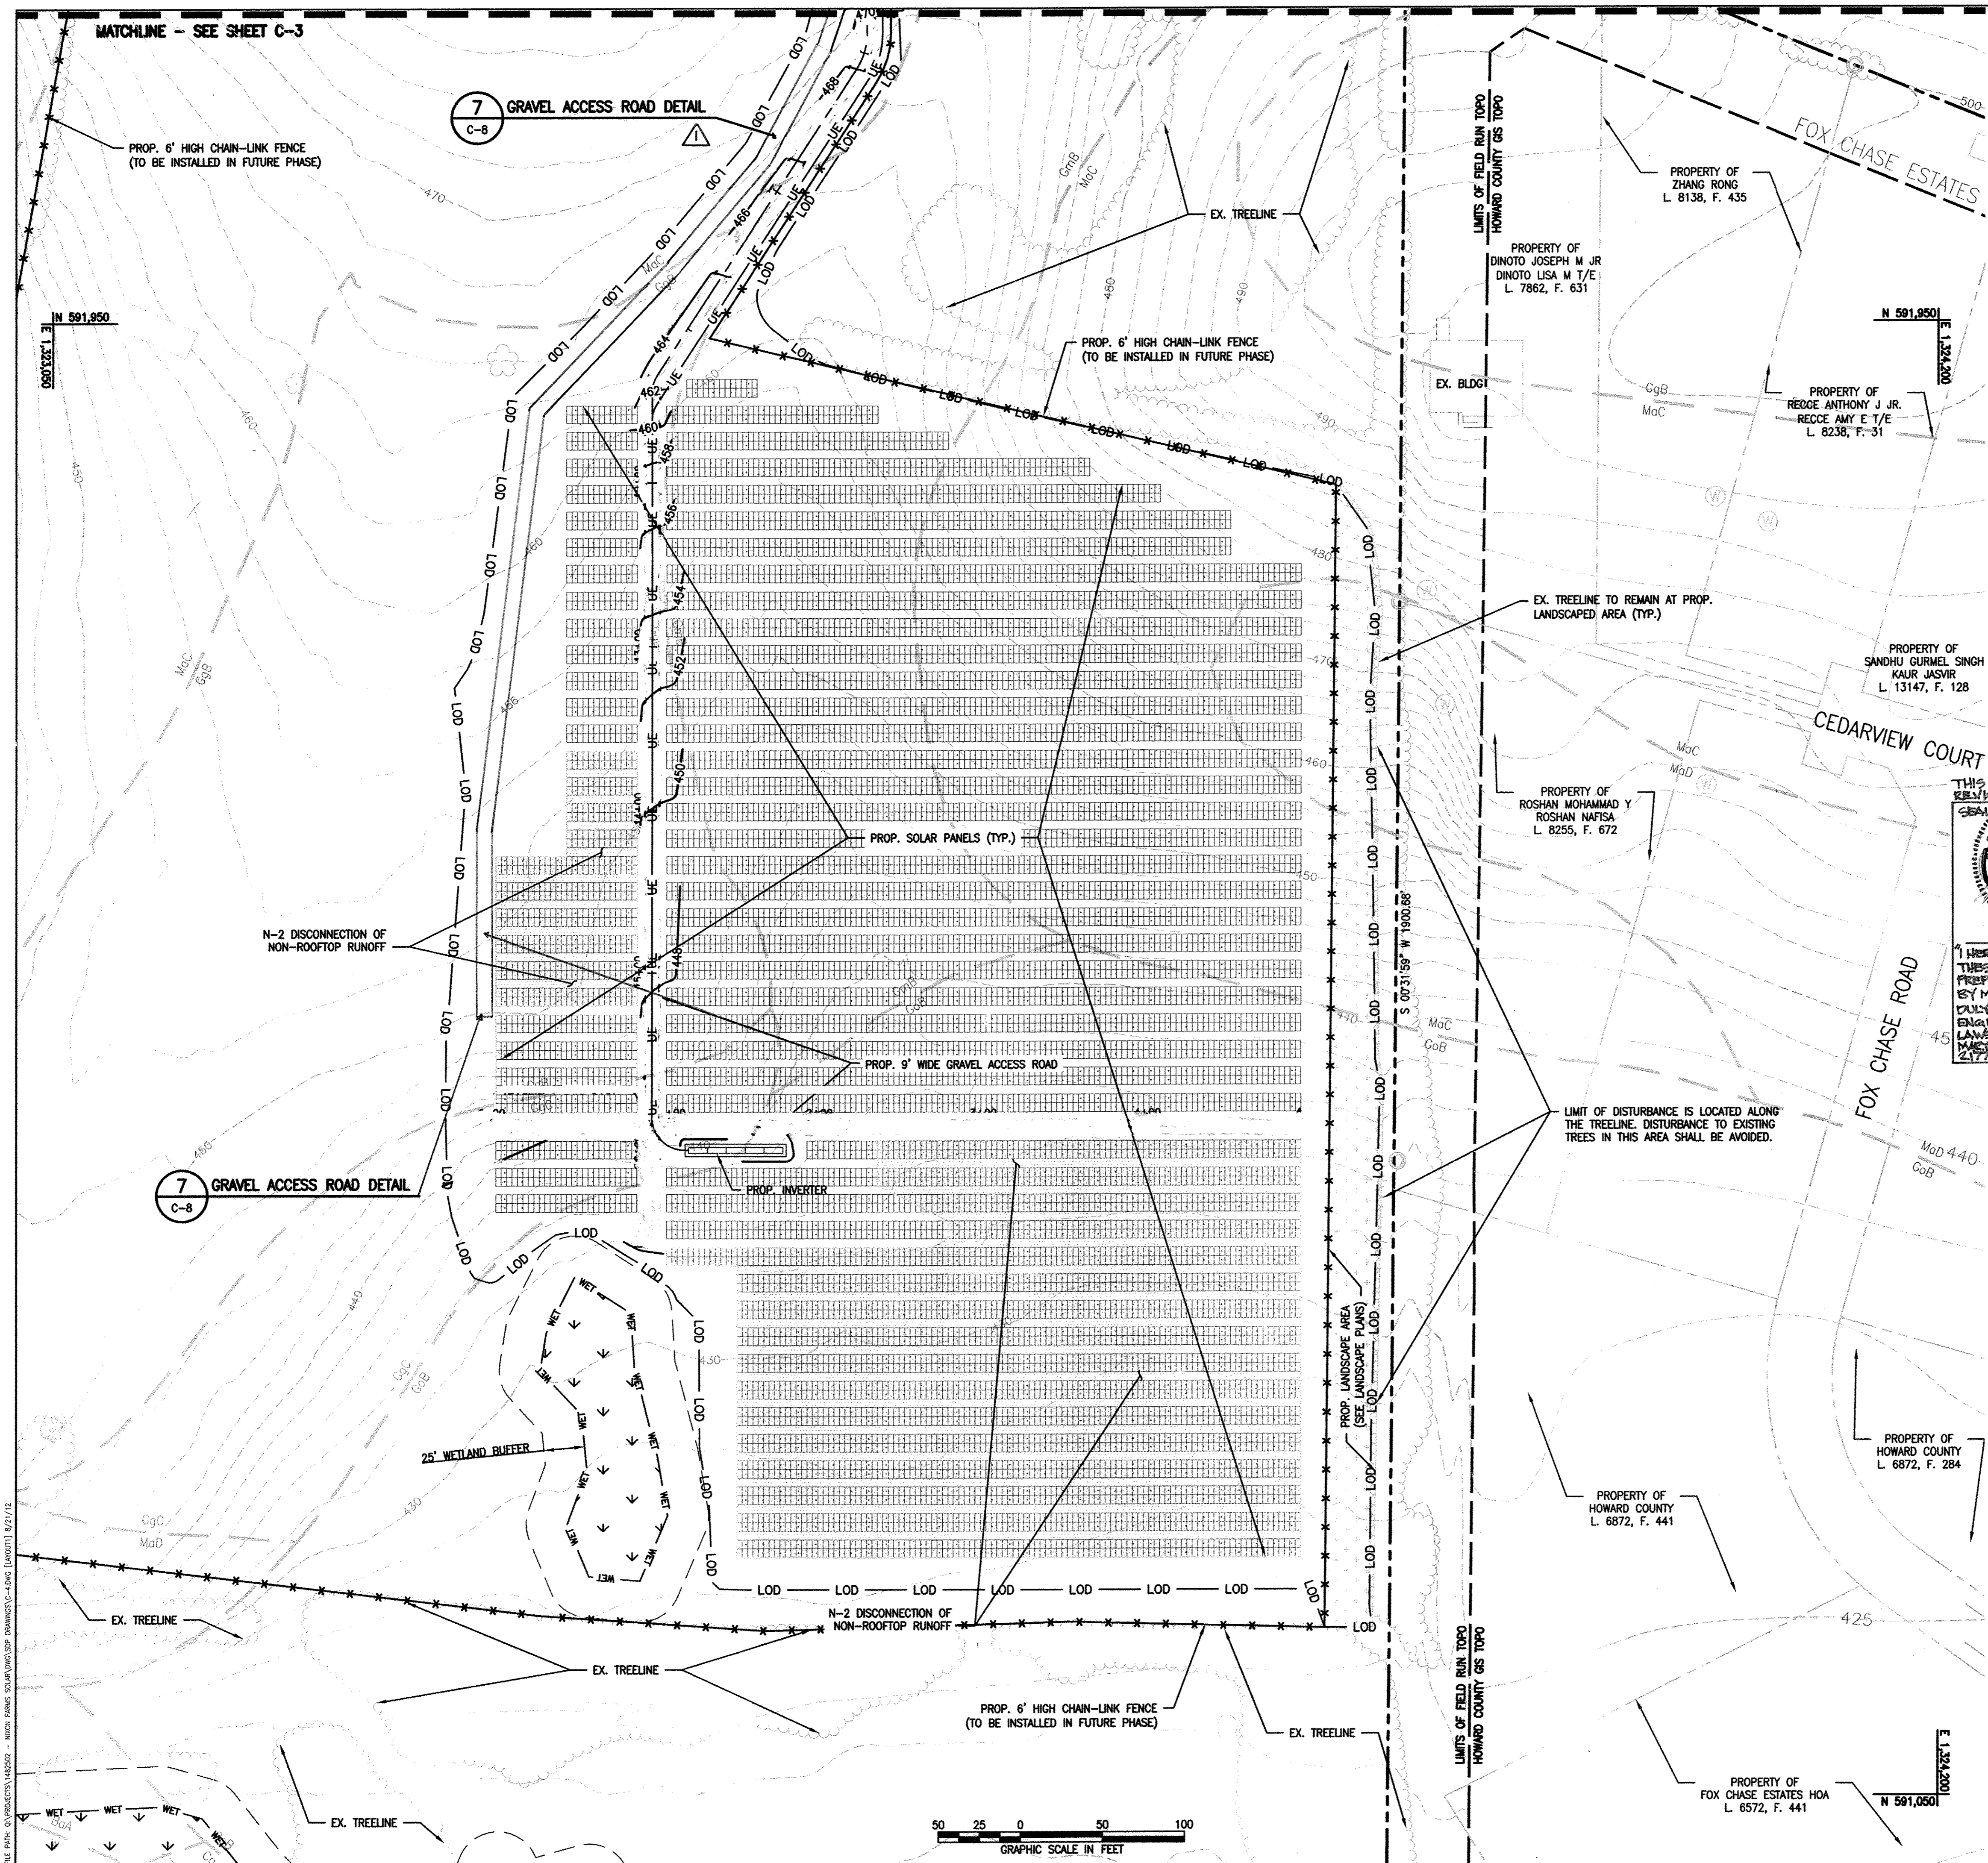

- LEGEND**
- EX. TREELINE
 - PROPERTY LINE
 - ADJACENT PROPERTY LINE
 - LIMIT OF FIELD RUN TOPO
 - EX. MAJOR CONTOUR
 - EX. MINOR CONTOUR
 - EX. WETLAND BUFFER
 - EX. WETLAND
 - EX. BUILDING
 - EX. WELL
 - EX. UTILITY POLE
 - EX. IRON PIN
 - SLOPE 15% TO 25%
 - SLOPE GREATER THAN 25%
 - GgC
 - GgB
 - SOIL TYPE BOUNDARY
 - EX. TREE
 - PROP. FENCE (TO BE INSTALLED IN FUTURE PHASE)
 - PROP. CONTOURS
 - PROP. LIMIT OF DISTURBANCE
 - DF
 - PROP. DIVERSION FENCE
 - SSF
 - PROP. SUPER SILT FENCE
 - UE
 - PROP. UNDERGROUND ELECTRIC
 - SD
 - PROP. DIVERSION PIPE
 - PROP. SOLAR PANEL
 - SWM DISCONNECTION AREA

THIS SEAL IS FOR REVISION ONLY.

I HEREBY CERTIFY THAT THESE DOCUMENTS WERE PREPARED OR APPROVED BY ME AND THAT I AM A FULLY LICENSED PROFESSIONAL ENGINEER UNDER THE LAWS OF THE STATE OF MARYLAND, LICENSE NO. 15653, EXP. DATE: JULY 02, 2013.



- BENCHMARK INFORMATION**
- HOWARD COUNTY SURVEY CONTROL: 22BB
ELEVATION 538.976
N 588,502.739 E 1,317,897.957
LOCATION IS 24 FT. FROM FACE OF CURB AT THE INTERSECTION OF MD RT.32 AND RIVER VALLEY CHASE
 - HOWARD COUNTY SURVEY CONTROL: 22AA
ELEVATION 569.713
N 587,502.739 E 1,317,897.957
LOCATION IS 4 FT. FROM EDGE OF MD RT. 32 PAVING, 0.45 MILES EAST OF PEPPERKORN ROAD AND 0.25 MILES WEST OF IVORY ROAD.
 - THE SYSTEM OF COORDINATES USED BY HOWARD COUNTY IS BASED ON THE FOLLOWING DATUMS AND PROJECTIONS:
 - HORIZONTAL: MARYLAND NAD83
 - VERTICAL: NAVD88

- DATA SOURCES**
- THE EXISTING TOPOGRAPHY IS TAKEN FROM FIELD RUN SURVEY WITH CONTOUR INTERVALS PREPARED BY VIRGINIA RESOURCE MAPPING, INC. DATED JANUARY 2005.
 - ALL INFORMATION LOCATED OUTSIDE OF THE LIMIT OF FIELD RUN TOPO LINE HAS BEEN TAKEN FROM THE HOWARD COUNTY GIS DATABASE.

APPROVED: DEPARTMENT OF PLANNING AND ZONING

CHIEF, DEVELOPMENT ENGINEERING DIVISION: *[Signature]* 10/26/12 DATE

CHIEF, DIVISION OF LAND DEVELOPMENT: *[Signature]* 10/29/12 DATE

DIRECTOR: *[Signature]* 10/9/12 DATE

DEVELOPER: BITH ENERGY
ATTN: R. DANIEL WALLACE
113 WEST MONUMENT ST.
BALTIMORE, MD 21201
PHONE: (410) 962-1188

OWNER: 2800 NIXON'S FARM LANE, LLC
17500 FREDERICK ROAD
MT. AIRY, MD 21771
PHONE: (410) 461-7200

NIXON FARMS SOLAR PHASE 1

2800 NIXON'S FARM LANE, WEST FRIENDSHIP, MARYLAND 21792

STORMWATER MANAGEMENT PLAN II

REVISIONS: REVISION ACCESS ROAD LOCATION

DATE: 5/17/15

NO. 1

PROFESSIONAL CERTIFICATION: I HEREBY CERTIFY THAT THESE DOCUMENTS WERE PREPARED OR APPROVED BY ME AND THAT I AM A FULLY LICENSED PROFESSIONAL ENGINEER UNDER THE LAWS OF THE STATE OF MARYLAND, LICENSE NO. 15653, EXPIRATION DATE: JULY 02, 2013.

SCALE: BLOCK: N/A, PARCEL: 0090, ELECTION DISTRICT: 3

GRID: GRD: 16, 17, 22
ZONING: RO-BEO
TAX MAP: 0015

EA ENGINEERING, SCIENTIFIC AND TECHNOLOGY

15 Loveton Center
Sparks, Maryland 21152
(410) 771-4950

DATE: AUGUST 2012

DESIGNED BY: MBS

DRAWN BY: JSP

CHECKED BY: GAT

PROJECT MANAGER: JMH

PROJECT NUMBER: 14825.02


DRAWING NUMBER: C-4

SHEET NUMBER: 5 OF 13

NP-13-018


MICRO-BIORETENTION PLAN INSET

SEE SHEET 4 FOR FULL SWM PLAN

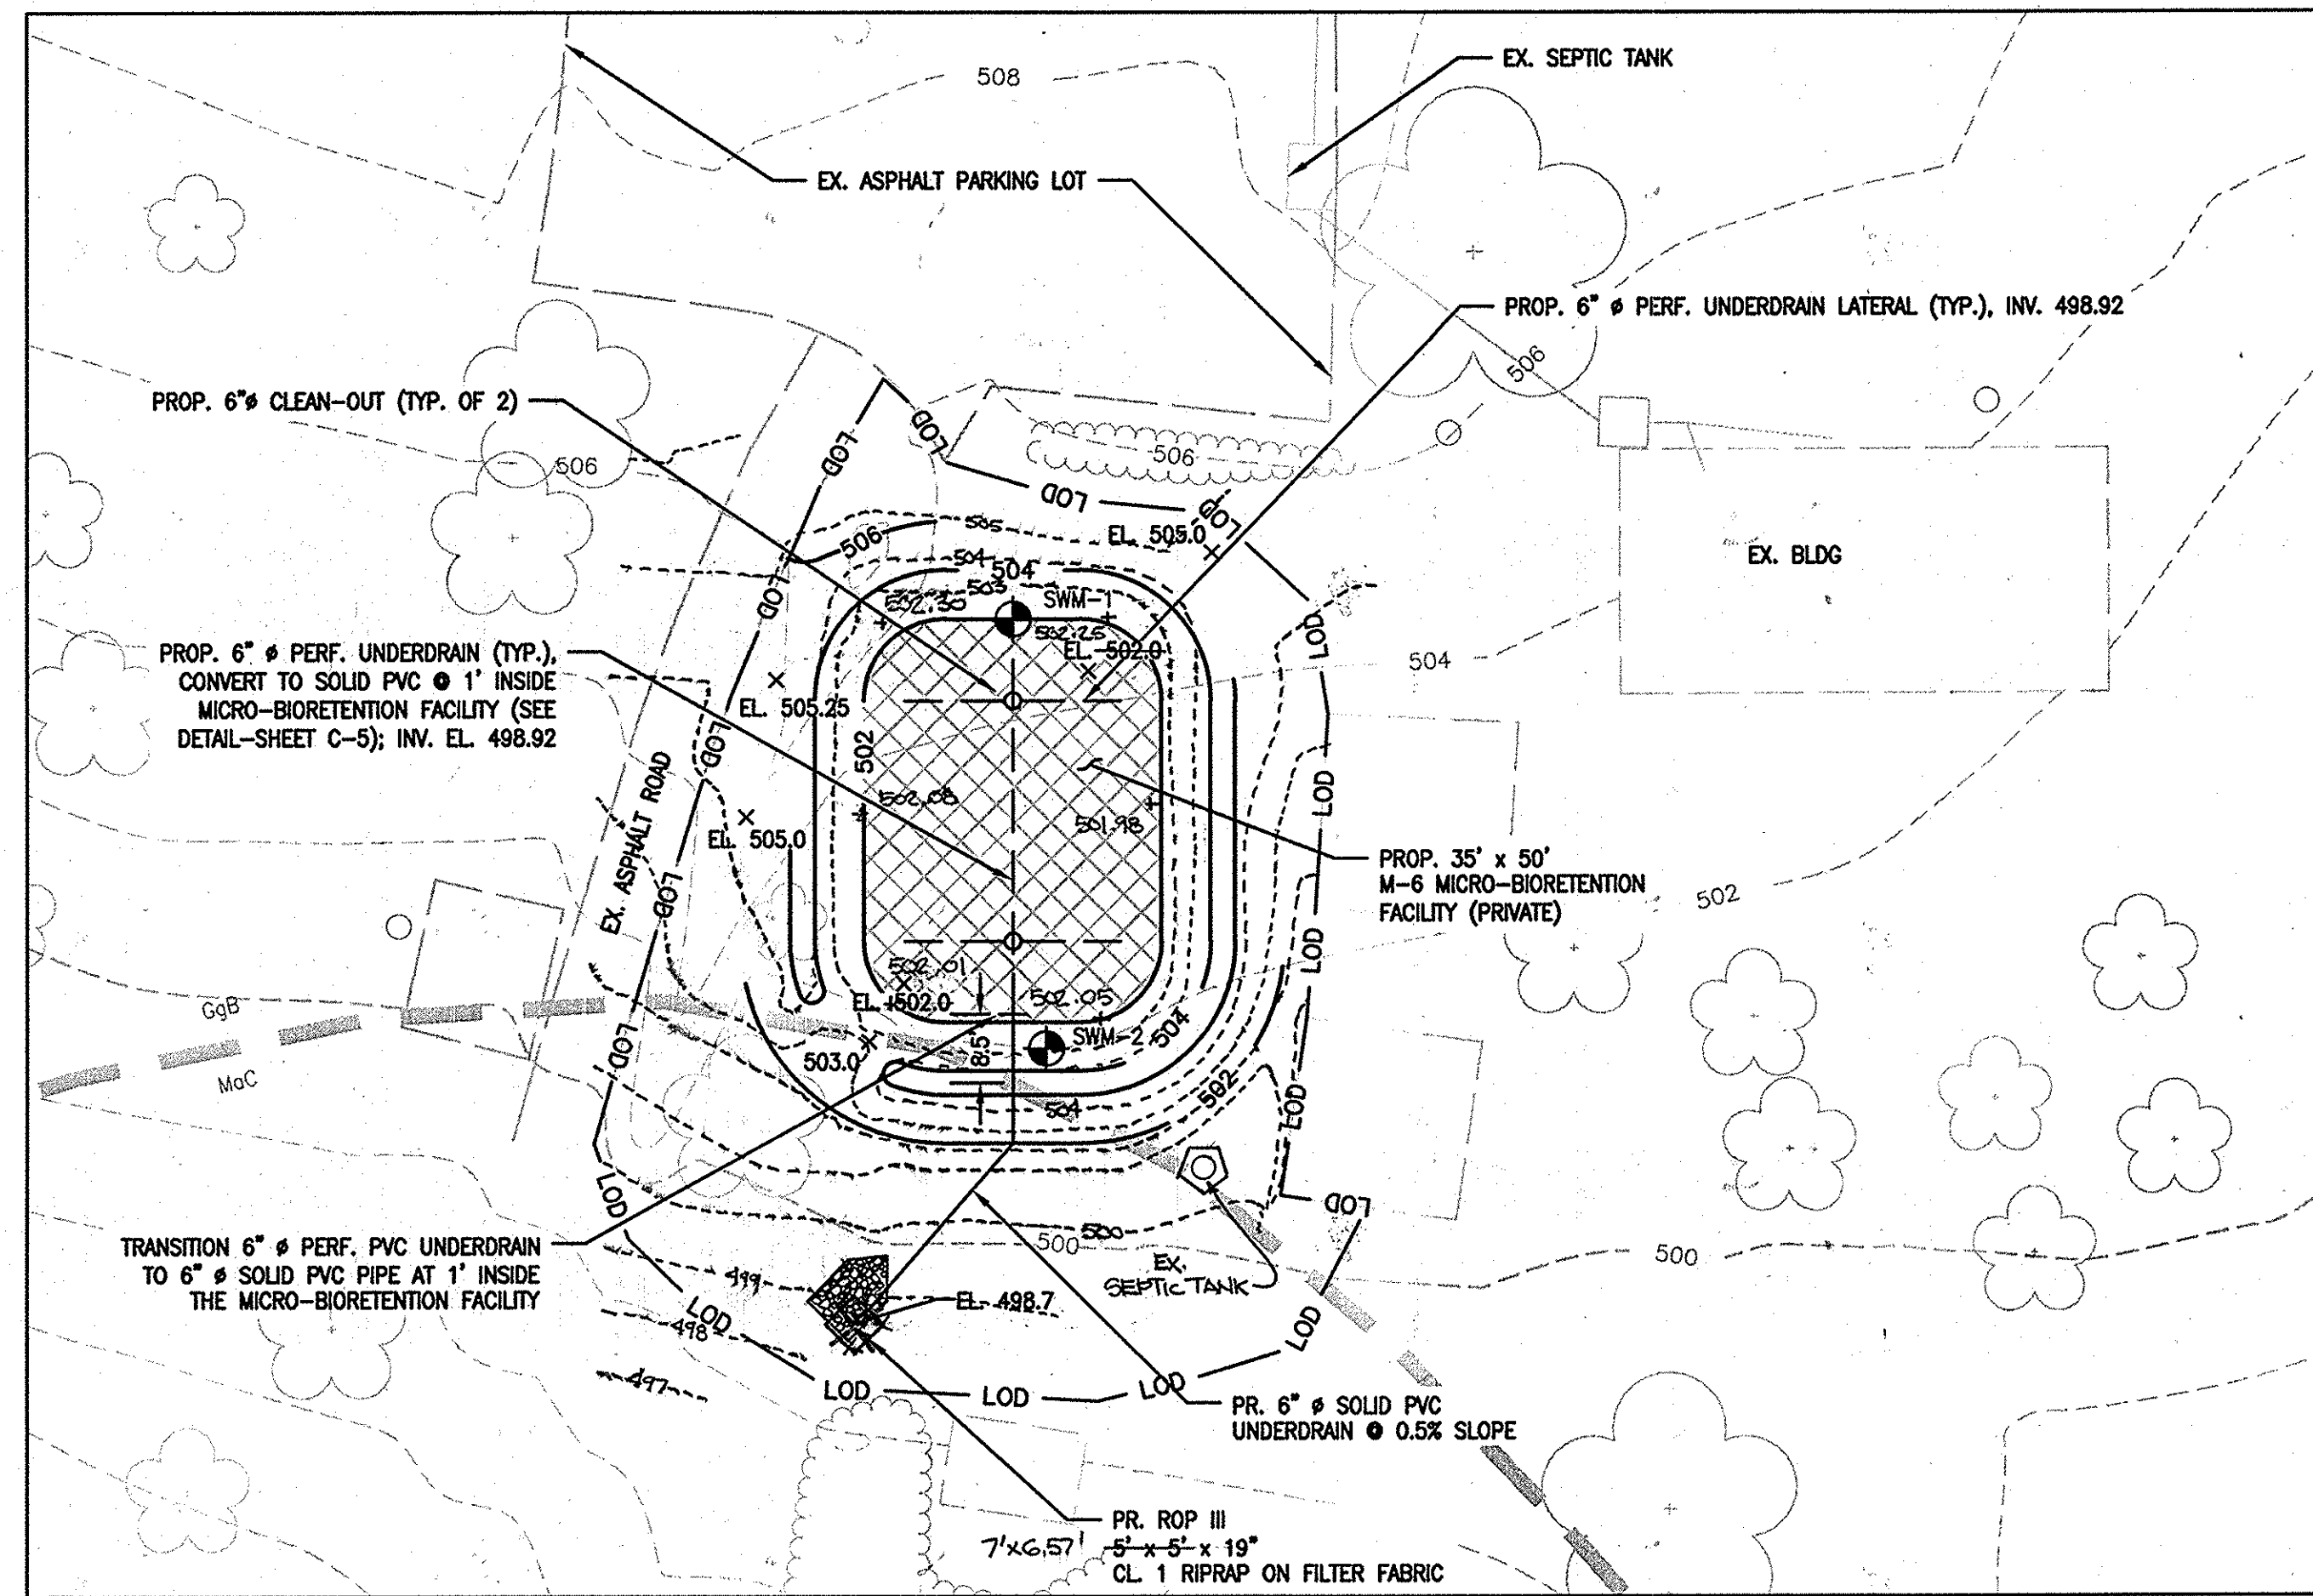

MICRO-BIORETENTION PLANTING PLAN

SEE SHEET 4 FOR FULL SWM PLAN

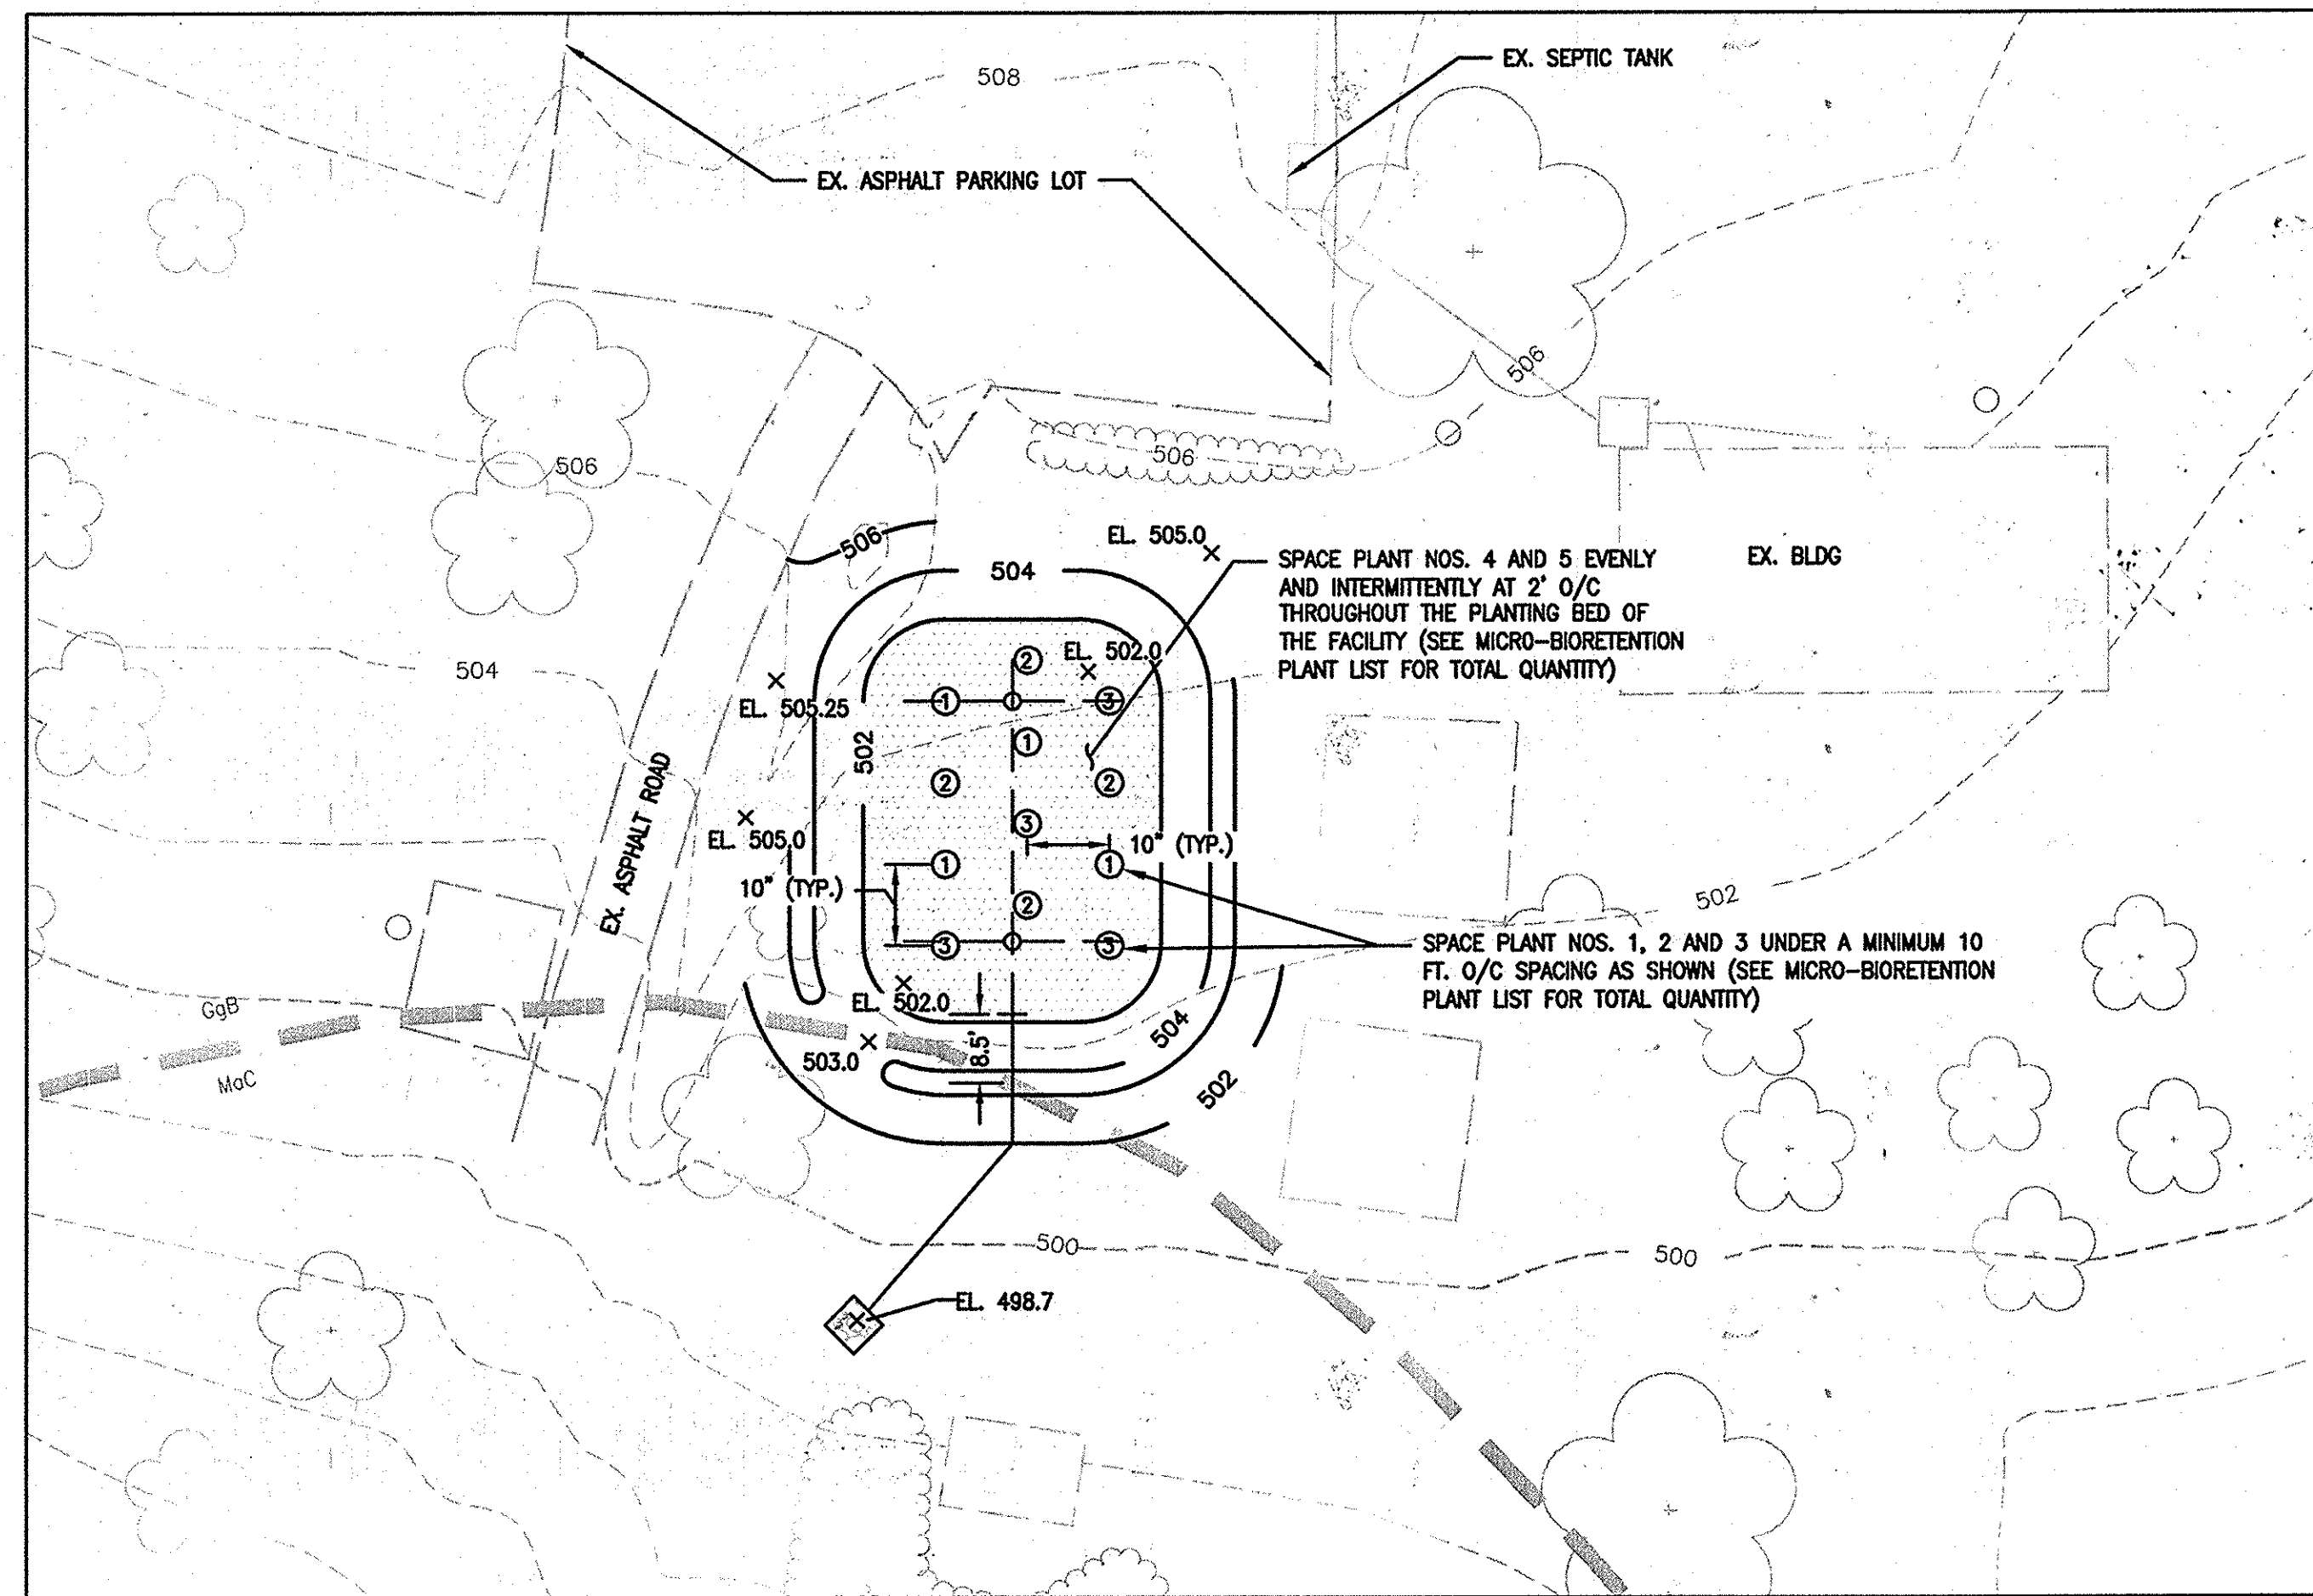

NOTE:

THE MICRO-BIORETENTION FACILITY AND ALL ASSOCIATED APPURTENANCES IS OWNED BY 2800 NIXONS FARM LANE, LLC. UNDER A LEASE AGREEMENT BETWEEN THE OWNER AND THE DEVELOPER (THE BITH GROUP), THE DEVELOPER ASSUMES ALL RESPONSIBILITY FOR FUTURE MAINTENANCE AND OPERATION OF THE MICRO-BIORETENTION FACILITY.

LEGEND

- EX. TREELINE
- PROPERTY LINE
- ADJACENT PROPERTY LINE
- LIMIT OF FIELD RUN TOPO
- 490 EX. MAJOR CONTOUR
- EX. MINOR CONTOUR
- EX. WETLAND BUFFER
- EX. WETLAND
- EX. BUILDING
- EX. WELL
- EX. UTILITY POLE
- EX. IRON PIN
- SLOPE 15% TO 25%
- SLOPE GREATER THAN 25%
- GgC SOIL TYPE BOUNDARY
- GgB
- EX. TREE
- PROP. FENCE (TO BE INSTALLED IN FUTURE PHASE)
- PROP. CONTOURS
- PROP. LIMIT OF DISTURBANCE
- PROP. DIVERSION FENCE
- PROP. SUPER SILT FENCE
- PROP. UNDERGROUND ELECTRIC
- PROP. DIVERSION PIPE
- PROP. SOLAR PANEL
- SWM DISCONNECTION AREA
- SWM NON-DISCONNECTION AREA
- MOUNTABLE BERM
- EROSION AND SEDIMENT CONTROL DRAINAGE AREA LIMIT
- PROP. EARTH DIKE
- SWM-1 SOIL BORING LOCATION
- PLANT ID NUMBER
- PROPOSED SPOT ELEVATION

BENCHMARK INFORMATION

- HOWARD COUNTY SURVEY CONTROL: 2288
ELEVATION 538.976
N 588,502.739 E 1,317,897.957
LOCATION IS 24 FT. FROM FACE OF CURB AT THE INTERSECTION OF MD RT.32 AND RIVER VALLEY CHASE.
- HOWARD COUNTY SURVEY CONTROL: 22AA
ELEVATION 569.713
N 587,502.739 E 1,317,897.957
LOCATION IS 4 FT. FROM EDGE OF MD RT. 32 PAVING, 0.45 MILES EAST OF PFEFFERKORN ROAD AND 0.25 MILES WEST OF IVORY ROAD.
- THE SYSTEM OF COORDINATES USED BY HOWARD COUNTY IS BASED ON THE FOLLOWING DATUMS AND PROJECTIONS:
 - HORIZONTAL: MARYLAND NAD83
 - VERTICAL: NAVD88

DATA SOURCES

- THE EXISTING TOPOGRAPHY IS TAKEN FROM FIELD RUN SURVEY WITH CONTOUR INTERVALS PREPARED BY VIRGINIA RESOURCE MAPPING, INC. DATED JANUARY 2005.
- ALL INFORMATION LOCATED OUTSIDE OF THE LIMIT OF FIELD RUN TOPO LINE HAS BEEN TAKEN FROM THE HOWARD COUNTY GIS DATABASE.


AS-BUILT CERTIFICATION

I HEREBY CERTIFY THAT THE FACILITY SHOWN ON THIS PLAN WAS CONSTRUCTED AS SHOWN ON THE "AS-BUILT" PLANS AND MEETS THE APPROVED PLANS AND SPECIFICATIONS.

FE No. 26816
DATE: 01/30/16

SIGNATURE

I HEREBY CERTIFY THAT THESE DOCUMENTS WERE PREPARED OR APPROVED BY ME, AND THAT I AM A DULY LICENSED PROFESSIONAL ENGINEER UNDER THE LAWS OF THE STATE OF MARYLAND LICENSE NO. 26816, EXPIRATION DATE FEBRUARY 15, 2017.

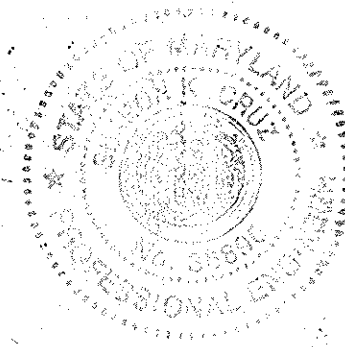

AS-BUILT

MICRO-BIORETENTION PLANT LIST

PLANTING TYPE	PLANTING ID NO.	COMMON NAME	SCIENTIFIC NAME	FORM	MINIMUM SPACING	INDICATOR STATUS	QUANTITY
SHRUBS	1	BUTTONBUSH	Cephalanthus occidentalis	1 GALLON	10' OC	OBL	4
	2	BAYBERRY	Myrica pennsylvanica	1 GALLON	10' OC	FAC	4
HERBACEOUS SPECIES	3	JOE PYE WEED	Eupatorium purpurea	1 QUART	10' OC	FAC	4
	5	WOOLGRASS	Scirpus cyperinus	1 PLUG	2' OC	FACW	220
	5	THREE SQUARE BULLRUSH	Scirpus pungens	1 PLUG	2' OC	FACW+	220

OBL = OBLIGATE WETLAND
FAC = FACULTATIVE
FACW = FACULTATIVE WETLAND
FACW+ = FACULTATIVE WETLAND (WETTER CONDITIONS)

APPROVED: DEPARTMENT OF PLANNING AND ZONING

CHIEF, DEVELOPMENT ENGINEERING DIVISION
DATE: 10/2/12

CHIEF, DIVISION OF LAND DEVELOPMENT
DATE: 10/29/12

DIRECTOR
DATE: 11/9/12

DEVELOPER:
BITH ENERGY
ATTN: R. DANIEL WALLACE
113 WEST MONUMENT ST.
BALTIMORE, MD 21201
PHONE: (410) 962-1188

OWNER:
2800 NIXONS FARM LANE, LLC
17500 FREDERICK ROAD
MT. AIRY, MD 21771
PHONE: (410) 461-7200

PROFESSIONAL CERTIFICATION: I HEREBY CERTIFY THAT THESE DOCUMENTS WERE PREPARED OR APPROVED BY ME, AND THAT I AM A DULY LICENSED PROFESSIONAL ENGINEER UNDER THE LAWS OF THE STATE OF MARYLAND, LICENSE NO. 15423, EXPIRATION DATE: JULY 02, 2013.

DATE: 10/2/12

DATE: 10/29/12

DATE: 11/9/12

GRID: 16, 17, 22
ZONING: RC-DEO
TAX MAP: 0015

BLOCK: N/A
PARCEL: 0900
ELECTION DISTRICT: 3

NIXON FARMS SOLAR PHASE 1
2800 NIXON'S FARM LANE, WEST FRIENDSHIP, MARYLAND 21792

STORMWATER MANAGEMENT PLAN III

EA
EA ENGINEERING, SCIENCE, AND TECHNOLOGY
15 Loveton Circle
Sparks, Maryland 21152
(410) 771-4950

DATE: AUGUST 2012
DESIGNED BY: MS
DRAWN BY: JSP
CHECKED BY: GAT
PROJECT MANAGER: JMH
PROJECT NUMBER: 14825.02
DRAWING NUMBER: C-4A
SHEET NUMBER: 6 OF 13

APPENDIX B.4. CONSTRUCTION SPECIFICATIONS FOR ENVIRONMENTAL SITE DESIGN PRACTICES

B.4.C. SPECIFICATIONS FOR MICRO-BIORETENTION, RAIN GARDENS, LANDSCAPE INFILTRATION AND INFILTRATION BERMS

1. MATERIAL SPECIFICATIONS

THE ALLOWABLE MATERIALS TO BE USED IN THESE PRACTICES ARE DETAILED IN TABLE B.4.1.

2. FILTERING MEDIA OR PLANTING SOIL

THE SOIL SHALL BE A UNIFORM MIX, FREE OF STONES, STUMPS, ROOTS OR OTHER SIMILAR OBJECTS LARGER THAN TWO INCHES. NO OTHER MATERIALS OR SUBSTANCES SHALL BE MIXED OR DUMPED WITHIN THE MICRO-BIORETENTION PRACTICE THAT MAY BE HARMFUL TO PLANT GROWTH, OR PROVE A HINDRANCE TO THE PLANTING OR MAINTENANCE OPERATIONS. THE PLANTING SOIL SHALL BE FREE OF BERMUDA GRASS, QUACKGRASS, JOHNSON GRASS, OR OTHER NOXIOUS WEEDS AS SPECIFIED UNDER COMAR 15.08.01.05.

THE PLANTING SOIL SHALL BE TESTED AND SHALL MEET THE FOLLOWING CRITERIA:

- SOIL COMPONENT - LOAMY SAND OR SANDY LOAM (USDA SOIL TEXTURAL CLASSIFICATION)
- ORGANIC CONTENT - MINIMUM 10% BY DRY WEIGHT (ASTM D 2974). IN GENERAL, THIS CAN BE MET WITH A MIXTURE OF LOAMY SAND (60%-65%) AND COMPOST (35%-40%) OR SANDY LOAM (30%), COARSE SAND (30%), AND COMPOST (40%).
- CLAY CONTENT - MEDIA SHALL HAVE A CLAY CONTENT OF LESS THAN 5%.
- pH RANGE - SHOULD BE BETWEEN 5.5-7.0. AMENDMENTS MAY BE MIXED INTO THE SOIL TO INCREASE OR DECREASE pH.

THERE SHALL BE AT LEAST ONE SOIL TEST PER PROJECT. EACH TEST SHALL CONSIST OF BOTH THE STANDARD SOIL TEST FOR pH, AND ADDITIONAL TESTS OF ORGANIC MATTER, AND SOLUBLE SALTS. A TEXTURAL ANALYSIS IS REQUIRED FROM THE SITE STOCKPILED TOPSOIL. IF TOPSOIL IS IMPORTED, THEN A TEXTURE ANALYSIS SHALL BE PERFORMED FOR EACH LOCATION WHERE THE TOPSOIL IS EXCAVATED.

3. COMPACTION

IT IS VERY IMPORTANT TO MINIMIZE COMPACTION OF BOTH THE BASE OF BIORETENTION PRACTICES AND THE REQUIRED BACKFILL. WHEN POSSIBLE, USE EXCAVATION HOES TO REMOVE ORIGINAL SOIL. IF PRACTICES ARE EXCAVATED USING A LOADER, THE CONTRACTOR SHOULD USE A WIDE TRACK OR MARCH TRACK EQUIPMENT, OR LIGHT EQUIPMENT WITH TURF TYPE TIRES. USE OF EQUIPMENT WITH NARROW TRACKS OR NARROW TIRES, RUBBER TIRES WITH LARGE LUGS, OR HIGH-PRESSURE TIRES WILL CAUSE EXCESSIVE COMPACTION RESULTING IN REDUCED INFILTRATION RATES AND IS NOT ACCEPTABLE. COMPACTION WILL SIGNIFICANTLY CONTRIBUTE TO DESIGN FAILURE.

COMPACTION CAN BE ALLEMIATED AT THE BASE OF THE BIORETENTION FACILITY BY USING A PRIMARY TILLING OPERATION SUCH AS A CHISEL PLOW, RIPPER, OR SUBSOILER. THESE TILLING OPERATIONS ARE TO REFRACATURE THE SOIL PROFILE THROUGH THE 12 INCH COMPACTION ZONE. SUBSTITUTE METHODS MUST BE APPROVED BY THE ENGINEER. ROTOTILLERS TYPICALLY DO NOT TILL DEEP ENOUGH TO REDUCE THE EFFECTS OF COMPACTION FROM HEAVY EQUIPMENT.

ROTOTILL 2 TO 3 INCHES OF SAND INTO THE BASE OF THE BIORETENTION FACILITY BEFORE BACKFILLING THE OPTIONAL SAND LAYER. PUMP ANY PONDED WATER BEFORE PREPARING (ROTOTILLING) BASE.

WHEN BACKFILLING THE TOPSOIL OVER THE SAND LAYER, FIRST PLACE 3-4 INCHES OF TOPSOIL OVER THE SAND, THEN ROTOTILL THE SAND/TOPSOIL TO CREATE A GRADATION ZONE. BACKFILL THE REMAINDER OF THE TOPSOIL TO FINAL GRADE.

WHEN BACKFILLING THE BIORETENTION FACILITY, PLACE SOIL IN LIFTS OF 12" TO 18". DO NOT USE HEAVY EQUIPMENT WITHIN THE BIORETENTION BASIN. HEAVY EQUIPMENT CAN BE USED AROUND THE PERIMETER OF THE BASIN TO SUPPLY SOILS AND SAND. GRADE BIORETENTION MATERIALS WITH LIGHT EQUIPMENT SUCH AS A COMPACT LOADER OR A DOZER/LOADER WITH MARSH TRACKS.

4. PLANT MATERIAL

RECOMMENDED PLANT MATERIAL FOR MICRO-BIORETENTION PRACTICES CAN BE FOUND IN APPENDIX A, SECTION A.2.3.

5. PLANT INSTALLATION

COMPOST IS A BETTER ORGANIC MATERIAL SOURCE, IS LESS LIKELY TO FLOAT, AND SHOULD BE PLACED IN THE INVERT AND OTHER LOW AREAS. MULCH SHOULD BE PLACED IN SURROUNDING TO A UNIFORM THICKNESS OF 2" TO 3". SHREDDED OR CHIPPED HARDWOOD MULCH IS THE ONLY ACCEPTED MULCH. PINE MULCH AND WOOD CHIPS WILL FLOAT AND MOVE TO THE PERIMETER OF THE BIORETENTION AREA DURING A STORM EVENT AND ARE NOT ACCEPTABLE. SHREDDED MULCH MUST BE WELL AGED (6 TO 12 MONTHS) FOR ACCEPTANCE.

ROOTSTOCK OF THE PLANT MATERIAL SHALL BE KEPT MOIST DURING TRANSPORT AND ON-SITE STORAGE. THE PLANT ROOT BALL SHOULD BE PLANTED SO 1/4th OF THE BALL IS ABOVE FINAL GRADE SURFACE. THE DIAMETER OF THE PLANTING PIT SHALL BE AT LEAST SIX INCHES LARGER THAN THE DIAMETER OF THE PLANTING BALL. SET AND MAINTAIN THE PLANT STRAIGHT DURING THE ENTIRE PLANTING PROCESS. THOROUGHLY WATER GROUND BED COVER AFTER INSTALLATION.

TREES SHALL BE BRACED USING 2" BY 2" STAKES ONLY AS NECESSARY AND FOR THE FIRST GROWING SEASON ONLY. STAKES ARE TO BE EQUALLY SPACED ON THE OUTSIDE OF THE TREE BALL.

GRASSES AND LEGUME SEED SHOULD BE DRILLED INTO THE SOIL TO A DEPTH OF AT LEAST ONE INCH. GRASS AND LEGUME PLUGS SHALL BE PLANTED FOLLOWING THE NON-GRASS GROUND COVER PLANTING SPECIFICATIONS.

THE TOPSOIL SPECIFICATIONS PROVIDE ENOUGH ORGANIC MATERIAL TO ADEQUATELY SUPPLY NUTRIENTS FROM NATURAL CYCLING. THE PRIMARY FUNCTION OF THE BIORETENTION STRUCTURE IS TO IMPROVE WATER QUALITY. ADDING FERTILIZERS DEFEATS, OR AT A MINIMUM, IMPEDES THIS GOAL. ONLY ADD FERTILIZER IF WOOD CHIPS OR MULCH ARE USED TO AMEND THE SOIL. ROTOTILL UREA FERTILIZER AT A RATE OF 2 POUNDS PER 1000 SQUARE FEET.

6. UNDERDRAINS

UNDERDRAINS SHOULD MEET THE FOLLOWING CRITERIA:

- PIPE - SHOULD BE 4" TO 6" DIAMETER, SLOTTED OR PERFORATED RIGID PLASTIC PIPE (ASTM F 758, TYPE PS 28, OR AASHTO-M-278) IN A GRAVEL LAYER. THE PREFERRED MATERIAL IS SLOTTED, 4" RIGID PIPE (e.g., PVC OR HDPE).
- PERFORATIONS - IF PERFORATED PIPE IS USED, PERFORATIONS SHOULD BE 3/8" DIAMETER LOCATED 6" ON CENTER WITH A MINIMUM OF FOUR HOLES PER ROW. PIPE SHALL BE WRAPPED WITH A 1/2" (NO. 4 OR 4x4) GALVANIZED HARDWARE CLOTH.
- GRAVEL - THE GRAVEL LAYER (NO. 57 STONE PREFERRED) SHALL BE AT LEAST 3" THICK ABOVE AND BELOW THE UNDERDRAIN.
- THE MAIN COLLECTOR PIPE SHALL BE AT A MINIMUM OF 0.50% SLOPE.
- A RIGID, NON-PERFORATED OBSERVATION WELL MUST BE PROVIDED (ONE PER EVERY 1,000 SQUARE FEET) TO PROVIDE A CLEAN-OUT PORT AND MONITOR PERFORMANCE OF THE FILTER.
- A 4" LAYER OF PEA GRAVEL (3/8" TO 3/4" STONE) SHALL BE LOCATED BETWEEN THE FILTER MEDIA AND UNDERDRAIN TO PREVENT MIGRATION OF FINES INTO THE UNDERDRAIN. THIS LAYER MAY BE CONSIDERED PART OF THE FILTER BED WHEN BED THICKNESS EXCEEDS 24".

THE MAIN COLLECTOR PIPE FOR UNDERDRAIN SYSTEMS SHALL BE CONSTRUCTED AT A MINIMUM SLOPE OF 0.5% OBSERVATION WELLS AND/OR CLEAN-OUT PIPES MUST BE PROVIDED (ONE MINIMUM PER EVERY 1,000 SQUARE FEET OF SURFACE AREA).

7. MISCELLANEOUS

THESE PRACTICES MAY NOT BE CONSTRUCTED UNTIL ALL CONTRIBUTING DRAINAGE AREA HAS BEEN STABILIZED.

OPERATION AND MAINTENANCE SCHEDULE FOR LANDSCAPE INFILTRATION (M-3), MICRO-BIORETENTION (M-6), RAIN GARDENS (M-7), BIORETENTION SWALE (M-8), ENHANCED FILTERS (M-9)

- ANNUAL MAINTENANCE OF PLANT MATERIAL, MULCH LAYER AND SOIL LAYER IS REQUIRED. MAINTENANCE OF MULCH AND SOIL IS LIMITED TO CORRECTING AREAS OF EROSION OR WASH OUT. ANY MULCH REPLACEMENT SHALL BE DONE IN THE SPRING. PLANT MATERIAL SHALL BE CHECKED FOR DISEASE AND INSECT INFESTATION AND MAINTENANCE WILL ADDRESS DEAD MATERIAL AND PRUNING. ACCEPTABLE REPLACEMENT PLANT MATERIAL IS LIMITED TO THE FOLLOWING: 2000 MARYLAND STORMWATER DESIGN MANUAL VOLUME II, TABLE A.4.1 AND 2.
- SCHEDULE OF PLANT INSPECTION WILL BE TWICE A YEAR IN SPRING AND FALL. THIS INSPECTION WILL INCLUDE REMOVAL OF DEAD AND DISEASED VEGETATION CONSIDERED BEYOND TREATMENT, TREATMENT OF ALL DISEASED TREES AND SHRUBS AND REPLACEMENT OF ALL DEFICIENT STAKES AND WIRES.
- MULCH SHALL BE INSPECTED EACH SPRING. REMOVE PREVIOUS MULCH LAYER BEFORE APPLYING NEW LAYER ONCE EVERY 2 TO 3 YEARS.
- SOIL EROSION TO BE ADDRESSED ON AN AS NEEDED BASIS, WITH A MINIMUM OF ONCE PER MONTH AND AFTER HEAVY STORM EVENTS.

OPERATION AND MAINTENANCE SCHEDULE FOR PRIVATELY OWNED AND MAINTAINED DISCONNECTION OF ROOFTOP RUNOFF (N-1), DISCONNECTION OF NON-ROOFTOP RUNOFF (N-2)

- MAINTENANCE OF AREAS RECEIVING DISCONNECTED RUNOFF IS GENERALLY NO DIFFERENT THAN THAT REQUIRED FOR OTHER LAWN OR LANDSCAPED AREAS. THE AREAS RECEIVING RUNOFF SHOULD BE PROTECTED FROM FUTURE COMPACTION OR DEVELOPMENT OF IMPERVIOUS AREA. IN COMMERCIAL AREAS, FOOT TRAFFIC SHOULD BE DISCOURAGED AS WELL.


Plantings	See Plant List (This Sheet)	n/a	Plantings are Site-specific
Planting Soil [2' to 4' deep]	loamy sand (60 - 65%) & compost (35 - 40%) or sandy loam (30%), coarse sand (30%) & compost (40%)	n/a	USDA soil types loamy sand or sandy loam; clay content < 5%
Organic content	Min. 10% by dry weight (ASTM-D-2974)		
Mulch	shredded hardwood		Aged 6 months, minimum; no pine or wood chips
Pea gravel diaphragm	pea gravel: ASTM-D-448	No. 8 or No. 9 (1/8" to 3/8")	
Curtain drain	ornamental stone: washed cobbles	stone: 2" to 5"	
Geotextile		n/a	PE Type I nonwoven
Gravel (underdrains and infiltration berms)	AASHTO M-43	No. 57 or No. 6 Aggregate (3/8" to 3/4")	
Underdrain Piping	F 758, Type PS 28 or AASHTO M-278	4" to 6" rigid Sch. 40 PVC or SDR35	Slotted or perforated pipe; 3/8" perf. @ 6" on center, 4 holes per row; minimum of 3" of gravel over pipes; not necessary underneath pipes. Perforated pipe shall be wrapped with 1/4-inch galvanized hardware cloth
Poured in place concrete (if required)	MSHA Mix No. 3; f'c = 3500 psi @ 28 days, normal weight, air-entrained; reinforcing to meet ASTM-615-60	n/a	On-site testing of poured-in-place concrete required: 28 day strength and slump test; all concrete design (cast-in-place or pre-cast) not using previously approved State or Local standards requires design drawings sealed and approved by a professional structural engineer licensed in the State of Maryland - design to include meeting ACI Code 350.R/89; vertical loading [H-10 or H-20]; allowable horizontal loading (based on soil pressures); and analysis of potential cracking
Sand	AASHTO-M-6 or ASTM-C-33	0.02" to 0.04"	Sand substitutions such as Diabase and Graystone (AASHTO) #10 are not acceptable. No calcium carbonated or dolomitic sand substitutions are acceptable. No "rock dust" can be used for sand.

AS-BUILT CERTIFICATION
I HEREBY CERTIFY THAT THE FACILITY SHOWN ON THIS PLAN WAS CONSTRUCTED AS SHOWN ON THE "AS-BUILT" PLANS AND MEETS THE APPROVED PLANS AND SPECIFICATIONS.
SIGNATURE: [Signature] PE No. 38896 DATE: 6/20/16

I HEREBY CERTIFY THAT THESE DOCUMENTS WERE PREPARED OR APPROVED BY ME, AND THAT I AM A DULY LICENSED PROFESSIONAL ENGINEER UNDER THE LAWS OF THE STATE OF MARYLAND LICENSE NO. 38896 EXPIRATION DATE FEBRUARY 15, 2017.

FEATURE	DESIGN	*AS-BUILT
FILTER BED DIMENSIONS (L X W)	35' x 50'	35' x 40.5'
FILTER BED SURFACE ELEVATION	EL. 502.00	EL. 501.98
MULCH DEPTH	3 in.	
OUTLET PIPE (UNDERDRAIN) SIZE/INVERT ELEVATION	6" / 498.92	6" / 499.26
THICKNESS OF SAND	6 in.	
PLACEMENT OF GEOTEXTILE	✓	
PLANTINGS	✓	
THICKNESS OF GRAVEL	12 in.	
OBSERVATION WELL WITH DEPTH TO FILTER BOTTOM INDICATED ON CAP	✓	
OVERFLOW WEIR ELEVATION/WIDTH	EL. 503.00 / 5'	EL. 503.28 / 6'
PLANTING MEDIA	24"	


Date As-Built Accepted:

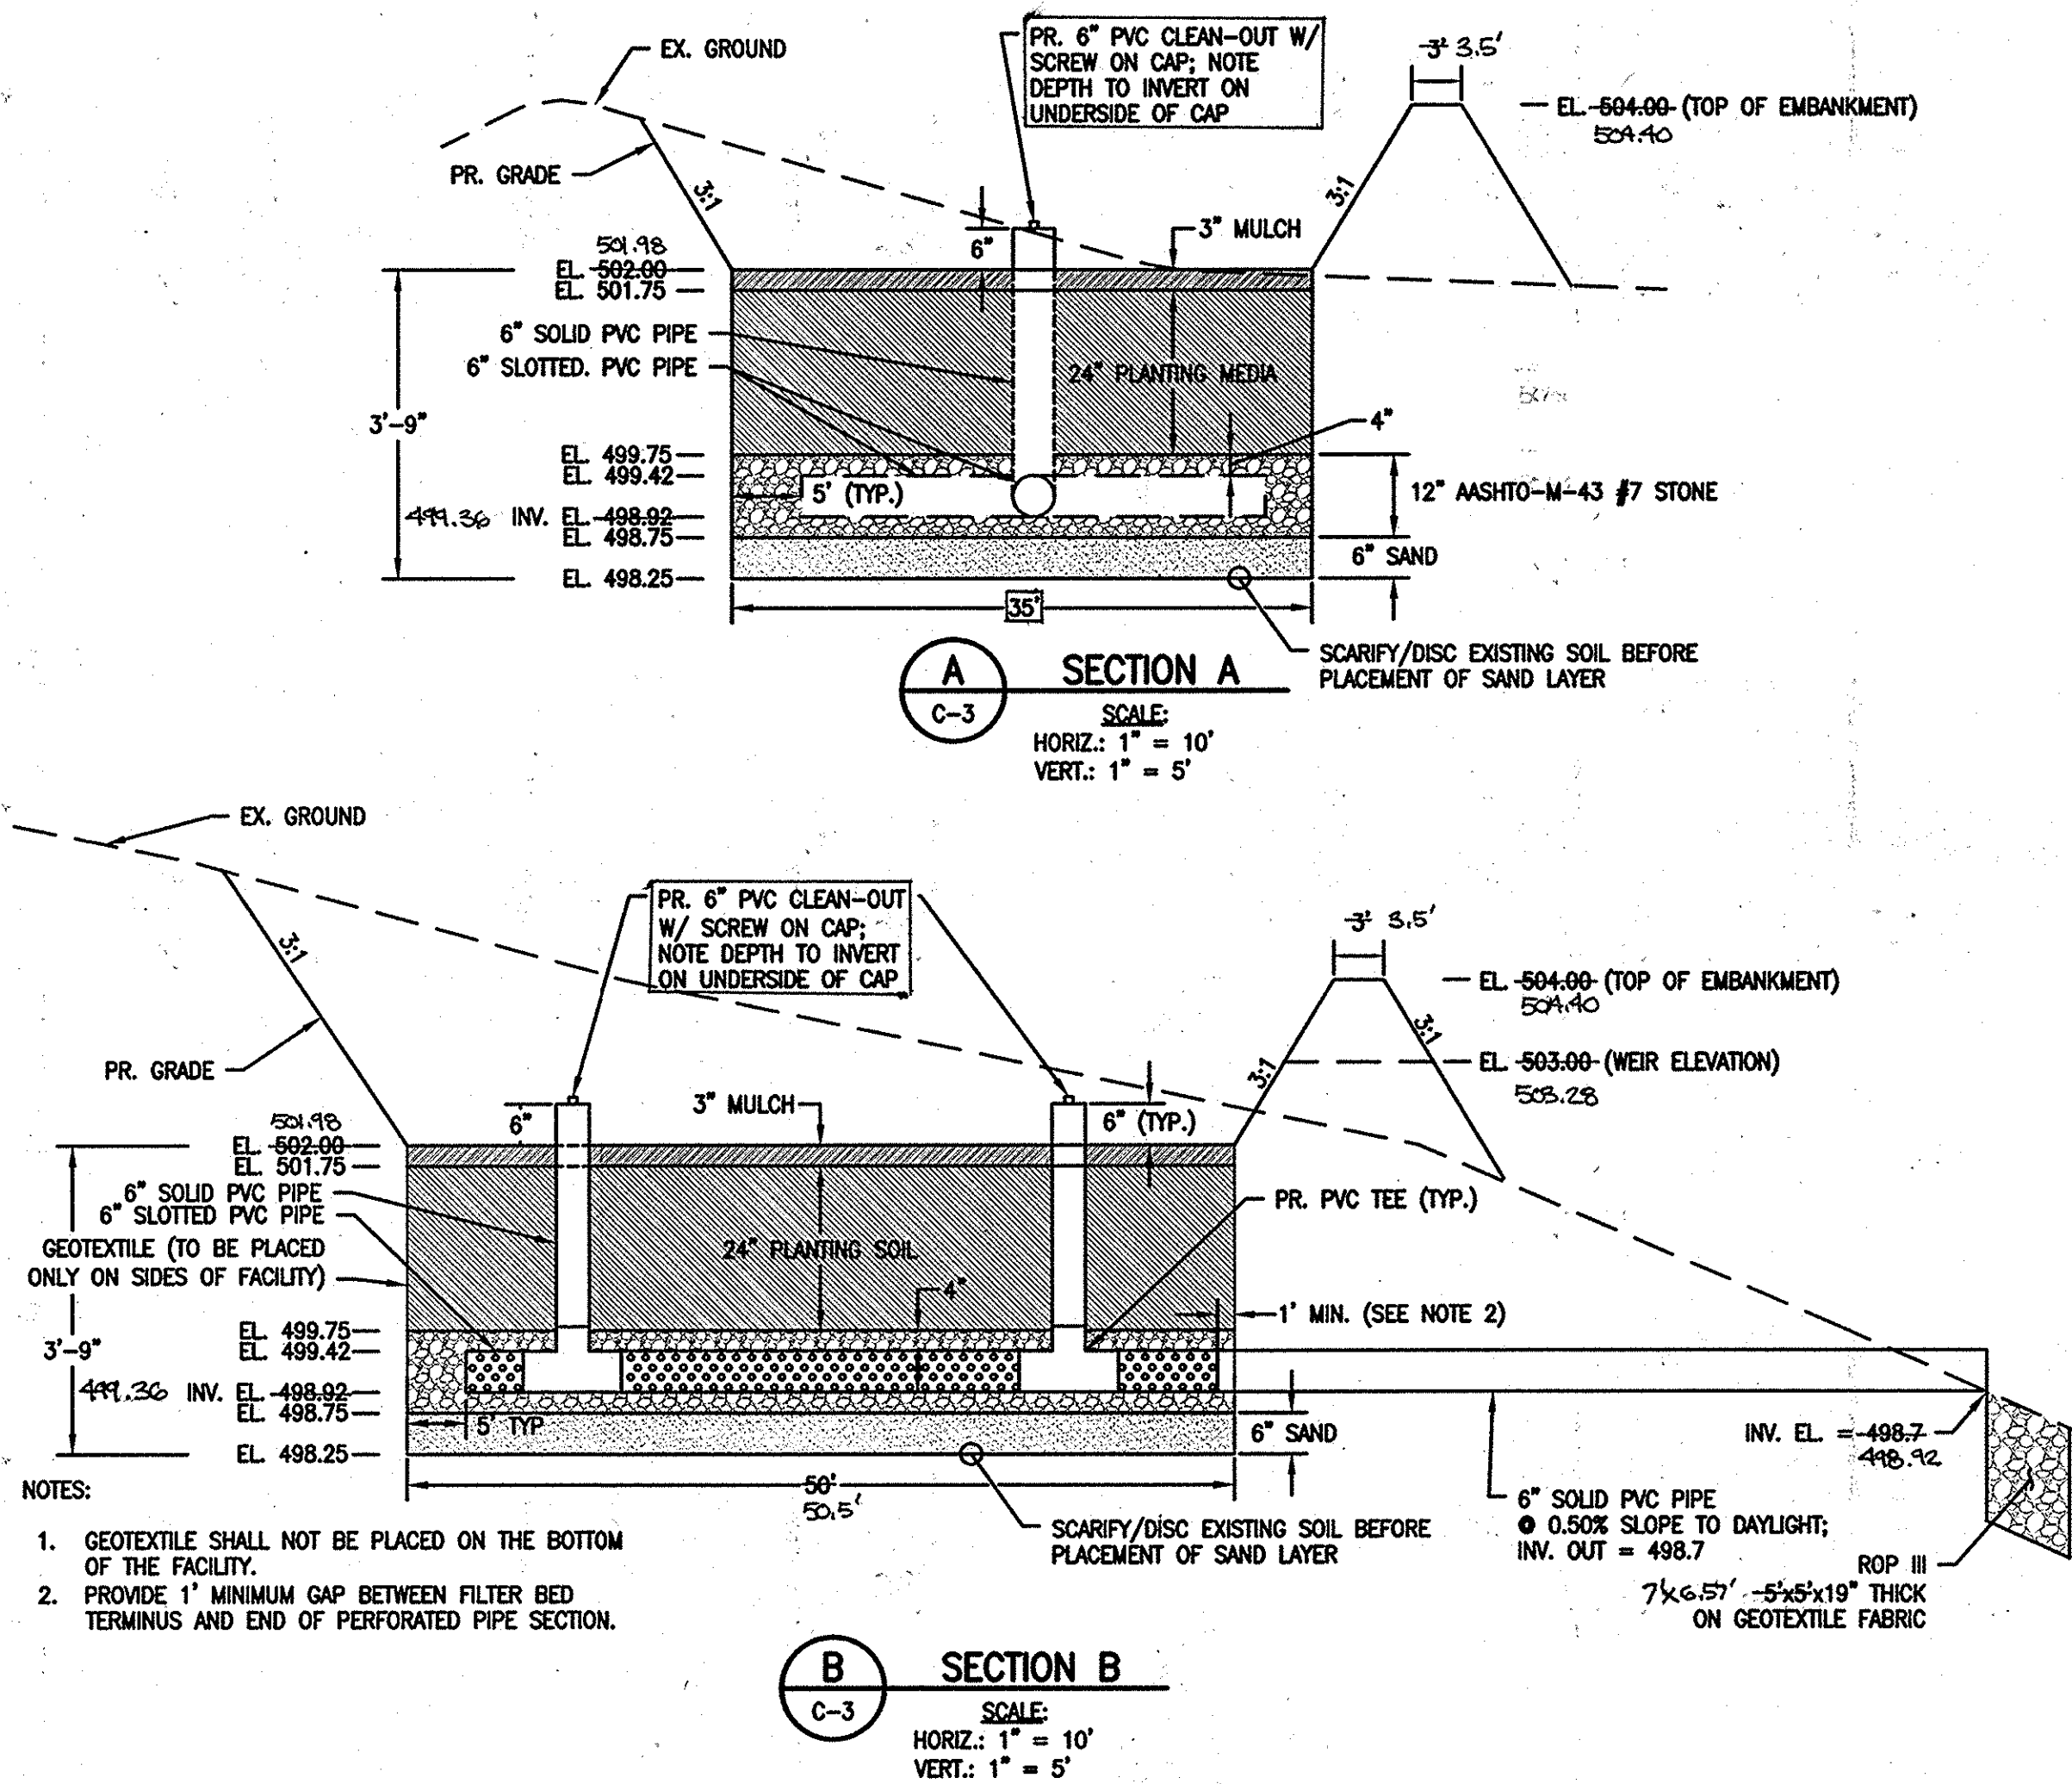

CENTURY ENGINEERING Boring Log
Page 1 of 1

PROJECT: Nixon Farms Solar (Micro-Bioretenion Facility) Boring No. SWM-1
LOCATION: Site Plan, West Friendship, Maryland PROJECT No.
ELEV.: 503.1 DATE START: 8/7/2012 FINISH: 8/7/2012 TECHNICIAN: C. Jacobs
EXCAVATING EQUIPMENT: Hand Auger

ELEV.	DESCRIPTION	DEPTH	SCALE	COMMENT
503.0	Topsoil (4")	0.3	0	
502.0	Red-Brown moist Clayey SILT, trace fine SAND (ML)	1.0	1.0	
502.5	Red moist micaceous Clayey SILT, trace fine SAND (ML)	2.5	2	Boring SWM-1A
499.75	Red slightly moist fine SAND & SILT (SM)	3	3	Boring was offset 5' for borehole infiltration test Augered to depth of 6.0' and installed casing Put 24" of water in casing to pre-soak hole
498.75		4	4	Conducted Borehole Infiltration Test on 8/8/12 Borehole was dry from previous day pre-soak Put 24" of water in casing and measured rate of infiltration over 4 hour period. Additional water was added to 24" depth after each 1 hour measurement.
498.25		5	5	
497.5		6	6	
496.5	Red-Brown slightly moist Silty F. SAND, trace weathered Rock Fragments (SM)	7.5	7.5	
496.25		8	8	
495.0	Brown slightly moist micaceous Silty Fm SAND, trace weathered Rock Fragments (SM)	8.0	8.0	
494.0		9.0	9.0	
493.0		10.0	10.0	
492.0		11.0	11.0	
377.0		126.0	126.0	
376.0		1		

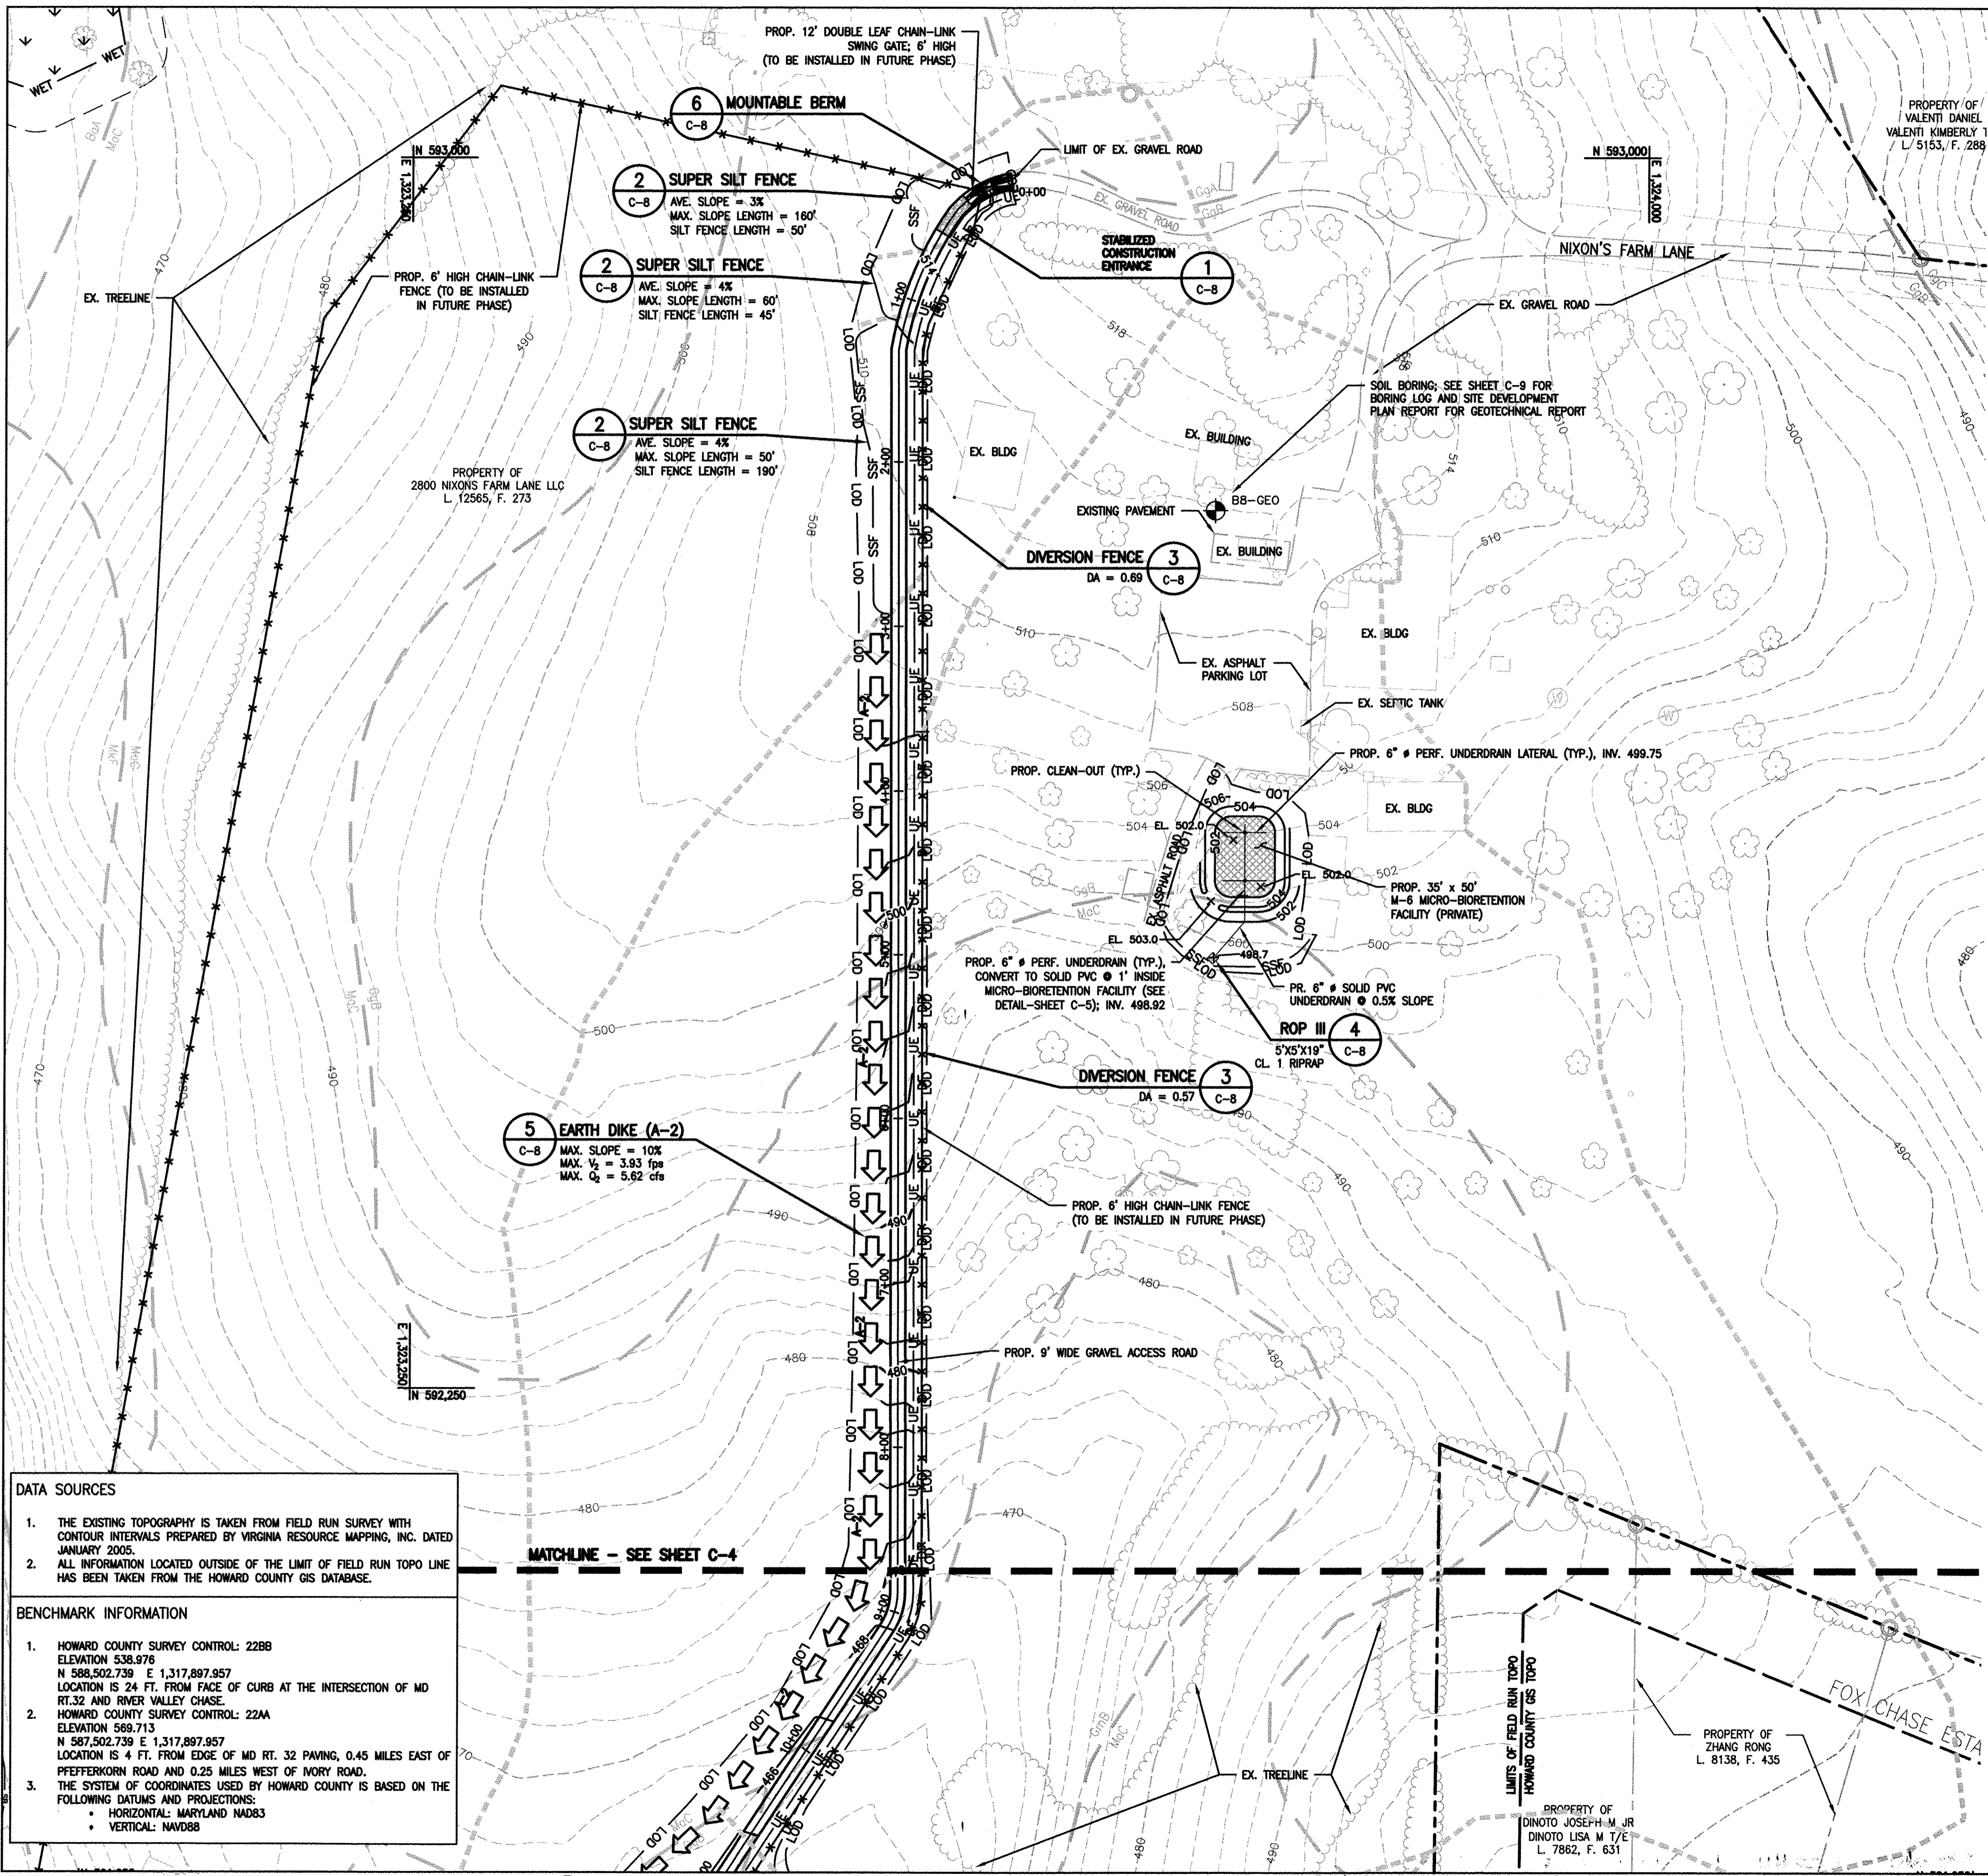

LEGEND

- EX. TREELINE
- PROPERTY LINE
- ADJACENT PROPERTY LINE
- LIMIT OF FIELD RUN TOPO
- EX. MAJOR CONTOUR
- EX. MINOR CONTOUR
- EX. WETLAND BUFFER
- EX. WETLAND
- EX. BUILDING
- EX. WELL
- EX. UTILITY POLE
- EX. IRON PIN
- SLOPE 15% TO 25%
- SLOPE GREATER THAN 25%
- SOIL TYPE BOUNDARY
- EX. TREE
- PROP. FENCE (TO BE INSTALLED IN FUTURE PHASE)
- PROP. CONTOURS
- LOD PROP. LIMIT OF DISTURBANCE
- DF PROP. DIVERSION FENCE
- SSF PROP. SUPER SILT FENCE
- UE PROP. UNDERGROUND ELECTRIC
- SD PROP. DIVERSION PIPE
- PROP. SOLAR PANEL
- SWM DISCONNECTION AREA
- SWM NON-DISCONNECTION AREA
- MOUNTABLE BERM
- EROSION AND SEDIMENT CONTROL DRAINAGE AREA LIMIT
- PROP. EARTH DIKE

NOTE:
ALL VEGETATIVE AND STRUCTURAL PRACTICES ARE TO BE INSTALLED ACCORDING TO THE PROVISIONS OF THIS PLAN AND ARE TO BE IN CONFORMANCE WITH THE MOST CURRENT MARYLAND STANDARDS AND SPECIFICATIONS FOR SOIL EROSION AND SEDIMENT CONTROL, AND REVISIONS THERETO (SEE STANDARD SEDIMENT CONTROL NOTE #2 - SHEET 11 OF 13).

() By the developer:
 "I/We certify that all development and construction will be done according to this plan, and that any responsible personnel involved in the construction project will have a Certificate of Attendance at a Department of the Environment approved Training Program for the Control of Sediment and Erosion before beginning the project. I also authorize periodic on-site inspection by the Howard Soil Conservation District."
 Signature of Developer *W. James Wood* Date *09/10/2012*
 Print name below Signature

() By the Engineer:
 "I certify that this plan for erosion and sediment control represents a practical and workable plan based on my personal knowledge of the site conditions and that it was prepared in accordance with the requirements of the Howard Soil Conservation District."
 Signature of Engineer *Gregory A. Tread* Date *10 September 2012*
 Print name below signature

() For the Howard Soil Conservation District:
 This development plan is approved for soil erosion and sediment control by the Howard Soil Conservation District.
 Howard Soil Conservation District Date *[Signature]*

DATA SOURCES

- THE EXISTING TOPOGRAPHY IS TAKEN FROM FIELD RUN SURVEY WITH CONTOUR INTERVALS PREPARED BY VIRGINIA RESOURCE MAPPING, INC. DATED JANUARY 2005.
- ALL INFORMATION LOCATED OUTSIDE OF THE LIMIT OF FIELD RUN TOPO LINE HAS BEEN TAKEN FROM THE HOWARD COUNTY GIS DATABASE.

BENCHMARK INFORMATION

- HOWARD COUNTY SURVEY CONTROL: 22BB
ELEVATION 538.978
N 588,502.739 E 1,317,897.957
LOCATION IS 24 FT. FROM FACE OF CURB AT THE INTERSECTION OF MD RT.32 AND RIVER VALLEY CHASE.
- HOWARD COUNTY SURVEY CONTROL: 22AA
ELEVATION 568.713
N 587,502.739 E 1,317,897.957
LOCATION IS 4 FT. FROM EDGE OF MD RT. 32 PAVING, 0.45 MILES EAST OF PEPPERKORN ROAD AND 0.25 MILES WEST OF IVORY ROAD.
- THE SYSTEM OF COORDINATES USED BY HOWARD COUNTY IS BASED ON THE FOLLOWING DATUMS AND PROJECTIONS:
 - HORIZONTAL: MARYLAND NAD83
 - VERTICAL: NAVD88

TOTAL SITE AREA = 96.920 ACRES
LIMIT OF DISTURBANCE = 9.460 ACRES

APPROVED: DEPARTMENT OF PLANNING AND ZONING

[Signature] 10/2/12
 CHIEF, DEVELOPMENT ENGINEERING DIVISION DATE

[Signature] 10/09/12
 CHIEF, DIVISION OF LAND DEVELOPMENT DATE

[Signature] 10/9/12
 DIRECTOR DATE



DEVELOPER:
 BITH ENERGY
 ATTN: R. DANIEL WALLACE
 113 WEST MONUMENT ST.
 BALTIMORE, MD 21201
 PHONE: (410) 982-1188

OWNER:
 2800 NIXONS FARM LANE, LLC
 17500 FREDERICK ROAD
 MT. AIRY, MD 21771
 PHONE: (410) 461-7200

NIXON FARMS SOLAR PHASE 1

2800 NIXON'S FARM LANE, WEST FRIENDSHIP, MARYLAND 21792

EROSION AND SEDIMENT CONTROL PLAN 1

GRID: 16, 17, 22
 ZONING: RC-BEO
 TAX MAP: 0015

PROFESSIONAL CERTIFICATION: I HEREBY CERTIFY THAT THESE DOCUMENTS WERE PREPARED OR APPROVED BY ME, AND THAT I AM A DULY LICENSED PROFESSIONAL ENGINEER UNDER THE LAWS OF THE STATE OF MARYLAND, LICENSE NO. 15453, EXPIRATION DATE: JULY 02, 2013.

[Signature] 10/10/12
 SEAL


REVISIONS: DESCRIPTION, BY, DATE, NO.

BLOCK: N/A
 PARCEL: 0080
 ELECTION DISTRICT: 3

EA ENGINEERING, SCIENCE, AND TECHNOLOGY
 Loveton Center
 15 Loveton Circle
 Sports, Maryland 21152
 (410) 771-4950

DATE: AUGUST 2012
 DESIGNED BY: MS
 DRAWN BY: JSP
 CHECKED BY: GAT
 PROJECT MANAGER: JMH
 PROJECT NUMBER: 14825.02
 DRAWING NUMBER: C-6
 SHEET NUMBER: 8 OF 13

WP-13-C48

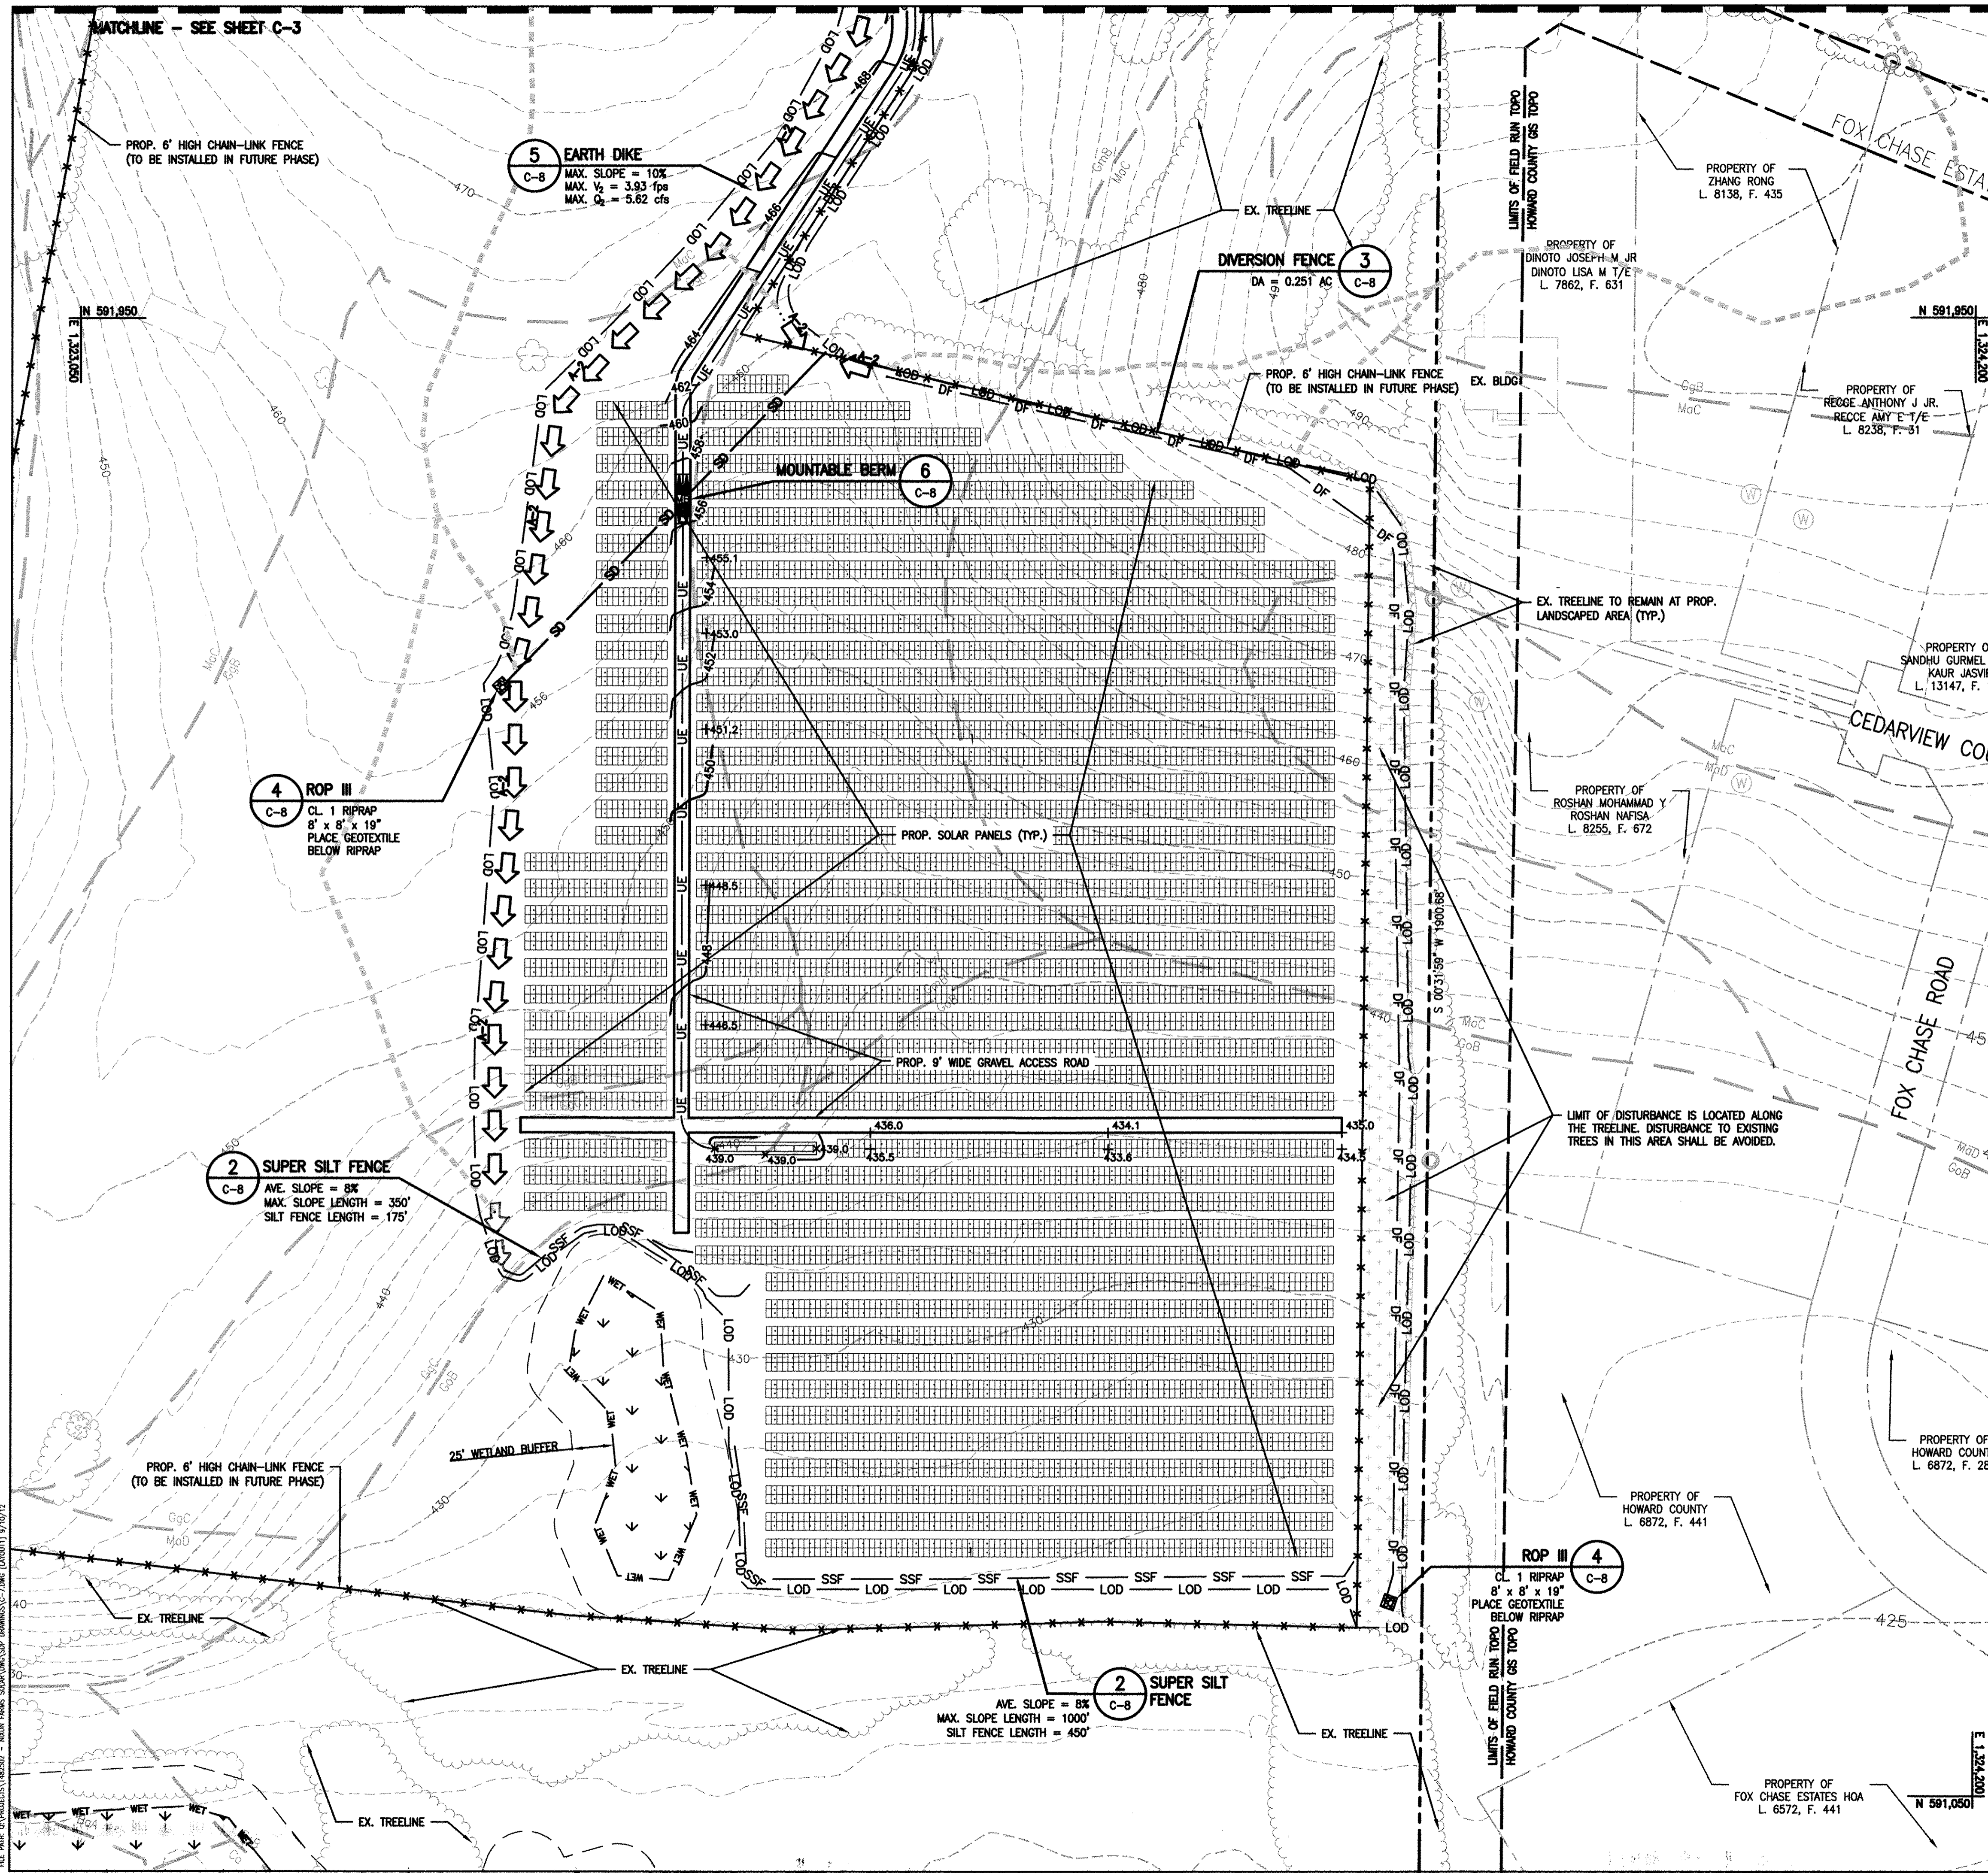

LEGEND

- EX. TREELINE
- PROPERTY LINE
- ADJACENT PROPERTY LINE
- LIMIT OF FIELD RUN TOPO
- 490 EX. MAJOR CONTOUR
- EX. MINOR CONTOUR
- EX. WETLAND BUFFER
- EX. WETLAND
- EX. BUILDING
- EX. WELL
- EX. UTILITY POLE
- EX. IRON PIN
- SLOPE 15% TO 25%
- SLOPE GREATER THAN 25%
- GgC SOIL TYPE BOUNDARY
- GgB SOIL TYPE BOUNDARY
- EX. TREE
- PROP. FENCE (TO BE INSTALLED IN FUTURE PHASE)
- PROP. CONTOURS
- LOD PROP. LIMIT OF DISTURBANCE
- DF PROP. DIVERSION FENCE
- SSF PROP. SUPER SILT FENCE
- UE PROP. UNDERGROUND ELECTRIC
- SD PROP. DIVERSION PIPE
- PROP. SOLAR PANEL
- SWM DISCONNECTION AREA
- SWM NON-DISCONNECTION AREA
- MOUNTABLE BERM
- EROSION AND SEDIMENT CONTROL DRAINAGE AREA LIMIT
- PROP. EARTH DIKE

NOTE: ALL VEGETATIVE AND STRUCTURAL PRACTICES ARE TO BE INSTALLED ACCORDING TO THE PROVISIONS OF THIS PLAN AND ARE TO BE IN CONFORMANCE WITH THE MOST CURRENT MARYLAND STANDARDS AND SPECIFICATIONS FOR SOIL EROSION AND SEDIMENT CONTROL, AND REVISIONS THERETO (SEE STANDARD SEDIMENT CONTROL NOTE #2 - SHEET 11 OF 13).

DEVELOPER:
 BITH ENERGY
 ATTN: R. DANIEL WALLACE
 113 WEST MONUMENT ST.
 BALTIMORE, MD 21201
 PHONE: (410) 962-1188

OWNER:
 2800 NIXON'S FARM LANE, LLC
 17500 FREDERICK ROAD
 MT. AIRY, MD 21771
 PHONE: (410) 461-7200

GRAPHIC SCALE IN FEET
 50 25 0 50 100

APPROVED: DEPARTMENT OF PLANNING AND ZONING

 CHIEF, DEVELOPMENT ENGINEERING DIVISION 10/2/12 DATE

 CHIEF, DIVISION OF LAND DEVELOPMENT 10/09/12 DATE

 DIRECTOR 10/19/12 DATE

() By the developer:

"I/We certify that all development and construction will be done according to this plan, and that any responsible personnel involved in the construction project will have a Certificate of Attendance at a Department of the Environment approved Training Program for the Control of Sediment and Erosion before beginning the project. I also authorize periodic on-site inspection by the Howard Soil Conservation District."

 Signature of Developer L. Aaron Wood 09/10/2012 Date
 Print name below Signature

() By the Engineer:

"I certify that this plan for erosion and sediment control represents a practical and workable plan based on my personal knowledge of the site conditions and that it was prepared in accordance with the requirements of the Howard Soil Conservation District."

 Signature of Engineer 10 September 2012 Date
 Print name below signature GUERRELL A. TIANO

() For the Howard Soil Conservation District:

This development plan is approved for soil erosion and sediment control by the Howard Soil Conservation District.

 Howard Soil Conservation District Date

BENCHMARK INFORMATION

- HOWARD COUNTY SURVEY CONTROL: 228B
 ELEVATION 538.976
 N 588,502.739 E 1,317,897.957
 LOCATION IS 24 FT. FROM FACE OF CURB AT THE INTERSECTION OF MD RT. 32 AND RIVER VALLEY CHASE.
- HOWARD COUNTY SURVEY CONTROL: 22AA
 ELEVATION 569.713
 N 587,502.739 E 1,317,897.957
 LOCATION IS 4 FT. FROM EDGE OF MD RT. 32 PAVING, 0.45 MILES EAST OF PFEFFERKORN ROAD AND 0.25 MILES WEST OF NORVY ROAD.
- THE SYSTEM OF COORDINATES USED BY HOWARD COUNTY IS BASED ON THE FOLLOWING DATUMS AND PROJECTIONS:
 - HORIZONTAL: MARYLAND NAD83
 - VERTICAL: NAVD88

DATA SOURCES

- THE EXISTING TOPOGRAPHY IS TAKEN FROM FIELD RUN SURVEY WITH CONTOUR INTERVALS PREPARED BY VIRGINIA RESOURCE MAPPING, INC. DATED JANUARY 2005.
- ALL INFORMATION LOCATED OUTSIDE OF THE LIMIT OF FIELD RUN TOPO LINE HAS BEEN TAKEN FROM THE HOWARD COUNTY GIS DATABASE.

NIXON FARMS SOLAR PHASE 1

2800 NIXON'S FARM LANE, WEST FRIENDSHIP, MARYLAND 21792





EROSION AND SEDIMENT CONTROL PLAN II

GRID: 16, 17, 22
 ZONING: RO-DEO
 TAX MAP: 0015

EA
EA ENGINEERING, SCIENCE, AND TECHNOLOGY
 Loveton Center
 15 Loveton Circle
 Sparks, Maryland 21152
 (410) 771-4950

DATE: AUGUST 2012
 DESIGNED BY: MBS
 DRAWN BY: JSP
 CHECKED BY: GAT
 PROJECT MANAGER: JMH
 PROJECT NUMBER: 14825.02
 DRAWING NUMBER: C-7
 SHEET NUMBER: 9 OF 13

W P-13-018

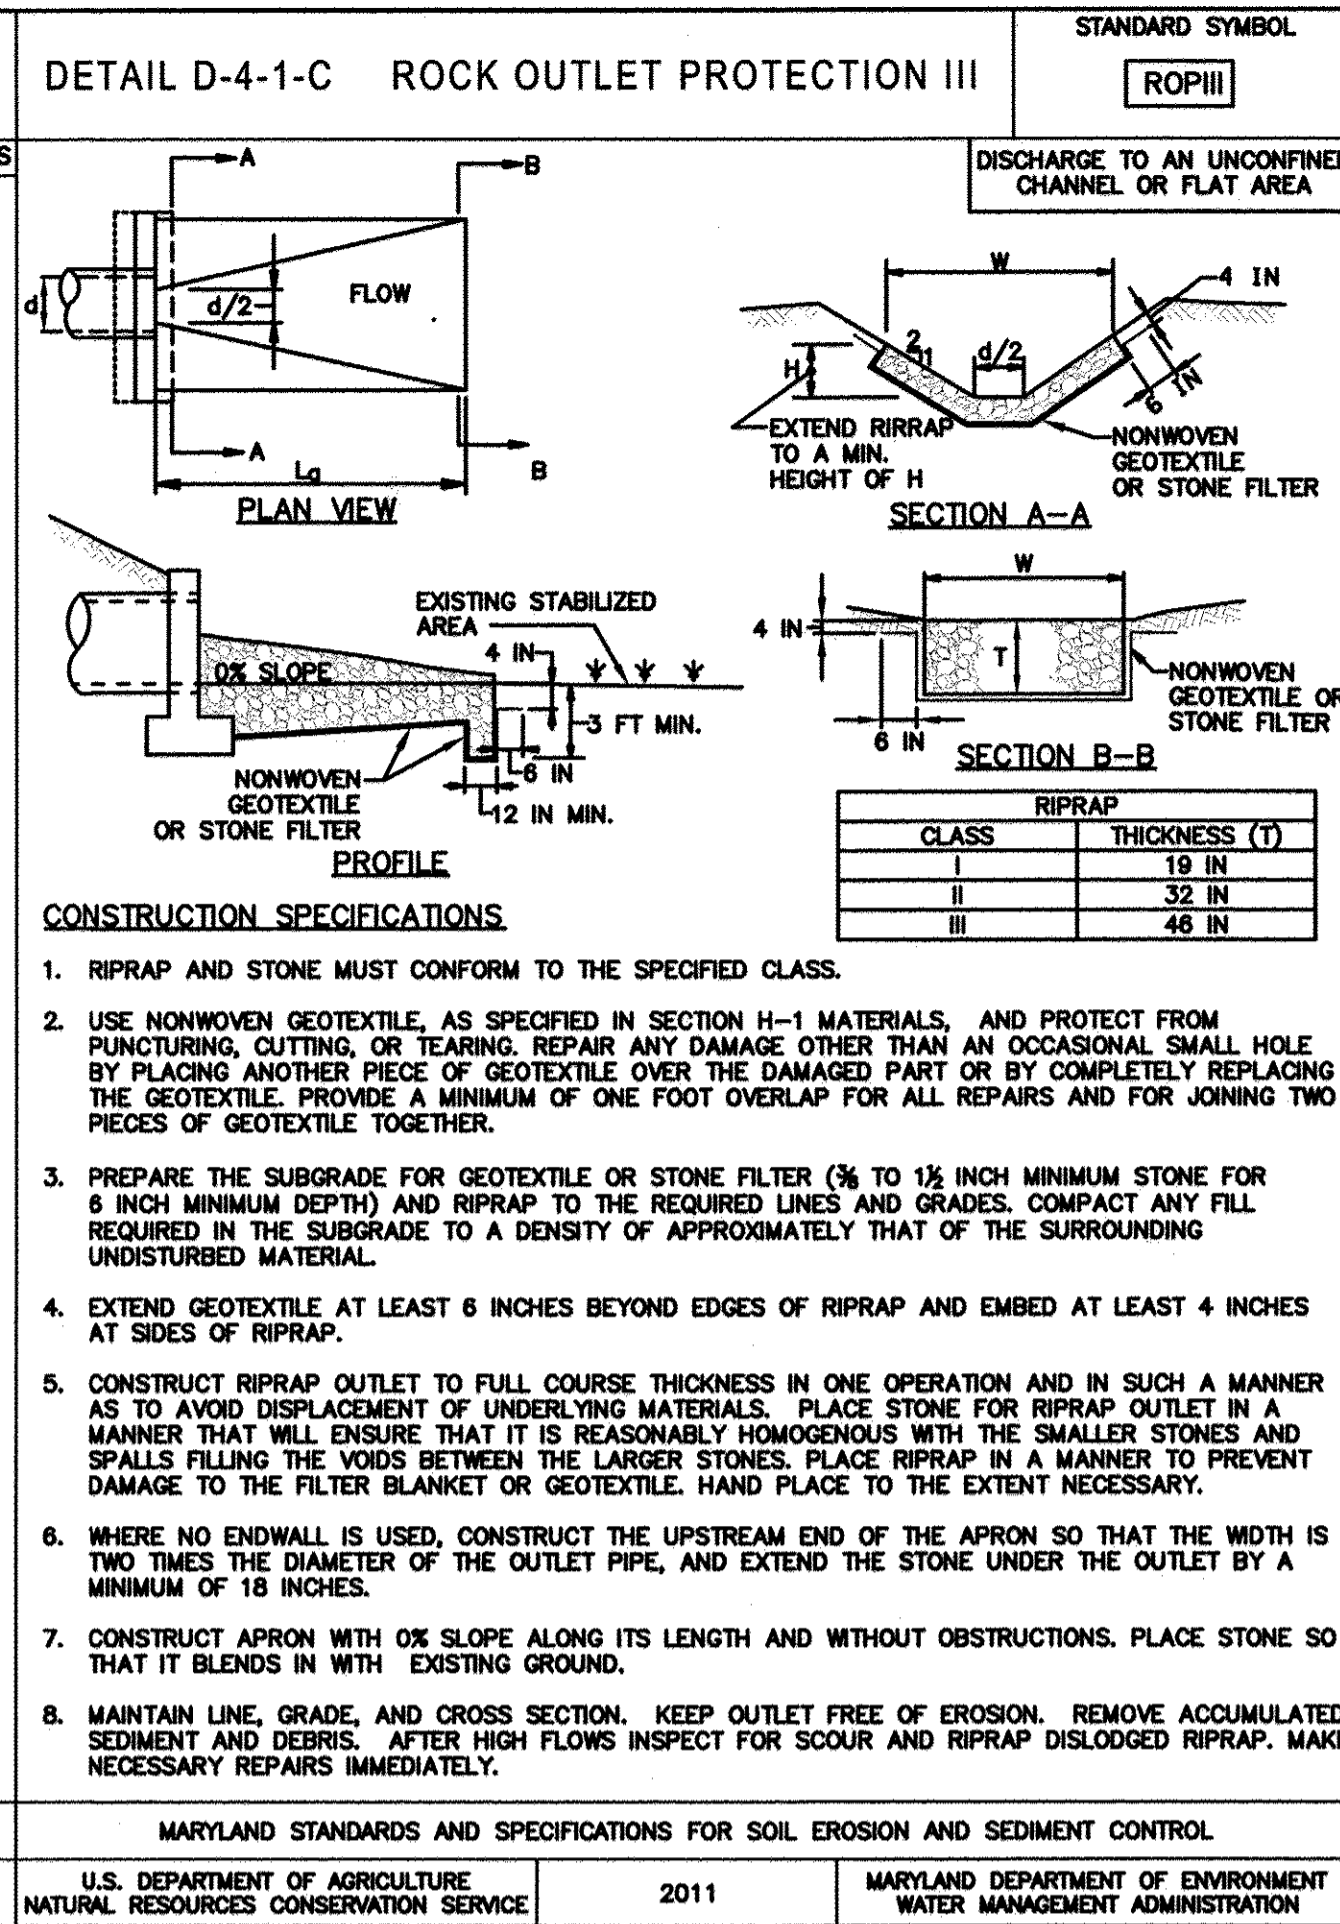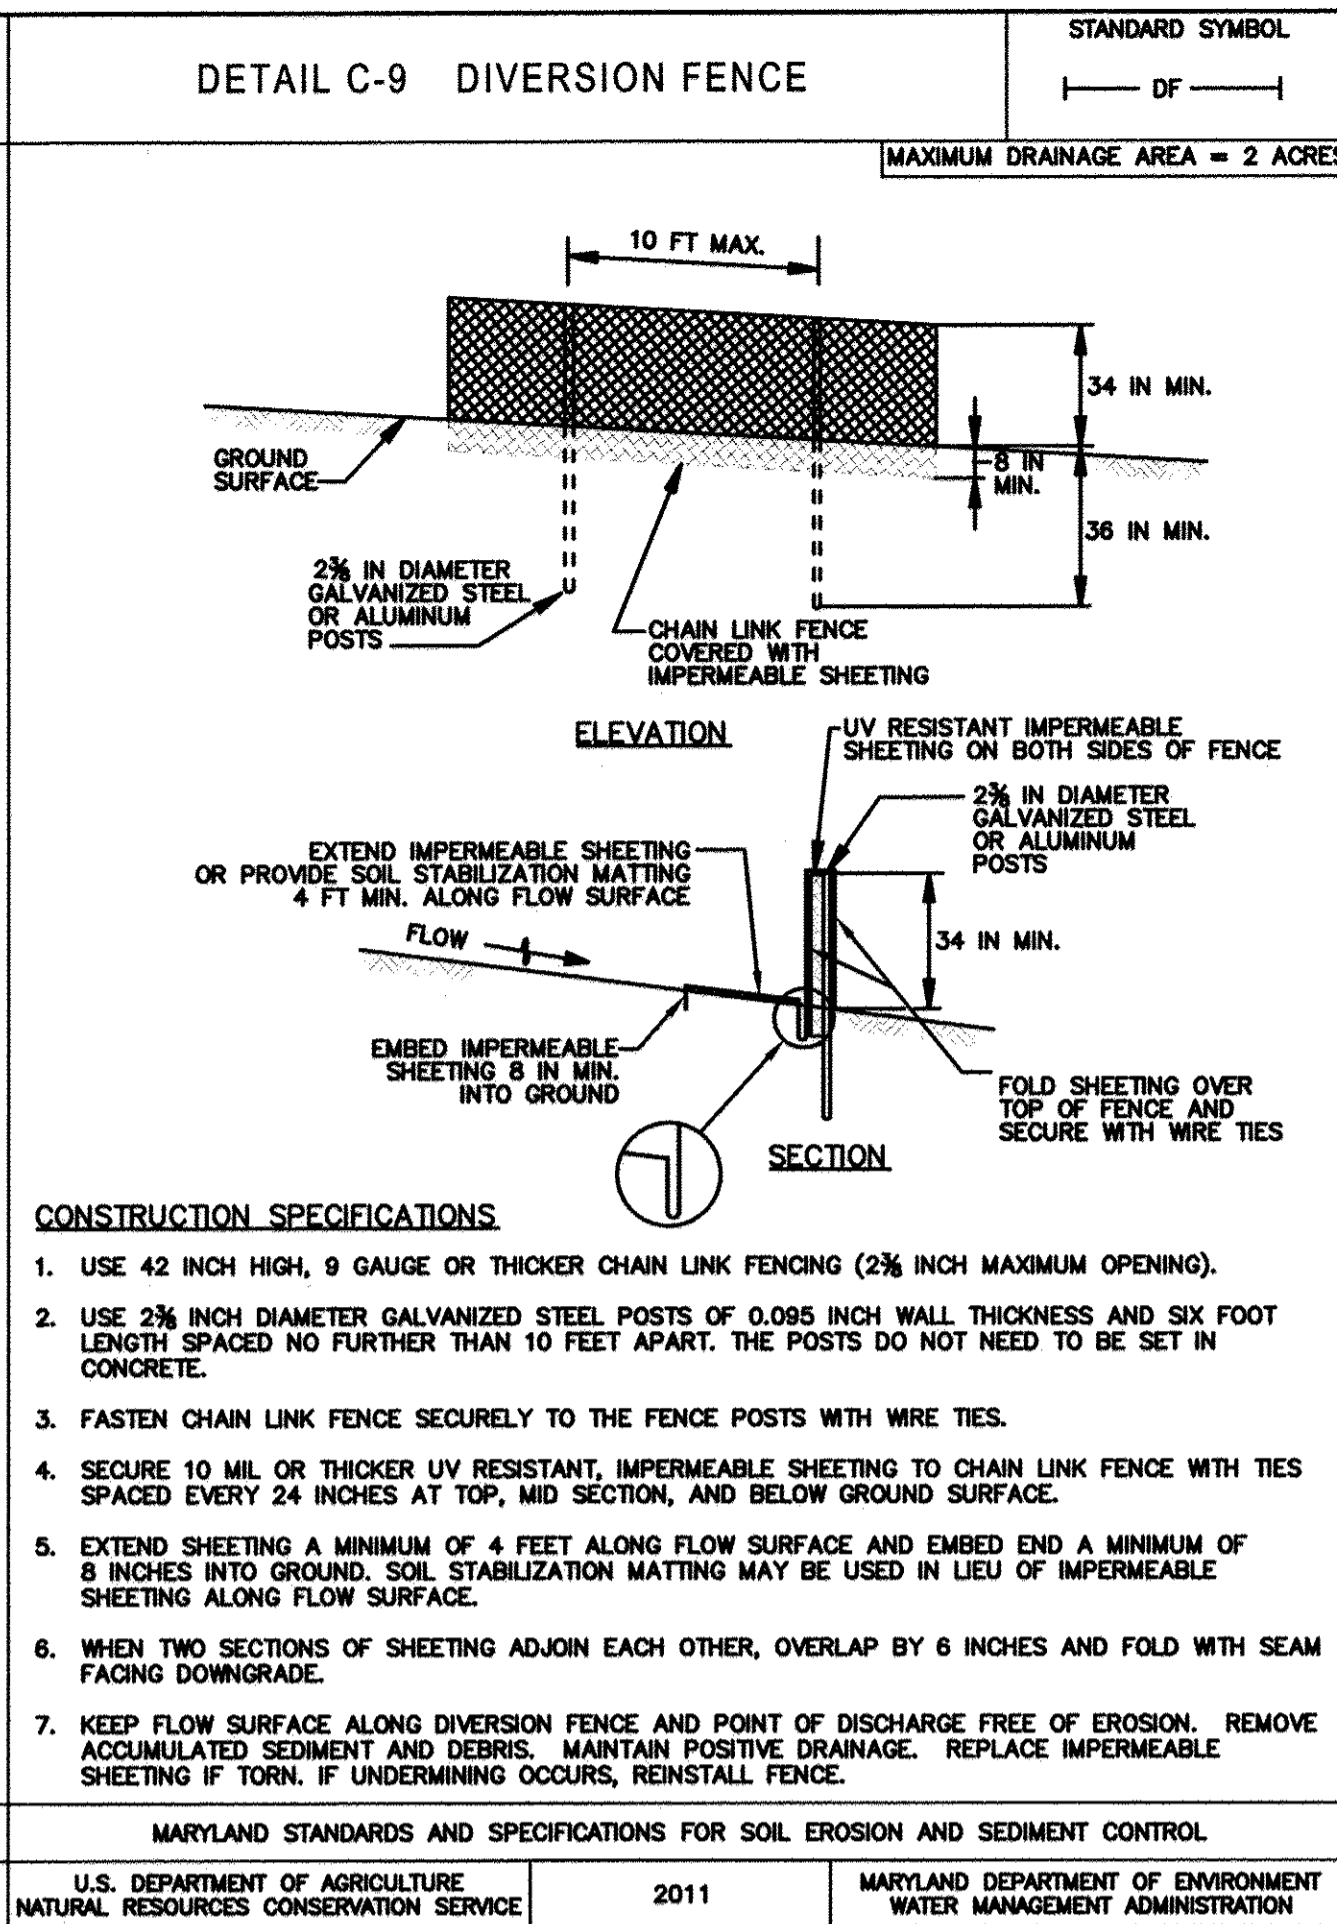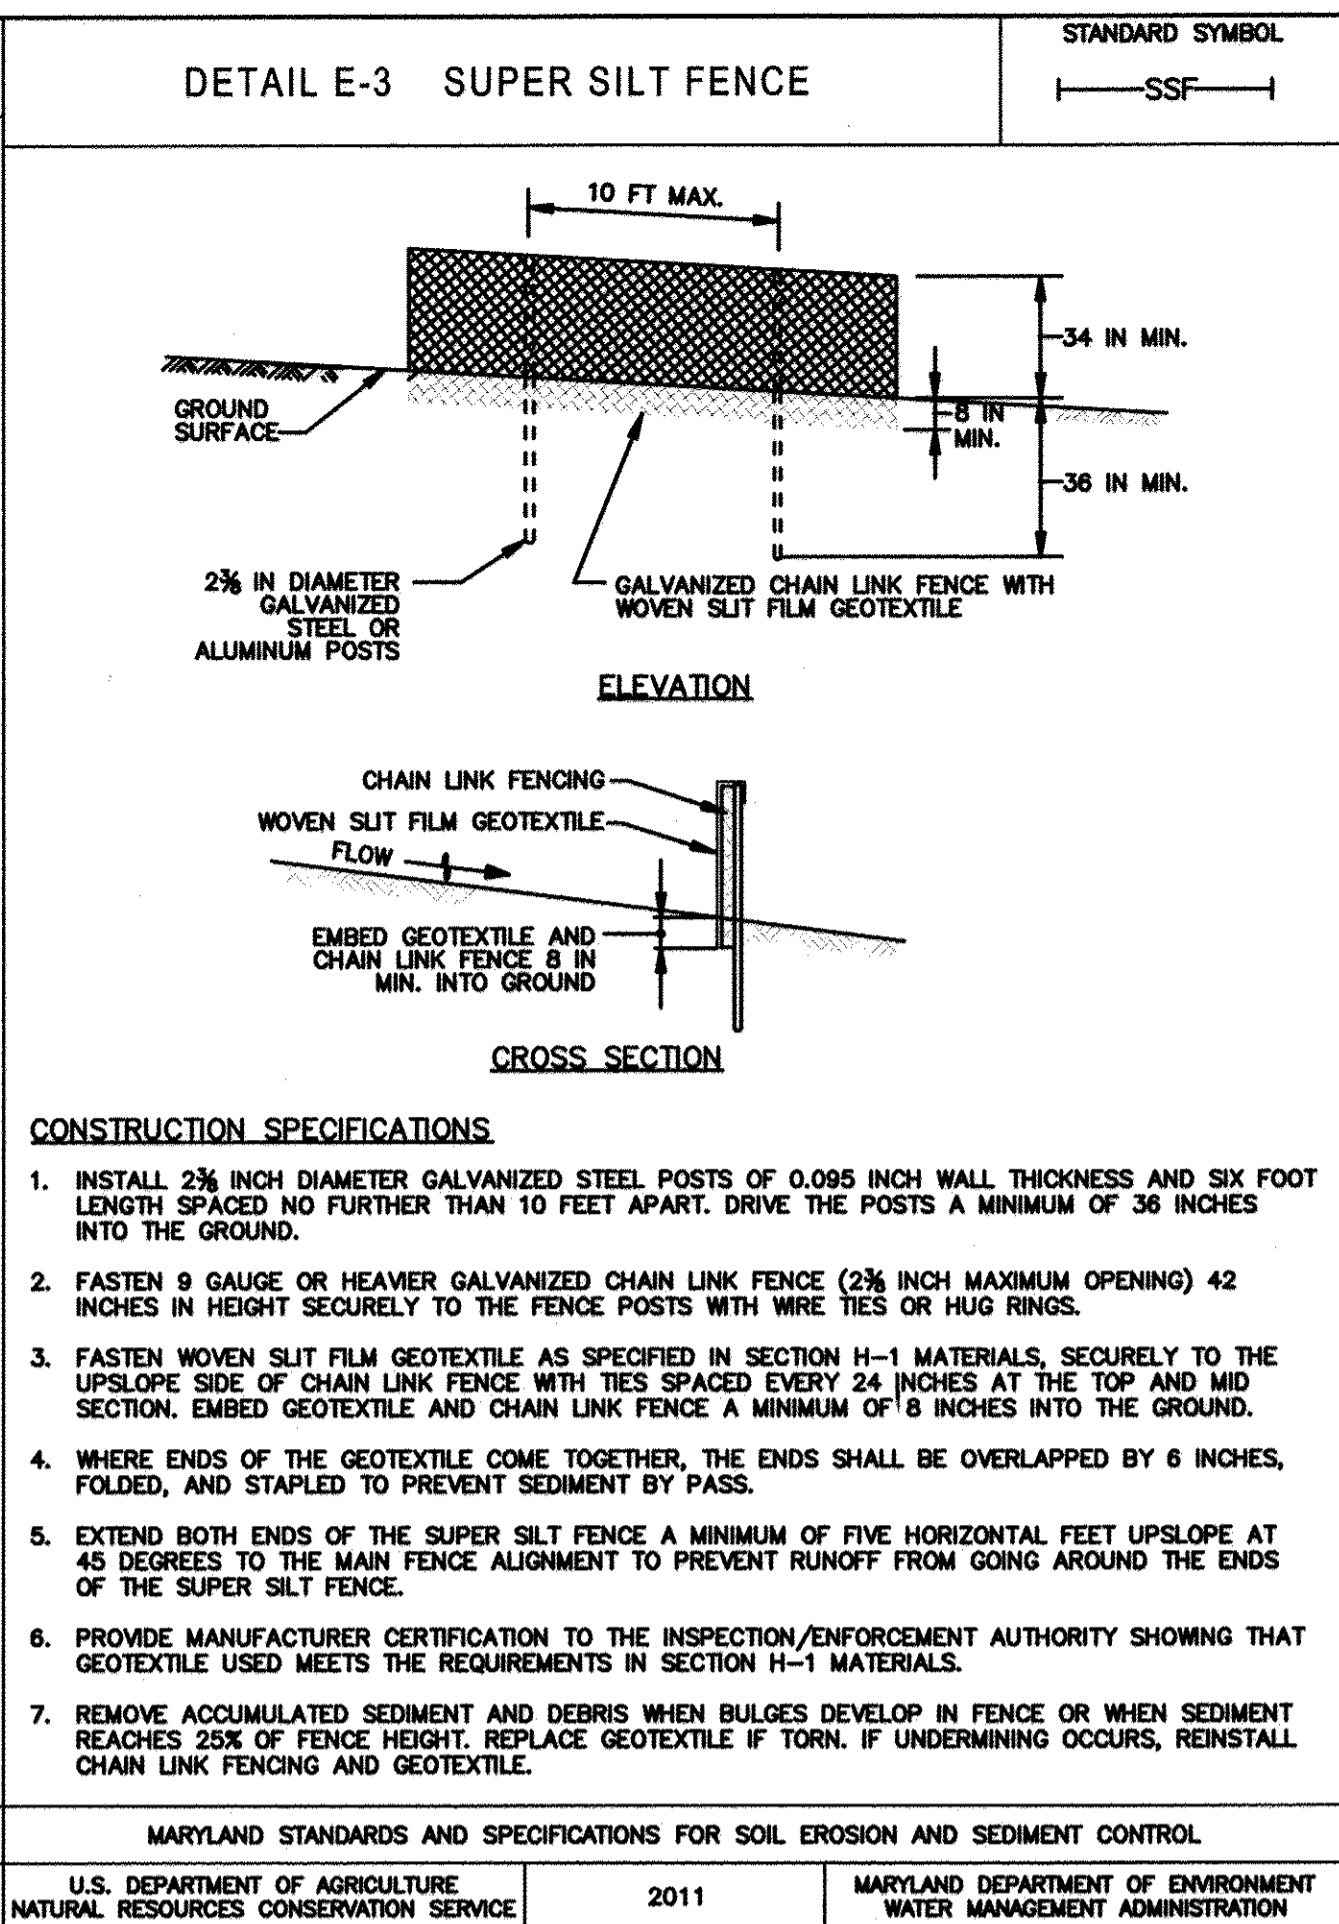
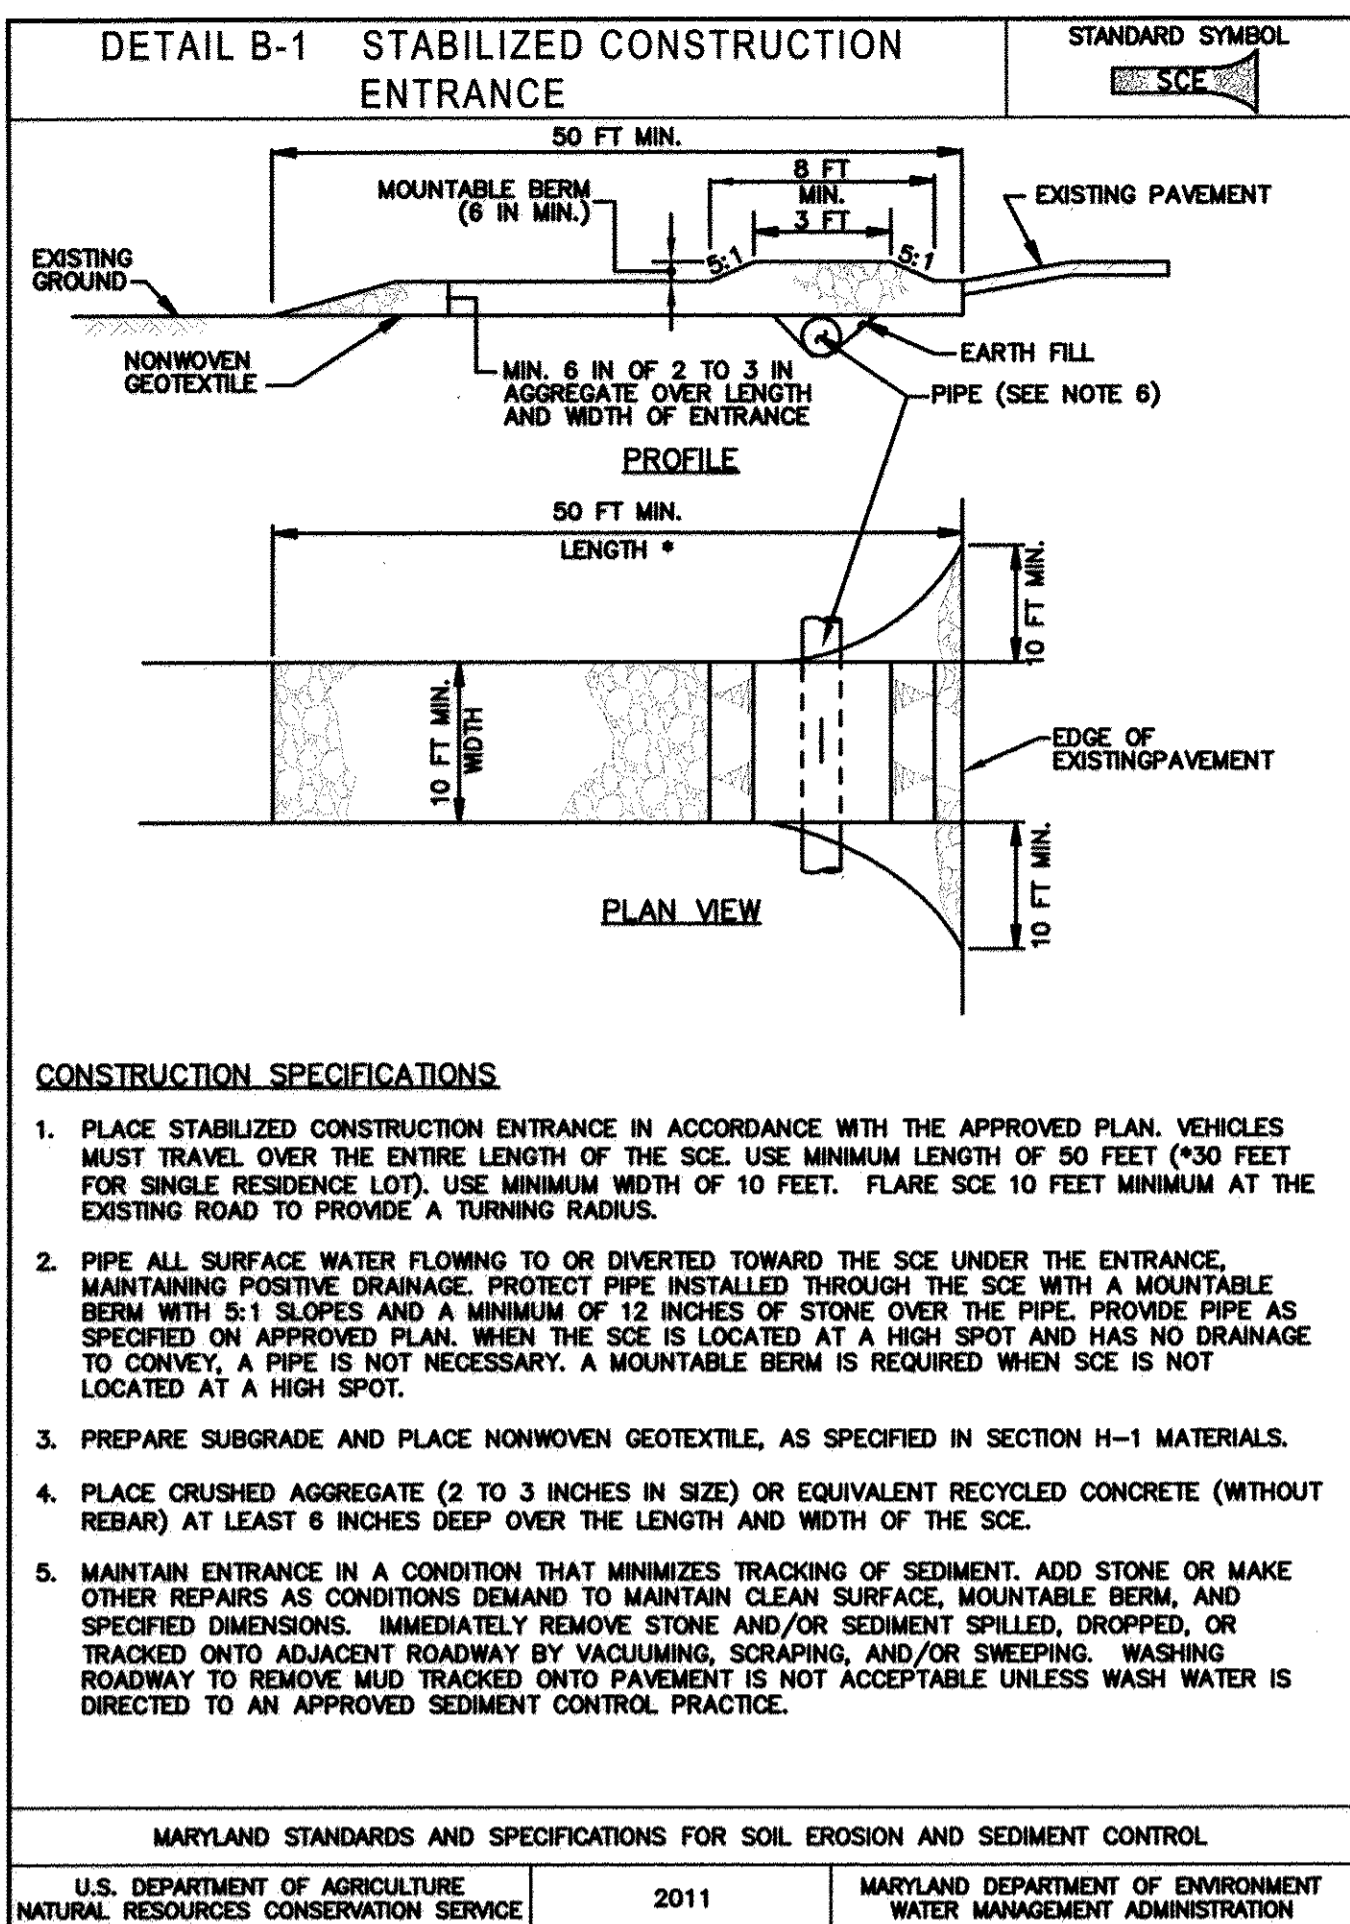


MARYLAND STANDARDS AND SPECIFICATIONS FOR SOIL EROSION AND SEDIMENT CONTROL
 U.S. DEPARTMENT OF AGRICULTURE NATURAL RESOURCES CONSERVATION SERVICE 2011
 MARYLAND DEPARTMENT OF ENVIRONMENT WATER MANAGEMENT ADMINISTRATION

MARYLAND STANDARDS AND SPECIFICATIONS FOR SOIL EROSION AND SEDIMENT CONTROL
 U.S. DEPARTMENT OF AGRICULTURE NATURAL RESOURCES CONSERVATION SERVICE 2011
 MARYLAND DEPARTMENT OF ENVIRONMENT WATER MANAGEMENT ADMINISTRATION

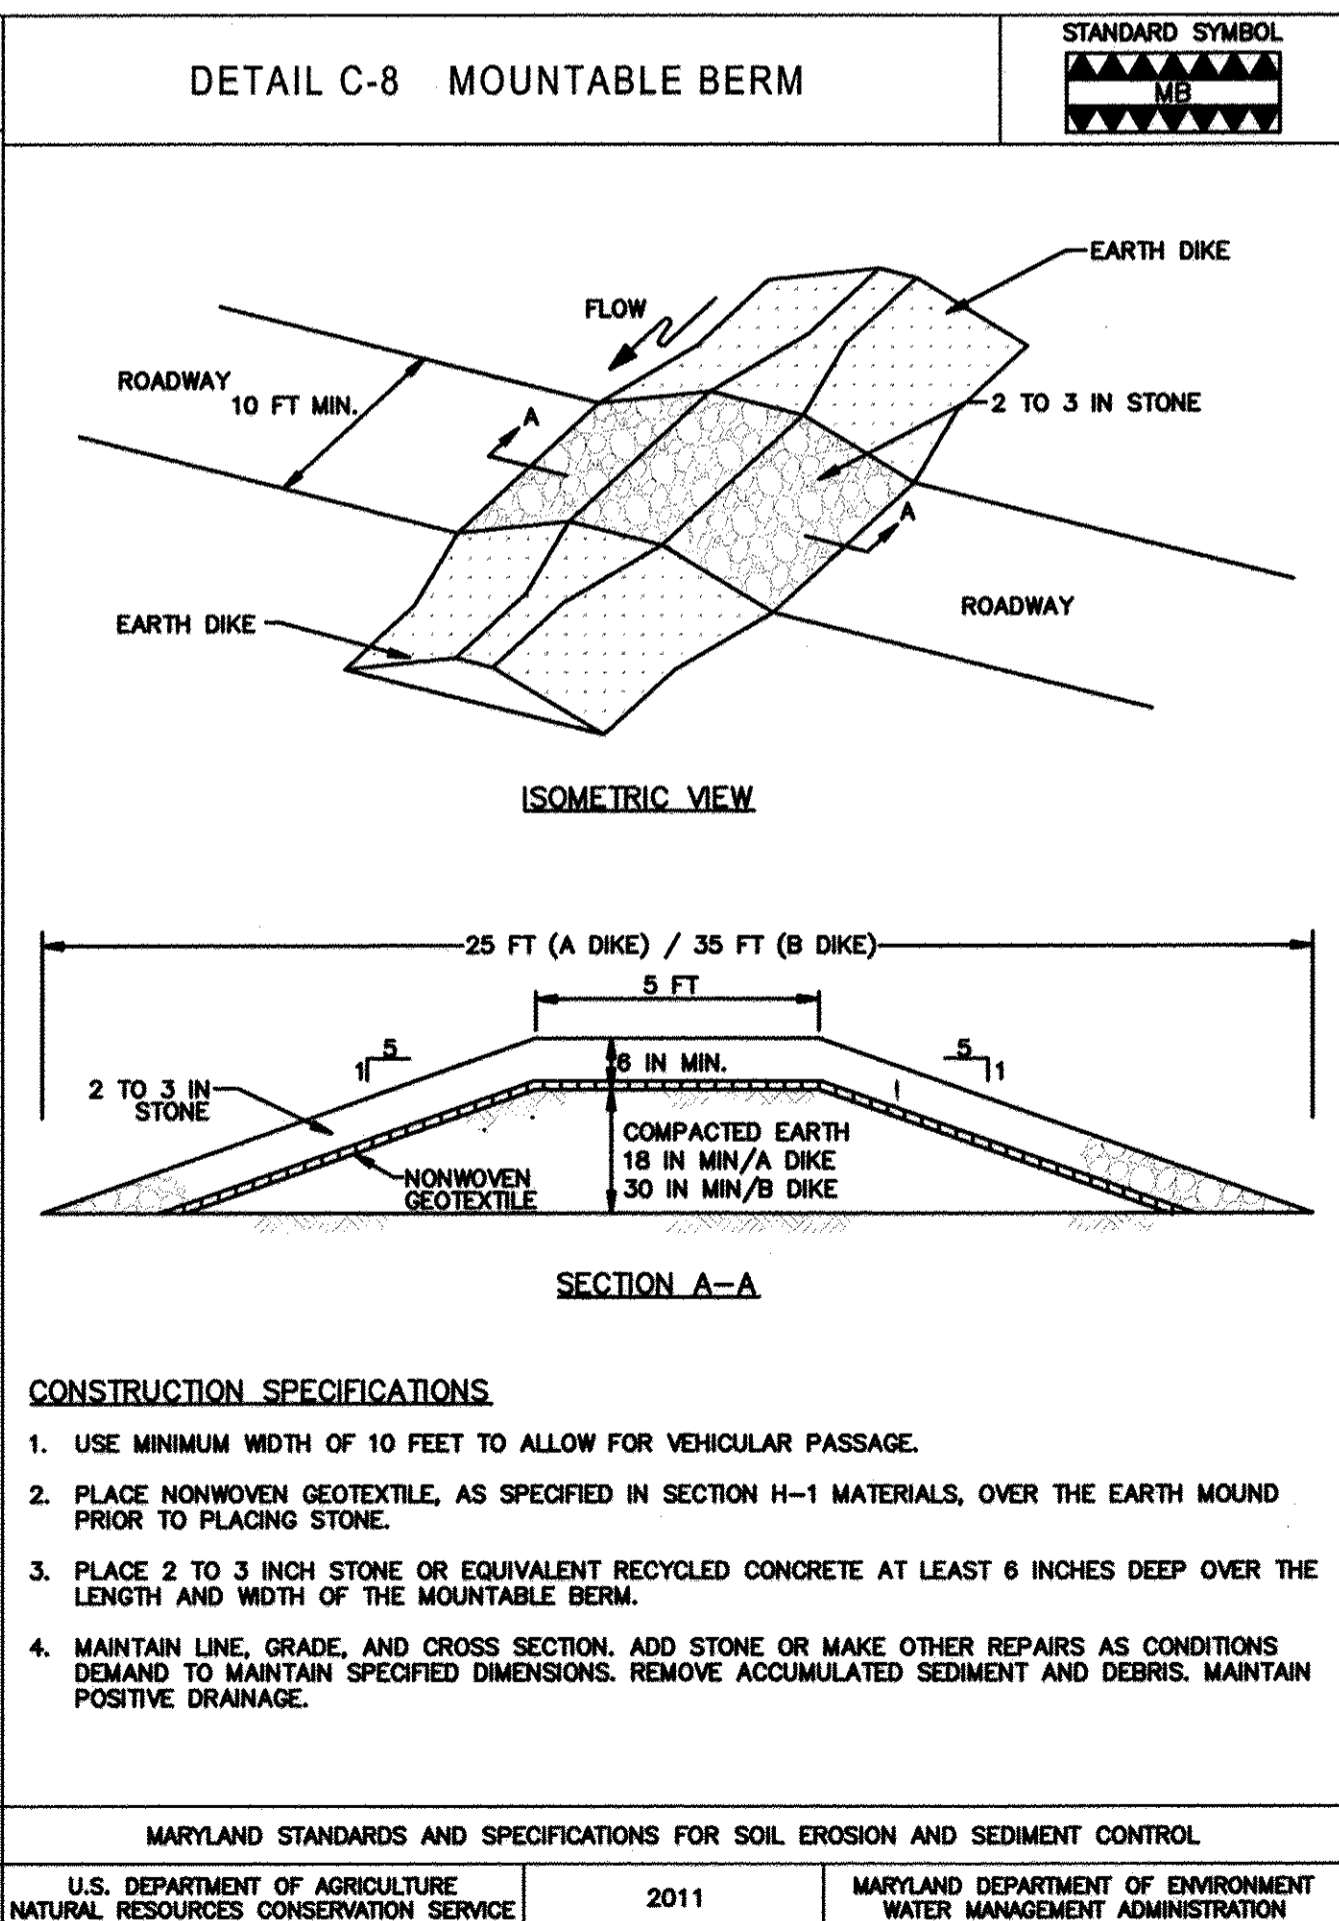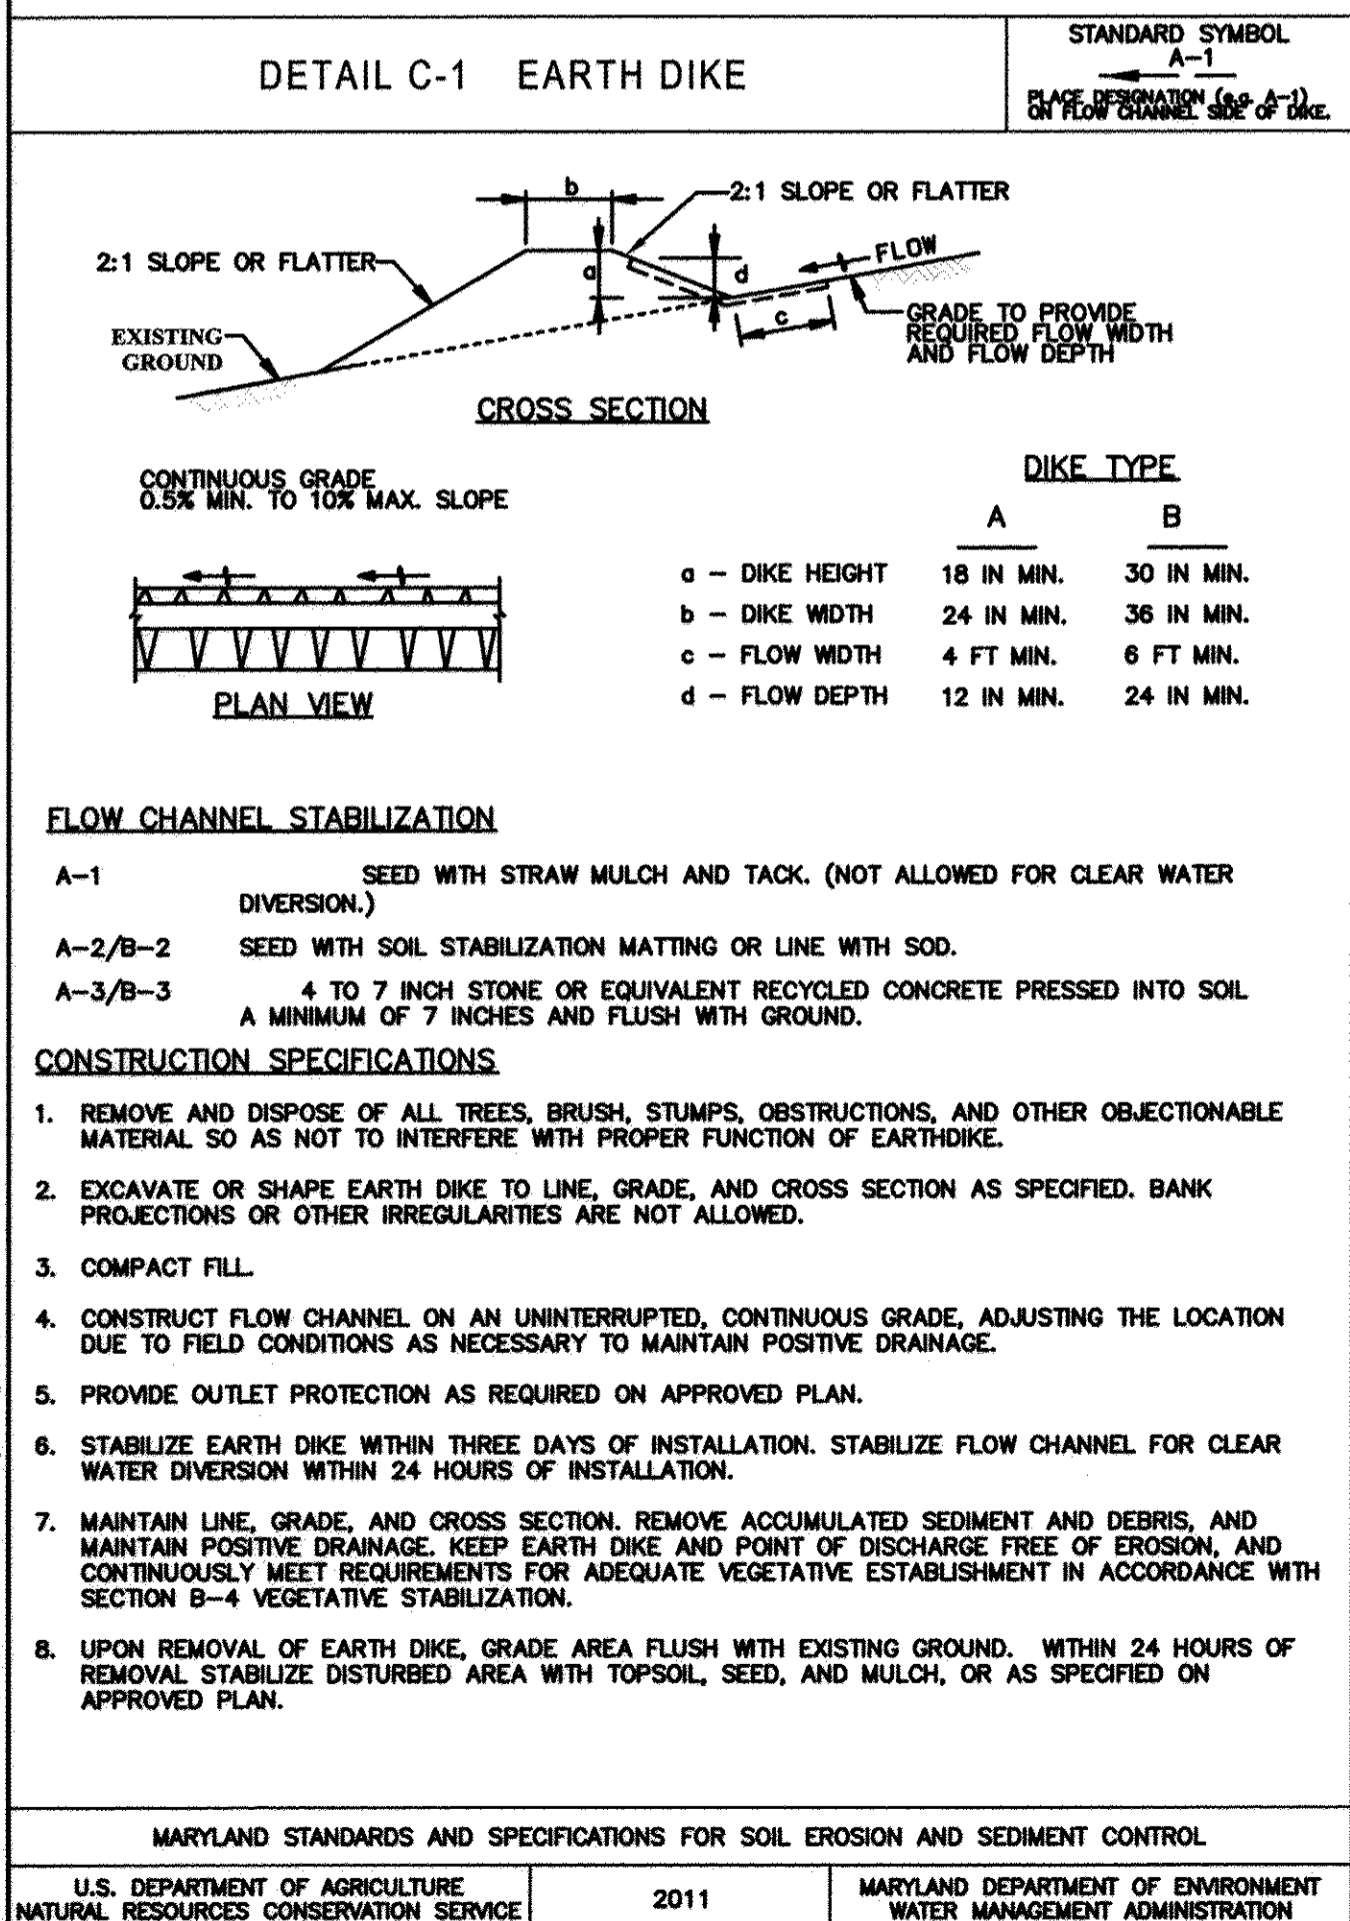


MARYLAND STANDARDS AND SPECIFICATIONS FOR SOIL EROSION AND SEDIMENT CONTROL
 U.S. DEPARTMENT OF AGRICULTURE NATURAL RESOURCES CONSERVATION SERVICE 2011
 MARYLAND DEPARTMENT OF ENVIRONMENT WATER MANAGEMENT ADMINISTRATION

MARYLAND STANDARDS AND SPECIFICATIONS FOR SOIL EROSION AND SEDIMENT CONTROL
 U.S. DEPARTMENT OF AGRICULTURE NATURAL RESOURCES CONSERVATION SERVICE 2011
 MARYLAND DEPARTMENT OF ENVIRONMENT WATER MANAGEMENT ADMINISTRATION

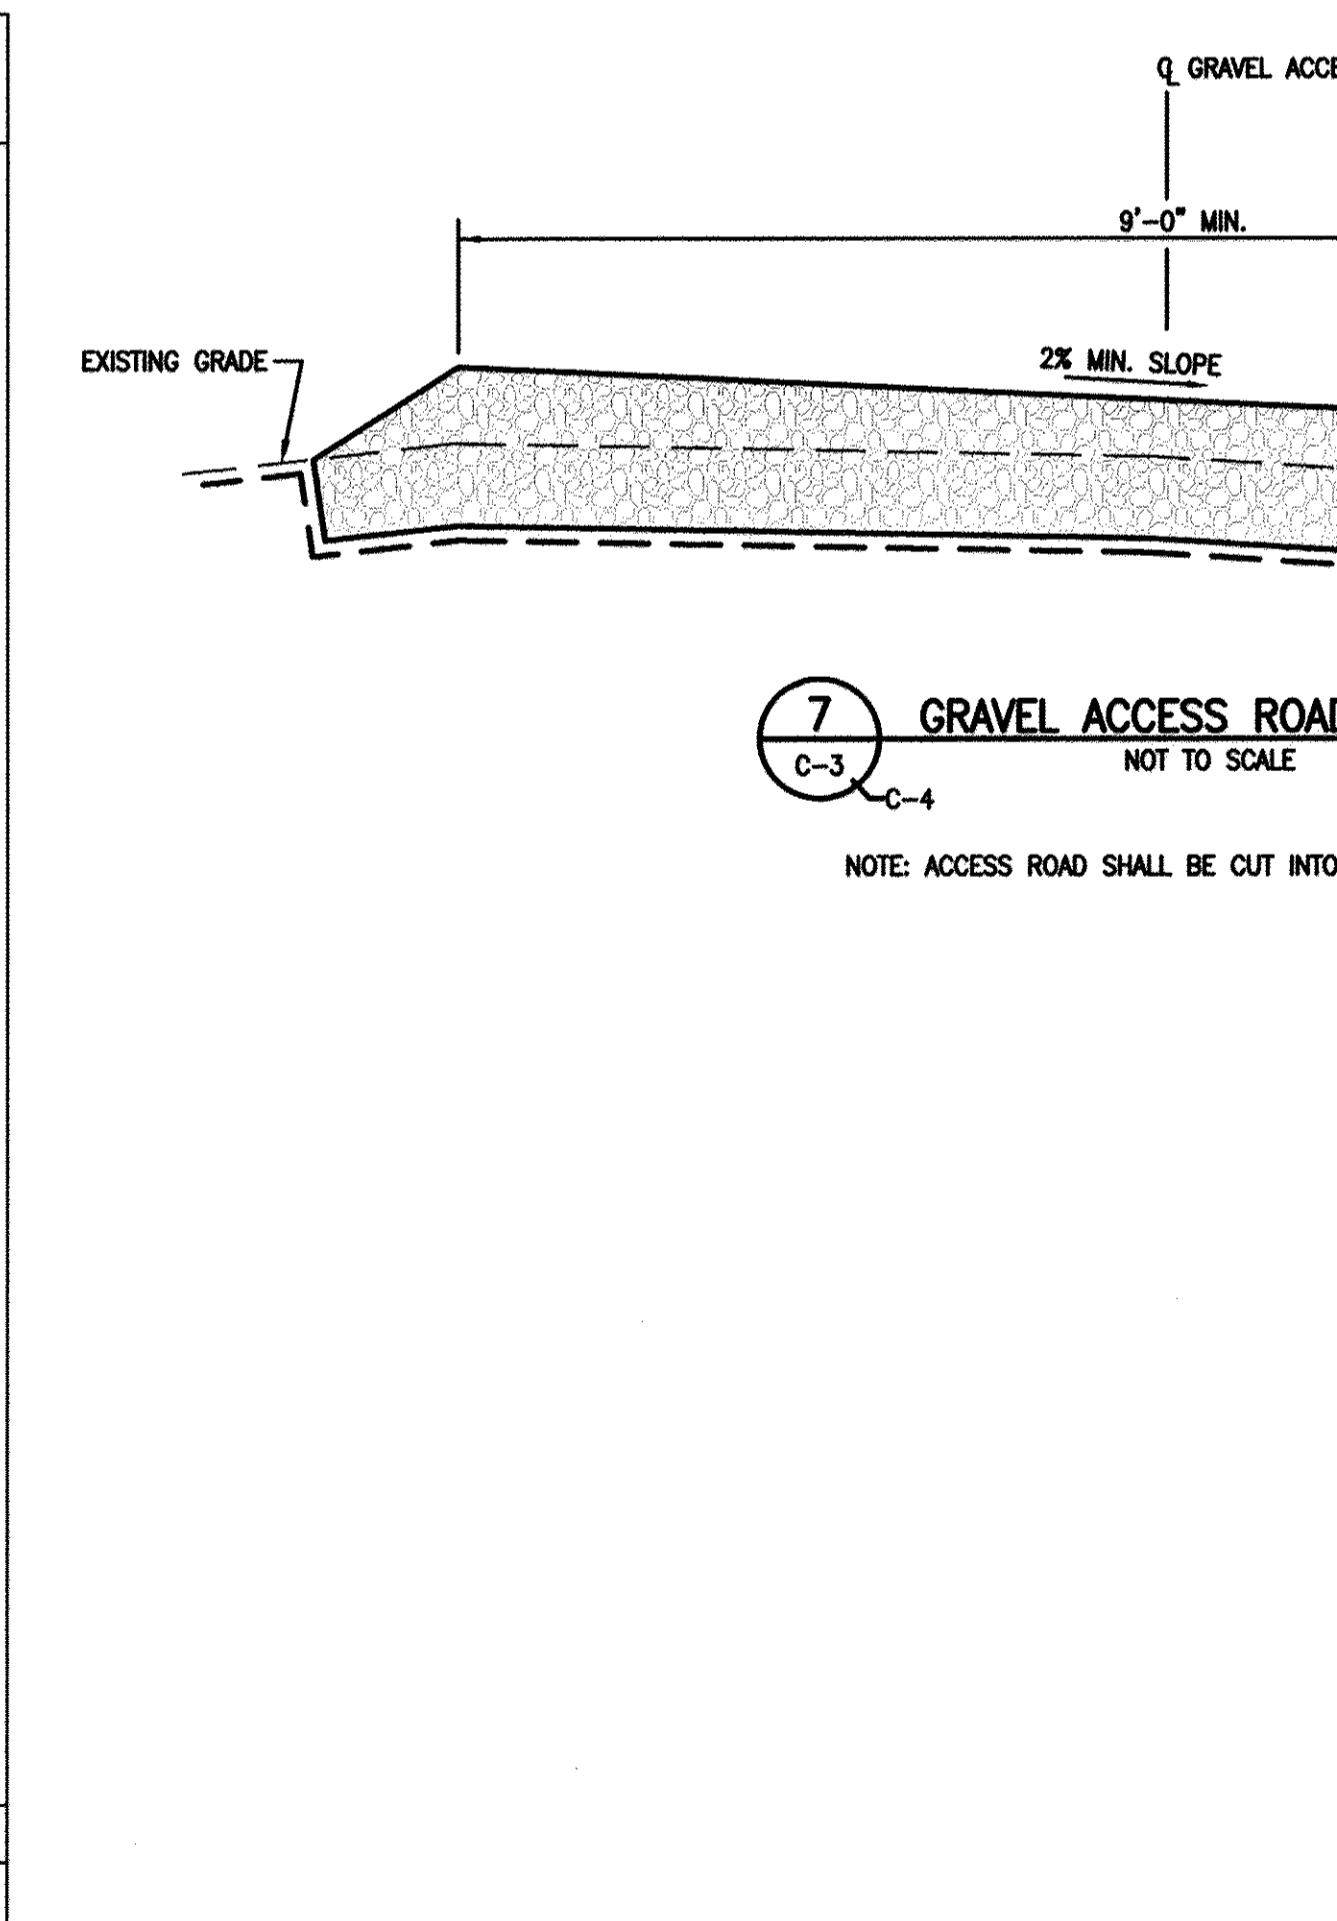

MARYLAND STANDARDS AND SPECIFICATIONS FOR SOIL EROSION AND SEDIMENT CONTROL
 U.S. DEPARTMENT OF AGRICULTURE NATURAL RESOURCES CONSERVATION SERVICE 2011
 MARYLAND DEPARTMENT OF ENVIRONMENT WATER MANAGEMENT ADMINISTRATION

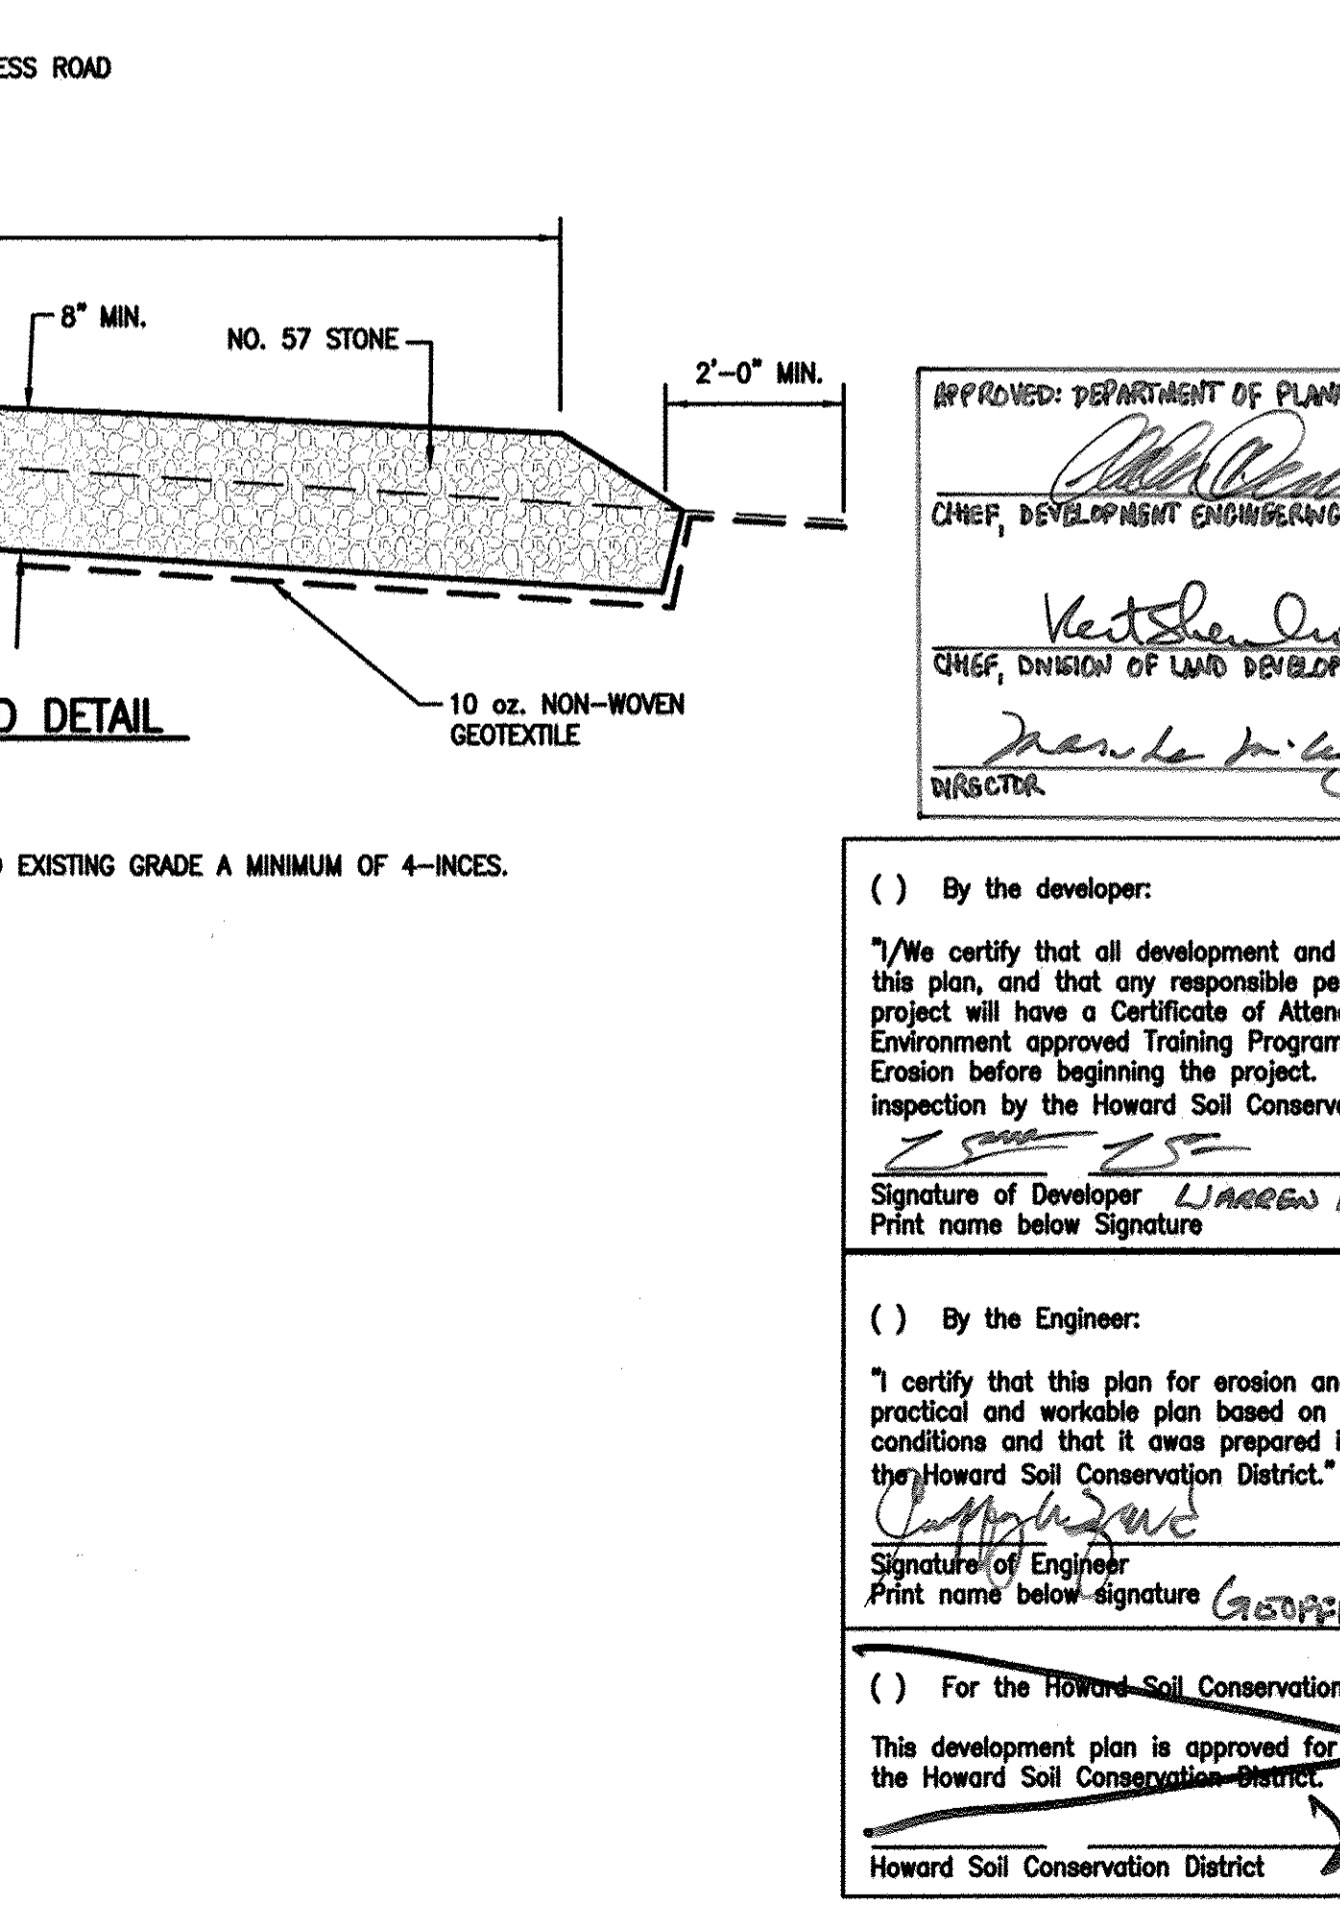

MARYLAND STANDARDS AND SPECIFICATIONS FOR SOIL EROSION AND SEDIMENT CONTROL
 U.S. DEPARTMENT OF AGRICULTURE NATURAL RESOURCES CONSERVATION SERVICE 2011
 MARYLAND DEPARTMENT OF ENVIRONMENT WATER MANAGEMENT ADMINISTRATION

CLASS	RIPRAP	THICKNESS (T)
I	19 IN	
II	32 IN	
III	48 IN	

PROFESSIONAL CERTIFICATION. I HEREBY CERTIFY THAT THESE DOCUMENTS WERE PREPARED OR APPROVED BY ME, AND THAT I AM A DULY LICENSED PROFESSIONAL ENGINEER UNDER THE LAWS OF THE STATE OF MARYLAND, LICENSE NO. 15453, EXPIRATION DATE: JULY 02, 2013.

APPROVED: DEPARTMENT OF PLANNING AND ZONING
 CHIEF, DEVELOPMENT ENGINEERING DIVISION
 CHIEF, DIVISION OF LAND DEVELOPMENT
 DIRECTOR

() By the developer:
 "I/We certify that all development and construction will be done according to this plan, and that any responsible personnel involved in the construction project will have a Certificate of Attendance at a Department of the Environment approved Training Program for the Control of Sediment and Erosion before beginning the project. I also authorize periodic on-site inspection by the Howard Soil Conservation District."

() By the Engineer:
 "I certify that this plan for erosion and sediment control represents a practical and workable plan based on my personal knowledge of the site conditions and that it was prepared in accordance with the requirements of the Howard Soil Conservation District."

() For the Howard Soil Conservation District:
 This development plan is approved for soil erosion and sediment control by the Howard Soil Conservation District.

NIXON FARMS SOLAR PHASE 1
 2800 NIXON'S FARM LANE, WEST FRIENDSHIP, MARYLAND 21792

GRID: 16, 17, 22
 ZONING: RC-DEO
 TAX MAP: 0015

EROSION AND SEDIMENT CONTROL DETAILS

EA ENGINEERING, SCIENCE, AND TECHNOLOGY
 Loveton Center
 15 Loveton Circle
 Sparks, Maryland 21152
 (410) 771-4950

DATE: AUGUST 2012
 DESIGNED BY: MBS
 DRAWN BY: JSP
 CHECKED BY: GAT
 PROJECT MANAGER: JMH
 PROJECT NUMBER: 14825.02
 DRAWING NUMBER: C-8
 SHEET NUMBER: 10 OF 13

HOWARD SOIL CONSERVATION DISTRICT
STANDARD SEDIMENT CONTROL NOTES

- A MINIMUM OF 48 HOURS NOTICE MUST BE GIVEN TO THE HOWARD COUNTY DEPARTMENT OF INSPECTIONS, LICENSES AND PERMITS, SEDIMENT CONTROL DIVISION PRIOR TO THE START OF ANY CONSTRUCTION (313-1855).
- ALL VEGETATIVE AND STRUCTURAL PRACTICES ARE TO BE INSTALLED ACCORDING TO THE PROVISIONS OF THIS PLAN AND ARE TO BE IN CONFORMANCE WITH THE MOST CURRENT MARYLAND STANDARDS AND SPECIFICATIONS FOR SOIL EROSION AND SEDIMENT CONTROL AND REVISIONS THERETO.
- FOLLOWING INITIAL SOIL DISTURBANCE OR RE-DISTURBANCE, PERMANENT OR TEMPORARY STABILIZATION SHALL BE COMPLETED WITHIN: A) 7 CALENDAR DAYS FOR ALL PERIMETER SEDIMENT CONTROL STRUCTURES, DIKES, PERIMETER SLOPES AND ALL SLOPES GREATER THAN 3:1, B) 14 DAYS AS TO ALL OTHER DISTURBED OR GRADED AREAS ON THE PROJECT SITE.
- ALL SEDIMENT TRAPS/BASINS SHOWN MUST BE FENCED AND WARNING SIGNS POSTED AROUND THEIR PERIMETER IN ACCORDANCE WITH VOL 1, CHAPTER 12 OF THE HOWARD COUNTY DESIGN MANUAL, STORM DRAINAGE.
- ALL DISTURBED AREAS MUST BE STABILIZED WITHIN THE TIME PERIOD SPECIFIED ABOVE IN ACCORDANCE WITH THE 1994 MARYLAND STANDARDS AND SPECIFICATIONS FOR SOIL EROSION AND SEDIMENT CONTROL FOR PERMANENT SEEDING (SEC. 51), SOD (SEC. 54), TEMPORARY SEEDING (SEC. 50) AND MULCHING (SEC. 52). TEMPORARY STABILIZATION WITH MULCH ALONE CAN ONLY BE DONE WHEN RECOMMENDED SEEDING DATES DO NOT ALLOW FOR PROPER GERMINATION AND ESTABLISHMENT OF GRASSES.
- ALL SEDIMENT CONTROL STRUCTURES ARE TO REMAIN IN PLACE AND ARE TO BE MAINTAINED IN OPERATIVE CONDITION UNTIL PERMISSION FOR THEIR REMOVAL HAS BEEN OBTAINED FROM THE HOWARD COUNTY SEDIMENT CONTROL INSPECTOR.
- SITE ANALYSIS:

TOTAL AREA OF SITE 96,920 ACRES
 AREA DISTURBED 9,460 ACRES
 AREA TO BE ROOFED OR PAVED 0,455 ACRES
 AREA TO BE VEGETATIVELY STABILIZED 9,005 ACRES
 TOTAL CUT 130 CU. YDS.
 TOTAL FILL 130 CU. YDS.

OFFSITE WASTE/BORROW AREA LOCATION: N/A

- ANY SEDIMENT CONTROL PRACTICE WHICH IS DISTURBED BY GRADING ACTIVITY FOR PLACEMENT OF UTILITIES MUST BE REPAIRED ON THE SAME DAY OF DISTURBANCE.
- ADDITIONAL SEDIMENT CONTROL MUST BE PROVIDED, IF DEEMED NECESSARY BY THE HOWARD COUNTY SEDIMENT CONTROL INSPECTOR.
- ON ALL SITES WITH DISTURBED AREAS IN EXCESS OF 2 ACRES, APPROVAL OF THE INSPECTION AGENCY SHALL BE REQUESTED UPON COMPLETION OF INSTALLATION OF PERIMETER EROSION AND SEDIMENT CONTROLS, BUT BEFORE PROCEEDING WITH ANY OTHER EARTH DISTURBANCE OR GRADING. OTHER BUILDING OR GRADING INSPECTION APPROVALS MAY NOT BE AUTHORIZED UNTIL THIS INITIAL APPROVAL BY THE INSPECTION AGENCY IS MADE.
- TRENCHES FOR THE CONSTRUCTION OF UTILITIES IS LIMITED TO THREE PIPE LENGTHS OR THAT WHICH SHALL BE BACK-FILLED AND STABILIZED BY THE END OF EACH WORK DAY, WHICHEVER IS SHORTER.

HOWARD SOIL CONSERVATION DISTRICT
PERMANENT SEEDING NOTES

APPLY TO GRADED OR CLEARED AREAS NOT SUBJECT TO IMMEDIATE FURTHER DISTURBANCE WHERE A PERMANENT LONG-LIVED VEGETATIVE COVER IS NEEDED.

SEEDBED PREPARATION: LOOSEN UPPER THREE INCHES OF SOIL BY RAKING, DISKING OR OTHER ACCEPTABLE MEANS BEFORE SEEDING, IF NOT PREVIOUSLY LOOSENED.

SOIL AMENDMENTS: IN LIEU OF SOIL TEST RECOMMENDATIONS, USE ONE OF THE FOLLOWING SCHEDULES:

1. PREFERRED -- APPLY 2 TONS/ACRE DOLOMITIC LIMESTONE (92 LBS/1000 SQ. FT.) AND 600 LBS/ACRE 10-10-10 FERTILIZER (14 LBS/1000 SQ. FT.) BEFORE SEEDING. HARROW OR DISK INTO UPPER THREE INCHES OF SOIL. AT TIME OF SEEDING, APPLY 400 LBS/ACRE 30-0-0 UREAFORM FERTILIZER (9 LBS/1000 SQ. FT.)

2. ACCEPTABLE -- APPLY 2 TONS/ACRE DOLOMITIC LIMESTONE (92 LBS/1000 SQ. FT.) AND 1000 LBS/ACRE 10-10-10 FERTILIZER (23 LBS/1000 SQ. FT.) BEFORE SEEDING. HARROW OR DISK INTO UPPER THREE INCHES OF SOIL.

SEEDING -- FOR THE PERIODS MARCH 1 - APRIL 30, AND AUGUST 1 - OCTOBER 15, SEED WITH 60 LBS/ACRE (1.4LBS/1000 SQ.FT.) OF KENTUCKY 31 TALL FESCUE. FOR THE PERIOD MAY 1 - JULY 31, SEED WITH 80 LBS KENTUCKY 31 TALL FESCUE PER ACRE AND 2 LBS/ACRE (.05 LBS/1000) SQ. FT.) OF WEEPING LOVEGRASS. DURING THE PERIOD OF OCTOBER 16 - FEBRUARY 28, PROTECT SITE BY:

- OPTION 1 -- TWO TONS PER ACRE OF WELL ANCHORED STRAW MULCH AND SEED AS SOON AS POSSIBLE IN THE SPRING.
 OPTION 2 -- USE SOD.
 OPTION 3 -- SEED WITH 60 LBS/ACRE KENTUCKY 30 TALL FESCUE AND MULCH WITH 2 TONS/ACRE WELL ANCHORED STRAW.

MULCHING -- APPLY 1-1/2 TO 2 TONS PER ACRE (70 TO 90 LBS/1000 SQ. FT.) OF UNROTTED SMALL GRAIN STRAW IMMEDIATELY AFTER SEEDING. ANCHOR MULCH IMMEDIATELY AFTER APPLICATION USING MULCH ANCHORING TOOL OR 218 GALLONS PER ACRE (5 GAL/1000 SQ. FT.) OF EMULSIFIED ASPHALT ON FLAT AREAS. ON SLOPE 8 FEET OR HIGHER, USE 348 GALLONS PER ACRE (8 GAL/1000 SQ. FT.) FOR ANCHORING.

MAINTENANCE -- INSPECT ALL SEEDING AREAS AND MAKE NEEDED REPAIRS, REPLACEMENTS AND RESEEDINGS.

TEMPORARY SEEDING NOTES

APPLY TO GRADED OR CLEARED AREAS LIKELY TO BE RE-DISTURBED WHERE A SHORT-TERM VEGETATIVE COVER IS NEEDED.

SEEDBED PREPARATION: -- LOOSEN UPPER THREE INCHES OF SOIL BY RAKING, DISKING OR OTHER ACCEPTABLE MEANS BEFORE SEEDING, IF NOT PREVIOUSLY LOOSENED.

SOIL AMENDMENTS: -- APPLY 600 LBS/ACRE 10-10-10 FERTILIZER (14 LBS/1000 SQ.FT.).

SEEDING: -- FOR PERIODS MARCH 1 - APRIL 30 AND FROM AUGUST 15 - OCTOBER 15, SEED WITH 2-1/2 BUSHEL PER ACRE OF ANNUAL RYE (3.2 LBS/1000 SQ. FT.). FOR THE PERIOD MAY 1 - AUGUST 14, SEED WITH 3 LBS/ACRE OF WEEPING LOVEGRASS (.07 LBS/1000 SQ. FT.). FOR THE PERIOD NOVEMBER 16 - FEBRUARY 28, PROTECT SITE BY APPLYING 2 TONS/ACRE OF WELL ANCHORED STRAW MULCH AND SEED AS SOON AS POSSIBLE IN THE SPRING, OR USE SOD.


MULCHING: -- APPLY 1-1/2 TO 2 TONS/ACRE (70 TO 90 LBS/1000 SQ. FT.) OF UNROTTED WEED-FREE, SMALL GRAIN STRAW IMMEDIATELY AFTER SEEDING. ANCHOR MULCH IMMEDIATELY AFTER APPLICATION USING MULCH ANCHORING TOOL OR 218 GAL. PER ACRE (5 GAL/1000 SQ. FT.) OF EMULSIFIED ASPHALT ON FLAT AREAS. ON SLOPE 8 FT. OR HIGHER, USE 348 GAL. PER ACRE (8 GAL/1000 SQ. FT.) FOR ANCHORING.

REFER TO THE 1994 MARYLAND STANDARDS AND SPECIFICATIONS FOR SOIL EROSION AND SEDIMENT CONTROL FOR ADDITIONAL RATES AND METHODS NOT COVERED.

SEQUENCE OF CONSTRUCTION

SEQUENCE OF CONSTRUCTION	DURATION
1. OBTAIN A GRADING PERMIT.	1 DAY
2. CONTACT HOWARD COUNTY SEDIMENT CONTROL INSPECTOR AT LEAST 72 HOURS PRIOR TO COMMENCEMENT OF CONSTRUCTION.	3 DAYS
3. INSTALL ALL PERIMETER SEDIMENT CONTROL FEATURES INCLUDING STONE CONSTRUCTION ENTRANCE, SUPER SILT FENCE, TEMPORARY 15" DIVERSION PIPE, EARTH DIKES AND DIVERSION FENCES.	2 DAYS
4. UPON INSTALLATION OF PERIMETER CONTROLS AND AFTER RECEIVING APPROVAL FROM THE SEDIMENT CONTROL INSPECTOR, BEGIN INSTALLATION OF GRAVEL ACCESS DRIVE, SOLAR PANELS, UNDERGROUND ELECTRIC AND INVERTERS.	30 DAYS
5. CONTACT THE AS-BUILT CERTIFYING ENGINEER AT LEAST 72 HOURS PRIOR TO BEGINNING CONSTRUCTION OF THE MICRO-BIORETENTION FACILITY.	3 DAYS
6. WITH A 3-DAY NOAA DRY WEATHER FORECAST, BEGIN AND COMPLETE CONSTRUCTION OF THE MICRO-BIORETENTION FACILITY.	3 DAYS
7. UPON COMPLETION OF SOLAR PANEL CONSTRUCTION, INSTALL LANDSCAPING BUFFER AS SHOWN ON THE LANDSCAPING PLANS.	2 DAYS
8. REMOVE SEDIMENT CONTROL PRACTICES UPON RECEIVING PERMISSION FROM THE HOWARD COUNTY SEDIMENT CONTROL INSPECTOR. PERMANENTLY SEED AND STABILIZE THESE AREAS IMMEDIATELY UPON REMOVAL.	1 DAY


PROFESSIONAL CERTIFICATION. I HEREBY CERTIFY THAT THESE DOCUMENTS WERE PREPARED OR APPROVED BY ME, AND THAT I AM A DULY LICENSED PROFESSIONAL ENGINEER UNDER THE LAWS OF THE STATE OF MARYLAND. LICENSE NO. 25453 EXPIRATION DATE: JULY 2, 2013

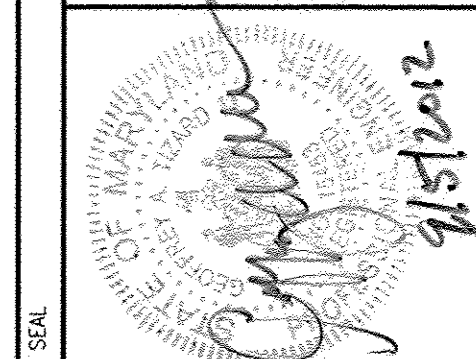

BLOCK: N/A
 PARCEL: 0080
 ELECTION DISTRICT: 3

NIXON FARMS SOLAR
 PHASE 1
 2800 NIXON'S FARM LANE, WEST FRIENDSHIP, MARYLAND 21792

GRID: 16, 17, 22
 ZONING: RC-DEO
 TAX MAP: 0015

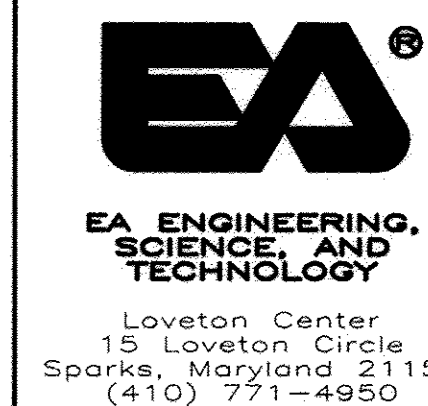

DATE: AUGUST 2012
 DESIGNED BY: MBS
 DRAWN BY: JSP
 CHECKED BY: GAT
 PROJECT MANAGER: JMH
 PROJECT NUMBER: 14825.02
 DRAWING NUMBER: C-9
 SHEET NUMBER: 11 OF 13

APPROVED: DEPARTMENT OF PLANNING AND ZONING
 [Signature] 10/2/12
 CHIEF, DEVELOPMENT ENGINEERING DIVISION
 [Signature] 10/05/12
 CHIEF, DIVISION OF LAND DEVELOPMENT
 [Signature] 10/1/12
 DIRECTOR

() By the developer:
 "I/We certify that all development and construction will be done according to this plan, and that any responsible personnel involved in the construction project will have a Certificate of Attendance at a Department of the Environment approved Training Program for the Control of Sediment and Erosion before beginning the project. I also authorize periodic on-site inspection by the Howard Soil Conservation District."
 [Signature] 09/07/2012
 Signature of Developer WARREN WOOD Date
 Print name below Signature

() By the Engineer:
 "I certify that this plan for erosion and sediment control represents a practical and workable plan based on my personal knowledge of the site conditions and that it was prepared in accordance with the requirements of the Howard Soil Conservation District."
 [Signature] 10 September 2012
 Signature of Engineer Date
 Print name below signature GUYMON A. FISHER



() For the Howard Soil Conservation District:
 This development plan is approved for soil erosion and sediment control by the Howard Soil Conservation District.
 [Signature]
 Howard Soil Conservation District Date

DEVELOPER:

BTH ENERGY
 ATTN: R. DANIEL WALLACE
 113 WEST MONUMENT ST.
 BALTIMORE, MD 21201
 PHONE: (410) 962-1188

OWNER:

2800 NIXONS FARM LANE, LLC
 17500 FREDERICK ROAD
 MT. AIRY, MD 21771
 PHONE: (410) 461-7200

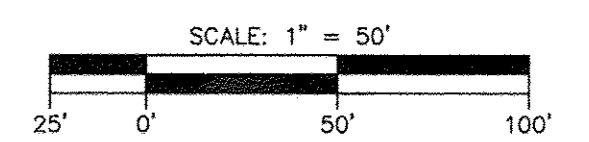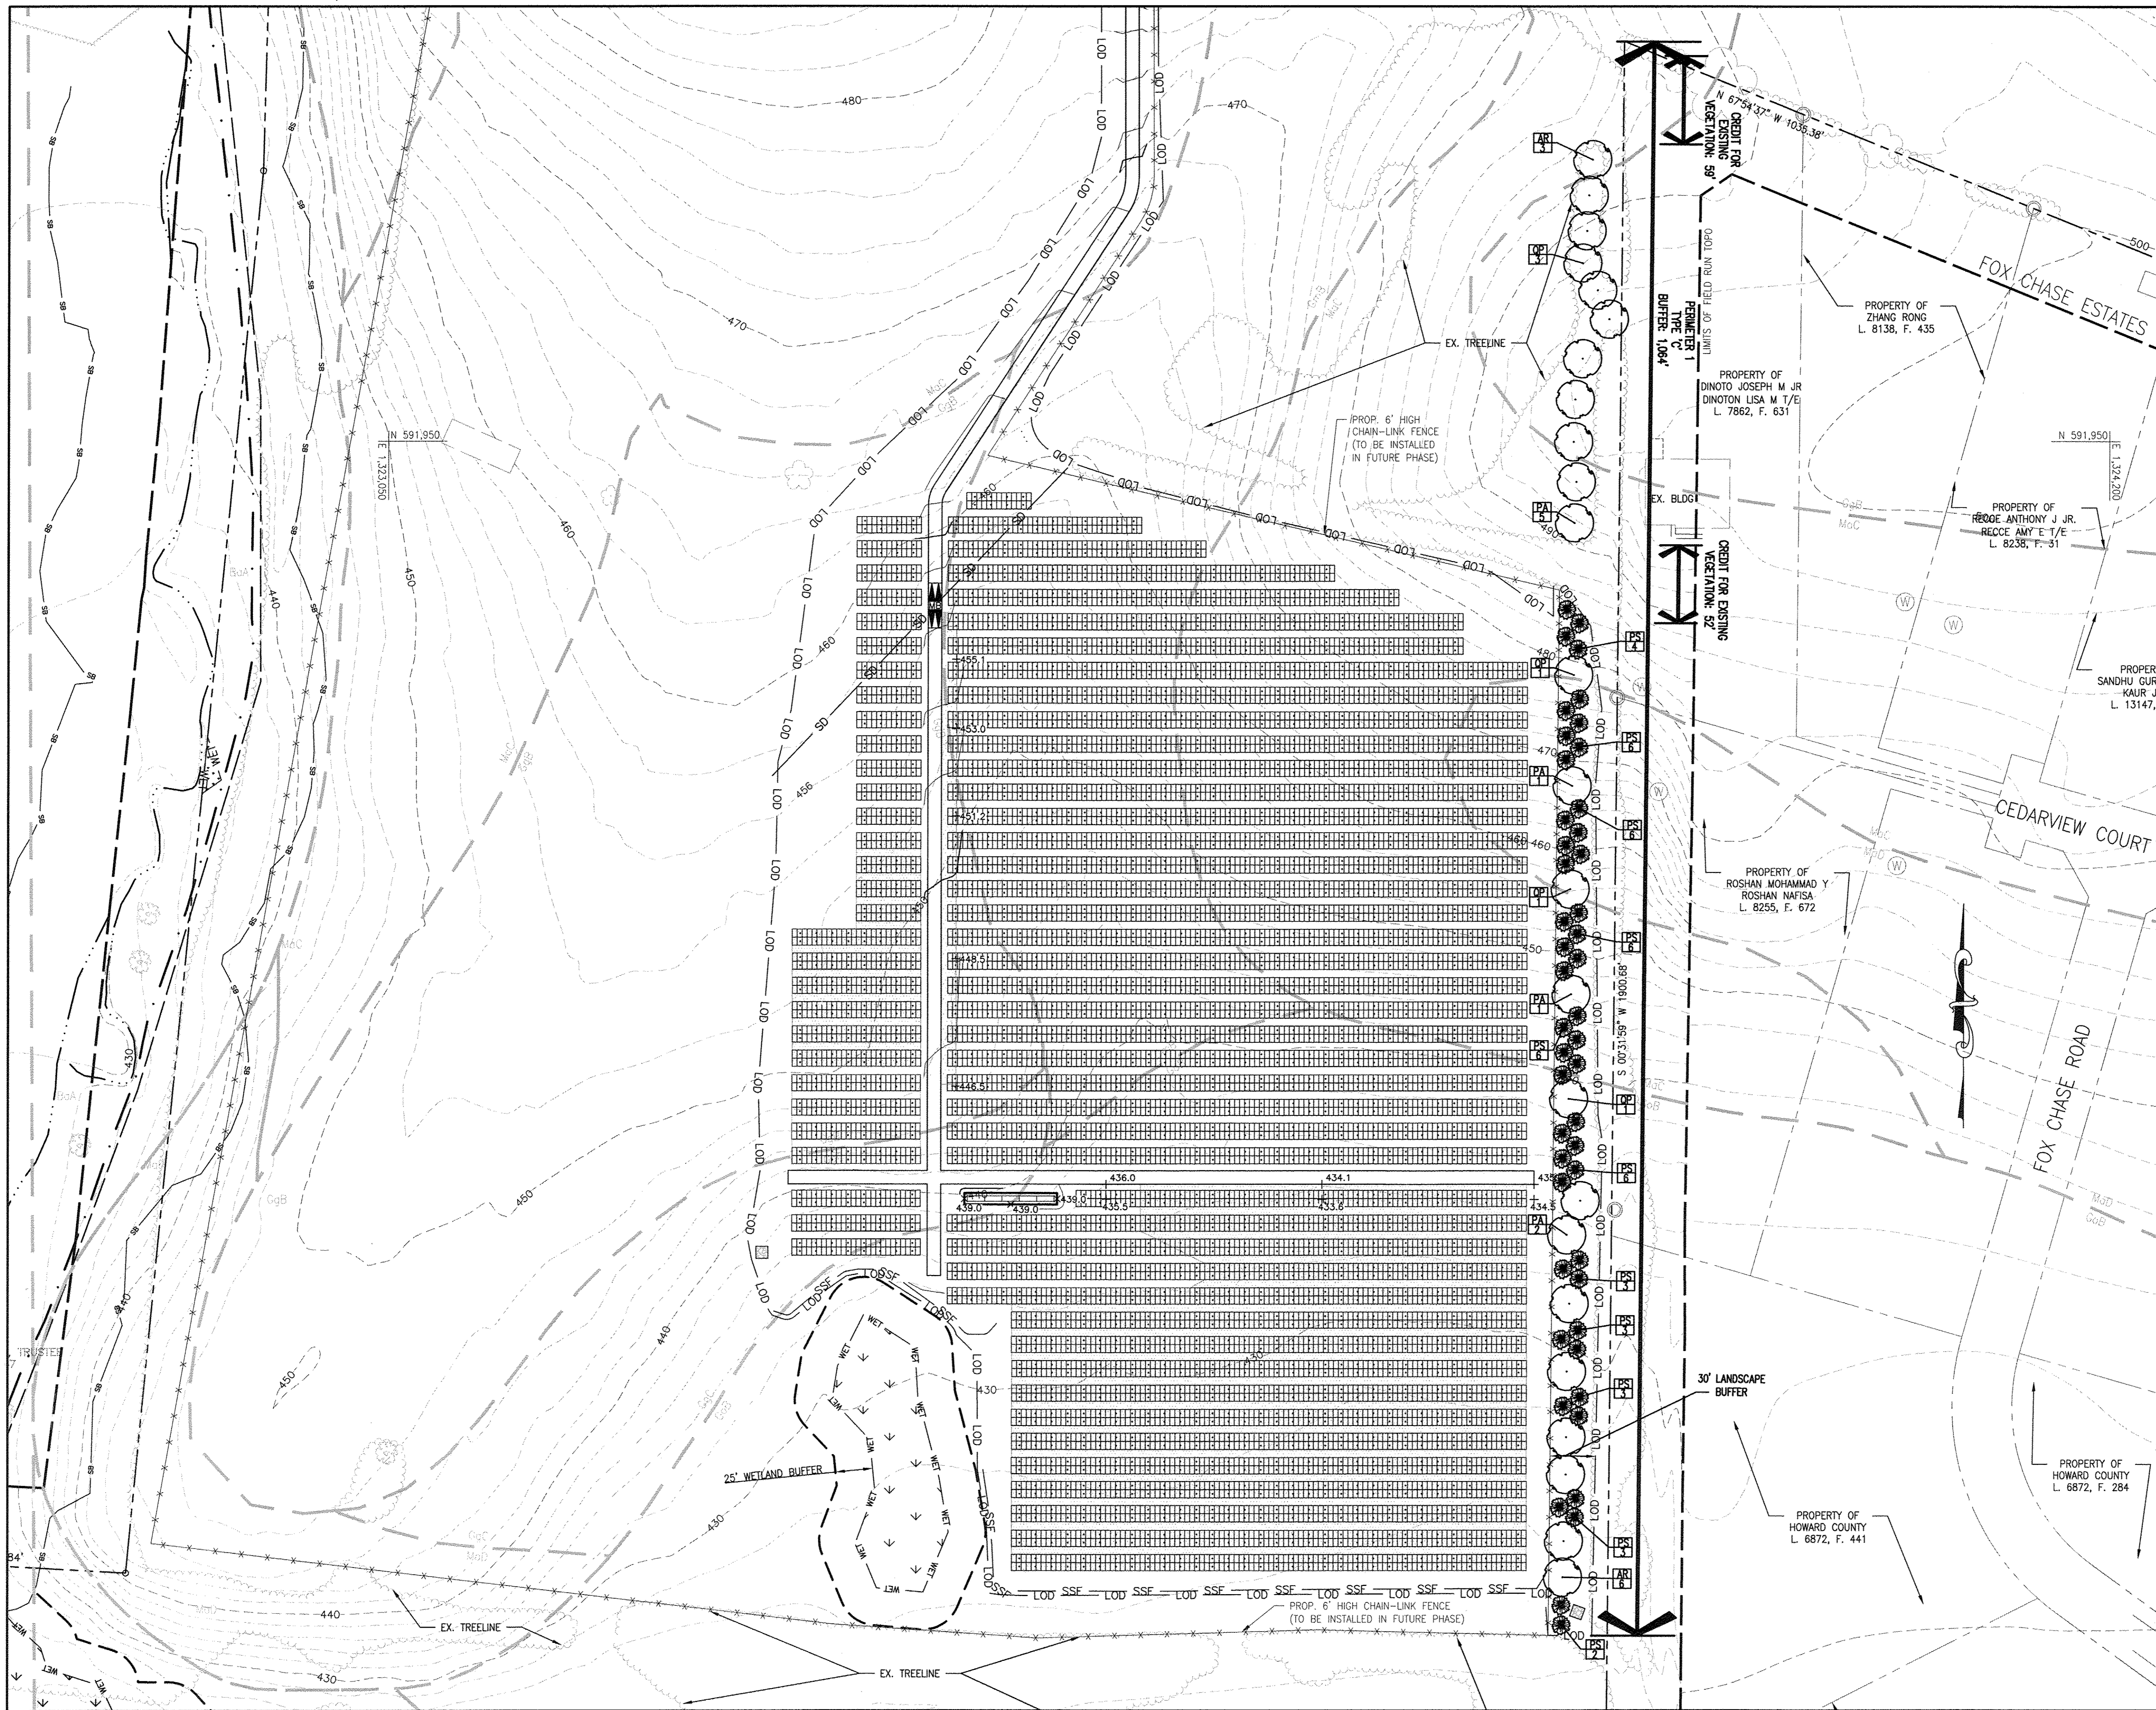

NOTE: PROPOSED PLANTING LOCATIONS SHALL BE ADJUSTED BASED ON MEETINGS WITH ADJACENT COMMUNITY MEMBERS. LANDSCAPING SHALL BE ADJUSTED TO PROVIDE MAXIMUM SCREENING BASED ON VIEWS FROM ADJACENT PROPERTIES.

APPROVED : DEPARTMENT OF PLANNING AND ZONING

[Signature] 10/2/12
 CHIEF, DEVELOPMENT ENGINEERING DIVISION DATE
 [Signature] 10/09/12
 CHIEF, DIVISION OF LAND DEVELOPMENT DATE
 [Signature] 10/9/12
 DIRECTOR DATE

DATE	NO.	REVISION

DEVELOPER

THE BITH GROUP
 ATTN: R. DANIEL WALLACE
 113 WEST MONUMENT STREET
 BALTIMORE, MD 21201
 T: 410-962-1188

OWNER

NIXONS FARM LANE LLC
 17500 FREDERICK ROAD
 MT AIRY, MD 21771
 T: 410-461-7200

PROJECT

NIXON SOLAR

AREA

TAX MAP 15, PARCEL 90 ZONED RC-DEO
 GRID NO.S 16, 17, AND 22 3rd ELECTION DISTRICT
 HOWARD COUNTY, MARYLAND

TITLE

LANDSCAPE PLAN

PHRA Patton Harris Rust & Associates
 Engineers, Surveyors, Planners, Landscape Architects.
 8818 Centre Park Drive, Suite 200, Columbia, MD 21045
 Tel: 410-997-8900 Fax: 410-997-9282

DATE: 9.6.12

DESIGNED BY : ALC

DRAWN BY: ALC/PJS

PROJECT NO : B1EN1201
 L200LND01.DWG

DATE : SEPTEMBER 10, 2012

SCALE : 1" = 50'

DRAWING NO. 12 OF 13

PETER J. STONE #3068

PLANTING SPECIFICATIONS

- Plants, related material, and operations shall meet the detailed description, as given on the plans and as described herein. Where discrepancies exist between Standards & Guidelines referenced within these specifications and the Landscape Manual of the applicable jurisdiction, the latter takes precedence.
- All plant material, unless otherwise specified, that is not nursery grown, uniformly branched, does not have a vigorous root system, and does not conform to the most recent edition of the American Nursery & Landscape Association (ANLA) Standards will be rejected. Plant material that is not healthy, vigorous, free from defects, decay, distiguring roots, sunscald injuries, abrasions of the bark, plant disease, insect pest eggs, borers and all forms of insect infestations or objectionable disfigurements will be rejected. Plant material that is weak or which has been cut back from larger grades to meet specified requirements will be rejected. Trees with forked leaders will be rejected. All B & B plants shall be freshly dug; no head-in plants or plants from cold storage will be accepted.
- Unless otherwise specified, all general conditions, planting operations, details and planting specifications shall conform to the most recent edition of the "Landscape Specification Guidelines by the Landscape Contractors Association of MD, DC, & VA", (hereinafter "Landscape Guidelines") approved by the Landscape Contractors Association of Metropolitan Washington and the Potomac Chapter of the American Society of Landscape Architects.
- Contractor shall guarantee all plant material for a period of one year after date of acceptance in accordance with the appropriate section on the Landscape Guidelines. Contractor's attention is directed to the maintenance requirements found within the one year specifications including watering and replacement of specified plant material.
- Contractor shall be responsible for notifying all relevant and appropriate utility companies, utility contractors, and "Miss Utility" a minimum of 48 hours prior to the beginning of any work. Contractor may make minor adjustments in spacing and location of plant material to avoid conflicts with utilities. Major changes will require the approval of the landscape architect. Damage to existing structure and utilities shall be repaired at the expense of the Contractor.
- Protection of existing vegetation to remain shall be accomplished via the temporary installation of 4 foot high snow fence at the drip line, see detail.
- Contractor is responsible for installing all material in the proper planting season for each plant type. All planting is to be completed within growing season of completion of site construction. Do not plant *Pinus strobus* or *Xcupressocyparis leylandii* between November 15 and March 15. Landscape plants are not to be installed before site is graded to final grade.
- Contractor to regrade, fine grade, sod, hydroseed and straw mulch all areas disturbed by their work.
- Bid shall be based on actual site conditions. No extra payment shall be made for work arising from actual site conditions differing from those indicated on drawings and specifications.
- Plant quantities are provided for the convenience of the contractor only. If discrepancies exist between quantities shown on plan and those shown on the plant list, the quantities on the plant list take precedence. Where discrepancies on the plan exist between the symbols and the callout letter, the number of symbols take precedence.
- All shrubs and groundcover areas shall be planted in continuous planting beds, prepared as specified, unless otherwise indicated on plans. (See Specification 13). Beds to be mulched with minimum 2" and maximum 3" of composted, double-shredded hardwood mulch throughout.
- Positive drainage shall be maintained on planting beds (minimum 2 percent slope).
- Bed preparation shall be as follows: Till into a minimum depth of 6" 1 yard of Compro or Leafgro per 200 SF of planting bed, and 1 yard of topsoil per 100 SF of bed. Add 3 lbs of standard 5-10-5 fertilizer per cubic yard of planting mix and till. Ericaceous plants (Azaleas, Rhododendrons, etc.); top dress after planting with iron sulfate or comparable product according to package directions. *Toxus baccata* 'Repandens' (English weeping yew); top dress after planting with 1/4 to 1/2 cup lime each.
- Planting mix: For trees not in a prepared bed, mix 50% Compro or Leafgro with 50% soil from tree hole to use as backfill, see tree planting detail.
- Weed & insect control: Incorporate a pre-emergent herbicide into the planting bed following recommended rates on the label. For tree planting, apply a pre-emergent on top of soil and root ball before mulching. Caution: For areas to be planted with a ground cover, be sure to carefully check the chemical used to assure its adaptability to the specific groundcover to be treated. Maintain the mulch weed-free for the extent of the warranty period. Under no circumstances is a pesticide containing chlorpyrifos to be used as a means of pest control.
- Water: All plant material planted shall be watered thoroughly the day of planting. All plant material not yet planted shall be properly protected from drying out until planted. At a minimum, water unplanted plant material daily and as necessary to avoid desiccation.
- Pruning: Do not heavily prune trees and shrubs at planting. Prune only broken, dead, or diseased branches.
- All areas within contract limits disturbed during or prior to construction not designated to receive plants and mulch shall be fine graded, grass seed planted, and covered with straw mulch.

GENERAL NOTES:

- THIS PLAN HAS BEEN PREPARED IN ACCORDANCE WITH THE PROVISIONS OF SECTION 16.124 OF THE HOWARD COUNTY CODE AND THE LANDSCAPE MANUAL.
- FINANCIAL SURETY FOR THE REQUIRED LANDSCAPING HAS BEEN POSTED AS PART OF THE DEVELOPER'S AGREEMENT IN THE AMOUNT OF \$14,400.00.
24 SHADE TREES @ \$300 = \$7,200.00
0 ORNAMENTAL TREES @ \$150 = \$0.00
48 EVERGREEN TREES @ \$150 = \$7,200.00
0 SHRUBS @ \$30 = \$0.00
BONDED LANDSCAPING INCLUDES REQUIRED LANDSCAPING PER THE LANDSCAPE MANUAL.
- THIS PLAN IS FOR LANDSCAPING PURPOSES ONLY.
- CONTRACTOR IS SOLELY RESPONSIBLE FOR CONSTRUCTION MEANS, METHODS, TECHNIQUES, SEQUENCES, PROCEDURES, AND SAFETY PRECAUTIONS AND PROGRAMS.
- ALL MATERIAL SELECTED SHALL BE EQUAL TO OR BETTER THAN THE REQUIREMENTS OF THE "USA STANDARD FOR NURSERY STOCK", LATEST EDITION, AS PUBLISHED BY THE AMERICAN ASSOCIATION OF NURSERYMEN.
- ALL MATERIAL SHALL BE PLANTED IN ACCORDANCE WITH THE MINIMUM STANDARDS CITED IN THE LATEST EDITION OF "LANDSCAPE SPECIFICATION GUIDELINES" PUBLISHED BY THE LANDSCAPE CONTRACTORS ASSOCIATION.
- AT THE TIME OF INSTALLATION, ALL SHRUBS AND OTHER PLANTINGS SHALL BE OF THE PROPER HEIGHT AND/OR SPREAD REQUIREMENTS IN ACCORDANCE WITH THIS PLAN AND THE HOWARD COUNTY LANDSCAPE MANUAL.
- NO SUBSTITUTIONS OR RELOCATION OF PLANTS MAY BE MADE WITHOUT PRIOR APPROVAL FROM THE DEPARTMENT OF PLANNING AND ZONING OF HOWARD COUNTY. ANY DEVIATION FROM THIS LANDSCAPE PLAN MAY RESULT IN A REQUIREMENT FOR SUBMITTAL OF AN OFFICIAL "REDLINE REVISION" TO THE SITE DEVELOPMENT PLAN(S) AND/OR DENIAL IN THE RELEASE OF LANDSCAPE SURETY.

DEVELOPER'S/BUILDER'S CERTIFICATE:

I/WE CERTIFY THAT THE LANDSCAPING SHOWN ON THIS PLAN WILL BE DONE ACCORDING TO THE PLAN, SECTION 16.124 OF THE HOWARD COUNTY CODE AND THE HOWARD COUNTY LANDSCAPE MANUAL. I/WE FURTHER CERTIFY THAT UPON COMPLETION, A LETTER OF LANDSCAPE INSTALLATION, ACCOMPANIED BY AN EXECUTED ONE YEAR GUARANTEE OF PLANT MATERIALS, WILL BE SUBMITTED TO THE DEPARTMENT OF PLANNING AND ZONING.

SIGNATURE Warren Wood DATE 09/07/2012

APPROVED : DEPARTMENT OF PLANNING AND ZONING
 [Signature] 10/2/12
 CHIEF, DEVELOPMENT ENGINEERING DIVISION DATE
 [Signature] 10/09/12
 CHIEF, DIVISION OF LAND DEVELOPMENT DATE
 [Signature] 10/9/12
 DIRECTOR DATE


DATE	NO.	REVISION
DEVELOPER		
THE BITH GROUP ATTN: R. DANIEL WALLACE 113 WEST MONUMENT STREET BALTIMORE, MD 21201 T: 410-962-1188		
OWNER		
NIXONS FARM LANE LLC 17500 FREDERICK ROAD MT AIRY, MD 21771 T: 410-461-7200		
PROJECT		
NIXON SOLAR		
AREA		
TAX MAP 15, PARCEL 90 ZONED RC-DEO GRID NO.S 16, 17, AND 22 3rd ELECTION DISTRICT HOWARD COUNTY, MARYLAND		
TITLE		
LANDSCAPE NOTES AND DETAILS		

PHRA Patton Harris Rust & Associates
 Engineers, Surveyors, Planners, Landscape Architects.
 8818 Centre Park Drive, Suite 200, Columbia, MD, 21045
 Tel: 410-997-8900 Fax: 410-997-9282

9-6-12
 DATE
 DESIGNED BY : ALC
 DRAWN BY: ALC/PJS
 PROJECT NO : BIENT201
 L200LND02.DWG
 DATE : SEPTEMBER 10, 2012
 SCALE : 1" = 50'
 DRAWING NO. 13 OF 13
 PETER J. STONE #3068

NOTES:


- DO NOT HEAVILY PRUNE THE TREE AT PLANTING. PRUNE ONLY CROSSOVER LIMBS, CO-DOMINANT LEADERS, AND BROKEN OR DEAD BRANCHES. SOME INTERIOR TWIGS AND LATERAL BRANCHES MAY BE PRUNED; HOWEVER, DO NOT REMOVE THE TERMINAL BUDS OF BRANCHES THAT EXTEND TO THE EDGE OF THE CROWN.
- STAKE TREES AS SHOWN.
- DIG PLANTING PIT TWICE AS WIDE AS THE DIAMETER OF THE TOP OF THE ROOT BALL WITH A MINIMUM PLANTING PIT DIAMETER OF 5'.
- PLACE ROOT BALL ON UNEXCAVATED OR COMPACTED SOIL.
- TIGHTEN GUY ONLY ENOUGH TO KEEP FROM SLIPPING. ALLOW FOR SOME TRUNK MOVEMENT. GUY SHALL BE LONG ENOUGH TO ACCOMMODATE 1.5 IN. OF GROWTH AND ALL BRANCHES SHALL BE BUFFERED FROM THE GUY.
- TUCK ANY LOOSE ENDS OF THE GUY SO THAT NO LOOSE ENDS ARE EXPOSED.
- INSTALL THREE GUYS PER TREE, SPACED EVENLY AROUND THE TRUNK.
- REMOVE STAKES AFTER ONE YEAR.
- CONTRACTOR TO REMOVE AND GRADE OUT PLANTING SAUCER AT END OF ONE YEAR MAINTENANCE PERIOD. AREA AROUND TREES SHALL BE GRADED SMOOTH TO ELIMINATE MOUNDING. CONTRACTOR TO REMULCH AREA AROUND TREE WHEN GRADING IS COMPLETE.
- CONSTRUCT 3" SAUCER ALL AROUND PLANTING HOLE. FLOOD WITH WATER TWICE WITHIN 24 HOURS.
- BACKFILL WITH PLANTING MIX (SEE PLANTING SPECIFICATIONS). TAMP SOIL AROUND ROOT BALL BASE FIRMLY WITH FOOT PRESSURE SO THAT ROOT BALL DOES NOT SHIFT.

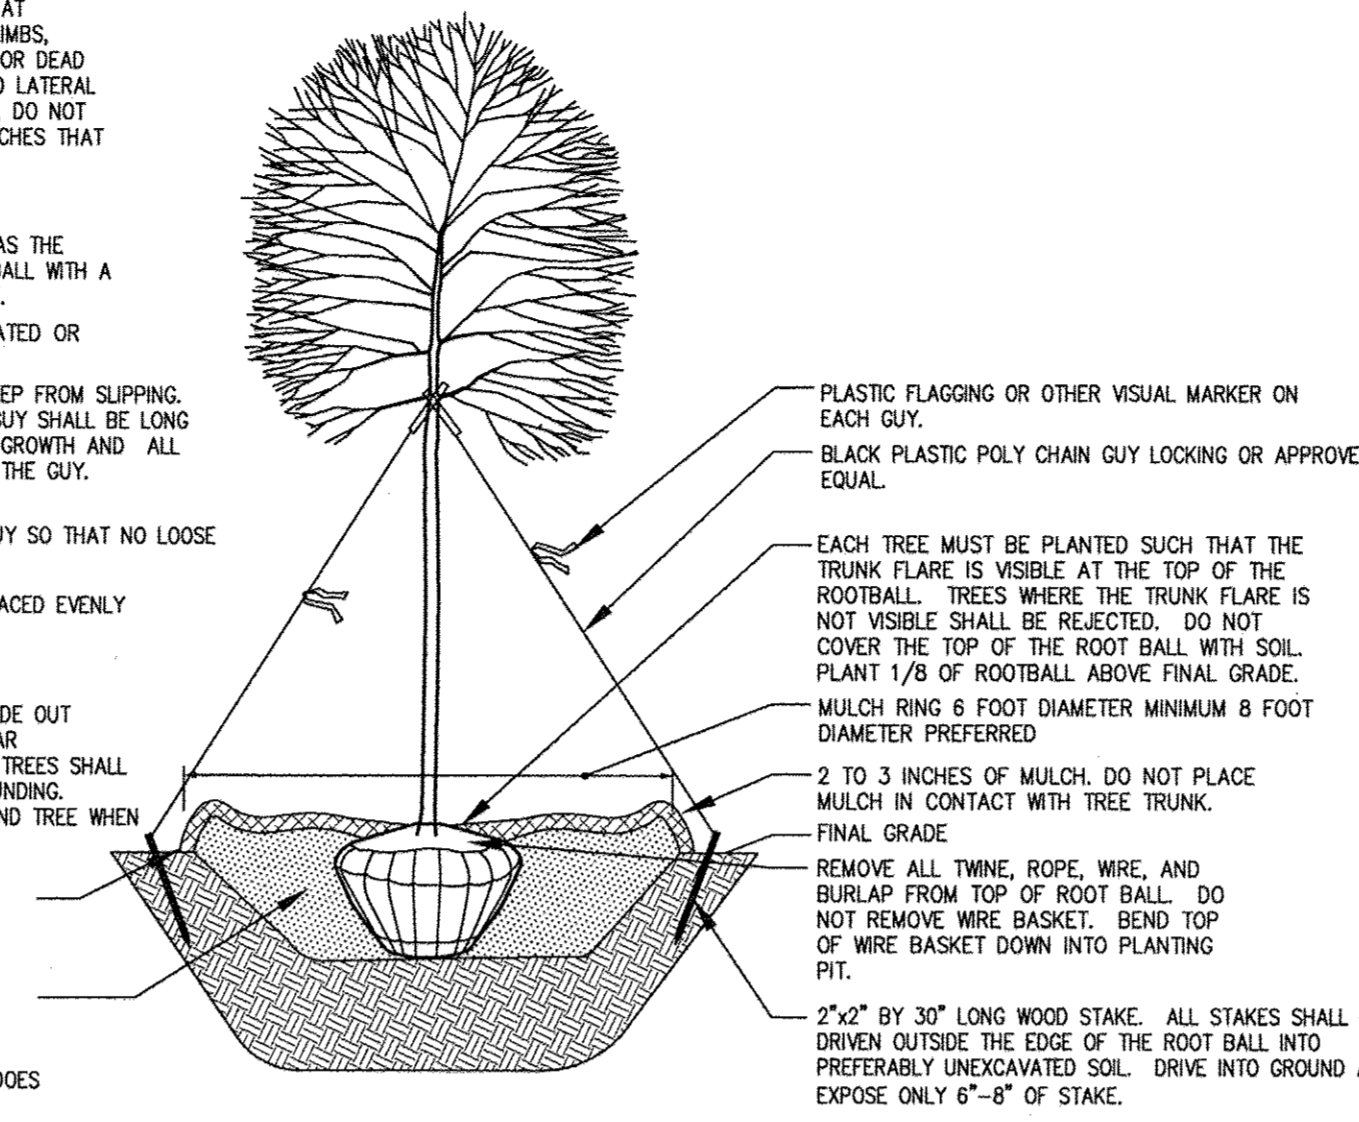

DECIDUOUS B&B TREE PLANTING DETAIL (TREES 3" CAL. OR LARGER)
 NOT TO SCALE

NOTES:

- SELECT ONLY NURSERY STOCK WITH A SINGLE LEADER UNLESS OTHERWISE SPECIFIED ON PLAN. PLANTS WITH CO-DOMINANT, MISSING, OR DAMAGED LEADERS SHALL BE REJECTED.
- STAKE TREES AS SHOWN.
- DIG PLANTING PIT TWICE AS WIDE AS THE DIAMETER OF THE TOP OF THE ROOT BALL WITH A MINIMUM PLANTING PIT DIAMETER OF 5'.
- CONTRACTOR TO REMOVE AND GRADE OUT PLANTING SAUCER AT END OF ONE YEAR MAINTENANCE PERIOD. AREA AROUND TREES SHALL BE GRADED SMOOTH TO ELIMINATE MOUNDING. CONTRACTOR TO REMULCH AREA AROUND TREE WHEN GRADING IS COMPLETE.
- CONSTRUCT 3" SAUCER ALL AROUND PLANTING HOLE. FLOOD WITH WATER TWICE WITHIN 24 HOURS.
- BACKFILL WITH PLANTING MIX (SEE PLANTING SPECIFICATIONS). TAMP SOIL AROUND ROOT BALL BASE FIRMLY WITH FOOT PRESSURE SO THAT ROOT BALL DOES NOT SHIFT.

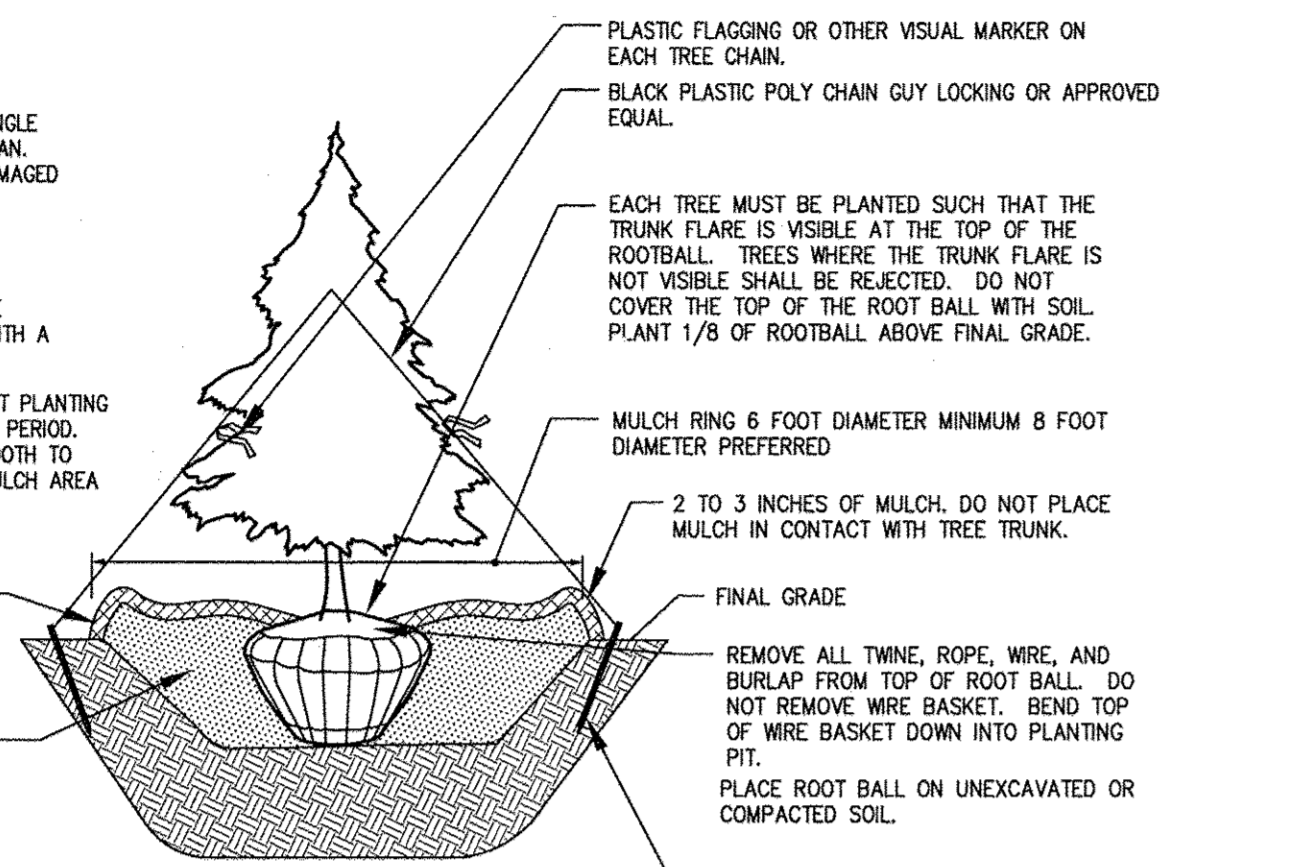

EVERGREEN B&B TREE PLANTING DETAIL
 NOT TO SCALE

SCHEDULE A - PERIMETER LANDSCAPE EDGE

	ADJACENT TO PERIMETER PROPERTIES	ADJACENT TO ROADWAYS
PERIMETER	1	
LANDSCAPE TYPE	C	
LINEAR FEET OF ROADWAY FRONTAGE/ PERIMETER	1,064±	
CREDIT FOR EXISTING VEGETATION (YES, NO, LINEAR FEET) (DESCRIBE BELOW IF NEEDED)	YES 111'	
CREDIT FOR WALL, FENCE, BERM OR DRIVE AISLE (YES/NO/LINEAR FEET)	NO	
LINEAR FEET REMAINING	953±	
NUMBER OF PLANTS REQUIRED		
SHADE TREES	24	
EVERGREEN TREES	48	
SHRUBS	-	
NUMBER OF PLANTS PROVIDED		
SHADE TREES	24	
EVERGREEN TREES	48	
SMALL FLOWERING TREES SHRUBS	-	

SCHEDULE 'A' NOTES:

CREDIT FOR EXISTING LANDSCAPING HAS BEEN TAKEN WHERE EXISTING TREE LINE WAS 20' OR WIDER. BASED ON FIELD EVALUATION, ADDITIONAL CREDIT MAY BE TAKEN FOR INDIVIDUAL TREES ALONG PERIMETER 1.

PLANT SCHEDULE

SYMBOL	QTY.	SCIENTIFIC/COMMON NAME	SIZE	ROOT	REMARKS
SHADE TREES					
AR	9	ACER RUBRUM 'OCTOBER GLORY'	2.5-3" CAL.	B&B	AS SHOWN
PA	9	PLATANUS X ACERIFOLIA LONDON PLANE TREE	2.5-3" CAL.	B&B	AS SHOWN
QP	6	QUERCUS PALUSTRIS PIN OAK	2.5-3" CAL.	B&B	AS SHOWN
EVERGREEN TREES					
PS	48	PINUS STROBUS EASTERN WHITE PINE	6-8' HT.	B&B	AS SHOWN