



HOWARD COUNTY DEPARTMENT OF PLANNING AND ZONING

3430 Courthouse Drive

Ellicott City, Maryland 21043

410-313-2350

Voice/Relay

FAX 410-313-3467

January 6, 2020

7075 Cedar Lane, LLC
6800 Deerpath Road, Ste. 100
Elkridge, MD 21075

RE: WP-20-059, Lennox Park, Lots 458-465

Dear Sir or Madam:

The Director of the Department of Planning and Zoning considered your request for an alternative compliance from the Howard County Subdivision and Land Development Regulations.

As of the date of this letter, the Planning Director **approved** your request for an alternative compliance of **Section 16.155(a)(2)** subject to the following conditions:

1. The Alternative Compliance Petition exhibit shall serve as the substitute for a site development plan for development. All improvements shown on the exhibit must be constructed per the plan exhibits submitted dated December 19, 2019. The alternative compliance plan exhibit shall be submitted as an original mylar and receive signature approval from the Department of Planning and Zoning prior to applying for permits. The original mylar plan exhibit shall be submitted within 45 days of this letter (on or before February 20, 2020).
2. The developer shall have 1 year from the date of signature approval of the Alternative Compliance Exhibit to apply for initial building permits and all permits must be applied for within 2 years of the Alternative Compliance signature approval.
3. Compliance with all applicable County and State Regulations and obtain all necessary permits from the Department of Inspections, Licenses and Permits prior to initiating development on-site.

Extraordinary Hardship or Practical Difficulty – If the alternative compliance is not granted, the applicant will be required to prepare a site development plan for the development of 6 single family semi-detached residential units. The fact that this subdivision was recorded prior to February 7, 1976 is a uniqueness of the Property that allows development of detached units without an SDP if the limit of disturbance is less than 5,000 square feet. DPZ has permitted waivers to Section 16.155 (a)(2)(ii) for similarly situated properties, causing an unreasonable hardship if this request was denied. DPZ agrees with the Petitioner's assertion that the distinction between detached and semi-detached is technical and not meaningful for purposes of applying this regulation.

Alternative Proposal – Based on a 2015 policy, DPZ permits alternative compliance to Section 16.155(a)(2)(ii) for subdivisions recorded prior to February 7, 1976. Since these are recorded lots, they could be developed through a building permit plot plan as individual lots. This alternative process allows DPZ to review contiguous recorded lots (pre-1976) as a cohesive project to ensure specific requirements such as stormwater manager, environmental resource protection, noise, traffic, roads and floodplain management are met. The detailed plan exhibit submitted with this alternative compliance is a suitable substitute for the SDP and shows the information necessary to evaluate this request for compliance with the Regulations. The applicant is still required to comply with all building permits as well as other state/local requirements.

Not Detrimental to the Public Interest – Approval of the alternative compliance will not alter the essential character of the neighborhood and will not substantially impair the appropriate use or development of the surrounding properties. DPZ and various SRC agencies have reviewed the alternative compliance in accordance with the current requirements, including the Howard County Code.

Will not Nullify the Intent or Purpose of the Regulations – The alternative compliance proposal is an acceptable alternative to submitting a site development plan for standard review because the alternative compliance exhibit complies with the current Regulations. The proposed improvements were reviewed by the SRC agencies and are required to comply with all building permits.

Indicate this alternative compliance petition file number, request, section of the regulations, action, conditions of approval, and date on all related plats, and site development plans, and building permits.

This requested alternative compliance will remain valid for the time period specified in the conditions of approval.

If you have any questions, please contact Jennifer Wellen at (410) 313-2350 or email at jwellen@howardcountymd.gov.

Sincerely,



Acting Division Chief
Division of Land Development

JM/jw

cc: Research
DED
Real Estate Services
Marian Honeczy- DNR (if waiver to forest conservation sections)
H&H Rock Companies

DEPARTMENT OF PLANNING AND ZONING
DEVELOPMENT ENGINEERING DIVISION

January 2, 2020

TO: Kent Sheubrooks, Chief (Acting: Jill Manion)
Division of Land Development

FROM: Chad Edmondson, Chief *CE*
Development Engineering Division

Project Engineer: _____ Jim Witmer

RE: DP&Z File #: _____ WP-20-059

_____ Lennox Park, lots 458-465

After review of the submitted information requesting a waiver of the Subdivision and Land Development Regulations, Section 16.155 (a)(2)(i), which requires a site development plan, approved by the Department of Planning and Zoning for new residential single family attached, apartment, and mobile home developments this Division recommends **APPROVAL** based on the following.

1. No building permits shall be approved for the proposed houses until water and sewer is available.
2. This approval is based upon the approved layout of the water and sewer plans.
3. The provided WP plan provided sufficient detail in accordance with our SDP requirements. All of the requirements for pavement width, utilities, SWM, and drainage have been addressed.


GENERAL NOTES

1. THE TOPOGRAPHY SHOWN HEREON IS BASED ON A FIELD RUN SURVEY DATED FEBRUARY, 2016 BY BENCHMARK ENGINEERING, INC. THE BOUNDARY SHOWN HEREON IS BASED ON BOUNDARY SURVEY PREPARED BY BENCHMARK ENGINEERING, INC., DATED MARCH, 2016.
2. THE PROPERTY IS KNOWN AS TAX MAP 43, GRID 06, PARCEL 319. THIS INCLUDES LOTS 458-465, P/O LOT 457, AND A PORTION OF CEDAR AVENUE. THE TOTAL PROPERTY AREA IS APPROXIMATELY 0.53 ACRES.
3. THE PROPERTY IS ZONED R-12 PER THE 10.06.13 COMPREHENSIVE ZONING PLAN.
4. THE EXISTING HOUSE LOCATED ON THE PROPERTY IS TO BE REMOVED; THE EXISTING DRIVEWAY WILL BE IMPROVED TO A 16' WIDE USE-IN-COMMON DRIVE TO PROVIDE ACCESS FOR THE DEVELOPMENT. THE APPROXIMATE LIMIT OF DISTURBANCE = 25,420 SF
5. STORMWATER MANAGEMENT FOR THIS SITE WILL BE PROVIDED BY DRYWELLS FOR THE ROOFTOPS AND MICRO-BIORETENTION FOR THE DRIVEWAYS AND USE-IN-COMMON DRIVE.
6. THESE LOTS ARE EXISTING LOTS KNOWN AS LENNOX PARK RECORDED AS PLATBOOK 83 PAGE 315 DATED FEBRUARY 4, 1907.
7. A TRAFFIC STUDY IS NOT REQUIRED FOR THIS DEVELOPMENT SINCE THE LOTS ARE EXISTING AND NO NEW LOTS ARE TO BE CREATED.
8. TO THE BEST OF OUR KNOWLEDGE AND AVAILABLE DATA, THERE ARE NO FLOODPLAINS, STREAMS, OR STEEP SLOPES LOCATED ON THIS SITE.
9. THERE ARE NO WETLANDS ON-SITE PER AN ENVIRONMENTAL FIELD INVESTIGATION PERFORMED BY HILLIS-CARNES ENGINEERING ASSOCIATES, INC. ON JANUARY, 2017.
10. THERE ARE NO SPECIMEN TREES OR FORESTED AREAS ON-SITE PER A SIMPLIFIED FOREST STAND DELINEATION PERFORMED BY BENCHMARK ENGINEERING, INC. ON FEBRUARY, 2017.
11. A GEOTECHNICAL INVESTIGATION WAS PERFORMED HILLIS-CARNES ENGINEERING ASSOCIATES, INC. WHICH DETERMINED THAT THE ONSITE SOILS ARE ACCEPTABLE FOR THE PROPOSED ESD PRACTICES.
12. A NOISE STUDY IS NOT REQUIRED FOR THIS PROPERTY SINCE IT IS NOT IN THE AIRPORT NOISE ZONE AND IS MORE THAN 500' FROM A RAIL LINE.
13. LOTS 458 THRU 463 WILL BE DEVELOPED WITH SINGLE-FAMILY SEMI-DETACHED UNITS; LOTS 464 TO 465 WILL BE UTILIZED FOR ESD-SWM; AND THE REMAINING PORTION OF PARCEL WILL BE UTILIZED FOR A USE-IN-COMMON DRIVEWAY AND UTILITIES.
14. THIS PLAN IS SUBJECT TO AN ALTERNATIVE COMPLIANCE WP-17-085 APPROVED NOVEMBER 14, 2017 TO SECTION 16.155(c)(2) RESIDENTIAL: NEW RESIDENTIAL DEVELOPMENT REQUIRING APPROVAL OF A SITE DEVELOPMENT PLAN FOR SIX SEMI-DETACHED DUPLEX UNITS APPROVAL IS SUBJECT TO THE FOLLOWING CONDITIONS:
 1. THE DED COMMENTS DATED NOVEMBER 13, 2017.
 2. THE ALTERNATIVE COMPLIANCE EXHIBIT SHALL SERVE AS A SUBSTITUTE FOR A SITE DEVELOPMENT PLAN FOR DEVELOPMENT. ALL IMPROVEMENTS SHOWN ON THE EXHIBIT MUST BE CONSTRUCTED PER THE PLAN EXHIBITS SUBMITTED DATED OCTOBER 7, 2017. THE REVISED ALTERNATIVE COMPLIANCE PLAN EXHIBIT SHALL BE SUBMITTED AS AN ORIGINAL MYLAR AND RECEIVE SIGNATURE APPROVAL FROM THE DEPARTMENT OF PLANNING & ZONING, PRIOR TO APPLYING FOR PERMITS. THE ORIGINAL MYLAR PLAN EXHIBIT SHALL BE SUBMITTED WITHIN 45 DAYS OF THIS LETTER (ON OR BEFORE DECEMBER 29, 2017)
 3. COMPLIANCE WITH ALL APPLICABLE COUNTY & STATE REGULATIONS, AND OBTAIN ALL NECESSARY PERMITS FROM THE DEPARTMENT OF INSPECTIONS, LICENSES & PERMITS, PRIOR TO INITIATING DEVELOPMENT ON-SITE

— NOTE: WP-17-085 HAS SINCE EXPIRED AND A NEW ALTERNATIVE COMPLIANCE IS BEING REQUESTED VIA THIS PLAN EXHIBIT AND APPLICATION.

LEGEND

- SOILS CLASSIFICATION AbC1
- SOILS DELINEATION
- EXISTING CONTOURS
- PROPOSED CONTOURS
- EXISTING WOODS LINE
- PROPOSED WOODS LINE
- EXISTING STRUCTURE
- PROPOSED STRUCTURE
- LIMIT OF DISTURBANCE
- PUBLIC WATER, SEWER, & UTILITY AND PRIVATE USE-IN-COMMON ACCESS EASEMENT
- PUBLIC SEWER & UTILITY EASEMENT
- PRIVATE DRAINAGE & UTILITY EASEMENT

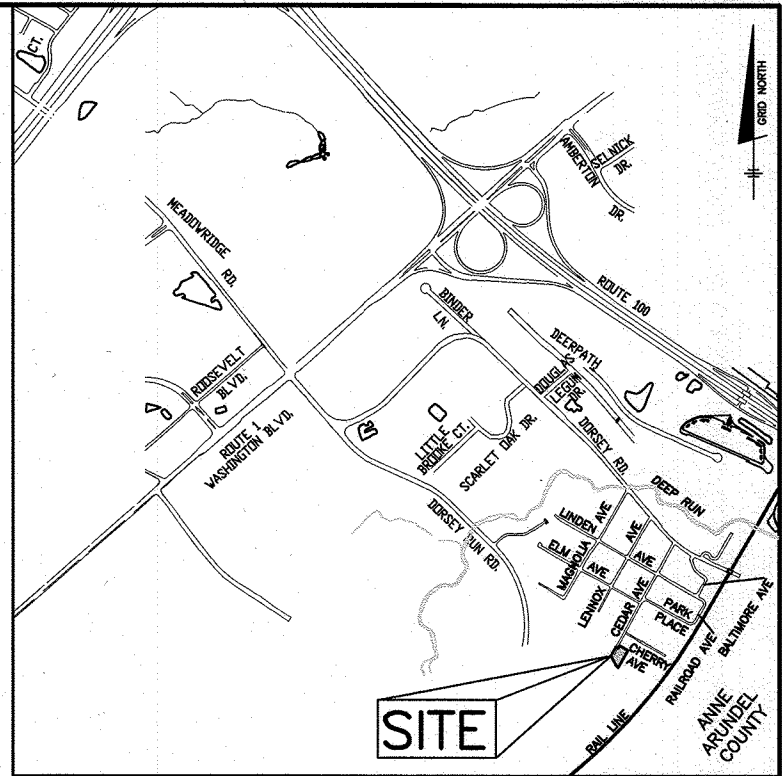

VICINITY MAP
SCALE: 1" = 2000'
ADC MAP NO. 35 GRID B6

NARRATIVE

The Lennox Park, Crosby Property Lots 458-465, Elkridge, Maryland comprises approximately 0.53 acres. The property is zoned R-12 and is located on the southeast side of Cedar Avenue at its terminus point adjoining the Howard Business Park. Access will be provided by a Use-In-Common Drive constructed from the existing edge of paving of Cedar Avenue. The proposed development shall consist of 3 Semi-Detached Dwellings containing 6 units total. The project is located within an existing neighborhood known as Lennox Park. The site drains from the northeast to the southwest and is conveyed off site through an off swale on the adjoining property. The project lies within the Patapsco River watershed (02-13-09) and the use is I-P.



The NRCS soils in the location of this development are mostly Hydrologic Group 'C' & 'D'. Other Lots within close proximity of this site have indicated 'B' type soils. A Geotechnical Investigation was performed by Hillis-Carnes Engineering Associates, Inc. in July 2017 which determined that the on-site soils are acceptable for the proposed ESD practices.

To the best of our knowledge and available data, there are no Floodplains, Streams, or Steep Slopes located on this site. There are no Wetlands on-site per an Environmental Field Investigation performed by Hillis-Carnes Engineering Associates, Inc. on January, 2017. There are no Specimen Trees or Forested areas on-site per a Simplified Forest Stand Delineation performed by Benchmark Engineering, Inc. on February, 2017.


This site was analyzed as woods in good condition and a target RCN was determined. A target rainfall depth treatment (Pe) was determined based on the measured impervious areas and HSG soil types (mostly 'C' & 'D'). The target Pe for this site is 1.8 inches based on the overall proposed drainage area. Full treatment of the target 1.8" Pe will be provided using Environmental Site Design practices as outlined in Chapter 5 of the 2000 Maryland Stormwater Design Manual, as amended by Maryland's Stormwater Management Act of 2007. The selected methods include Drywells (M-5) for the entire rooftop for each unit and a Micro-Bioretenion (M-6) for the driveways. The facilities will be privately owned and maintained.

To protect natural resources, it is important to minimize and adequately treat the stormwater runoff. The final design will incorporate adequate treatment and storage in order to create the least possible stormwater runoff in general compliance with this concept plan. The runoff will be treated on-site using approved methods. Outfalls generally correspond with the natural drainage patterns for the site.

The proposed development and ESD implementation should have no effect on adjacent properties as treatment of the target Pe in the development runoff conditions meet the existing runoff. The proposed development is not expected to have adverse effects on downstream properties, utilities, public facilities or natural systems since natural drainage pathways are maintained. Preliminary ESD practices have been designed to address 1.8 inches of runoff, the target Pe, for all area which could be conveyed to a facility. We believe this plan provides environmental site design to the maximum extent possible.

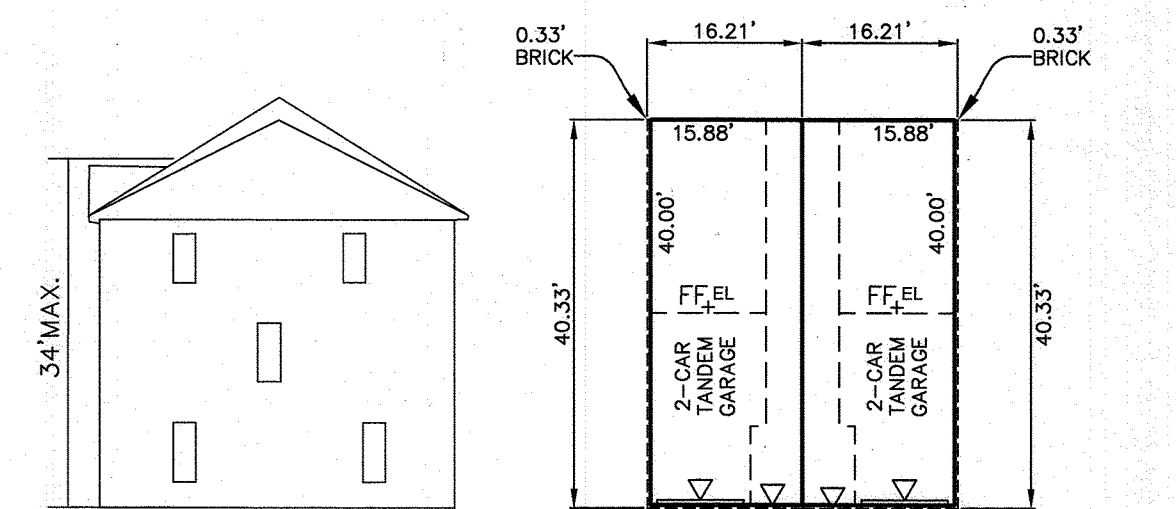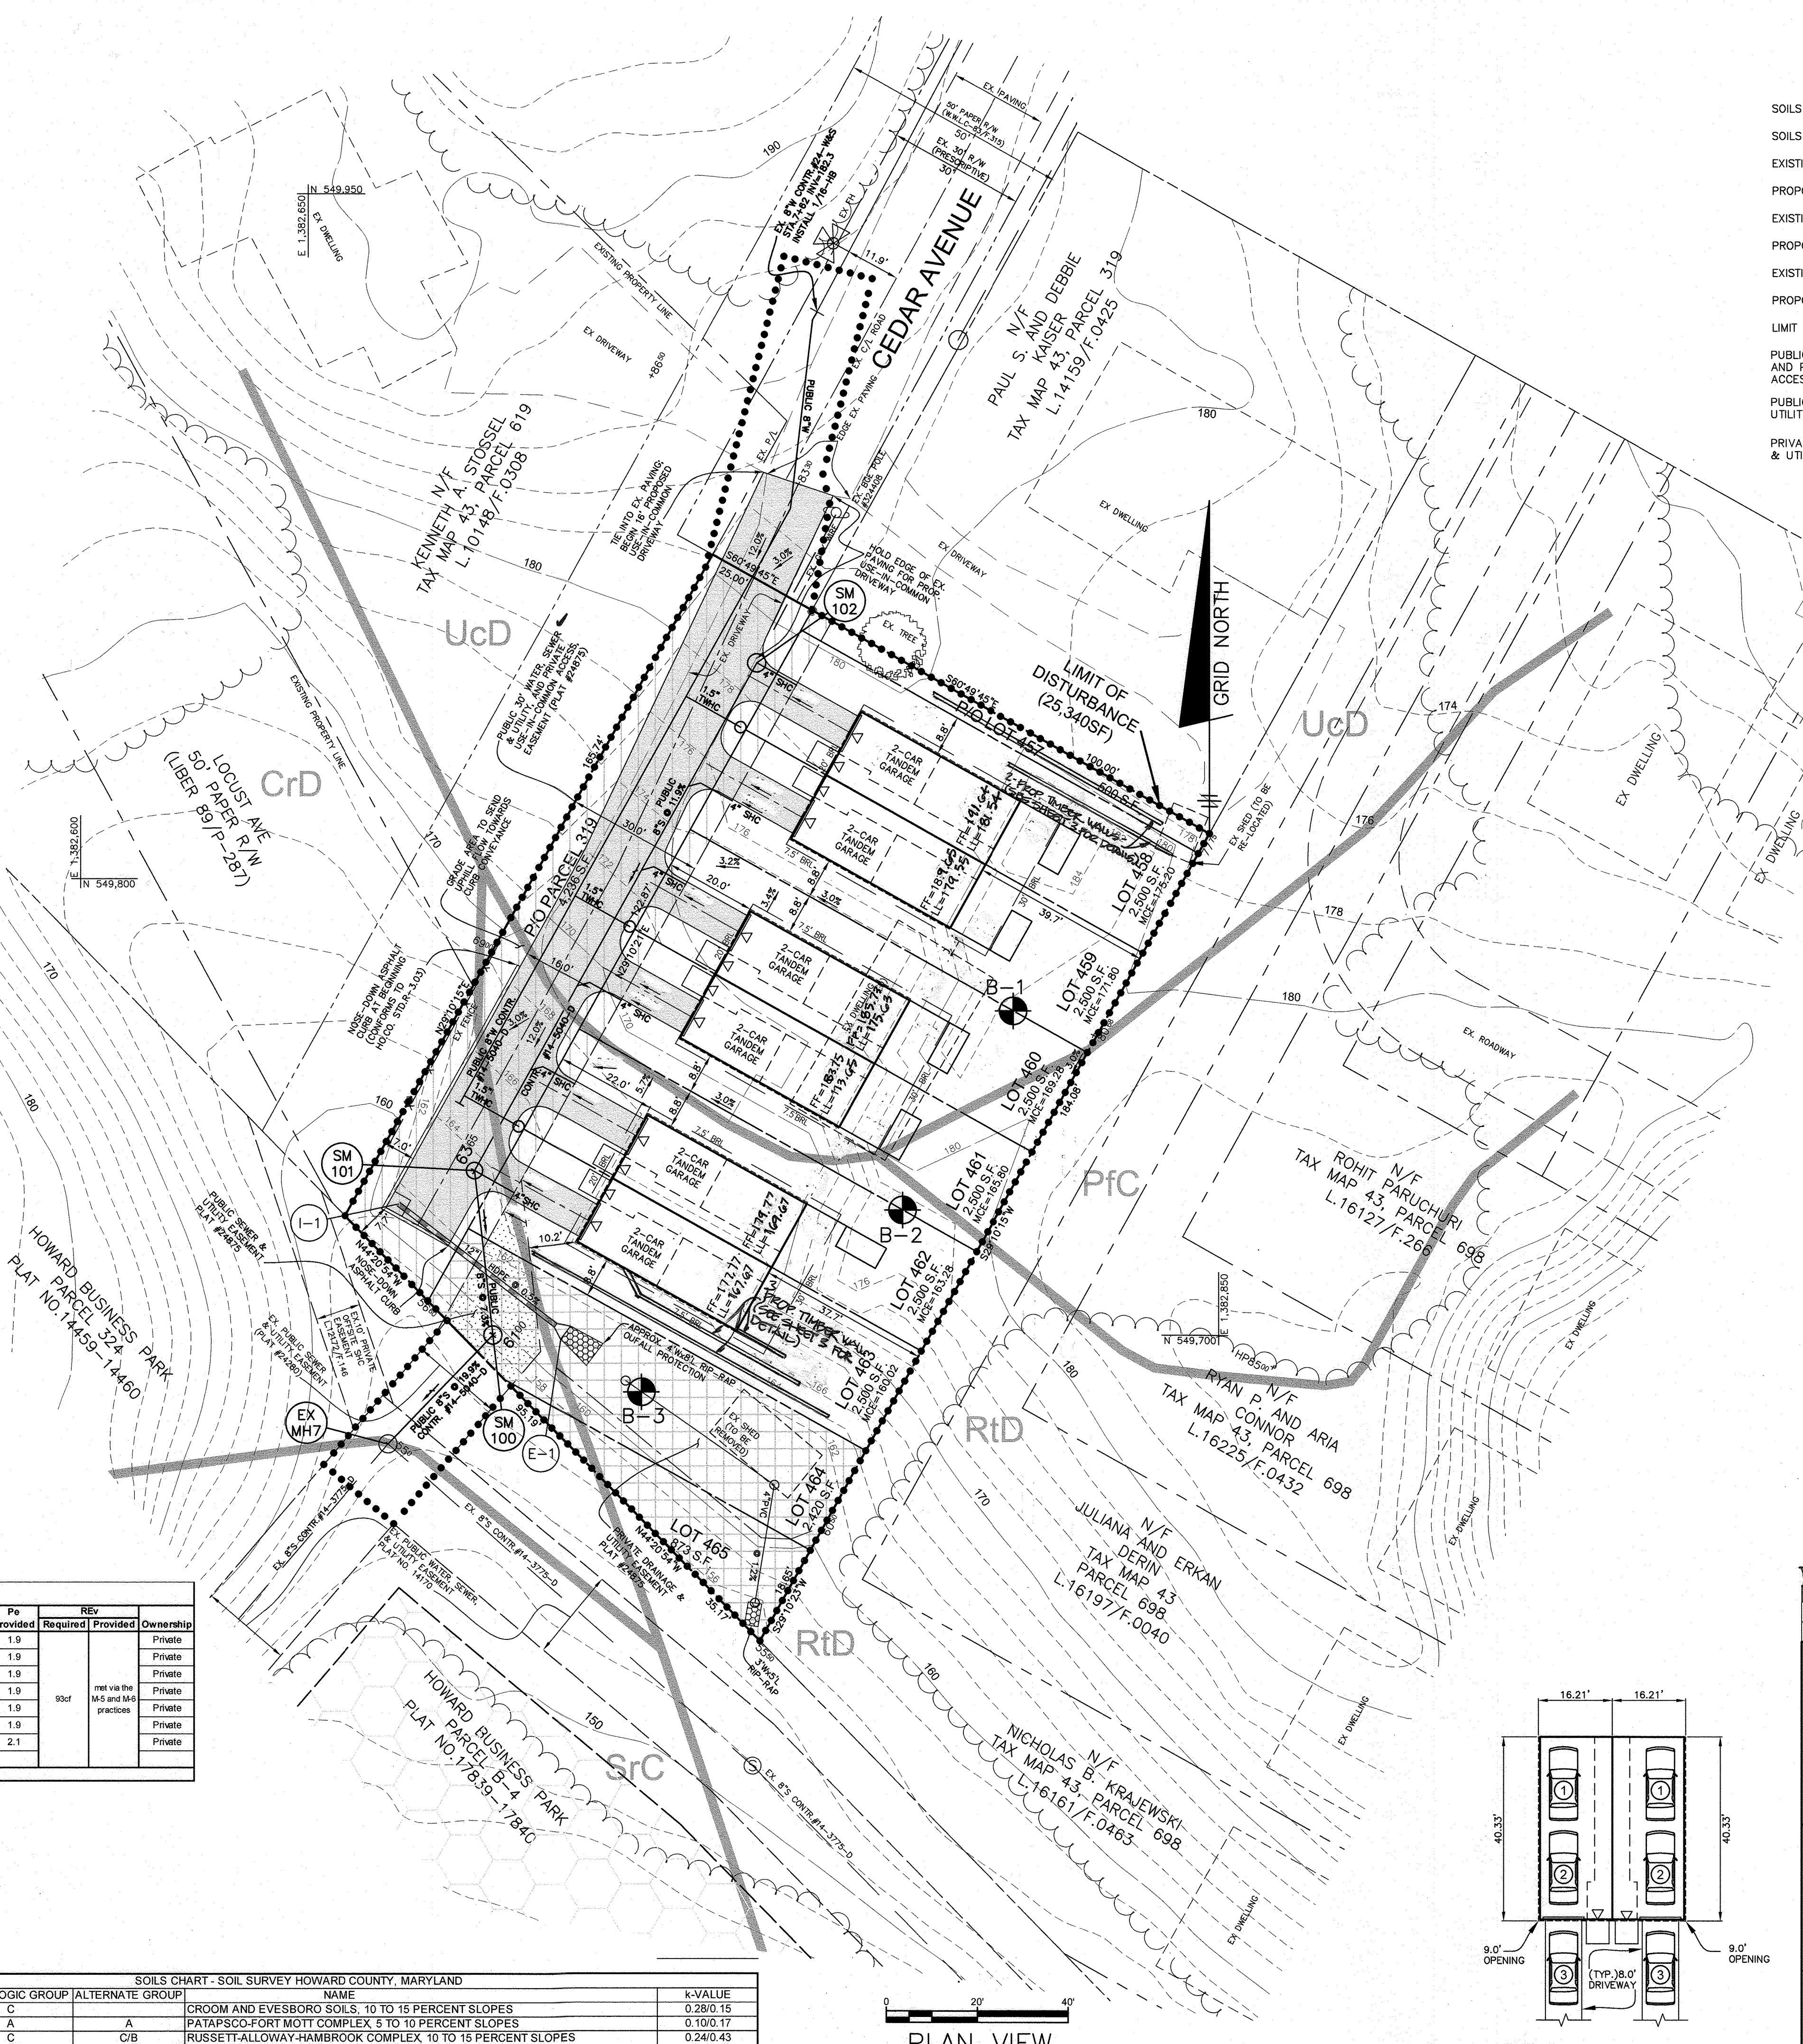

CLARENDON (MODIFIED DOUBLE END UNIT)
TYPICAL HOUSE FOOTPRINT
SCALE: 1" = 20'

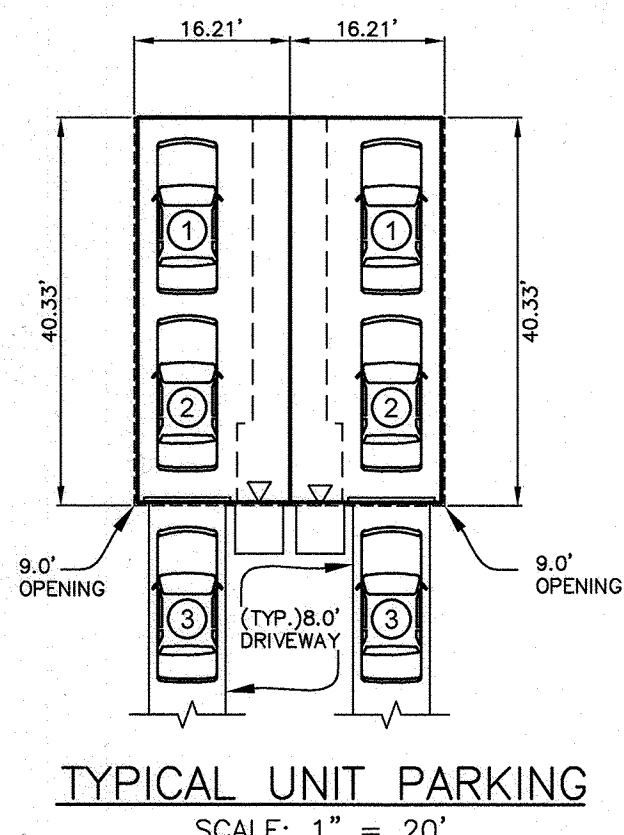

TYPICAL UNIT PARKING
SCALE: 1" = 20'

Practice	DA (sf)	Imp Area (sf)	% Imp	Rv	Pe Required	Pe Provided	ESDv (cf)	ESDv Provided	Pe Provided	Rev	Ownership	
(M-5) Drywell	LOT 458	652	652	100%	0.95	1.8	50	50	PASS	93	100	1.9
(M-5) Drywell	LOT 459	652	652	100%	0.95	1.8	50	50	PASS	93	100	1.9
(M-5) Drywell	LOT 460	652	652	100%	0.95	1.8	50	50	PASS	93	100	1.9
(M-5) Drywell	LOT 461	652	652	100%	0.95	1.8	50	50	PASS	93	100	1.9
(M-5) Drywell	LOT 462	652	652	100%	0.95	1.8	50	50	PASS	93	100	1.9
(M-5) Drywell	LOT 463	652	652	100%	0.95	1.8	50	50	PASS	93	100	1.9
(M-6) Micro-Bioretenion	MB-1	18,384	4,490	24%	0.27	1.8	368	446	PASS	744	854	2.1
Totals per Individual Drainage Area	22,296	8,402	40%	0.41						1301	1454	
Totals per Overall Site	26,125	8,414	35%	0.37	1.8					1332	1454	

Notes:
1. The Pe required column is based on total site Pe calculation. The Rv is based on individual drainage area percent impervious (per DED).
2. The ESDv Required for the (M-6) practices is based on 75% of ESDv.

APPROVED: HOWARD COUNTY DEPARTMENT OF PLANNING AND ZONING
 CHEF, DIVISION OF LAND DEVELOPMENT
 DATE: 1/3/20
 DATE: 1-3-20
 DATE: 1-3-20

SYMBOL	HYDRIC	HYDROLOGIC GROUP	ALTERNATE GROUP	NAME	K-VALUE
C/D		C	A	CROOM AND EVESBORO SOILS, 10 TO 15 PERCENT SLOPES	0.28/0.15
P/C		A	A	PATAPSCO-FORT MOTT COMPLEX 5 TO 10 PERCENT SLOPES	0.10/0.17
R/D		C	C/B	RUSSETT-ALLOWAY-HAMBROOK COMPLEX 10 TO 15 PERCENT SLOPES	0.24/0.43
S/C		B	C	SASSAFRAS AND CROOM SOIL, 5 TO 10 PERCENT SLOPES	0.37/0.28
U/D		D	B/C	URBAN LAND-CHILLUM-BELTSVILLE COMPLEX 5 TO 15 PERCENT SLOPES	0.37

3	12.21.20	REVISE FLOOR ELEV. PER AS-BUILT
2	9.11.20	ADD TIMBER WALL TO LOT 463
1	5.10.20	REVISE GRADES ROAD OF LOTS 458 TO 463
NO.	DATE	REVISION
<p>8480 BALTIMORE NATIONAL PIKE & SUITE 315 & ELLIOTT CITY, MARYLAND 21043 (P) 410-465-8105 (F) 410-465-8644 WWW.BEI-CIVILENGINEERING.COM</p>		<p>Professional Certification: I hereby certify that these documents were prepared or approved by me, and that I am a duly licensed professional engineer under the laws of the State of Maryland. License No. 22390, Expiration Date: 6/30/21.</p>
<p>OWNER: 7075 CEDAR, LLC 6800 DEERPATH ROAD SUITE 100 ELK RIDGE, MARYLAND 21075</p>		<p>LENNOX PARK CROSBY PROPERTY LOTS 458-465 TAX MAP: 43 - GRID: 06 - PARCEL: p/o319 ZONED: R-12 (RESIDENTIAL) ELECTION DISTRICT NO. 1 - HOWARD COUNTY, MARYLAND</p>
<p>DEVELOPER: H&H ROCK COMPANIES 6800 DEERPATH ROAD SUITE 100 ELK RIDGE, MARYLAND 21075</p>		<p>ALTERNATIVE COMPLIANCE EXHIBIT & SIMPLIFIED ECP DATE: JANUARY 03, 2020 BEI PROJECT NO. 2741 SCALE: AS SHOWN SHEET 1 OF 3</p>
DESIGN:	MCR	DRAFT:

CONSTRUCTION SPECIFICATIONS

B.4.C Specifications for Micro-Bioretenion, Rain Gardens, Landscape Infiltration & Infiltration Berms

1. Material Specifications:

The allowable materials to be used in these practices are detailed in Table B.4.1.

2. Filtering Media or Planting Soil:

The soil shall be a uniform mix, free of stones, stumps, roots or other similar objects larger than two inches. No other materials or substances shall be mixed or dumped within the micro-bioretenion practice that may be harmful to plant growth, or prove a hindrance to the planting or maintenance operations. The planting soil shall be free of Bermuda grass, Quackgrass, Johnson grass, or other noxious weeds as specified under COMAR 15.08.01.05.

The planting soil shall be tested and shall meet the following criteria:

- Soil Component - Loamy Sand or Sandy Loam (USDA Soil Textural Classification)
- Organic Content - Minimum 10% by dry weight (ASTM D 2974). In general, this can be met with a mixture of loamy and (60%-85%) and compost (35% to 40%) or sandy loam (30%), coarse sand (30%), and compost (40%).
- Clay Content - Media shall have a clay content of less than 5%.
- pH Range - Should be between 5.5 - 7.0. Amendments (e.g., lime, iron sulfate plus sulfur) may be mixed into the soil to increase or decrease pH.

There shall be at least one soil test per project. Each test shall consist of both the standard soil test for pH, and additional tests of organic matter, and soluble salts. A textural analysis is required from the site stockpiled topsoil. If topsoil is imported, then a texture analysis shall be performed for each location where the topsoil was excavated.

3. Compaction:

It is very important to minimize compaction of both the base of bioretention practices and the required backfill. When possible, use excavation hoses to remove original soil. If practices are excavated using a loader, the contractor should use wide track or marsh track equipment, or light equipment with turf type tires. Use of equipment with narrow tracks or narrow tires, rubber tires with large lugs, or high-pressure tires will cause excessive compaction resulting in reduced infiltration rates and is not acceptable. Compaction will significantly contribute to design failure.

Compaction can be alleviated at the base of the bioretention facility by using a primary tilling operation such as a chisel plow, ripper, or subsoiler. These tilling operations are to refracture the soil profile through the 12 inch compaction zone. Substitute methods must be approved by the engineer. Rototillers typically do not till deep enough to reduce the effects of compaction from heavy equipment.

Rototill to 3 inches of sand into the base of the bioretention facility before backfilling the optional sand layer. Pump any ponded water before preparing (rototilling) base.

When backfilling the topsoil over the sand layer, first place 3 to 4 inches of topsoil over the sand, then rototill the sand/topsoil to create a gradation zone. Backfill the remainder of the topsoil to final grade.

When backfilling the bioretention facility, place soil in lifts 12" to 18". Do not use heavy equipment within the bioretention basin. Heavy equipment can be used around the perimeter of the basin to supply soils and sand. Grade bioretention materials with light equipment such as a compact loader or a dozer/loader with marsh tracks.

4. Plant Material:

Recommended plant material for micro-bioretenion practices can be found in Appendix A, Section A.2.3.

5. Plant Installation:

Compost is a better organic material source, is less likely to float, and should be placed in the invert and other low areas. Mulch should be placed in surrounding to a uniform thickness of 2" to 3". Shredded or chipped hardwood mulch is the only acceptable mulch. Pine mulch and wood chips will float and move to the perimeter of the bioretention area during a storm event and are not accepted. Shredded mulch must be well aged (6 to 12 months) for acceptance.

Rootstock of the plant material shall be kept moist during transport and on-site storage. The plant root ball should be planted so 1/8th of the ball is above final grade surface. The diameter of the planting pit shall be at least six inches larger than the diameter of the planting ball. Set and maintain the plant straight during the entire planting process. Thoroughly water ground bed cover after installation.

Trees shall be braced using 2" by 2" stakes only as necessary and for the first growing season only. Stakes are to be equally spaced on the outside of the tree ball.

Grasses and legume seed should be drilled into the soil to a depth of at least one inch. Grass and legume plugs shall be planted following the non-grass ground cover planting specifications.

The topsoil specifications provide enough organic material to adequately supply nutrients from natural cycling. The primary function of the bioretention structure is to improve water quality. Adding fertilizers, fertilizers, or at a minimum, impedes this goal. Only add fertilizer if wood chips or mulch are used to amend the soil. Rototill urea fertilizer at a rate of 2 pounds per 1000 square feet.

6. Underdrains:

Underdrains should meet the following criteria:

- Pipe- Should be 4" to 6" diameter, slotted or perforated rigid plastic pipe (ASTM F 758, Type PS 28, or AASHTO M-278) in a gravel layer. The preferred material is slotted, 4" rigid pipe (e.g., PVC or HDPE).
- Perforations - If perforated pipe is used, perforations should be 3/4" diameter located 6" on center with a minimum of four holes per row. Pipes shall be wrapped with a 1/2" (No. 4 or 6W) galvanized hardware cloth.
- Gravel - The gravel layer (No. 57 stone preferred) shall be at least 3" thick above and below the underdrain.
- The main collector pipe shall be at a minimum 0.5% slope.
- A rigid, non-perforated observation well must be provided (one per every 1,000 square feet) to provide a clean-out port and monitor performance of the filter.
- A 4" layer of pea gravel (3/4" to 1 1/4" stone) shall be located between the filter media and underdrain to prevent migration of fines into the underdrain. This layer may be considered part of the filter bed when bed thickness exceeds 24".

The main collector pipe for underdrain systems shall be constructed at a minimum slope of 0.5%. Observation wells and/or clean-out pipes must be provided (one minimum per every 1000 square feet of surface area).

7. Miscellaneous:




These practices may not be constructed until all contributing drainage area has been stabilized.

OPERATION & MAINTENANCE SCHEDULE FOR (M-6) MICRO-BIORETENTION


- The Owner shall maintain the plant material, mulch layer and soil layer annually. Maintenance of mulch and soil is limited to correcting areas of erosion or wash out. Any mulch replacement shall be done in the spring. Plant material shall be checked for disease and insect infestation and maintenance will address dead material and pruning. Acceptable replacement plant material is limited to the following: 2000 Maryland Stormwater Design Manual Volume II, Table A-4.1 and 2.
- The Owner shall perform a plant in the spring and in the fall of each year. During the inspection, the Owner shall remove dead and diseased vegetation considered beyond treatment, replace dead plant material with acceptable replacement plant material, treat diseased trees and shrubs, and replace all deficient stakes and wires.
- The Owner shall inspect the mulch each spring. The mulch shall be replaced every two to three years. The previous mulch layer shall be removed before the new layer is applied.
- The Owner shall correct soil erosion on an as needed basis, with a minimum of once per month and after each heavy storm.

MICRO-BIORETENTION DESIGN TABLE

MB-1	(M-6)
4" PVC	
Elevation 1	160.00
Elevation 2	159.75
Elevation 3	159.00
Elevation 4	158.83
Elevation 5	156.93
Elevation 6	156.59
Elevation 7	155.92
Elevation 8	155.40
Surface (ft)	889.8

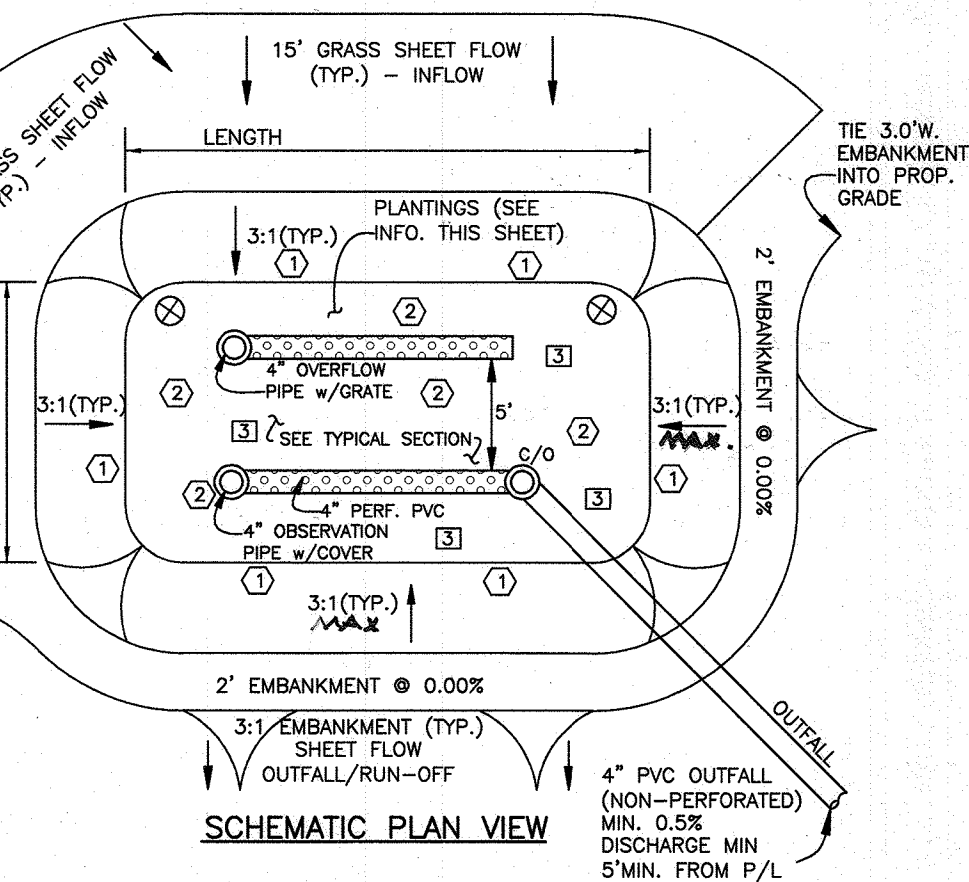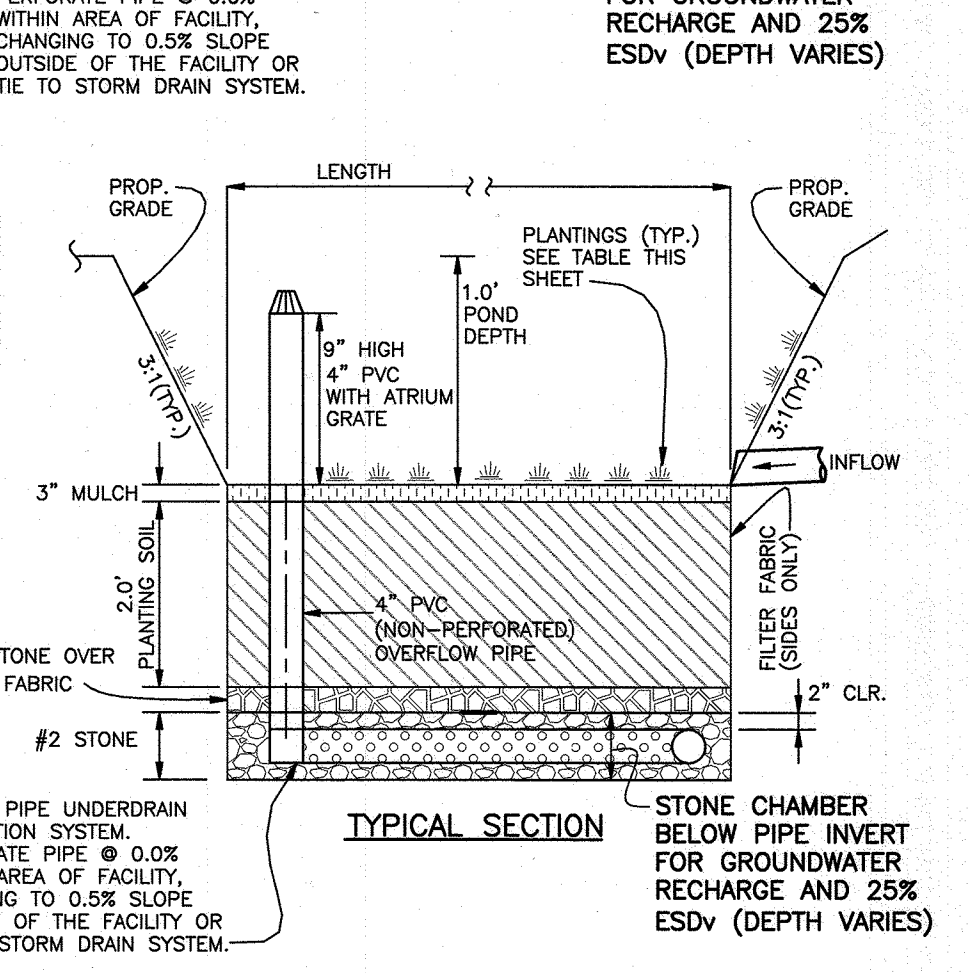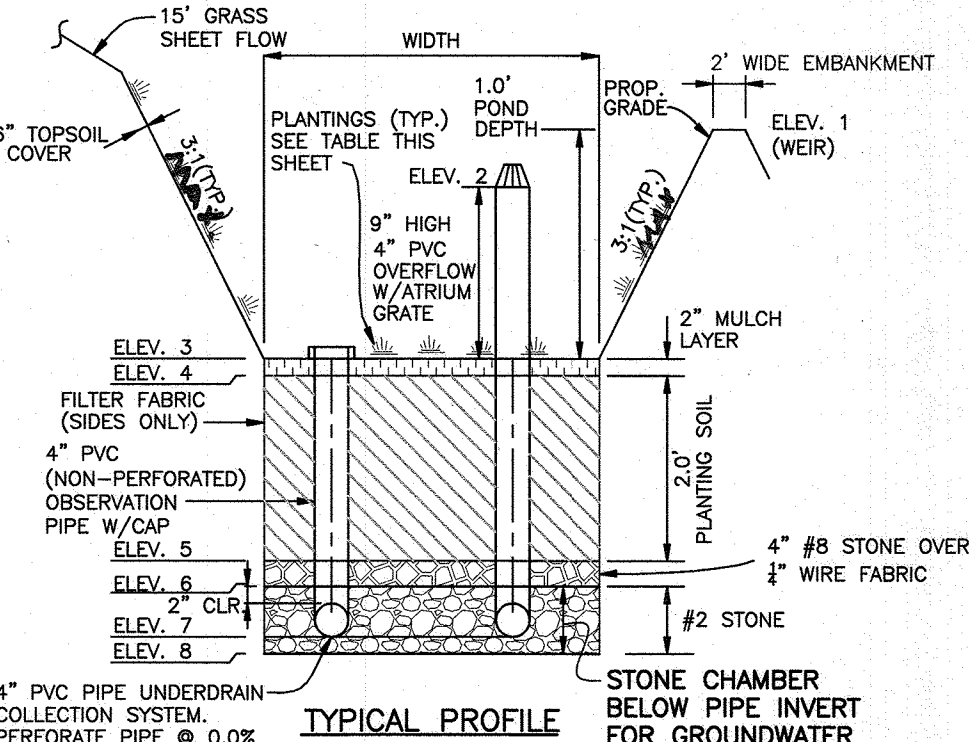

LEGEND

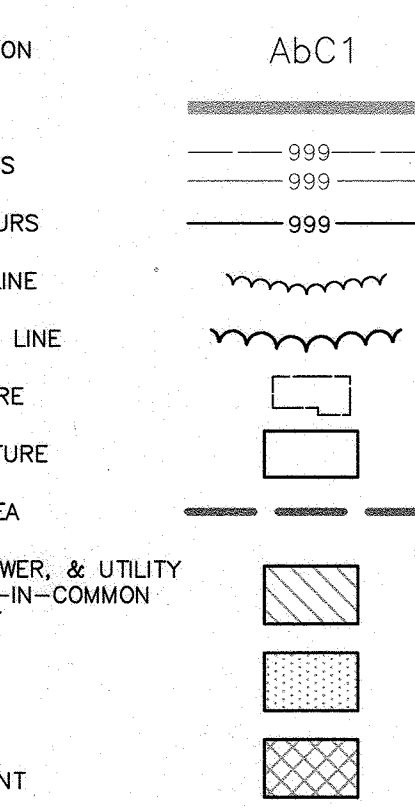


OPERATION AND MAINTENANCE SCHEDULE FOR PRIVATELY OWNED AND MAINTAINED STORMWATER DRY WELLS (M-5)

- THE MONITORING WELLS AND STRUCTURES SHALL BE INSPECTED ON A QUARTERLY BASIS AND AFTER EVERY LARGE STORM EVENT.
- WATER LEVELS AND SEDIMENT BUILD UP IN THE MONITORING WELLS SHALL BE RECORDED OVER A PERIOD OF SEVERAL DAYS TO INSURE TRENCH DRAINAGE.
- A LOG BOOK SHALL BE MAINTAINED TO DETERMINE THE RATE AT WHICH THE FACILITY DRAINS.
- WHEN THE FACILITY BECOMES CLOGGED SO THAT IT DOES NOT DRAIN DOWN WITHIN THE 72 HOUR TIME PERIOD, CORRECTIVE ACTION SHALL BE TAKEN.
- THE MAINTENANCE LOG BOOK SHALL BE AVAILABLE TO HOWARD COUNTY FOR INSPECTION TO INSURE COMPLIANCE WITH OPERATION AND MAINTENANCE CRITERIA.
- ONCE THE PERFORMANCE CHARACTERISTICS OF THE INFILTRATION FACILITY HAVE BEEN VERIFIED, THE MONITORING SCHEDULE CAN BE REDUCED TO AN ANNUAL BASIS UNLESS THE PERFORMANCE DATA INDICATES THAT A MORE FREQUENT SCHEDULE IS REQUIRED.

TABLE B.3.2 MATERIALS AND SPECIFICATIONS FOR SWM FACILITIES (DRYWELLS)

MATERIAL	SPECIFICATION	SIZE	NOTES:
PLANTINGS (IF REQUIRED)	SEE APPENDIX A, TABLE A.4	N/A	PLANTINGS ARE SITE SPECIFIC
PLANTING SOIL (2\"/>			
MULCH	SHREDDED HARDWOOD	N/A	2\"/>
GEOTEXTILE (CLASS \"C\")	APPARENT OPENING SIZE: (ASTM D-4751) 50 MIL TENSILE STRENGTH: (ASTM D-4832) FIBRE RESISTANCE: (ASTM D-4833)	N/A	FOR USE AS NECESSARY BENEATH UNDERDRAINS ONLY
UNDERDRAIN GRAVEL	AASHTO M-43	0.375\"/>	
UNDERDRAIN PIPING	F754 TYPE PS28 OR AASHTO M-278	4\"/>	3/8\"/>
POURED-IN-PLACE CONC. (IF REQUIRED)	M50 MIX NO.3; FC-30000 @ 28 DAYS; NORMAL CURE; AIR ENTRAINMENT; REINFORCING TO MEET A573-10	N/A	ON-SITE TESTING OF POURED-IN-PLACE CONC. REQUIRED; 28 DAY STRENGTH TEST AND SLUMP TEST; ALL CONC. DESIGN CAST IN PLACE OR PRE-CAST; NOT USING PREVIOUSLY APPROVED STATE OR LOCAL STANDARDS REQUIRES DESIGN DRAWINGS SEALED AND APPROVED BY A PROFESSIONAL STRUCTURAL ENGINEER LICENSED IN THE STATE OF MARYLAND. DESIGN TO INCLUDE MEETING ACI CODE 309/89 VERTICAL LOADING (10-10 OR 11-20) ALLOWABLE HORIZONTAL LOADING (BASED ON SOIL PRESSURES); AND ANALYSIS OF POTENTIAL CRACKING.
CHECK DAM (TREATED WOOD)	AWPA STANDARD C6	6\"/>	DO NOT COAT WITH CROSSLITE; EMBED AT LEAST 3\"/>

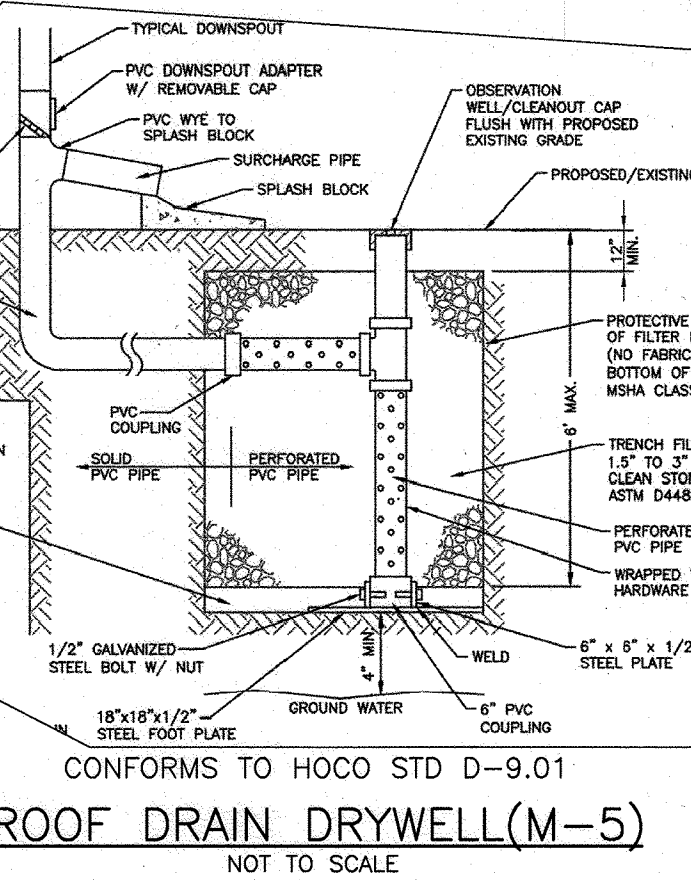

DRYWELL DIMENSION CHART

Dry Well	Length (ft)	Width (ft)	Depth of Media (ft)	Bottom of Stone Elevation	Bottom of Sand Elevation
LOT 458	10.0	5.0	5.0	179.0	178.0
LOT 459	10.0	5.0	5.0	179.1	177.1
LOT 460	10.0	5.0	5.0	173.9	172.9
LOT 461	10.0	5.0	5.0	172.1	171.1
LOT 462	10.0	5.0	5.0	166.5	165.5
LOT 463	10.0	5.0	5.0	161.4	160.4

DRAINAGE AREAS TO THE DRYWELLS ARE ROOFTOPS OF EACH UNIT (652 SF)

MICRO-BIORETENTION (M-6) PLANTING DATA

- PLANTINGS WITHIN THE PONDING AREA OF THE LS INFILTRATION ARE TO BE OF A MEDIUM TO HIGH WATER TOLERANCE. SUGGESTED SPECIES: CREEPING BUTTERFLY (AULICA REPTANS) COMMON PERENNIAL (VINCA MINOR) LILY-TURF (LIRIOPE, SP.)
- PLANTINGS ALONG THE PERIMETER (BERM) AREA OF THE LS INFILTRATION ARE TO BE OF A LOW TO MEDIUM WATER TOLERANCE. SUGGESTED SPECIES: (PERENNIALS/ANNUALS) DAVIDY (HEMERICALLIS SP.) WHITE GLORY (ASTILE SP.)

MICRO-BIORETENTION (M-6) LANDSCAPE DATA

HYDROLOGIC ZONE 3 - REGULARLY INUNDATED SHORELINE FRINGE (HIGH MARSH)
HYDROLOGIC CONDITION - 0\"/>

NOTE: REFER TO MDE 2000 MD STORMWATER DESIGN MANUAL VOLUMES 1 & 2 FOR LANDSCAPE CONTRACTOR RESPONSIBILITIES, PRACTICES AND MAINTENANCE DUTIES

APPROVED: HOWARD COUNTY DEPARTMENT OF PLANNING AND ZONING
[Signatures]
DATE: 1/2/20
DATE: 1-3-20
DATE: 1-3-20

(M-6) Micro Bio-Retention Landscaping Chart

PLANT NAME	COMMON NAME	TYPE	SURFACE AREA	SIZE	MB#1	TOTAL
Lobelia cardinalis	Common Winterberry	perennial herbaceous plant	2.5' x 3' ft	quart. bubb.	59	59
Lobelia siphilitica	Great Blue Lobelia	perennial herbaceous plant	quart. bubb.	59	59	
Carex stricta	Upright Sedge	grass	quart. bubb.	59	59	
Liatris scapata	Prairie Gay Feather	perennial herbaceous plant	quart. bubb.	59	59	

- ADD TIMBER WALL TO LOT 463
- REVISE GRADES KEAR OF LOTS 463 TO 458
- REVISE FLOOR LEVEL, PAVES BUILT & REVISE GRADES

BENCHMARK ENGINEERING, INC.
8480 BALTIMORE NATIONAL PIKE & SUITE 515 • ELLOTT CITY, MARYLAND 21043
(P) 410-485-8105 (F) 410-485-8844
WWW.BEI-CVLENGINEERING.COM


Professional Certification: I hereby certify that these documents were prepared or approved by me, and that I am a duly licensed professional engineer under the laws of the State of Maryland, License No. 26249, Expiration Date: 6/30/21.

LENNOX PARK CROSBY PROPERTY
LOTS 458-465

TAX MAP: 43 - GRID: 06 - PARCEL: p/0319
ZONED: R-12 (RESIDENTIAL)
ELECTION DISTRICT NO. 1 - HOWARD COUNTY, MARYLAND


ALTERNATIVE COMPLIANCE EXHIBIT & SIMPLIFIED ECP

DATE: JANUARY 03, 2020 BEI PROJECT NO. 2741
SCALE: AS SHOWN SHEET 2 OF 3

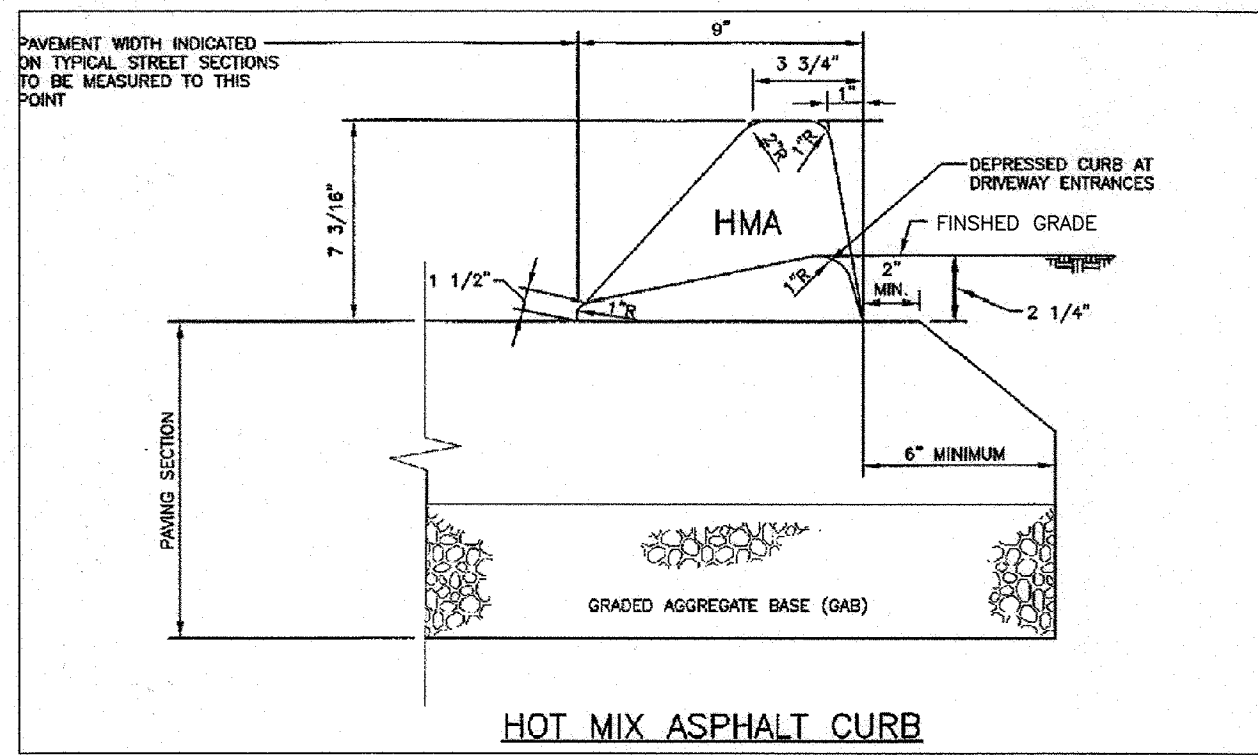

HOT MIX ASPHALT CURB
NOT TO SCALE


THIS DETAIL CONFORMS TO
HO.CO. DMV IV R-3.03

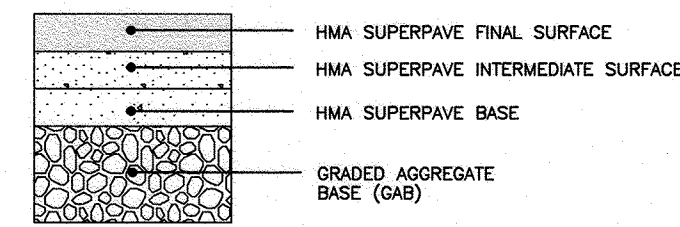

SCHEMATIC PAVING DETAIL
NOT TO SCALE

SECTION NUMBER	ROAD AND STREET CLASSIFICATION	CALIFORNIA BEARING RATIO (CBR)	3 to <5 to <7		3 to <5 to <7	
			3 to <5 to <7	3 to <5 to <7	3 to <5 to <7	3 to <5 to <7
P-2	PARKING DRIVE AISLES: RESIDENTIAL AND NON-RESIDENTIAL WITH NO MORE THAN 10 HEAVY TRUCKS PER DAY LOCAL ROADS: ACCESS DRIVE, ACCESS STREET CUL-DE-SAC: RESIDENTIAL	PAVEMENT MATERIAL (INCHES)	MIN. HMA WITH GAB	HMA WITH CONSTANT GAB		
		9.5 HMA SUPERPAVE FINAL SURFACE 9.5 MM PG 64-22, LEVEL 1 (LOW ESAL)	1.5	1.5	1.5	1.5
		9.5 HMA SUPERPAVE INTERMEDIATE SURFACE 9.5 MM PG 64-22, LEVEL 1 (LOW ESAL)	1.0	1.0	1.0	1.0
		9.0 HMA SUPERPAVE BASE 9.0 MM PG 64-22, LEVEL 1 (LOW ESAL)	2.0	2.0	2.0	2.0
		GRADED AGGREGATE BASE (GAB)	8.0	4.0	3.0	4.0

PAVING SPECIFICATIONS (HO.CO. STD R-2.01)

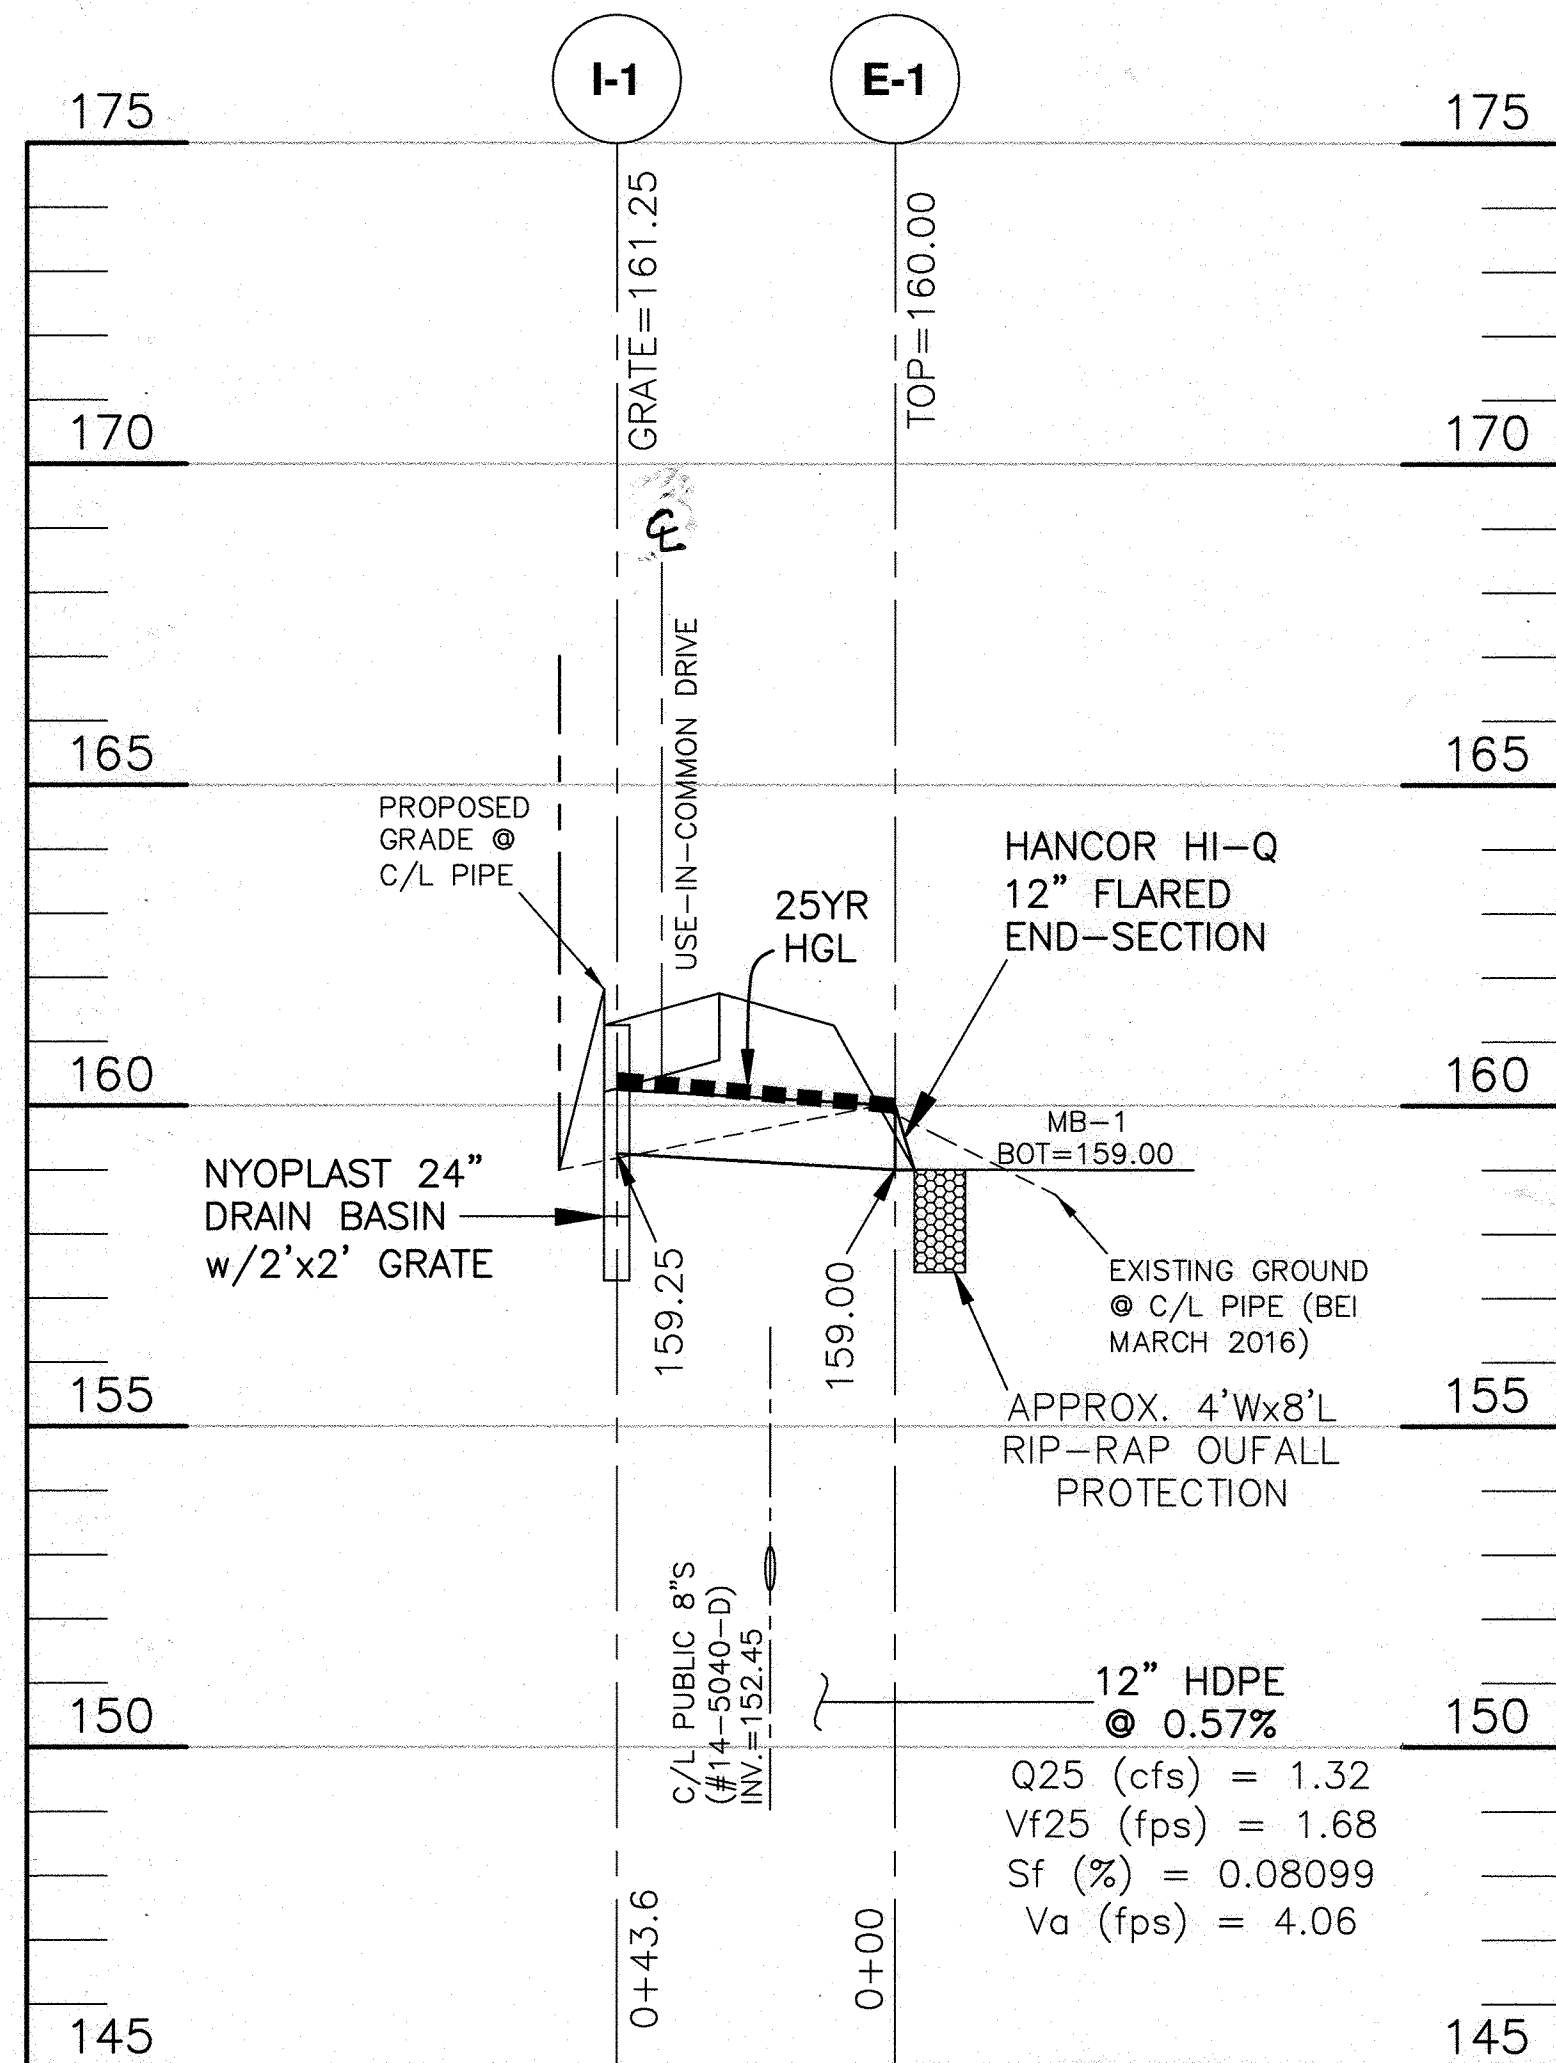


SD PROFILE
HORIZONTAL SCALE: 1" = 30'
VERTICAL SCALE: 1" = 3'

SIZE	TYPE	LENGTH (L.F.)	MAINTENANCE
12"	HDPE	43.6	PRIVATE
4" (MB-1)	PVC	28.3	PRIVATE

All pipes shall have smooth interior. No interior constrictions.

STRUCTURE	TYPE	LOCATION	INVERT IN	INVERT OUT	TOP ELEV.	THROAT ELEV.	STD. DETAIL	MAINTENANCE
INLETS								
I-1	NDS 24"x24"	N 549,728.7314 E 1,382,669.8137		159.25		161.25	Manufacturer Specs.	PRIVATE
MANHOLES								
								PRIVATE
HEADWALLS/END SECTIONS								
ES-1	HDPE End Section	N 549,702.1827 E 1,382,704.3474		159.00		160.00	Manufacturer Specs.	PRIVATE



STRUCTURE LOCATION FOR MANHOLES IS AT THE CENTER OF THE MANHOLE RIM.
STRUCTURE LOCATION FOR END SECTIONS IS AT THE MIDPOINT OF THE END OF THE STRUCTURE.
PRECAST STRUCTURES MEETING HS-20 LOADING MAY BE USED.

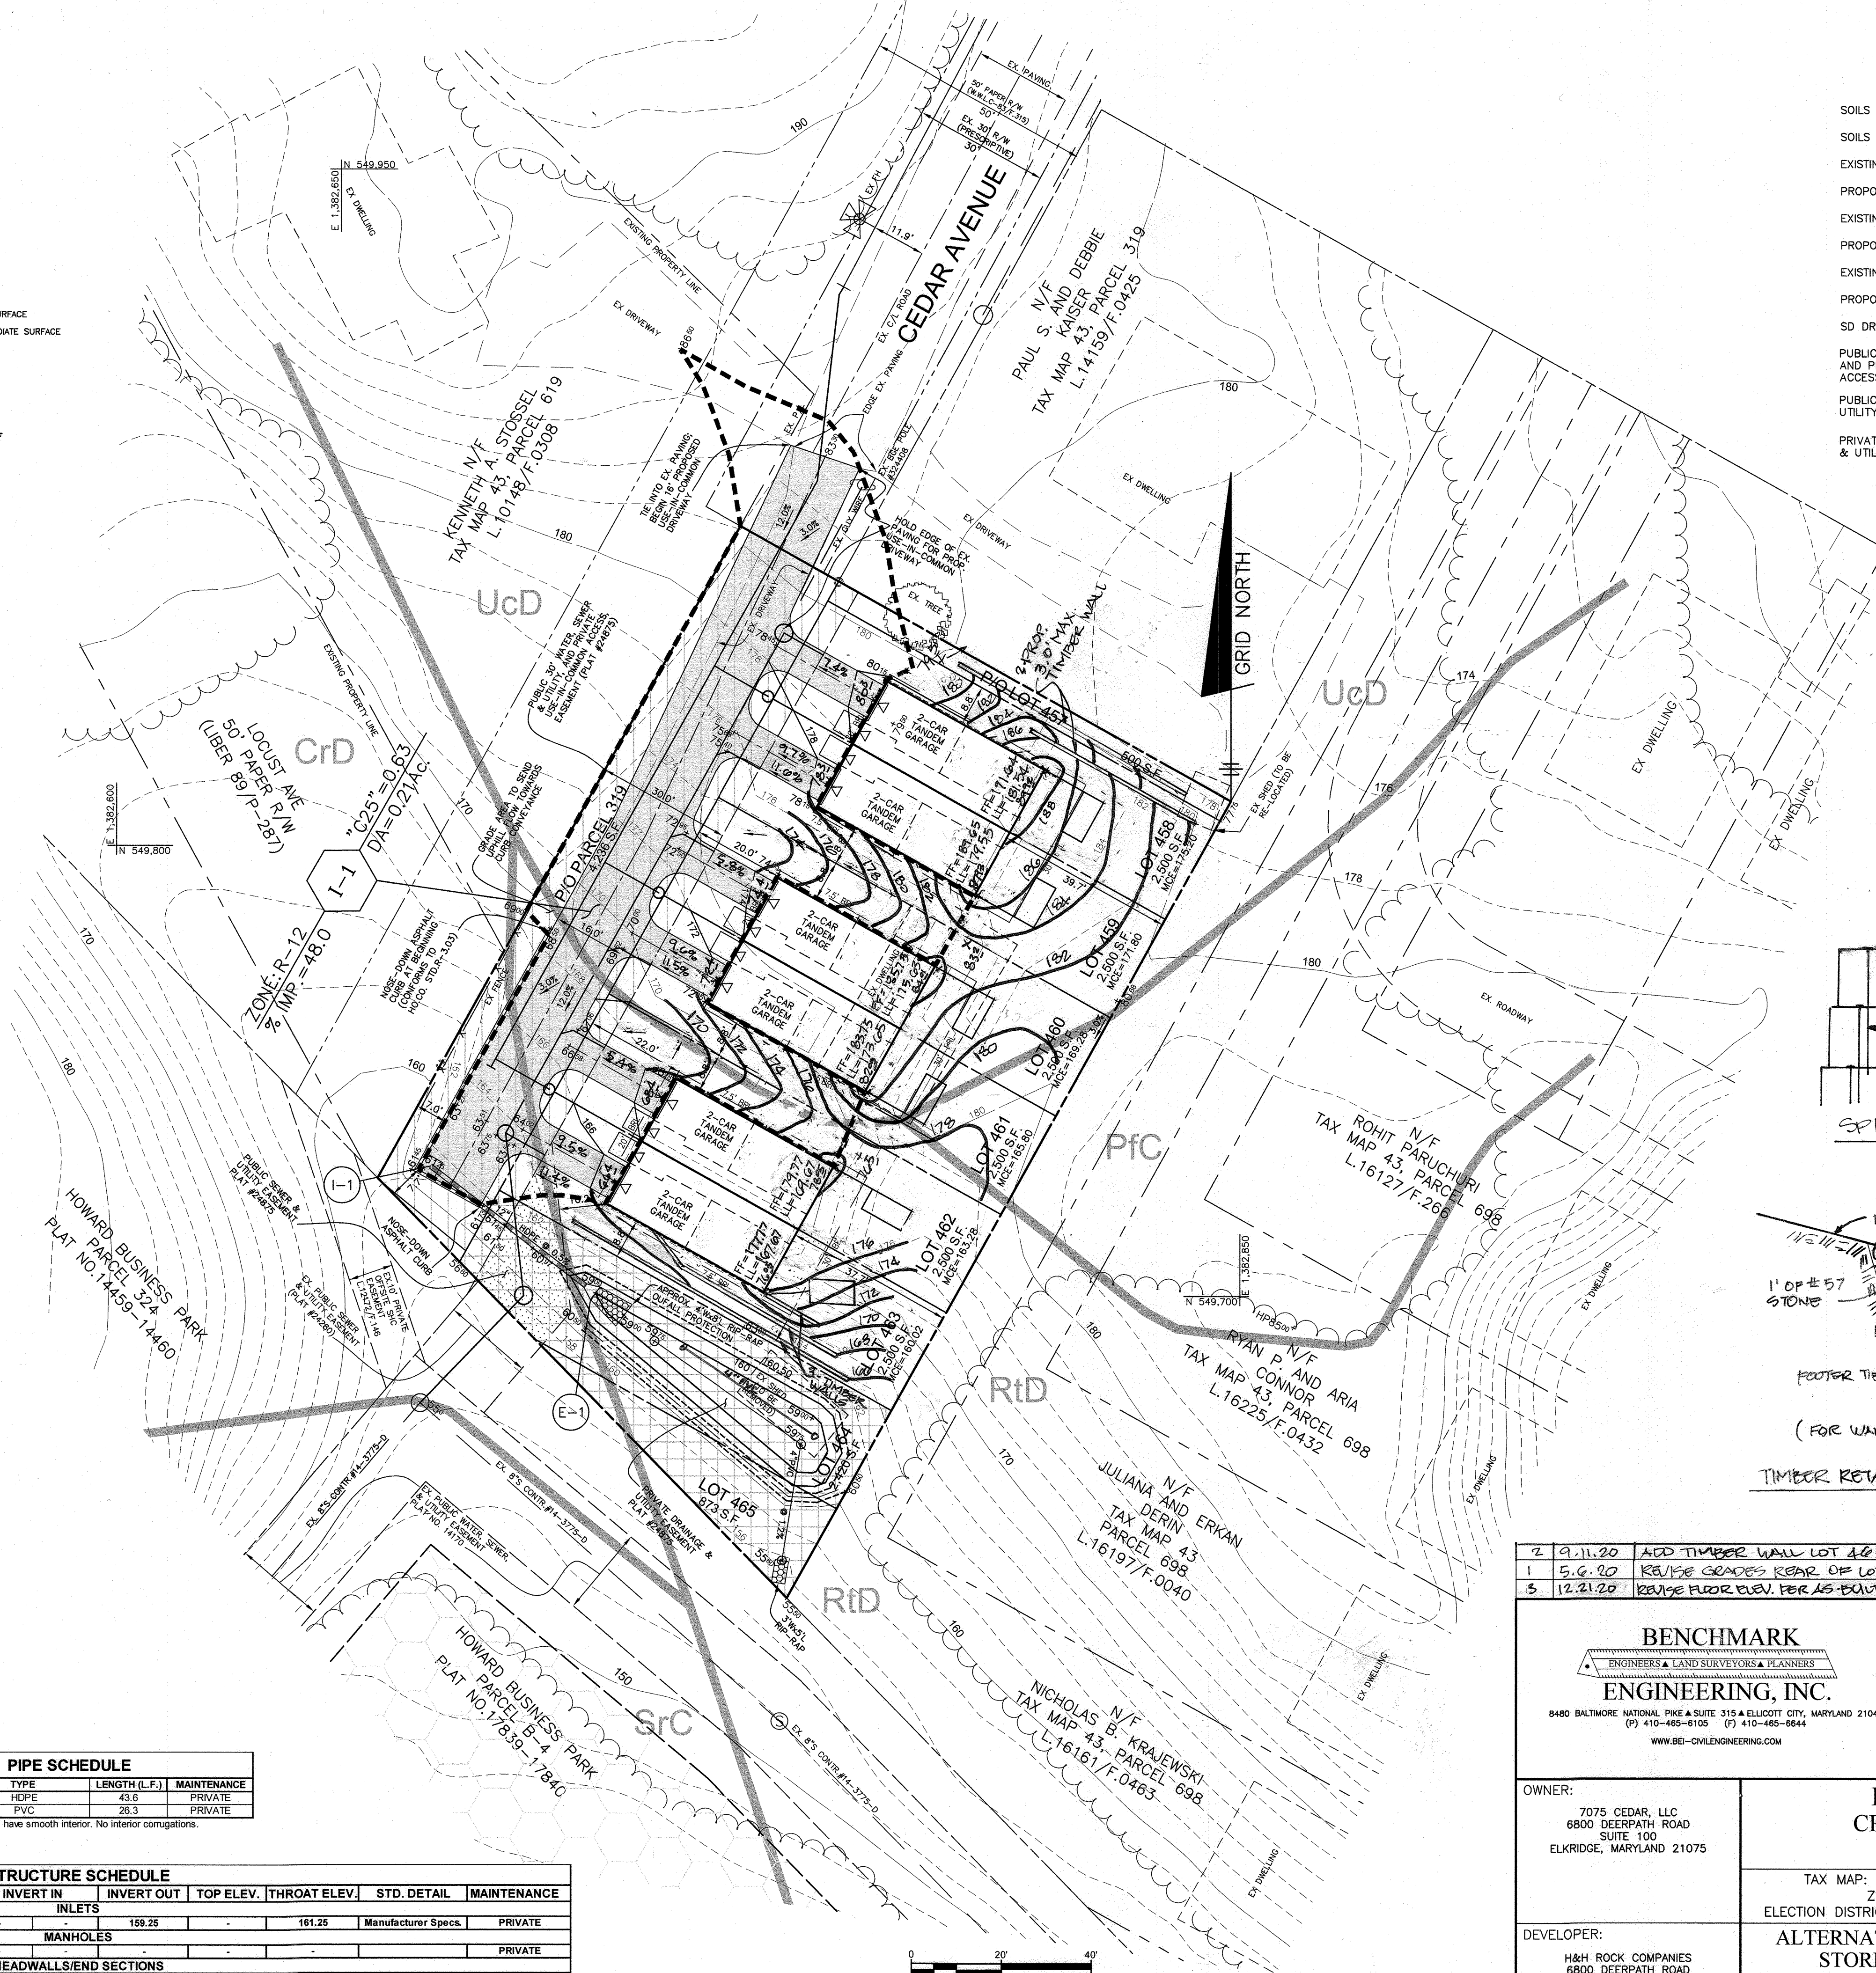

PLAN VIEW
SCALE: 1"=20'

LEGEND

SOILS CLASSIFICATION	AbC1
SOILS DELINEATION	---
EXISTING CONTOURS	---
PROPOSED CONTOURS	---
EXISTING WOODS LINE	~ ~ ~
PROPOSED WOODS LINE	~ ~ ~
EXISTING STRUCTURE	[]
PROPOSED STRUCTURE	[]
SD DRAINAGE AREA	---
PUBLIC WATER, SEWER, & UTILITY AND PRIVATE USE-IN-COMMON ACCESS EASEMENT	[]
PUBLIC SEWER & UTILITY EASEMENT	[]
PRIVATE DRAINAGE & UTILITY EASEMENT	[]

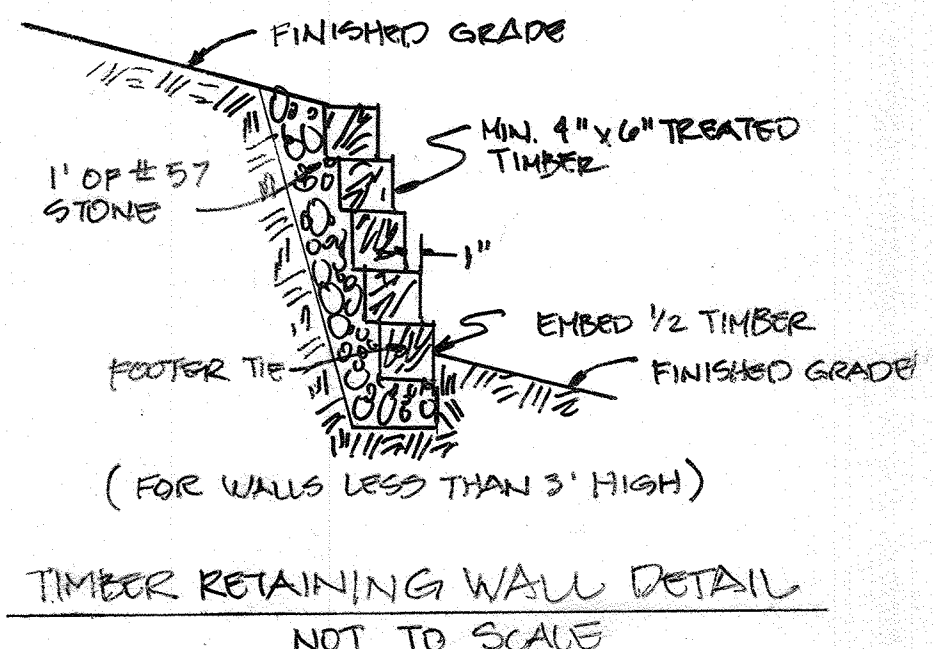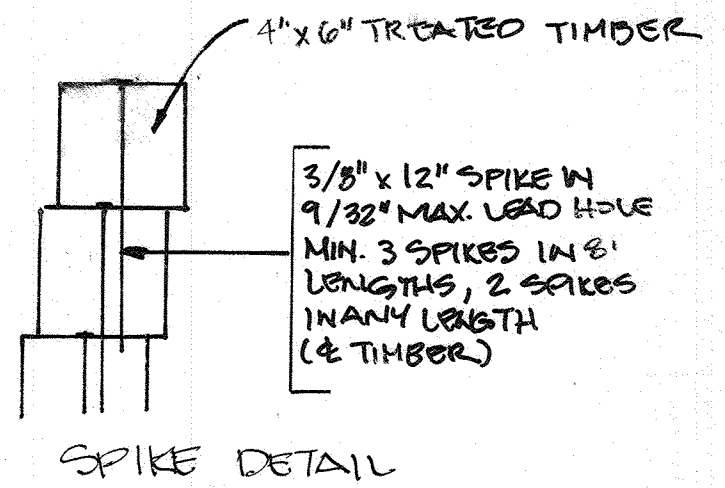

<p>2 9.11.20 ADD TIMBER WALL LOT 463</p> <p>1 5.6.20 REVISE GRADES REAR OF LOTS 458 TO 463 & ADD TIMBER WALL</p> <p>3 12.21.20 REVISE FLOOR ELEV. PER AS-BUILT & ADJUST REAR GRADES</p>	<p>Professional Certification I hereby certify that these documents were prepared or approved by me, and that I am a duly licensed professional engineer under the laws of the State of Maryland, License No. 22990, Expiration Date 9/30/21.</p> <p>BENCHMARK ENGINEERS, INC. ENGINEERS & LAND SURVEYORS & PLANNERS 8480 BALTIMORE NATIONAL PIKE & SUITE 315 & ELLICOTT CITY, MARYLAND 21043 (P) 410-485-8105 (F) 410-485-8644 WWW.BEI-CIVILENGINEERING.COM</p>
<p>OWNER: 7075 CEDAR, LLC 6800 DEERPATH ROAD SUITE 100 ELKRIDGE, MARYLAND 21075</p>	<p>LENNOX PARK CROSBY PROPERTY LOTS 458-465 TAX MAP: 43 - GRID: 06 - PARCEL: p/6319 ZONED: R-12 (RESIDENTIAL) ELECTION DISTRICT NO. 1 - HOWARD COUNTY, MARYLAND</p>
<p>DEVELOPER: H&H ROCK COMPANIES 6800 DEERPATH ROAD SUITE 100 ELKRIDGE, MARYLAND 21075</p>	<p>ALTERNATIVE COMPLIANCE EXHIBIT STORM DRAINAGE MAP AND PROFILES, NOTES & DETAILS DATE: JANUARY 03, 2020 BEI PROJECT NO. 2741</p>
<p>DESIGN: MCR DRAFT: MCR</p>	<p>SCALE: AS SHOWN SHEET 3 OF 3</p>

APPROVED: HOWARD COUNTY DEPARTMENT OF PLANNING AND ZONING

[Signature] 1/3/20
CHIEF, DIVISION OF LAND DEVELOPMENT

[Signature] 1-3-20
CHIEF, DEVELOPMENT ENGINEERING DIVISION

[Signature] 1-3-20
DIRECTOR


GENERAL NOTES

- THE TOPOGRAPHY SHOWN HEREON IS BASED ON A FIELD RUN SURVEY DATED FEBRUARY, 2016 BY BENCHMARK ENGINEERING, INC. THE BOUNDARY SHOWN HEREON IS BASED ON BOUNDARY SURVEY PREPARED BY BENCHMARK ENGINEERING INC., DATED MARCH, 2016.
- THE PROPERTY IS KNOWN AS TAX MAP 43, GRID 06, PARCEL 319. THIS INCLUDES LOTS 458-465, P/O LOT 457, AND A PORTION OF CEDAR AVENUE. THE TOTAL PROPERTY AREA IS APPROXIMATELY 0.53 ACRES.
- THE PROPERTY IS ZONED R-12 PER THE 10.06.13 COMPREHENSIVE ZONING PLAN.
- THE EXISTING HOUSE LOCATED ON THE PROPERTY IS TO BE REMOVED; THE EXISTING DRIVEWAY WILL BE IMPROVED TO A 16' WIDE USE-IN-COMMON DRIVE TO PROVIDE ACCESS FOR THE DEVELOPMENT. THE APPROXIMATE LIMIT OF DISTURBANCE = 25,420 SF
- STORMWATER MANAGEMENT FOR THIS SITE WILL BE PROVIDED BY DRYWELLS FOR THE ROOFTOPS AND MICRO-BIORETENTION FOR THE DRIVEWAYS AND USE-IN-COMMON DRIVE.
- THESE LOTS ARE EXISTING LOTS KNOWN AS LENNOX PARK RECORDED AS PLATBOOK 83 PAGE 315 DATED FEBRUARY 4, 1907.
- A TRAFFIC STUDY IS NOT REQUIRED FOR THIS DEVELOPMENT SINCE THE LOTS ARE EXISTING AND NO NEW LOTS ARE TO BE CREATED.
- TO THE BEST OF OUR KNOWLEDGE AND AVAILABLE DATA, THERE ARE NO FLOODPLAINS, STREAMS, OR STEEP SLOPES LOCATED ON THIS SITE.
- THERE ARE NO WETLANDS ON-SITE PER AN ENVIRONMENTAL FIELD INVESTIGATION PERFORMED BY HILLS-CARNES ENGINEERING ASSOCIATES, INC. ON JANUARY, 2017.
- THERE ARE NO SPECIMEN TREES OR FORESTED AREAS ON-SITE PER A SIMPLIFIED FOREST STAND DELINEATION PERFORMED BY BENCHMARK ENGINEERING, INC. ON FEBRUARY, 2017.
- A GEOTECHNICAL INVESTIGATION WAS PERFORMED HILLS-CARNES ENGINEERING ASSOCIATES, INC. WHICH DETERMINED THAT THE ON-SITE SOILS ARE ACCEPTABLE FOR THE PROPOSED ESD PRACTICES.
- A NOISE STUDY IN NOT REQUIRED FOR THIS PROPERTY SINCE IT IS NOT IN THE AIRPORT NOISE ZONE AND IS MORE THAN 500' FROM A RAIL LINE.
- LOTS 458 THRU 463 WILL BE DEVELOPED WITH SINGLE-FAMILY SEMI-DETACHED UNITS; LOTS 464 TO 465 WILL BE UTILIZED FOR ESD-SWM; AND THE REMAINING PORTION OF PARCEL WILL BE UTILIZED FOR A USE-IN-COMMON DRIVEWAY AND UTILITIES.
- THIS PLAN IS SUBJECT TO AN ALTERNATIVE COMPLIANCE WP-17-085 APPROVED NOVEMBER 14, 2017 TO SECTION 16.155(o)(2) RESIDENTIAL: NEW RESIDENTIAL DEVELOPMENT REQUIRING APPROVAL OF A SITE DEVELOPMENT PLAN FOR SIX SEMI-DETACHED DUPLEX UNITS APPROVAL IS SUBJECT TO THE FOLLOWING CONDITIONS:
 - THE DED COMMENTS DATED NOVEMBER 13, 2017.
 - THE ALTERNATIVE COMPLIANCE EXHIBIT SHALL SERVE AS A SUBSTITUTE FOR A SITE DEVELOPMENT PLAN FOR DEVELOPMENT. ALL IMPROVEMENTS SHOWN ON THE EXHIBIT MUST BE CONSTRUCTED PER THE PLAN EXHIBITS SUBMITTED DATED OCTOBER 7, 2017. THE REVISED ALTERNATIVE COMPLIANCE PLAN EXHIBIT SHALL BE SUBMITTED AS AN ORIGINAL MYLAR AND RECEIVE SIGNATURE APPROVAL FROM THE DEPARTMENT OF PLANNING & ZONING, PRIOR TO APPLYING FOR PERMITS. THE ORIGINAL MYLAR PLAN EXHIBIT SHALL BE SUBMITTED WITHIN 45 DAYS OF THIS LETTER (ON OR BEFORE DECEMBER 29, 2017)
 - COMPLIANCE WITH ALL APPLICABLE COUNTY & STATE REGULATIONS, AND OBTAIN ALL NECESSARY PERMITS FROM THE DEPARTMENT OF INSPECTIONS, LICENSES & PERMITS, PRIOR TO INITIATING DEVELOPMENT ON-SITE

- NOTE: WP-17-085 HAS SINCE EXPIRED AND A NEW ALTERNATIVE COMPLIANCE IS BEING REQUESTED VIA THIS PLAN EXHIBIT AND APPLICATION.

LEGEND

- SOILS CLASSIFICATION: AbC1
- SOILS DELINEATION: [Symbol]
- EXISTING CONTOURS: [Symbol]
- PROPOSED CONTOURS: [Symbol]
- EXISTING WOODS LINE: [Symbol]
- PROPOSED WOODS LINE: [Symbol]
- EXISTING STRUCTURE: [Symbol]
- PROPOSED STRUCTURE: [Symbol]
- LIMIT OF DISTURBANCE: [Symbol]
- PUBLIC WATER, SEWER, & UTILITY AND PRIVATE USE-IN-COMMON ACCESS EASEMENT: [Symbol]
- PUBLIC SEWER & UTILITY EASEMENT: [Symbol]
- PRIVATE DRAINAGE & UTILITY EASEMENT: [Symbol]

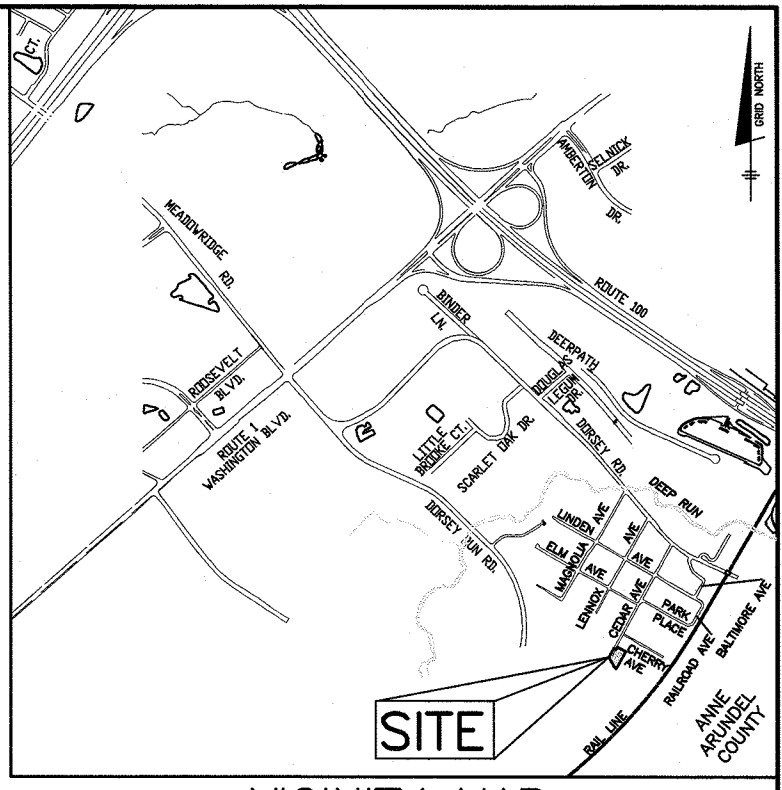

VICINITY MAP
SCALE: 1" = 2000'
ADC MAP NO. 35 GRID B6

NARRATIVE


The Lennox Park, Crosby Property Lots 458-465, Elkrige, Maryland comprises approximately 0.53 acres. The property is zoned R-12 and is located on the southeast side of Cedar Avenue at its terminus point adjoining the Howard Business Park. Access will be provided by a Use-In-Common Drive constructed from the existing edge of paving of Cedar Avenue. The proposed development shall consist of 3 Semi-Detached Dwellings containing 6 units total. The project is located within an existing neighborhood known as Lennox Park. The site drains from the northeast to the southwest and is conveyed off site through an off swale on the adjoining property. The project lies within the Patapsco River watershed (02-13-09) and the use is I-P.

The NRCS soils in the location of this development are mostly Hydrologic Group 'C' & 'D'. Other Lots within close proximity of this site have indicated 'B' type soils. A Geotechnical Investigation was performed by Hills-Carnes Engineering Associates, Inc. on January, 2017. There are no Specimen Trees or Forested areas on-site per a Simplified Forest Stand Delineation performed by Benchmark Engineering, Inc. on February, 2017.


This site was analyzed as woods in good condition and a target RCN was determined. A target rainfall depth treatment (Pe) was determined based on the measured impervious areas and HSG soil types (mostly 'C' & 'D'). The target Pe for this site is 1.8 inches based on the overall proposed drainage area. Full treatment of the target 1.8" Pe will be provided using Environmental Site Design practices as outlined in Chapter 5 of the 2000 Maryland Stormwater Design Manual, as amended by Maryland's Stormwater Management Act of 2007. The selected methods include Drywells (M-5) for the entire rooftop for each unit and a Micro-Bioretenion (M-6) for the driveways. The facilities will be privately owned and maintained.

To protect natural resources, it is important to minimize and adequately treat the stormwater runoff. The final design will incorporate adequate treatment and storage in order to create the least possible stormwater runoff in general compliance with this concept plan. The runoff will be treated on-site using approved methods. Outfalls generally correspond with the natural drainage patterns for the site.

The proposed development and ESD implementation should have no effect on adjacent properties as treatment of the target Pe in the development runoff conditions meet the existing runoff. The proposed development is not expected to have adverse effects on downstream properties, utilities, public facilities or natural systems since natural drainage pathways are maintained. Preliminary ESD practices have been designed to address 1.8 inches of runoff, the target Pe, for all area which could be conveyed to a facility. We believe this plan provides environmental site design to the maximum extent possible.

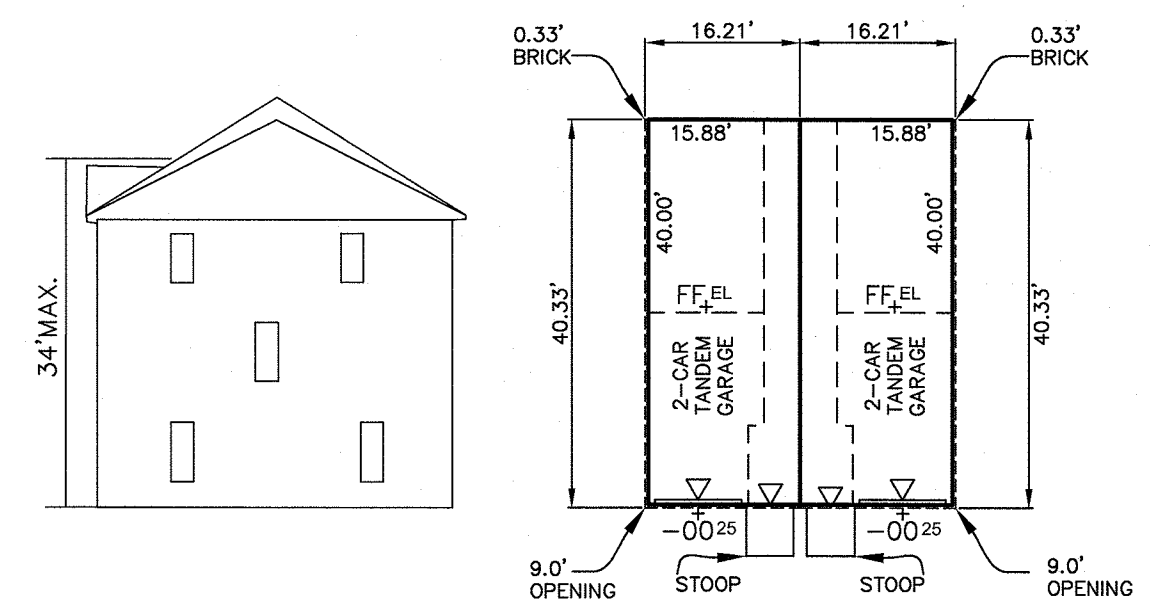

CLARENDON (MODIFIED DOUBLE END UNIT)
TYPICAL HOUSE FOOTPRINT
SCALE: 1" = 20'

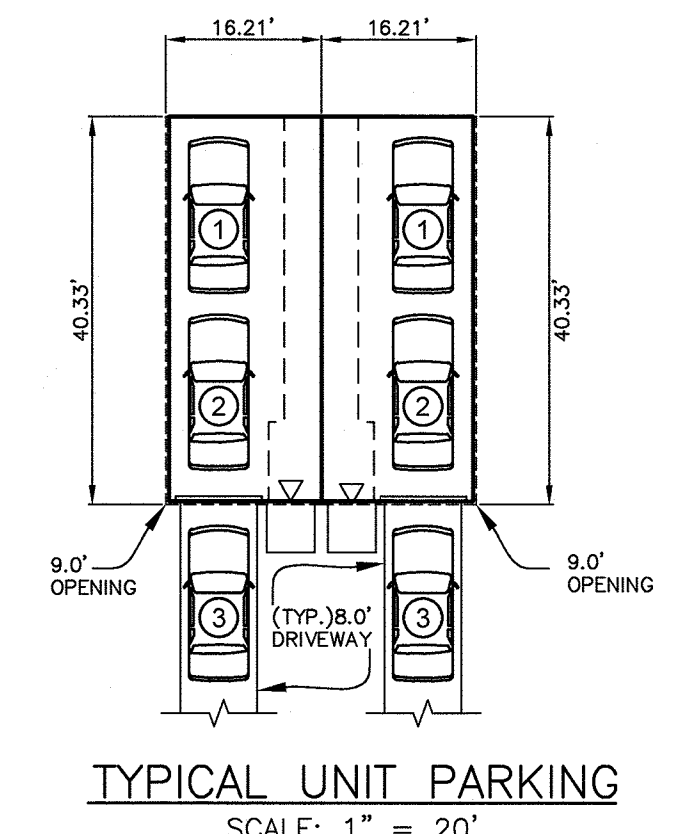

TYPICAL UNIT PARKING
SCALE: 1" = 20'

Practice	DA (sf)	Imp Area (sf)	%	Rv	Pe required	Required	At (sf)	Z/DAT	ESDv (sf)	Provided	Pe	Rev	Ownership
(M-6) Drywall	LOT 458	652	652	100%	0.95	1.8	50	50	PASS	93	100	1.9	Private
(M-6) Drywall	LOT 459	652	652	100%	0.95	1.8	50	50	PASS	93	100	1.9	Private
(M-6) Drywall	LOT 460	652	652	100%	0.95	1.8	50	50	PASS	93	100	1.9	Private
(M-6) Drywall	LOT 461	652	652	100%	0.95	1.8	50	50	PASS	93	100	1.9	Private
(M-6) Drywall	LOT 462	652	652	100%	0.95	1.8	50	50	PASS	93	100	1.9	Private
(M-6) Drywall	LOT 463	652	652	100%	0.95	1.8	50	50	PASS	93	100	1.9	Private
(M-6) Micro-Bioretenion	MB-1	18,384	4,400	24%	0.27	1.8	368	446	PASS	744	854	2.1	Private
Totals per Individual Drainage Area		22,296	8,402	40%	0.41					1301	1454		
Totals per Overall Site		26,125	8,414	35%	0.37	1.8				1332	1454		

Notes:
1. The Pe required column is based on total site Pe calculation. The Rv is based on individual drainage area percent impervious (per DED)
2. The ESDv Required for the (M-6) practices is based on 75% of ESDv.

APPROVED: HOWARD COUNTY DEPARTMENT OF PLANNING AND ZONING
 [Signature] 1/3/20
 CHIEF, DIVISION OF LAND DEVELOPMENT
 [Signature] 1-3-20
 CHIEF, DEVELOPMENT ENGINEERING DIVISION
 [Signature] 1-3-20
 DIRECTOR

SYMBOL	HYDRIC	HYDROLOGIC GROUP	ALTERNATE GROUP	NAME	k-VALUE
C/D		C	A	CROOM AND EVESBORO SOILS, 10 TO 15 PERCENT SLOPES	0.28/0.15
P/C		A	A	PATAPSCO-FORT MOTT COMPLEX 5 TO 10 PERCENT SLOPES	0.10/0.17
R/D		C	C/B	RUSSETT-ALLOWAY-HAMBROOK COMPLEX 10 TO 15 PERCENT SLOPES	0.24/0.43
S/C		C	C	SASSAFRAS AND CROOM SOIL, 5 TO 10 PERCENT SLOPES	0.37/0.28
U/D		D	B/C	URBAN LAND-CHILLUM-BELTSVILLE COMPLEX 5 TO 15 PERCENT SLOPES	0.37

2	9.11.20	ADD TIMBER WALL TO LOT 463
1	5.10.20	REVISE GRADES REAR OF LOTS 458 TO 463
NO.	DATE	REVISION
BENCHMARK ENGINEERING, INC. 8480 BALTIMORE NATIONAL PIKE A SUITE 315 A ELLICOTT CITY, MARYLAND 21043 (P) 410-485-8105 (F) 410-485-8644 WWW.BEI-CIVILENGINEERING.COM		
Professional Certification. I hereby certify that these documents were prepared or approved by me and that I am a duly licensed professional engineer under the laws of the State of Maryland, License No. 22390, Expiration Date: 6/30/21.		
OWNER:	7075 CEDAR, LLC 6800 DEERPATH ROAD SUITE 100 ELKRIDGE, MARYLAND 21075	
DEVELOPER:	H&H ROCK COMPANIES 6800 DEERPATH ROAD SUITE 100 ELKRIDGE, MARYLAND 21075	
DESIGN:	MCR	DRAFT: MCR
LENNOX PARK CROSBY PROPERTY LOTS 458-465 TAX MAP: 43 - GRID: 06 - PARCEL: p/o319 ZONED: R-12 (RESIDENTIAL) ELECTION DISTRICT NO. 1 - HOWARD COUNTY, MARYLAND		ALTERNATIVE COMPLIANCE EXHIBIT & SIMPLIFIED ECP DATE: JANUARY 03, 2020 BEI PROJECT NO. 2741 SCALE: AS SHOWN SHEET 1 OF 3

CONSTRUCTION SPECIFICATIONS

B.4.C Specifications for Micro-Bioretentment, Rain Gardens, Landscape Infiltration & Infiltration Berms

1. Material Specifications:

The allowable materials to be used in these practices are detailed in Table B.4.1.

2. Filtering Media or Planting Soil:

The soil shall be a uniform mix, free of stones, stumps, roots or other similar objects larger than two inches. No other materials or substances shall be mixed or dumped within the micro-bioretentment practice that may be harmful to plant growth, or prove a hindrance to the planting or maintenance operations. The planting soil shall be free of Bermuda grass, Quackgrass, Johnson grass, or other noxious weeds as specified under COMAR 15.08.01.05.

The planting soil shall be tested and shall meet the following criteria:

- Soil Component - Loamy Sand or Sandy Loam (USDA Soil Textural Classification)
- Organic Content - Minimum 10% by dry weight (ASTM D 2974). In general, this can be met with a mixture of loamy and (80%-85%) and compost (35% to 40%) or sandy loam (30%), coarse sand (30%), and compost (40%).
- Clay Content - Media shall have a clay content of less than 5%.
- pH Range - Should be between 5.5 - 7.0. Amendments (e.g., lime, iron sulfate plus sulfur) may be mixed into the soil to increase or decrease pH.

There shall be at least one soil test per project. Each test shall consist of both the standard soil test for pH, and additional tests of organic matter, and soluble salts. A textural analysis is required from the site stockpiled topsoil. If topsoil is imported, then a texture analysis shall be performed for each location where the topsoil was excavated.

3. Compaction:

It is very important to minimize compaction of both the base of bioretention practices and the required backfill. When possible, use excavation hoers to remove original soil. If practices are excavated using a loader, the contractor should use wide track or marsh track equipment, or light equipment with turf type tires. Use of equipment with narrow tracks or narrow tires, rubber tires with large lugs, or high-pressure tires will cause excessive compaction resulting in reduced infiltration rates and is not acceptable. Compaction will significantly contribute to design failure.

Compaction can be alleviated at the base of the bioretention facility by using a primary tilling operation such as a chisel plow, ripper, or subsoiler. These tilling operations are to restructure the soil profile through the 12 inch compaction zone. Substitute methods must be approved by the engineer. Rototillers typically do not till deep enough to reduce the effects of compaction from heavy equipment.

Rototill 2 to 3 inches of sand into the base of the bioretention facility before backfilling the optional sand layer. Pump any ponded water before preparing (rototilling) base.

When backfilling the topsoil over the sand layer, first place 3 to 4 inches of gravel over the sand, then rototill the sand/topsoil to create a gradation zone. Backfill the remainder of the topsoil to final grade.

When backfilling the bioretention facility, place soil in lifts 12" to 18". Do not use heavy equipment within the bioretention basin. Heavy equipment can be used around the perimeter of the basin to supply soils and sand. Grade bioretention materials with light equipment such as a compact loader or a dozer/loader with marsh tracks.

4. Plant Material:

Recommended plant material for micro-bioretentment practices can be found in Appendix A, Section A.2.3.

5. Plant Installation:

Compost is a better organic material source, is less likely to float, and should be placed in the invert and other low areas. Mulch should be placed in surrounding to a uniform thickness of 2" to 3". Shredded or chipped hardwood mulch is the only accepted mulch. Pine mulch and wood chips will float and move to the perimeter of the bioretention area during a storm event and are not acceptable. Shredded mulch must be well aged (6 to 12 months) for acceptance.

Rootstock of the plant material shall be kept moist during transport and on-site storage. The plant root ball should be planted so 1/8th of the ball is above final grade surface. The diameter of the planting pit shall be at least six inches or than the diameter of the planting ball. Set and maintain the plant straight during the entire planting process. Thoroughly water ground bed cover after installation.

Trees shall be braced using 2" by 2" stakes only as necessary and for the first growing season only. Stakes are to be equally spaced on the outside of the tree ball.

Grasses and legume seed should be drilled into the soil to a depth of at least one inch. Grass and legume plugs shall be planted following the non-grass ground cover planting specifications.

The topsoil specifications provide enough organic material to adequately supply nutrients from natural cycling. The primary function of the bioretention structure is to improve water quality. Adding fertilizers defeats, or at a minimum, impedes this goal. Only acid fertilizer or wood chips or mulch are used to amend the soil. Rototill urea fertilizer at a rate of 2 pounds per 1000 square feet.

6. Underdrains:

Underdrains should meet the following criteria:


- Pipe - Should be 4" to 6" diameter, slotted or perforated rigid plastic pipe (ASTM F 758, Type PS 28, or AASHTO-M-278) in a gravel layer. The preferred material is slotted, 4" rigid pipe (e.g., PVC or HDPE).
- Perforations - If perforated pipe is used, perforations should be 1/4" diameter located 6" on center with a minimum of four holes per row. Pipes shall be wrapped with 1/2" (No. 4 or 6W) galvanized hardware cloth.
- Gravel - The gravel layer (No. 57 stone preferred) shall be at least 3" thick above and below the underdrain.
- The main collector pipe shall be at a minimum 0.5% slope.
- A rigid, non-perforated observation well must be provided (one per every 1,000 square feet) to provide a clean-out port and monitor performance of the filter.
- A 4" layer of pea gravel (3/4" to 3/8" stone) shall be located between the filter media and underdrain to prevent migration of fines into the underdrain. This layer may be considered part of the filter bed when bed thickness exceeds 24".

The main collector pipe for underdrain systems shall be constructed at a minimum slope of 0.5%. Observation wells and/or clean-out pipes must be provided (one minimum per every 1000 square feet of surface area).

7. Miscellaneous:

These practices may not be constructed until all contributing drainage area has been stabilized.

LEGEND

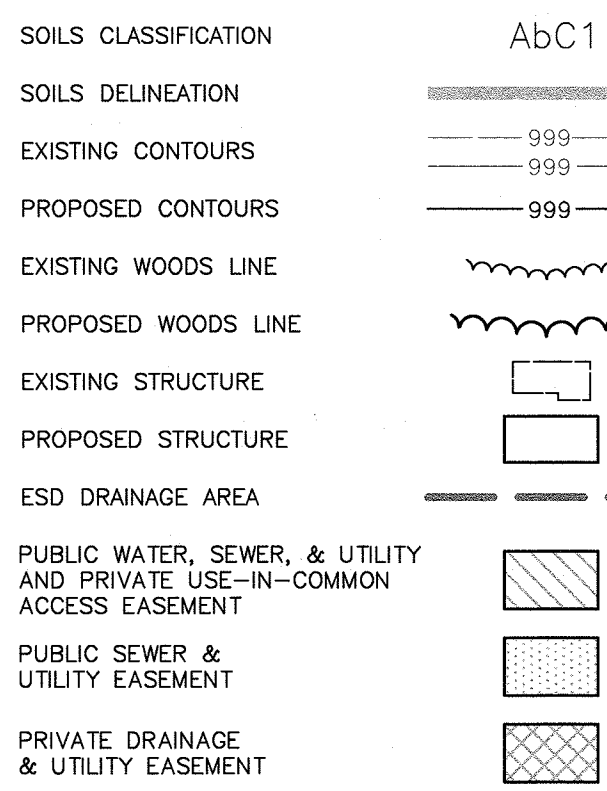


OPERATION AND MAINTENANCE SCHEDULE FOR PRIVATELY OWNED AND MAINTAINED STORMWATER DRY WELLS (M-5)

- THE MONITORING WELLS AND STRUCTURES SHALL BE INSPECTED ON A QUARTERLY BASIS AND AFTER EVERY LARGE STORM EVENT.
- WATER LEVELS AND SEDIMENT BUILD UP IN THE MONITORING WELLS SHALL BE RECORDED OVER A PERIOD OF SEVERAL DAYS TO INSURE TRENCH DRAINAGE.
- A LOG BOOK SHALL BE MAINTAINED TO DETERMINE THE RATE AT WHICH THE FACILITY DRAINS.
- WHEN THE FACILITY BECOMES CLOGGED SO THAT IT DOES NOT DRAIN DOWN WITHIN THE 72 HOUR TIME PERIOD, CORRECTIVE ACTION SHALL BE TAKEN.
- THE MAINTENANCE LOG BOOK SHALL BE AVAILABLE TO HOWARD COUNTY FOR INSPECTION TO INSURE COMPLIANCE WITH OPERATION AND MAINTENANCE CRITERIA.
- ONCE THE PERFORMANCE CHARACTERISTICS OF THE INFILTRATION FACILITY HAVE BEEN VERIFIED, THE MONITORING SCHEDULE CAN BE REDUCED TO AN ANNUAL BASIS UNLESS THE PERFORMANCE DATA INDICATES THAT A MORE FREQUENT SCHEDULE IS REQUIRED.

TABLE B.3.2 MATERIALS AND SPECIFICATIONS FOR SWM FACILITIES (DRYWELLS)

MATERIAL	SPECIFICATION	SIZE	NOTES:
PLANTINGS (IF REQUIRED)	SEE APPENDIX A, TABLE A.4	N/A	PLANTINGS ARE SITE SPECIFIC
PLANTING SOIL (2" TO 4" DEEP)	SAND: 35-60% SILT: 35-60% CLAY: 10-25%	N/A	USDA SOIL TYPES: LOAMY SAND, SANDY LOAM OR LOAM
MULCH	SHREDED HARDWOOD	N/A	2" TO 3" DEPTH, AGED 6 MONTHS, MINIMUM
GEOTEXTILE (CLASS "C")	APPARENT OPENING SIZE: (ASTM D-4751) TENSILE STRENGTH: (ASTM D-4833) PUNCTURE RESISTANCE: (ASTM D-4833)	N/A	FOR USE AS NECESSARY BENEATH UNDERDRAINS ONLY
UNDERDRAIN GRAVEL	AASHTO M-43	0.375" TO 0.750"	
UNDERDRAIN PIPING	F758, TYPE PS28 OR AASHTO M-278	4" TO 6" PERIOD SOIL, 40 PVC OR 8" HDPE	3/8" PERF. @ 6" O.C., 4 HOLES PER ROW, MINIMUM OF 3" OF GRAVEL OVER PIPES, NOT NECESSARY UNDERNEATH PIPES
POURED-IN-PLACE CONC. (IF REQUIRED)	MSHA MIX NO.3, FC-3020P @ 28 DAYS, NORMAL SET, AIR ENTRAINMENT, RINFORCING TO MEET ASTM A108-90	N/A	ON-SITE TESTING OF POURED-IN-PLACE CONC. REQUIRED; 28 DAY STRENGTH TEST AND SLUMP TEST; ALL CONC. DESIGNED, CAST AND APPROVED BY A PROFESSIONAL STRUCTURAL ENGINEER LICENSED IN THE STATE OF MARYLAND. DESIGN TO INCLUDE MEETING ACI CODE 309.7R VERTICAL LOADING (4-10 OR 11-20) ALLOWABLE HORIZONTAL LOADING (BASED ON SOIL PRESSURES); AND ANALYSIS OF POTENTIAL CRACKING
CHECK DAM (TRENCH WALL)	AWPA STANDARD C6	6" X 6" OR 8" X 8"	DO NOT COAT WITH CROSSLINK EMBED (SEE S.I. INTO SITE SLOPES)

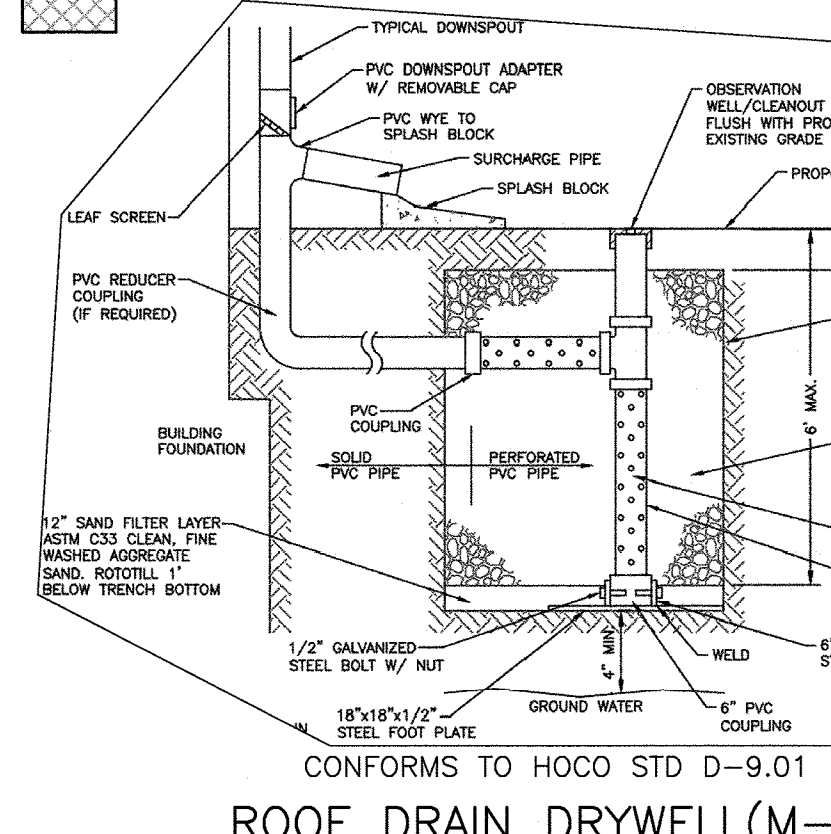

DRYWELL DIMENSION CHART

Dry Well	Length (ft)	Width (ft)	Depth of Media (ft)	Bottom of Stone Elevation	Bottom of Sand Elevation
LOT 458	10.0	5.0	5.0	174.0	178.0
LOT 459	10.0	5.0	5.0	176.1	177.1
LOT 460	10.0	5.0	5.0	173.9	172.9
LOT 461	10.0	5.0	5.0	172.1	171.1
LOT 462	10.0	5.0	5.0	168.5	167.5
LOT 463	10.0	5.0	5.0	161.4	160.4




DRAINAGE AREAS TO THE DRYWELLS ARE ROOFTOPS OF EACH UNIT (652 SF)

OPERATION & MAINTENANCE SCHEDULE FOR (M-6) MICRO-BIORETENTION

- The Owner shall maintain the plant material, mulch layer and soil layer annually. Maintenance of mulch and soil is limited to correcting areas of erosion or wash out. Any mulch replacement shall be done in the spring. Plant material shall be checked for disease and insect infestation and maintenance will address dead material and pruning. Acceptable replacement plant material is limited to the following: 2000 Maryland Stormwater Design Manual Volume II, Table A-4.1 and 2.
- The Owner shall perform a plant in the spring and in the fall of each year. During the inspection, the Owner shall remove dead and diseased vegetation, considered beyond treatment, replace dead plant material with acceptable replacement plant material, treat diseased trees and shrubs, and replace all deficient stakes and wires.
- The Owner shall inspect the mulch each spring. The mulch shall be replaced every two to three years. The previous mulch layer shall be removed before the new layer is applied.
- The Owner shall correct soil erosion on an as needed basis, with a minimum of once per month and after each heavy storm.

MICRO-BIORETENTION DESIGN TABLE

MB-1	(M-6)
4" PVC	
Elevation 1	160.00
Elevation 2	159.75
Elevation 3	159.00
Elevation 4	158.83
Elevation 5	156.83
Elevation 6	156.50
Elevation 7	155.92
Elevation 8	155.40
Surface (sf)	889.8

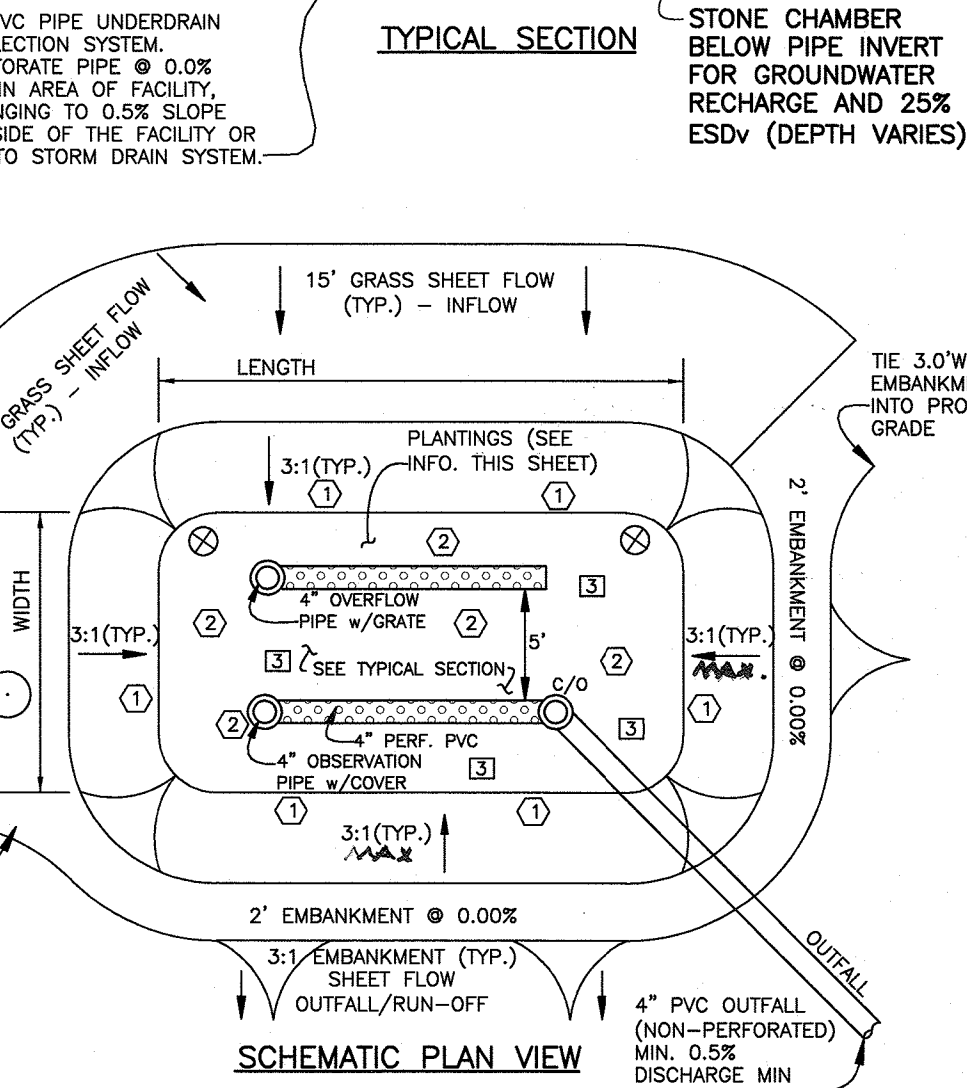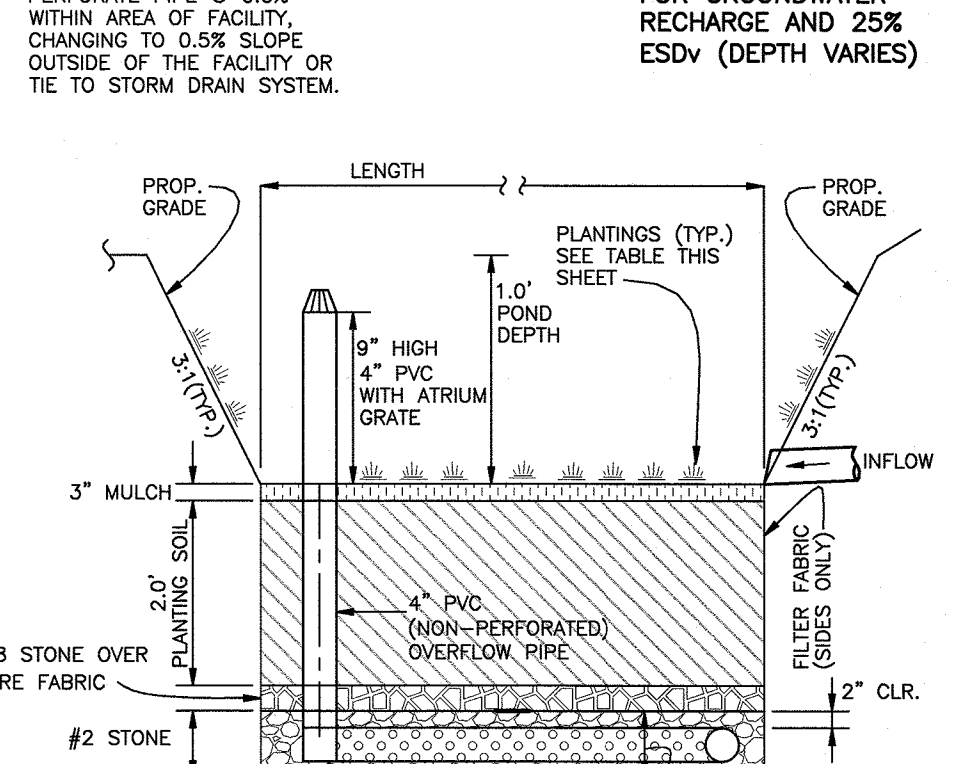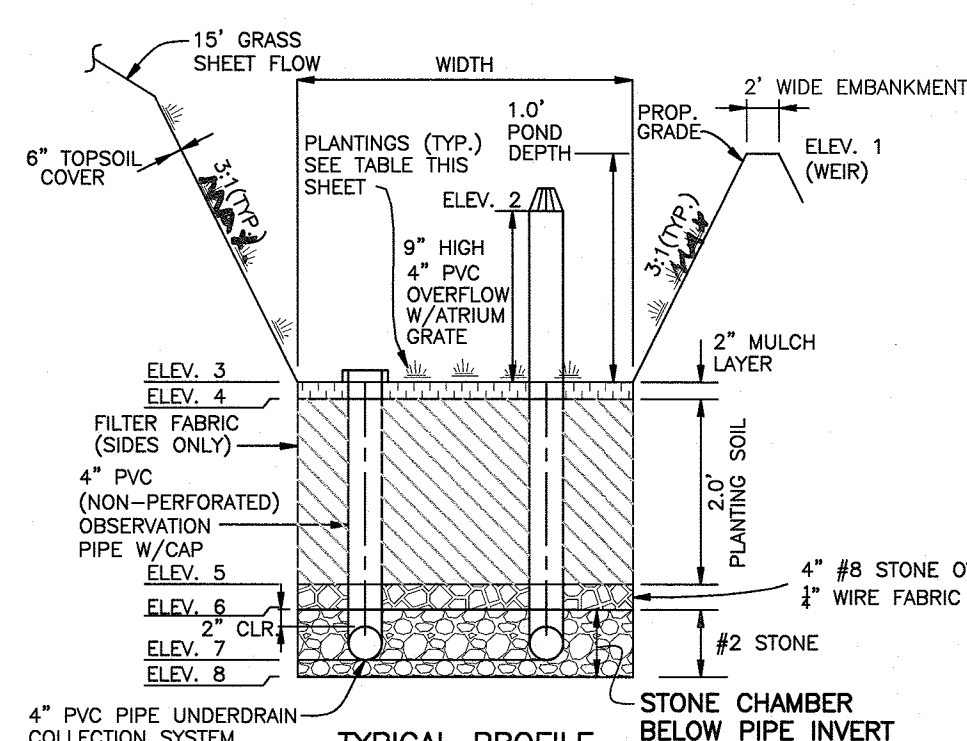

UNDERDRAIN, OVERFLOW AND OUTFALL NOTES

- THE LAST CLEAN-OUT LOCATION WITHIN EACH MICRO-BIORETENTION FACILITY SHALL BE FITTED WITH A NON-CLOGGING SURFACE DRAIN (EXAMPLE: 4" ABS ROOF DRAIN W/ CAST ALUMINUM COME) AT THE POND SURFACE ELEVATION INDICATED IN THE CORRESPONDING TABLE ELEV. 2.
- THE PVC WITHIN THE FACILITY SHALL BE PERFORATED.
- THE UNDER-DRAIN AND PIPE TO OUTFALL SHALL BE INSTALLED TO A MINIMUM DEPTH OF 2' BELOW FINISHED GRADE AND SHALL MAINTAIN A MINIMUM 1% SLOPE AND MAINTAIN A MINIMUM OF 1' OF SEPARATION AT ALL CROSSINGS.

TYPICAL MICRO-BIORETENTION DETAILS

NOT TO SCALE

(M-6) Micro Bio-Retention Landscaping Chart

PLANT NAME	COMMON NAME	TYPE	Surface Area	SIZE	MB#1 QUANTITY	TOTAL QUANTITY
Ilex verticillata	Common Winterberry	Shrub	2.5-3' Ht	3	9	9
Lobelia cardinalis	Cardinal flower	perennial herbaceous plant	quart bulb	59	59	59
Lobelia siphillica	Great Blue Lobelia	perennial herbaceous plant	quart bulb	59	59	59
Carex stricta	Upright Sedge	grass	quart bulb	59	59	59
Blue Water Iris	Blue Water Iris	perennial herbaceous plant	quart bulb	59	59	59
Liilris spicata	Prairie Jay Feather	perennial herbaceous plant	quart bulb	59	59	59

MICRO-BIORETENTION (M-6) PLANTING DATA

- PLANTINGS WITHIN THE PONDING AREA OF THE LS INFILTRATION ARE TO BE OF A MEDIUM TO HIGH WATER TOLERANCE.
 - PLANTINGS ALONG THE PERIMETER (BERM) AREA OF THE LS INFILTRATION ARE TO BE OF A LOW TO MEDIUM WATER TOLERANCE.
- SUGGESTED SPECIES:
CREEPING BUCKLEWEED (ALUGA REPTANS)
COMMON PERENNIAL (ONCA MINOR)
LILY-TURT (LIRIOPE, SP.)
- SUGGESTED SPECIES:(PERENNIALS/ANNUALS)
DAVILEY (THEMOCALLIS SP.)
WHITE GLORY (ASTILE SP.)

MICRO-BIORETENTION (M-6) LANDSCAPE DATA

HYDROLOGIC ZONE 3 - REGULARLY INUNDATED SHORELINE FRINGE (HIGH MARSH)
HYDROLOGIC CONDITION - 0" TO 1"-0" DEEP HARDNESS - TEMPERATURE ZONE 8a (-5" TO 0") SEE SHEET - FOR SEQUENCE OF CONSTRUCTION

NOTE: REFER TO MDE 2000 MD STORMWATER DESIGN MANUAL VOLUMES 1 & 2 FOR LANDSCAPE CONTRACTOR RESPONSIBILITIES, PRACTICES AND MAINTENANCE DUTIES


APPROVED: HOWARD COUNTY DEPARTMENT OF PLANNING AND ZONING

[Signature] 1/2/20
CHIEF, DIVISION OF LAND DEVELOPMENT

[Signature] 1-3-20
CHIEF, DEVELOPMENT ENGINEERING DIVISION

[Signature] 1-3-20
DIRECTOR

BENCHMARK ENGINEERING, INC.
8480 BALTIMORE NATIONAL PIKE & SUITE 315 ELLICOTT CITY, MARYLAND 21043
(P) 410-485-8105 (F) 410-485-8644
WWW.BEI-CVLENGINEERING.COM

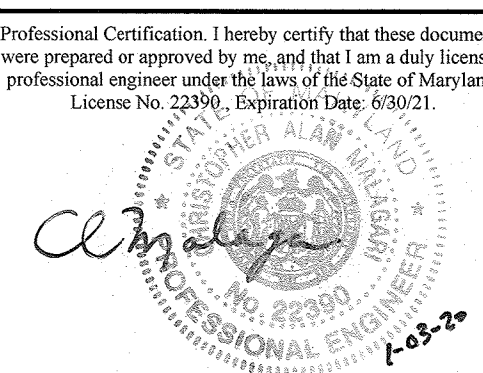


LENNOX PARK CROSBY PROPERTY
LOTS 458-465

TAX MAP: 43 - GRID: 06 - PARCEL: p/0319
ZONED: R-12 (RESIDENTIAL)
ELECTION DISTRICT NO. 1 - HOWARD COUNTY, MARYLAND

DEVELOPER: H&H ROCK COMPANIES
6800 DEERPATH ROAD SUITE 100 ELK RIDGE, MARYLAND 21075

DATE: JANUARY 03, 2020
SCALE: AS SHOWN


BEI PROJECT NO. 2741
SHEET 2 OF 3

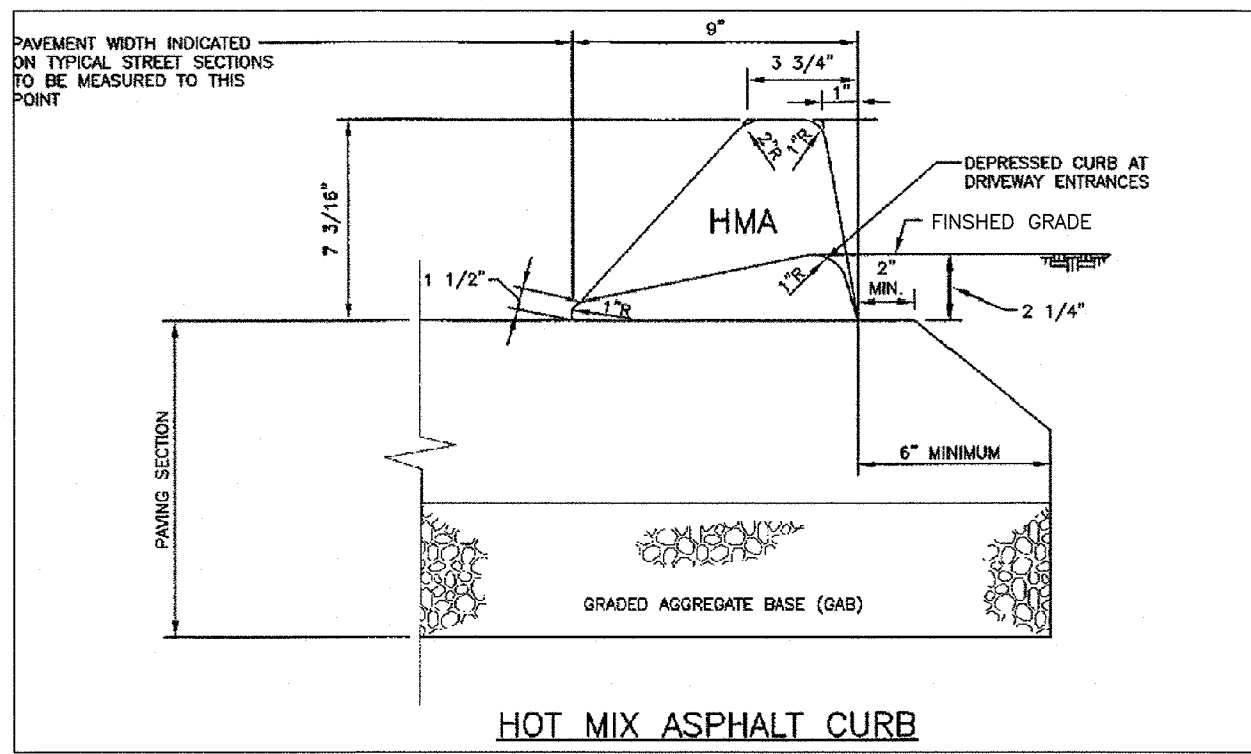

HOT MIX ASPHALT CURB

NOT TO SCALE

THIS DETAIL CONFORMS TO HO.CO. DMV IV R-3.03

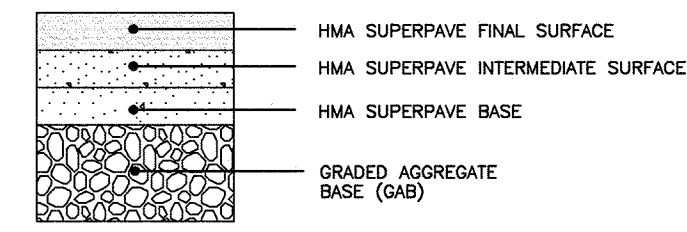


SCHEMATIC PAVING DETAIL

NOT TO SCALE

SECTION NUMBER	ROAD AND STREET CLASSIFICATION	CALIFORNIA BEARING RATIO (CBR)	
		3 to <5	5 to <7
P-2	PARKING DRIVE AISLES: RESIDENTIAL AND NON-RESIDENTIAL WITH NO MORE THAN 10 HEAVY TRUCKS PER DAY LOCAL ROADS: ACCESS DRIVE, ACCESS STREET CUL-DE-SAC: RESIDENTIAL	PAVEMENT MATERIAL (INCHES)	
		HMA SUPERPAVE FINAL SURFACE 9.5 MM PG 64-22, LEVEL 1 (LOW ESAL)	MIN. HMA WITH GAB
		HMA SUPERPAVE INTERMEDIATE SURFACE 9.5 MM PG 64-22, LEVEL 1 (LOW ESAL)	HMA WITH CONSTANT GAB
		HMA SUPERPAVE BASE 9.0 MM PG 64-22, LEVEL 1 (LOW ESAL)	
		8.0	4.0

PAVING SPECIFICATIONS (HO.CO. STD R-2.01)

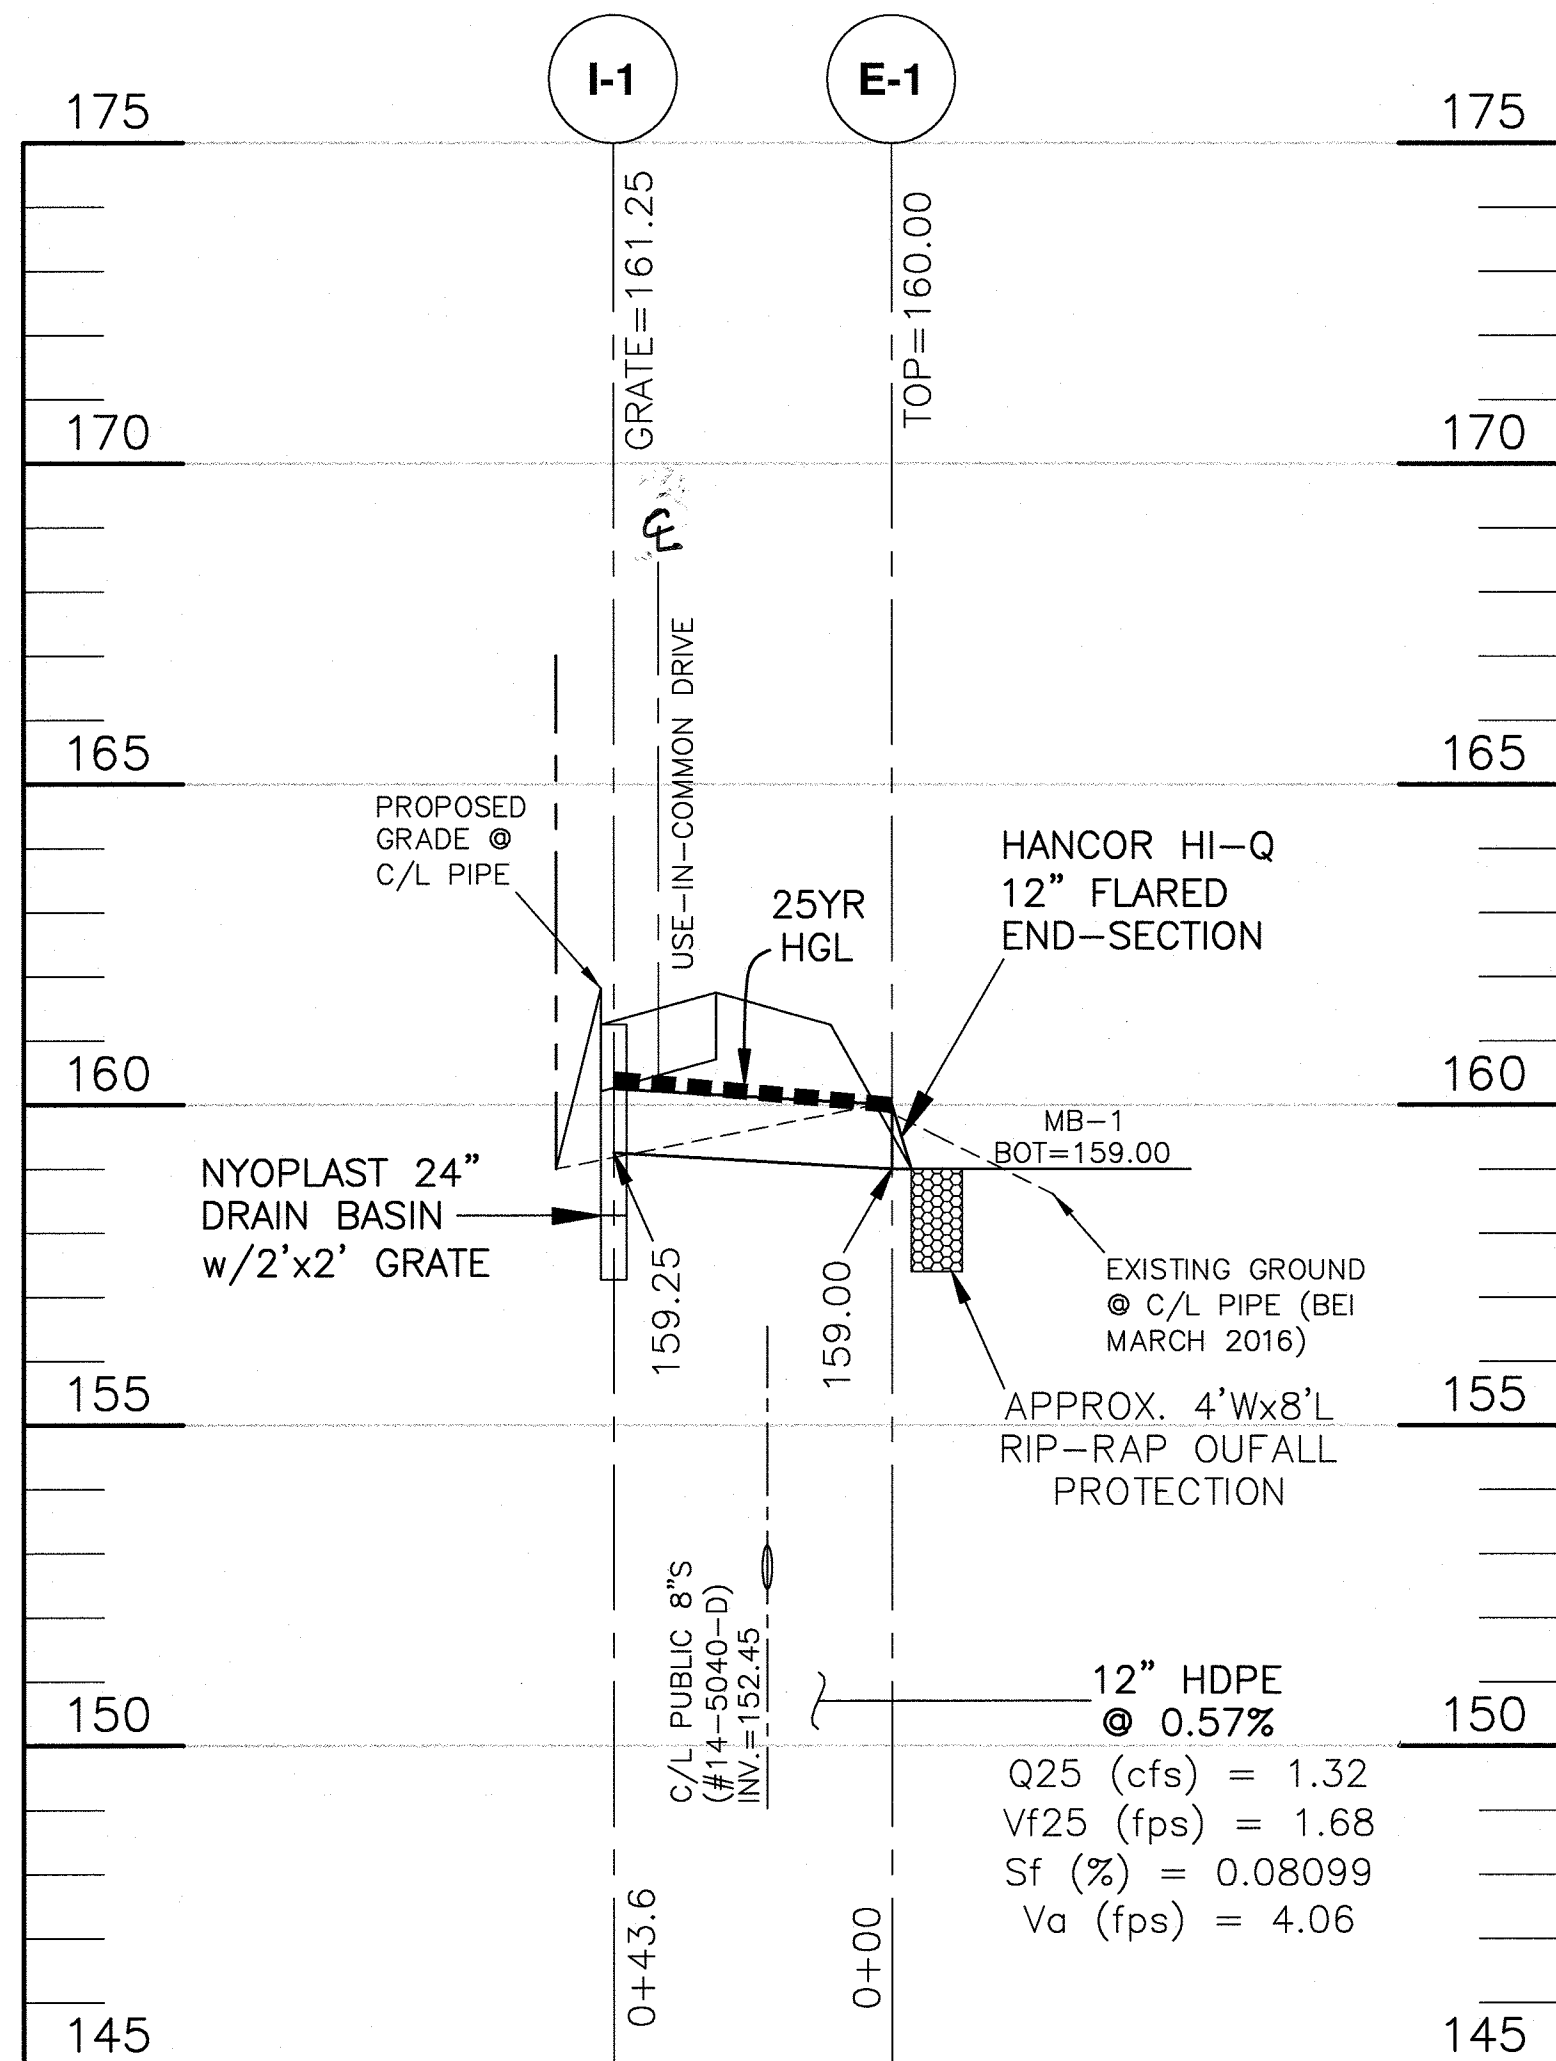

SD PROFILE
HORIZONTAL SCALE: 1" = 30'
VERTICAL SCALE: 1" = 3'

SIZE	TYPE	LENGTH (L.F.)	MAINTENANCE
12"	PVC	43.6	PRIVATE
4" (MB-1)	PVC	26.3	PRVATE

All pipes shall have smooth interior. No interior corrugations.

APPROVED: HOWARD COUNTY DEPARTMENT OF PLANNING AND ZONING

[Signature] 1/3/20
CHIEF, DIVISION OF LAND DEVELOPMENT

[Signature] 1-3-20
CHIEF, DEVELOPMENT ENGINEERING DIVISION




[Signature] 1-3-20
DIRECTOR

STRUCTURE SCHEDULE							
STRUCTURE	TYPE	LOCATION	INVERT IN	INVERT OUT	TOP ELEV.	THROAT ELEV.	STD. DETAIL
I-1	NDS 24"x24"	N 549,728.7314 E 1,382,669.8137			159.25	161.25	Manufacturer Specs. PRIVATE
MANHOLES							
HEADWALLS/END SECTIONS							
ES-1	HDPE End Section	N 549,702.1827 E 1,382,704.3474			159.00	160.00	Manufacturer Specs. PRIVATE

STRUCTURE LOCATION FOR MANHOLES IS AT THE CENTER OF THE MANHOLE RIM.
STRUCTURE LOCATION FOR END SECTIONS IS AT THE MIDPOINT OF THE END OF THE STRUCTURE.
PRECAST STRUCTURES MEETING HS-20 LOADING MAY BE USED.

LEGEND

SOILS CLASSIFICATION	Abc1
SOILS DELINEATION	---
EXISTING CONTOURS	---999---
PROPOSED CONTOURS	---999---
EXISTING WOODS LINE	~~~~~
PROPOSED WOODS LINE	~~~~~
EXISTING STRUCTURE	[Symbol]
PROPOSED STRUCTURE	[Symbol]
SD DRAINAGE AREA	[Symbol]
PUBLIC WATER, SEWER, & UTILITY AND PRIVATE USE-IN-COMMON ACCESS EASEMENT	[Symbol]
PUBLIC SEWER & UTILITY EASEMENT	[Symbol]
PRIVATE DRAINAGE & UTILITY EASEMENT	[Symbol]

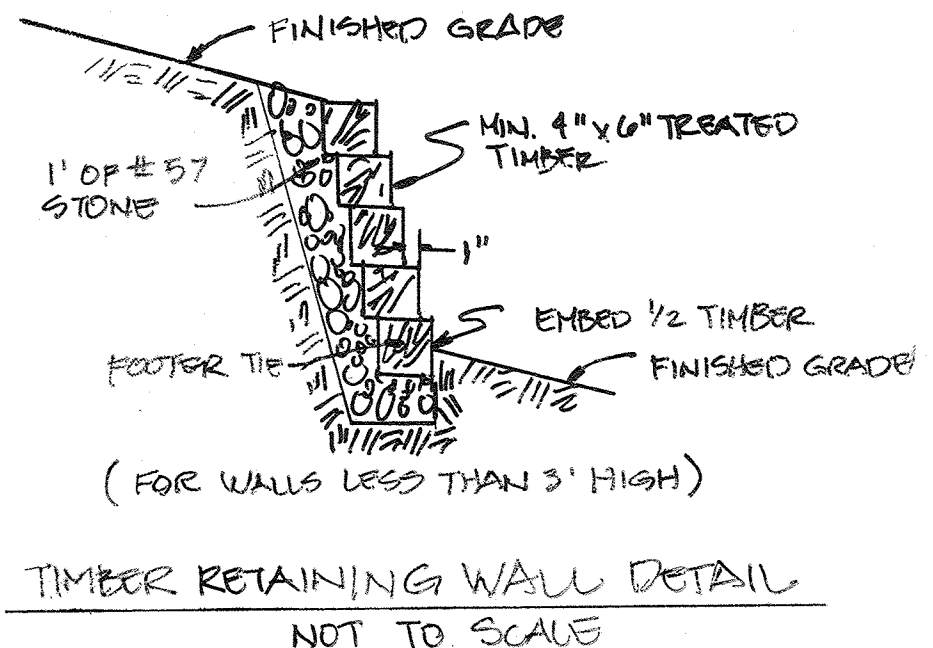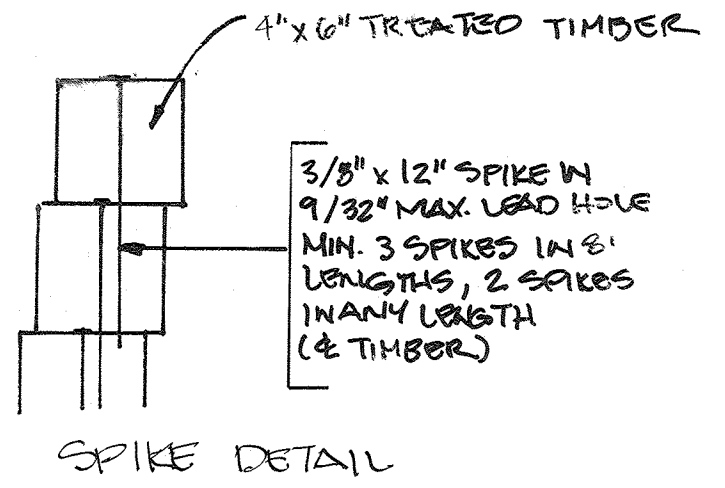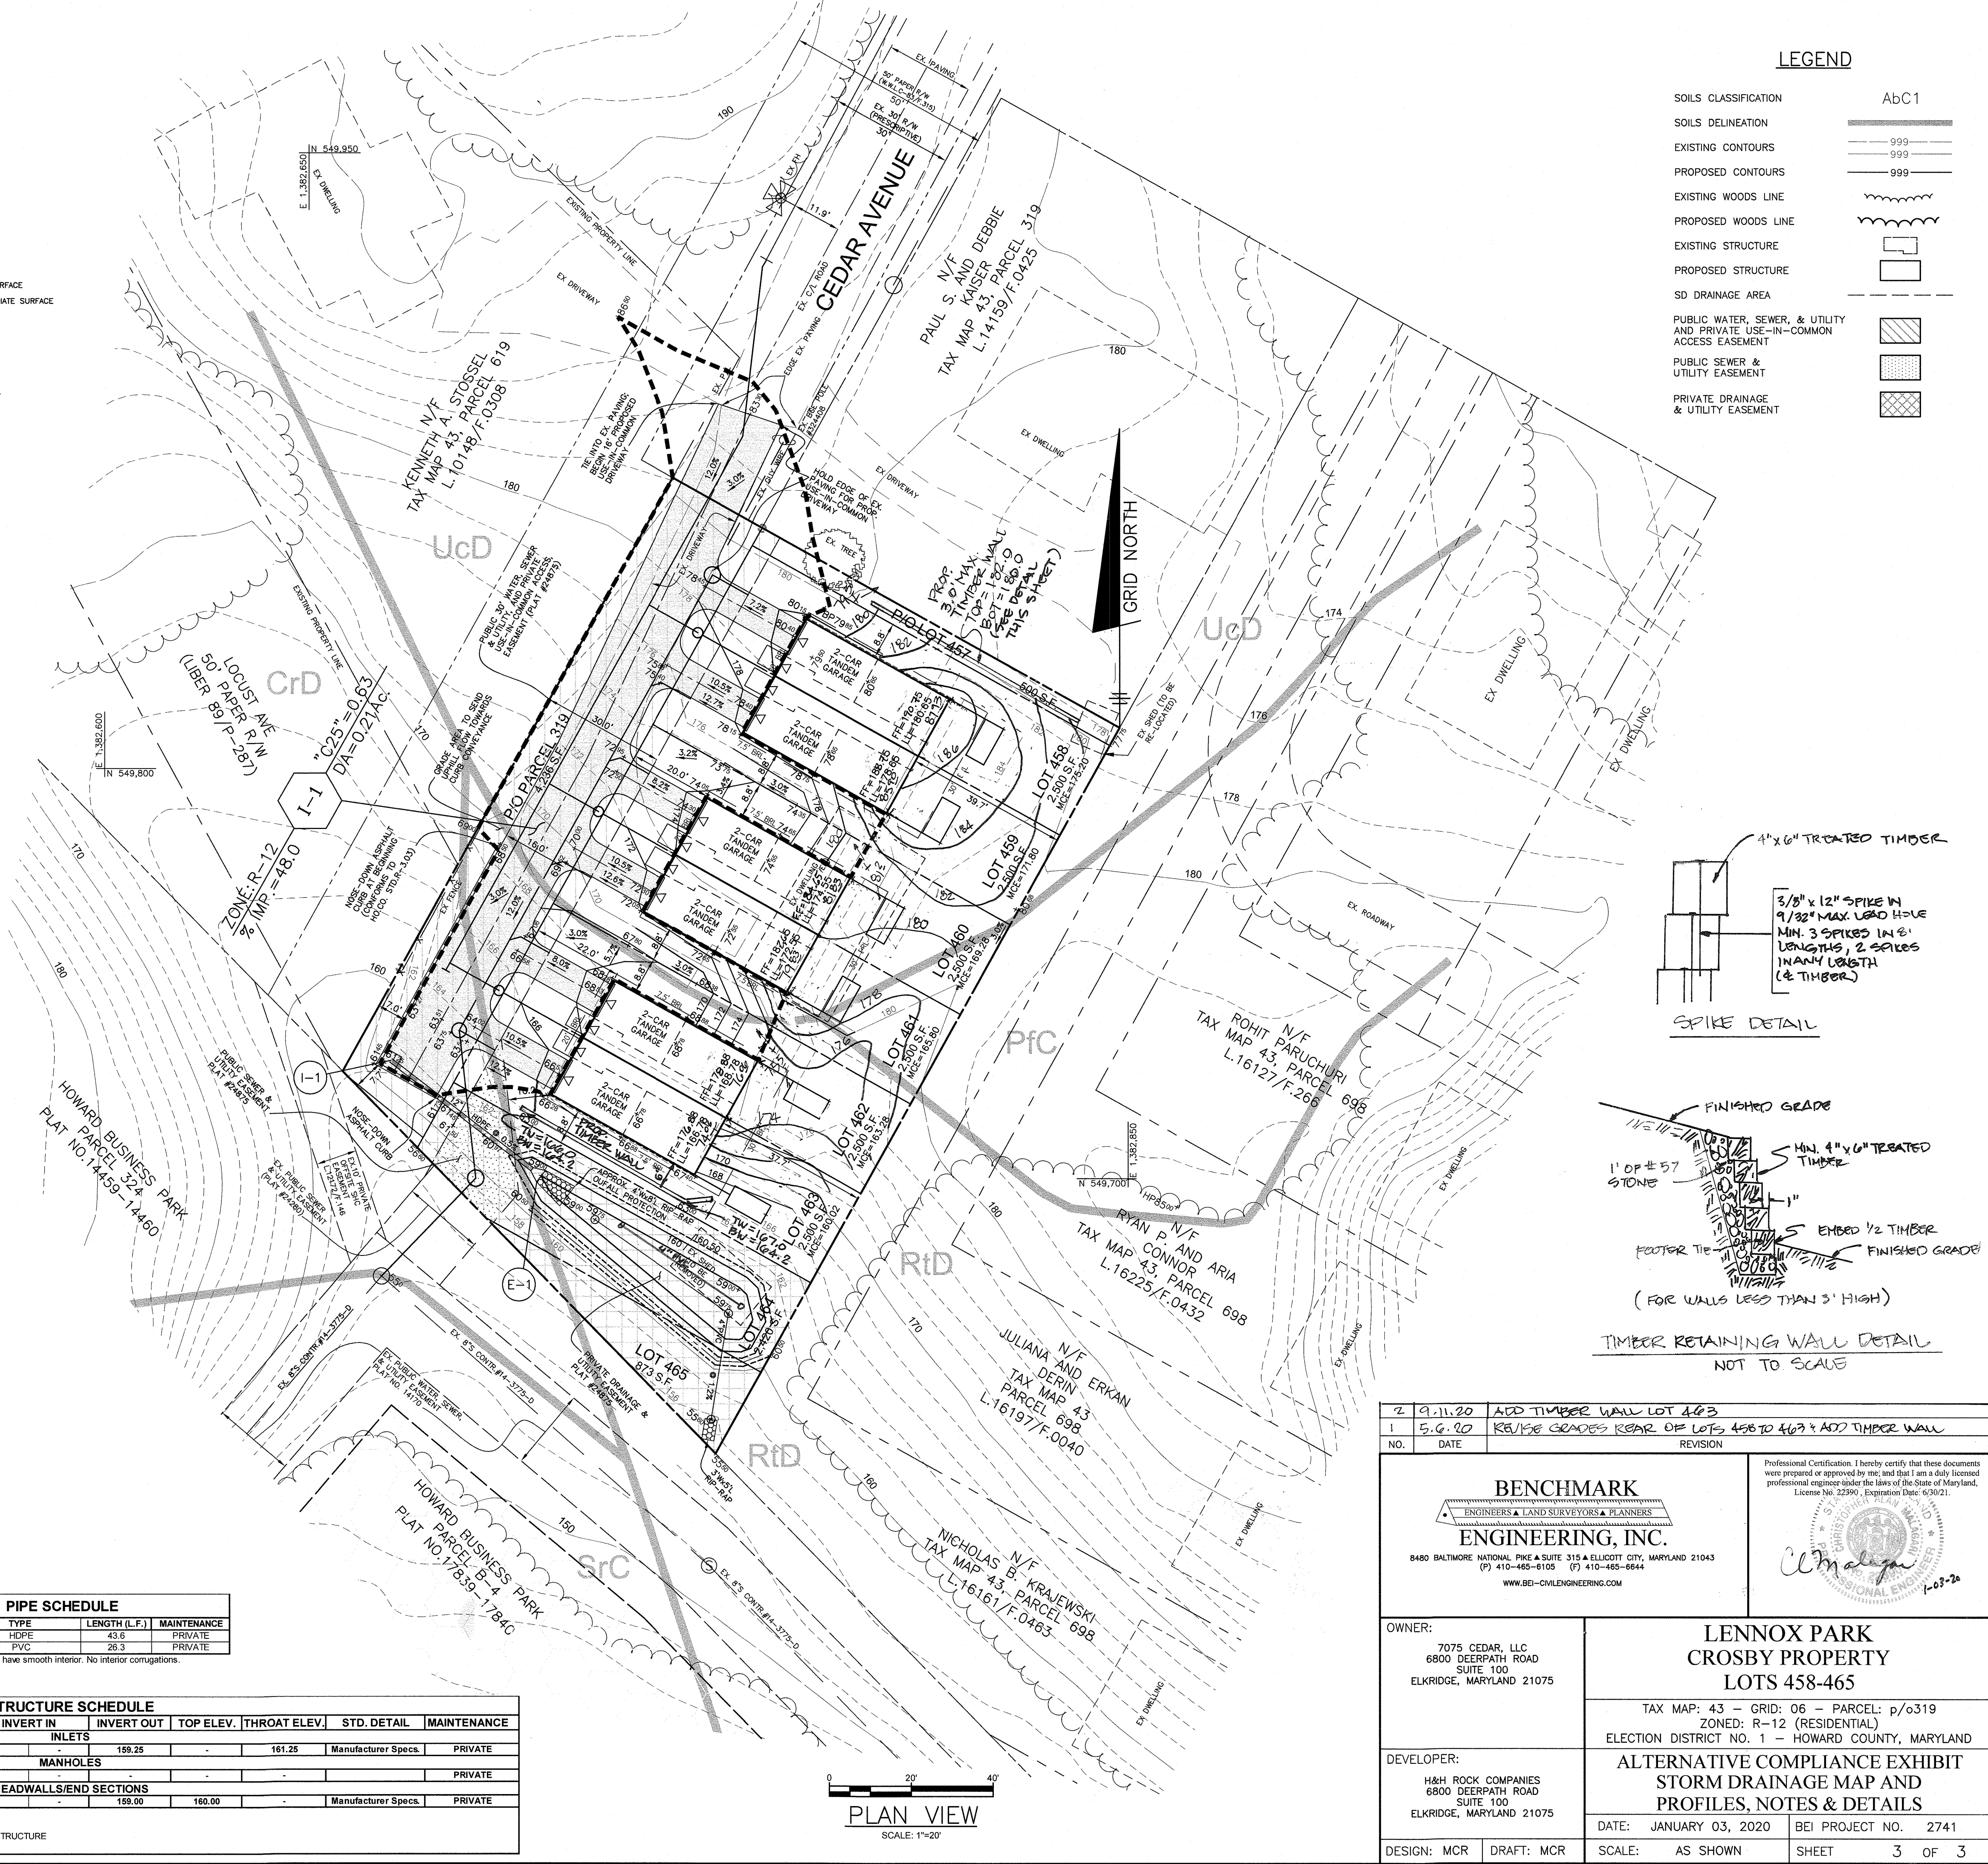

NO.	DATE	REVISION
2	9.11.20	ADD TIMBER WALL LOT 463
1	5.6.20	REVISE GRADES REAR OF LOTS 458 TO 463 & ADD TIMBER WALL

BENCHMARK ENGINEERING, INC.
8400 BALTIMORE NATIONAL PIKE & SUITE 315 & ELLICOTT CITY, MARYLAND 21043
(P) 410-485-6105 (F) 410-465-6644
WWW.BE-CIVILENGINEERING.COM

Professional Certification. I hereby certify that these documents were prepared or approved by me, and that I am a duly licensed professional engineer under the laws of the State of Maryland, License No. 22990, Expiration Date: 6/30/21.

[Signature]

OWNER: 7075 CEDAR, LLC 6800 DEERPATH ROAD SUITE 100 ELKRIDGE, MARYLAND 21075	LENOX PARK CROSBY PROPERTY LOTS 458-465 TAX MAP: 43 - GRID: 06 - PARCEL: p/0319 ZONED: R-12 (RESIDENTIAL) ELECTION DISTRICT NO. 1 - HOWARD COUNTY, MARYLAND
DEVELOPER: H&H ROCK COMPANIES 6800 DEERPATH ROAD SUITE 100 ELKRIDGE, MARYLAND 21075	ALTERNATIVE COMPLIANCE EXHIBIT STORM DRAINAGE MAP AND PROFILES, NOTES & DETAILS DATE: JANUARY 03, 2020 BEI PROJECT NO. 2741
DESIGN: MCR DRAFT: MCR	SCALE: AS SHOWN SHEET 3 OF 3


GENERAL NOTES

1. THE TOPOGRAPHY SHOWN HEREON IS BASED ON A FIELD RUN SURVEY DATED FEBRUARY, 2016 BY BENCHMARK ENGINEERING, INC. THE BOUNDARY SHOWN HEREON IS BASED ON BOUNDARY SURVEY PREPARED BY BENCHMARK ENGINEERING INC., DATED MARCH, 2016.
2. THE PROPERTY IS KNOWN AS TAX MAP 43, GRID 06, PARCEL 319. THIS INCLUDES LOTS 458-465, P/O LOT 457, AND A PORTION OF CEDAR AVENUE. THE TOTAL PROPERTY AREA IS APPROXIMATELY 0.53 ACRES.
3. THE PROPERTY IS ZONED R-12 PER THE 10.06.13 COMPREHENSIVE ZONING PLAN.
4. THE EXISTING HOUSE LOCATED ON THE PROPERTY IS TO BE REMOVED; THE EXISTING DRIVEWAY WILL BE IMPROVED TO A 16' WIDE USE-IN-COMMON DRIVE TO PROVIDE ACCESS FOR THE DEVELOPMENT. THE APPROXIMATE LIMIT OF DISTURBANCE = 25,420 SF
5. STORMWATER MANAGEMENT FOR THIS SITE WILL BE PROVIDED BY DRYWELLS FOR THE ROOFTOPS AND MICRO-BIORETENTION FOR THE DRIVEWAYS AND USE-IN-COMMON DRIVE.
6. THESE LOTS ARE EXISTING LOTS KNOWN AS LENNOX PARK RECORDED AS PLATBOOK 83 PAGE 315 DATED FEBRUARY 4, 1907.
7. A TRAFFIC STUDY IS NOT REQUIRED FOR THIS DEVELOPMENT SINCE THE LOTS ARE EXISTING AND NO NEW LOTS ARE TO BE CREATED.
8. TO THE BEST OF OUR KNOWLEDGE AND AVAILABLE DATA, THERE ARE NO FLOODPLAINS, STREAMS, OR STEEP SLOPES LOCATED ON THIS SITE.
9. THERE ARE NO WETLANDS ON-SITE PER AN ENVIRONMENTAL FIELD INVESTIGATION PERFORMED BY HILLS-CARNES ENGINEERING ASSOCIATES, INC. ON JANUARY, 2017.
10. THERE ARE NO SPECIMEN TREES OR FORESTED AREAS ON-SITE PER A SIMPLIFIED FOREST STAND DELINEATION PERFORMED BY BENCHMARK ENGINEERING, INC. ON FEBRUARY, 2017.
11. A GEOTECHNICAL INVESTIGATION WAS PERFORMED HILLS-CARNES ENGINEERING ASSOCIATES, INC. WHICH DETERMINED THAT THE ON-SITE SOILS ARE ACCEPTABLE FOR THE PROPOSED ESD PRACTICES.
12. A NOISE STUDY IS NOT REQUIRED FOR THIS PROPERTY SINCE IT IS NOT IN THE AIRPORT NOISE ZONE AND IS MORE THAN 500' FROM A RAIL LINE.
13. LOTS 458 THRU 463 WILL BE DEVELOPED WITH SINGLE-FAMILY SEMI-DETACHED UNITS; LOTS 464 TO 465 WILL BE UTILIZED FOR ESD-SWM; AND THE REMAINING PORTION OF PARCEL WILL BE UTILIZED FOR A USE-IN-COMMON DRIVEWAY AND UTILITIES.
14. THIS PLAN IS SUBJECT TO AN ALTERNATIVE COMPLIANCE WP-17-085 APPROVED NOVEMBER 14, 2017 TO SECTION 16.155(o)(2) RESIDENTIAL: NEW RESIDENTIAL DEVELOPMENT REQUIRING APPROVAL OF A SITE DEVELOPMENT PLAN FOR SIX SEMI-DETACHED DUPLEX UNITS APPROVAL IS SUBJECT TO THE FOLLOWING CONDITIONS:
 1. THE DED COMMENTS DATED NOVEMBER 13, 2017.
 2. THE ALTERNATIVE COMPLIANCE EXHIBIT SHALL SERVE AS A SUBSTITUTE FOR A SITE DEVELOPMENT PLAN FOR DEVELOPMENT. ALL IMPROVEMENTS SHOWN ON THE EXHIBIT MUST BE CONSTRUCTED PER THE PLAN EXHIBITS SUBMITTED DATED OCTOBER 7, 2017. THE REVISED ALTERNATIVE COMPLIANCE PLAN EXHIBIT SHALL BE SUBMITTED AS AN ORIGINAL MYLAR AND RECEIVE SIGNATURE APPROVAL FROM THE DEPARTMENT OF PLANNING & ZONING, PRIOR TO APPLYING FOR PERMITS. THE ORIGINAL MYLAR PLAN EXHIBIT SHALL BE SUBMITTED WITHIN 45 DAYS OF THIS LETTER (ON OR BEFORE DECEMBER 29, 2017)
 3. COMPLIANCE WITH ALL APPLICABLE COUNTY & STATE REGULATIONS, AND OBTAIN ALL NECESSARY PERMITS FROM THE DEPARTMENT OF INSPECTIONS, LICENSES & PERMITS, PRIOR TO INITIATING DEVELOPMENT ON-SITE

- NOTE: WP-17-085 HAS SINCE EXPIRED AND A NEW ALTERNATIVE COMPLIANCE IS BEING REQUESTED VIA THIS PLAN EXHIBIT AND APPLICATION.

LEGEND

- SOILS CLASSIFICATION AbC1
- SOILS DELINEATION
- EXISTING CONTOURS
- PROPOSED CONTOURS
- EXISTING WOODS LINE
- PROPOSED WOODS LINE
- EXISTING STRUCTURE
- PROPOSED STRUCTURE
- LIMIT OF DISTURBANCE
- PUBLIC WATER, SEWER, & UTILITY AND PRIVATE USE-IN-COMMON ACCESS EASEMENT
- PUBLIC SEWER & UTILITY EASEMENT
- PRIVATE DRAINAGE & UTILITY EASEMENT

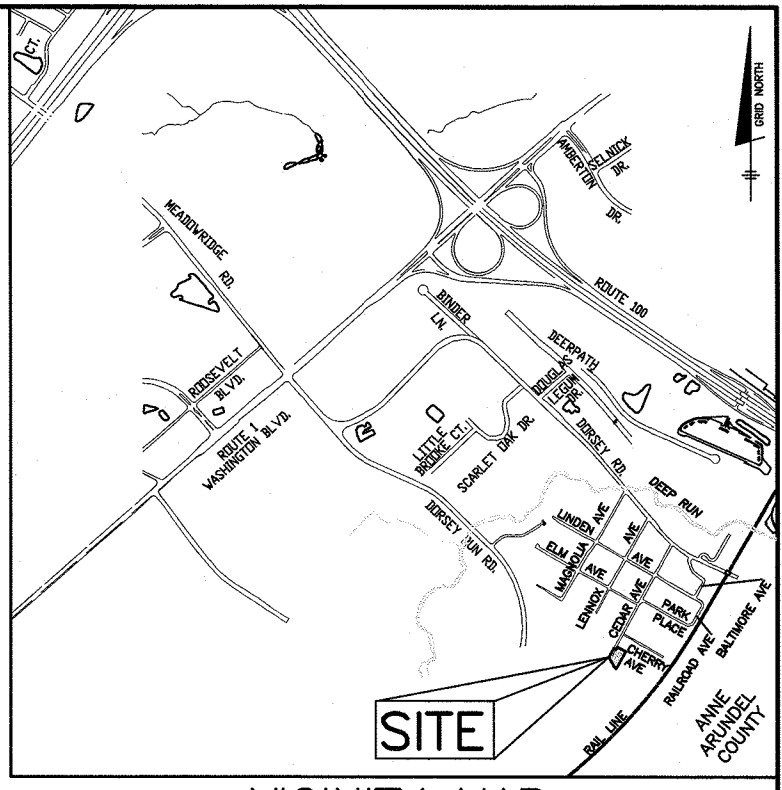

VICINITY MAP
SCALE: 1" = 2000'
ADC MAP NO. 35 GRID B6

NARRATIVE



The Lennox Park, Crosby Property Lots 458-465, Elkrige, Maryland comprises approximately 0.53 acres. The property is zoned R-12 and is located on the southeast side of Cedar Avenue at its terminus point adjoining the Howard Business Park. Access will be provided by a Use-In-Common Drive constructed from the existing edge of paving of Cedar Avenue. The proposed development shall consist of 3 Semi-Detached Dwellings containing 6 units total. The project is located within an existing neighborhood known as Lennox Park. The site drains from the northeast to the southwest and is conveyed off site through an off swale on the adjoining property. The project lies within the Patapsco River watershed (02-13-09) and the use is I-P.

The NRCS soils in the location of this development are mostly Hydrologic Group 'C' & 'D'. Other Lots within close proximity of this site have indicated 'B' type soils. A Geotechnical Investigation was performed by Hills-Carnes Engineering Associates, Inc. on January, 2017. There are no Specimen Trees or Forested areas on-site per a Simplified Forest Stand Delineation performed by Benchmark Engineering, Inc., on February, 2017.

This site was analyzed as woods in good condition and a target RCN was determined. A target rainfall depth treatment (Pe) was determined based on the measured impervious areas and HSG soil types (mostly 'C' & 'D'). The target Pe for this site is 1.8 inches based on the overall proposed drainage area. Full treatment of the target 1.8" Pe will be provided using Environmental Site Design practices as outlined in Chapter 5 of the 2000 Maryland Stormwater Design Manual, as amended by Maryland's Stormwater Management Act of 2007. The selected methods include Drywells (M-5) for the entire rooftop for each unit and a Micro-Bioretenion (M-6) for the driveways. The facilities will be privately owned and maintained.


To protect natural resources, it is important to minimize and adequately treat the stormwater runoff. The final design will incorporate adequate treatment and storage in order to create the least possible stormwater runoff in general compliance with this concept plan. The runoff will be treated on-site using approved methods. Outfalls generally correspond with the natural drainage patterns for the site.

The proposed development and ESD implementation should have no effect on adjacent properties as treatment of the target Pe in the development runoff conditions meet the existing runoff. The proposed development is not expected to have adverse effects on downstream properties, utilities, public facilities or natural systems since natural drainage pathways are maintained. Preliminary ESD practices have been designed to address 1.8 inches of runoff, the target Pe, for all area which could be conveyed to a facility. We believe this plan provides environmental site design to the maximum extent possible.

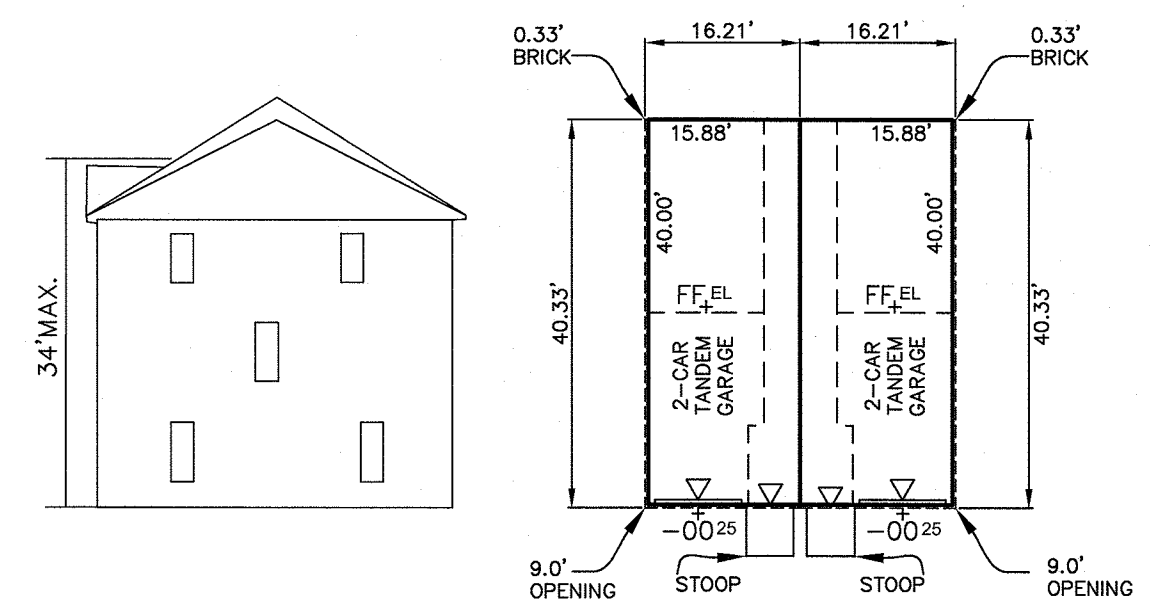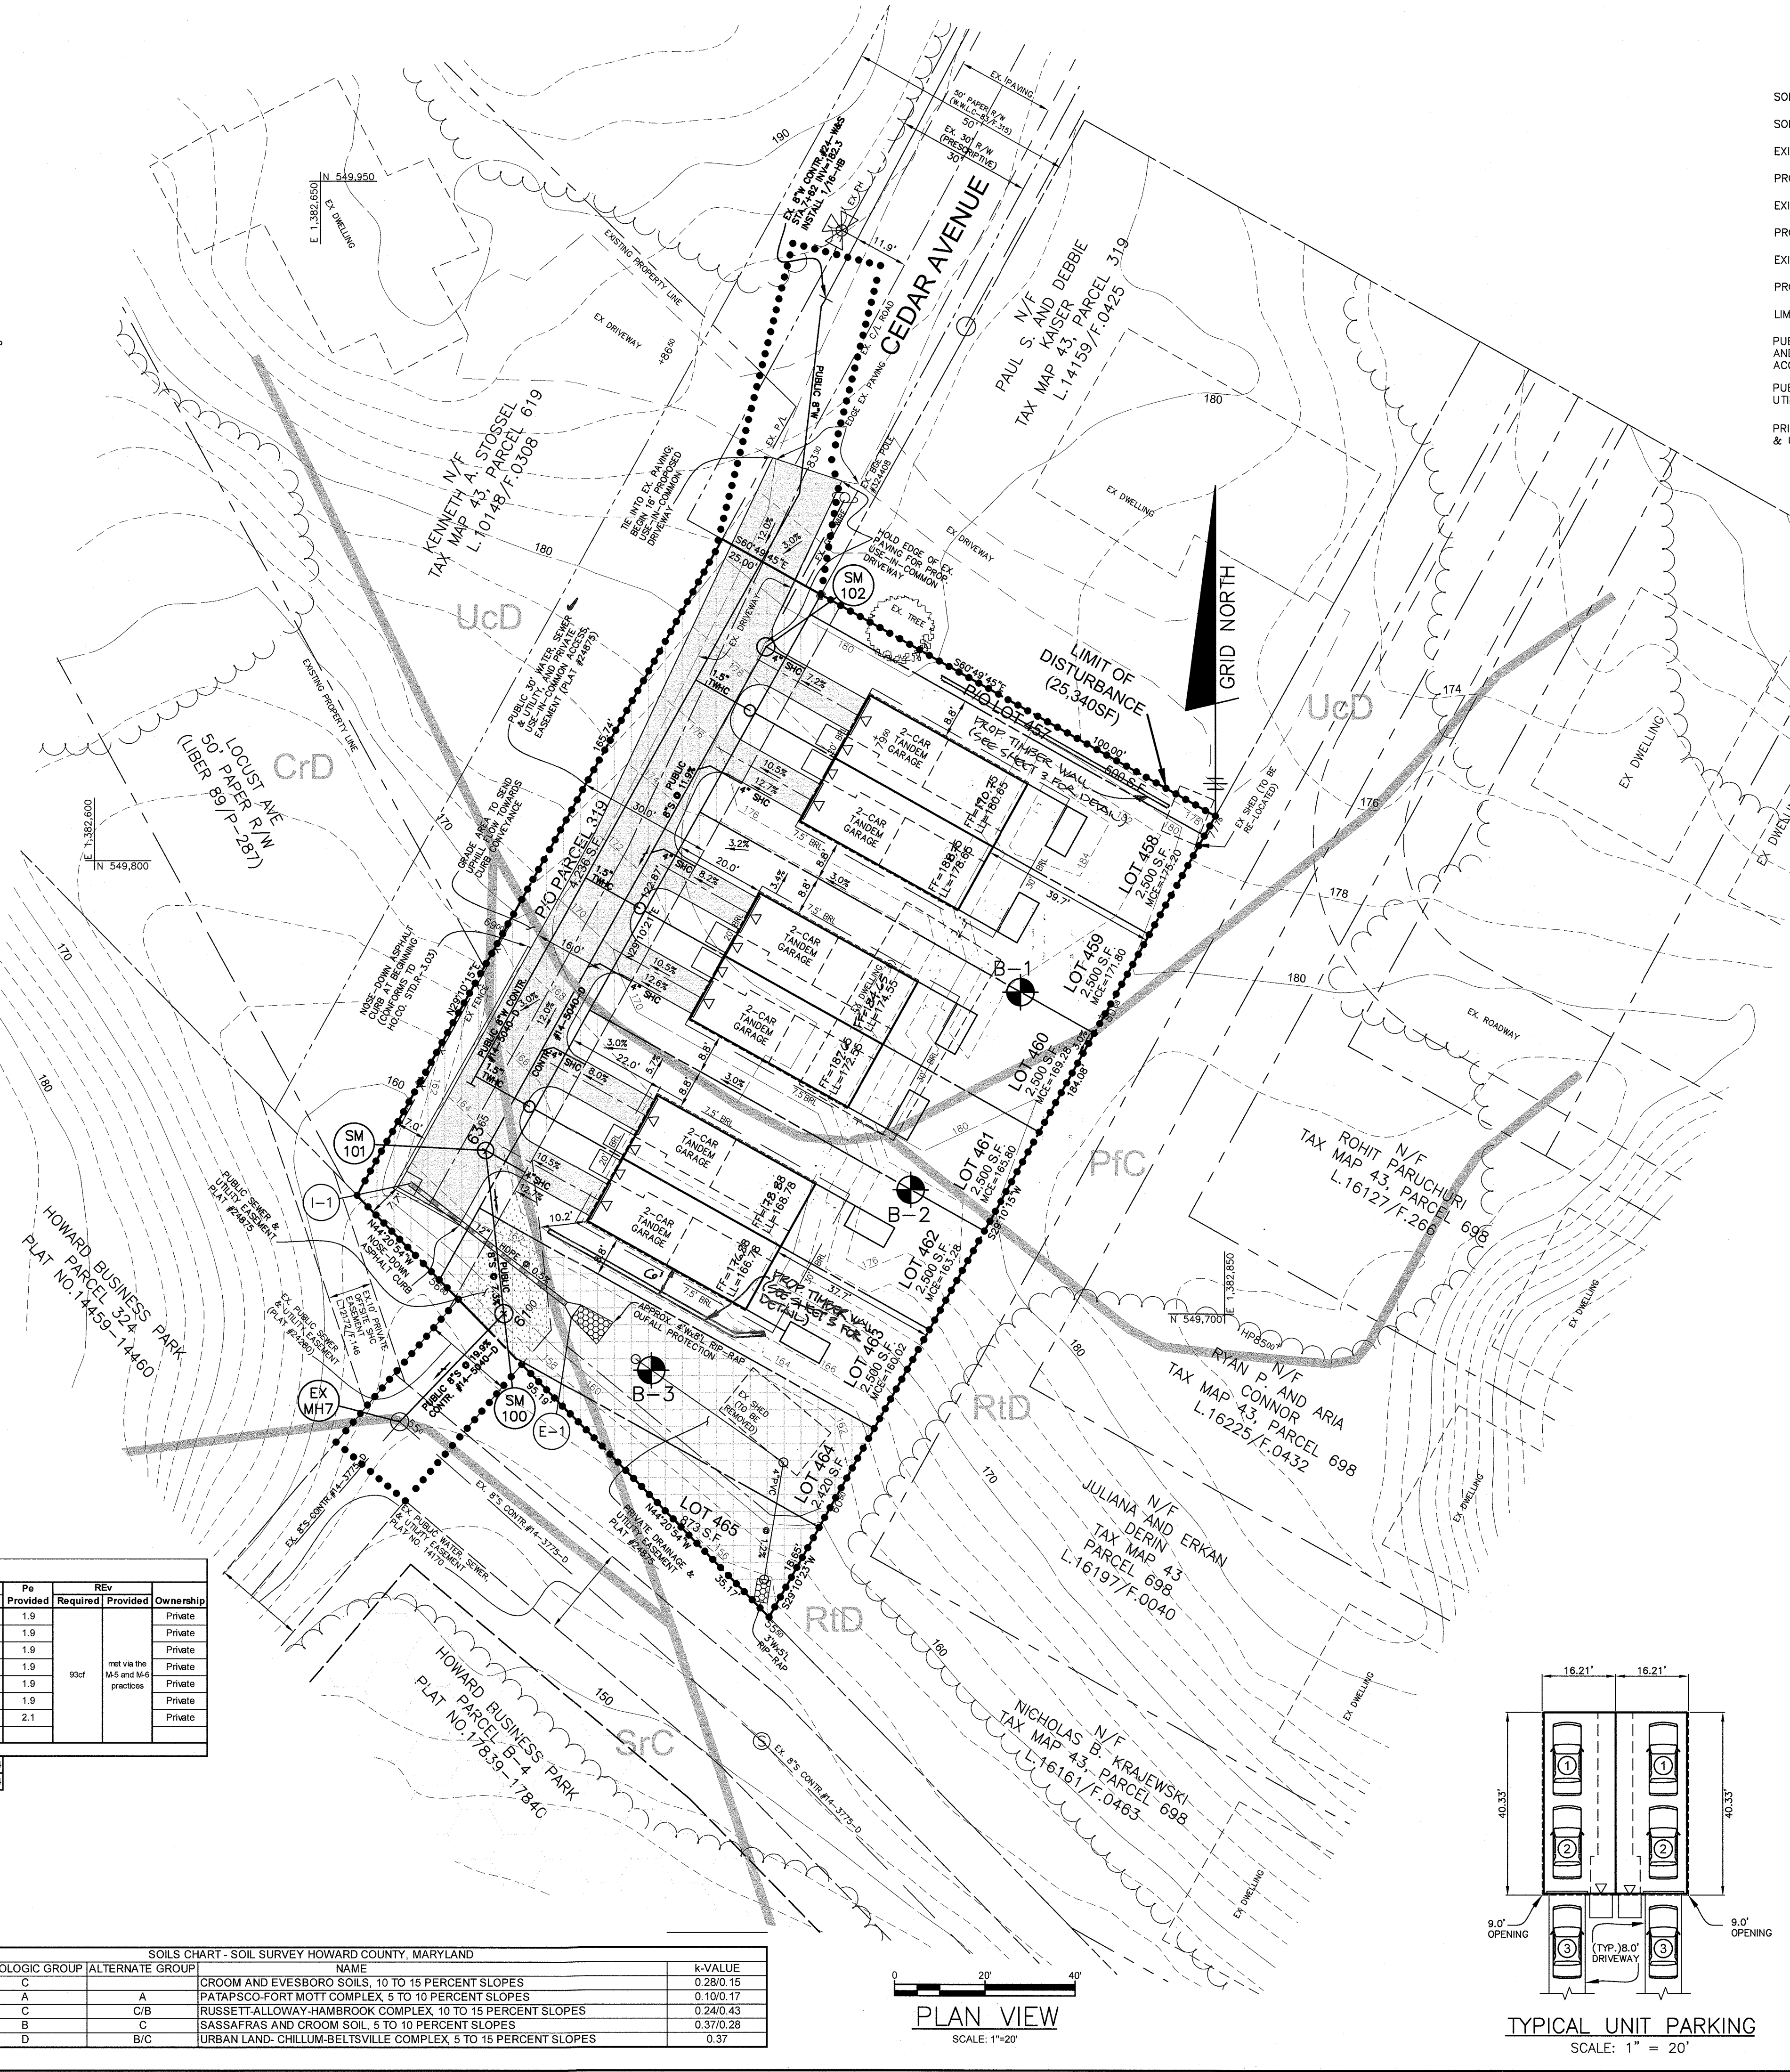

CLARENDON (MODIFIED DOUBLE END UNIT)

TYPICAL HOUSE FOOTPRINT
SCALE: 1" = 20'

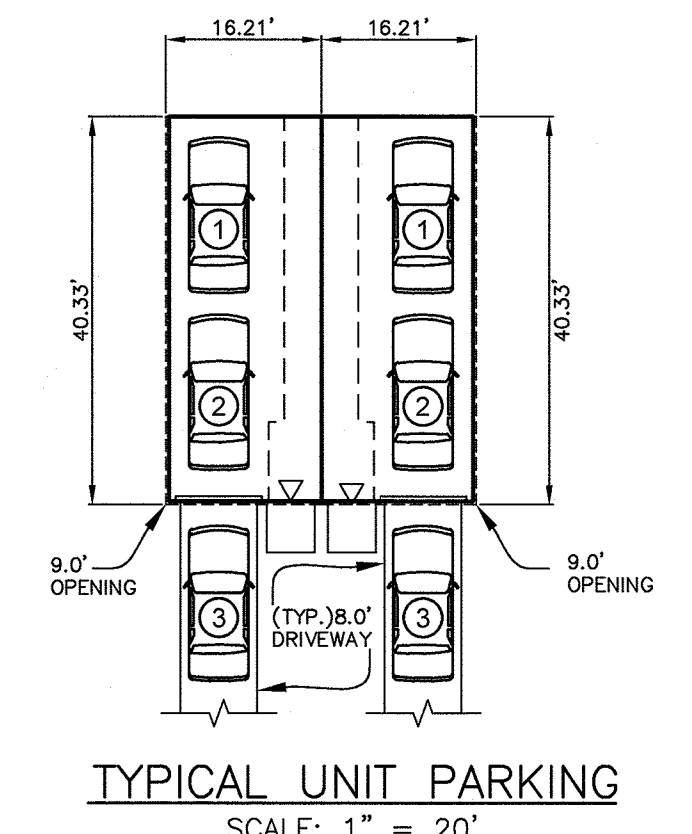

TYPICAL UNIT PARKING
SCALE: 1" = 20'

Practice	DA (sf)	Imp Area (sf)	%	Rv	Pe required	Required	At (sf)	Z/DAT	ESDv (cf)	Provided	Pe	Rev	Ownership
(M-6) Drywall	LOT 458	652	652	100%	0.95	1.8	50	50	PASS	93	100	1.9	Private
(M-6) Drywall	LOT 459	652	652	100%	0.95	1.8	50	50	PASS	93	100	1.9	Private
(M-6) Drywall	LOT 460	652	652	100%	0.95	1.8	50	50	PASS	93	100	1.9	Private
(M-6) Drywall	LOT 461	652	652	100%	0.95	1.8	50	50	PASS	93	100	1.9	Private
(M-6) Drywall	LOT 462	652	652	100%	0.95	1.8	50	50	PASS	93	100	1.9	Private
(M-6) Drywall	LOT 463	652	652	100%	0.95	1.8	50	50	PASS	93	100	1.9	Private
(M-6) Micro-Bioretenion	MB-1	18,384	4,400	24%	0.27	1.8	368	446	PASS	744	854	2.1	Private
Totals per individual Drainage Area		22,296	8,402	40%	0.41					1301	1454		
Totals per Overall Site		26,125	8,414	35%	0.37	1.8				1332	1454		

Notes:
1. The Pe required column is based on total site Pe calculation. The Rv is based on individual drainage area percent impervious (per DED)
2. The ESDv Required for the (M-6) practices is based on 75% of ESDv.

APPROVED: HOWARD COUNTY DEPARTMENT OF PLANNING AND ZONING
 DATE: 1/3/20
 DATE: 1-3-20
 DATE: 1-3-20

SYMBOL	HYDRIC	HYDROLOGIC GROUP	ALTERNATE GROUP	NAME	k-VALUE
C/D		C	A	CROOM AND EVESBORO SOILS, 10 TO 15 PERCENT SLOPES	0.28/0.15
P/C		A	A	PATAPSCO-FORT MOTT COMPLEX 5 TO 10 PERCENT SLOPES	0.10/0.17
R/D		C	C/B	RUSSETT-ALLOWAY-HAMBROOK COMPLEX 10 TO 15 PERCENT SLOPES	0.24/0.43
S/C		C	C	SASSAFRAS AND CROOM SOIL, 5 TO 10 PERCENT SLOPES	0.37/0.28
U/D		D	B/C	URBAN LAND-CHILLUM-BELTSVILLE COMPLEX 5 TO 15 PERCENT SLOPES	0.37

2	9.11.20	ADD TIMBER WALL TO LOT 463	
1	5.10.20	REVISE GRADES REAR OF LOTS 458 TO 463	
NO.	DATE	REVISION	
<p>8480 BALTIMORE NATIONAL PIKE A SUITE 315 A ELLICOTT CITY, MARYLAND 21043 (P) 410-485-8105 (F) 410-485-8644 WWW.BEI-CIVILENGINEERING.COM</p>			Professional Certification. I hereby certify that these documents were prepared or approved by me and that I am a duly licensed professional engineer under the laws of the State of Maryland. License No. 22390, Expiration Date: 6/30/21.
OWNER:		LENNOX PARK CROSBY PROPERTY LOTS 458-465	
7075 CEDAR, LLC 6800 DEERPATH ROAD SUITE 100 ELKRIDGE, MARYLAND 21075		TAX MAP: 43 - GRID: 06 - PARCEL: p/o319 ZONED: R-12 (RESIDENTIAL) ELECTION DISTRICT NO. 1 - HOWARD COUNTY, MARYLAND	
DEVELOPER:		ALTERNATIVE COMPLIANCE EXHIBIT & SIMPLIFIED ECP	
H&H ROCK COMPANIES 6800 DEERPATH ROAD SUITE 100 ELKRIDGE, MARYLAND 21075		DATE: JANUARY 03, 2020 SCALE: AS SHOWN	
DESIGN: MCR	DRAFT: MCR	BEI PROJECT NO. 2741	SHEET 1 OF 3

CONSTRUCTION SPECIFICATIONS

B.4.C Specifications for Micro-Bioretentation, Rain Gardens, Landscape Infiltration & Infiltration Berms

1. Material Specifications:

The allowable materials to be used in these practices are detailed in Table B.4.1.

2. Filtering Media or Planting Soil:

The soil shall be a uniform mix, free of stones, stumps, roots or other similar objects larger than two inches. No other materials or substances shall be mixed or dumped within the micro-bioretentation practice that may be harmful to plant growth...

The planting soil shall be tested and shall meet the following criteria:

- Soil Component - Loamy Sand or Sandy Loam (USDA Soil Textural Classification)
Organic Content - Minimum 10% by dry weight (ASTM D 2974). In general, this can be met with a mixture of loamy and (60%-85%) and compost (35% to 40%) or sandy loam (30%), coarse sand (30%), and compost (40%).
Clay Content - Media shall have a clay content of less than 5%.
pH Range - Should be between 5.5 - 7.0. Amendments (e.g., lime, iron sulfate plus sulfur) may be mixed into the soil to increase or decrease pH.

There shall be at least one soil test per project. Each test shall consist of both the standard soil test for pH, and additional tests of organic matter, and soluble salts. A textural analysis is required from the site stockpiled topsoil. If topsoil is imported, then a texture analysis shall be performed for each location where the topsoil was excavated.

3. Compaction:

It is very important to minimize compaction of both the base of bioretention practices and the required backfill. When possible, use excavation hoers to remove original soil. If practices are excavated using a loader, the contractor should use wide track or marsh track equipment...

Compaction can be alleviated at the base of the bioretention facility by using a primary tilling operation such as a chisel plow, ripper, or subsoiler. These tilling operations are to restructure the soil profile through the 12 inch compaction zone. Substitute methods must be approved by the engineer.

Rototill 2 to 3 inches of sand into the base of the bioretention facility before backfilling the optional sand layer. Pump any ponded water before preparing (rototilling) base.

When backfilling the topsoil over the sand layer, first place 3 to 4 inches of gravel over the sand, then rototill the sand/topsoil to create a gradation zone. Backfill the remainder of the topsoil to final grade.

When backfilling the bioretention facility, place soil in lifts 12" to 18". Do not use heavy equipment within the bioretention basin. Heavy equipment can be used around the perimeter of the basin to supply soils and sand. Grade bioretention materials with light equipment such as a compact loader or a dozer/loader with marsh tracks.

4. Plant Material:

Recommended plant material for micro-bioretentation practices can be found in Appendix A, Section A.2.3.

5. Plant Installation:

Compost is a better organic material source, is less likely to float, and should be placed in the invert and other low areas. Mulch should be placed in surrounding to a uniform thickness of 2" to 3". Shredded or chipped hardwood mulch is the only acceptable mulch. Pine mulch and wood chips will float and move to the perimeter of the bioretention area during a storm event and are not accepted.

Rootstock of the plant material shall be kept moist during transport and on-site storage. The plant root ball should be planted so 1/8th of the ball is above final grade surface. The diameter of the planting pit shall be at least six inches or than the diameter of the planting ball. Set and maintain the plant straight during the entire planting process.

Trees shall be braced using 2" by 2" stakes only as necessary and for the first growing season only. Stakes are to be equally spaced on the outside of the tree ball.

Grasses and legume seed should be drilled into the soil to a depth of at least one inch. Grass and legume plugs shall be planted following the non-grass ground cover planting specifications.

The topsoil specifications provide enough organic material to adequately supply nutrients from natural cycling. The primary function of the bioretention structure is to improve water quality. Adding fertilizers defeats, or at a minimum, impedes this goal. Only acid fertilizer if wood chips or mulch are used to amend the soil. Rototill urea fertilizer at a rate of 2 pounds per 1000 square feet.

6. Underdrains:

Underdrains should meet the following criteria:

- Pipe- Should be 4" to 6" diameter, slotted or perforated rigid plastic pipe (ASTM F 758, Type PS 28, or AASHTO-M-278) in a gravel layer. The preferred material is slotted, 4" rigid pipe (e.g., PVC or HDPE).
Perforations - If perforated pipe is used, perforations should be 3/4" diameter located 6" on center with a minimum of four holes per row. Pipes shall be wrapped with 2" (No. 4 or 6) galvanized hardware cloth.
Gravel - The gravel layer (No. 57 stone preferred) shall be at least 3" thick above and below the underdrain.
The main collector pipe shall be at a minimum 0.5% slope.
A rigid, non-perforated observation well must be provided (one per every 1,000 square feet) to provide a clean-out port and monitor performance of the filter.
A 4" layer of pea gravel (3/4" to 3/8" stone) shall be located between the filter media and underdrain to prevent migration of fines into the underdrain. This layer may be considered part of the filter bed when bed thickness exceeds 24".

The main collector pipe for underdrain systems shall be constructed at a minimum slope of 0.5%. Observation wells and/or clean-out pipes must be provided (one minimum per every 1000 square feet of surface area).

7. Miscellaneous:

These practices may not be constructed until all contributing drainage area has been stabilized.

LEGEND


Legend table with columns for SOILS CLASSIFICATION (AbC1), SOILS DELINEATION, EXISTING CONTOURS, PROPOSED CONTOURS, EXISTING WOODS LINE, PROPOSED WOODS LINE, EXISTING STRUCTURE, PROPOSED STRUCTURE, ESD DRAINAGE AREA, PUBLIC WATER, SEWER, & UTILITY AND PRIVATE USE-IN-COMMON ACCESS EASEMENT, PUBLIC SEWER & UTILITY EASEMENT, PRIVATE DRAINAGE & UTILITY EASEMENT.

OPERATION AND MAINTENANCE SCHEDULE FOR PRIVATELY OWNED AND MAINTAINED STORMWATER DRY WELLS (M-5)

- 1. THE MONITORING WELLS AND STRUCTURES SHALL BE INSPECTED ON A QUARTERLY BASIS AND AFTER EVERY LARGE STORM EVENT.
2. WATER LEVELS AND SEDIMENT BUILD UP IN THE MONITORING WELLS SHALL BE RECORDED OVER A PERIOD OF SEVERAL DAYS TO INSURE TRENCH DRAINAGE.
3. A LOG BOOK SHALL BE MAINTAINED TO DETERMINE THE RATE AT WHICH THE FACILITY DRAINS.
4. WHEN THE FACILITY BECOMES CLOGGED SO THAT IT DOES NOT DRAIN DOWN WITHIN THE 72 HOUR TIME PERIOD, CORRECTIVE ACTION SHALL BE TAKEN.
5. THE MAINTENANCE LOG BOOK SHALL BE AVAILABLE TO HOWARD COUNTY FOR INSPECTION TO INSURE COMPLIANCE WITH OPERATION AND MAINTENANCE CRITERIA.
6. ONCE THE PERFORMANCE CHARACTERISTICS OF THE INFILTRATION FACILITY HAVE BEEN VERIFIED, THE MONITORING SCHEDULE CAN BE REDUCED TO AN ANNUAL BASIS UNLESS THE PERFORMANCE DATA INDICATES THAT A MORE FREQUENT SCHEDULE IS REQUIRED.

TABLE B.3.2 MATERIALS AND SPECIFICATIONS FOR SWM FACILITIES (DRYWELLS)

Table with columns: MATERIAL, SPECIFICATION, SIZE, NOTES. Lists materials for plantings, mulch, geotextile, underdrain gravel, underdrain piping, poured-in-place conc., and check dam.

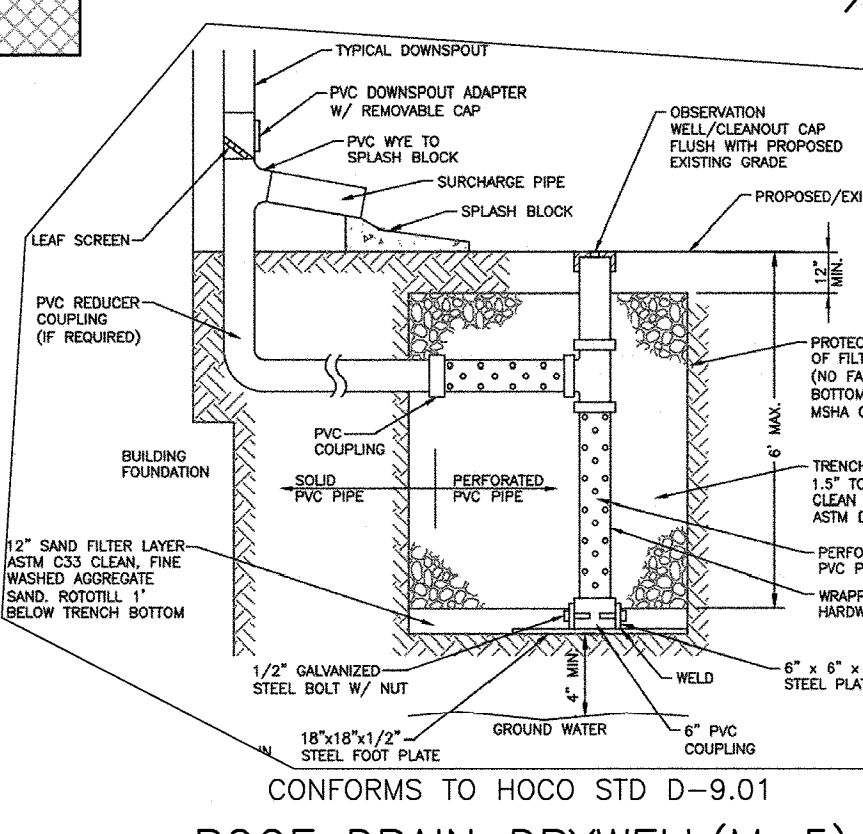




Drywell Dimension Chart table with columns: Dry Well, Length (ft), Width (ft), Depth of Media (ft), Bottom of Stone Elevation, Bottom of Sand Elevation. Lists dimensions for lots 458, 459, 460, 461, 462, 463.

OPERATION & MAINTENANCE SCHEDULE FOR (M-6) MICRO-BIORETENTION

- a. The Owner shall maintain the plant material, mulch layer and soil layer annually. Maintenance of mulch and soil is limited to correcting areas of erosion or wash out. Any mulch replacement shall be done in the spring. Plant material shall be checked for disease and insect infestation and maintenance will address dead material and pruning. Acceptable replacement plant material is limited to the following: 2000 Maryland Stormwater Design Manual Volume II, Table A-4.1 and 2.
b. The Owner shall perform a plant in the spring and in the fall of each year. During the inspection, the Owner shall remove dead and diseased vegetation, considered beyond treatment, replace dead plant material with acceptable replacement plant material, treat diseased trees and shrubs, and replace all deficient stakes and wires.
c. The Owner shall inspect the mulch each spring. The mulch shall be replaced every two to three years. The previous mulch layer shall be removed before the new layer is applied.
d. The Owner shall correct soil erosion on an as needed basis, with a minimum of once per month and after each heavy storm.

MICRO-BIORETENTION DESIGN TABLE

Design table with columns: MB-1, (M-6), 4" PVC, Elevation 1-8, Surface (sf). Lists elevations from 160.00 to 155.40 and a total surface area of 889.8.

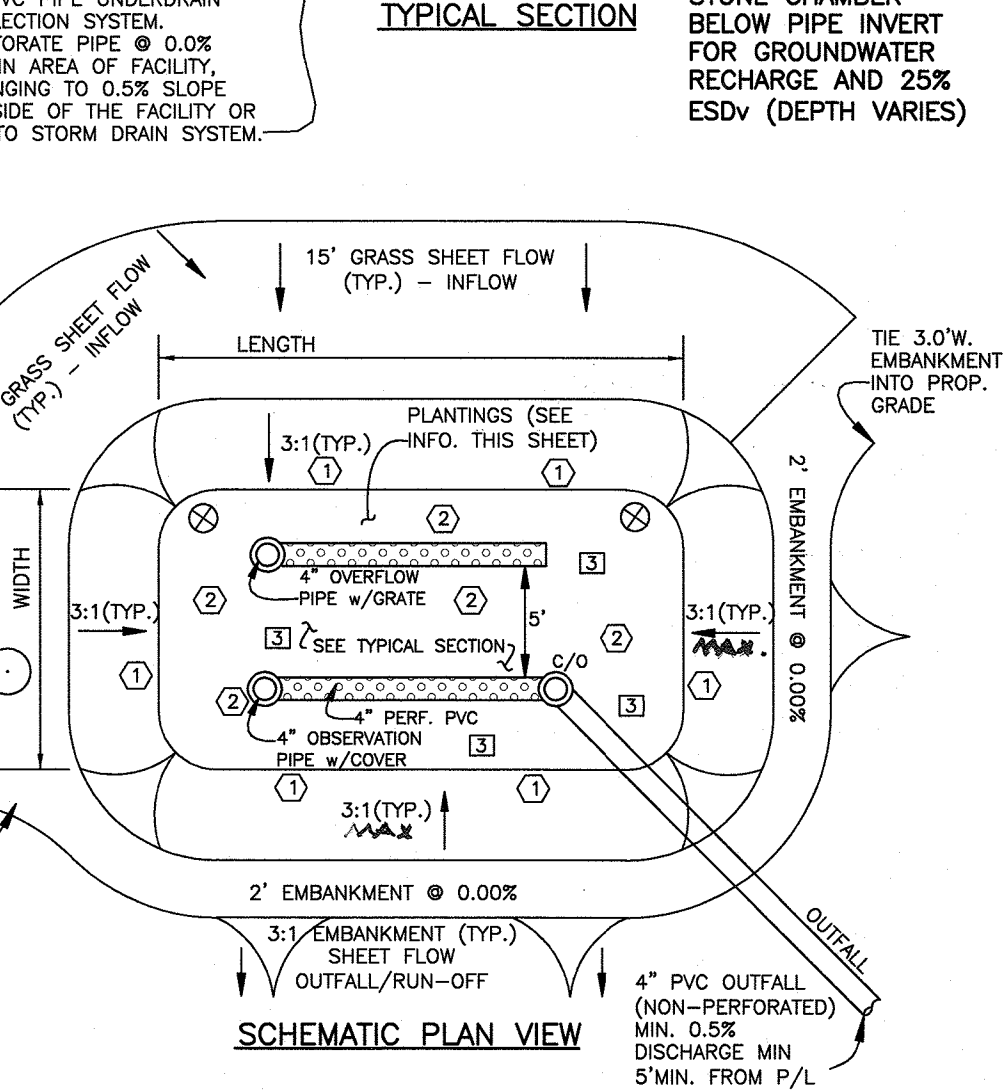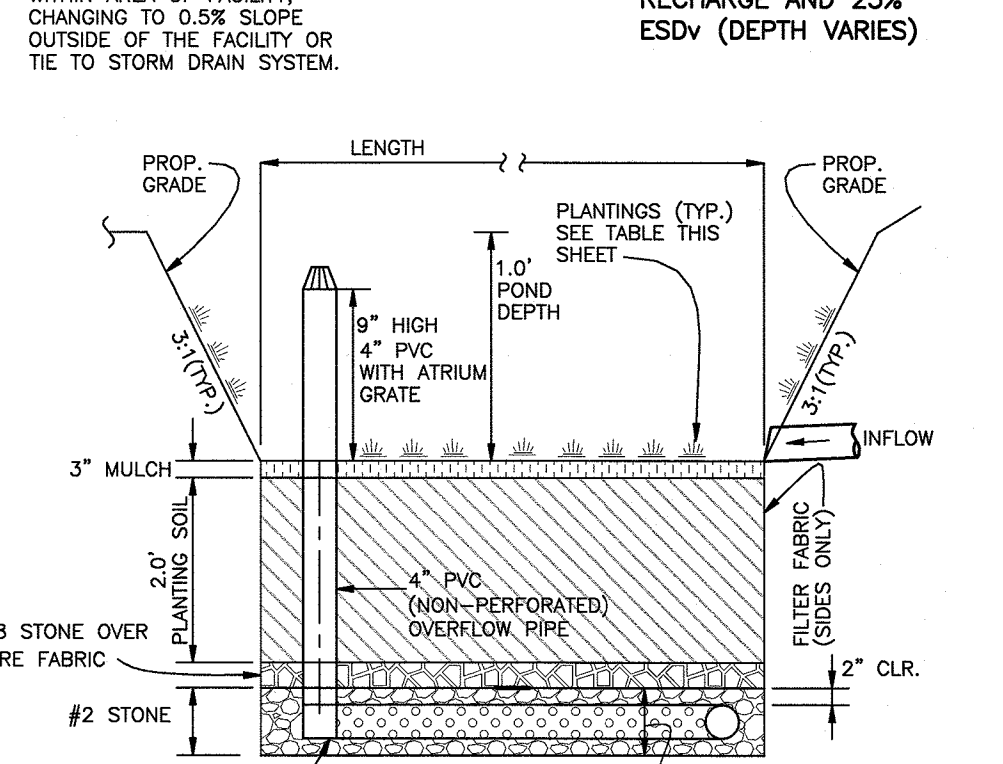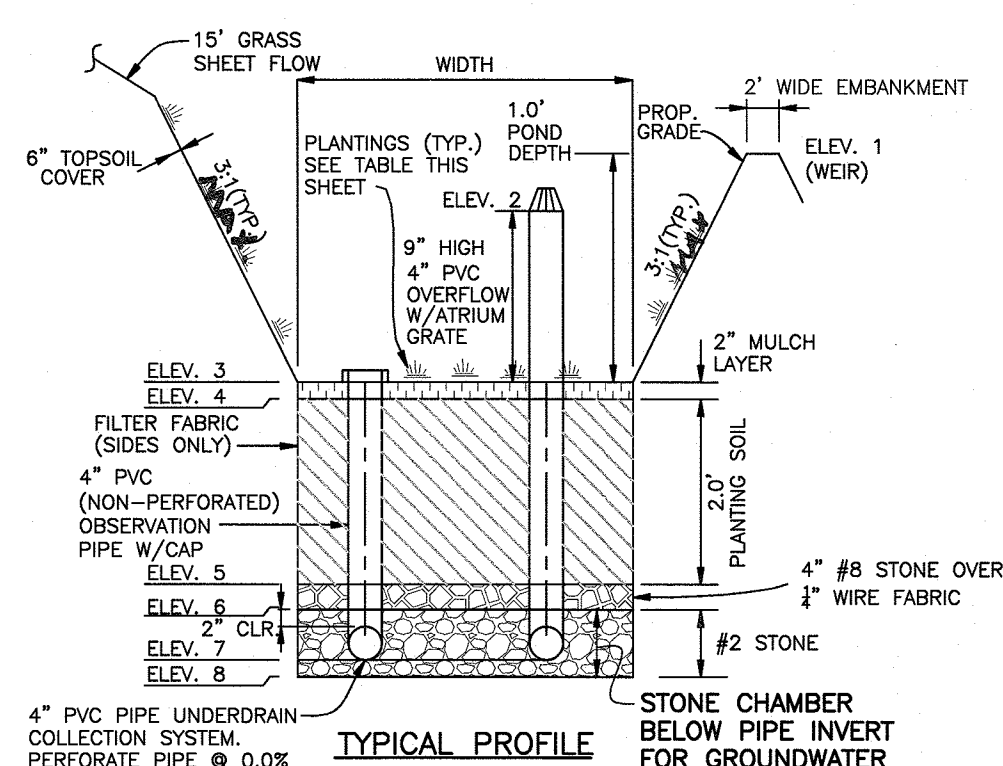

UNDERDRAIN, OVERFLOW AND OUTFALL NOTES

- 1. THE LAST CLEAN-OUT LOCATION WITHIN EACH MICRO-BIORETENTION FACILITY SHALL BE FITTED WITH A NON-CLOGGING SURFACE DRAIN (EXAMPLE: 4" ABS ROOF DRAIN W/CAST ALUMINUM DOME) AT THE POND SURFACE ELEVATION INDICATED IN THE CORRESPONDING TABLE ELEV. 2.
2. THE PVC WITHIN THE FACILITY SHALL BE PERFORATED.
3. THE UNDER-DRAIN AND PIPE TO OUTFALL SHALL BE INSTALLED TO A MINIMUM DEPTH OF 2' BELOW FINISHED GRADE AND SHALL MAINTAIN A MINIMUM 1% SLOPE AND MAINTAIN A MINIMUM OF 1' OF SEPARATION AT ALL CROSSINGS.

TYPICAL MICRO-BIORETENTION DETAILS NOT TO SCALE

(M-6) Micro Bio-Retention Landscaping Chart table with columns: PLANT NAME, COMMON NAME, TYPE, SURFACE AREA, SIZE, QUANTITY, TOTAL QUANTITY. Lists plants like Lobelia cardinalis, Lobelia siphillica, Carex stricta, and Liatris spicata.

MICRO-BIORETENTION (M-6) PLANTING DATA

- 1. PLANTINGS WITHIN THE PONDING AREA OF THE LS INFILTRATION ARE TO BE OF A MEDIUM TO HIGH WATER TOLERANCE. SUGGESTED SPECIES: CREEPING BUDLEWED (ALUGA REPTANS), COMMON PERNNIAL (ONCA MINOR), LILY-TURT (LIRIOPE, SP.).
2. PLANTINGS ALONG THE PERIMETER (BERM) AREA OF THE LS INFILTRATION ARE TO BE OF A LOW TO MEDIUM WATER TOLERANCE. SUGGESTED SPECIES: (PERENNIALS/ANNUALS) DAYLILY (HEMEROCALLIS SP.), WHITE GLORY (ASTILBE SP.).


MICRO-BIORETENTION (M-6) LANDSCAPE DATA

HYDROLOGIC ZONE 3 - REGULARLY INUNDATED SHORELINE FRINGE (HIGH MARSH)
HYDROLOGIC CONDITION - 0' TO 1'-0" DEEP HARDNESS - TEMPERATURE ZONE Bb (-5' TO 0') SEE SHEET - FOR SEQUENCE OF CONSTRUCTION

NOTE: REFER TO MDE 2000 MD STORMWATER DESIGN MANUAL VOLUMES 1 & 2 FOR LANDSCAPE CONTRACTOR RESPONSIBILITIES, PRACTICES AND MAINTENANCE DUTIES

APPROVED: HOWARD COUNTY DEPARTMENT OF PLANNING AND ZONING. Includes signatures and dates for Chief, Division of Land Management (1/2/20) and Chief, Development Engineering Division (1-3-20).


BENCHMARK ENGINEERING, INC. logo and contact info. LENNOX PARK CROSBY PROPERTY LOTS 458-465. TAX MAP: 43 - GRID: 06 - PARCEL: p/0319. ZONED: R-12 (RESIDENTIAL). ELECTION DISTRICT NO. 1 - HOWARD COUNTY, MARYLAND. ALTERNATIVE COMPLIANCE EXHIBIT & SIMPLIFIED ECP. DATE: JANUARY 03, 2020. SHEET 2 OF 3.

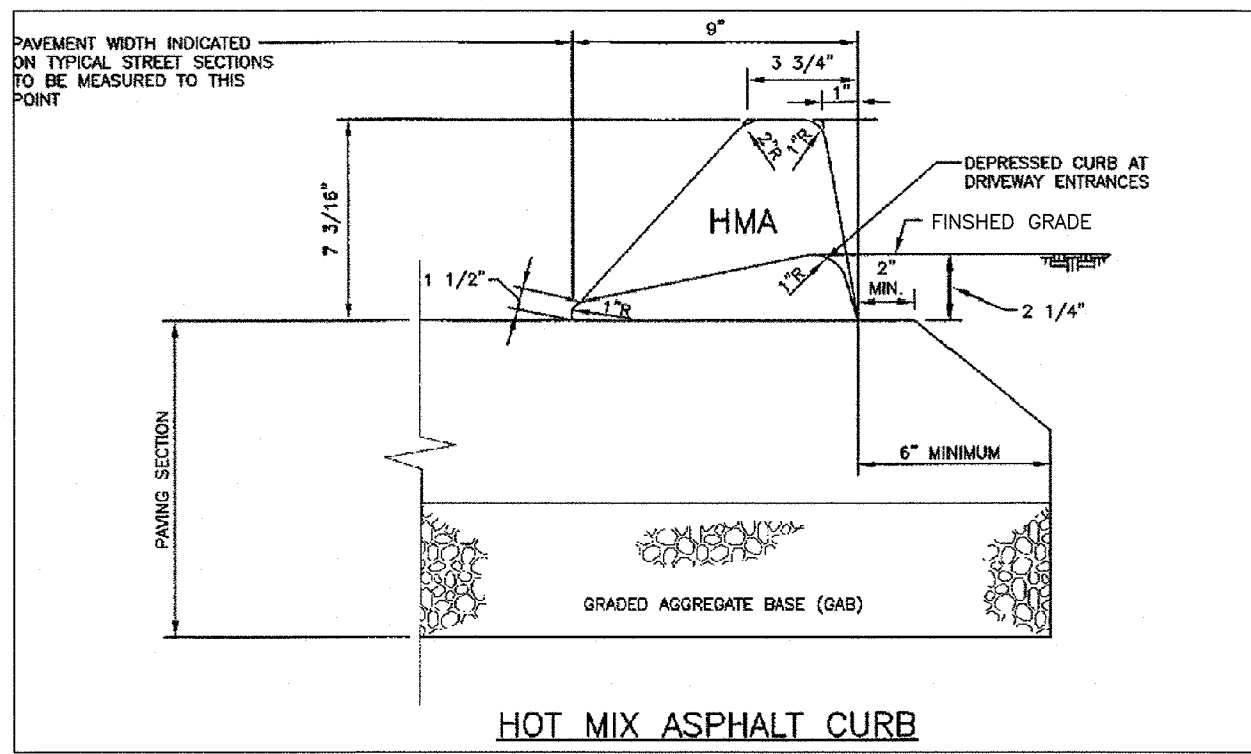

HOT MIX ASPHALT CURB

NOT TO SCALE

THIS DETAIL CONFORMS TO HO.CO. DMV IV R-3.03

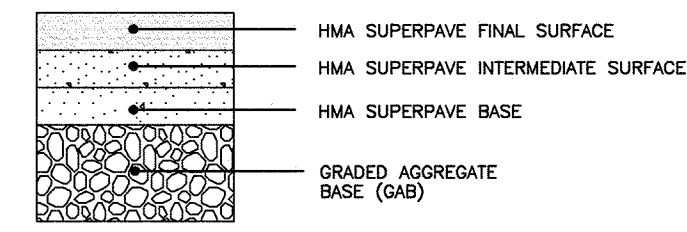


SCHEMATIC PAVING DETAIL

NOT TO SCALE

SECTION NUMBER	ROAD AND STREET CLASSIFICATION	CALIFORNIA BEARING RATIO (CBR)			
		3 to <5	5 to <7	7 to <10	10 to <15
P-2	PARKING DRIVE AISLES: RESIDENTIAL AND NON-RESIDENTIAL WITH NO MORE THAN 10 HEAVY TRUCKS PER DAY LOCAL ROADS: ACCESS DRIVE, ACCESS STREET CUL-DE-SAC: RESIDENTIAL	PAVEMENT MATERIAL (INCHES)		MIN. HMA WITH GAB	
		HMA SUPERPAVE FINAL SURFACE 9.5 MM PG 64-22, LEVEL 1 (LOW ESAL)		HMA WITH CONSTANT GAB	
		HMA SUPERPAVE INTERMEDIATE SURFACE 9.5 MM PG 64-22, LEVEL 1 (LOW ESAL)			
		HMA SUPERPAVE BASE 9.0 MM PG 64-22, LEVEL 1 (LOW ESAL)			
		GRADED AGGREGATE BASE (GAB)			

PAVING SPECIFICATIONS (HO.CO. STD R-2.01)

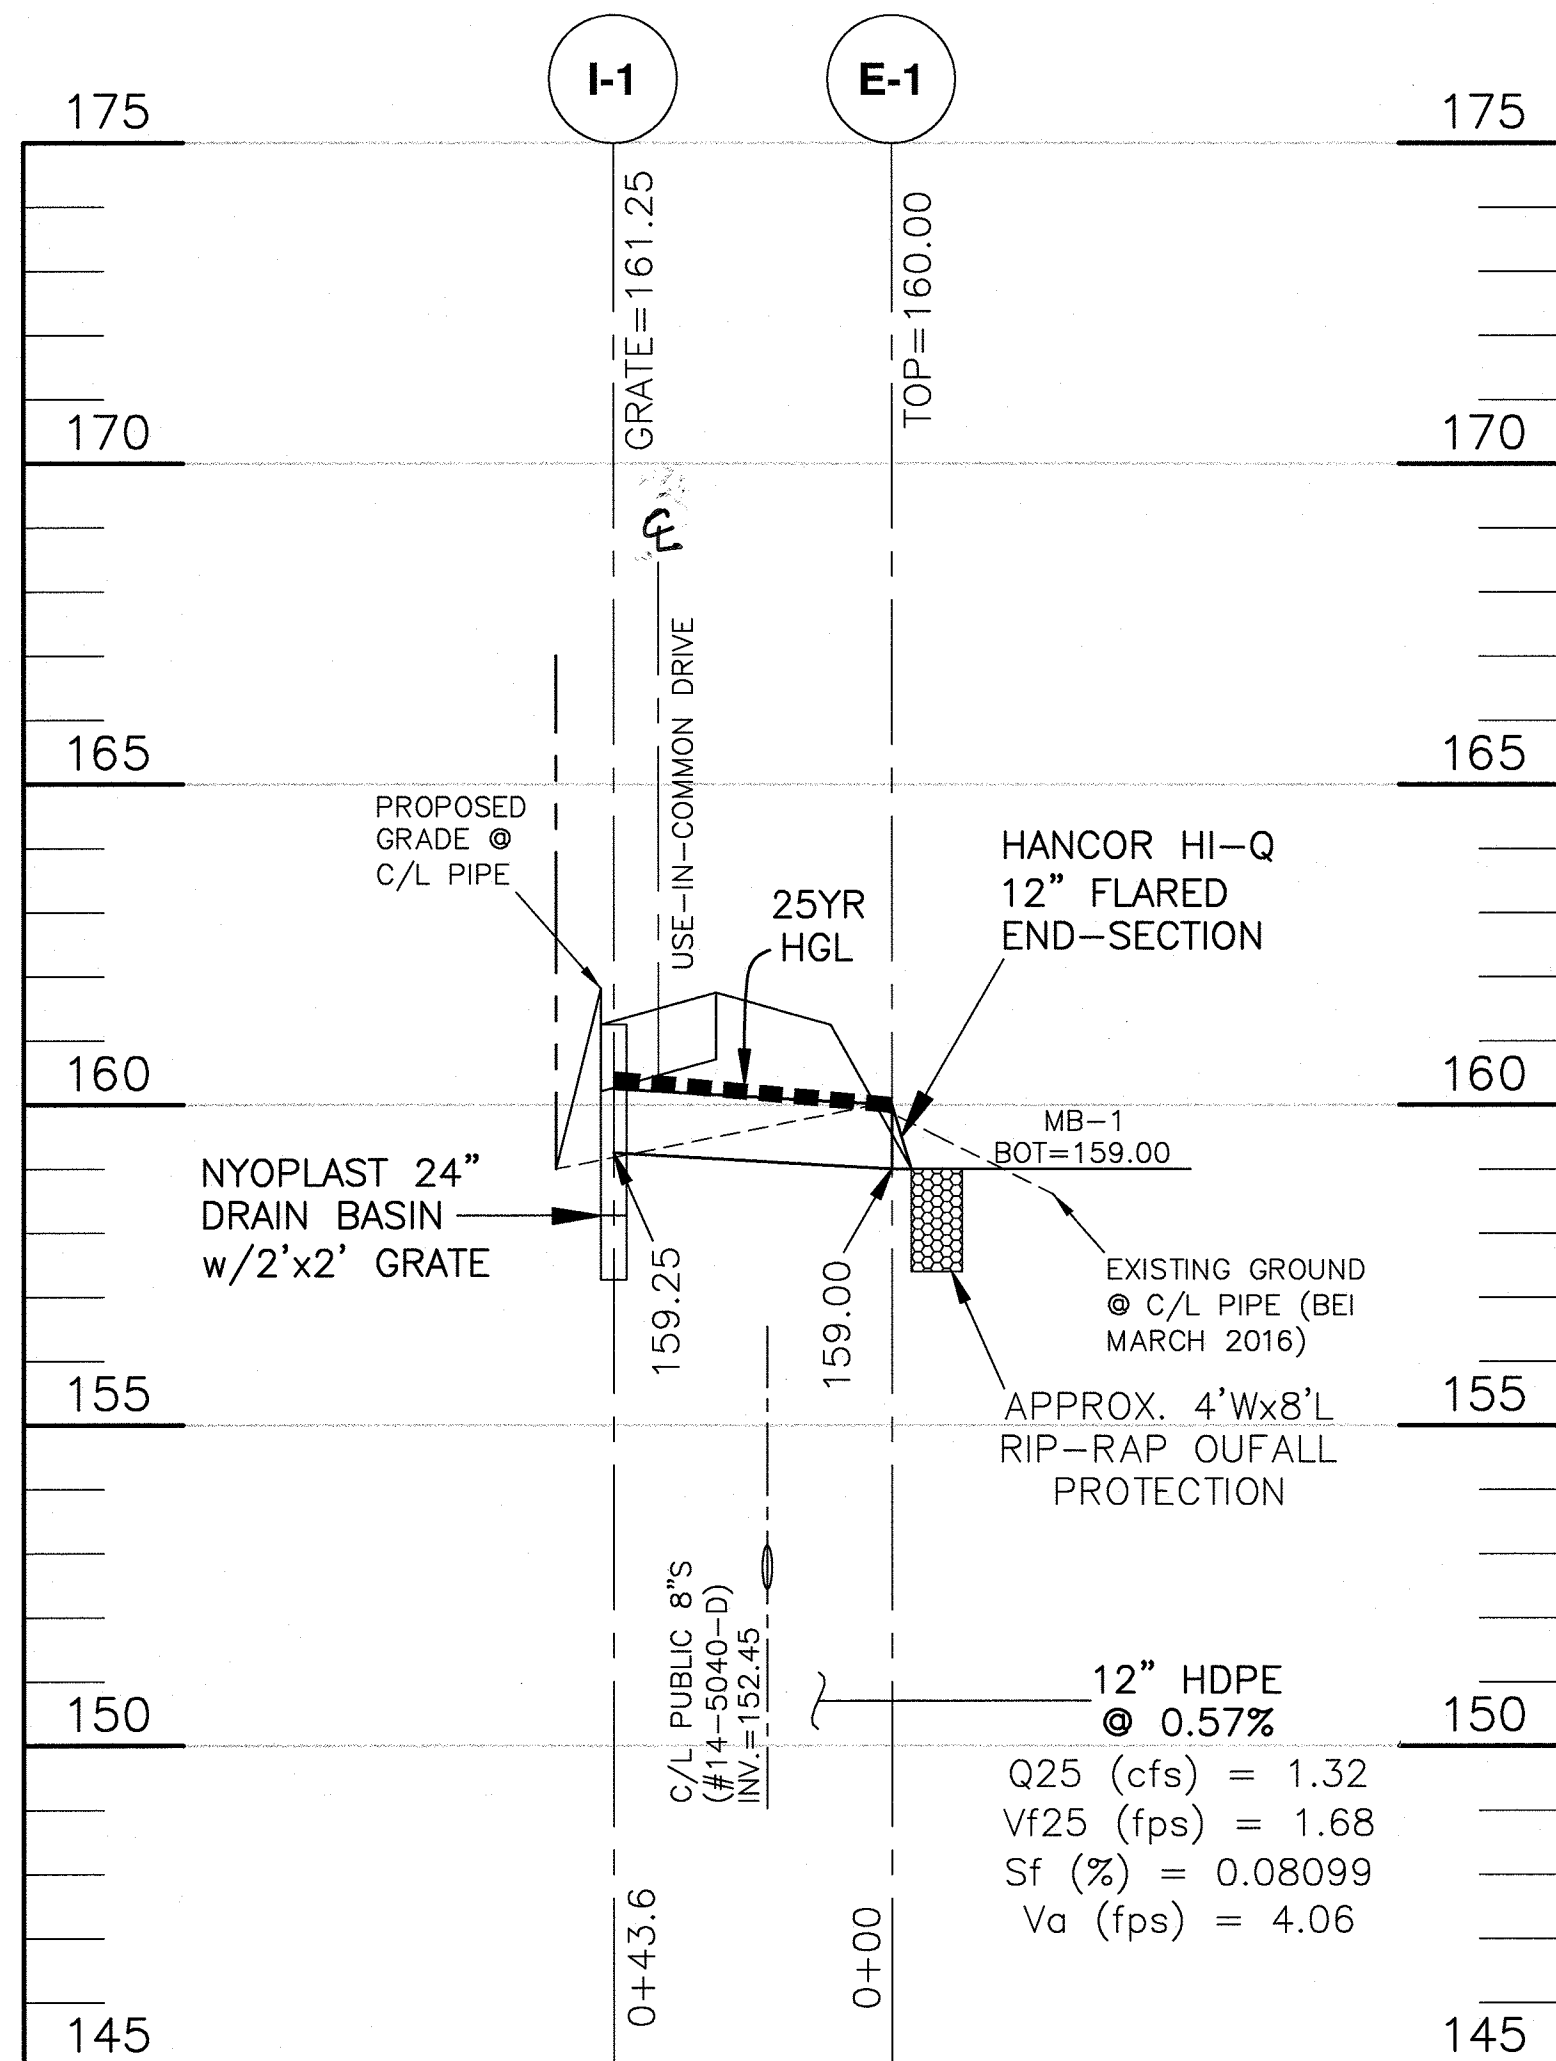

SD PROFILE
HORIZONTAL SCALE: 1" = 30'
VERTICAL SCALE: 1" = 3'

SIZE	TYPE	LENGTH (L.F.)	MAINTENANCE
12"	PVC	43.6	PRIVATE
4" (MB-1)	PVC	26.3	PRIVATE

All pipes shall have smooth interior. No interior corrugations.

APPROVED: HOWARD COUNTY DEPARTMENT OF PLANNING AND ZONING


John D. Mann 1/3/20
CHIEF, DIVISION OF LAND DEVELOPMENT
DATE

Chris Clark 1-3-20
CHIEF, DEVELOPMENT ENGINEERING DIVISION
DATE

Andy Gorman 1-3-20
DIRECTOR
DATE



STRUCTURE SCHEDULE							
STRUCTURE	TYPE	LOCATION	INVERT IN	INVERT OUT	TOP ELEV.	THROAT ELEV.	STD. DETAIL
INLETS							
I-1	NDS 24"x24"	N 549,728.7314 E 1,382,669.8137			159.25	161.25	Manufacturer Specs. PRIVATE
MANHOLES							
							PRIVATE
HEADWALLS/END SECTIONS							
ES-1	HDPE End Section	N 549,702.1827 E 1,382,704.3474			159.00	160.00	Manufacturer Specs. PRIVATE

STRUCTURE LOCATION FOR MANHOLES IS AT THE CENTER OF THE MANHOLE RIM.
STRUCTURE LOCATION FOR END SECTIONS IS AT THE MIDPOINT OF THE END OF THE STRUCTURE.
PRECAST STRUCTURES MEETING HS-20 LOADING MAY BE USED.

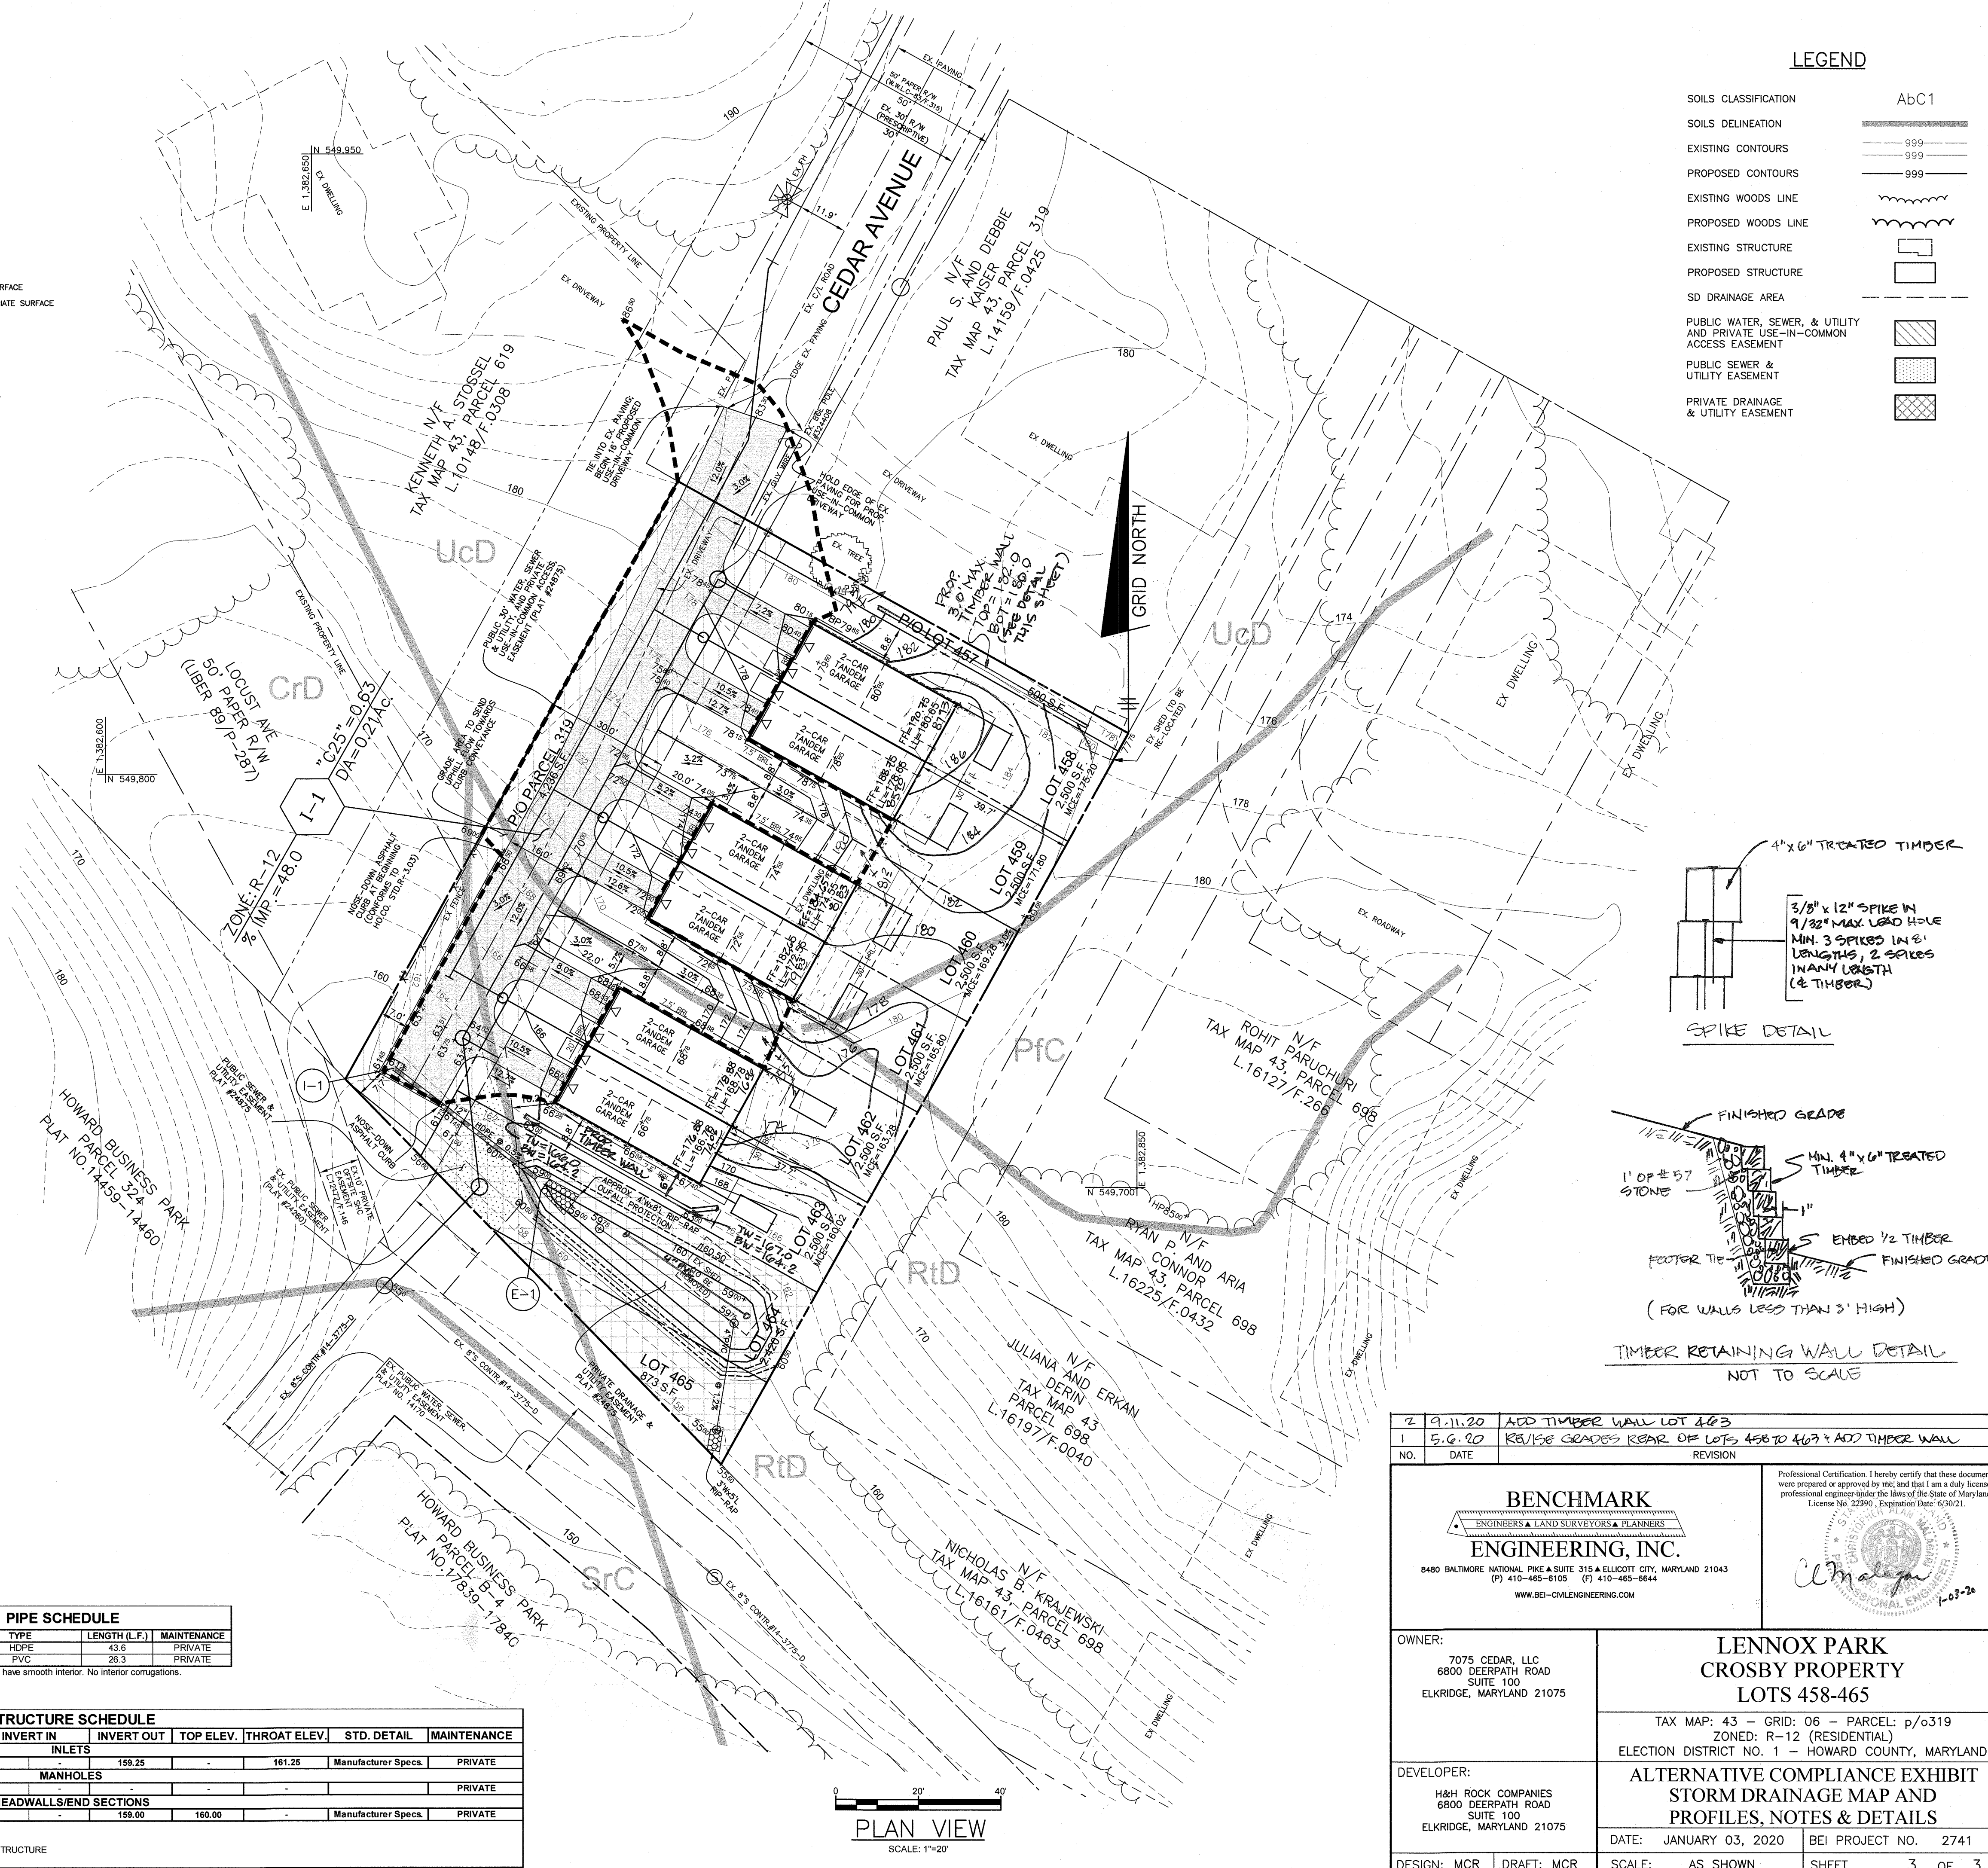

LEGEND

SOILS CLASSIFICATION	Abc1
SOILS DELINEATION	---
EXISTING CONTOURS	---999---
PROPOSED CONTOURS	---999---
EXISTING WOODS LINE	~~~~~
PROPOSED WOODS LINE	~~~~~
EXISTING STRUCTURE	▭
PROPOSED STRUCTURE	▭
SD DRAINAGE AREA	---
PUBLIC WATER, SEWER, & UTILITY AND PRIVATE USE-IN-COMMON ACCESS EASEMENT	▨
PUBLIC SEWER & UTILITY EASEMENT	▩
PRIVATE DRAINAGE & UTILITY EASEMENT	▧

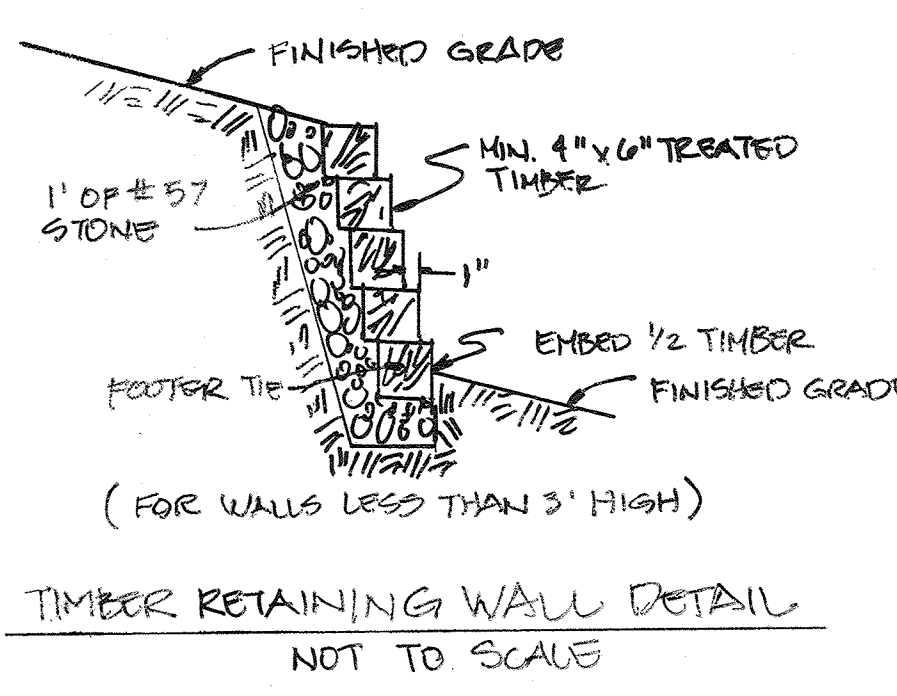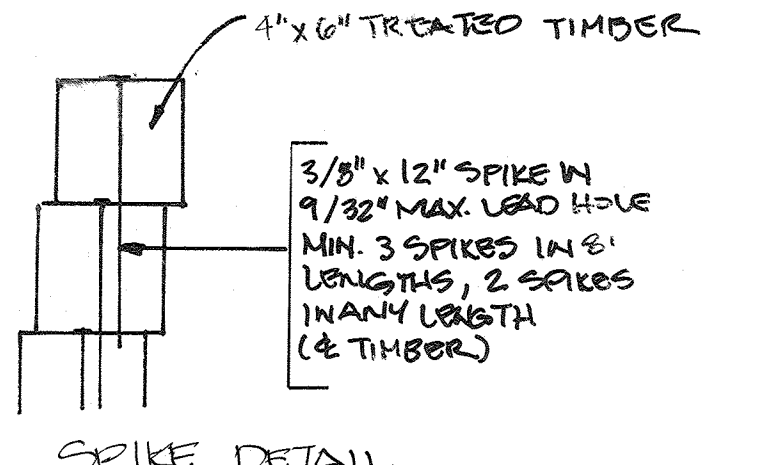

2	9.11.20	ADD TIMBER WALL LOT 463
1	5.6.20	REVISE GRADES REAR OF LOTS 458 TO 463 & ADD TIMBER WALL
NO.	DATE	REVISION

BENCHMARK ENGINEERING, INC.
8400 BALTIMORE PIKE & SUITE 315 & ELLICOTT CITY, MARYLAND 21043
(P) 410-485-6105 (F) 410-465-6644
WWW.BE-CIVILENGINEERING.COM

Professional Certification. I hereby certify that these documents were prepared or approved by me, and that I am a duly licensed professional engineer under the laws of the State of Maryland, License No. 22990, Expiration Date: 6/30/21.

<p>OWNER: 7075 CEDAR, LLC 6800 DEERPATH ROAD SUITE 100 ELKRIDGE, MARYLAND 21075</p>	<p>LENNOX PARK CROSBY PROPERTY LOTS 458-465 TAX MAP: 43 - GRID: 06 - PARCEL: p/0319 ELECTION DISTRICT NO. 1 - HOWARD COUNTY, MARYLAND</p>		
<p>DEVELOPER: H&H ROCK COMPANIES 6800 DEERPATH ROAD SUITE 100 ELKRIDGE, MARYLAND 21075</p>	<p>ALTERNATIVE COMPLIANCE EXHIBIT STORM DRAINAGE MAP AND PROFILES, NOTES & DETAILS DATE: JANUARY 03, 2020 BEI PROJECT NO. 2741</p>		
DESIGN: MCR	DRAFT: MCR	SCALE: AS SHOWN	SHEET 3 OF 3