



W.R. & A. B.M. 4-Y [Elev. 280.94]
 2.2" spike base A.C.P.P. Co. pole # 309342
 50'± South of Madison Street on West side
 of Savage - Guilford Road.

PLAN
 Scale: 1" = 50'

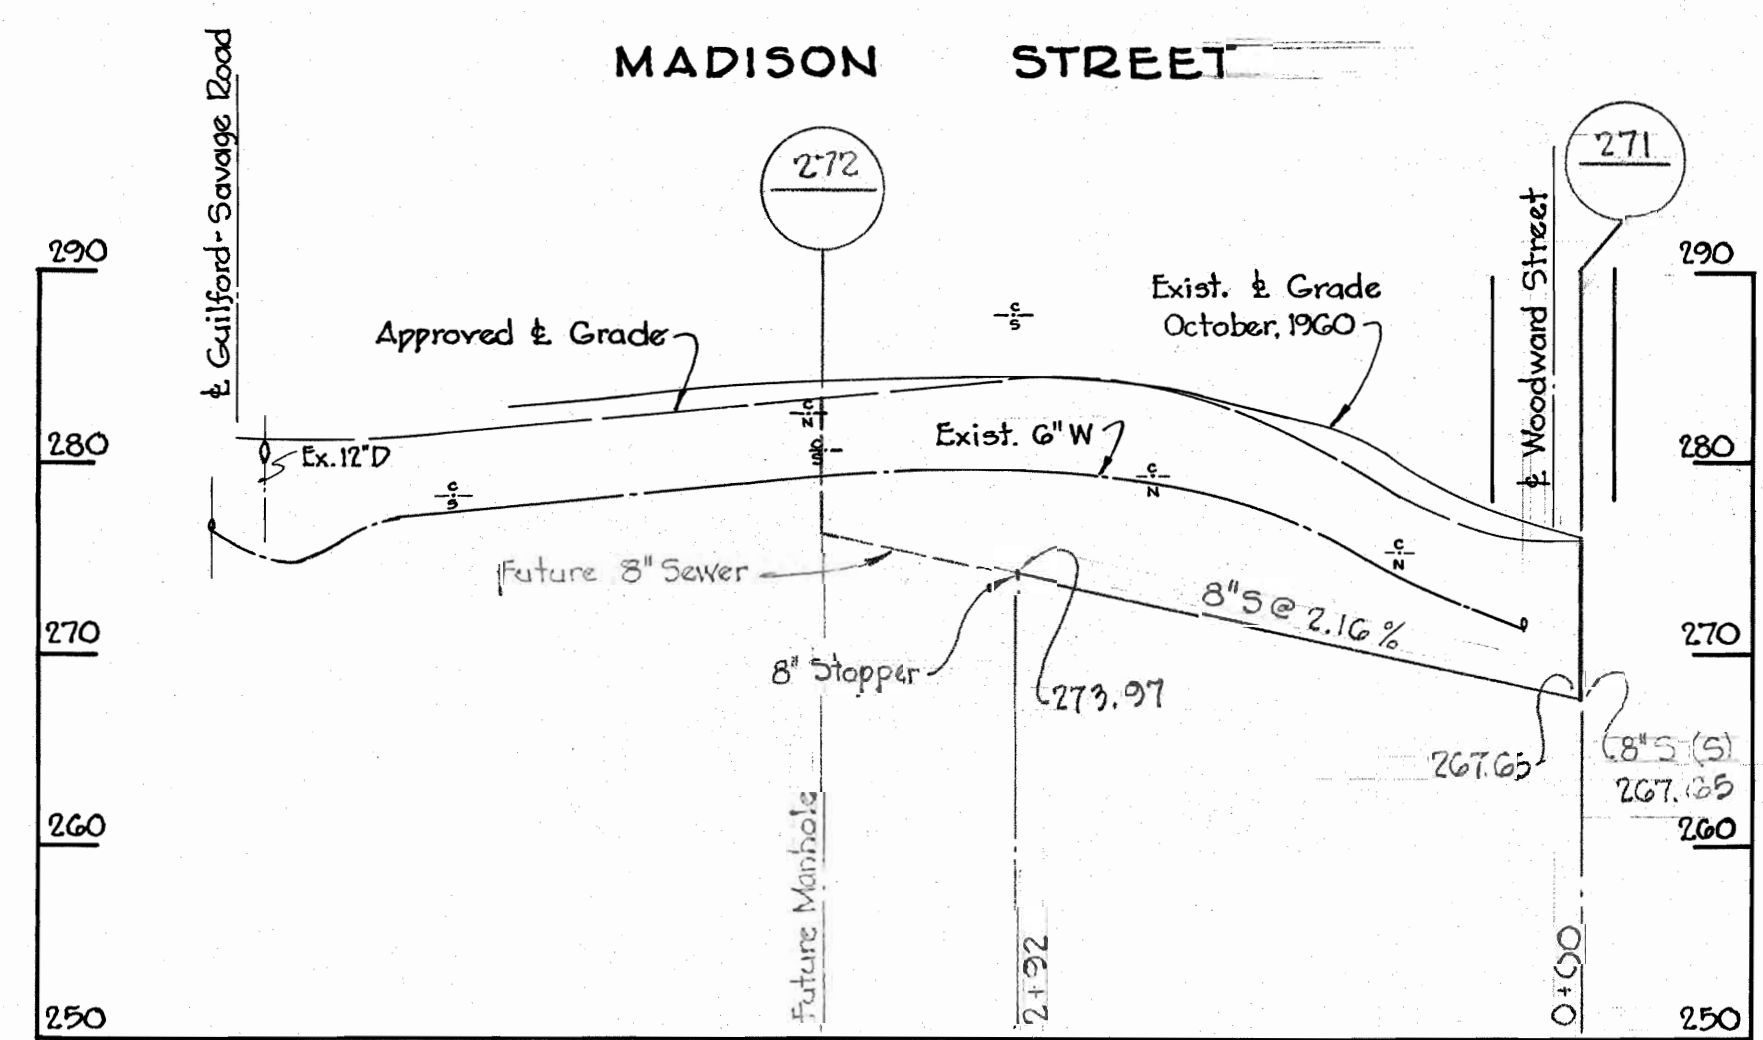

PROFILE
 Scale - H: 1" = 100'
 V: 1" = 10'

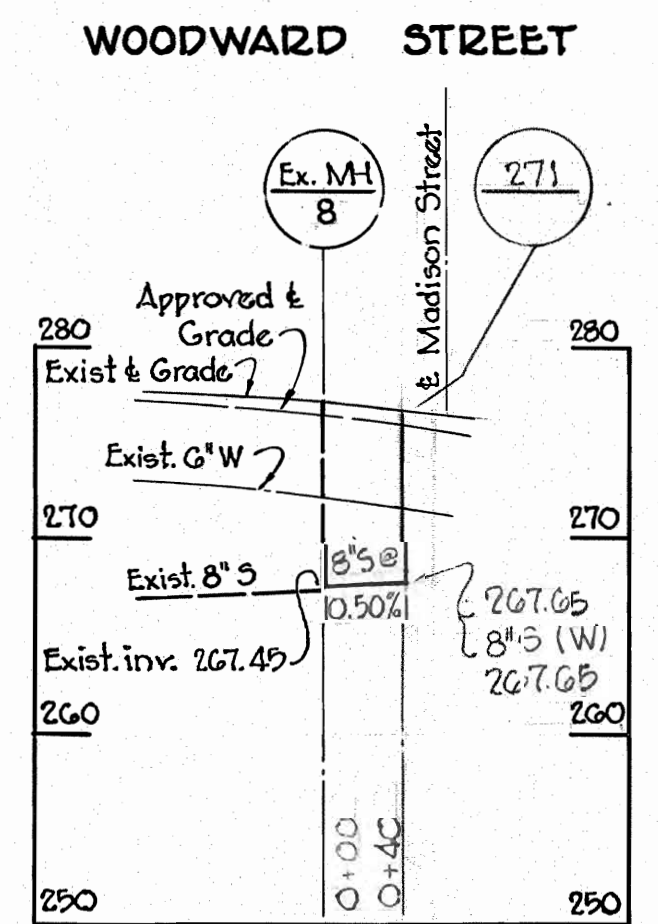

Contract No

WHITMAN, REQUARDT & ASSOCIATES ENGINEERS 1304 ST. PAUL ST. BALTIMORE, MARYLAND	HOWARD COUNTY METROPOLITAN COMMISSION _____ DATE _____ CHIEF ENGINEER	CONTRACT NO. <u>2-5</u>	PLAN AND PROFILES SEWER EXTENSIONS	PATUXENT SUB-DISTRICT NO. 2	DRAWING NO. <u>1</u>	SCALE AS SHOWN	47 NE. 18-3,4
					OF <u>1</u>		

W. O. 4955-2

PRELIMINARY Nov. 2, 1960

WS 2/1-5