




PLAN
Scale: 1"=50'

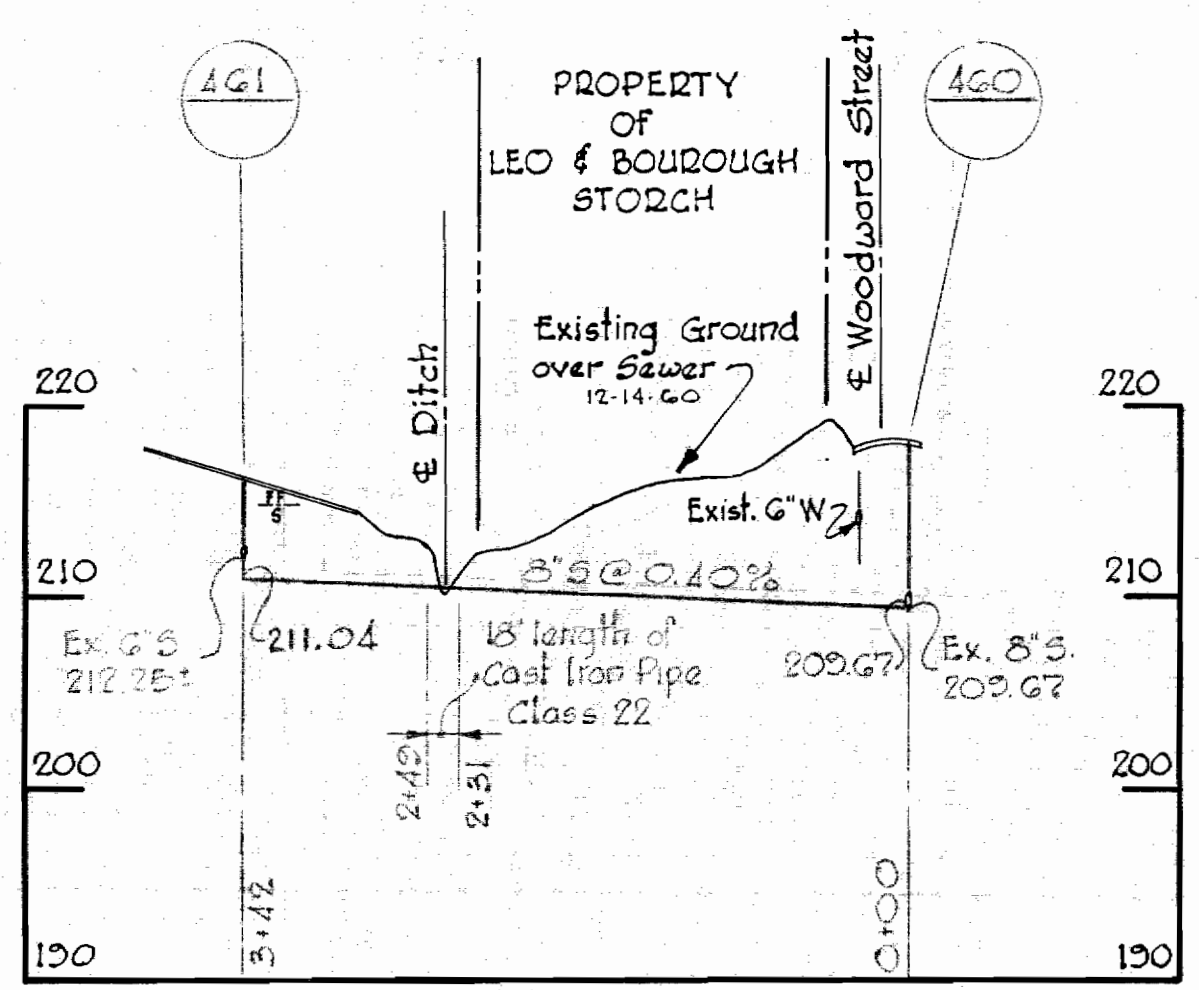

PROFILE
Scale: H. 1"=100'
V. 1"=10'

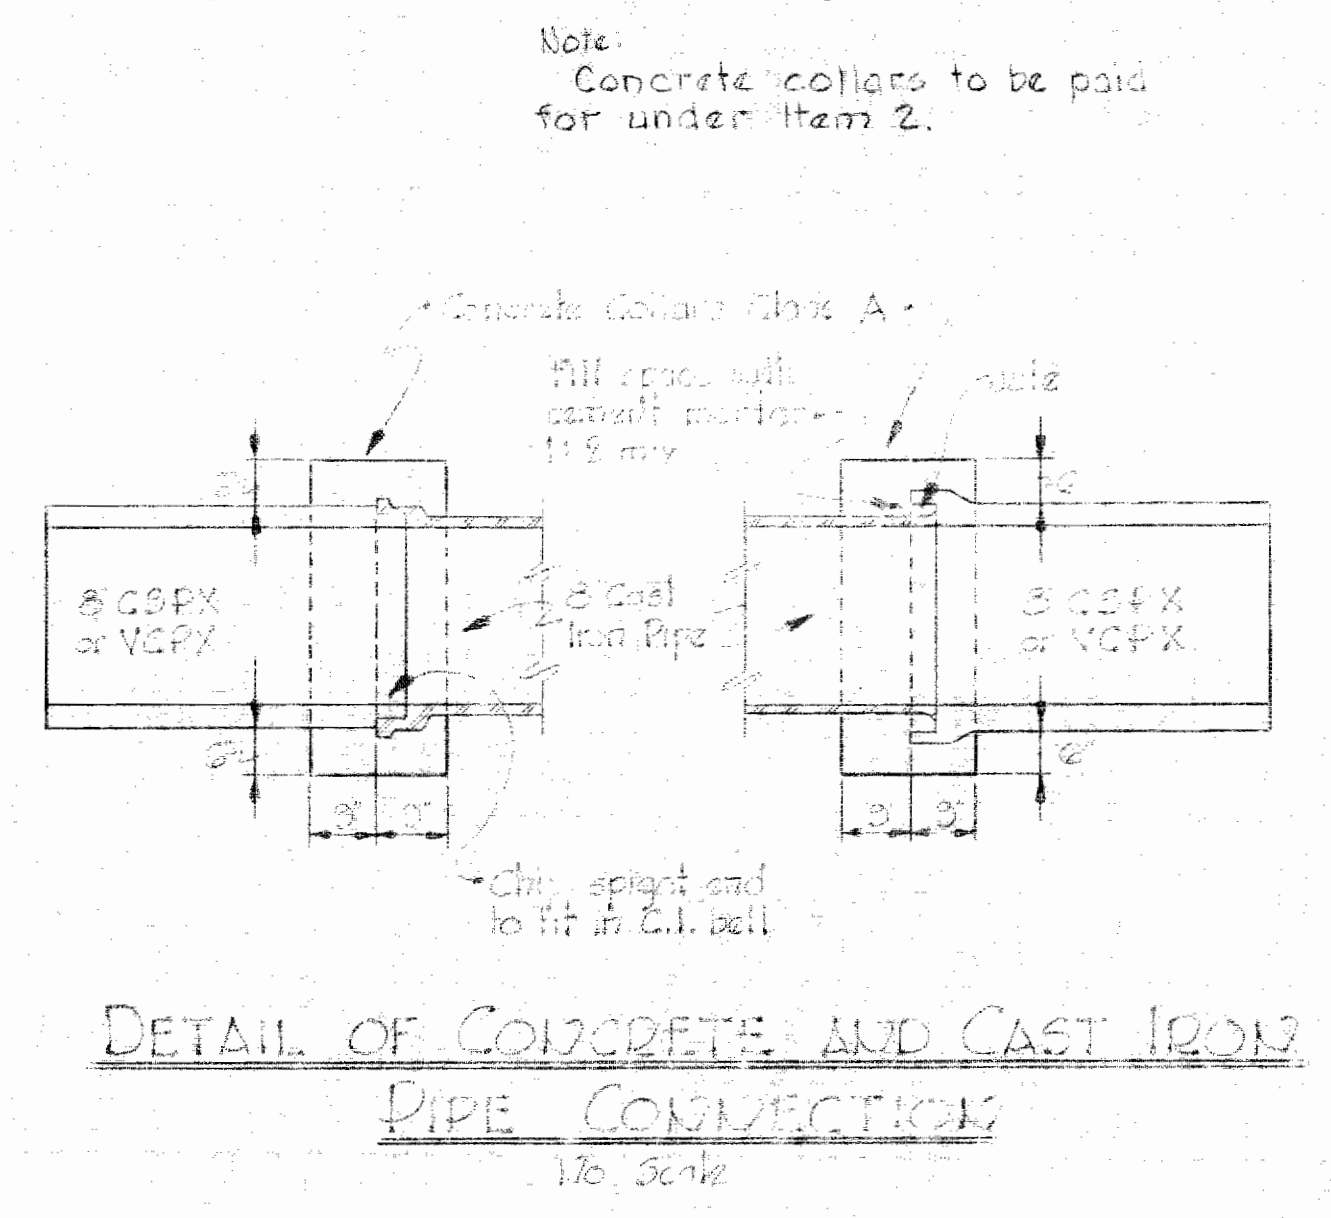

DETAIL OF CONCRETE AND CAST IRON PIPE CONNECTION
No. Scale

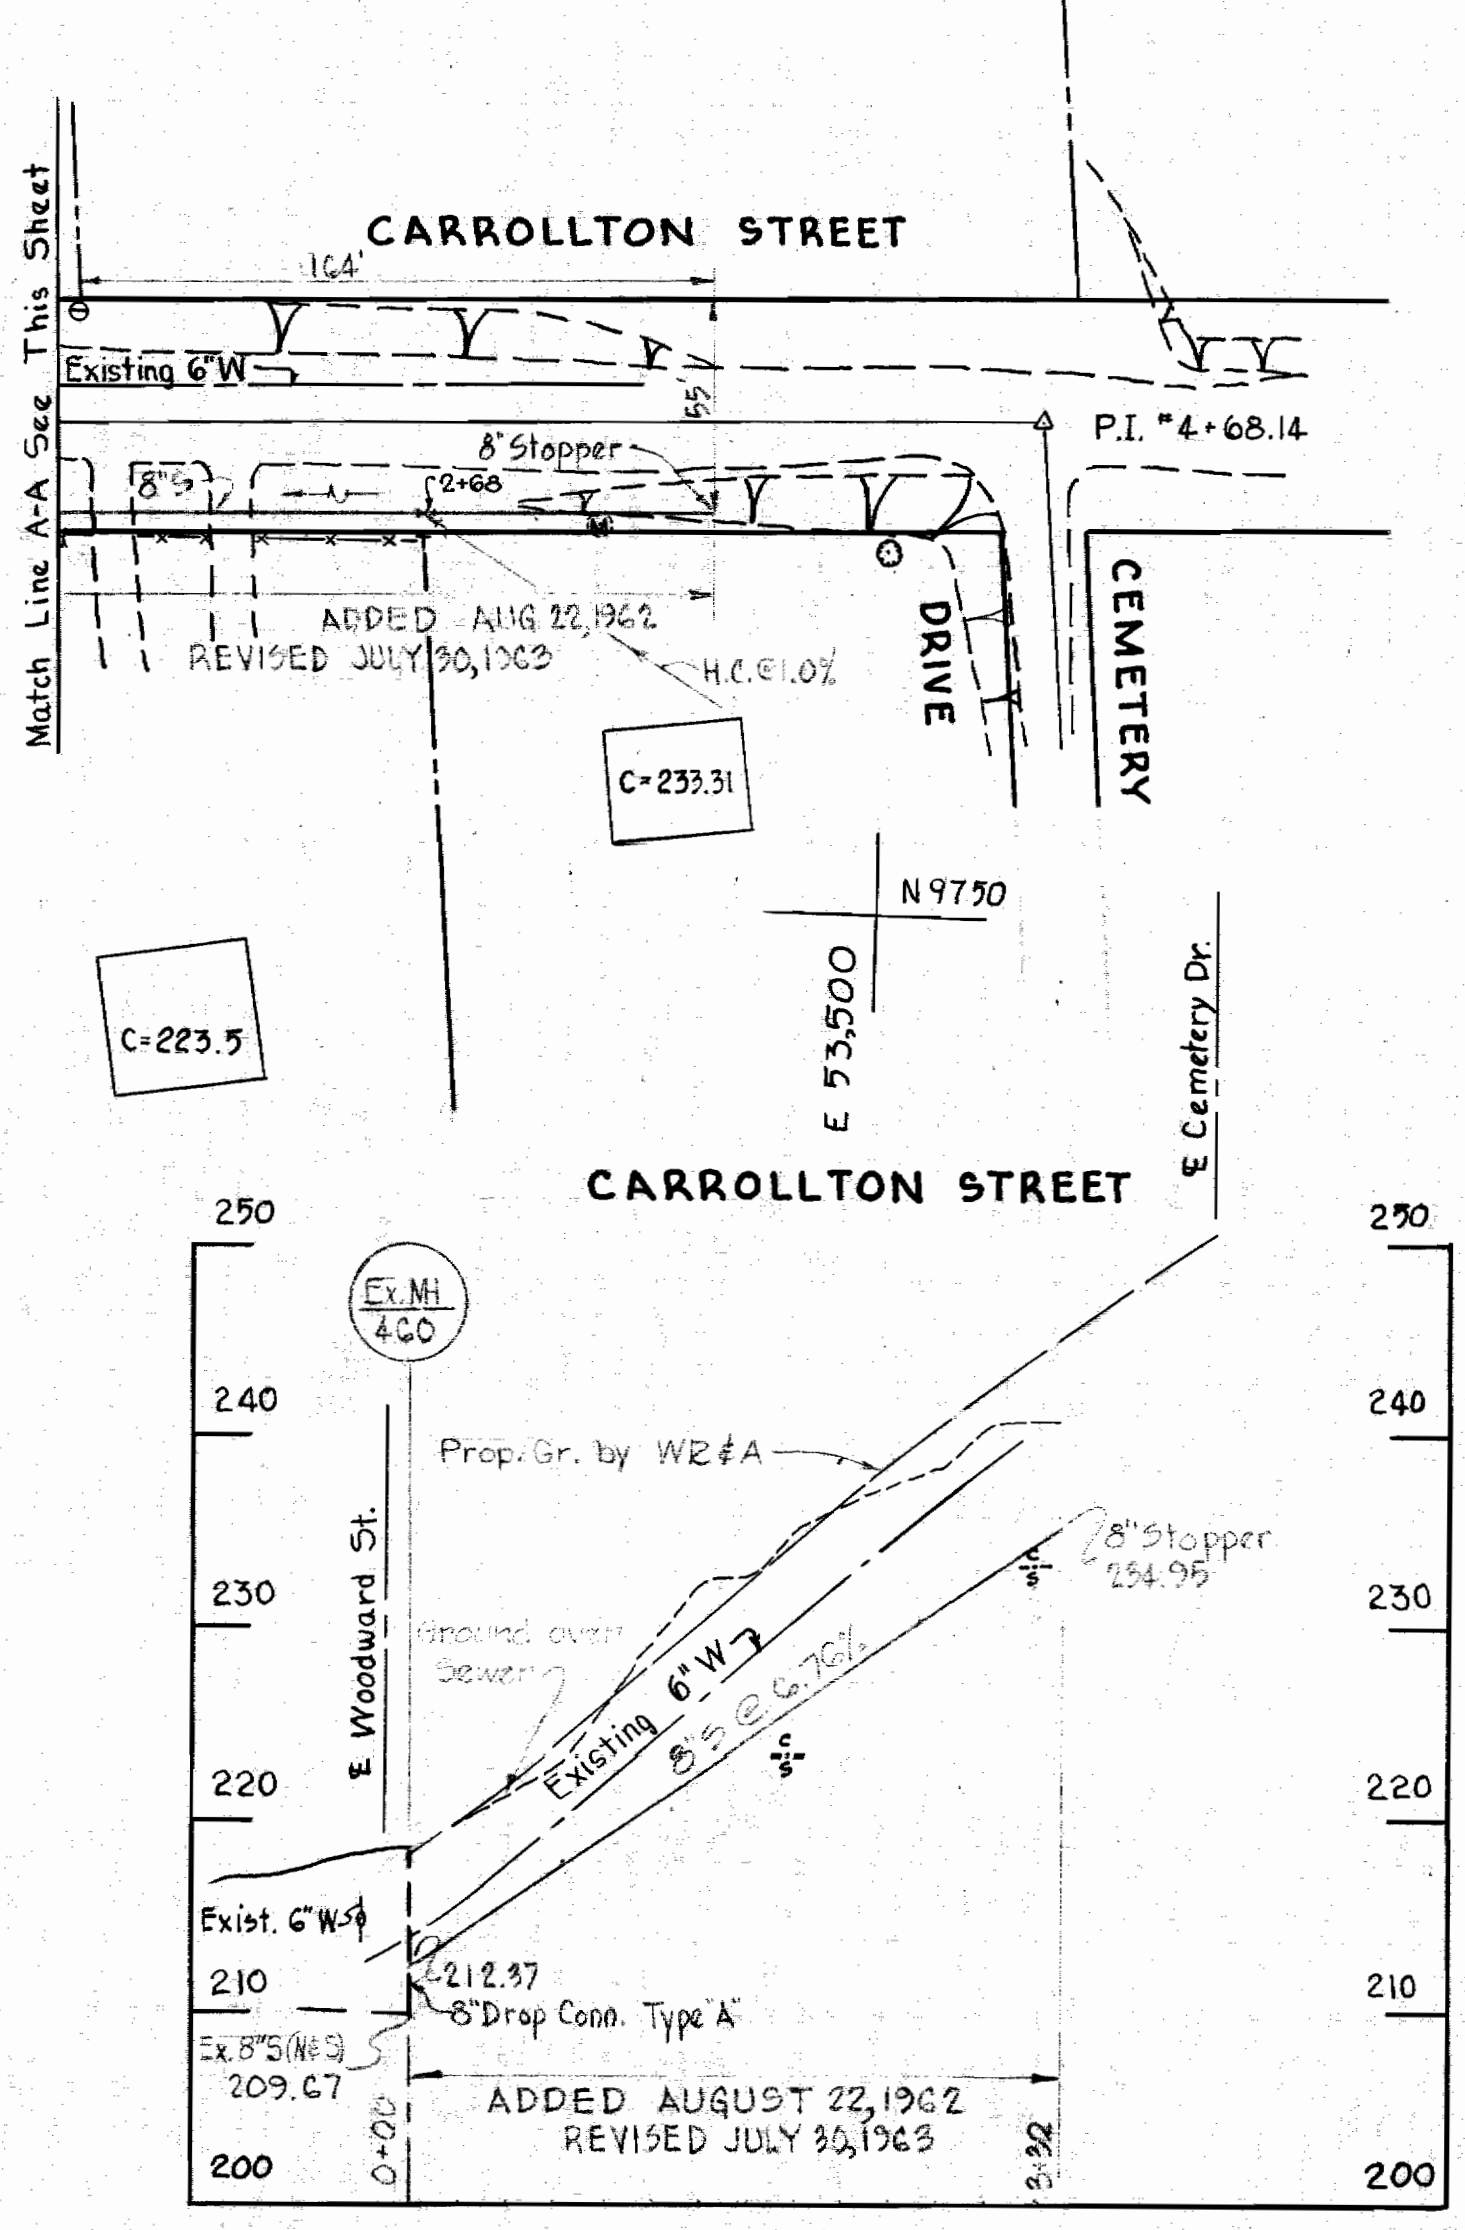

PROFILE
Scale: Horz. 1"=100'
Vert. 1"=10'

WHITMAN, REQUARDT & ASSOCIATES ENGINEERS 1304 ST. PAUL ST. BALTIMORE, MARYLAND	HOWARD COUNTY METROPOLITAN COMMISSION JAN. 30, 1961 DATE	CONTRACT NO. 28 S <i>Carl W. Nepper</i> CHIEF ENGINEER	PLAN & PROFILE OF SEWER MAIN	PATUXENT SUB-DISTRICT	DRAWING NO. 1	SCALE AS SHOWN
					OF 1	4C NE 18-4

WS 285/1