


Note:  
Exact locations of sewer house connections shall be determined in the field.

**PLAN**  
Scale 1"=50'

W.R. & A. T.P. Elev. 279.85  
Flange bolt on Fire Hydrant at intersection of Woodward & Madison Sts.

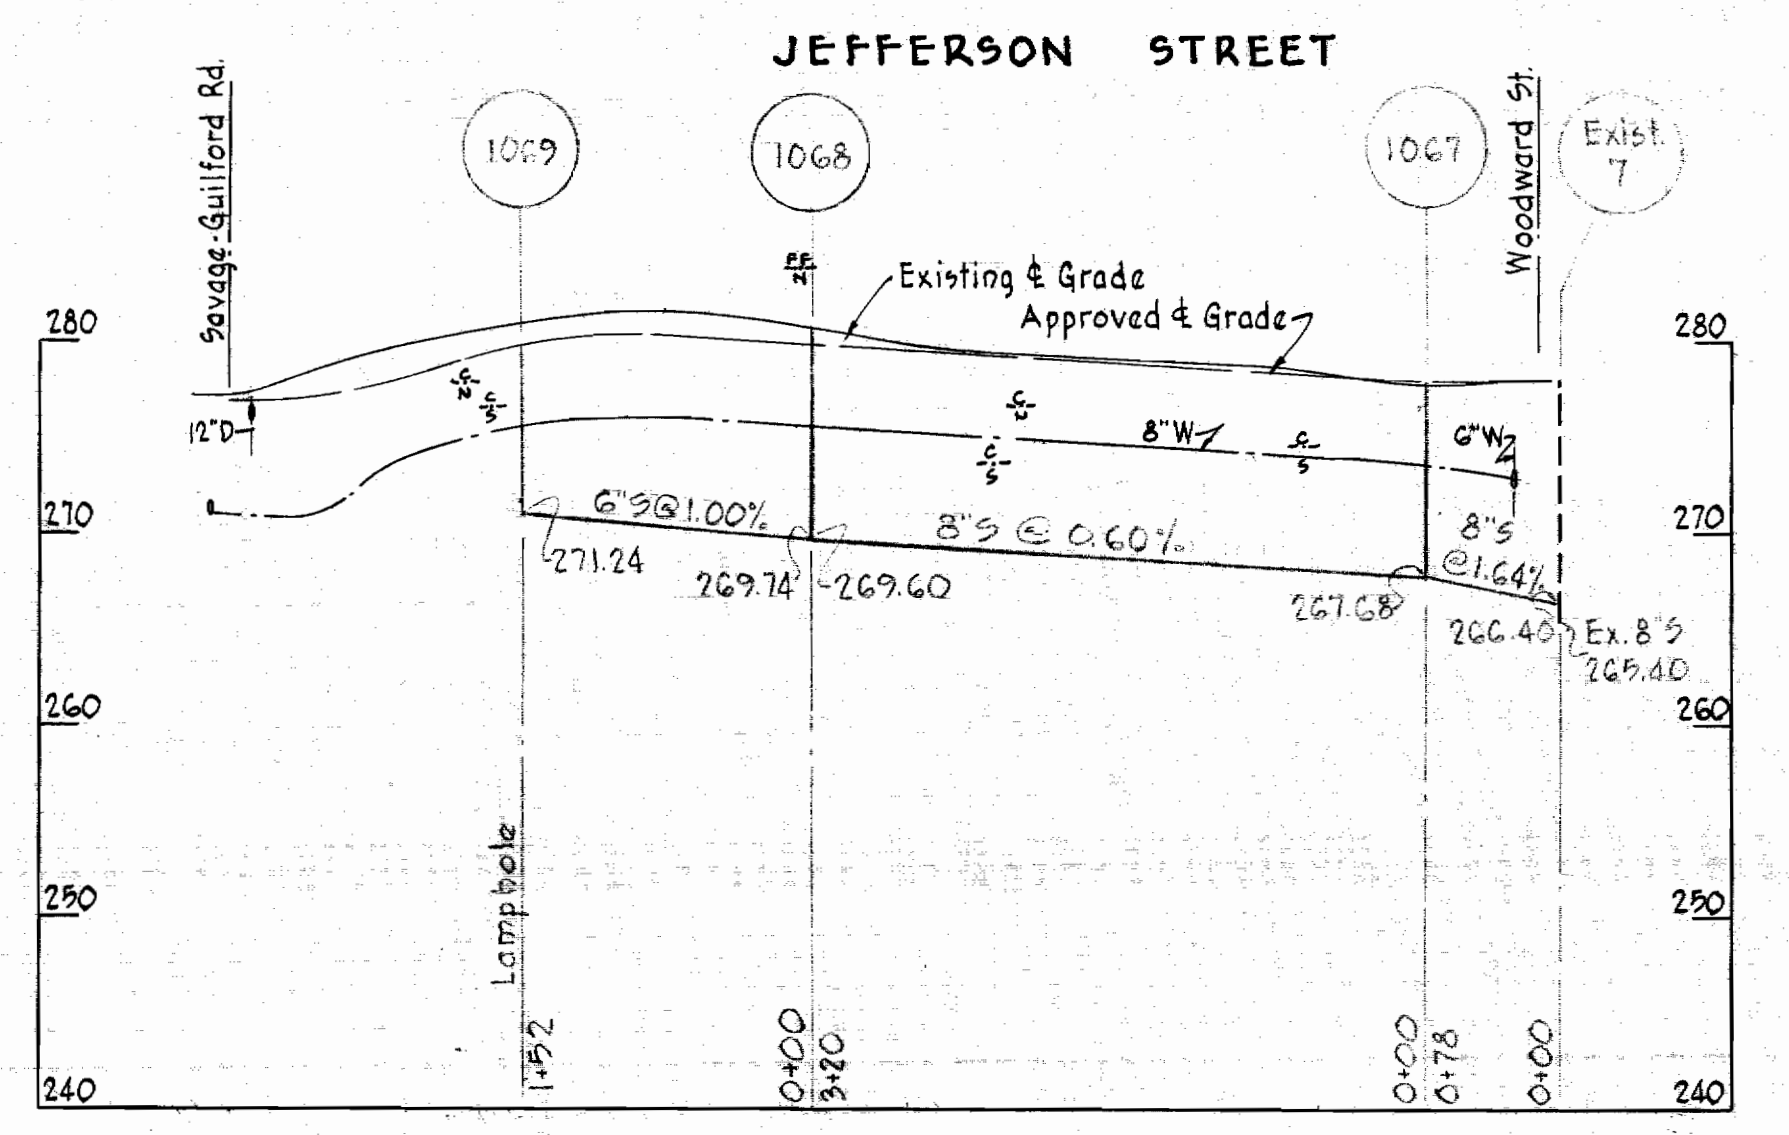

**PROFILE**  
Scale Vert. 1"=10'  
Horz. 1"=100'

**AS BUILT**

Contract 40-9

WHITMAN, REQUARDT & ASSOCIATES ENGINEERS 1304 ST. PAUL ST. BALTIMORE, MARYLAND	HOWARD COUNTY METROPOLITAN COMMISSION Feb. 18, 1962 <i>Carl W. Meyer</i> CHIEF ENGINEER	CONTRACT NO. 40-S	PLANS & PROFILES OF SEWER MAIN EXTENTIONS	PATUXENT SUB - DISTRICT	DRAWING NO. 1 OF 1 SCALE AS SHOWN 4" NE 18-3, 4
-----------------------------------------------------------------------------------------	--------------------------------------------------------------------------------------------------	-------------------	----------------------------------------------	-------------------------	-------------------------------------------------------

W. O. 5129-2

5 APR. 62 FB 2192

WS 40S/1