

W. 12 & A. B.M. #51-L Elev. 372.70
 2\"/>


PLAN
 Scale 1"=50'

WG5250
 511.5

WALKER DRIVE

GENERAL NOTES

1. Approximate location of existing mains are shown. The Contractor shall take all necessary precautions to protect the existing mains and services and maintain uninterrupted supply. Any damage incurred shall be repaired immediately.
2. All pipe elevations shown are invert elevation.
3. The Contractor shall locate existing utilities a minimum of two weeks in advance of construction operations in vicinity of utilities.
4. For all standard details, see standards bound in specifications.
5. Block all fittings with concrete, see standard details bound in specifications.
6. All water mains to be C.I.P. Class 22 and have a minimum of 35' cover.

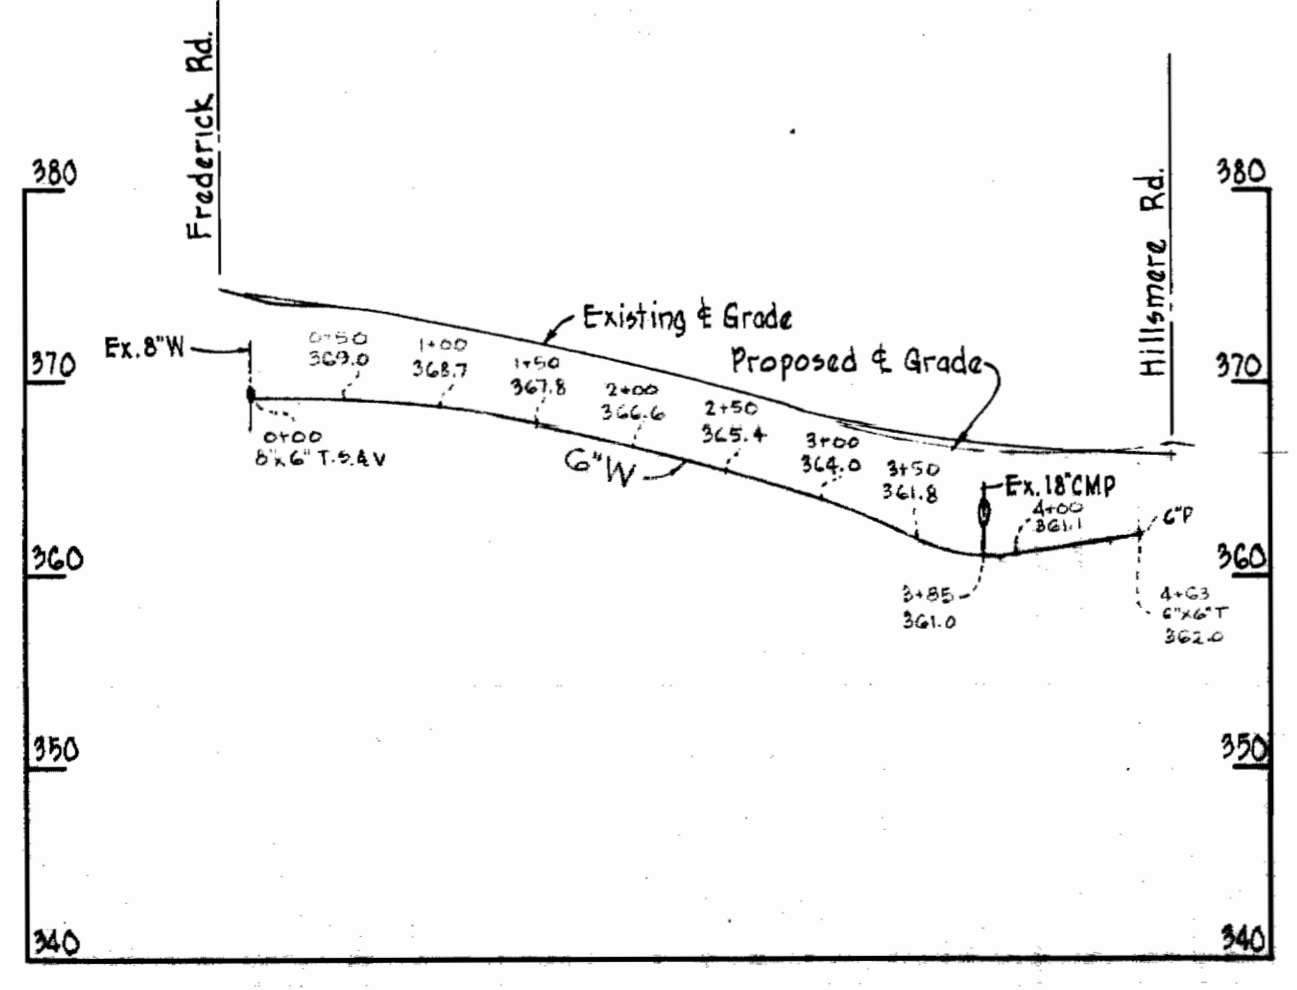

PROFILE
 Scale: Vert. 1"=10'
 Horz. 1"=100'

Glenbrook Section 2
 Contract 59-W

WHITMAN, REQUARDT & ASSOCIATES
 ENGINEERS
 1304 ST. PAUL ST.
 BALTIMORE, MARYLAND

HOWARD COUNTY METROPOLITAN COMMISSION
 DATE 2-19-1963
 Chief Engineer

CONTRACT NO. 59-W

PLAN & PROFILE
 OF WATER MAINS

ELLCOTT CITY SUB-DISTRICT

DRAWING NO. 1 OF 1
 SCALE AS SHOWN

AS BUILT - 20 JAN. 1964

WS 59W/1