


**GENERAL NOTES**

1. Approximate location of existing mains are shown. The Contractor shall take all necessary precautions to protect the existing mains and services and maintain uninterrupted supply. Any damage incurred shall be repaired immediately.
2. All pipe elevations shown are invert elevations.
3. For all standard details see Standards bound in Specifications.
4. All water mains to be C.I.P. Class 22 and have a minimum cover of 3 1/2'.
5. Block all fittings with concrete, see standard details bound in the Specifications.

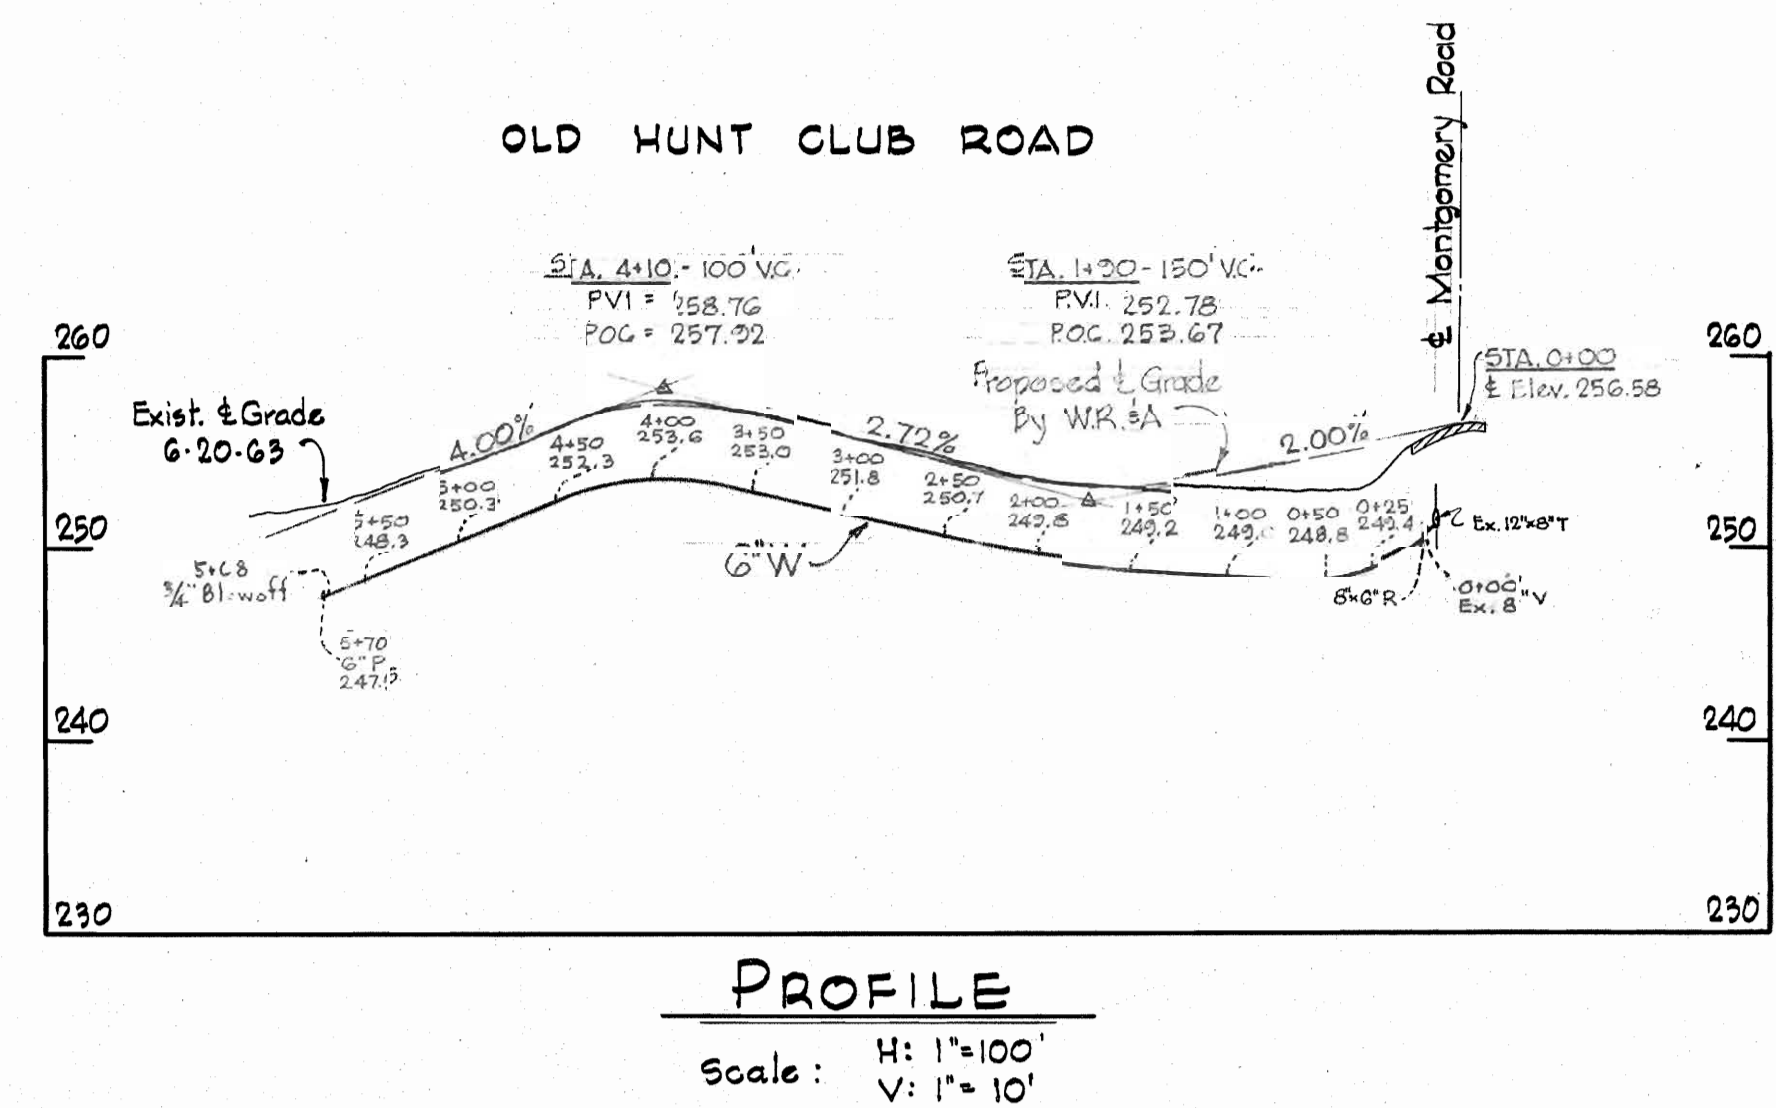

WHITMAN, REQUARDT & ASSOCIATES ENGINEERS 1304 ST. PAUL ST. BALTIMORE, MARYLAND	HOWARD COUNTY METROPOLITAN COMMISSION JULY 3, 1963 <i>Carl W. Meyer</i> CHIEF ENGINEER	CONTRACT NO. 60-W	PLAN AND PROFILE OF WATER MAIN	ELKRIDGE SUB-DISTRICT	Contract N <sup>o</sup> 60-W
					DRAWING NO. 1 OF 1

W. O. 5129-2

AS BUILT 30 JAN. 64

WS 60W/1