



GENERAL NOTES

1. The approximate location of existing mains are shown. The Contractor shall take all necessary precautions to protect existing mains and services and maintain uninterrupted supply. Any damage incurred shall be repaired immediately.
2. All pipe elevations shown are invert \ominus Elev.
3. All sewer mains to be C.S.P.X. or V.C.P.X. unless otherwise noted.

PLAN
Scale 1"=50'

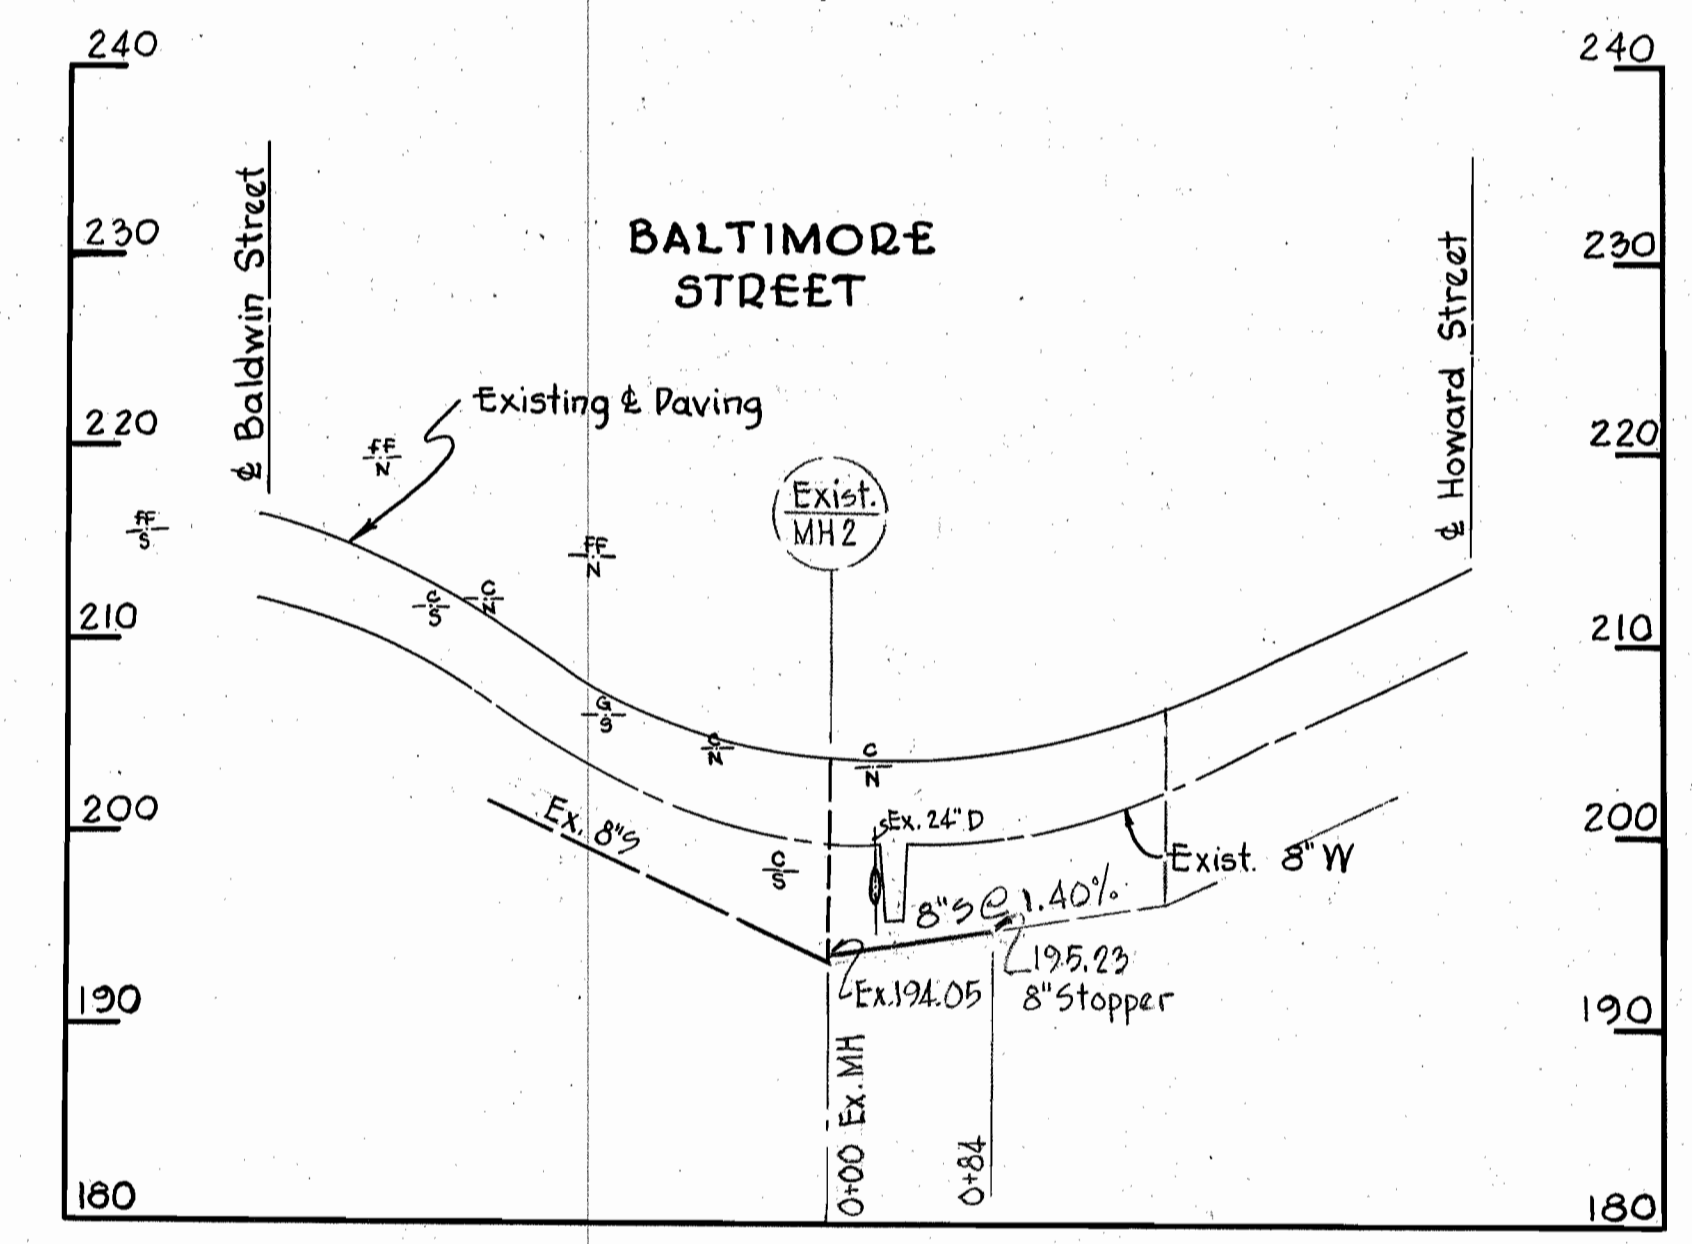

PROFILE
Scale: Vert. 1"=10'
Horz. 1"=100'

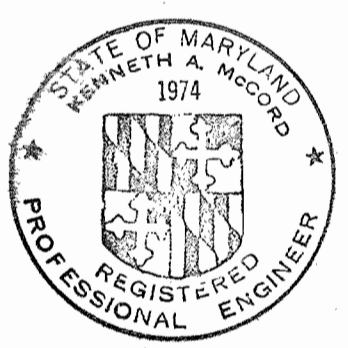

Thomas G. McLeod

WHITMAN, REQUARDT & ASSOCIATES ENGINEERS 1304 ST. PAUL ST. BALTIMORE, MARYLAND	HOWARD COUNTY METROPOLITAN COMMISSION Jan 3, 1964 <i>Carl W. Meyer</i> CHIEF ENGINEER	CONTRACT NO. 72-S	PLAN & PROFILE SEWER EXTENSION	PATUXENT SUB - DISTRICT	DRAWING NO. 1 OF 1 SCALE AS SHOWN
---	--	-------------------	-----------------------------------	-------------------------	--------------------------------------

W. O. 5129:2

AS BUILT 13 FEB. 64

WS 72-S/1