



W.R.# B.M. No. 51-P Elev. 411.57
 R.R. spike base of P pole #835, S side
 Frederick Rd. 625' E. of int. of
 Frederick Rd. & Centennial Lane.

2/13/69 Added Driveways
 N:1 Date Revision

Match Line 'DD' See Drawing No. 5

Contract No. 316-W

WHITMAN, REQUARDT & ASSOCIATES ENGINEERS 1304 ST. PAUL ST. BALTIMORE, MARYLAND	HOWARD COUNTY METROPOLITAN COMMISSION 9-25-68 <i>W O P</i> DATE CHIEF ENGINEER	CONTRACT NO. 316-W	PLAN OF WATER MAINS	ELLICOTT CITY FONT HILL MANOR, GLEN BROOK, OAK LEA ELECTION DISTRICT ELLICOTT CITY No. 2	DRAWING NO 1 OF 2 SCALE 1"=50'
---	--	--------------------	------------------------	--	-----------------------------------

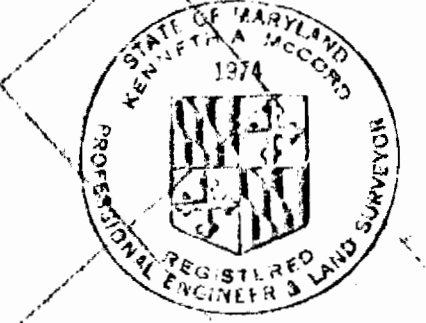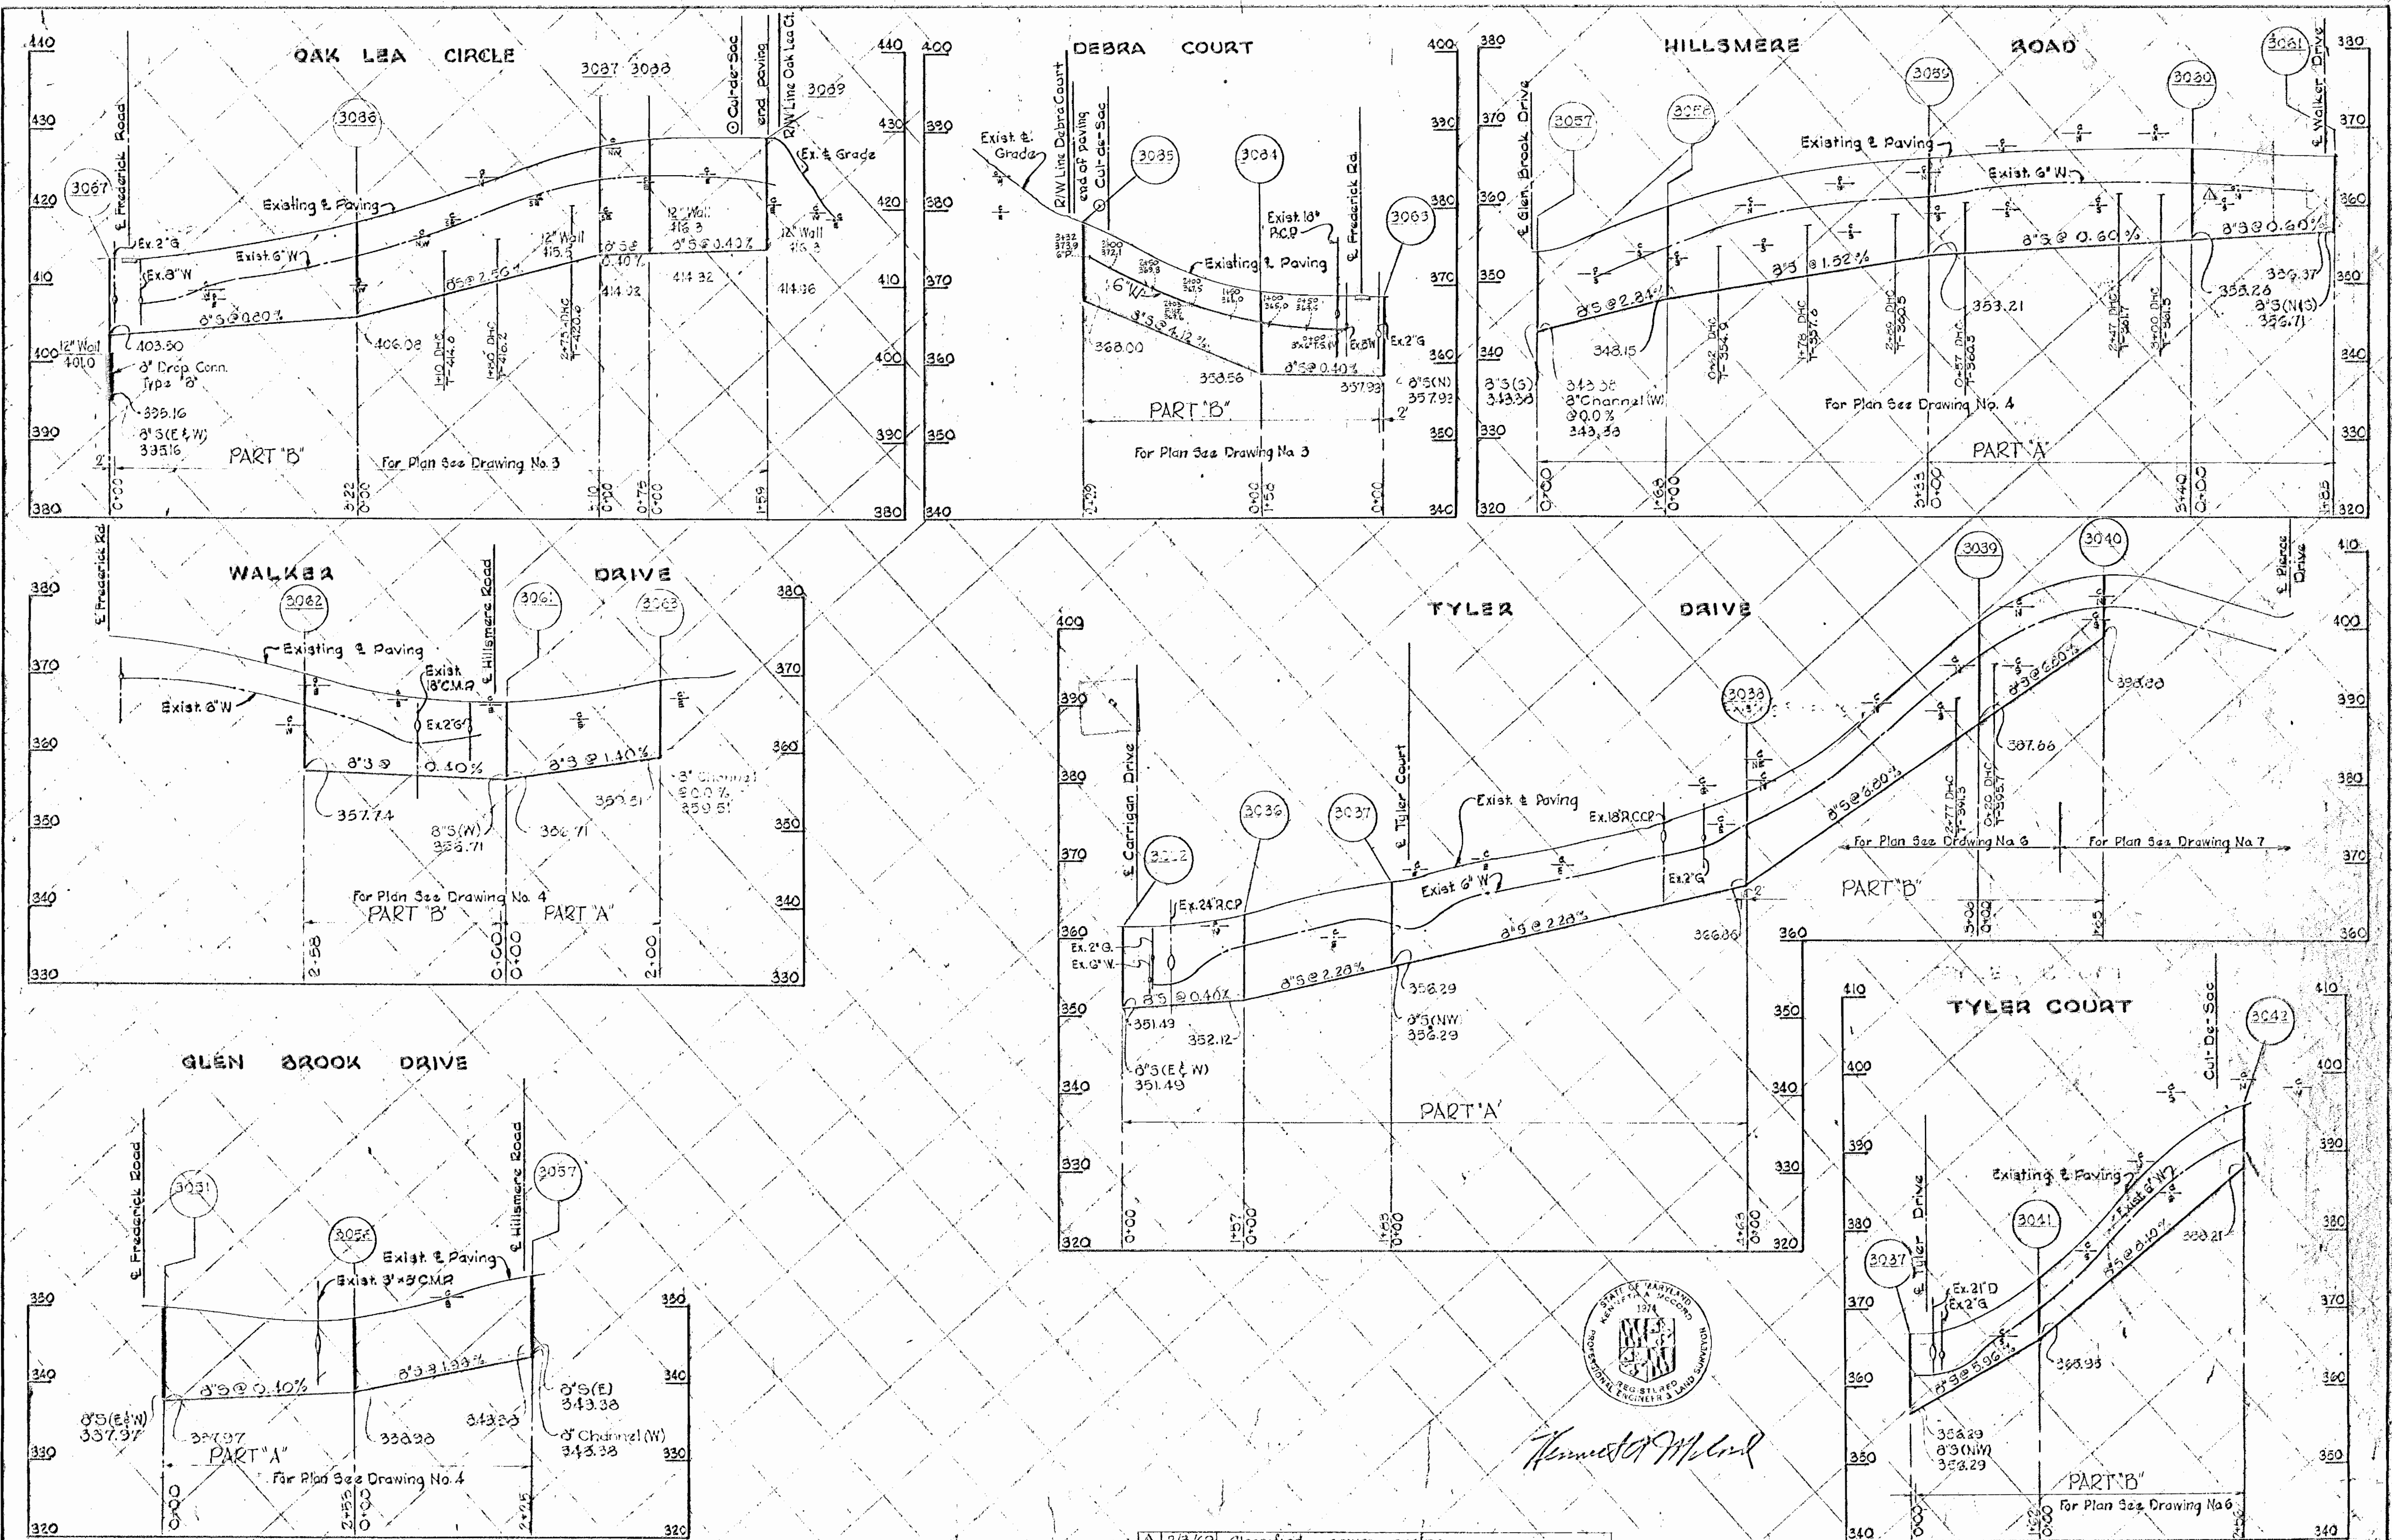

Handwritten signature

▲	2/3/63	Classified sewer mains.
▼		Revision

WHITMAN, REQUARDT & ASSOCIATES
 ENGINEERS
 1304 ST. PAUL ST.
 BALTIMORE, MARYLAND

HOWARD COUNTY METROPOLITAN COMMISSION
 DATE 1-23-62 *Handwritten signature*
 CHIEF ENGINEER

CONTRACT NO. 316-W

PROFILES OF WATER MAINS

ELICOTT CITY
 FONT HILL MANOR, GLEN BROOK, OAK LEA
 ELECTION DISTRICT-ELICOTT CITY No. 2

DRAWING NO. 2 OF 2
 SCALE: HORIZONTAL 1"=100' VERTICAL 1"=10'
 CONTRACT #316-W