


SUPERIOR

SUPERIOR

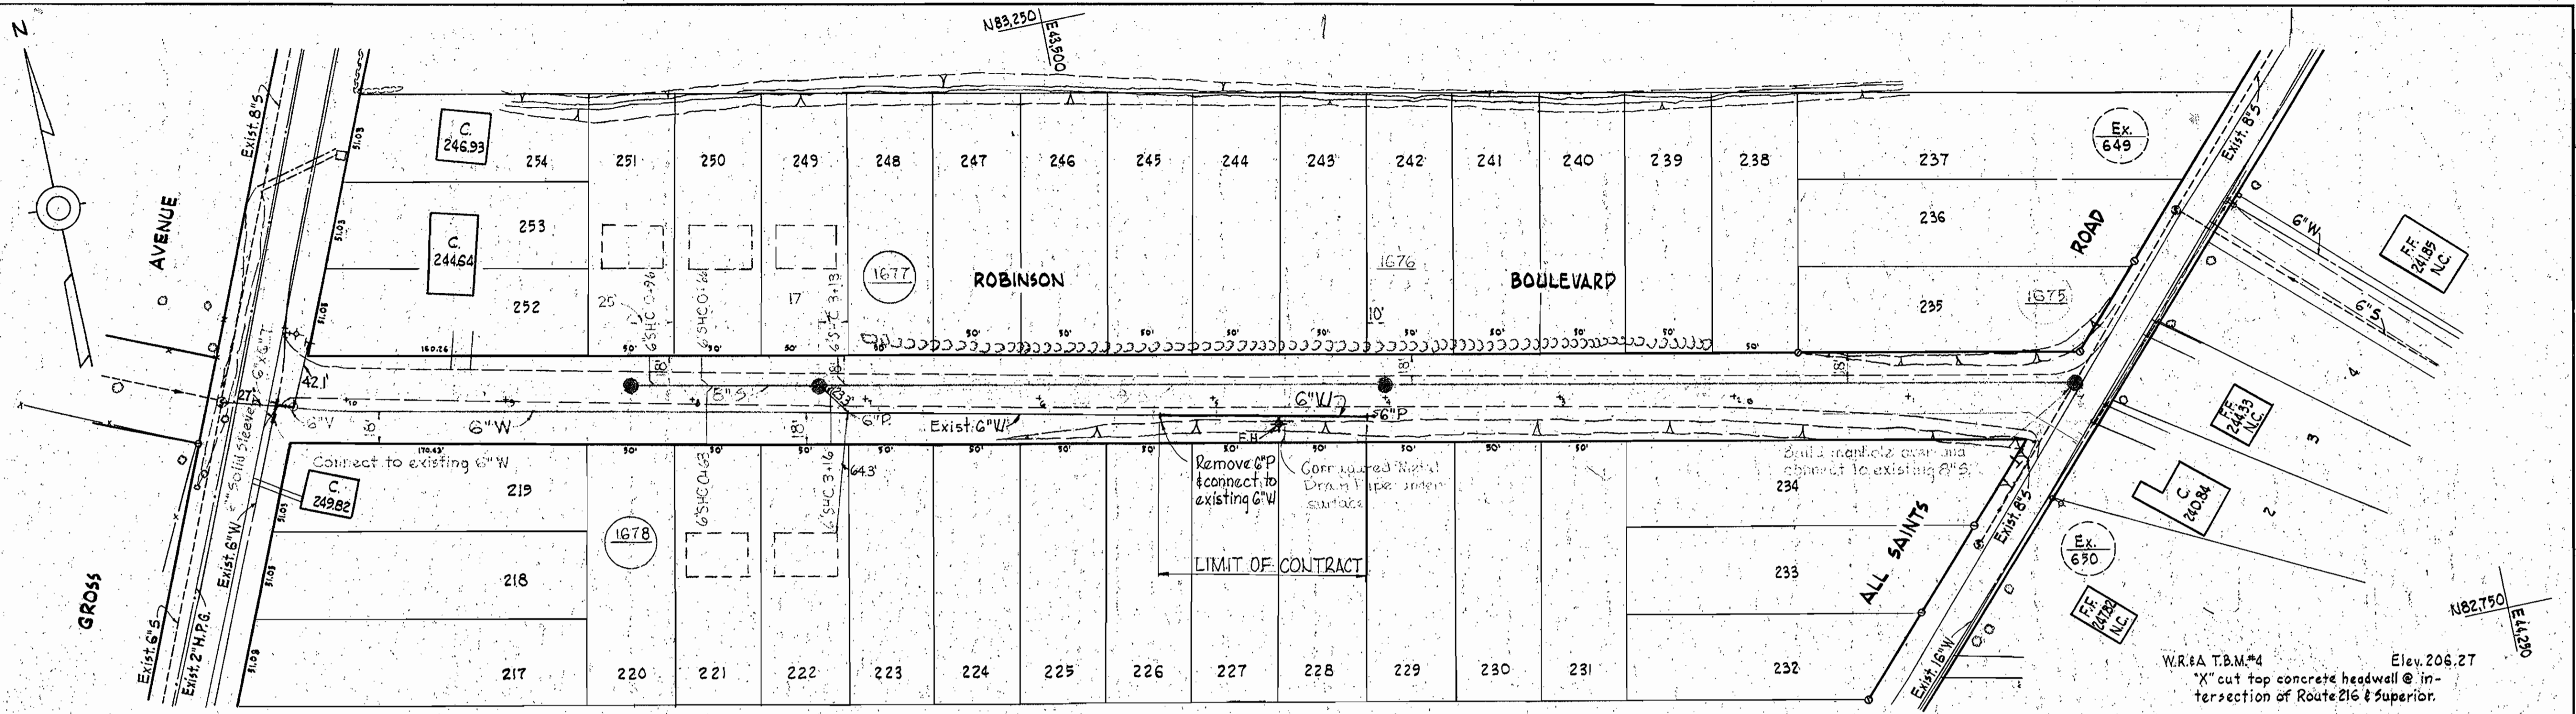


Note:
Time of connection to existing water main shall be made during normal working hours.


PLAN
Scale: 1"=50'

GENERAL NOTES

1. Approximate location of existing mains are shown. The Contractor shall take all necessary precautions to protect existing mains and services and maintain uninterrupted supply. Any damage incurred shall be repaired immediately.
2. All pipe elevations shown are invert elevations.
3. The Contractor shall locate existing utilities a minimum of two weeks in advance of construction operations in vicinity of utilities.
4. For all standard details see standards bound in Specifications.
5. All water mains to be C.I.P. or D.I.P. and have a minimum of 3/4" cover.
6. Block all fittings with concrete, see standard details bound in Specifications.
7. The Contractor shall provide a joint in all sewer mains within 2'-0" of manhole walls.
8. Clear all poles by 2'-0" minimum or tunnel as required. Clear all existing utilities by 6" minimum.

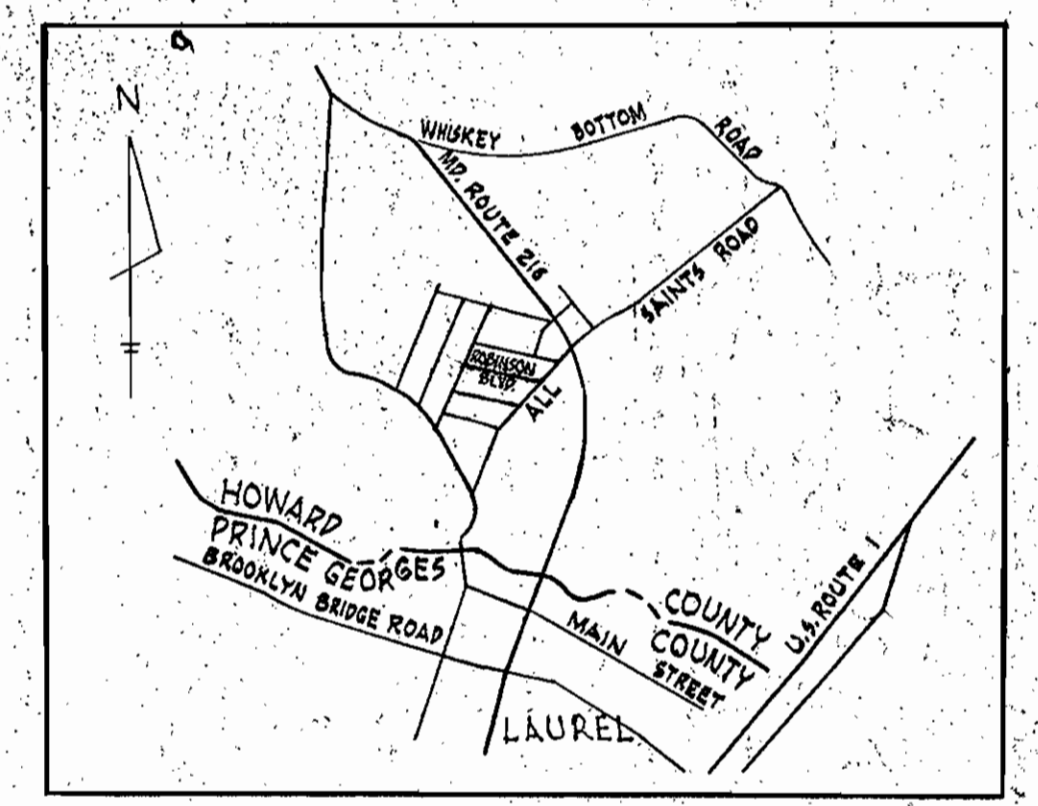

VICINITY MAP
Scale: 1"=1/2 mile

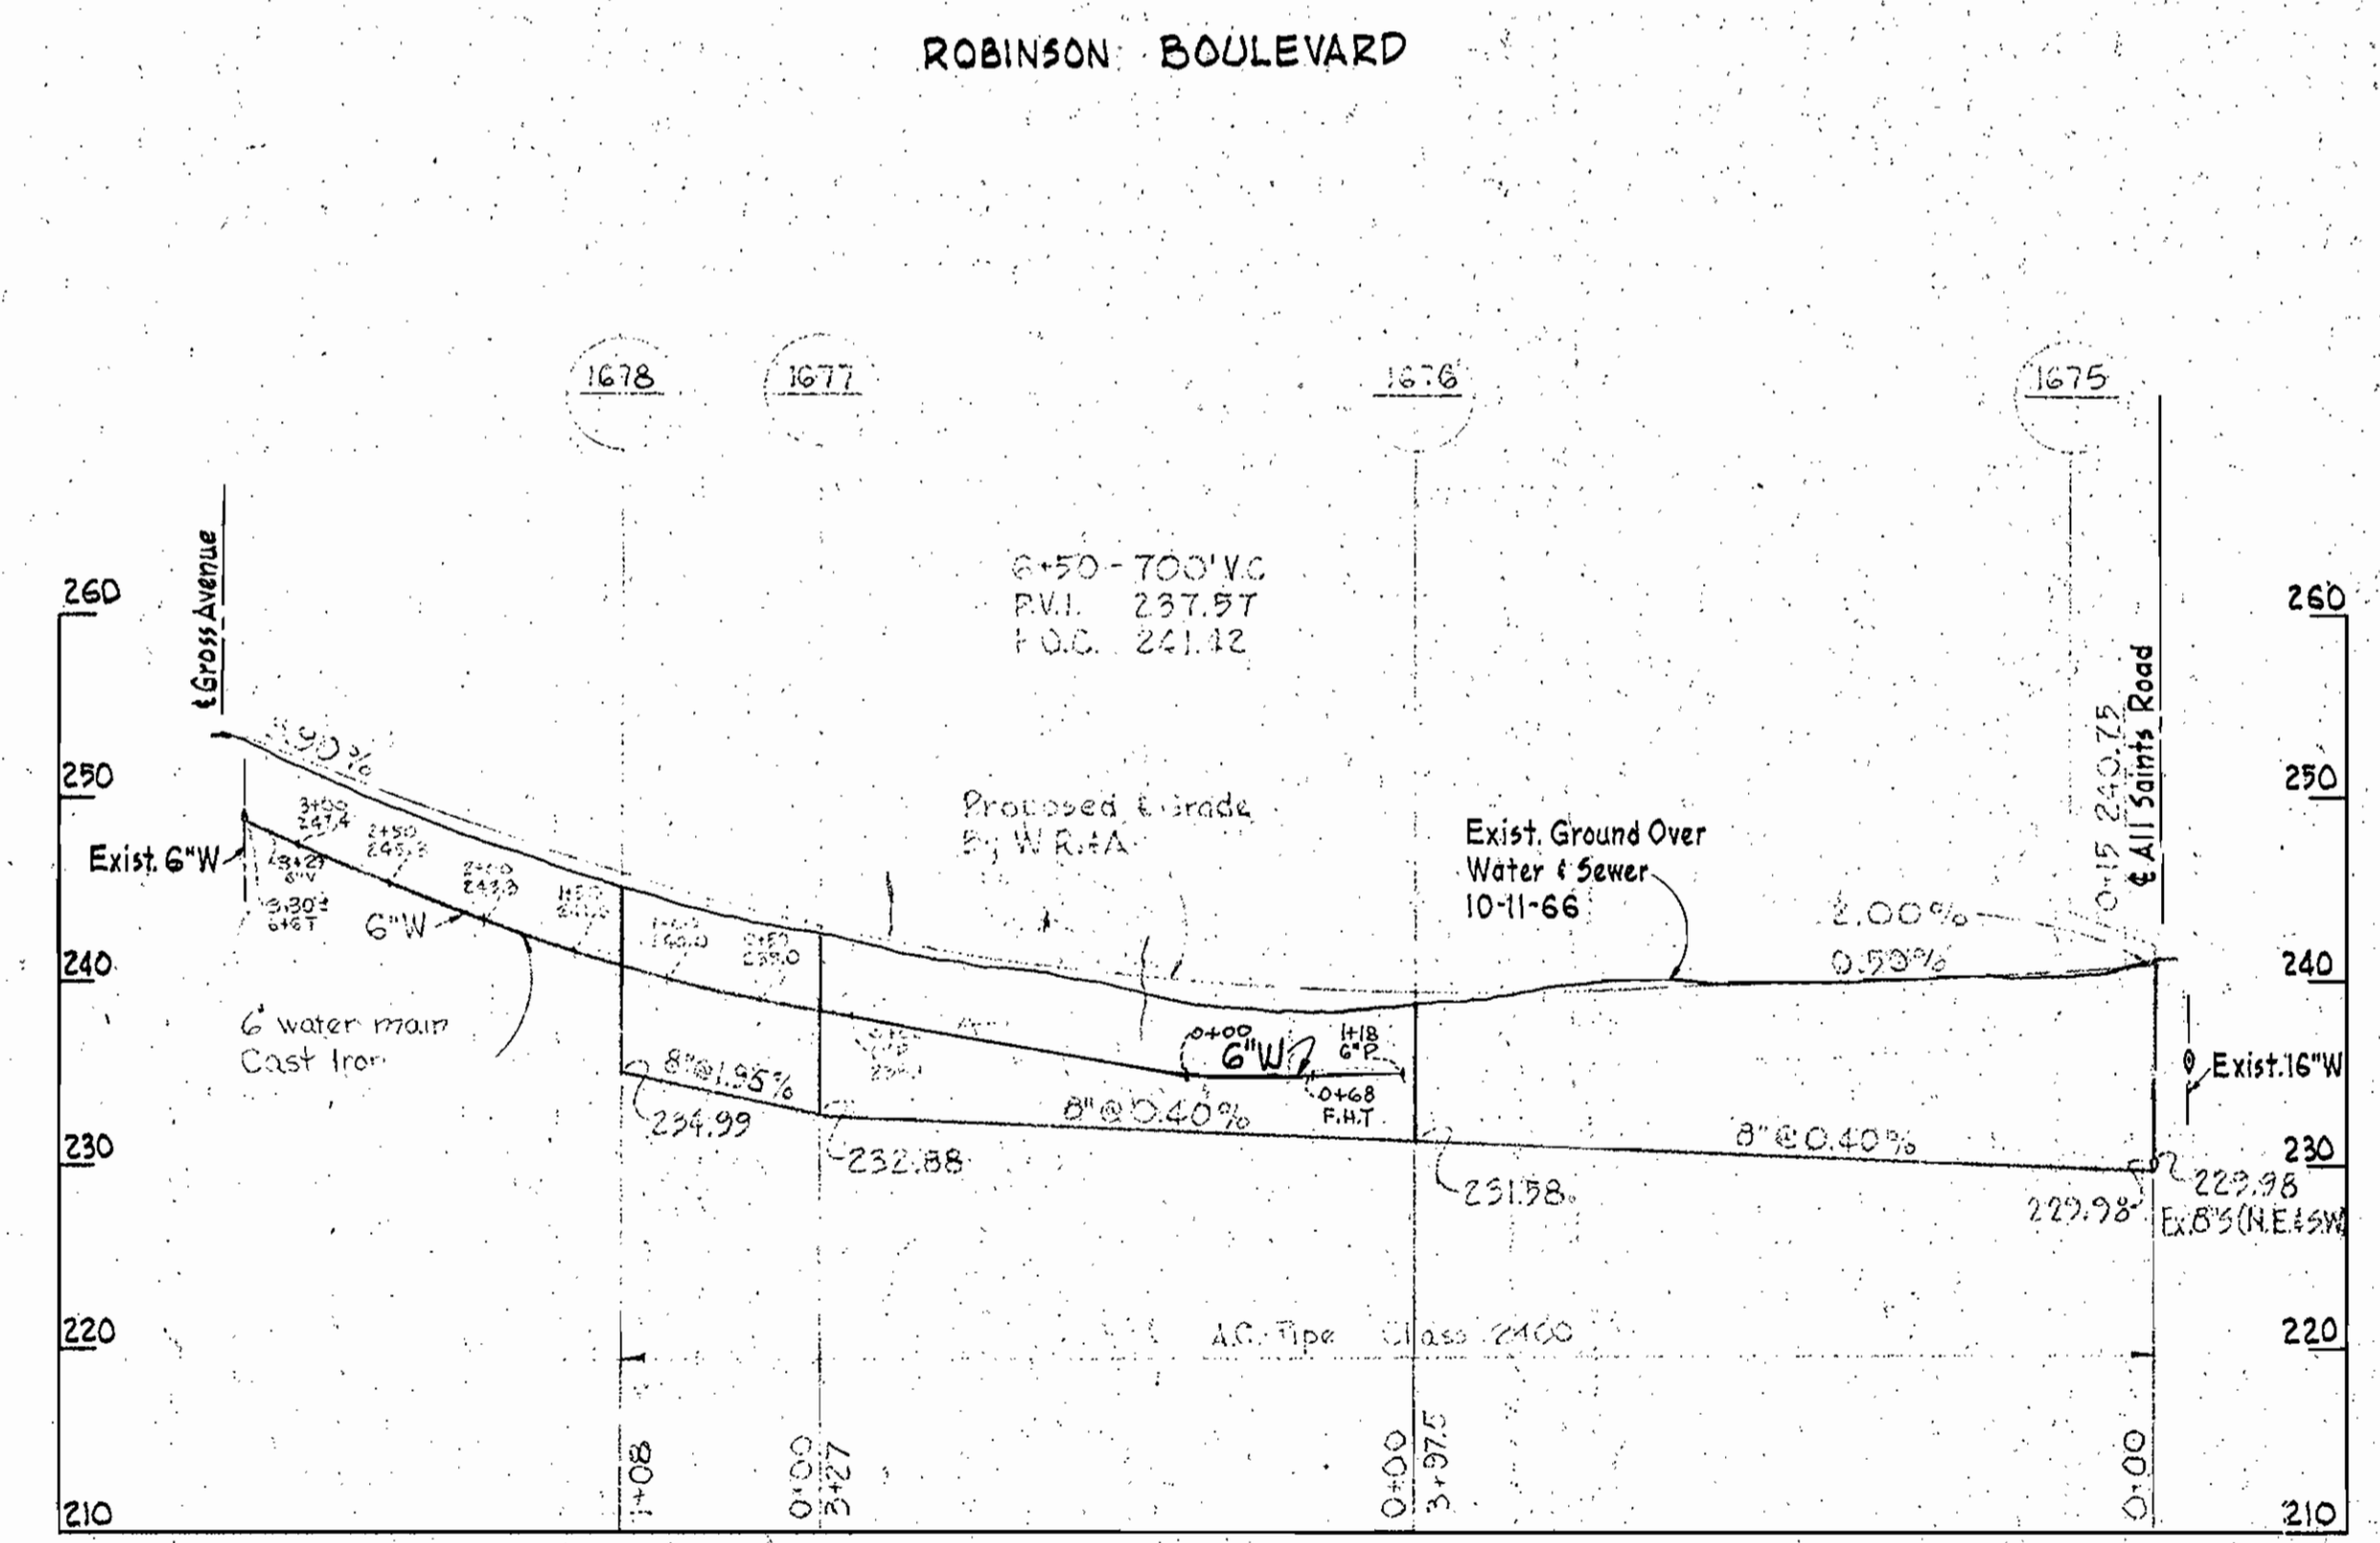

PROFILE
Hor. 1"=100'
Vert. 1"=10'

[Signature]
Robinson Blvd.
Contract No. 331-W/161WSS

WHITMAN, REQUARDT & ASSOCIATES
ENGINEERS
1304 ST. PAUL ST.
BALTIMORE, MARYLAND

HOWARD COUNTY METROPOLITAN COMMISSION
DATE 10-27-66
W. O. Libart
CHIEF ENGINEER

CONTRACT NO. 331-W/161WSS

PLAN AND PROFILE OF
WATER & SEWER MAINS

ELECTION DISTRICT
GUILFORD NO. 6

DRAWING NO. 1 OF 1
SCALE AS SHOWN

WS 331-W/1