

VICINITY MAP
Scale: 1"=600'

GENERAL NOTES

1. Approximate location of existing mains are shown. The Contractor shall take all necessary precautions to protect existing mains and services and maintain uninterrupted supply. Any damage incurred shall be repaired immediately.
2. All pipe elevations shown are invert elevations.
3. The Contractor shall locate existing utilities a minimum of two weeks in advance of construction operations in vicinity of utilities.
4. For standard Details see standards bound in specifications.
5. Horiz. control is based on subdivision plat, Mount Hebron - section 12. Vert. control is based on Howard County Datum.
6. Clear all utilities by a minimum of 6'; clear all poles by a minimum of 2'-0" or tunnel as required.
7. All water mains are to have a minimum of 3 1/2' cover.
8. Block all fittings with concrete, see standards bound in specifications.
9. Bury Line elevations on fire hydrants shall be set to elevations shown on drawings or as directed by the Engineer in the field.
10. All fire hydrants shall be strapped and buttressed in accordance with standard details.
11. Cost of strapping fire hydrants and valves to trees to be included in unit price bid for furnishing and laying water mains.

QUANTITIES	
6" Water	2,200'
Fire Hydrants	3

Stakeout & Diary: FB# 4931



James M. McLeod

R#J.B.M.*F W.R.#A. Elev. 428.81'
Roadside Bonnet Bolt
of fire hydrant, Furrow Ave.

R#J.B.M.*E W.R.#A. Elev. 446.97'
Railroad Spike set in
G.E. pole no. 281124.

Remove Plug and Buttress
and connect to Existing
Water Built under Contract
No. 71-W.

Mount Hebron
Section Twelve
Contract No. 406-W

WHITMAN, REQUARDT & ASSOCIATES
ENGINEERS
1304 ST. PAUL ST.
BALTIMORE, MARYLAND

DEPARTMENT OF PUBLIC WORKS
HOWARD COUNTY, MARYLAND
DATE: 8-31-71
W. O. Falbert
CHIEF - BUREAU OF WATER AND SEWER

CONTRACT NO. 406 W

**PLAN OF
WATER MAINS**

ELLICOTT CITY SUB-DISTRICT


DRAWING NO. 1 OF 2
SCALE 1"=50'
555-584
555-585
556-584
556-585

AS BUILT

AUGUST 31, 1971


W. O. 6024-2

FURROW AVENUE

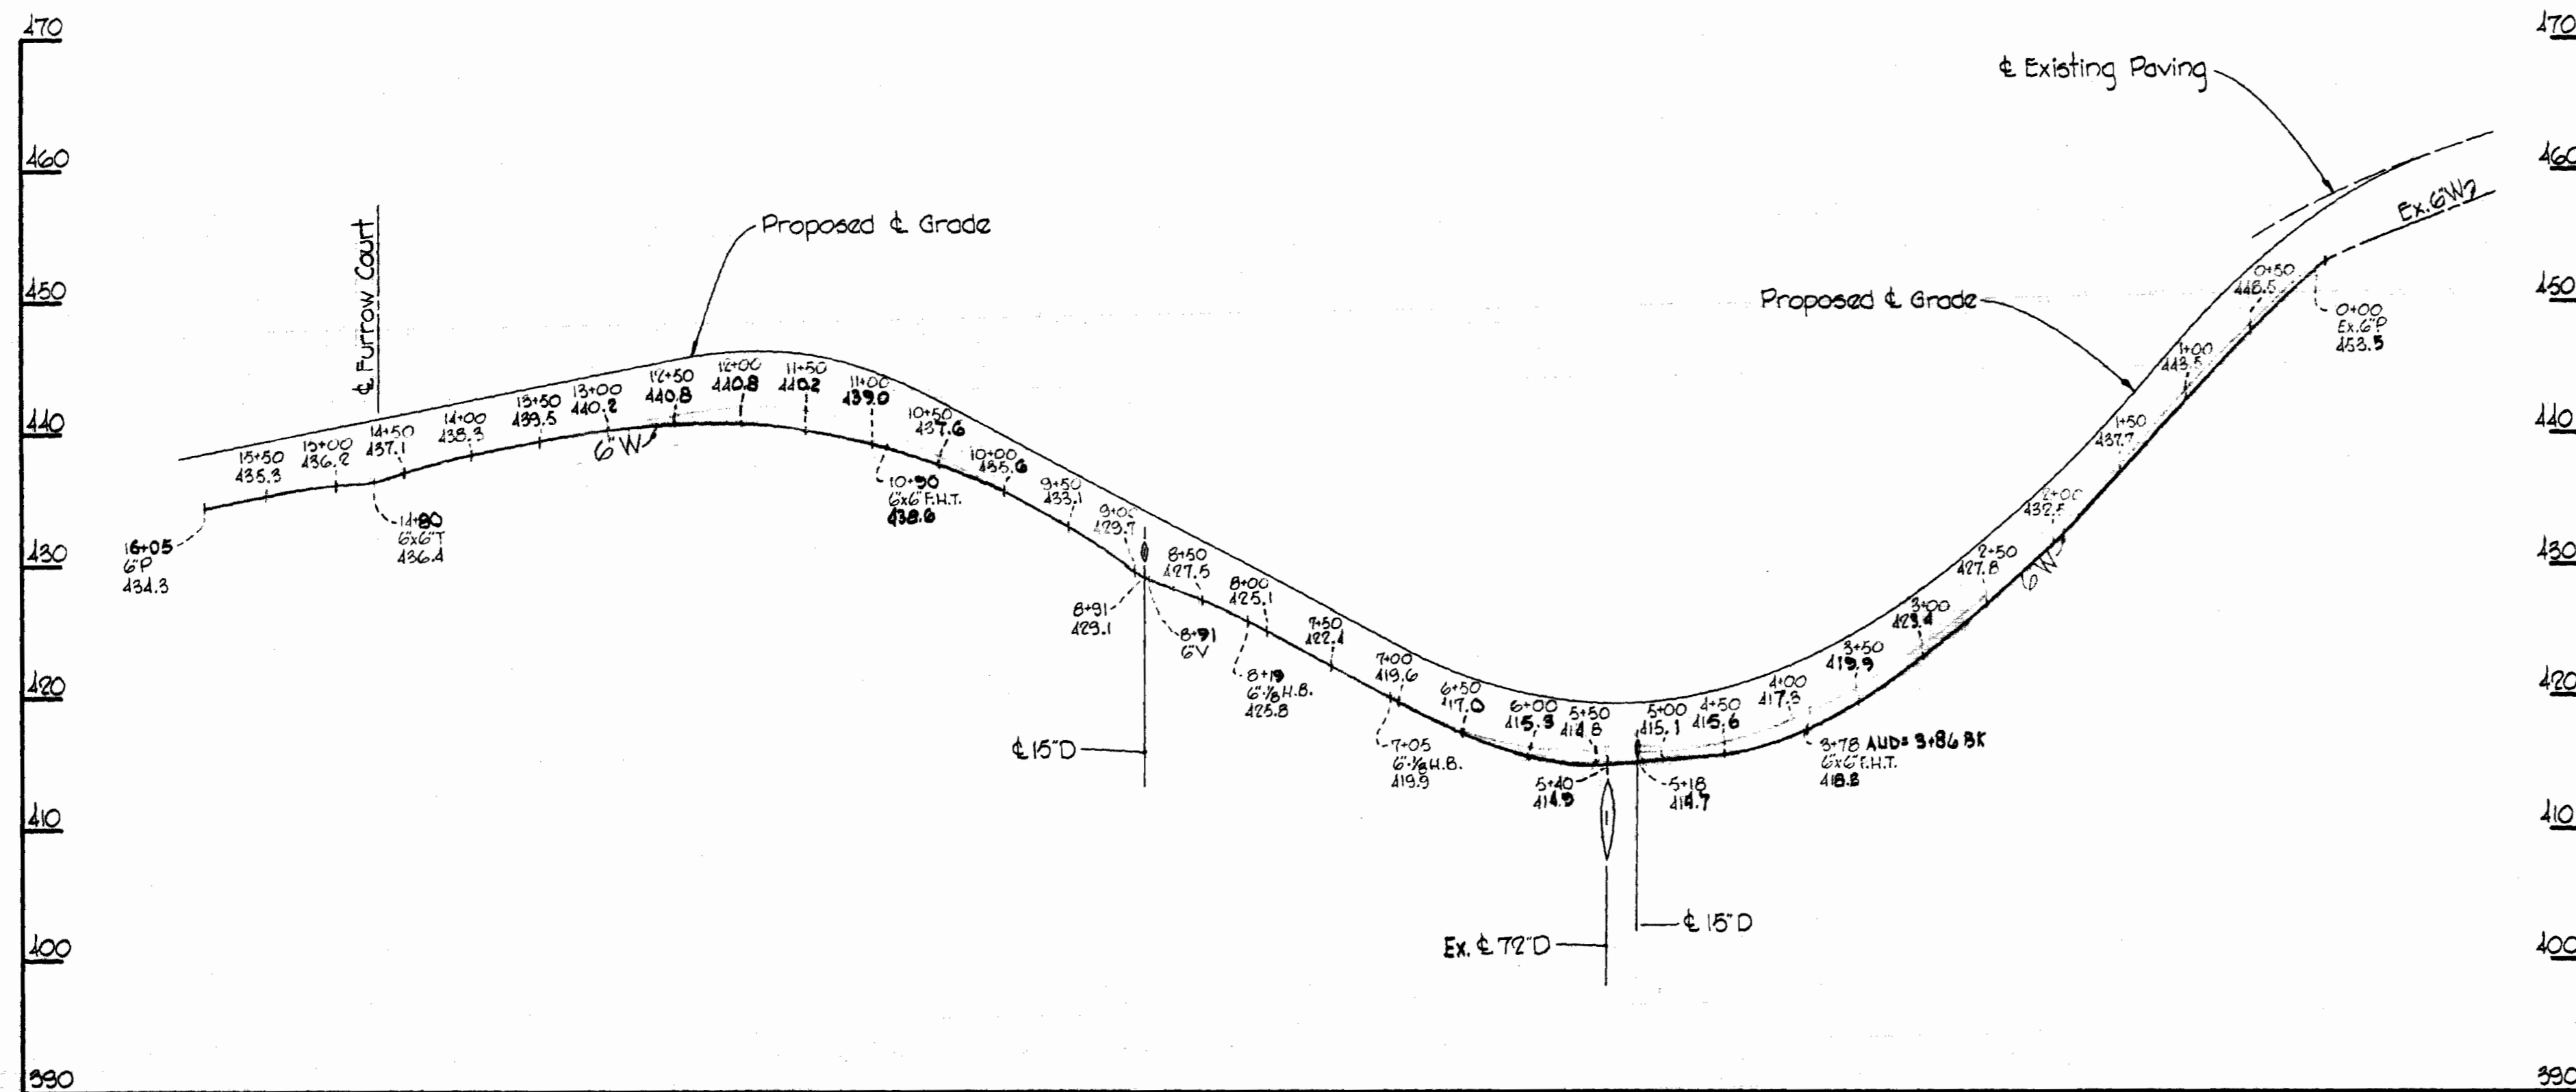

All Water Pipe: Cast Iron

FURROW COURT

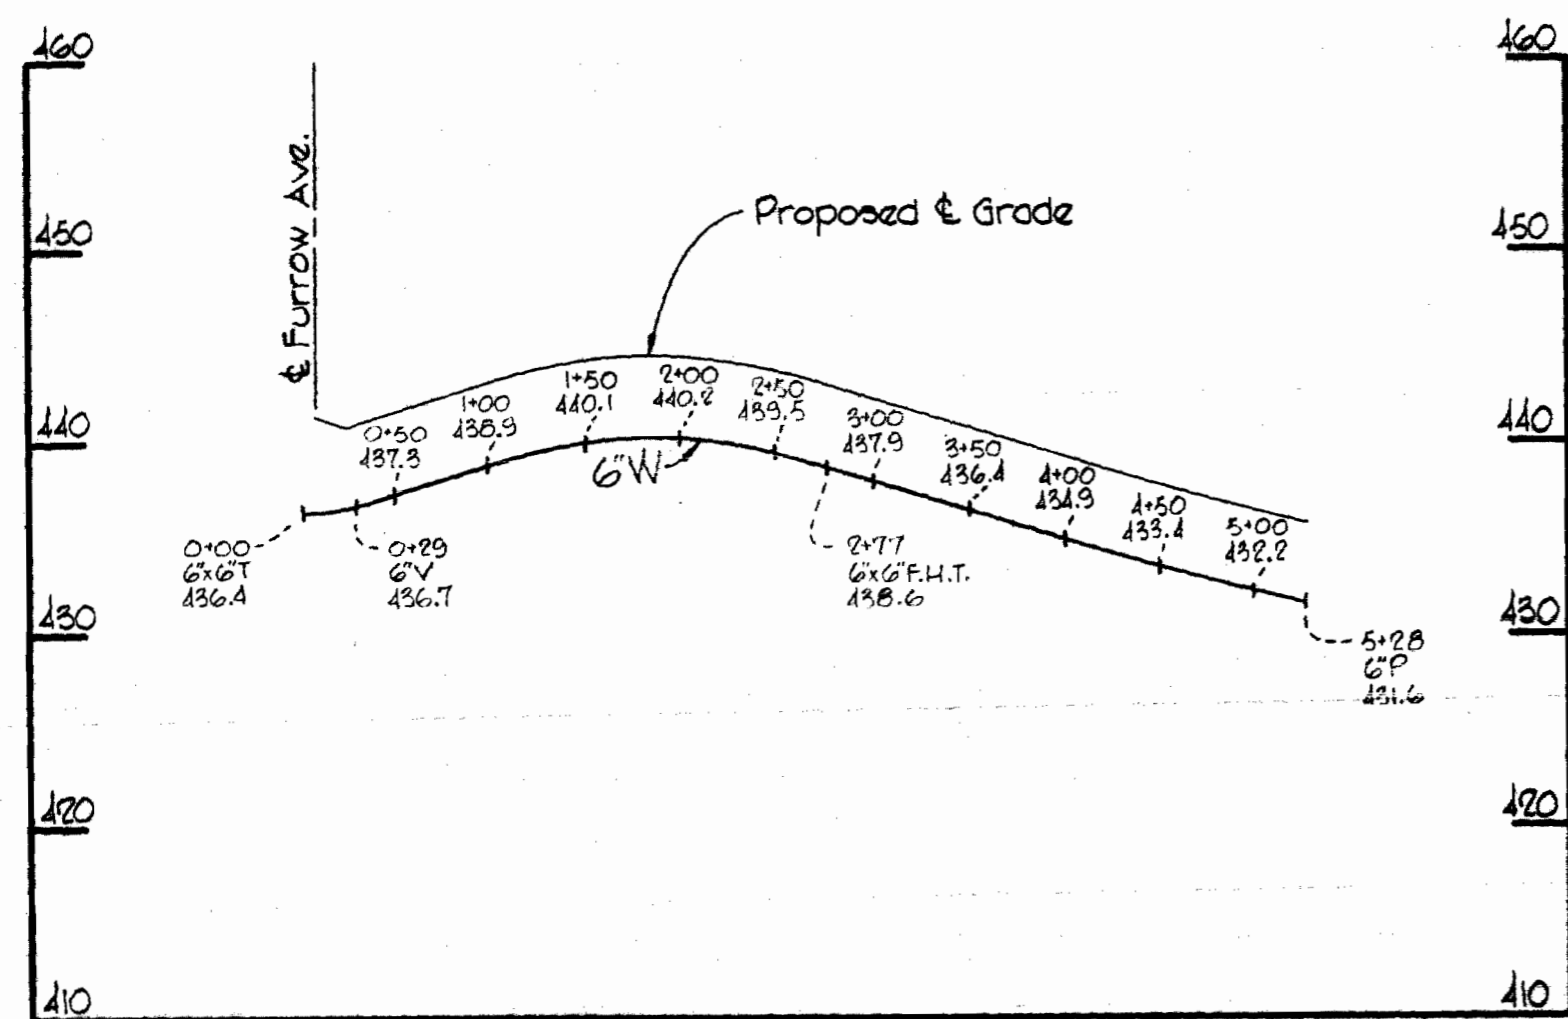

Kenneth A. McLeod

Mount Hebron
Section Twelve
Contract No. 406-W

WHITMAN, REQUARDT & ASSOCIATES
ENGINEERS
1304 ST. PAUL ST.
BALTIMORE, MARYLAND

DEPARTMENT OF PUBLIC WORKS

HOWARD COUNTY, MARYLAND

2-11-71
DATE

W. O. Falbert
CHIEF-BUREAU OF WATER AND SEWER

CONTRACT NO. 406 W

PROFILES OF
WATER MAINS

ELLICOTT CITY SUB-DISTRICT

DRAWING
NO. 2
OF 2

SCALE
H: 1"=100'
V: 1"=10'

WS 406-W/2