


VICINITY MAP  
SCALE: 1" = 800'





WATER HOSE CONNECTION SCHEDULE						SANITARY HOSE CONNECTION SCHEDULE					
BLDG. NO.	WATER CONN.	BLDG. NO.	WATER CONN.	BLDG. NO.	WATER CONN.	BLDG. NO.	SAN. CONN.	BLDG. NO.	SAN. CONN.	BLDG. NO.	SAN. CONN.
G-1	TWIN	G-23	TWIN	G-30	TWIN	G-1	SINGLE	G-26	TWIN	G-31	TWIN
G-2	TWIN	G-24	TWIN	G-31	TWIN	G-2	TWIN	G-27	TWIN	G-32	SINGLE
G-3	TWIN	G-25	TWIN	G-32	TWIN	G-3	SINGLE	G-28	TWIN	G-33	SINGLE
G-4	TWIN	G-26	TWIN	G-33	TWIN	G-4	SINGLE	G-29	TWIN	G-34	TWIN
G-5	TWIN	G-27	TWIN	G-34	TWIN	G-5	TWIN	G-30	TWIN	G-35	TWIN
G-6	TWIN	G-28	TWIN	G-35	TWIN	G-6	TWIN	G-31	TWIN	G-36	TWIN
G-7	TWIN	G-29	TWIN	G-36	TWIN	G-7	TWIN	G-32	TWIN	G-37	TWIN
G-8	TWIN	G-30	TWIN	G-37	TWIN	G-8	TWIN	G-33	TWIN	G-38	TWIN
G-9	TWIN	G-31	TWIN	G-38	TWIN	G-9	TWIN	G-34	TWIN	G-39	TWIN
G-10	TWIN	G-32	TWIN	G-39	TWIN	G-10	TWIN	G-35	TWIN	G-40	TWIN
G-11	TWIN	G-33	TWIN	G-40	TWIN	G-11	TWIN	G-36	TWIN	G-41	TWIN
G-12	TWIN	G-34	TWIN	G-41	TWIN	G-12	TWIN	G-37	TWIN	G-42	TWIN
G-13	TWIN	G-35	TWIN	G-42	TWIN	G-13	TWIN	G-38	TWIN	G-43	TWIN
G-14	TWIN	G-36	TWIN	G-43	TWIN	G-14	TWIN	G-39	TWIN	G-44	TWIN
G-15	TWIN	G-37	TWIN	G-44	TWIN	G-15	TWIN	G-40	TWIN	G-45	TWIN
G-16	TWIN	G-38	TWIN	G-45	TWIN	G-16	TWIN	G-41	TWIN	G-46	TWIN
G-17	TWIN	G-39	TWIN	G-46	TWIN	G-17	TWIN	G-42	TWIN	G-47	TWIN
G-18	TWIN	G-40	TWIN	G-47	TWIN	G-18	TWIN	G-43	TWIN	G-48	TWIN
G-19	TWIN	G-41	TWIN	G-48	TWIN	G-19	TWIN	G-44	TWIN	G-49	TWIN
G-20	TWIN	G-42	TWIN	G-49	TWIN	G-20	TWIN	G-45	TWIN	G-50	TWIN
G-21	TWIN	G-43	TWIN	G-50	TWIN	G-21	TWIN	G-46	TWIN	G-51	TWIN
G-22	TWIN	G-44	TWIN	G-51	TWIN	G-22	TWIN	G-47	TWIN	G-52	TWIN
G-23	TWIN	G-45	TWIN	G-52	TWIN	G-23	TWIN	G-48	TWIN	G-53	TWIN
G-24	SINGLE	G-46	TWIN	G-53	TWIN	G-24	TWIN	G-49	TWIN	G-54	TWIN
G-25	SINGLE	G-47	TWIN	G-54	TWIN	G-25	TWIN	G-50	TWIN	G-55	TWIN
G-26	SINGLE	G-48	TWIN	G-55	TWIN	G-26	TWIN	G-51	TWIN	G-56	TWIN
G-130	SINGLE	G-152	TWIN	G-159	TWIN	G-130	TWIN	G-155	TWIN	G-160	TWIN
G-131	SINGLE	G-153	TWIN	G-160	TWIN	G-131	TWIN	G			

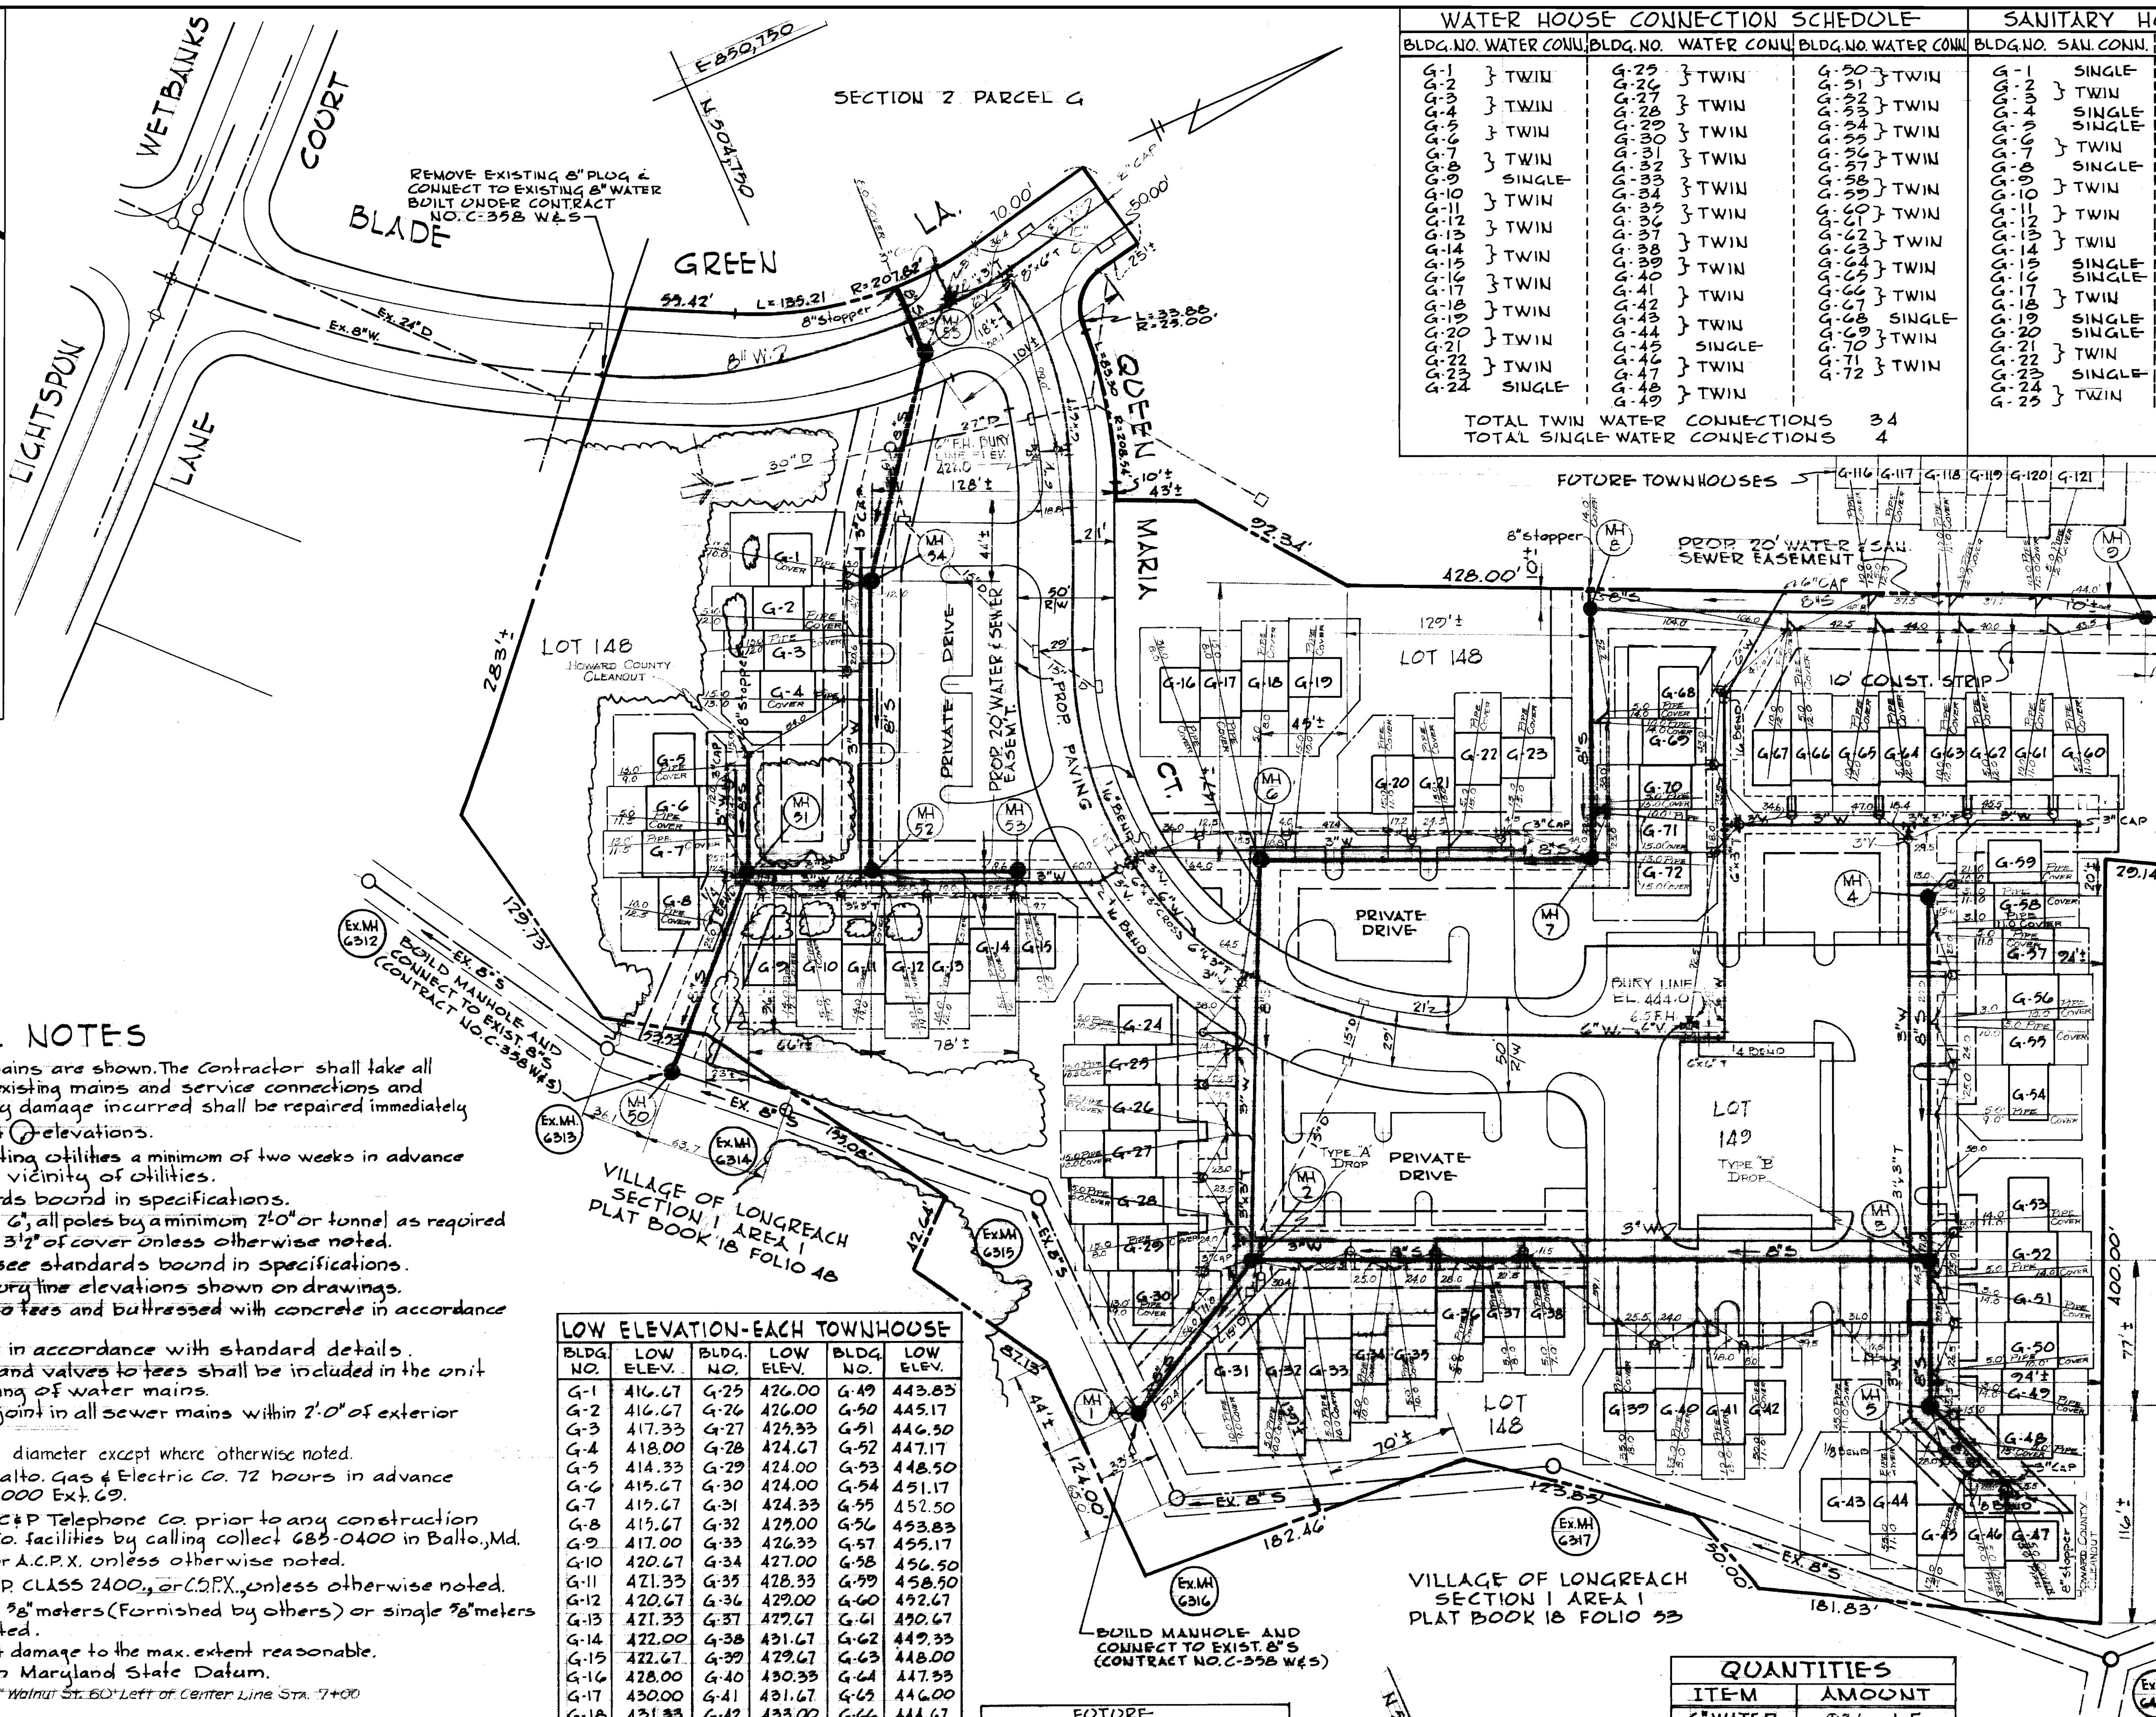

SUSPENSE

SUSPENSE

SUSPENSE

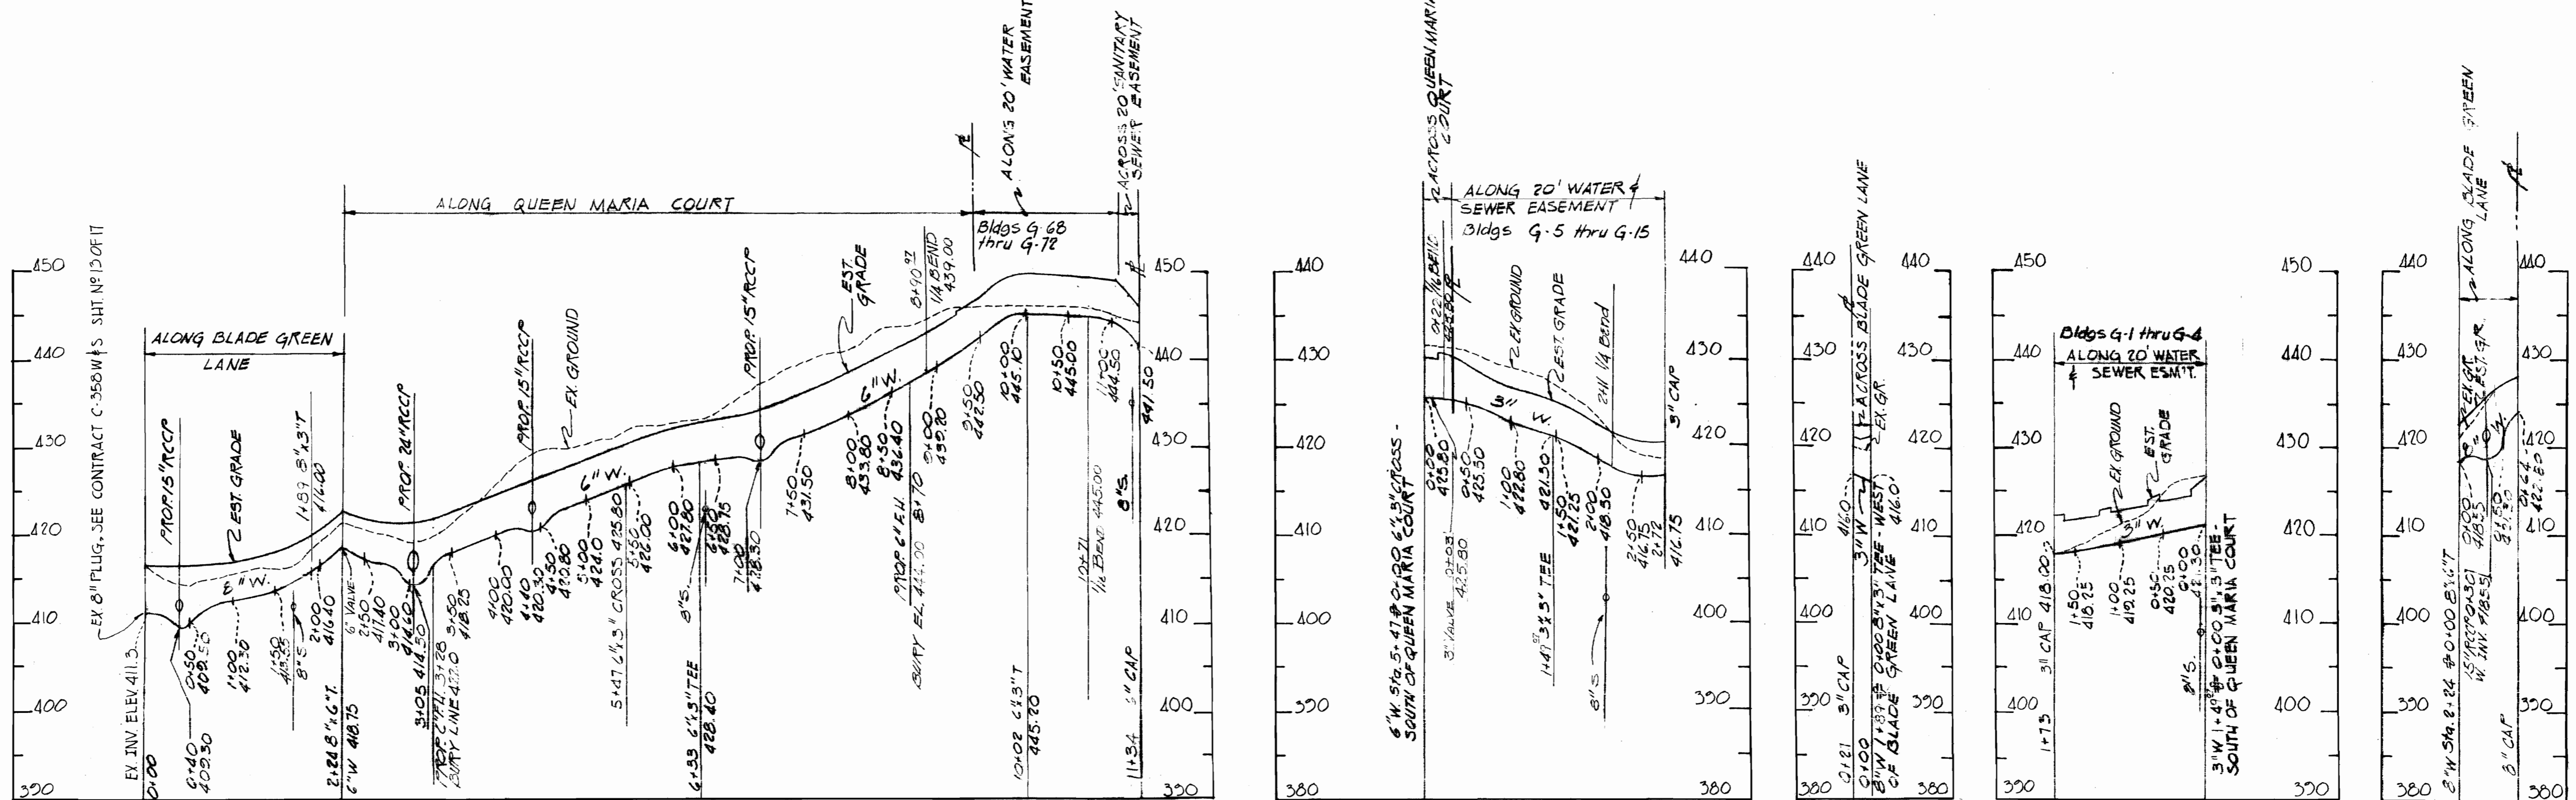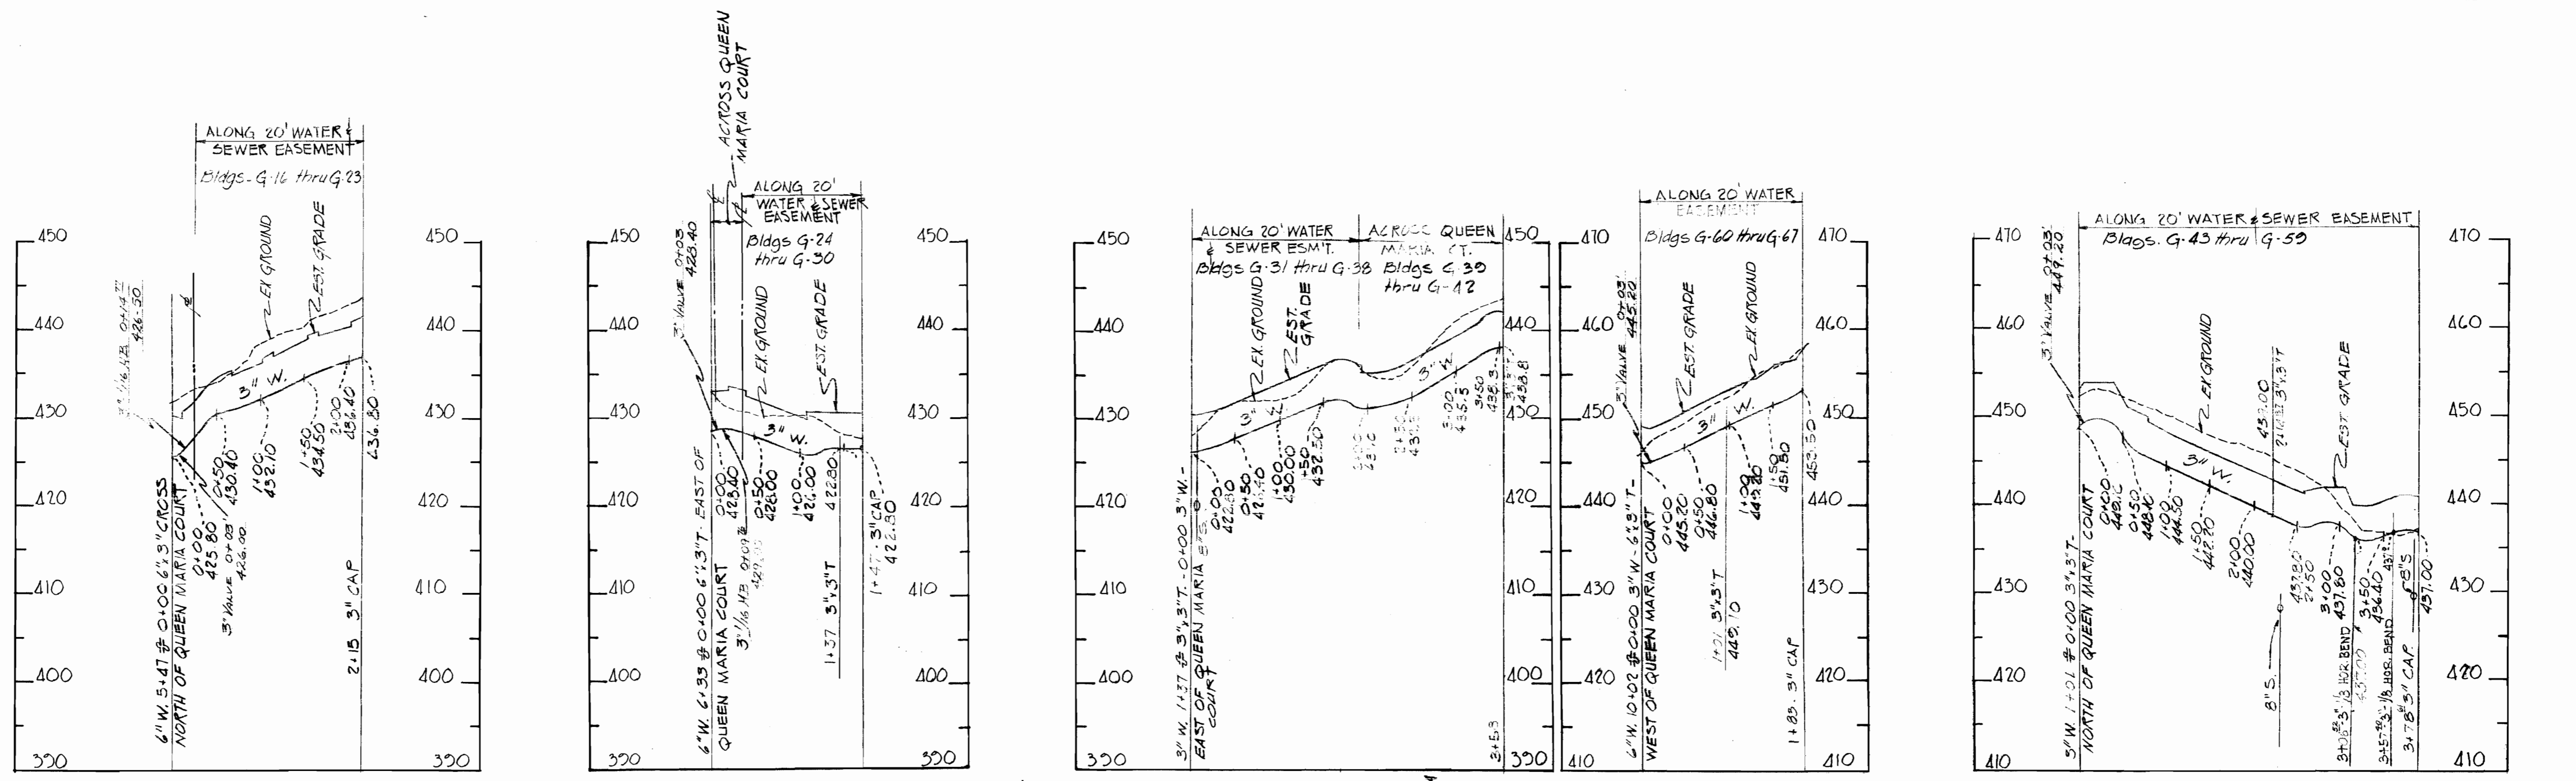

*Richard P. Browne*  
Richard P. Browne, P. E. & L. S.  
Maryland license No. 5238

**RICHARD P. BROWNE ASSOCIATES**  
ENGINEERS  
Columbia, Maryland

HOWARD COUNTY DEPARTMENT OF PUBLIC WORKS  
12/20/71  
Date  
William A. Oltman, Chief Engineer

CONTRACT NO. 461-D W & S

PROFILES OF WATER MAINS




COLUMBIA  
VILLAGE OF LONGREACH  
SECTION I AREA I  
PARCEL "G"  
LOTS G-1 TO G-72 & G-148 & G-149

DRAWING NO. 2 OF 3  
SCALE HOR. 1"=100' VERT. 1"=10'

NS 461 W&S/2

supplex

supplex

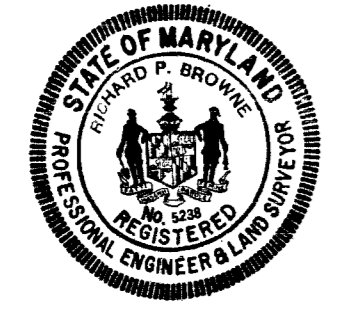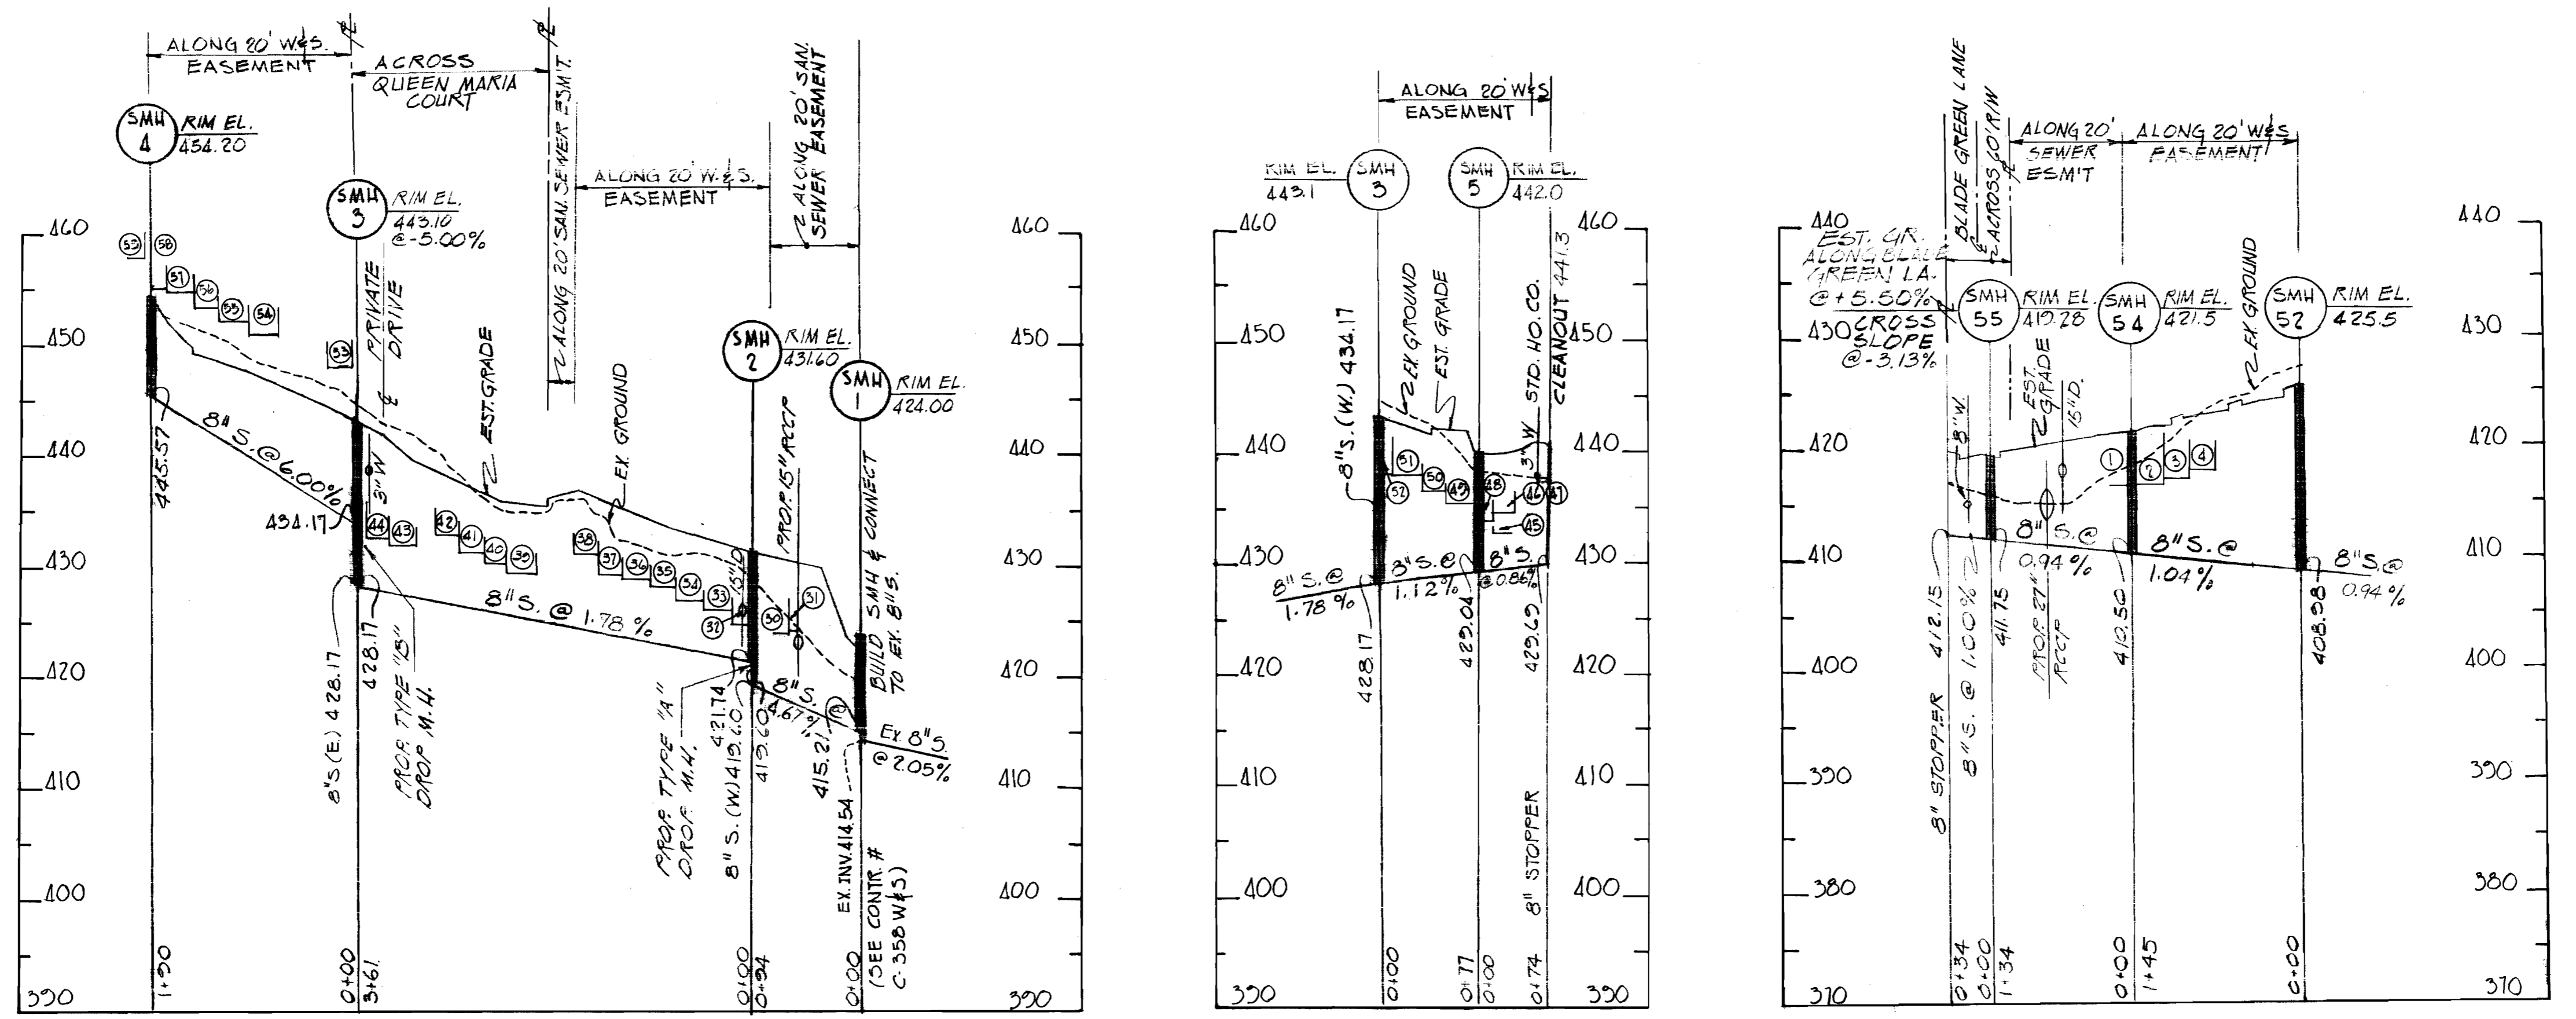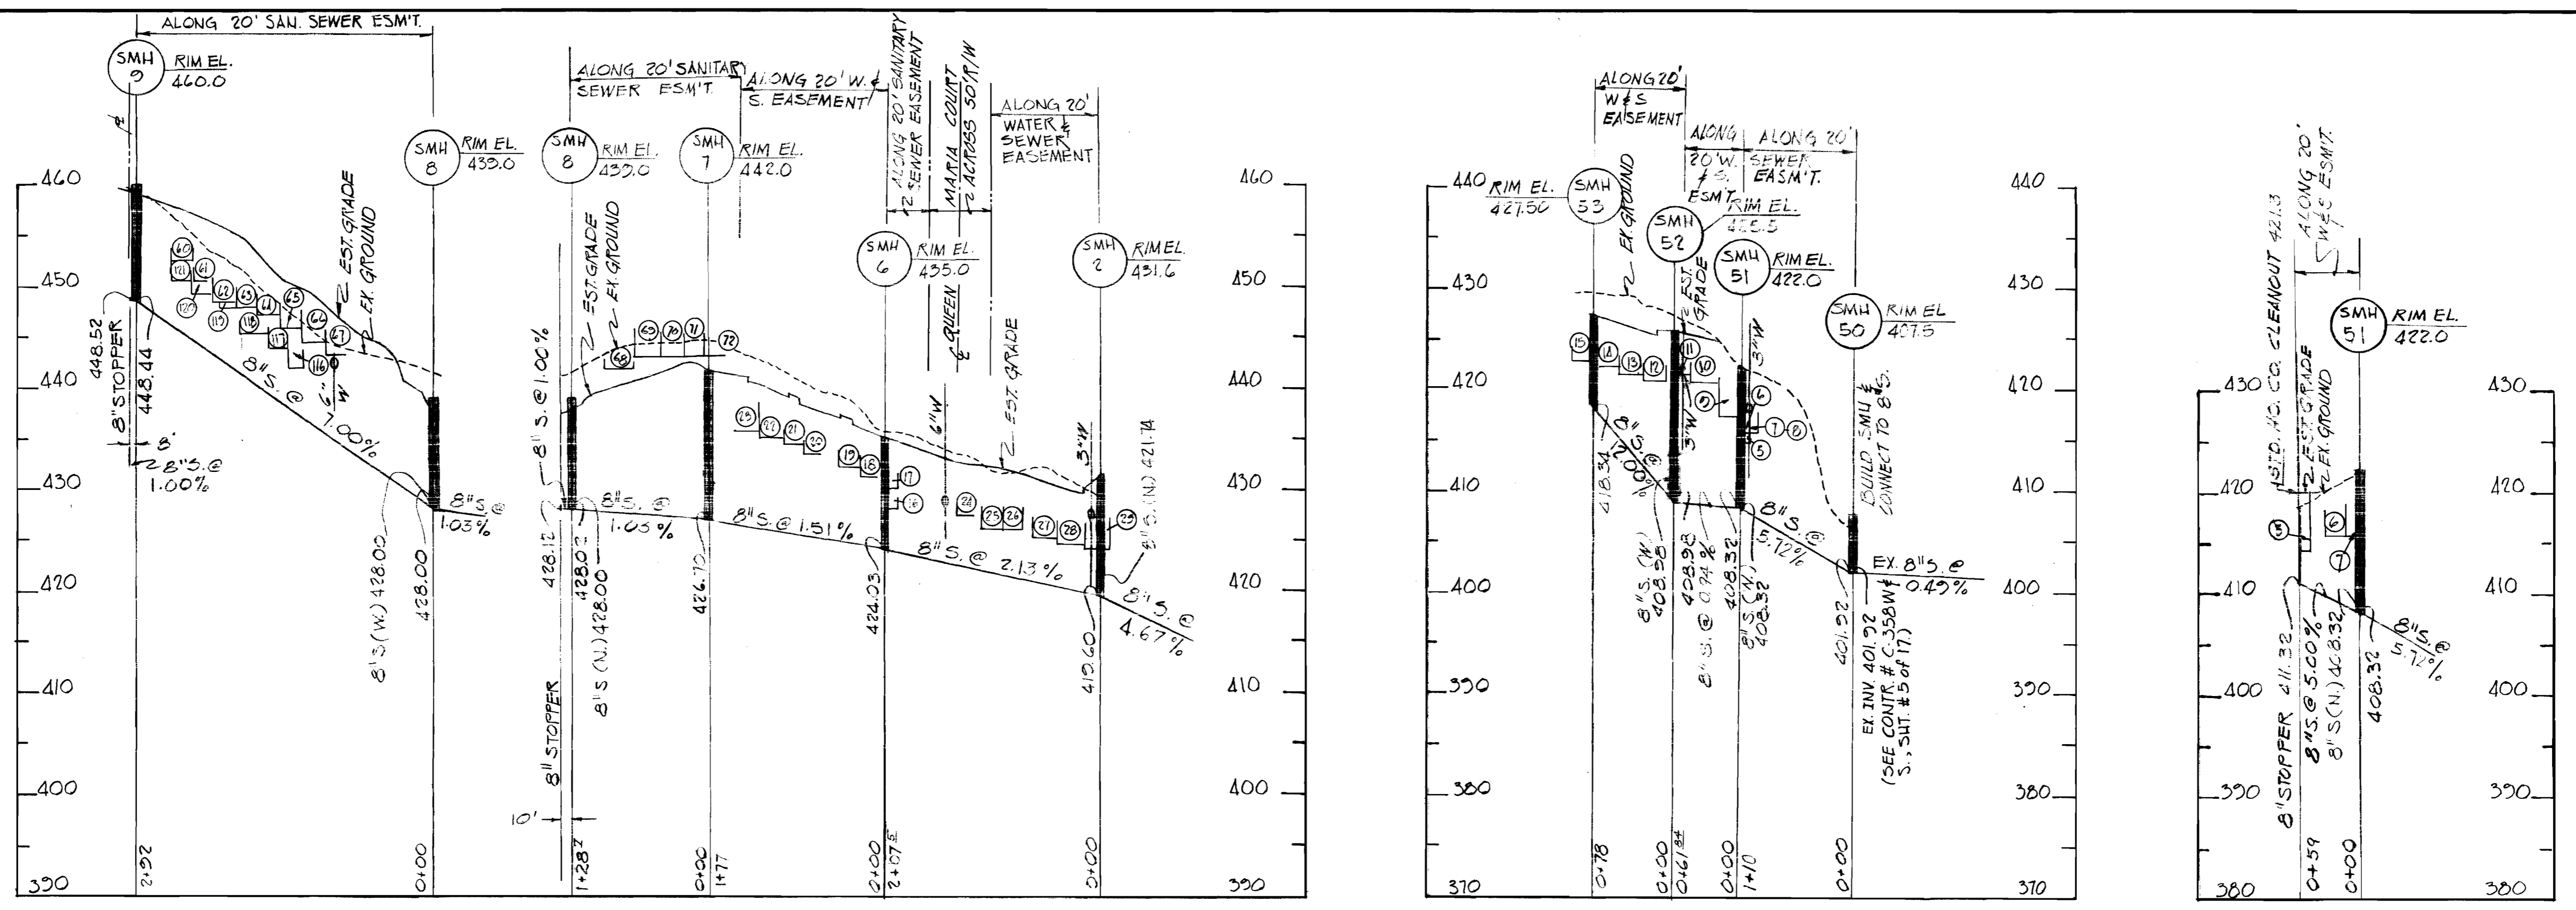

*Richard P. Browne*  
 Richard P. Browne, P. E. & L.S.  
 Maryland License No. 5838

<b>RICHARD P. BROWNE ASSOCIATES</b> ENGINEER Columbia, Maryland	HOWARD COUNTY DEPARTMENT OF PUBLIC WORKS 12/20/72 <i>William A. O'Brien</i> for H.O.F. Date Chief Engineer		CONTRACT NO. 461-D W & S	PROFILES OF SANITARY SEWER MAINS	COLUMBIA VILLAGE OF LONGREACH SECTION I AREA I PARCEL "G" LOTS G-1 TO G-72 & G-148 & G-149	DRAWING NO. 3 OF 3	SCALE HOR. 1"=100' VERT. 1"=10'	DES. W.H.N. DRW. W.H.N. CHK. T.K.S.
	AS BUILT MAY 25, 1972							

WS 461 wds/3