


- NOTES:**
- Provide and install temporary "Y" Branch. Store 45° Bend & 36" Short piece 13'-3/2" (See C.P.P. Co. Inc. Lay Schedule.) Exact station to be determined by C.O. Lay Schedule for temporary connection.
 - When Design construction is to be completed (See Critical Path Schedule):
 (2A) drain clarifier, remove wye branch, Cap end of 36" 60° Bend, and complete installation of 36" S.C. Profile B-1 per contract drawing add C.P.P. Co. Inc. Lay Schedule
 - When Aeration Basin No.4 is removed from service for modifications, Remove all 36" steel pipe and fittings not embedded, plug end of 36" steel pipe header at Aeration Basin wall, and Complete concrete construction of Effluent Chamber.
- Wye Branch changed to 30° Bends 8-29-78


WHITMAN, REQUARDT & ASSOCIATES ENGINEERS 1304 ST. PAUL ST. BALTIMORE, MARYLAND	DEPARTMENT OF PUBLIC WORKS HOWARD COUNTY, MARYLAND DATE _____ CHIEF-BUREAU OF ENVIRONMENTAL SERVICES	CONTRACT NO. <u>500-S</u>	PROPOSAL NO.14 SECONDARY CLARIFIER NO.3 PART PLAN, PROFILES, & DETAILS	SAVAGE WASTEWATER TREATMENT PLANT ADDITION NO. 4	DRAWING NO. <u>1</u>	SCALE AS SHOWN
					OF <u>2</u>	

W. O. 7132-2A

△ SUPPLEMENTAL DRAWING - NO.133-A
 MODIFIED DRAWING - MAY 6, 1982

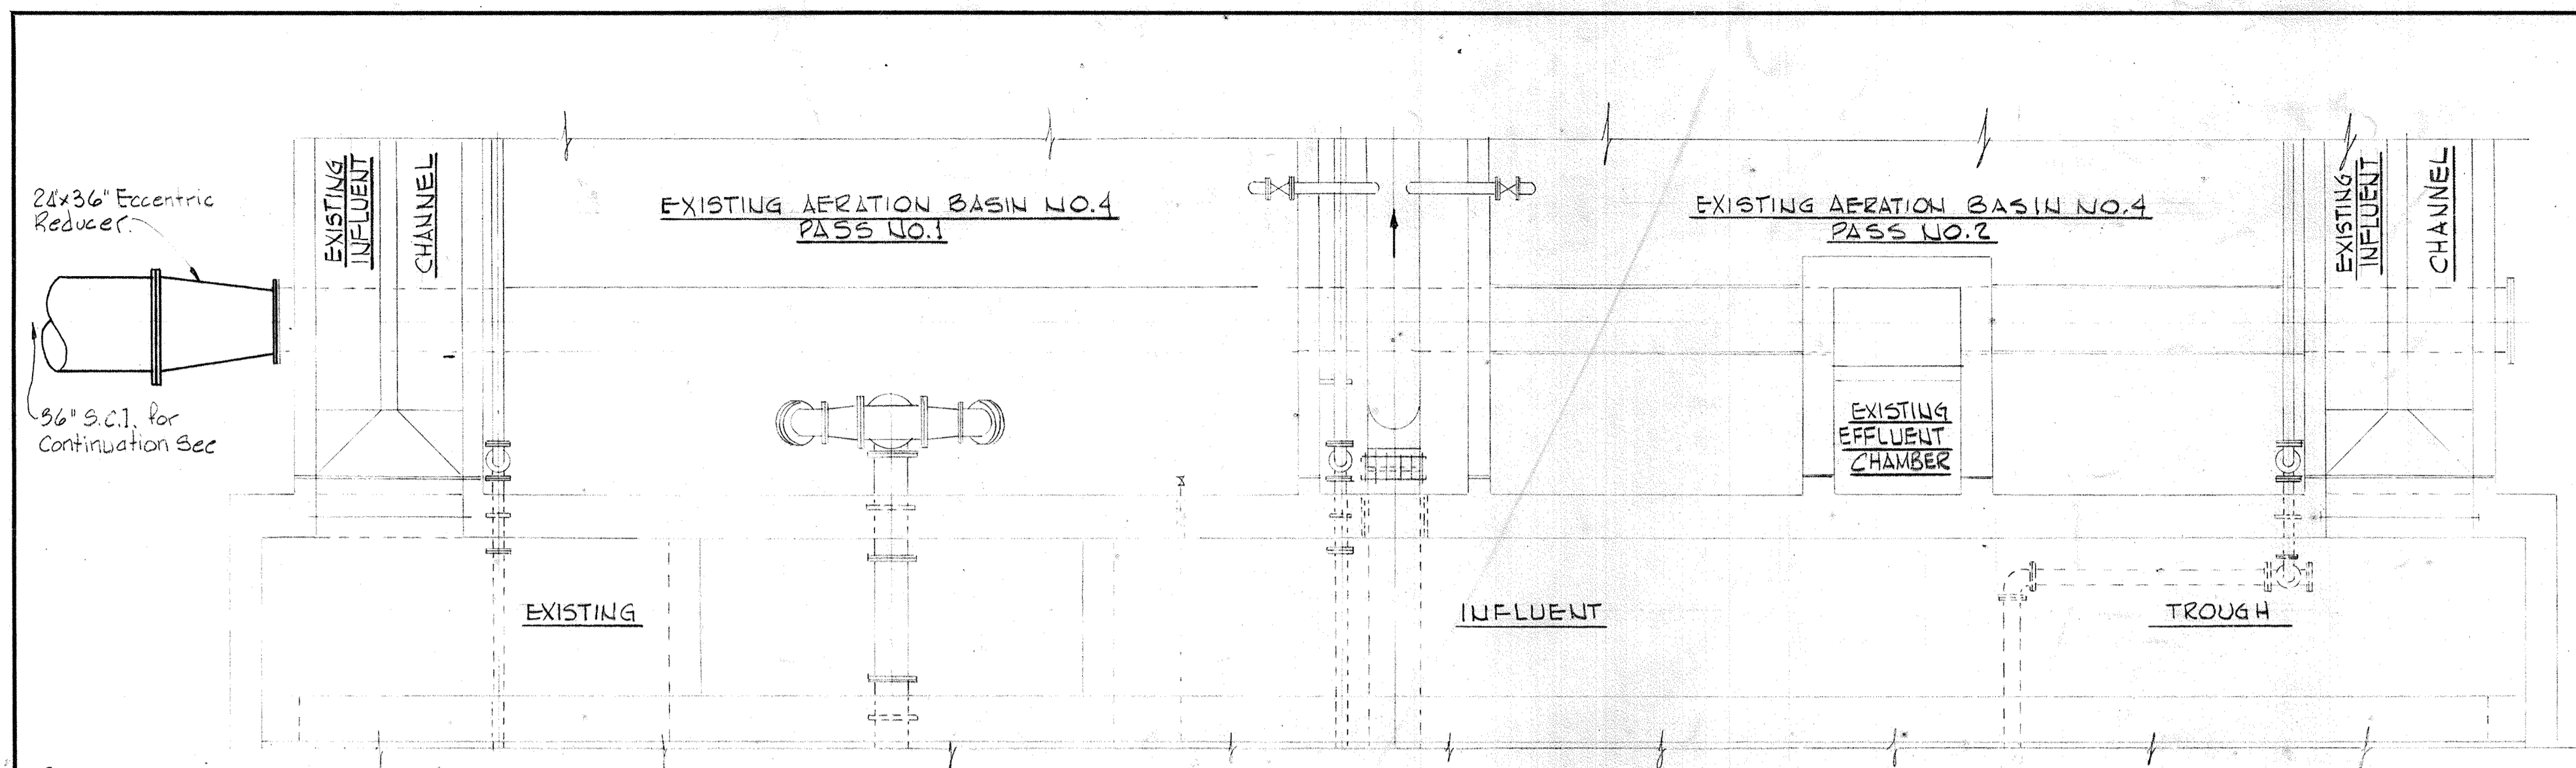

UPPER PIPING PART PLAN
 Scale: 1/2" = 1'-0"

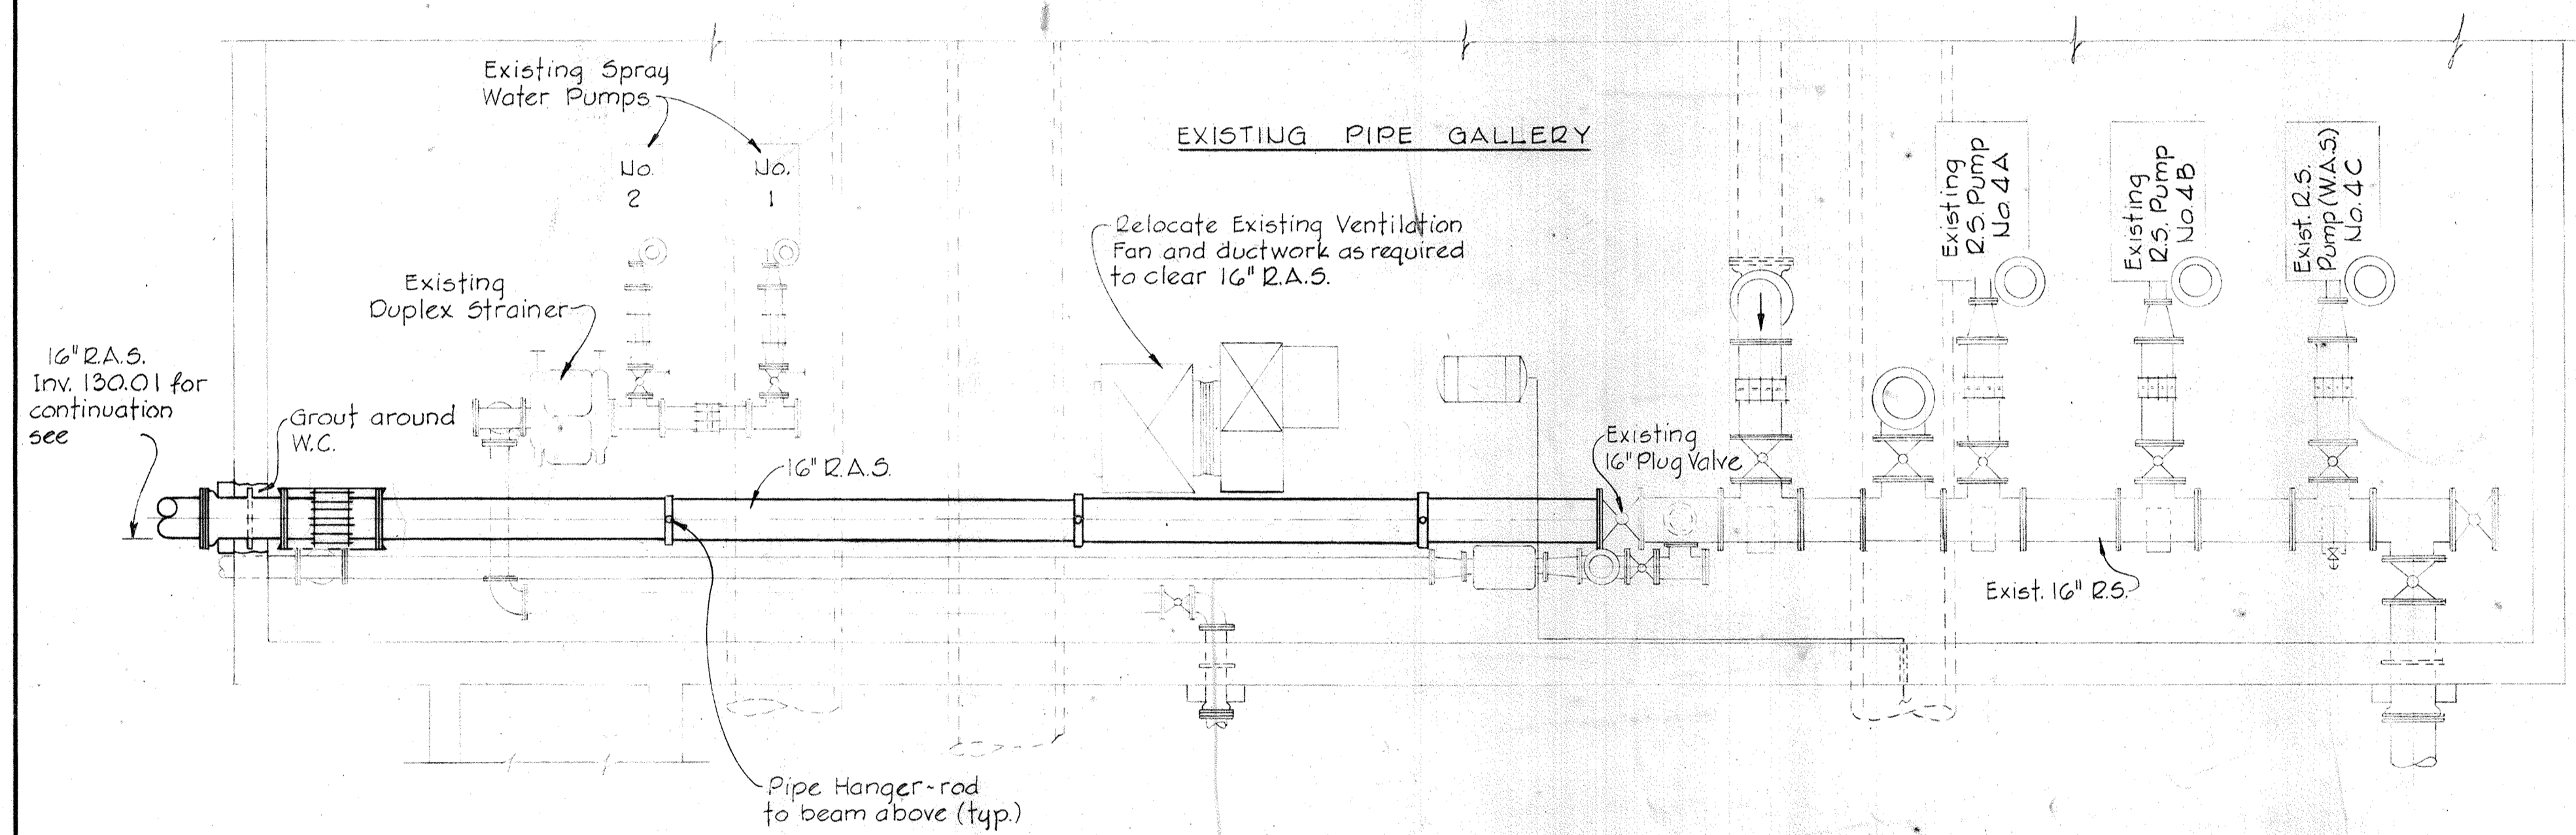

LOWER PIPING PART PLAN
 Scale: 1/4" = 1'-0"



WHITMAN, REQUARDT & ASSOCIATES ENGINEERS 1304 ST. PAUL ST. BALTIMORE, MARYLAND	DEPARTMENT OF PUBLIC WORKS HOWARD COUNTY, MARYLAND DATE _____ CHIEF - BUREAU OF ENVIRONMENTAL SERVICES	CONTRACT NO. 500-S	PROPOSAL NO. 14 AERATION BASIN PIPE GALLERY PART PLANS	SAVAGE WASTEWATER TREATMENT PLANT ADDITION NO. 4	DRAWING NO. 2 OF 2 SCALE AS SHOWN
---	--	--------------------	--	---	--------------------------------------

W. O. 7132-2A

△ SUPPLEMENTAL DRAWING - NO. 133-B
 MODIFIED DRAWING - MAY 6, 1982