


- GENERAL NOTES**
- APPROXIMATE LOCATIONS OF EXISTING MAINS ARE SHOWN. THE CONTRACTOR SHALL TAKE ALL NECESSARY PRECAUTIONS TO PROTECT EXISTING MAINS AND SERVICES AND MAINTAIN UNINTERRUPTED SUPPLY. ANY DAMAGE INCURRED BY CONTRACTOR OPERATIONS SHALL BE REPAIRED IMMEDIATELY AT CONTRACTOR EXPENSE.
 - ALL HORIZONTAL CONTROLS ARE BASED ON MARYLAND STATE COORDINATES
 - ALL VERTICAL CONTROLS ARE BASED ON U.S.G.S. DATUM (MD. STATE DATUM)
 - ALL PIPE ELEVATIONS SHOWN ARE INVERT ELEVATIONS
 - CLEAR ALL UTILITIES BY A MINIMUM OF 6". CLEAR ALL POLES 2'-0" MINIMUM OR TUNNEL AS REQUIRED
 - FOR ALL STANDARD DETAILS SEE STANDARDS BOUND IN SPECIFICATIONS.
 - CONTRACTOR SHALL LOCATE EXISTING UTILITIES A MINIMUM OF TWO WEEKS IN ADVANCE OF CONSTRUCTION OPERATIONS IN THE VICINITY OF PROPOSED UTILITIES.
 - CONTRACTOR SHALL NOTIFY THE FOLLOWING UTILITIES OR AGENCIES AT LEAST FIVE (5) DAYS BEFORE STARTING WORK SHOWN ON THESE PLANS.
 - STATE HIGHWAY ADMINISTRATION 531-5533
 - BALTIMORE GAS AND ELECTRIC COMPANY - UNDERGROUND ELECTRIC DISTRIBUTION ENGINEERING - "DAMAGE CONTROL" 234-3691
 - BALTIMORE GAS AND ELECTRIC COMPANY - UNDERGROUND GAS DISTRIBUTION ENGINEERING - 559-0100
 - CHESAPEAKE AND POTOMAC TELEPHONE CO. 725-9976
 - AMERICAN TELEPHONE AND TELEGRAPH - CABLE LOCATION DIVISION - 301-393-3553
 - COLONIAL PIPELINE COMPANY - 781-4641
 - MISS UTILITY - 393-3648
 - PLACE REGULATION "MEN WORKING" AND WARNING SIGNS AS REQUIRED TO COMPLY WITH MARYLAND STATE HIGHWAY ADMINISTRATION MANUAL OF TRAFFIC CONTROL FOR HIGHWAY CONSTRUCTION AND MAINTENANCE OPERATIONS.

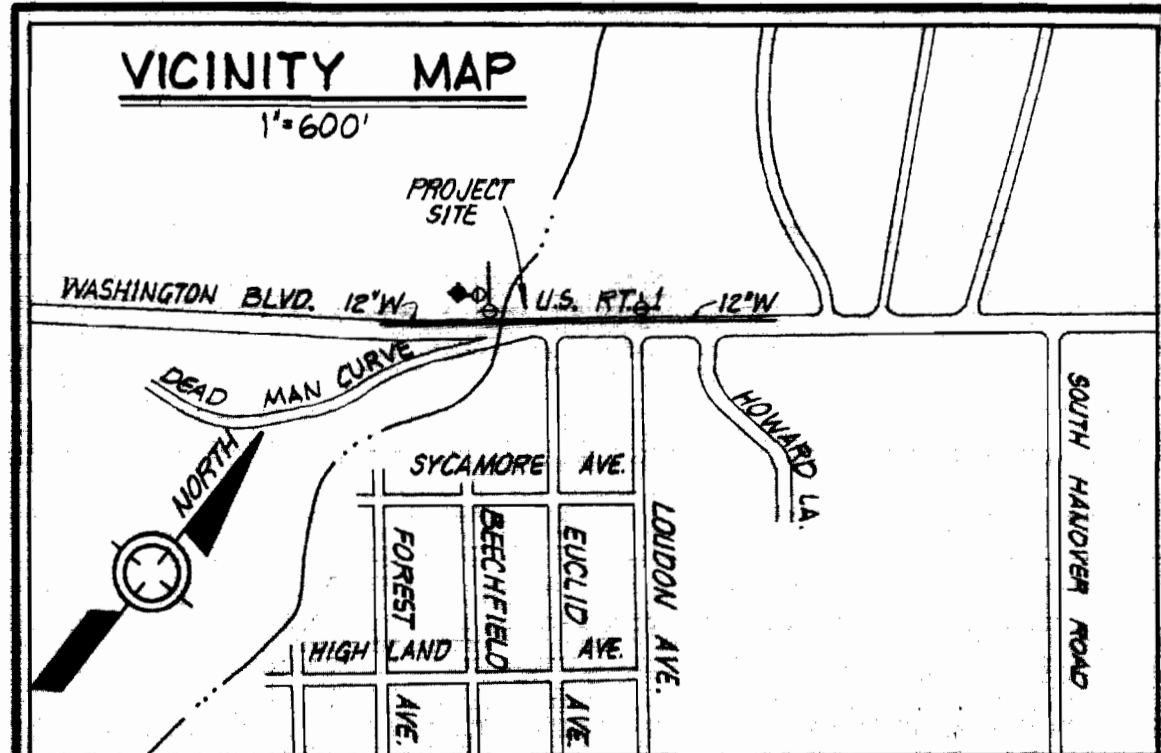

DEPARTMENT OF PUBLIC WORKS BUREAU OF ENGINEERING CONSTRUCTION INSPECTION - SURVEY DIV.	DEPARTMENT OF PUBLIC WORKS HOWARD COUNTY, MARYLAND DATE _____ NOTED 5-28-79 CHIEF BUREAU OF ENGINEERING	CONTRACT NO. 592 M&O-W	PLAN AND PROFILE OF WATER MAINS	ELKRIDGE SUB-DISTRICT	DRAWING NO. 1 OF 1	SCALE AS SHOWN
----------------------------------------------------------------------------------------------	---------------------------------------------------------------------------------------------------------------------	------------------------	------------------------------------	-----------------------	--------------------	----------------

'As-Built'

WS 592 -W/1