

PROJECT NO. SP 6071


DORSEY RUN

HOWARD COUNTY, MARYLAND

DEPARTMENT OF PUBLIC WORKS

QUANTITIES	
ITEM	QUANTITY
8" Sewer	7420 LF 135LF
10" Sewer	3430 LF 3391LF

AS-BUILT
 Stakeout F.B.# 6167
 Diary F.B.# 6173

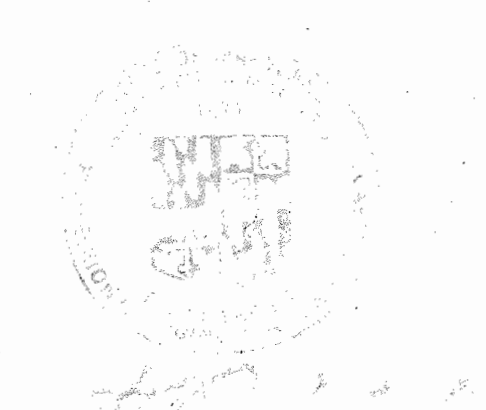

Project S-4-6071
 Sharewood Acres
 Contract No. 612-5

WHITMAN, REQUARDT & ASSOCIATES ENGINEERS 1304 ST. PAUL ST. BALTIMORE, MARYLAND	DEPARTMENT OF PUBLIC WORKS HOWARD COUNTY, MARYLAND <i>P. J. Regan Jr. 7-6-76</i> DIRECTOR OF PUBLIC WORKS — DATE	CONTRACT NO. <u>612-5</u> PROJECT NO. <u>S-4-6071</u>	LOCATION PLAN	ELECTION DISTRICT GUILFORD NO. 6	DRAWING NO. <u>1</u> OF <u>8</u>	SCALE <u>1"=2000'</u>
---	---	--	---------------	-------------------------------------	-------------------------------------	--------------------------



W. O. 6840-2

March 14, 1978 Nov. 12, 1979

AS-BUILT






WS 612-S/1

WS 612-S/5

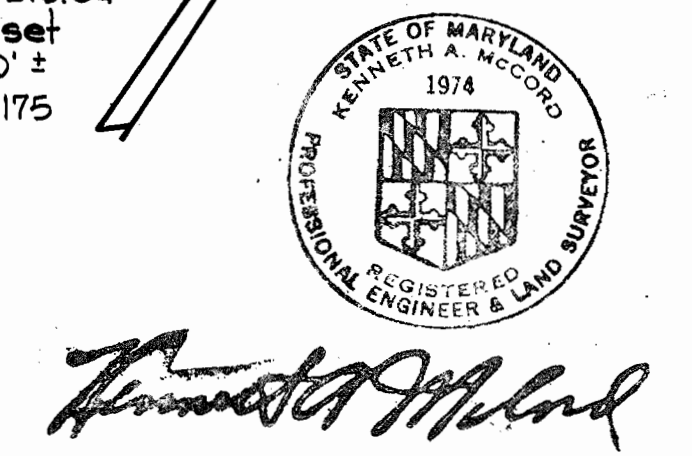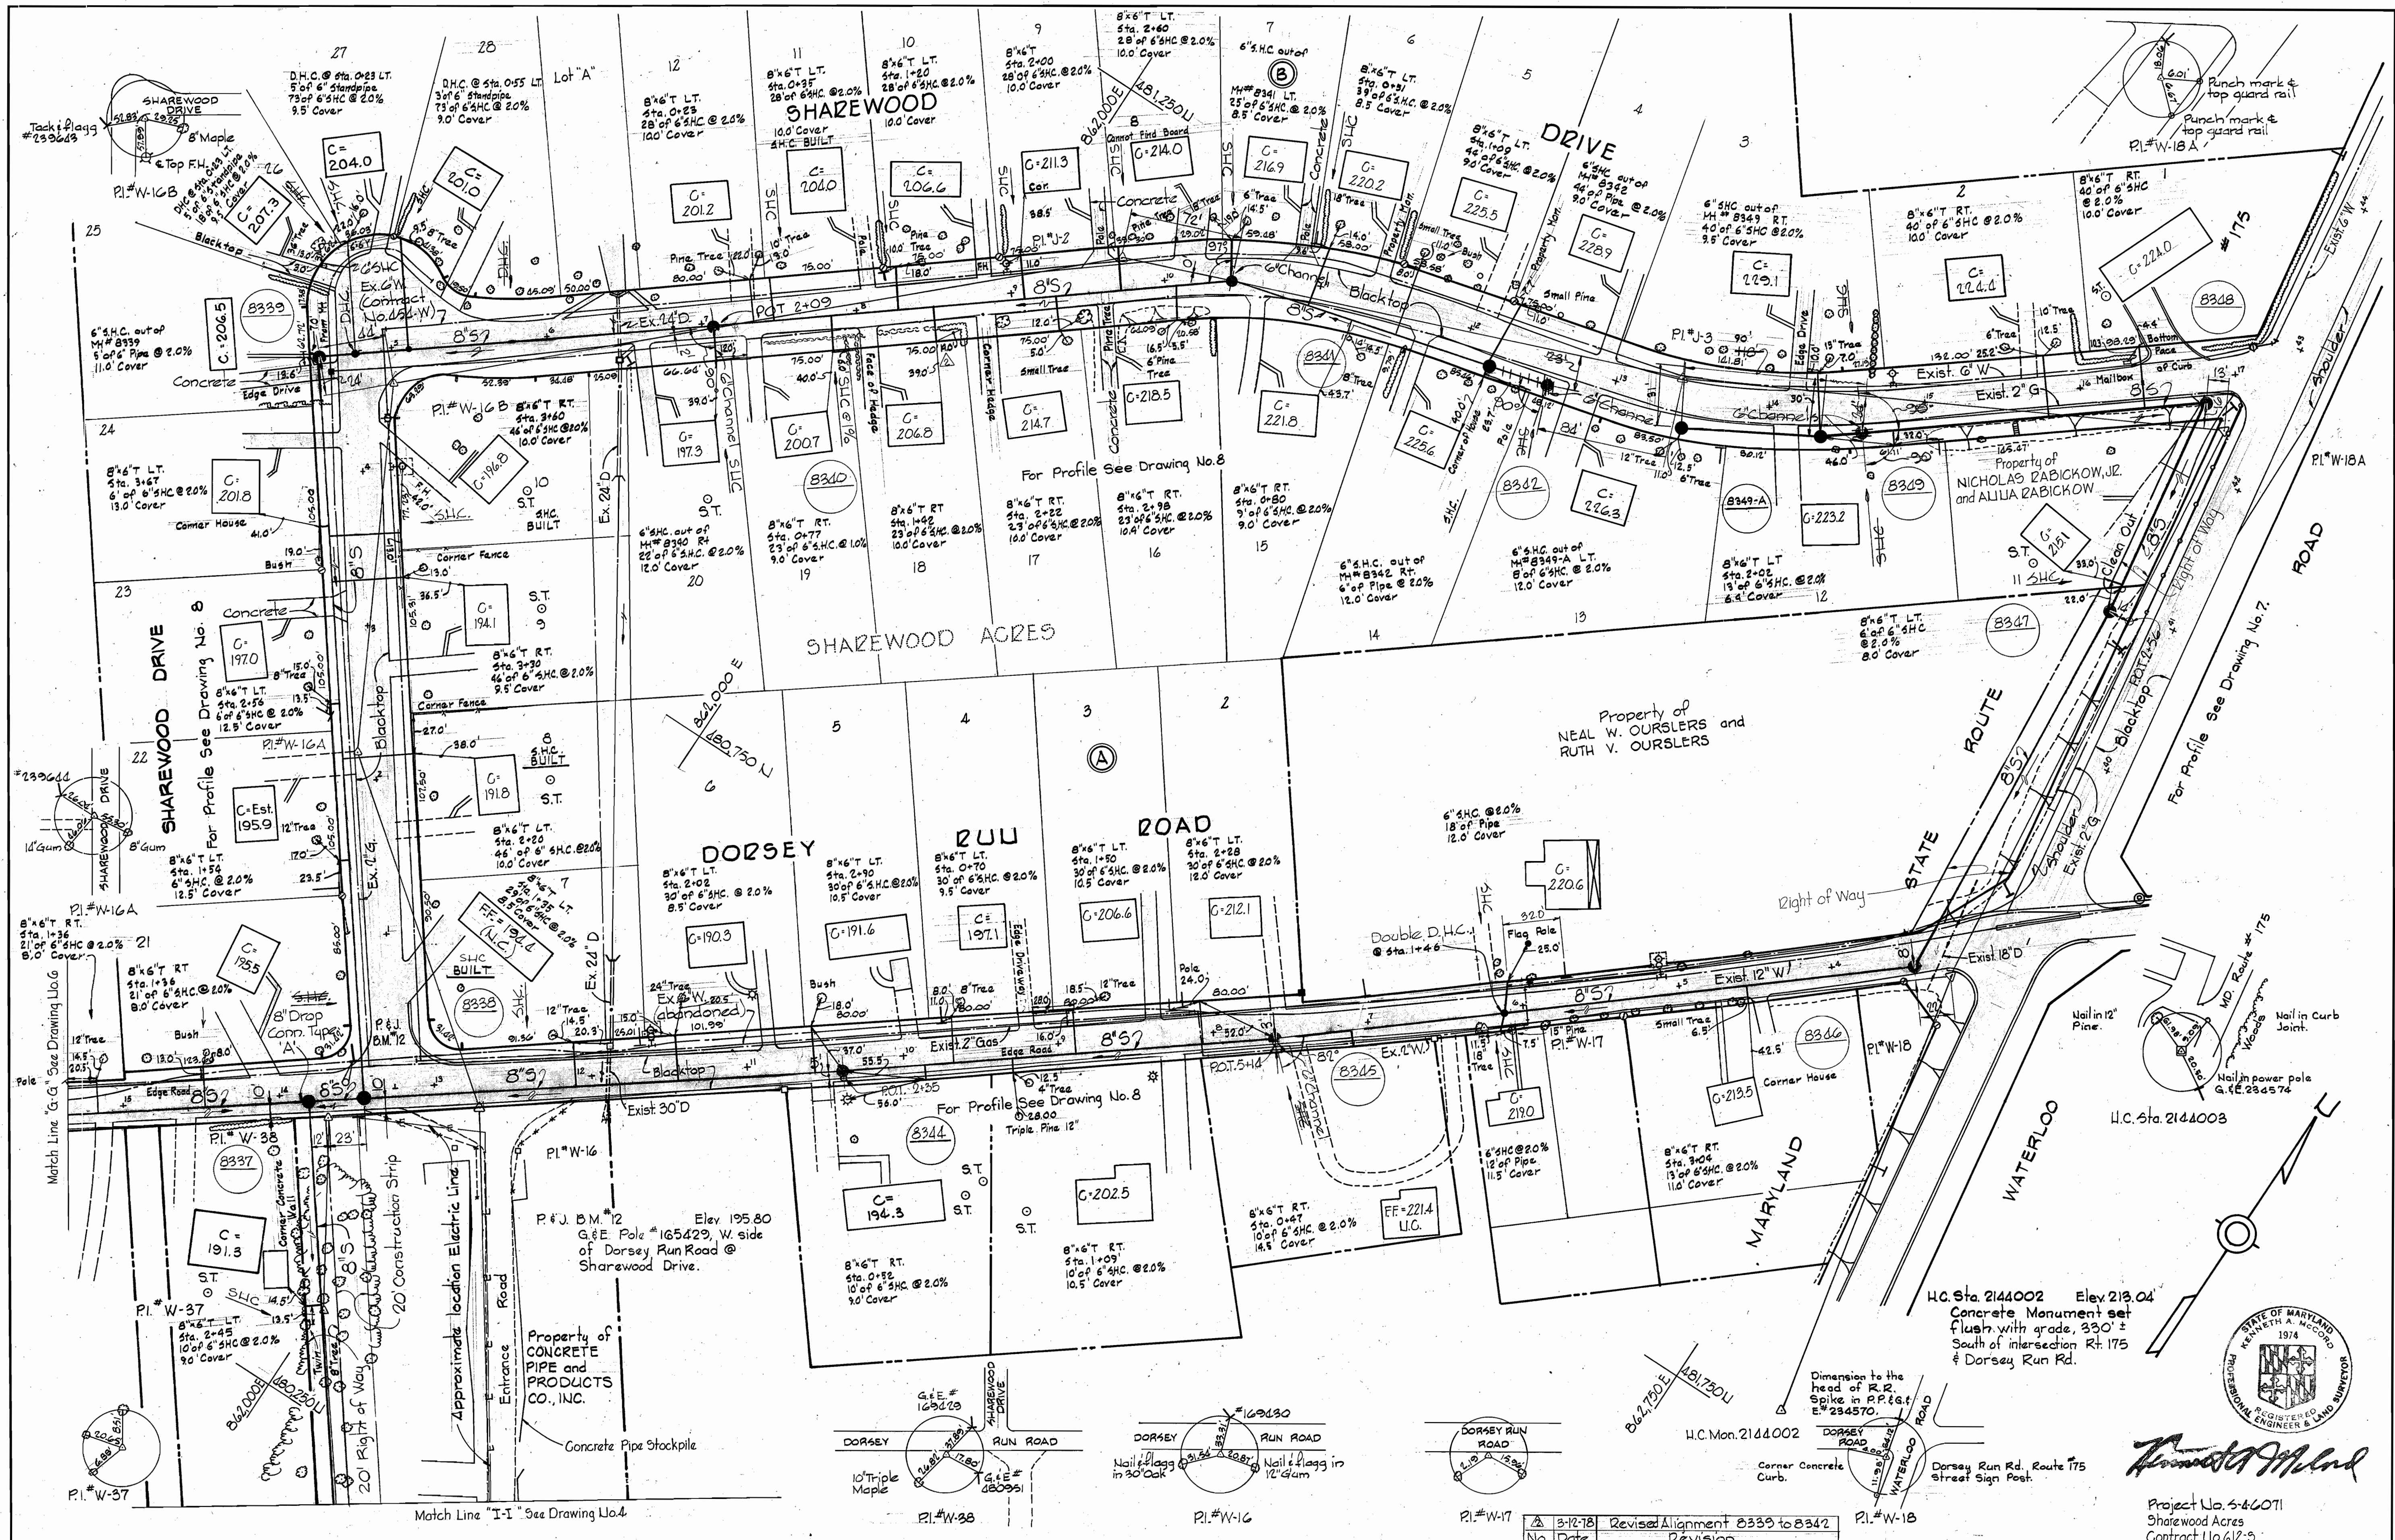

Project No. 646071
Sharewood Acres
Contract No. 612-S

WHITMAN, REQUARDT & ASSOCIATES ENGINEERS 1304 ST. PAUL ST. BALTIMORE, MARYLAND	DEPARTMENT OF PUBLIC WORKS HOWARD COUNTY, MARYLAND <i>P.J. Rogan 7-16-76</i> DIRECTOR OF PUBLIC WORKS - DATE	CONTRACT NO. 612-S PROJECT NO. S-4-6071 <i>W.O. Libert 7-15-76</i> CHIEF-BUREAU OF ENGINEERING - DATE	PLAN OF SEWER MAINS	ELECTION DISTRICT GUILFORD NO. 6	DRAWING NO. 5 OF 8 SCALE 1" = 50'
--	--	--	----------------------------	---	--

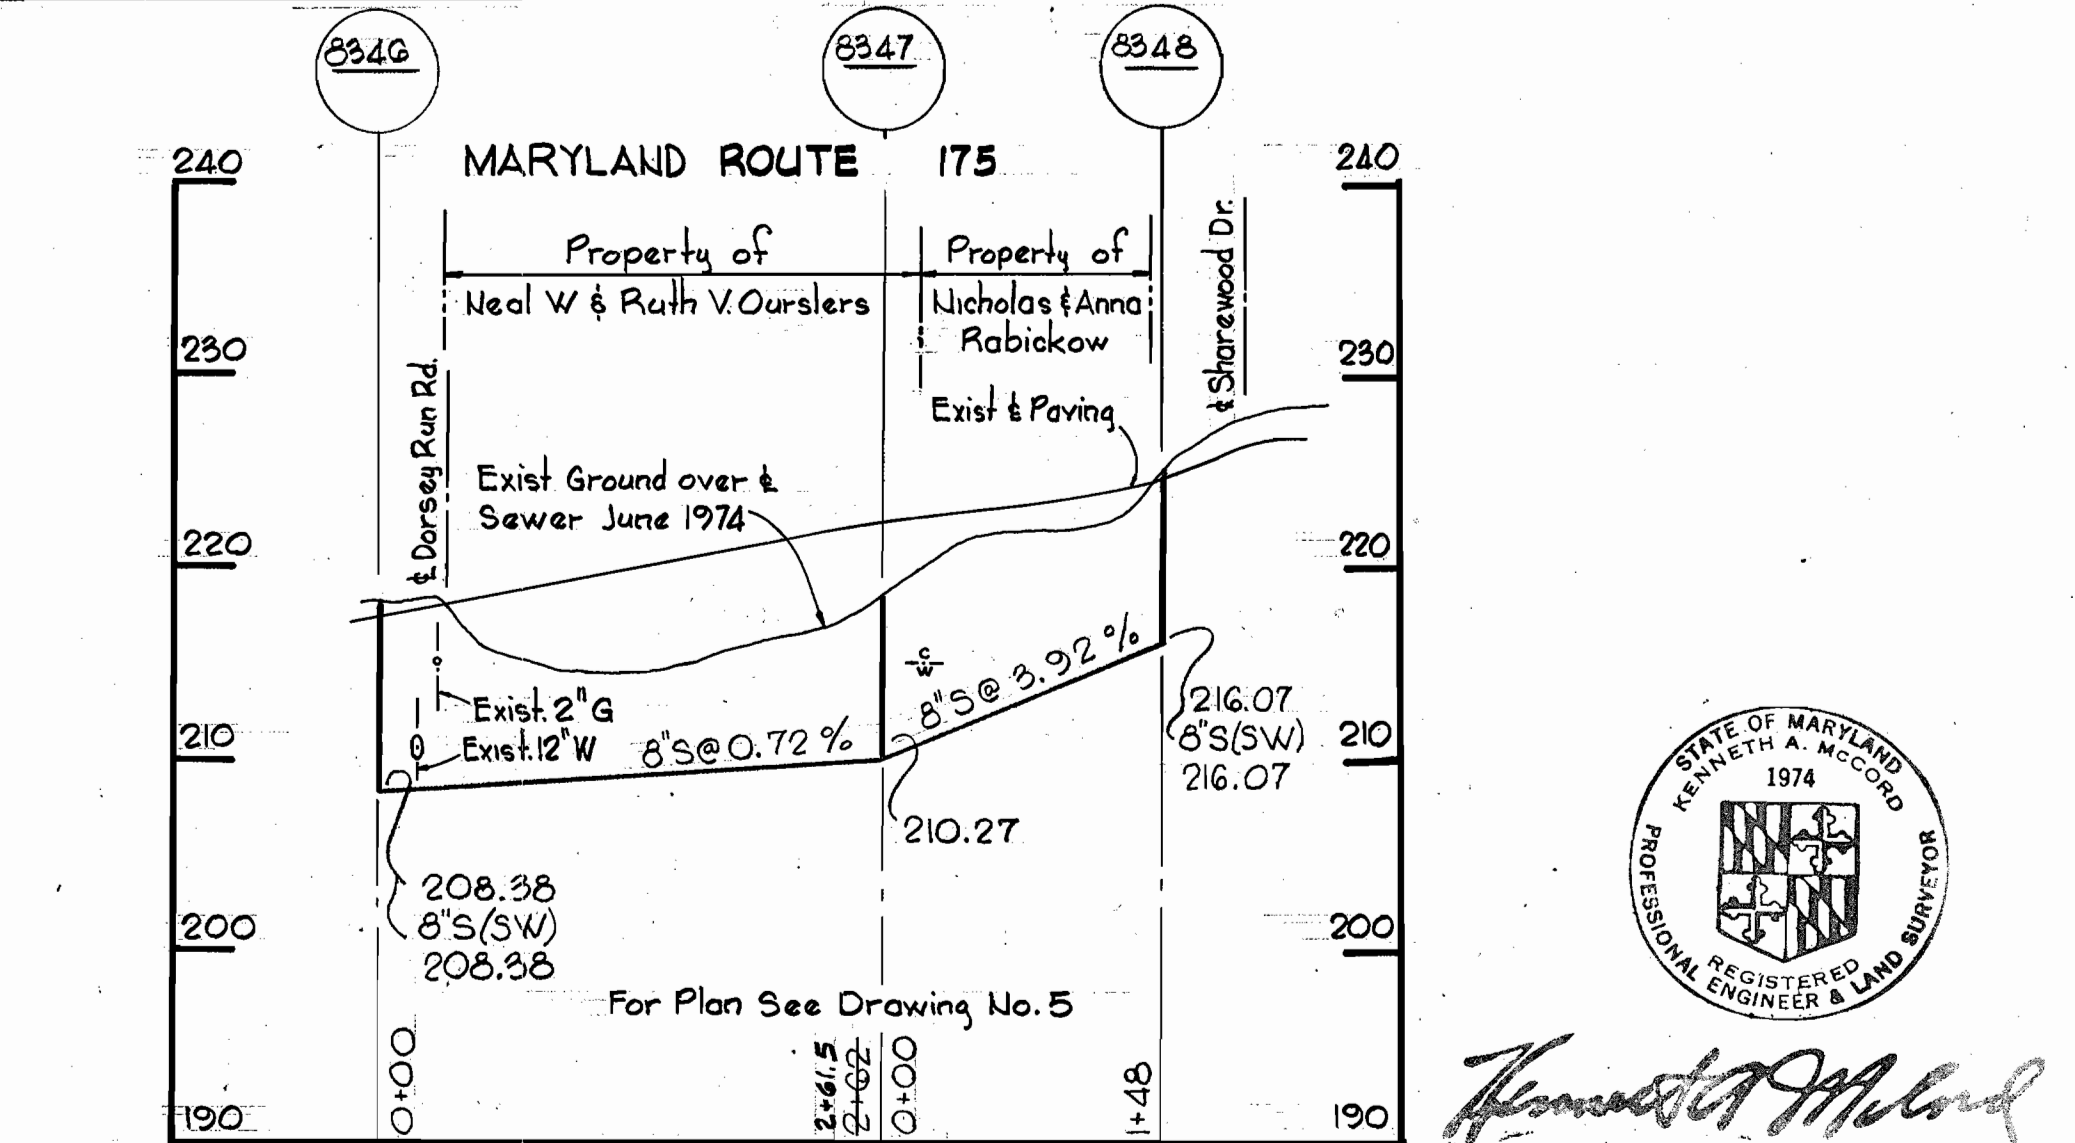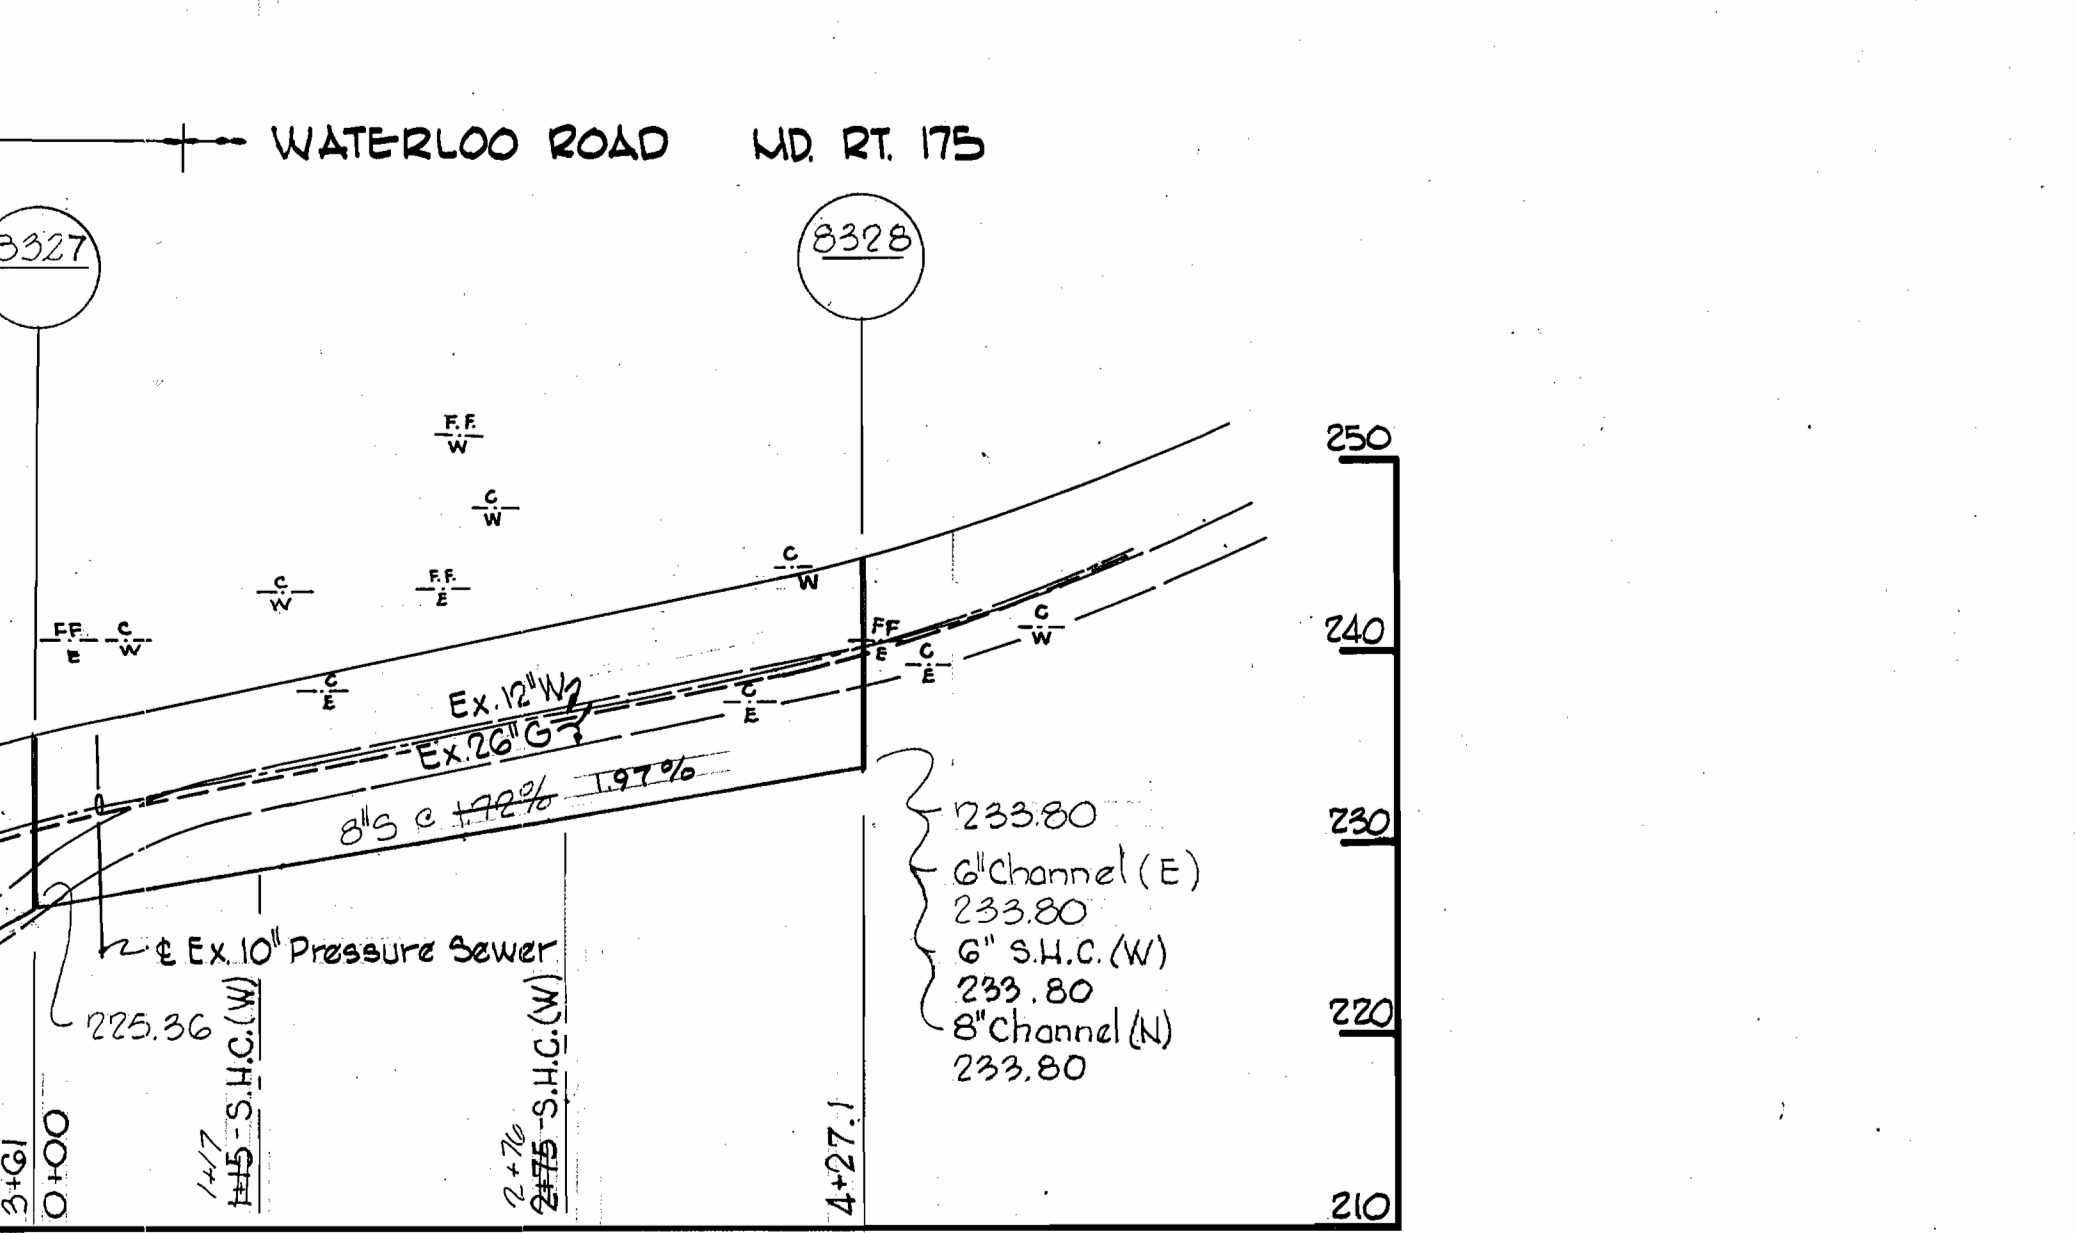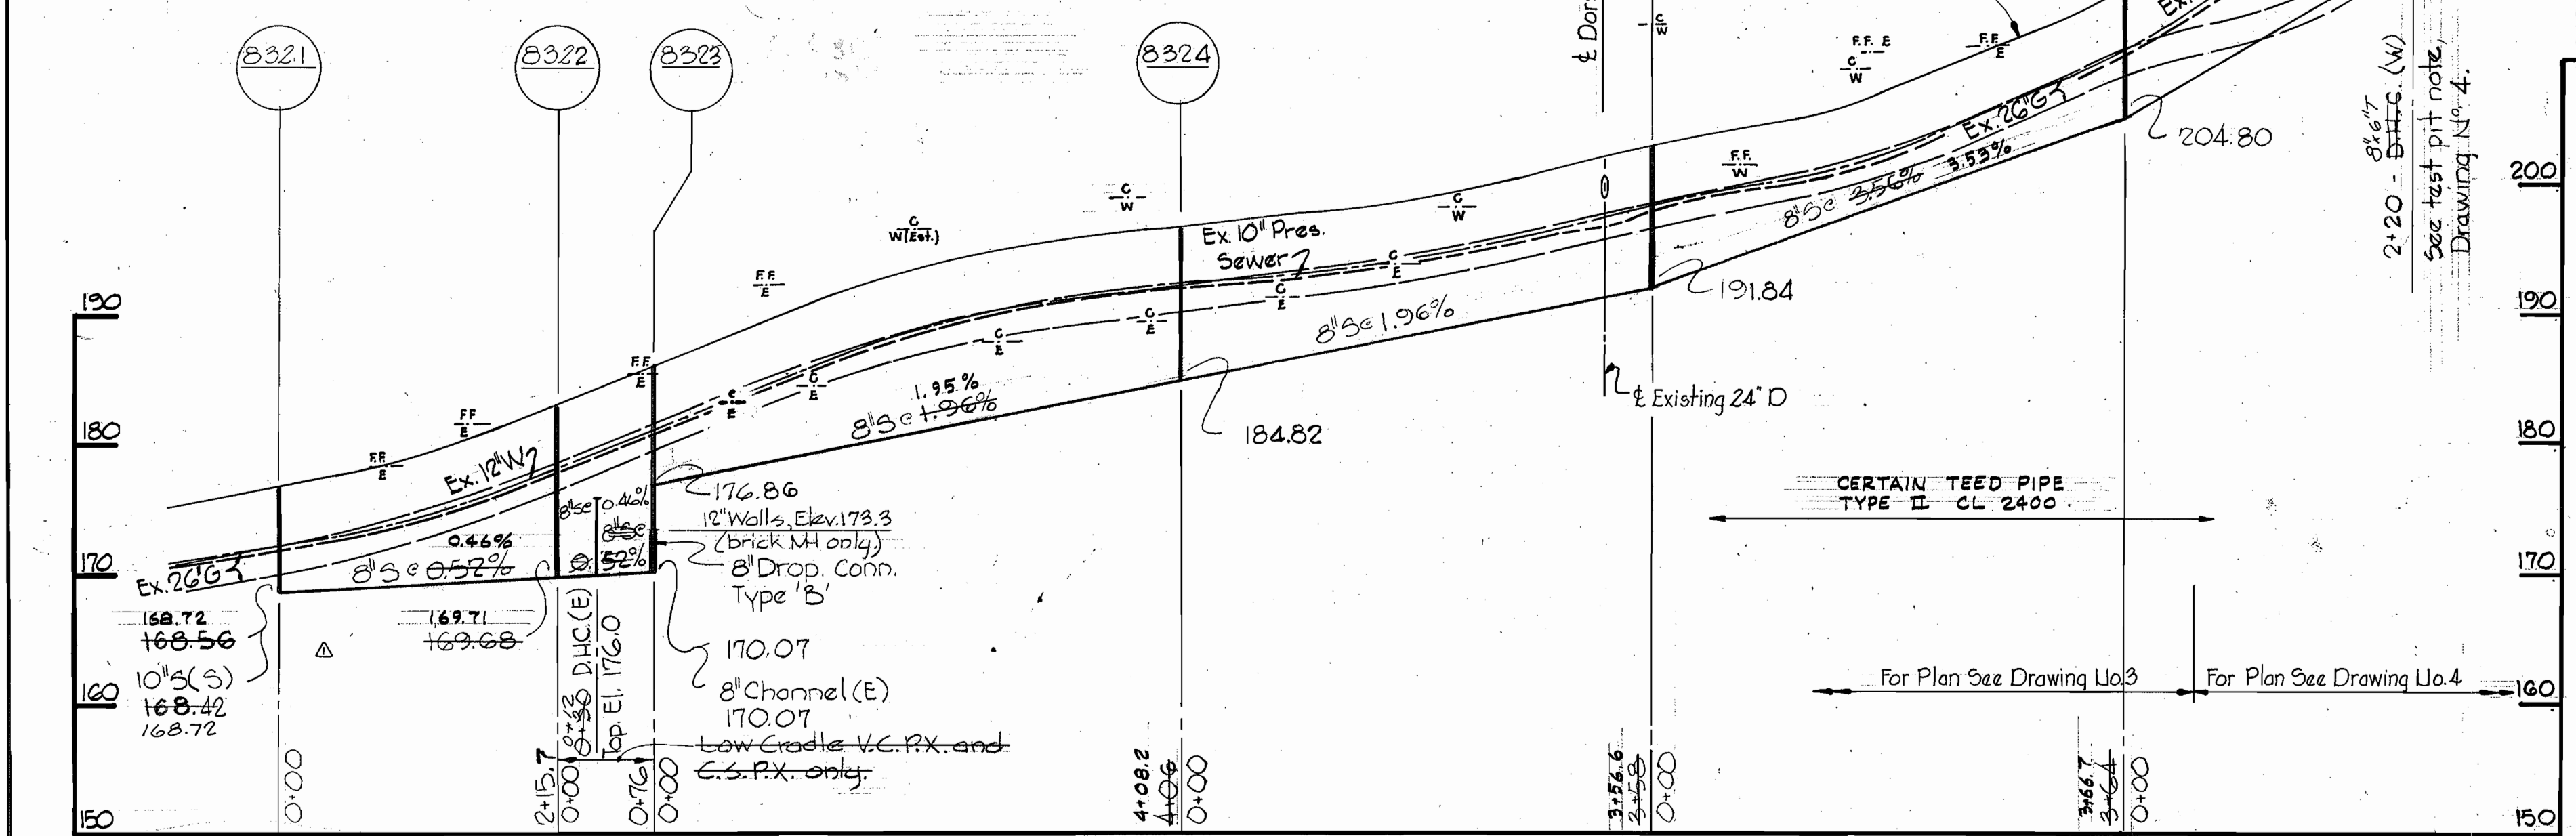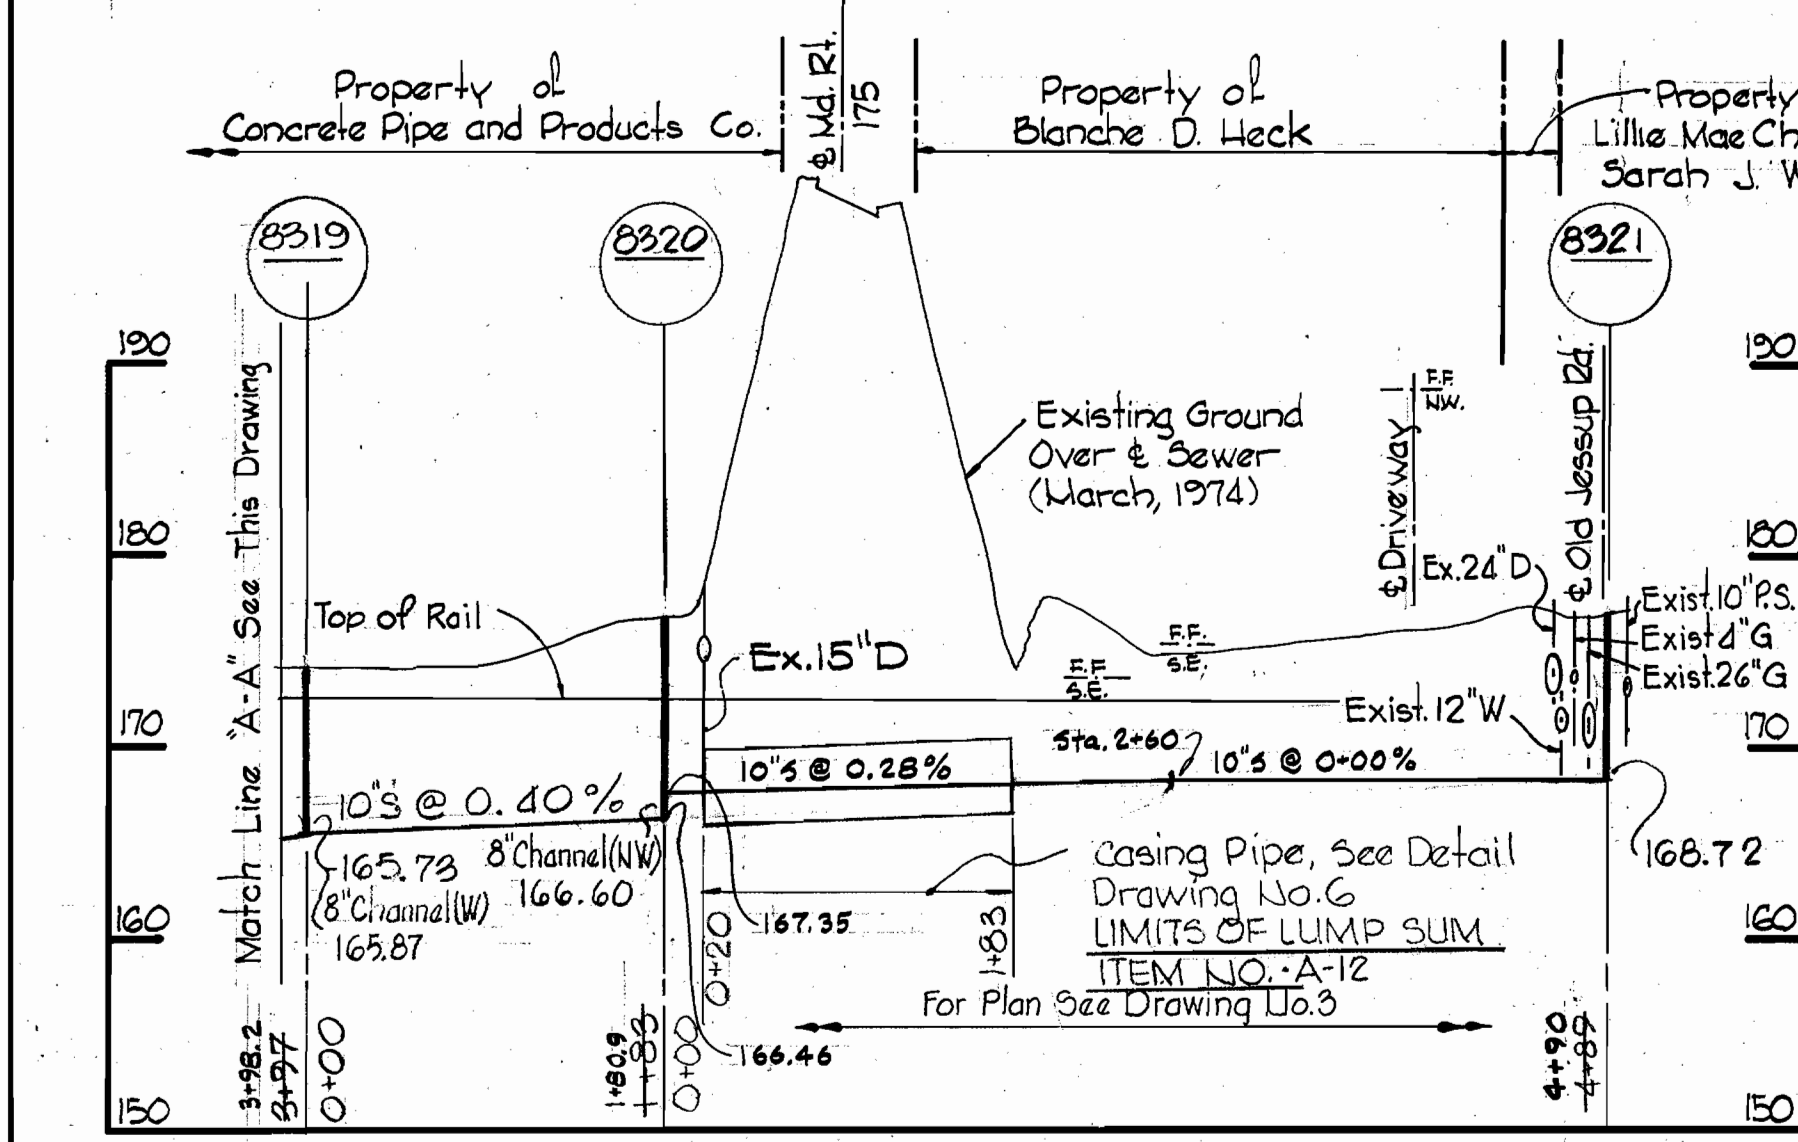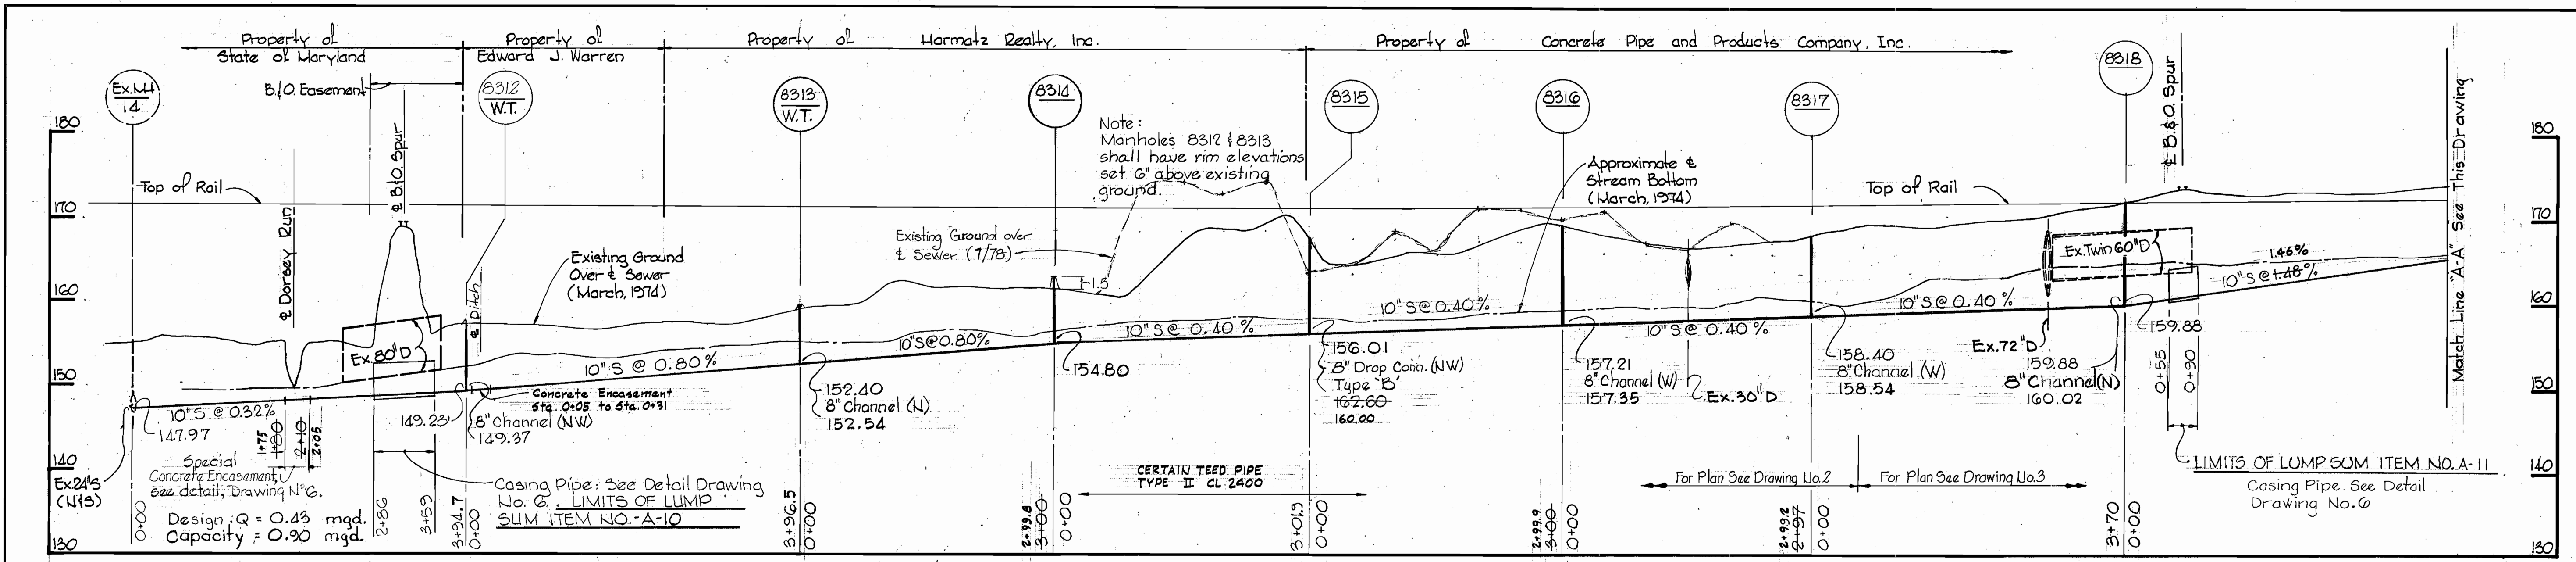

WHITMAN, REQUARDT & ASSOCIATES ENGINEERS 1304 ST. PAUL ST. BALTIMORE, MARYLAND	DEPARTMENT OF PUBLIC WORKS HOWARD COUNTY, MARYLAND <i>P.J. Rogan</i> 7-16-76 DIRECTOR OF PUBLIC WORKS - DATE	CONTRACT NO. 612-S PROJECT NO. S-4-6071	PROFILES OF SEWER MAINS	ELECTION DISTRICT GUILFORD NO. 6	DRAWING NO. 7	SCALE H: 1"=100' V: 1"=10'
					OF 8	
W.O. 6810-2					August 13, 1976	
Project No. S-4-6071 Sharwood Acres Contract No. 612-S					Nov. 12, 1979	




Kenneth A. McCord

WS 612-S/7


DRAWING 24-510 18892

SHAREWOOD DRIVE

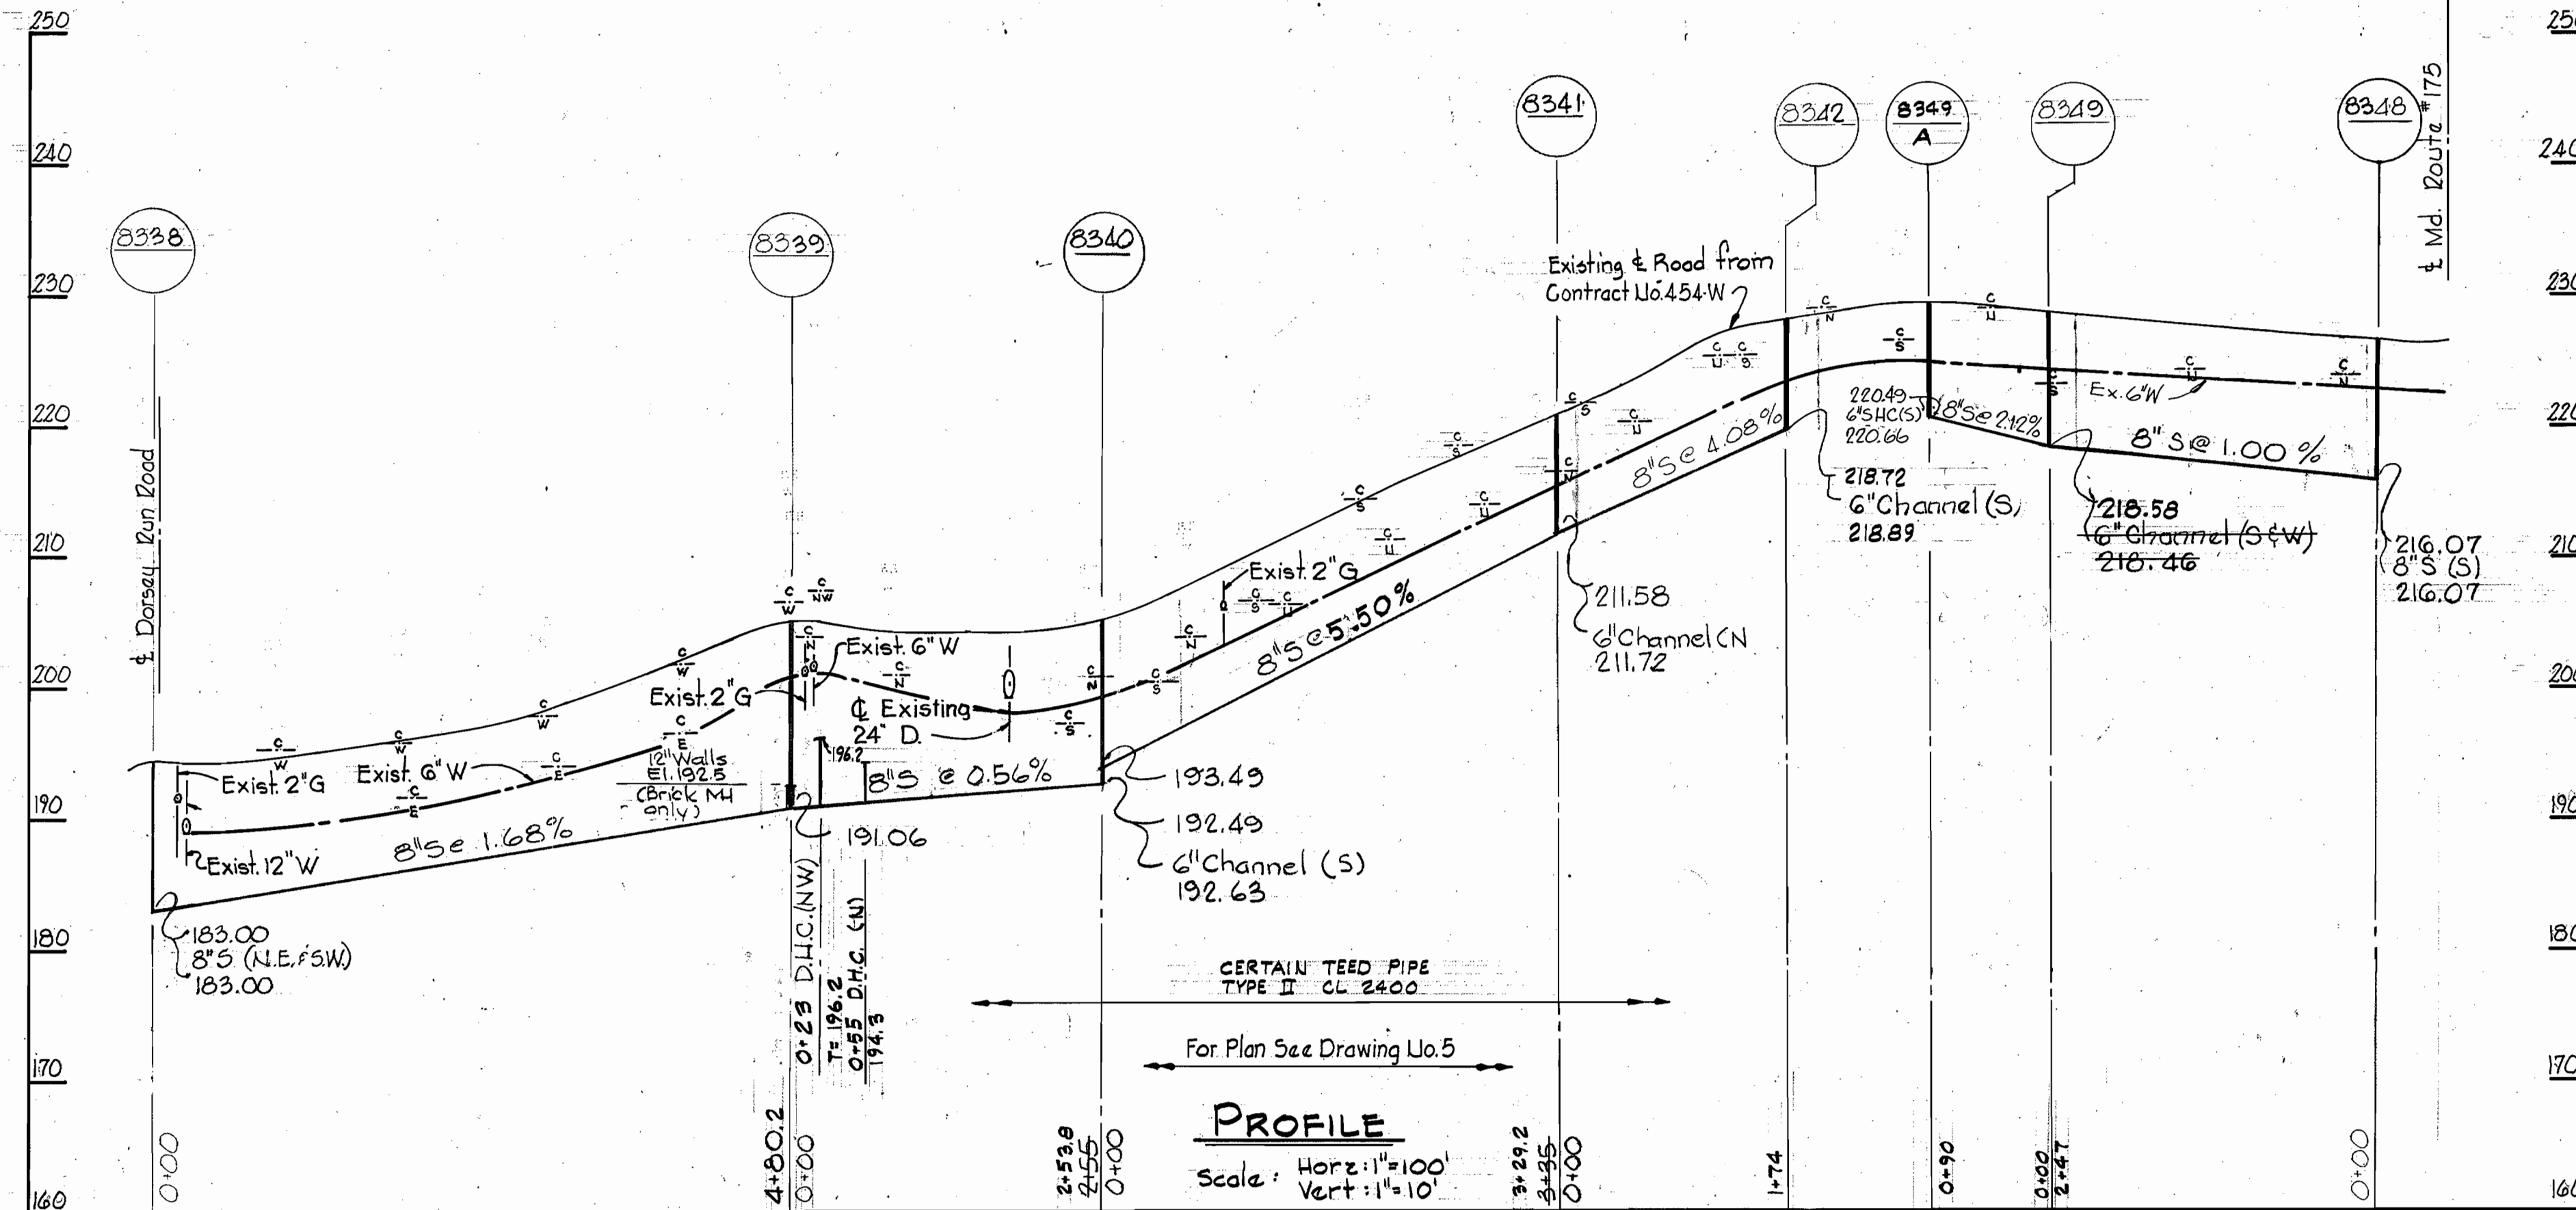


PROFILE
Scale: Horiz: 1"=100'
Vert: 1"=10'

DORSEY RUN ROAD

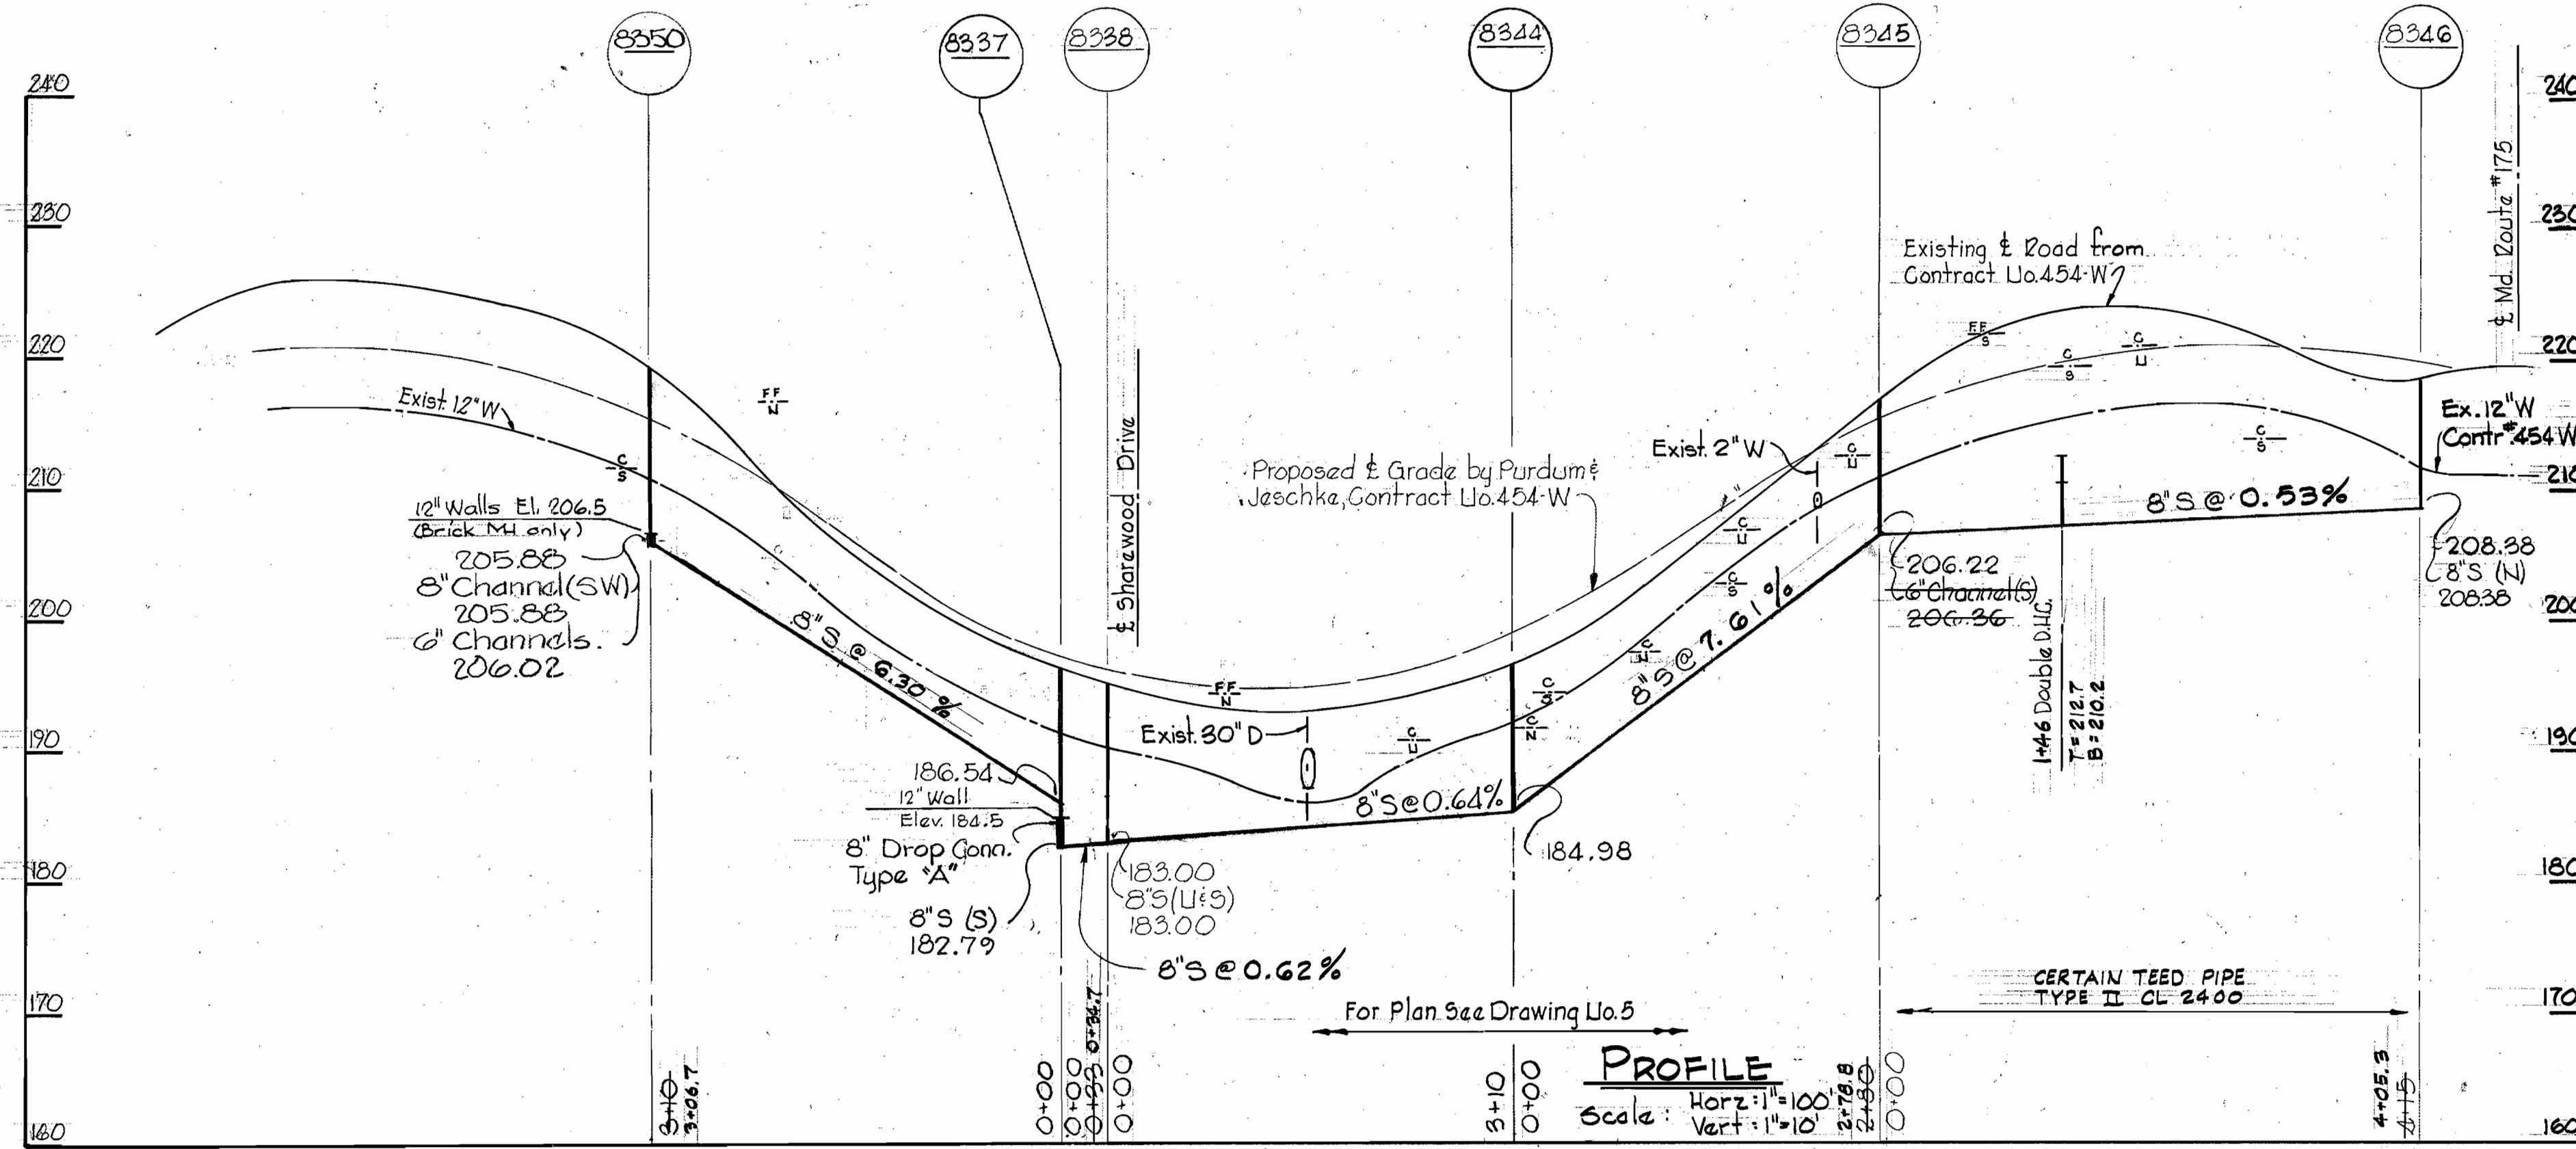

PROFILE
Scale: Horiz: 1"=100'
Vert: 1"=10'

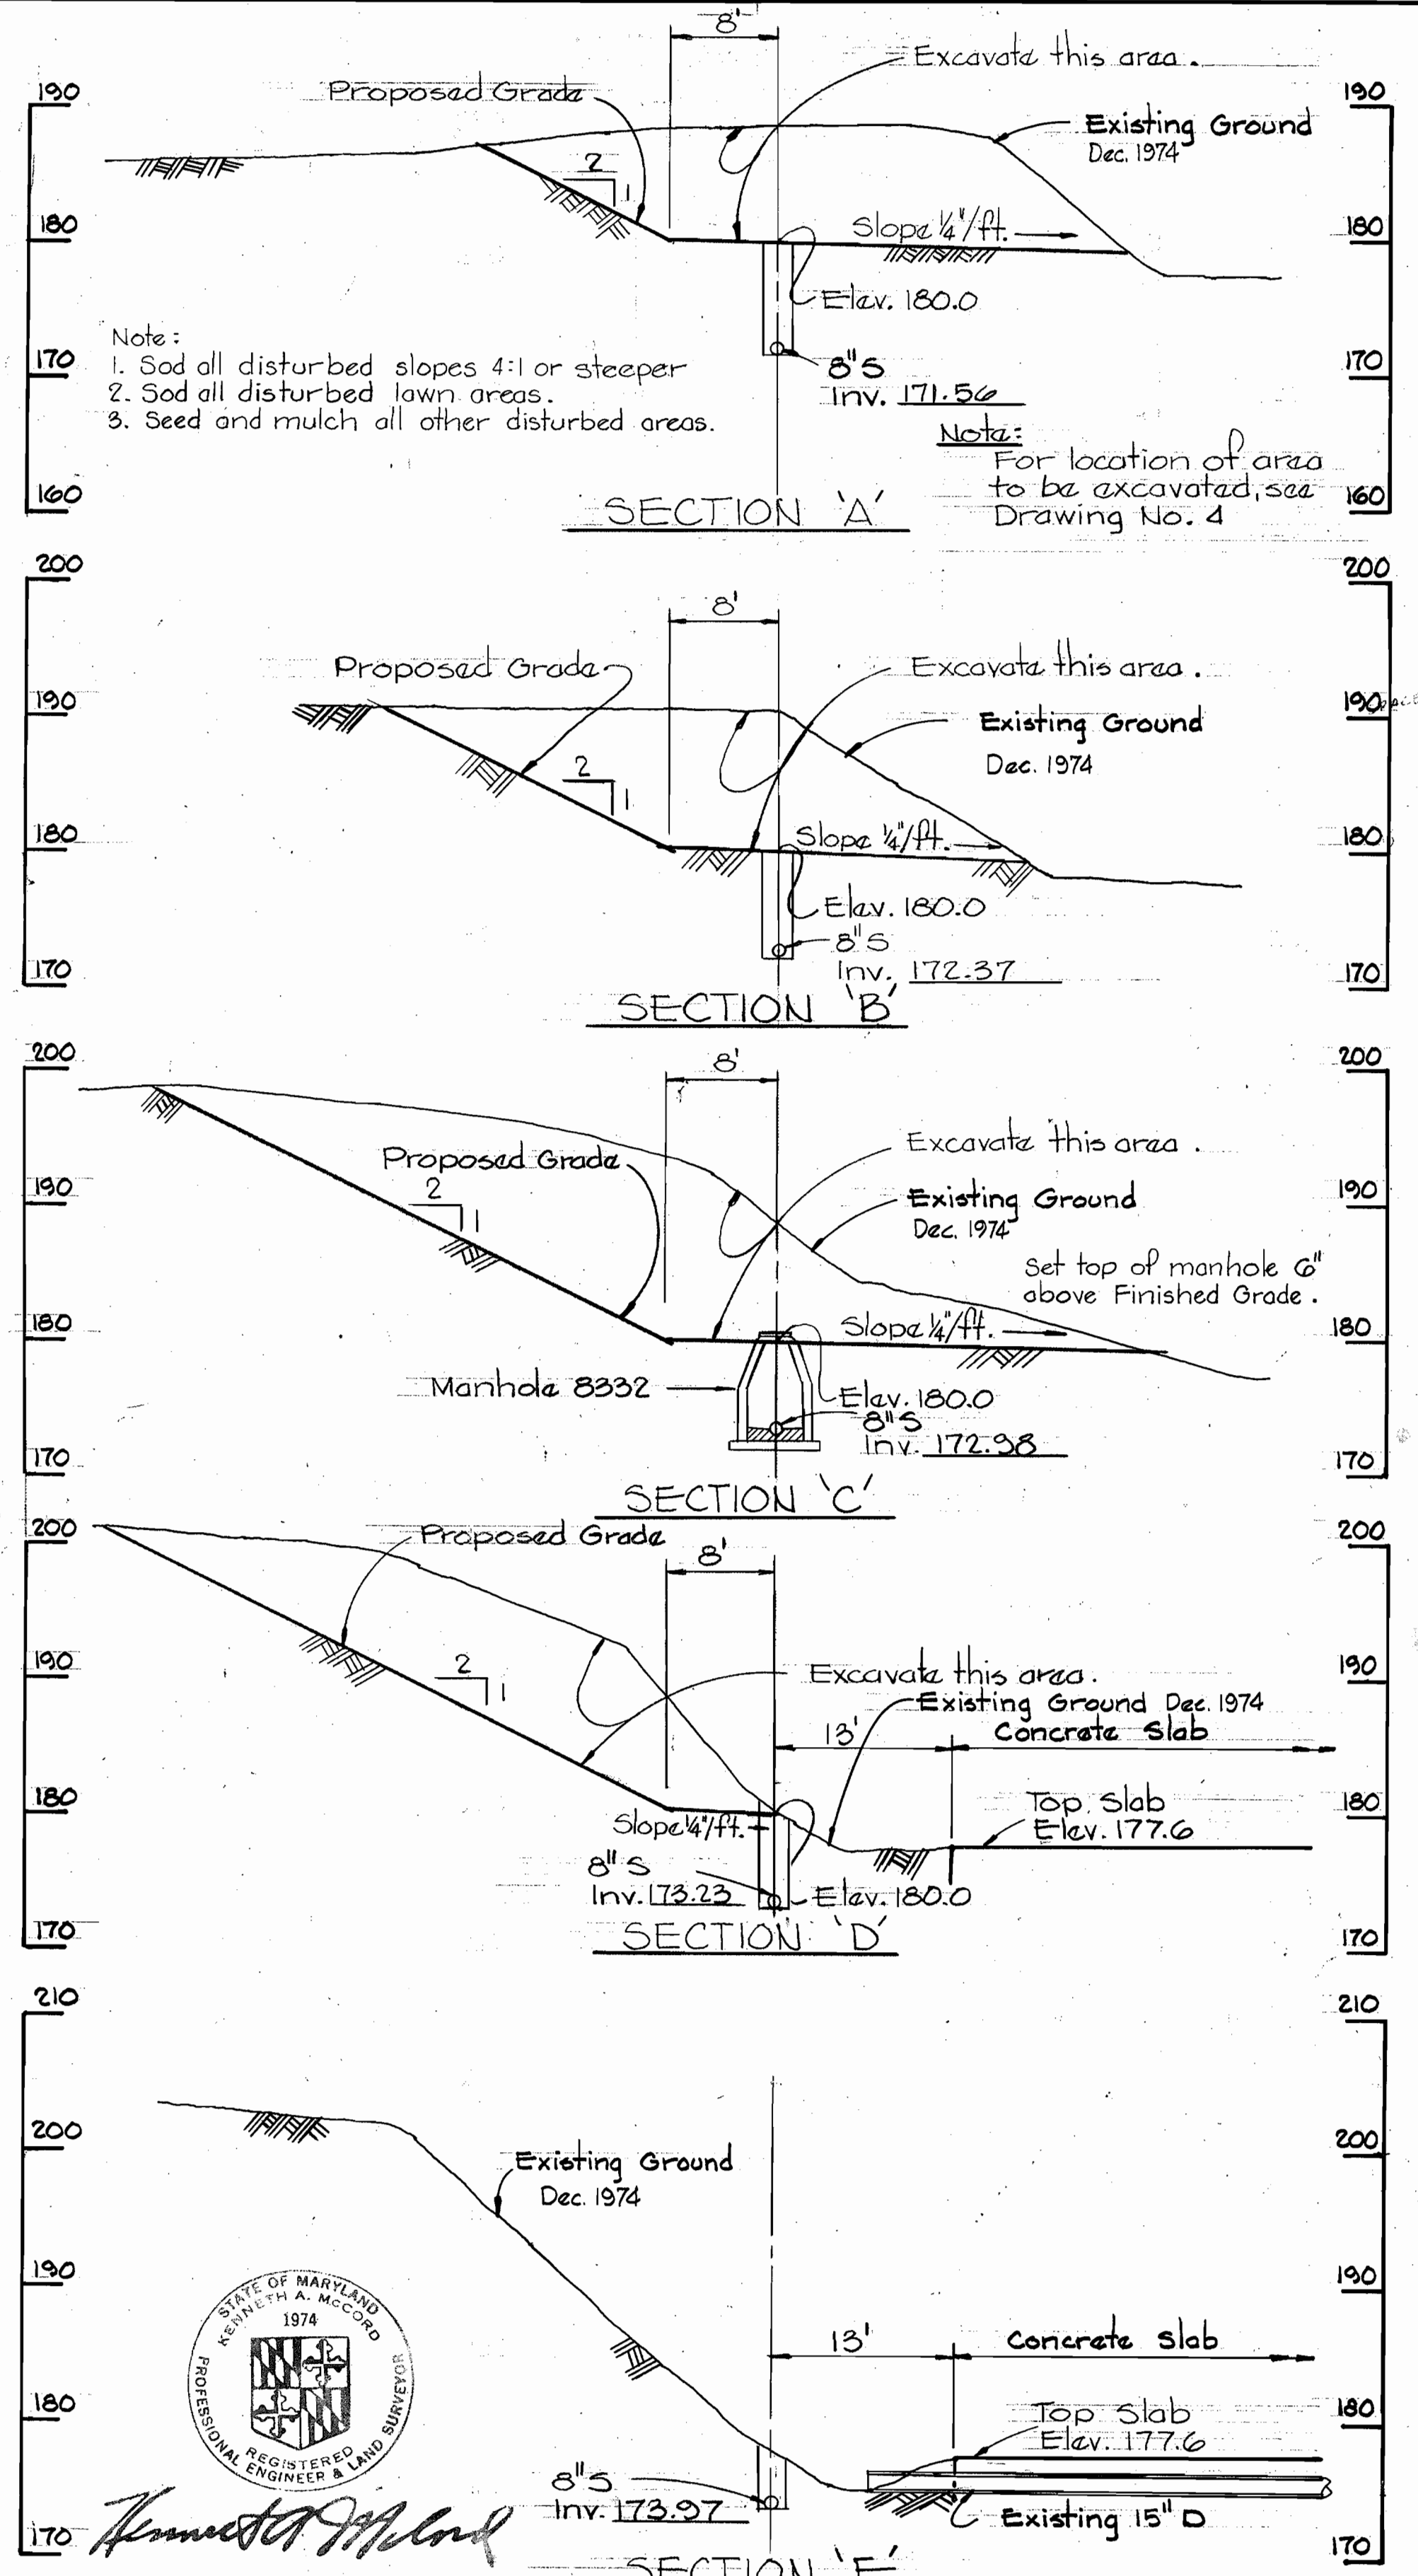

SECTIONS THRU SLOPE AREA -
MANHOLE 8331-A TO 8333 Scale: 1"=10'



WHITMAN, REQUARDT & ASSOCIATES
ENGINEERS
1304 ST. PAUL ST.
BALTIMORE, MARYLAND

DEPARTMENT OF PUBLIC WORKS
HOWARD COUNTY, MARYLAND
P.J. Regard 7-16-76
W.O. Lambert 7-15-76

CONTRACT NO. 612-S
PROJECT NO. S-4-6071

PROFILES OF
SEWER MAINS

ELECTION DISTRICT
GUILFORD NO.6

DRAWING NO. 8
OF 8
SCALE AS SHOWN

Project No. 612-6071
Sharewood Acres
Contract No. 612-5
March 14, 1979
AS-BUILT
Nov. 12, 1979

WS 612-S/8

W.O. 6810-2