

VICINITY MAP
SCALE: 1"=600'

CONTRACT NO. ~~2707~~-D-W & S
GWYNN ACRES SECTION 15
DEPARTMENT OF PUBLIC WORKS HOWARD CO.,MD.

| QUANTITIES | | |
|---------------|----------|-------------------|
| ITEM | QUANTITY | AS BUILT QUANTITY |
| 8" WATER | 3416LF | |
| 8" SEWER | 3300LF | |
| FIRE HYDRANTS | 5 | |
| 6" WATER | 50 LF | |



CONTRACT 2707-D-W&S-2-18-77

| | | | | | | |
|---|--|-------------------------------------|--------------|---|-----------------------|-------------------|
| BOENDER ASSOCIATES, INC. ENGINEERS SUITE 101-107 TOWN & COUNTRY PROFESSIONAL BUILDING ELLCOTT CITY, MD. 21043 | DEPARTMENT OF PUBLIC WORKS HOWARD COUNTY, MARYLAND <i>PA Regan</i> 2-28-77 DIRECTOR OF PUBLIC WORKS - DATE <i>WOLbert</i> 2-25-77 CHIEF-BUREAU OF ENGINEERING - DATE | CONTRACT NO. 2707 -D-W&S | VICINITY MAP | ELECTION DISTRICT ELLCOTT CITY NO. 2 | DRAWING NO. 1 OF 5 | SCALE AS SHOWN |
|---|--|-------------------------------------|--------------|---|-----------------------|-------------------|

B.M. #5 P.K. NAIL
 & INTERSECTION FONT HILL
 AND WINDFLOWER EL. 367.82

B.M. #6-B EL. 387.31
 IRON PIPE 78.00' SOUTHEAST
 OF & STA. 21+26
 WINDFLOWER DR.

| QUANTITIES | | |
|------------|----------|---------------------|
| ITEM | AS-BUILT | MATERIAL / SUPPLIER |
| 8" WATER | 3967' | J.M. |
| 8" SEWER | 3175' | J.M. |
| FH's | 5 | |

B.M. #R.M.1 - X CUT ON
 TOP OF MANHOLE RIM
 MH 2258 EL. 352.57

FOR PROFILES SEE
 DRWG. 5 OF 5

PLAN
 SCALE: 1" = 50'



CONTRACT 270-D-W-S
 Gwynn Acres
 Section 15

Rev. 1-11-77: W.H.N. - CHK:R.M.

| | | | | | | |
|--|---|---|----------------------------------|--|-------------|----------------------|
| BOENDER ASSOCIATES, INC. ENGINEERS SUITE 101-107 TOWN & COUNTRY PROFESSIONAL BUILDING ELLICOTT CITY, MD. 21043 | DEPARTMENT OF PUBLIC WORKS HOWARD COUNTY MARYLAND 2-28-77 DIRECTOR OF PUBLIC WORKS - DATE | CONTRACT NO. 270-D-W-S 2-25-77 CHIEF - BUREAU OF ENGINEERING - DATE | PLAN OF WATER AND SEWER MAINS | ELECTION DISTRICT ELLICOTT CITY NO. 2 | DRAWING NO. | SCALE AS SHOWN |
| | | | | | 2 OF 5 | |

AS-BUILT 7-8-77


NOTE: SANITARY PIPE BETWEEN MH #8 & MH #9 HAS BEEN SHORTENED FROM 12' LF TO 80' LF. SHC'S FOR LOTS 11, 13 & 14 HAVE BEEN RELOCATED TO THE BACK OF THE LOTS, OFF OF THE EXISTING 12'S.

NOTE: FOR PROFILES SEE DRWG. 5 OF 5

B.M. #4 EL. 359.40 IRON PIPE 85.00' SOUTH OF & STA. 13+45 ARJAY CIRCLE

B.M. #B.M.3 - X-CUT ON TOP OF MANHOLE RIM MH 2254 EL. 340.66

B.M. #105 EL. 349.88 X-CUT ON RIM OF SEWER MH ON RIVERSIDE CIRCLE

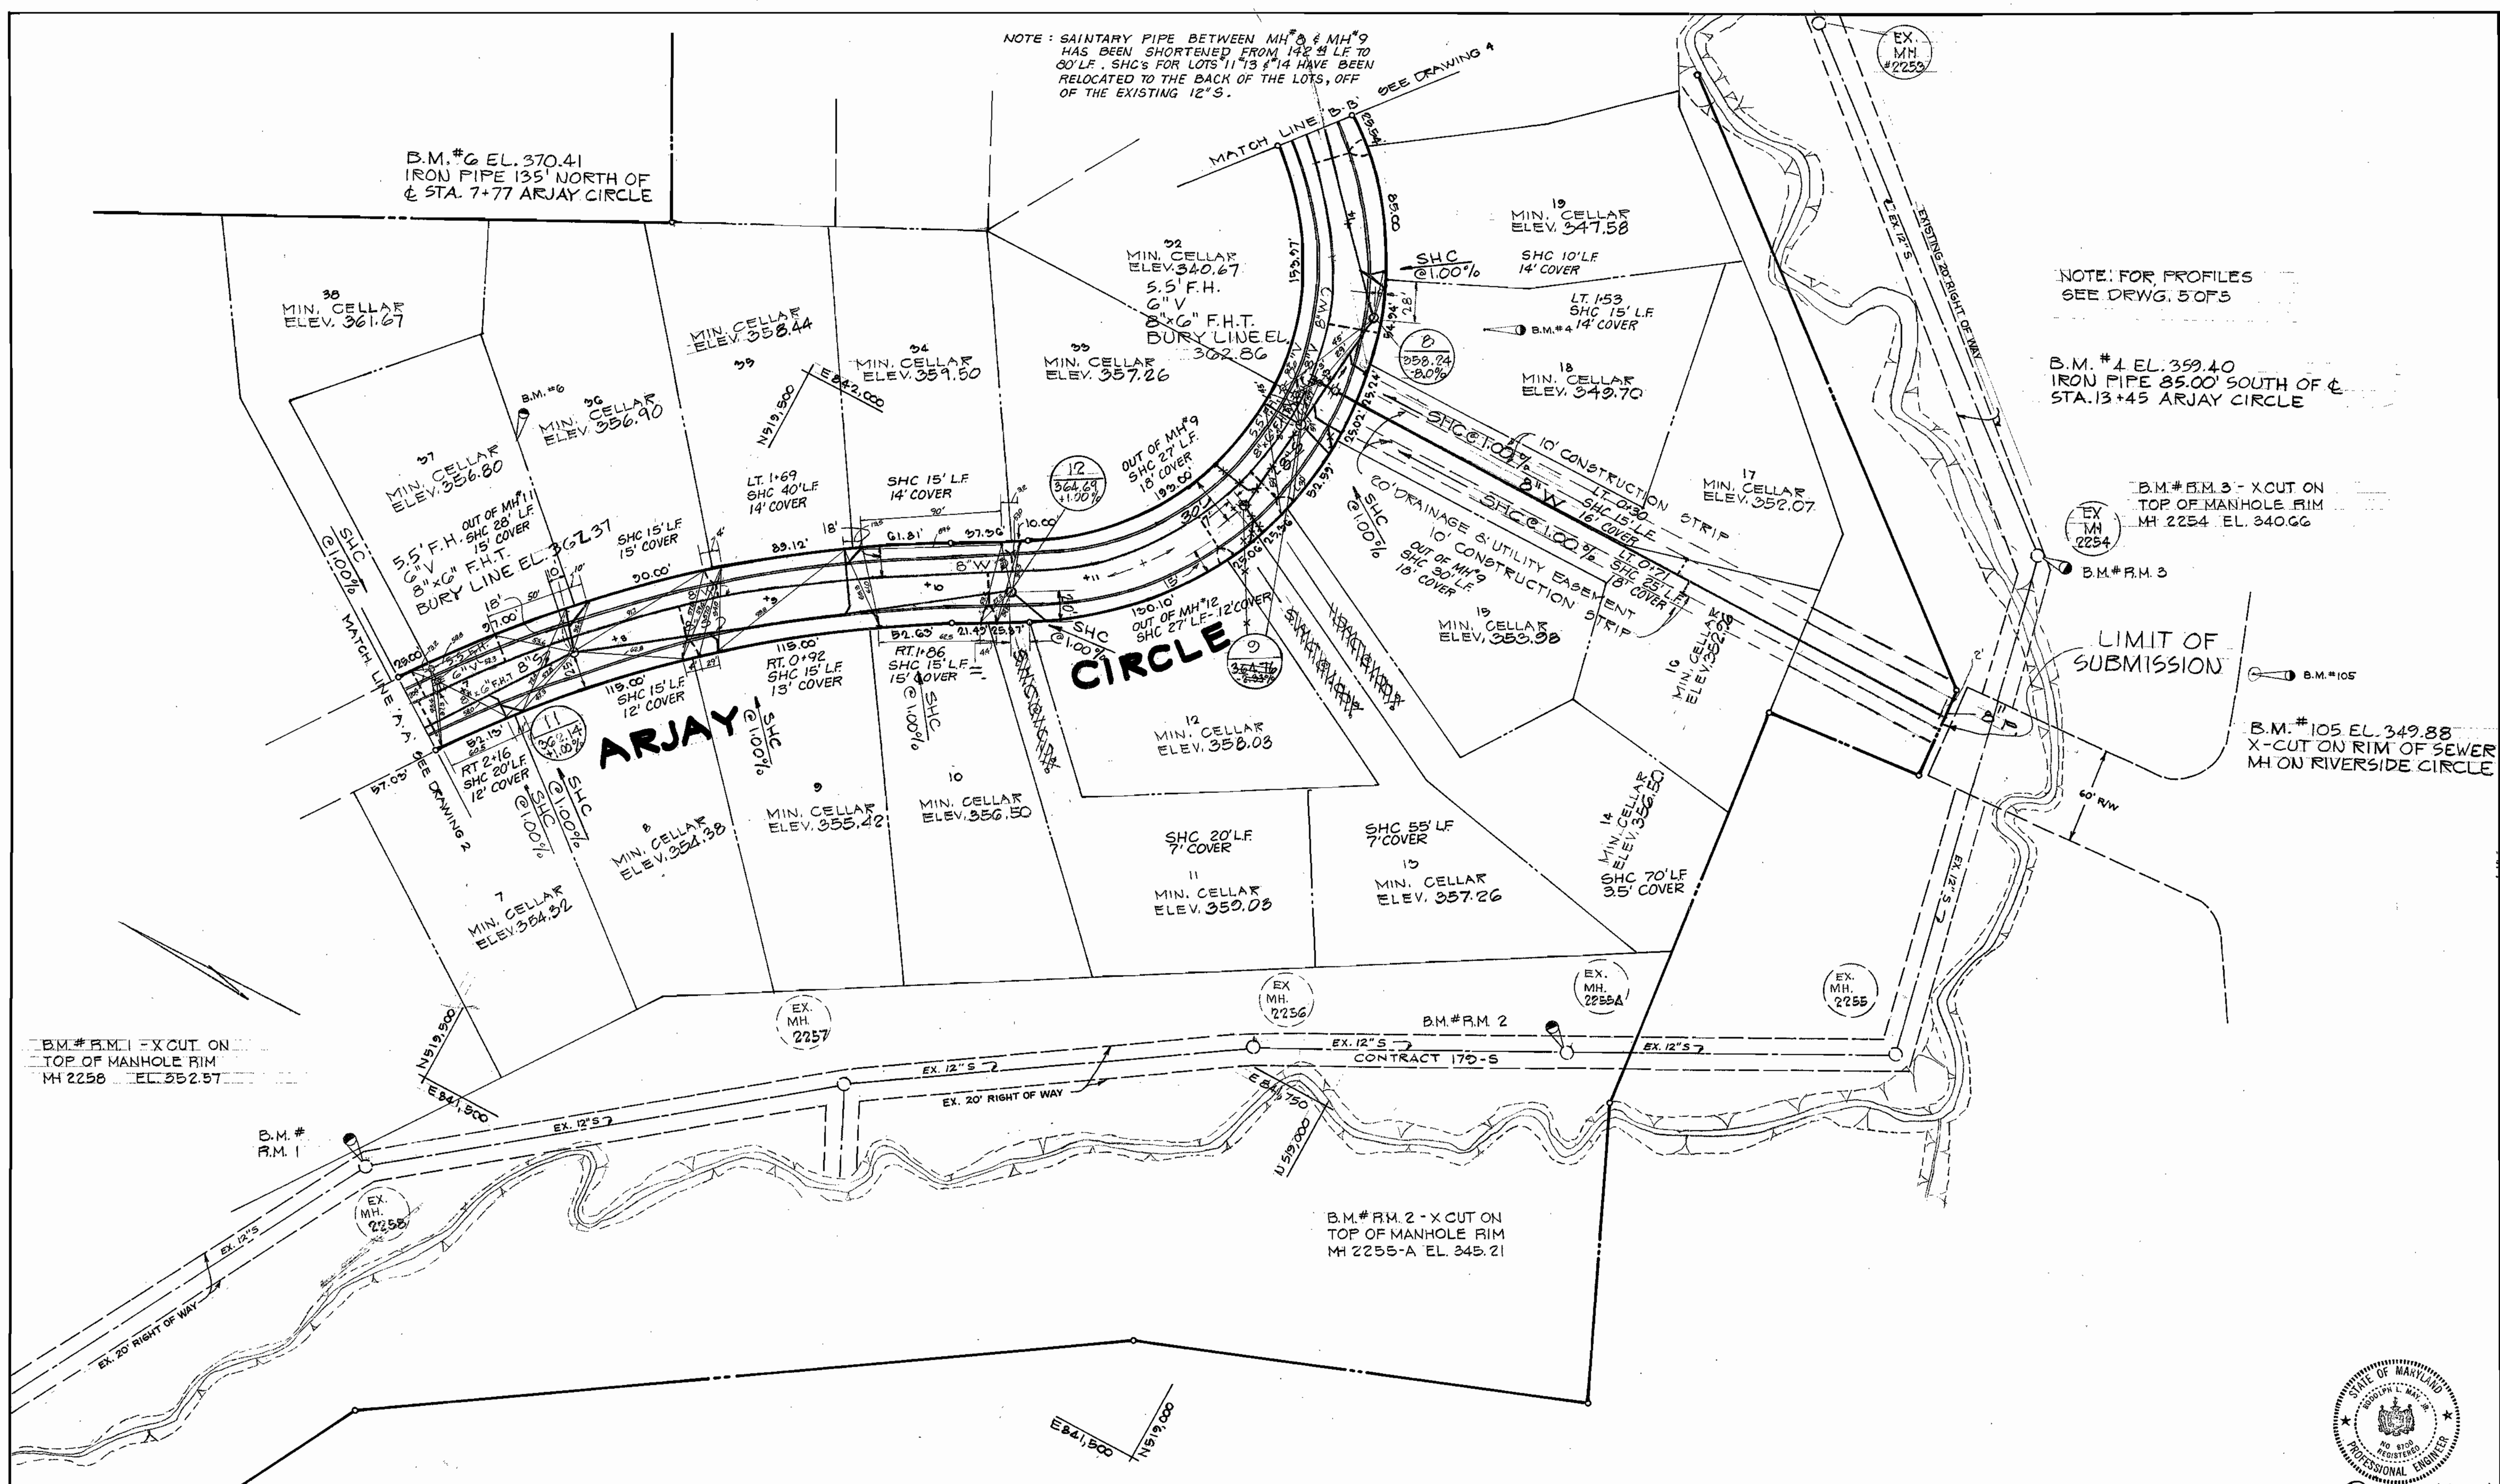

ARJAY CIRCLE

PLAN
SCALE: 1"=50'




Rodolph Mayhew
2-18-77
CONTRACT 2707D W&S
Gwynn Acres
Section 15


Rev. 1-11-77 W.H.N.-Ch. R.M.

| | | | | | | |
|---|---|---|----------------------------------|---|-------------|----------|
| BOENDER ASSOCIATES, INC. ENGINEERS SUITE 101-107 TOWN & COUNTRY PROFESSIONAL BUILDING ELLCOTT CITY, MD. 21043 | DEPARTMENT OF PUBLIC WORKS HOWARD COUNTY MARYLAND 2-28-77 DIRECTOR OF PUBLIC WORKS - DATE | CONTRACT NO. 2707-D-W&S W.O. Gilbert 2-21-77 CHIEF - BUREAU OF ENGINEERING - DATE | PLAN OF WATER AND SEWER MAINS | ELECTION DISTRICT ELLCOTT CITY NO. 2 | DRAWING NO. | SCALE |
| | | | | | 3 OF 5 | AS SHOWN |

AS-BUILT 7-8-77

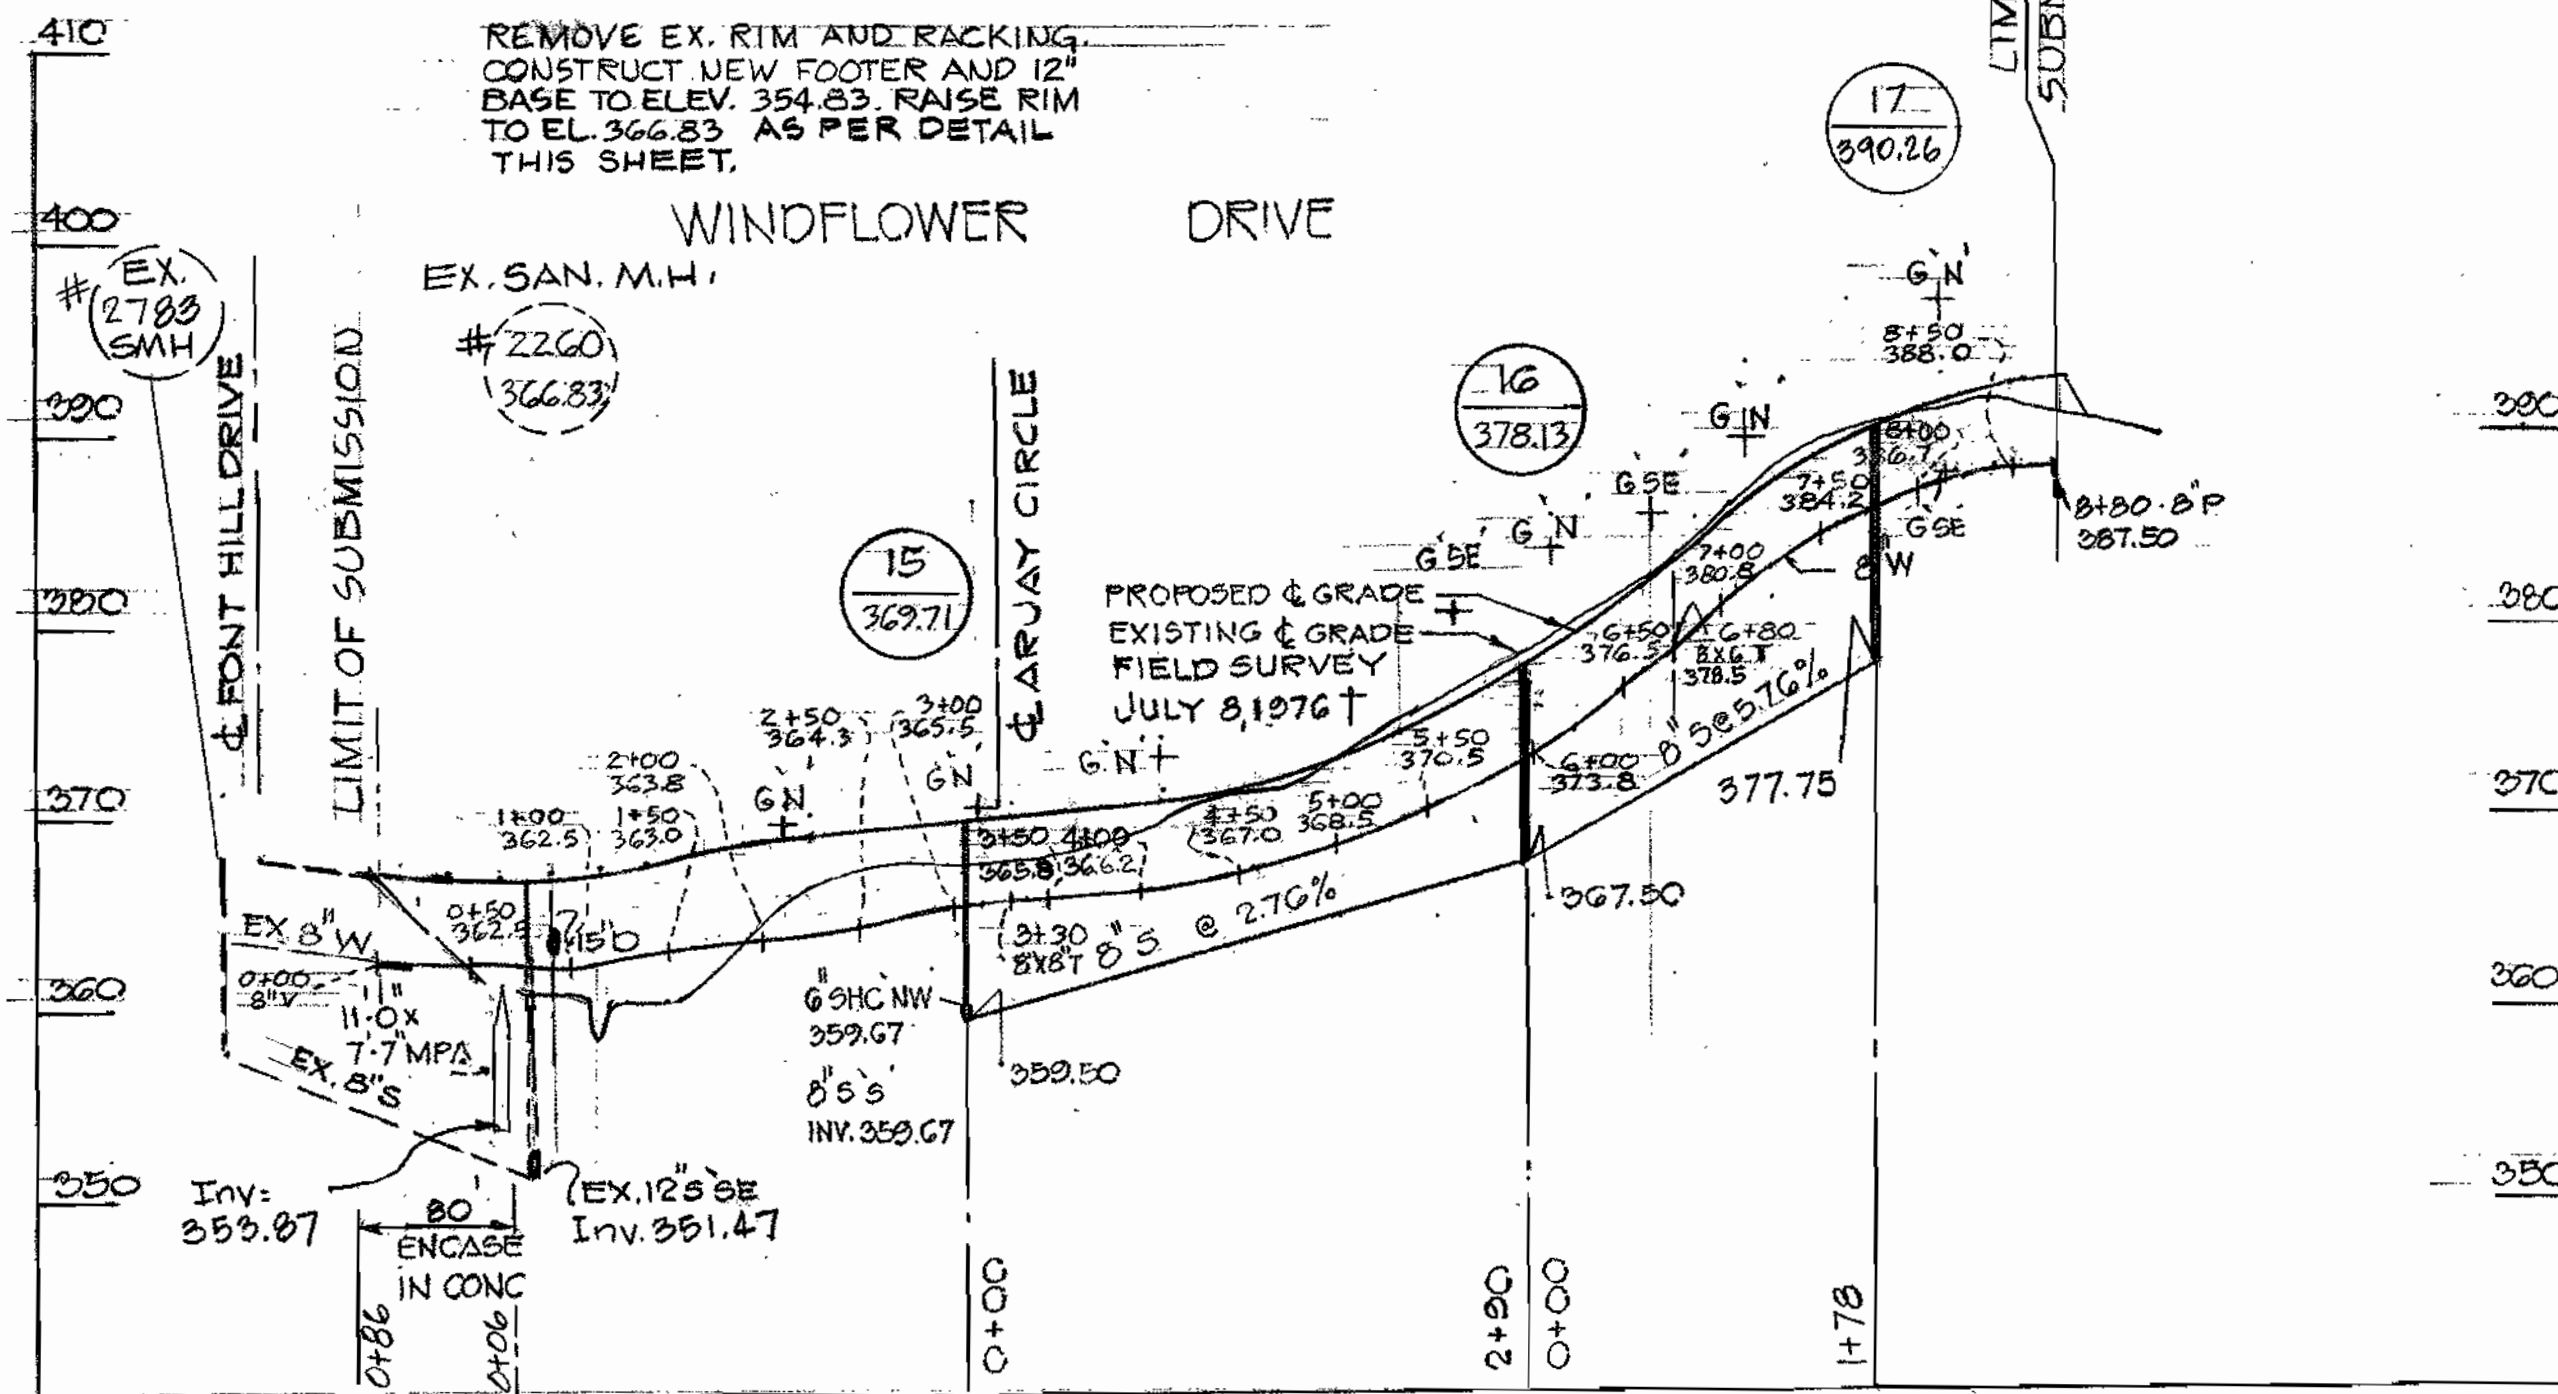


PROFILE
SCALE: HOR. 1" = 100'
VERT. 1" = 10'

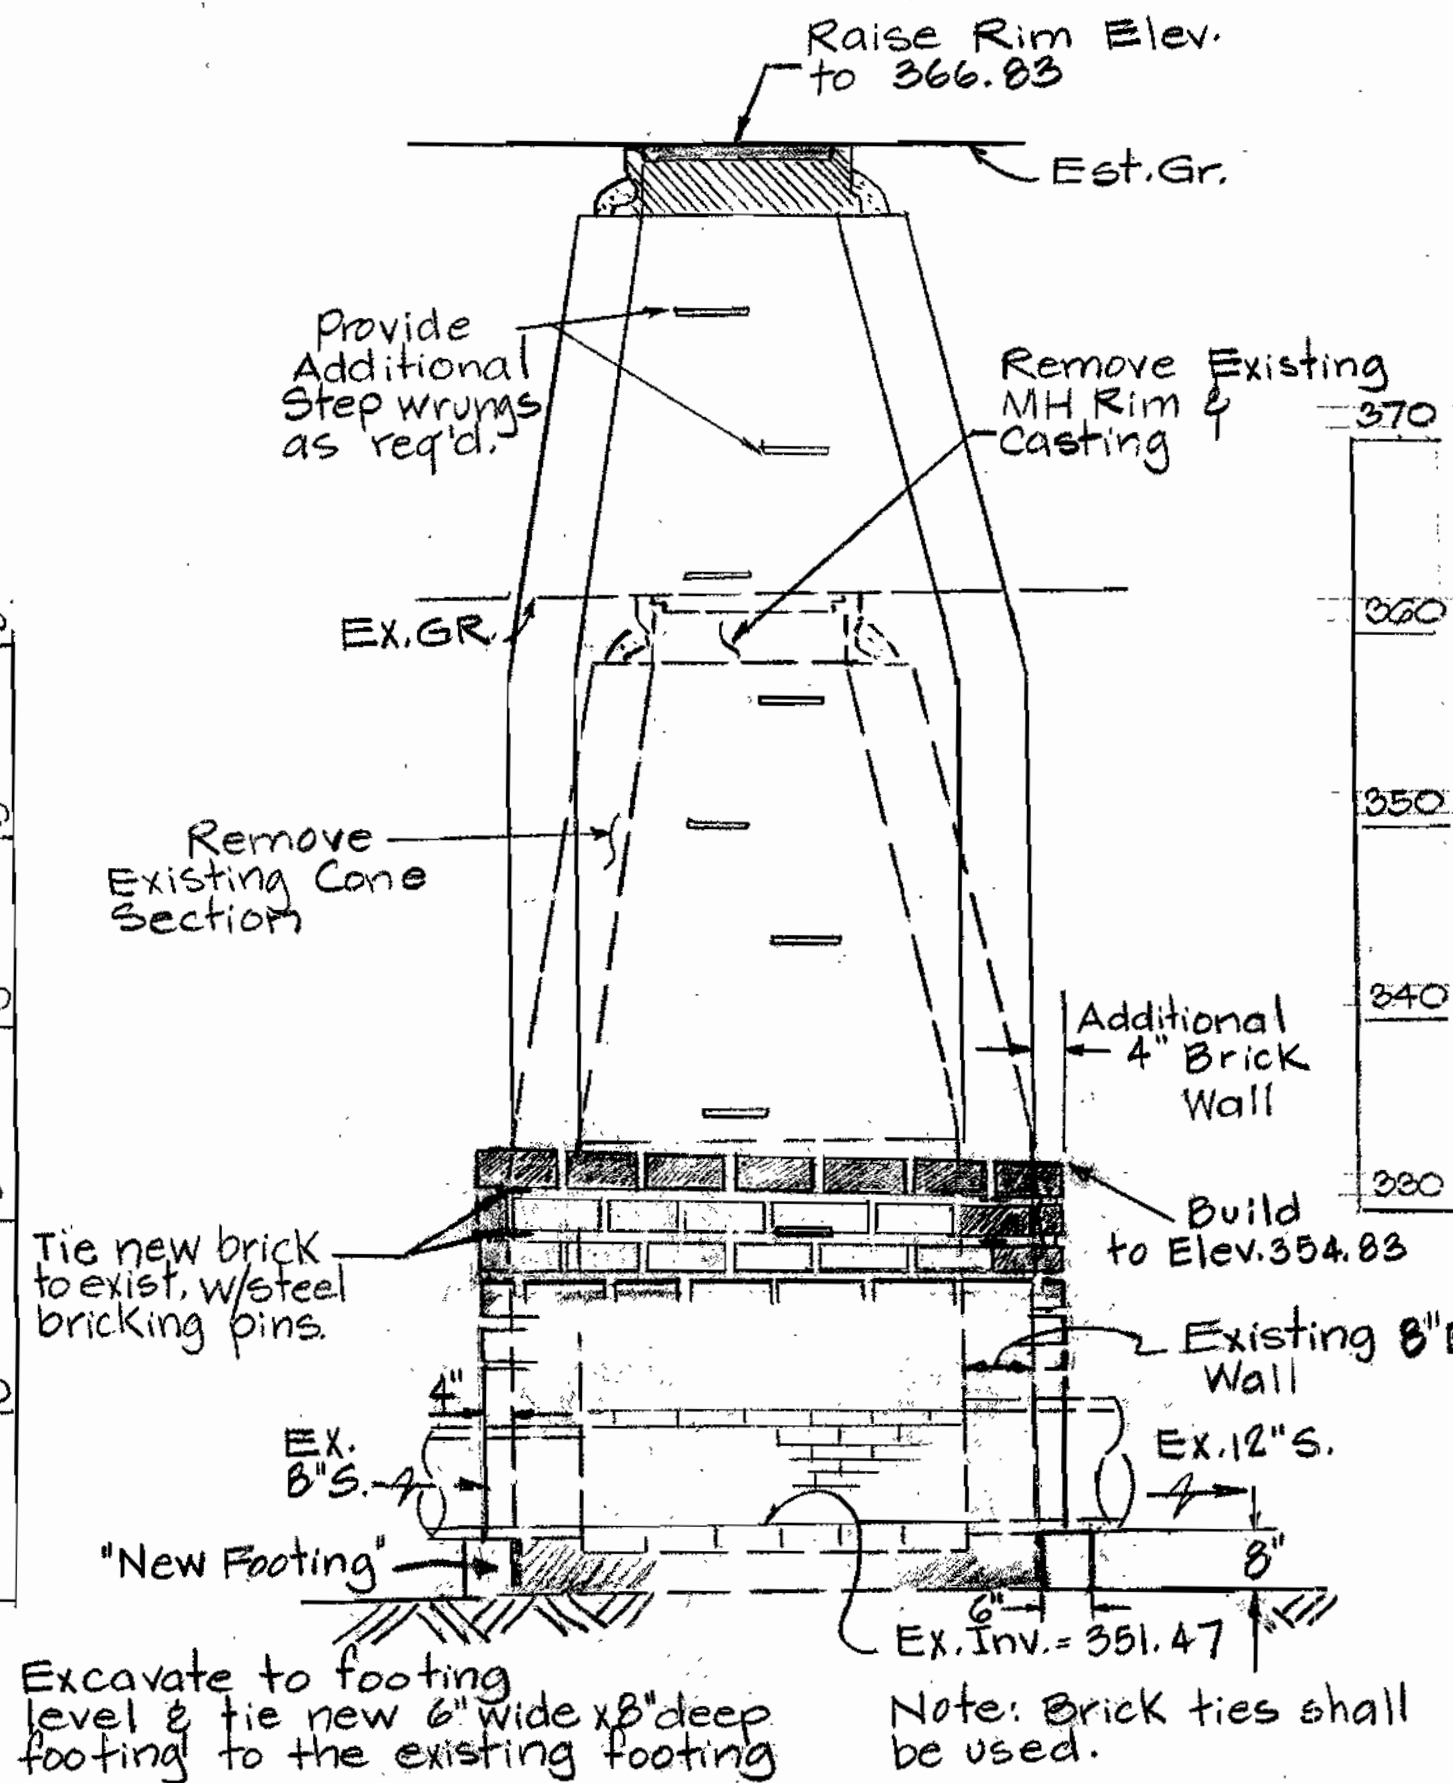


RECONSTRUCTION OF EXISTING MH 2260

NO SCALE
Note: All reconstruction of Brick Manholes shall be performed according to the provisions of Section 13 of the Howard County W&S General Specs.

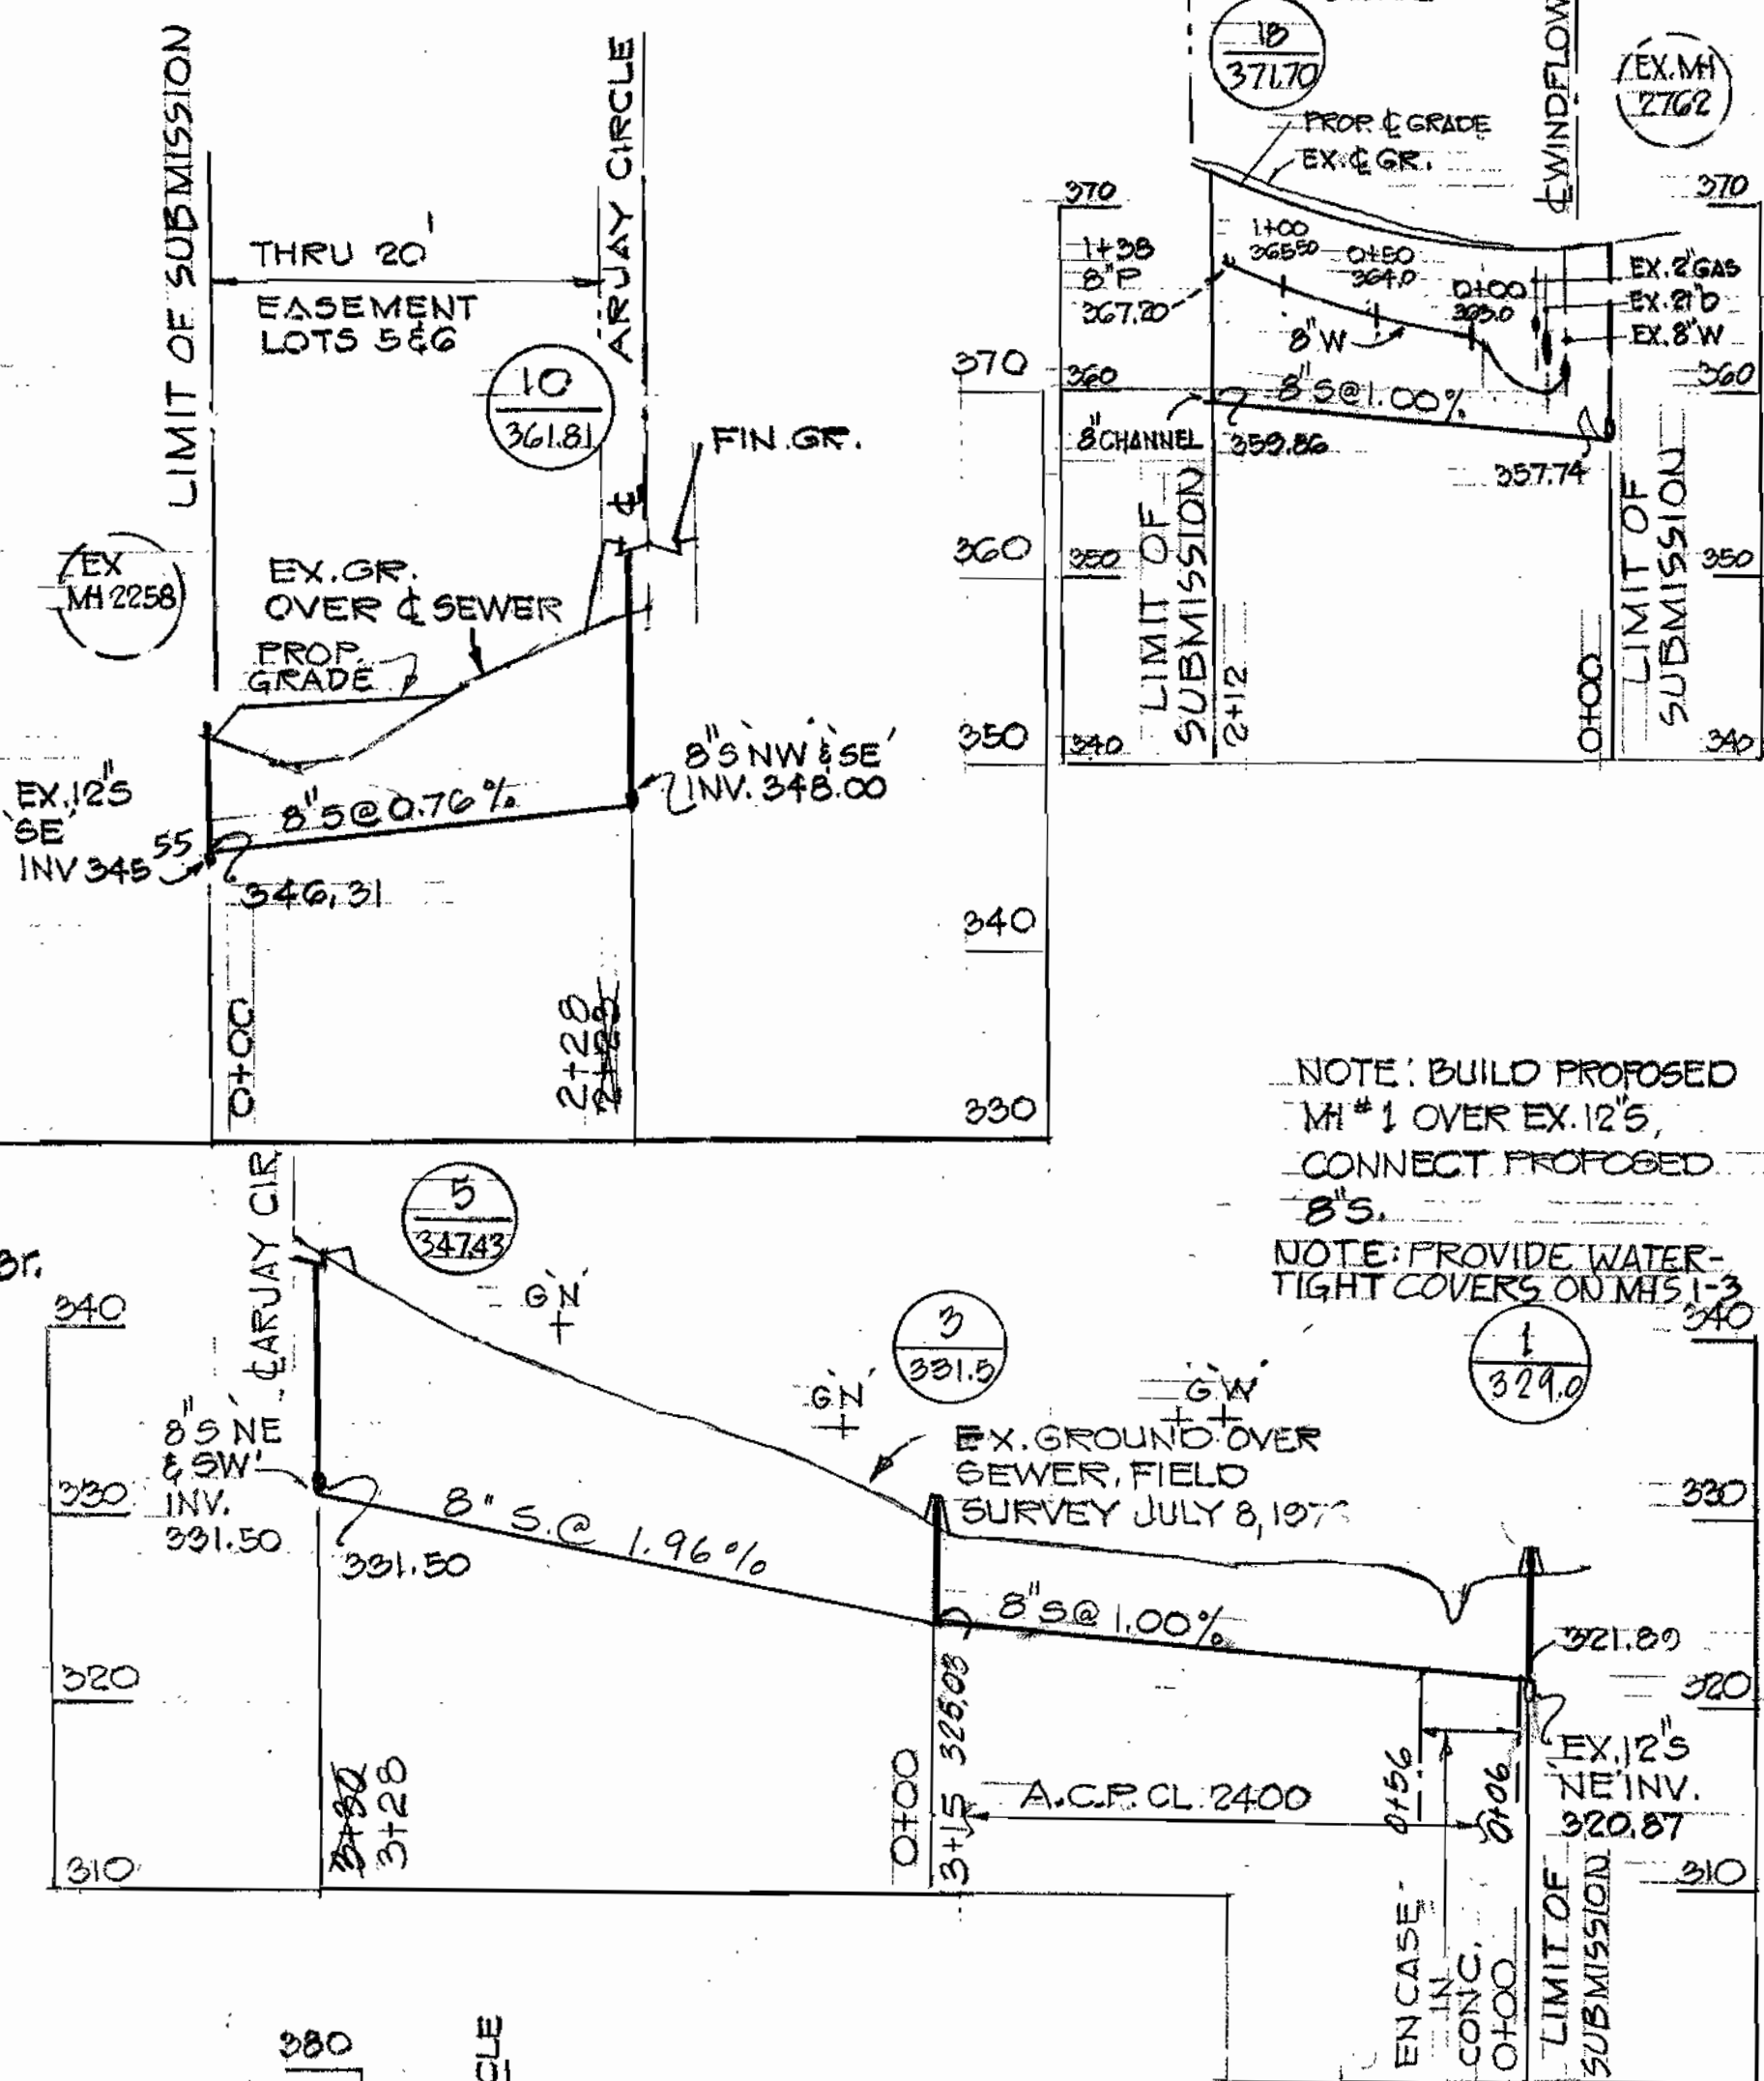

PROFILE
SCALE: HOR. 1" = 100'
VERT. 1" = 10'

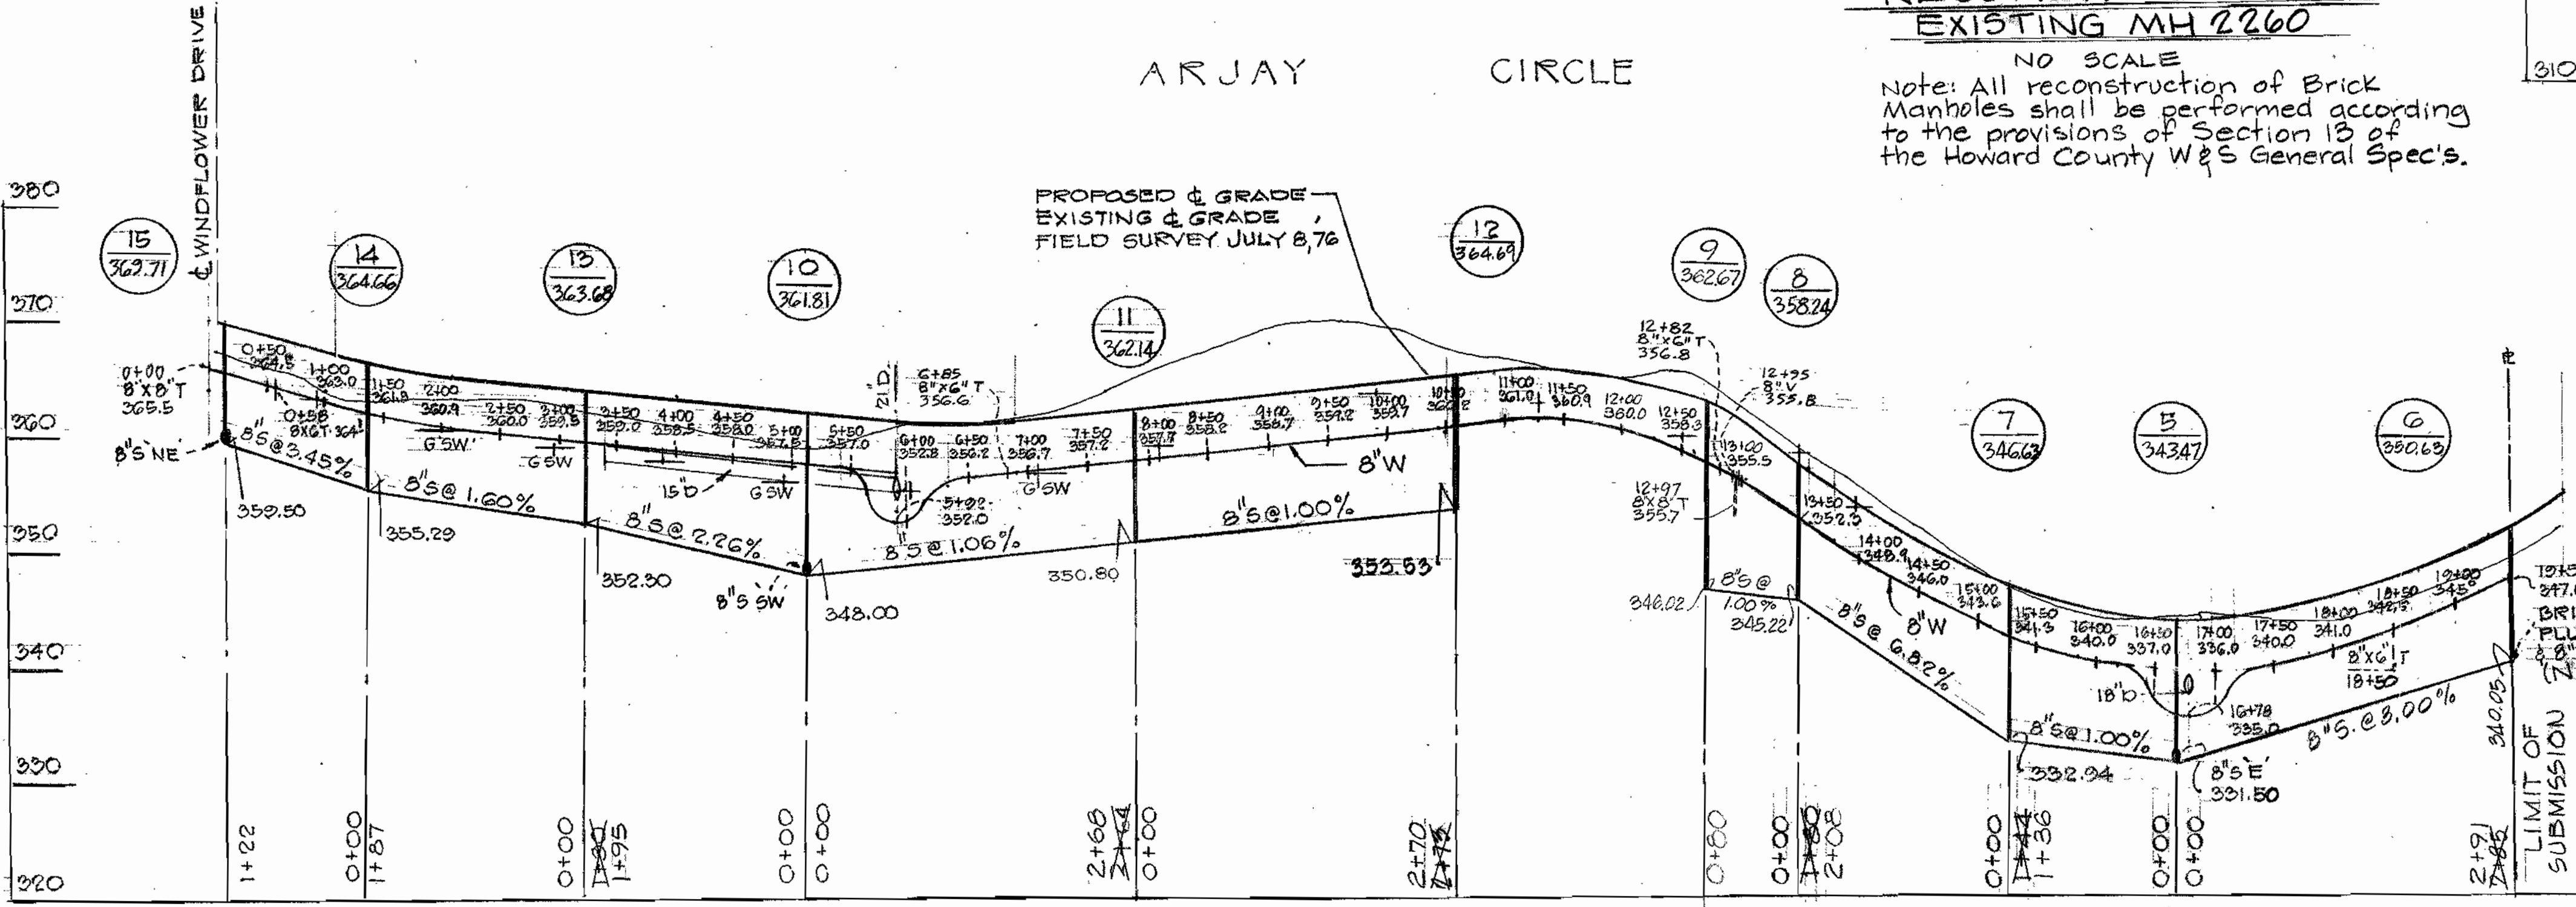

PROFILE
SCALE: HOR. 1" = 100'
VERT. 1" = 10'



CONTRACT 2707-D-W&S
Rev. 1-11-77: W.H.N. - ch. R.M.

| | | | | | |
|---|---|-------------------------|----------------------------------|---------------------------------------|--------------------------------------|
| BOENDER ASSOCIATES, INC. ENGINEERS SUITE 101-107 TOWN & COUNTRY PROFESSIONAL BUILDING ELLCOTT CITY, MD. 21043 | DEPARTMENT OF PUBLIC WORKS HOWARD COUNTY MARYLAND 2-28-77 W. O. Filled 2-25-77 DIRECTOR OF PUBLIC WORKS - DATE CHIEF - BUREAU OF ENGINEERING - DATE | CONTRACT NO. 2707-D-W&S | PROFILE OF WATER AND SEWER MAINS | ELECTION DISTRICT ELLICOTT CITY NO. 2 | DRAWING NO. 5 OF 5 SCALE AS SHOWN |
|---|---|-------------------------|----------------------------------|---------------------------------------|--------------------------------------|