



SEWELL'S ORCHARD, INC.
LIDER 467 FOLIO 673

SAMUEL E. ECKER
LIDER 222 FOLIO 574

PLAN
SCALE: 1" = 50'

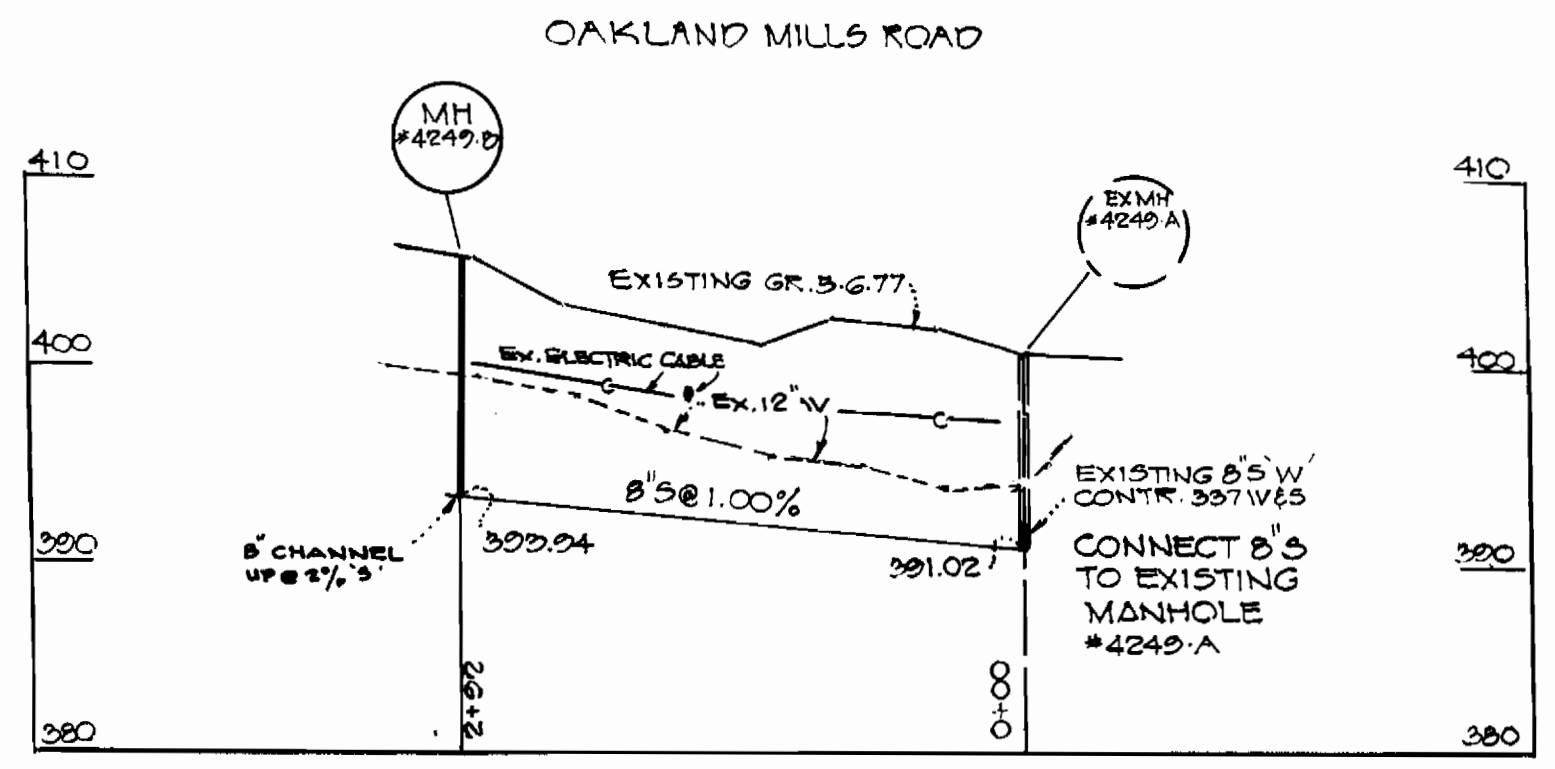

PROFILE
SCALE: HORIZ. 1" = 100'
VERT. 1" = 10'

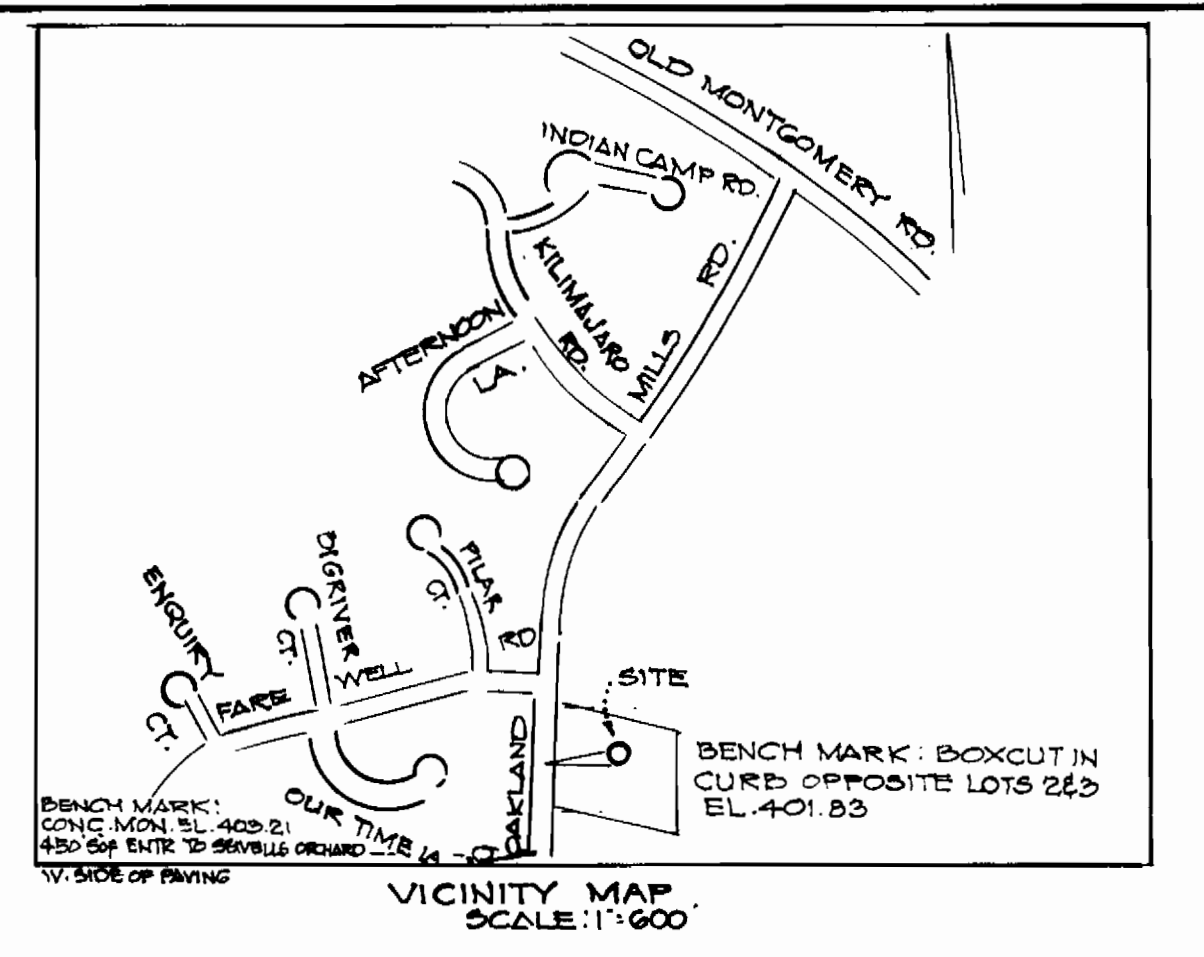

GENERAL NOTES:

1. APPROXIMATE LOCATION OF EXISTING MAINS ARE SHOWN. THE CONTRACTOR SHALL TAKE ALL NECESSARY PRECAUTIONS TO PROTECT EXISTING MAINS AND SERVICES AND MAINTAIN UNINTERRUPTED SUPPLY OR SERVICE. ANY DAMAGE INCURRED, SHALL BE REPAIRED IMMEDIATELY.
2. ALL PIPE ELEVATIONS SHOWN ARE INVERT ELEVATIONS.
3. THE CONTRACTOR SHALL LOCATE EXISTING UTILITIES A MINIMUM OF 2 (TWO) WEEKS IN ADVANCE OF CONSTRUCTION OPERATIONS IN VICINITY OF UTILITIES.
4. THE CONTRACTOR SHALL NOTIFY THE FOLLOWING UTILITIES OR AGENCIES AT LEAST FIVE DAYS BEFORE STARTING WORK SHOWN ON THESE PLANS.
BALTIMORE GAS AND ELECTRIC COMPANY UNDERGROUND ELECTRIC DISTRIBUTION ENGINEERING DAMAGE CONTROL 234-5691
UNDERGROUND GAS DISTRIBUTION ENGINEERING 559-0100
CHESAPEAKE AND POTOMAC TELEPHONE COMPANY 727-9976
5. FOR ALL STANDARDS & DETAILS SEE STANDARDS FOUND IN SPECIFICATIONS.
6. ALL HORIZONTAL AND VERTICAL CONTROLS ARE BASED ON MARYLAND STATE DATUM.
7. CLEAR ALL UTILITIES BY A MINIMUM OF 6" CLEAR ALL POLES BY A MINIMUM OF 2'0" OR TUNNEL AS REQUIRED.
8. ALL SEWER MAINS SHALL BE C.S.P.X., V.C.P.X., OR A.C.F. CLASS 2400 UNLESS OTHERWISE NOTED.
9. ALL MANHOLES SHALL BE 4'-0" INSIDE DIAMETER.
10. THE CONTRACTOR SHALL PROVIDE A JOINT IN ALL SEWER MAINS WITHIN 2'-0" OF EXTERIOR MANHOLE WALLS.
11. BENCH MARK: BOXCUT CURB OPPOSITE FRONT LOTS 2&3 EL. 401.83
12. BENCH MARK: WHITMAN REQUARDT & ASSOCIATES EL. 403.21
DESCRIPTION: CONCRETE MONUMENT TOPPED BY BRASS CAP 450 FT. SOUTH OF ENTRANCE TO SEWELL'S ORCHARD ON OAKLAND MILLS ROAD, WEST SIDE OF PAVING.

QUANTITIES			
SIZE	QUANTITY	AS BUILT	SUPPLIER
8" S	202 LF	200 LF	
6" SHC	60 LF		
1" VHC	64 LF		
3/4" VHC	10 LF		

Sewer: ACP Class 2400 - JOHNS MANFIELD

OAKLAND MILLS ROAD
LOTS 1, 2, 3 & 4
CONTRACT 2756-D-IV&S



HUDKINS ASSOCIATES INCORPORATED
ENGINEERS
231 JOSEPH SQUARE
COLUMBIA, MD.

DEPARTMENT OF PUBLIC WORKS
HOWARD COUNTY, MARYLAND
W. O. Fellert 7-29-77
CHIEF BUREAU OF WATER AND SEWER

CONTRACT NO. 2756-D-W&S

PLAN & PROFILE OF
SEWER MAINS

OAKLAND MILLS ROAD LOTS 1, 2, 3 & 4
ELECTION DISTRICT NO. 6

DRAWING NO. 1 OF 1
SCALE AS SHOWN

As Built - Nov. 19, 1977