

Wastewater Treatment	Savage
No of SHC's	2
No of WHC's	-
Type of Lots	Single Family
No of Lots	1




- GENERAL NOTES**
- APPROXIMATE LOCATION OF EXISTING MAINS ARE SHOWN. THE CONTRACTOR SHALL TAKE ALL NECESSARY PRECAUTIONS TO PROTECT EXISTING MAINS AND SERVICES AND MAINTAIN UNINTERRUPTED SUPPLY. ANY DAMAGE INCURRED SHALL BE REPAIRED IMMEDIATELY.
  - ALL PIPE ELEVATIONS SHOWN ARE INVERT ELEVATIONS.
  - THE CONTRACTOR SHALL LOCATE EXISTING UTILITIES A MINIMUM OF TWO WEEKS IN ADVANCE OF CONSTRUCTION OPERATIONS IN VICINITY OF UTILITIES.
  - THE CONTRACTOR SHALL NOTIFY THE FOLLOWING UTILITIES OR AGENCIES AT LEAST FIVE DAYS BEFORE STARTING WORK SHOWN ON THESE PLANS:  
 BALTIMORE GAS AND ELECTRIC COMPANY - UNDERGROUND ELECTRIC DISTRIBUTION ENGINEERING DEPARTMENT 289-5691  
 UNDERGROUND GAS DISTRIBUTION ENGINEERING 289-5621  
 CHESAPEAKE AND POTOMAC TELEPHONE COMPANY 398-3648.  
 MISS. UTILITY - 1 - 569-8100
  - FOR ALL STANDARD DETAILS SEE STANDARDS BOUND IN SPECIFICATIONS.
  - ALL HORIZONTAL AND VERTICAL CONTROLS ARE BASED ON MARYLAND STATE DATUM.
  - CLEAR ALL UTILITIES BY A MINIMUM OF 8".
  - ALL SEWER MAINS SHALL BE C.S.P.X., V.C.P.X. OR A.C.P. CLASS 2408 UNLESS OTHERWISE NOTED.
  - ALL MANHOLES SHALL BE 4'-0" INSIDE DIAMETER.
  - THE CONTRACTOR SHALL PROVIDE A JOINT IN ALL SEWER MAINS WITHIN 2'-0" OF EXTERIOR WARDHOLE WALLS.
  - TREES ARE TO BE PROTECTED FROM DAMAGE TO MAXIMUM EXTENT. TREES LOCATED WITHIN THE CONSTRUCTION STRIP ARE NOT TO BE REMOVED OR DAMAGED BY THE CONTRACTOR.
  - MANHOLES DESIGNATED W.T. IN PROFILES SHALL HAVE WATER TIGHT FRAME AND COVERS.

ITEM	QUANTITIES		MATERIAL/SUPPLIER
	BID	AS BUILT	
8" Sewer	430 L.F.	335.49 L.F.	ACP JOHN'S MANVILLE DIP GALEITH
Manholes	15 V.F.	14 V.F.	PRECAST CONC. ATLANTIC



*Kenneth A. McCord*

Sewer Extension  
Maisel Property  
Parcel 13 - Map 30  
Columbia Road - Ellicott City  
Contract No. 20-0922-D

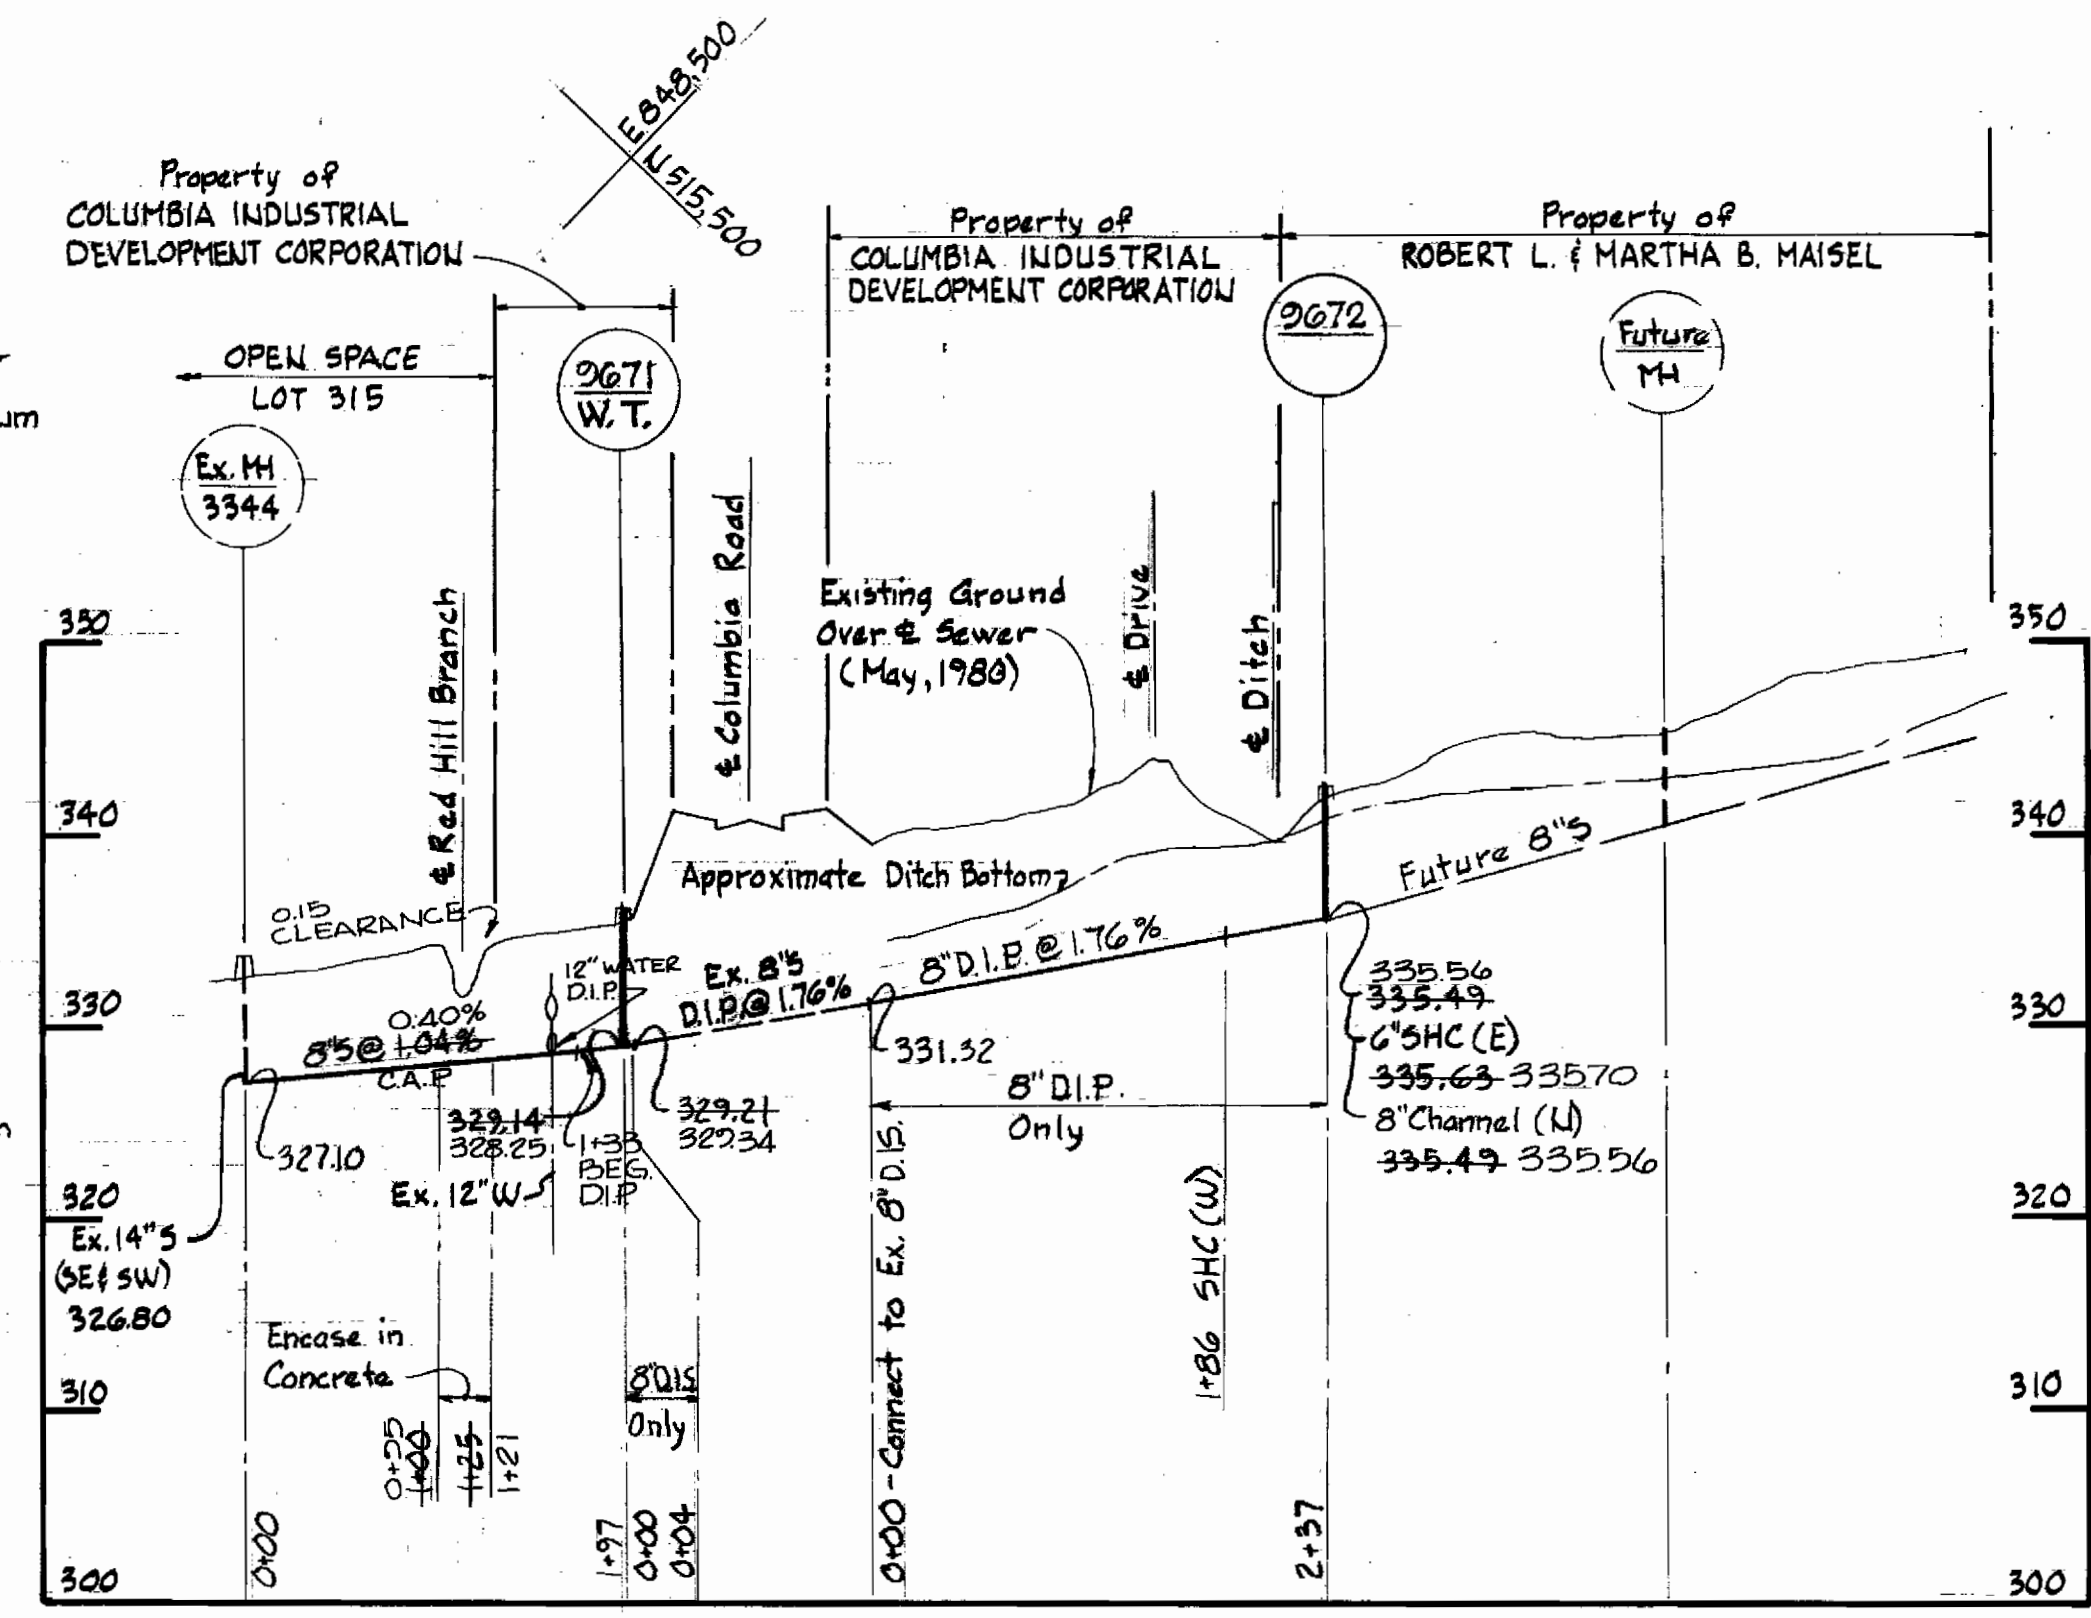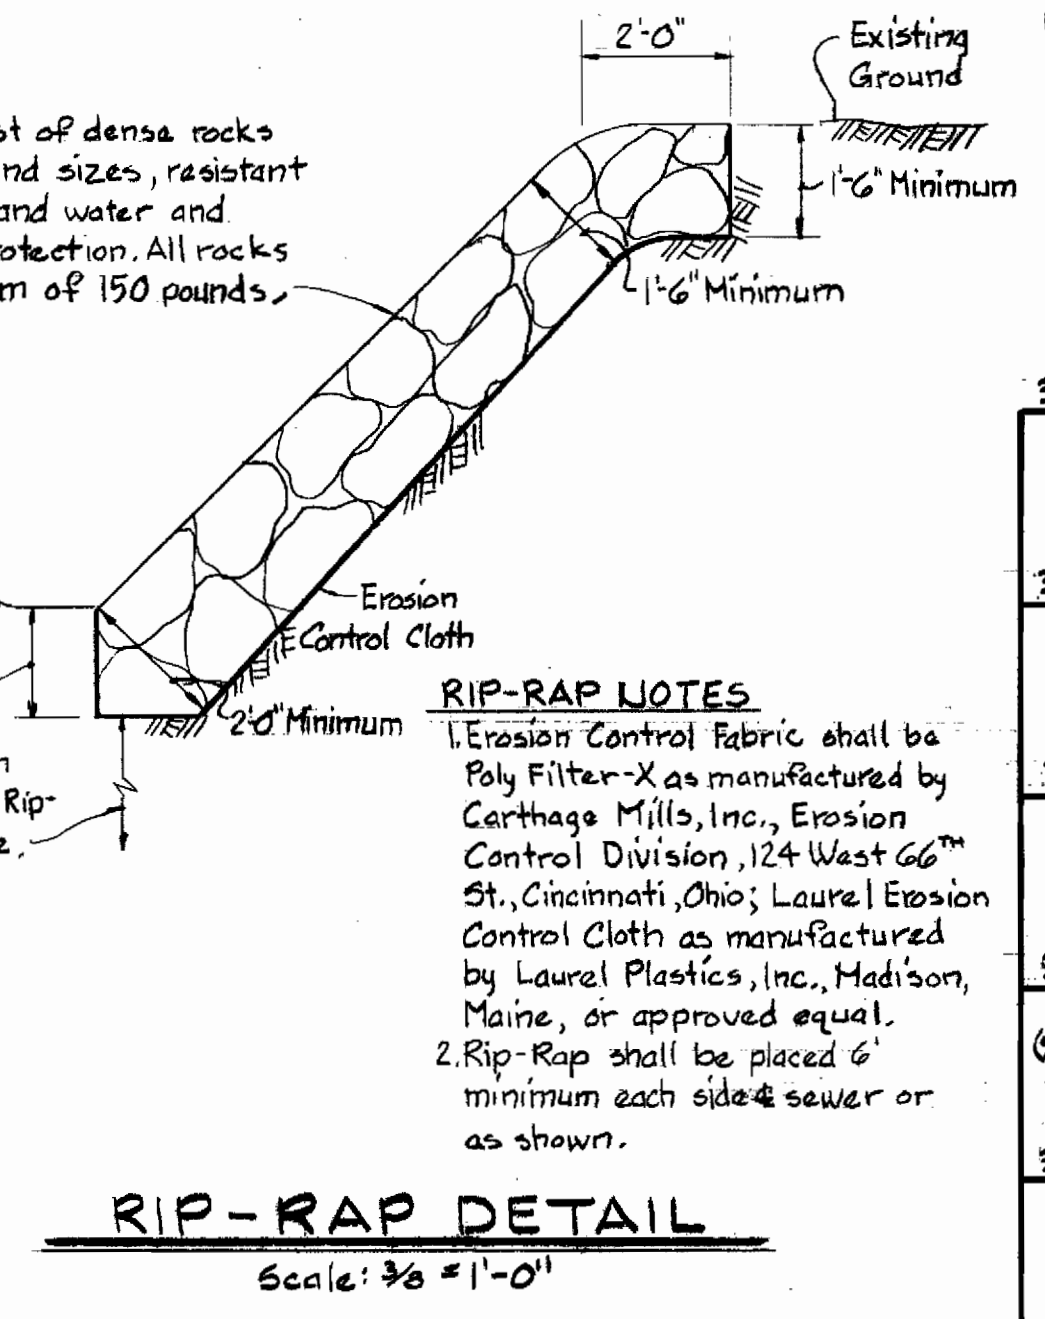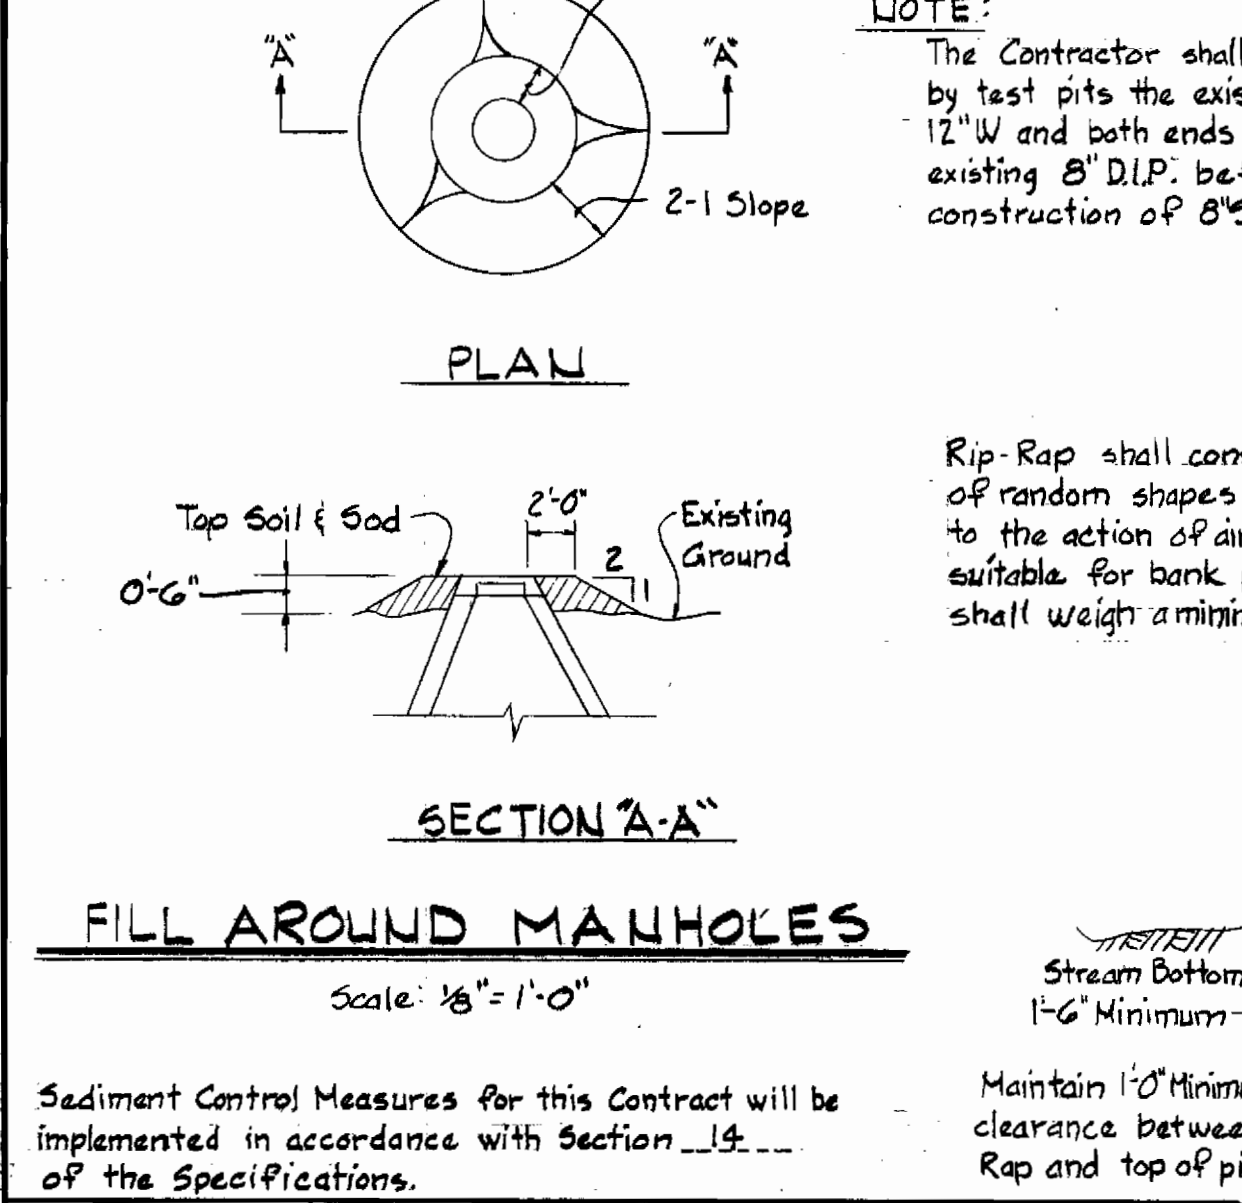

WHITMAN, REQUARDT AND ASSOCIATES  
 ENGINEERS  
 1304 ST. PAUL ST.  
 BALTIMORE, MARYLAND

CONTRACT NO. 20-0922-D

PLAN & PROFILE OF  
 SEWER MAIN

ELECTION DISTRICT  
 ELLICOTT CITY NO. 2

DRAWING NO. 1 OF 1  
 SCALE AS SHOWN