



BENCH MARKS


BM *A ELEV 449.00
 Top of existing fire hydrant opposite
 to sta. 0+00± of Hickory Ridge Road
 BM *B ELEV 445.21
 Top stem of existing fire hydrant
 opposite entrance to Howard County
 Community College.

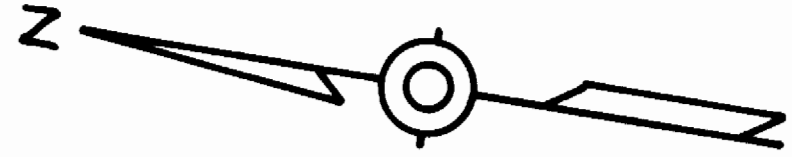

HOWARD COMMUNITY COLLEGE
 523 / 928

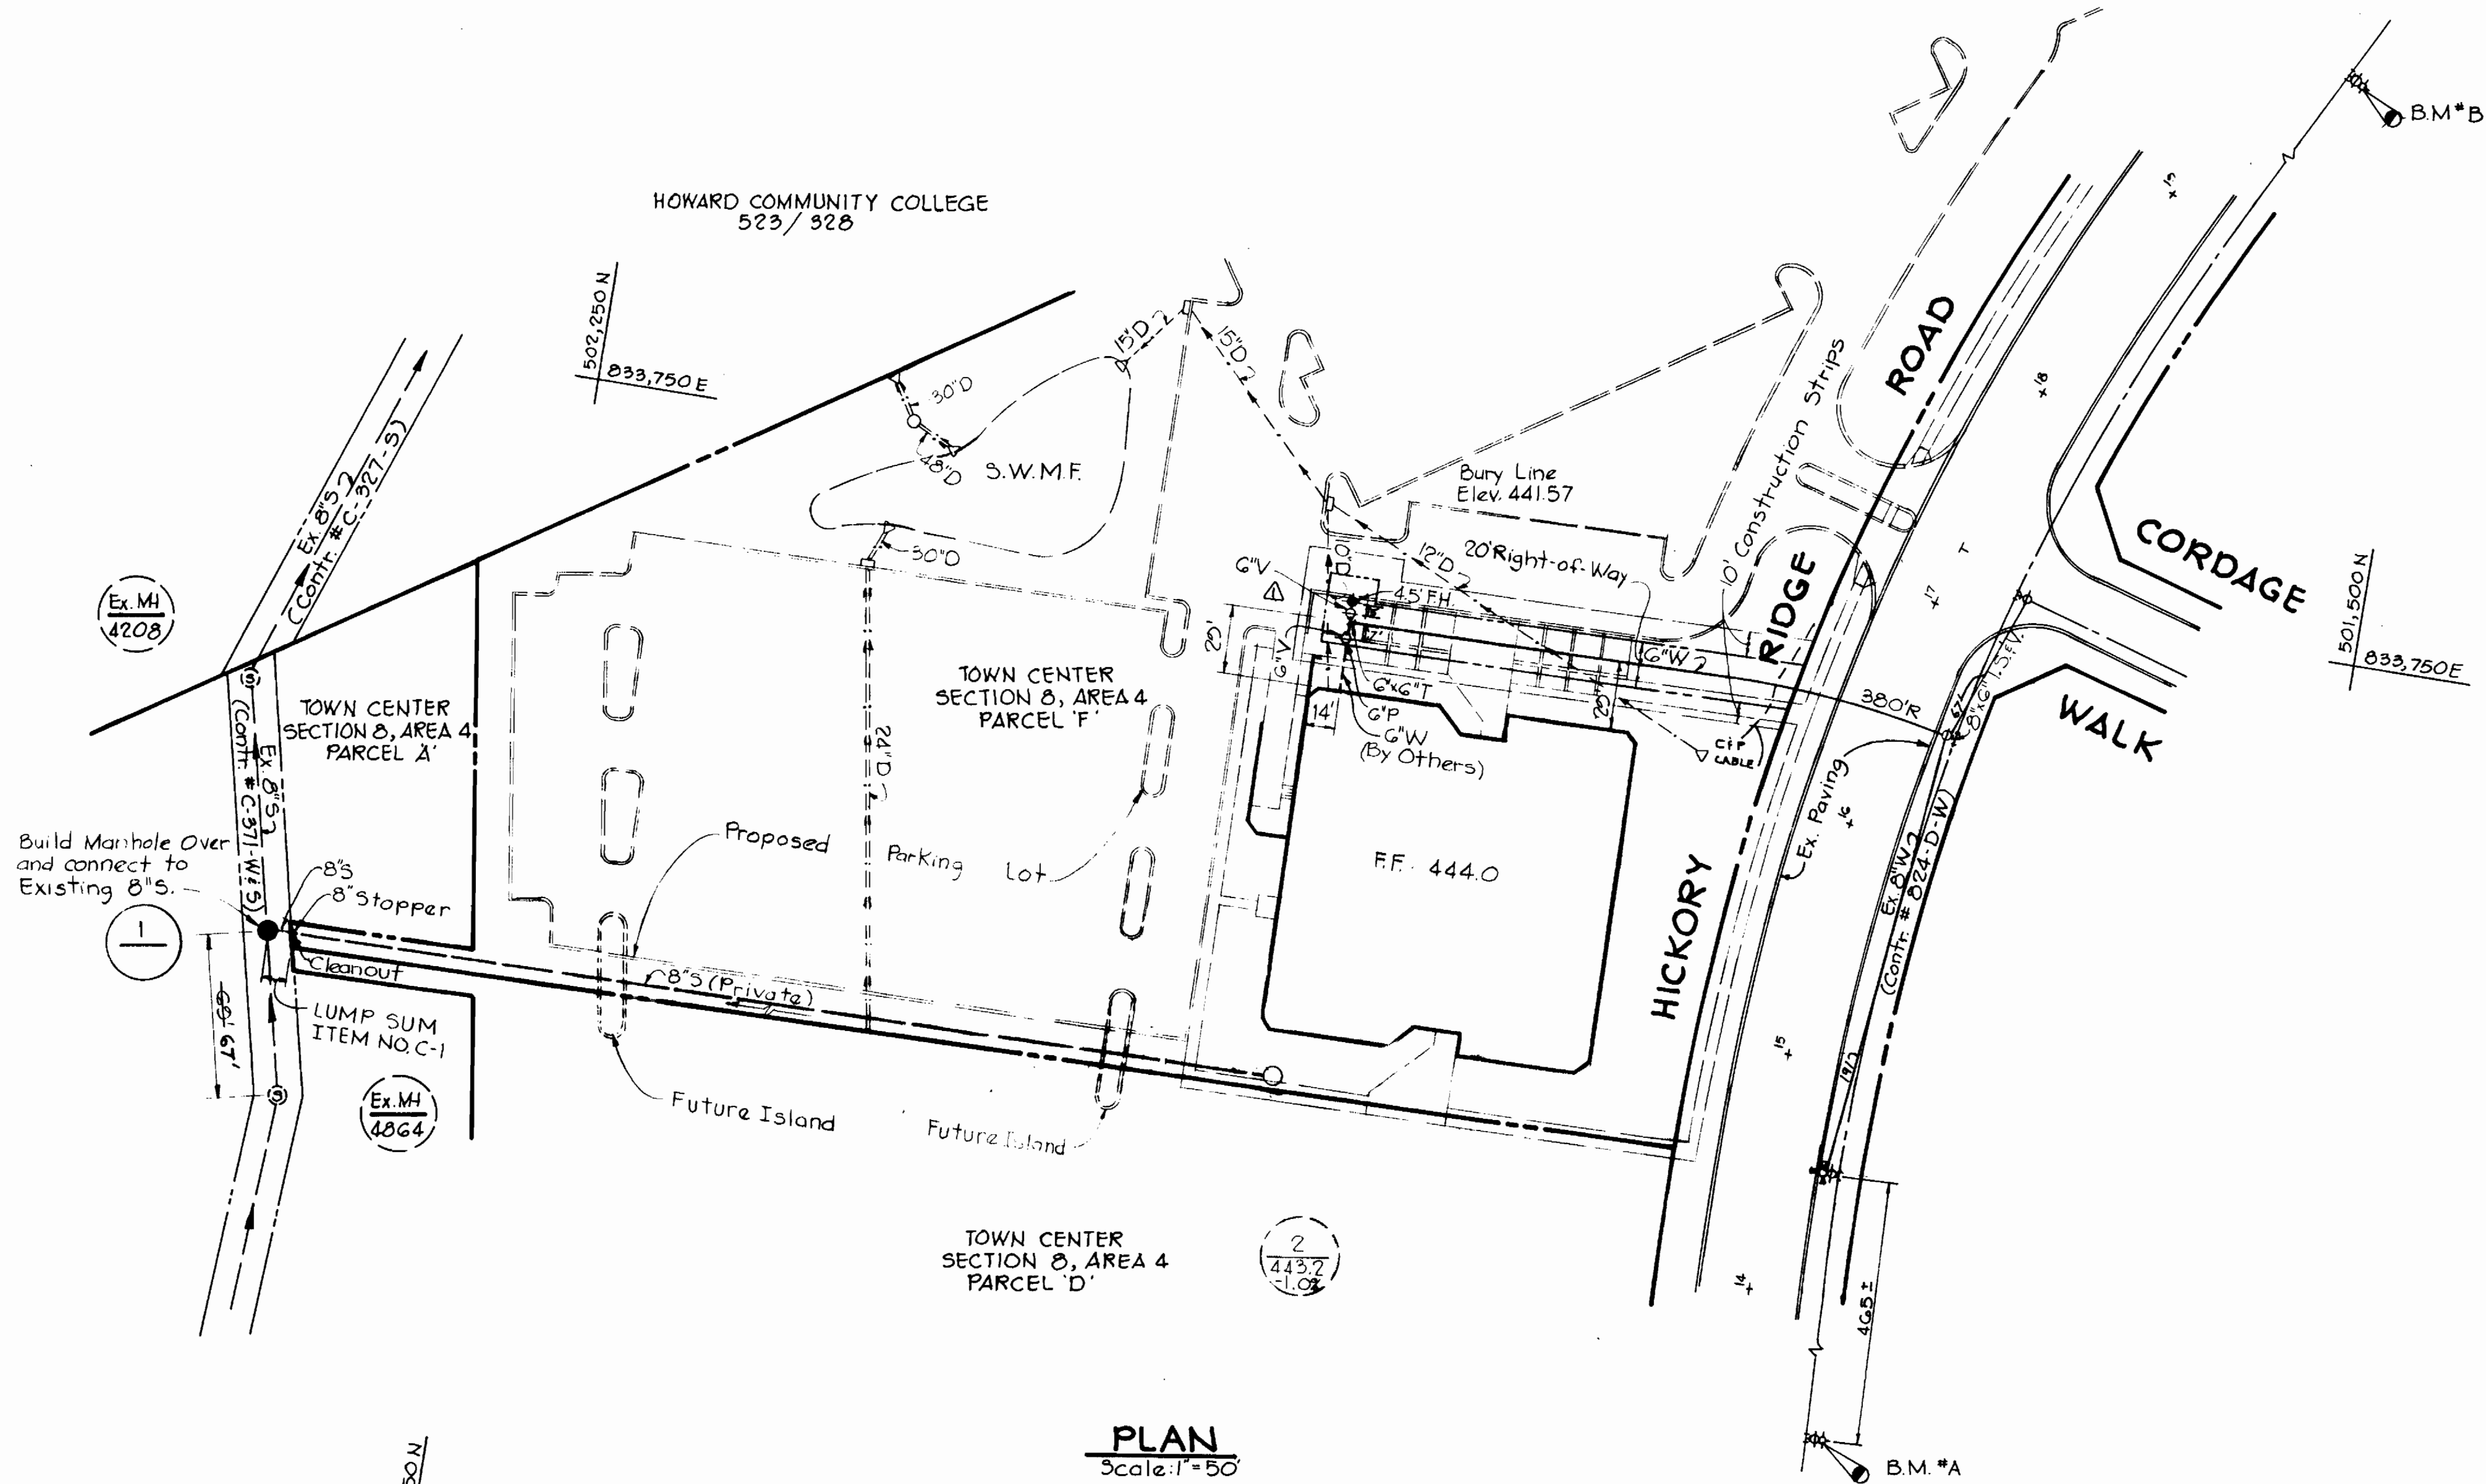

PLAN
 Scale: 1" = 50'

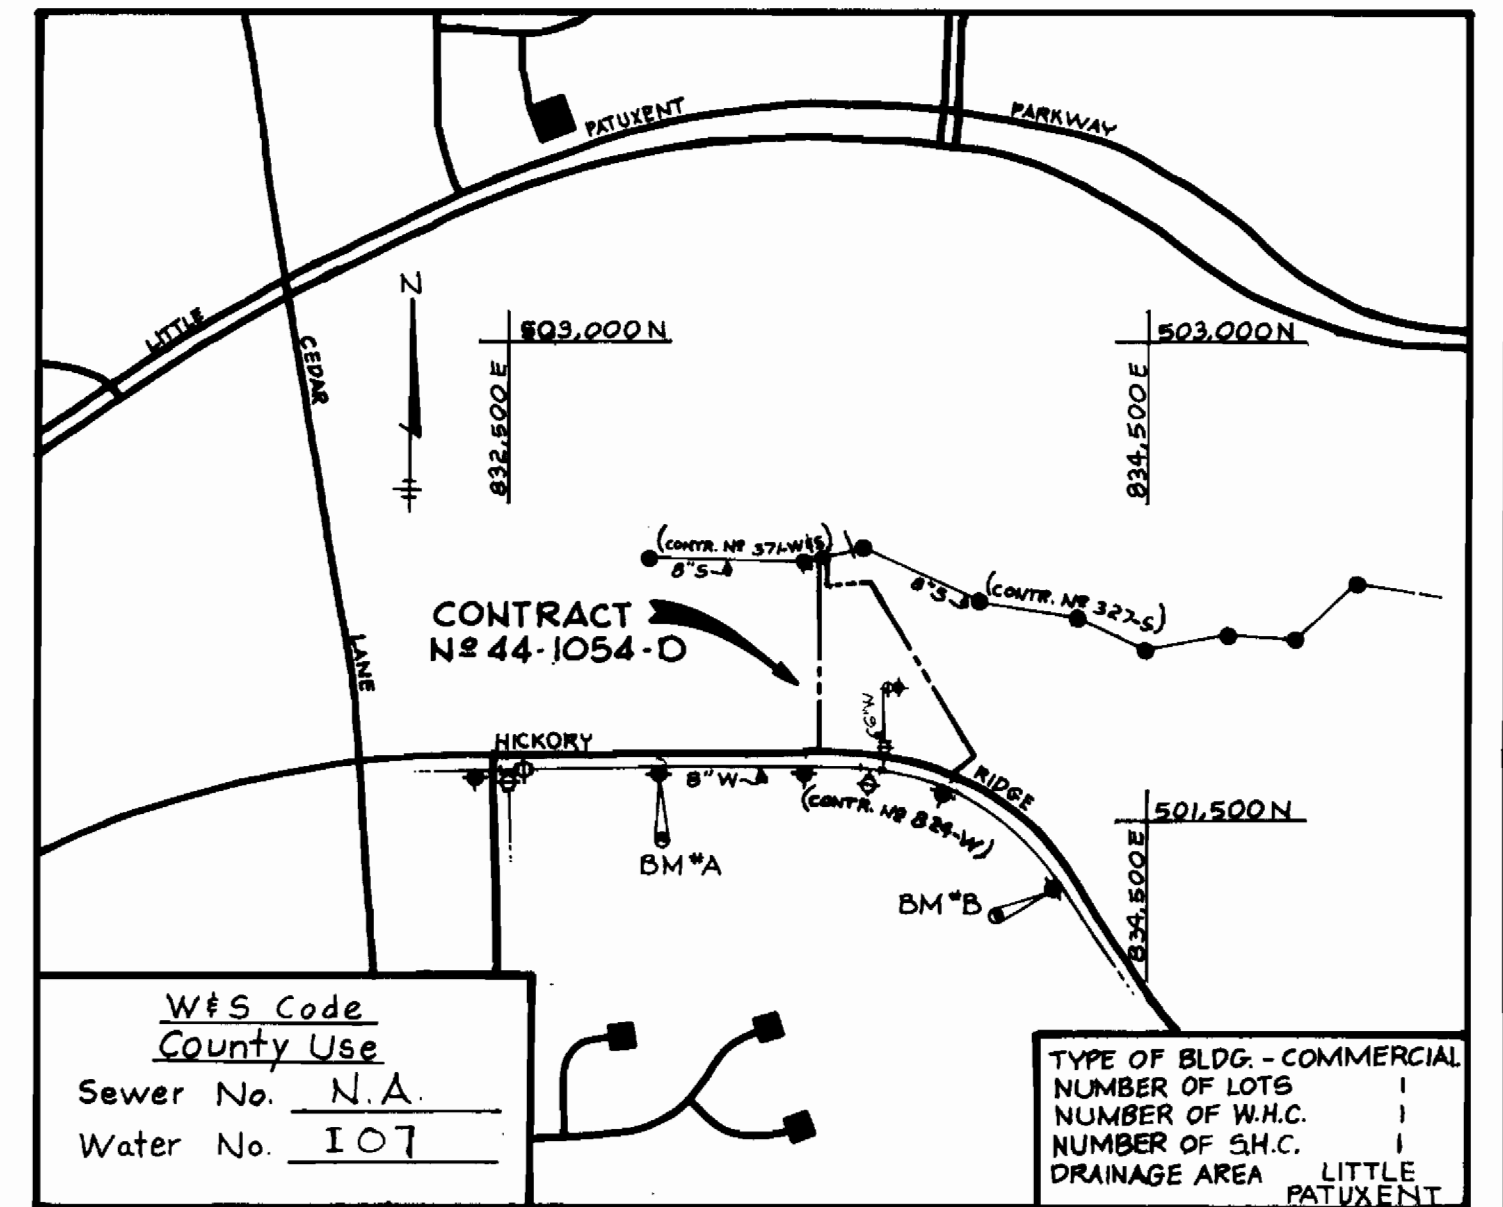

VICINITY MAP
 Scale: 1" = 600'

W&S Code	County Use	TYPE OF BLDG. - COMMERCIAL NUMBER OF LOTS 1 NUMBER OF W.H.C. 1 NUMBER OF S.H.C. 1 DRAINAGE AREA PATIENT
Sewer No.	N.A.	
Water No.	107	

SEDIMENT CONTROL MEASURES FOR THIS CONTRACT WILL BE IMPLEMENTED IN ACCORDANCE WITH ARTICLE 15 OF SPECIFICATIONS AND FINAL DEVELOPMENT PLAN *SDP 82-650

HOWARD SOIL CONSERVATION DISTRICT REVIEWED FOR HOWARD SOIL CONSERVATION DISTRICT AND MEETS TECHNICAL REQUIREMENTS
 U.S. SOIL CONSERVATION SERVICE DATE 4/27/82
 THIS PLAN IS APPROVED FOR SOIL EROSION AND SEDIMENT CONTROL BY THE HOWARD SOIL CONSERVATION DISTRICT
 HOWARD SOIL CONSERVATION DISTRICT DATE 4/27/82

Item	Estimated	As Built	Material/Supplier
6" Water	270 L.F.	271 L.F.	D.L.P. GRIFFIN
6" V's (excl. F.H.V's)	1	1	GRIFFIN
Fire Hydrants	1	1	M.H. FLOW
8" Sewer	10 L.F.	7	P.V.C. - CARLON
Manholes	6 V.F.	6 V.F.	BRICK-BALT. BRICK

Town Center Section 8, Area 4
 Contract No. 44-1054-D

1-6-82
 DATE

 James K. Tracy
 PROFESSIONAL ENGR. NO. 9566

Δ	6-16-82	Changed Water Service to Bldg. from 4" W to 6" W
No.	Date	Revision

RIEMER-TRACY & ASSOCIATES, INC.
 8659 BALTIMORE NATIONAL PIKE
 ELLICOTT CITY, MARYLAND 21043

DEPARTMENT OF PUBLIC WORKS
 HOWARD COUNTY, MARYLAND
 Chief, Land Development Division
 Chief, Bureau of Engineering
 Chief, Bureau of Utilities

CONTRACT NO. 44-1054-D

PLAN OF WATER AND SEWER MAINS

TOWN CENTER SECTION 8 AREA 4 PARCEL F
 5TH ELECTION DISTRICT
 HOWARD COUNTY, MARYLAND

DRAWING NO. 1 OF 2
 SCALE AS SHOWN
 SHEETS 35-501-8345 35-502-8345

