



E. 350,500
N. 423,250

E. 350,500
N. 423,500

E. 350,500
N. 423,000

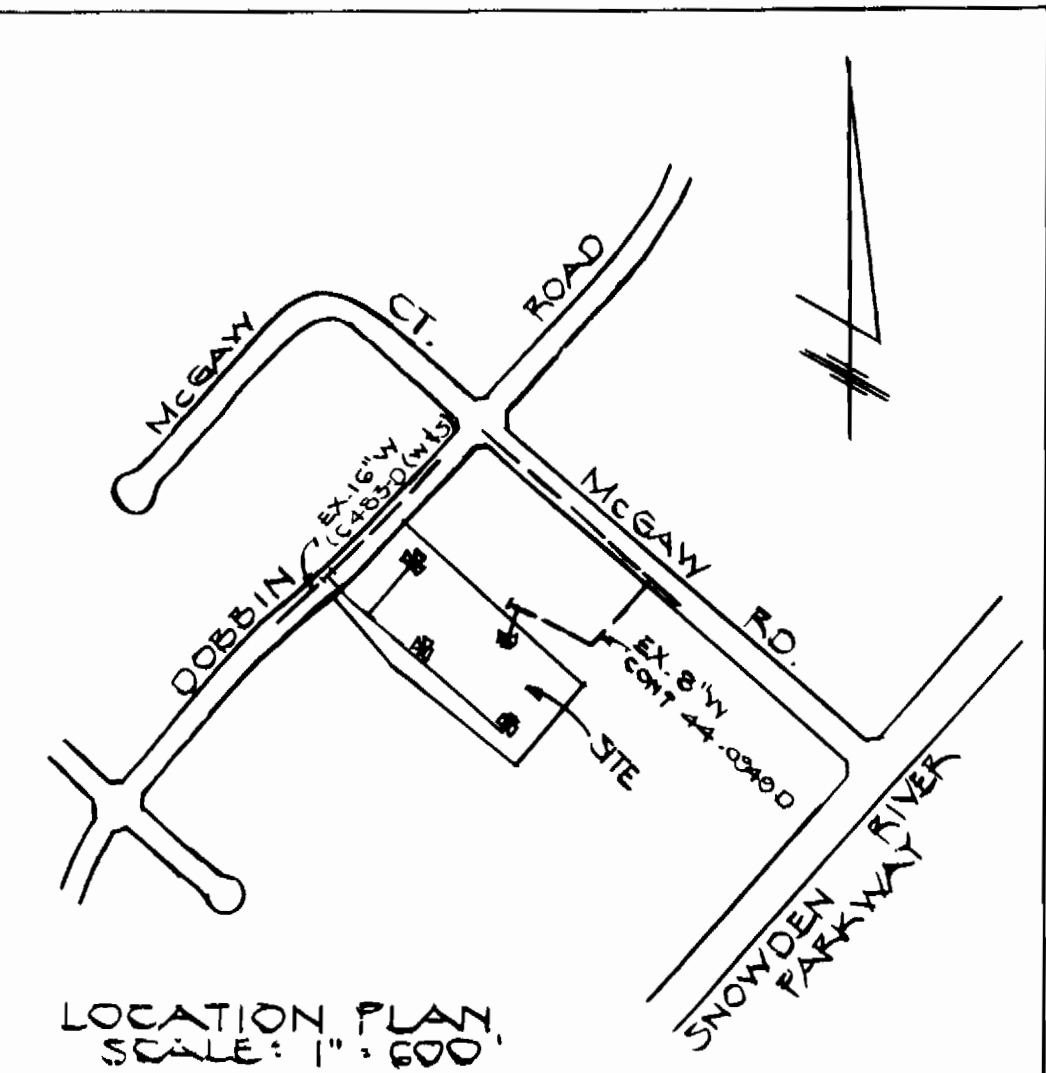

WATER CODE FOR COUNTY USE
WATER NO. E06
TYPE OF BUILDING - WAREHOUSE & OFFICE
NO. OF LOTS - 1
NO. OF WATER HOUSE CONN. - 1

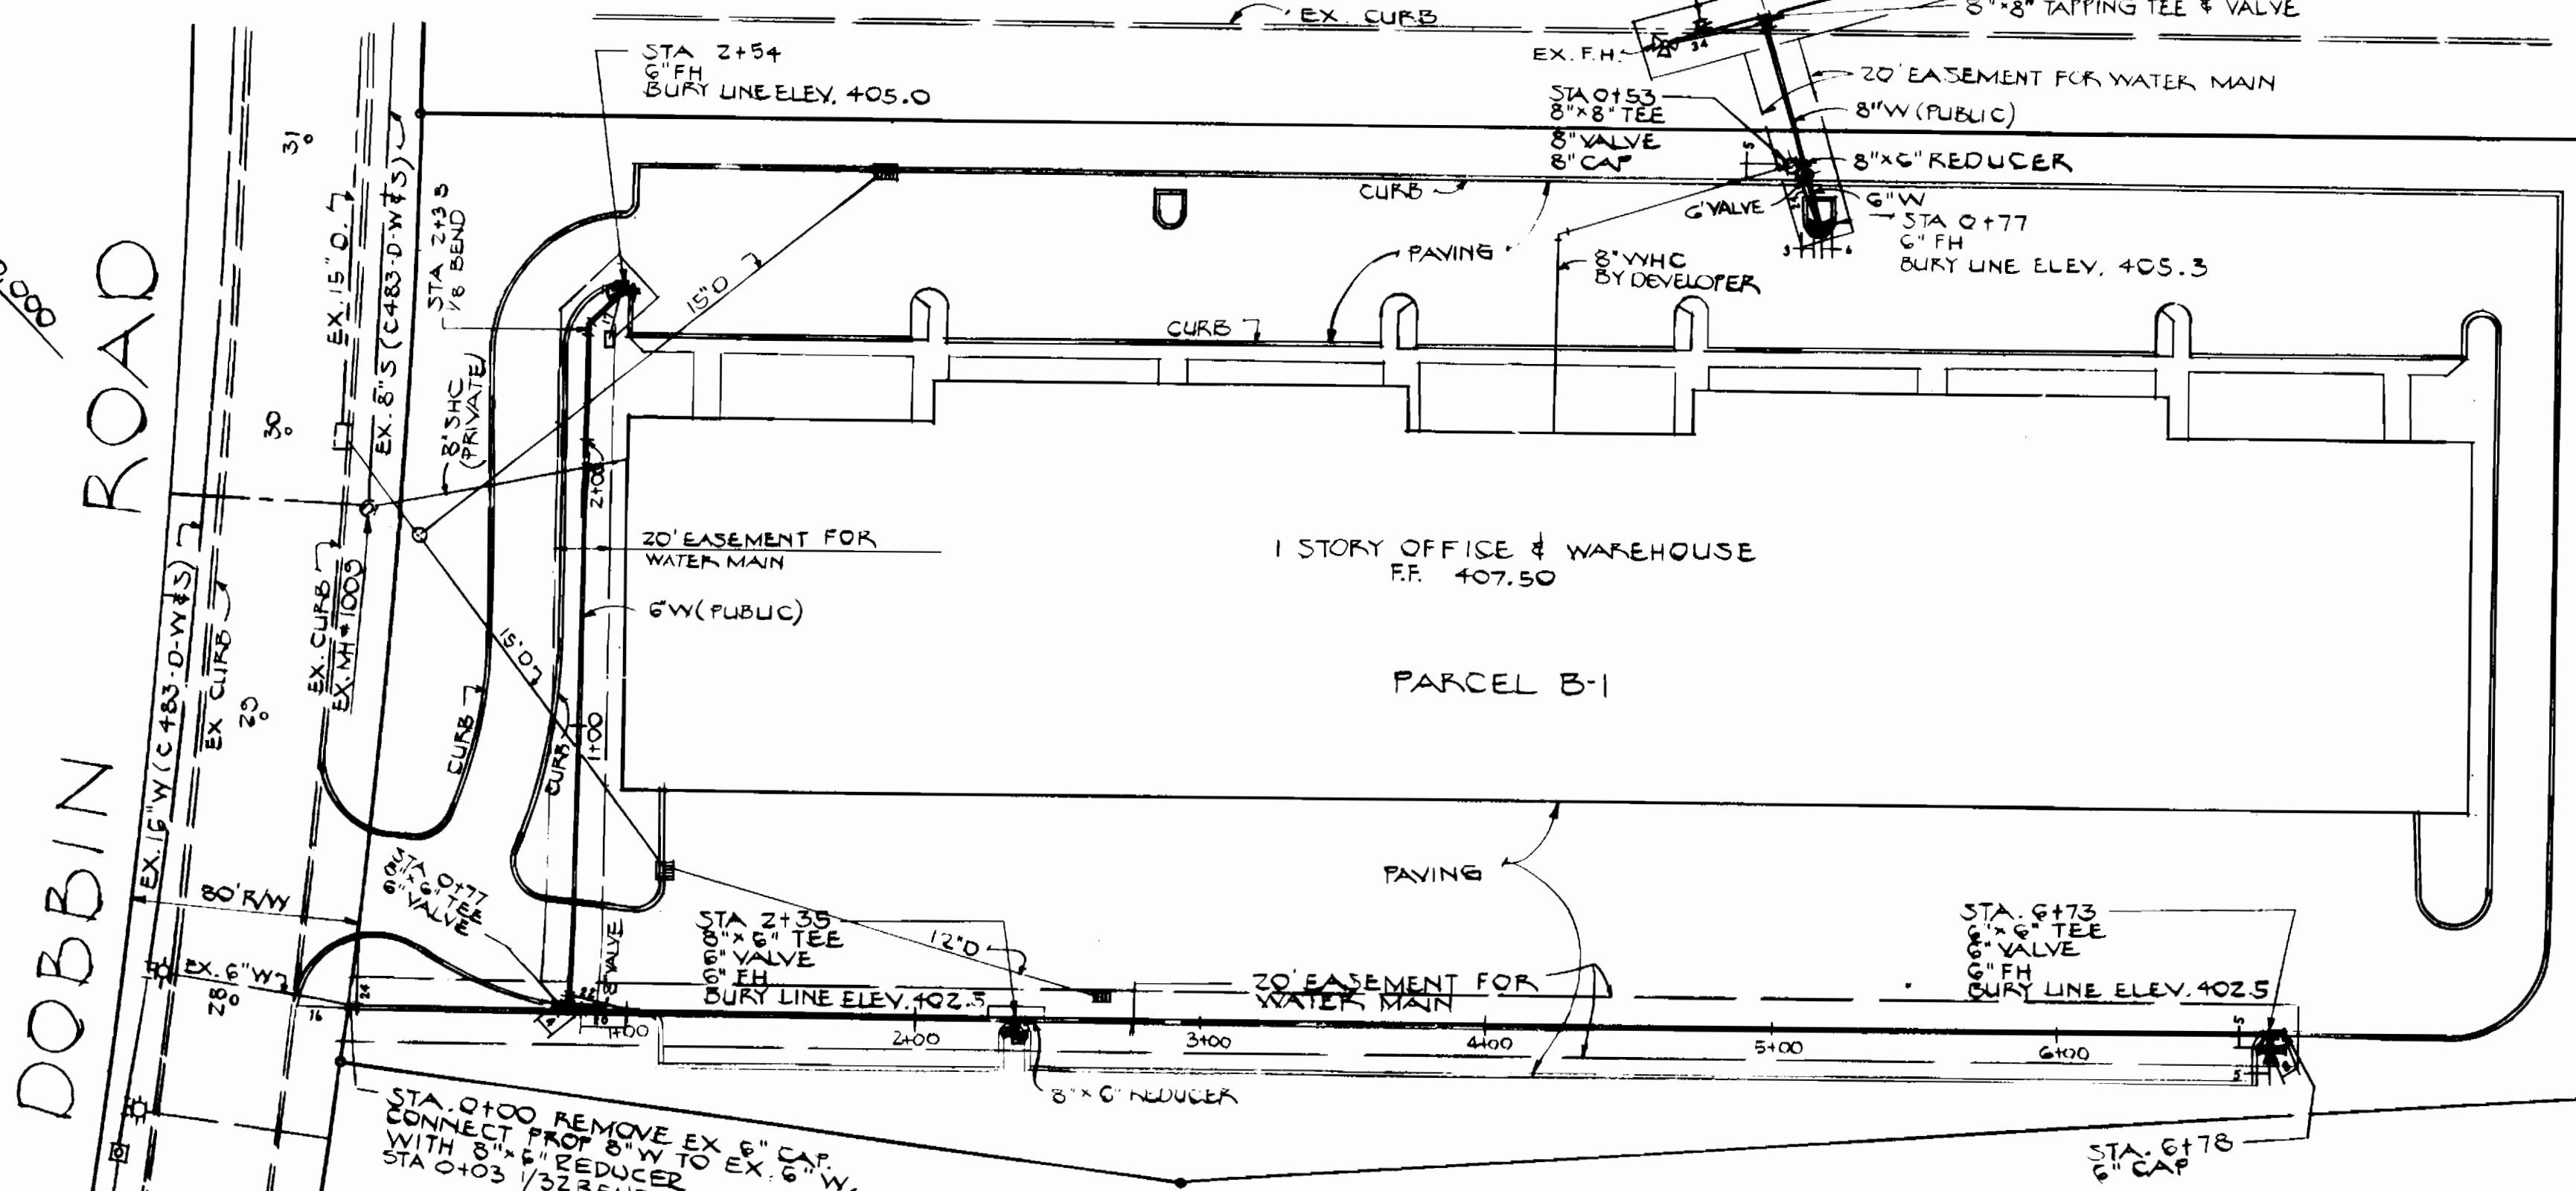

- APPROXIMATE LOCATION OF EXISTING MAINS ARE SHOWN. THE CONTRACTOR SHALL TAKE ALL NECESSARY PRECAUTIONS TO PROTECT EX. MAINS & SERVICES AND MAINTAIN UNINTERRUPTED SUPPLY. ANY DAMAGE INCURRED SHALL BE REPAIRED IMMEDIATELY.
- ALL HORIZONTAL CONTROLS ARE BASED ON MD. STATE COORDINATES.
- ALL VERT. CONTROLS ARE BASED ON U.S.G.S. DATUM.
- ALL PIPE ELEVATIONS SHOWN ARE INVERTS.
- CLEAR ALL UTILITIES BY A MIN. OF 6". CLEAR ALL POLES 2'-0" MIN. OR TUNNEL AS REQ.
- FOR ALL STD. DETAILS SEE SEE STANDARDS BOUND IN SPECIFICATIONS.
- CONTRACTOR SHALL NOTIFY THE FOLLOWING UTILITIES AT LEAST 5 DAYS BEFORE STARTING WORK:
BALTO. G & E CO. 685-0123
HOWARD CO. BUREAU OF UTILITIES 302-2366
A.T. & T. CABLE LOCATION DIVISION 303-3553
C&P TELEPHONE CO. 725-0076
- CONTRACTOR SHALL LOCATE EX. UTILITIES IN ADVANCE OF CONSTRUCTION OPERATIONS IN THE VICINITY OF PROPOSED UTILITIES.
- CONTRACTOR SHALL REMOVE TREES, STUMPS & ROOTS ALONG LINE OF EXCAVATION AS DIRECTED BY THE ENGR. PAYMENT SHALL BE INCLUDED IN THE UNIT PRICE BID FOR EXCAVATION & BACKFILL FOR WATER MAINS.
- PLACE REGULATION "MEN WORKING" SIGNS AS REQUIRED TO COMPLY WITH THE MD. STATE HIGHWAY ADMIN. MANUAL OF TRAFFIC CONTROL FOR HIGHWAY CONSTRUCTION & MAINTENANCE OPERATIONS.
- ALL WATER MAINS TO BE C.I.P. OR D.I.P.
- TOP OF ALL WATER MAINS TO HAVE 3'-6" OF COVER UNLESS OTHERWISE NOTED.
- ALL VALVES SHALL BE STRAPPED TO TEES PER STD. DETAILS.
- BLOCK ALL FITTINGS W/ CONC. SEE STD. DETAILS
- BURY LINE ELEVATIONS ON FIRE HYDRANTS SHALL BE TO THE ELEVATION SHOWN ON THE PLAN. ALL FIRE HYDRANTS SHALL BE STRAPPED & BUTTRESSED IN CONCRETE PER STD. DETAILS. SOIL AROUND THE FIRE HYDRANTS TO BE COMPACTED IN ACCORDANCE WITH SECTION 3701:3105 OF THE STD. SPECS.
- ALL WATER HOUSE CONNECTIONS SHALL BE METER SETTING FOR INSIDE.
- THE CONTRACTOR SHALL NOT OPERATE ANY WATER MAIN VALVES ON THE EXIST. SYSTEM.

DEPARTMENT OF PUBLIC WORKS
HOWARD COUNTY, MD.
DIR., DEPT. OF PUBLIC WORKS
CHIEF BUR. OF ENGINEERING
CHIEF BUR. OF UTILITIES
CHIEF LAND DEVELOPMENT DIV.

THIS PLAN IS APPROVED FOR SOIL EROSION AND SEDIMENT CONTROL BY THE HOWARD COUNTY SOIL CONSERVATION DISTRICT
SEDIMENT CONTROL MEASURES FOR THIS CONTRACT WILL BE IMPLEMENTED IN ACCORDANCE WITH ARTICLE 15 OF THE STANDARDS AND SPECIFICATIONS AND SDP 83-20C
REVIEWED FOR HOWARD SOIL CONSERVATION DISTRICT AND MEETS TECHNICAL REQUIREMENTS
U.S. SOIL CONSERVATION DISTRICT

CONTRACT NO 44-1115-0
PLAN & PROFILE OF WATER MAIN
ELECT. DIST. G

DATE	DESCRIPTION OF REVISIONS	BY
OCT 19, 1983	ALIGNMENT OF MAIN WATER. REVISED QUANTITIES REVISED	EJM
OCT 7, 1983	ADD CONC. ALKOL - ADD 2 CROSSINGS ELIMINATE T.S.V.	EJM

QUANTITIES			
ITEM	ESTIMATED	AS-BUILT	SUPPLIER
6" WATER	288	295	ATLANTIC
6" WATER	531	714	ATLANTIC
FH	4	4	MUELLER
VALVE 8"	2	2	MUELLER
VALVE 6"	4	4	MUELLER
6" TAPPING TEE VALVE	1	1	MUELLER

SIELING INDUSTRIAL CENTER
PARCEL B-1 SECT. 1 AREA 1
DRAWING NO 1 OF 1
SCALE PLAN 1"=50' PROFILE 1"=50' VERT. 1"=5'
JOB # 6251

AS BUILT JULY 19, 1984