




HOWARD COUNTY, MARYLAND DEPARTMENT OF PUBLIC WORKS BUREAU OF ENGINEERING

INDEX OF SHEETS

SHEET NO.	DESCRIPTION
1	Title Sheet
2	Typical Sections
3	Typical Sections
4	Typical Sections
5	Typical Sections
6	Typical Sections and Details
7	Horizontal and Vertical Controls
8	Maintenance of Traffic and Sediment and Erosion Control
9	Maintenance of Traffic and Sediment and Erosion Control
10	Maintenance of Traffic and Sediment and Erosion Control
11	Sediment and Erosion Control Details and Construction Sequence
12	Plan and Profile STA 9+62.44 to 22+50
13	Plan and Profile STA 22+50 to 37+00
14	Plan and Profile STA 37+00 to 52+00
15	Plan and Profile STA 52+00 to 67+00
16	Plan and Profile STA 67+00 to 82+00
17	Plan and Profile STA 82+00 to 95+00
18	Profiles - Intersecting Streets
18A	Curbline Profiles
19	Storm Drain Profiles
20	Fire Hydrant Relocation Plan
21	Fire Hydrant Relocation Plan
22	Water Main Relocation Plan and Profile
23	Box Culvert Plan and Elevation
24	Box Culvert Headwall Details
25	Box Culvert Boring Logs and Typical Details
<u>CAPITAL PROJECT S-6050</u>	
<u>SANITARY SEWER</u>	
S-1	Plan and Profiles of Sewer Main
S-2	Plan and Profiles of Sewer Main
S-3	Plan and Profiles of Sewer Main

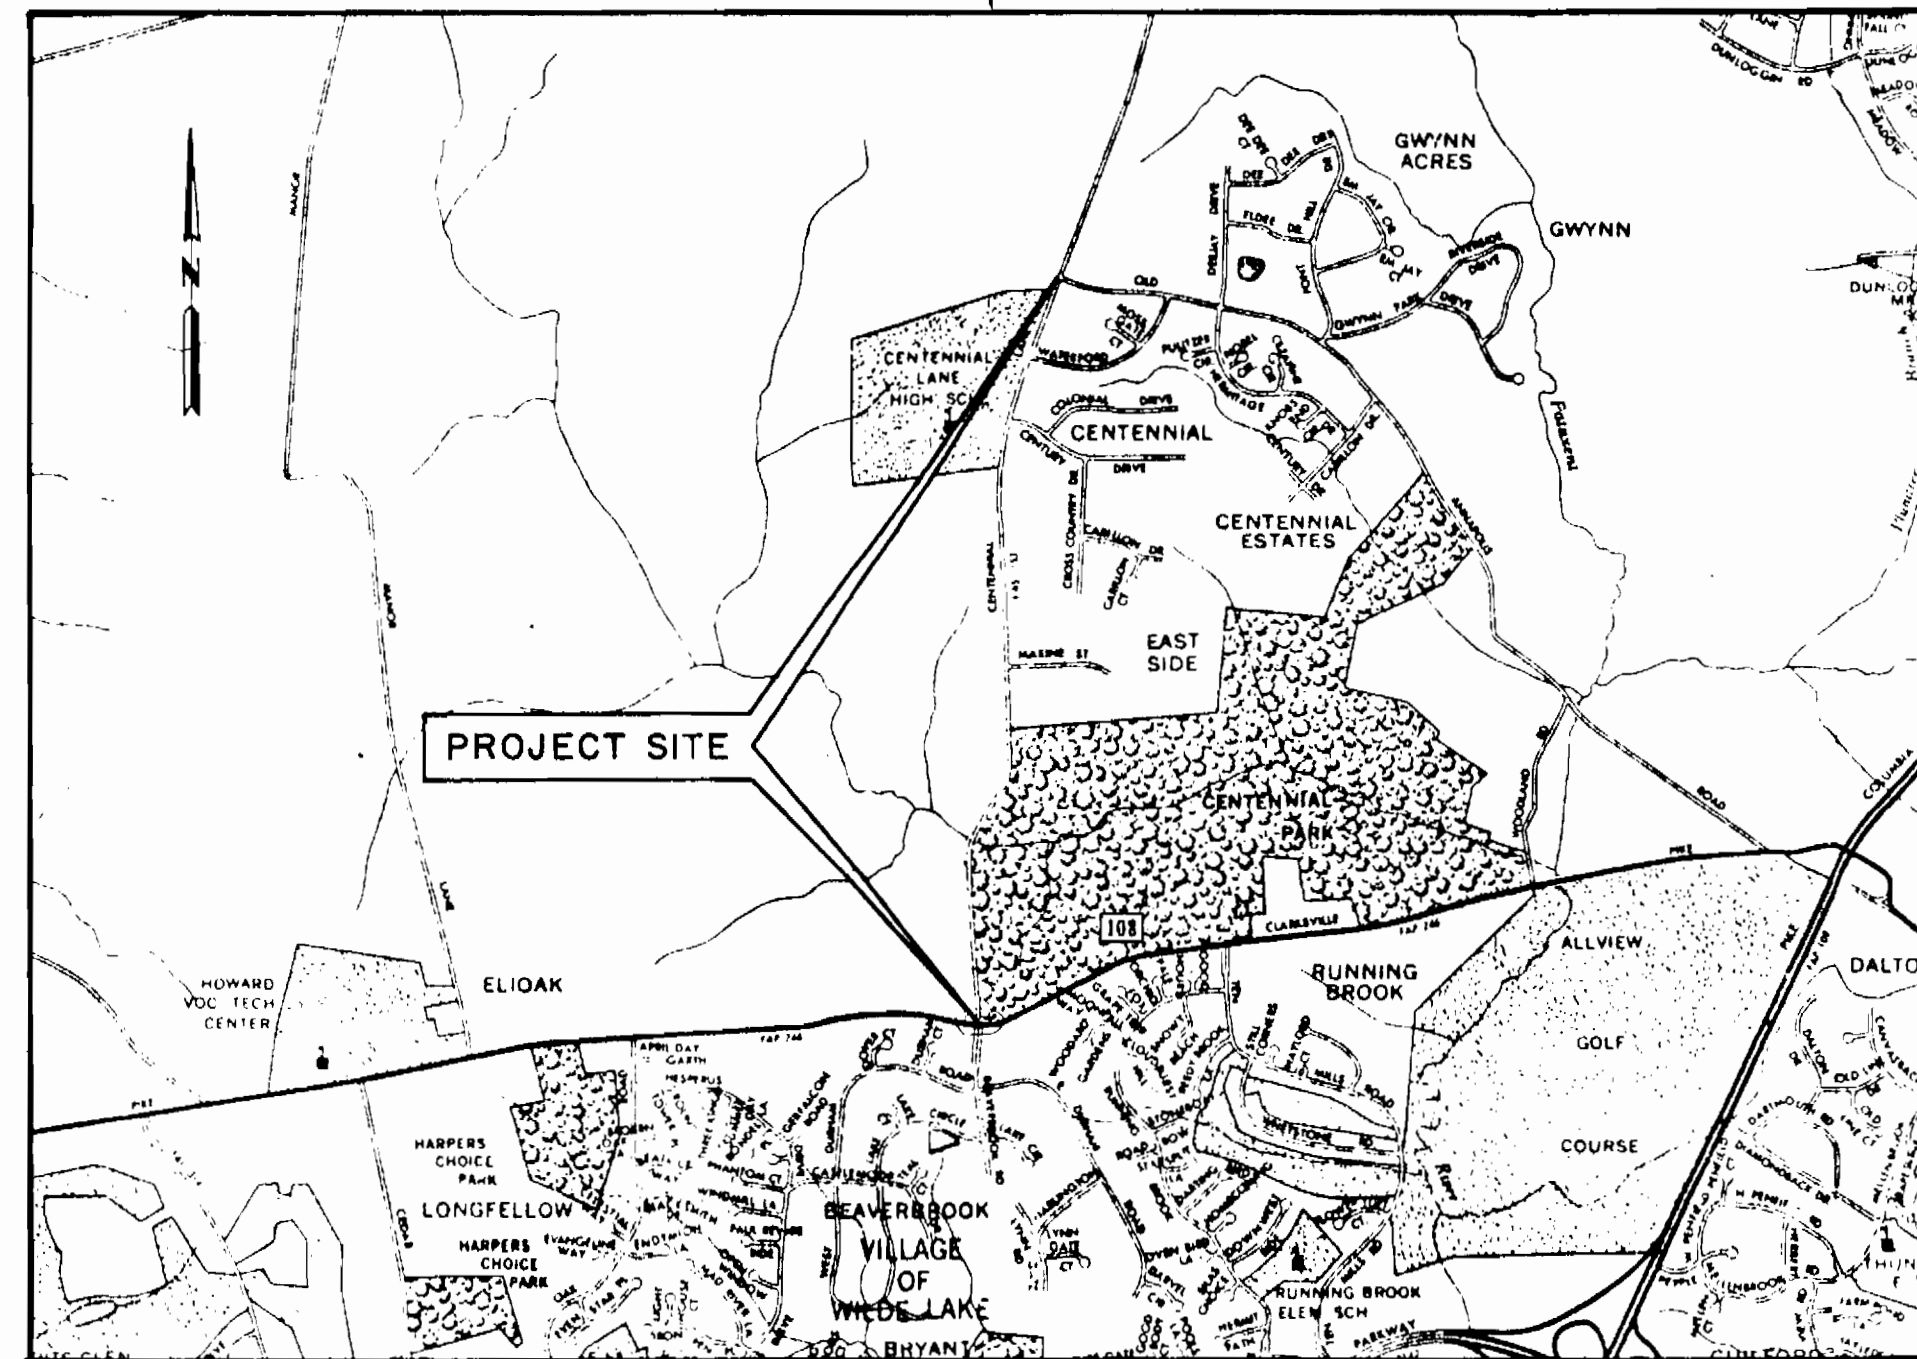

LOCATION MAP
SCALE: 1"=2000'

LEGEND
 FULL DEPTH BIT. CONC. PAVEMENT
 SHOULDER

CERTIFICATION BY THE DEVELOPER

"I/WE CERTIFY THAT ALL DEVELOPMENT AND/OR CONSTRUCTION WILL BE DONE ACCORDING TO THIS PLAN, AND THAT THE RESPONSIBLE PERSONAL INVOLVED IN THIS CONSTRUCTION PROJECT WILL HAVE A CERTIFICATE OF ATTENDANCE AT THE DEPARTMENT OF NATURAL RESOURCES APPROVED TRAINING PROGRAM FOR THE CONTROL OF SEDIMENT AND EROSION BEFORE BEGINNING THE PROJECT.

SIGNATURE OF DEVELOPER

DATE

CERTIFICATION BY THE ENGINEER

"I CERTIFY THAT THIS PLAN FOR EROSION AND SEDIMENT CONTROL REPRESENTS A PRACTICAL AND WORKABLE PLAN BASED ON MY PERSONAL KNOWLEDGE OF THE SITE CONDITIONS AND THAT IT WAS PREPARED IN ACCORDANCE WITH THE REQUIREMENTS OF THE HOWARD SOIL CONSERVATION DISTRICT"

SIGNATURE OF ENGINEER

DATE

REVIEWED FOR HOWARD S.C.D.
NAME
AND MEETS TECHNICAL REQUIREMENTS

SIGNATURE

DATE: 4/1/86

U.S. SOIL CONSERVATION SERVICE

THIS DEVELOPMENT PLAN IS APPROVED FOR SOIL EROSION AND SEDIMENT CONTROL BY THE HOWARD SOIL CONSERVATION DISTRICT.

APPROVED: Stephen J. Flinn

DATE: 4/1/86

HOWARD S.C.D.


CENTENNIAL LANE MARYLAND ROUTE 108 TO OLD ANNAPOLIS ROAD

CAPITAL PROJECT J-4015 AND S-6050
PROJECT LENGTH = 1.56 MILES
ROADWAY CLASSIFICATION: MINOR ARTERIAL
DESIGN SPEED = 40 M.P.H.

44-1471

2015 4/1/86


44-1471

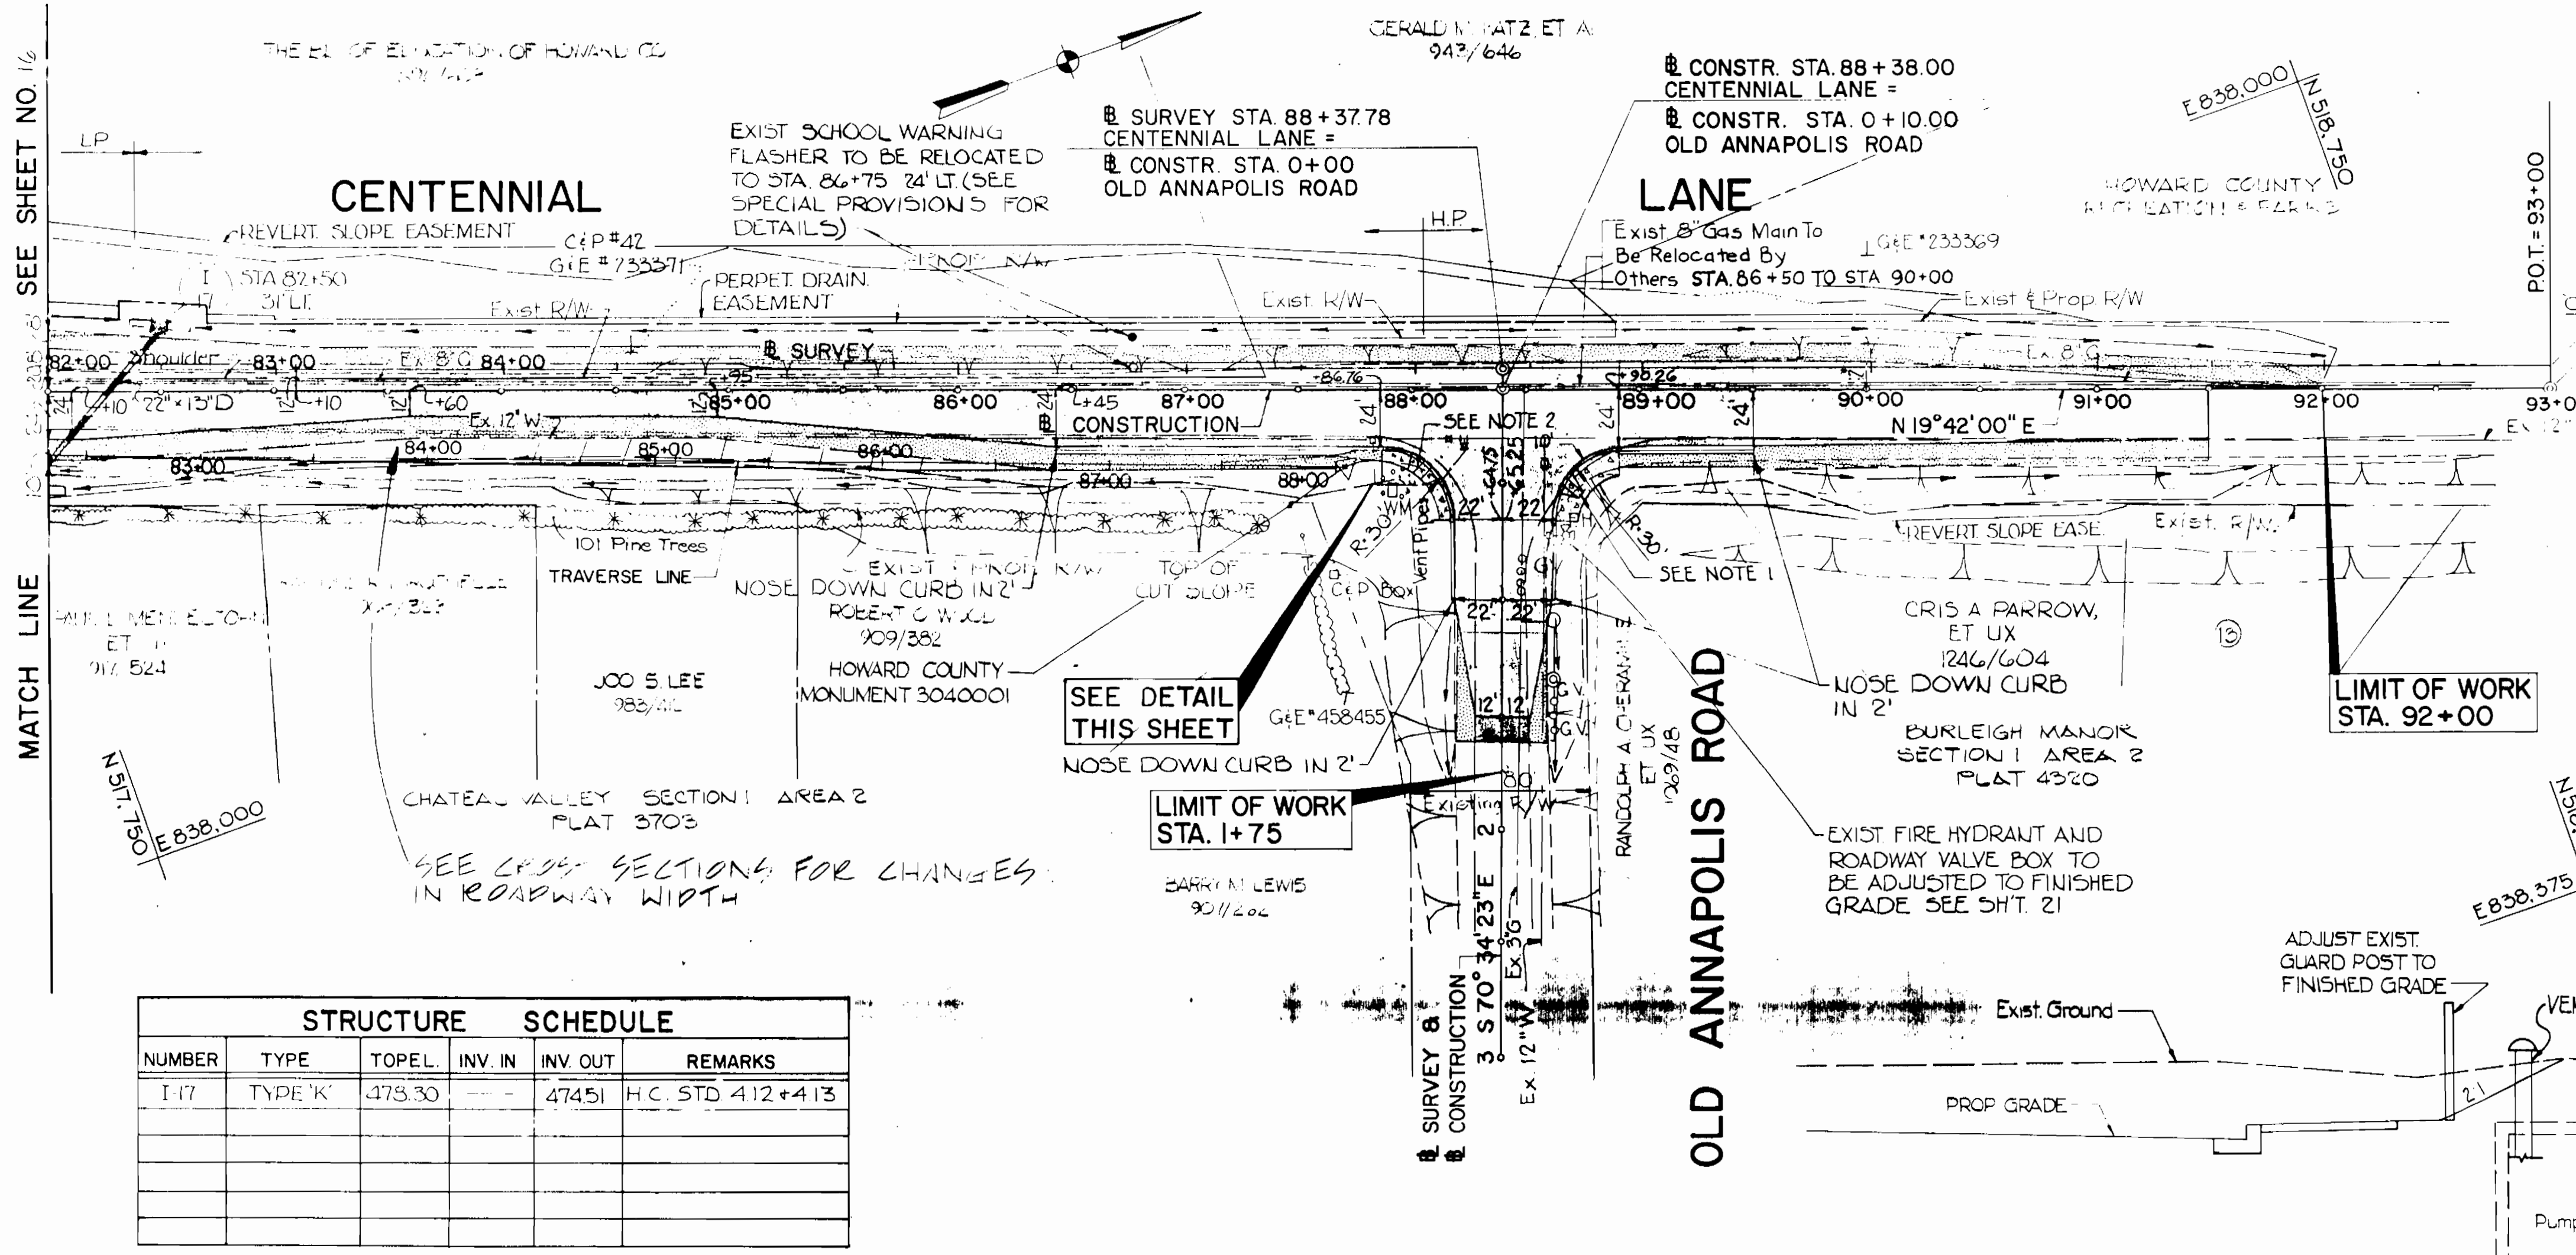

NOTES:
 1 TYPE A SIDEWALK RAMP SEE HOWARD CO STD R-4.01
 2 TYPE D SIDEWALK RAMP. SEE HOWARD CO STD R-4.04


DITCH CONSTRUCTION SCHEDULE				
LOCATION	LENGTH	TYPE	LINING	DEPTH OF LINING
STA 82+00 TO 82+38 LT	38LF	SURFACE DRAIN DITCH	SOD	1'25"
STA 82+42 TO 92+00 LT	938LF	SURFACE DRAIN DITCH	SOD	1'25"
STA 82+02 TO 87+45 RT	443LF	SURFACE DRAIN DITCH	SOD	1'25"
STA 87+50 TO 91+70 RT	220LF	SURFACE DRAIN DITCH	SOD	1'25"
OLD ANNAPOLIS ROAD				
STA 1+12 TO 1+75 LT (RT)	124LF	SURFACE DRAIN DITCH	SOD	1'25"

STRUCTURE SCHEDULE					
NUMBER	TYPE	TOPEL	INV. IN	INV. OUT	REMARKS
I-17	TYPE 'K'	473.30		474.51	H.C. STD 412+413

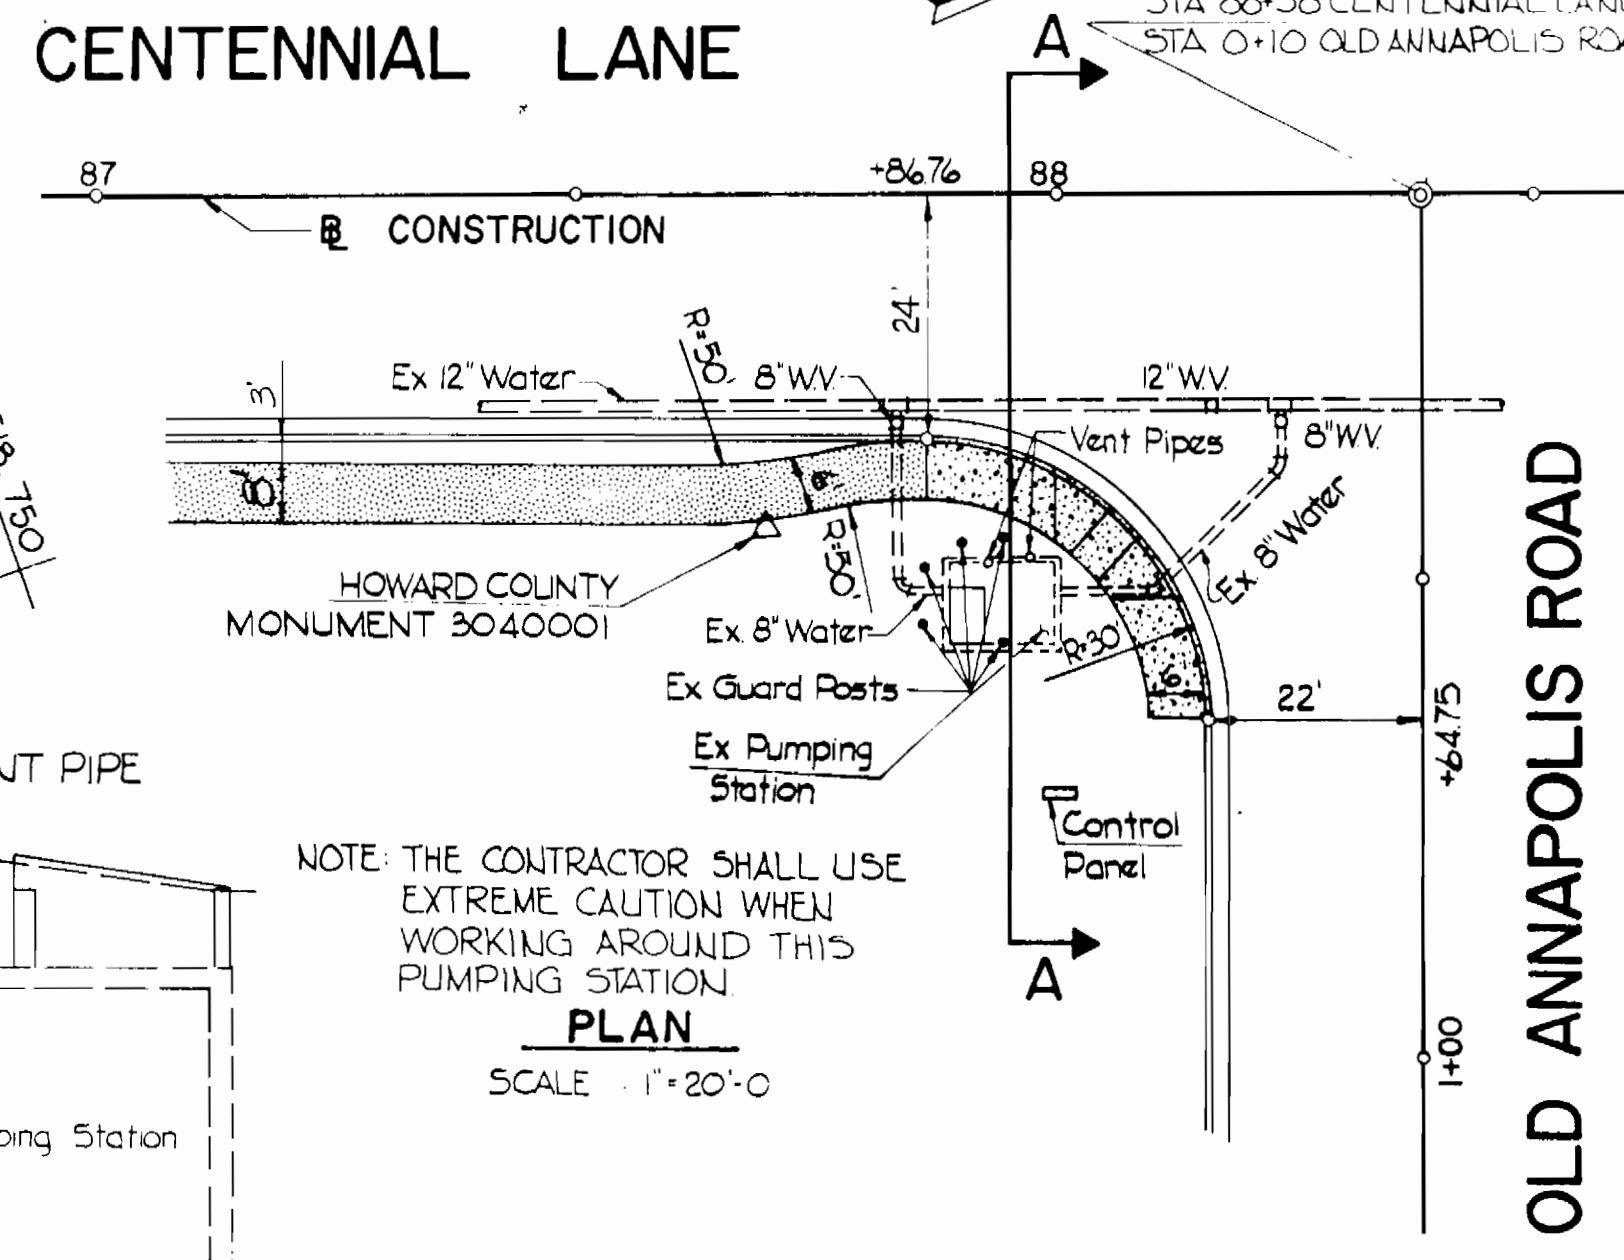

SECTION A-A
SCALE 1"=5'-0"

EXISTING WATER PUMPING STATION
AT CENTENNIAL LANE AND OLD ANNAPOLIS ROAD

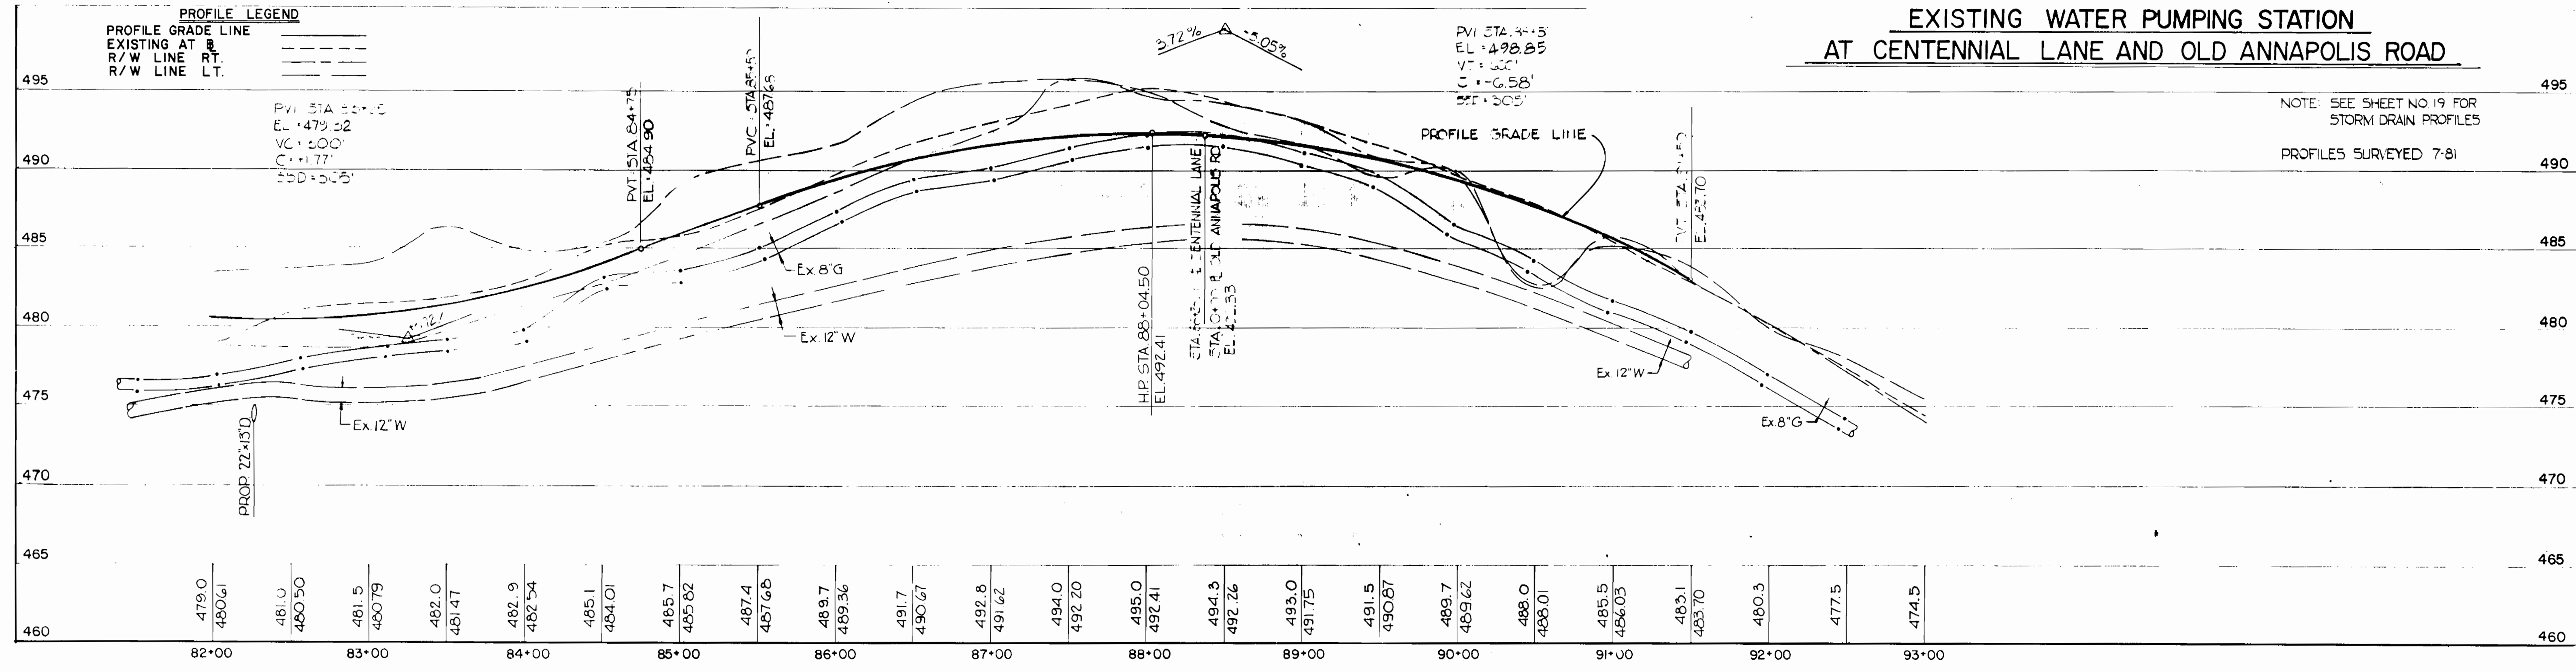

NOTE: SEE SHEET NO. 19 FOR STORM DRAIN PROFILES
 PROFILES SURVEYED 7-81

DEPARTMENT OF PUBLIC WORKS
 HOWARD COUNTY, MARYLAND
 DIRECTOR OF PUBLIC WORKS DATE: 3/25/06
 CHIEF, BUREAU OF ENGINEERING DATE:

Johnson, Mirmiran & Thompson, P. A.
 ENGINEERS • PLANNERS • SURVEYORS • LANDSCAPE ARCHITECTS
 1526 YORK ROAD • BALTIMORE, MARYLAND • 21063 • (301) 821-6500




PLAN & PROFILE
 STA. 82+00 TO STA. 95+
 CENTENNIAL LANE


MARYLAND ROUTE 108 TO OLD ANNAPOLIS ROAD
 CAPITAL PROJECT J-4015
 ELECTION DISTRICT NO. 2
 HOWARD COUNTY, MARYLAND

CONTRACT NO. 44-1471


DRAWING NO. 17	SCALE: HORIZ. 1"=50' VERT. 1"=5'	DES. B.D.B.
OF 15		DRW. S.L.
		CHK. D.T.C.

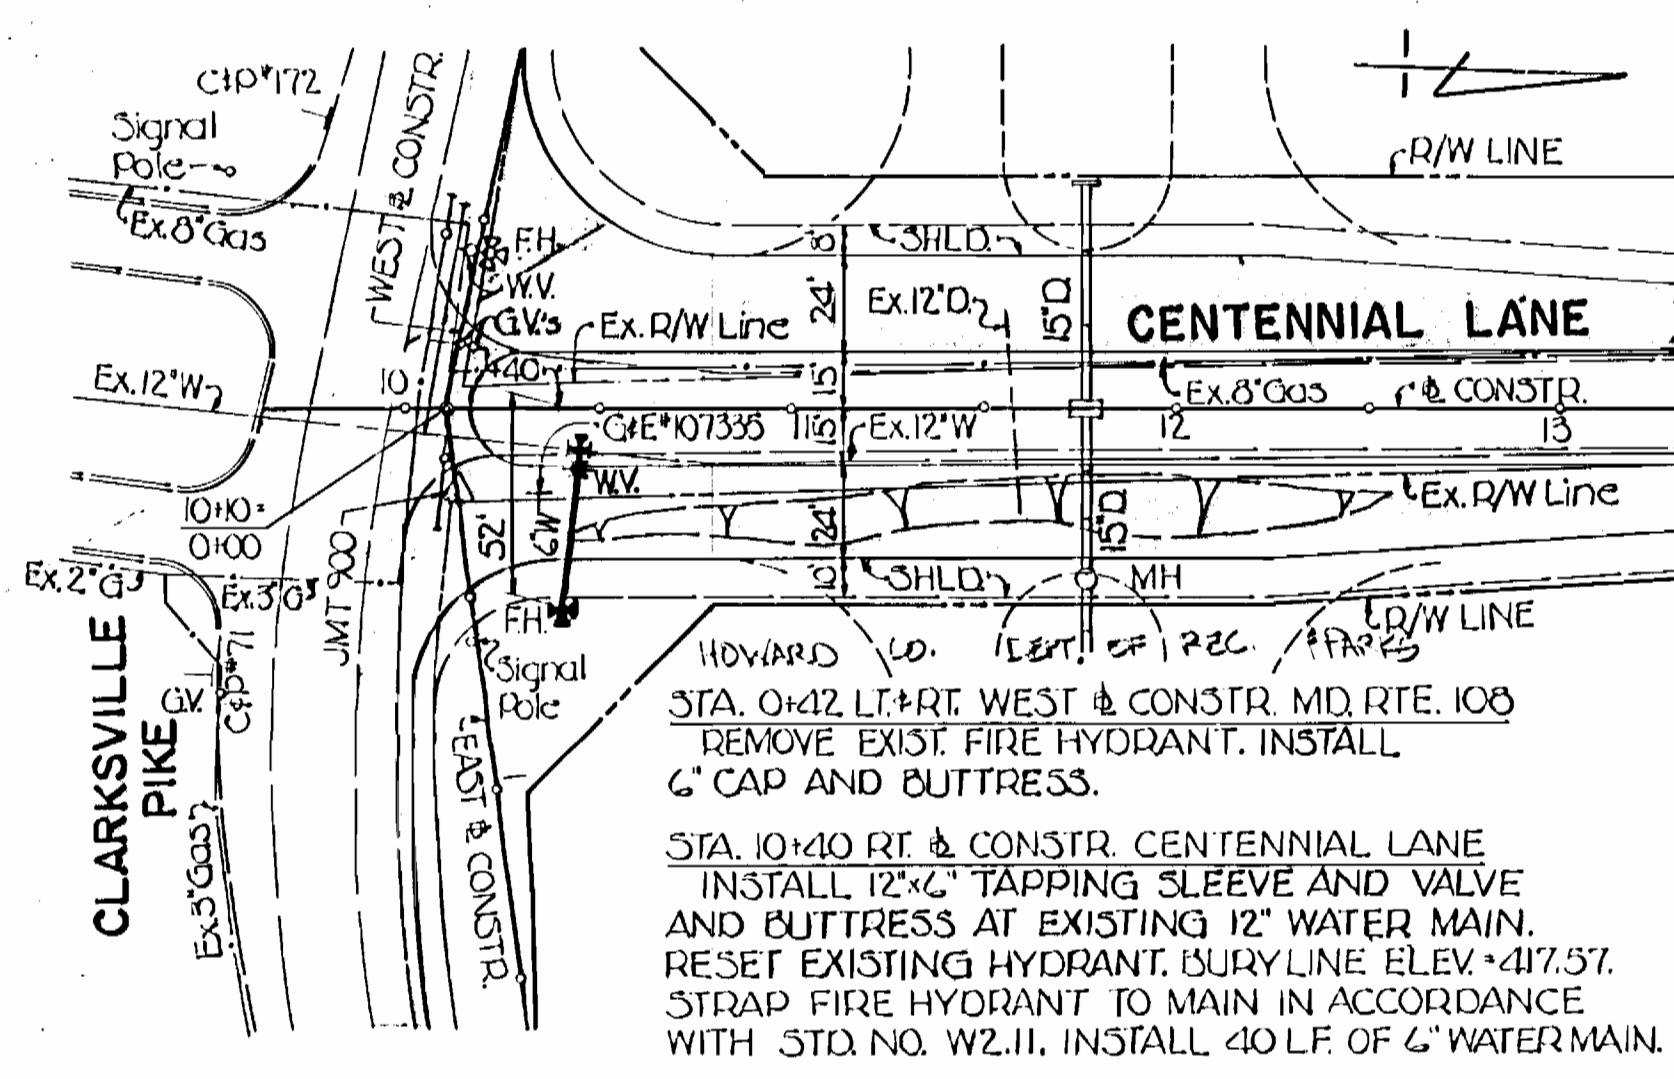


① STA. 10+40 & CONSTR. CENTENNIAL LANE

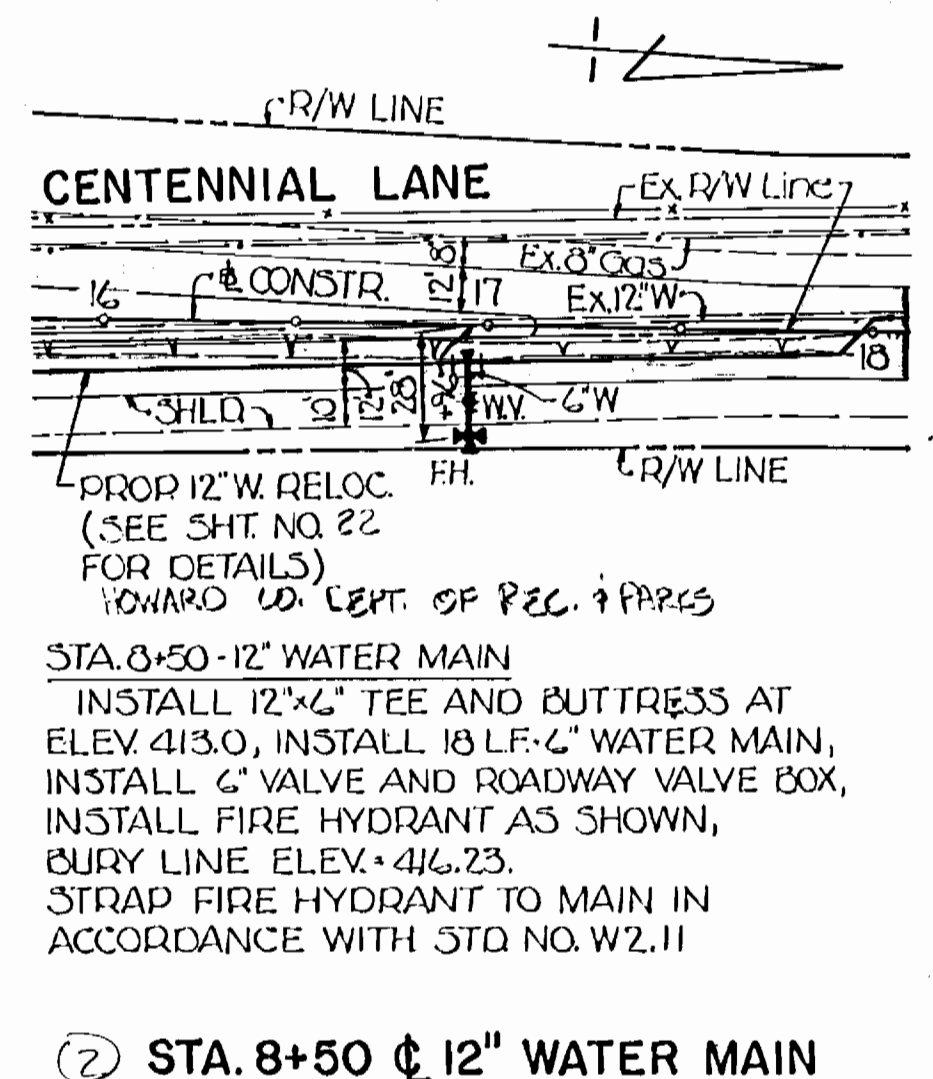


② STA. 8+50 & 12" WATER MAIN

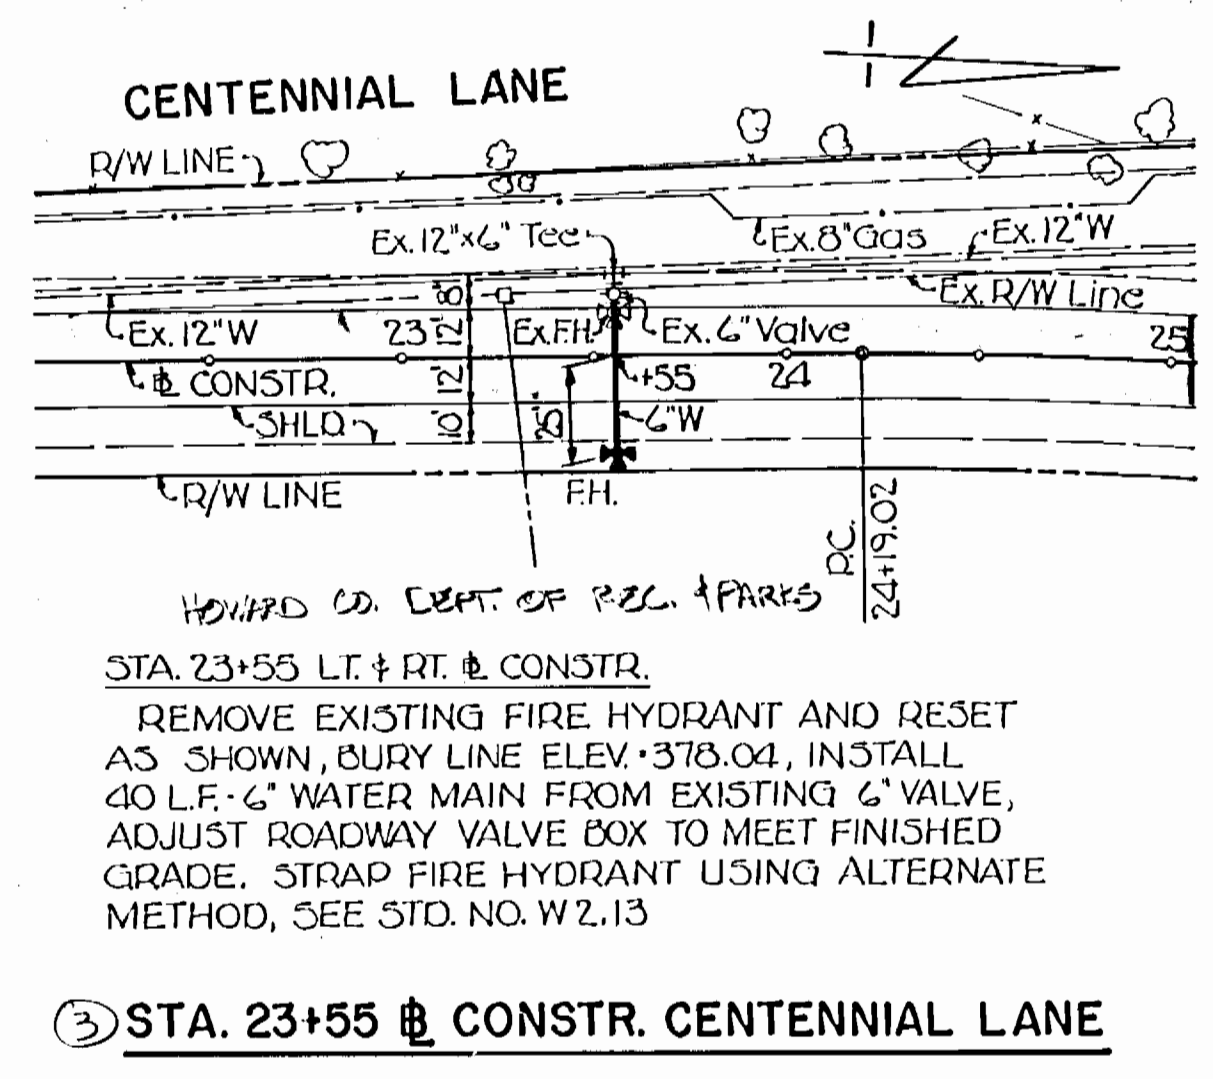


③ STA. 23+55 & CONSTR. CENTENNIAL LANE

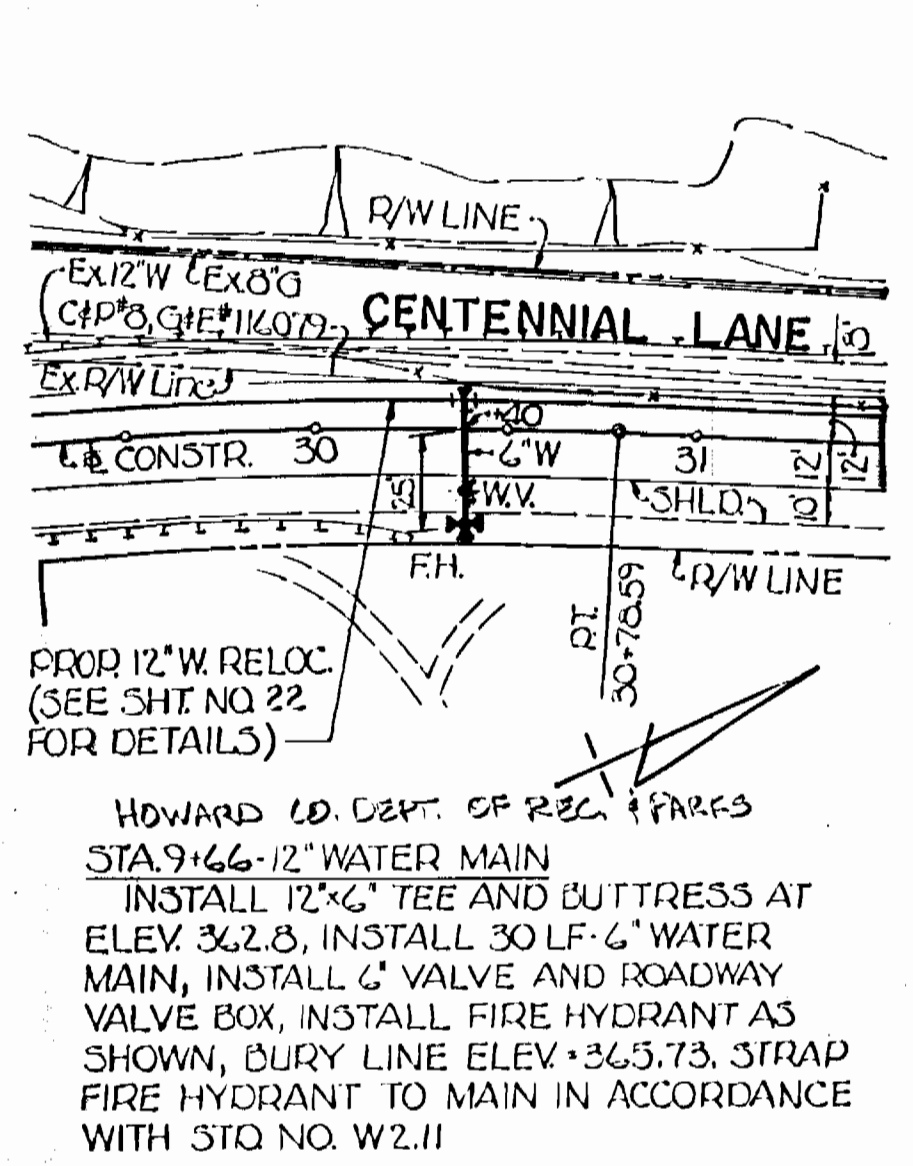


④ STA. 9+66 & 12" WATER MAIN

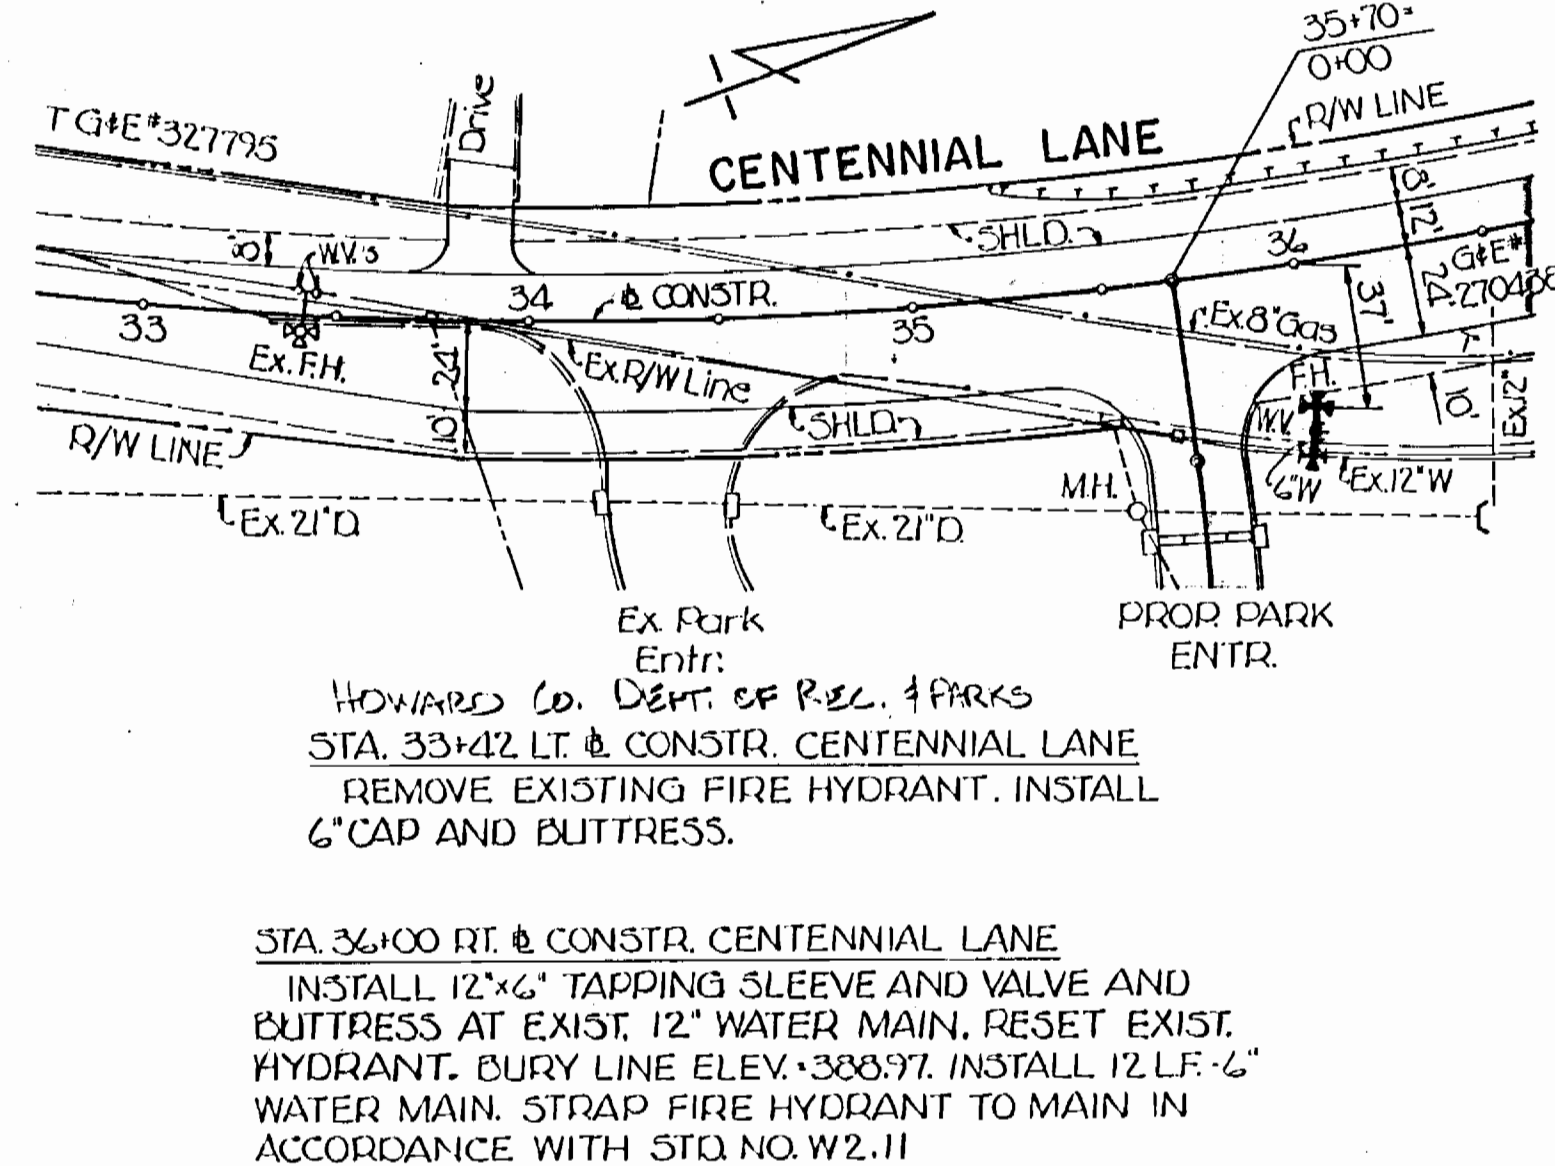


⑤ STA. 36+00 & CONSTR. CENTENNIAL LANE

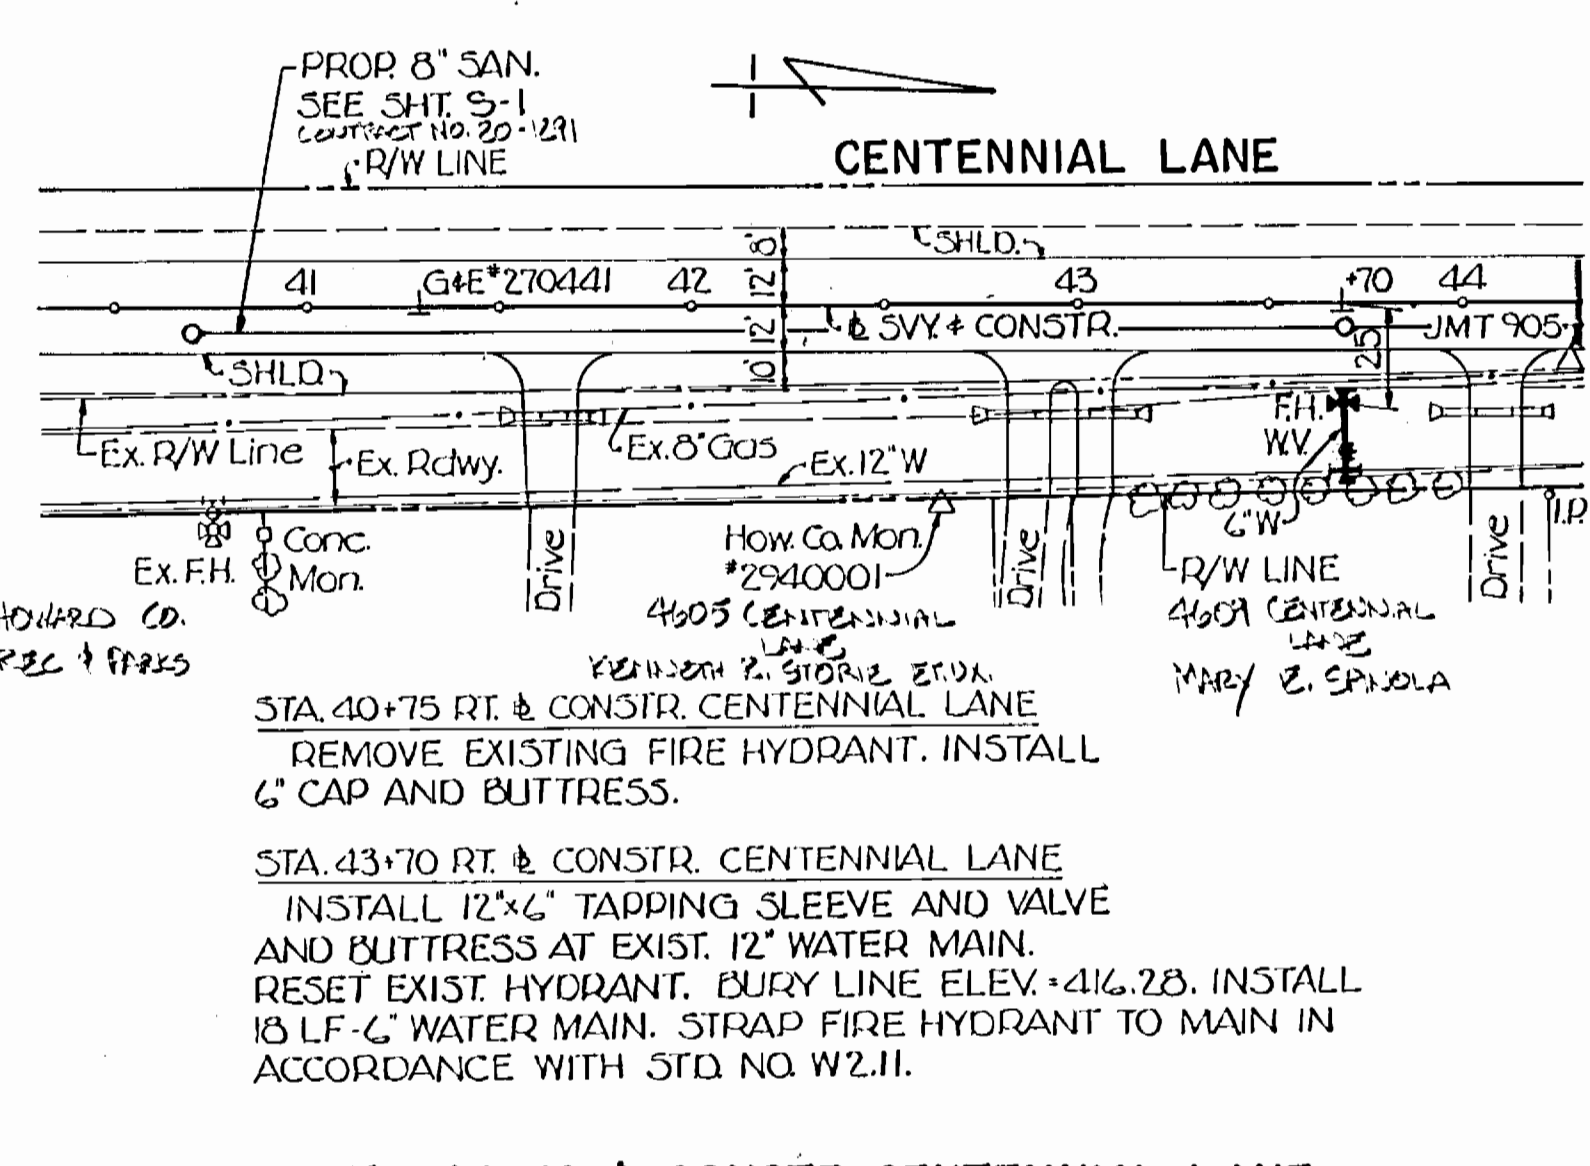


⑥ STA. 43+70 & CONSTR. CENTENNIAL LANE

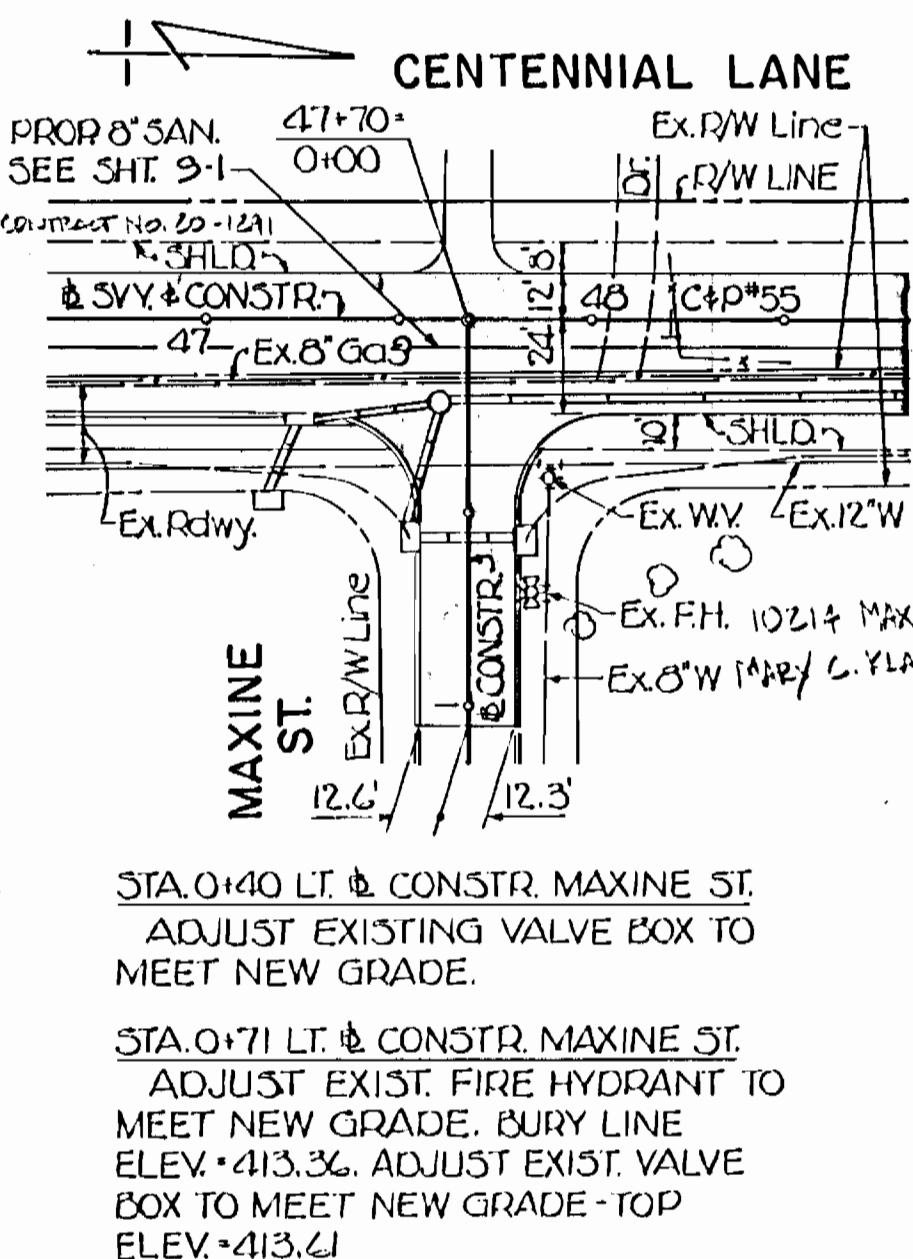


⑦ STA. 0+71 & CONSTR. MAXINE ST.

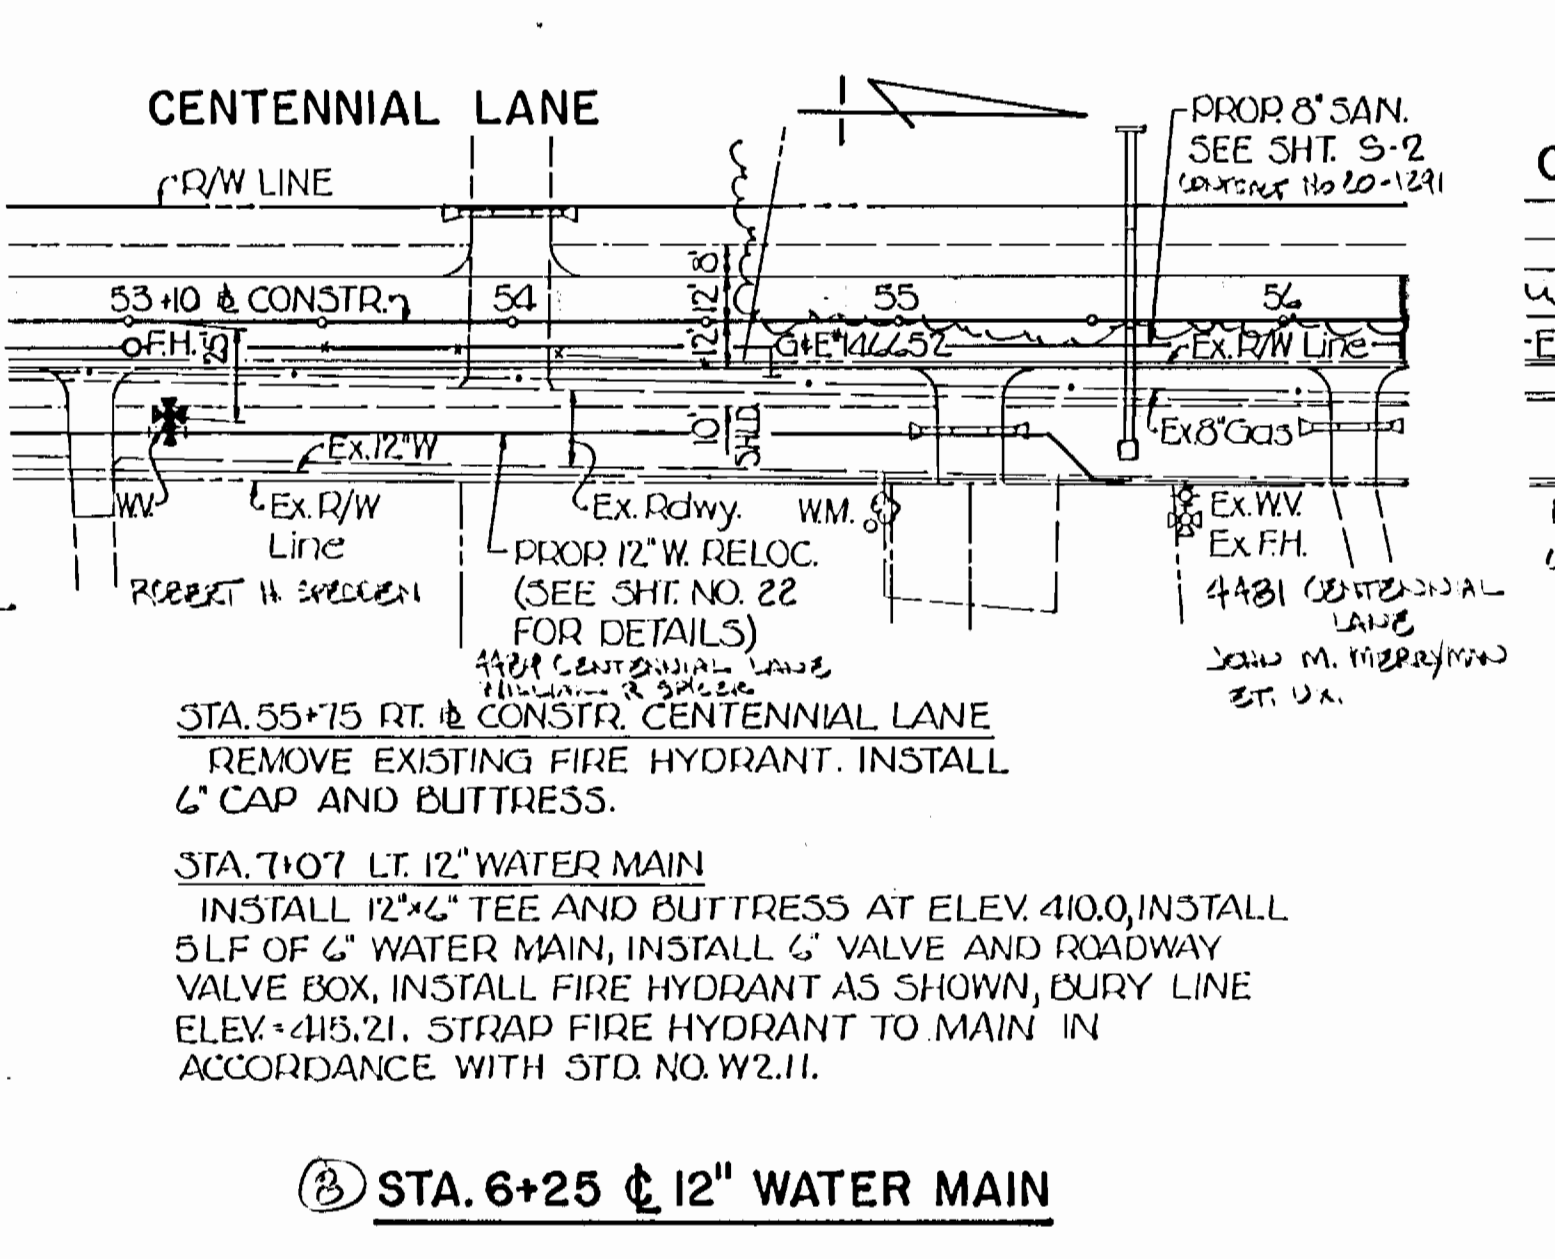


⑧ STA. 6+25 & 12" WATER MAIN

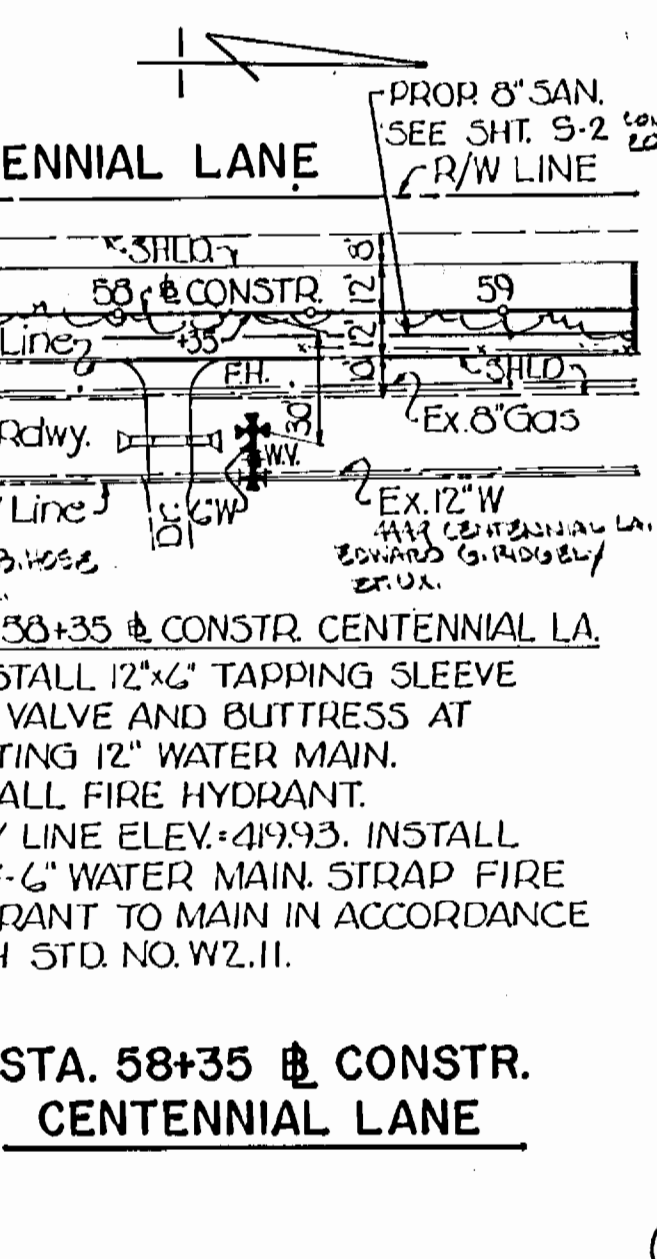

⑨ STA. 58+35 & CONSTR. CENTENNIAL LANE

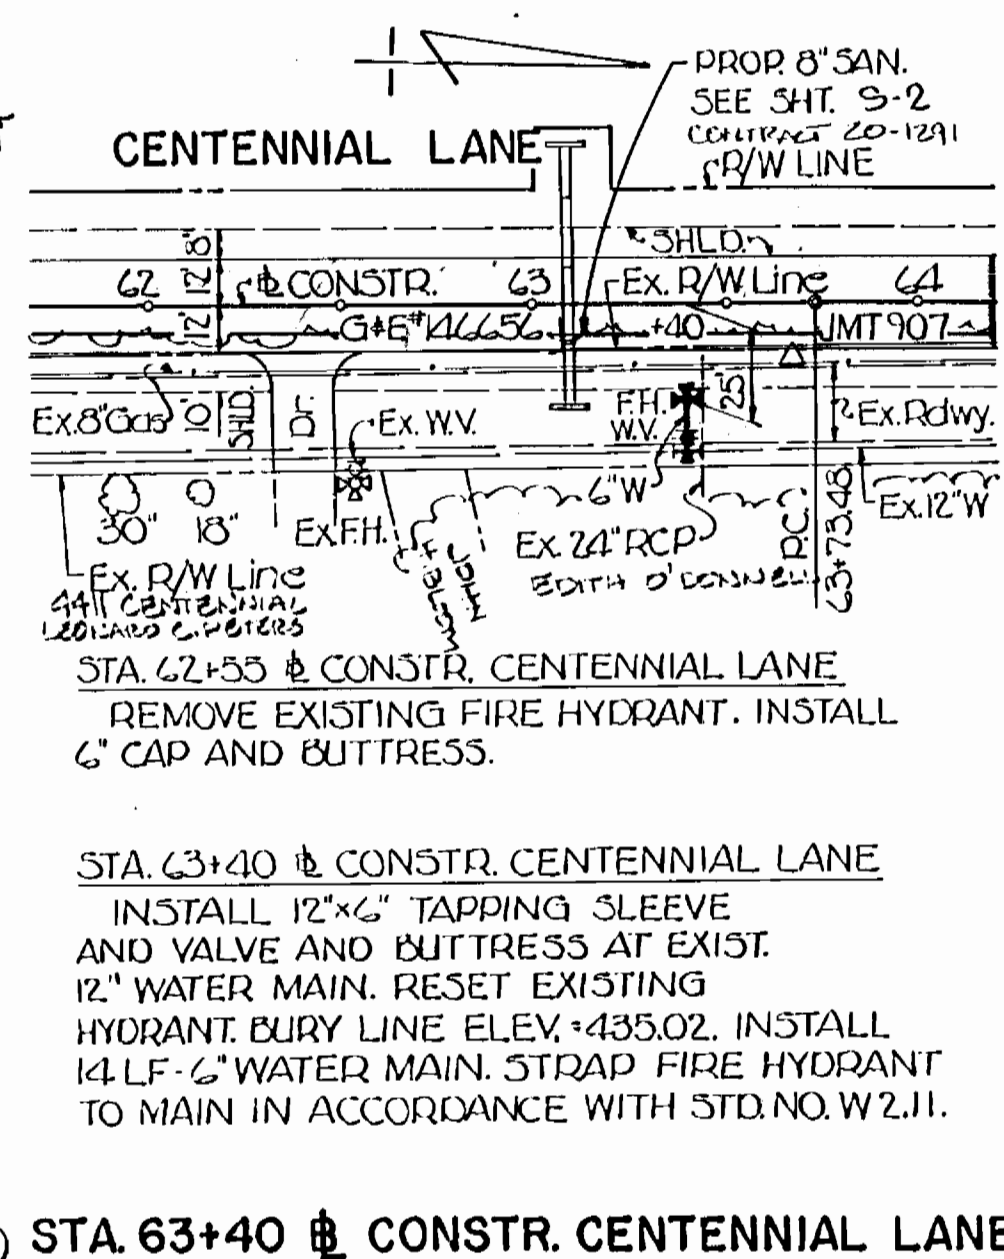

⑩ STA. 63+40 & CONSTR. CENTENNIAL LANE

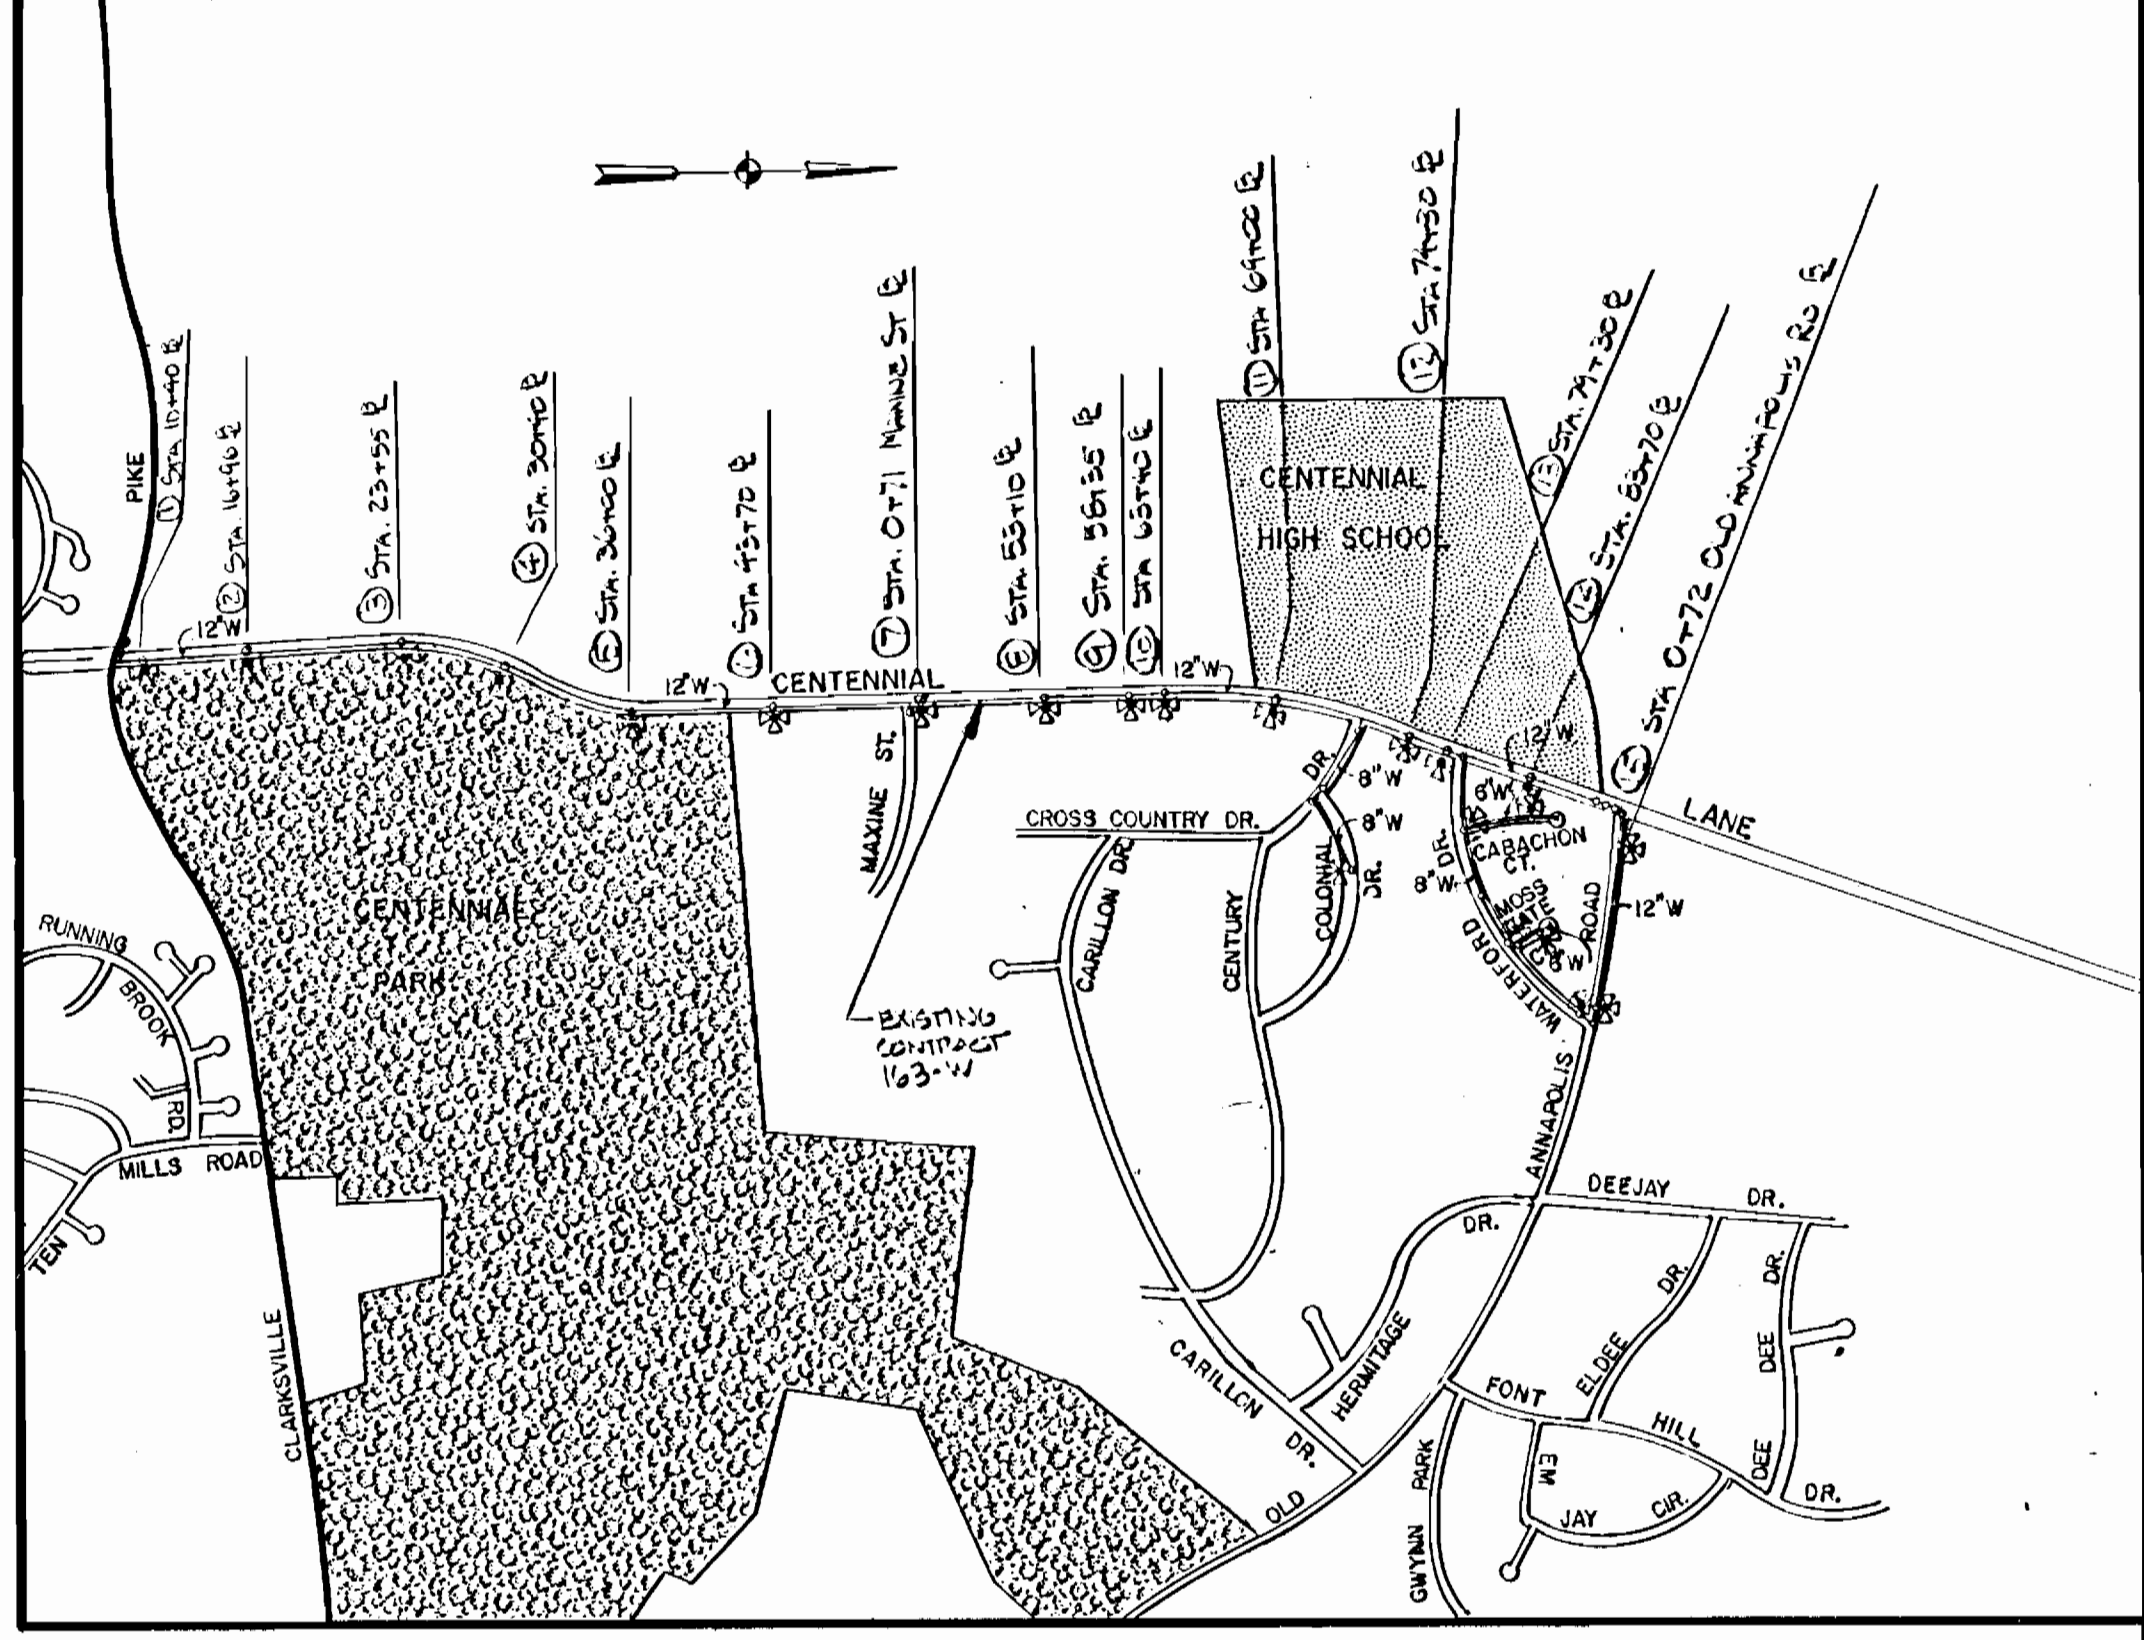

- Approximate locations of existing utilities are shown. The contractor shall take all necessary precautions to protect the existing utilities and maintain uninterrupted services, any damage to existing utilities shall immediately be repaired to the satisfaction of the Engineer at the Contractor's expense.
- All pipe elevations are shown as invert elevations.
- Clear all utilities by a minimum of 6". Clear all poles by 2' - 0" minimum or tunnel as required. The owner has contacted the utilities companies and has made arrangements for bracing of poles as shown on the drawings. In the event the contractor's work requires the bracing of additional poles, any cost incurred by the owner for the bracing of additional poles or damages shall be deducted from money owed the Contractor. The Contractor shall coordinate with the utility companies to schedule the bracing of the poles.
- For details not shown on the drawings, and for materials and construction methods, use Howard County Design Manual, Volume IV, Standard Specifications and Details for Construction. The Contractor shall have a copy of Volume IV on the job.
- Contractor shall locate existing utilities a minimum of two (2) weeks in advance of construction operations in the vicinity of proposed utilities at his own expense.
- Contractor shall notify the following utilities or agencies at least five working days before starting work shown on these plans:
State Highway Administration - 531-5533
Baltimore Gas & Electric - Contractor Services 561-2585
Baltimore Gas & Electric - Underground Damage Control - 234-5621
Baltimore Gas & Electric - Trouble Shooting - 298-9013
Miss Utility - 1-559-0100
Colonial Pipeline Company - 795-1390
Bureau of Utilities, Howard County Dept. of Public Works - 992-2366
- All water mains to be D.I.P. unless otherwise noted.
- Top of all water mains to have a minimum of 31" cover unless otherwise noted.
- Valves adjacent to tees shall be strapped to tees.
- All fittings shall be buttressed or anchored with concrete in accordance with the Standard Details unless otherwise provided for on the drawings.
- Bury line elevations on fire hydrants shall be set to the elevations shown on the drawings. All fire hydrants shall be strapped and buttressed with concrete in accordance with Standard Details. Soil around fire hydrants to be compacted in accordance with Section 1003 of the Standard Specifications.
- All water house connections shall be for an inside meter setting.
- The Contractor shall not operate any water main valves on the existing system.
- All roadway valves and manholes shall be adjusted to finished grade by the contractor. The price for adjusting existing roadway valves and manholes shall be included in the price bid for the bituminous concrete items.
- All horizontal controls are based on Maryland State Coordinates. All vertical controls are based on U.S.G.S. data.

DEPARTMENT OF PUBLIC WORKS
HOWARD COUNTY, MARYLAND

Robert Ward, Director of Public Works
DATE: 4/1/86

Chief, Bureau of Engineering
DATE: 3/25/86

Chief, Utility Design Division

Johnson, Mirman & Thompson, P.A.
310 GLENAGES COURT • BALTIMORE, MARYLAND 21204
(301) 921-6500




DES: B.D.B.	
DRN: R.W.S.	
CHK: D.T.C.	
DATE: JAN. 1985	BY NO. REVISIONS DATE

FIRE HYDRANT RELOCATION PLAN

MARYLAND ROUTE 108 TO OLD ANNAPOLIS ROAD
CONTRACT NO. 44-1471


SCALE 1" = 50'
SHEET 20 OF 25

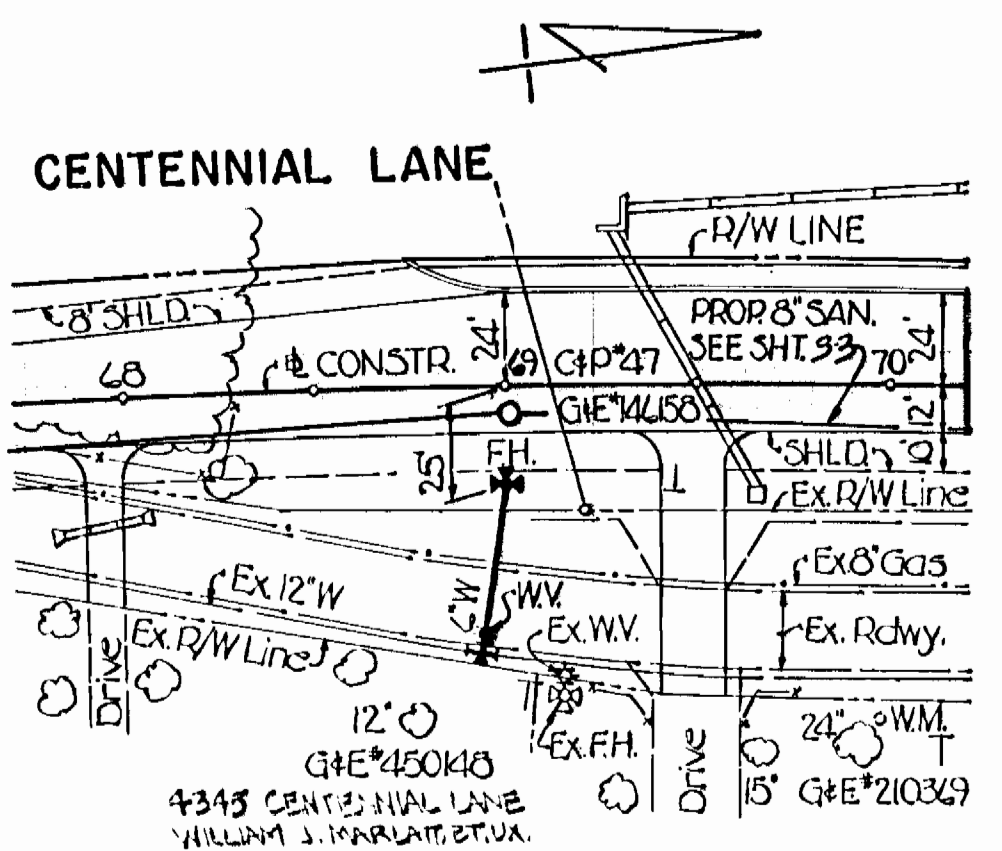

STA. 69+15 RT. & CONSTR. CENTENNIAL LA.
REMOVE EXISTING FIRE HYDRANT.
INSTALL 6" CAP AND BUTTRISS.


STA. 69+00 RT. & CONSTR. CENTENNIAL LA.
INSTALL 12"x6" TAPPING SLEEVE AND VALVE AND BUTTRISS AT EXISTING 12" WATER MAIN. RESET EXISTING FIRE HYDRANT. BURY LINE ELEV. +423.54. INSTALL 42 LF-6" WATER MAIN. STRAP FIRE HYDRANT TO MAIN USING ALTERNATE METHOD, SEE STD. NO. W2.13.

11 STA. 69+00 & CONSTR. CENTENNIAL LANE

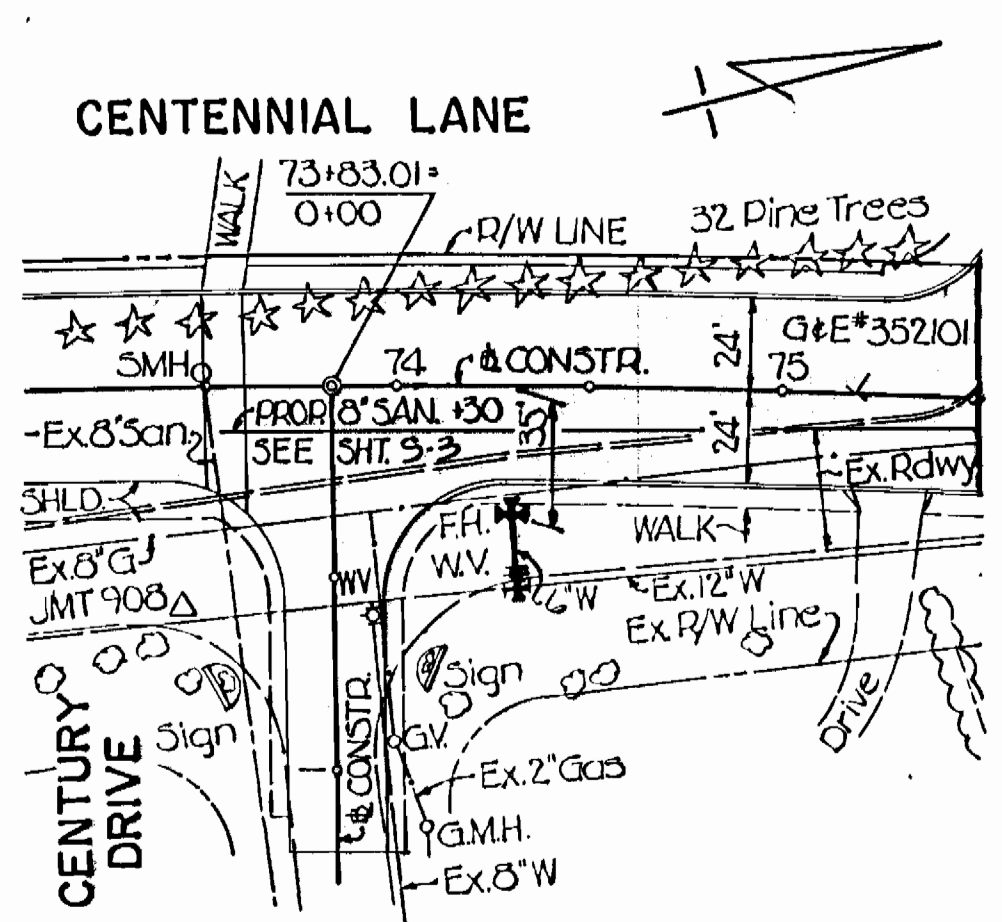

STA. 74+30 RT. & CONSTR. CENTENNIAL LA.
INSTALL 12"x6" TAPPING SLEEVE AND VALVE AND BUTTRISS AT EXISTING 12" WATER MAIN. INSTALL FIRE HYDRANT. BURY LINE ELEV. +424.73. INSTALL 14 LF-6" WATER MAIN. STRAP FIRE HYDRANT TO MAIN IN ACCORDANCE WITH STD. NO. W2.11. ADJUST EXISTING 8" VALVE ON CENTURY DRIVE TO FINISHED GRADE.


12 STA. 74+30 & CONSTR. CENTENNIAL LANE

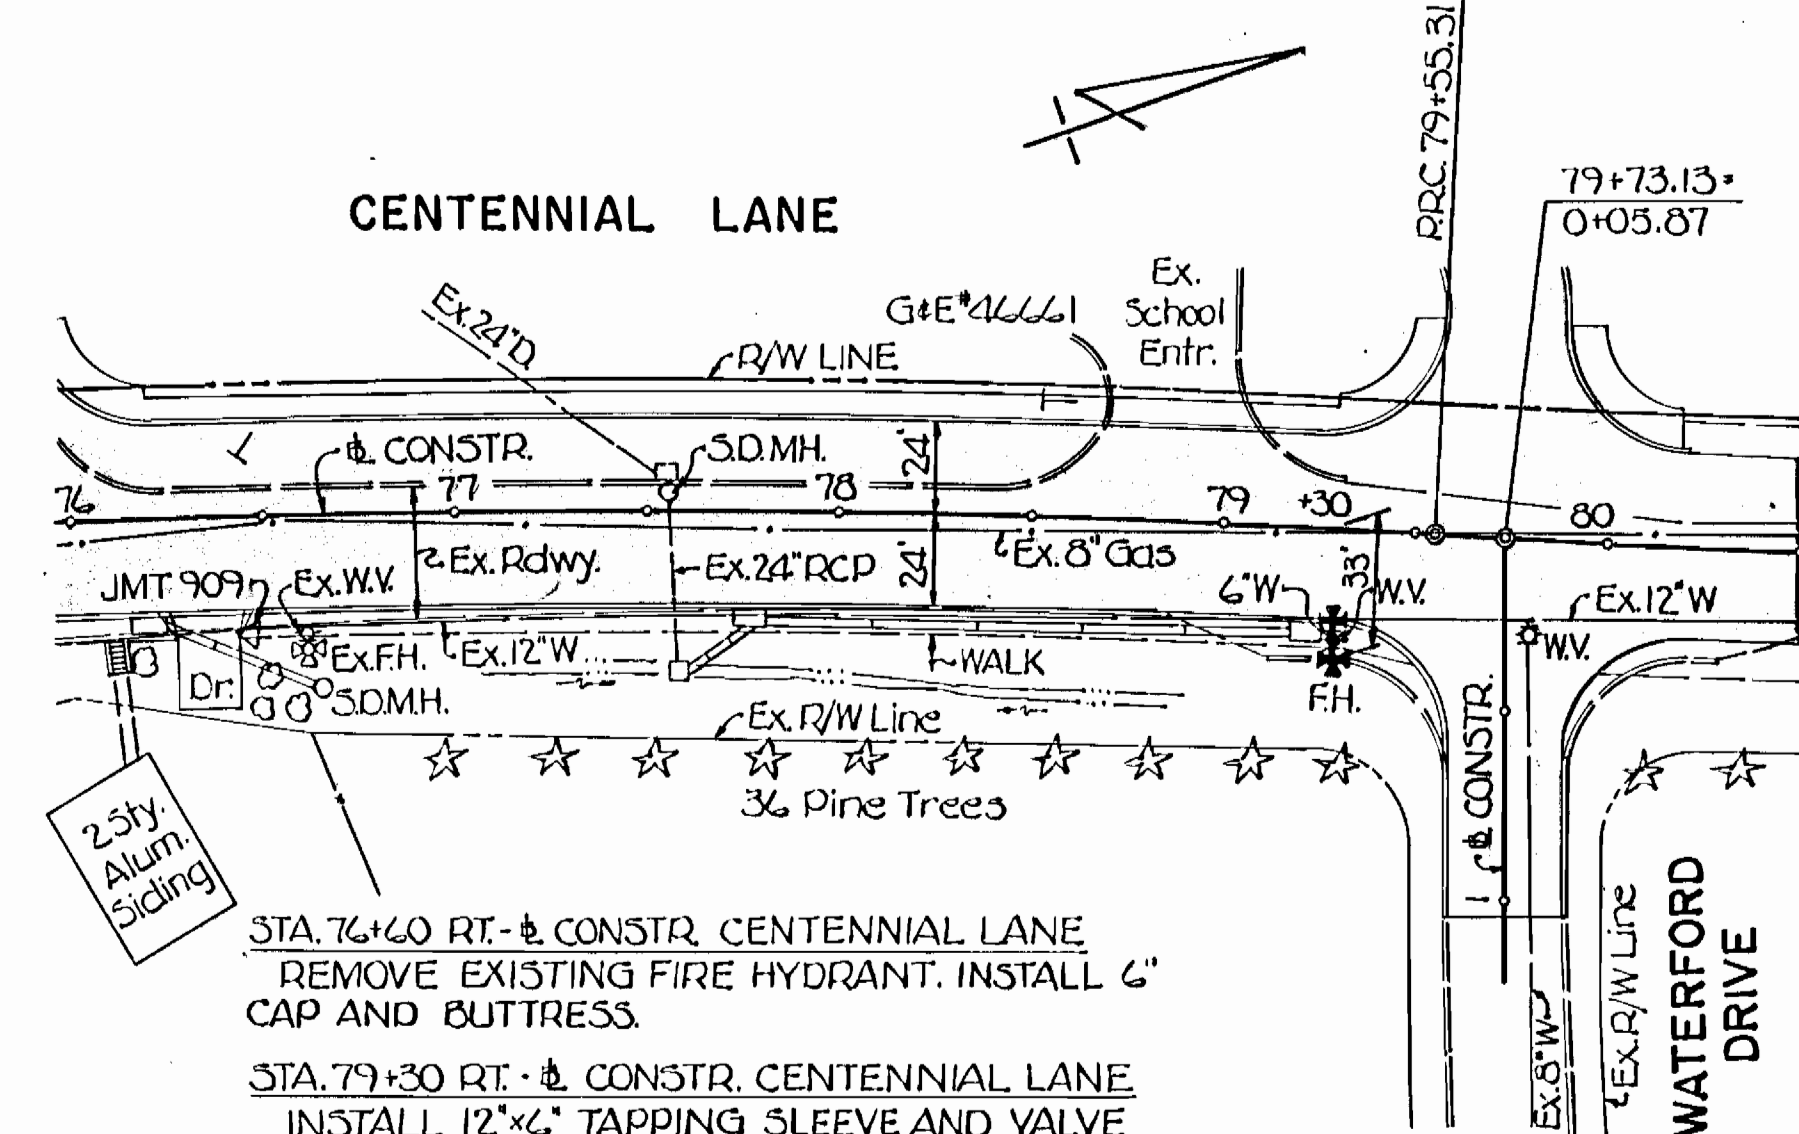

STA. 76+40 RT. & CONSTR. CENTENNIAL LANE
REMOVE EXISTING FIRE HYDRANT. INSTALL 6" CAP AND BUTTRISS.


STA. 79+30 RT. & CONSTR. CENTENNIAL LANE
INSTALL 12"x6" TAPPING SLEEVE AND VALVE AND BUTTRISS AT EXISTING 12" WATER MAIN. RESET EXISTING HYDRANT. BURY LINE ELEV. +480.99. INSTALL 10 LF-6" WATER MAIN. STRAP FIRE HYDRANT TO MAIN IN ACCORDANCE WITH STD. NO. W2.11.

13 STA. 79+30 & CONSTR. CENTENNIAL LANE

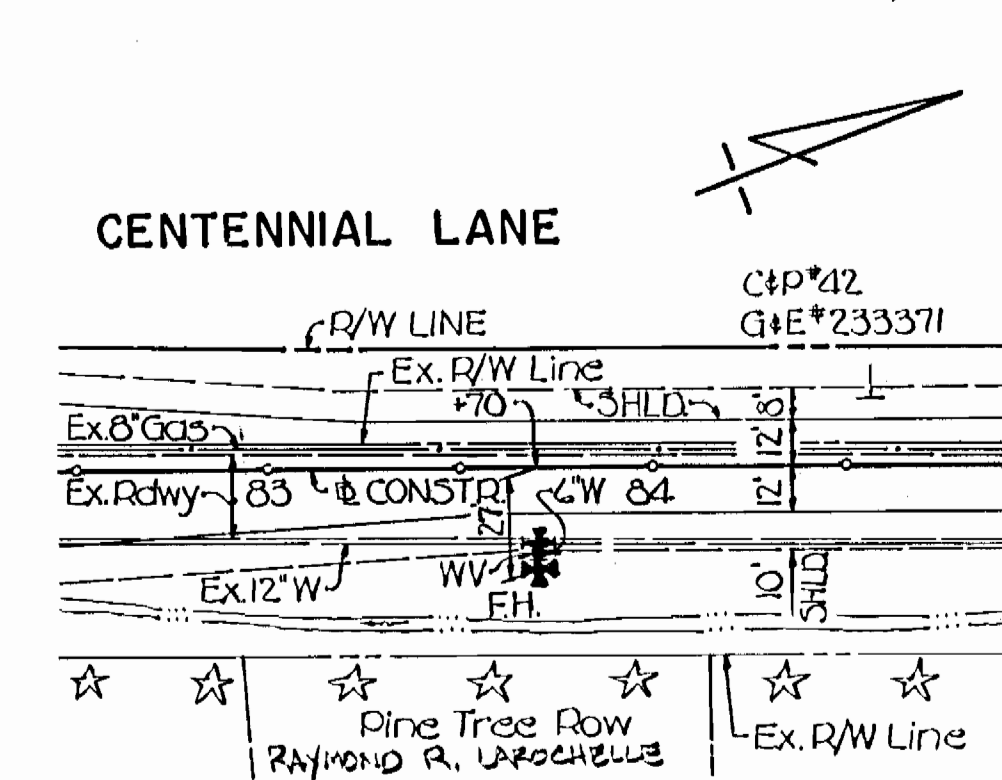


STA. 83+70 RT. & CONSTR. CENTENNIAL LA.
INSTALL 12"x6" TAPPING SLEEVE AND VALVE AND BUTTRISS AT EXISTING 12" WATER MAIN. INSTALL FIRE HYDRANT. BURY LINE ELEV. +479.65. INSTALL 6 LF-6" WATER MAIN. STRAP FIRE HYDRANT TO MAIN IN ACCORDANCE WITH STD. NO. W2.11.

14 STA. 83+70 & CONSTR. CENTENNIAL LANE

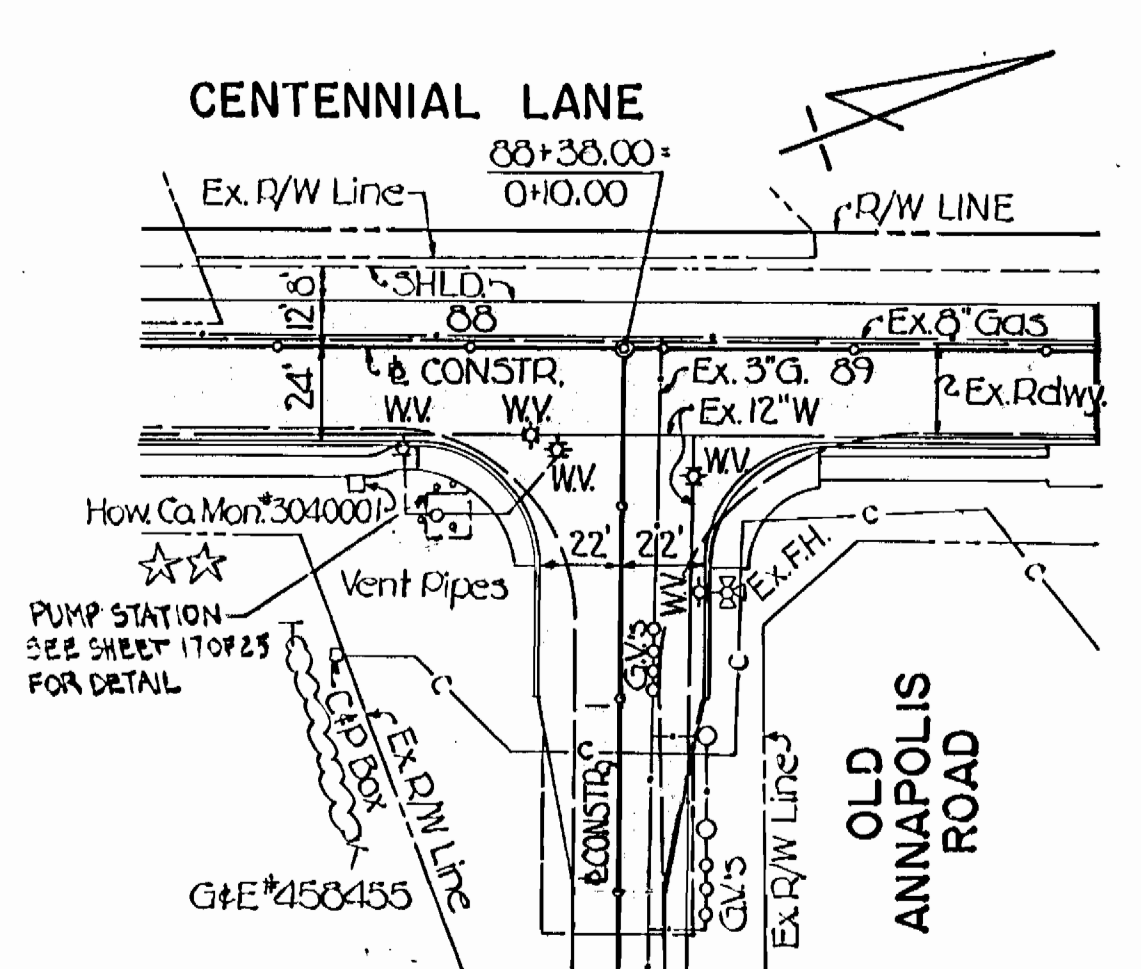


STA. 0+72 LT. & CONSTR. OLD ANNAPOLIS ROAD
ADJUST EXISTING FIRE HYDRANT TO FINISHED GRADE. BURY LINE ELEV. +492.97. ADJUST EXISTING ROADWAY VALVE BOXES TO FINISHED GRADE ON OLD ANNAPOLIS ROAD AND CENTENNIAL LANE.

15 STA. 0+72 & CONSTR. OLD ANNAPOLIS ROAD

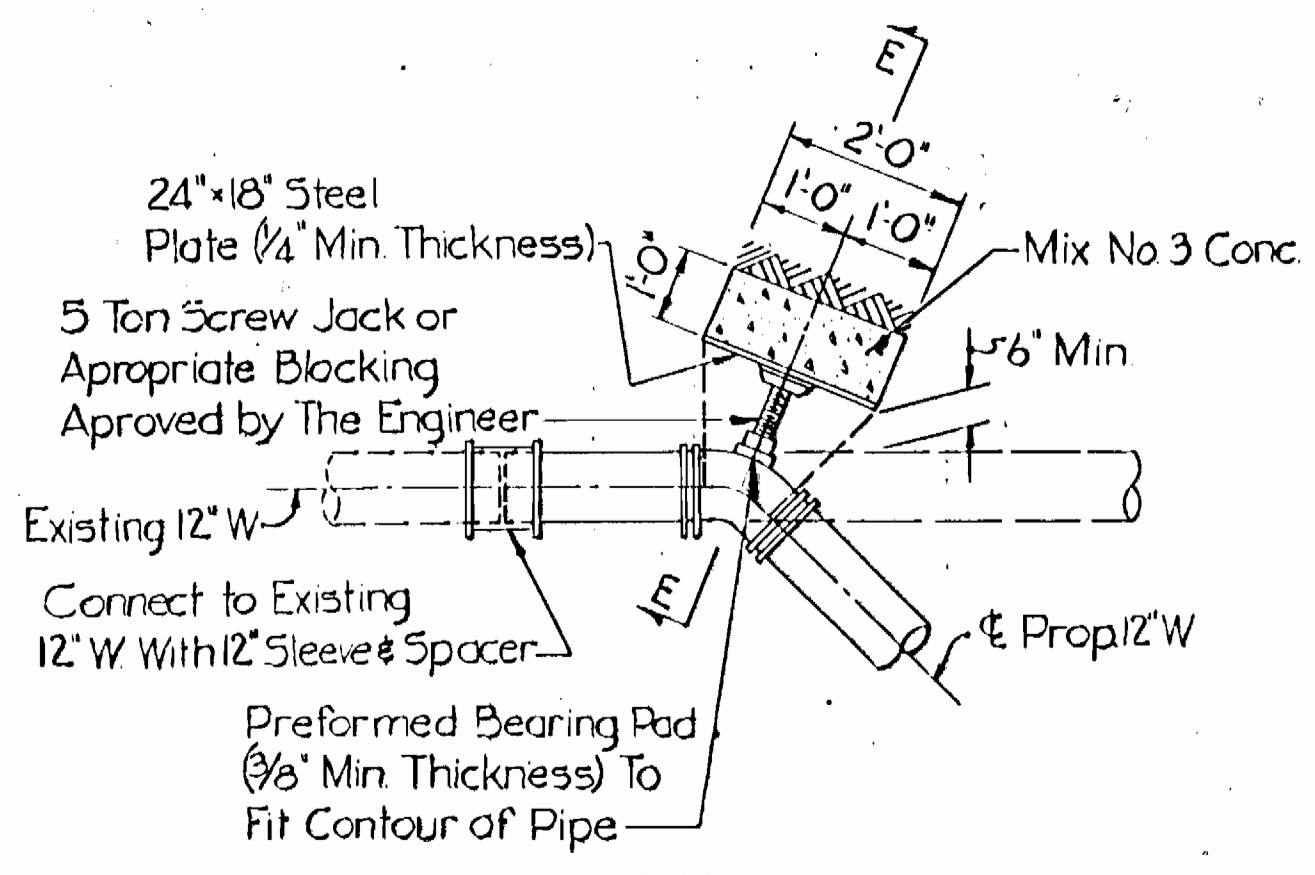

PLAN

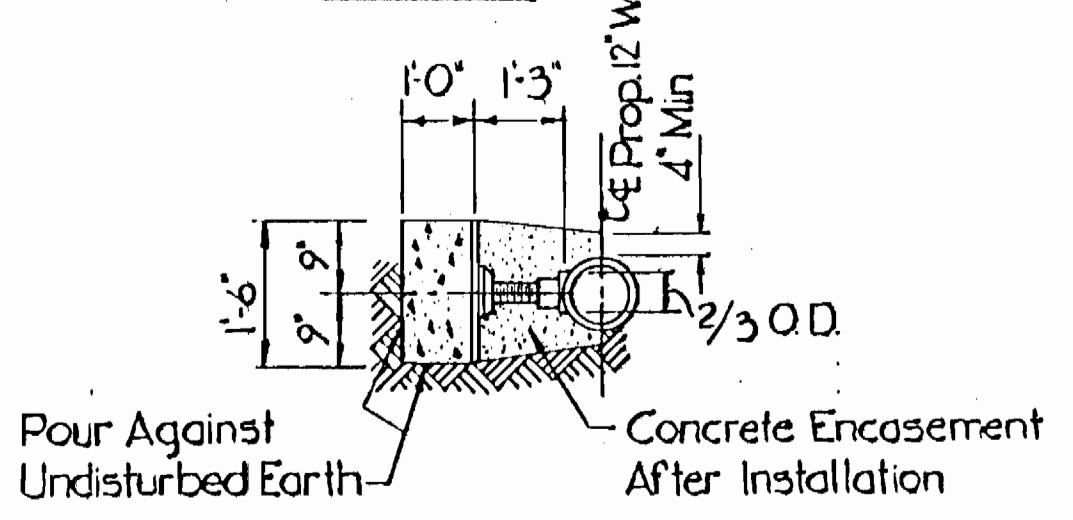

SECTION A-A

DETAIL A
45° PREFORMED BUTTRISS
NOT TO SCALE

SEQUENCE OF WATER MAIN RELOCATION

STATION 13+40 TO STATION 18+10

1. Construct the preprepared buttresses at the bends at station 5+00 and station 9+59.94 of the 12" Water Main.
2. Construct the 12" Water Main and temporarily cap and block the ends at the location shown on the plan.
3. Test and chlorinate the new main.
4. Close the valves at station 9+56+ and station 33+44.5-7' left. Cut the existing pipe and make connection with 12" sleeve and spacer. Open valves and put the main back in service.
5. Remove the existing 12" Water Main from Station 13+50 to Station 18+00.

SEQUENCE OF WATER MAIN RELOCATION

STATION 25+83 TO STATION 32+90

1. Construct the preprepared buttresses at the bends at station 5+10 and station 12+05.78 of the 12" Water Main.
2. Construct the 12" Water Main and temporarily cap and block the ends at the location shown on the plan.
3. Test and chlorinate the new main.
4. Close the valves at station 9+56+ and station 33+44.5 - 7' left. Cut the existing pipe and make connection with 12" sleeve and spacer. Open valves and put the main back in service.
5. Cap and abandon the existing 12" Water Main from Station 26+00 to 28+25 and 29+00 to 32+73 and remove the existing 12" Water Main from Station 28+25 to Station 29+00.

SEQUENCE OF WATER MAIN RELOCATION

STATION 51+10 TO STATION 55+60

1. Construct the preprepared buttresses at the bends at Station 5+10 and Station 9+51.59 of the 12" Water Main.
2. Construct the 12" Water Main and temporarily cap and block the ends at the locations shown on the plan. Install 3/4 inch service connection and corporation cock.
3. Test and chlorinate the new main.
4. Close the valves at station 33+44.5-7' left and station 59+90-43.5' right. Cut the existing pipe and make connection with 12" sleeve and spacer. Open valves and put the main back in service.
5. Remove the existing 12" Water Main from Station 51+52 to Station 55+33.

Notes:

1. The Contractor shall do everything possible to minimize the length of time for water service shut down. In no case shall the Water Main be shut down for more than six (6) hours at a time.
2. It will be the responsibility of the Contractor to notify all water customers of the County, in writing, who will be without service, a minimum of 48 hours in advance of the scheduled shutdown.
3. The Contractor shall notify the Bureau of Utilities of Howard County, in writing, at least one (1) week prior to making any tie-in to the existing system.
4. The Contractor shall not operate any water main valve on the existing system.
5. The water main may not be shut down during peak periods May thru September.

CAPITAL PROJECT J-4015

DEPARTMENT OF PUBLIC WORKS
HOWARD COUNTY, MARYLAND
Robert Woodford, Director of Public Works
3/15/86
Robert Woodford, Director of Utilities
3/15/86







Johnson, Mirrman & Thompson, P.A.
1001 221 Avenue
122-85



DES: B.D.B.					
DWN: R.W.S.					
CHK: D.T.C.					
DATE: JAN. 1985	BY	NO.	REVISIONS	DATE	

FIRE HYDRANT
RELOCATION PLAN

MARYLAND ROUTE 108 TO
OLD ANNAPOLIS ROAD
CONTRACT NO. 44-1471
SCALE
1"=50'
SHEET
21 OF 25

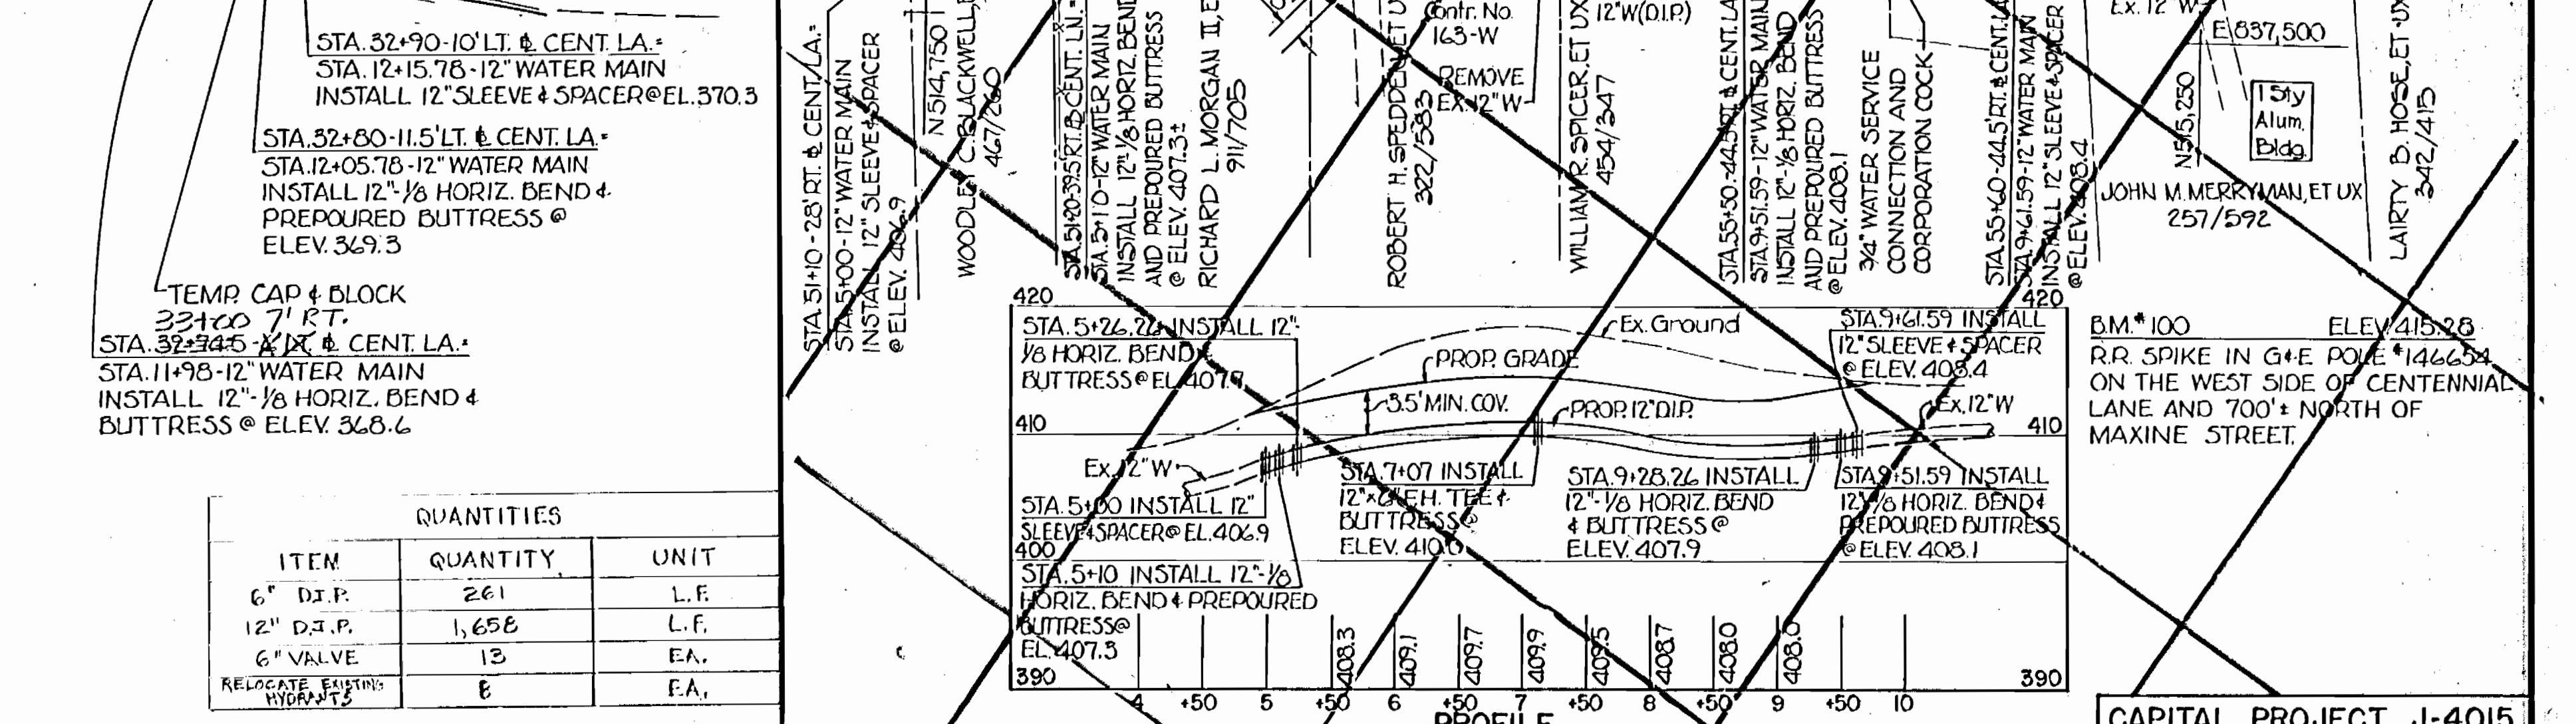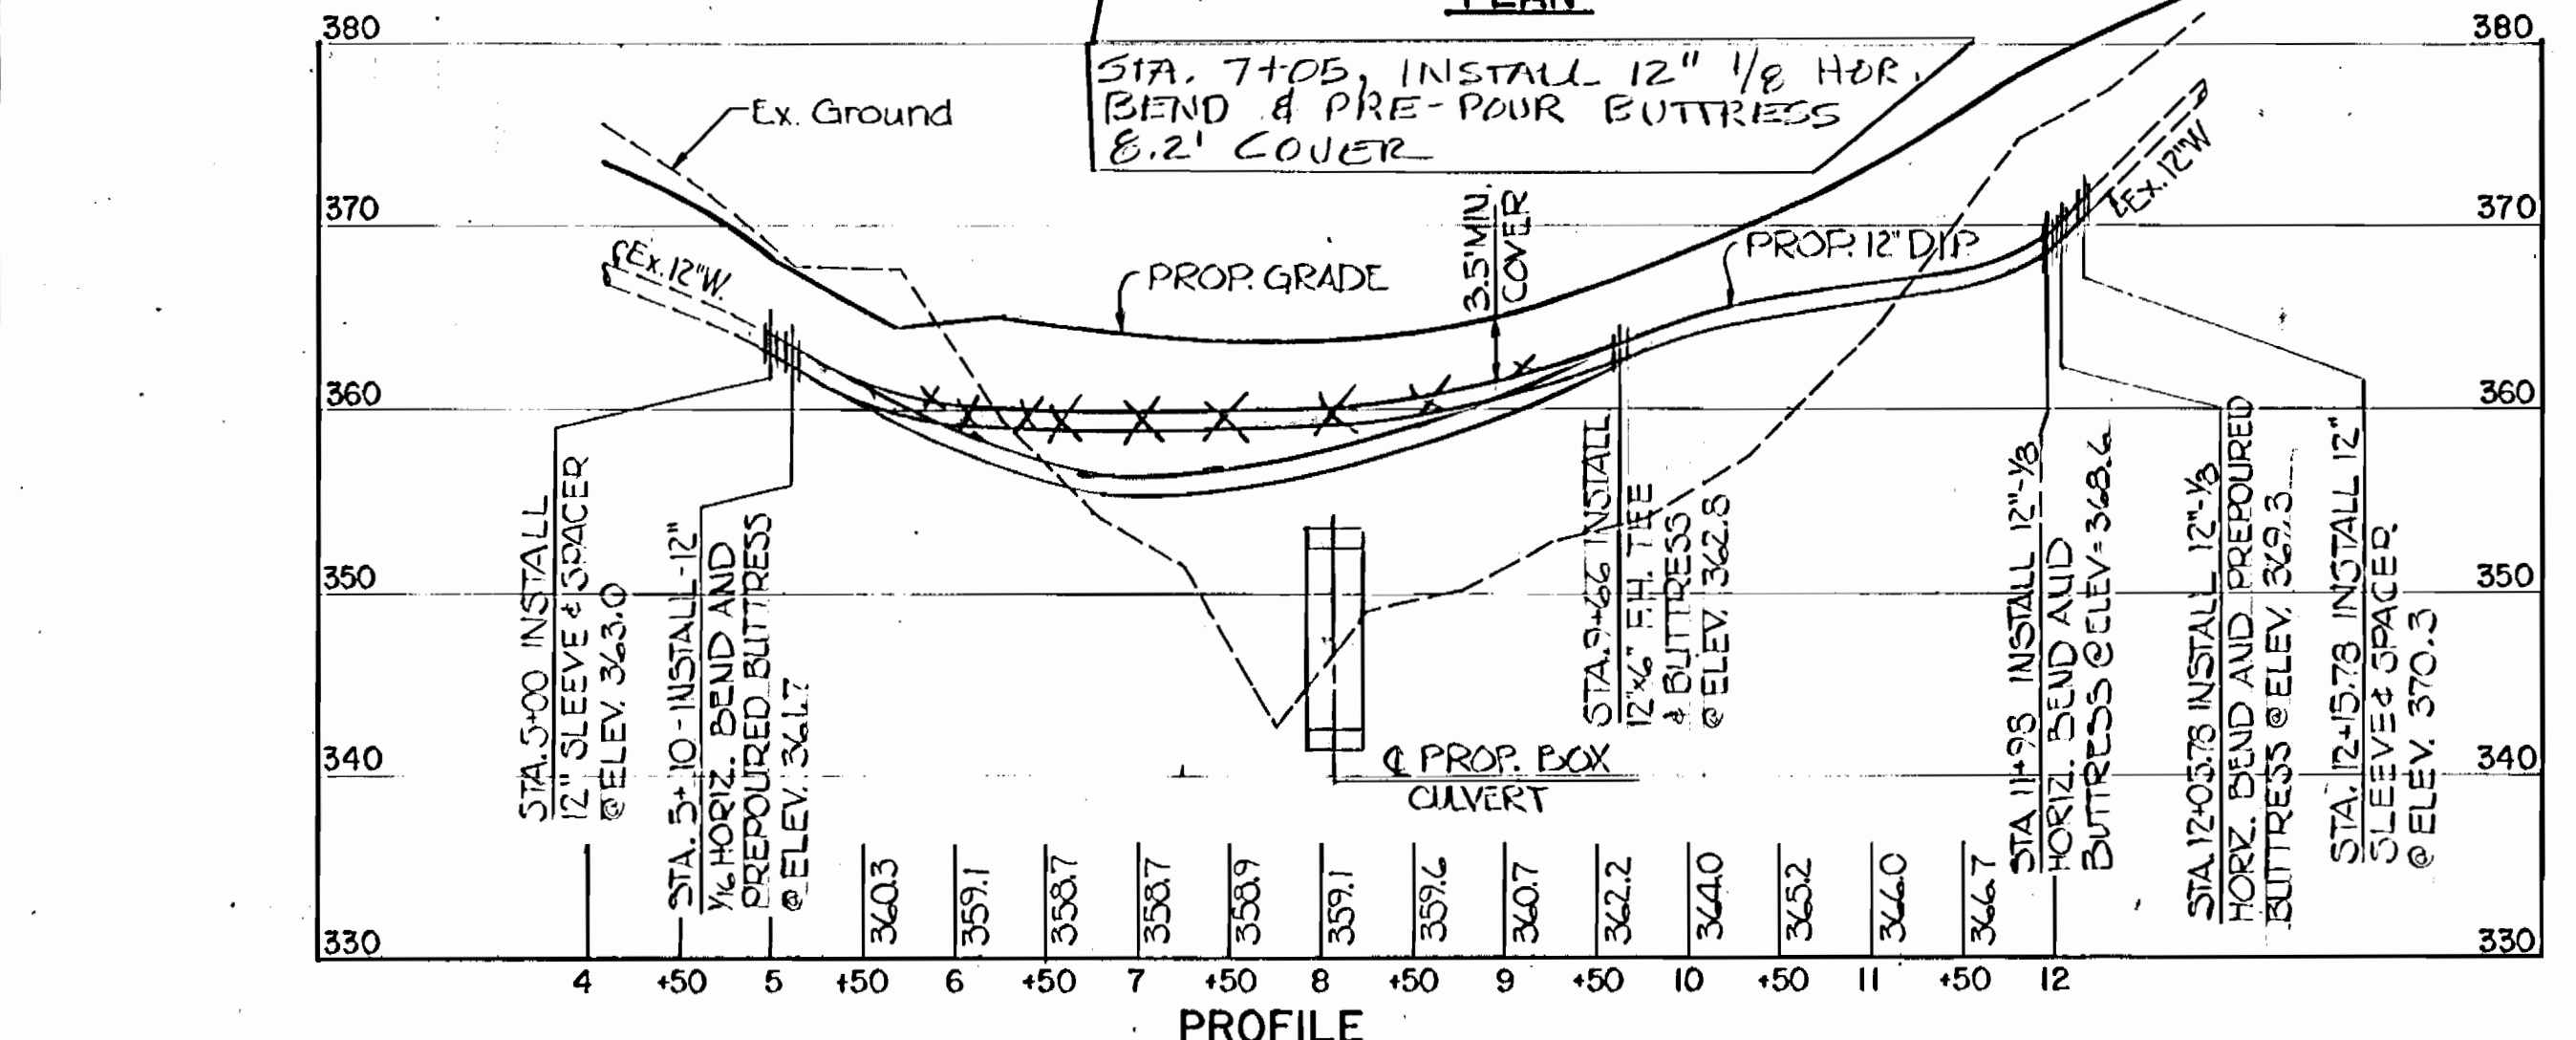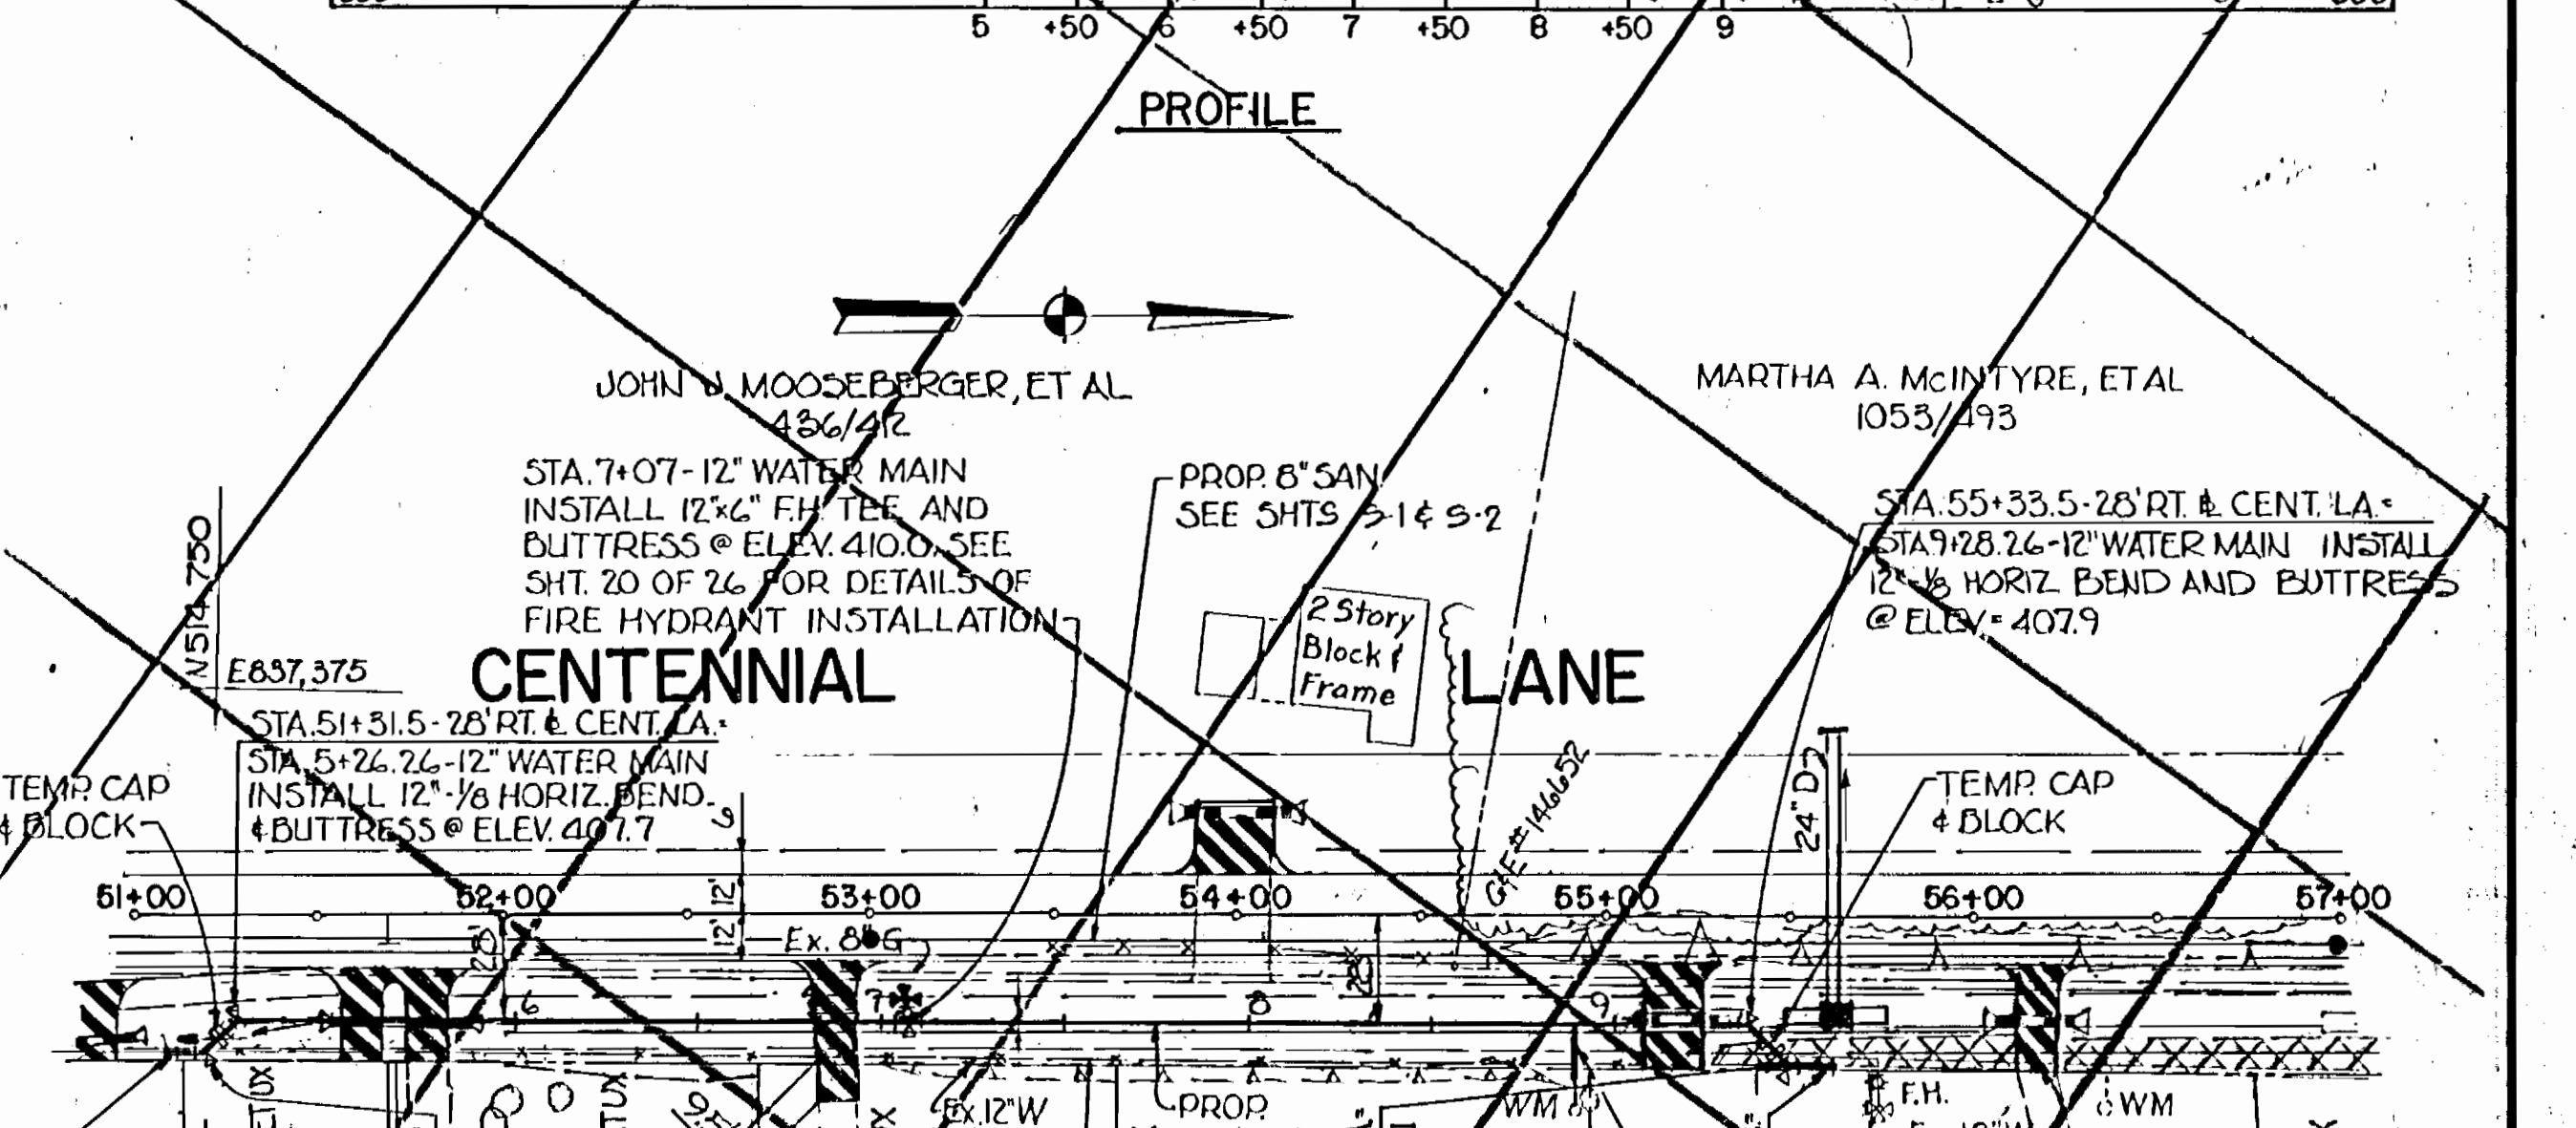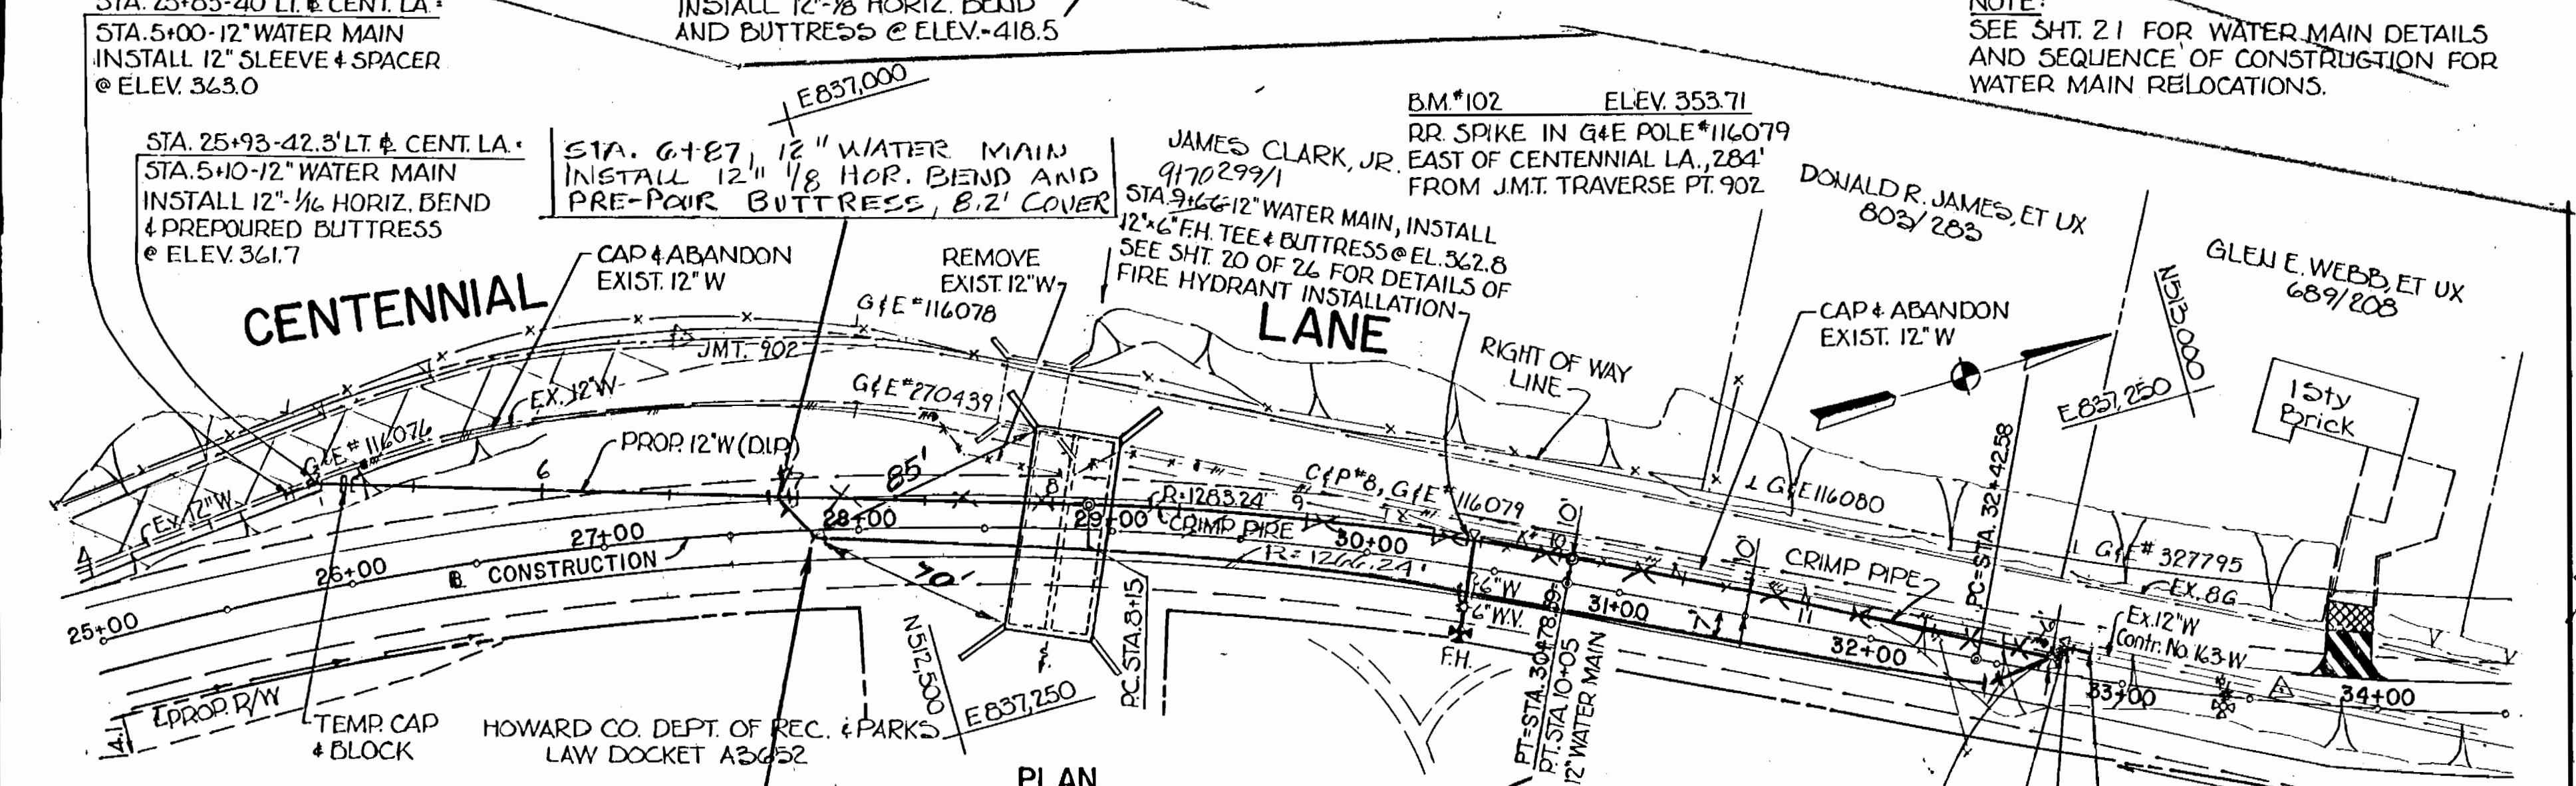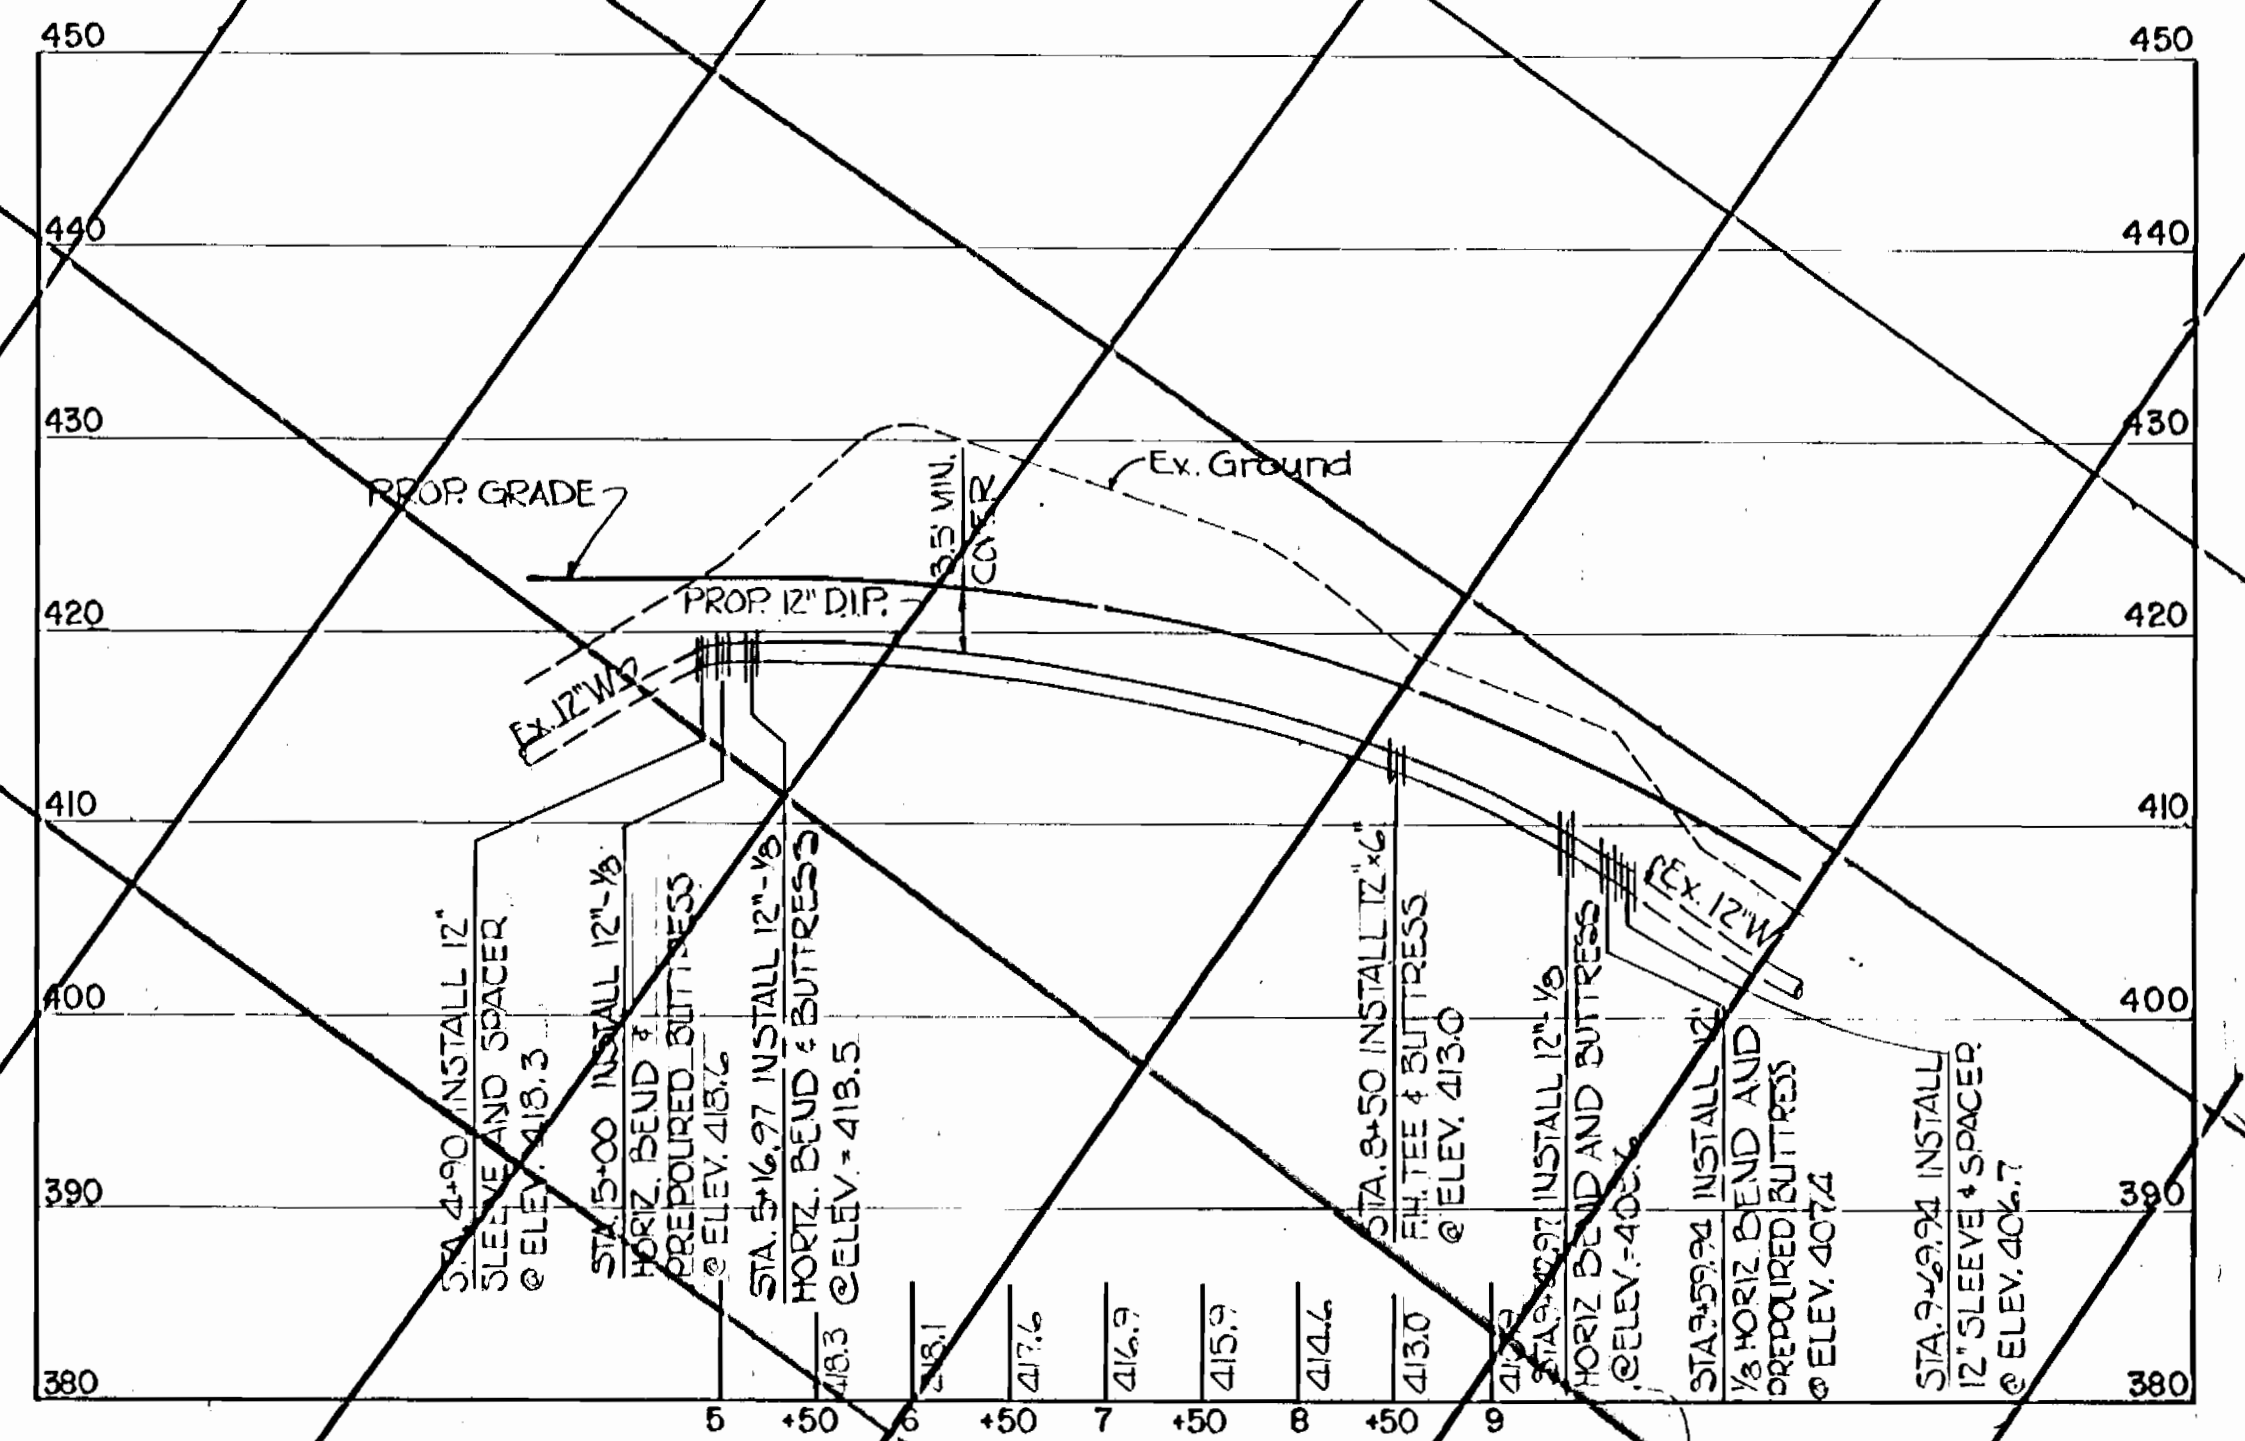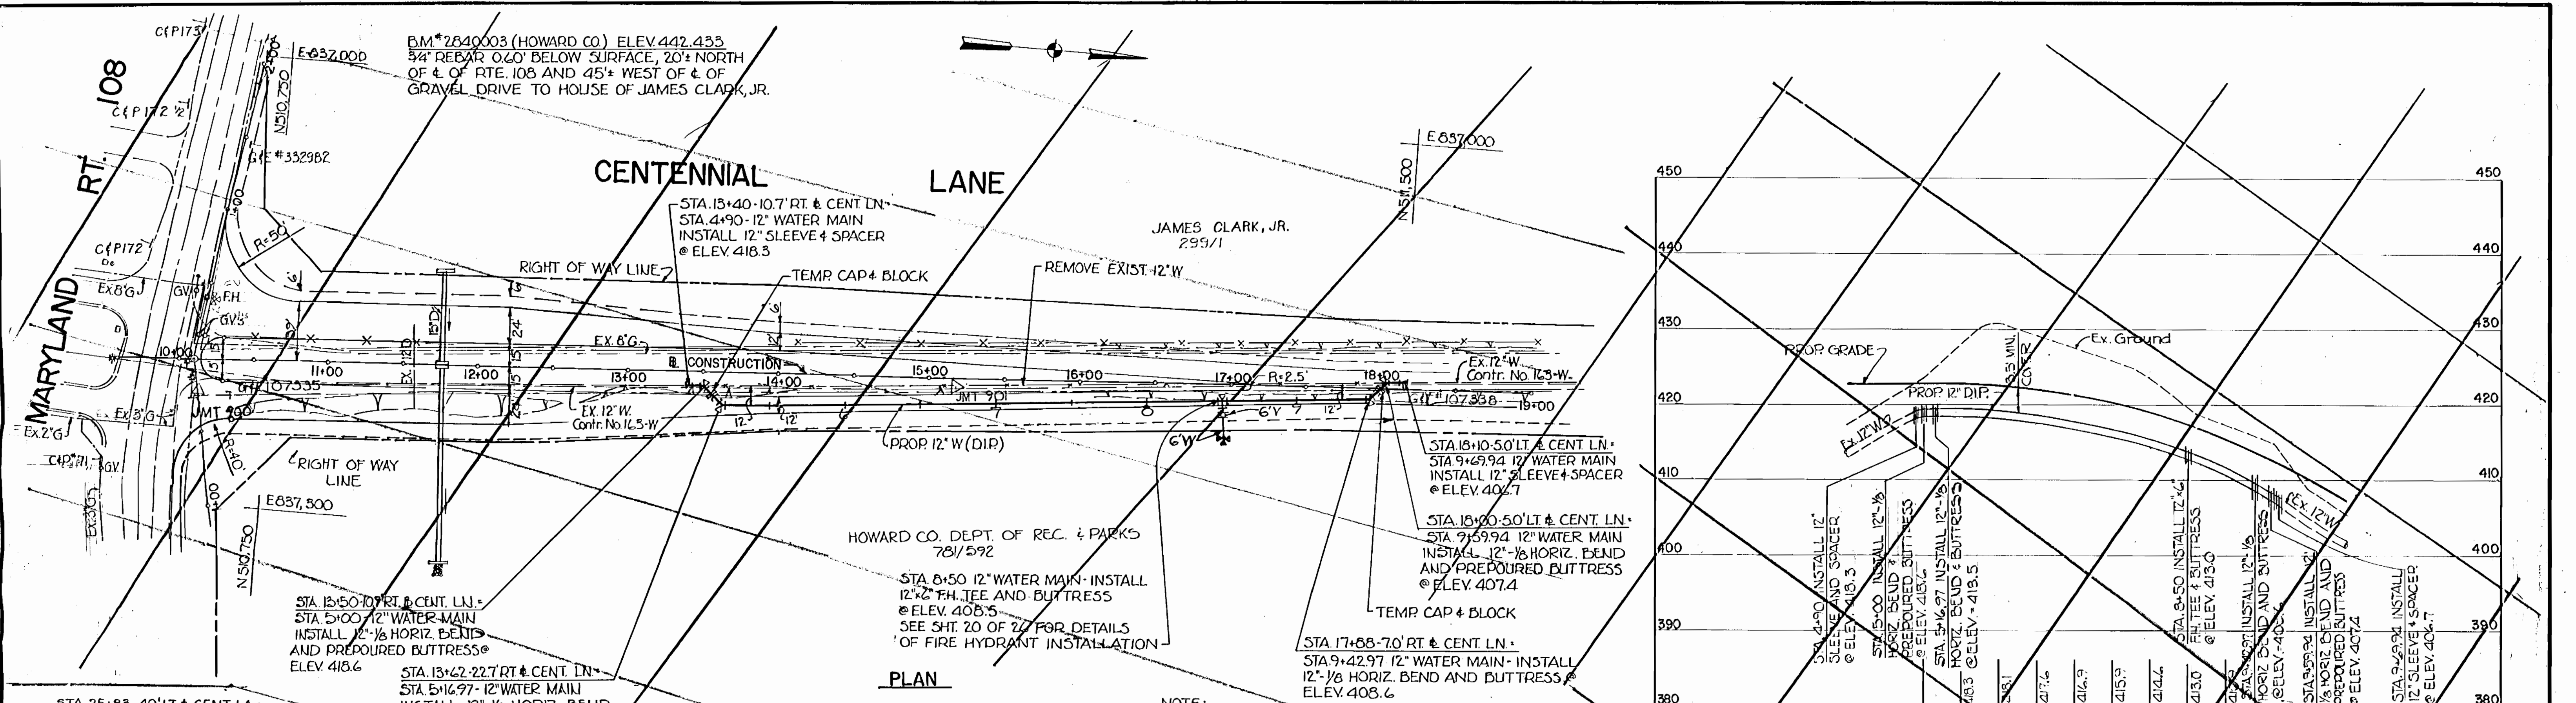

QUANTITIES		
ITEM	QUANTITY	UNIT
6" D.I.P.	261	L.F.
12" D.I.P.	1,658	L.F.
6" VALVE	13	E.A.
RELOCATE EXISTING HYDRANTS	8	F.A.

DEPARTMENT OF PUBLIC WORKS
 HOWARD COUNTY, MARYLAND

Robert Wood / 1/15/86
 DIRECTOR OF PUBLIC WORKS DATE
 CHIEF, BUREAU OF UTILITIES, DATE

Johnson, Mirman & Thompson, P.A.
 810 GLENDALE COURT • BALTIMORE, MARYLAND 21202
 (301) 821-6500

STATE OF MARYLAND
 PROFESSIONAL ENGINEER
 1-25-86

DEB: B.D.E.
 DRN: A.M.R.
 CHK: D.T.C.
 DATE: JAN. 1985

BY	NO.	REVISIONS	DATE

WATER MAIN RELOCATION
PLAN AND PROFILE

MARYLAND ROUTE 108 TO
OLD ANNAPOLIS ROAD
 CONTRACT NO. 44-1471

SCALE
 PLAN: 1"=50'
 PROFILE: 1"=100'
 SHEET 22 OF 23

AS-BUILT 2-7-89