


ITEM	QUANTITIES		MATERIAL/SUPPLIER
	BID	AS BUILT	
8" Sewer L.F.	1850	3,376	SDR 35/BELAIR RD SUPPLY
Manholes Ea.	14	20	PRECAST CONC./ATLANTIC
6" S.H.C. L.F.	520	636	SDR 35/BELAIR RD SUPPLY
B.H.C. V.F.	45	48.5	SDR 35 " " "
8" Sewer D.I.P.L.F.	910	890	DIP/GRIFFIN PIPE PROD.

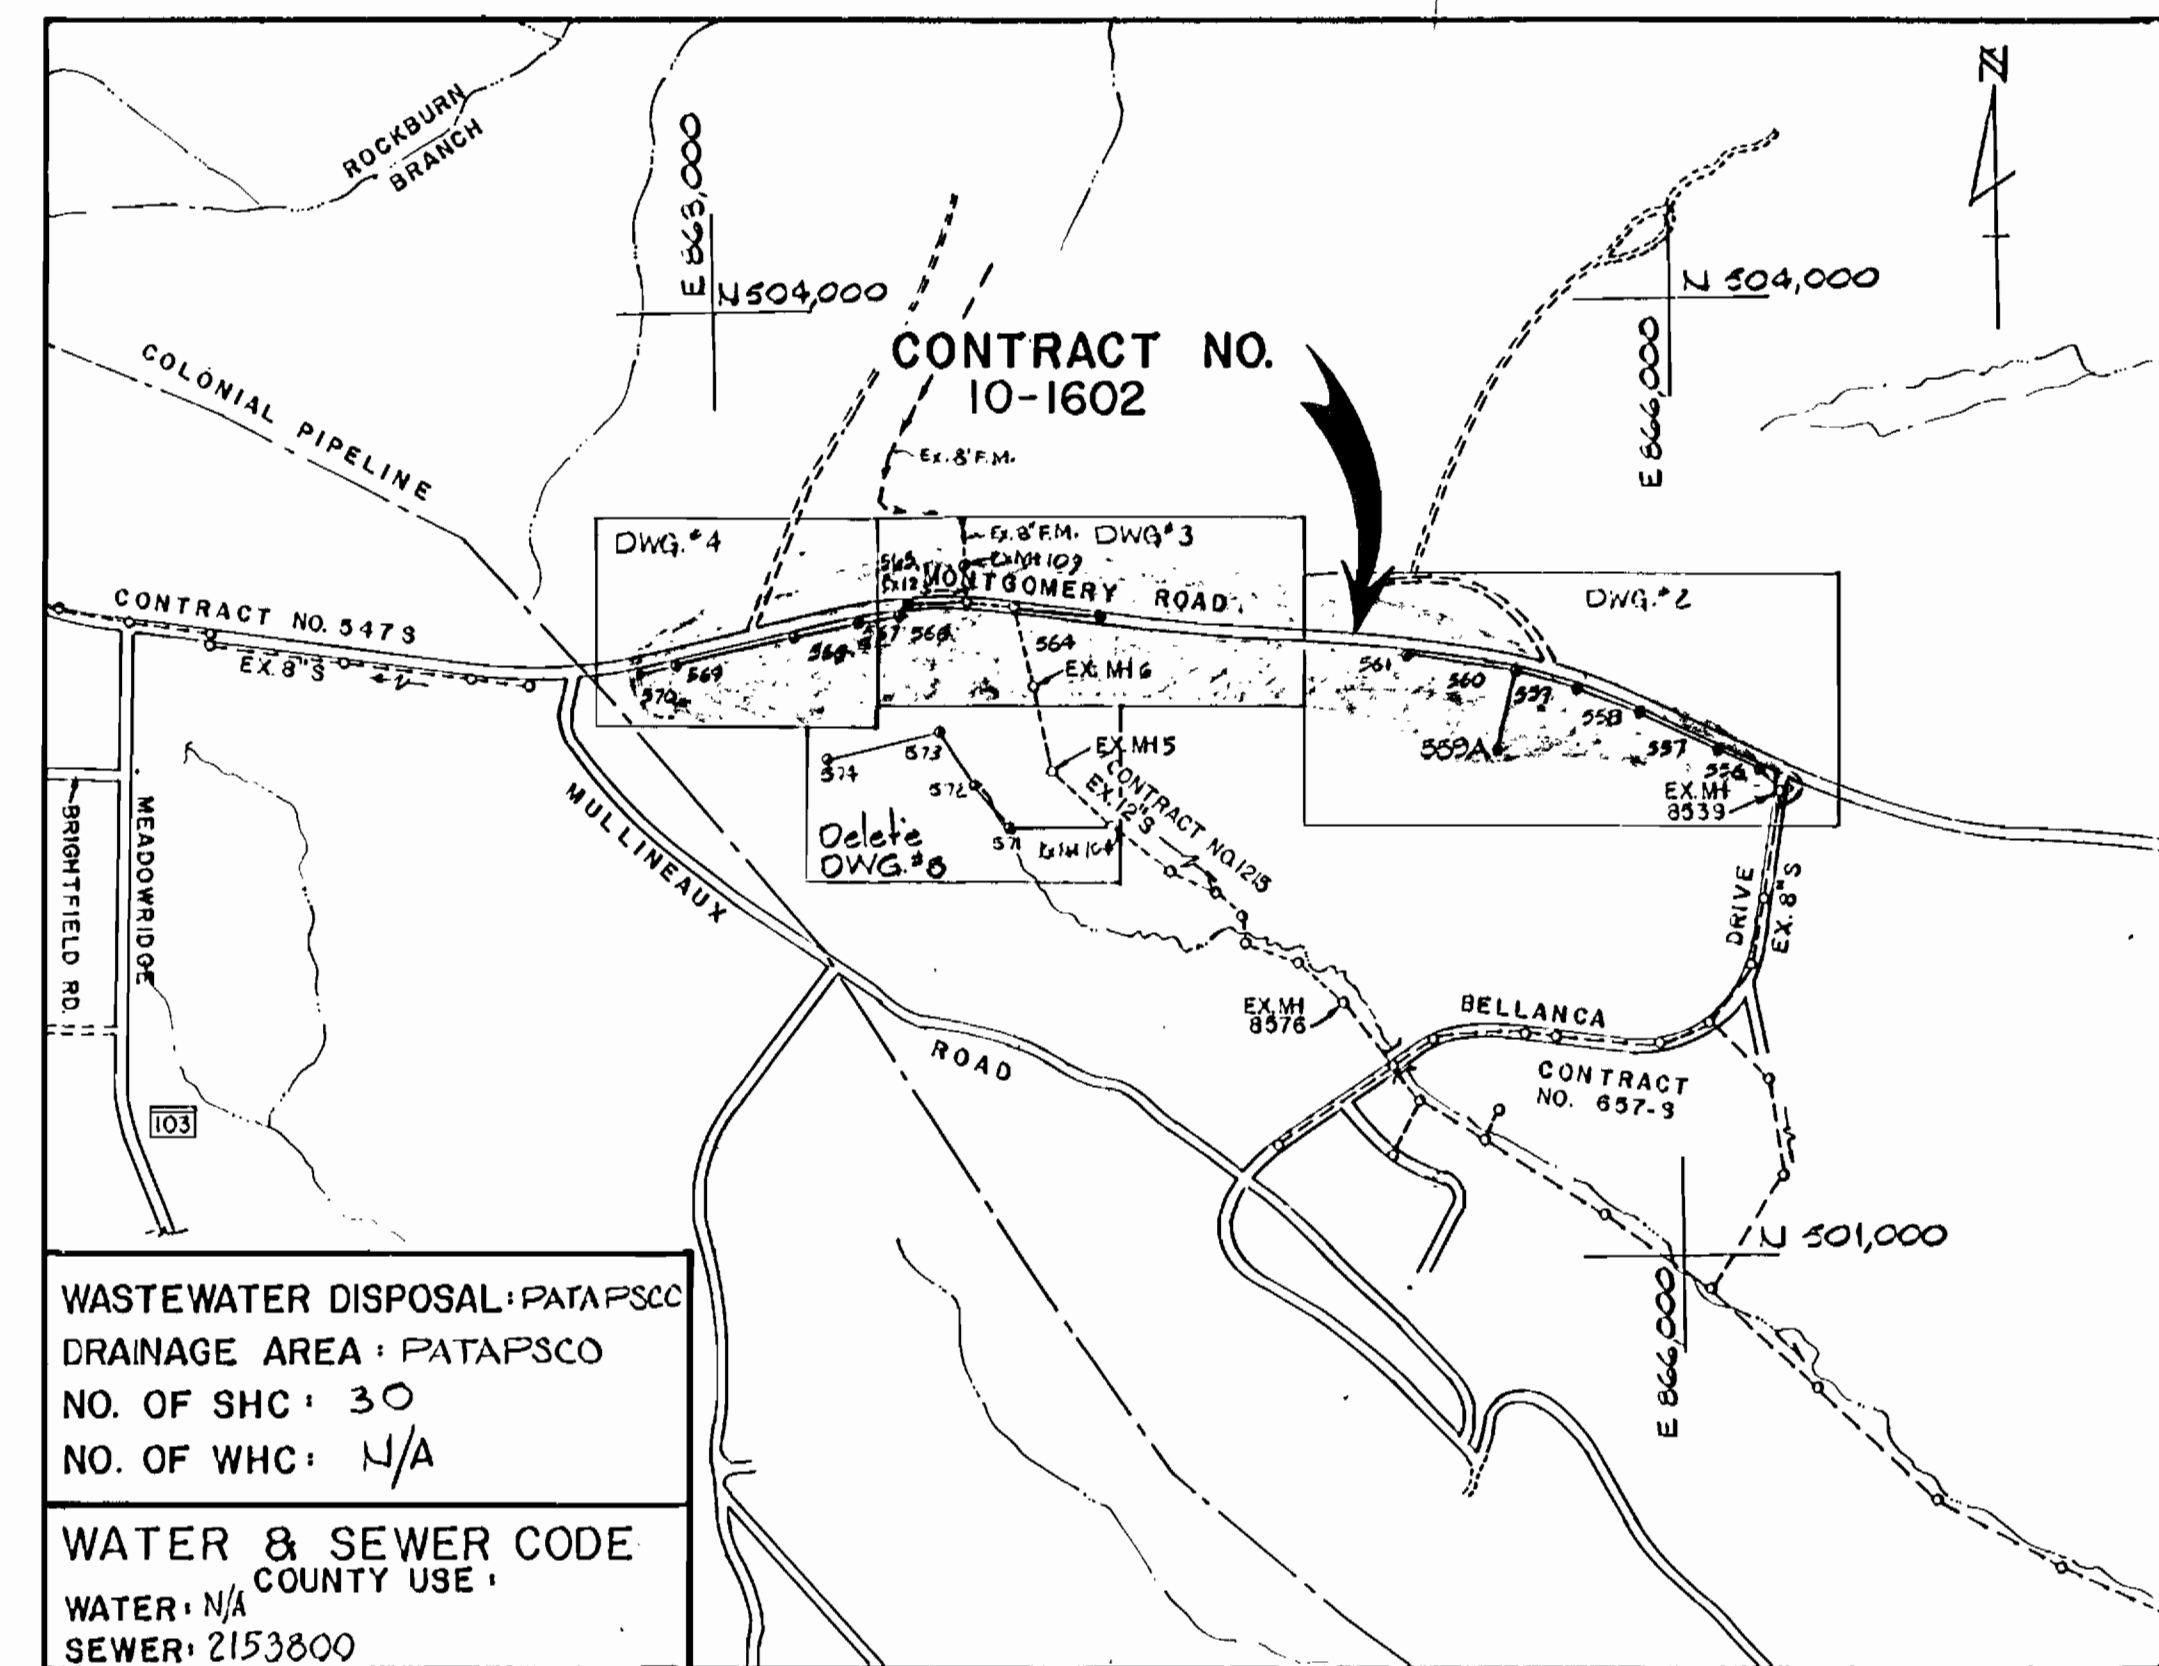

# CONTRACT NO. 10-1602

## MONTGOMERY ROAD SEWER MAIN

CAPITAL PROJECT NO. S-6147

### HOWARD COUNTY MARYLAND

### DEPARTMENT OF PUBLIC WORKS

VICINITY MAP  
SCALE: 1" = 600'

GENERAL NOTES

- APPROXIMATE LOCATION OF EXISTING MAINS ARE SHOWN. THE CONTRACTOR SHALL TAKE ALL NECESSARY PRECAUTIONS TO PROTECT EXISTING MAINS AND SERVICES AND MAINTAIN UNINTERRUPTED SUPPLY. ANY DAMAGE INCURRED SHALL BE REPAIRED IMMEDIATELY TO THE SATISFACTION OF THE ENGINEER, AT THE CONTRACTOR'S EXPENSE.
- ALL HORIZONTAL CONTROLS ARE BASED ON MARYLAND STATE COORDINATES.
- ALL VERTICAL CONTROLS ARE BASED ON U.S.G.S. DATUM.
- ALL PIPE ELEVATIONS SHOWN ARE INVERT ELEVATIONS.
- CLEAR ALL UTILITIES BY A MINIMUM OF 6". CLEAR ALL POLES BY 2'-0" MINIMUM OR TUNNEL AS REQUIRED.
- FOR DETAILS NOT SHOWN ON THE DRAWINGS, AND FOR MATERIALS AND CONSTRUCTION METHODS USE HOWARD COUNTY DESIGN MANUAL, VOLUME IV, STANDARD SPECIFICATIONS AND DETAILS FOR CONSTRUCTION. THE CONTRACTOR SHALL HAVE A COPY OF VOLUME IV ON THE JOB.
- WHERE TEST PITS HAVE BEEN MADE ON EXISTING UTILITIES, THEY ARE NOTED BY THE SYMBOL [ ] AT THE LOCATION OF THE TEST PIT. A NOTE OR NOTES CONTAINING THE RESULTS OF THE TEST PIT OR PITS IS INCLUDED ON THE DRAWINGS. EXISTING UTILITIES IN THE VICINITY OF THE PROPOSED WORK FOR WHICH TEST PITS HAVE BEEN DUG SHALL BE VERIFIED BY THE CONTRACTOR TO HIS OWN SATISFACTION. ANY DAMAGE TO EXISTING FACILITIES DUE TO THE CONTRACTOR'S NEGLIGENCE SHALL BE REPAIRED AT THE CONTRACTOR'S EXPENSE.
- CONTRACTOR SHALL NOTIFY THE FOLLOWING UTILITIES OR AGENCIES AT LEAST FIVE WORKING DAYS BEFORE STARTING WORK SHOWN ON THESE PLANS:
  - STATE HIGHWAY ADMINISTRATION - 531-5533
  - BALTIMORE GAS & ELECTRIC CO. - CONTRACTOR SERVICES - 850-4620
  - BALTIMORE GAS & ELECTRIC CO. - UNDER GROUND DAMAGE CONTROL - 859-9004
  - BALTIMORE GAS & ELECTRIC CO. - TROUBLE SHOOTING - 298-9001
  - MISS UTILITY - 1-800-257-7777
  - COLONIAL PIPELINE CO. - 795-1390
  - C&P TELEPHONE CO. - 1-800-257-7777
  - BUREAU OF UTILITIES, HOWARD COUNTY DEPARTMENT OF PUBLIC WORKS - 992-2366
- TREES AND SHRUBS ARE TO BE PROTECTED FROM DAMAGE TO MAXIMUM EXTENT. TREES AND SHRUBS LOCATED WITHIN THE CONSTRUCTION STRIP ARE NOT TO BE REMOVED OR DAMAGED BY THE CONTRACTOR.
- CONTRACTOR SHALL REMOVE TREES, STUMPS AND ROOTS ALONG LINE OF EXCAVATION.
- ALL SEWER MAINS SHALL BE C.S.P.X., D.I.P., V.C.P.X. OR P.V.C. UNLESS OTHERWISE NOTED.
- THE CONTRACTOR SHALL PROVIDE A JOINT IN ALL SEWER MAINS WITHIN 2'-0" OF EXTERIOR MANHOLE WALL.
- ALL MANHOLES SHALL BE 4'-0" INSIDE DIAMETER UNLESS OTHERWISE NOTED.
- MANHOLES SHOWN WITH 12" AND 16" WALLS ARE FOR BRICK MANHOLES ONLY.
- MANHOLES DESIGNATED W.T. IN PLAN AND PROFILE SHALL HAVE WATERTIGHT FRAME AND COVERS, STANDARD DETAIL 05.52. WHERE WATERTIGHT MANHOLE FRAME AND COVER IS USED, SET TOP OF FRAME 1.5' ABOVE FINISHED GRADE UNLESS OTHERWISE NOTED ON THE DRAWINGS.
- STRAW BALE DIKE AND SILT FENCE ARE INTERCHANGEABLE.
- FOR MANHOLES IN OPEN SPACE OR OUTFALL, SET TOP OF FRAME 1.5' ABOVE FINISHED GRADE UNLESS OTHERWISE NOTED ON THE DRAWINGS.

REVIEWED FOR HOWARD CONSERVATION DISTRICT AND MEETS TECHNICAL REQUIREMENTS  
 Signature: *James M. DeVal* DATE: 11-29-88  
 US. SOIL CONSERVATION SERVICE  
 This Development Plan is approved for Soil Erosion and Sediment Control by the Howard County Conservation District  
 APPROVED  
 Signature: *Stephen L. Eshen* DATE: 11/29/88  
 HOWARD SCD

Sediment Control Measures for this Contract will be implemented in accordance with Section 219 of the Standard Specifications

DEPARTMENT OF PUBLIC WORKS  
 HOWARD COUNTY, MARYLAND  
 Signature: *Robert M. Beaman* DATE: 12-1-89  
 DIRECTOR OF PUBLIC WORKS - DATE  
 Signature: *Debra L. Lewis* DATE: 11-29-88  
 CHIEF - BUREAU OF ENGINEERING - DATE  
 Signature: *Debra L. Lewis* DATE: 11-29-88  
 CHIEF - UTILITY DESIGN DIVISION - DATE

WHITMAN, REQUARDT AND ASSOCIATES ENGINEERS  
 2315 ST. PAUL ST. BALTIMORE, MARYLAND  
 Signature: *Robert M. Beaman* DATE: 12-1-89  
 Signature: *Debra L. Lewis* DATE: 11-29-88

DES: BJ			
DRN: C.B			
CHK: RBN			
DATE: 8/24/88	BY: DMD	NO. 1	DATE: 8/11/89

VICINITY MAP AND GENERAL NOTES  
 87-502-8045 CAPITAL PROJECT S-6147  
 600' SCALE MAP NO. 37 BLOCK NO.

MONTGOMERY ROAD SEWER MAIN  
 ELECTION DISTRICT NO. 1  
 HOWARD COUNTY  
 CONTRACT NO. 10-1602



SCALE AS SHOWN  
 SHEET 1 OF 5

**BENCH MARKS**

WR&A B.M. #100 El. 370.35  
Front Flange Bolt of F.H., 0'  
ahead of P.I.M. 2603, 3' Left  
of traverse.

WR&A B.M. #200 El. 397.61  
Roadside Flange Bolt of F.H.,  
70' (?) ahead of P.I.M. 2604,  
7' to right of traverse.

HOWARD CO., MD.  
# G145 P. 235  
735/205

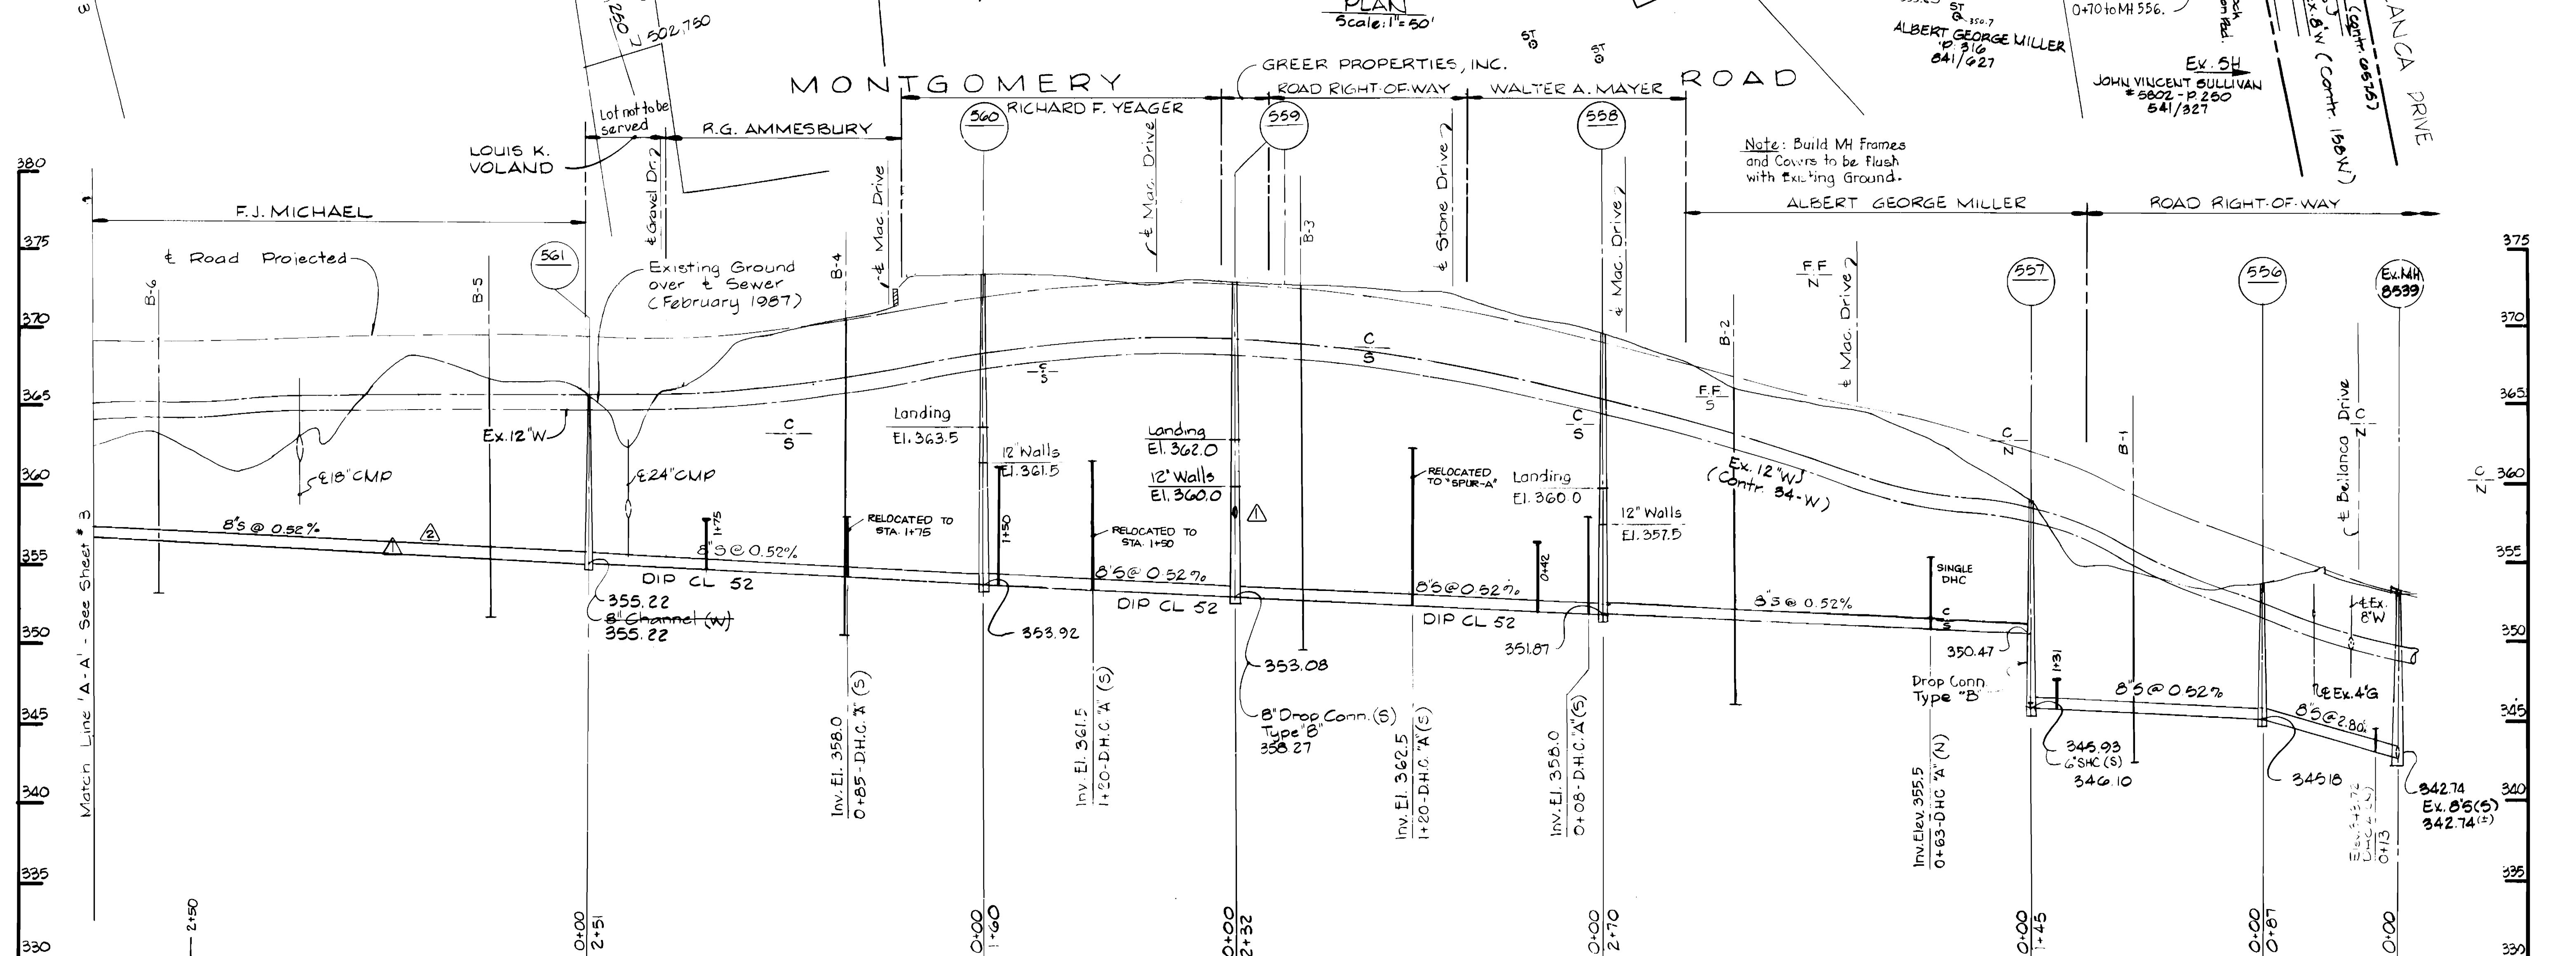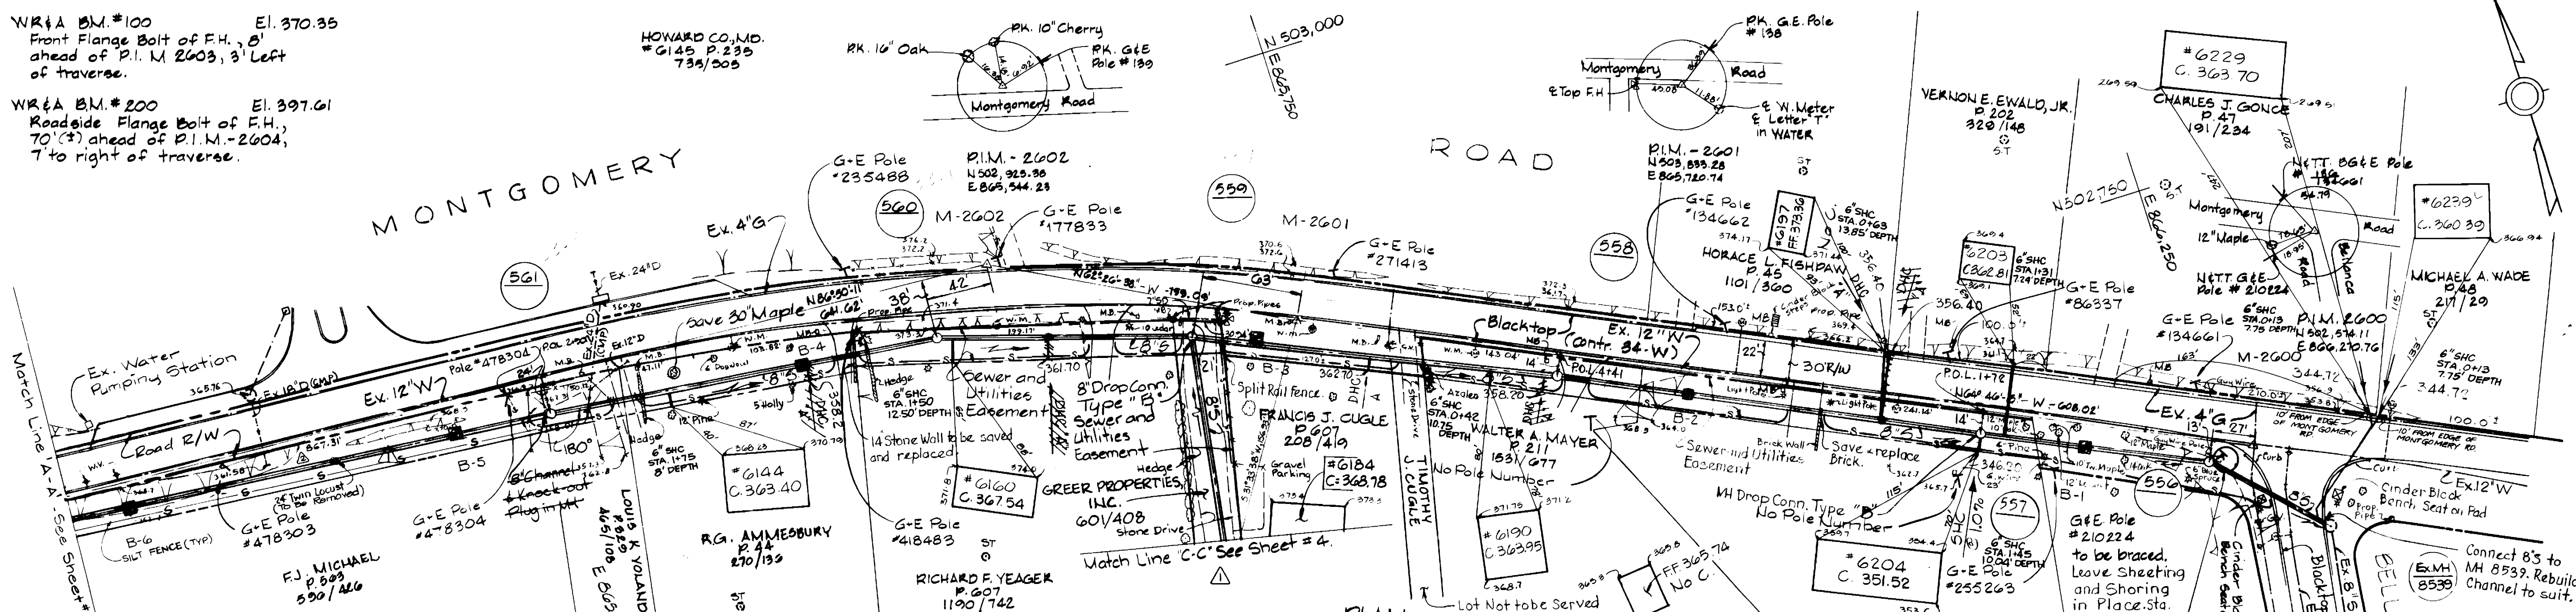

**PROFILE** Scale: Horizontal: 1" = 50' Vertical: 1" = 5'

37-502-866  
37-502-867  
**CAPITAL PROJECT S-6147**

DEPARTMENT OF PUBLIC WORKS  
HOWARD COUNTY, MARYLAND

DIRECTOR OF PUBLIC WORKS - DATE  
*Robert Reimer* 12-1-88

CHIEF - BUREAU OF UTILITIES - DATE

WHITMAN, REQUARDT  
AND ASSOCIATES  
ENGINEERS

2315 ST PAUL ST  
BALTIMORE, MARYLAND

CHIEF - BUREAU OF ENGINEERING - DATE  
*Robert Reimer* 11-29-88

CHIEF - UTILITY DESIGN DIVISION DATE

DES. S.J.					
DRN. Q.D.N.					
CHK. R.P.N.	TEB	REVISED ALIGNMENT (ADDITIONAL 313 LF OF B'S)	11-15-88		
DATE 8/24/88	DMD	Revised Alignment	11/1/88		
BY NO		REVISION	DATE		

**PLAN & PROFILE  
OF SEWER MAIN**

600' SCALE MAP NO. 37 BLOCK NO. 4 x 5

**MONTGOMERY ROAD SEWER MAIN**


ELECTION DISTRICT NO. 1

HOWARD COUNTY  
CONTRACT NO. 10-1602

SCALE AS SHOWN

SHEET 2 OF 5




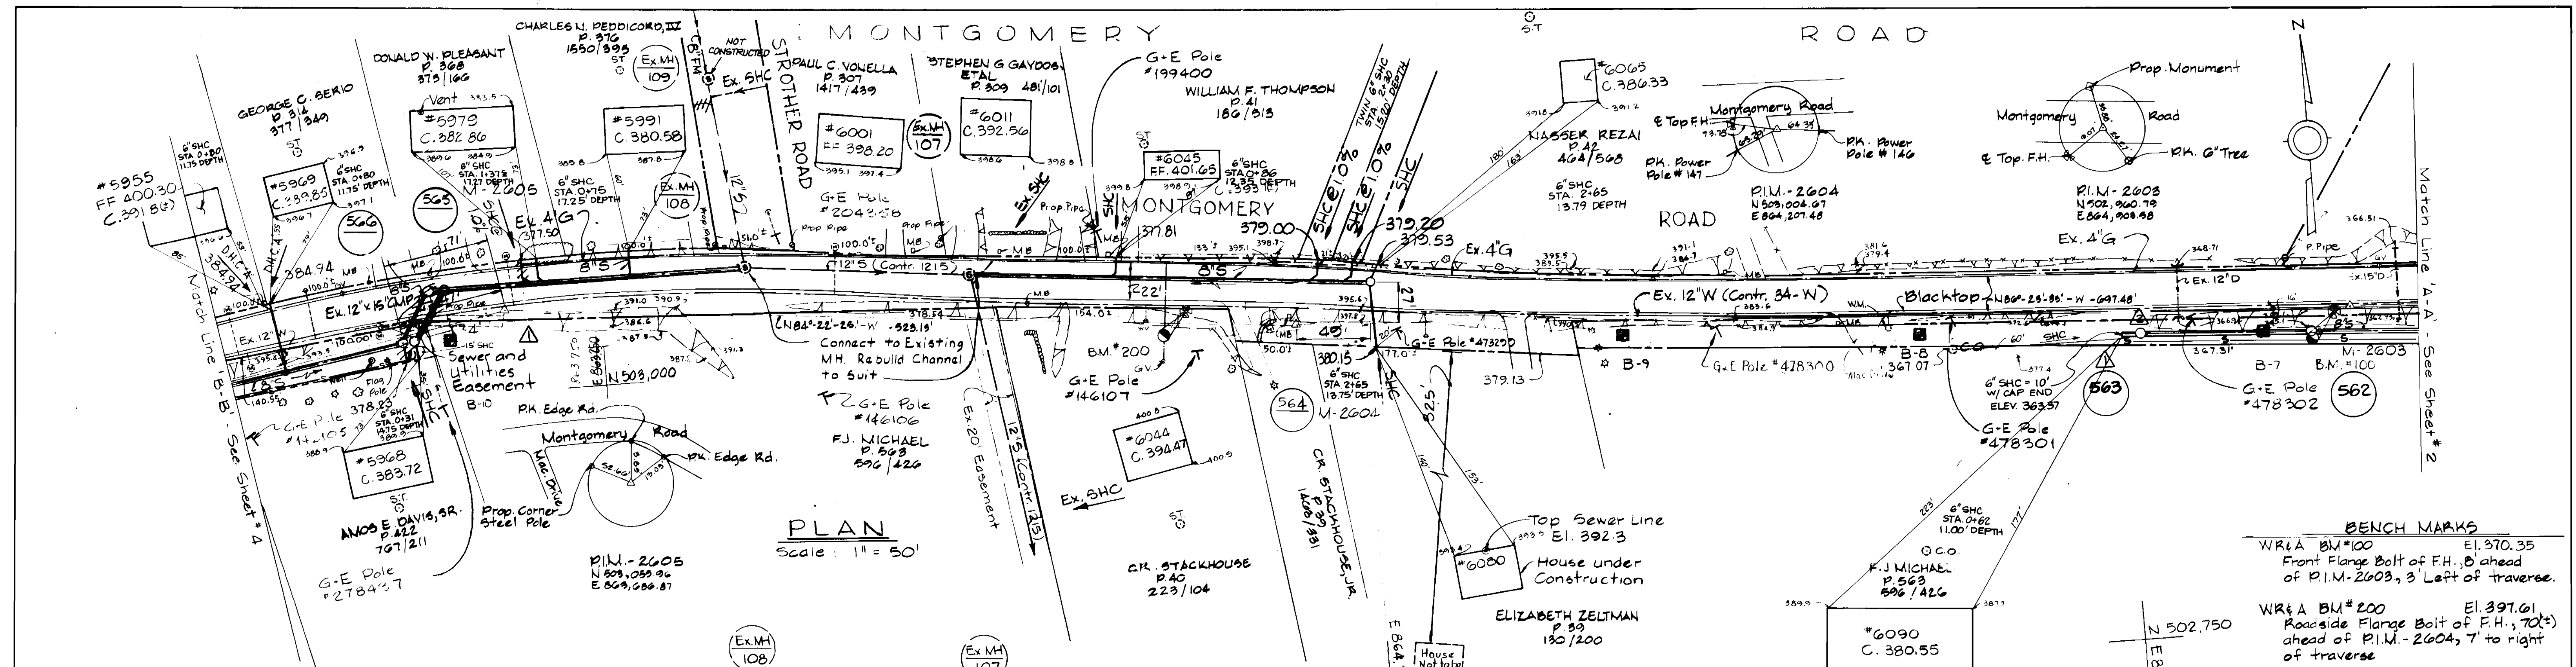

PLAN  
Scale: 1" = 50'

**BENCH MARKS**  
 WR & A BM #100 El. 370.35  
 Front Flange Bolt of F.H. #8 ahead of P.I.M.-2603, 3' left of traverse.  
 WR & A BM #200 El. 397.01  
 Roadside Flange Bolt of F.H. #70 ahead of P.I.M.-2604, 7' to right of traverse

**MANHOLE STAKEOUT**  
 MH 563 - FROM TP M2604 TO TP M2603 560 FT., 17 FT. RT.  
 MH 562 - FROM TP M2604 TO TP M2603 675 FT., 16 FT. RT.

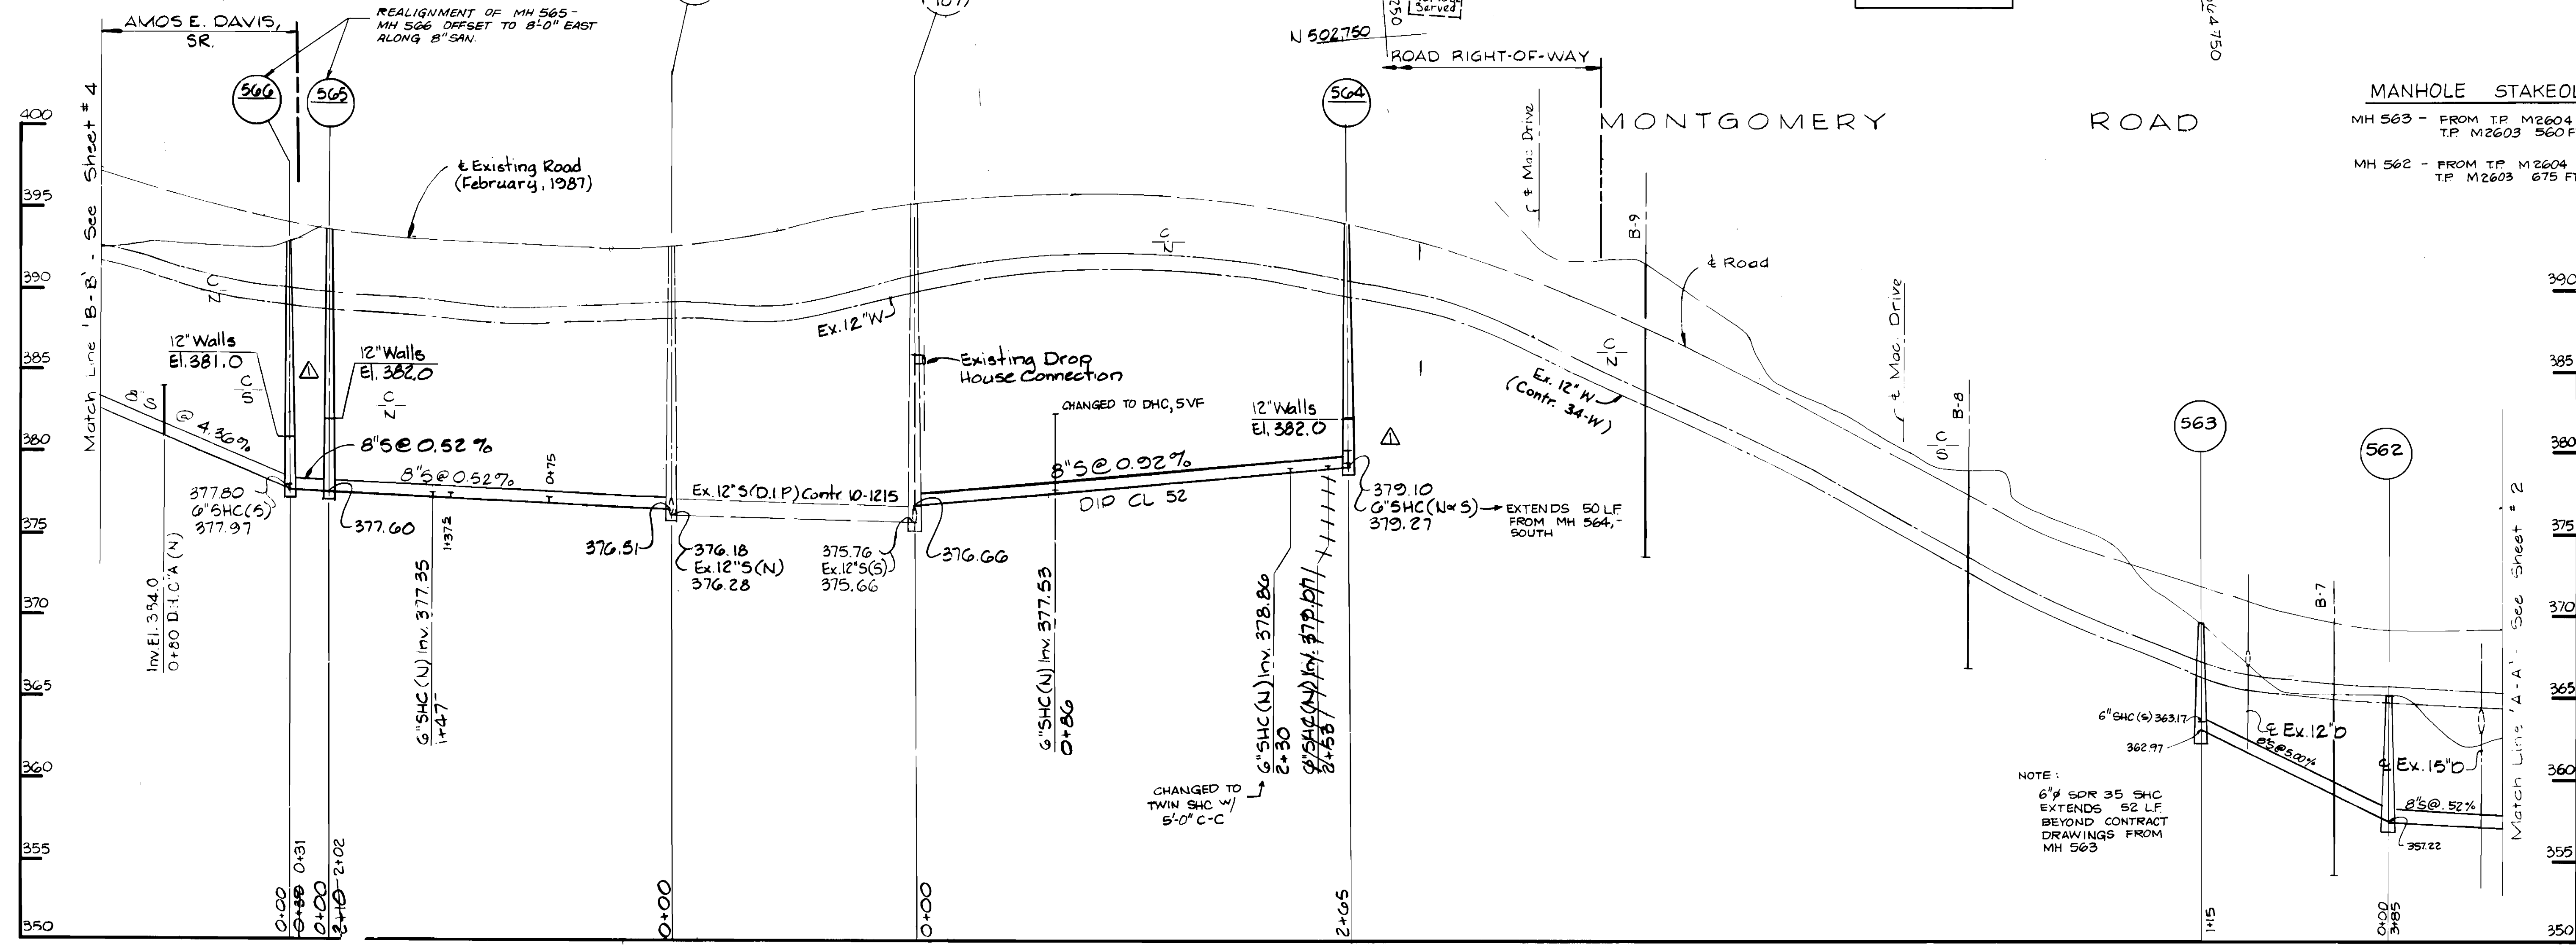

PROFILE  
 Scale: Horizontal: 1" = 50'  
 Vertical: 1" = 5'

NOTE:  
 6" SDR 35 SHC EXTENDS 52 LF BEYOND CONTRACT DRAWINGS FROM MH 563

DEPARTMENT OF PUBLIC WORKS  
 HOWARD COUNTY, MARYLAND  
 DIRECTOR OF PUBLIC WORKS  
 DATE 12-19-88  
 CHIEF - BUREAU OF UTILITIES - DATE

WHITMAN, REQUARDT AND ASSOCIATES ENGINEERS  
 2315 ST. PAUL ST. BALTIMORE, MARYLAND





DES: S.J.					
DRN: Q.D.N.					
CHK: R.B.N.	TEB	REVISED ALIGNMENT (185 LF OF 85 ADDITIONAL)	11/15/88		
DATE: 8/24/88	DMD	Revised Alignment	4/11/89		
BY: NO.		REVISION	DATE		

PLAN & PROFILE OF SEWER MAIN  
 600' SCALE MAP NO. 37 BLOCK NO. 4

CAPITAL PROJECT S-6147  
 MONTGOMERY ROAD SEWER MAIN  
 ELECTION DISTRICT NO. 1  
 HOWARD COUNTY  
 CONTRACT NO. 10-1602

SCALE AS SHOWN  
 SHEET 3 OF 5

**BENCH MARKS**  
 WR&A BM #300 El. 402.49  
 Roadside Flange Bolt of F.H.  
 @ Sta. 2+95, 6' to right of  
 Traverse between M-2605 & M-2606.  
 WR&A BM #400 El. 420.83  
 Roadside Flange Bolt of F.H.  
 @ Sta. 0+45, 10' to right of  
 Traverse between M-2607 &  
 M-2608.

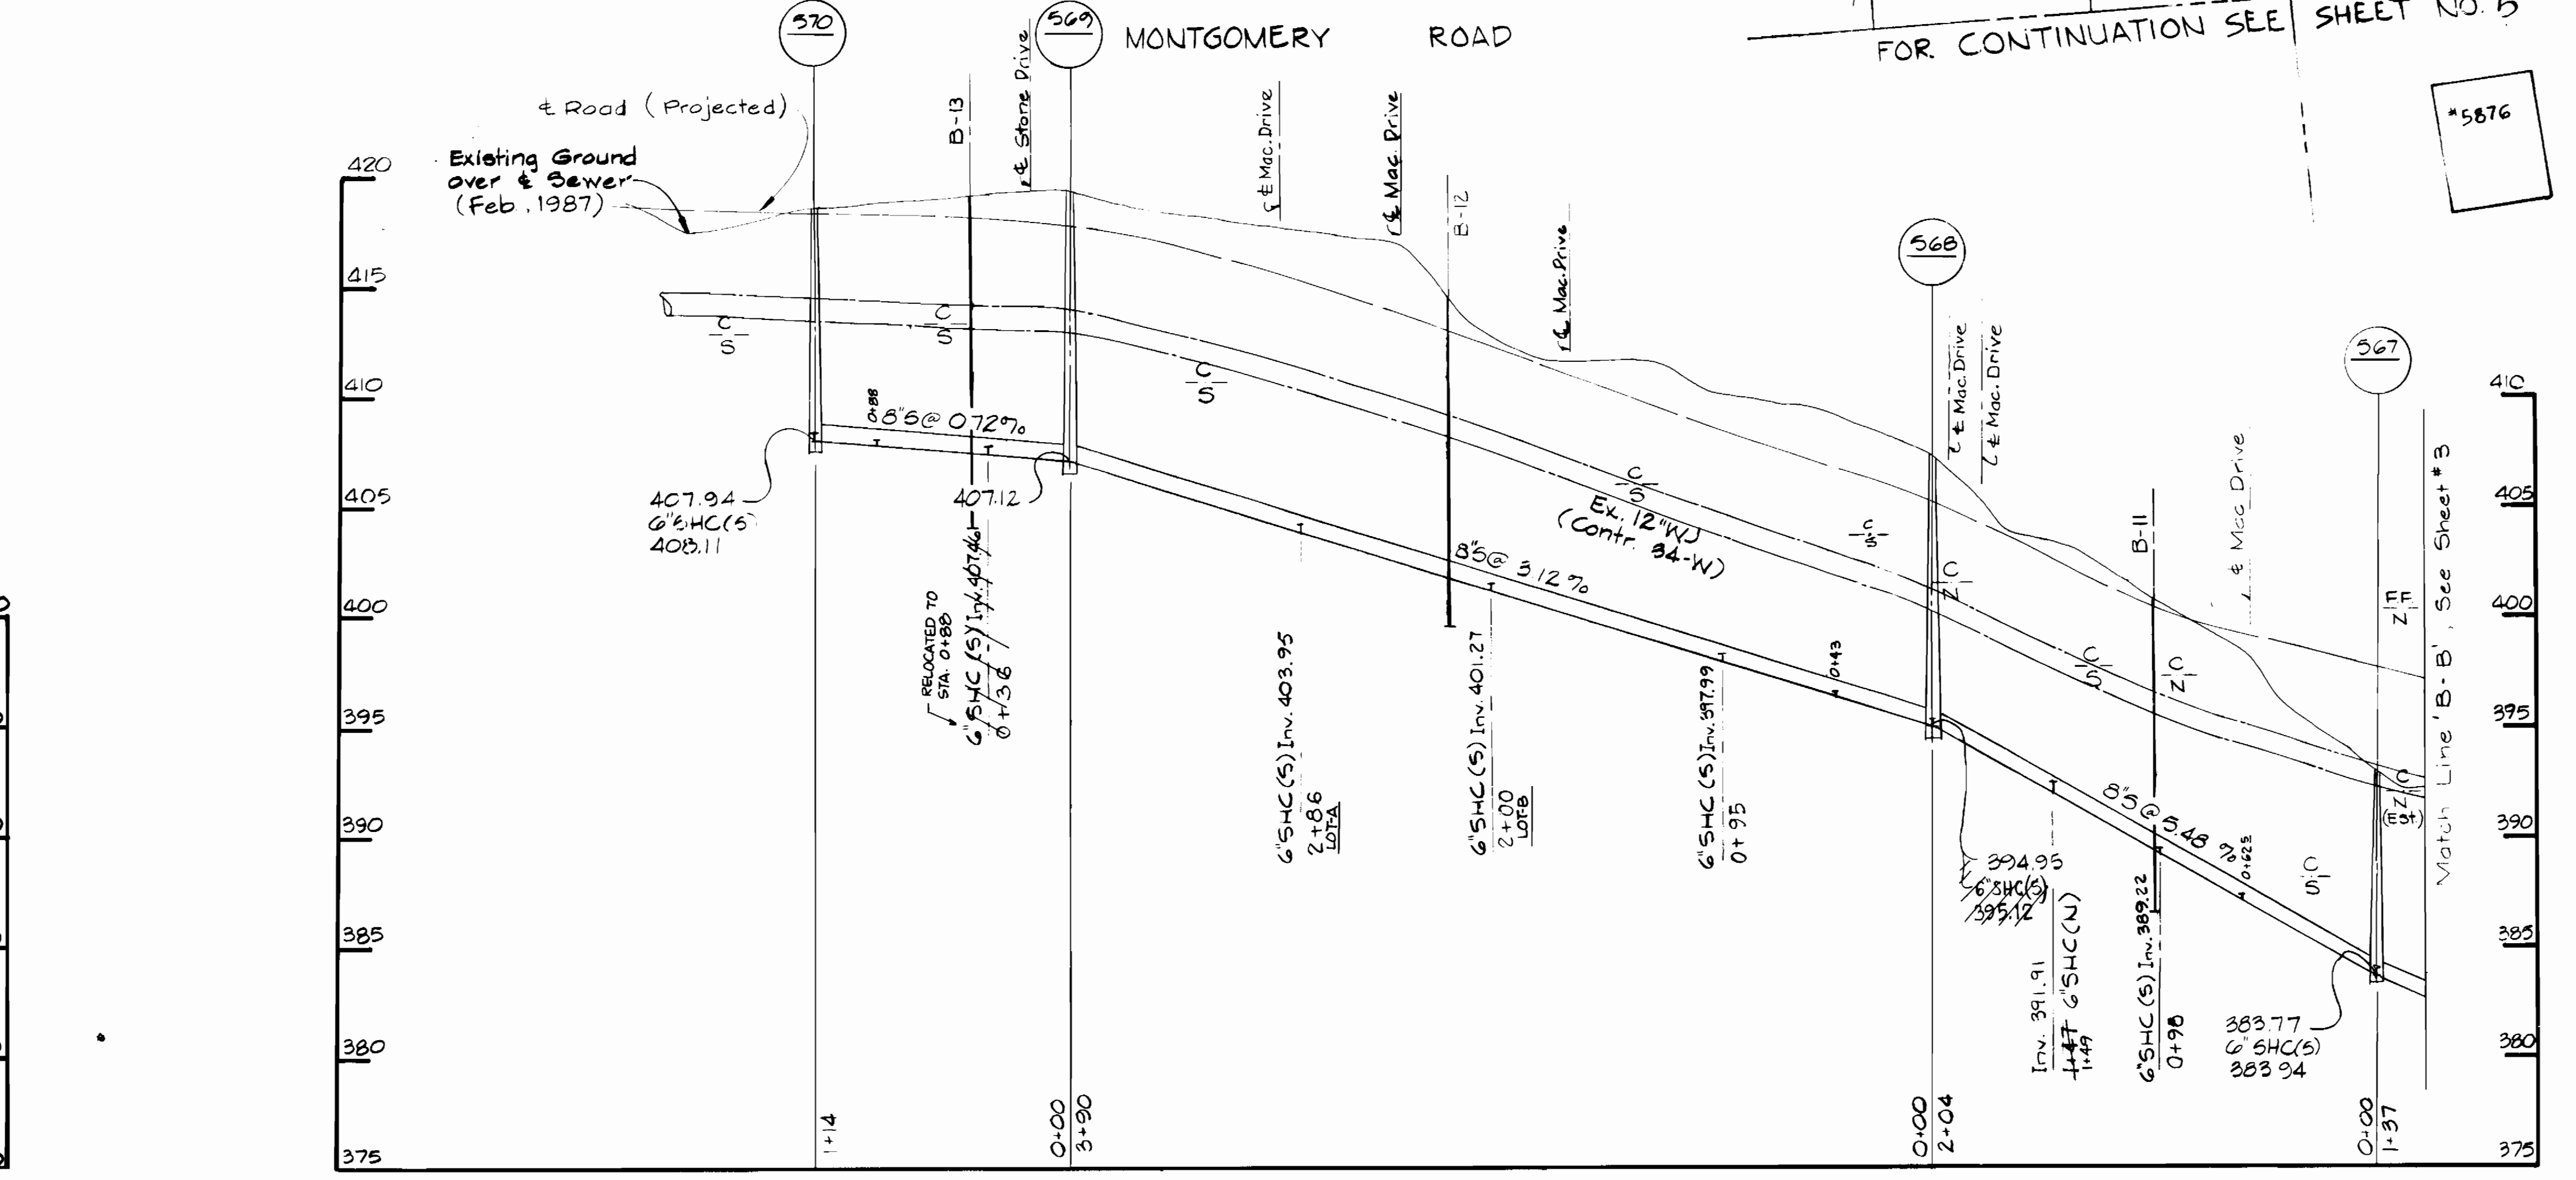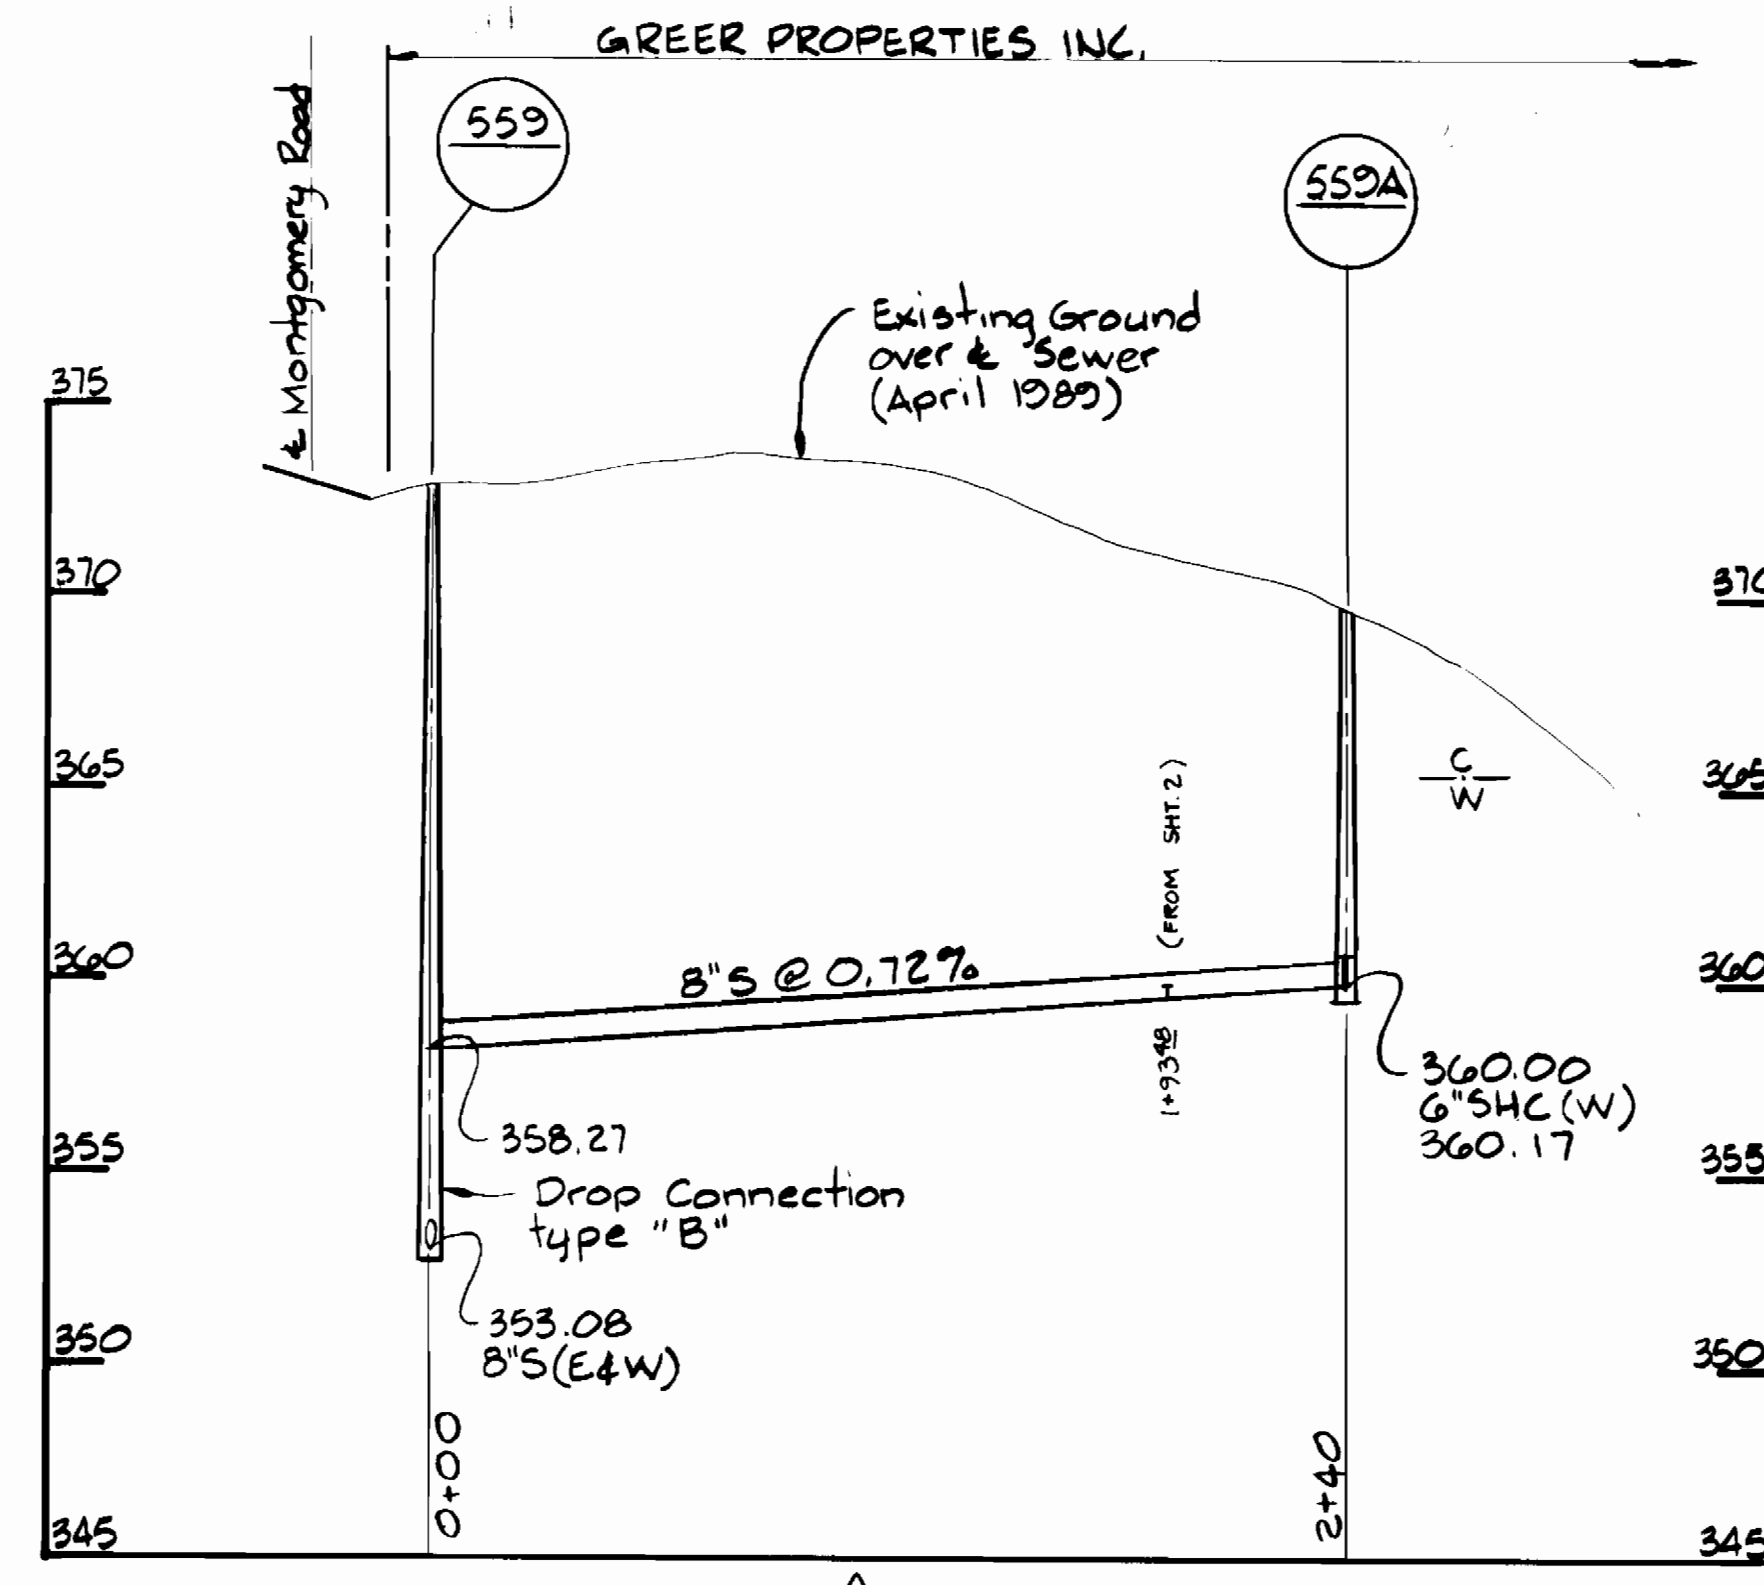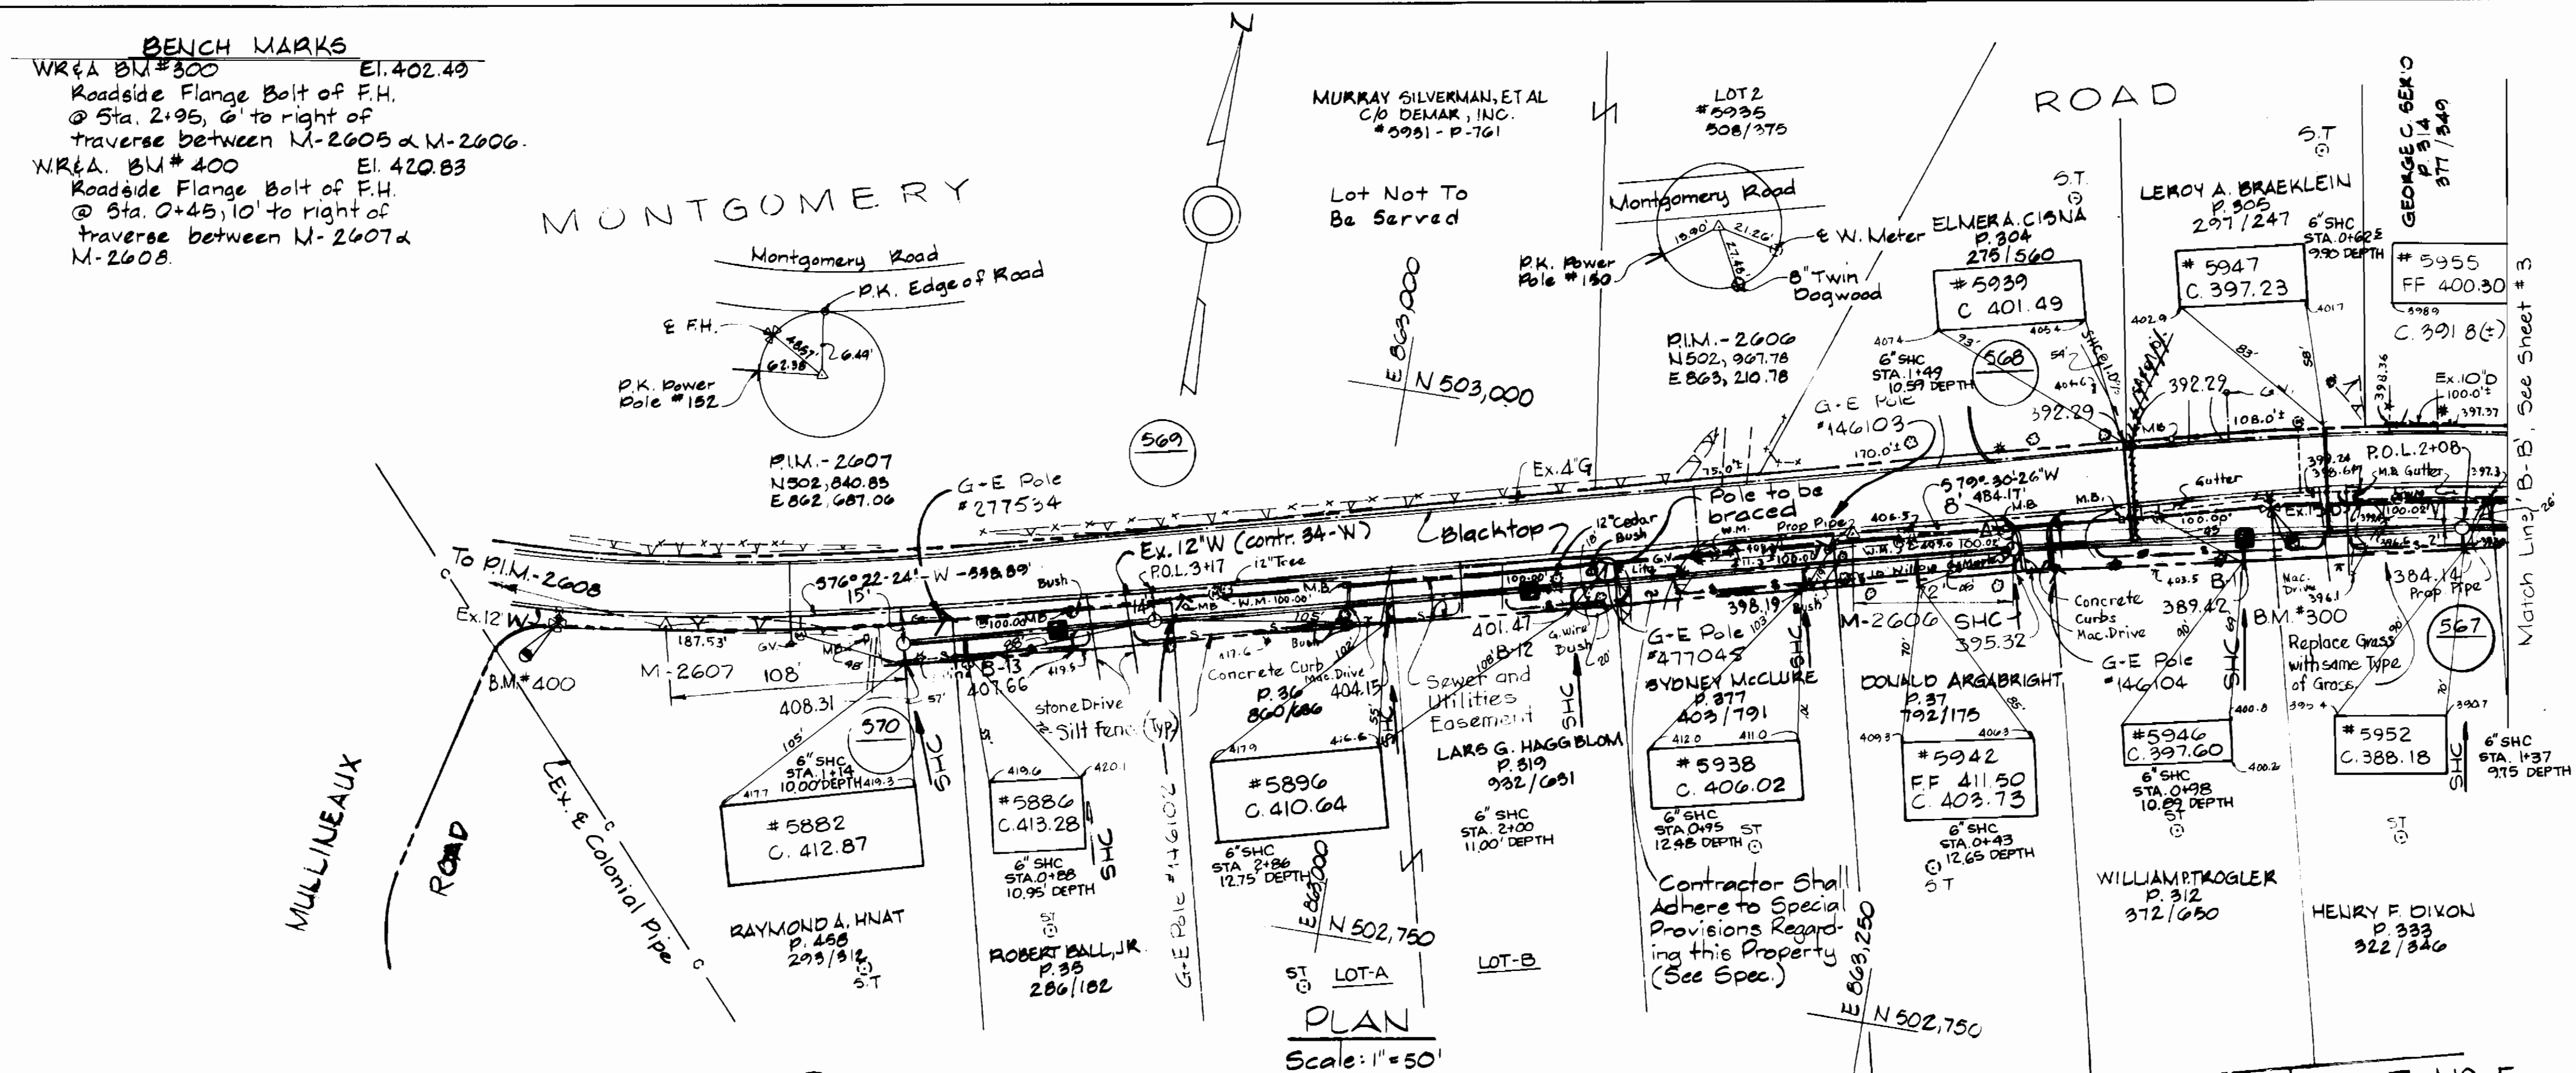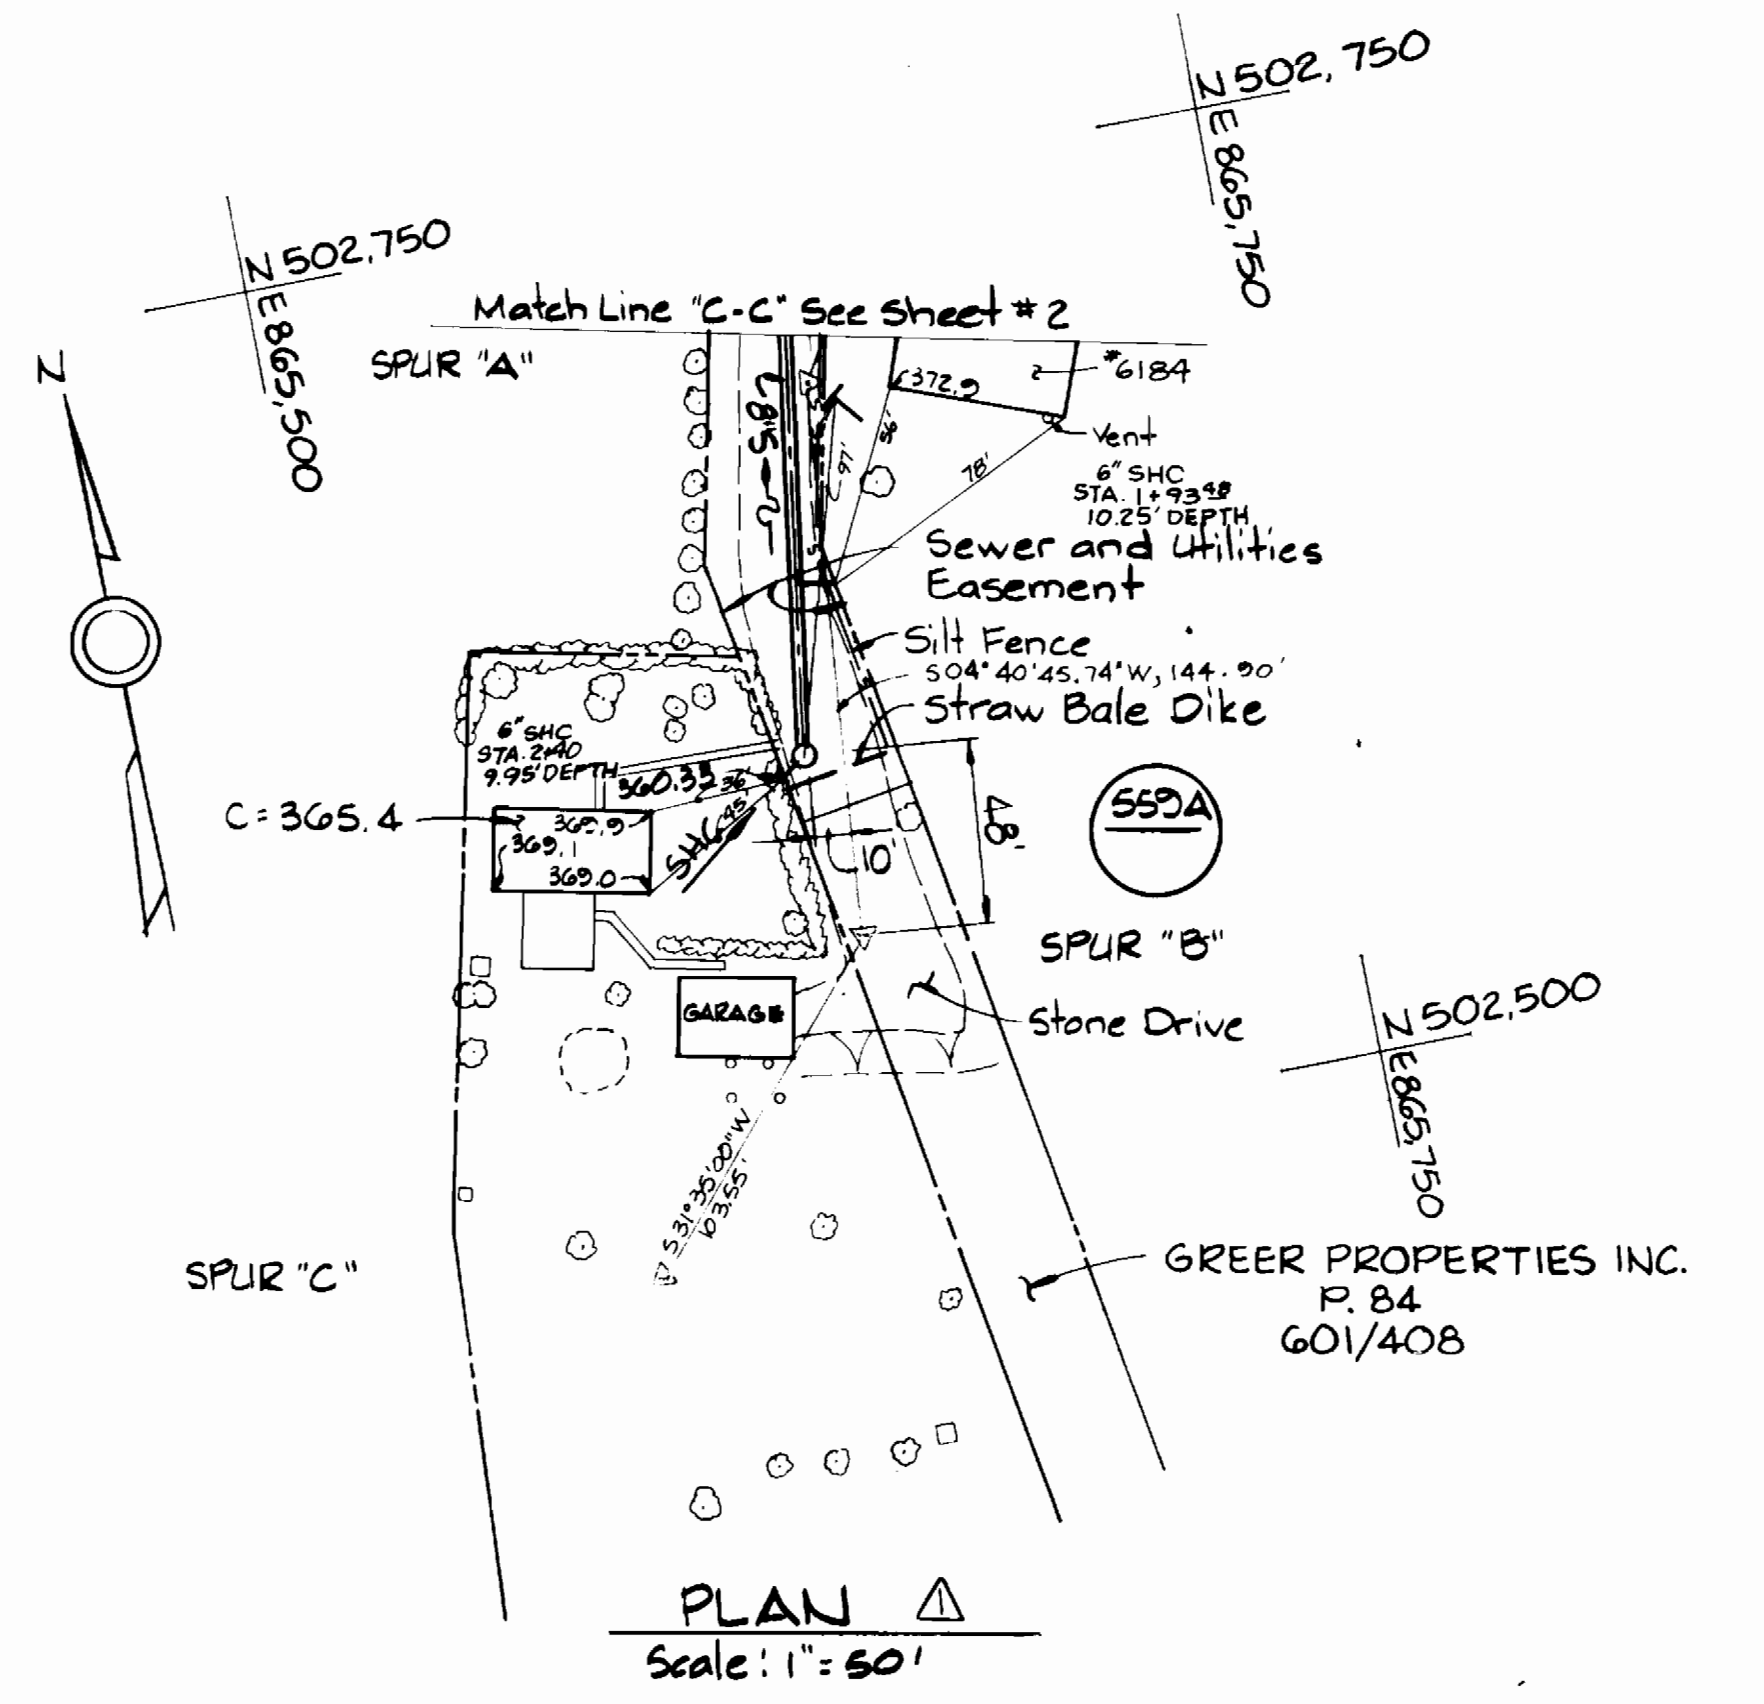

BRUNING 44 132 691 50

DEPARTMENT OF PUBLIC WORKS  
 HOWARD COUNTY, MARYLAND  
 Director of Public Works  
 Chief, Bureau of Engineering  
 Chief, Bureau of Utilities - Date

WHITMAN, REQUARDT  
 AND ASSOCIATES  
 ENGINEERS  
 2315 ST. PAUL ST.  
 BALTIMORE, MARYLAND

DES: S.J.			
DRN: Q.D.N			
CHK: R.B.N.			
DATE: 8/24/88			
DMD Added Plan & Profile			
BY	NO.	REVISION	DATE

PLAN & PROFILE  
 OF SEWER MAIN  
 600' SCALE MAP NO. 37 BLOCK NO. 3-4

MONTGOMERY ROAD SEWER MAIN  
 ELECTION DISTRICT NO. 1  
 HOWARD COUNTY  
 CONTRACT NO. 10-1602

SCALE AS SHOWN  
 SHEET 4 OF 5







### STRAW BALE DIKE

**STANDARD SYMBOL**  
SBD

**CONSTRUCTION SPECIFICATIONS**

- BALES SHALL BE PLACED AT THE TOE OF A SLOPE OR ON THE CONTOUR AND IN A ROW WITH ENDS TIGHTLY ADJUTING THE ADJACENT BALES.
- EACH BALE SHALL BE EMBEDDED IN THE SOIL A MINIMUM OF (4) INCHES, AND PLACED SO THE BINDINGS ARE HORIZONTAL.
- BALES SHALL BE SECURELY ANCHORED IN PLACE BY EITHER TWO STAKES OR RE-BARS DRIVEN THROUGH THE BALE. THE FIRST STAKE IN EACH BALE SHALL BE DRIVEN TOWARD THE PREVIOUSLY LAID BALE AT AN ANGLE TO FORCE THE BALES TOGETHER. STAKES SHALL BE DRIVEN FLUSH WITH THE BALE.
- INSPECTION SHALL BE FREQUENT AND REPAIR REPLACEMENT SHALL BE MADE PROMPTLY AS NEEDED.
- BALES SHALL BE REMOVED WHEN THEY HAVE SERVED THEIR USEFULNESS SO AS NOT TO BLOCK OR IMPED EARTH FLOW OR DRAINAGE.

U.S. DEPARTMENT OF AGRICULTURE  
SOIL CONSERVATION SERVICE  
COLLEGE PARK, MARYLAND

STRAW BALE DIKE

STANDARD DRAWING  
SBD-1

### EARTH DIKE

not to scale

**CONSTRUCTION SPECIFICATIONS**

- ALL DIKES SHALL BE COMPACTED BY EARTH-MOVING EQUIPMENT.
- ALL DIKES SHALL HAVE POSITIVE DRAINAGE TO AN OUTLET.
- TOP WIDTH MAY BE WIDER AND SIDE SLOPES MAY BE FLATTER IF DESIRED TO FACILITATE CROSSING BY CONSTRUCTION TRAFFIC.
- FIELD LOCATION SHOULD BE ADJUSTED AS NEEDED TO UTILIZE A STABILIZED SAFE OUTLET.
- DIKES SHALL HAVE AN OUTLET THAT FUNCTIONS WITH A MINIMUM OF EROSION. FLOOD BASIN WHERE EITHER THE DIKE CHANNEL OR THE DRAINAGE AREA ABOVE THE DIKE ARE NOT ADEQUATELY STABILIZED.
- STABILIZATION SHALL BE: (A) IN ACCORDANCE WITH STANDARD SPECIFICATIONS FOR SEED AND STRAW MULCH OR STRAW MULCH IF NOT IN SEEDING SEASON; (B) FLOW CHANNEL AS PER THE CHART BELOW.

TYPE OF TREATMENT	CHANNEL SLOPE	DIKE A	DIKE B
1	5-3.0%	SEED AND STRAW MULCH	SEED AND STRAW MULCH
2	3.1-5.0%	SEED AND STRAW MULCH	SEED USING JUTE, OR EXCELISUR, SOD; 2" STONE
3	5.1-8.0%	SEED WITH JUTE, OR SOD; 2" STONE	LINED RIP-RAP 4-8"
4	8.1-20%	LINED RIP-RAP 4-8"	ENGINEERING DESIGN

U.S. DEPARTMENT OF AGRICULTURE  
SOIL CONSERVATION SERVICE  
COLLEGE PARK, MARYLAND

EARTH DIKE

STANDARD DRAWING  
ED-1

### TEMPORARY ACCESS CULVERT

**CONSTRUCTION SPECIFICATIONS**

- Restrictions** - No construction or removal of a temporary access culvert will be permitted between October 1 through April 30 for all Class III and Class IV Trout Waters or between March 15 through June 15 for non-trout waterways.
- Culvert Strength** - All culverts shall be strong enough to support their cross sectional area under maximum expected loads.
- Culvert Size** - The size of the culvert pipe shall be the largest pipe diameter that will fit into the existing channel without major excavation of the waterway channel or without major approach fills. If a channel width exceeds 3 feet, additional pipes may be used until the cross sectional area of the pipes is greater than 60 percent of the cross sectional area of the existing channel. The minimum size culvert that may be used is a 12" diameter pipe.
- Culvert Length** - The culvert(s) shall extend a minimum of one foot beyond the upstream and downstream toe of the aggregate placed around the culvert. In no case shall the culvert exceed 40 feet in length.
- Filter Cloth** - Filter cloth shall be placed on the streambed and streambanks prior to placement of the pipe culvert(s) and aggregate. The filter cloth shall cover the streambed and extend a minimum six inches and a maximum one foot beyond the end of the culvert and bedding material. Filter cloth reduces settlement and improves crossing stability.
- Culvert Placement** - The invert elevation of the culvert shall be installed on the natural streambed grade to minimize interference with fish migration (free passage of fish).
- Culvert Protection** - The culvert(s) shall be covered with a minimum of one foot of aggregate. If multiple culverts are used they shall be separated by at least 12" of compacted aggregate fill. At a minimum, the bedding and fill material used in the construction of the temporary access culvert crossings shall conform with the aggregate requirements cited in Section I.H. 1. above.
- Stabilization** - All areas disturbed during culvert installation shall be stabilized within 14 calendar days of the disturbance in accordance with the Standard for "Critical Area Stabilization With Permanent Seeding."

U.S. DEPARTMENT OF AGRICULTURE  
SOIL CONSERVATION SERVICE  
COLLEGE PARK, MARYLAND

TEMPORARY ACCESS CULVERT

STANDARD DRAWING  
ED-1

### SILT FENCE

**CONSTRUCTION NOTES FOR FABRICATED SILT FENCE**

- WOVEN WIRE FENCE TO BE FASTENED SECURELY TO FENCE POSTS WITH WIRE TIES OR STAPLES.
- FILTER CLOTH TO BE FASTENED SECURELY TO WOVEN WIRE FENCE WITH TIES SPACED EVERY 24" AT TOP AND MID SECTION.
- WHEN TWO SECTIONS OF FILTER CLOTH ADJOIN EACH OTHER THEY SHALL BE OVERLAPPED BY SIX INCHES AND FOLDED.
- MAINTENANCE SHALL BE PERFORMED AS NEEDED AND MATERIAL REMOVED WHEN "MUDGES" DEVELOP IN THE SILT FENCE.

U.S. DEPARTMENT OF AGRICULTURE  
SOIL CONSERVATION SERVICE  
COLLEGE PARK, MARYLAND

SILT FENCE

STANDARD DRAWING  
SF-1

### STABILIZED CONSTRUCTION ENTRANCE

not to scale

**CONSTRUCTION SPECIFICATIONS**

- Stone Size - Use 2" stone, or reclaimed or recycled concrete equivalent.
- Length - As required, but not less than 50 feet (except on a single residence lot where a 30 foot minimum length would apply).
- Thickness - Not less than six (6) inches.
- Width - Ten (10) foot minimum, but not less than the full width at points where ingress or egress occurs.
- Filter Cloth - Will be placed over the entire area prior to placing of stone. Filter will not be required on a single family residence lot.
- Surface Water - All surface water flowing or diverted toward construction entrance shall be piped across the entrance. If piping is impractical, a mountable berm with 5:1 slopes will be permitted.
- Maintenance - The entrance shall be maintained in a condition which will prevent tracking or flowing of sediment onto public rights-of-way. This may require periodic top dressing with additional stone as conditions demand and repair and/or cleanout of any measures used to trap sediment. All sediment spilled, dropped, washed or tracked onto public rights-of-way must be removed immediately.
- Washing - Wheels shall be cleaned to remove sediment prior to entrance onto public rights-of-way. When washing is required, it shall be done on an area stabilized with stone and which drains into an approved sediment trapping device.
- Periodic inspection and needed maintenance shall be provided after each rain.

U.S. DEPARTMENT OF AGRICULTURE  
SOIL CONSERVATION SERVICE  
COLLEGE PARK, MD.

STABILIZED CONSTRUCTION ENTRANCE

Standard Drawing  
SCE-1

### CONSTRUCTION SEQUENCE SEDIMENT CONTROL PROCEDURES

(FOR AREAS NOT PROTECTED BY ROAD CONSTRUCTION-SEDIMENT CONTROL DEVICES)

- Obtain Sediment Control Permit.
- Construct continuous sediment barrier for all Disturbed Areas not protected by sediment traps.
- Clear, grub and strip as required. Protect stream from erosion of stored top soil, separate top soil from subsoil.
- Construct pipelines.
- All excavated material shall be stockpiled on high side of trench.
- Restore erosion control structures disturbed by sewer and water construction.
- Stabilize disturbed area as construction progresses with temporary seeding and mulching (or permanent restoration).
- Complete permanent restoration.
- All sediment control devices shall remain in service until removal is approved by the SCS inspector.
- Restoration (temporary or permanent) of an area between manholes or 400' watermain section shall follow within one week of pipelaying in this area.
- Disturbed Areas shall be restricted to 20' Easements.

U.S. DEPARTMENT OF AGRICULTURE  
SOIL CONSERVATION SERVICE  
COLLEGE PARK, MARYLAND

CONSTRUCTION SEQUENCE  
SEDIMENT CONTROL PROCEDURES

STANDARD DRAWING  
SCE-1

### RIP-RAP DETAIL

**CONSTRUCTION SPECIFICATIONS**

- Erosion Control Fabric shall be Poly-Filter-X as manufactured by Carthage Mills, Inc., Erosion Control Division, 124 West 66th Street, Cincinnati, Ohio; Laurel Erosion Control Cloth as manufactured by Laurel Plastics Inc., Madison, Missouri, or equal.
- Rip-Rap shall be placed 6" each side & over or as shown. Any disturbance to stream banks beyond these limits shall be protected with Rip-Rap at Contractor's expense.
- Gabions may be used in lieu of Rip-Rap.

U.S. DEPARTMENT OF AGRICULTURE  
SOIL CONSERVATION SERVICE  
COLLEGE PARK, MARYLAND

RIP-RAP DETAIL

STANDARD DRAWING  
ED-1

DEPARTMENT OF PUBLIC WORKS  
HOWARD COUNTY, MARYLAND

Director of Public Works - DATE  
R. J. ... 12-1-88

Chief - Bureau of Engineering - DATE  
... 11-29-88

Chief - Bureau of Utilities - DATE  
...

WHITMAN, REQUARDT  
AND ASSOCIATES  
ENGINEERS

2315 ST. PAUL ST.  
BALTIMORE, MARYLAND

DES. J.W.B.  
CHK. R.L.P.  
CHK. R.B.W.

DATE 8/24/88

SEDIMENT CONTROL  
DETAILS

600' SCALE MAP NO. \_\_\_\_\_ BLOCK NO. \_\_\_\_\_

MONTGOMERY ROAD SEWER MAIN  
ELECTION DISTRICT NO. 1  
HOWARD COUNTY  
CONTRACT NO. 10-1602

SCALE AS SHOWN  
SHEET 5 OF 5