


PROFILE
HOR: 1"=50'
VERT: 1"=5'

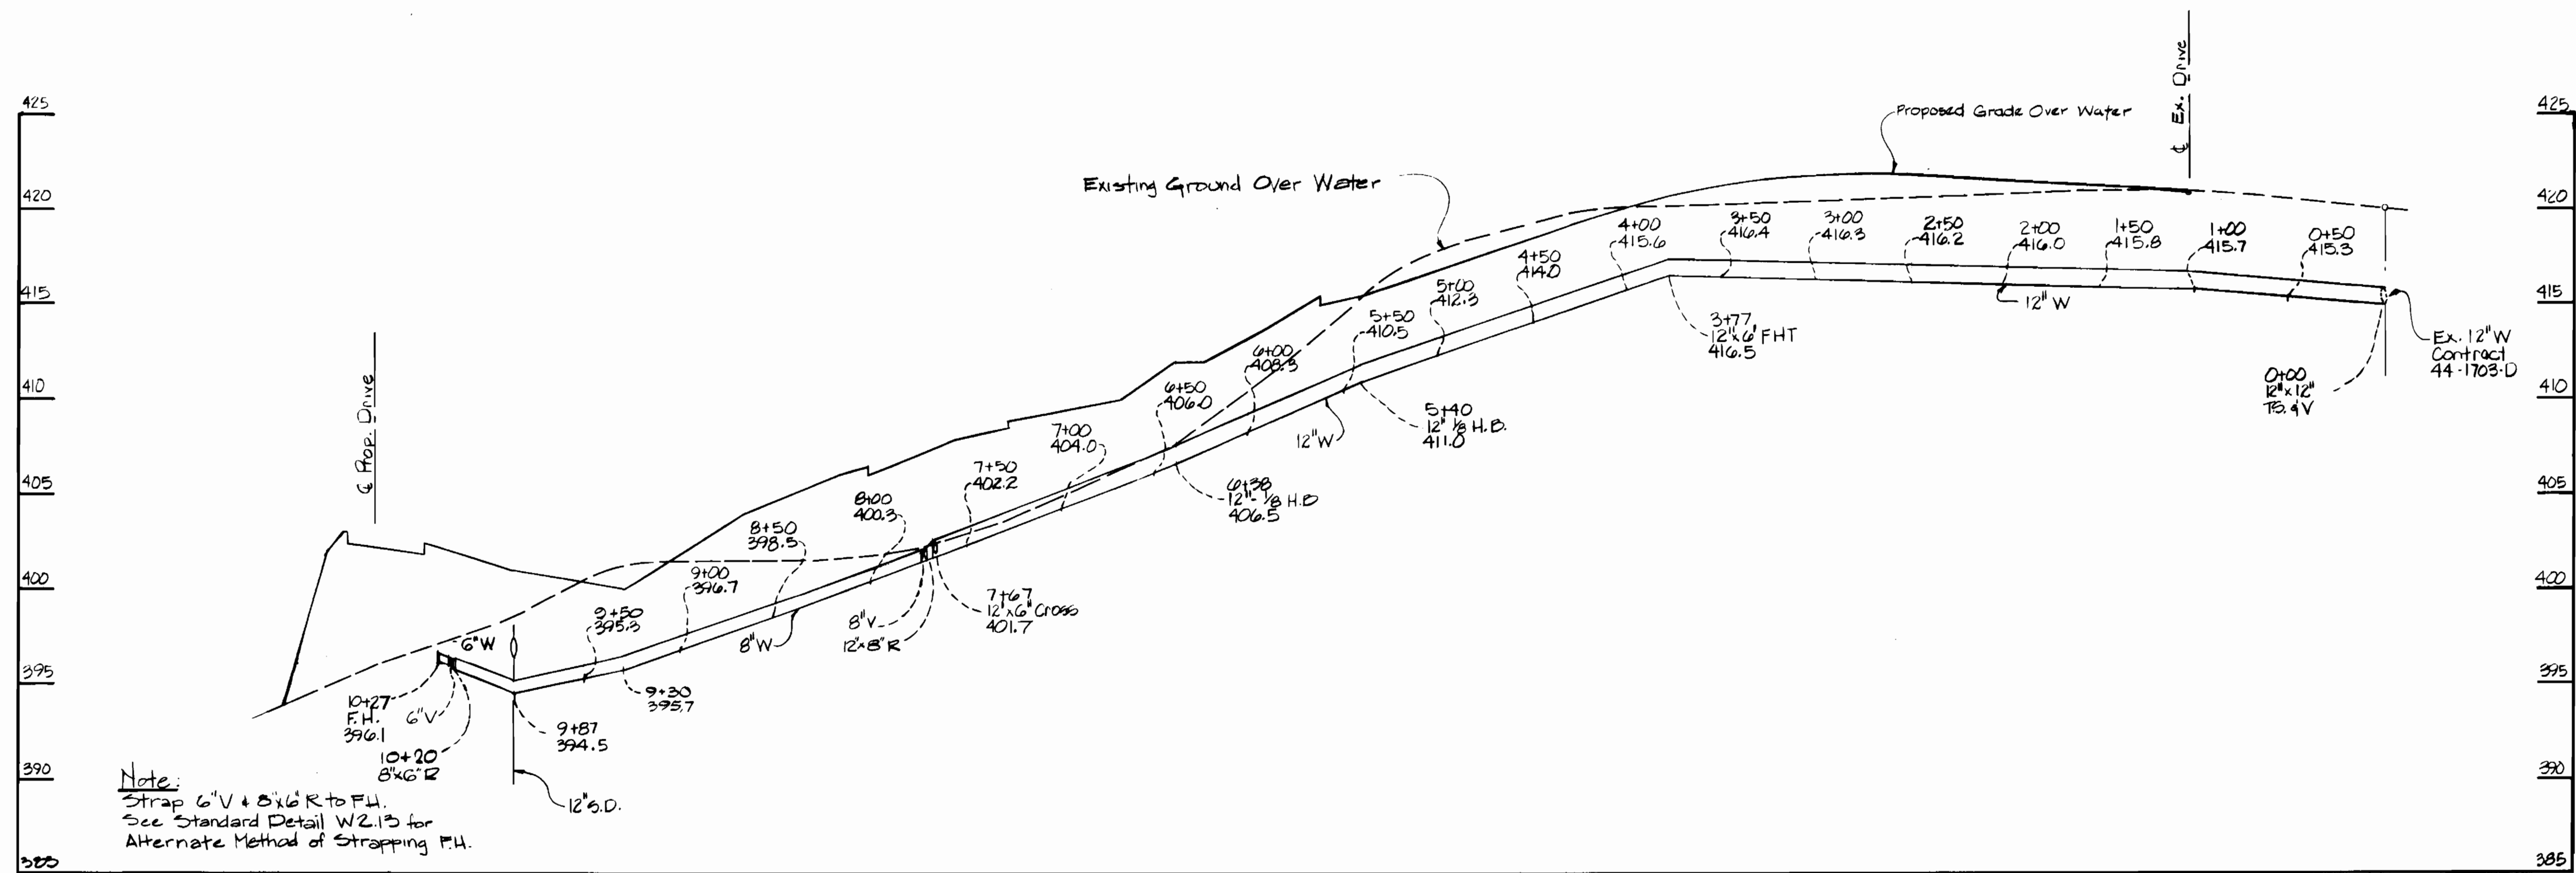

PROFILE
HOR: 1"=50'
VERT: 1"=5'

Note:
Strap 6" V + 8" x 6" R to F.H.
See Standard Detail W2.13 for
Alternate Method of Strapping F.H.

DEPARTMENT OF PUBLIC WORKS HOWARD COUNTY, MARYLAND Director of Public Works <i>Robert B. ...</i> 1-5-98 CHIEF - BUREAU OF UTILITIES - DATE	WHITMAN, REQUARDT AND ASSOCIATES ENGINEERS 2315 ST. PAUL ST BALTIMORE, MARYLAND <i>James M. ...</i> 1/2/89 CHIEF - LAND DEVELOPMENT DIVISION - DATE		DES: J.W.B.			WATER PROFILES	WESTVACO CORPORATION LAUREL RESEARCH CENTER JOHNS HOPKINS ROAD ELECTION DISTRICT 5 CONTRACT NO. 44-1882-D	SCALE AS SHOWN
			DRN: G.R.					SHEET 2 OF 2
DATE: 1/2/89			CHK: L.J.D.			BY: NO. _____ REVISION _____ DATE _____	600' SCALE MAP NO. _____ BLOCK NO. _____	AS-BUILT 7-3-89