


SEWER AS-BUILTS

LOTS	STRUCTURE	DIST.	STRUCTURE	DIST.	STRUCTURE	DIST.
56	MH#1	40.8'	MH#2	83.4'	F.H.#1	150.7'
57	"	47.8'	"	75.4'	"	141.8'
42	"	64.5'	"	43.7'	"	113.2'
58	"	107.7'	"	36.5'	"	79.4'
59	MH#3	33.2'	"	48.9'	"	54.6'
43	"	88.4'	"	26.7'	"	51.3'
60	"	66.2'	STORMDRAIN I-2	44.9'	STORMDRAIN I-3	10.8'
61	"	95.4'	"	56.6'	"	38.8'
62	"	106.8'	"	65.4'	"	50.0'
52	"	128.9'	"	74.5'	"	85.8'
53	"	189.5'	"	136.0'	"	142.4'
63	"	174.6'	"	126.6'	"	119.5'
54	MH#4	83.0'	"	206.2'	"	211.1'
51	MH#3	114.7'	MH#5	60.8'	3" VALVE FOR BLOWOFF	65.7'
50	"	135.0'	"	55.2'	"	51.7'
49	BLOWOFF HYD.	27.5'	"	42.1'	"	26.7'
48	"	19.3'	"	38.6'	"	18.9'
47	MH#3	161.0'	"	28.5'	"	20.5'
46	"	150.0'	"	30.0'	"	39.5'
45	"	148.4'	"	31.7'	"	43.0'
44	"	106.3'	"	55.0'	"	80.3'
64	MH#4	118.9'	STORMDRAIN I-2	180.3'	STORMDRAIN I-3	175.2'
65	"	92.1'	STORMDRAIN M-1	100.8'	CURB STOP W/C LOT 66	62.0'
66	"	76.6'	"	86.1'	"	44.8'
67	"	36.4'	"	4.70'	CURB STOP W/C LOT 65	23.1'
68	STORMDRAIN M-2	92.4'	STORMDRAIN M-3	134.8'	F.H.#2	126.6'
69	"	163.8'	"	61.0'	"	191.2'

WATER AS-BUILTS

LOTS	STRUCTURE	DIST.	STRUCTURE	DIST.	STRUCTURE	DIST.
56	MH#1	36.2'	MH#2	94.0'	F.H.#1	162.0'
57	"	96.0'	"	36.0'	"	89.0'
42	"	75.0'	"	33.8'	"	102.6'
58	"	100.2'	"	35.4'	"	85.1'
43	MH#3	52.6'	"	61.7'	"	13.8'
59	"	49.6'	STORMDRAIN I-2	44.8'	STORMDRAIN I-3	16.2'
60	"	77.9'	"	45.7'	"	20.6'
61	"	83.2'	"	48.9'	"	25.9'
62	"	158.4'	"	111.0'	"	103.2'
51	"	115.9'	"	61.3'	"	74.4'
52	"	176.4'	"	122.8'	"	129.9'
63	"	163.5'	"	115.9'	"	108.2'
50	"	144.2'	MH#5	49.9'	3" VALVE FOR BLOWOFF	41.2'
49	"	146.5'	"	47.2'	"	36.9'
48	"	156.0'	"	32.3'	"	11.0'
47	BLOWOFF HYD METER	10.3'	"	29.2'	"	11.3'
46	MH#3	158.0'	"	28.0'	"	27.5'
45	"	147.0'	"	35.1'	"	49.8'
44	"	121.7'	"	47.3'	"	70.2'
64	MH#4	107.7'	STORMDRAIN I-2	190.0'	STORMDRAIN I-3	185.8'
65	"	102.7'	"	195.2'	"	191.0'
66	"	40.8'	STORMDRAIN M-1	52.3'	CURB BOX W/C LOT 65	74.0'
67	"	63.0'	STORMDRAIN M-1	67.3'	STORMDRAIN M-2	74.0'
68	"	67.0'	"	70.8'	"	70.0'
53	"	101.2'	STORMDRAIN I-2	188.8'	STORMDRAIN I-3	193.4'
54	"	96.5'	"	193.7'	"	198.2'
69	STORMDRAIN M-2	151.3'	STORMDRAIN M-3	75.9'	F.H.#2	182.6'

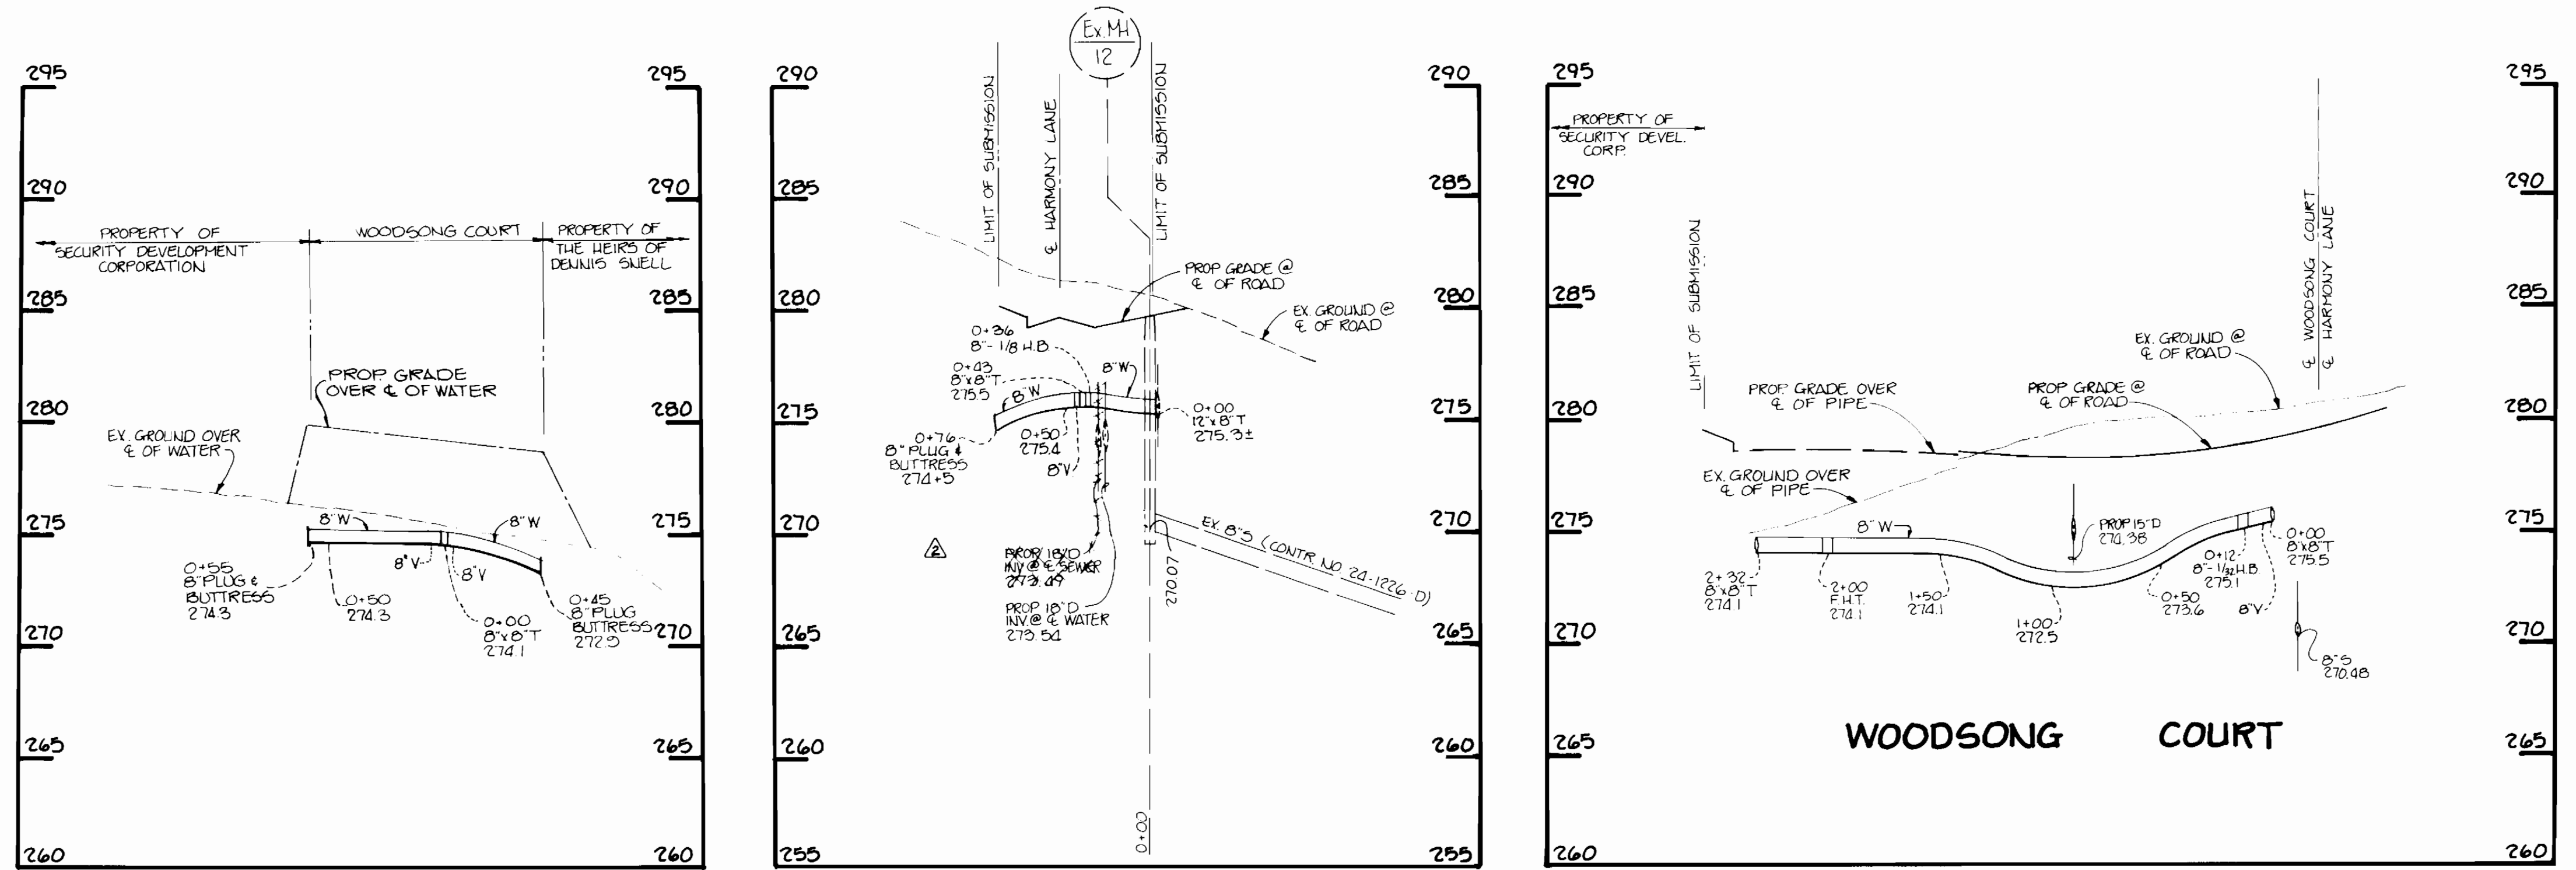

PROFILES SCALE: HORIZ-1"=50' VERT-1"=5'

DEPARTMENT OF PUBLIC WORKS  
HOWARD COUNTY, MARYLAND

TRACY, SCHULTE & ASSOCIATES INC.

planning engineering surveying  
8480 Baltimore National Pike Suite 418  
Ellicott City, Maryland 21043

DES.	DAM/JH	DRN.	JH	CHK.	DATE	BY	NO.	REVISIONS	DATE
					12-14-00			REMOVED PROP 8" @ EX MH 12 ADD 8" WOODSONG CT REV CALLOUT 8" @ KING GRANT	

PROFILES

KINGS WOODS  
SECTION 1, AREA 2  
ELECTION DISTRICT NO. 6  
CONTRACT NO. 24-1925-D

SCALE AS SHOWN

SHEET 2 OF 2